



Unit 2
Sept. 10, 1958

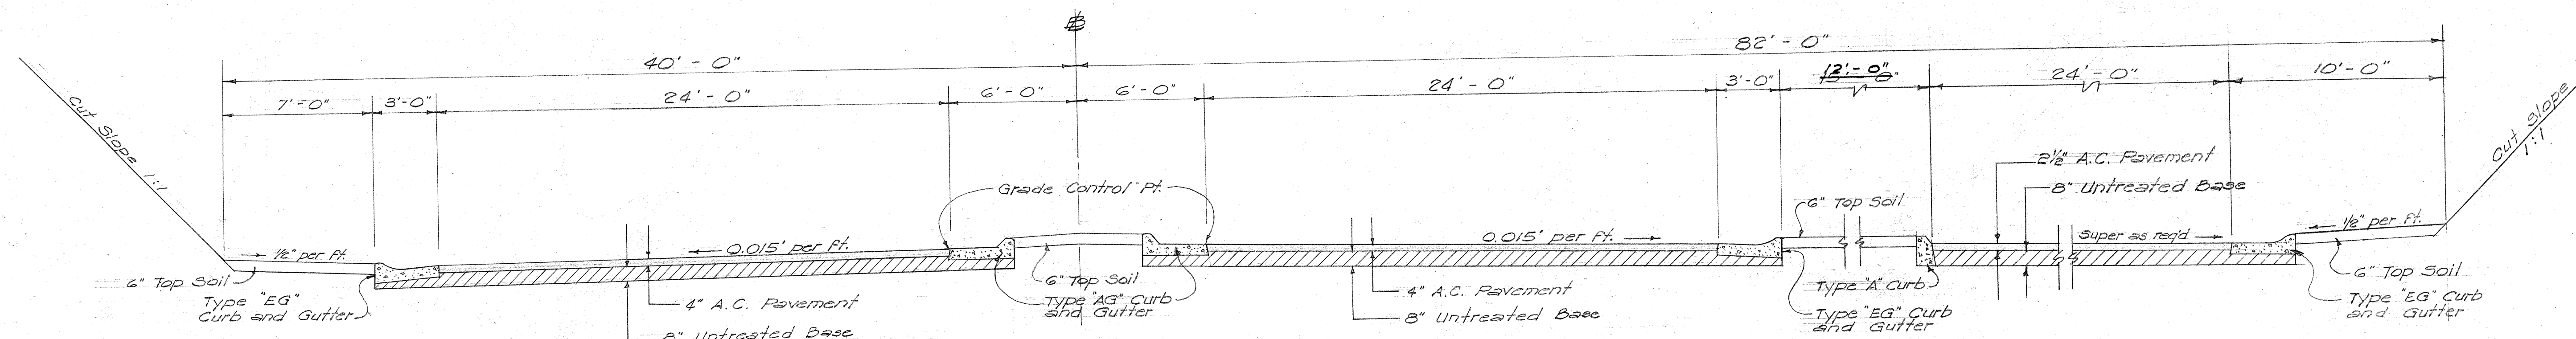

TYPICAL SECTION ON TANGENTS
Scale: 1/4" = 1'-0"

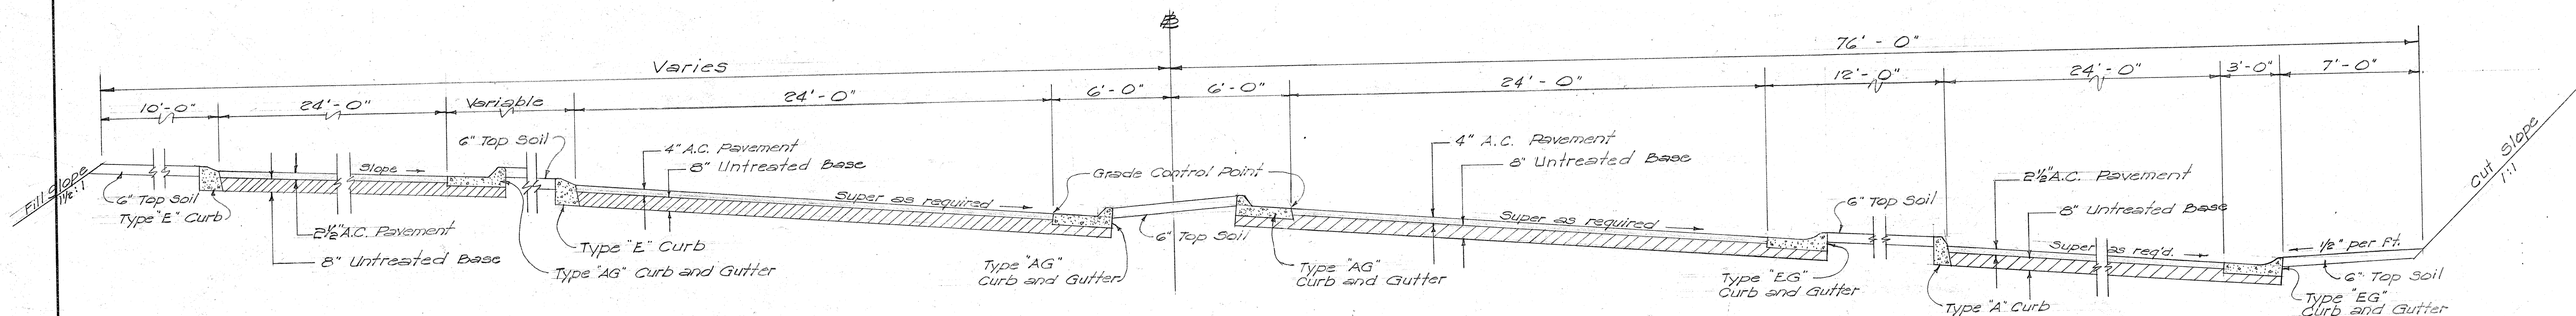


TYPICAL SECTION ON CURVES
STA. 335+00 ± to 346+00 ±
Scale: 1/4" = 1'-0"

GENERAL NOTES

- Pavement shall be Asphalt Concrete 4" and 2 1/2" thick when fully compacted. It shall be laid in two courses as follows:
 - 4" Pavement - A 2 1/2" Leveling Course using Mix II and a 1 1/2" Surface Course using Mix I.
 - 2 1/2" Pavement - A 1 1/2" Leveling Course using Mix III and a 1" Surface Course using Mix I.
- Base Course shall be Untreated Base, 8" compacted thickness placed in two layers of 4" compacted thickness each, and consisting of Mineral Aggregate uniformly graded from coarse to fine (2 1/2" to #200).

Both above courses subject to Specifications and Special Prov.

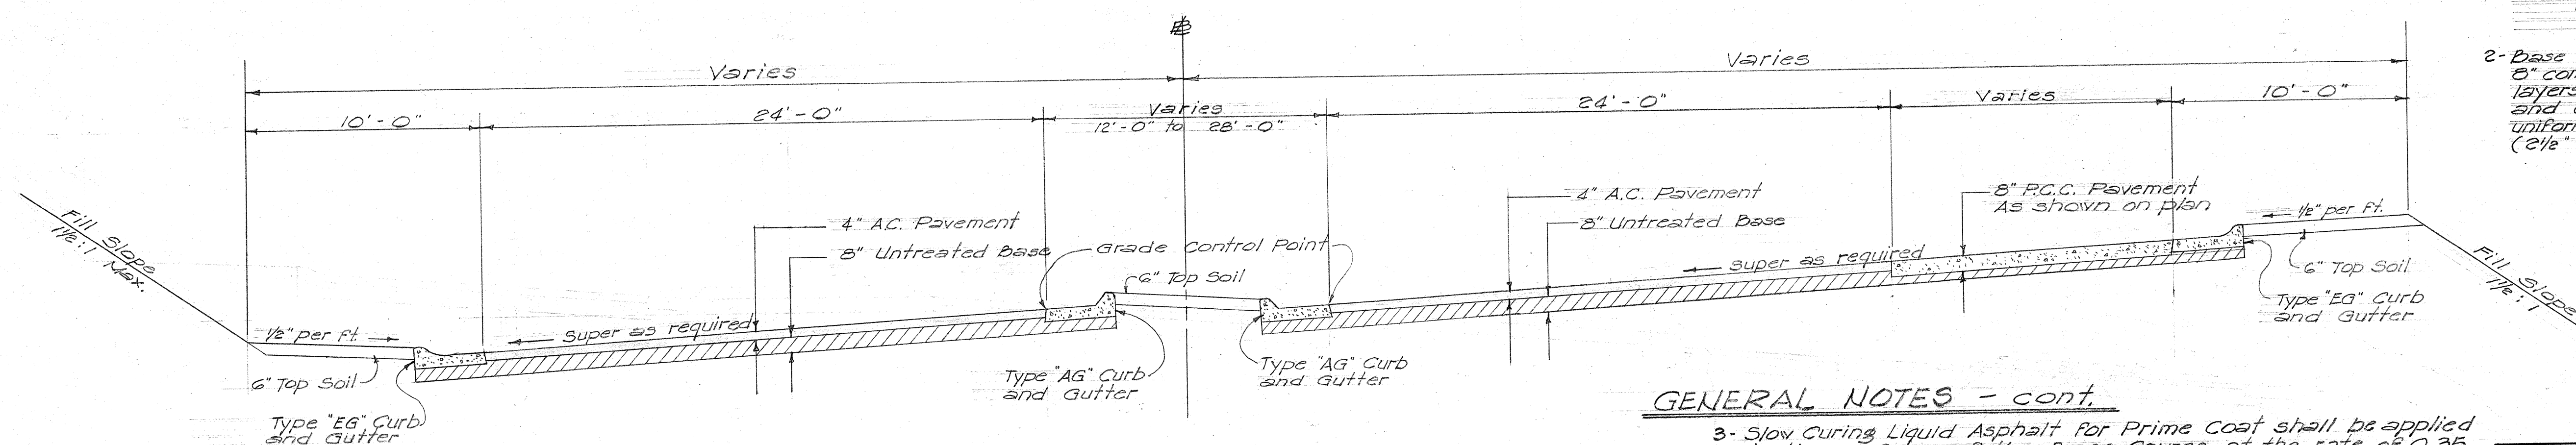

TYPICAL SECTION ON CURVES
STA. 316+00 to 320+00 ±
Scale: 1/4" = 1'-0"

GENERAL NOTES - cont.

- Slow Curing Liquid Asphalt for Prime Coat shall be applied to the surface of the Base Course at the rate of 0.35 gal. per sq. yd. before placing the Leveling Course.
- Portland Cement Concrete Pavement shall not be reinforced with bars or wire mesh except where bar reinforcement is required by the Engineer for protection of certain sub-structures. No longitudinal Contact Joints are permitted. Pavement shall be paved full width. Weakened Plane Joints shall be installed approximately 30 ft. on centers. No Expansion Joints are required. All PCC Pavements to be 8" thick unless otherwise noted.

TERRITORIAL HIGHWAY DEPARTMENT
TERRITORY OF HAWAII


TYPICAL SECTIONS
MOANALUA ROAD
PROJ. NO. 5-0720(1)
UNIT 2

Scale: 1/4" = 1'-0" March 1958


SHEET NO. 1 OF 2 SHEETS

5444.2


DATE:
DESIGNED BY:
CHECKED BY:
ORIGINAL PLAN:
NOTE BOOK:
NO.:

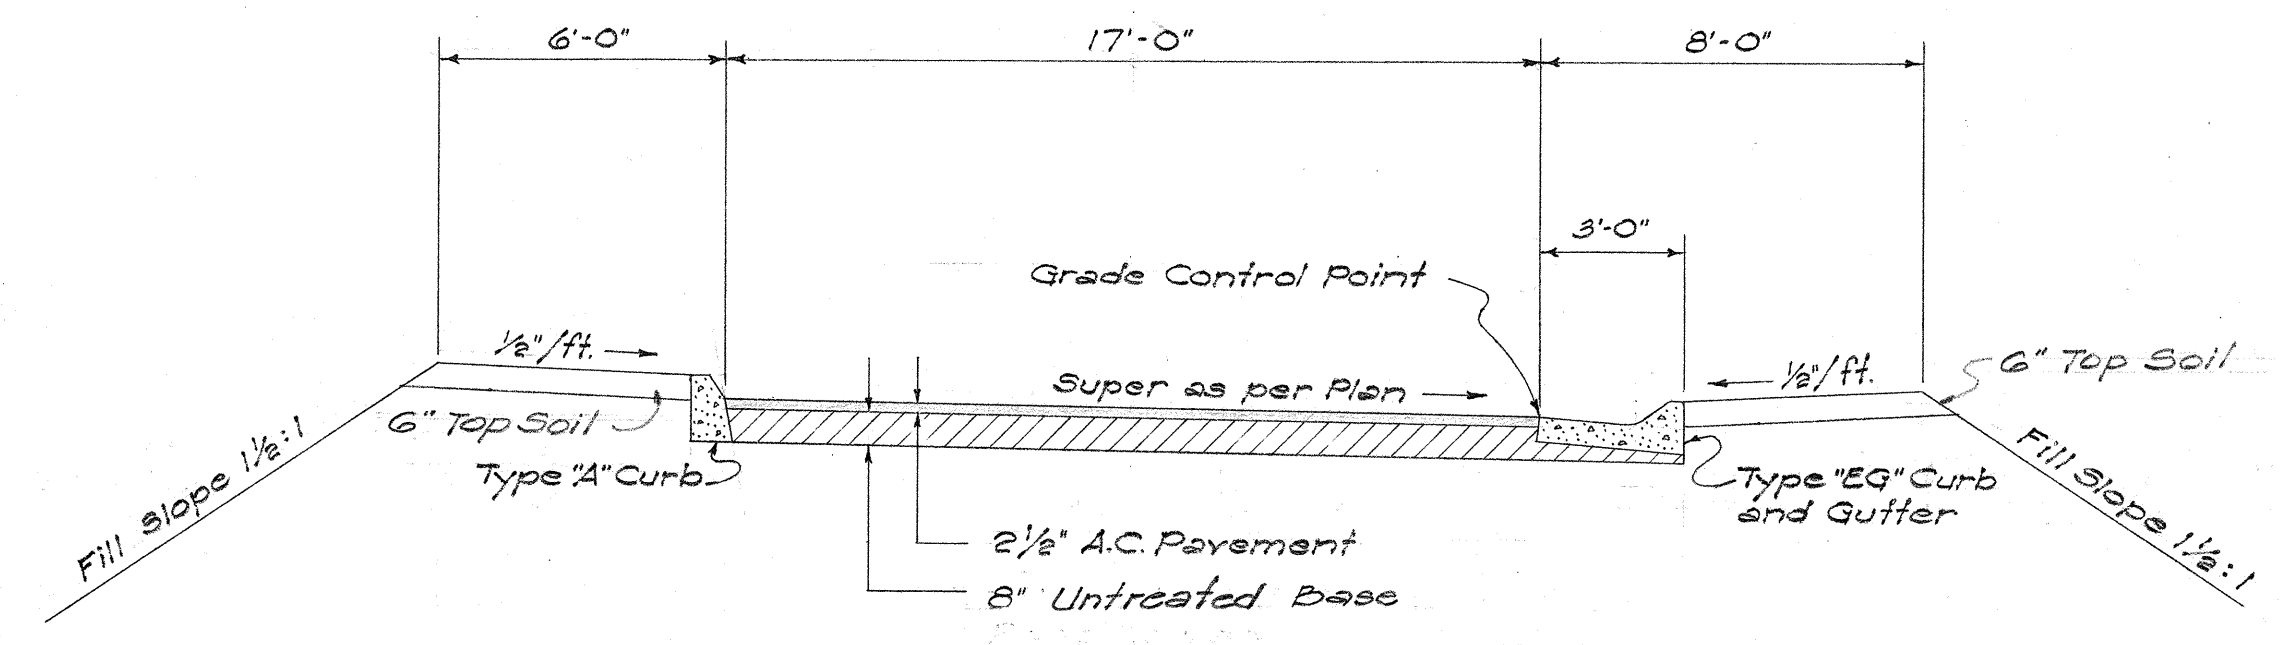


TYPICAL SECTION ON WEST & SOUTH LOOPS
Scale: 1/4" = 1'-0"

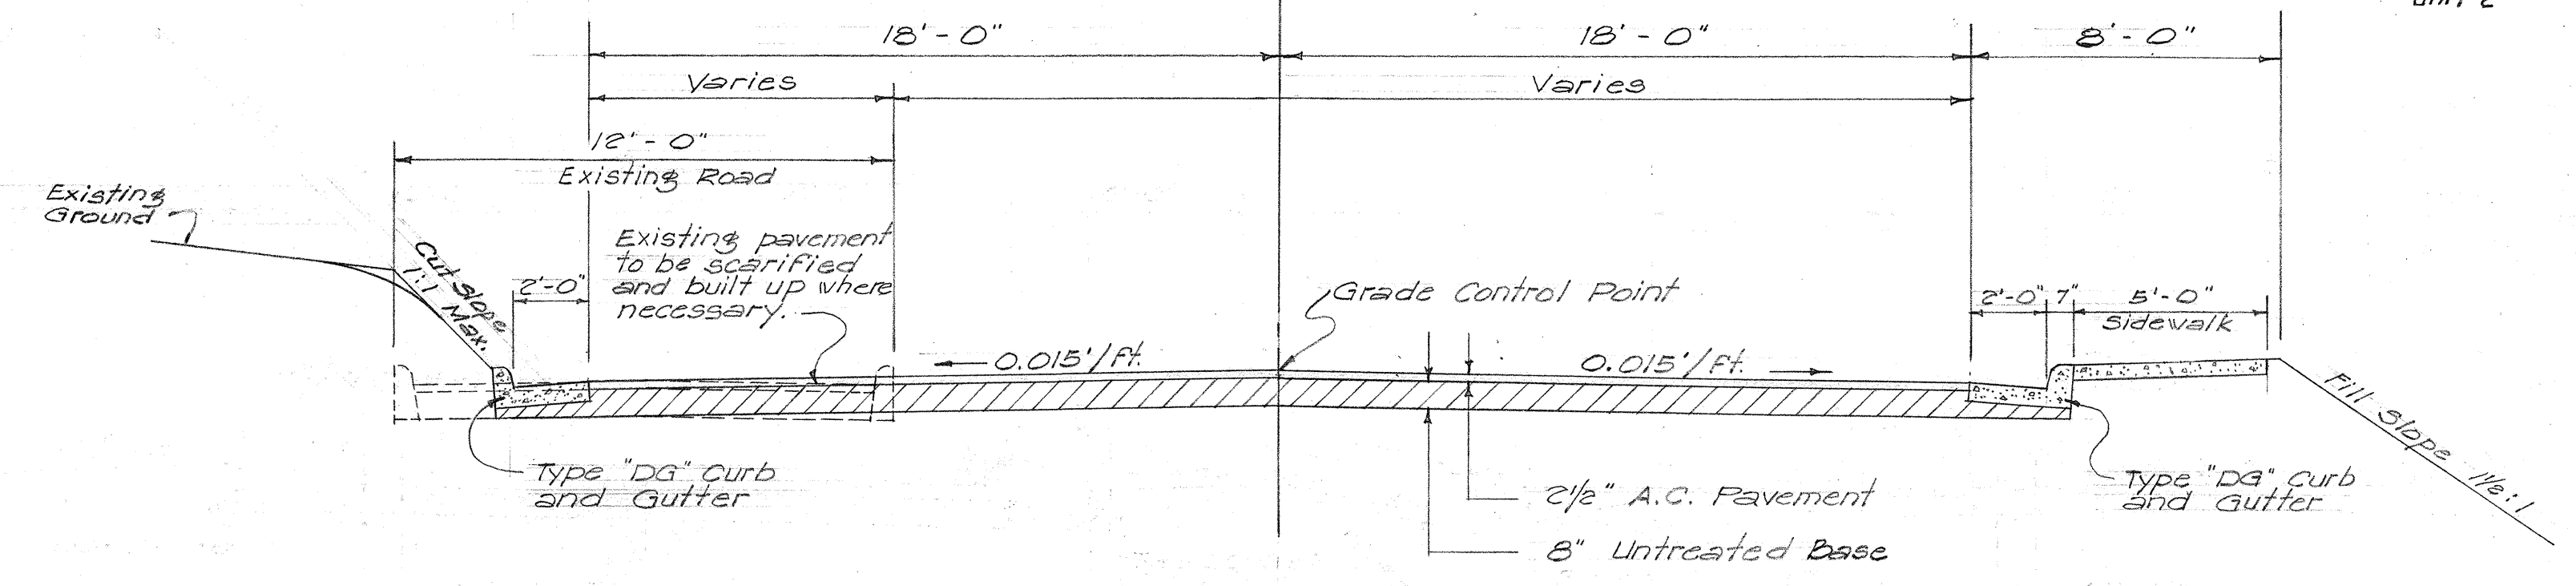


TYPICAL SECTION ON "E" STREET
Scale: 1/4" = 1'-0"

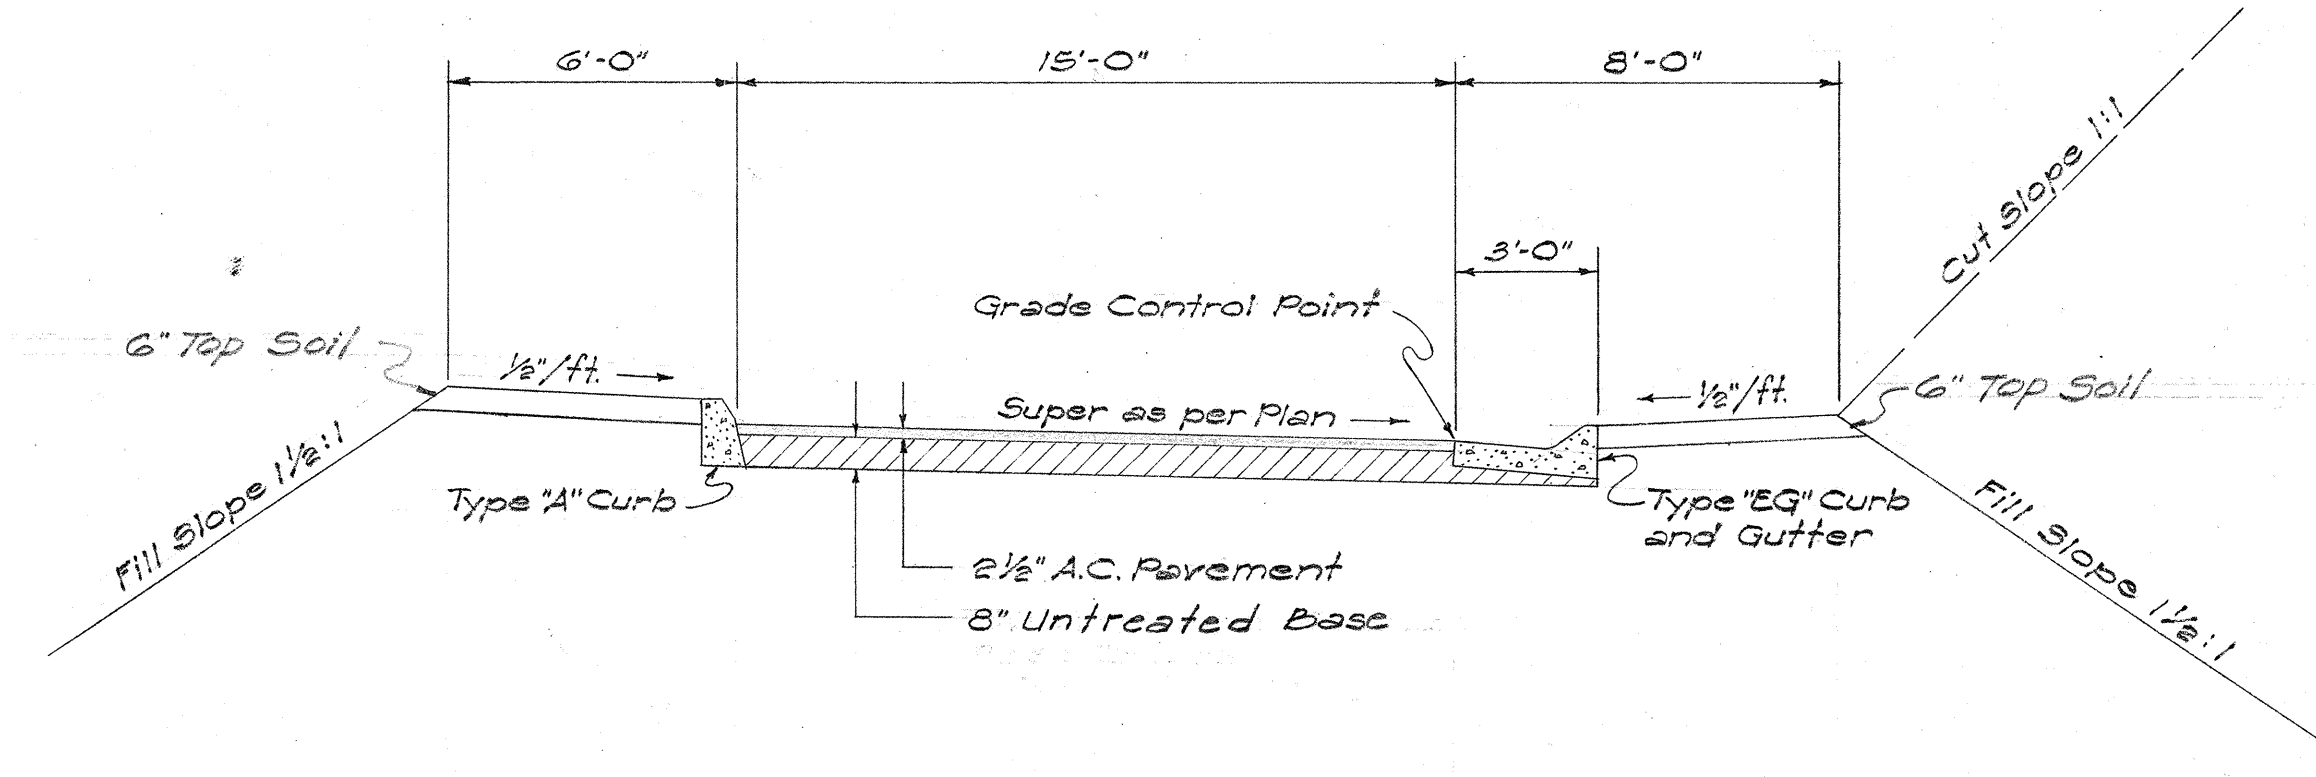


TYPICAL SECTION ON RAMPs
Scale: 1/4" = 1'-0"

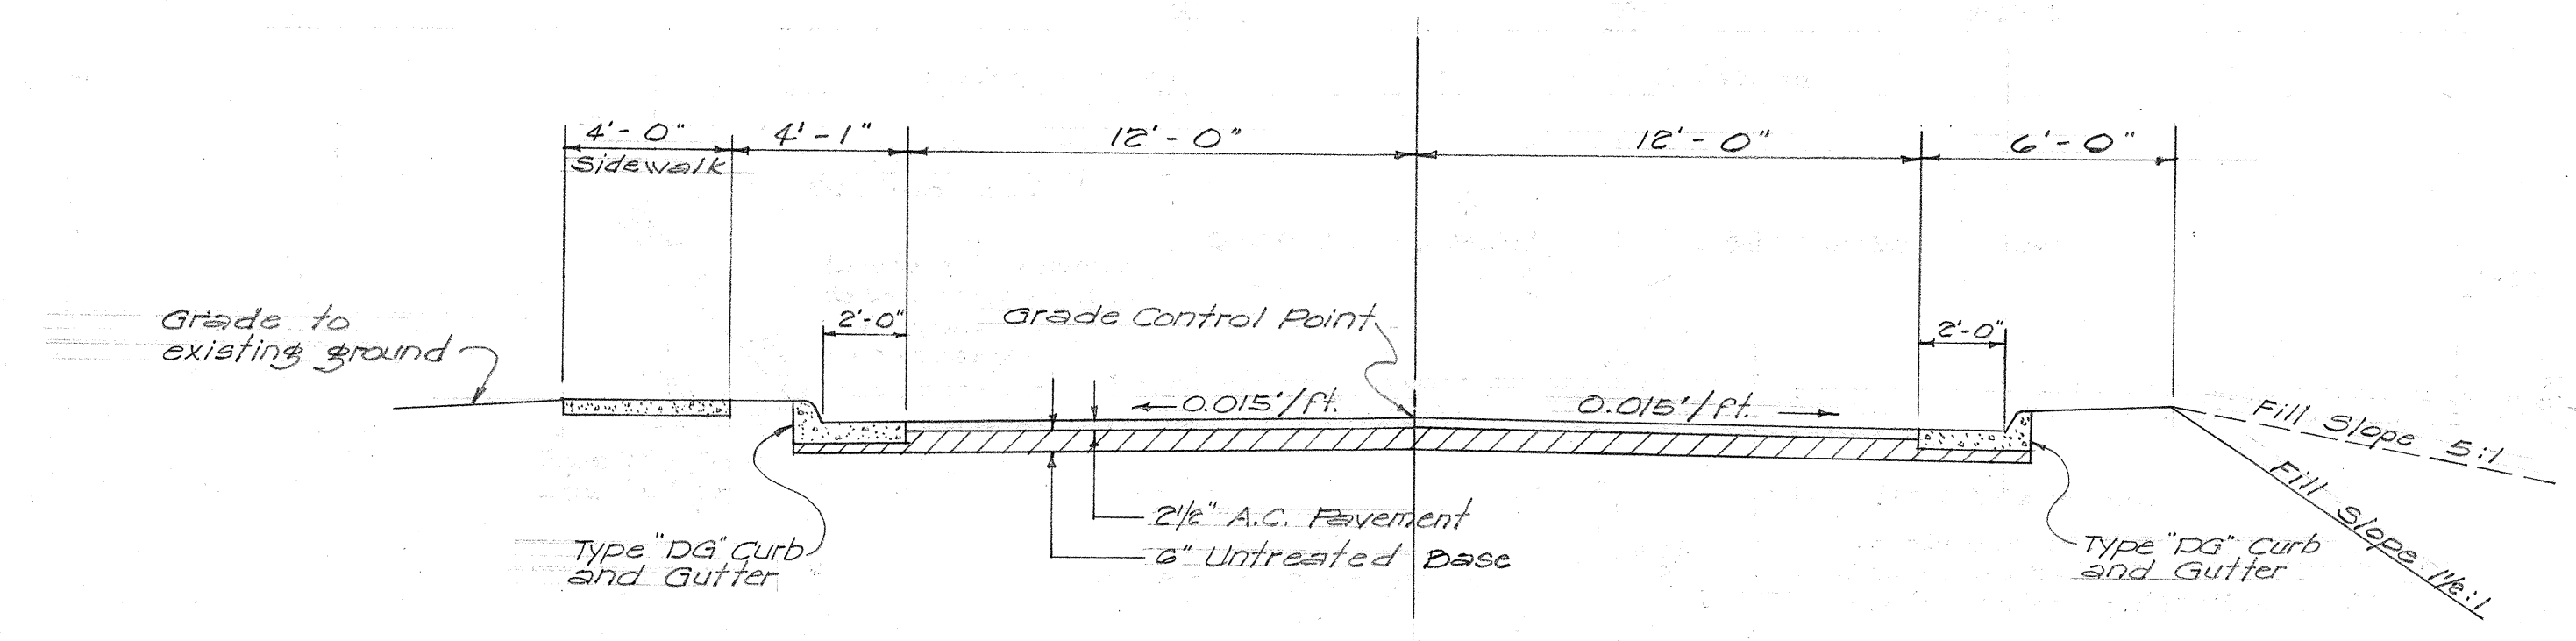


TANGENT SECTION
STA. 0+00 to 1+75 ±

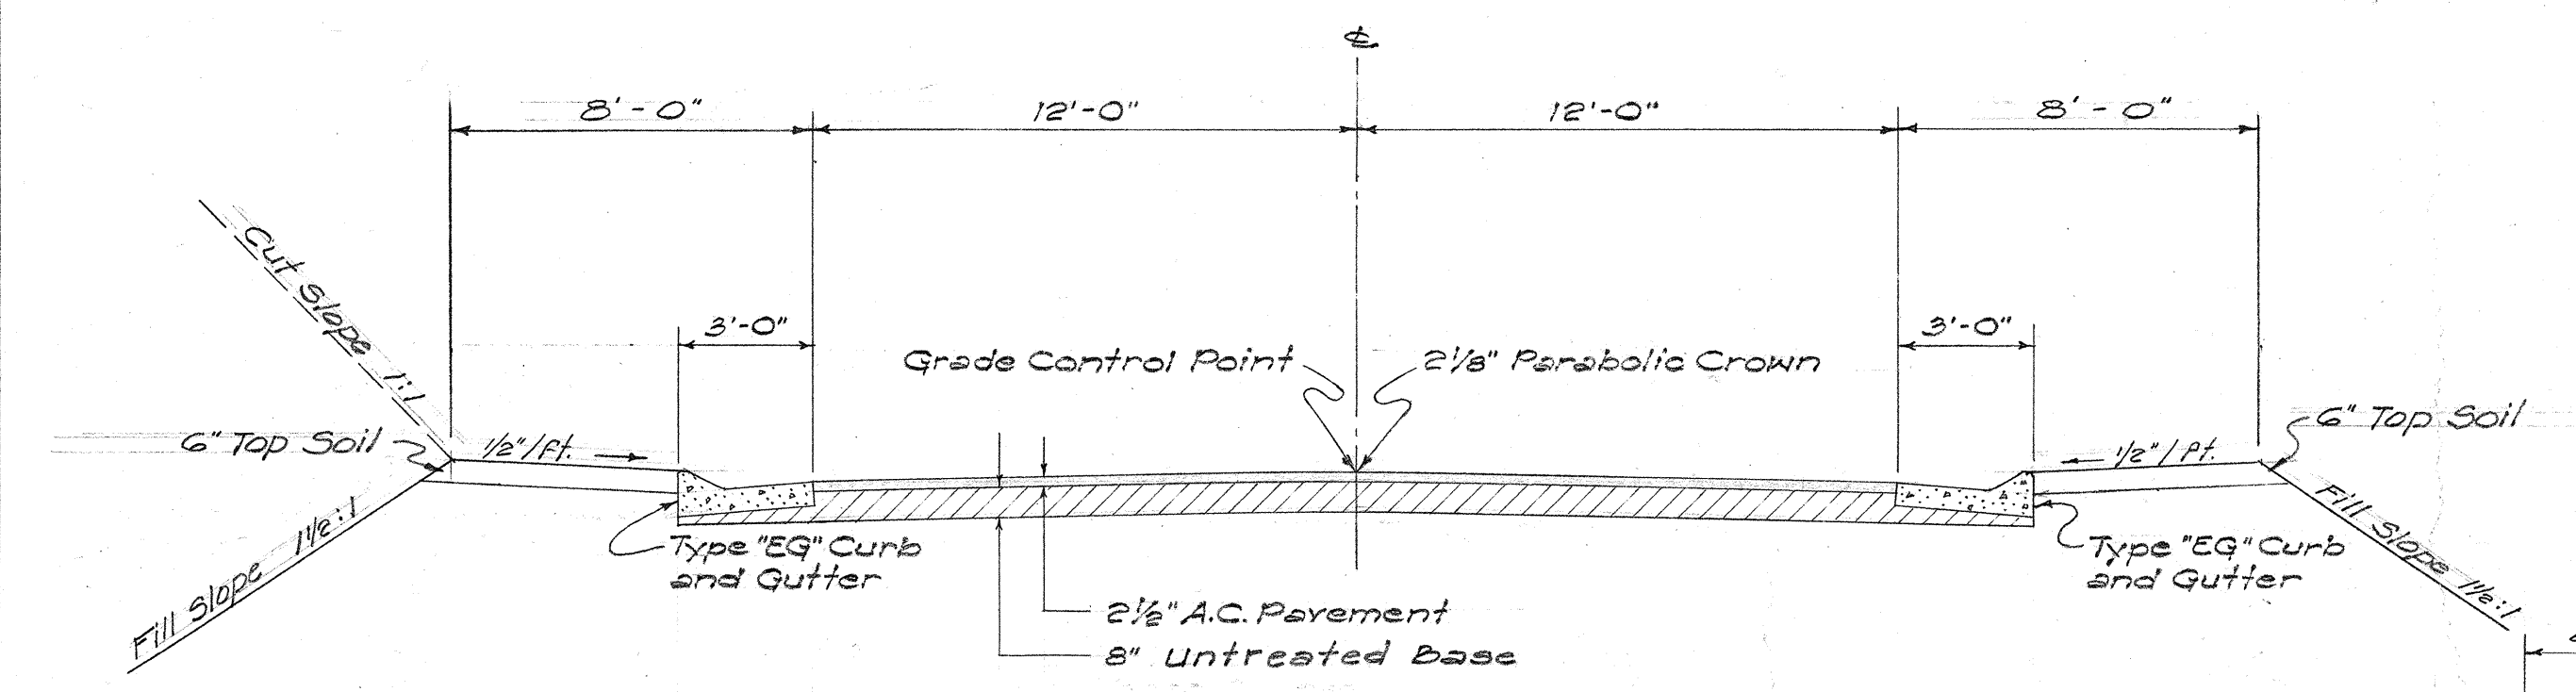


TYPICAL SECTION ON FORT SHAFTER ACCESS ROAD
Scale: 1/4" = 1'-0"

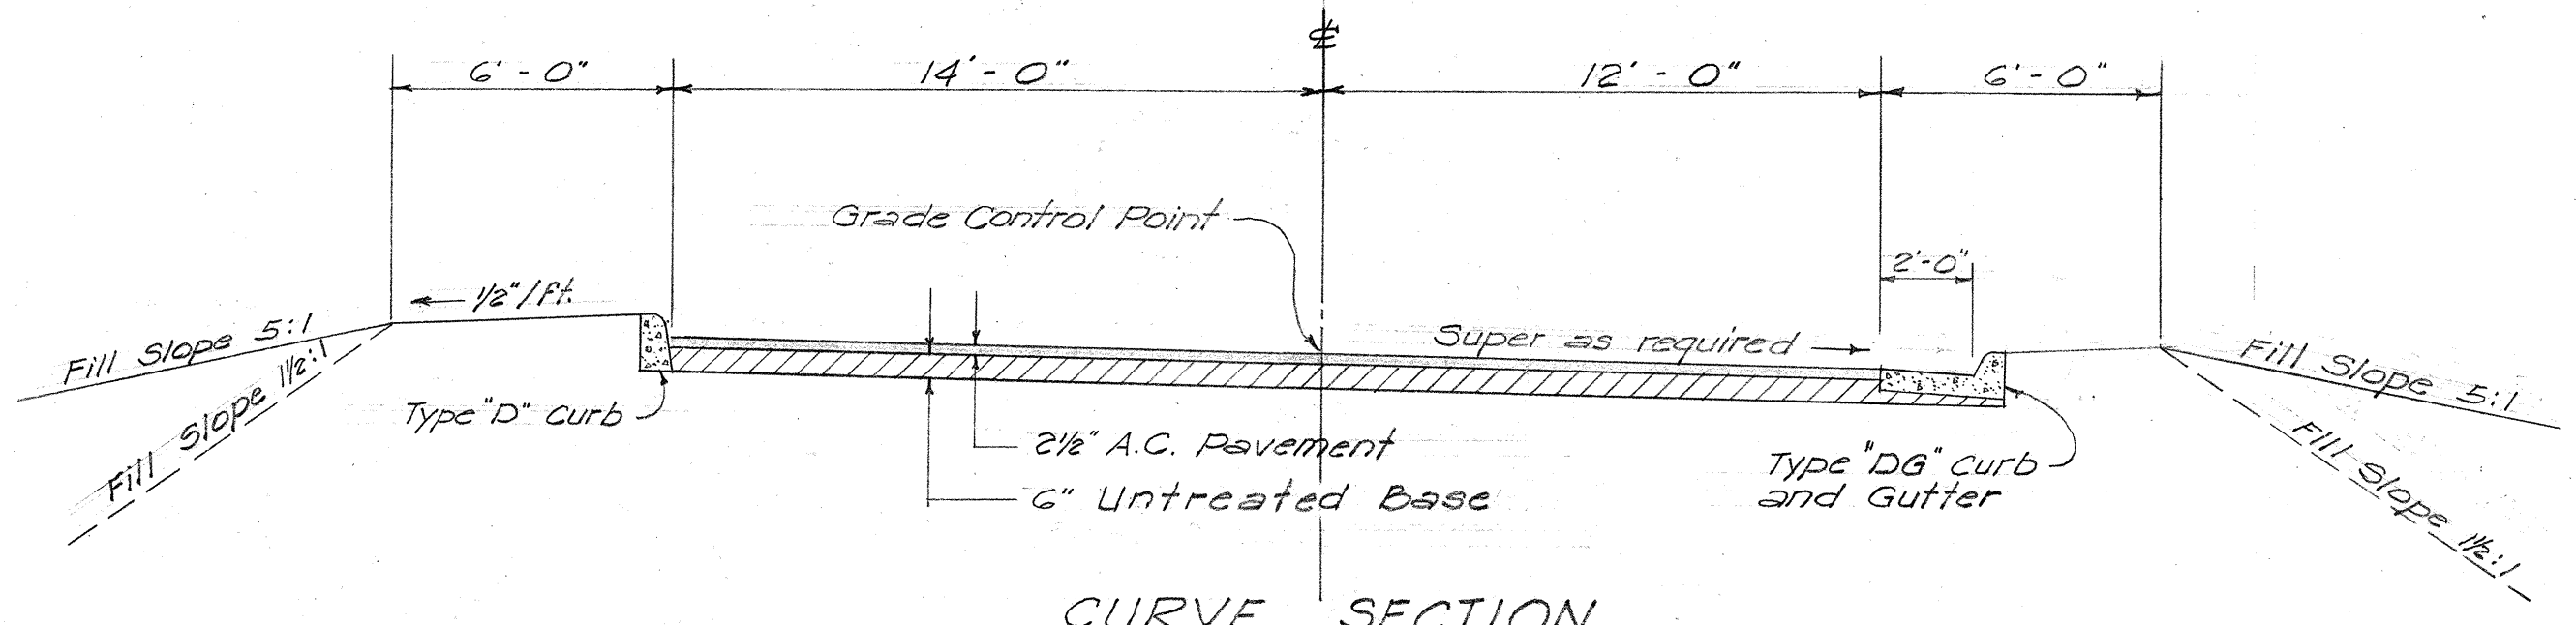

CURVE SECTION

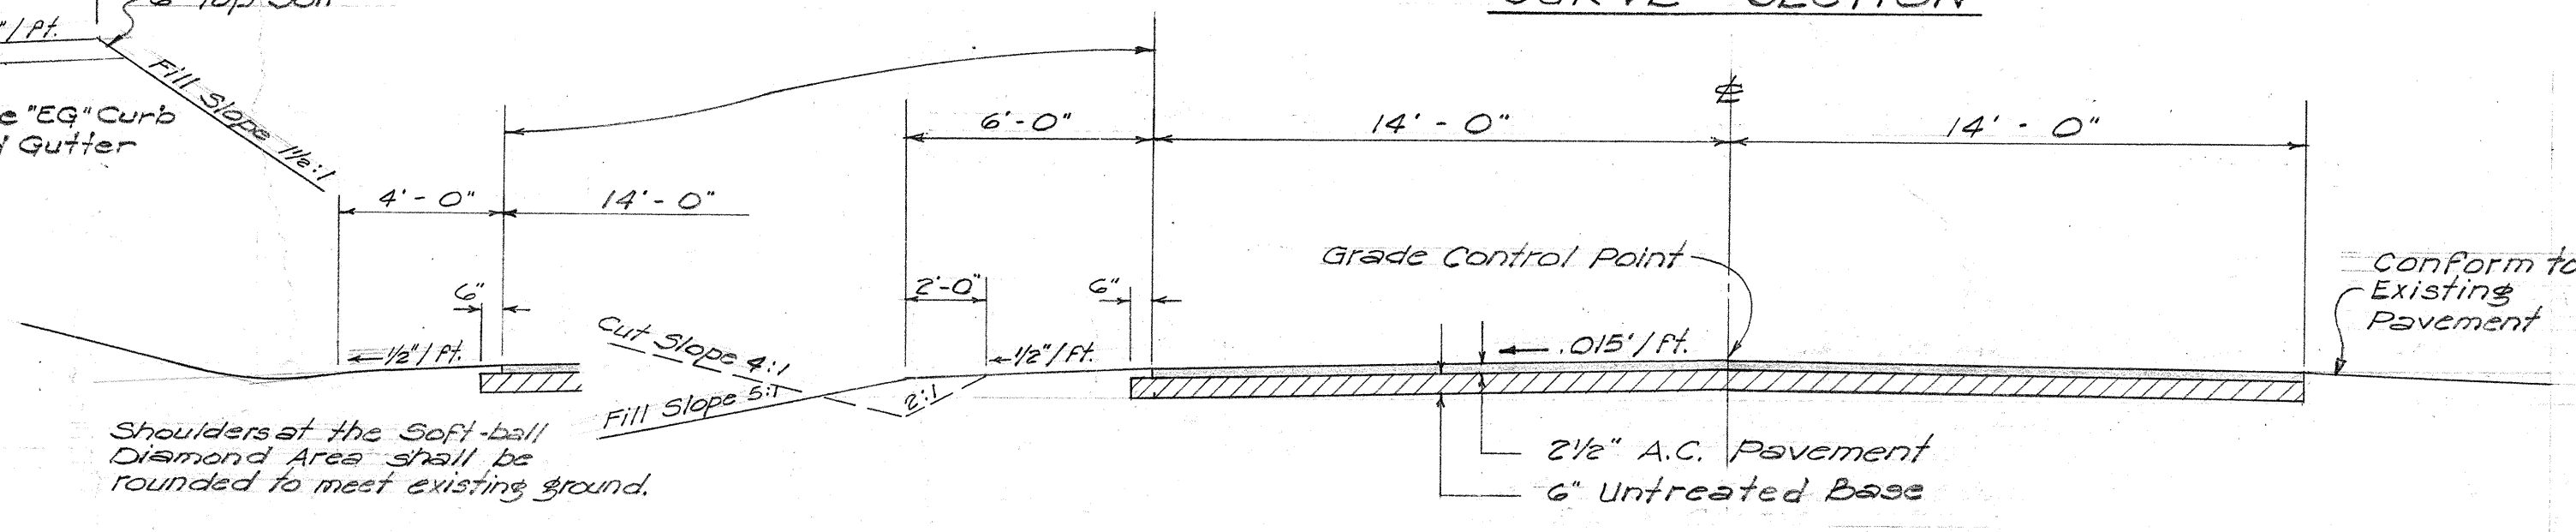

SHOULDER SECTION AT THE SOFT-BALL DIAMOND AREA

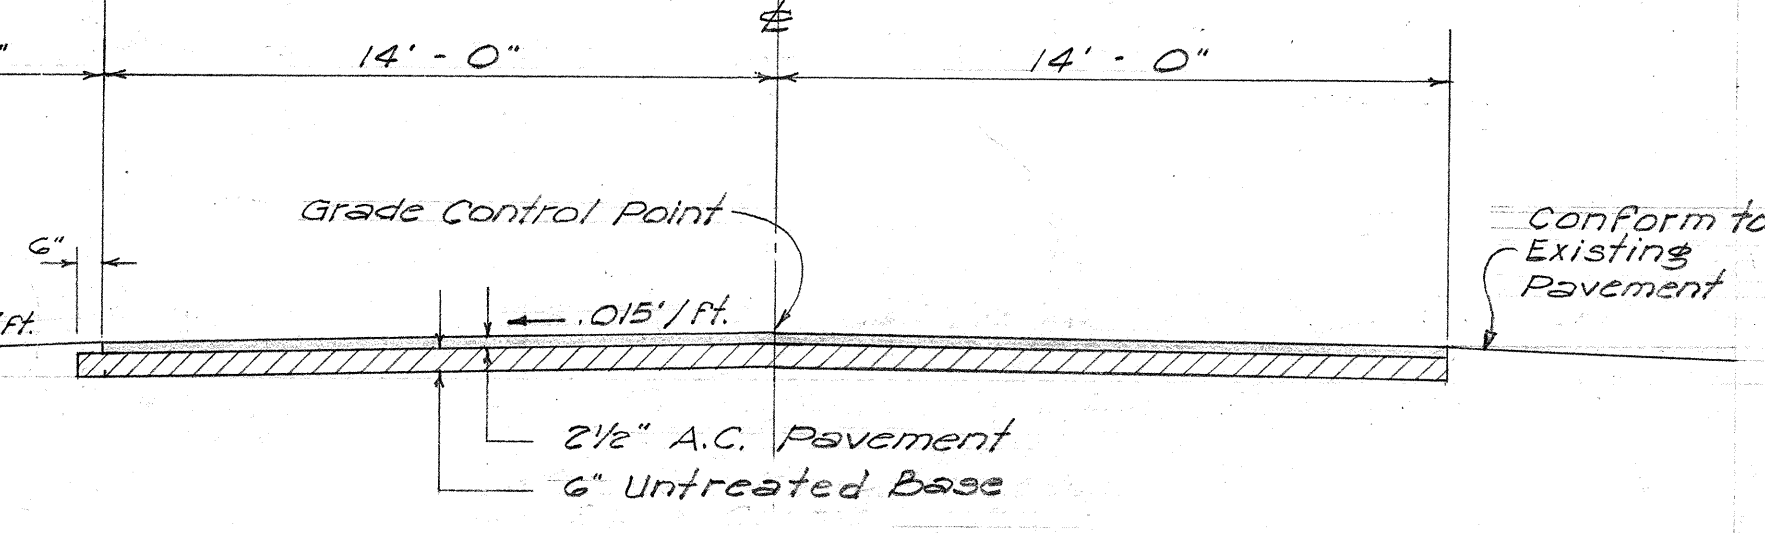

TANGENT SECTION

TYPICAL SECTIONS ON PEACE ST.
Scale: 1/4" = 1'-0"

NOTE:
Use 5:1 Fill Slope for Fill 3 Feet or less.
Use 1 1/2:1 Fill Slope for Fill more than 3 Feet.

TERRITORIAL HIGHWAY DEPARTMENT
TERRITORY OF HAWAII

TYPICAL SECTIONS
MOANALUA ROAD
PROJ. NO. S-0720(1)
UNIT 2

Scale: 1/4" = 1'-0" March 1958

DATE: _____
DESIGNED BY: _____
CHECKED BY: _____
ORIGINAL PLAN: _____
NOTE BOOK: _____
NO. _____