






FED. ROAD DIST. NO.	STATE	FED. AID PROJ. NO.	FISCAL YEAR	SHEET NO.	TOTAL SHEETS
HAWAII	HAW	US-5-0720(3) UNIT 3	1960	21	77

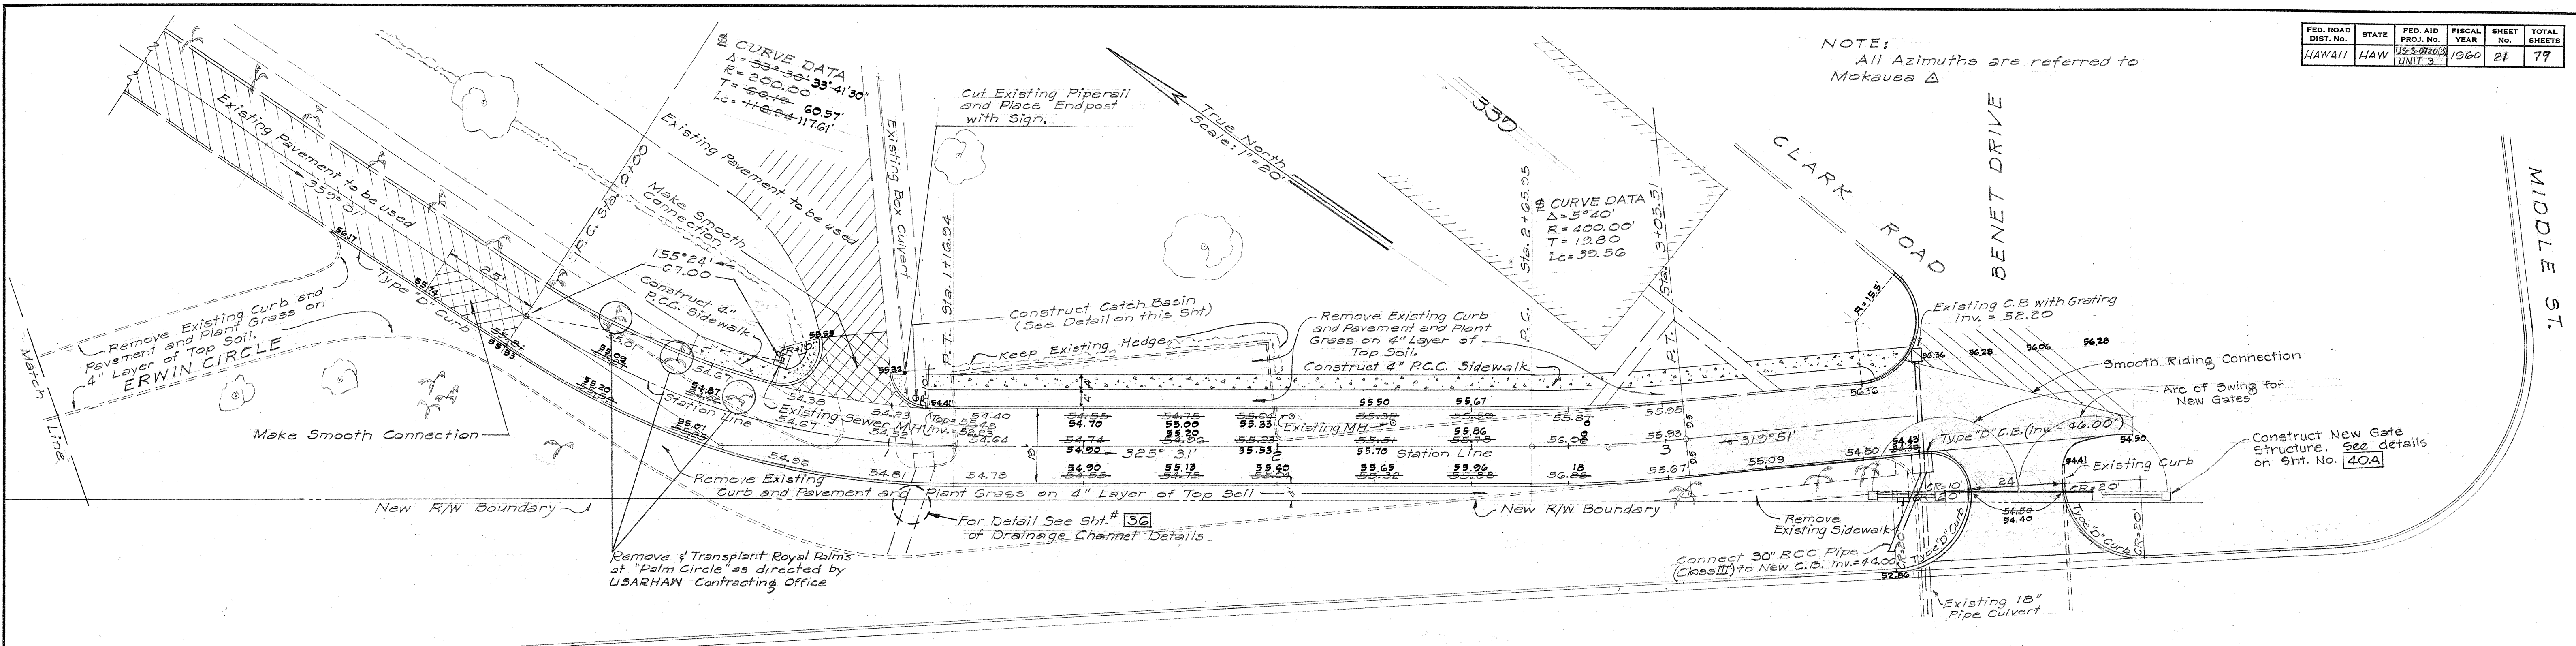


RAMP "M-1"

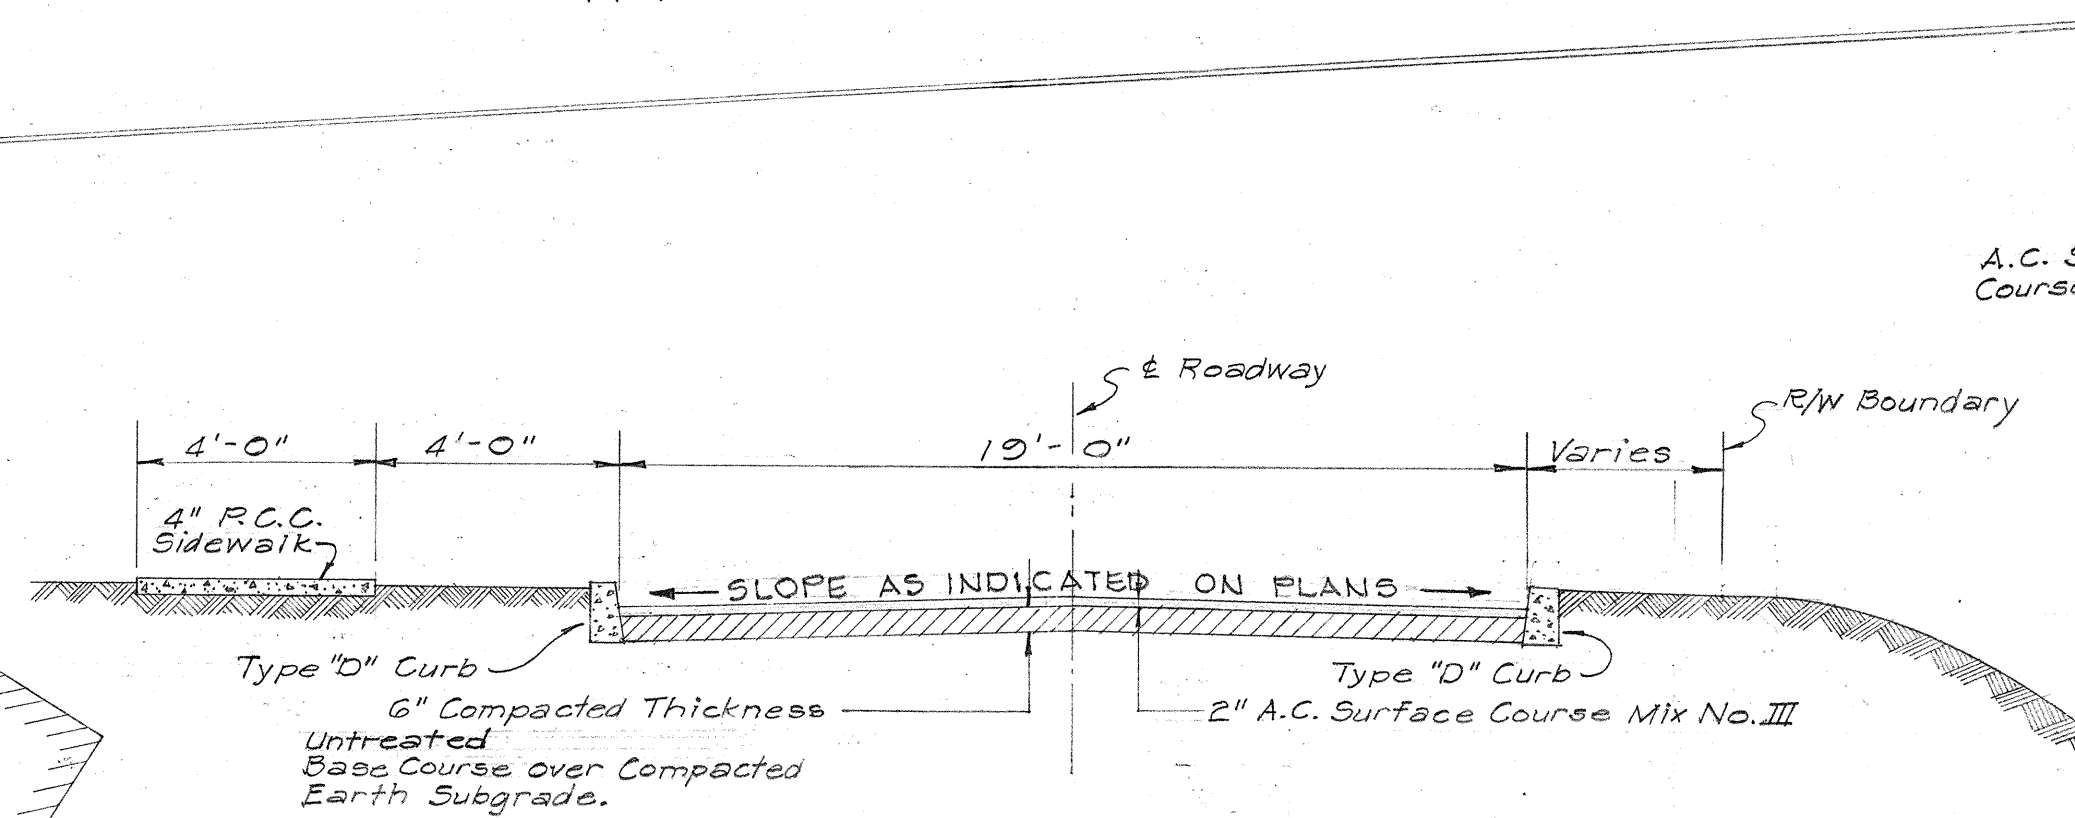

TYPICAL ROADWAY SECTION
Scale: 1/4" = 1'-0"

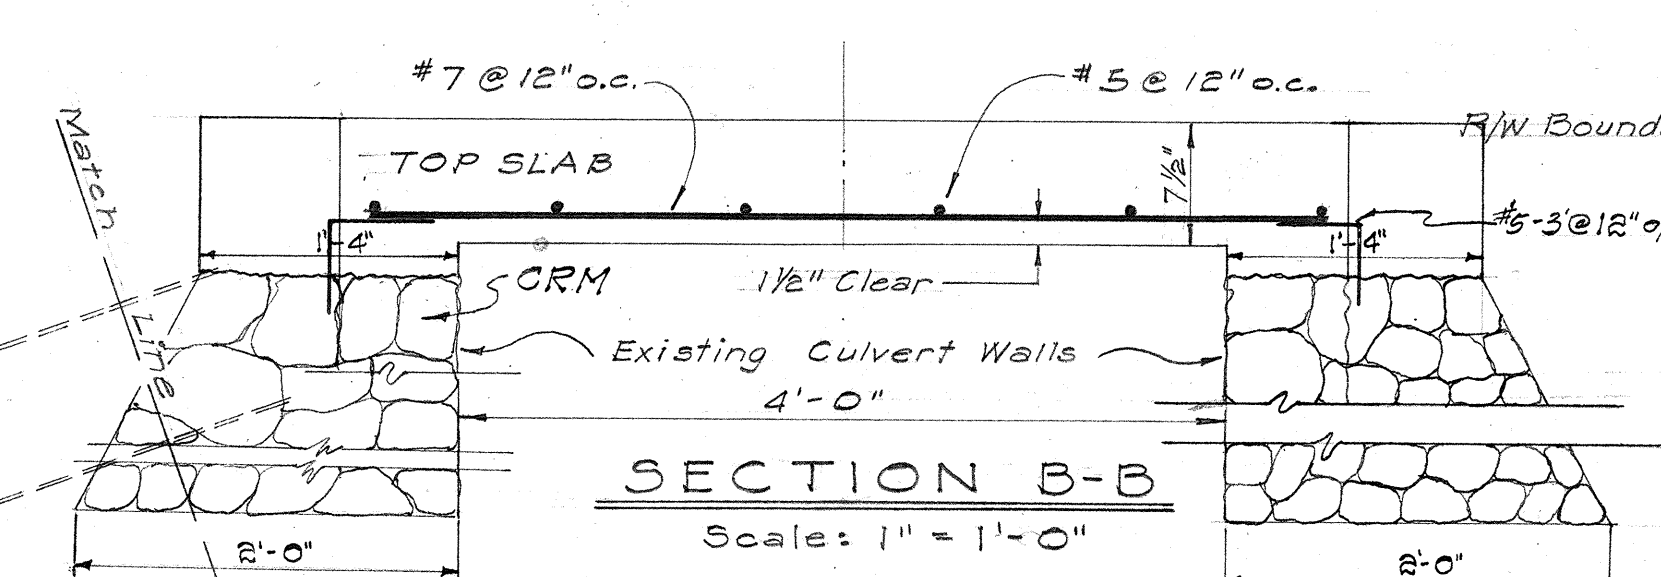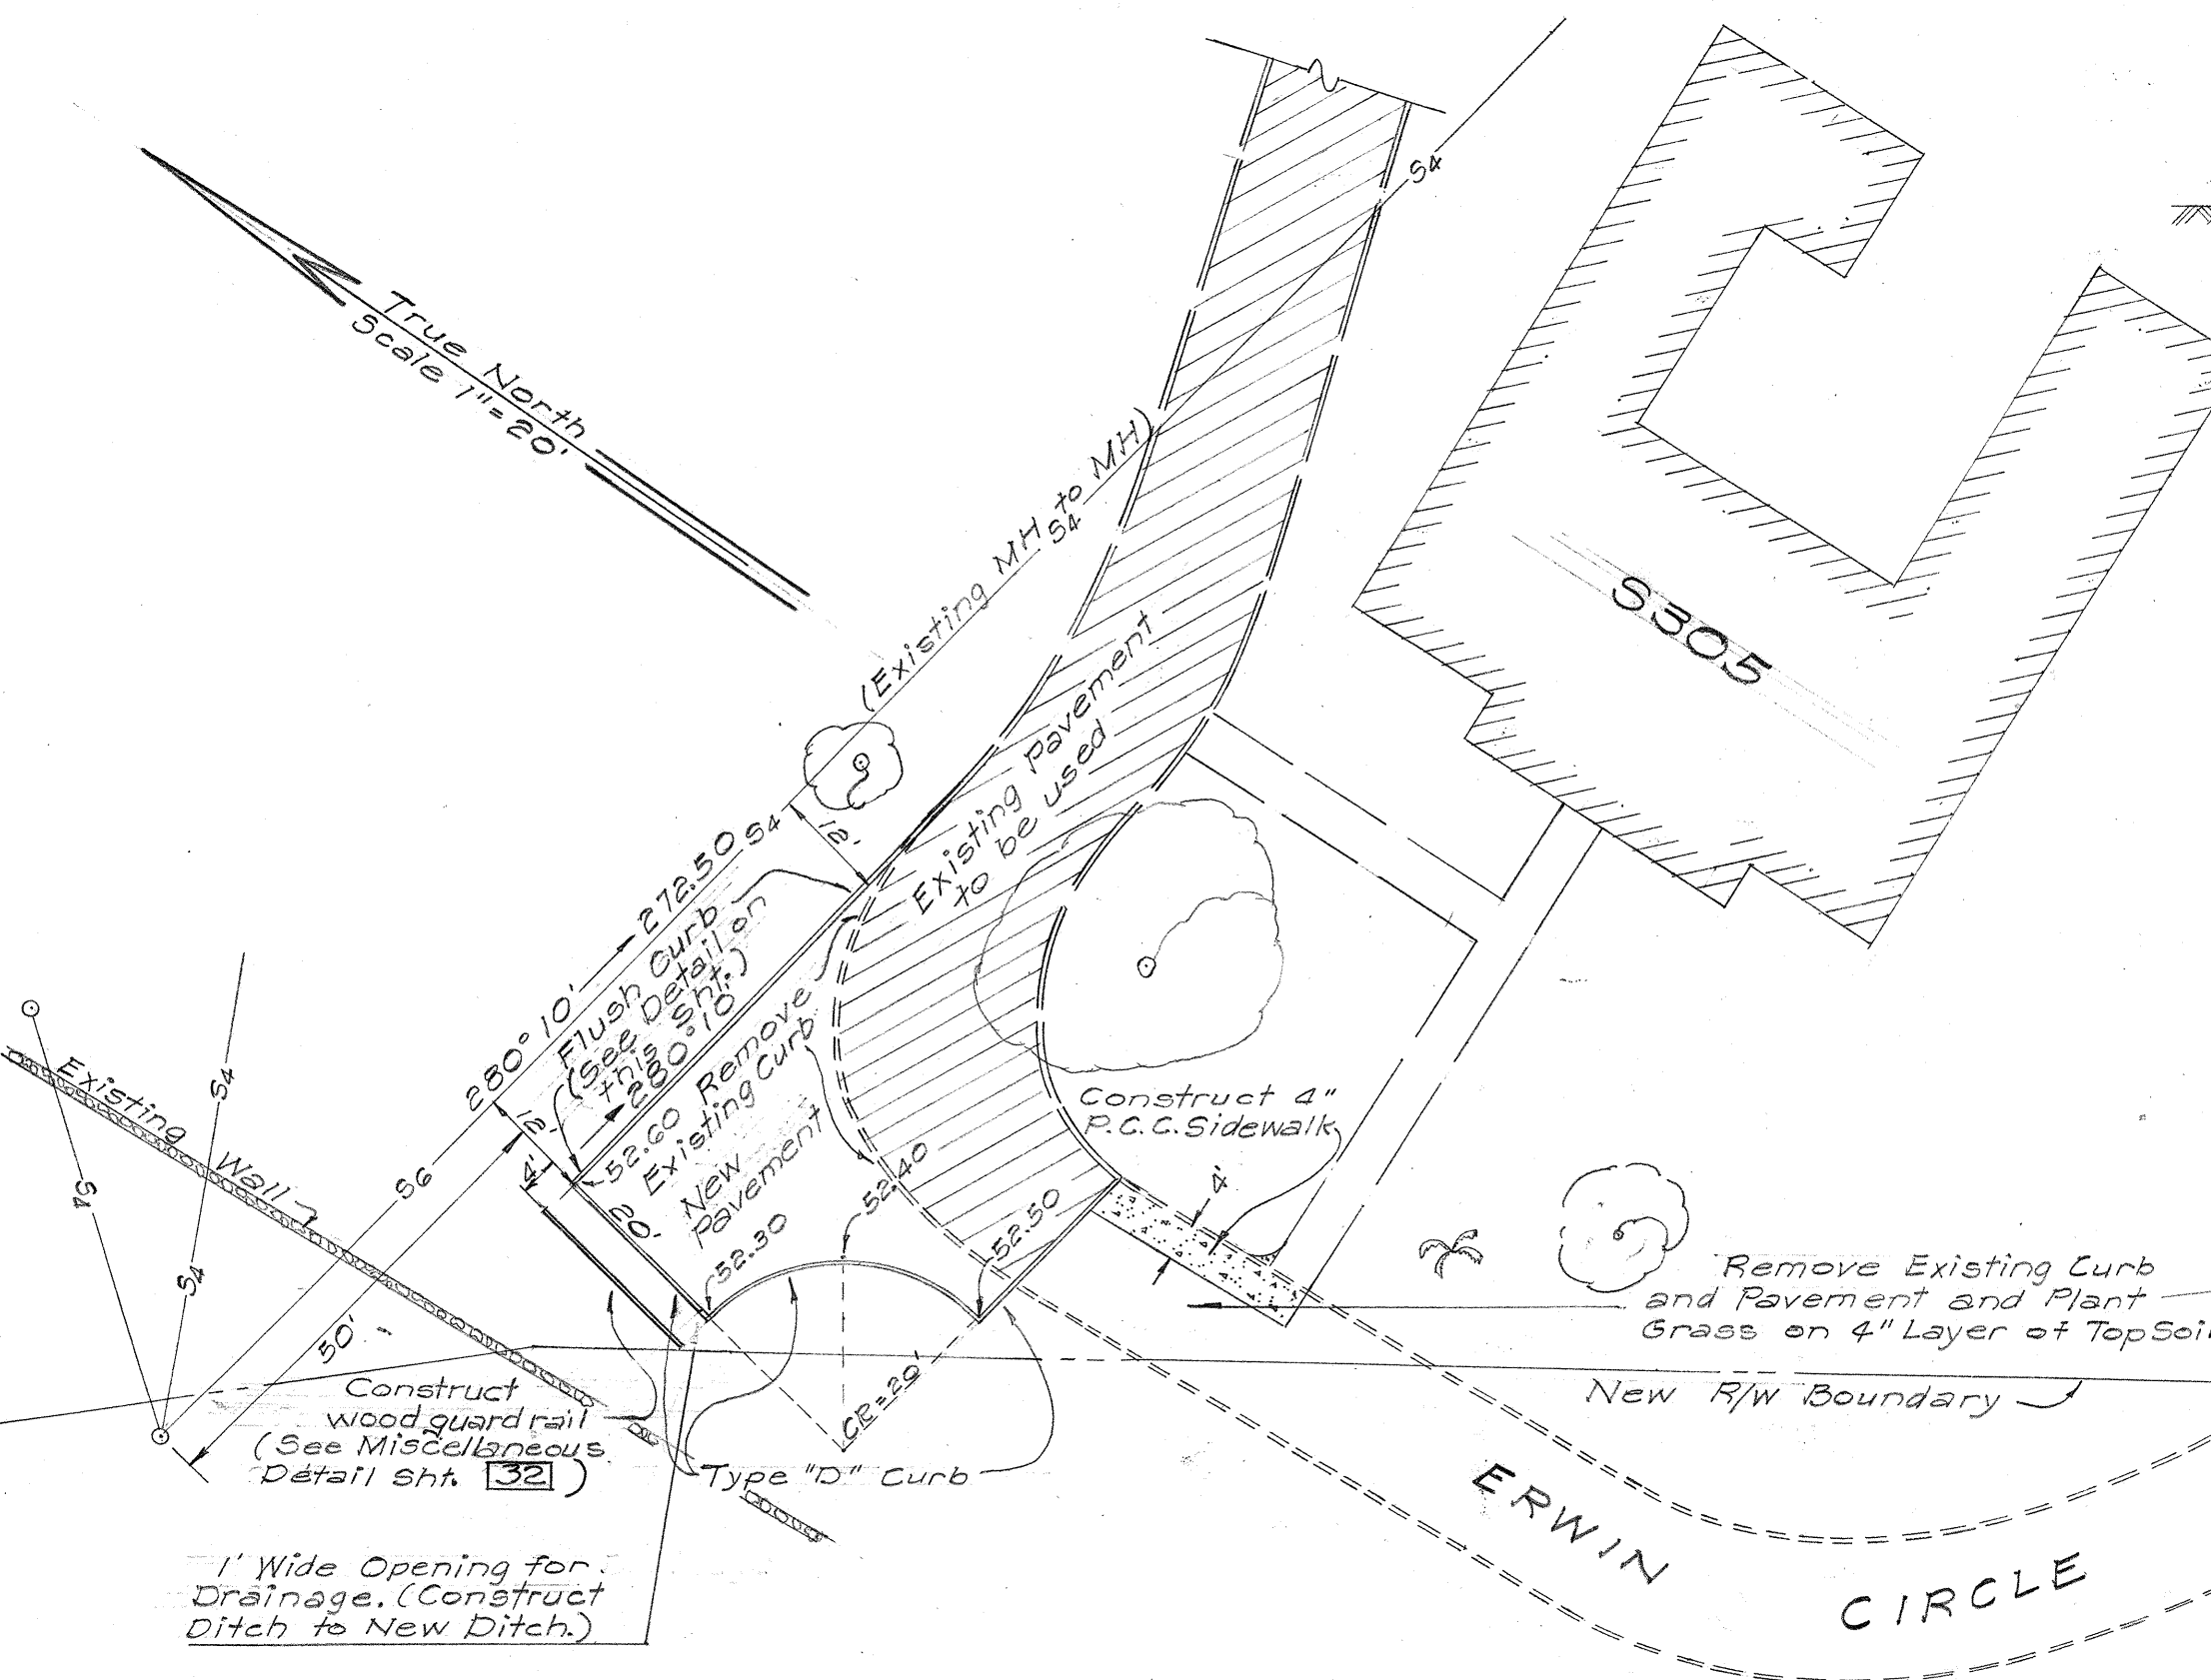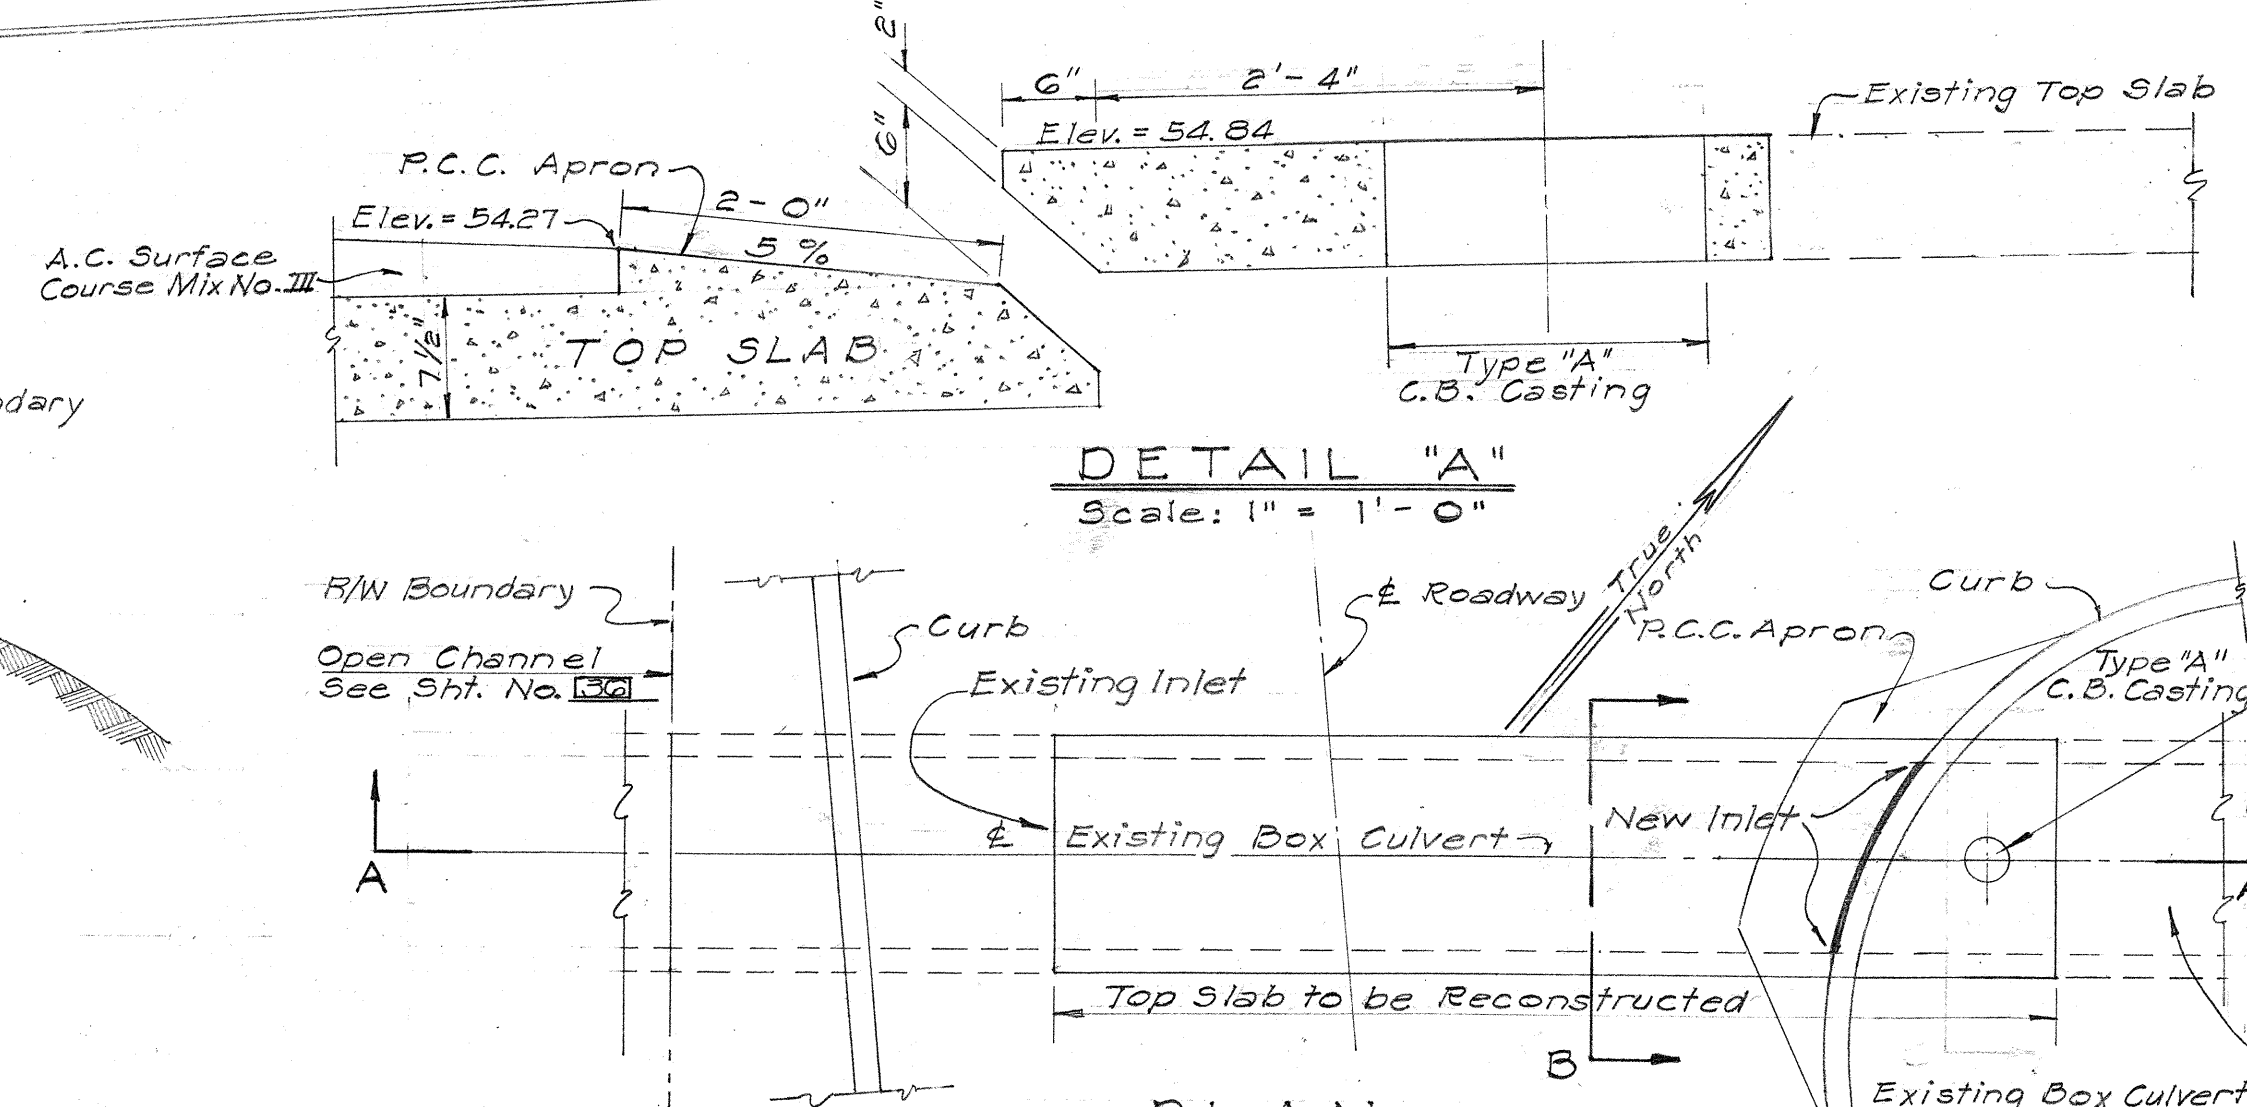


SECTION B-B
Scale: 1" = 1'-0"

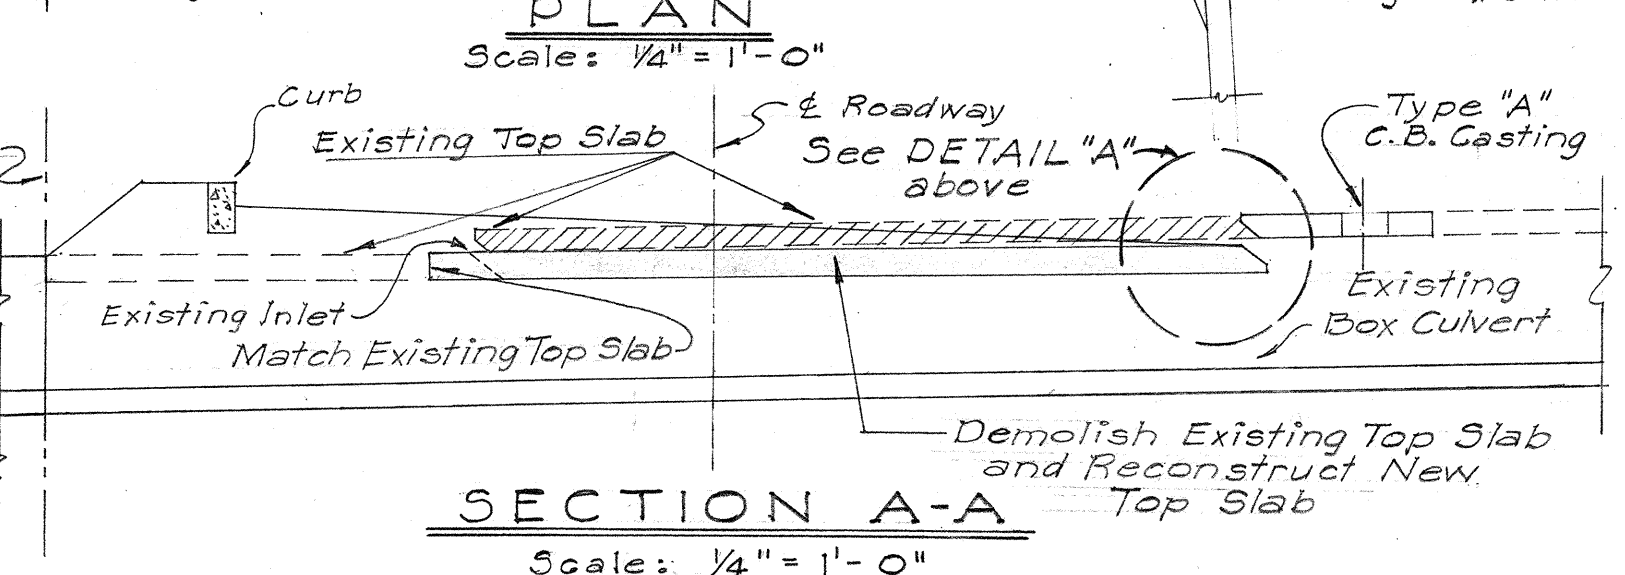


SECTION A-A
Scale: 1/4" = 1'-0"

CATCH BASIN DETAIL

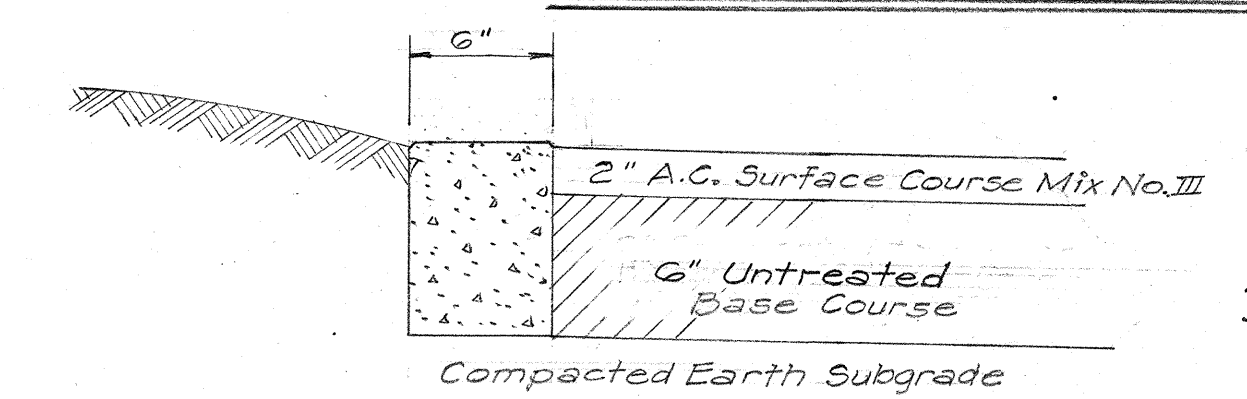

FLUSH CURB DETAIL
Scale: 1 1/2" = 1'-0"

SURVEY PLOTTED BY	C. M. K. K.	DATE	5-57
DESIGNED BY	C. M. K. K.	DATE	5-57
DRAWN BY	C. M. K. K.	DATE	5-57
CHECKED BY	C. M. K. K.	DATE	5-57
QUANTITIES CHECKED BY	C. M. K. K.	DATE	5-57
NOTED BY	C. M. K. K.	DATE	5-57
NO.			

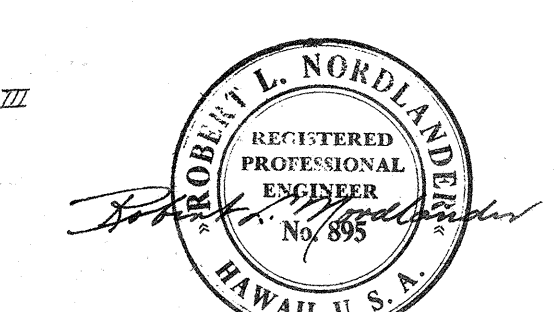

BELT, COLLINS & ASSOC., LTD.
Civil and Structural Engineers

HAWAII STATE HIGHWAY DEPARTMENT
STATE OF HAWAII

ROADWAY RELOCATION
H. O. D. FT. SHAFTER

MOANALUA ROAD US-5-0720(3) UNIT 3