INDEX TO DRAWINGS	
SHEET NO.	DESCRIPTION
	TITLE SHEET
2 – 4	LANDSCAPE PLANS
5	SPRINKLER SYSTEM
6	STANDARD SPRINKLER
	SYSTEM DETAILS

DEPARTMENT OF TRANSPORTATION
HIGHWAYS DIVISION
"AS BUILT" PLANS OF

MOANALUA ROAD


LANDSCAPING AND SPRINKLER SYSTEM EXTENSION


FEDERAL AID SECONDARY PROJECT S-0720(5)

DISTRICT OF HONOLULU

ISLAND OF OAHU

SCALES

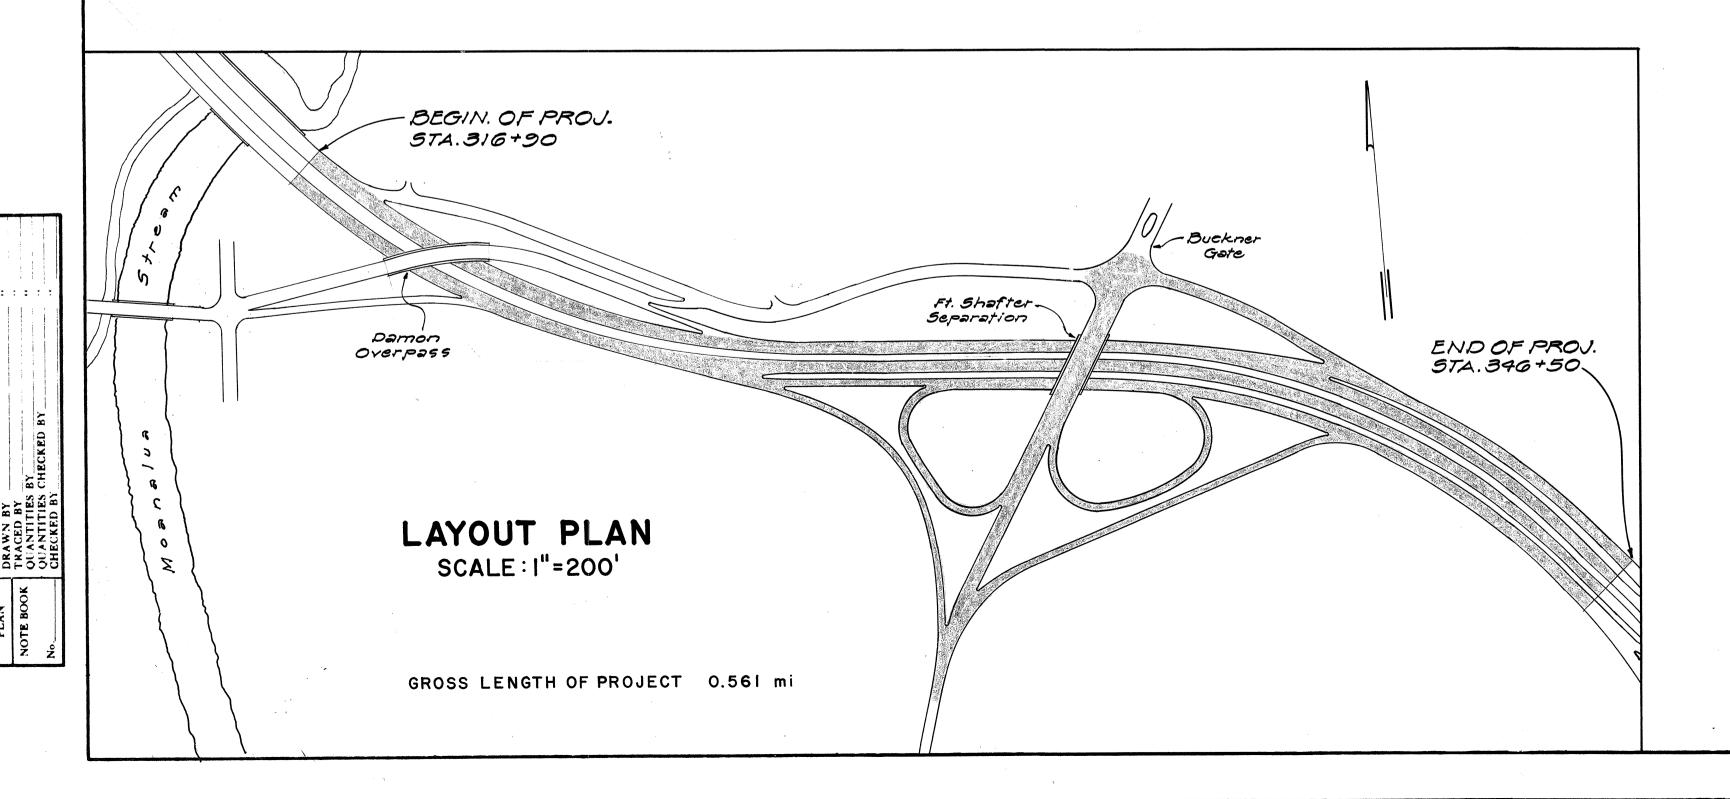

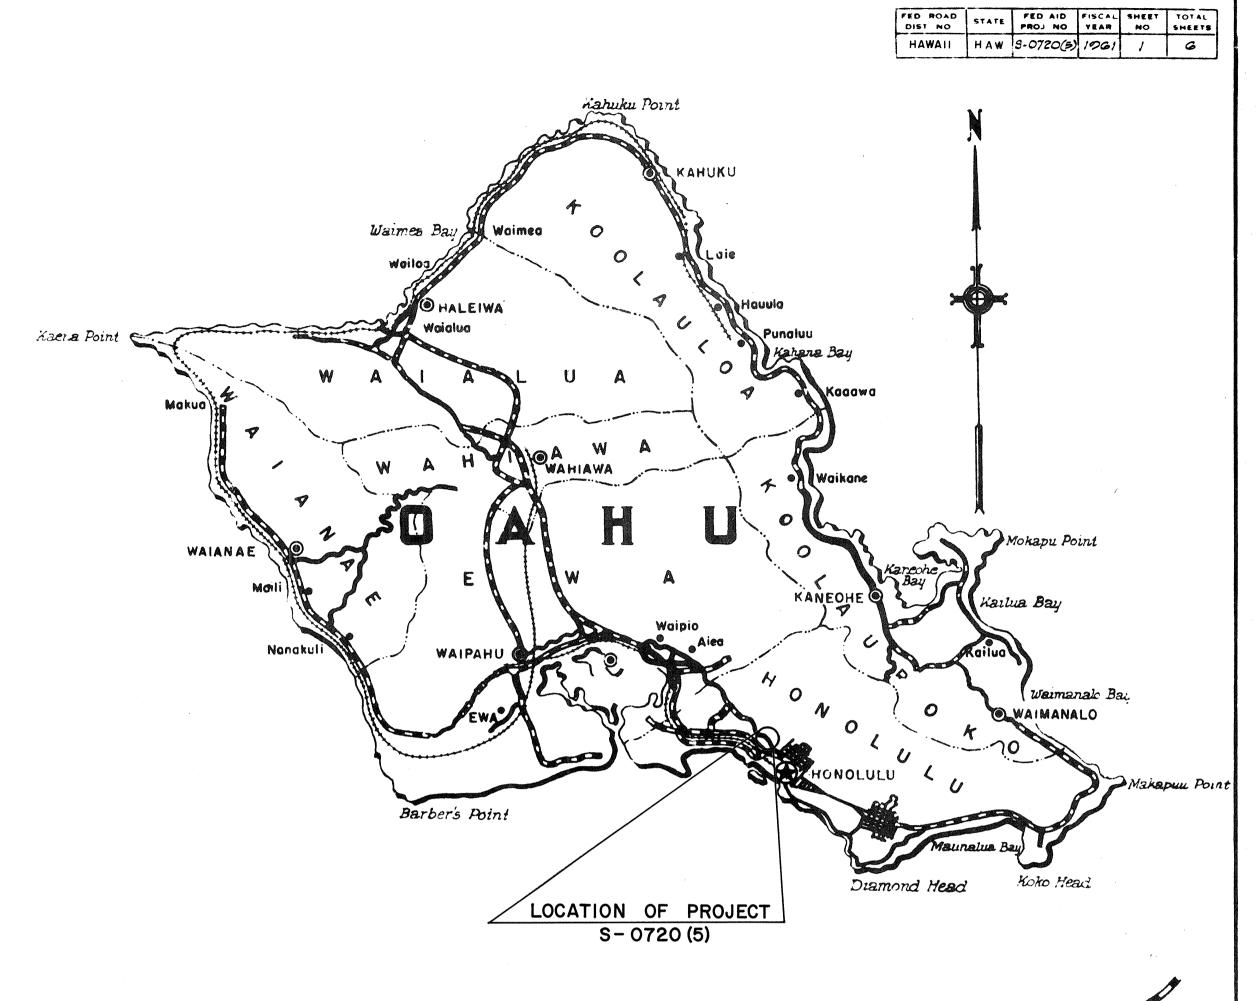

Federal Aid Projects Previously Constructed Or Under Construction

NOTE:

ALL CHANGES MADE DURING CONSTRUCTION HAVE BEEN NOTED ON THESE TRACINGS IN RED AND CHECKED BY:

PROJECT ENGINEER
5/28/63
DATE

Sand. Hirota

Acts. DIRECTOR OF TRANSPORTATION

DEPARTMENT OF COMMERCE
BUREAU OF PUBLIC ROADS

APPROVED:

DIVISION ENGINEER DATE

S072005.1