

PROJ. ROAD DIST. NO.	STATE	PROJ. AID PROJ. NO.	FISCAL YEAR	SHEET NO.	TOTAL SHEETS
HAWAII	HAW.	U-072-1(21)	1967	22	35

Exc = 19
Emb = 322

Exc = 15
Emb = 231

Exc = 4
Emb = 58

C = 17
F = 210

C = 0
F = 138

C = 7
F = 112

C = 0
F = 0

R/W & C/A Line

R/W & C/A Line



BRIDGE

50



100

22



PROJ. ROAD DIST. NO.	STATE	FED. AID PROJ. NO.	FISCAL YEAR	SHEET NO.	TOTAL SHEETS
HAWAII	HAW	U-078-1(20)	1967	23	35

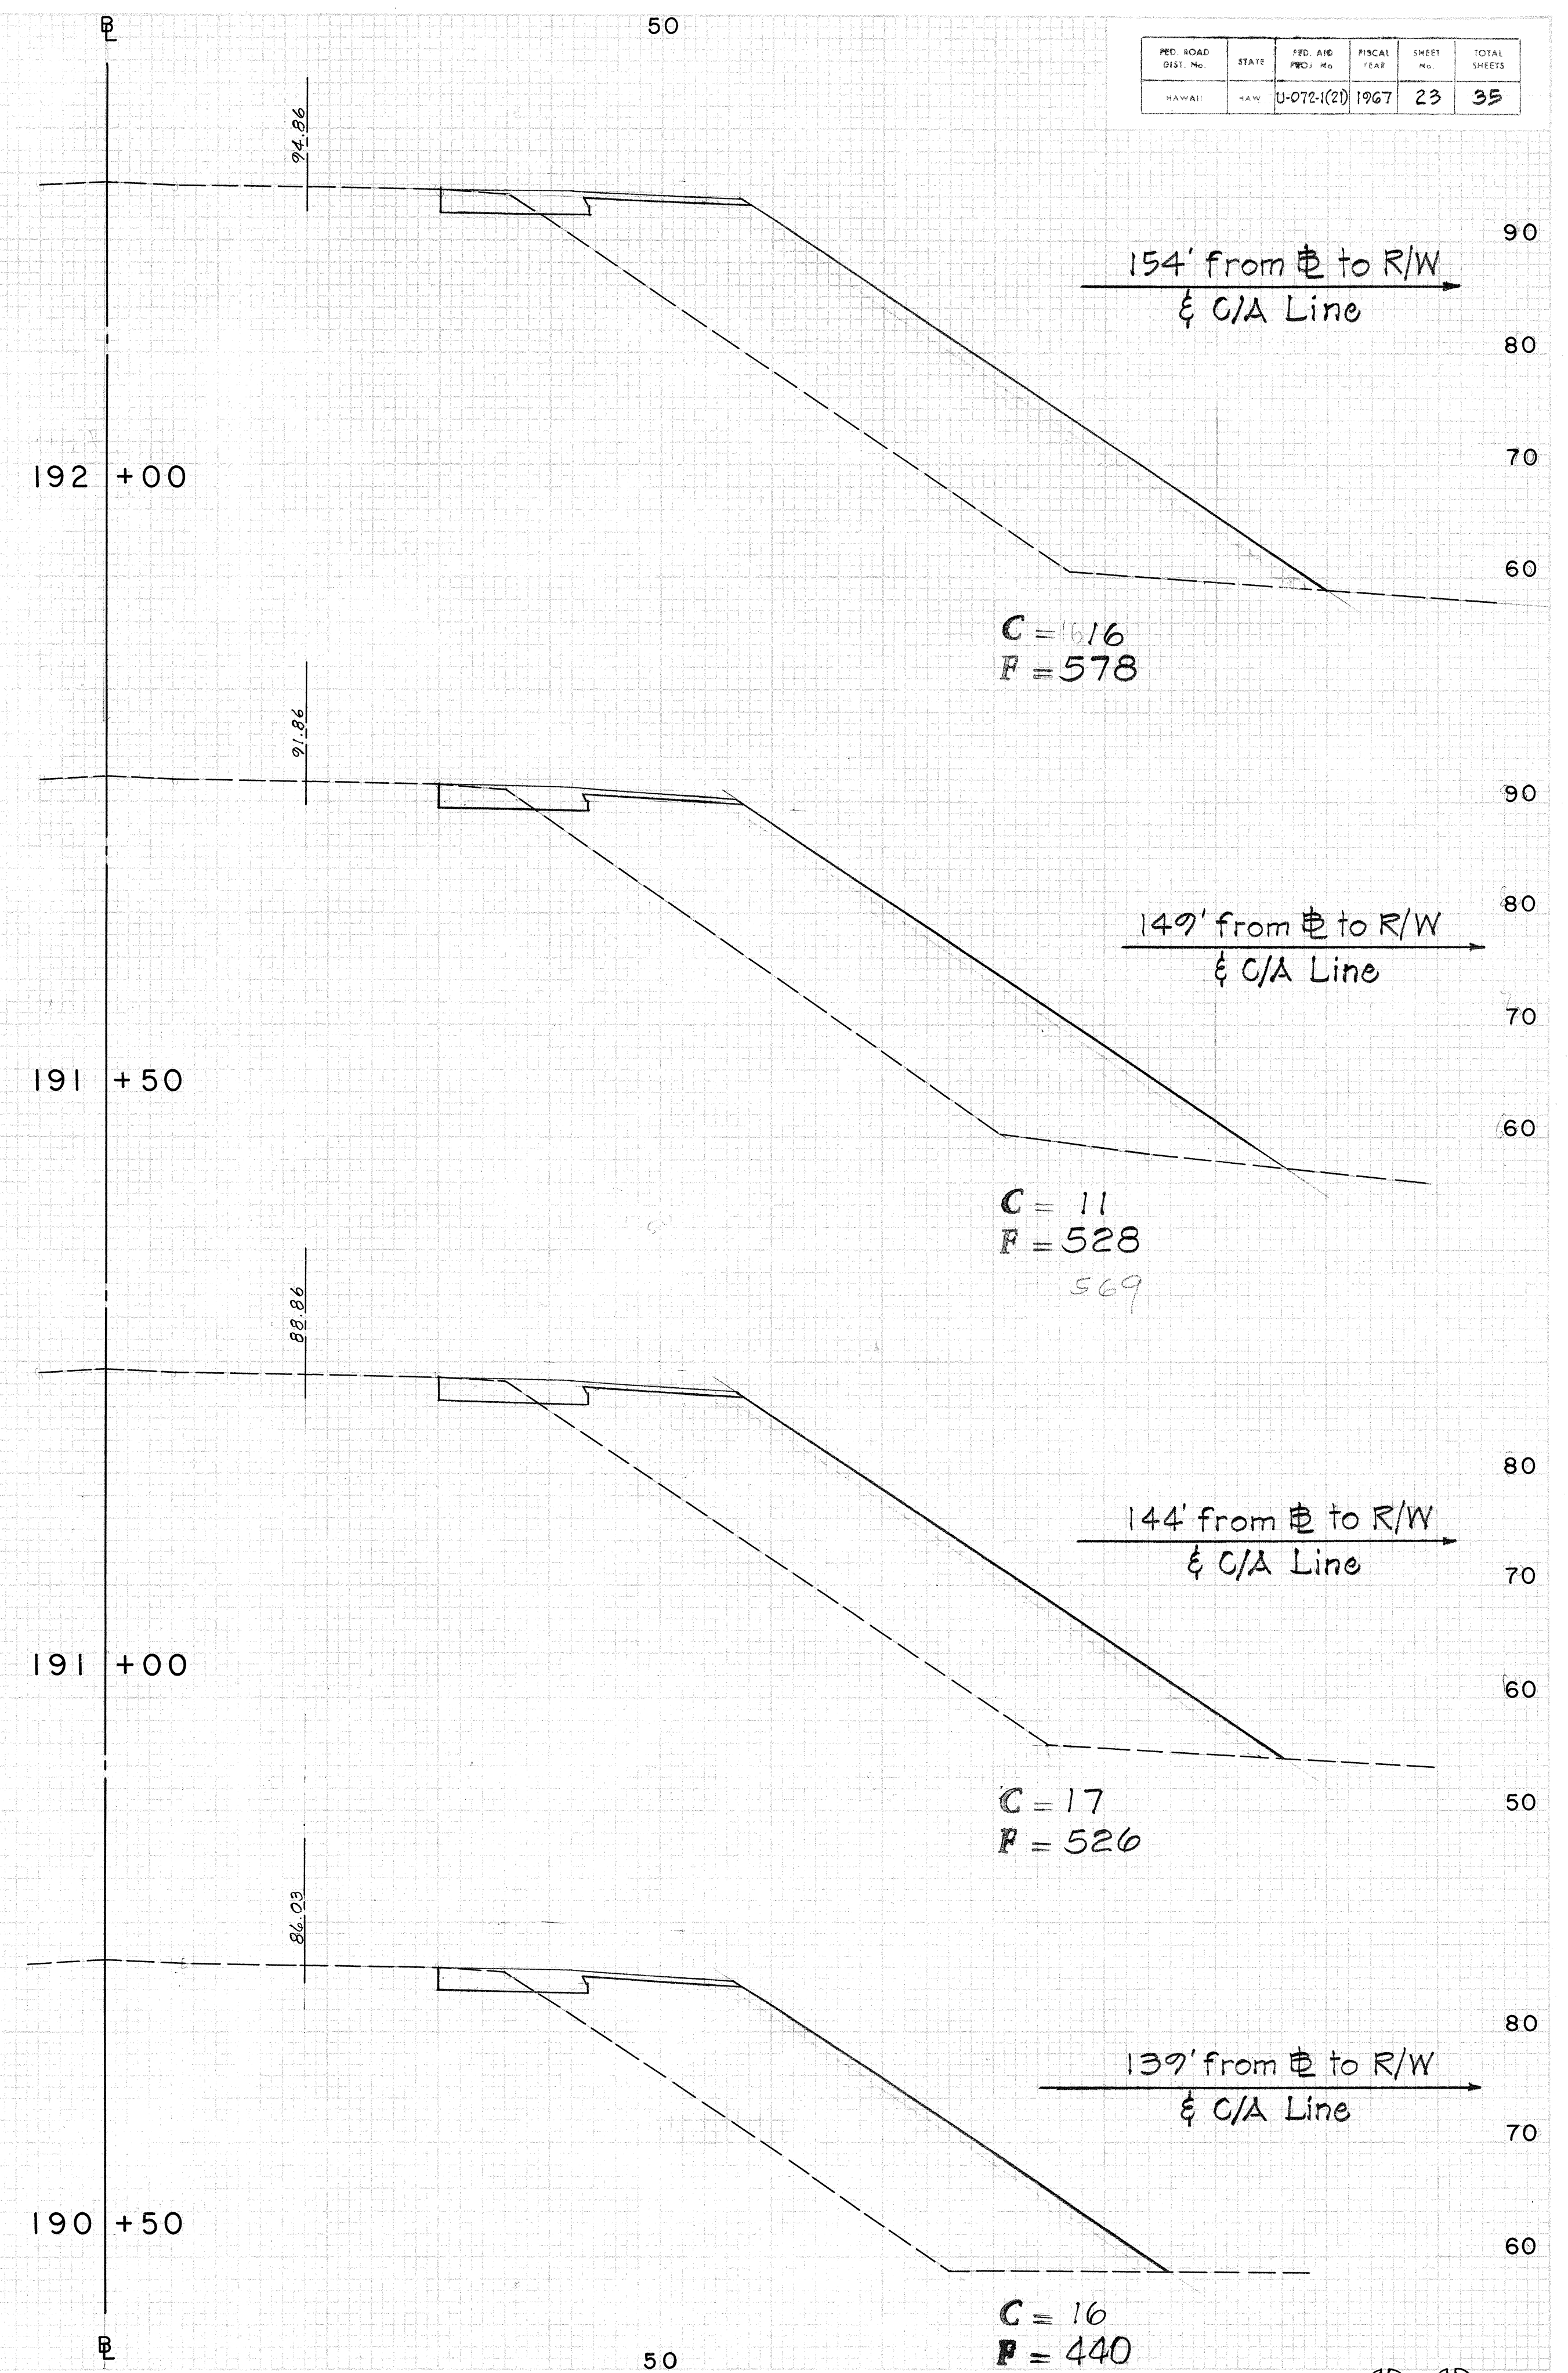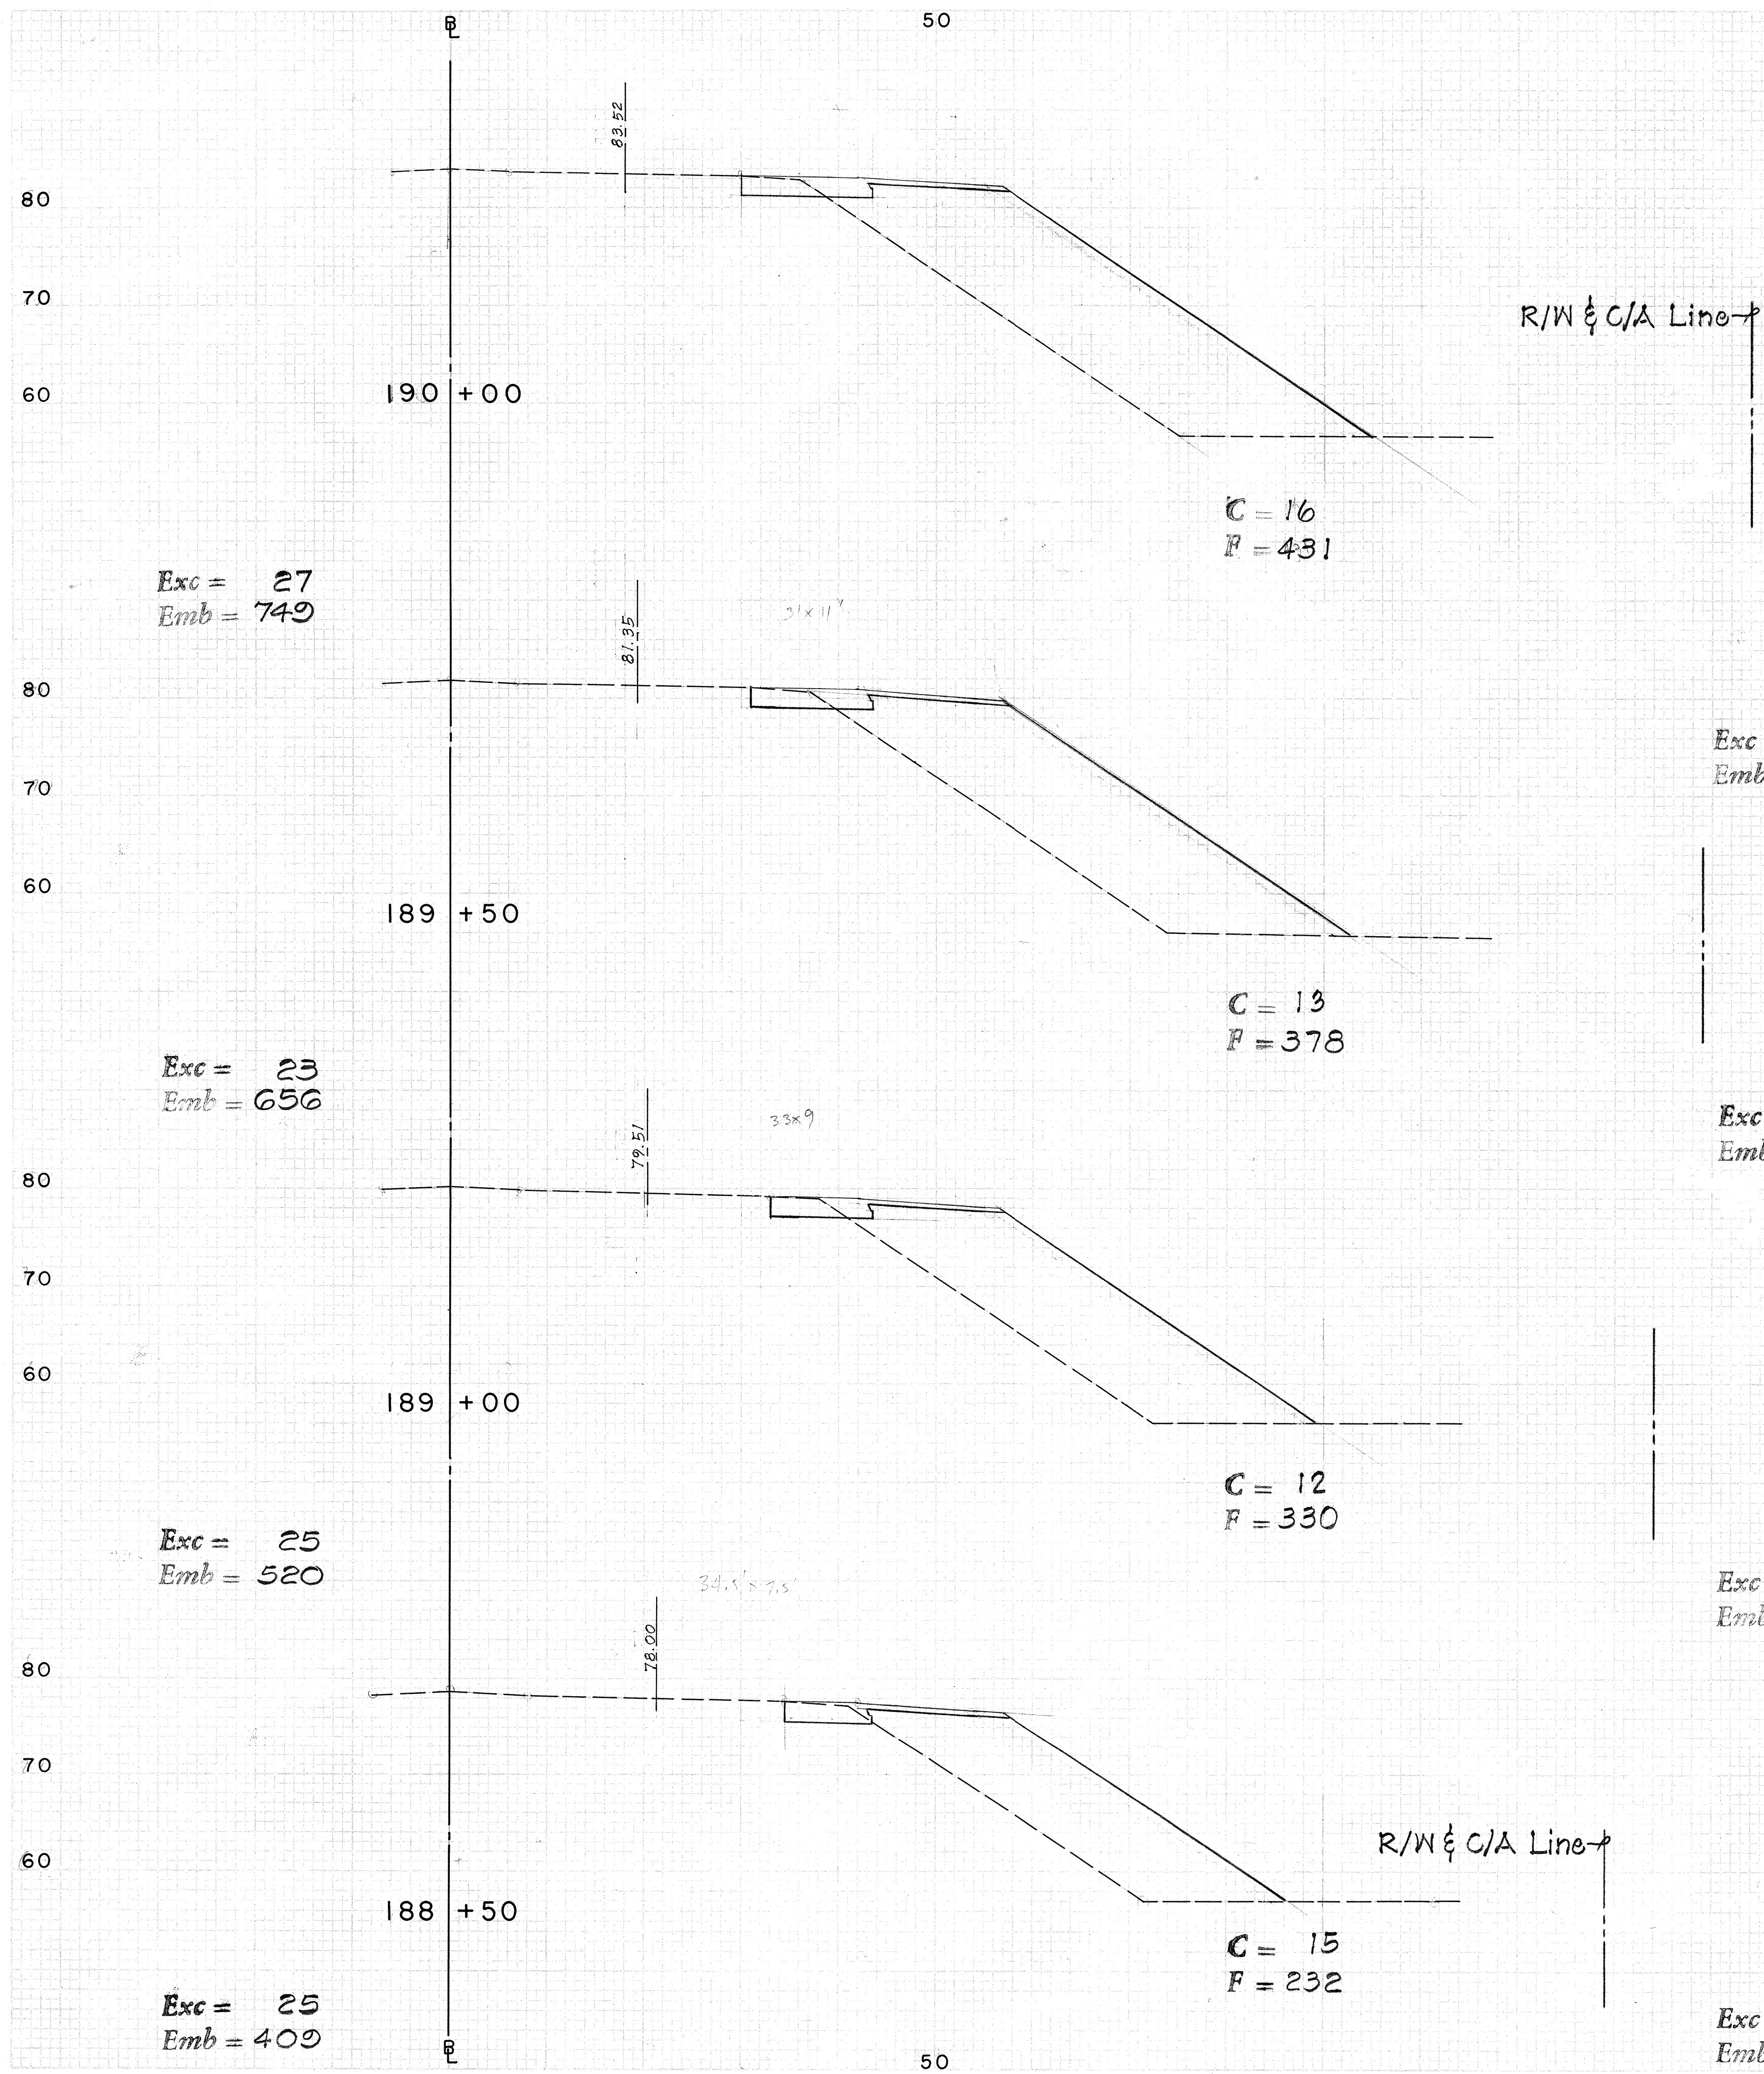



FED. ROAD DIST. No.	STATE	FED. AID PROJ. No.	FISCAL YEAR	SHEET No.	TOTAL SHEETS
HA-072-1(2)	HA	1072-1(2)	1967	24	35

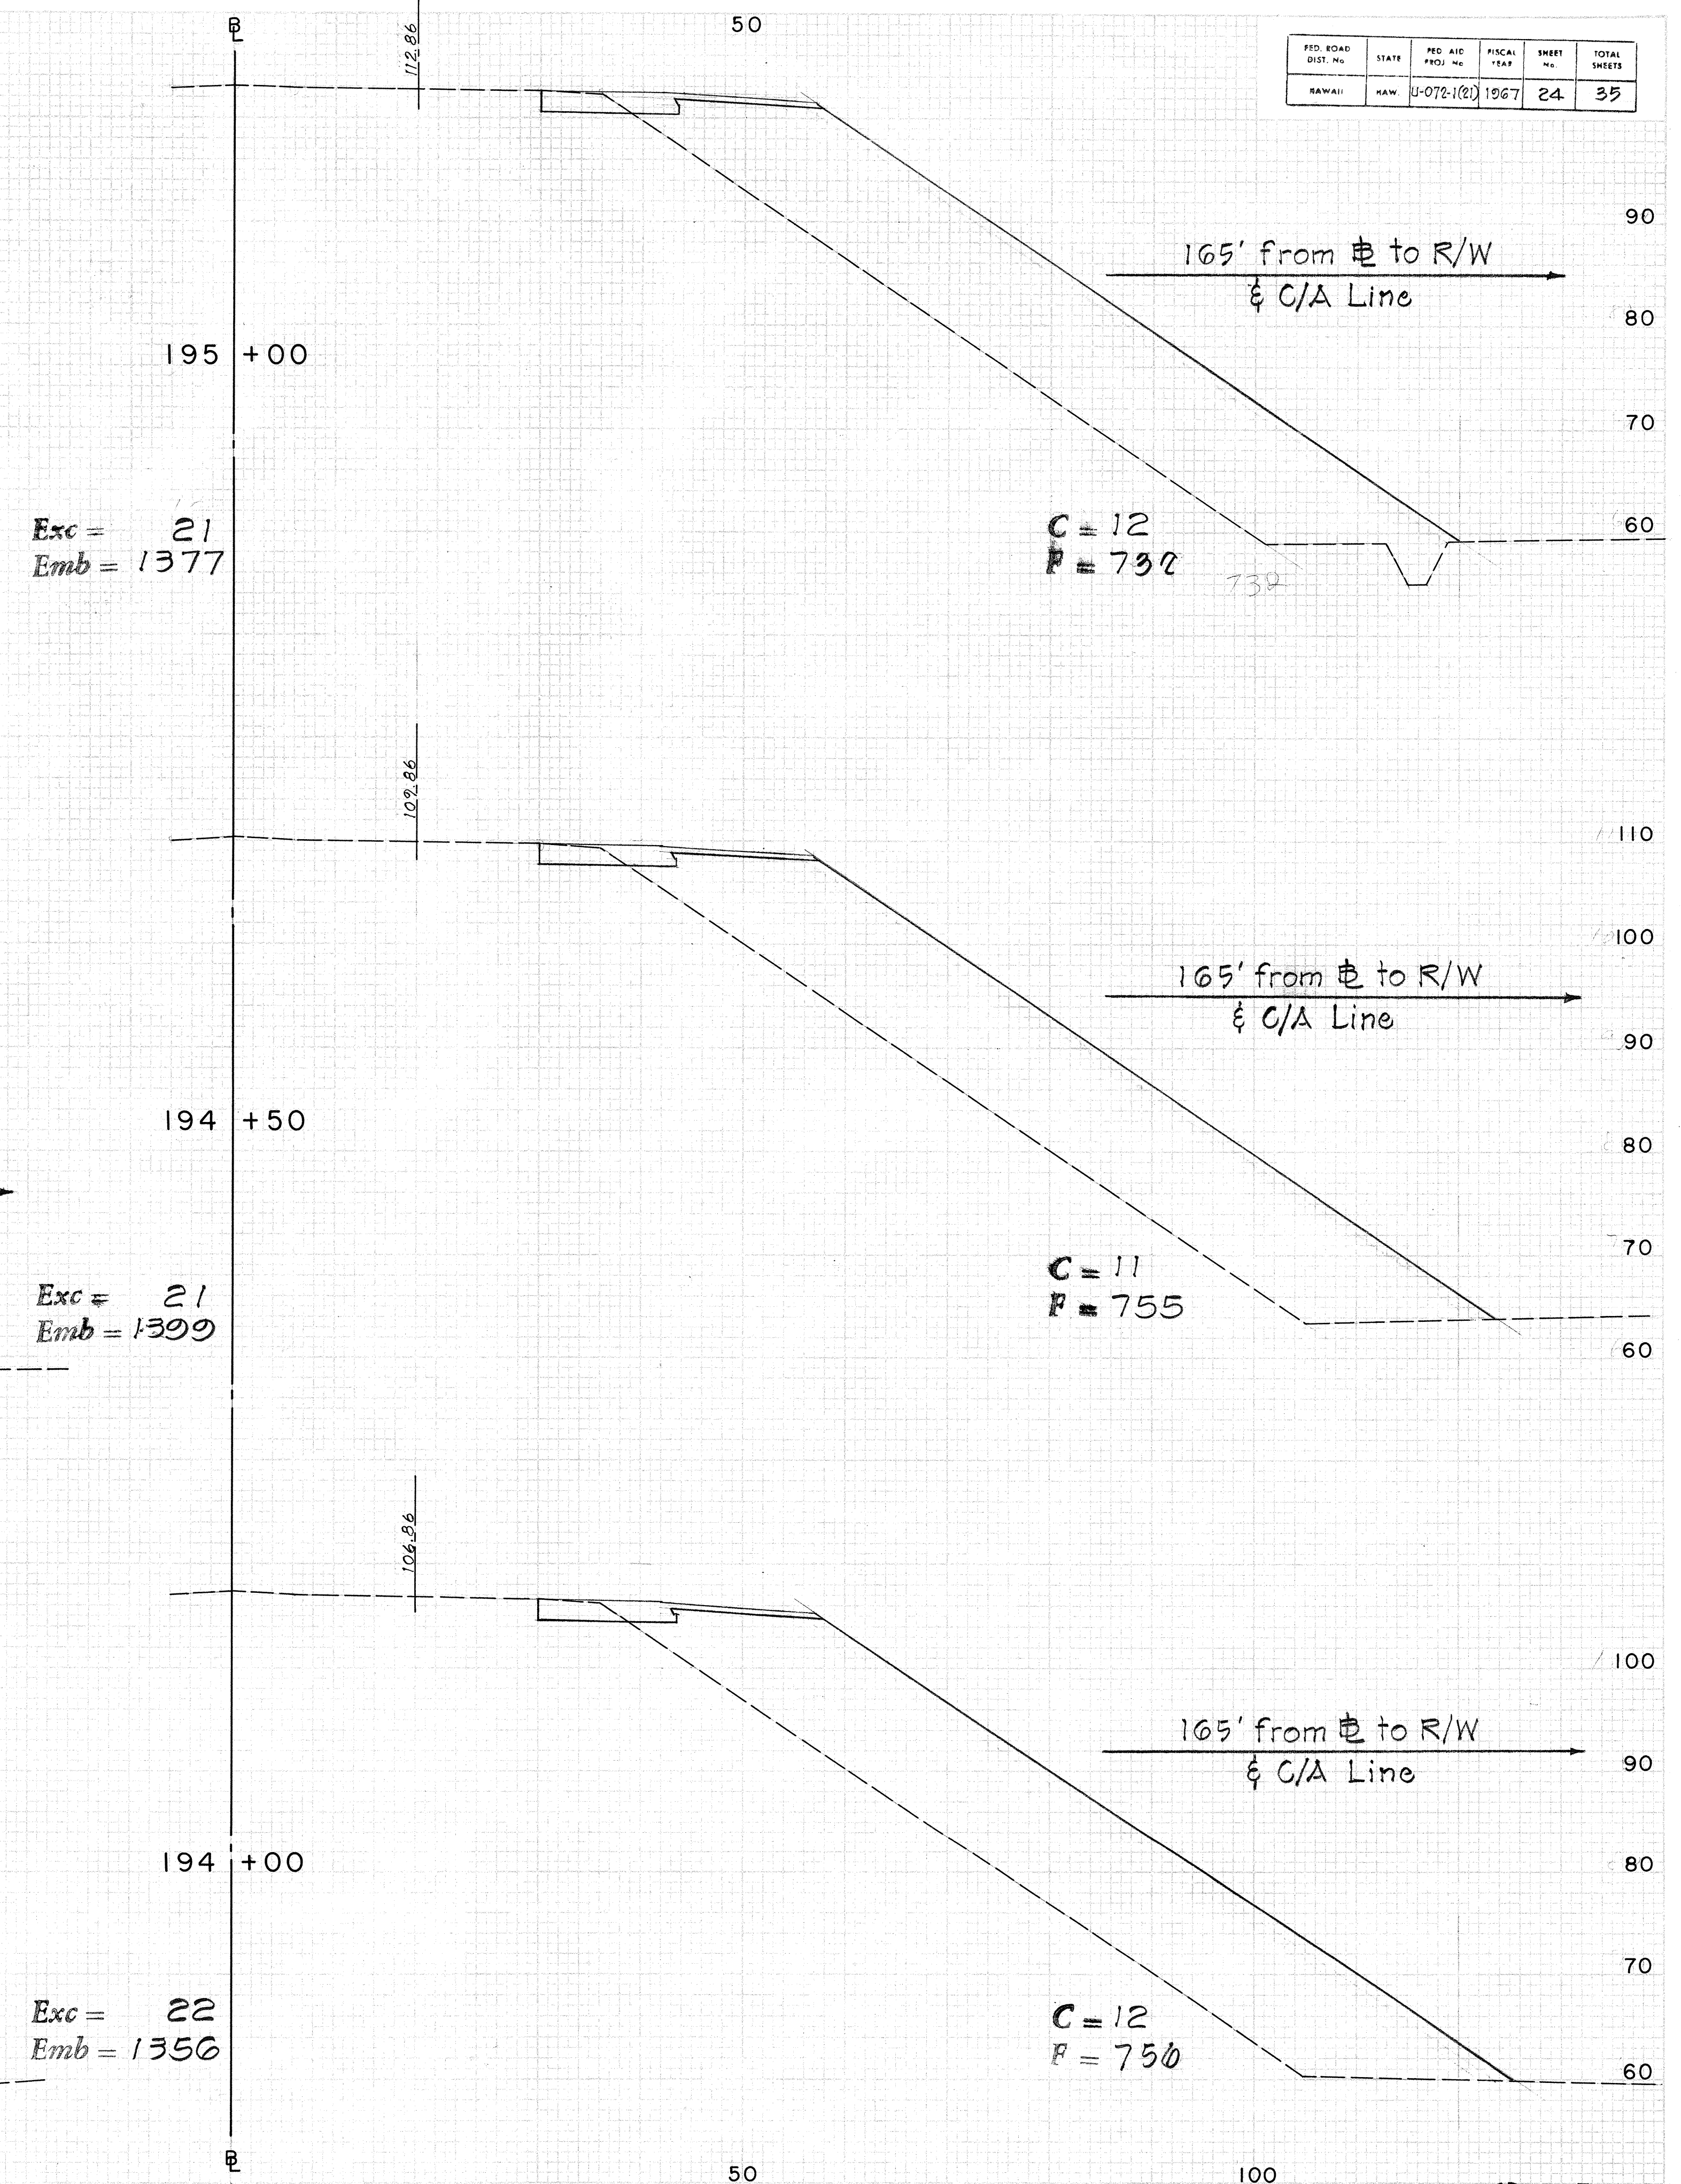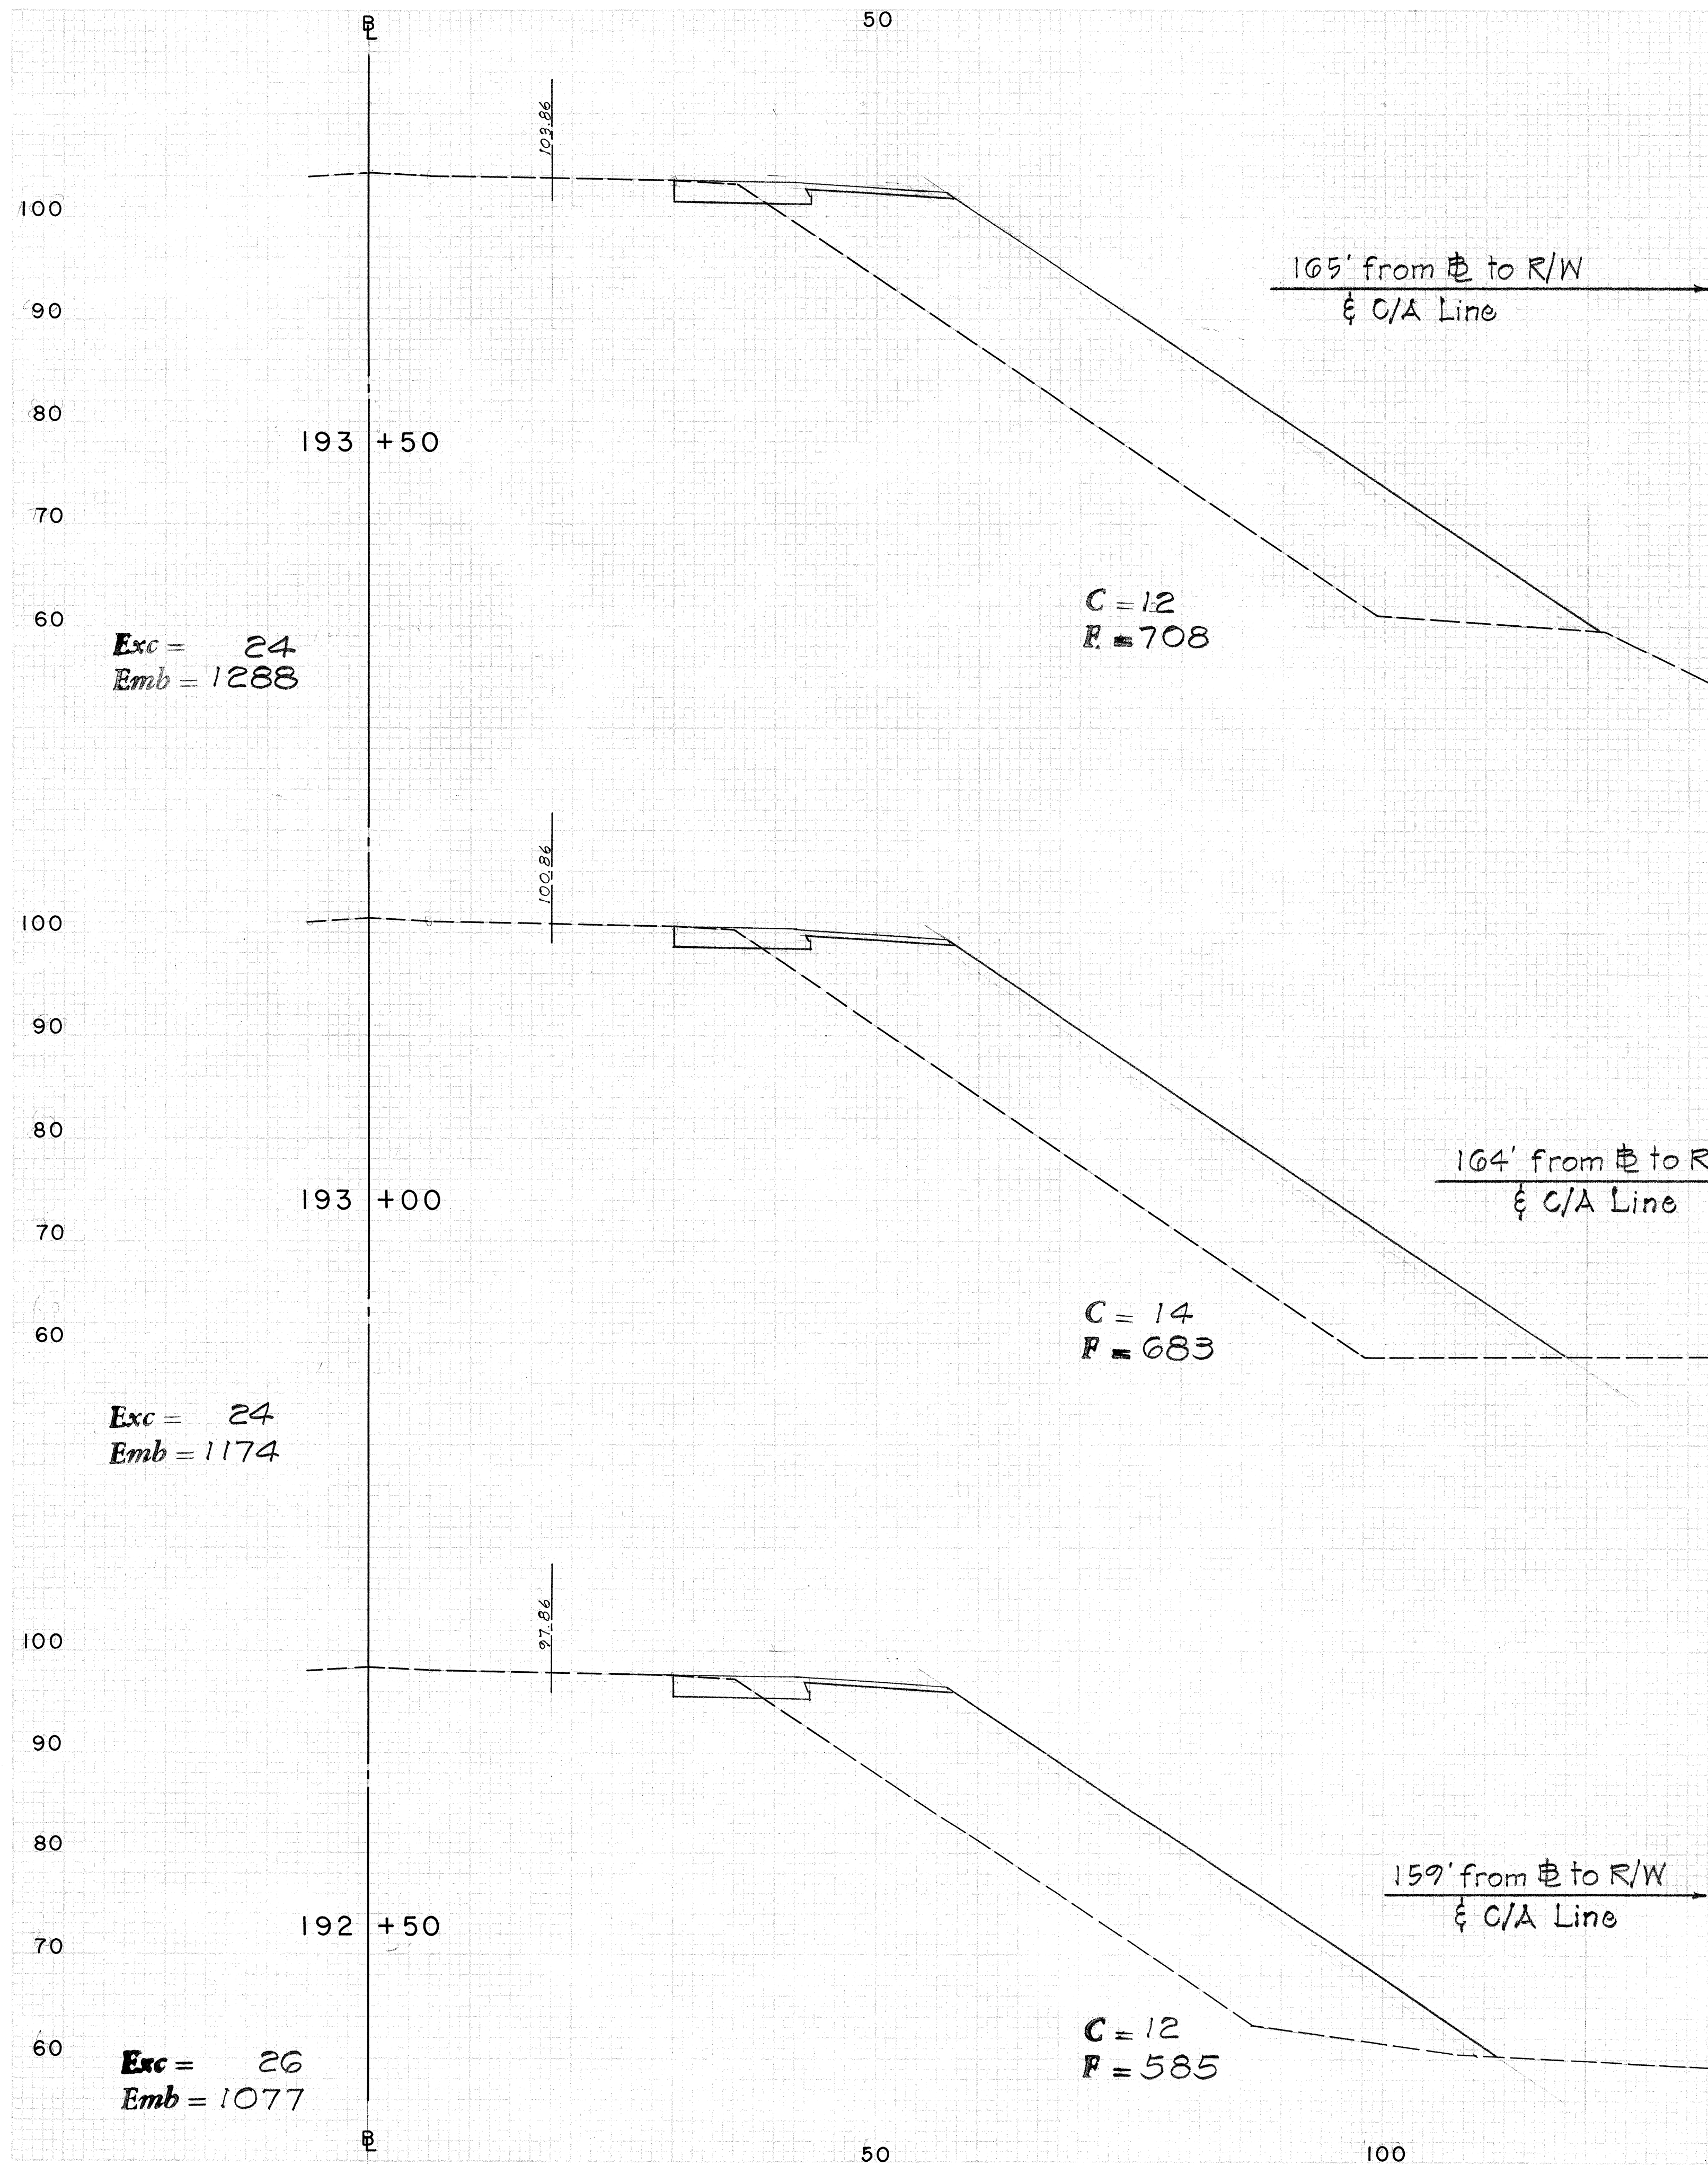



FED. ROAD DIST. NO.	STATE	FED. AID PROJ. NO.	FISCAL YEAR	SHEET NO.	TOTAL SHEETS
HAWAII	HAW.	U-072-1(21)	1967	25	35

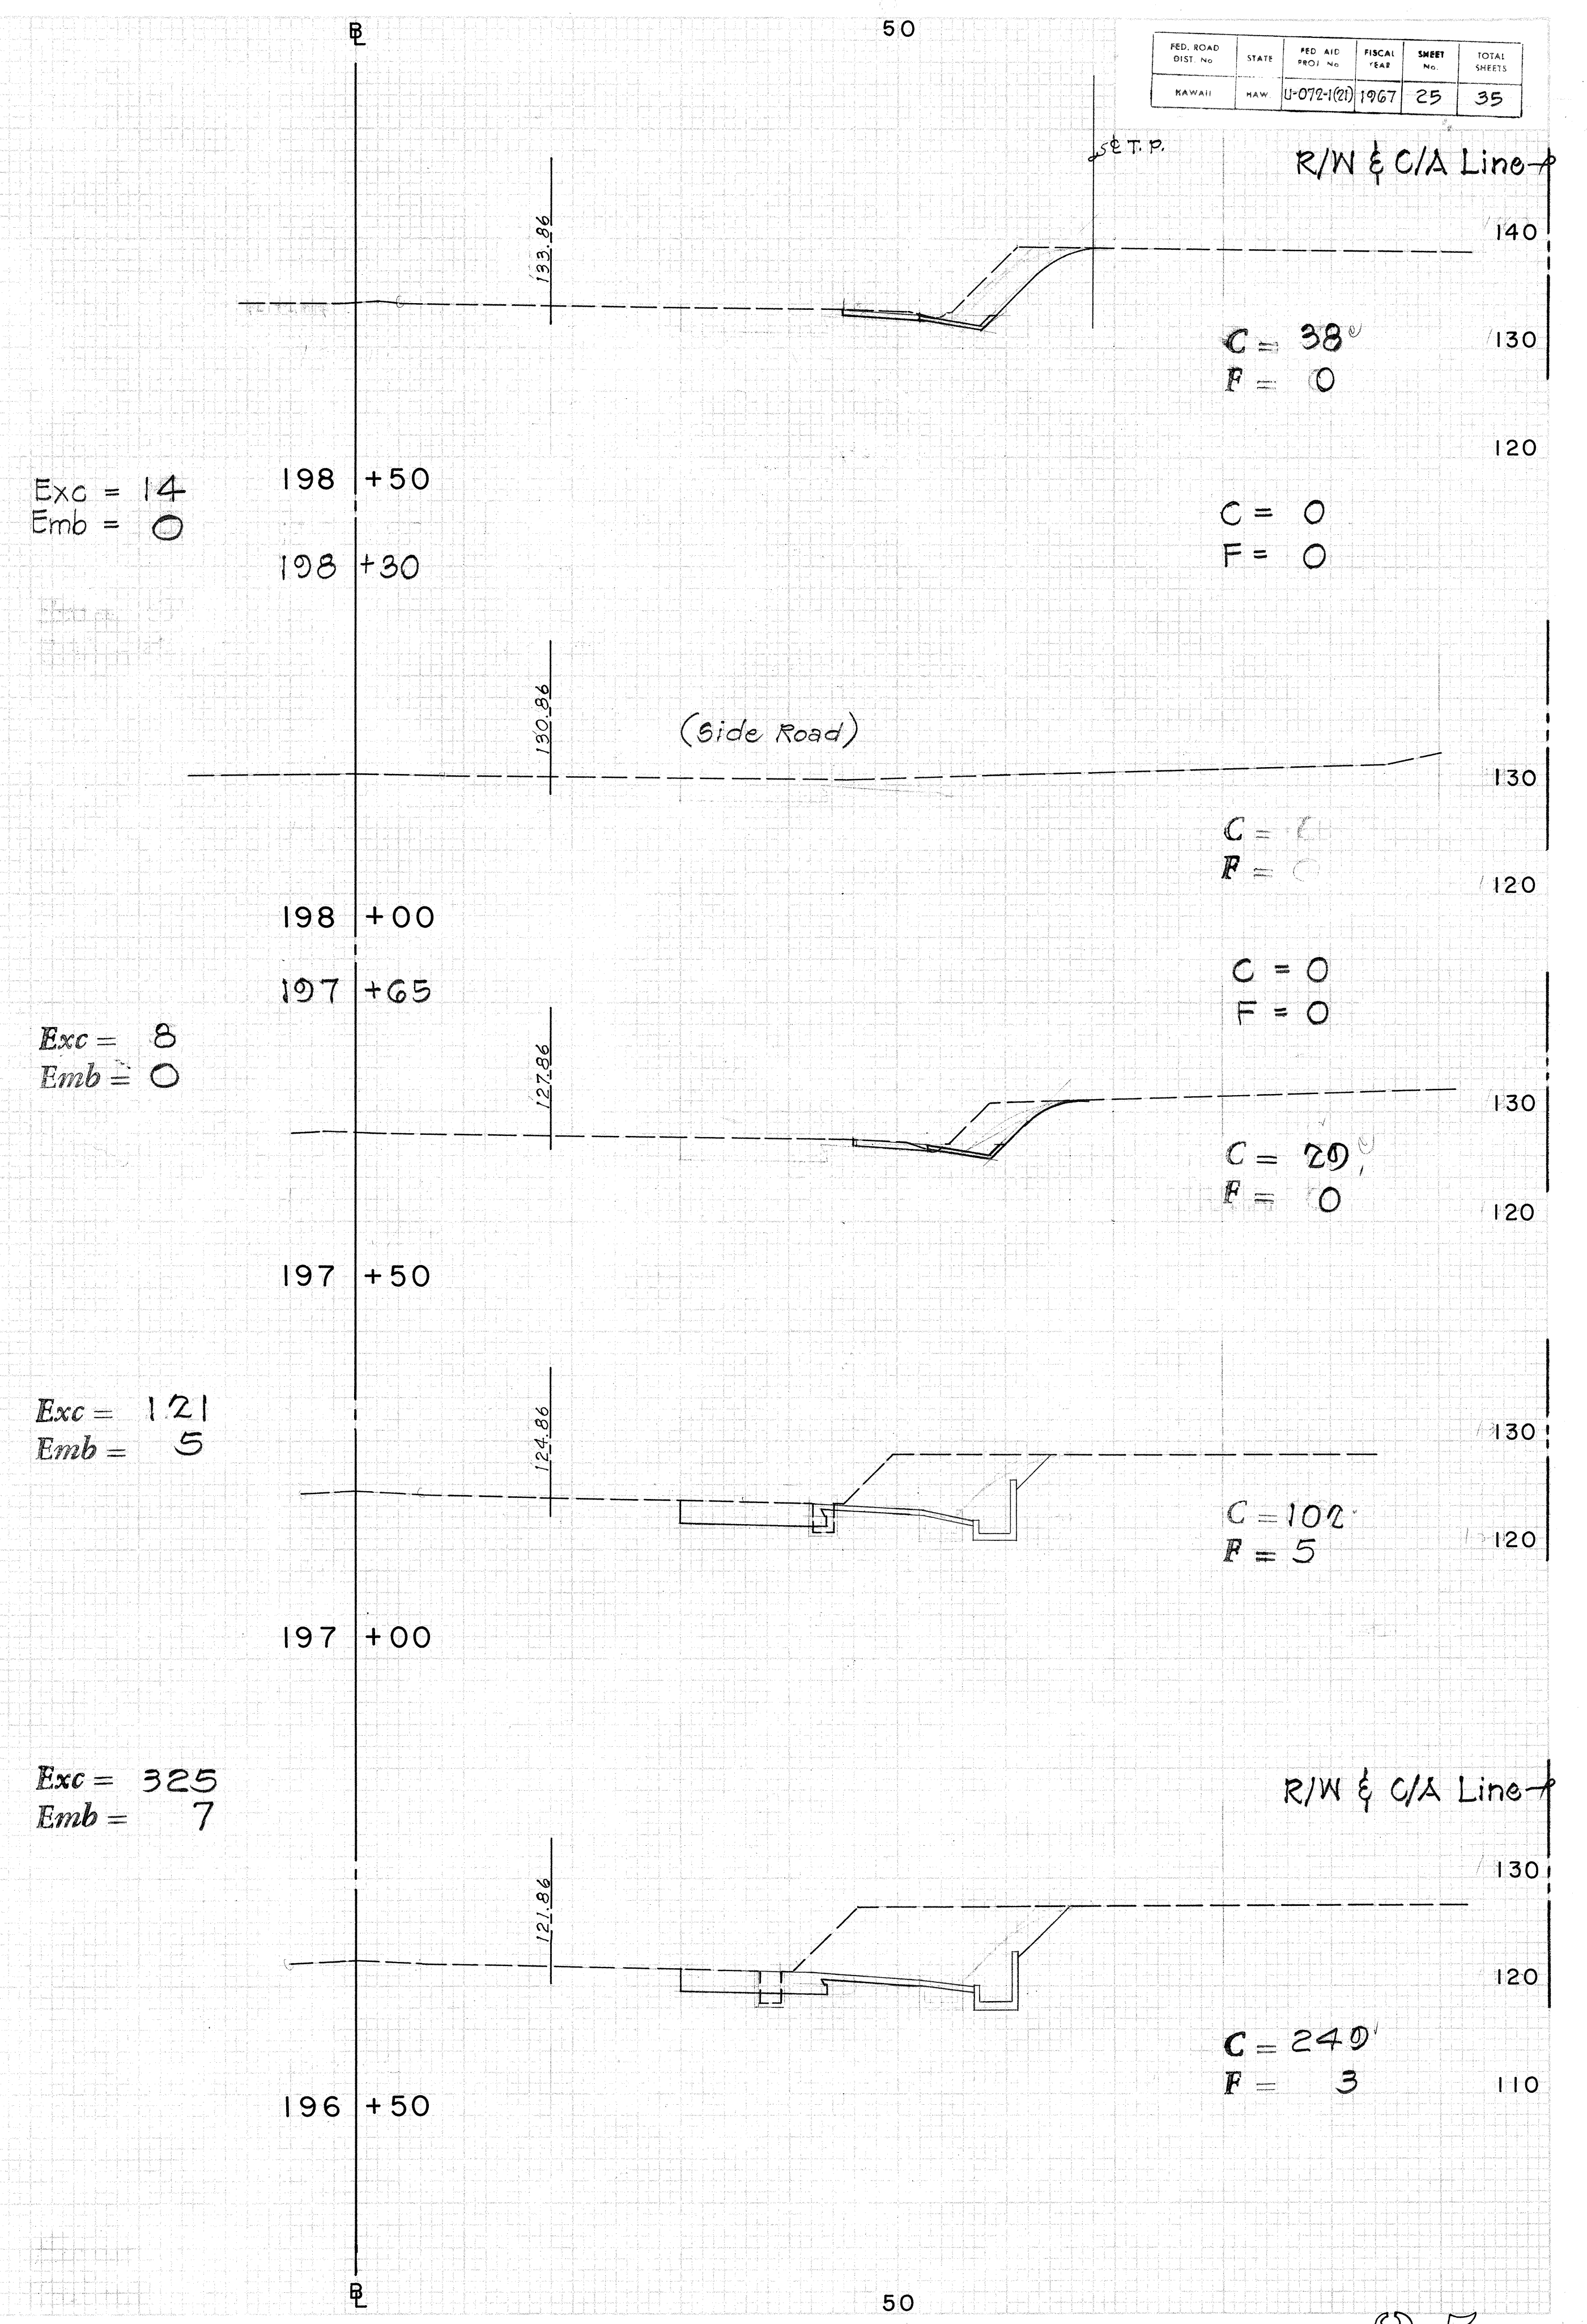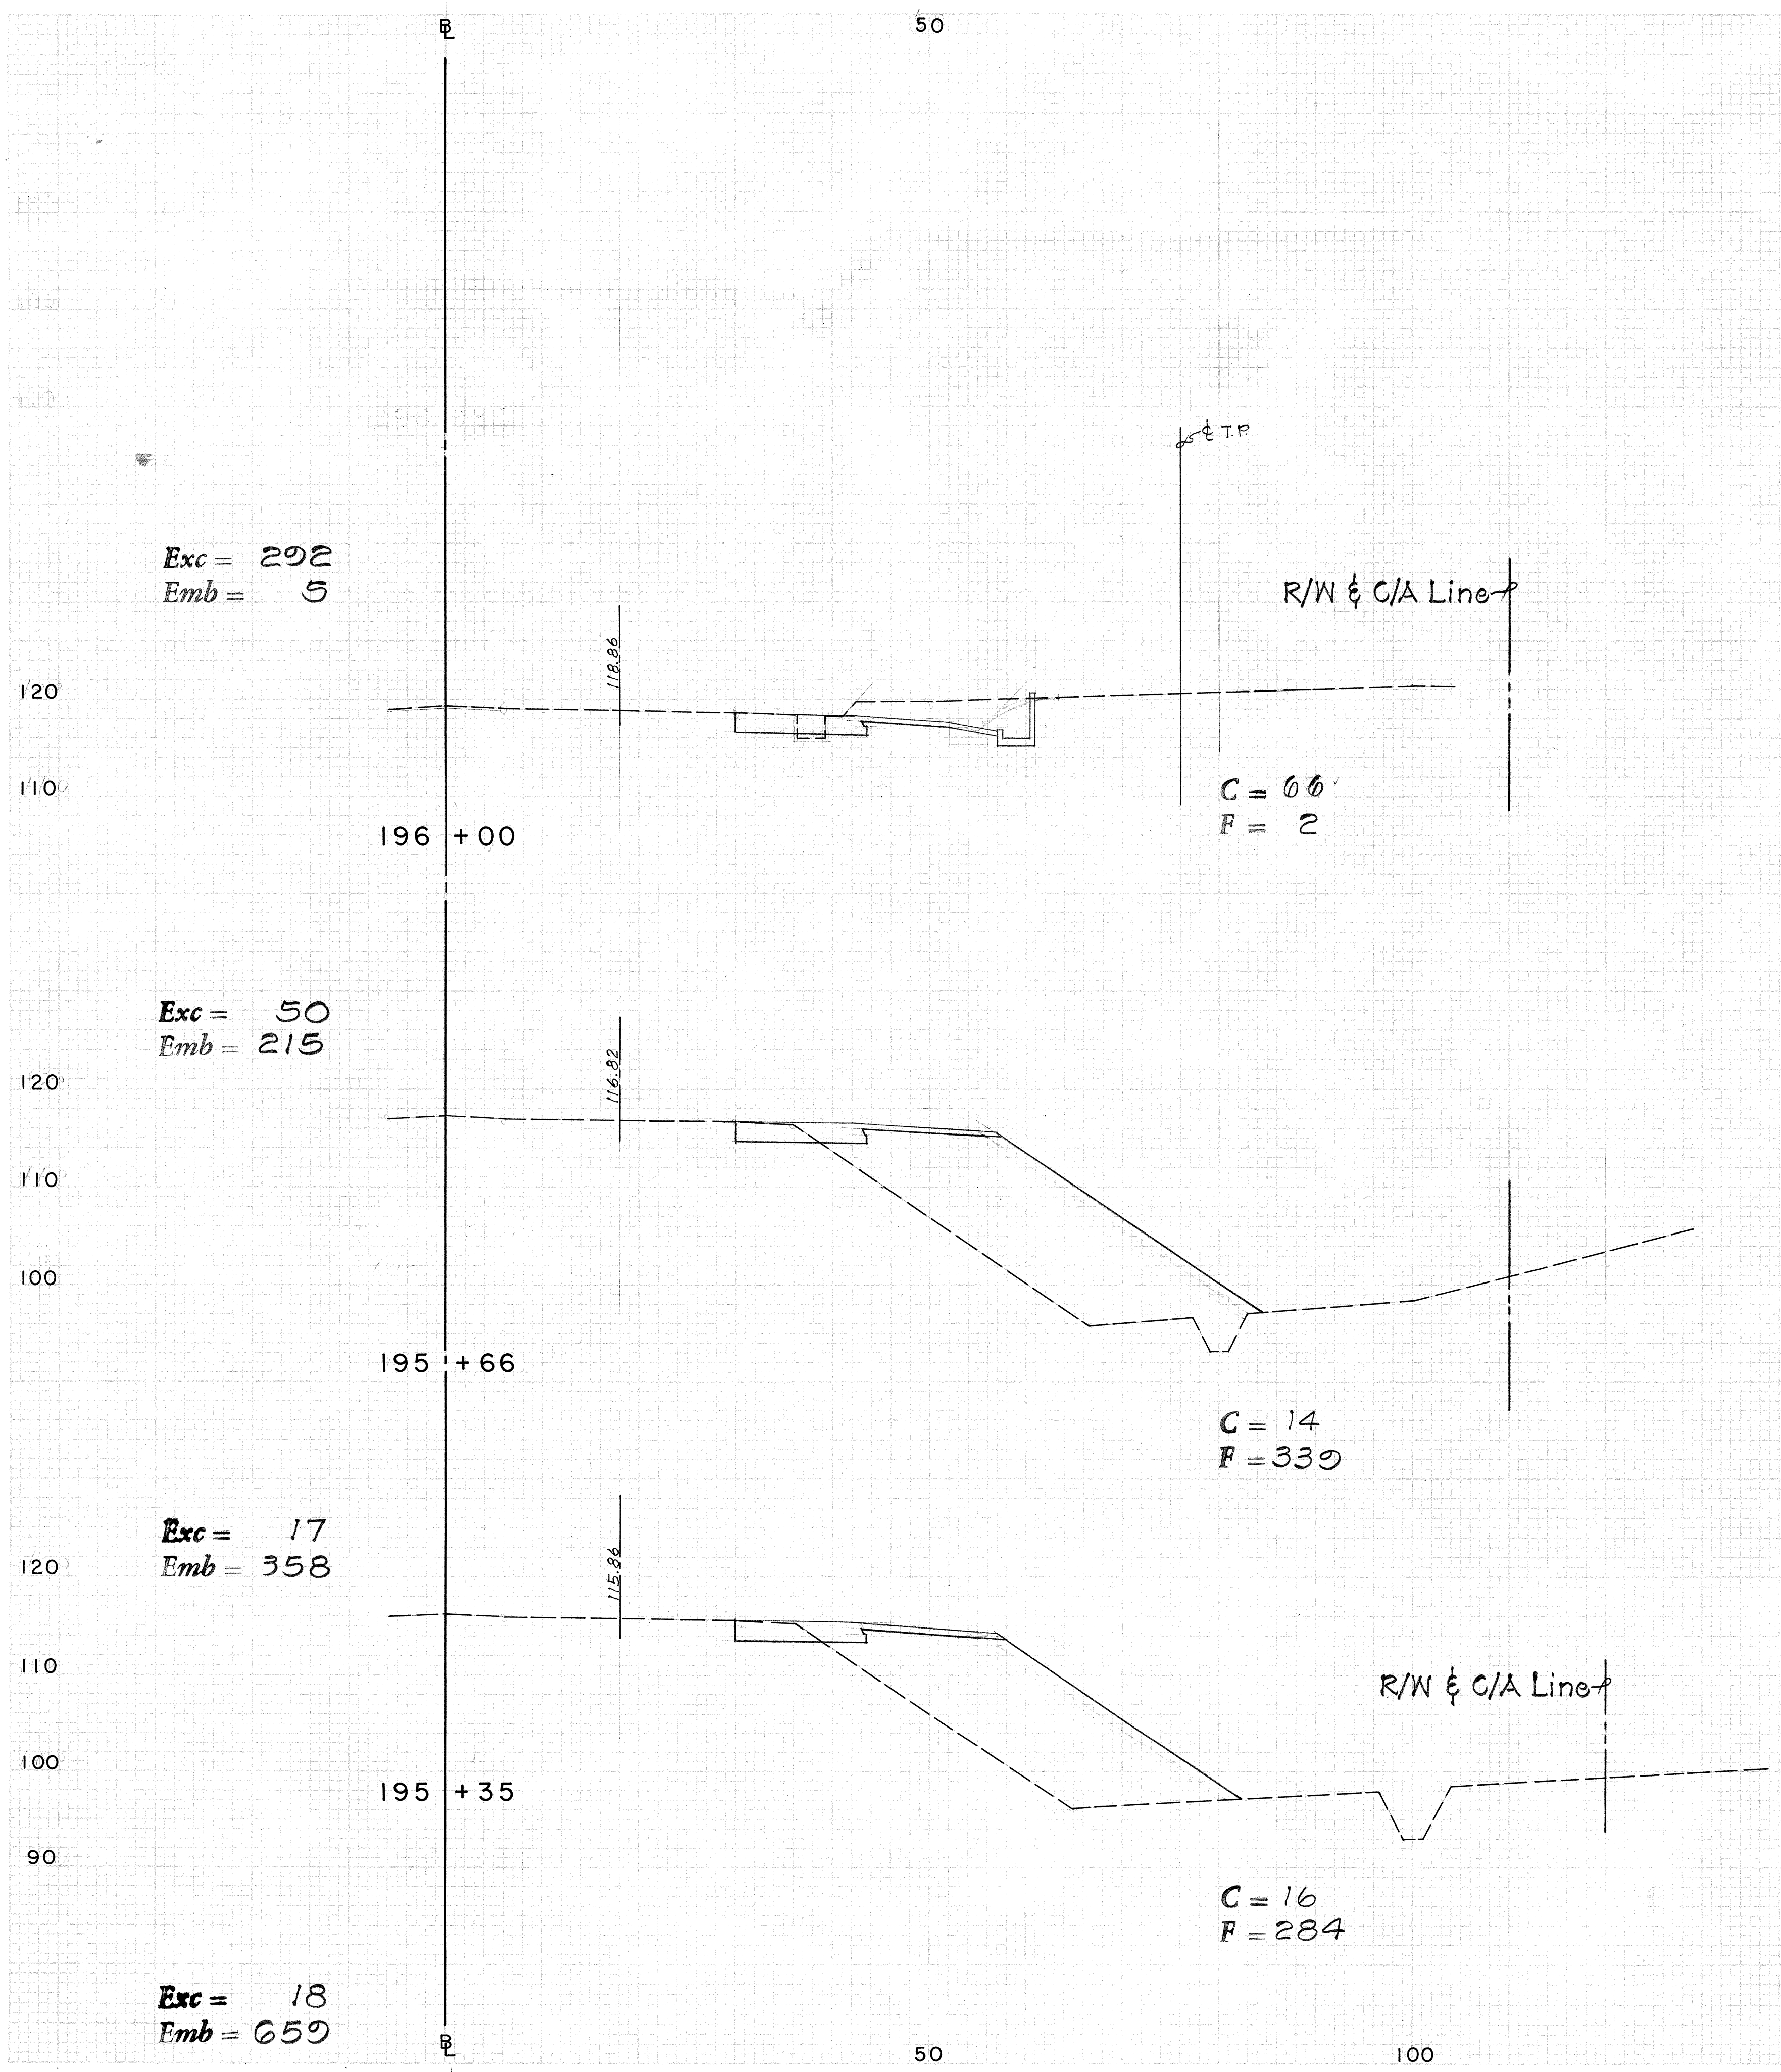



FED. ROAD DIST. NO.	STATE	FED. AID PROJ. NO.	FISCAL YEAR	SHEET NO.	TOTAL SHEETS
HAWAII	HAW	11-072-1(2)	1967	20	35

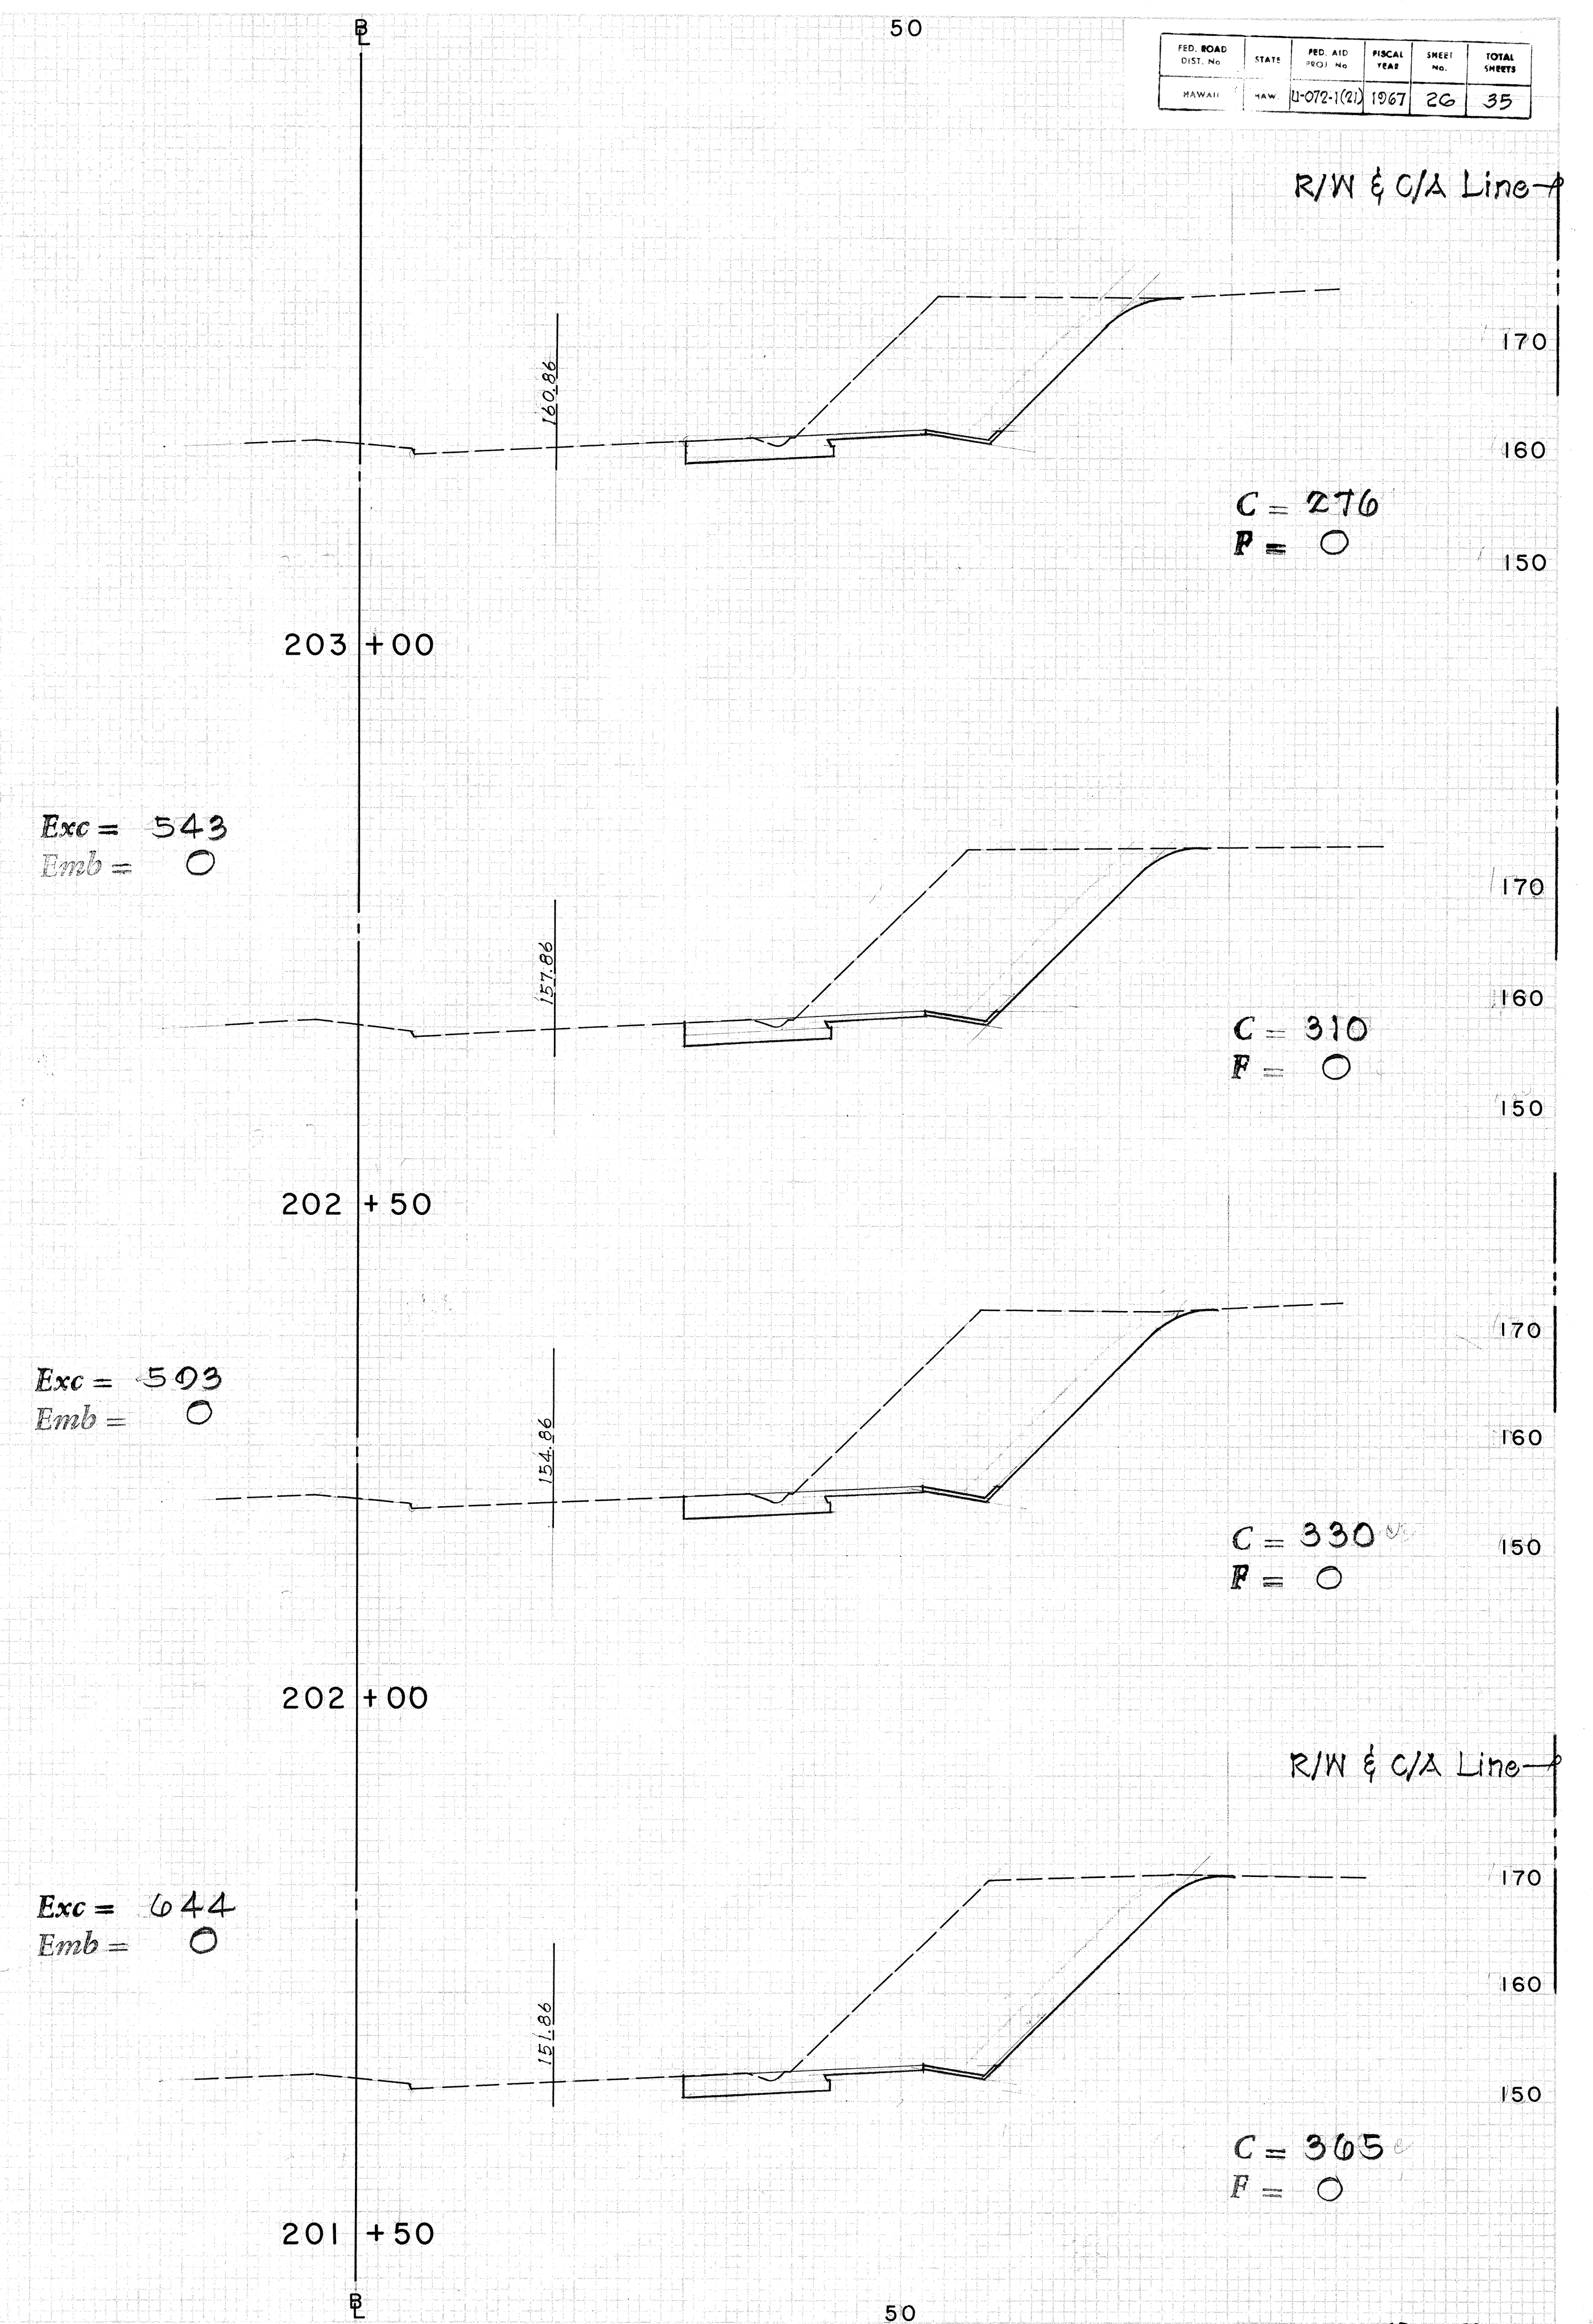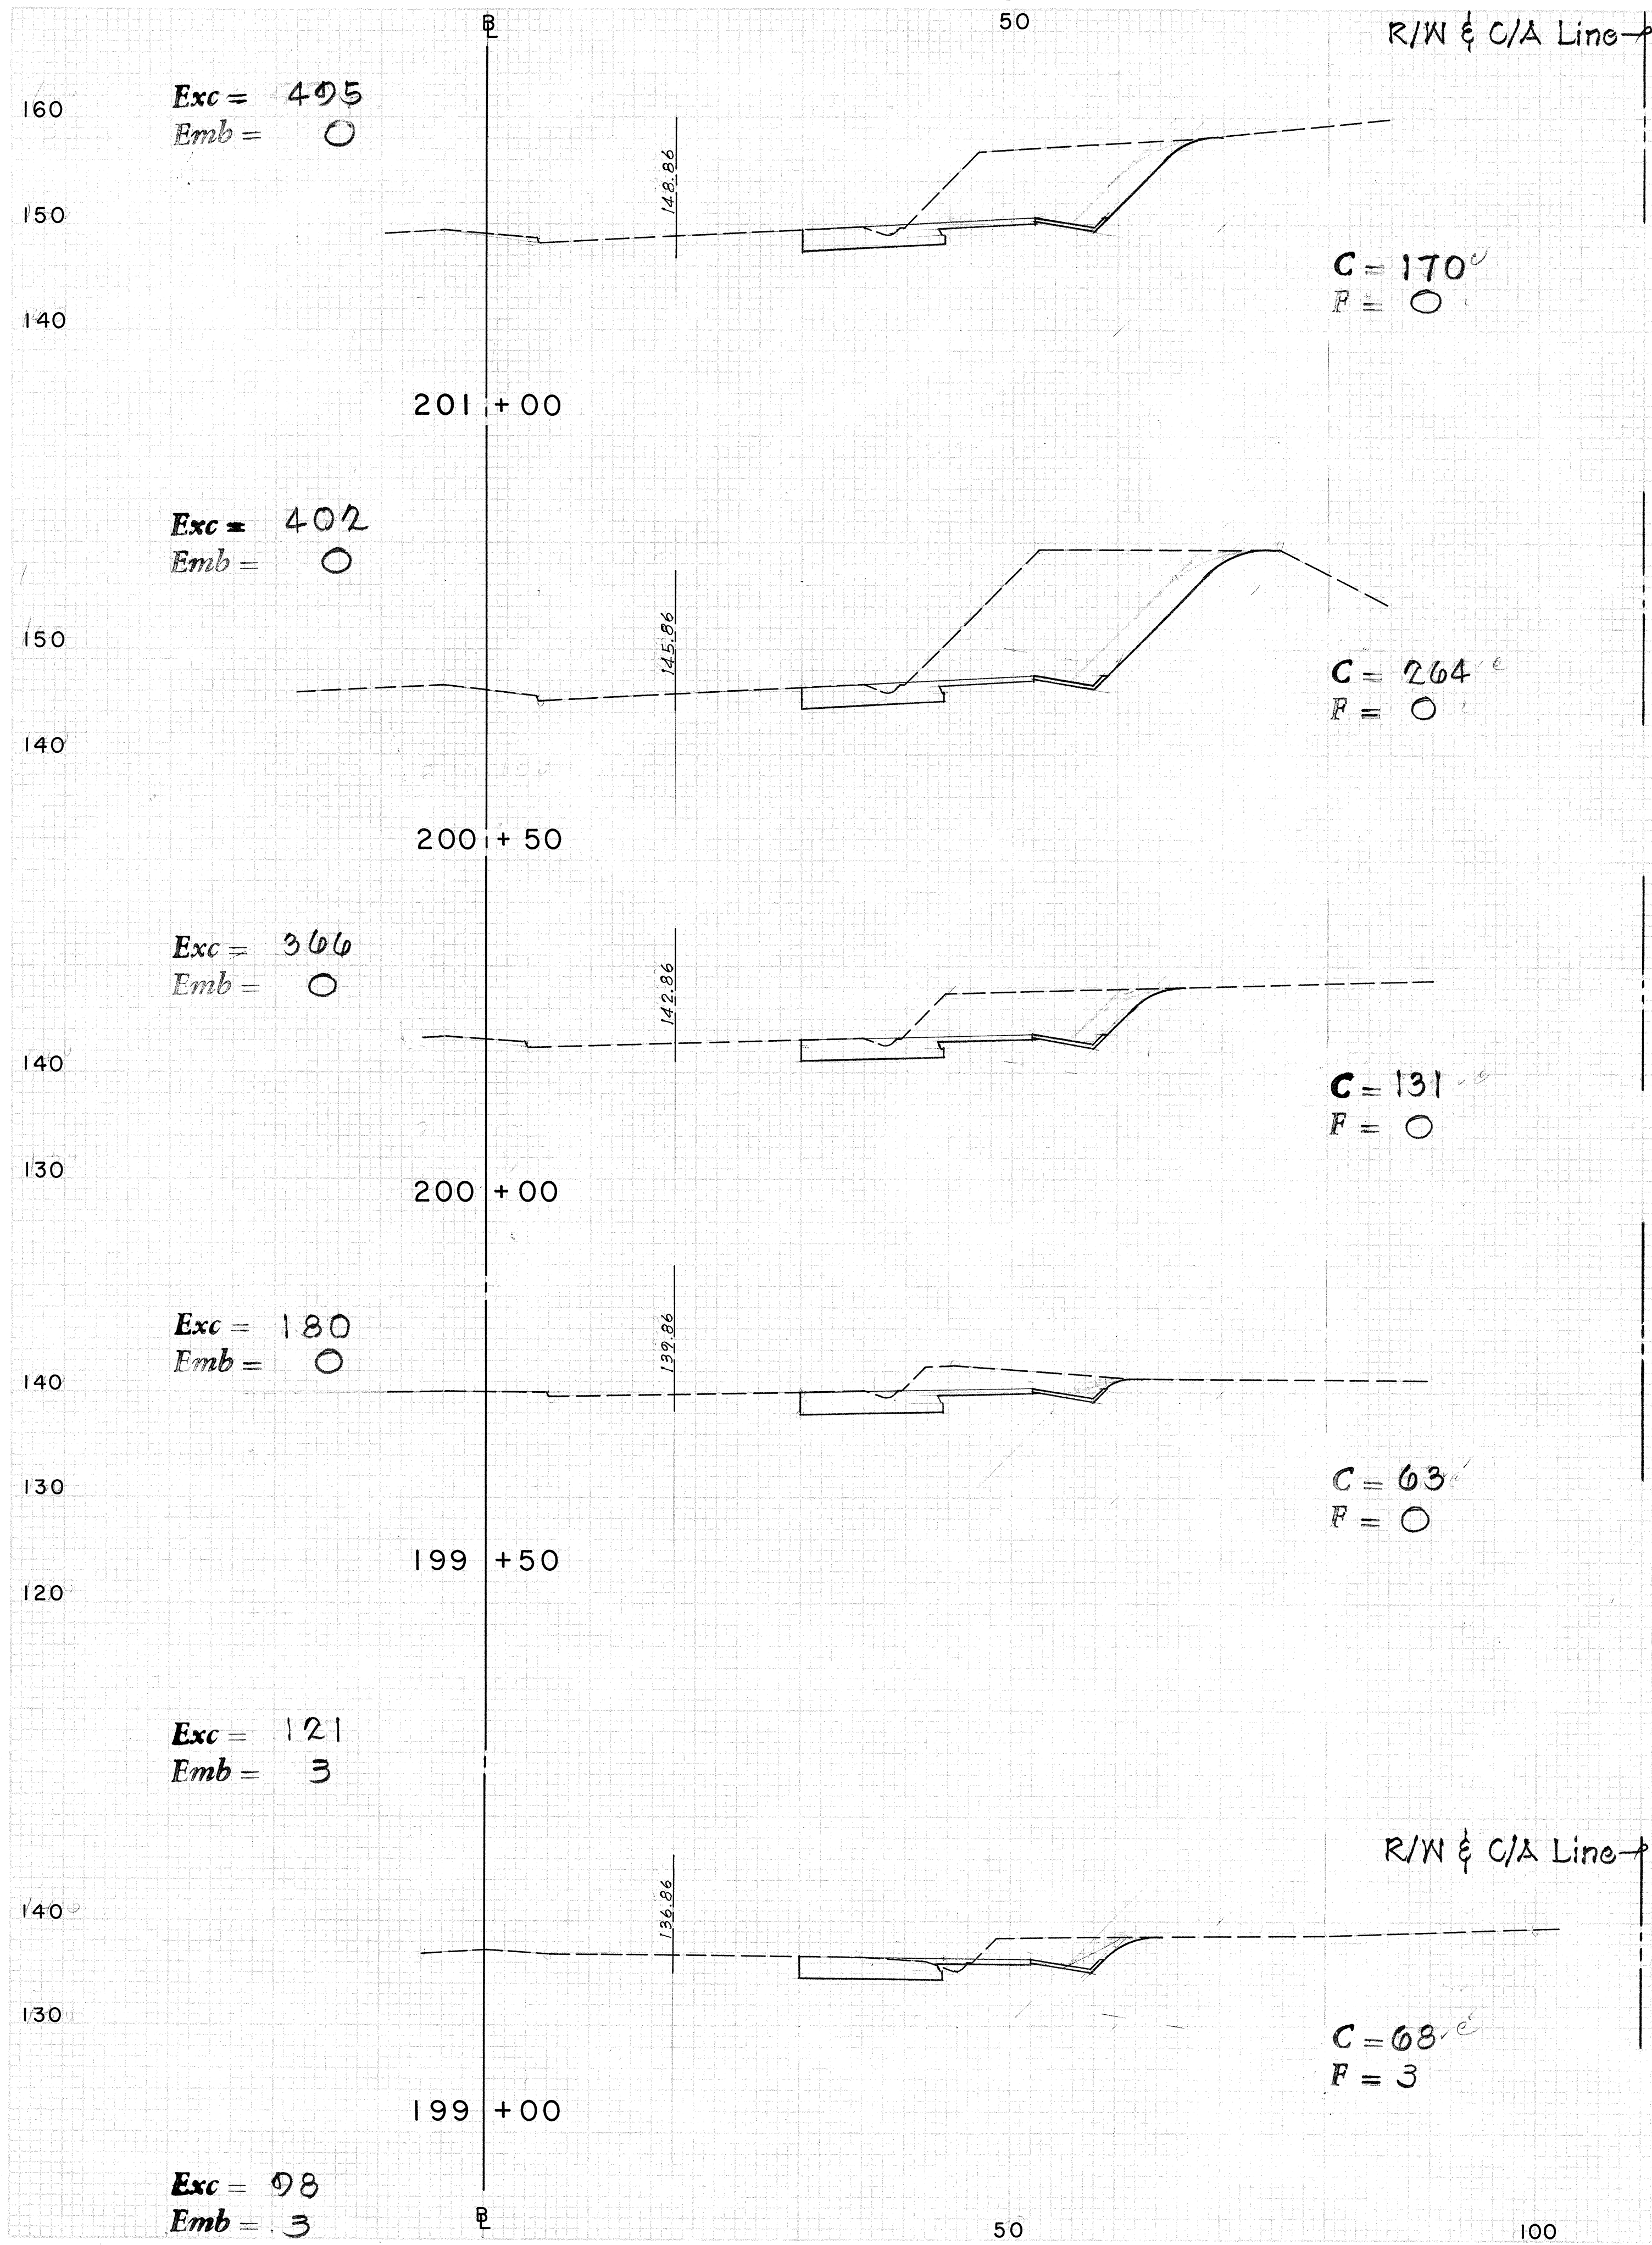



FED. ROAD DIST. NO.	STATE	FED. AID PROJ. NO.	FISCAL YEAR	SHEET NO.	TOTAL SHEETS
HAWAII	HAW	11-072-1(21)	1967	27	35

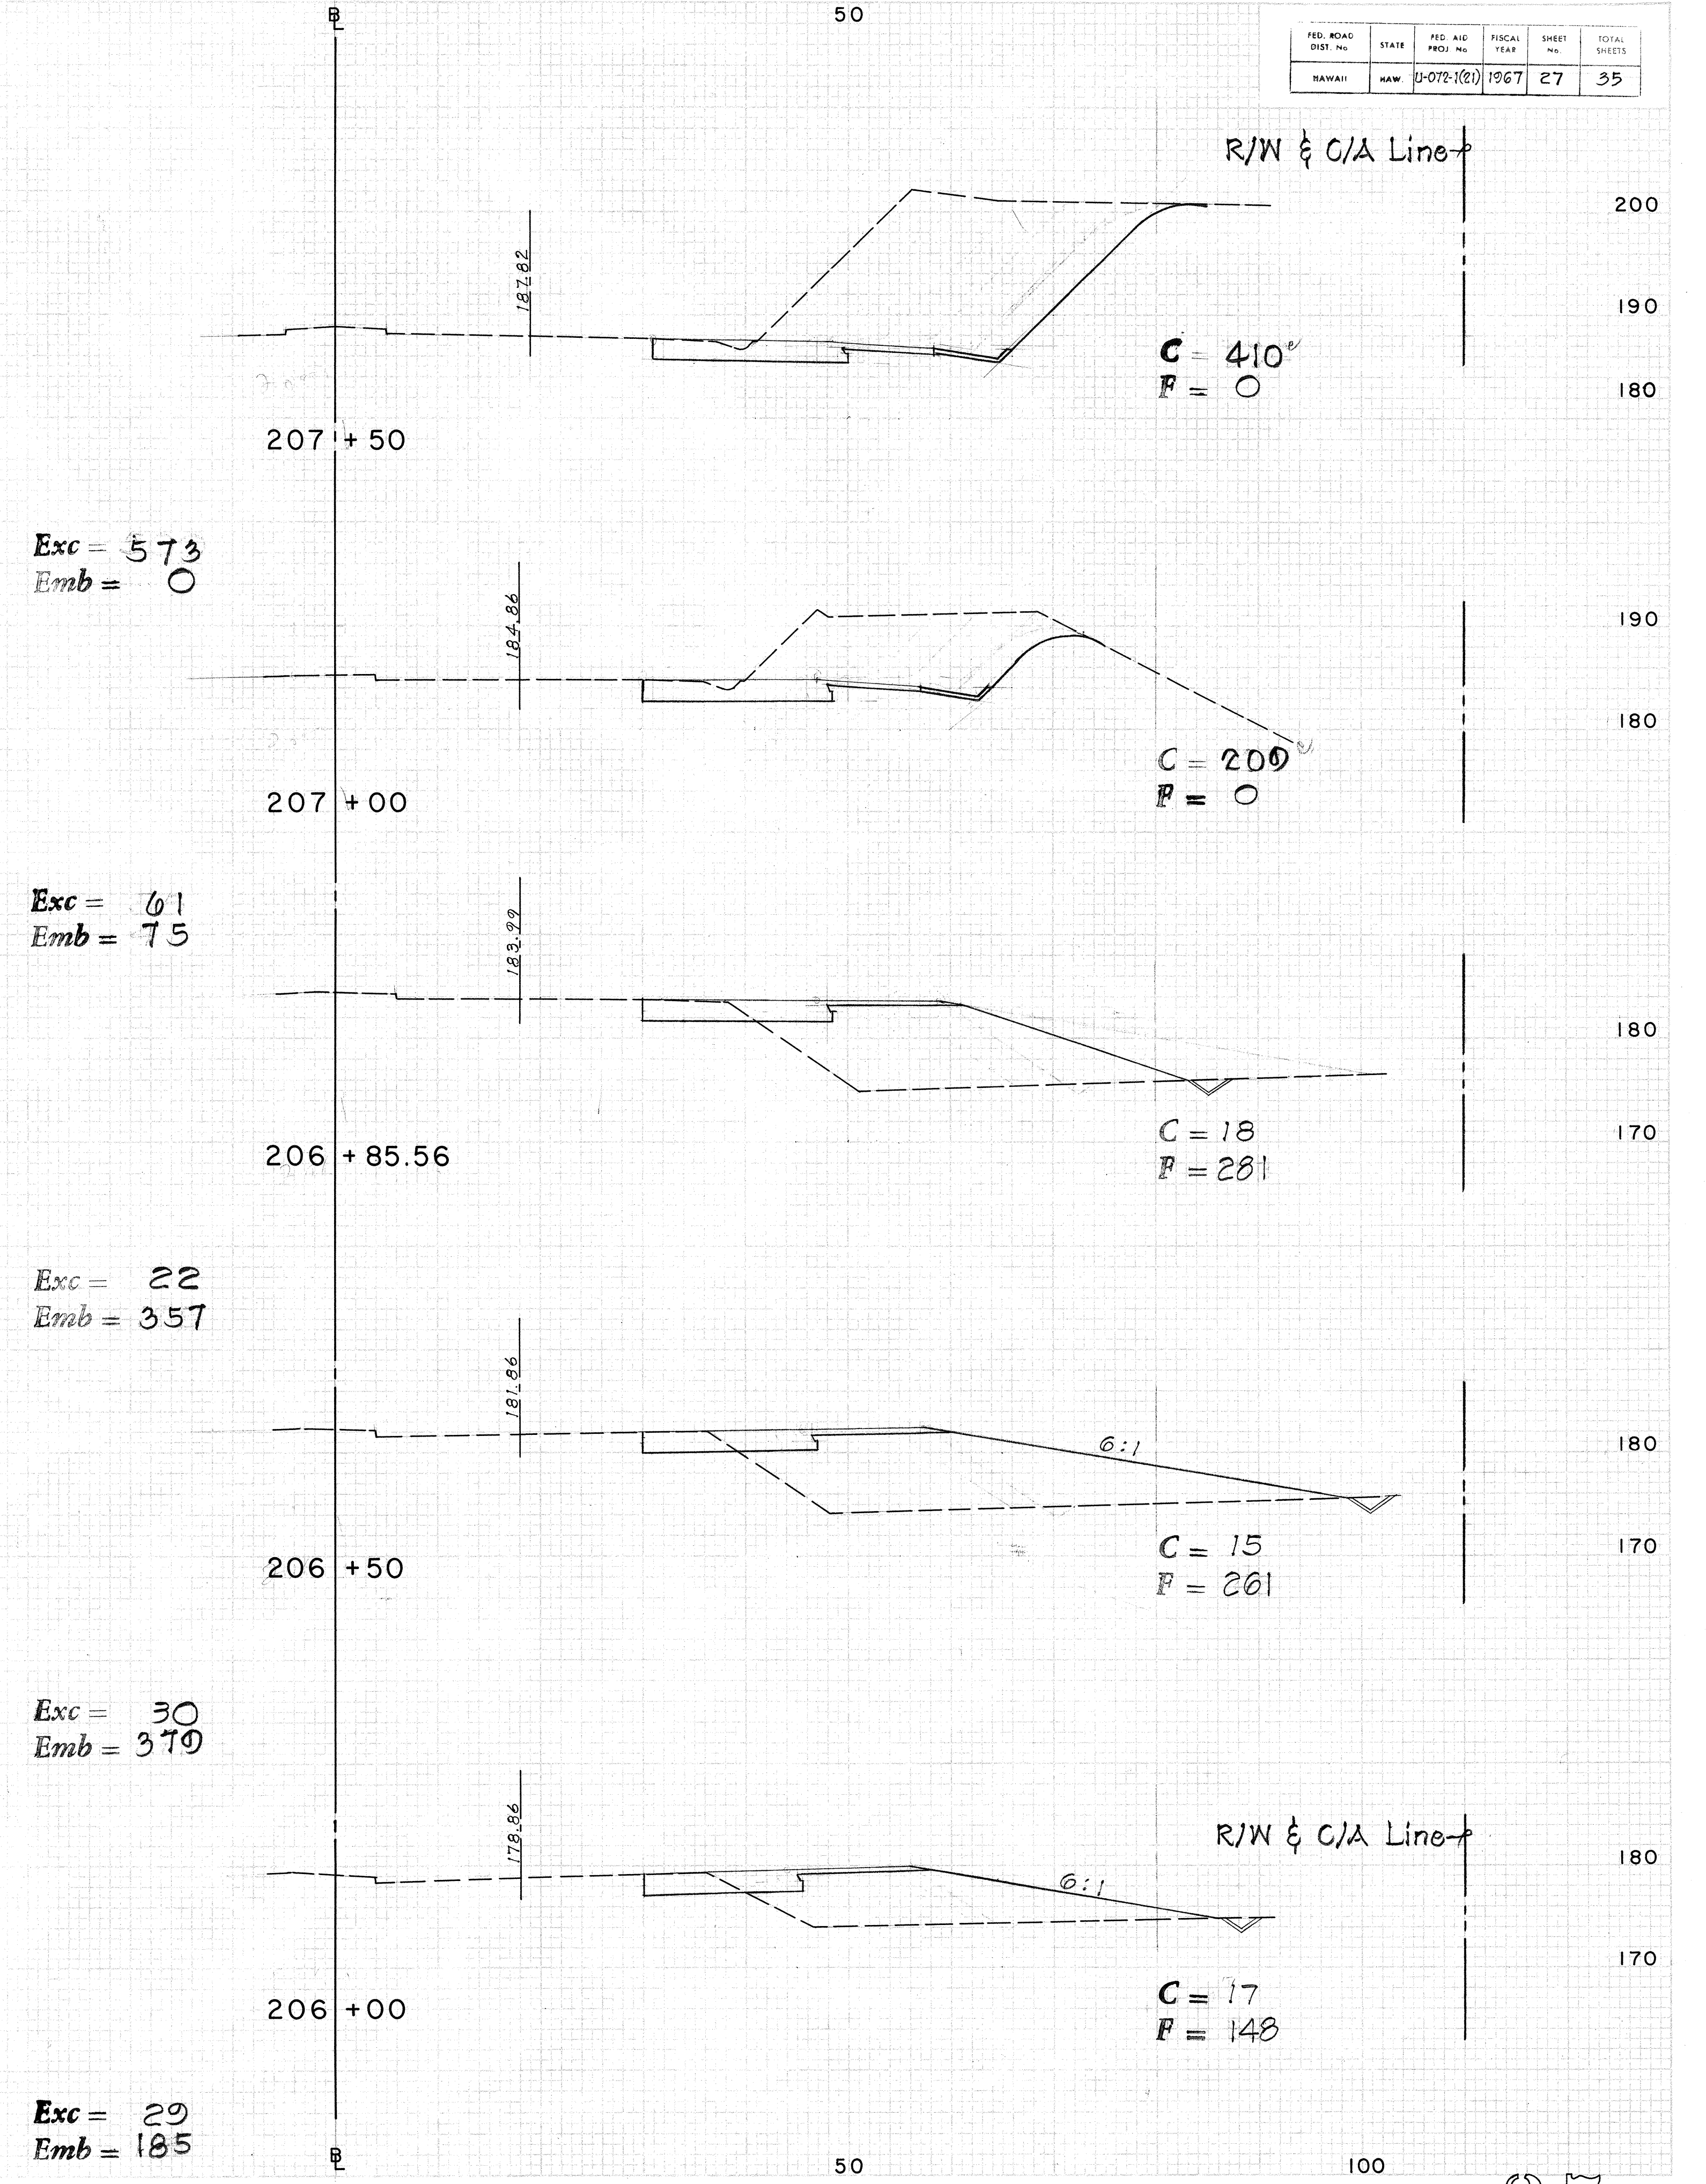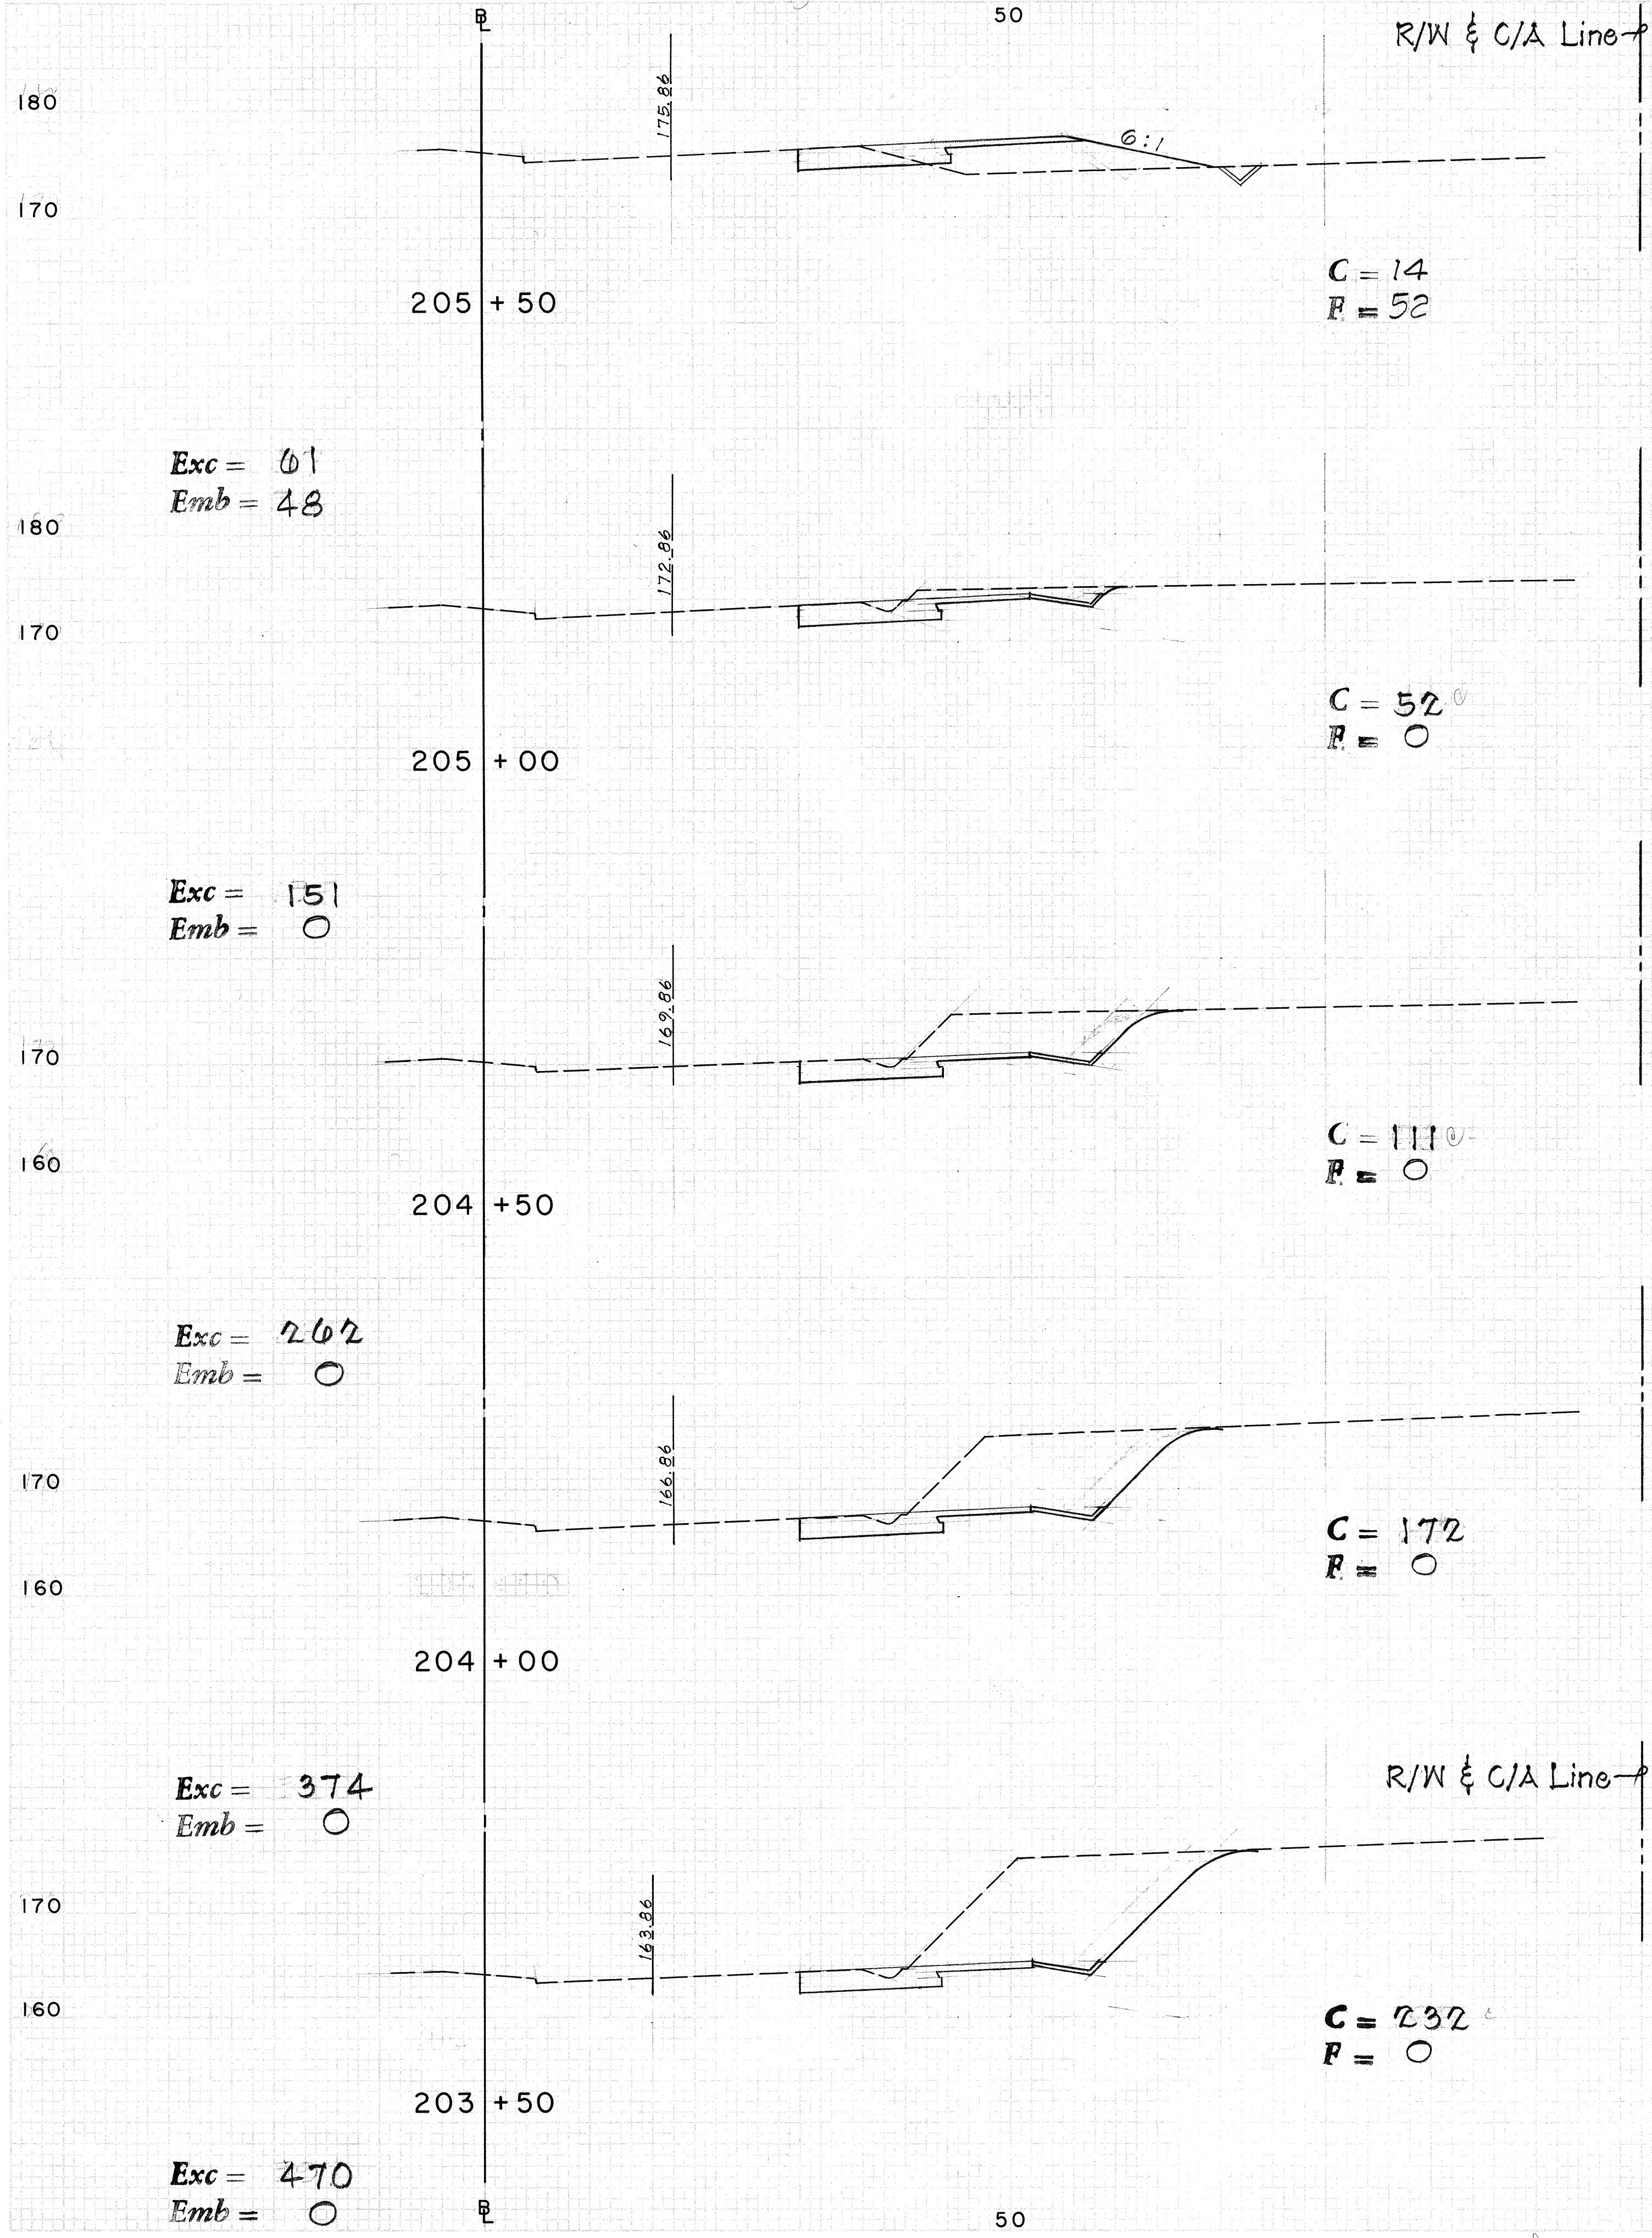



FED. ROAD DIST. NO.	STATE	FED. AID PROJ. NO.	FISCAL YEAR	SHEET NO.	TOTAL SHEETS
HAWAII	HAW.	U-072-100	1967	28	35

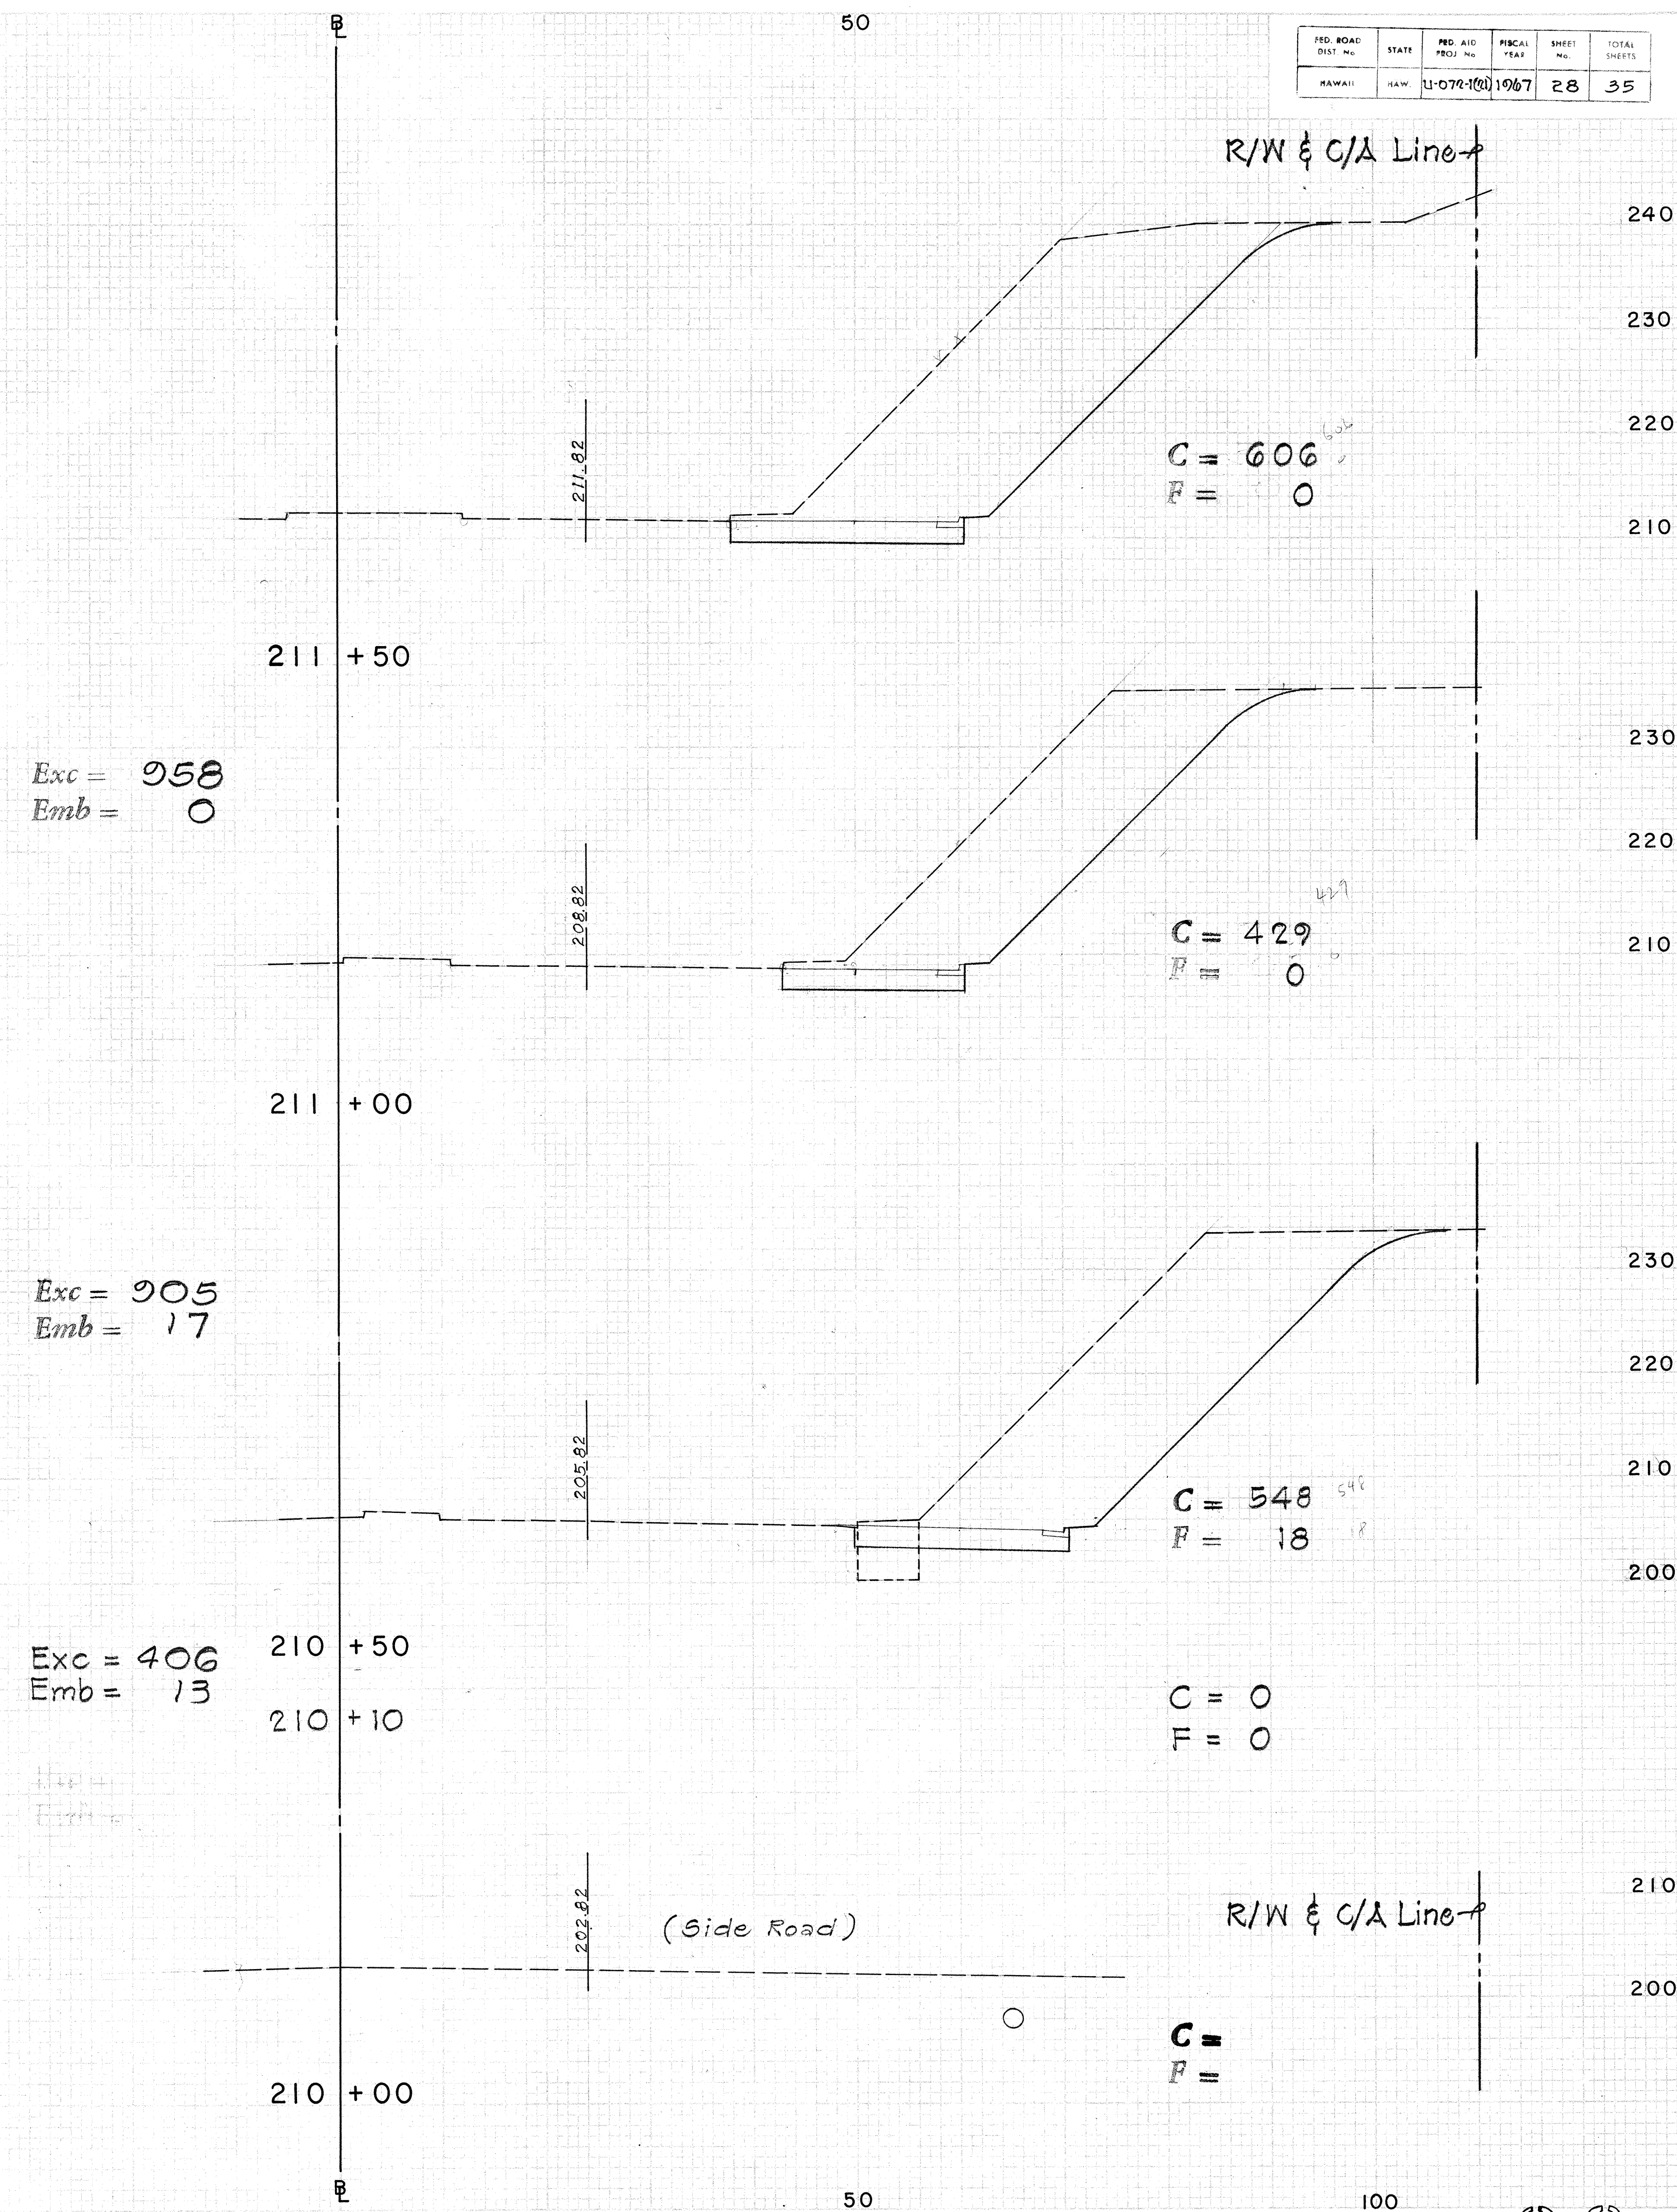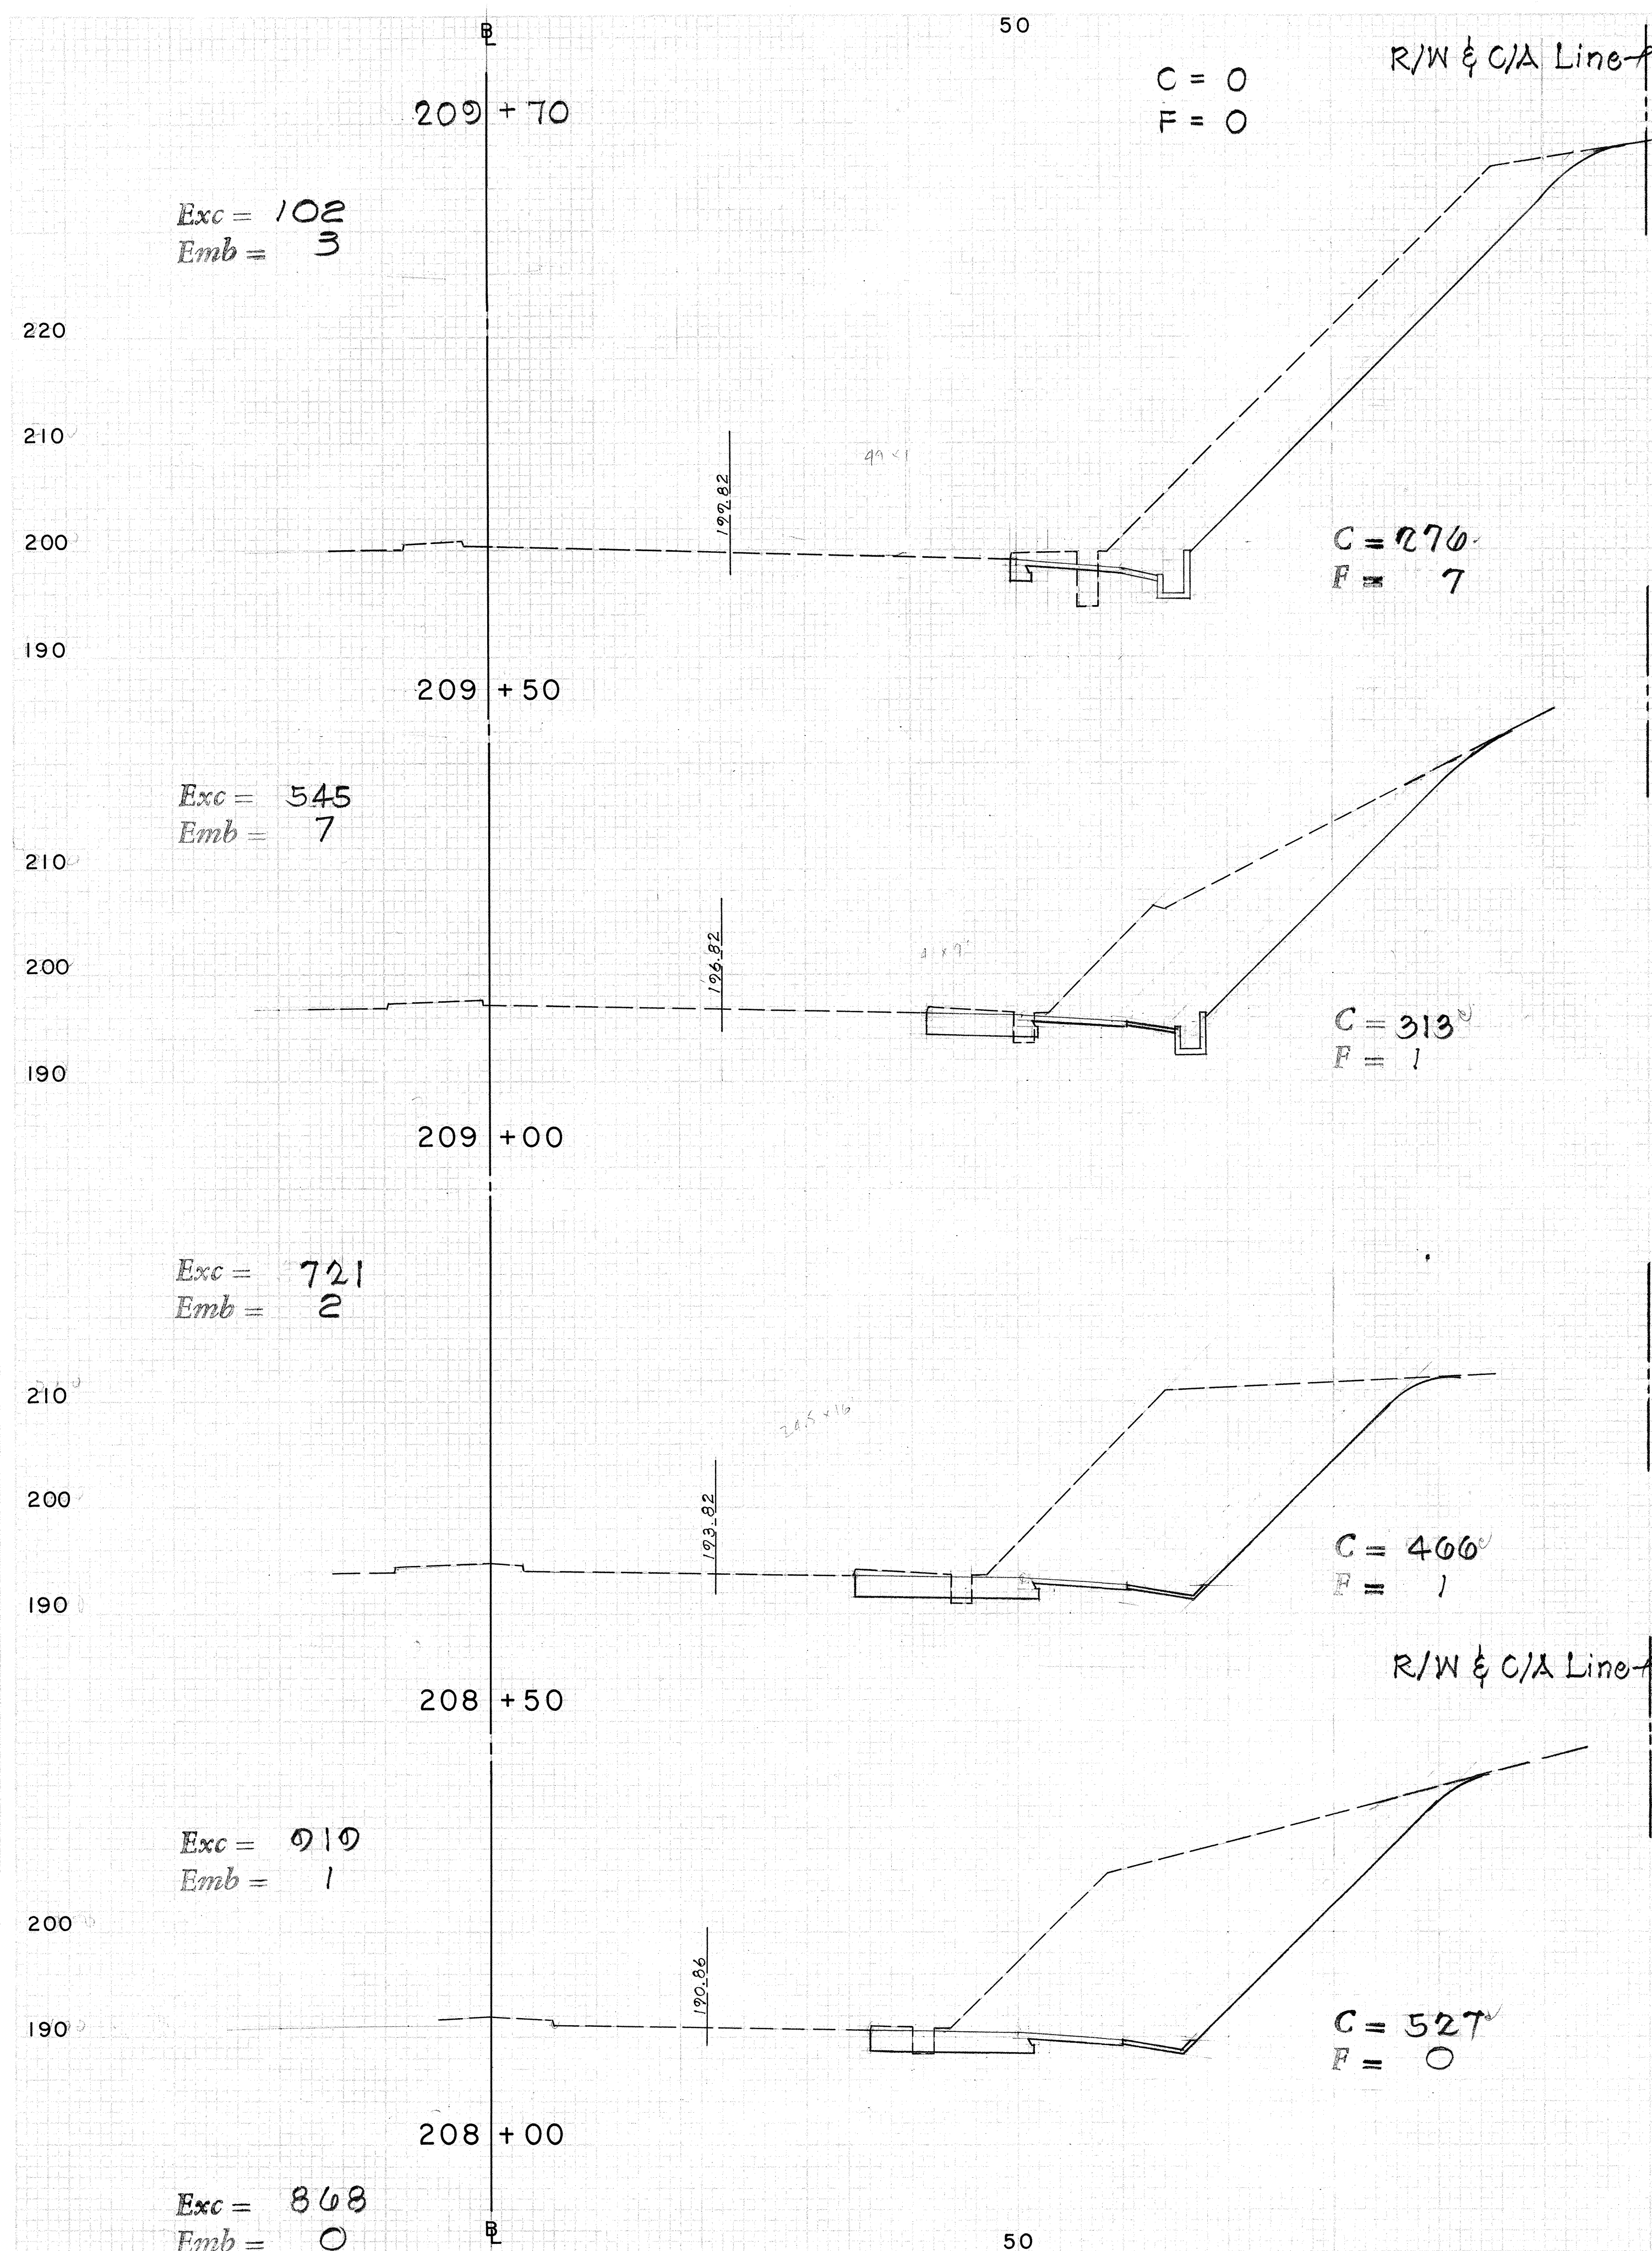



PRO. ROAD DIST. NO.	STATE	FED. AID PROJ. NO.	FISCAL YEAR	SHEET NO.	TOTAL SHEETS
HAWAII	HAW.	11-0721(2)	1967	29	35

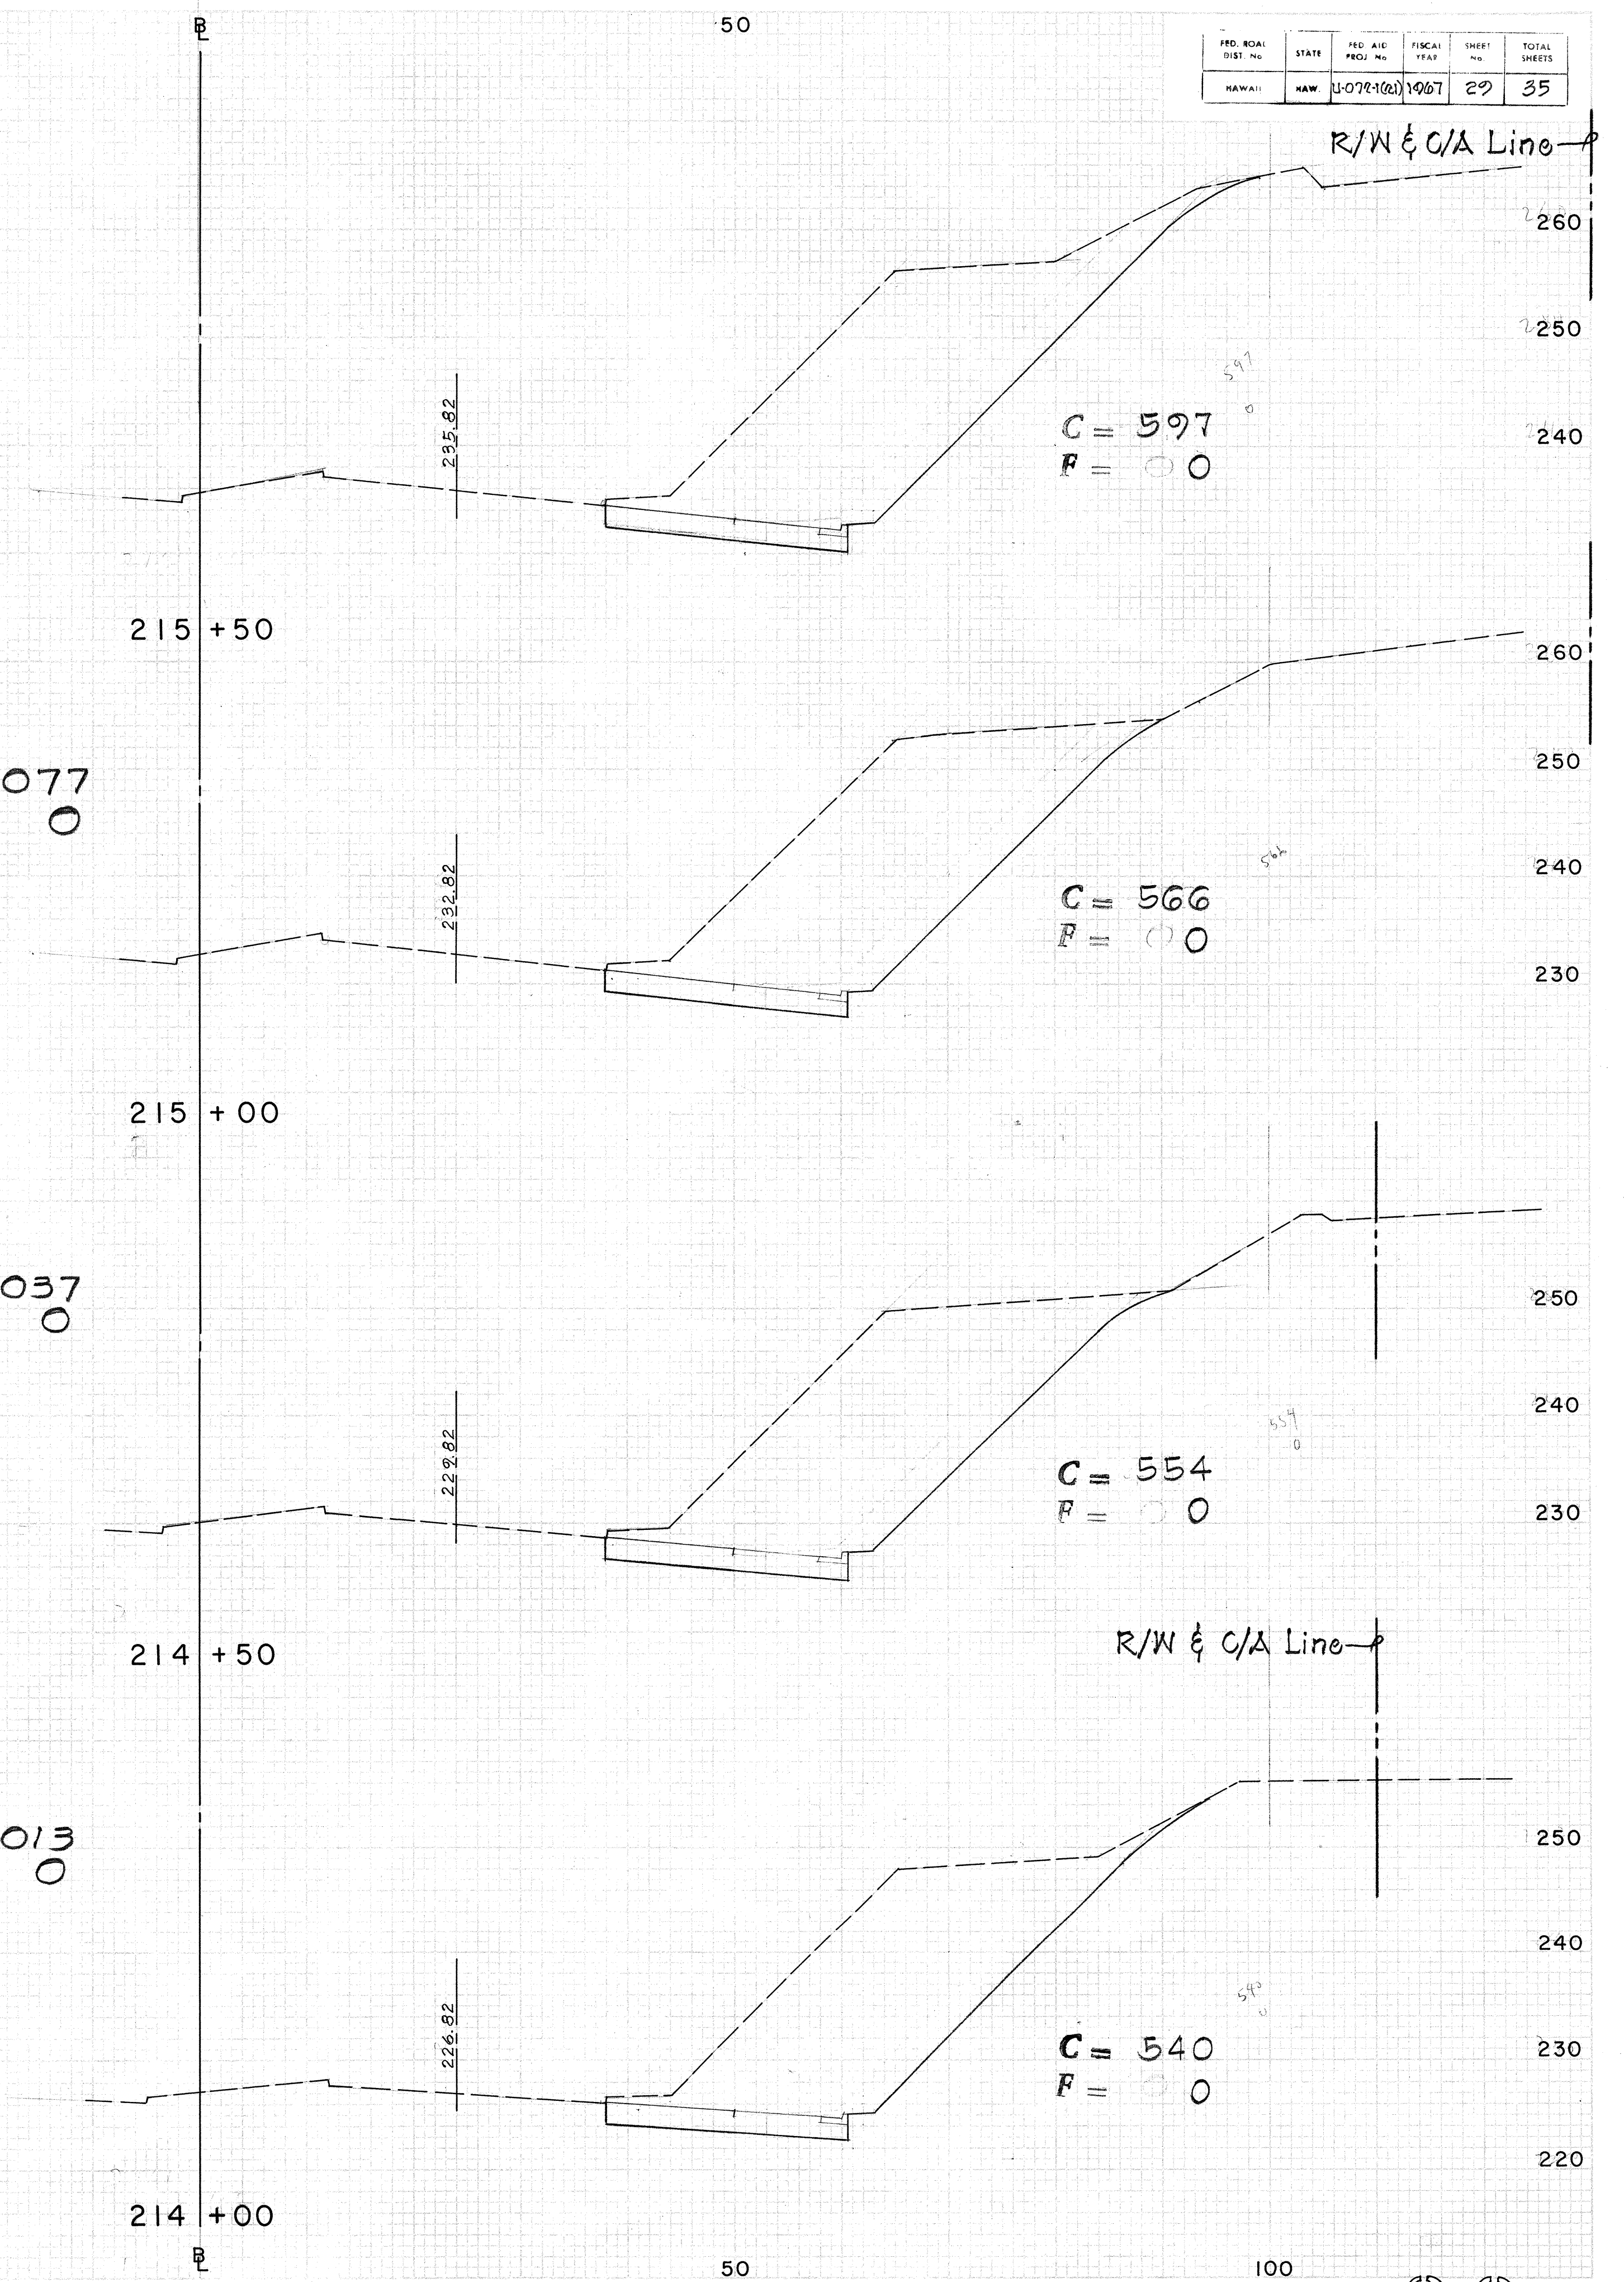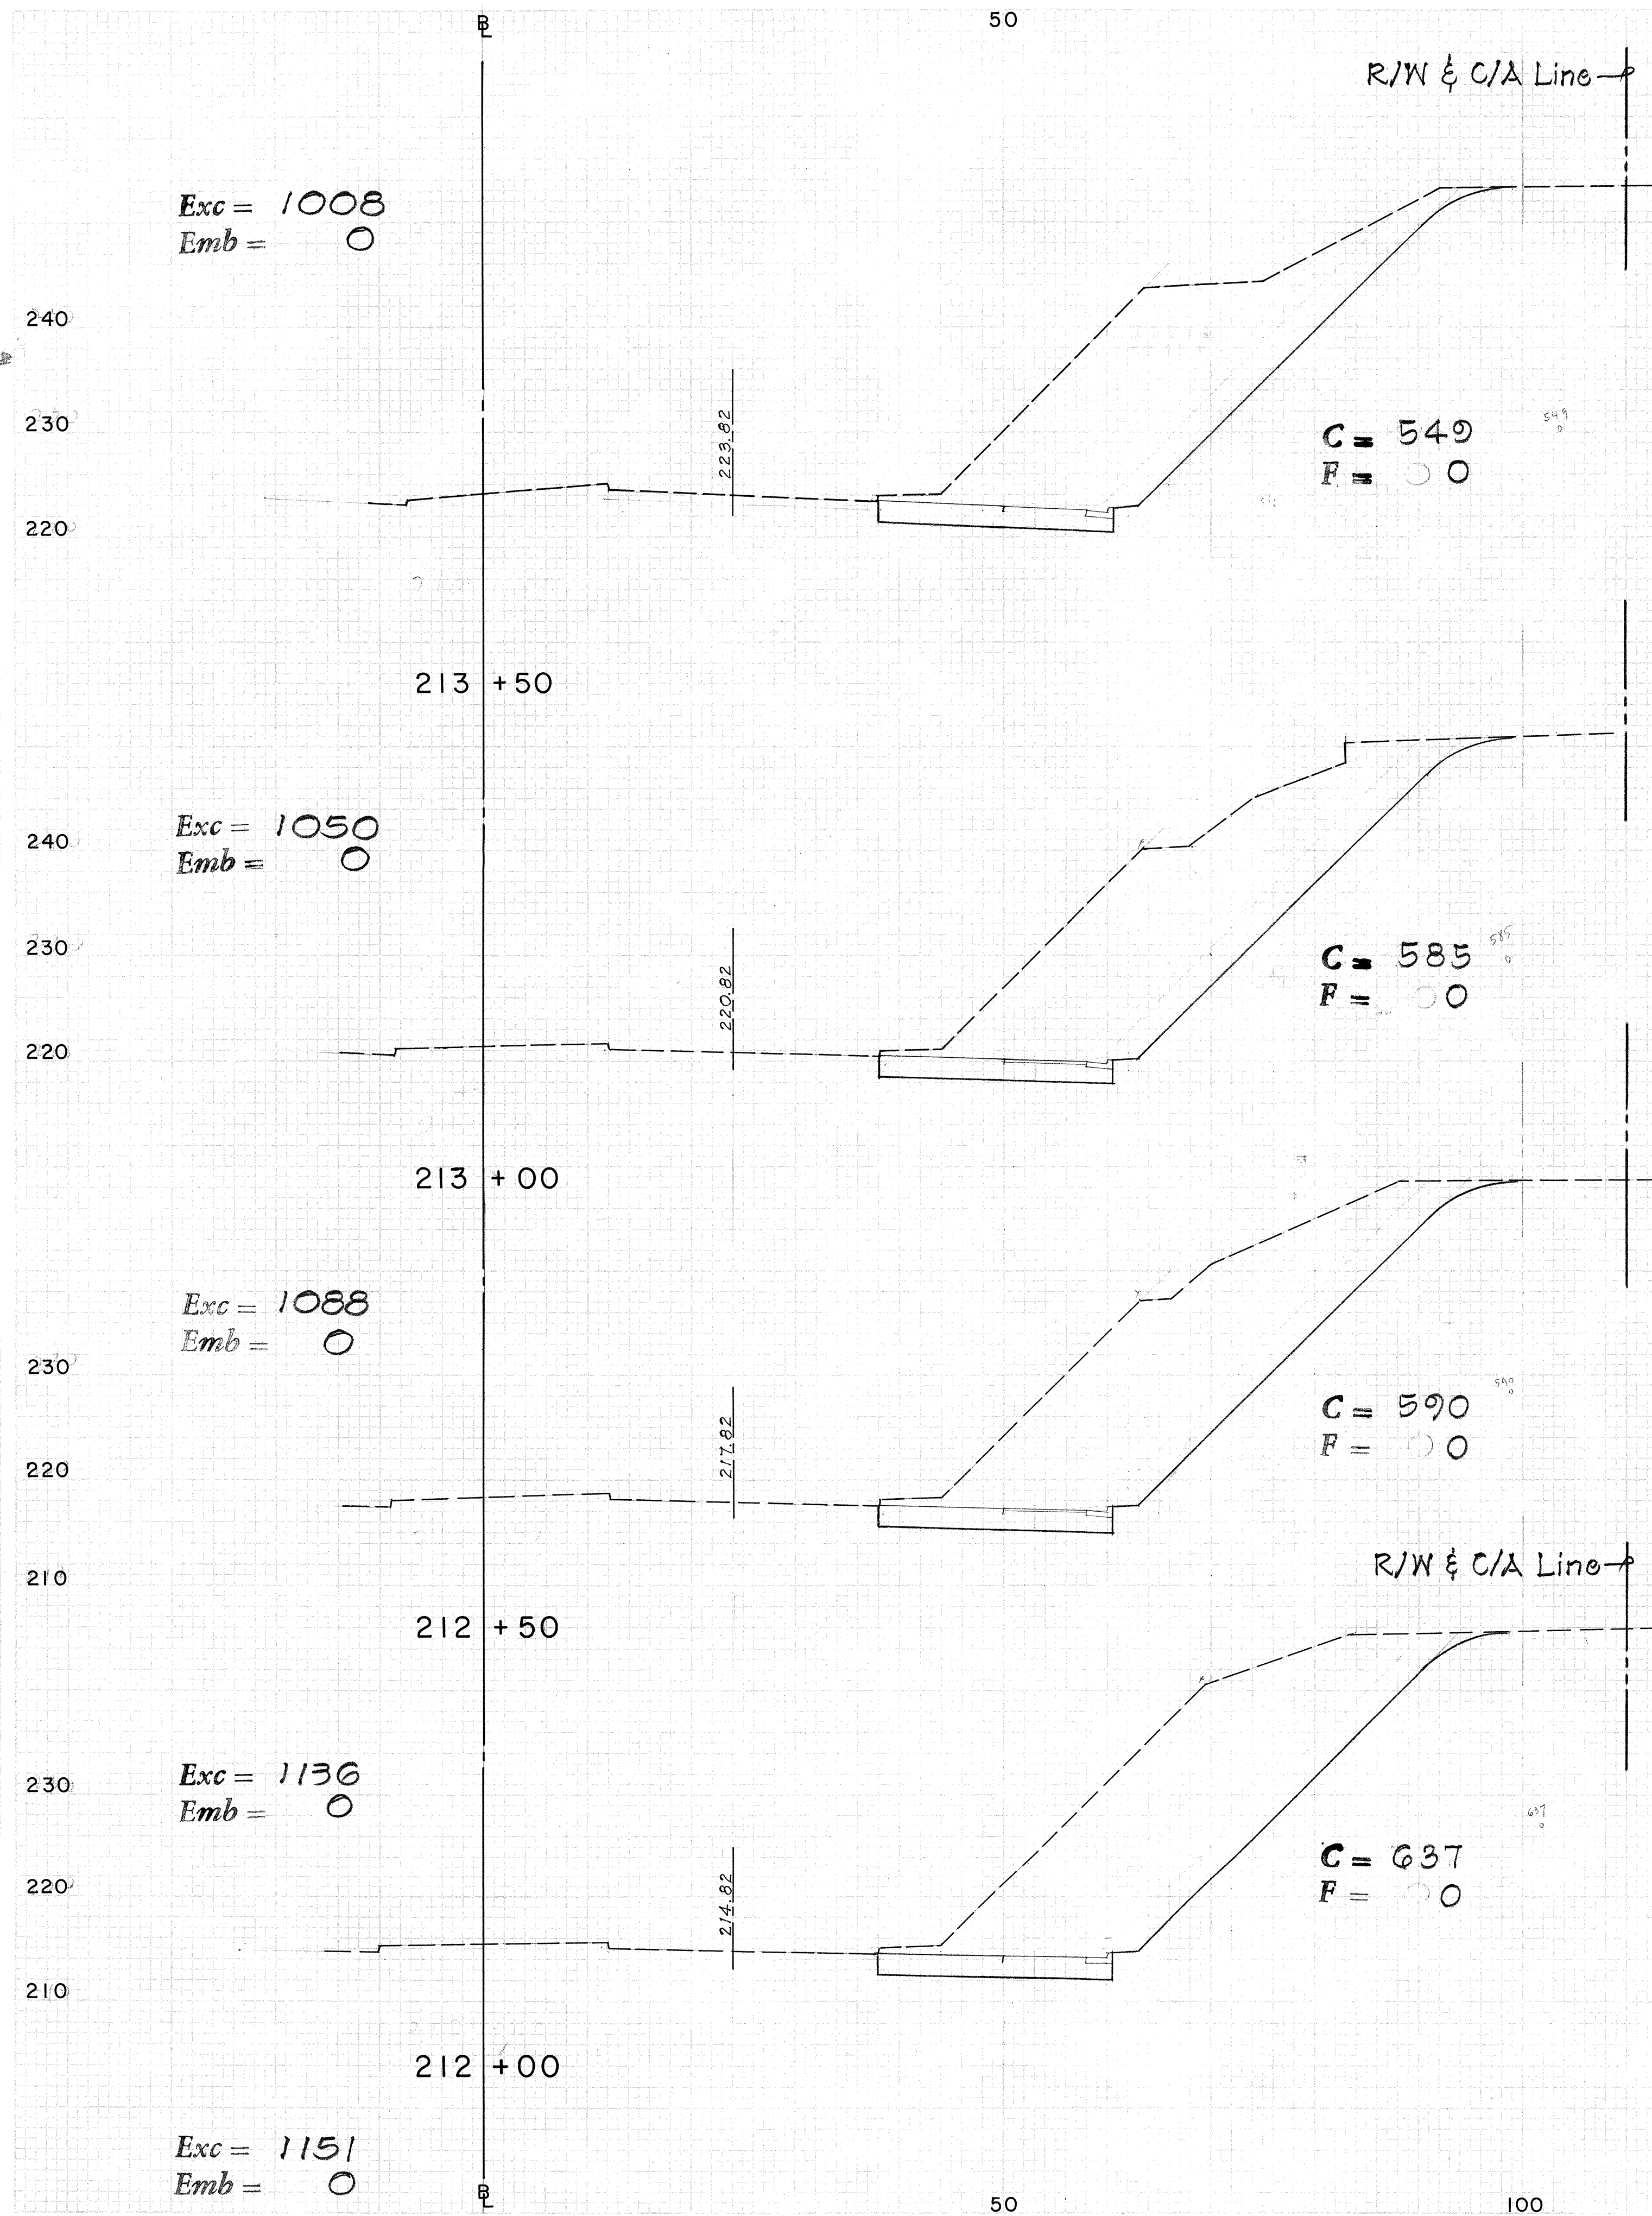



PRO. BOARD	STATE	PRO. AND	FISCAL	SHEET	TOTAL
DIST. NO.		PROJ. NO.	YEAR	NO.	SHEETS
HAWAII	HAU	11-070-100	1967	30	35

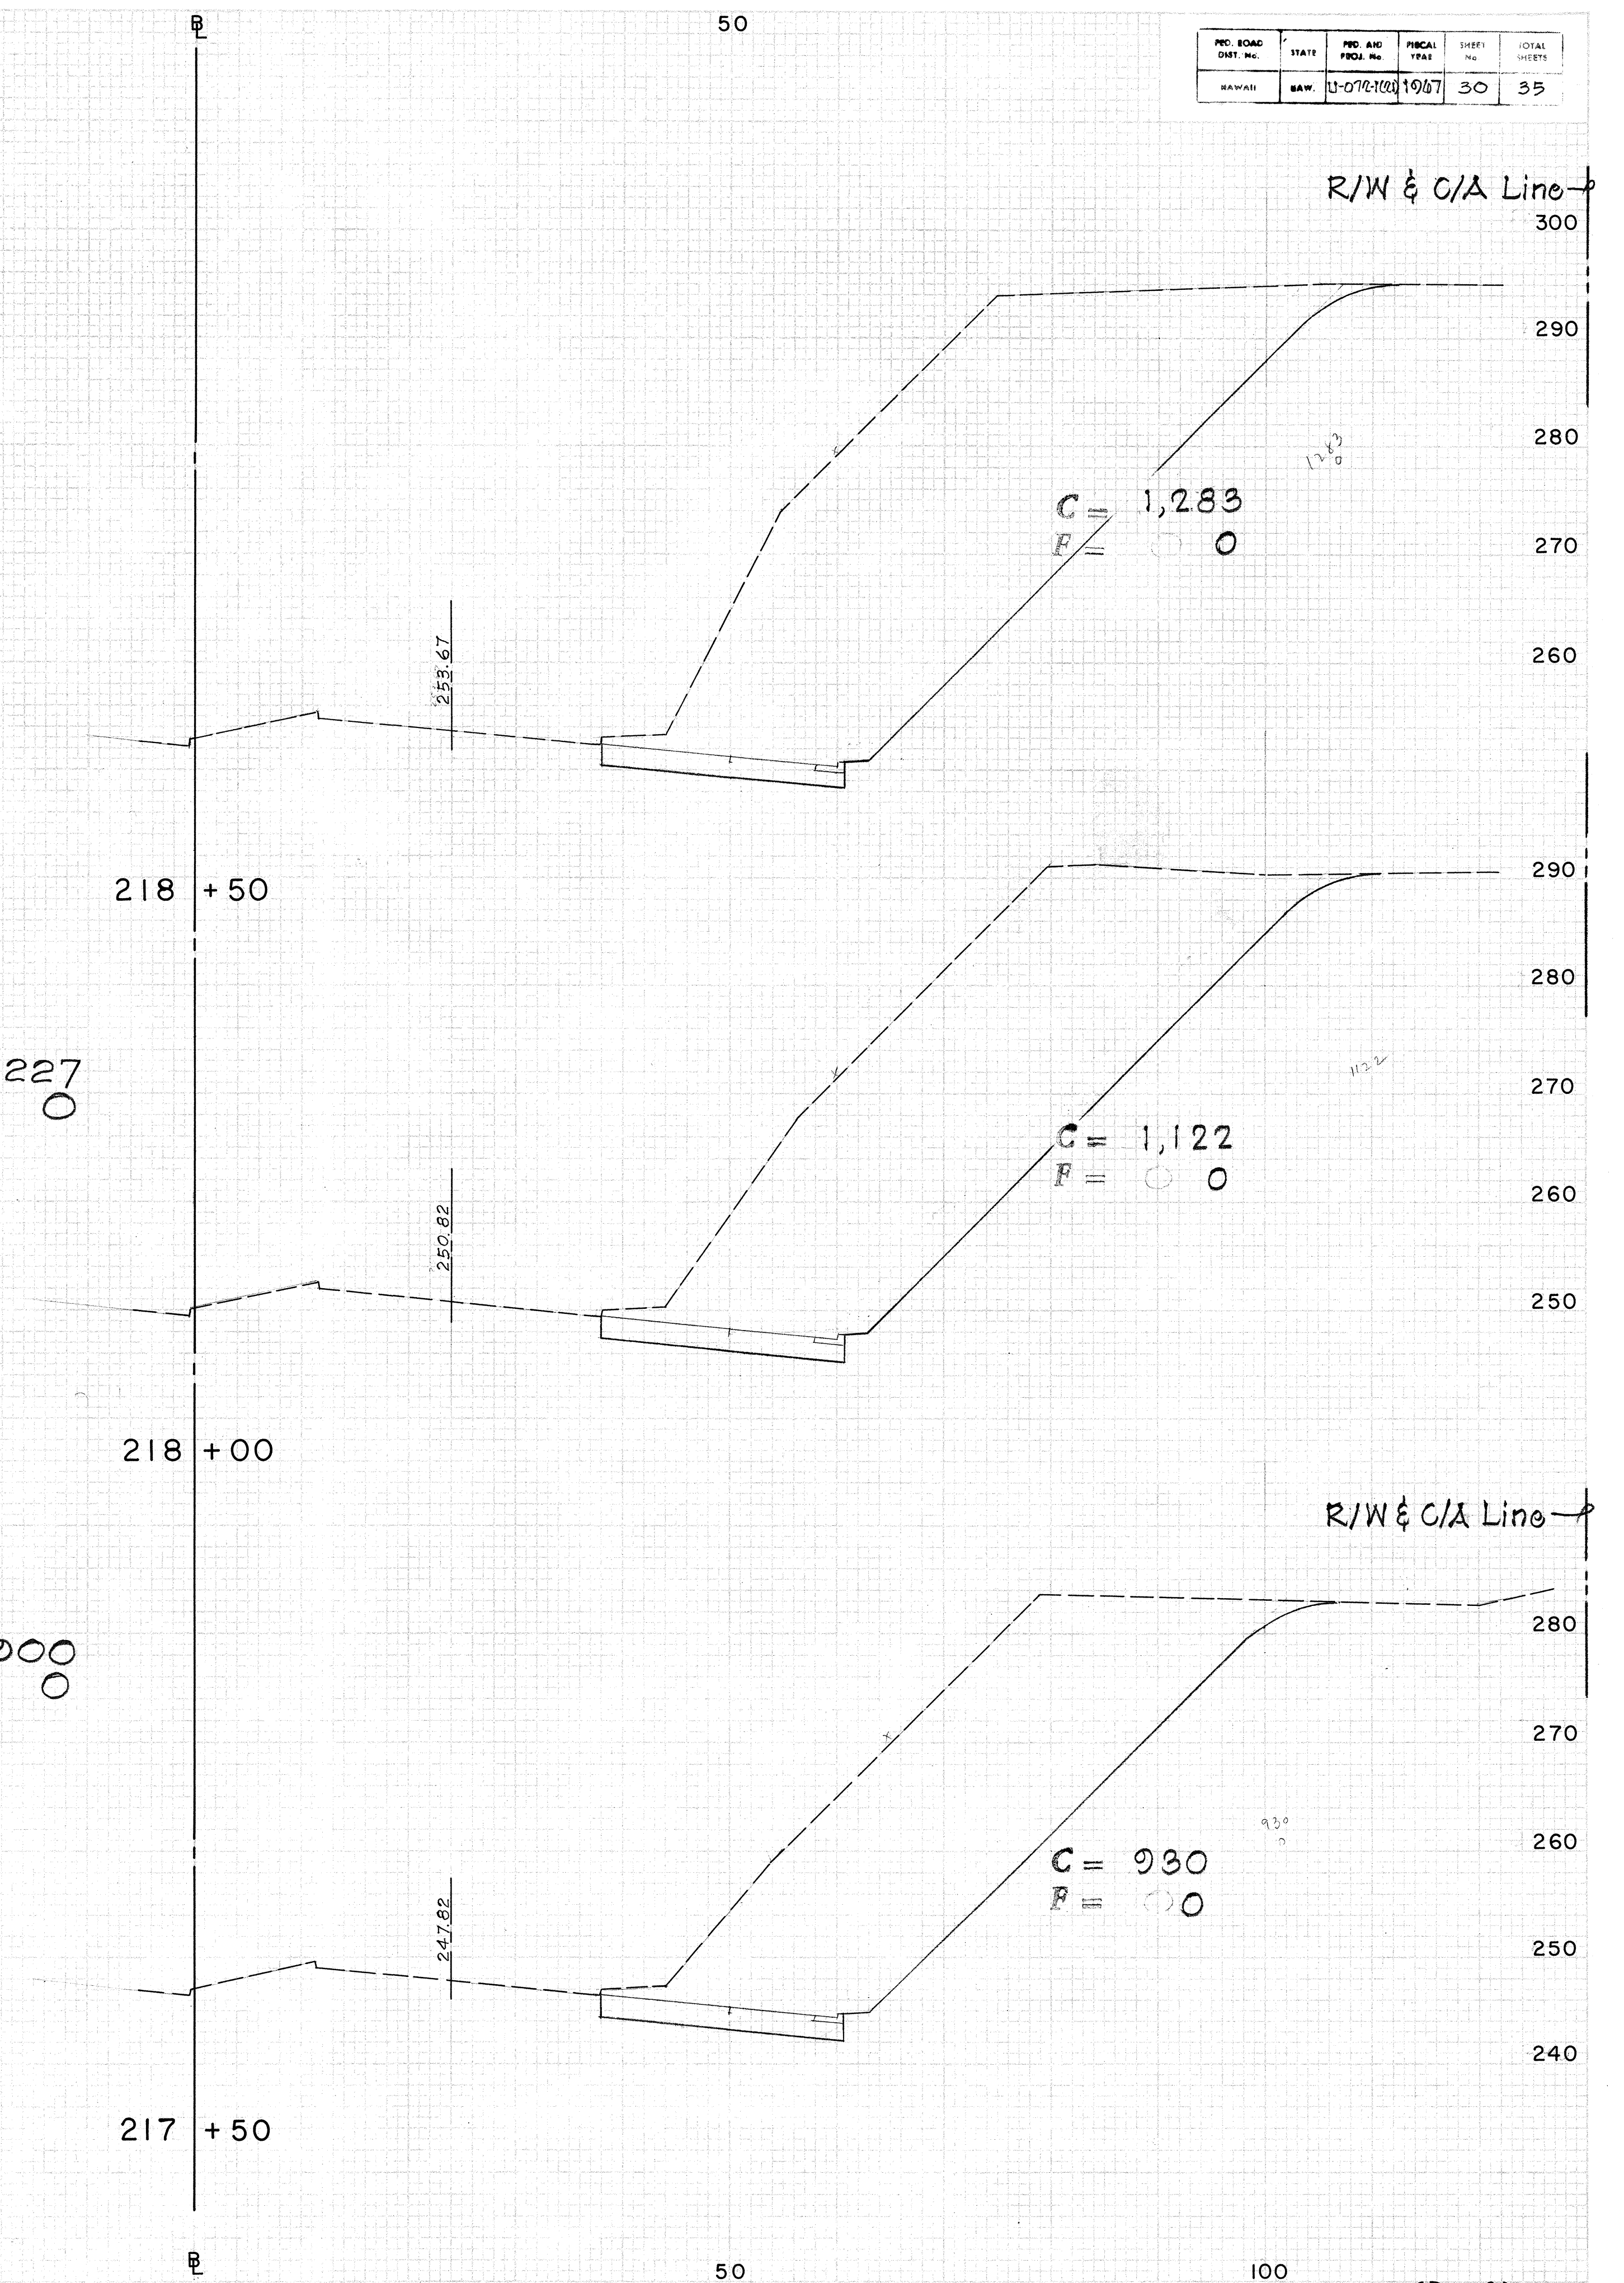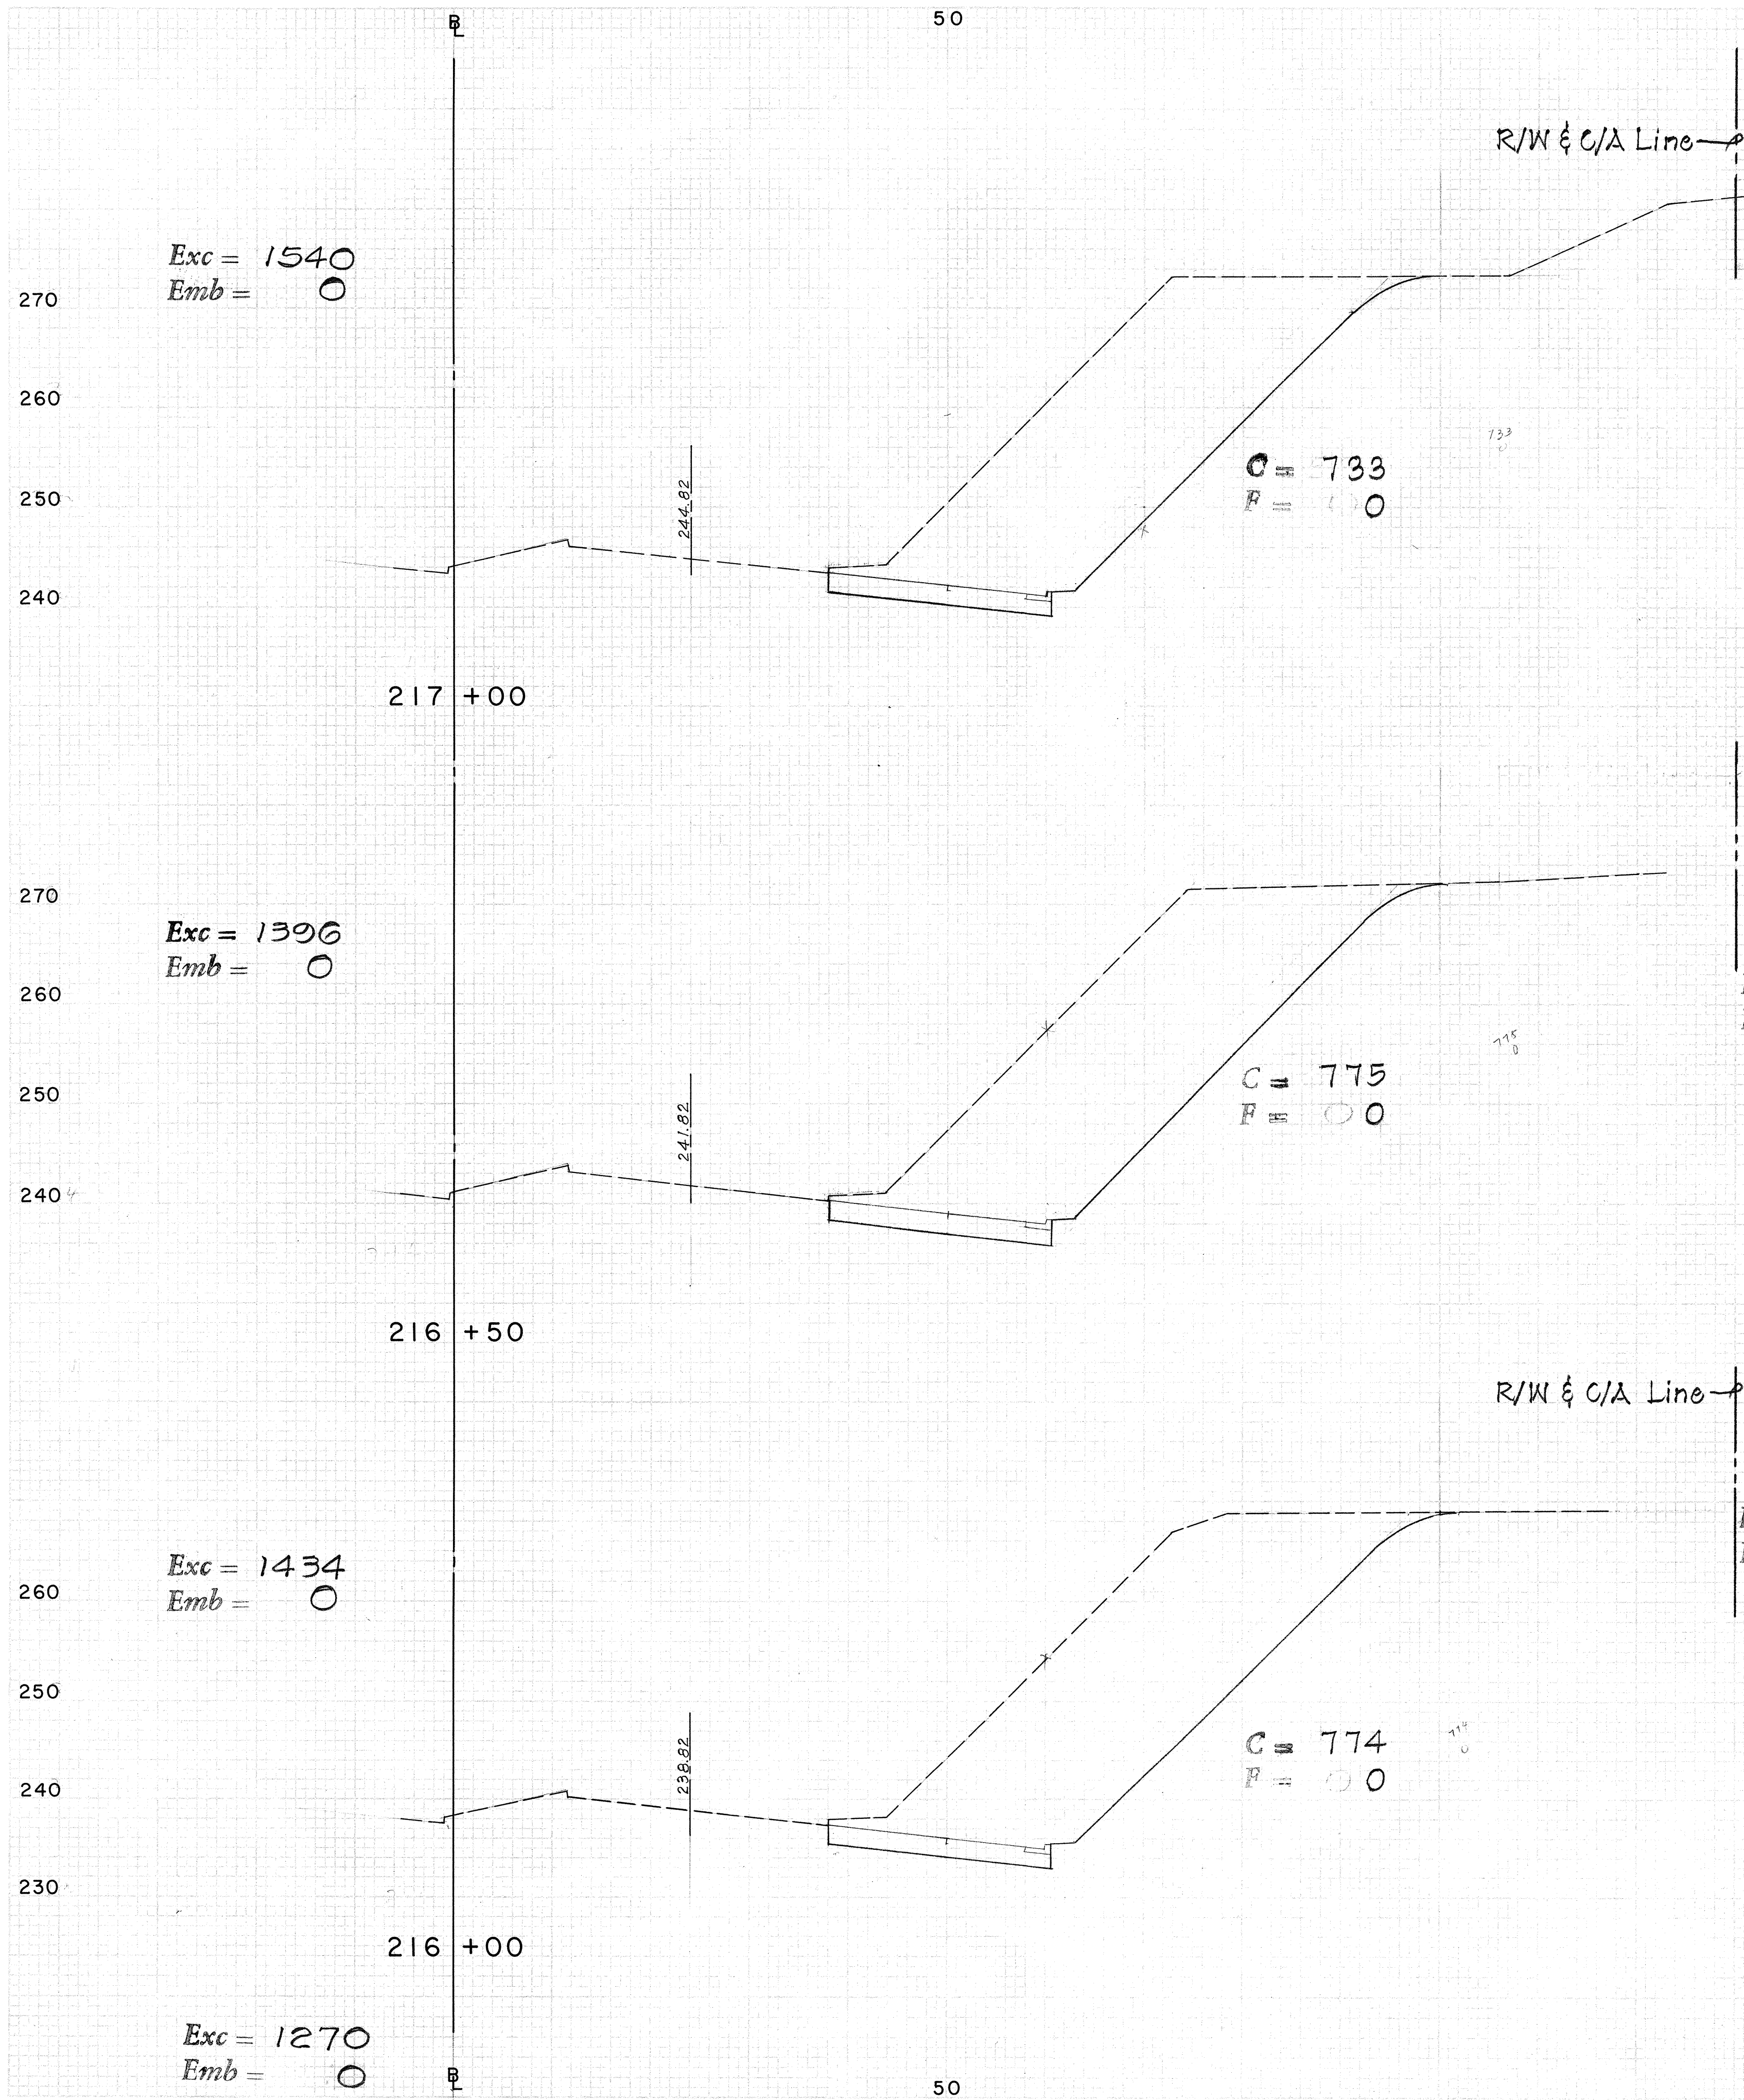



FED. ROAD DIST. NO.	STATE	FED. AID PROJ. NO.	FISCAL YEAR	SHEET NO.	TOTAL SHEETS
	HAWAII	U-072-1(2)	1967	32	35

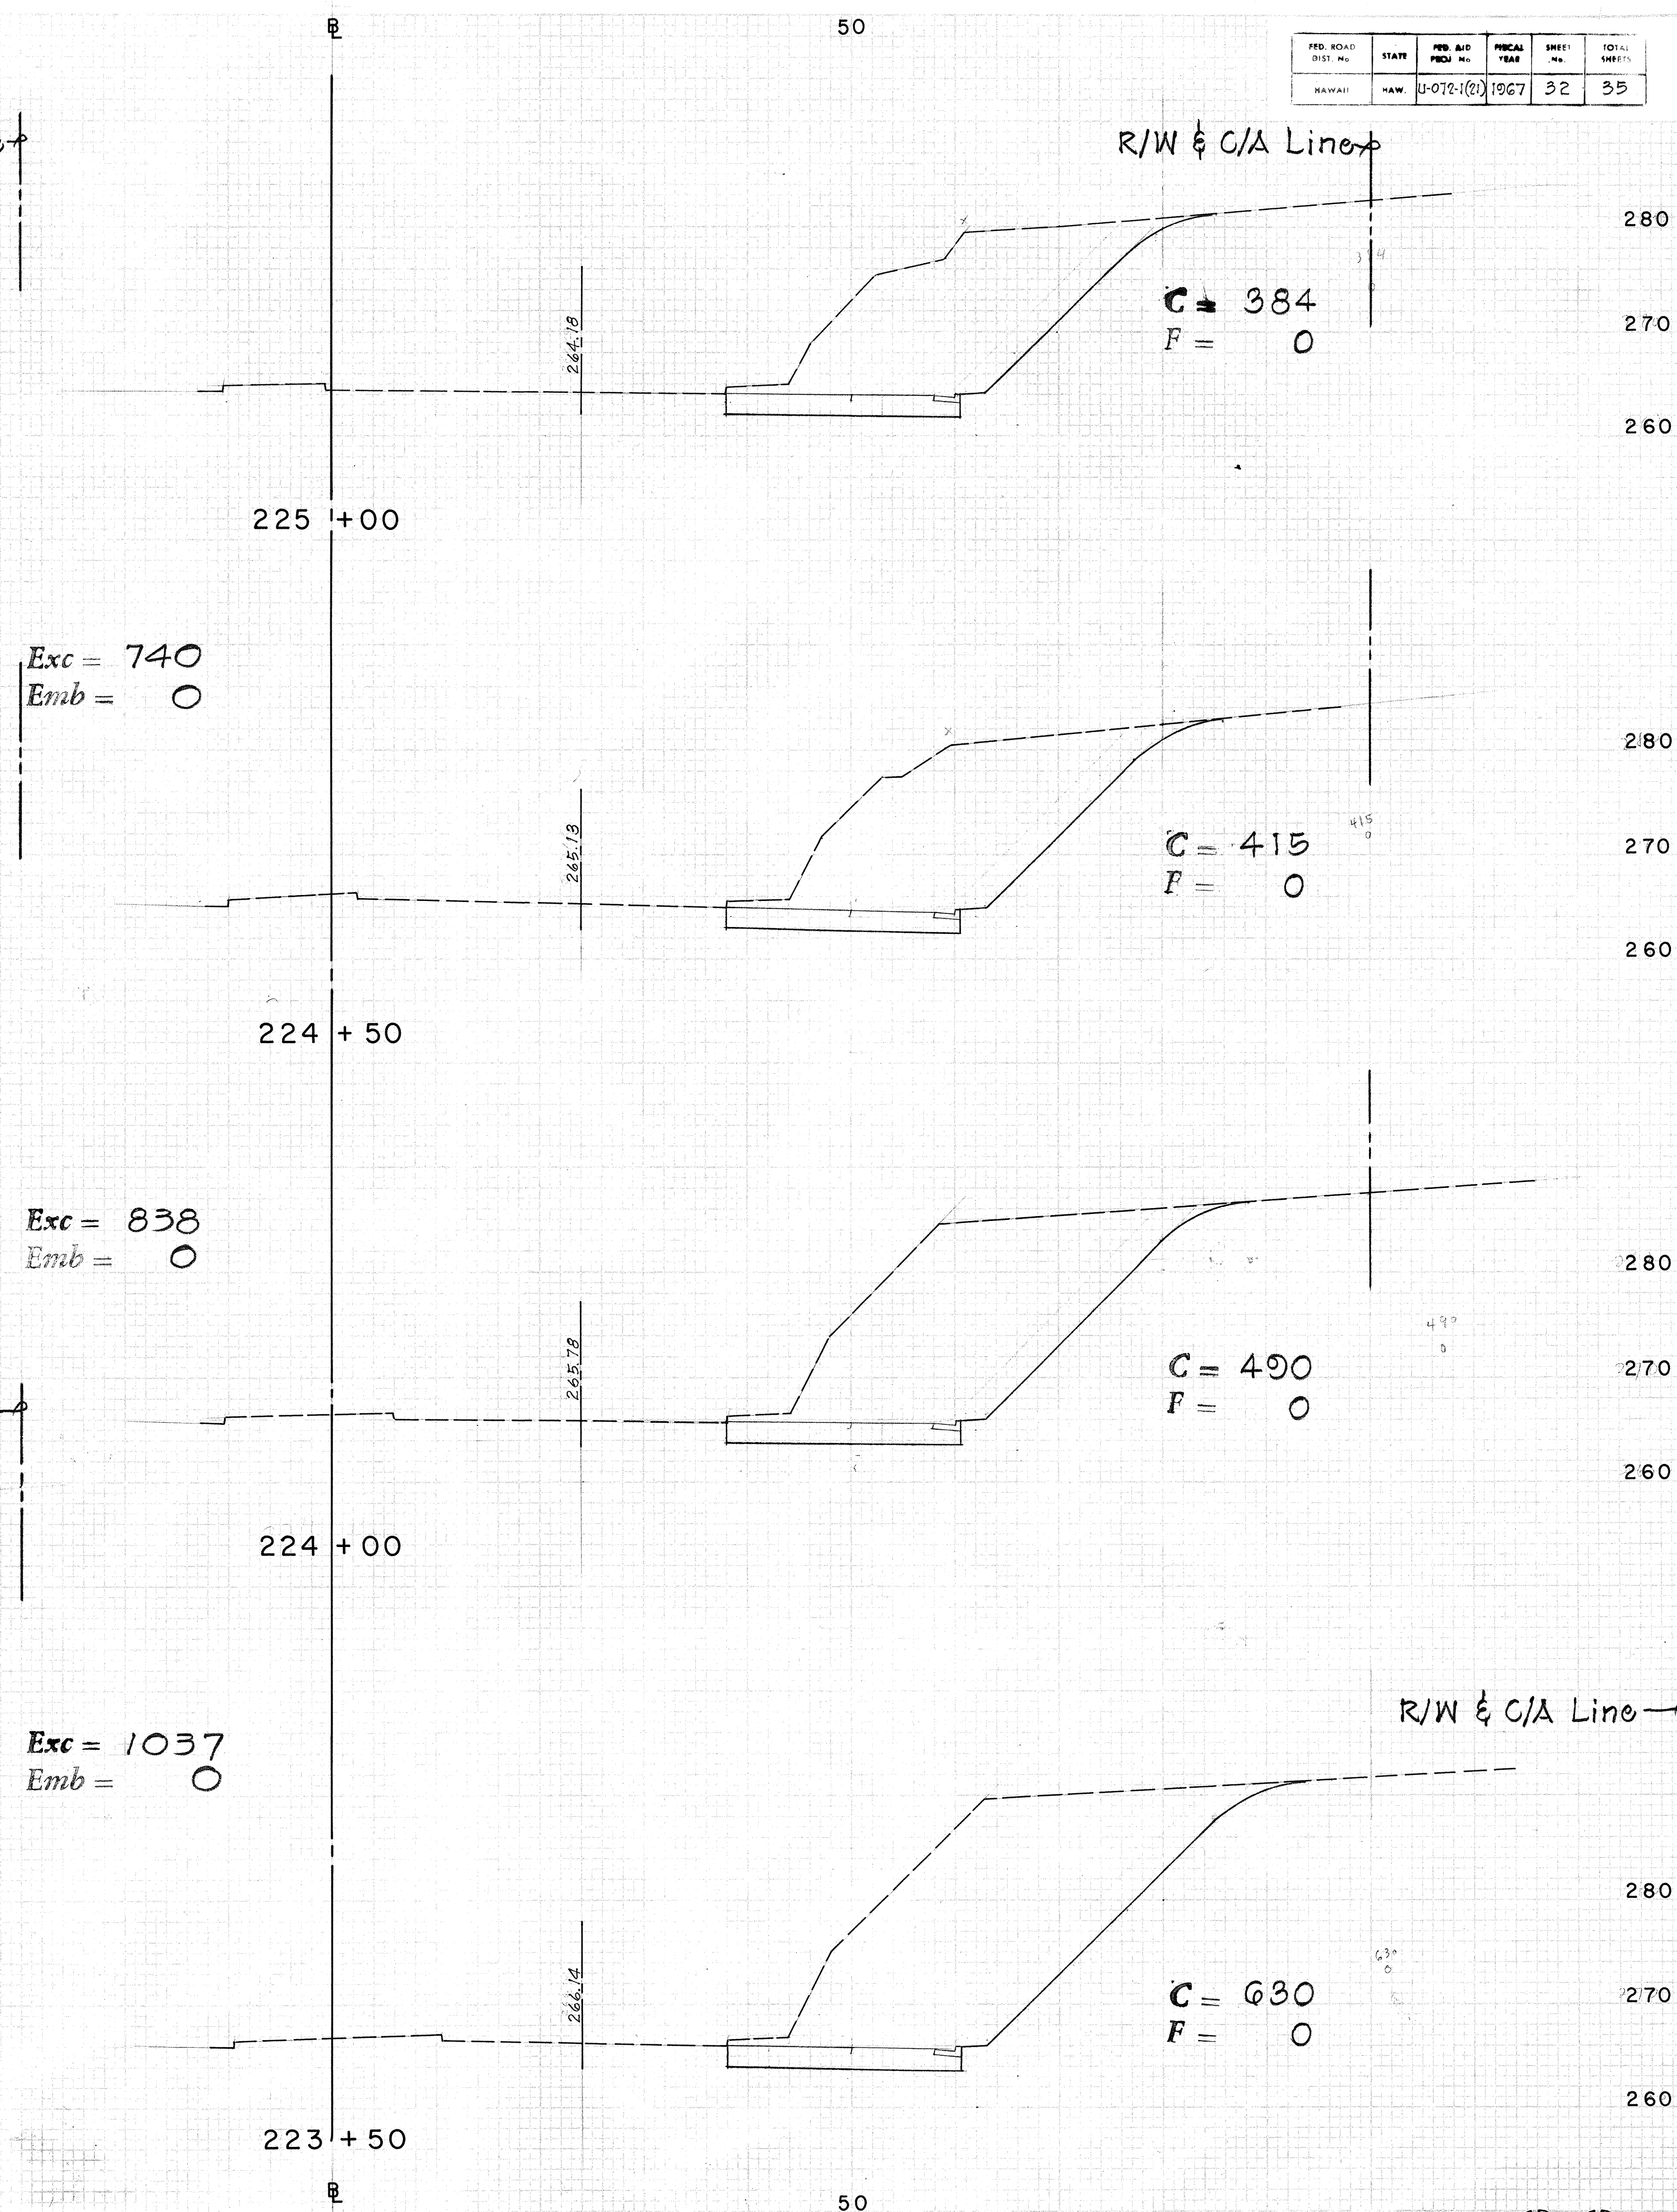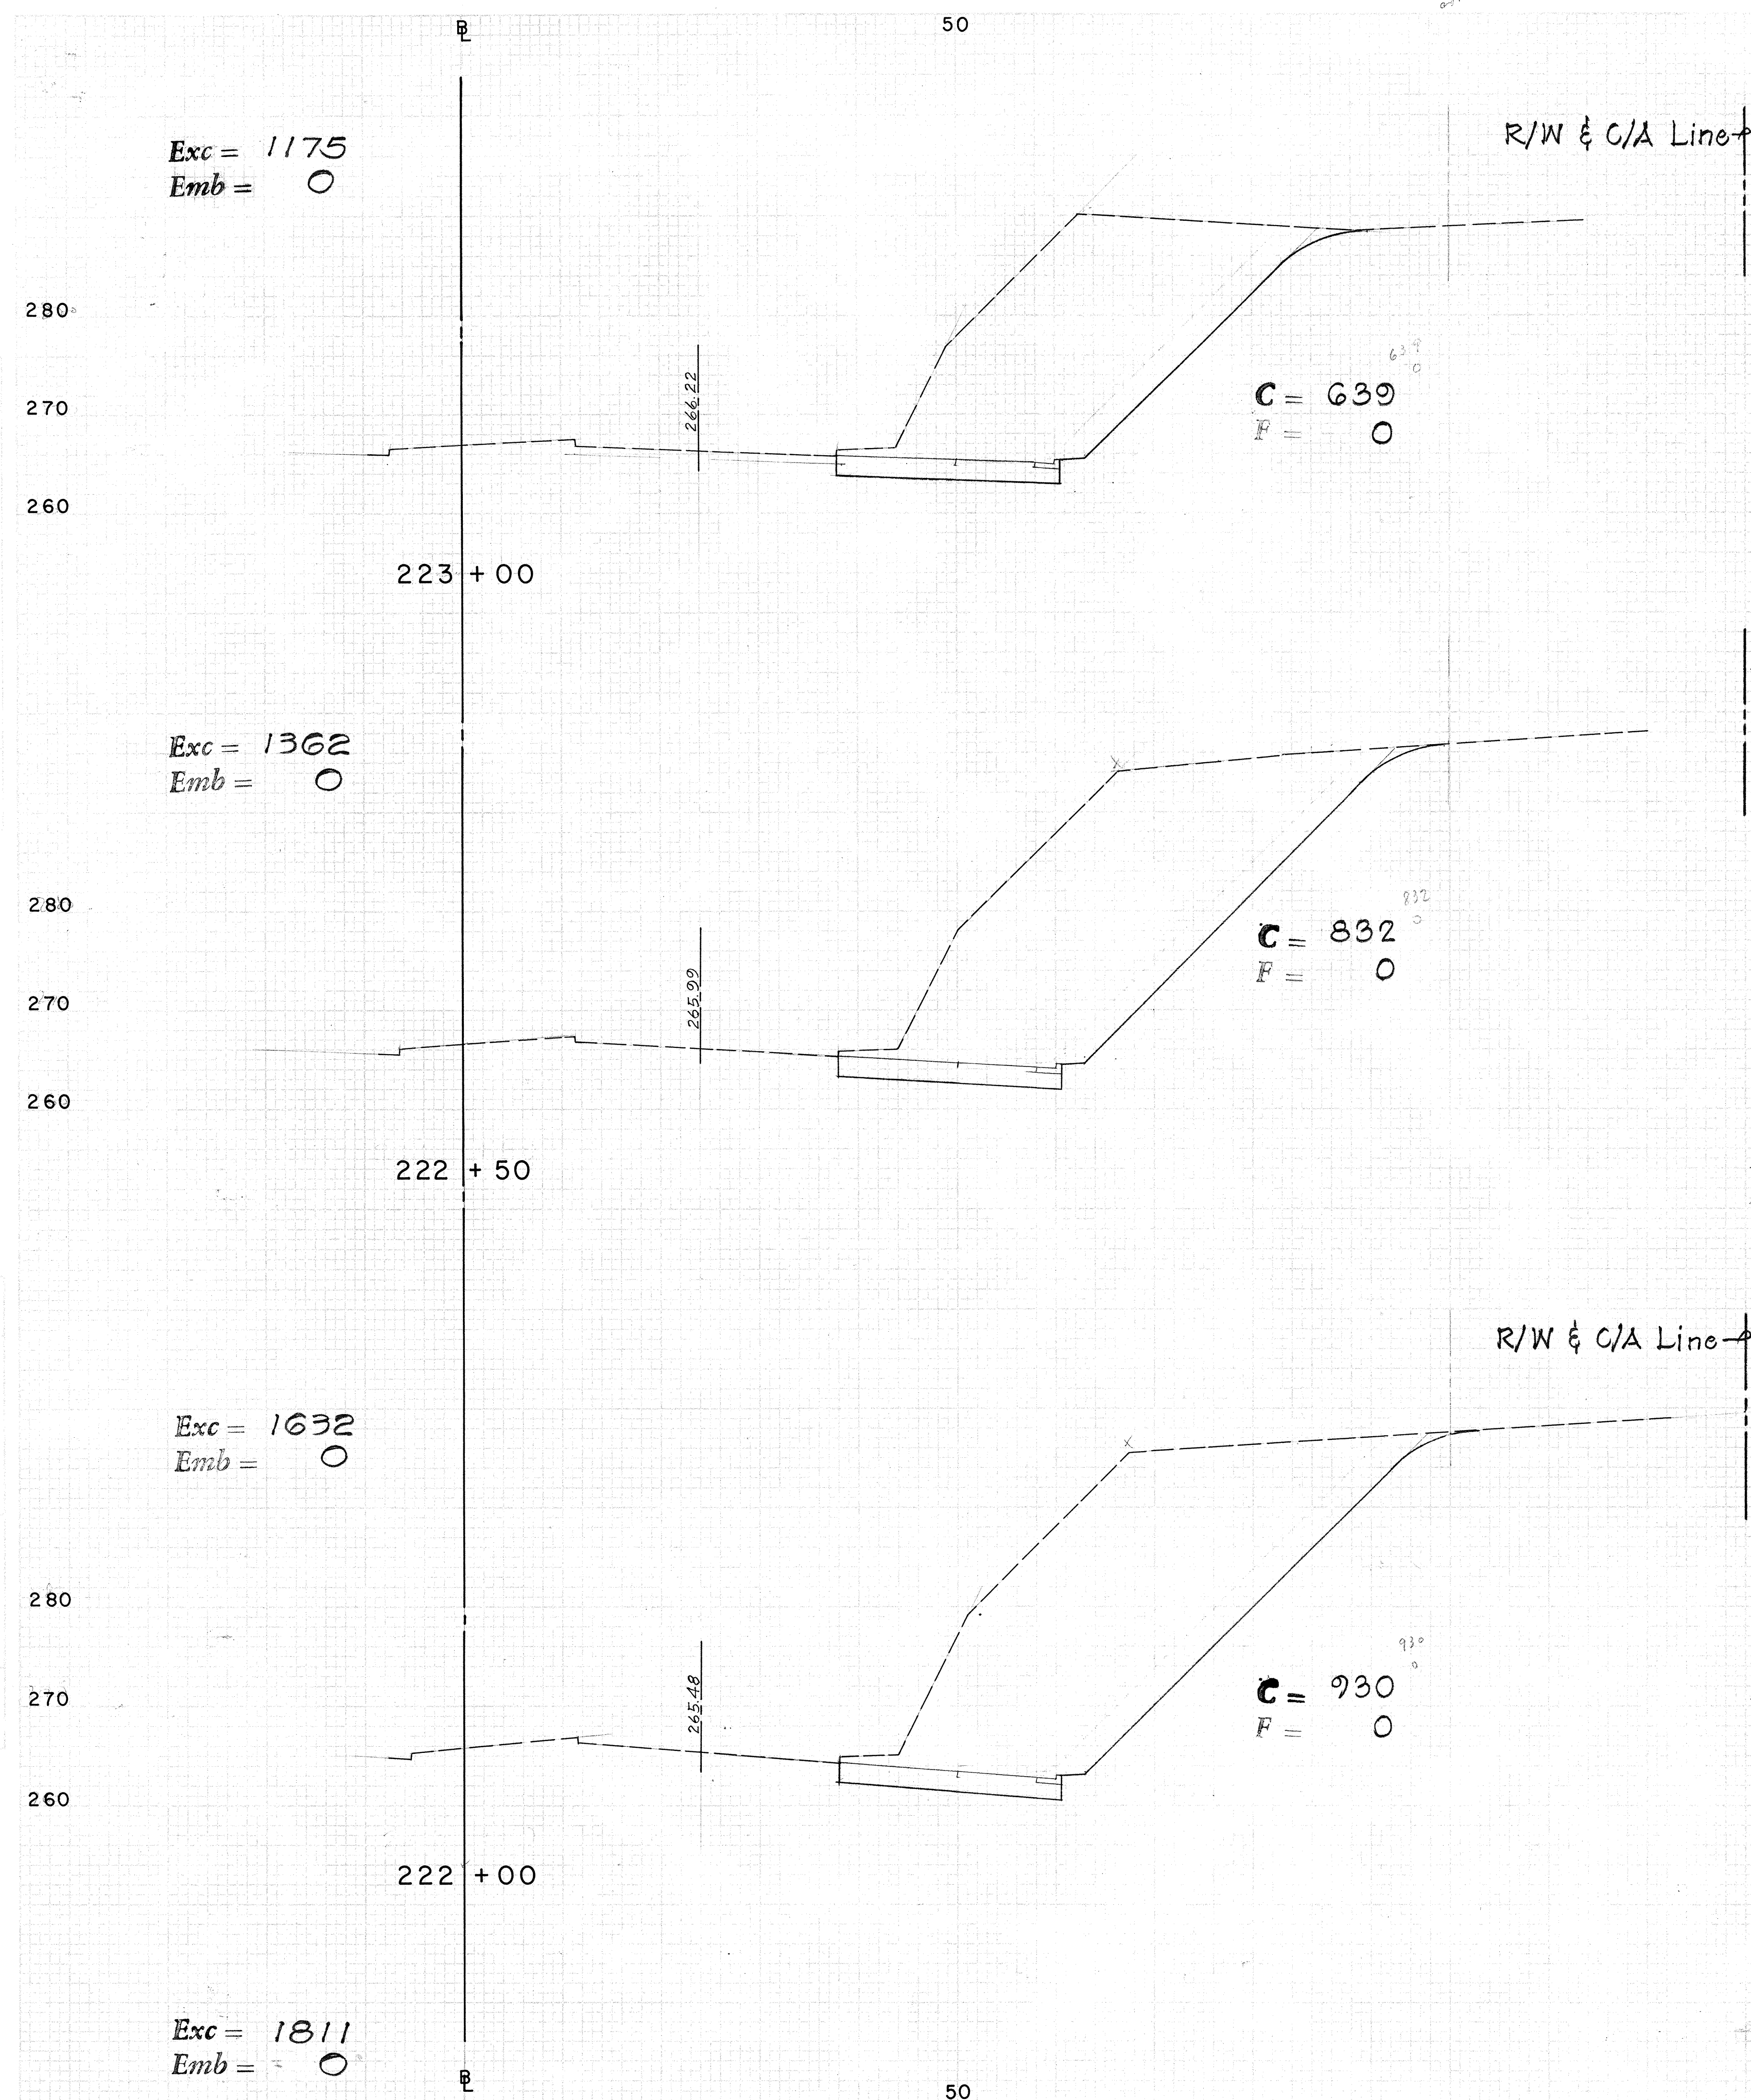

FED. ROAD DIST. No.	STATE	PRO. AND SUB. PROJ. No.	FISCAL YEAR	SHEET No.	TOTAL SHEETS
HAWAII	HAW.	U-072-1(2)	1967	33	35

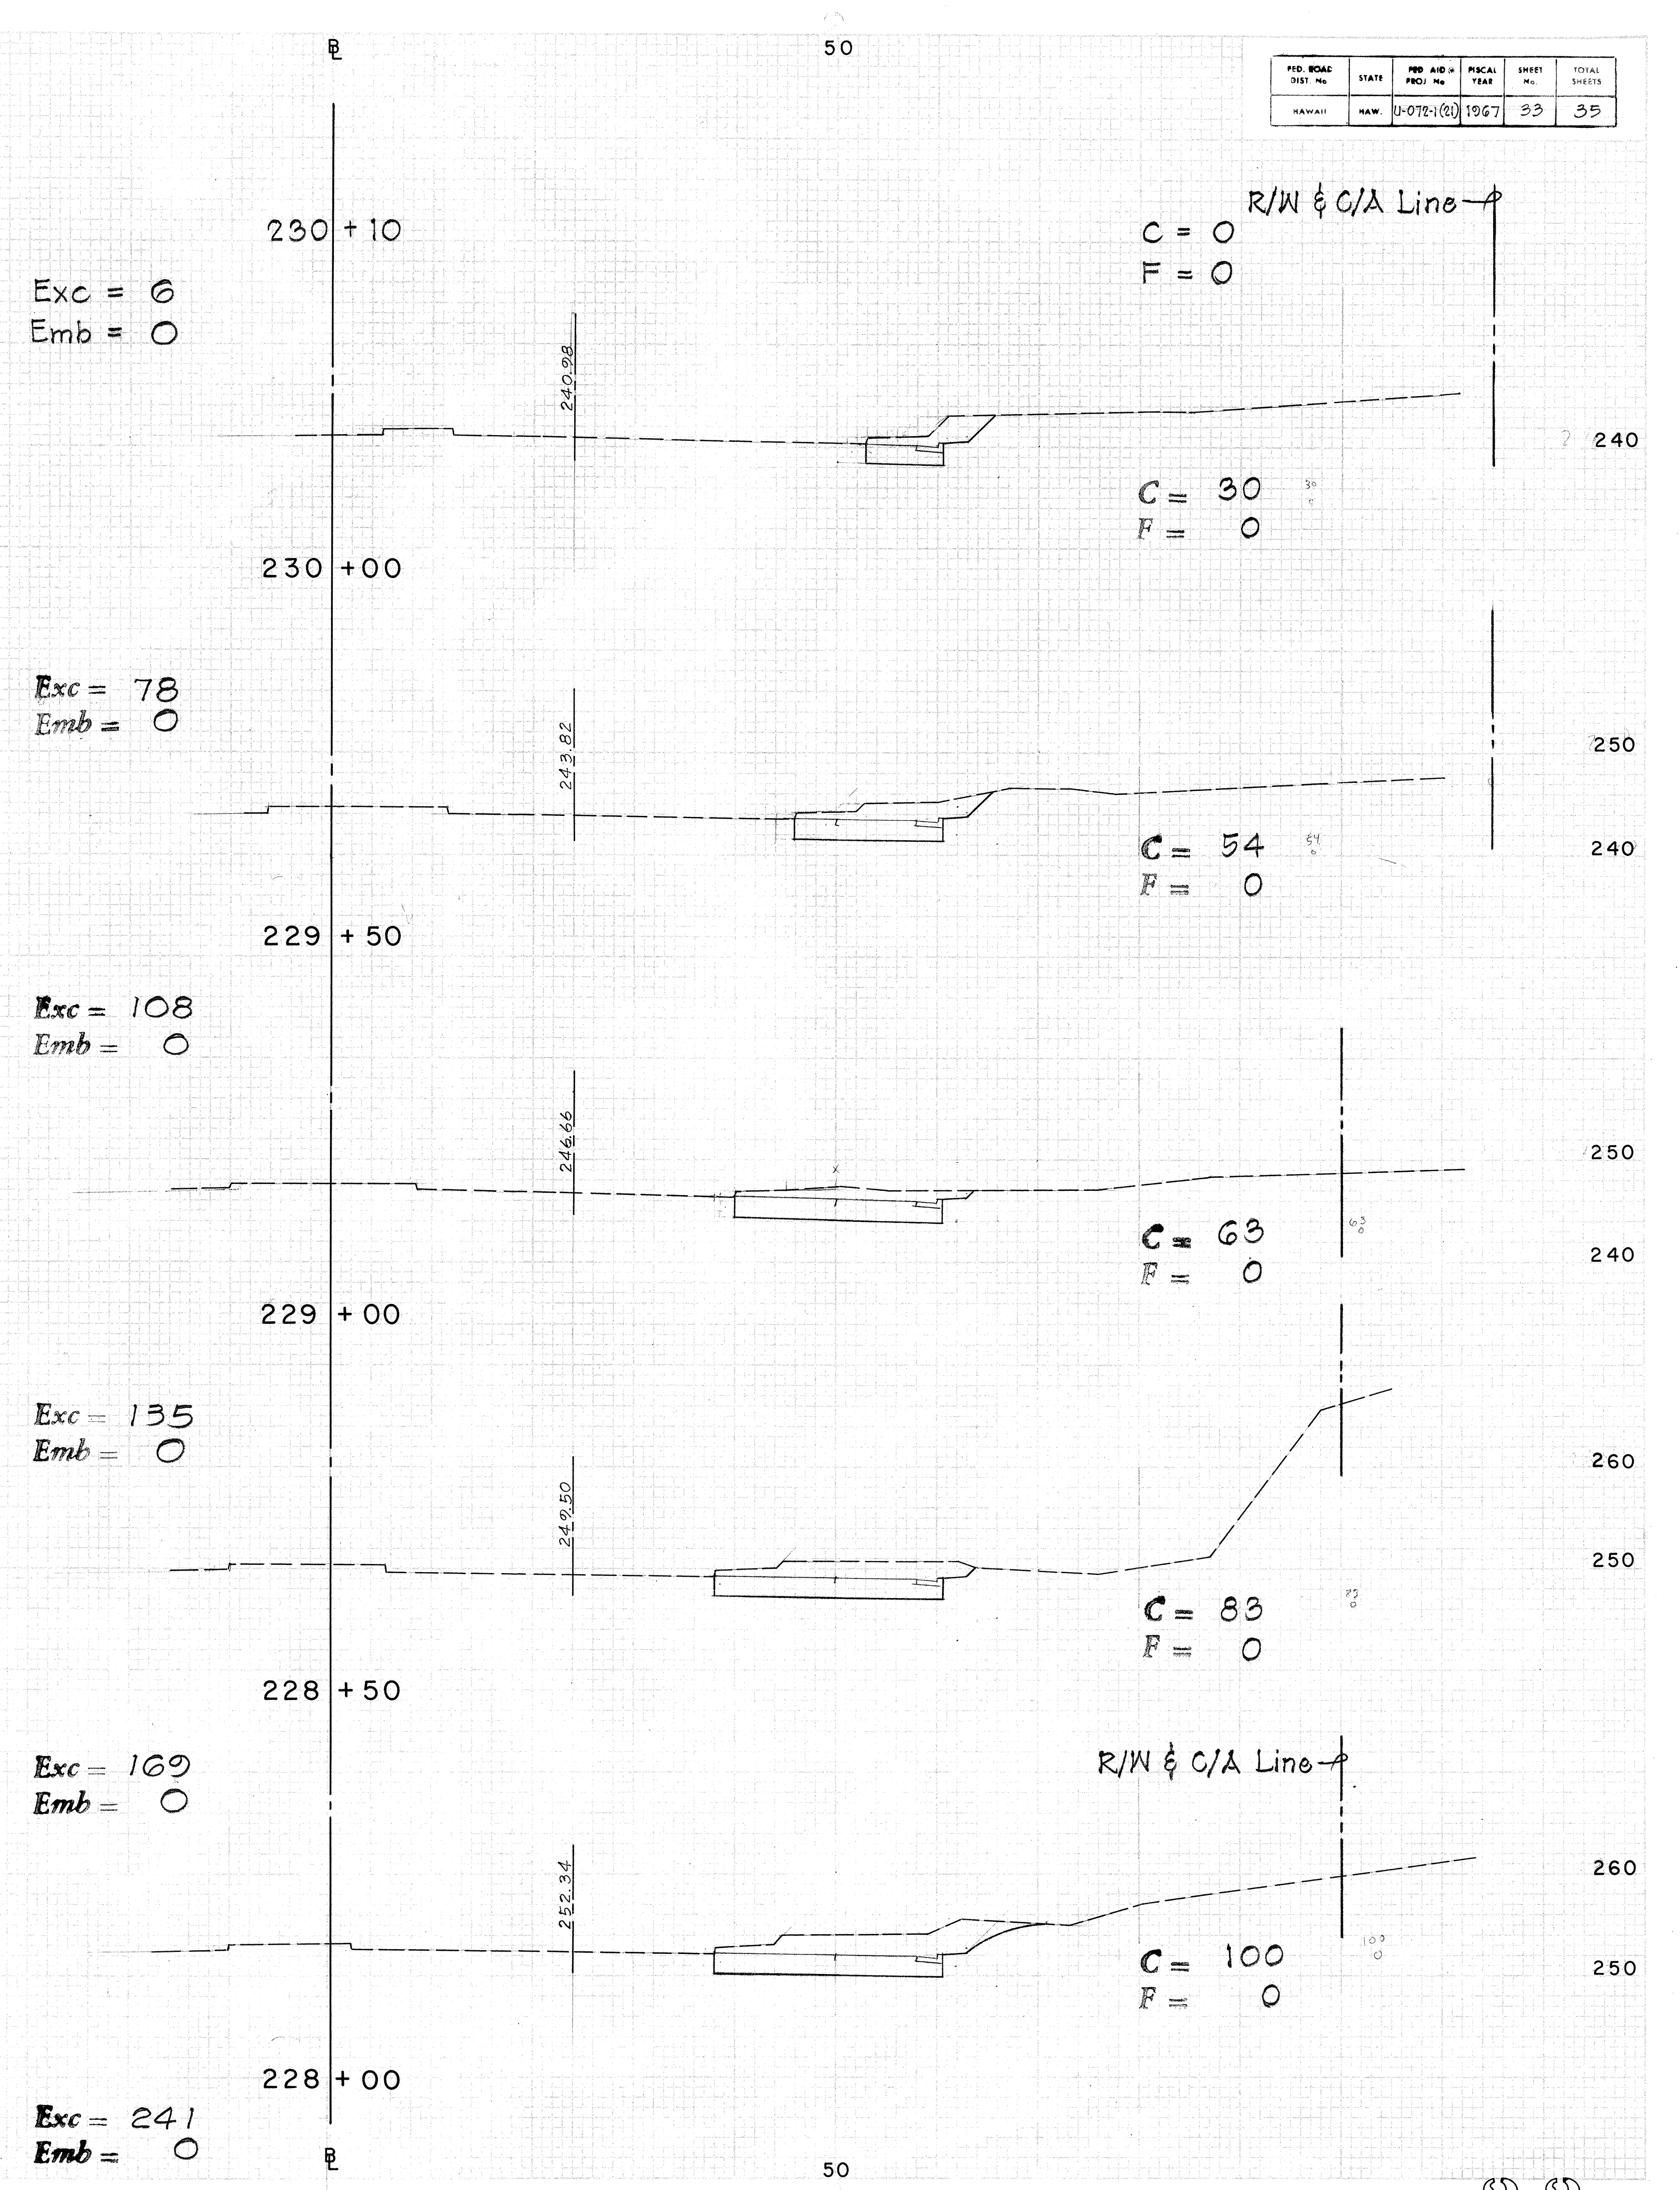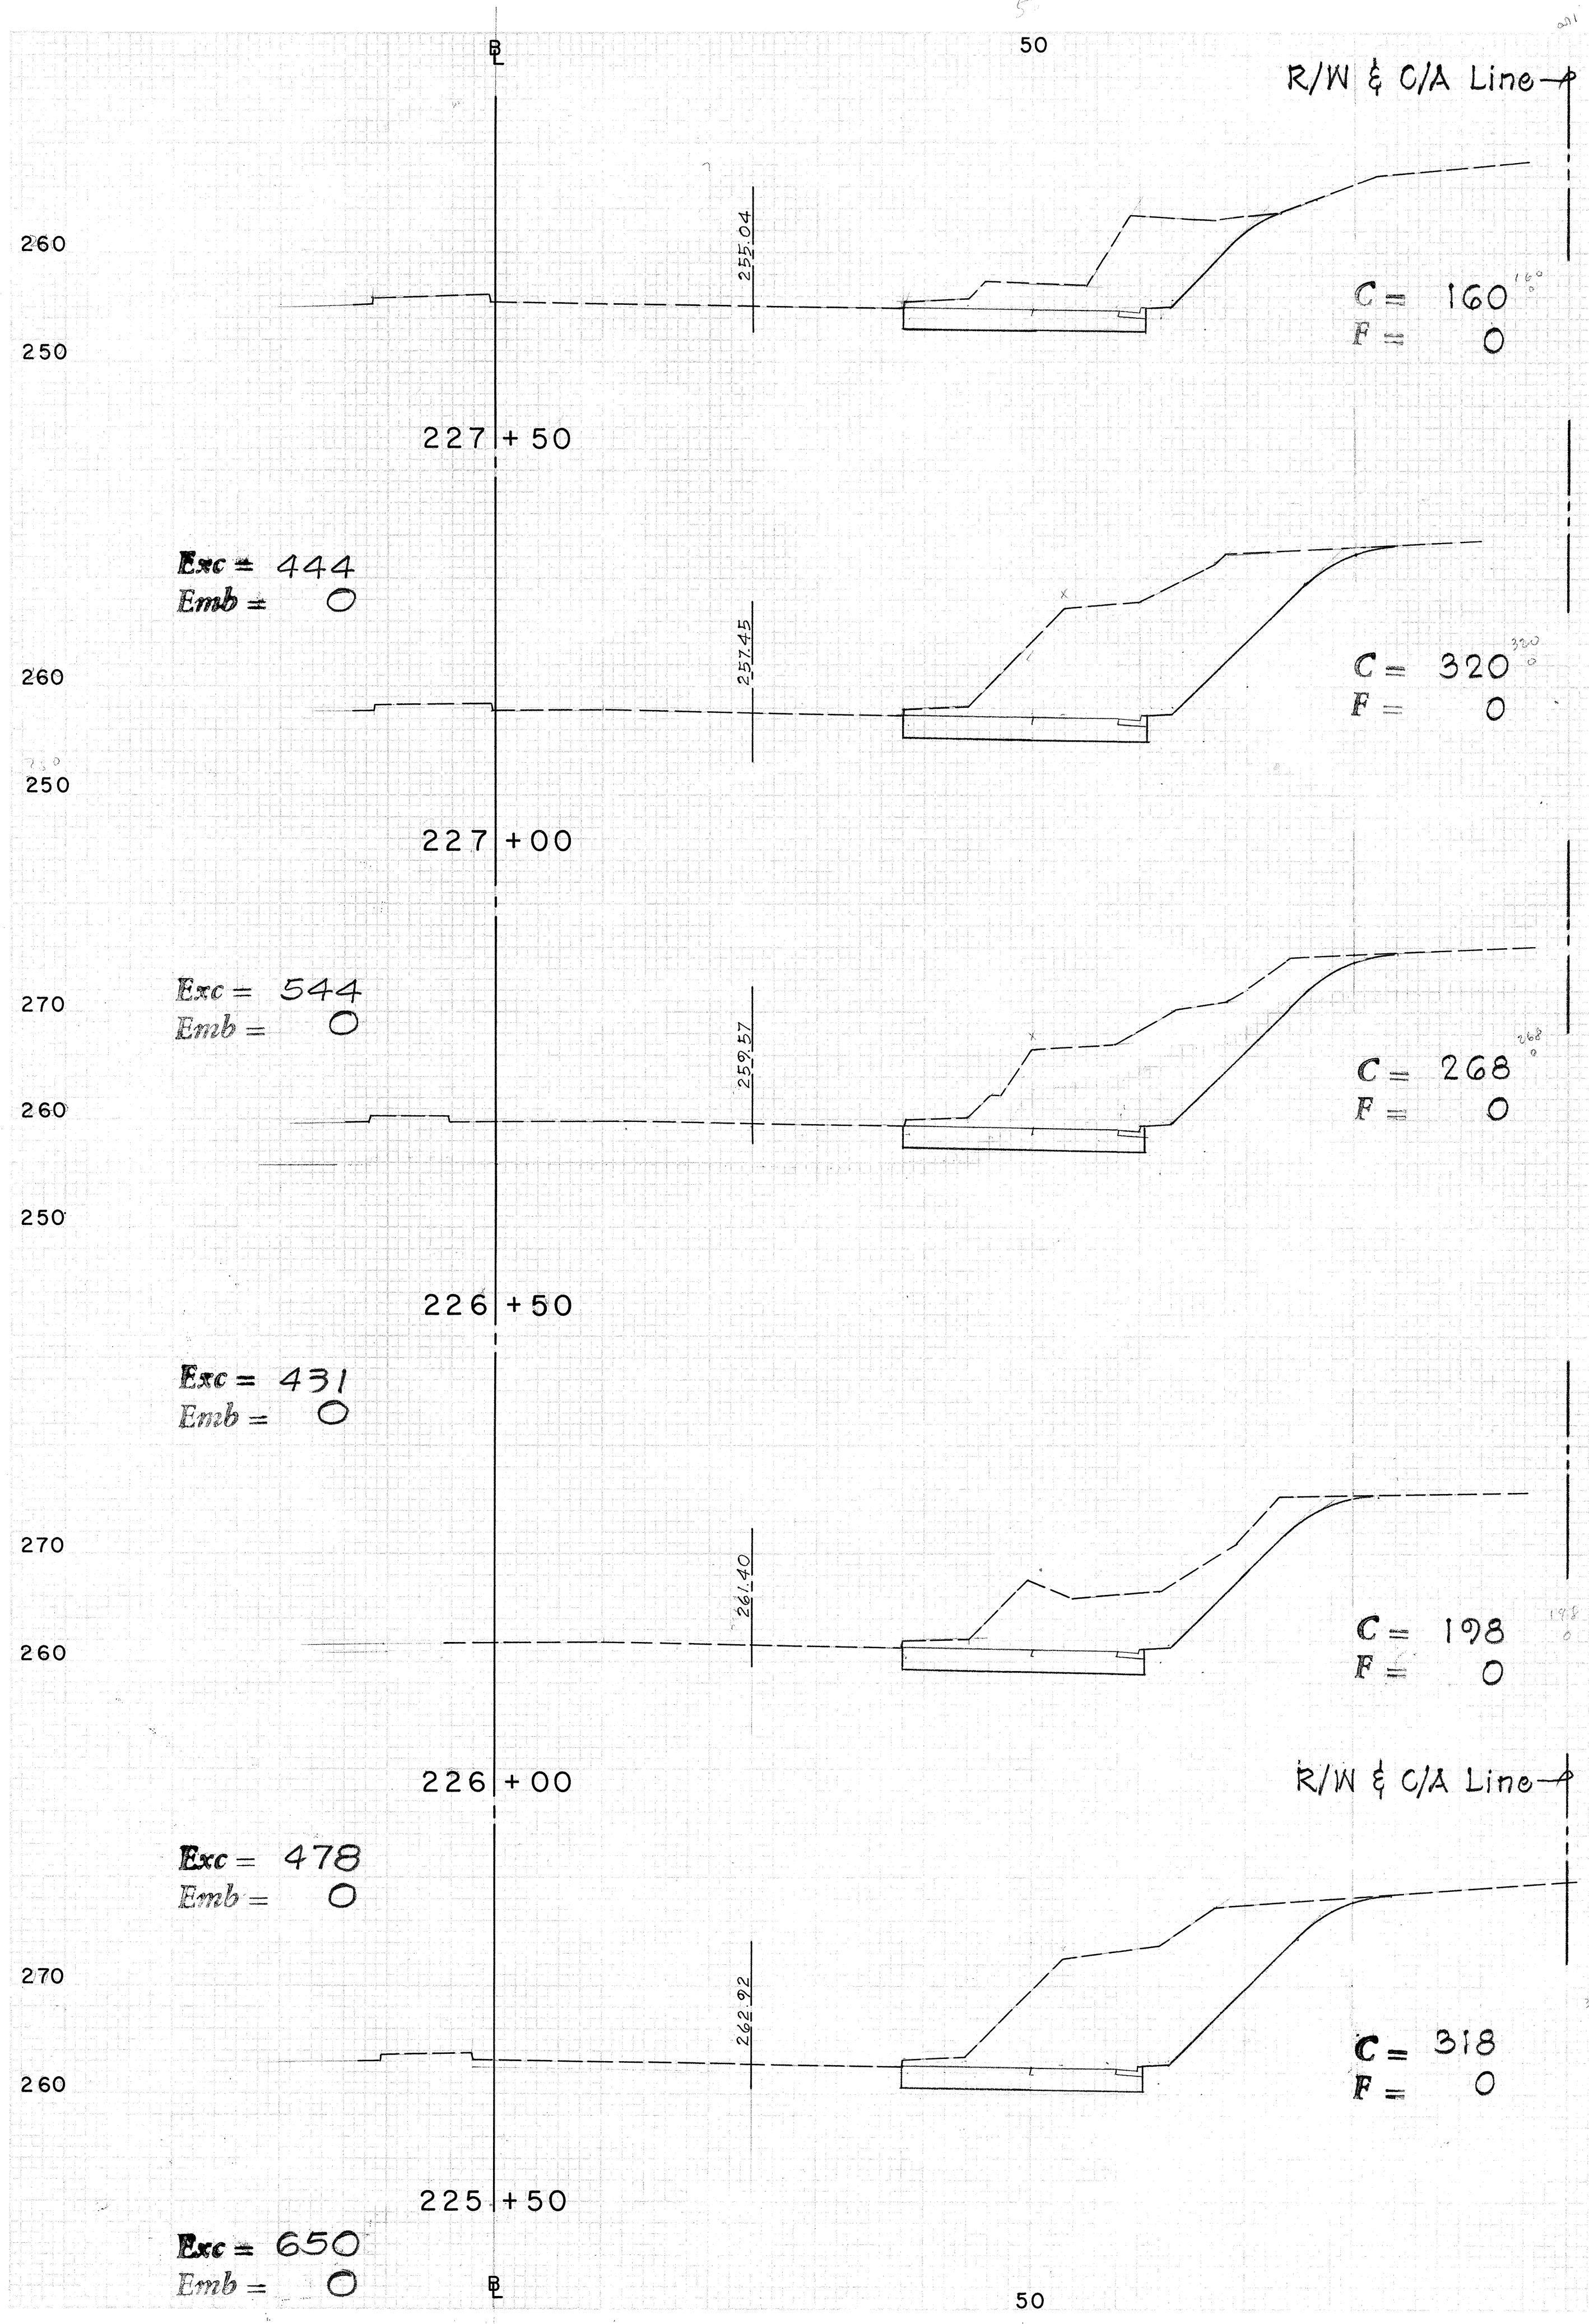

FED. ROAD DIST. NO.	STATE	FED. AID PROJ. NO.	FISCAL YEAR	SHEET NO.	TOTAL SHEETS
HAWAII	HAW.	U-072-1(2)	1967	34	35

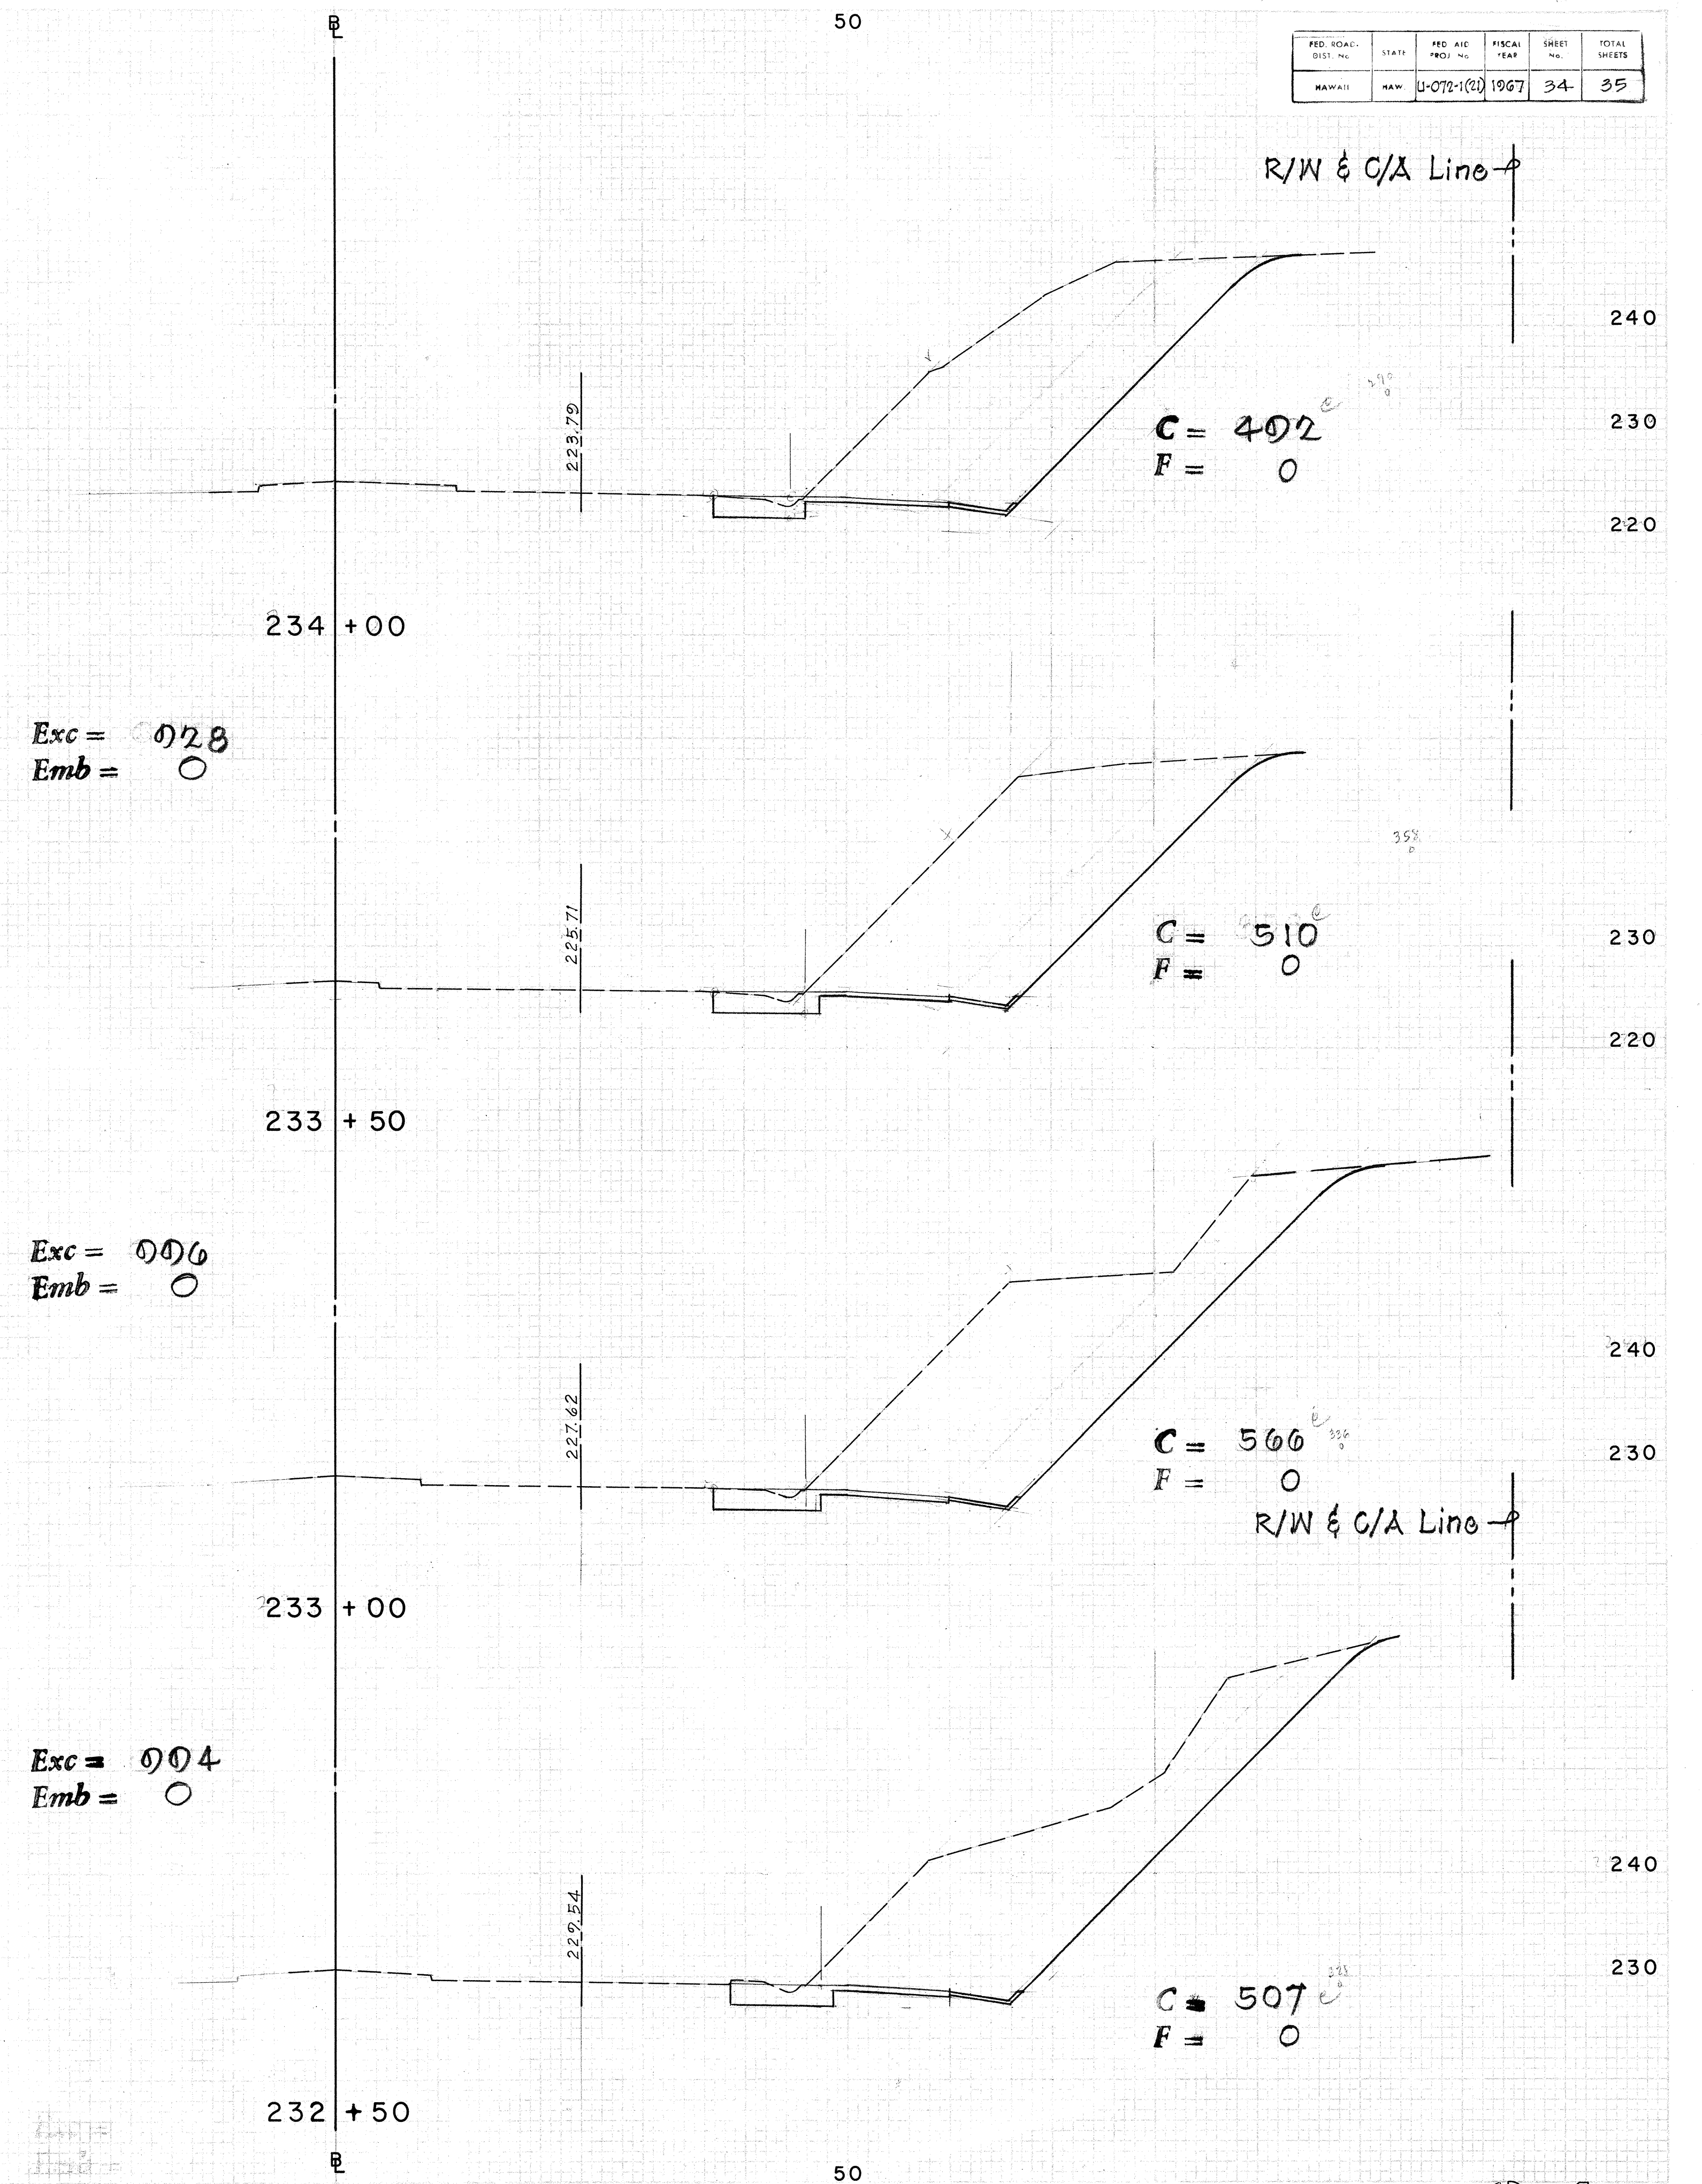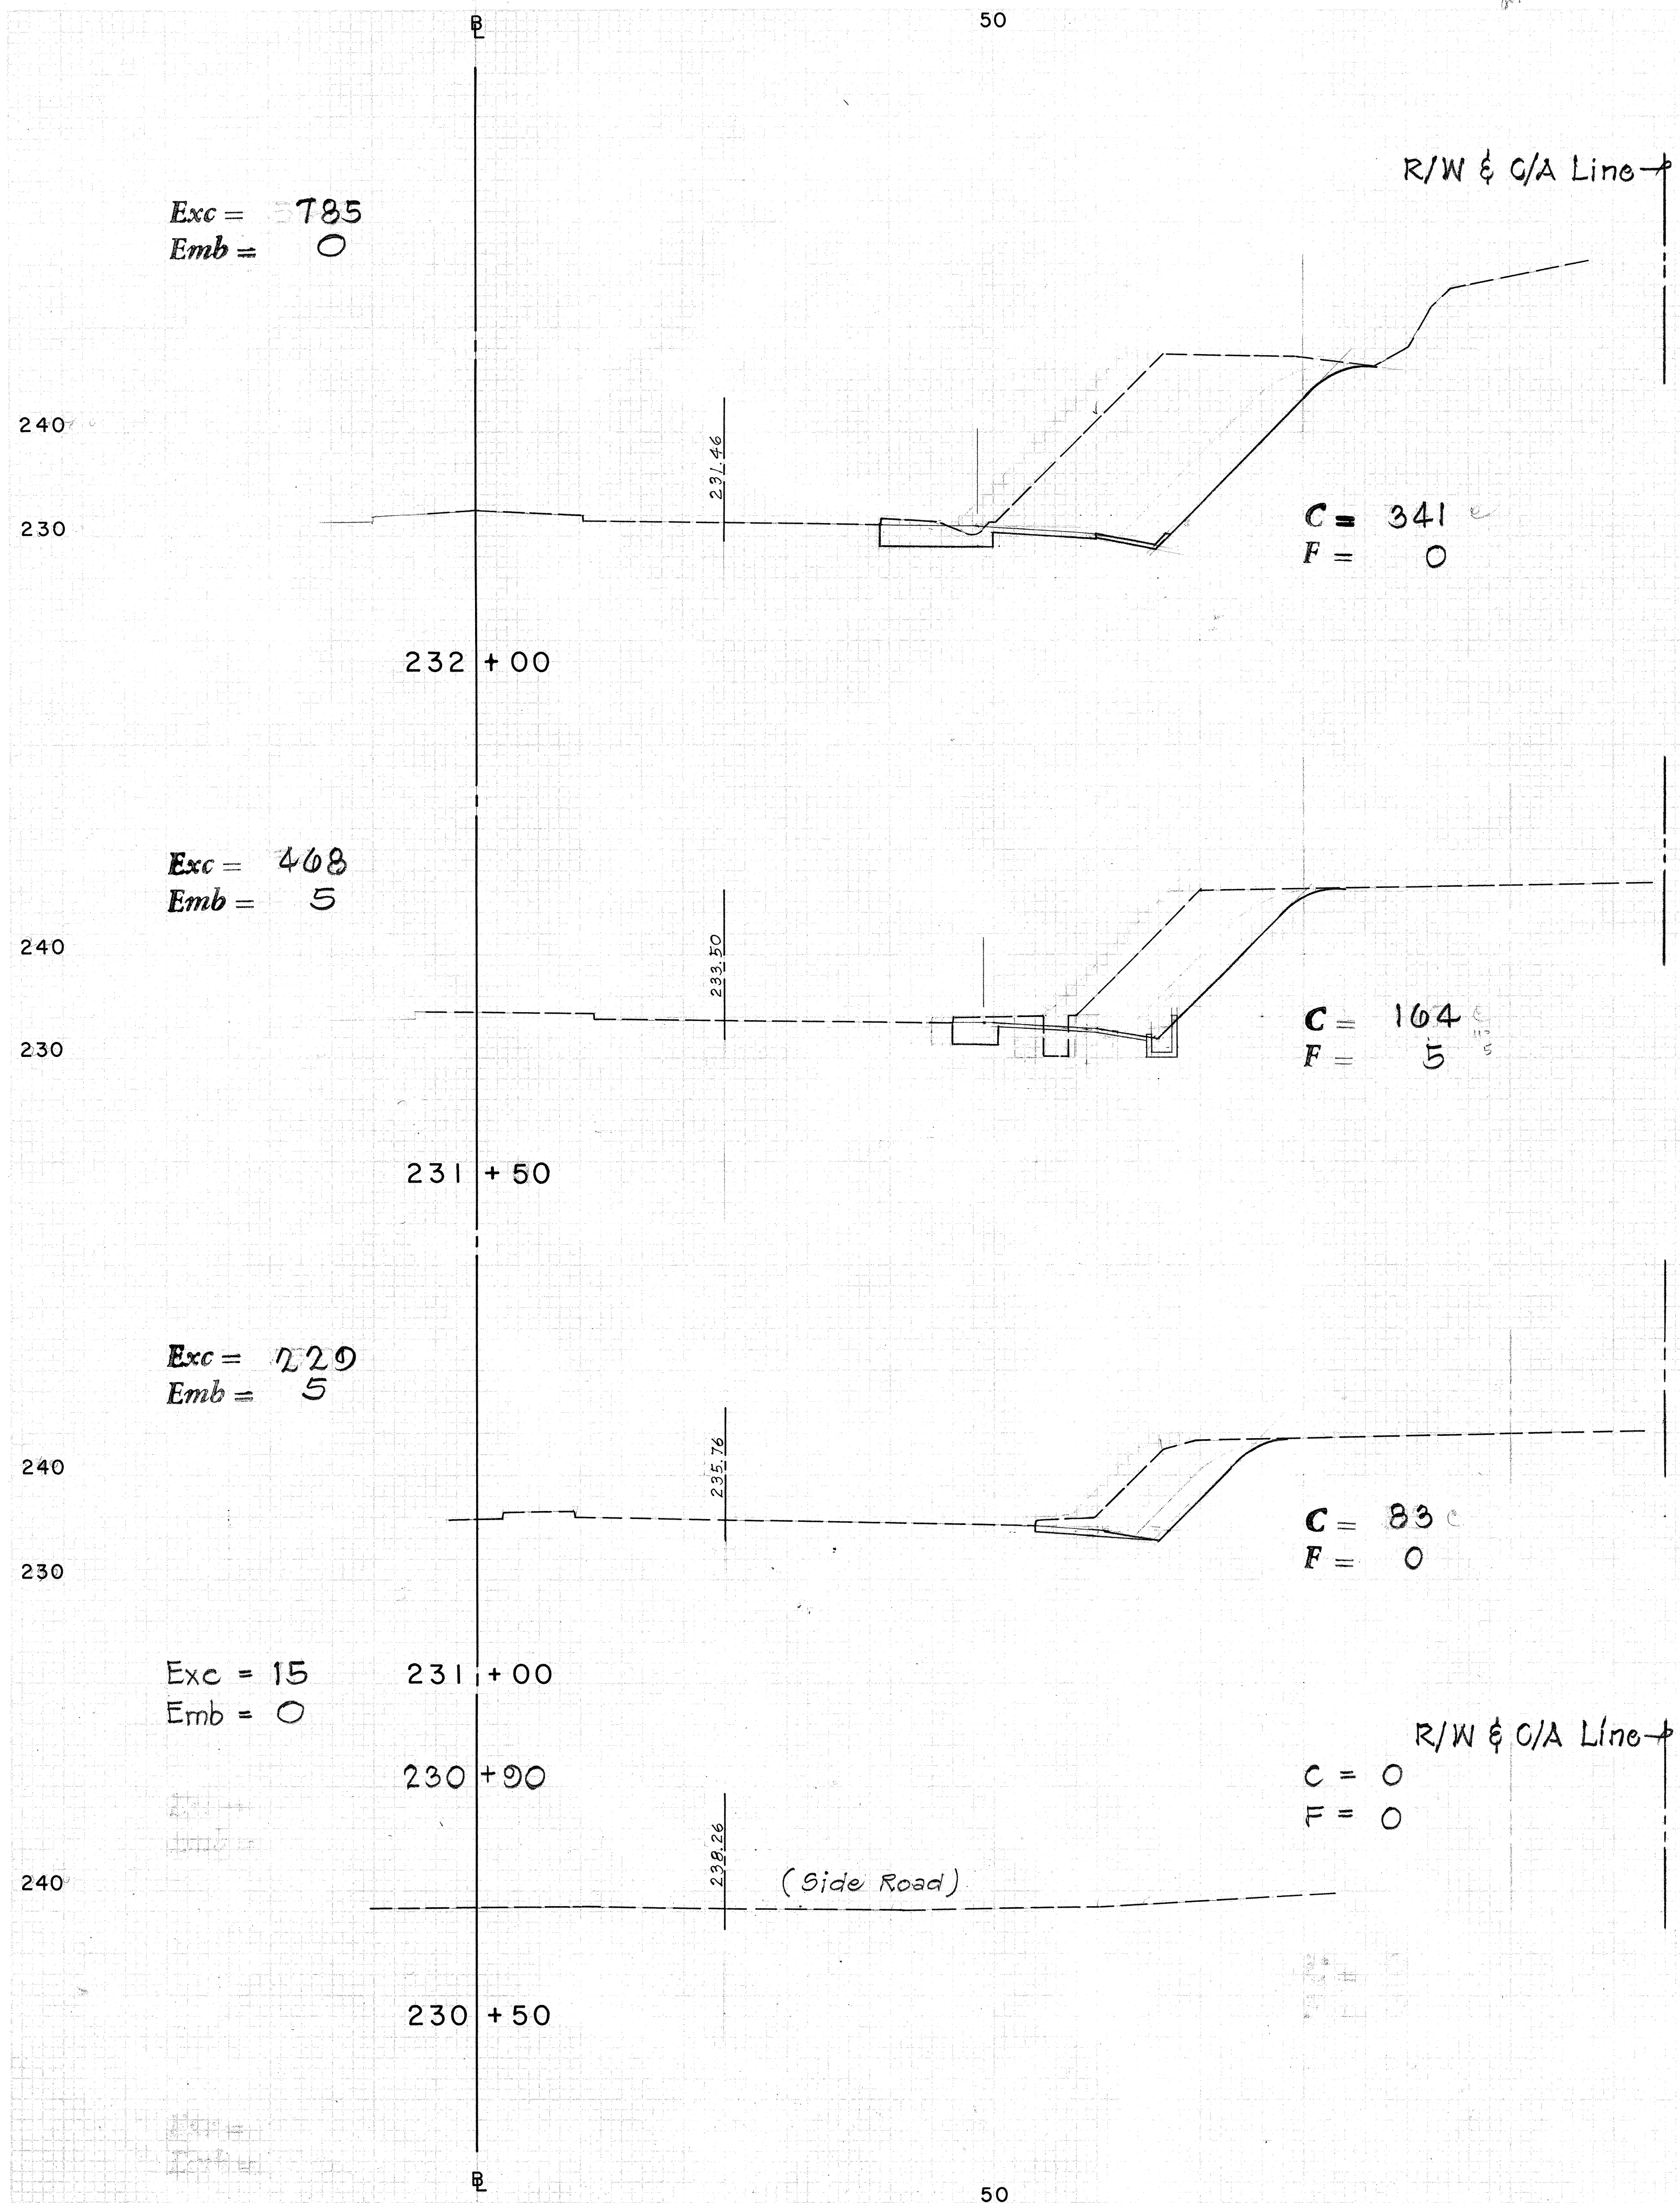

PROJ. ROAD DIST. NO.	STATE	PROJ. AID PROJ. NO.	FISCAL YEAR	SHEET NO.	TOTAL SHEETS
HAUAI	HAW.	U-072-1(2)	1967	35	35

