
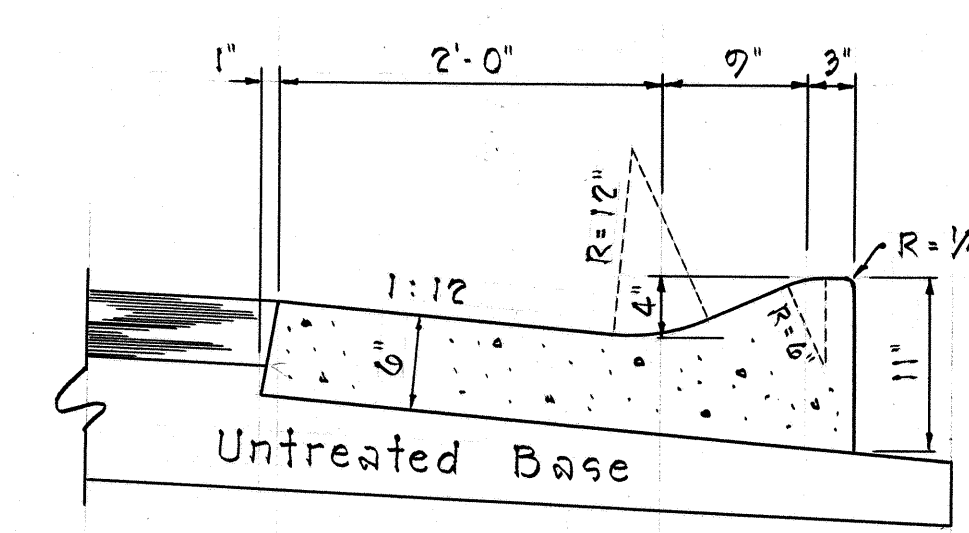
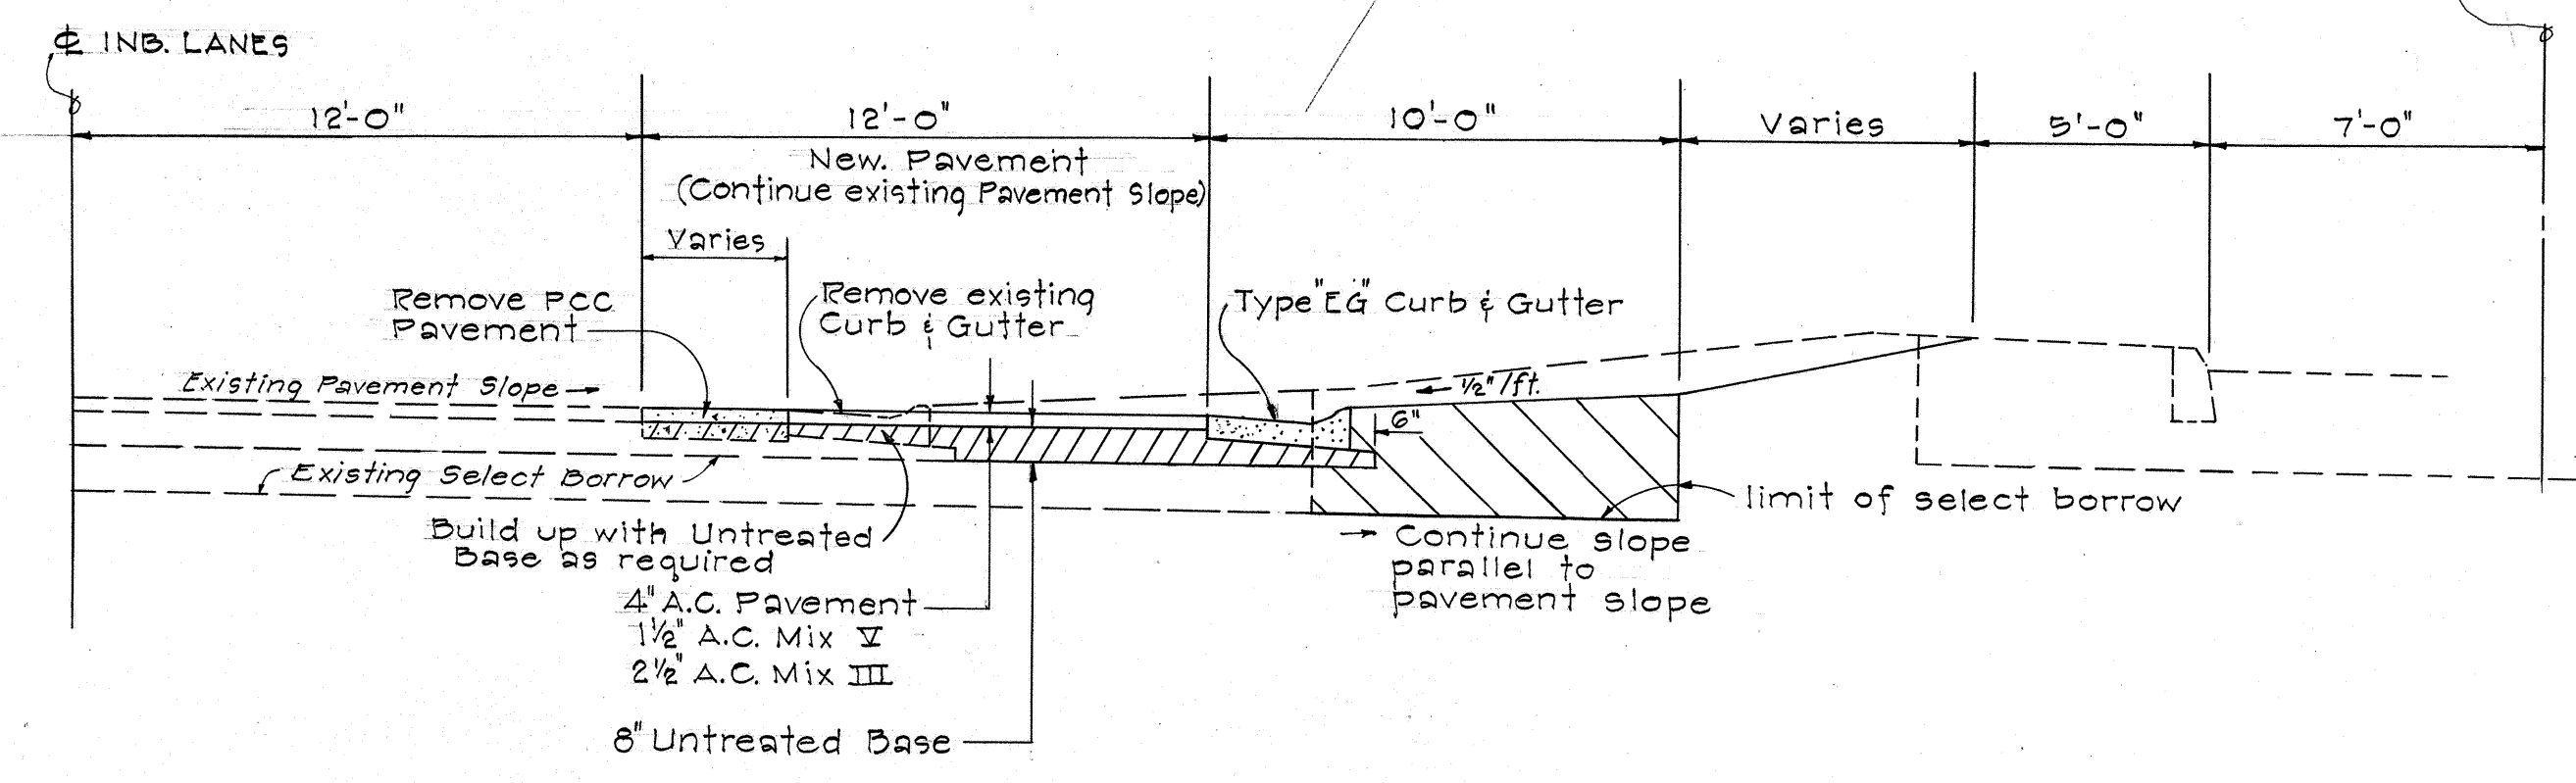


FED. ROAD DIST. NO.	STATE	PROJ. NO.	FISCAL YEAR	SHEET NO.	TOTAL SHEETS
HAWAII	HAW.	720A-02-68	1967	2	6

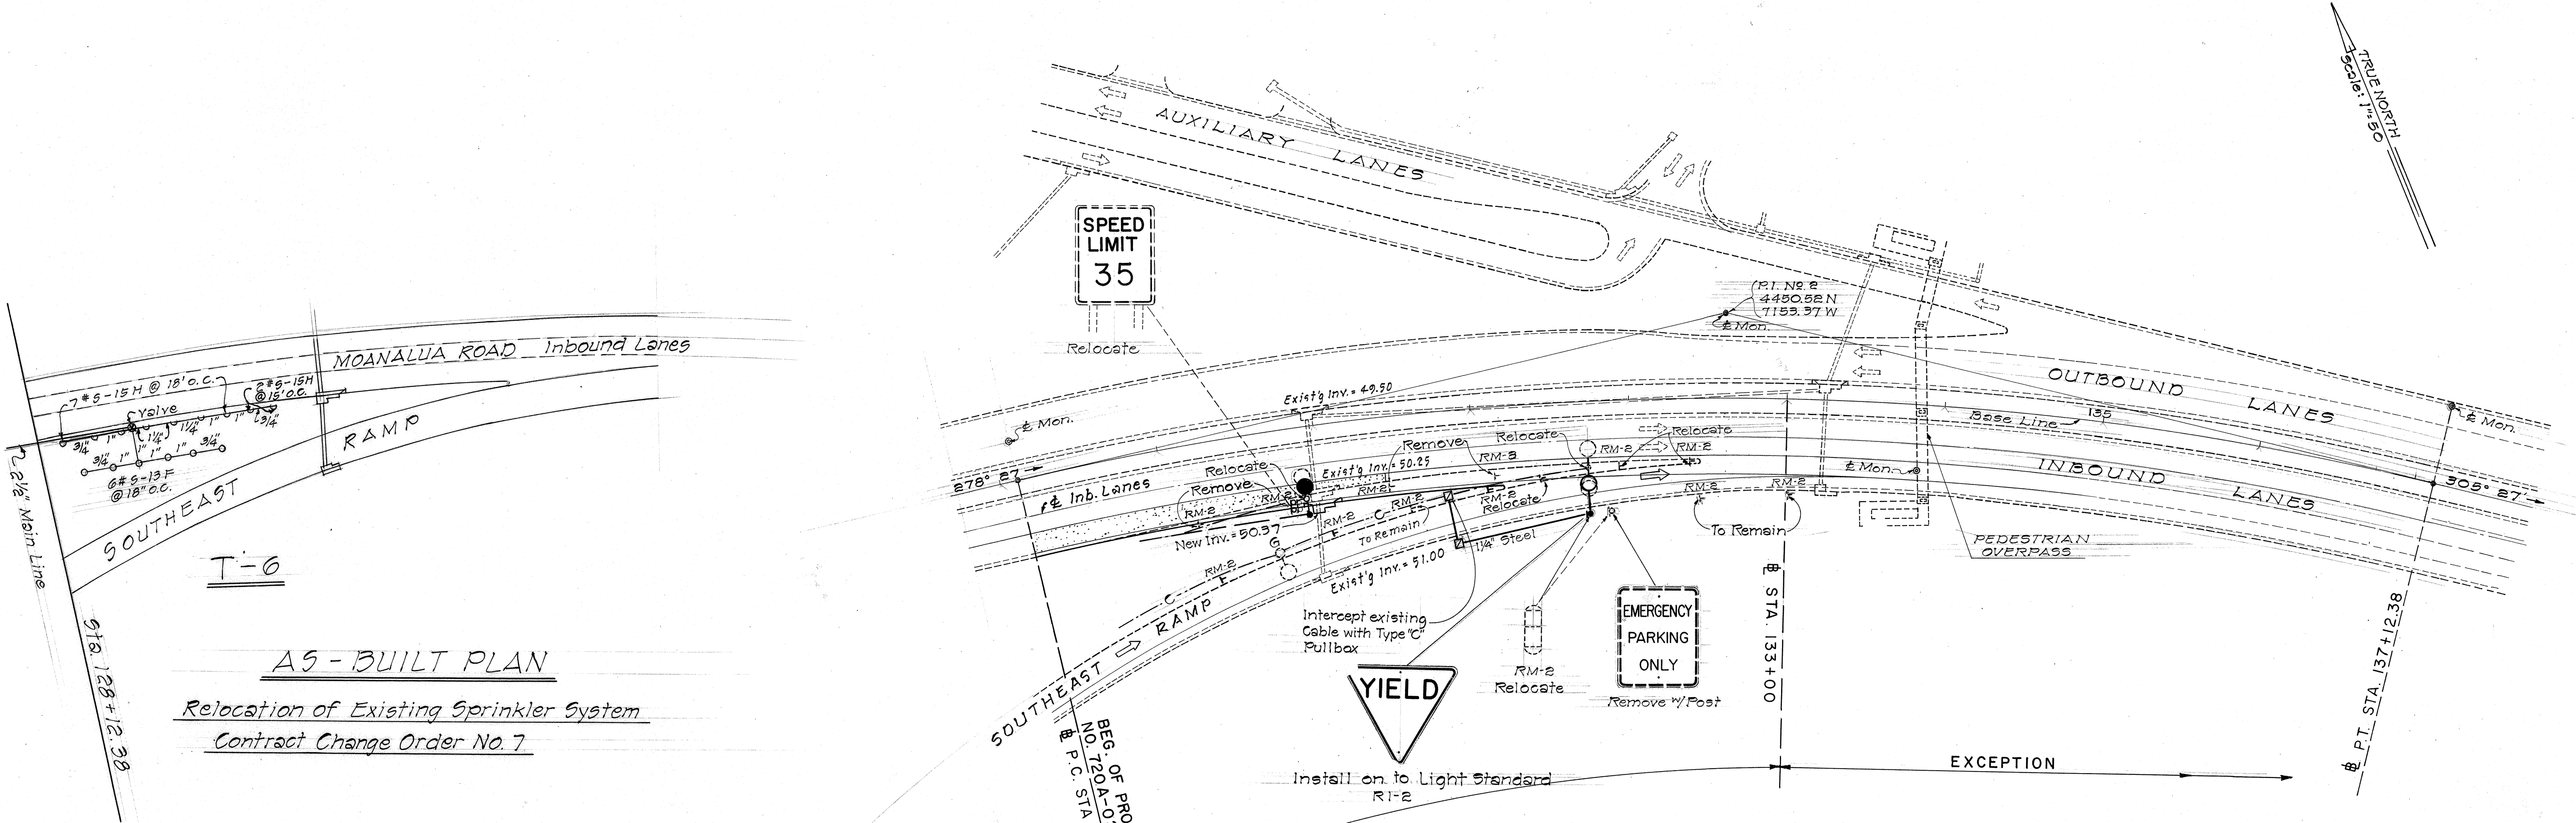

- LEGEND**
- New regulatory or warning sign.
 - Relocated regulatory or warning sign.
 - Existing regulatory or warning sign.
 - Existing direct burial cable.
 - Relocated existing direct burial cable.
 - New 1/4" Steel Conduit 3/8" Conductor cable.
 - New Type "C" Pullbox.
 - Existing light standard 1/2" single bracket and luminaire to be relocated.
 - Existing light standard 1/2" double bracket and luminaire to be relocated. Double bracket and one luminaire shall be salvaged as directed by the Engineer.
 - Relocated light standard 1/2" single bracket and luminaire.
 - Relocated light standard and luminaire with new 15' single bracket.
 - Existing reflector marker to be relocated, removed or to remain as noted.
 - Relocated reflector marker.

STATE OF HAWAII
DEPARTMENT OF TRANSPORTATION
HIGHWAYS DIVISION

DETAIL PLAN OF ROADWAY


MOANALUA ROAD IMPROVEMENT
PROJ. NO. 720A-02-68

Scale: As Noted September 1967

SHEET No. 1 OF 2 SHEETS

DATE	BY
DESIGNED BY	CHECKED BY
NOTED BY	NO.

FED. ROAD DIST. NO.	STATE	PROJ. NO.	FISCAL YEAR	SHEET NO.	TOTAL SHEETS
HAWAII	HAW.	720A-02-68	1967	3	6

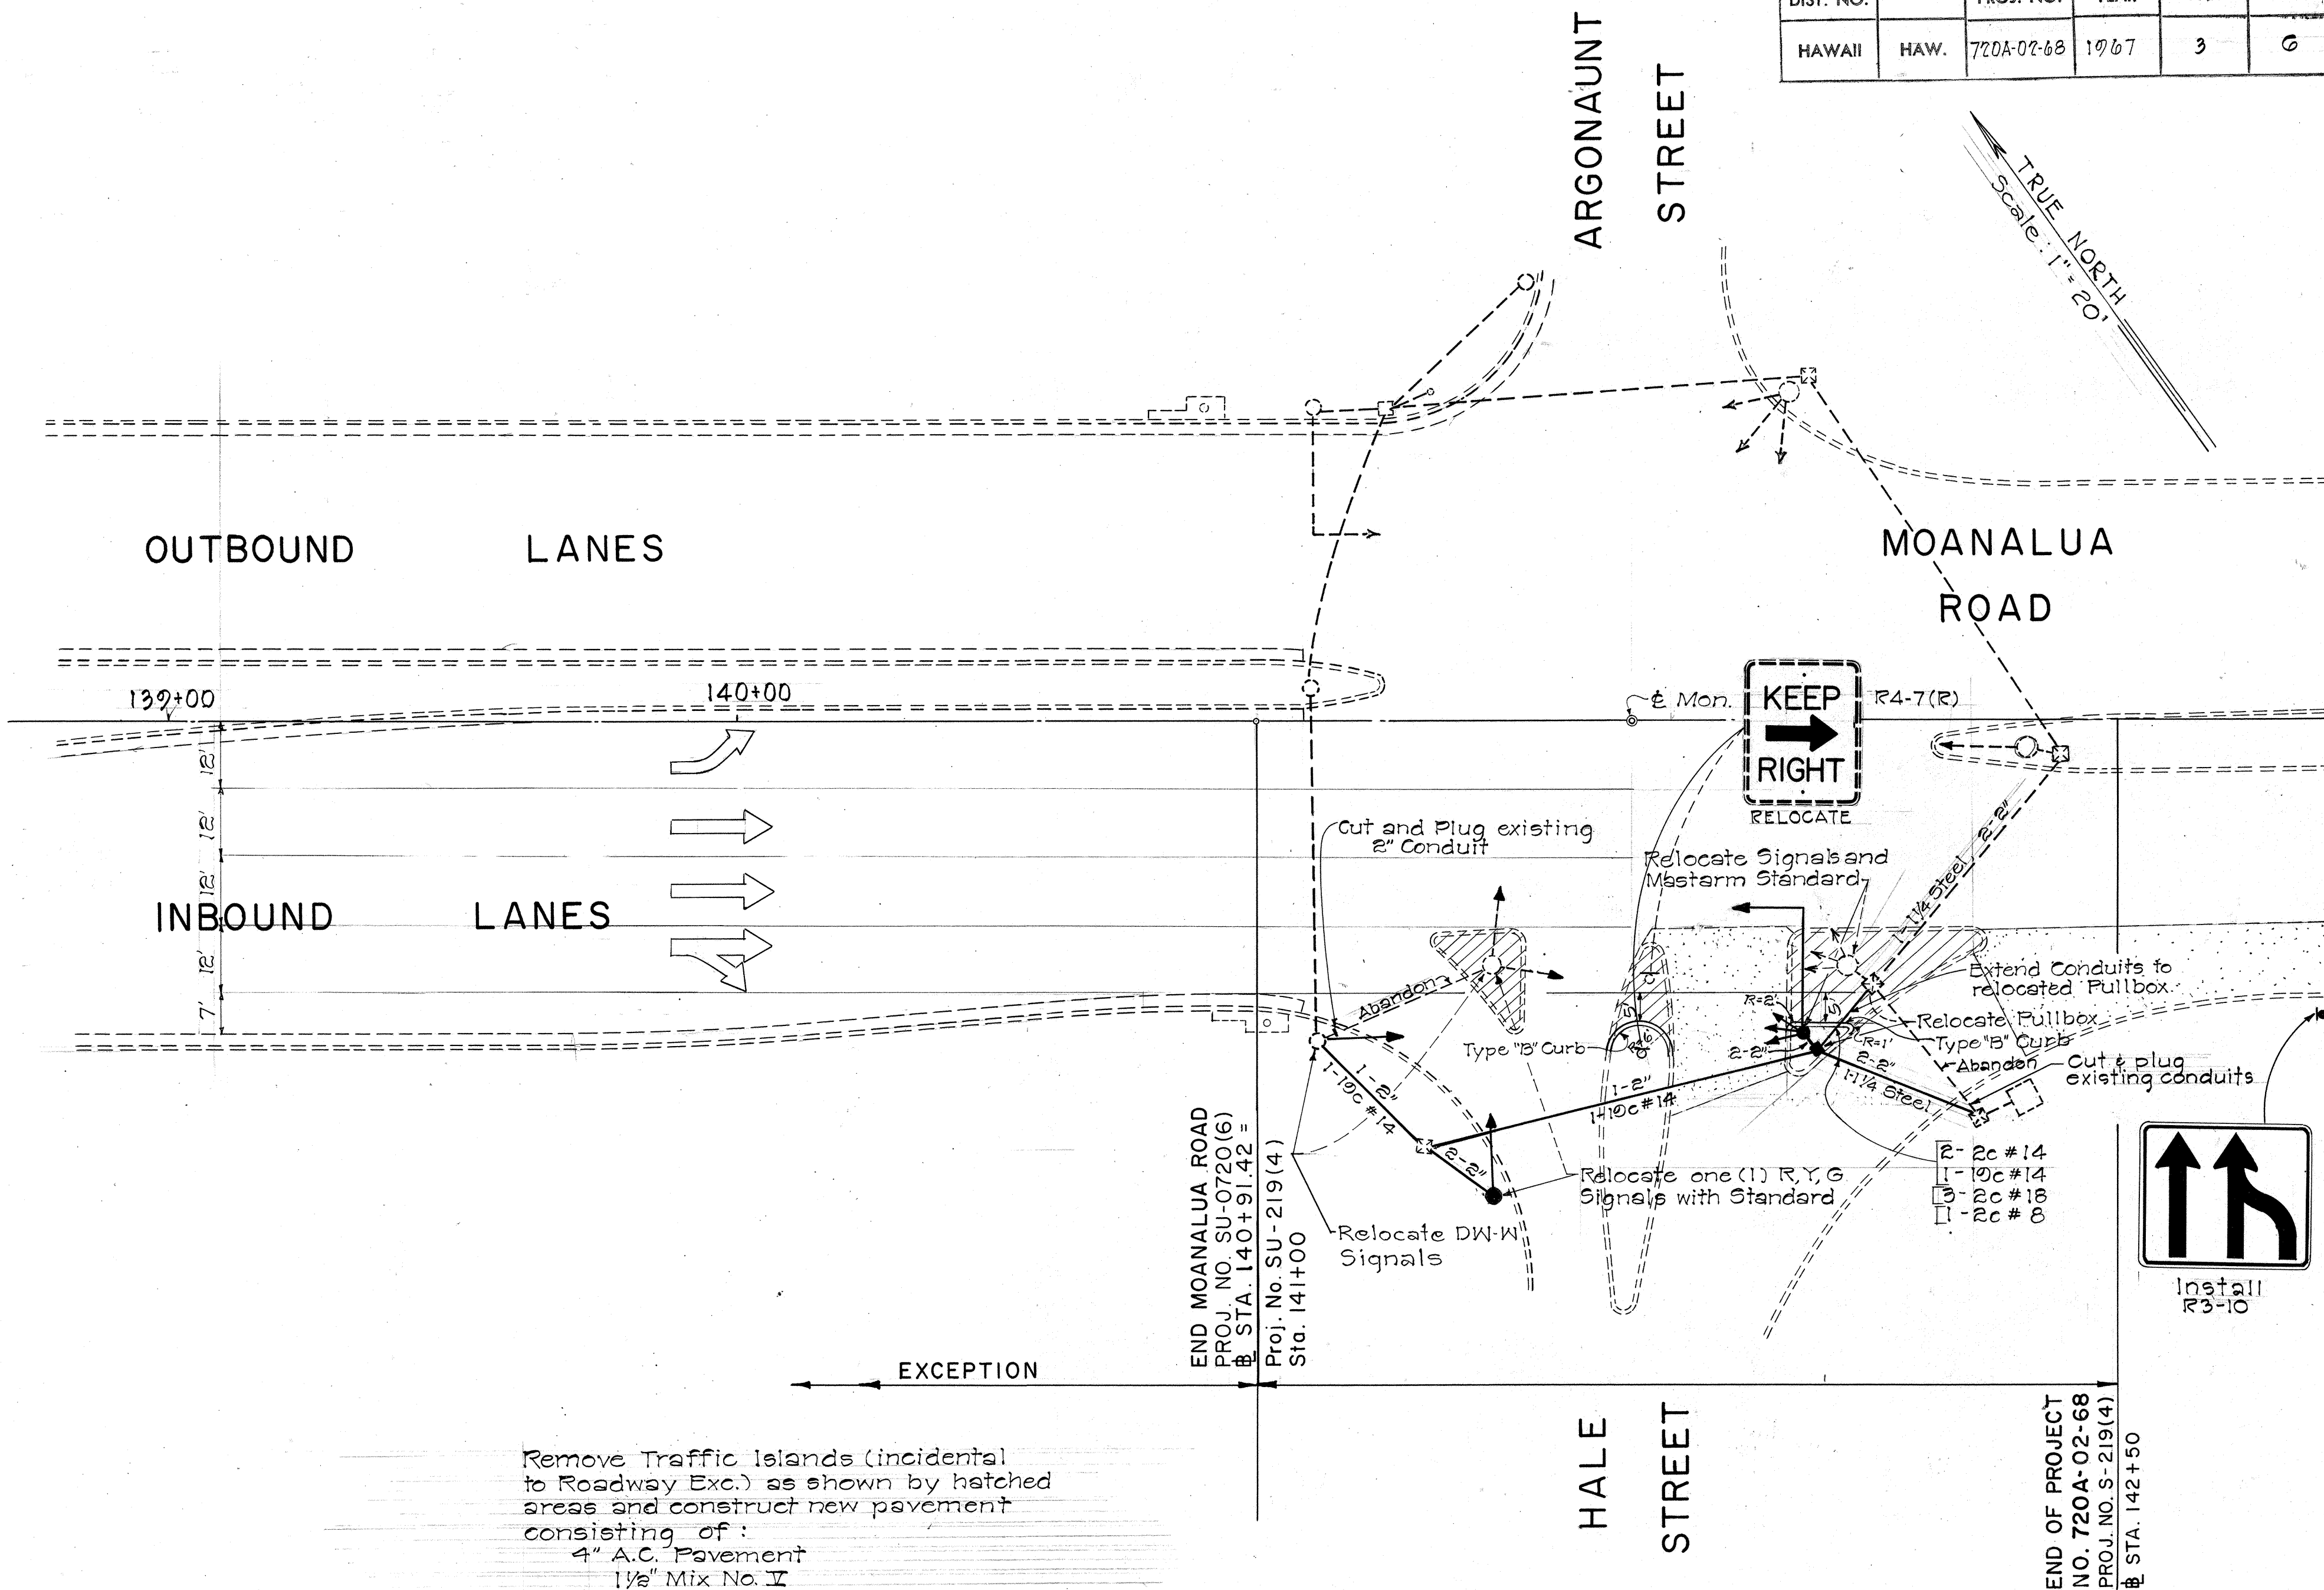

Remove Traffic Islands (incidental to Roadway Exc.) as shown by hatched areas and construct new pavement consisting of:

- 4" A.C. Pavement
- 1 1/2" Mix No. II
- 2 1/2" Mix No. III
- 8" Untreated Base
- 12" Select Borrow Subbase

Provide smooth transition to adjacent pavement.

GENERAL NOTES

- Exact locations of the traffic signal standards, pullboxes, detectors, and conduits shall be determined in the field by the project engineer.
- Existing underground conduits not used in the traffic signal system shall be abandoned or removed as directed by the project engineer. (All cost incidental to the item of "Roadway Excavation".)
- Removal of existing pullboxes shall not be paid for separately but shall be incidental to the item of "Traffic Signal System".
- Contractor shall furnish necessary materials to complete the relocation of traffic signals and Standards.

LEGEND

- Relocated Signal and Standard.
- Relocated Masterm Signal Standard
- Existing Signal and Standard
- Relocated Signal
- Relocated Pullbox
- Existing Pullbox
- New Steel or P.V.C. Conduit. (No. & Size as indicated)

STATE OF HAWAII
DEPARTMENT OF TRANSPORTATION

DETAIL PLAN OF ROADWAY
MOANALUA ROAD IMPROVEMENT
PROJ. NO. 720A-02-68
Scale: As Noted
September 1967

SHEET NO. 2 OF 2 SHEETS

SURVEY PLOTTED BY	DATE
DRAWN BY	
TRACED BY	
CHECKED BY	
ORIGINAL PLAN	
NOTE BOOK	
No.	