


INDEX TO DRAWINGS	
SHEET NO.	DESCRIPTION
1	TITLE SHEET
2-3	DETAIL PLAN OF ROADWAY
4-6	MISCELLANEOUS AND STANDARD DETAILS

STATE OF HAWAII
DEPARTMENT OF TRANSPORTATION
HIGHWAYS DIVISION

"AS BUILT" PLANS OF
MOANALUA ROAD IMPROVEMENT,
AIEA ACCESS ROAD TO HALE STREET
PROJECT NO. 720A-02-68

DISTRICT OF EWA
ISLAND OF OAHU

FED. ROAD DIST. NO.	STATE	PROJ. NO.	FISCAL YEAR	SHEET NO.	TOTAL SHEETS
HAWAII	HAW.	720A-02-68	1967	1	6

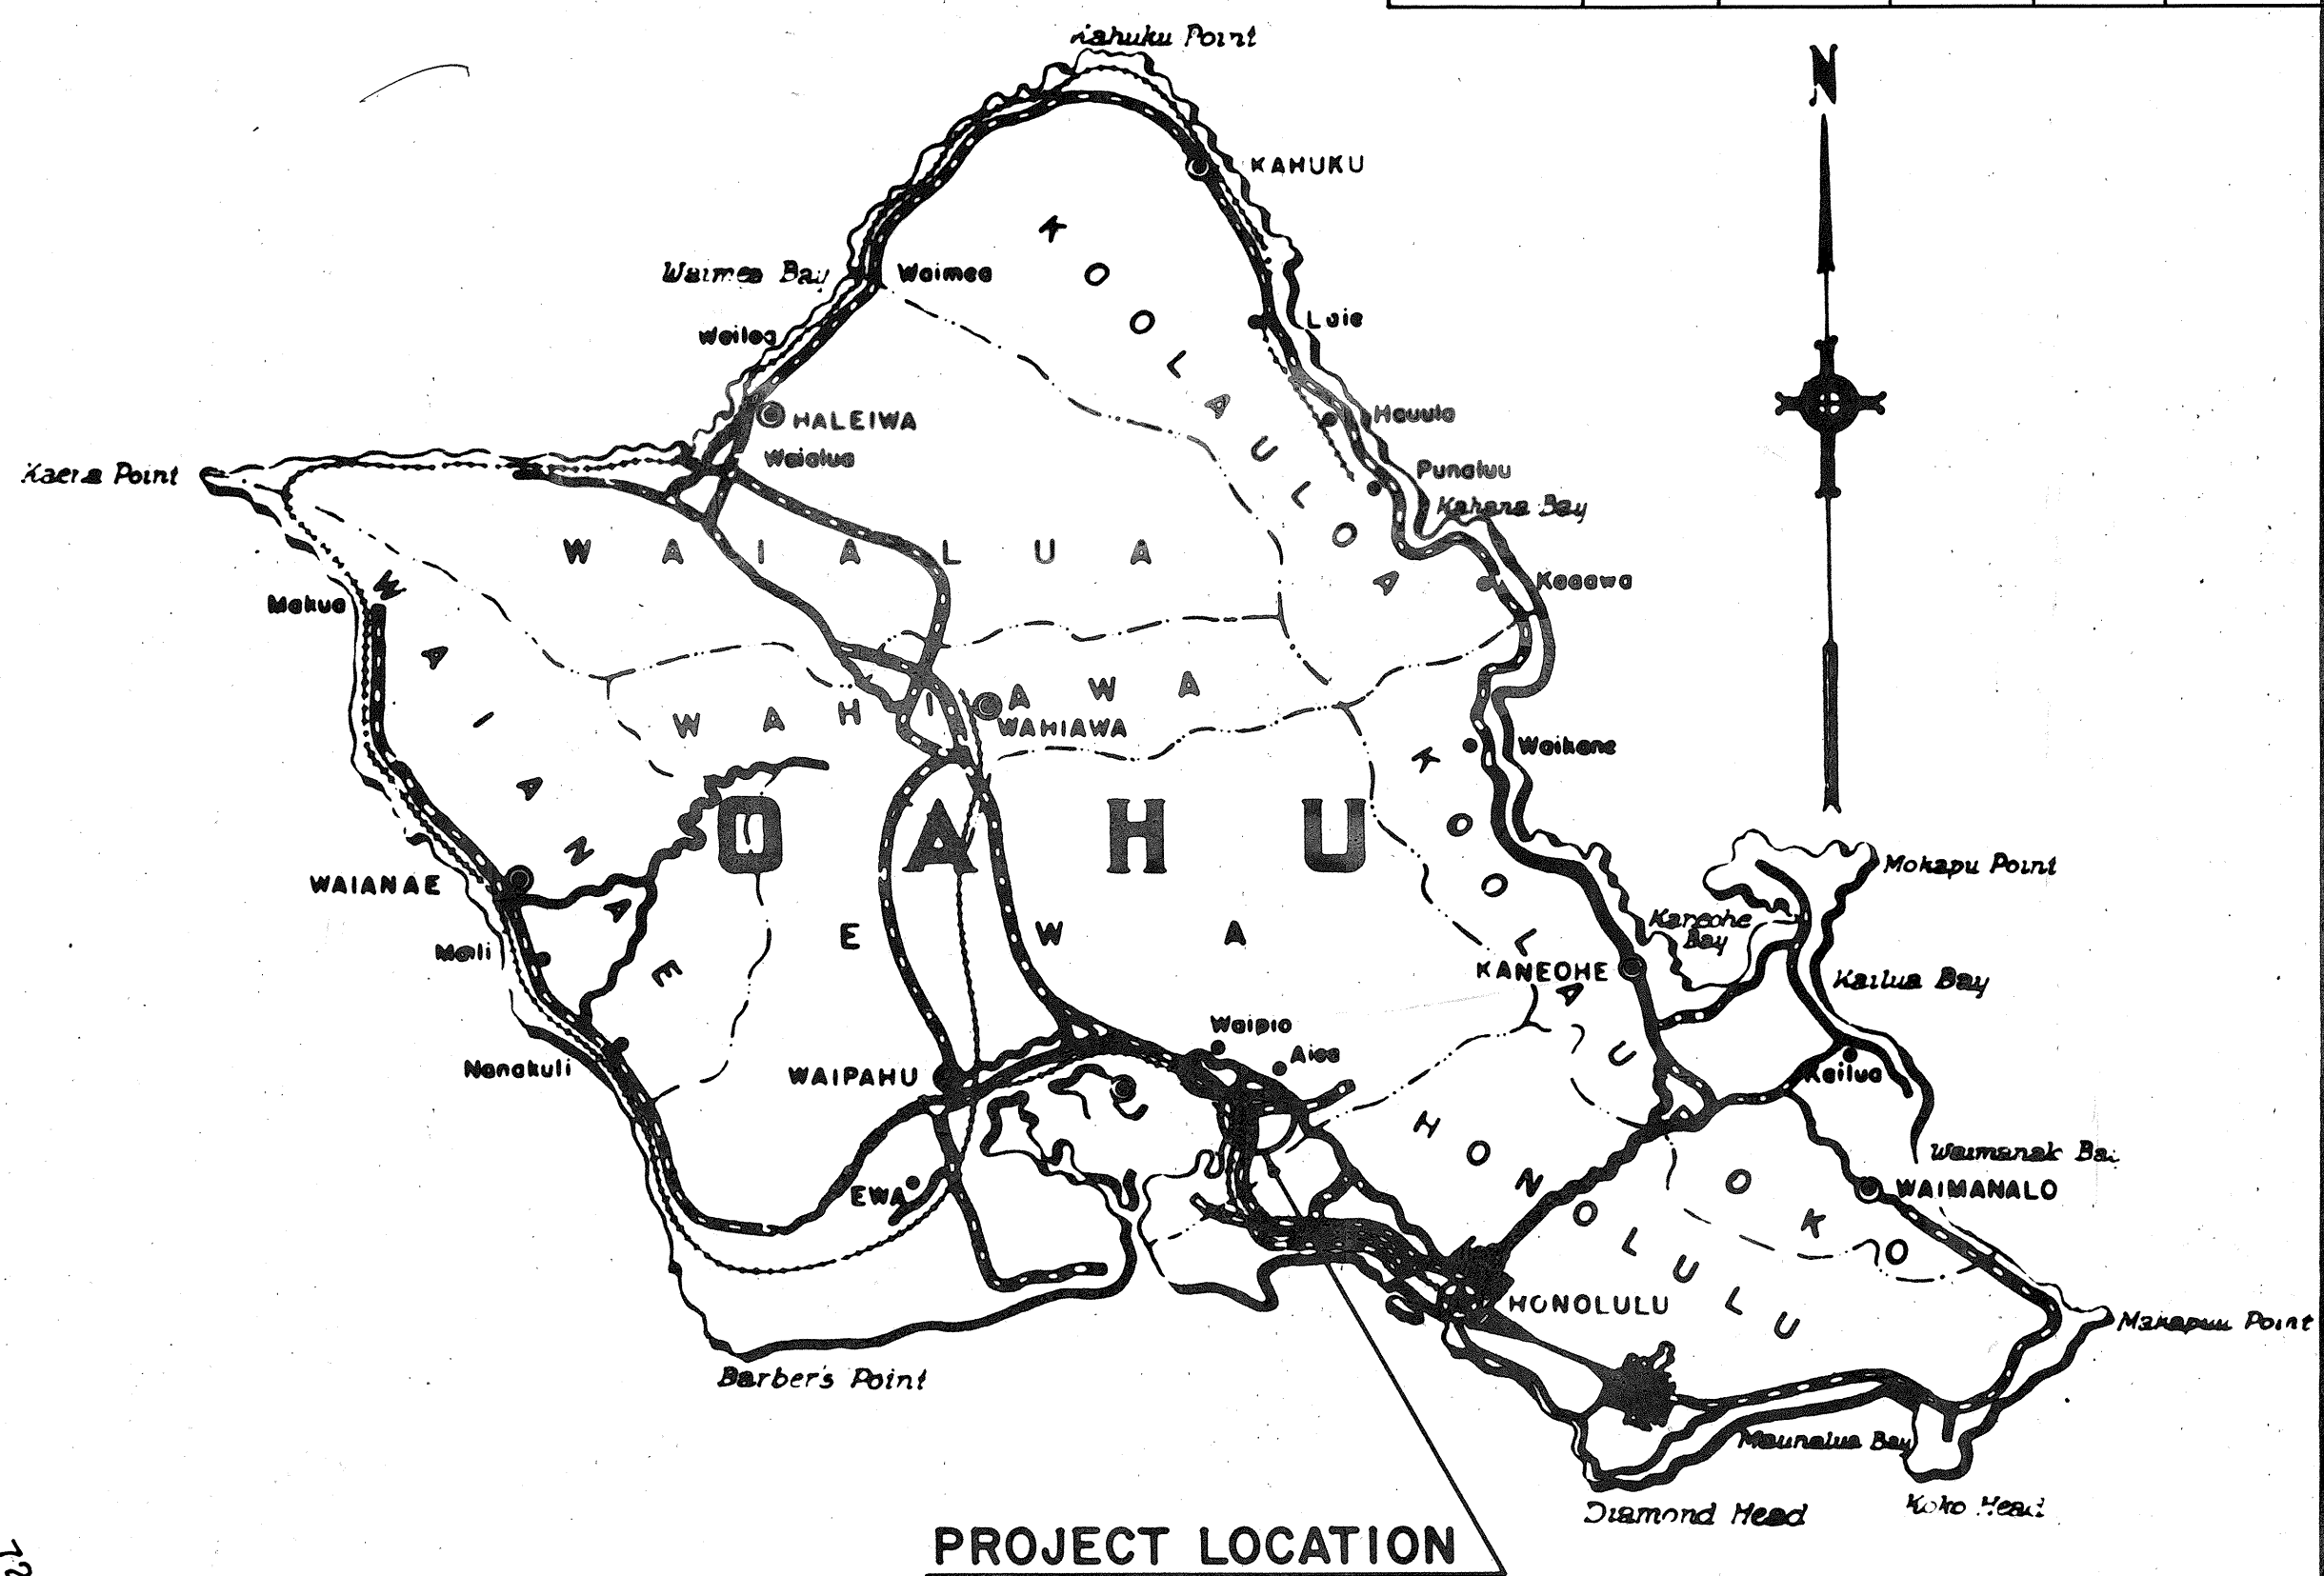

PROJECT LOCATION

Federal Aid Projects Previously Constructed Or Under Construction


NOTE:
ALL CHANGES MADE DURING CONSTRUCTION HAVE BEEN NOTED IN RED ON THESE TRACINGS AND CHECKED BY:

John D. Cabana
PROJECT ENGINEER
July 19, 1968
DATE

LENGTH OF PROJECT0.121 Mi.

DEPARTMENT OF TRANSPORTATION STATE OF HAWAII	
APPROVED:	
<i>John D. Cabana</i>	<i>11/8/67</i>
DIR. OF TRANSPORTATION	DATE

LAYOUT PLAN

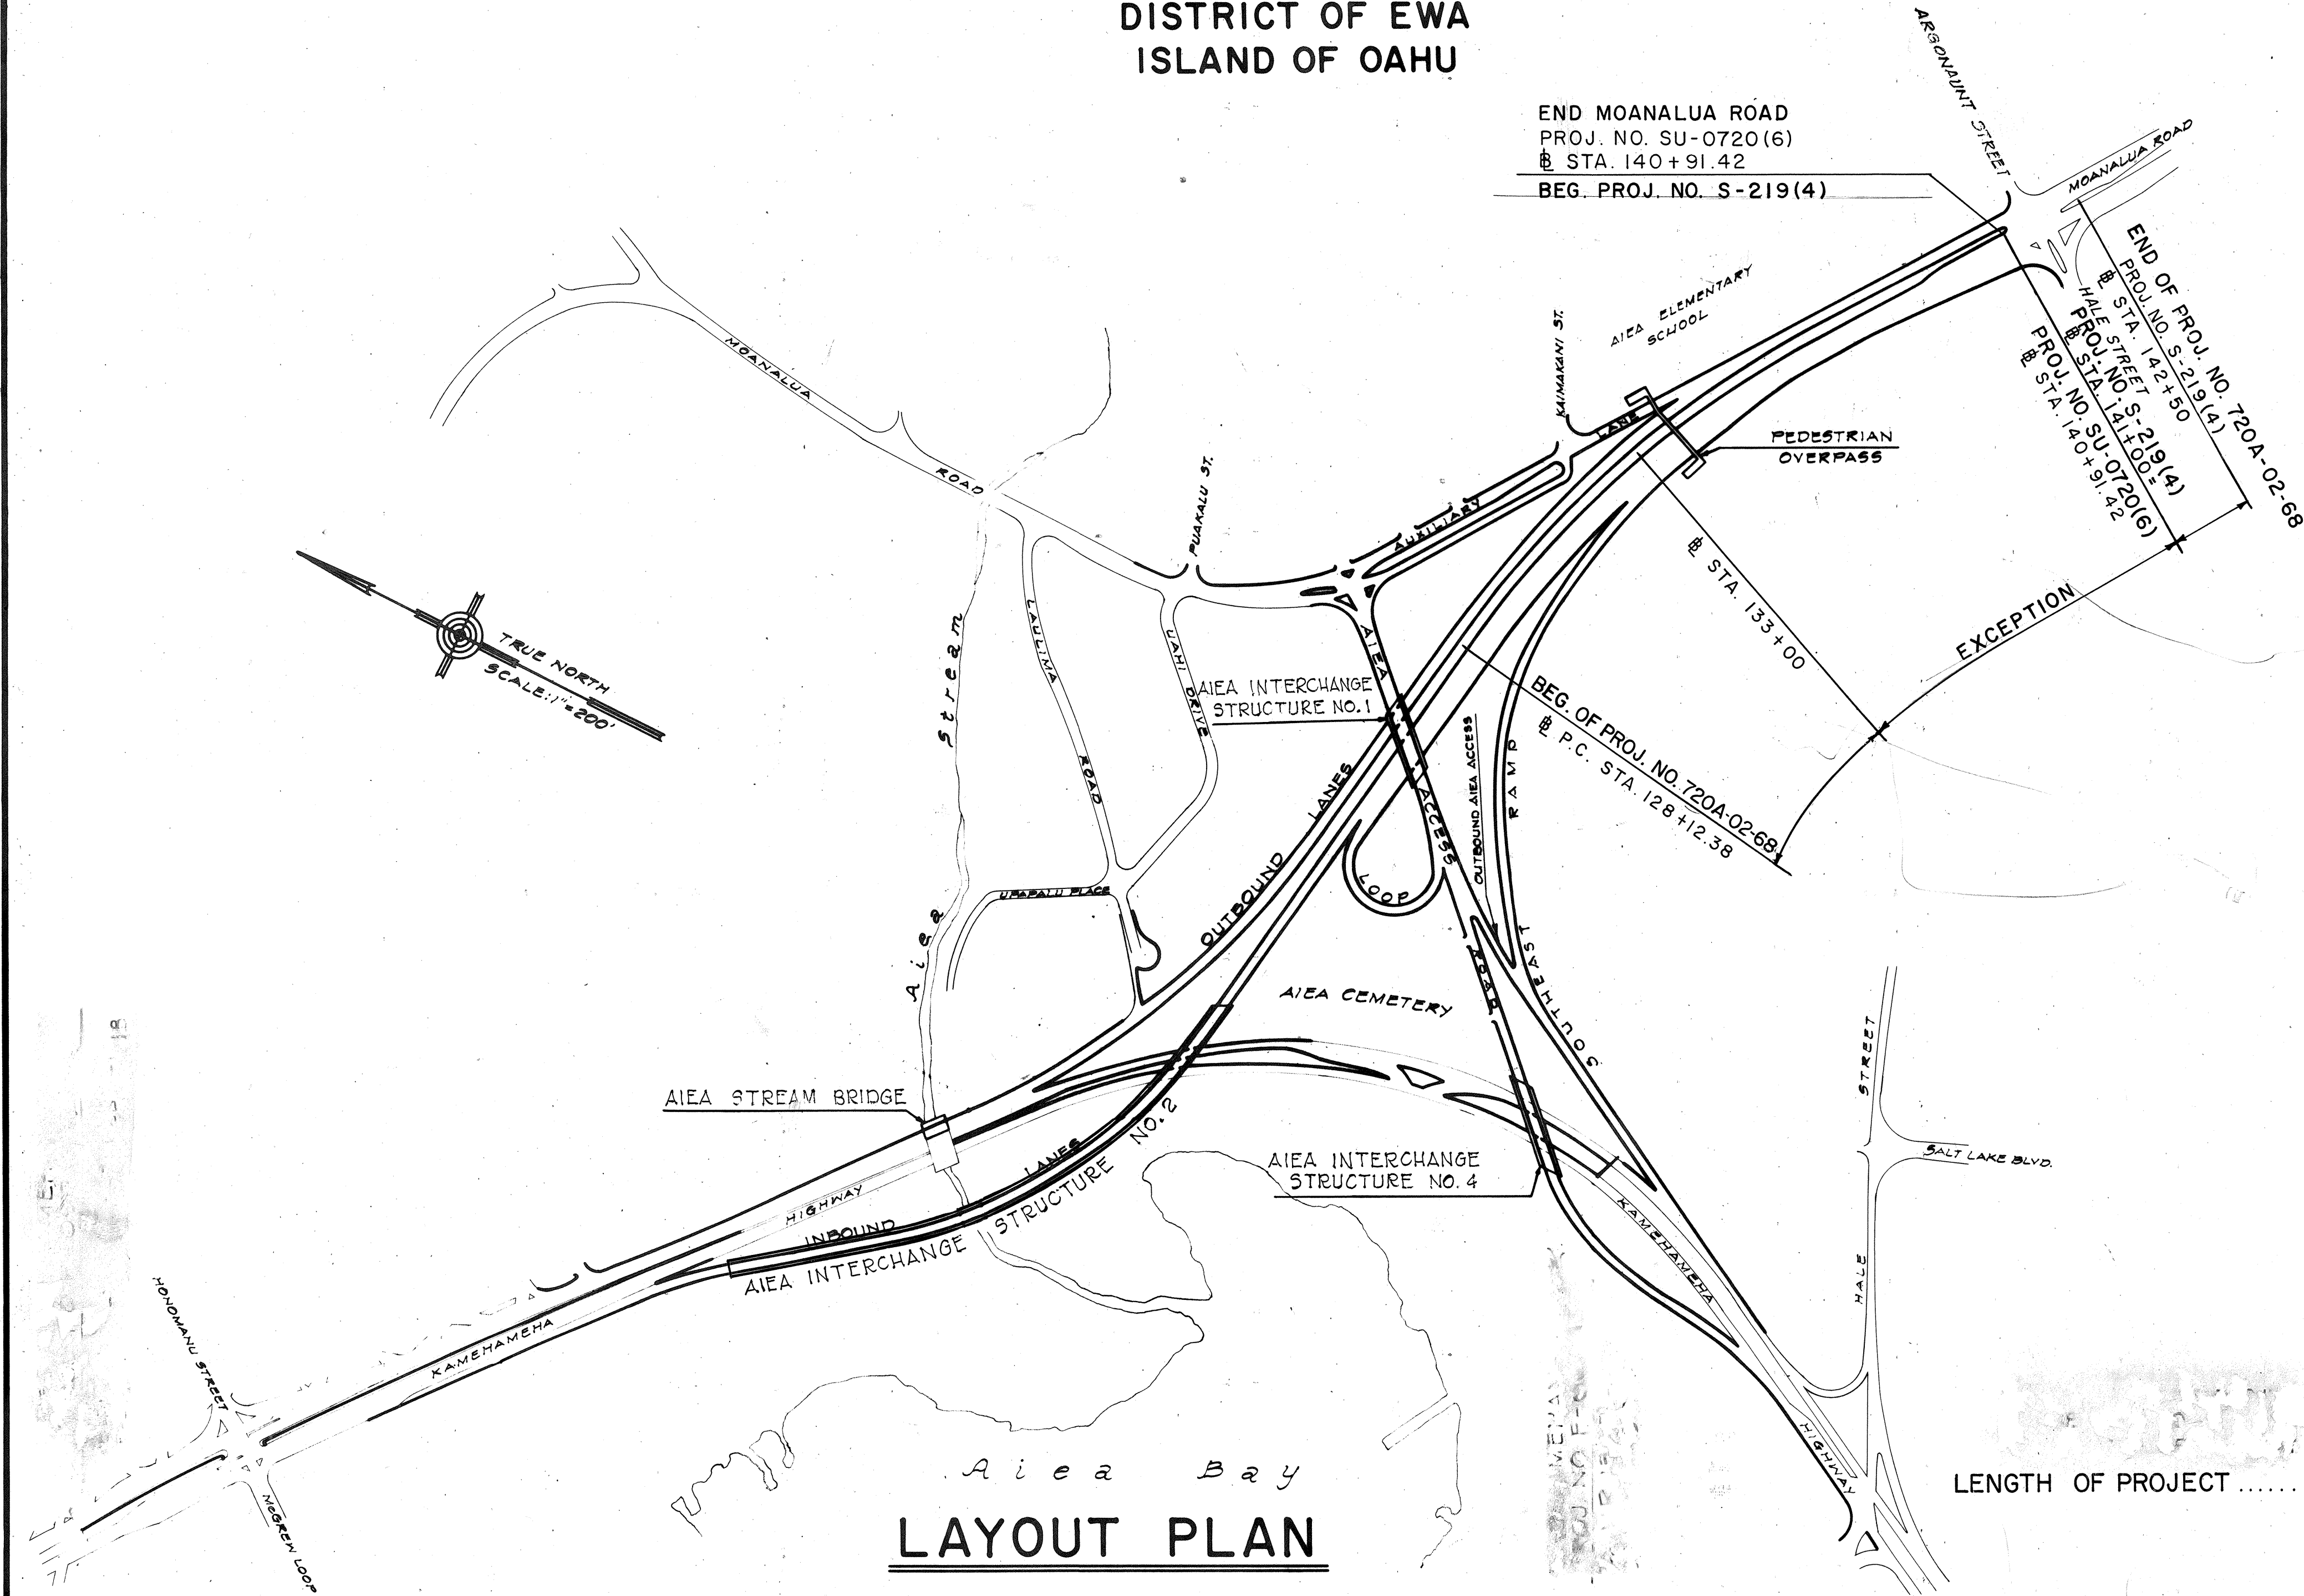

SURVEY PLOTTED BY	DATE
DESIGNED BY	
TRACED BY	
CHECKED BY	
DATE	Oct 67