

INDEX TO DRAWINGS	
SHEET NO.	DESCRIPTION
1	TITLE SHEET
2	GENERAL PLAN
3 - 9	TYPICAL SECTIONS
10 - 19	ALIGNMENT PLANS
20 - 34	ROADWAY PROFILES & S.E. DIAGRAMS
35 - 45	RAMP TERMINALS & MISCELLANEOUS
46 - 65	ROADWAY CONSTR. PLANS & DETAILS
66 - 102	DRAINAGE PLANS & DETAILS
103 - 113	BORING LOCATION PLANS & BORING LOGS
114 - 130	SOIL STABILIZATION DETAILS
131 - 149	CONSTR. SEQUENCE & TEMP. SIGNING
150 - 174	SIGNING PLANS & DETAILS
175 - 189	HIGHWAY LIGHTING & ELECTRICAL
190 - 242	UTILITY PLANS & DETAILS
243 - 260	STRUCTURE NO. 2
261 - 275	STRUCTURE NO. 7
276 - 286	STRUCTURE DETAILS
287 - 290	HALAWA HTS. STREAM BOX CULVERT
291 - 296	HALAWA STREAM
297 - 299	CROSS SECTION KEY SHEETS
300 - 457	CROSS SECTIONS


① 54R, 65 S-1, ② C.O. 174 S-1, C.O. 174 S-2, C.O. 174 S-3, ③ C.O. 245 S-1 ④ C.O. 458 Thru C.O. 465, Are Supplement Sheets To The Contract Plans. Total = 471 Shts.

STATE OF HAWAII
DEPARTMENT OF TRANSPORTATION
HIGHWAYS DIVISION
HONOLULU, HAWAII
"AS-BUILT"
PLANS FOR
CONSTRUCTION OF A PORTION OF
INTERSTATE ROUTE H-1
HALAWA INTERCHANGE
EAST OF KAIMAKANI STREET TO SOUTH OF MOANALUA ROAD
FEDERAL AID INTERSTATE PROJECT NO. I-HI-1(88):13

DISTRICT OF EWA
ISLAND OF OAHU


SCALES:

PLANS	1" = 50'
PROFILES	HOR. 1" = 50'
	VER. 1" = 10'
DETAIL ROADWAY PLANS	1" = 50'
CROSS SECTIONS	HOR. 1" = 10'
	VER. 1" = 10'

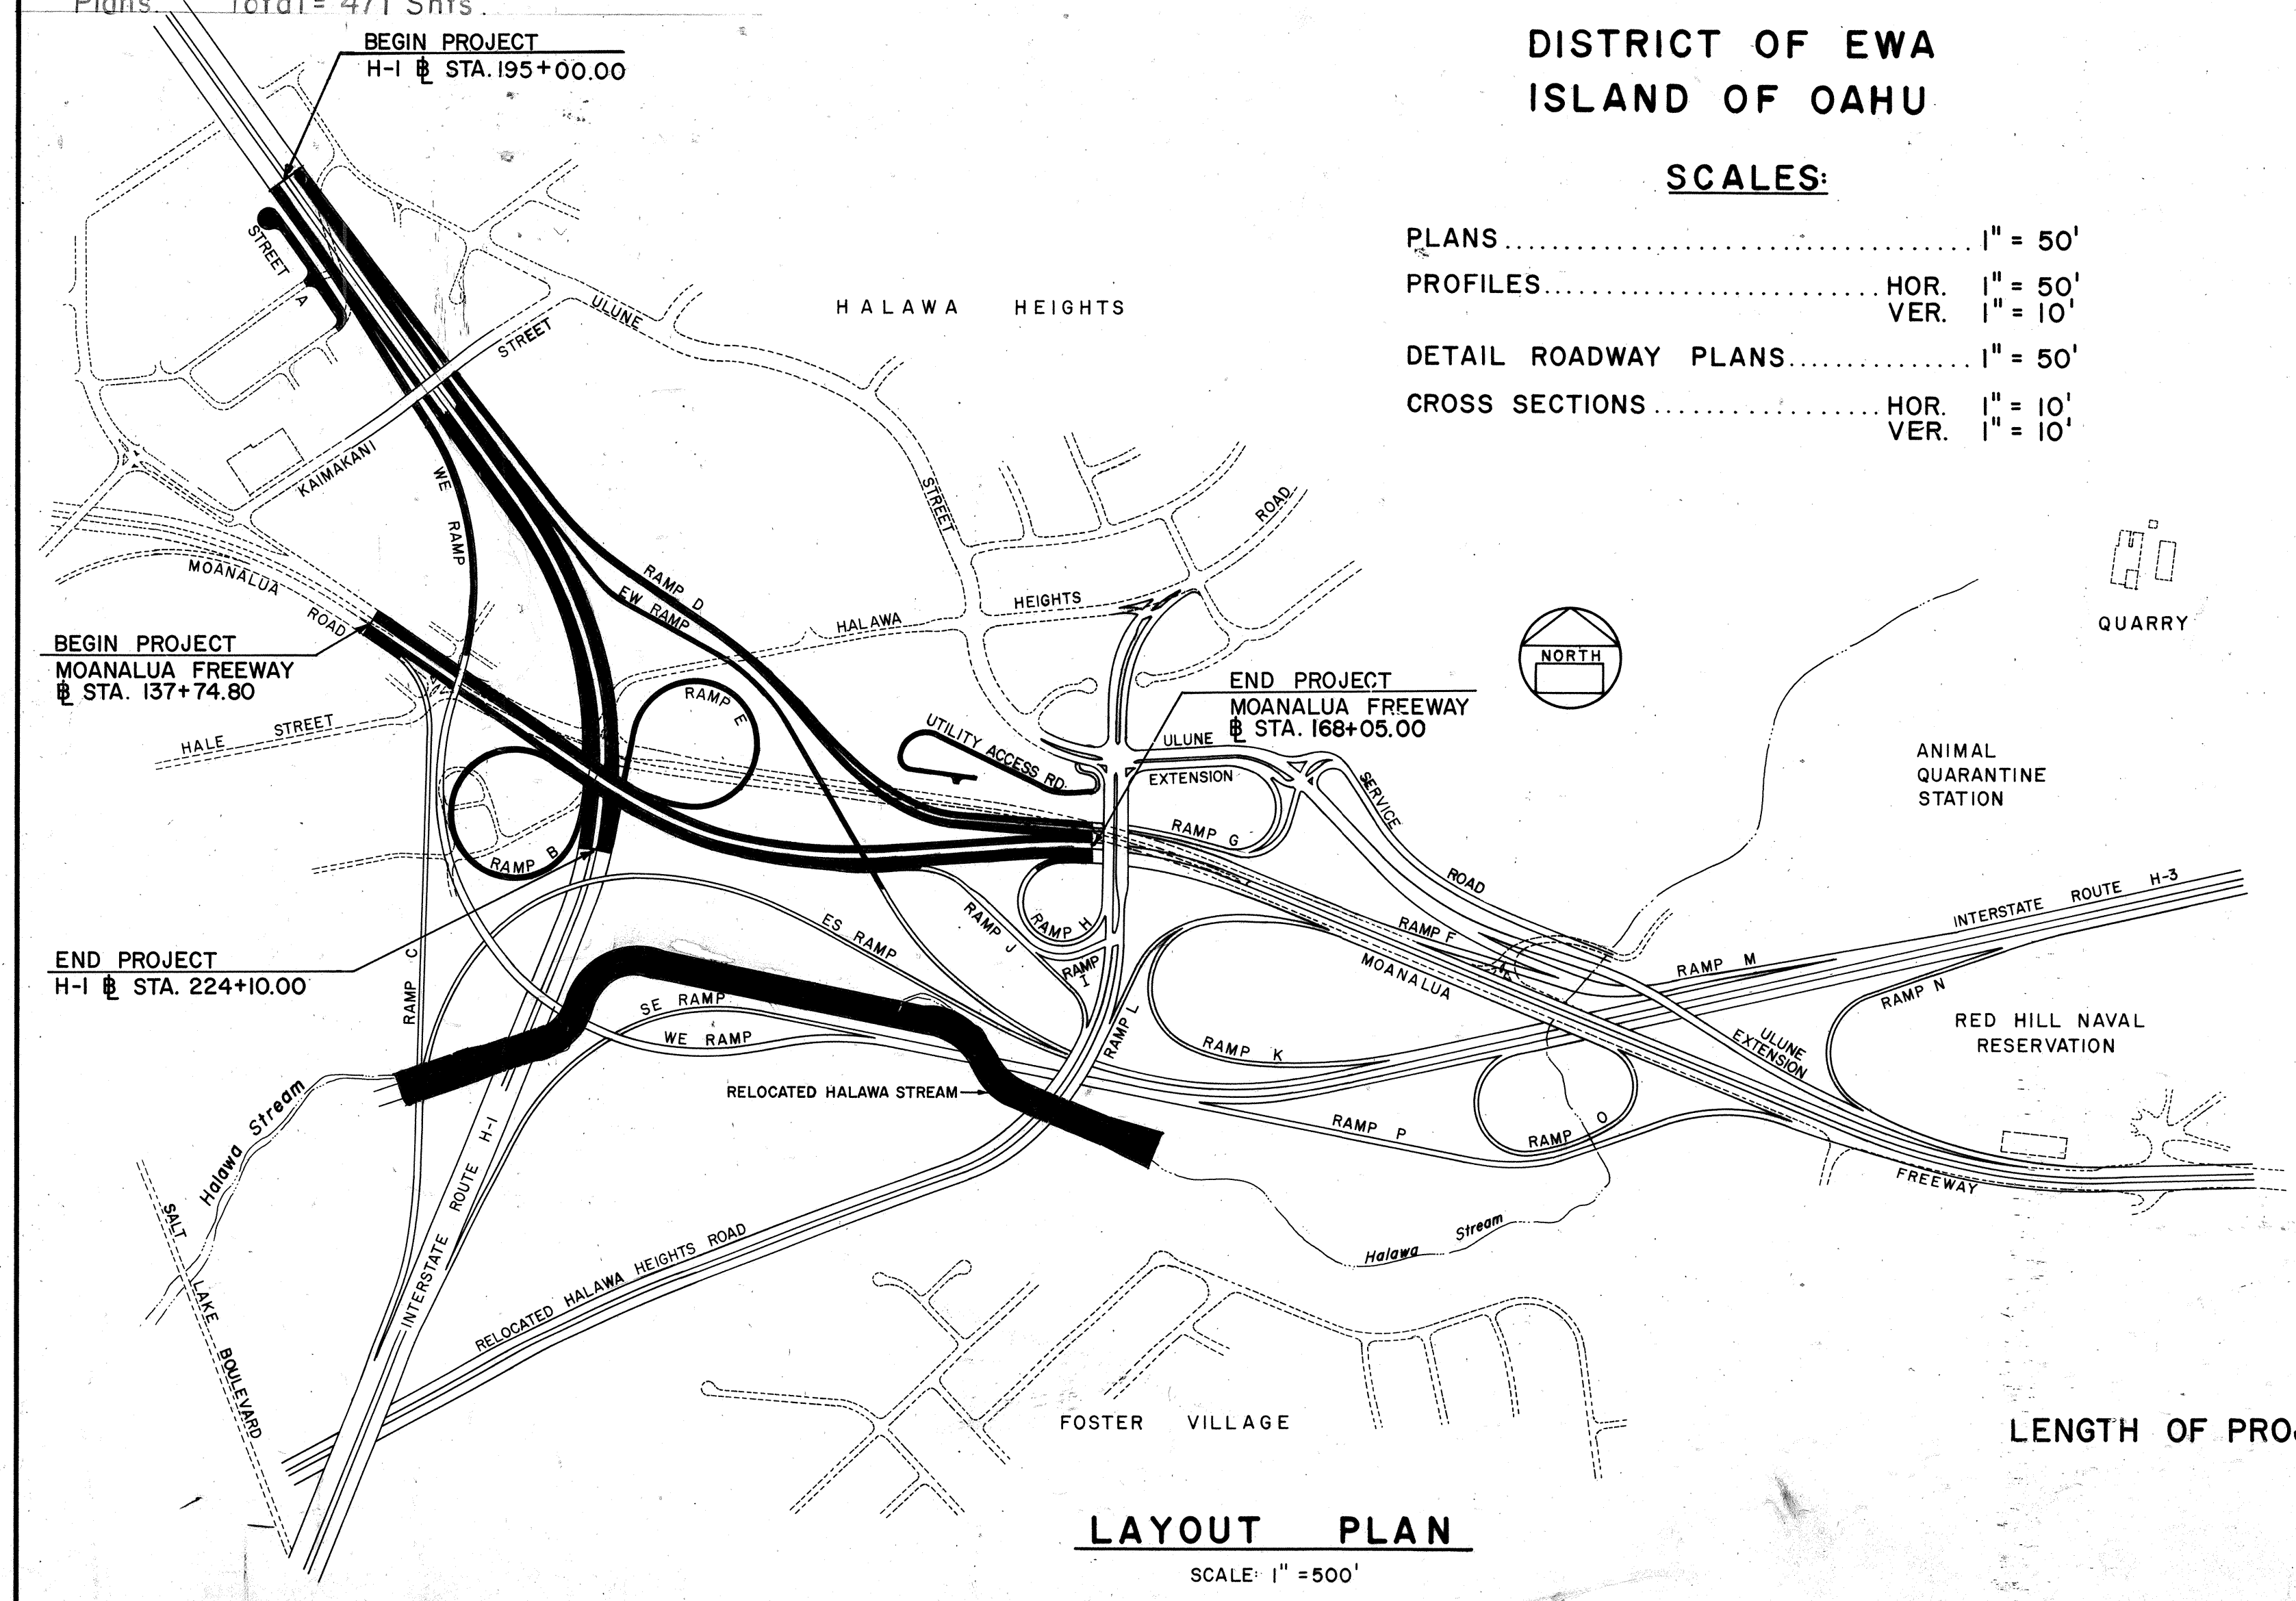

LAYOUT PLAN
SCALE: 1" = 500'

LENGTH OF PROJECT.....0.552 MILES (ROUTE H-1)
0.574 MILES (MOANALUA FWY)

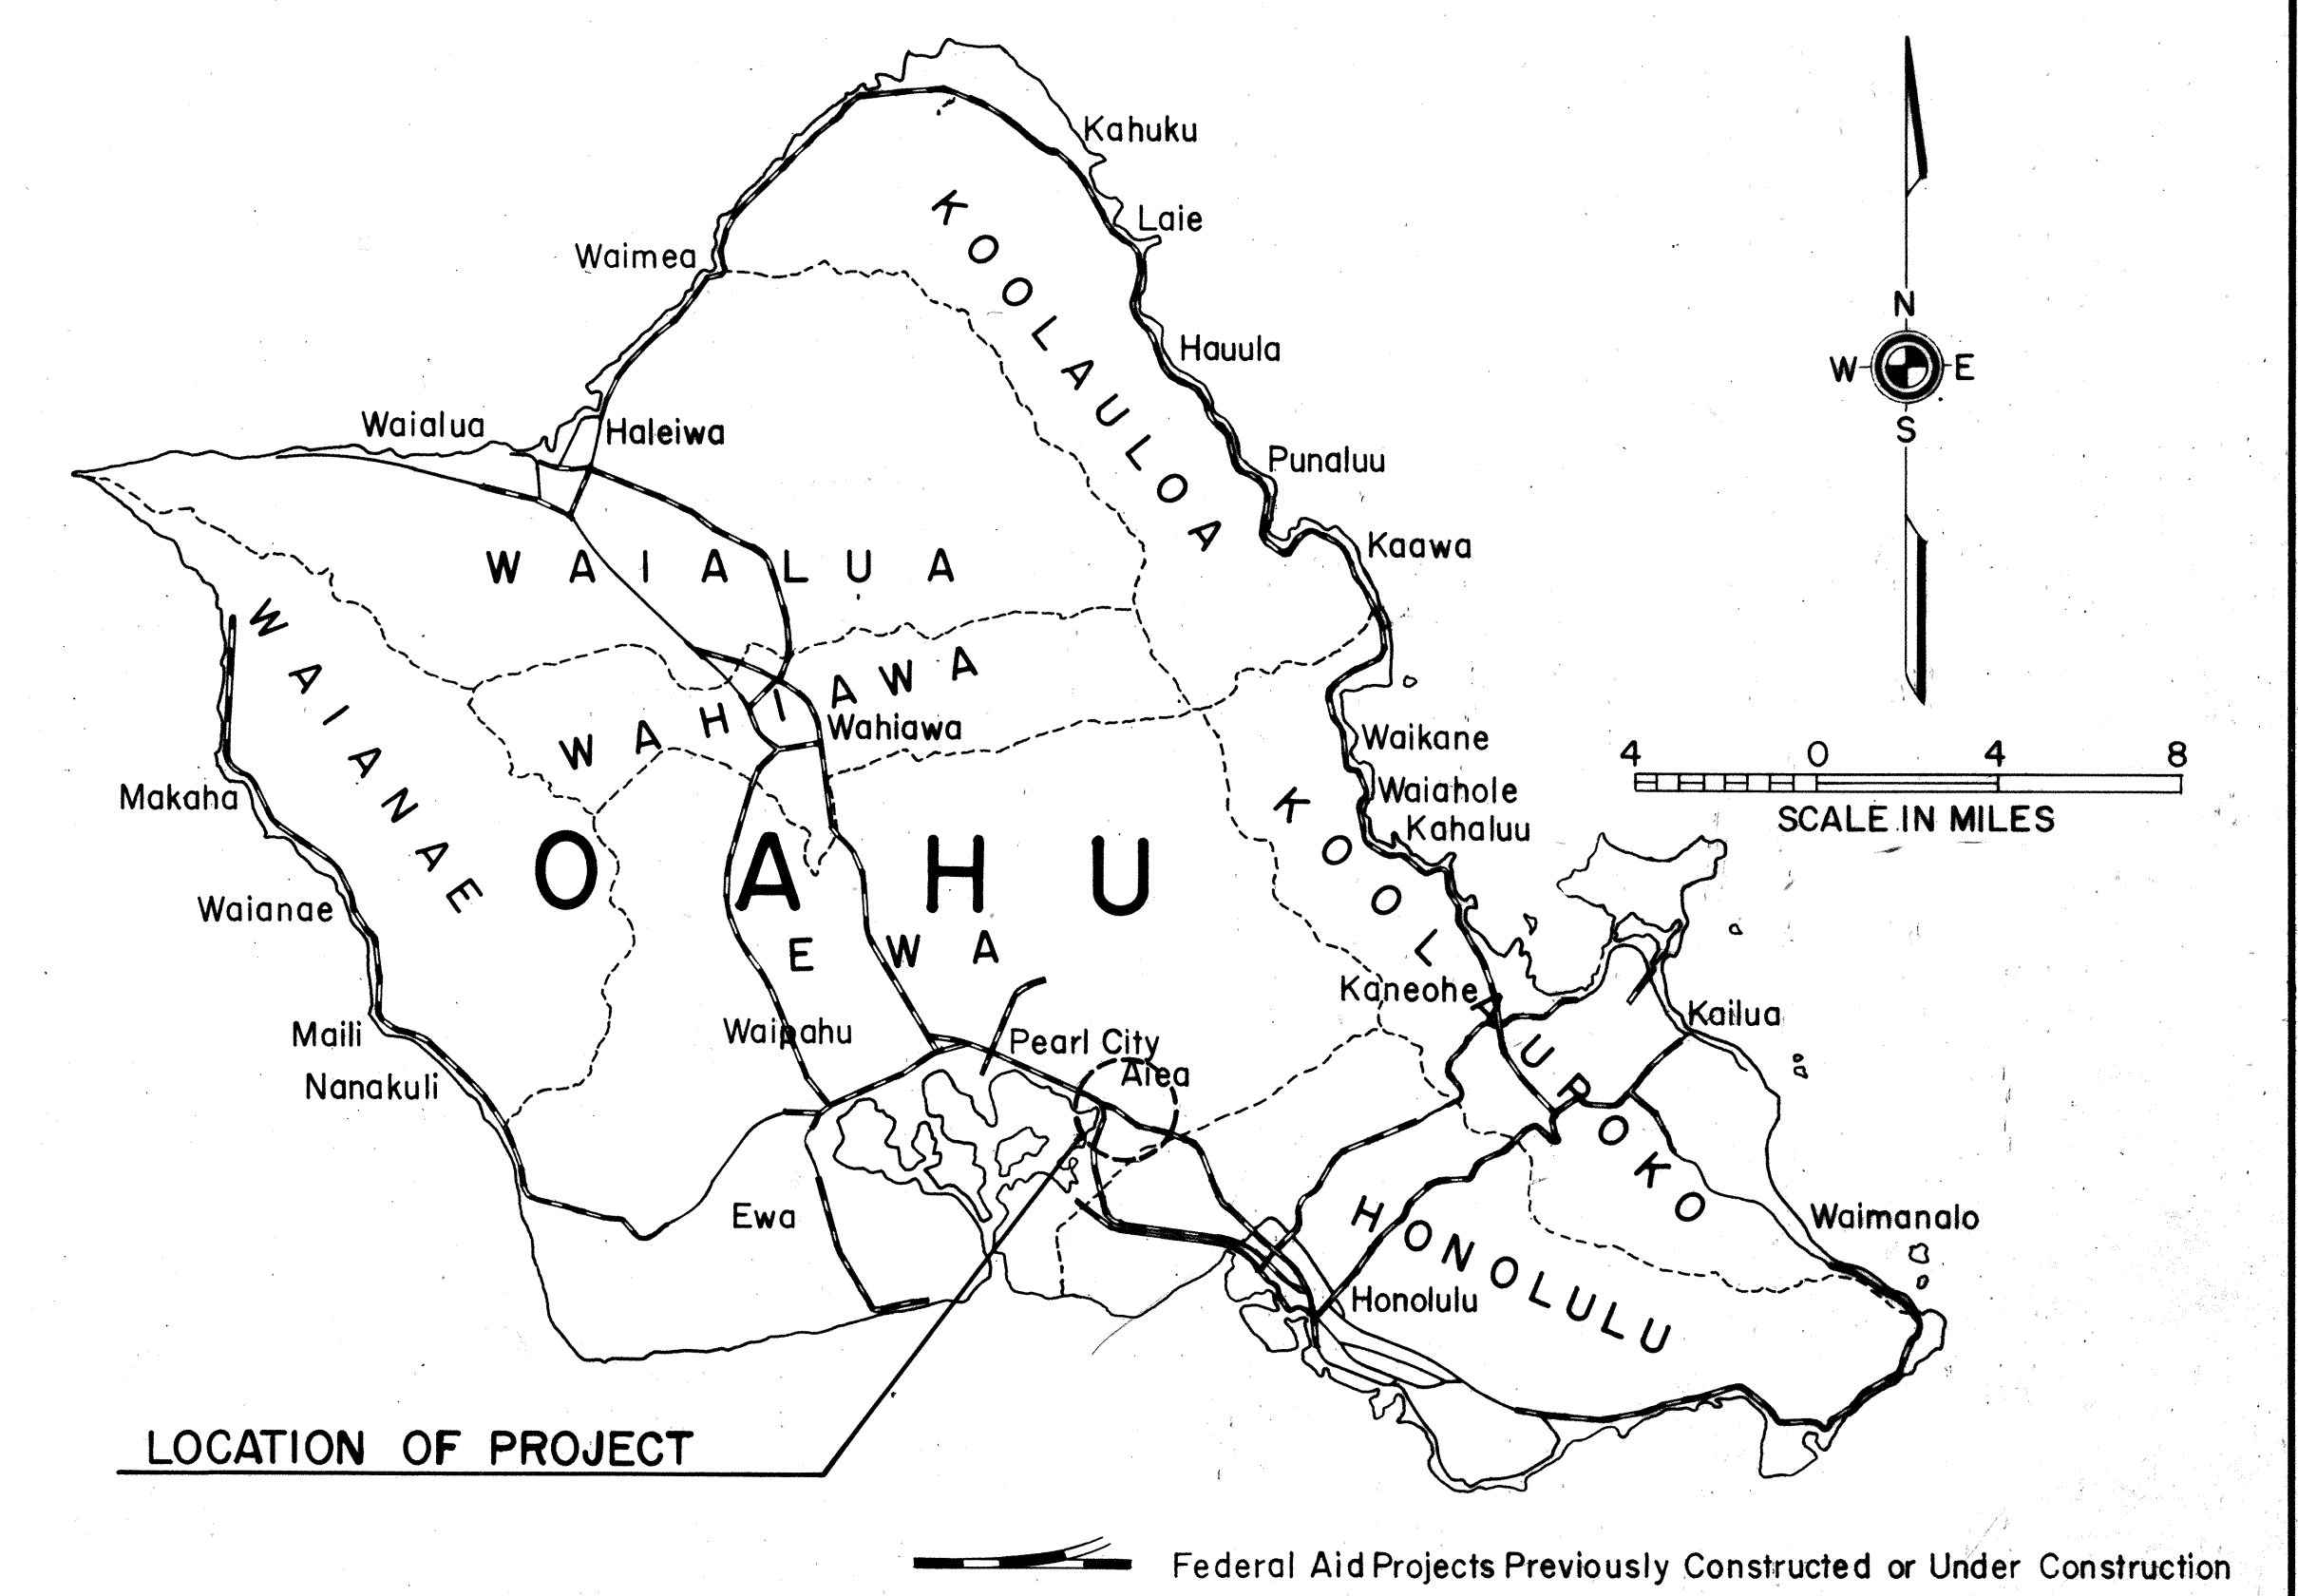

DESIGN CLASSIFICATION

DESIGN ADT (1990).....	113,933
DHV.....	11,531
D.....	60/40
T.....	5%
V.....	60 MPH

NO SIGNIFICANT CHANGES WERE MADE DURING CONSTRUCTION ON THESE PLANS EXCEPT CHANGES IN THE ORIGINAL THEORETICAL QUANTITIES. FOR ACTUAL QUANTITIES, REFER TO PROJECT LEDGER AND/OR COMPUTATION BOOK.

Robert H. Fisher 12-29-86
for RESIDENT ENGINEER DATE

DEPARTMENT OF TRANSPORTATION
FEDERAL HIGHWAY ADMINISTRATION
APPROVED: *[Signature]* 6-17-91
for DIVISION ENGINEER DATE

DEPARTMENT OF TRANSPORTATION
STATE OF HAWAII
APPROVED: *[Signature]* 4/2/91
for DIR. OF TRANSPORTATION DATE

D. Lee April, 1971