



FED. ROAD DIST. NO.	STATE	FED. AID PROJ. NO.	FISCAL YEAR	SHEET NO.	TOTAL SHEETS
HAWAII	HAW.	F-078-1(7)	1971	126	302

Revised: July 13, 1971

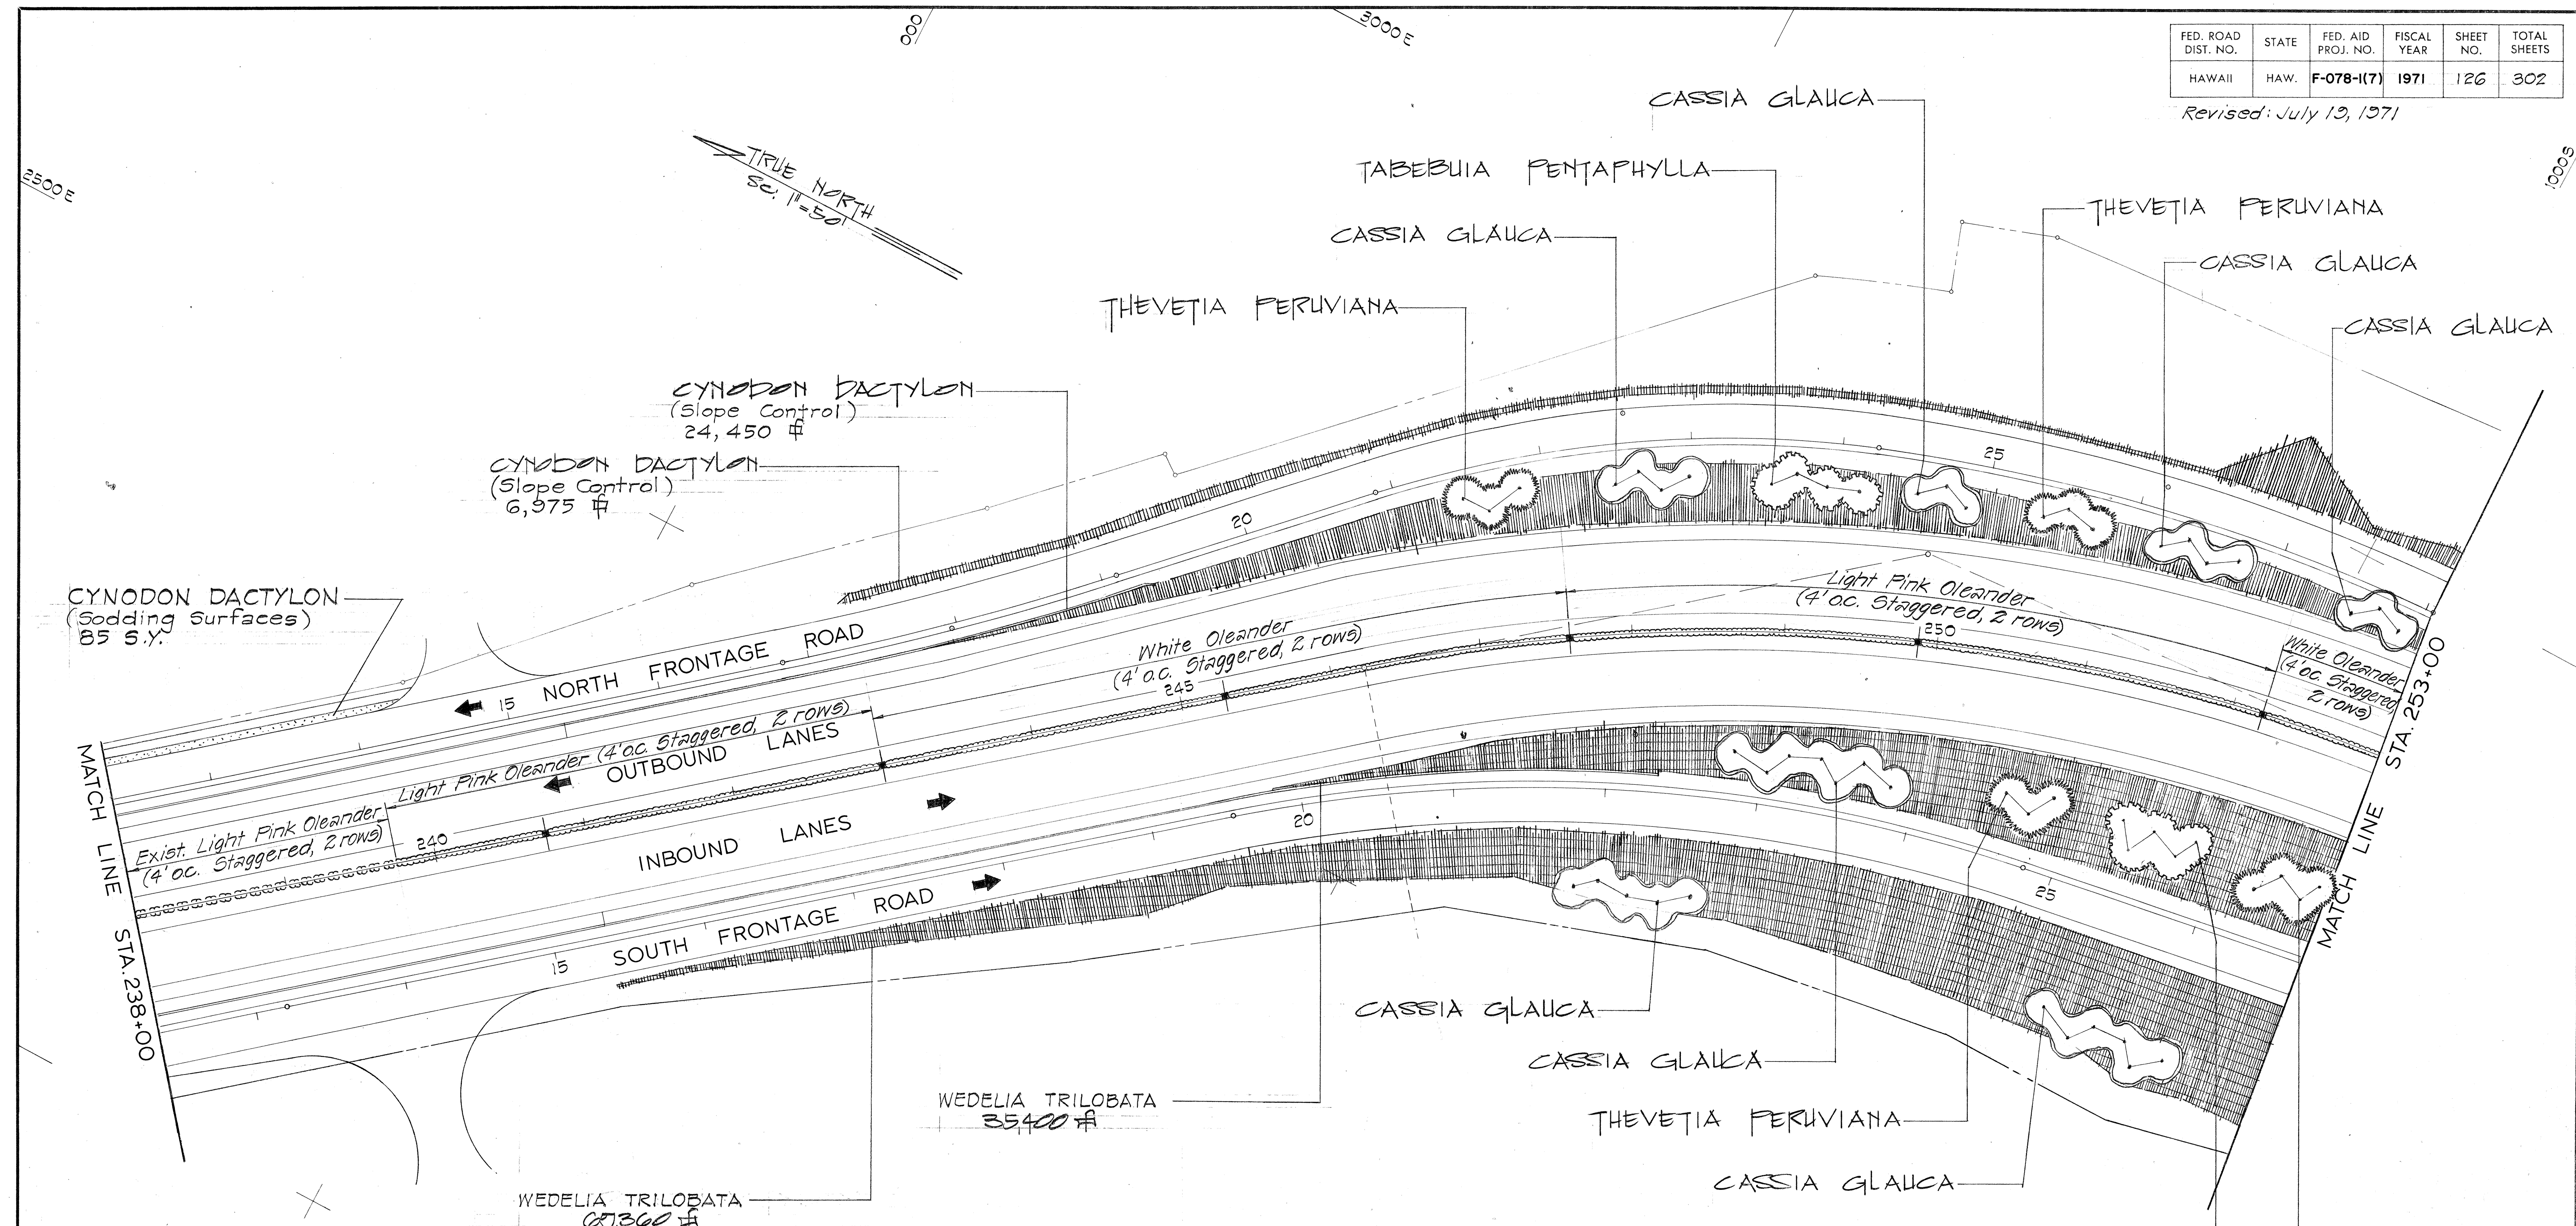

DATE	BY
DESIGNED BY	NOTED BY
CHECKED BY	APPROVED BY
DATE	DATE

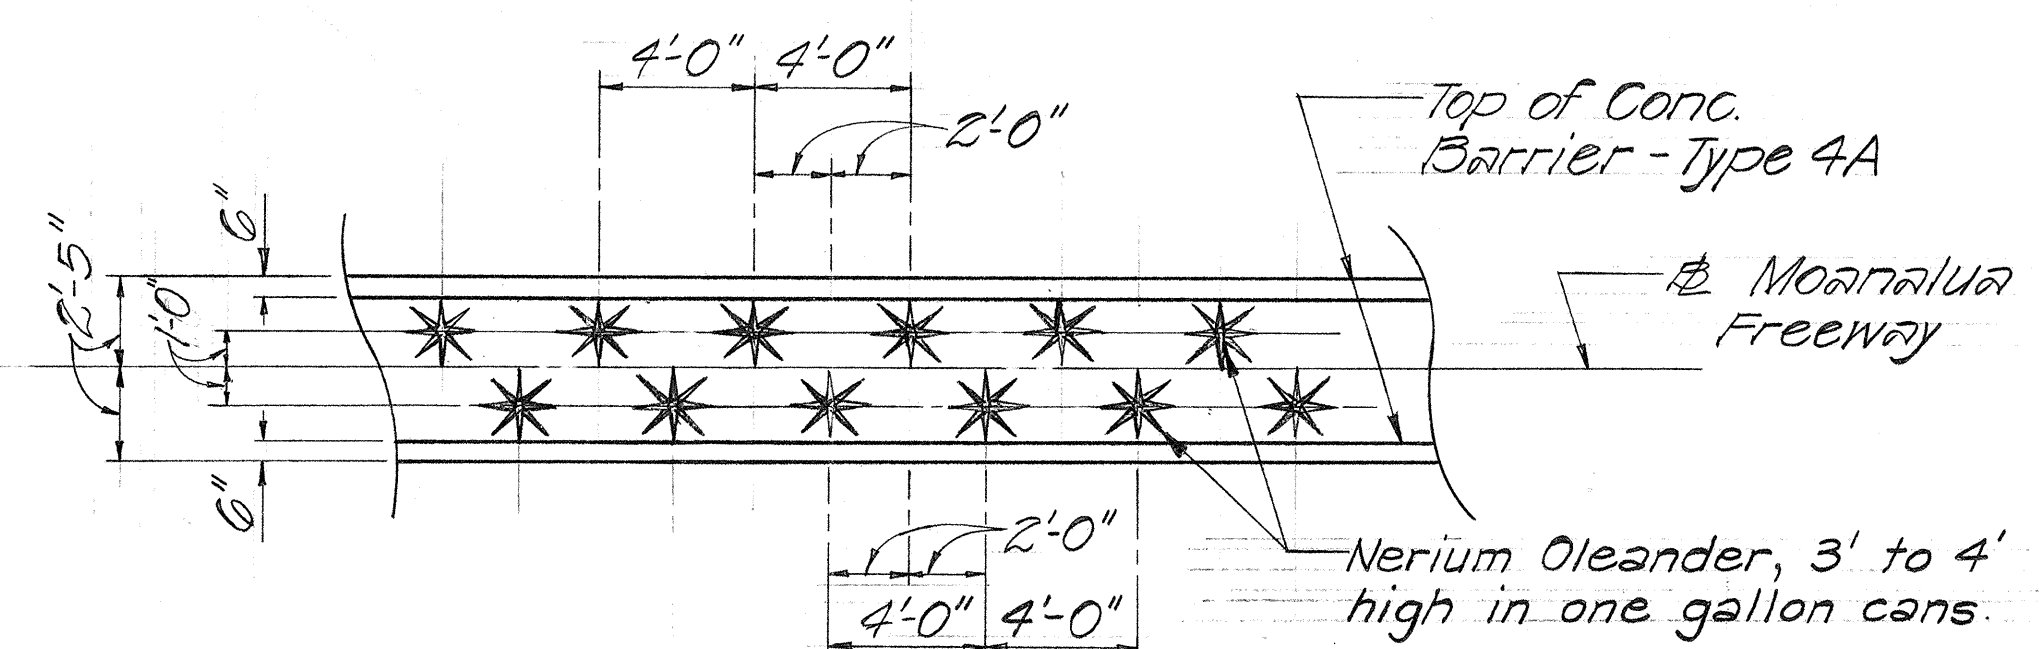

PLANTING DETAIL AT MEDIAN
Scale: 1"=5'

- NOTE**
1. Slope Control Planting on this project may require planting to be done in stages due to construction phasing and utilities relocation. See Section 643-Slope Control Planting of the SPECIAL PROVISIONS for slope control planting requirements.
 2. The Contractor's attention is directed to Subsection 203.02(A)(1) of the SPECIAL PROVISIONS in regard to planting as excavation is in progress.
 3. Location of trees planted shall not be closer than 10' from any utility except as approved by the Engineer.
 4. Dwarfed Lantana shall be 10" (minimum) high in one quart cans.

7/19/73	Other landscaping revisions by previous Contract Change Orders are not shown.
7/19/73	Additional planting of shrubs in the median.
DATE	REVISION

THIS SHEET SUPERSEDES
SHEET NO. 126

STATE OF HAWAII
DEPARTMENT OF TRANSPORTATION
HIGHWAYS DIVISION

LANDSCAPING

MOANALUA ROAD
F.A.P. Proj. No. F-078-1(7)



Scale: As Shown
SHEET NO. OF 3 SHEETS

C.O. ADD. 126

FED. ROAD DIST. NO.	STATE	FED. AID PROJ. NO.	FISCAL YEAR	SHEET NO.	TOTAL SHEETS
HAWAII	HAW.	F-078-1(7)	1971	127	302

REVISED: July 13, 1971

LEGEND

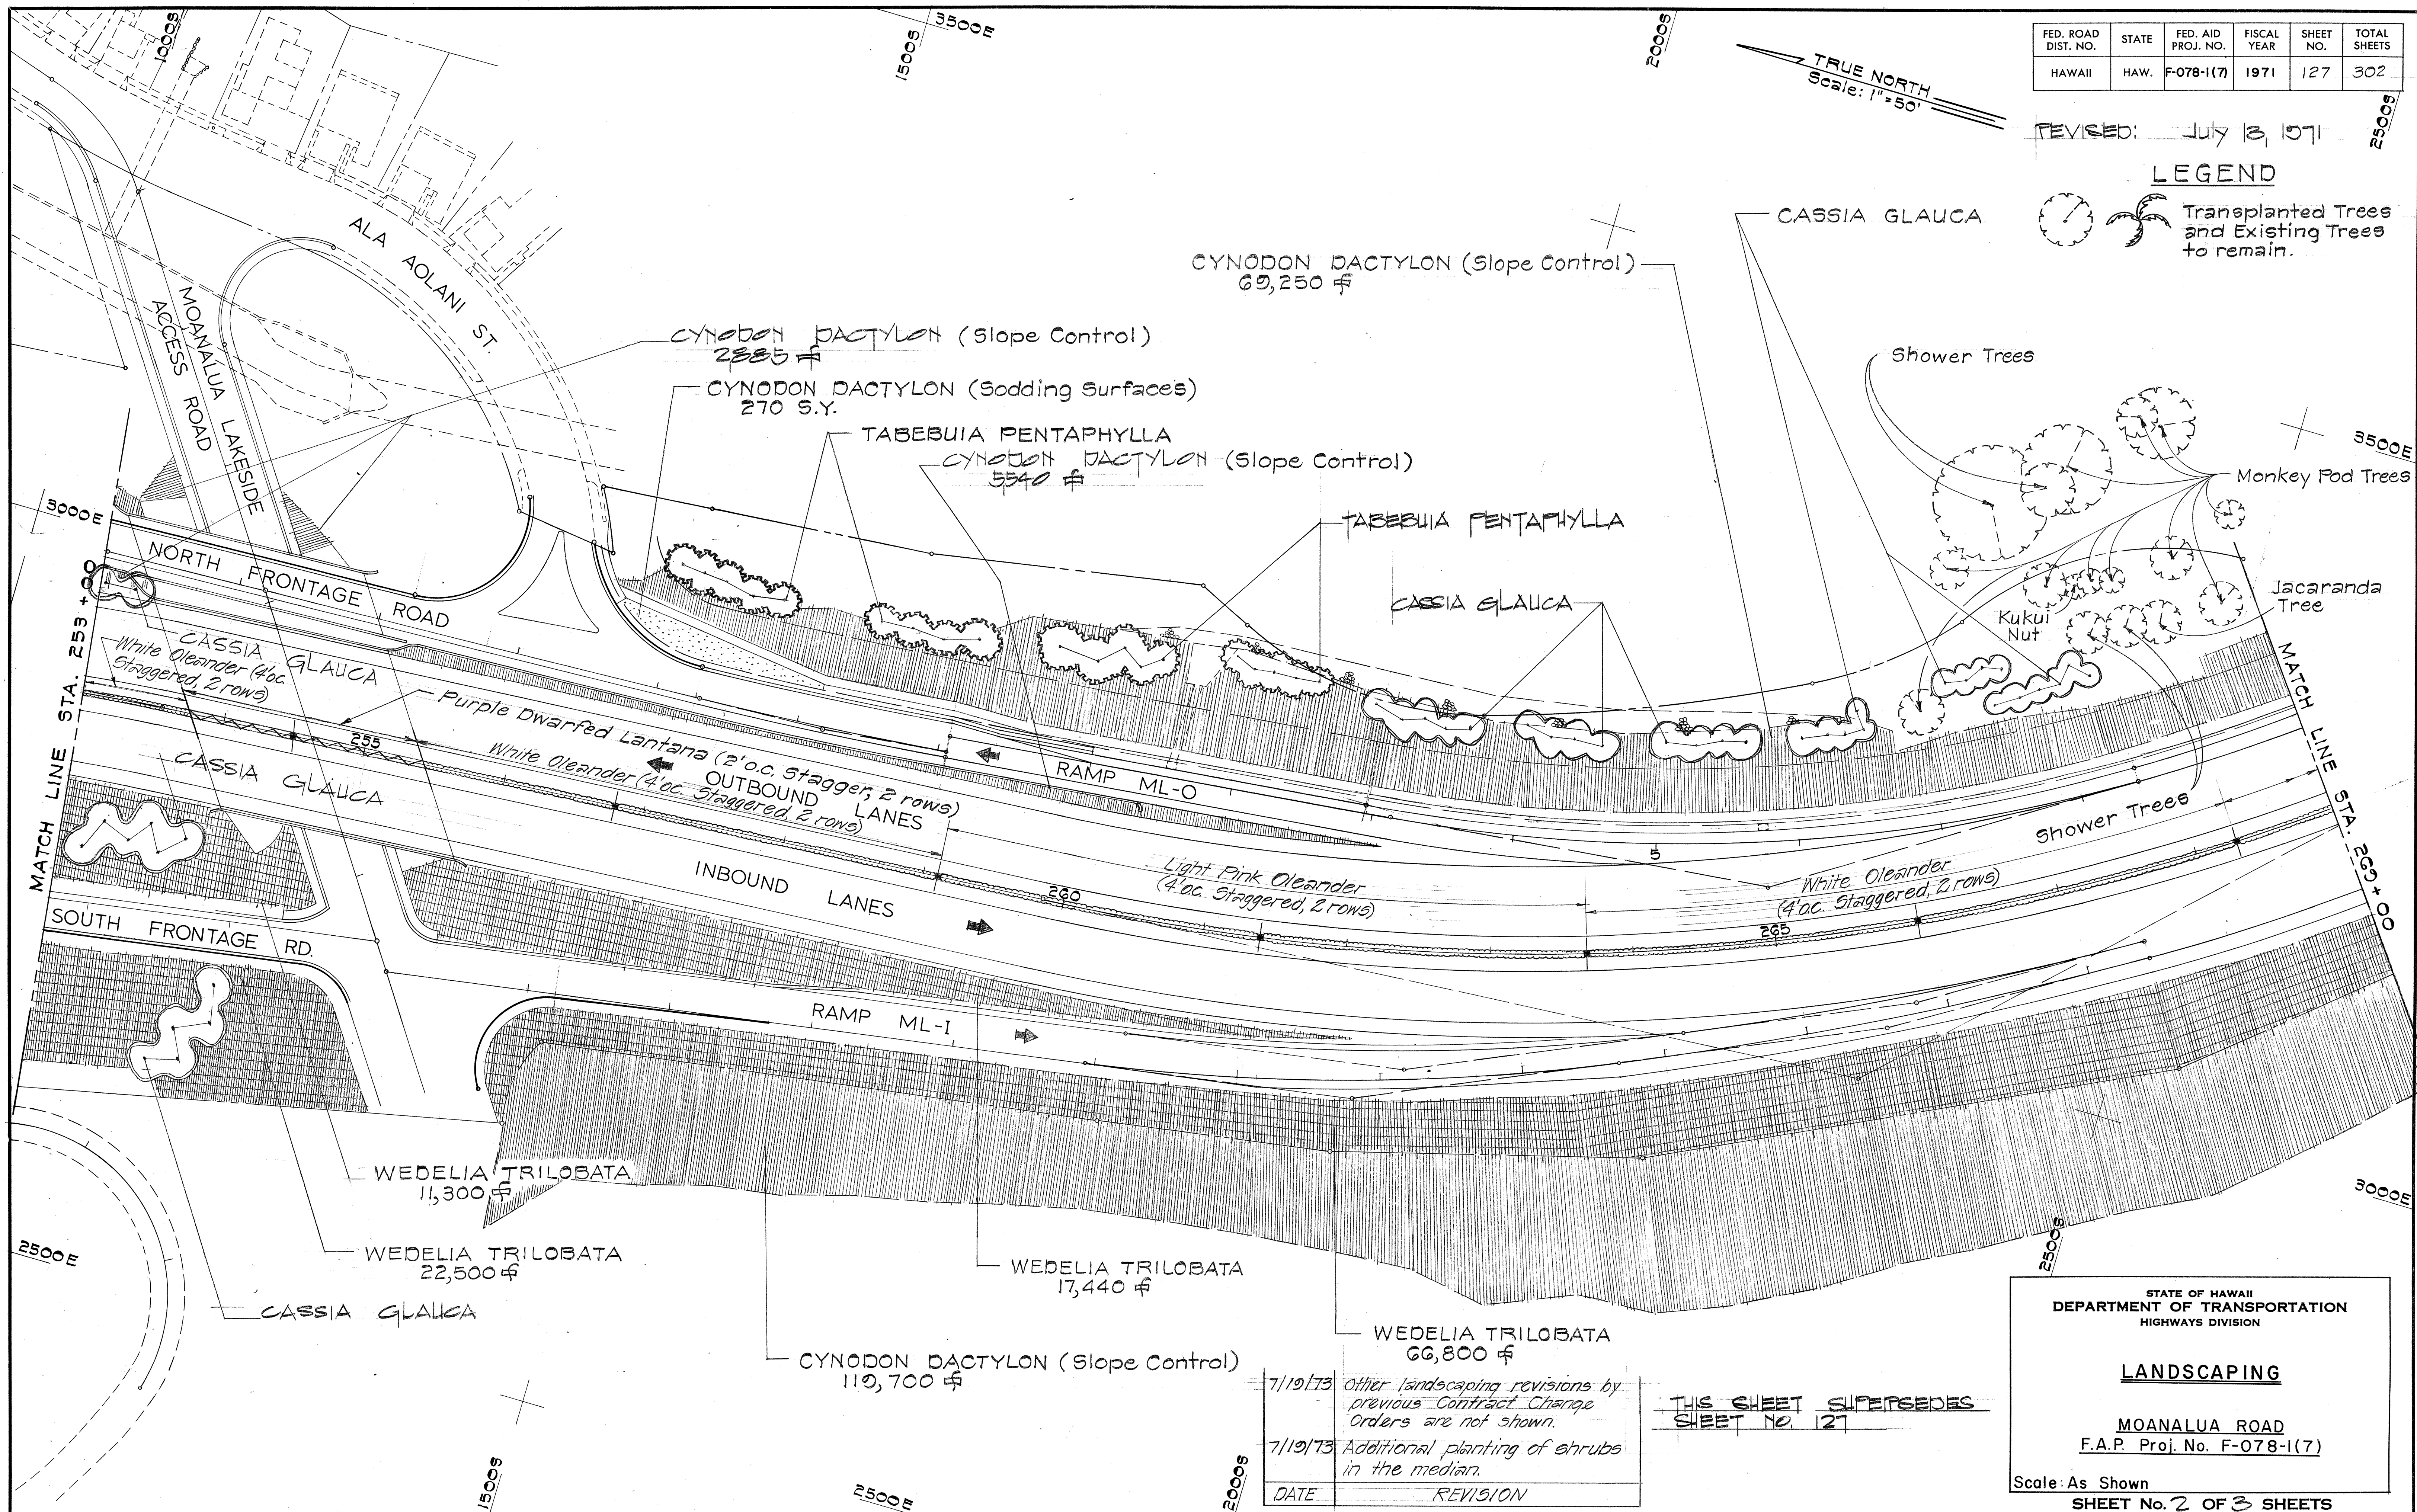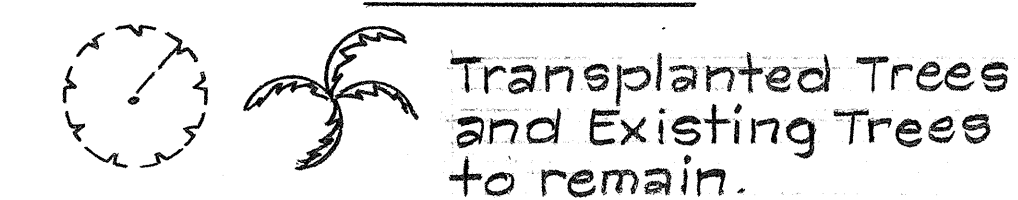

DATE	REVISION
7/19/73	Other landscaping revisions by previous Contract Change Orders are not shown.
7/19/73	Additional planting of shrubs in the median.

THIS SHEET SUPERSEDES SHEET NO. 127

STATE OF HAWAII
DEPARTMENT OF TRANSPORTATION
HIGHWAYS DIVISION

LANDSCAPING

MOANALUA ROAD
F.A.P. Proj. No. F-078-1(7)

Scale: As Shown
SHEET No. 2 OF 3 SHEETS

C.O. ADD. 127

SURVEY PLOTTED BY	DATE
DRAWN BY	
CHECKED BY	
NOTE BOOK	
No.	

TRUE NORTH
Scale: 1"=50'

2500S
4000E

3000S

LEGEND
Transplanted Trees and Existing Trees to remain.

FED. ROAD DIST. NO.	STATE	FED. AID PROJ. NO.	FISCAL YEAR	SHEET NO.	TOTAL SHEETS
HAWAII	HAW.	F-078-1(7)	1971	128	302

REVISED: July 13, 1971

4500E

7/19/73 Other landscaping revisions by previous Contract Change Orders are not shown.


7/19/73 Additional planting of shrubs in the median.

DATE	REVISION
------	----------

3500E

MATCH LINE STA. 269+00

4000E
4000S

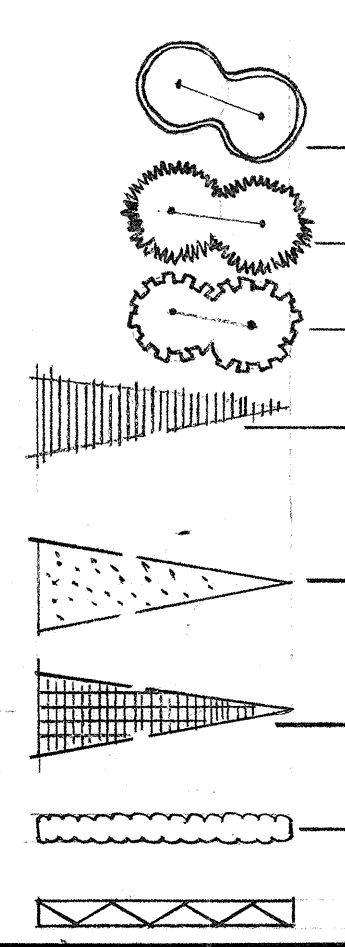

TOTAL PLANT LIST		
BOTANICAL NAME	COMMON NAME	QUANTITY
CASSIA GLAUCA	KALAMONA	73 ea.
THEVETIA PERUVIANA	BE-STILL	13 ea.
TABEBA PENTAPHYLLA	PINK TECOMA	28 ea.
CYNODON DACTYLON (Slope Control)	BERMUDA GRASS	314,300 f
CYNODON DACTYLON * (Sodding Surfaces)	BERMUDA GRASS	355 s.y.
WEDELIA TRILOBATA	WEDELIA	306,630 f
NERIUM OLEANDER	OLEANDER { Pink White	1130 ea. 276 ea.
LANTANA SELLOWIANA	DWARFED LANTANA (Purple)	125 ea.

C.C.O. #34
CYNODON DACTYLON (Slope Control)
8,250 f

White Oleander (4' oc. Staggered, 2 rows)

Light Pink Oleander (4' oc. Staggered, 2 rows)

Light Pink Oleander (2' oc. single row)

WEDELIA TRILOBATA
21,910 f

PLANT BOUGANVILLEA
WEDELIA TRILOBATA
6,920 f
C.C.O. #34

* For additional sodding surfaces refer to Plan Sheet No. 54.

THIS SHEET SUPERSEDES SHEET No. 128

STATE OF HAWAII
DEPARTMENT OF TRANSPORTATION
HIGHWAYS DIVISION

LANDSCAPING

MOANALUA ROAD
F.A.P. Proj. No. F-078-1(7)

Scale: As Shown
SHEET No. 3 OF 3 SHEETS

C.O. ADD. 128