

FED. ROAD DIST. NO.	STATE	FED. AID PROJ. NO.	FISCAL YEAR	SHEET NO.	TOTAL SHEETS
HAWAII	HAW.	F-078-1(7)	1971	C.O. ADD.129	302

Revised: July 20, 1971
 Δ Sept. 30, 1971
 Δ July 14, 1972

LEGEND AND SPRINKLER HEAD SPECIFICATIONS

SYMBOL	NUMBER	TYPE	P.S.I.	RADIUS	G.P.M.	RISER
◆	J-20	Jet Sprinkler Part Circle 1/8" Nozzle w/Deflector	35	20'	2.8	1/2" I.P.S.
◊	J-30	Jet Sprinkler Part Circle 1/4" Nozzle	35	30'	3.6	1/2" I.P.S.
◈	J-40	Jet Sprinkler Part Circle 3/8" Nozzle	40	30'	4.6	1/2" I.P.S.
▽	J-50	Jet Sprinkler Part Circle 1/2" Nozzle	50	47'	7.2	3/4" I.P.S.
⊗		Remote Control Valve 1/2" Type A Valve Box				
⊙		Atmospheric Vacuum Breaker				
⊠		Water Meter (Furnished & Installed by B.W.S.)				
⊞		Valve and Valve Box				
●	S-10F	Shrubbery Sprinkler Full Circle	20	10'	3.2	1/2" I.P.S.
○	S-10H	Shrubbery Sprinkler Half Circle	20	10'	2.5	1/2" I.P.S.
—		Nozzle, 5/16" x 24 NF Male Thread	15	4'	0.3	
⊙	S-15F	Shrubbery Sprinkler Full Circle, Stream Spray type	20	14'	1.7	1/2" I.P.S.

NOTE: 1. "Pressure" is the minimum pressure in pounds per square inch, which is available at the base of the last head. The operating pressure of acceptable heads must not exceed this value when operating at the tabulated flow and radius.

2. "Radius of Coverage" is the minimum radius at the tabulated pressure.

3. "Flow" is the maximum flow, in gallons per minute, which is discharged at the tabulated pressure.

4. Jet sprinkler shall be brass construction, except for springs and washers. Nozzles shall be brass. Corrosion resistant Stainless Steel construction will be acceptable & preferred over brass construction.

5. Remote Control Valves shall operate at the following minimum discharge for the size indicated.

Size	1	1 1/4	1 1/2	2	2 1/2
G.P.M.	15	20	40	60	80

GENERAL NOTES:

- Final location of Meter, Remote Control Valves and Vacuum Breakers shall be determined by the Engineer.
- Unless otherwise called for or directed by the Engineer, the center line of the feeder pipe shall be located 3" from the back of curbs or 12" from the fence line or guard rail post or edge of slope.
- When the consumers water service will be interrupted the Contractor shall notify each consumer and the Board of Water Supply concerning the time and the duration of the shut-down.
- See Sht. No. 177 for Water General Notes.


Δ 5. For all pipes 3" or larger provide concrete reaction blocks at all bends and tees.

Δ 6. Minimum cover (top of pipe to finish grade) for 4" pipe shall be 2'-6".

ELECTRICAL GENERAL NOTES:

- Direct burial lines shall be laid parallel with sprinkler feeder line in common trench where possible.
- PVC conduits under roadway shall have a minimum cover of 2 feet.

BEG. OF PROJECT (Δ STA 239+00)
 F.A.P. Proj. No. F-078-1(7)

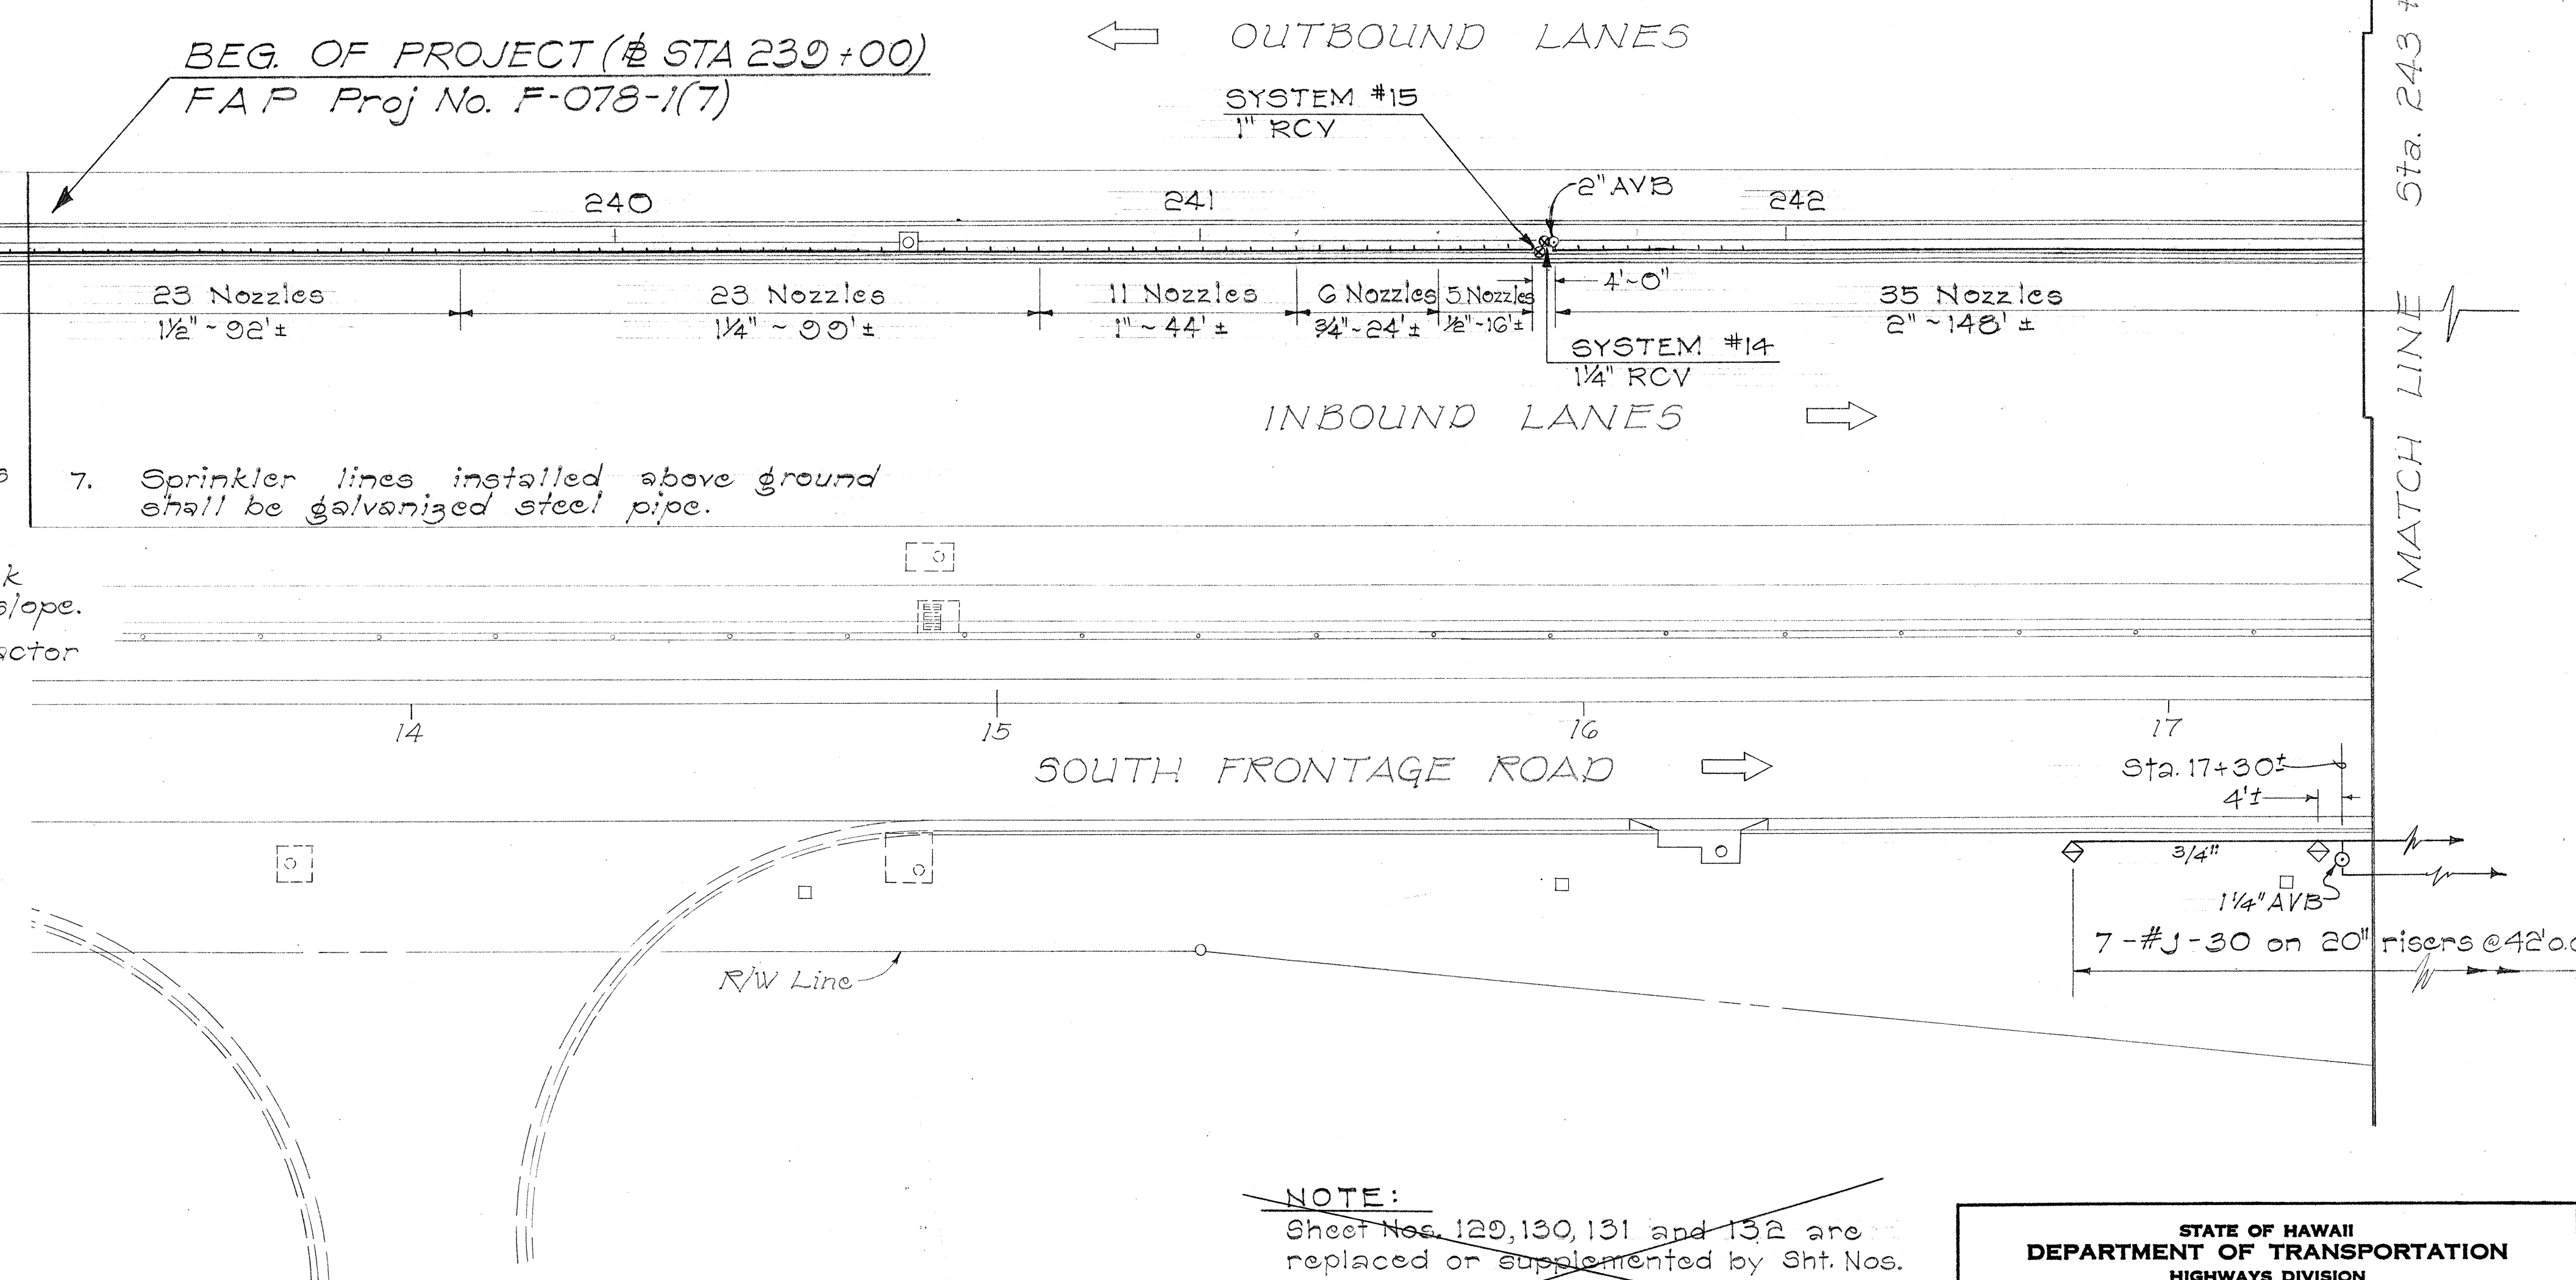

NOTE:

Sheet Nos. 129, 130, 131 and 132 are replaced or supplemented by Sht. Nos. ADD.129, ADD.130, ADD.131, ADD.131 S-1 to ADD.131 S-7 and ADD.132.

This sht. replaces sht. no. 129

Δ THIS SHEET SUPERSEDES SHEET NO. ADD.129

Δ THIS SHEET SUPERSEDES SHT. NO. C.O. ADD.130

CCO #50	Added S-15F to Legend & Sprinkler Specifications
5-21-73	Add Systems No. 14 & 15. Add Notes to Legend & Sprinkler Specification.
DATE	REVISION

STATE OF HAWAII
 DEPARTMENT OF TRANSPORTATION
 HIGHWAYS DIVISION
SPRINKLER SYSTEM
 (Sta. 239+00 to Sta. 243+00)
 MOANALUA ROAD
 (Ala Aolani To Puuloa Interchange)
 F.A.P. PROJECT NO. F-078-1(7)

Scale: 1" = 20' Date: July, 1971



SHEET No. 1 OF 11 SHEETS

C.O. ADD. 129


DESIGNED BY	DATE
CHECKED BY	
NOTED BY	
ORIGINAL	
PLAN	
NOTE BOOK	
NO.	

FED. ROAD DIST. NO.	STATE	FED. AID PROJ. NO.	FISCAL YEAR	SHEET NO.	TOTAL SHEETS
HAWAII	HAW.	F-078-117	1971	ADD.130	302

Revised: July 20, 1971

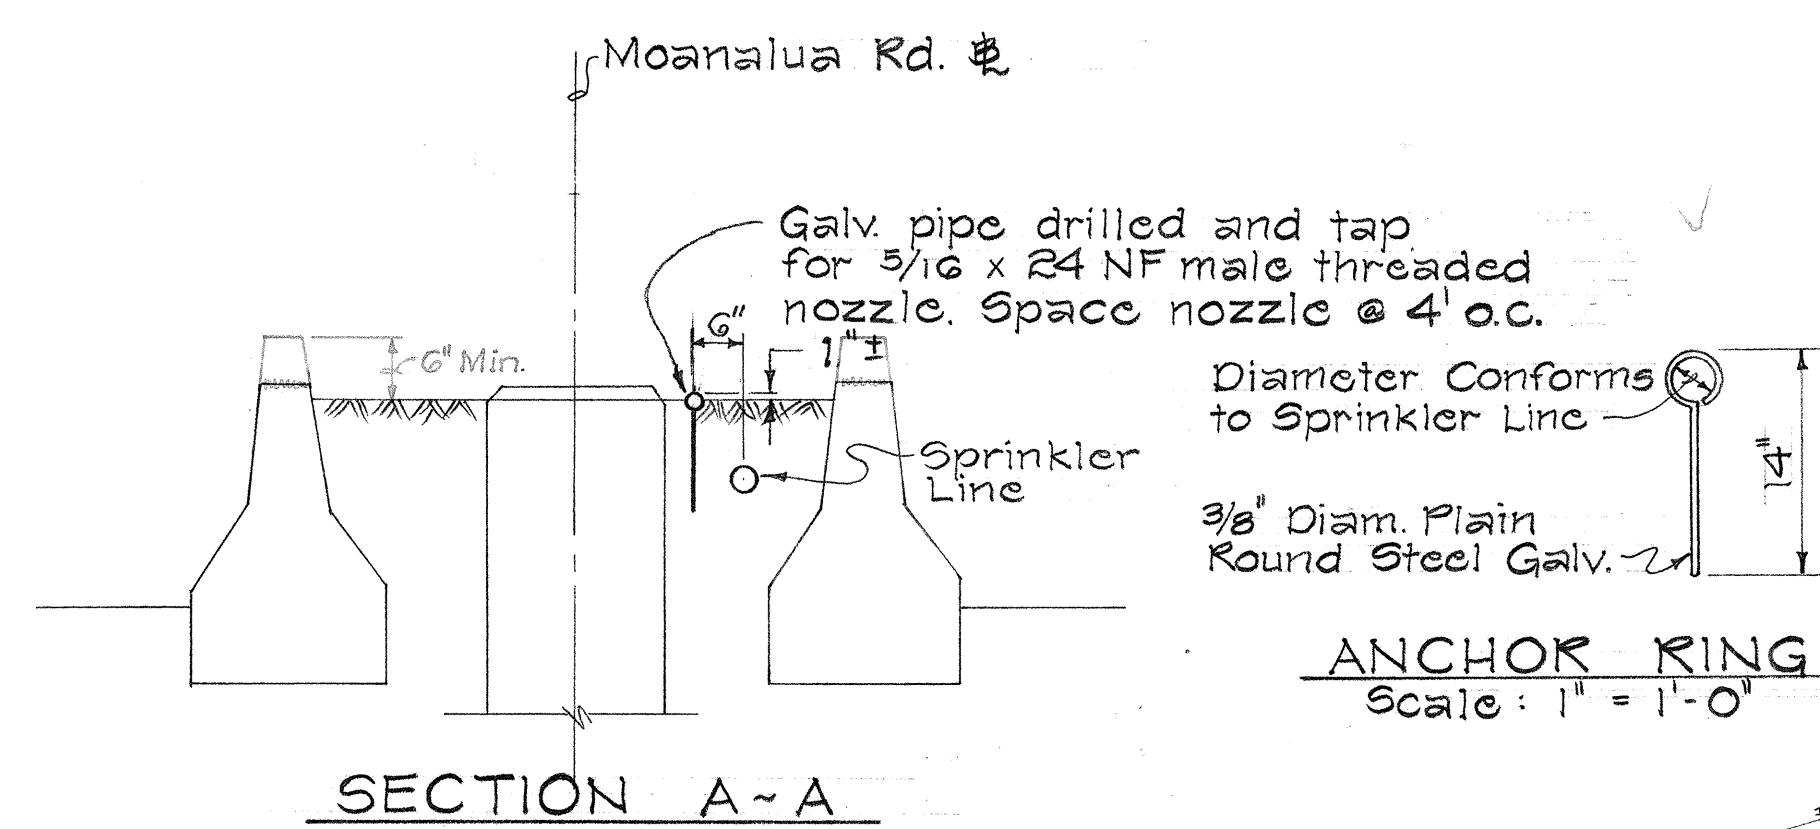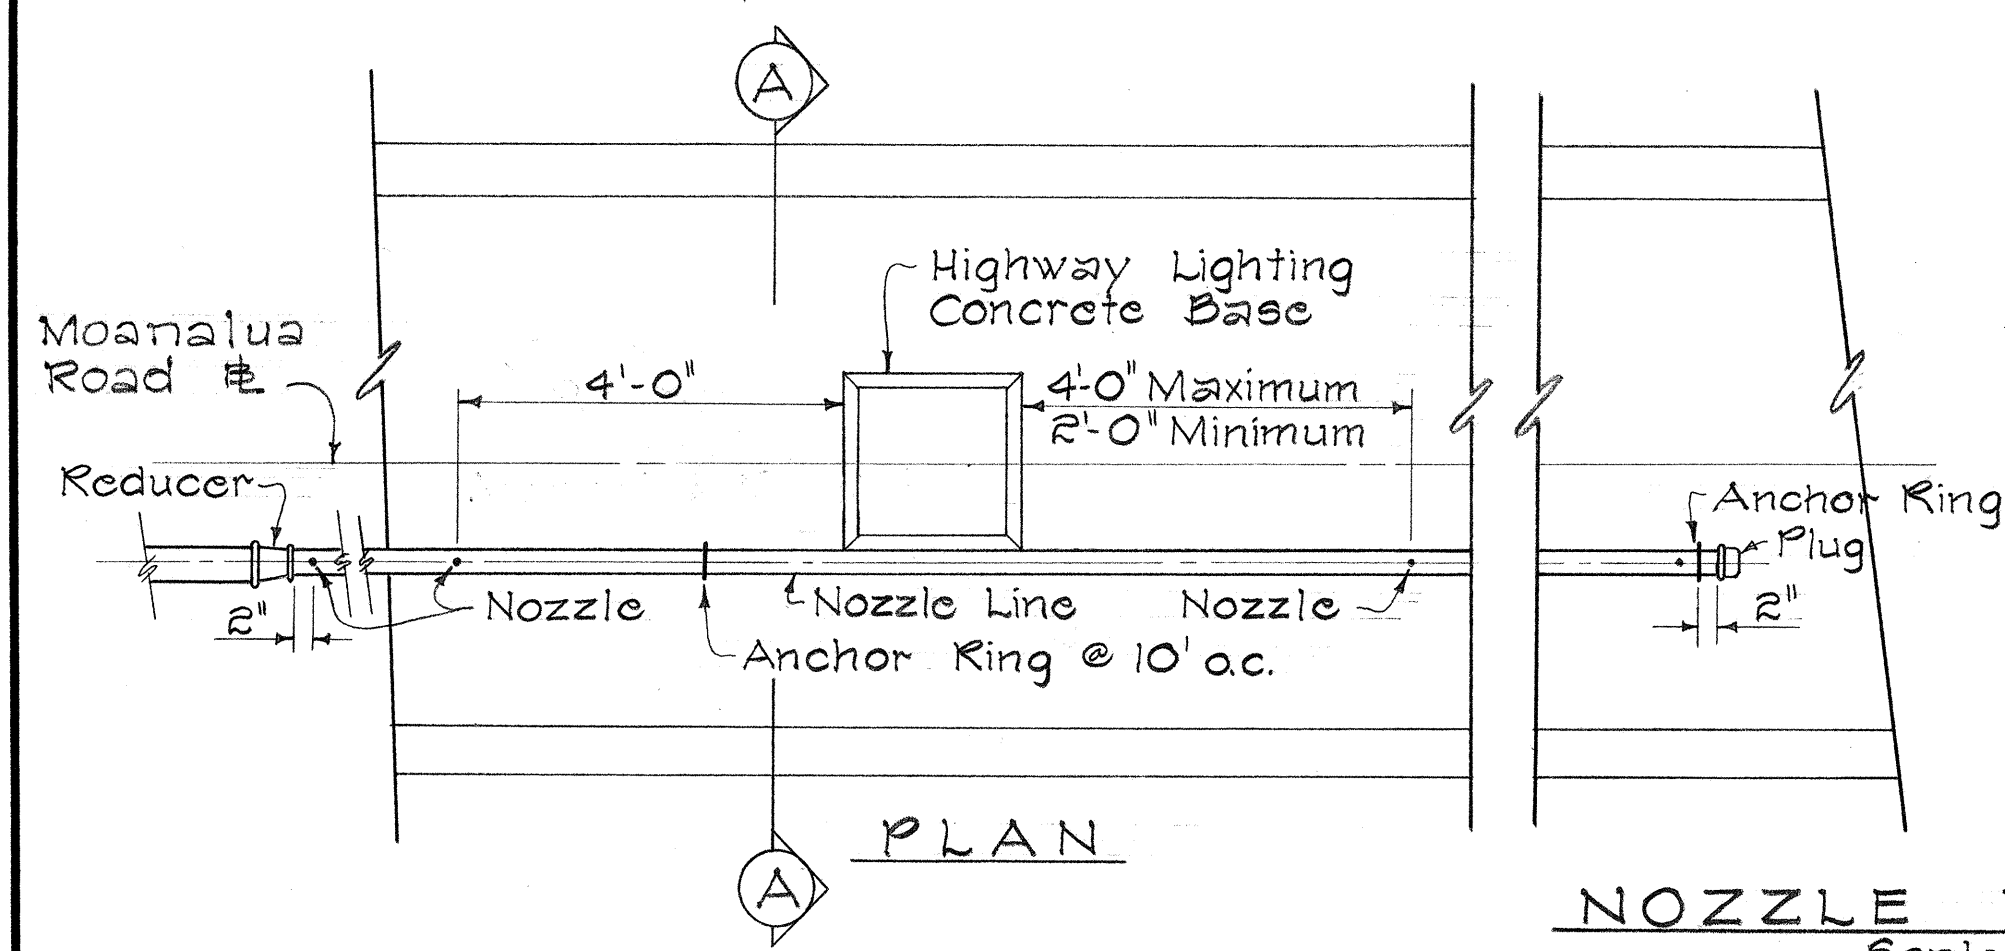

NOZZLE LINE LAYOUT
Scale: 1/2" = 1'-0"

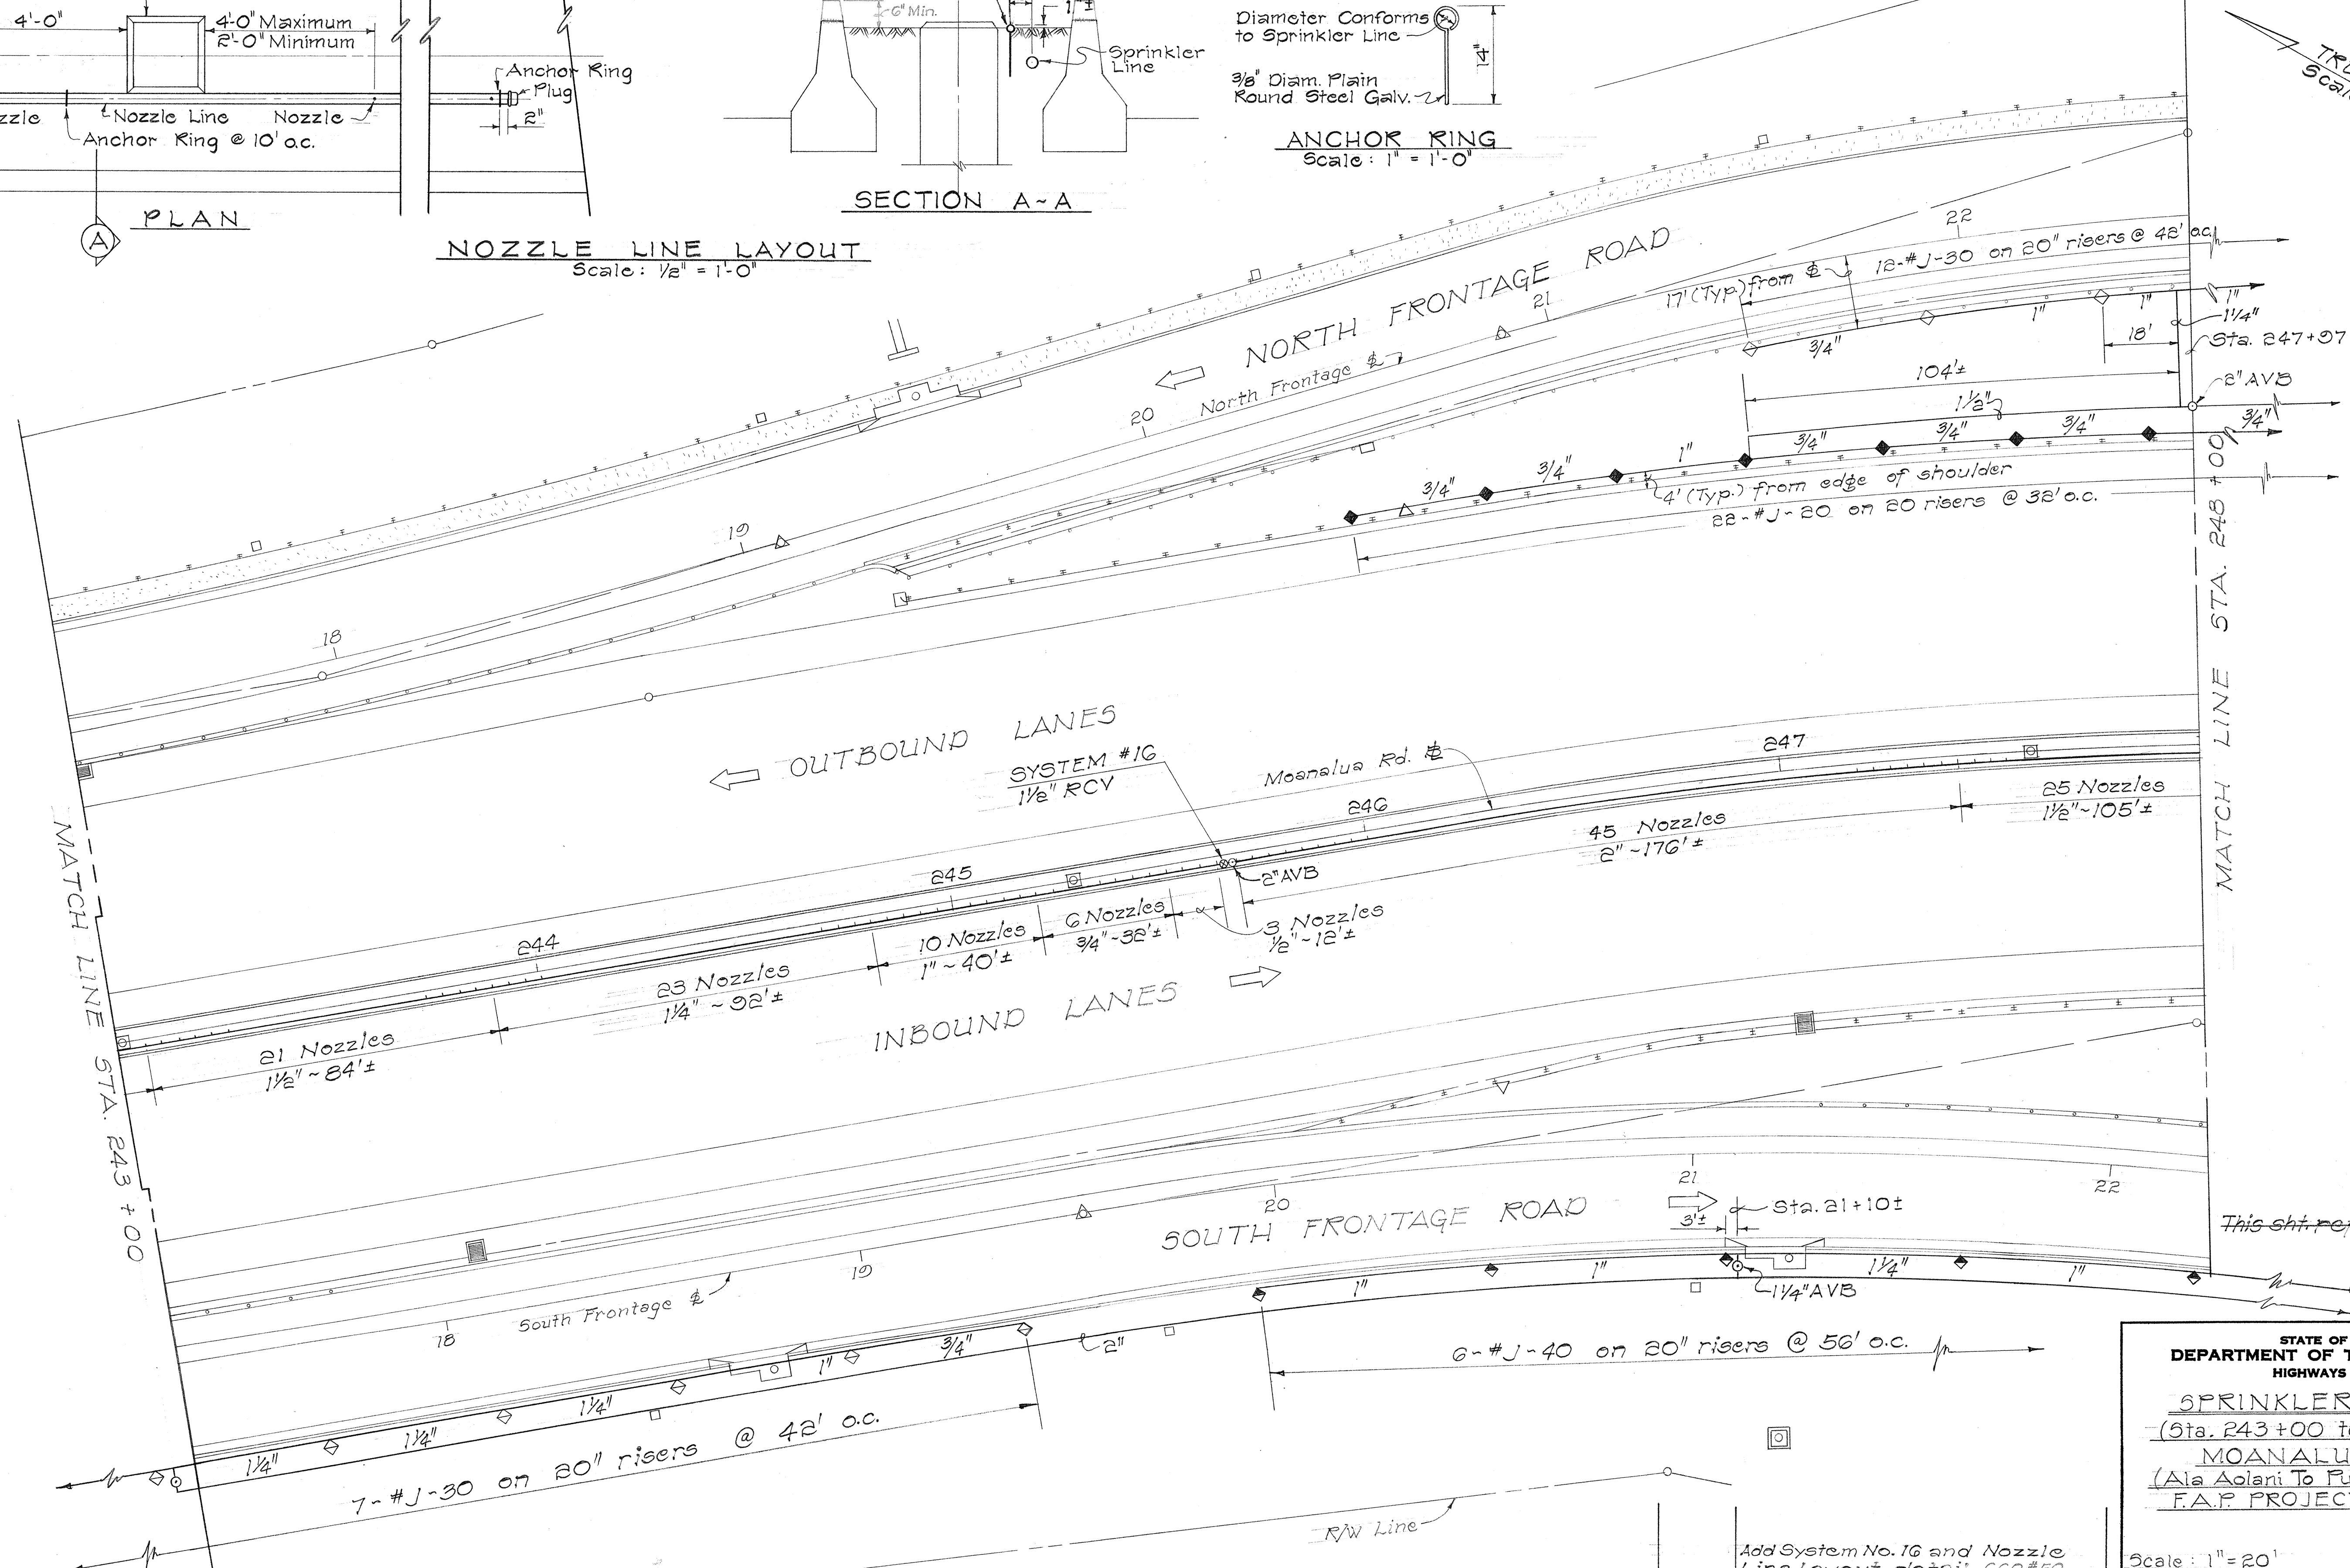

STATE OF HAWAII
DEPARTMENT OF TRANSPORTATION
HIGHWAYS DIVISION

SPRINKLER SYSTEM
(Sta. 243+00 to Sta. 248+00)
MOANALUA ROAD
(Aiea Aieani To Puuloa Interchange)
F.A.P. PROJECT NO. F-078-117

Scale: 1" = 20' Date: July 1971



SHEET No. 2 OF 11 SHEETS

C.O. ADD. 130

DESIGNED BY	DATE
CHECKED BY	
NOTED BY	
APPROVED BY	

Revised: July 20, 1971
 Sept. 30, 1971
 July 14, 1972

FED. ROAD DIST. NO.	STATE	FED. AID PROJ. NO.	FISCAL YEAR	SHEET NO.	TOTAL SHEETS
HAWAII	HAW.	F-078-1(7)	1971	C.O. ADD. 131	302

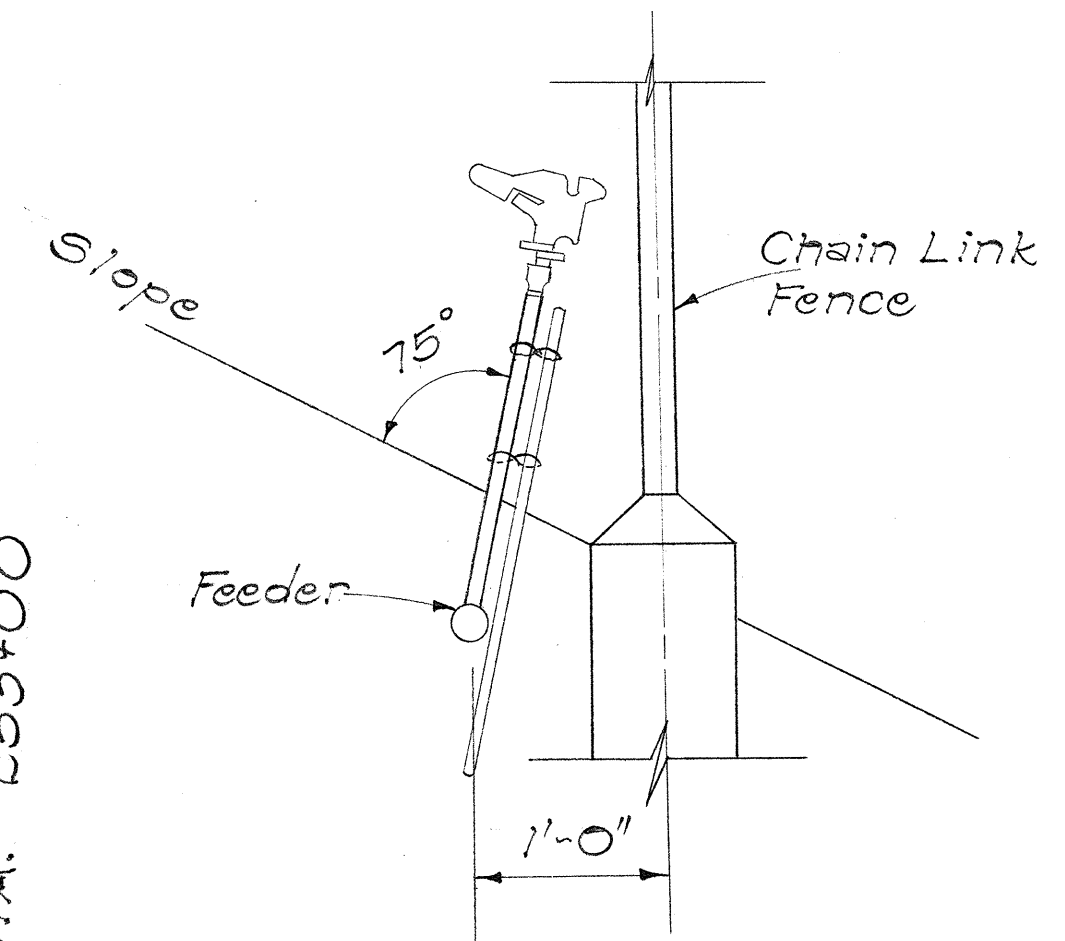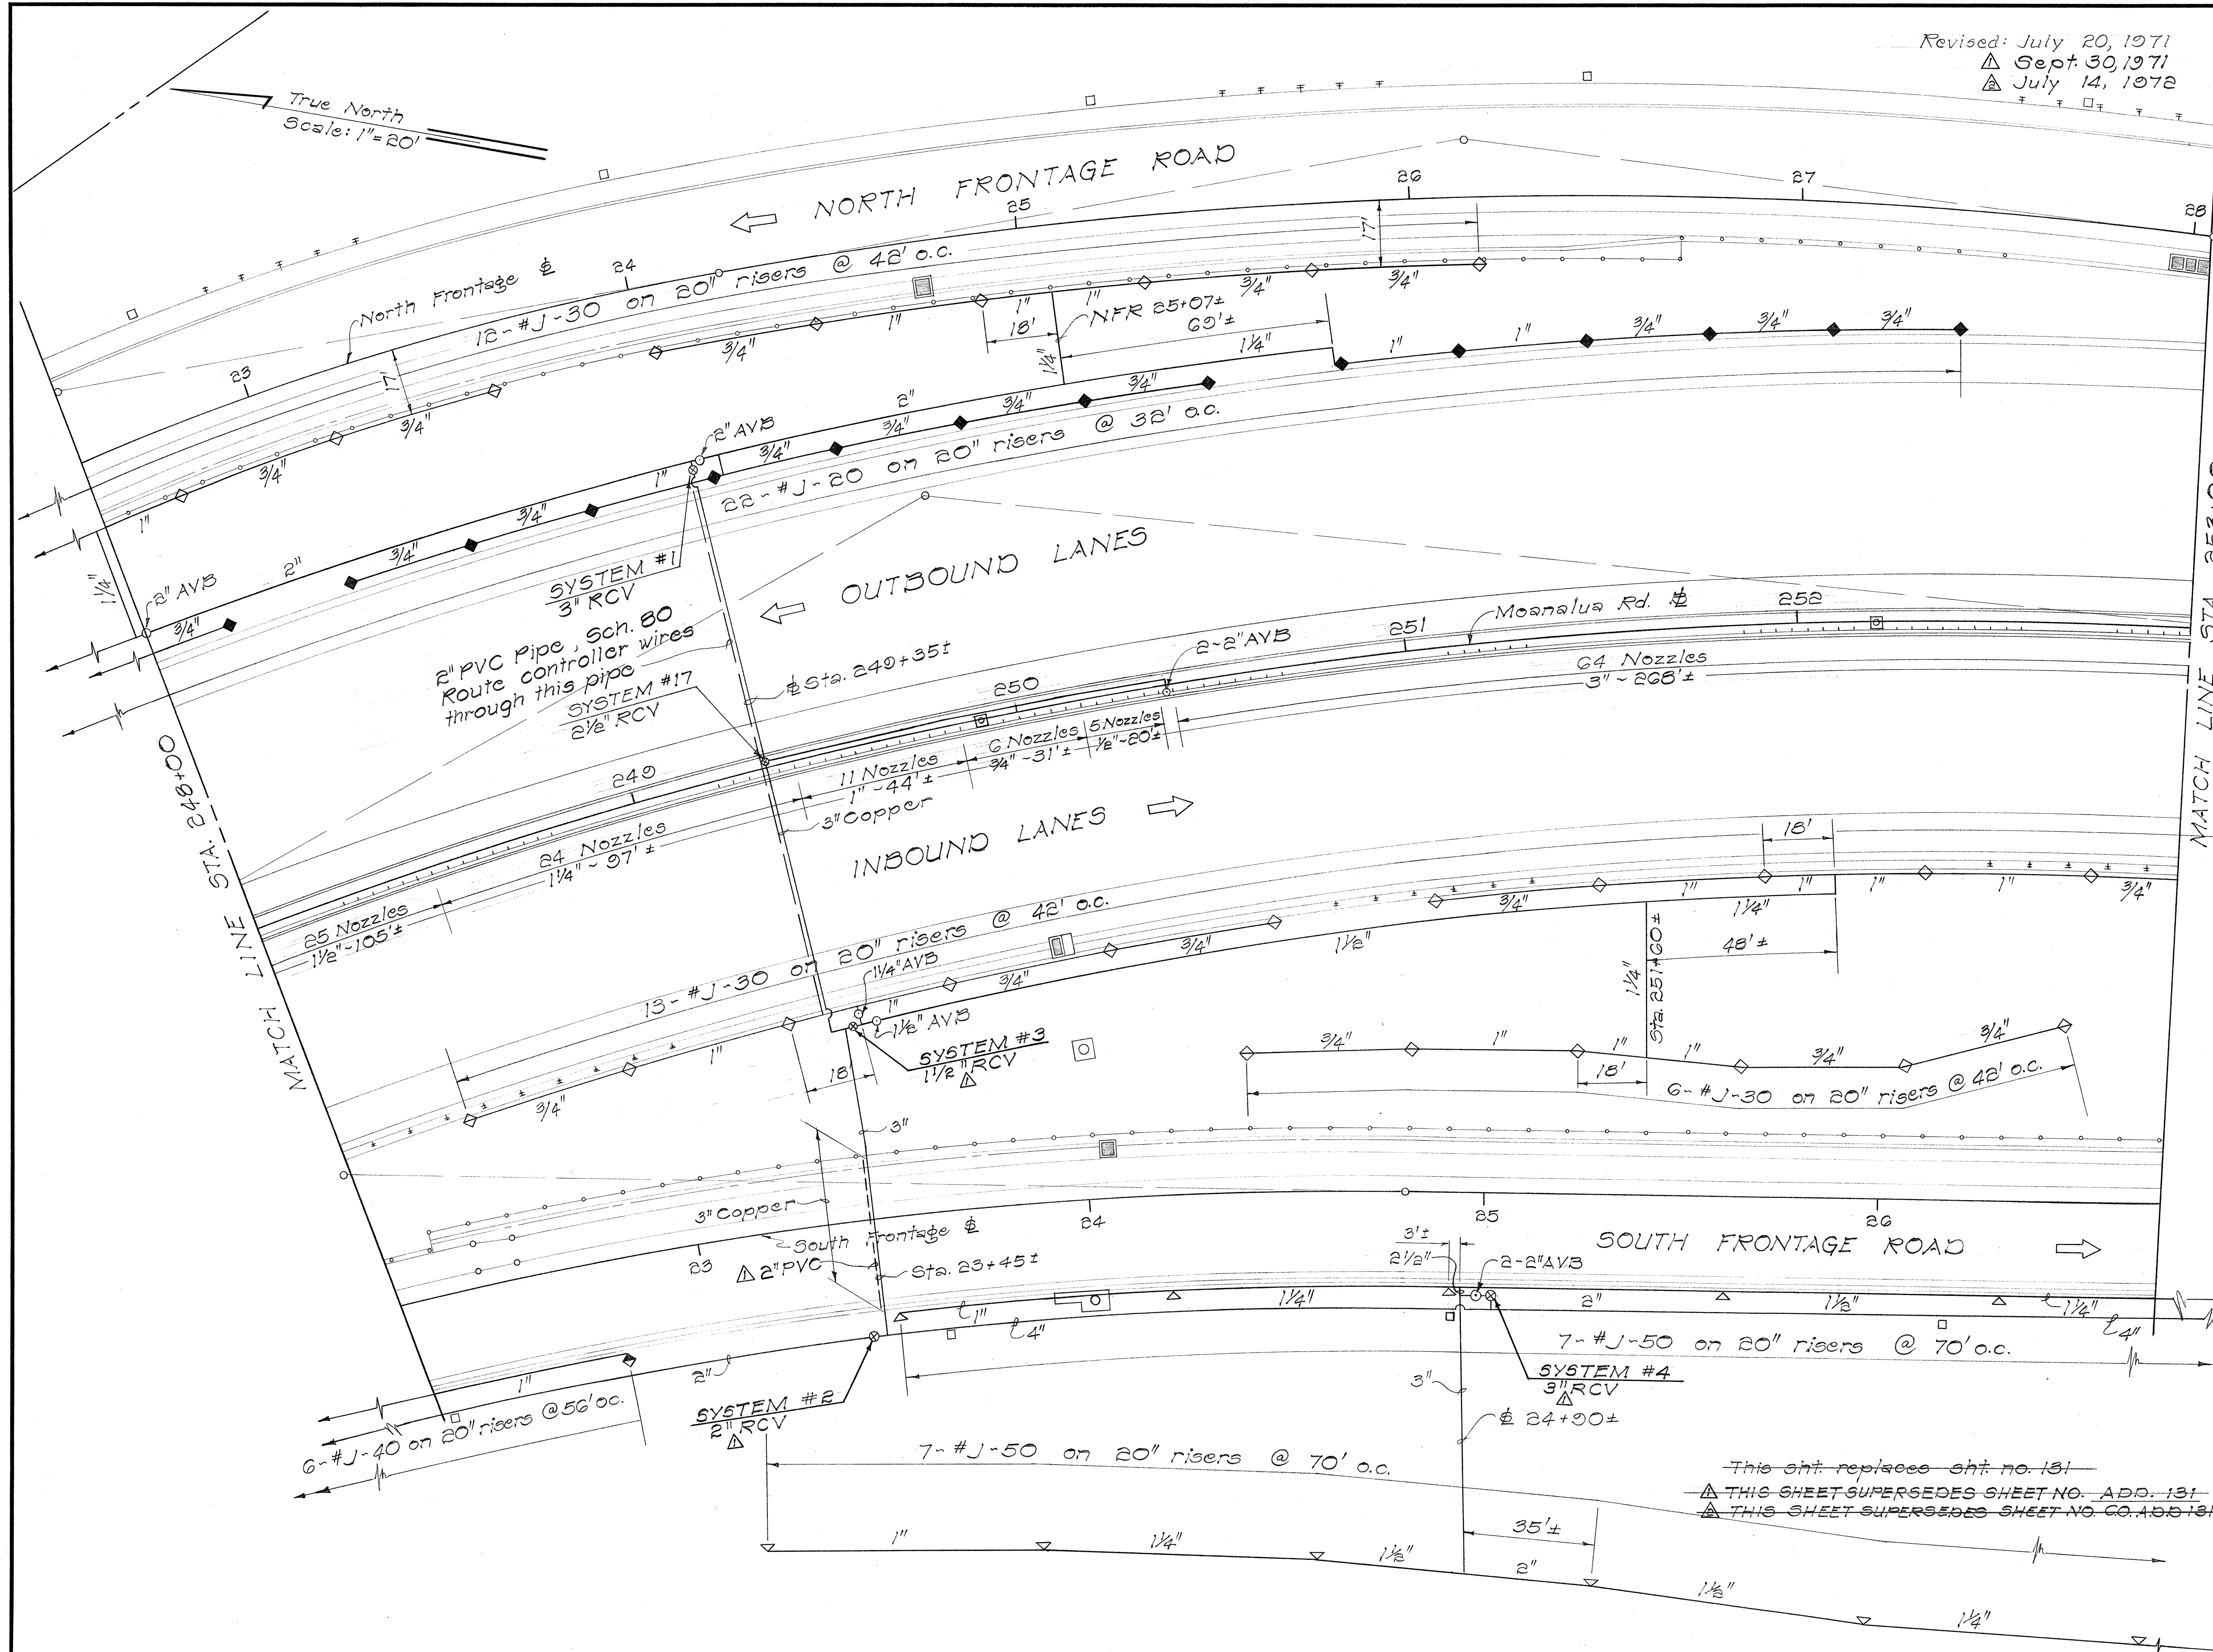

TYPICAL SECTION AT FENCE
 ALONG NORTH FRONTAGE RD.
 Scale: 1" = 1'-0"

DESIGNED BY	DATE
DRAWN BY	
CHECKED BY	
NOTED BY	
NO.	

DATE	REVISION
	Add System No. 17 moved RCV for System No. 1 CCO #50
STATE OF HAWAII DEPARTMENT OF TRANSPORTATION HIGHWAYS DIVISION SPRINKLER SYSTEM (Sta. 248+00 to Sta. 253+00) MOANALUA ROAD (Aia Aolani To Puuloa Interchange) F.A.P. PROJECT NO. F-078-1(7)	
Scale: 1" = 20' Date: July 1971 SHEET No. 3 OF 11 SHEETS	


This sheet replaces sheet no. 131
 THIS SHEET SUPERSEDES SHEET NO. ADD. 131
 THIS SHEET SUPERSEDES SHEET NO. CO. ADD. 131

FED. ROAD DIST. NO.	STATE	FED. AID PROJ. NO.	FISCAL YEAR	SHEET NO.	TOTAL SHEETS
HAWAII	HAW.	F-078-1(7)	1971	C.O. ADD. 131 S-1	302

Revised: July 20, 1971
 Sept. 30, 1971
 July 14, 1972

NOTE:
 1. For detail of Type "B" Pullbox see sht. 138
 2. Minimum cover for PVC Conduit 3'-0"

TRUE NORTH
 Scale: 1" = 20'

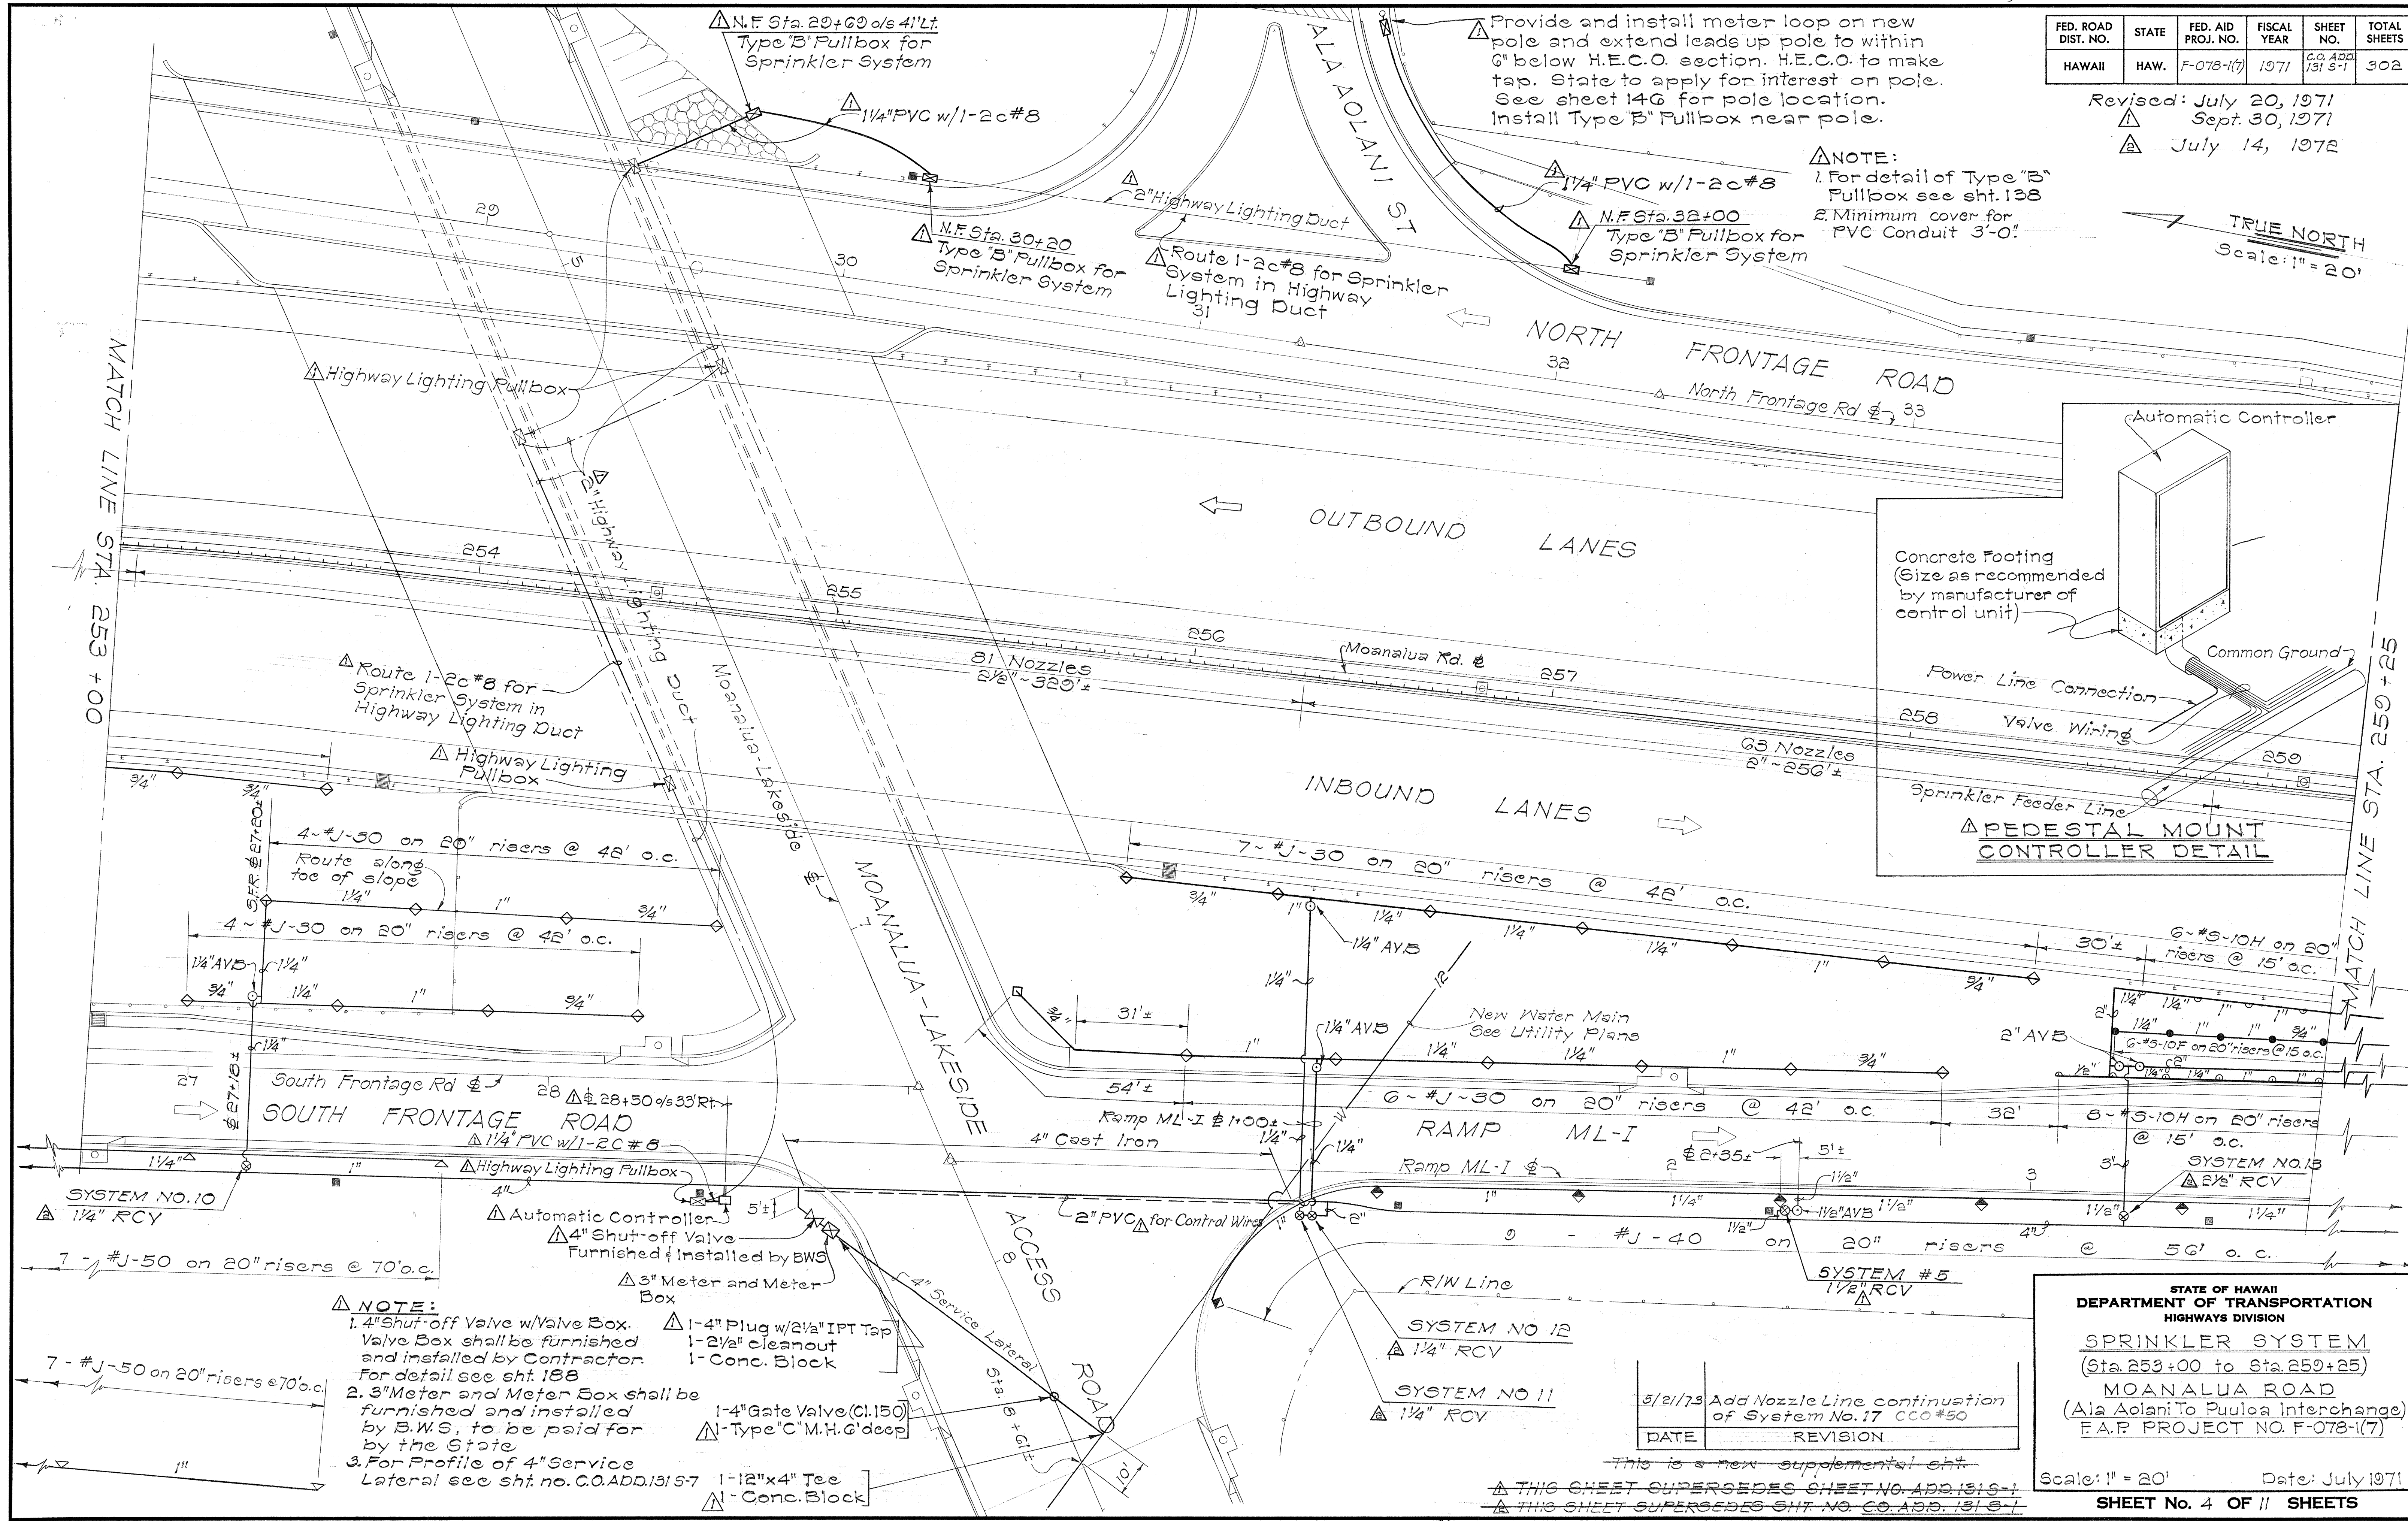

NOTE:

1. 4" Shut-off Valve w/Valve Box. Valve Box shall be furnished and installed by Contractor. For detail see sht. 138
2. 3" Meter and Meter Box shall be furnished and installed by B.W.S. to be paid for by the State
3. For Profile of 4" Service Lateral see sht. no. C.O. ADD. 131 S-7
- 1-4" Plug w/2 1/2" IPT Tap
- 1-2 1/2" cleanout
- 1-Conc. Block
- 1-4" Gate Valve (Cl. 150)
- 1-Type "C" M.H.G' deep
- 1-12"x4" Tee
- 1-Conc. Block

STATE OF HAWAII
 DEPARTMENT OF TRANSPORTATION
 HIGHWAYS DIVISION

SPRINKLER SYSTEM

(Sta. 253+00 to Sta. 250+25)

MOANALUA ROAD

(Aia Aolani To Puuloa Interchange)

F.A.P. PROJECT NO. F-078-1(7)

Scale: 1" = 20' Date: July 1971

SHEET No. 4 OF 11 SHEETS

C.O. ADD. 131 S-1

3/21/73	Add Nozzle Line continuation of System No. 17 C.O. #50
DATE	REVISION


THIS SHEET SUPERSEDES SHEET NO. ADD. 131 S-1
 THIS SHEET SUPERSEDES SHEET NO. C.O. ADD. 131 S-1

SURVEY PLOTTED BY	DATE
DRAWN BY	
DESIGNED BY	
QUANTITIES BY	
CHECKED BY	
ORIGINAL PLAN	
NOTE BOOK	
No.	

FED. ROAD DIST. NO.	STATE	FED. AID PROJ. NO.	FISCAL YEAR	SHEET NO.	TOTAL SHEETS
HAWAII	HAW.	F-078-1(7)	1971	C.O. ADD. 131 S-2	302

Revised: July 20, 1971
 ▲ Sept. 30, 1971
 ▲ July 14, 1972

TRUE NORTH
 Scale: 1" = 20'

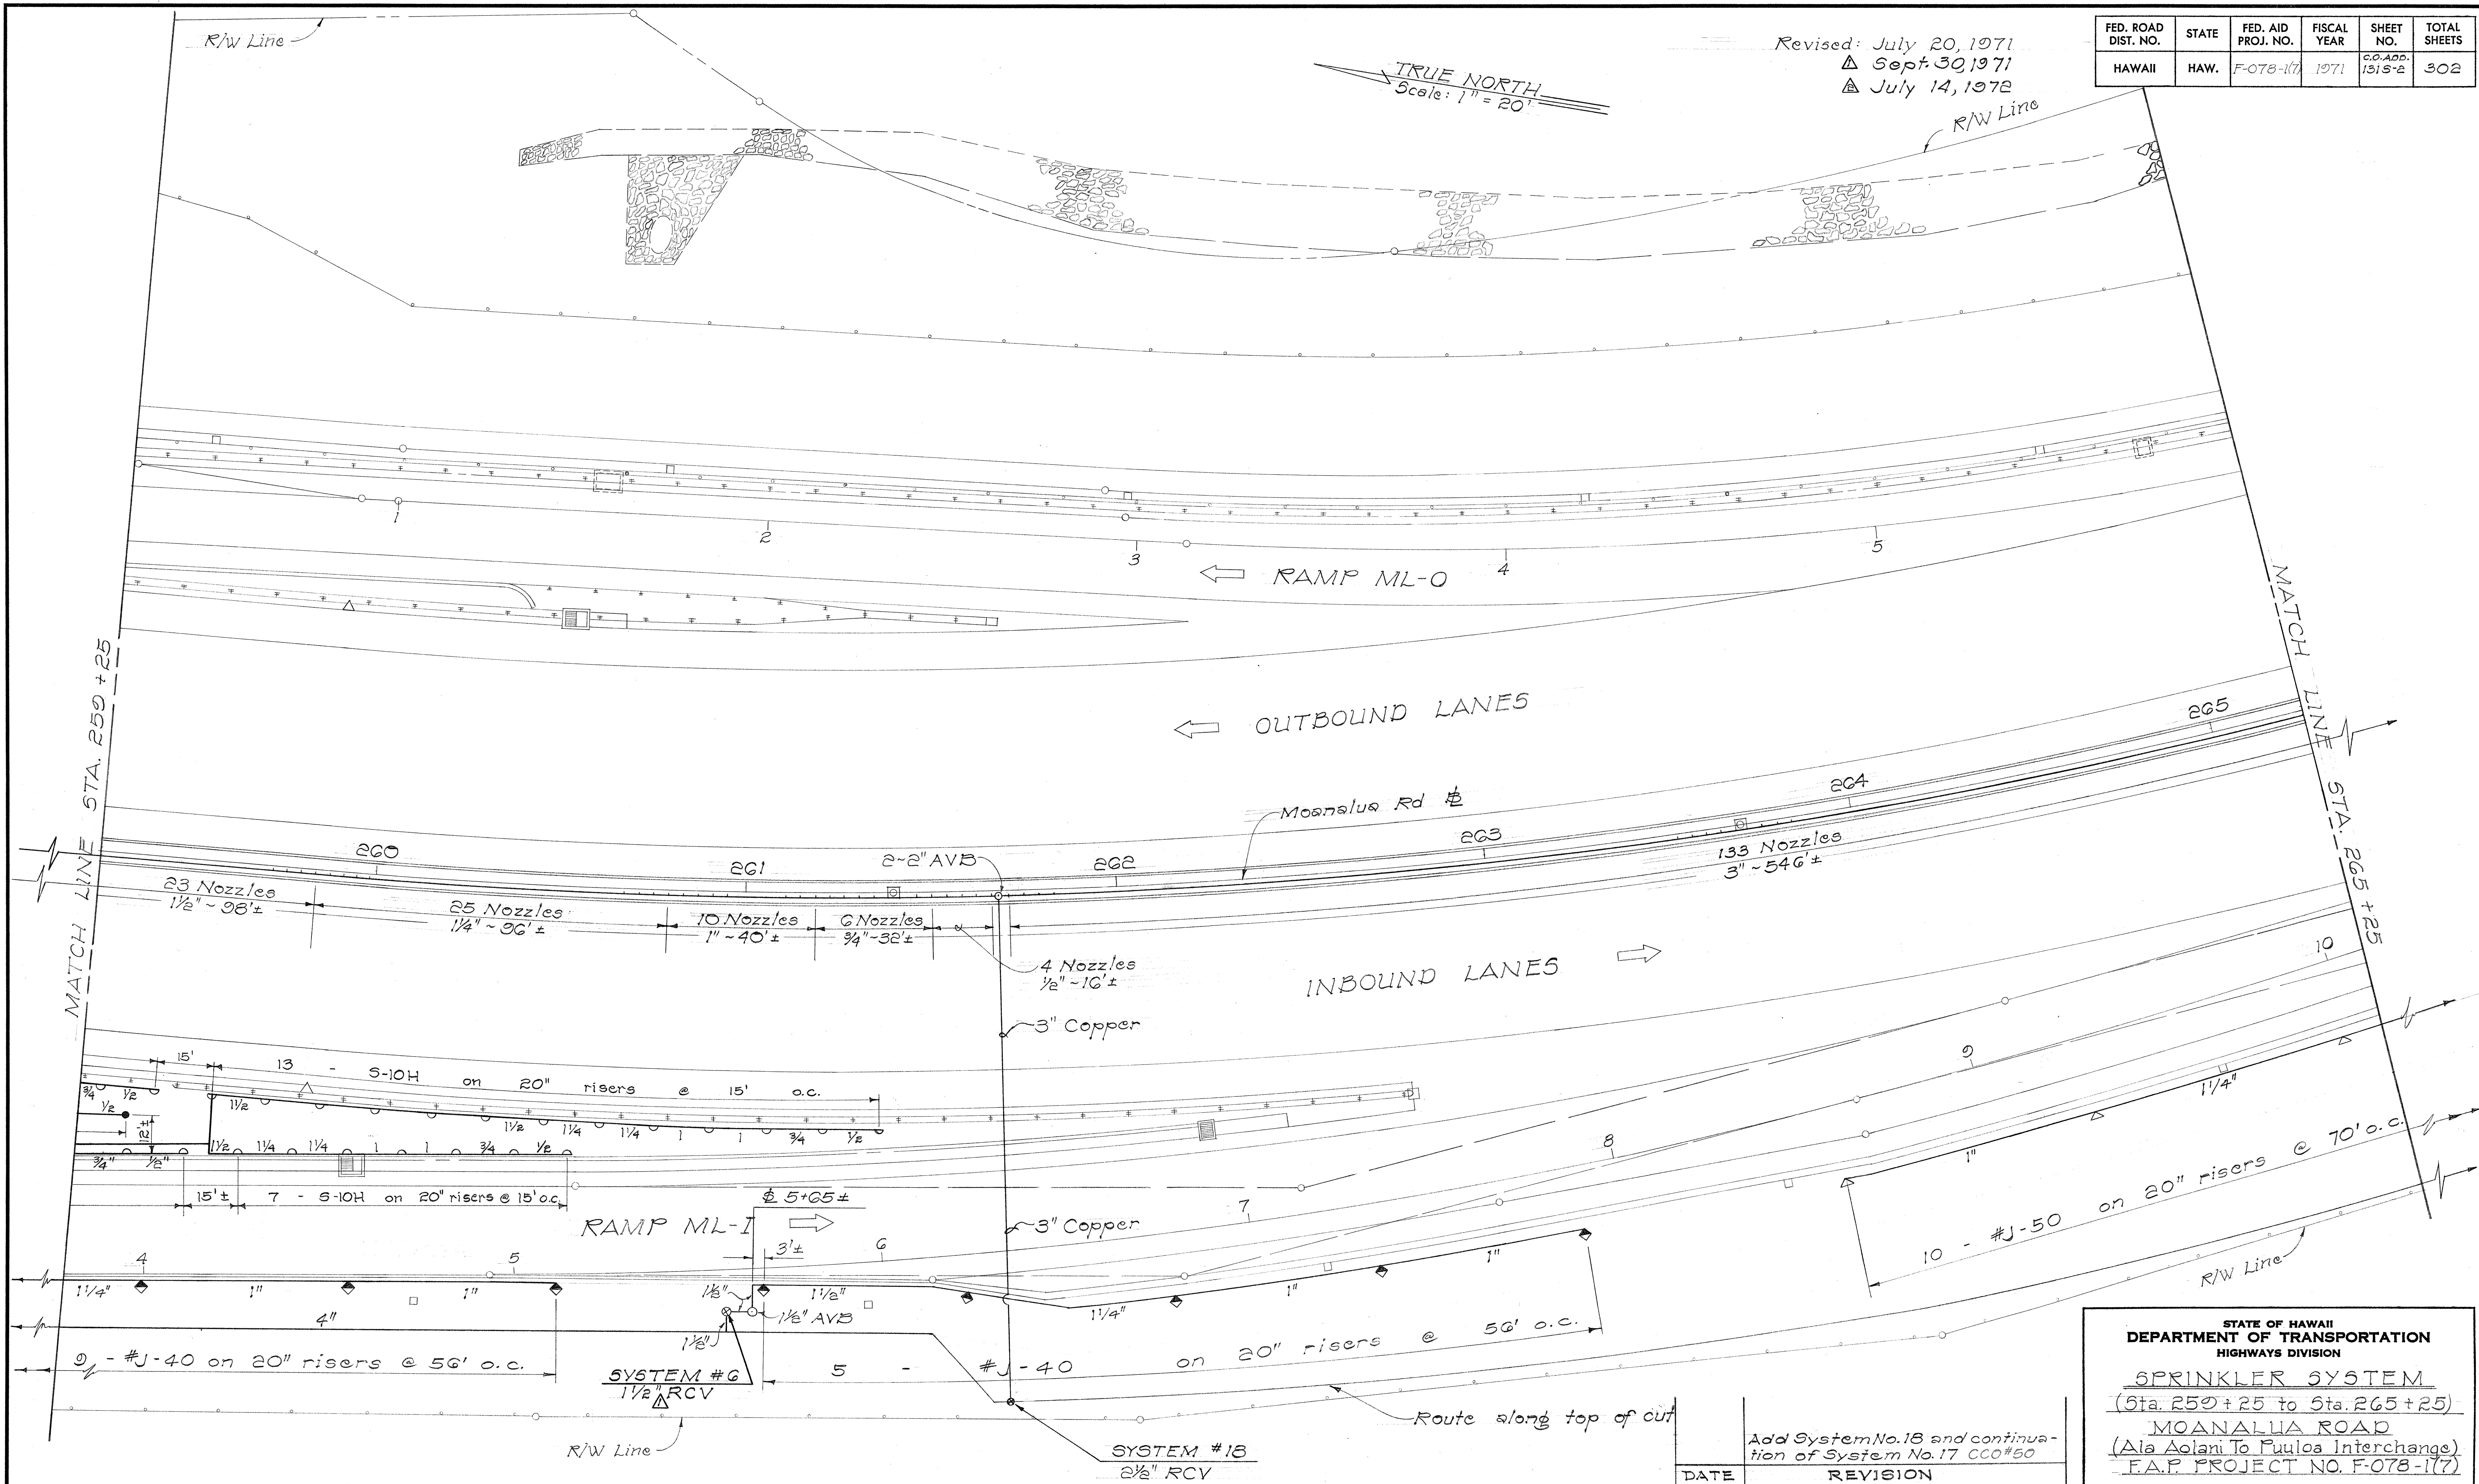

SURVEY PLOTTED BY	DATE
DESIGNED BY	
TRACED BY	
NOTE BOOK	
QUANTITIES BY	
CHECKED BY	
No.	


STATE OF HAWAII
 DEPARTMENT OF TRANSPORTATION
 HIGHWAYS DIVISION
 SPRINKLER SYSTEM
 (Sta. 250+25 to Sta. 265+25)
 MOANALUA ROAD
 (Ala Aolani To Puuloa Interchange)
 F.A.P. PROJECT NO. F-078-1(7)
 Scale: 1" = 20' Date: July 1971
 SHEET No. 5 OF 11 SHEETS

DATE	REVISION
	Add System No. 18 and continuation of System No. 17 C.O.#50

This is a new supplemental sheet.
 ▲ THIS SHEET SUPERSEDES SHEET NO. ADD. 131 S-2
 ▲ THIS SHEET SUPERSEDES SHEET NO. C.O. ADD. 131 S-2

FED. ROAD DIST. NO.	STATE	FED. AID PROJ. NO.	FISCAL YEAR	SHEET NO.	TOTAL SHEETS
HAWAII	HAW.	F-078-1(7)	1971	C.O. ADD. 131 S-3	302

Revised: July 20, 1971
 Sept. 30, 1971

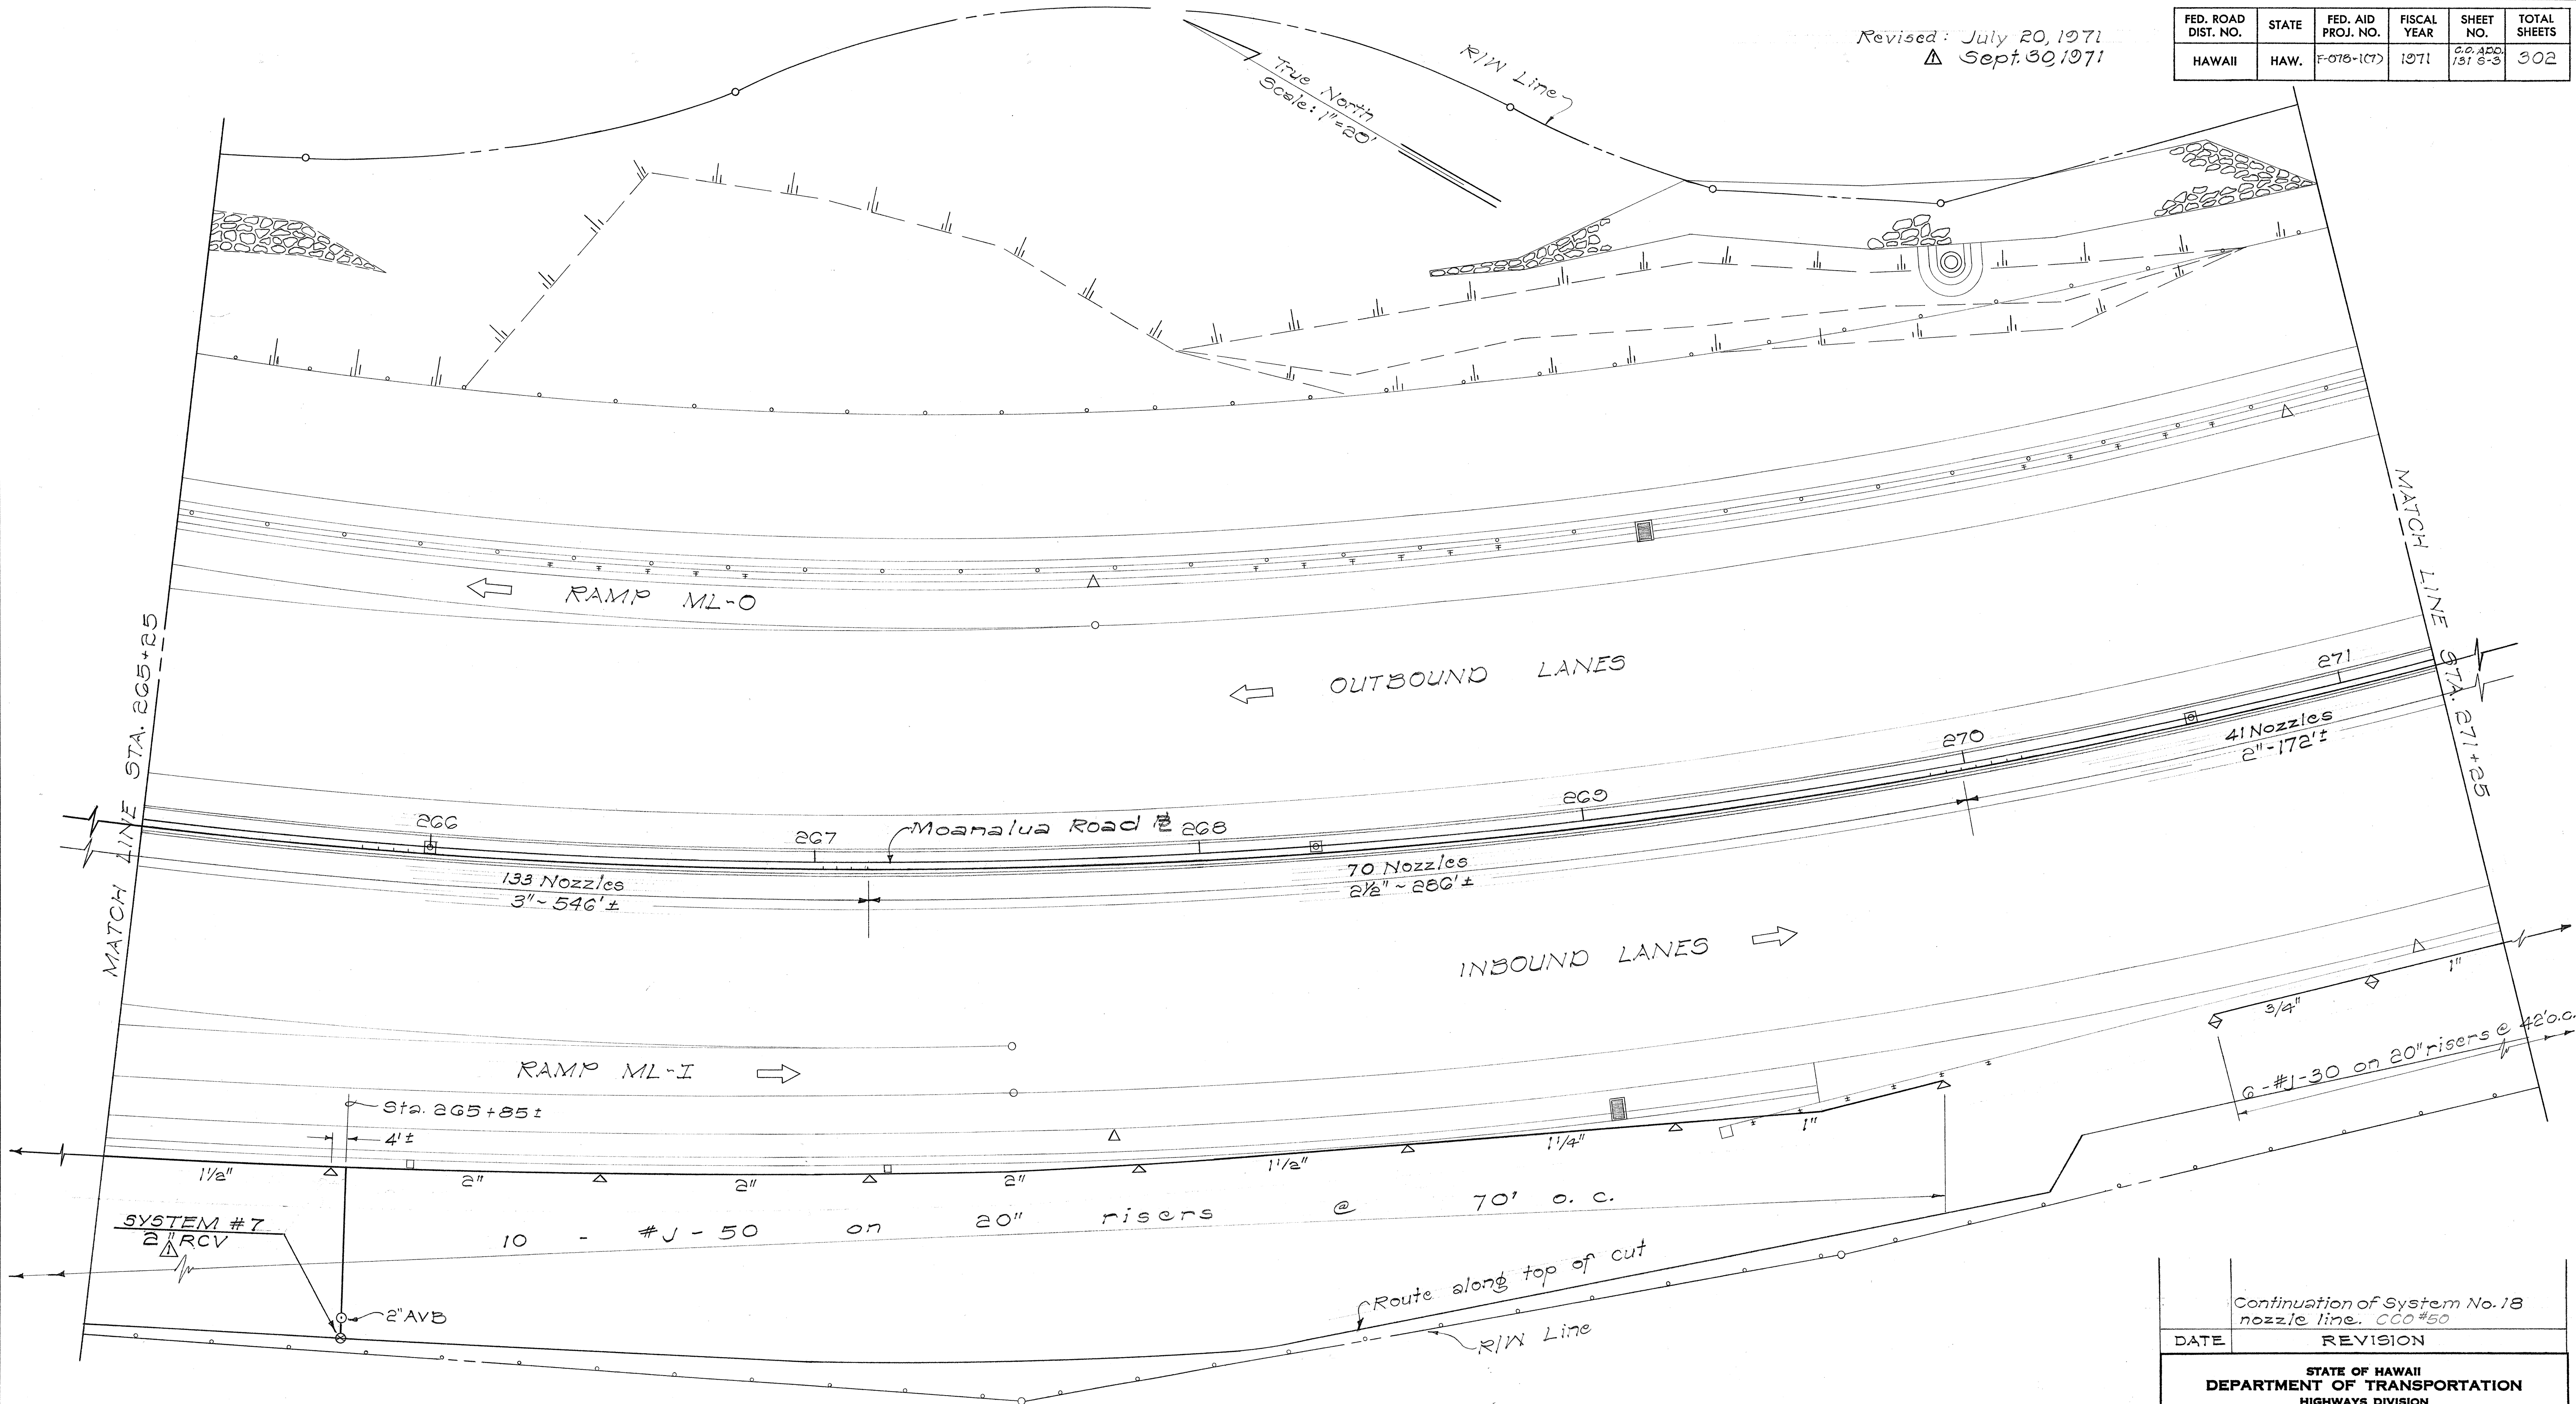


SURVEY PLOTTED BY	DATE
DESIGNED BY	
TRACED BY	
QUANTITIES BY	
CHECKED BY	
ORIGINAL PLAN	NOTE BOOK
No.	

This is a new supplemental cht.
 THIS SHEET SUPERSEDES SHEET NO. ADD. 131 S-3

Continuation of System No. 18 nozzle line, CCO #50	
DATE	REVISION
STATE OF HAWAII DEPARTMENT OF TRANSPORTATION HIGHWAYS DIVISION SPRINKLER SYSTEM (Sta. 265+25 to Sta. 271+25) MOANALUA ROAD (Aia Aolani To Puuloa Interchange) F.A.P. PROJECT NO. F-078-1(7)	
Scale: 1" = 20'	Date: July 1971
SHEET No. 6 OF 11 SHEETS	

FED. ROAD DIST. NO.	STATE	FED. AID PROJ. NO.	FISCAL YEAR	SHEET NO.	TOTAL SHEETS
HAWAII	HAW.	F-07B-1(7)	1971	C.O. ADD. 131 S-4	302

Revised: July 20, 1971
 Sept. 30, 1971

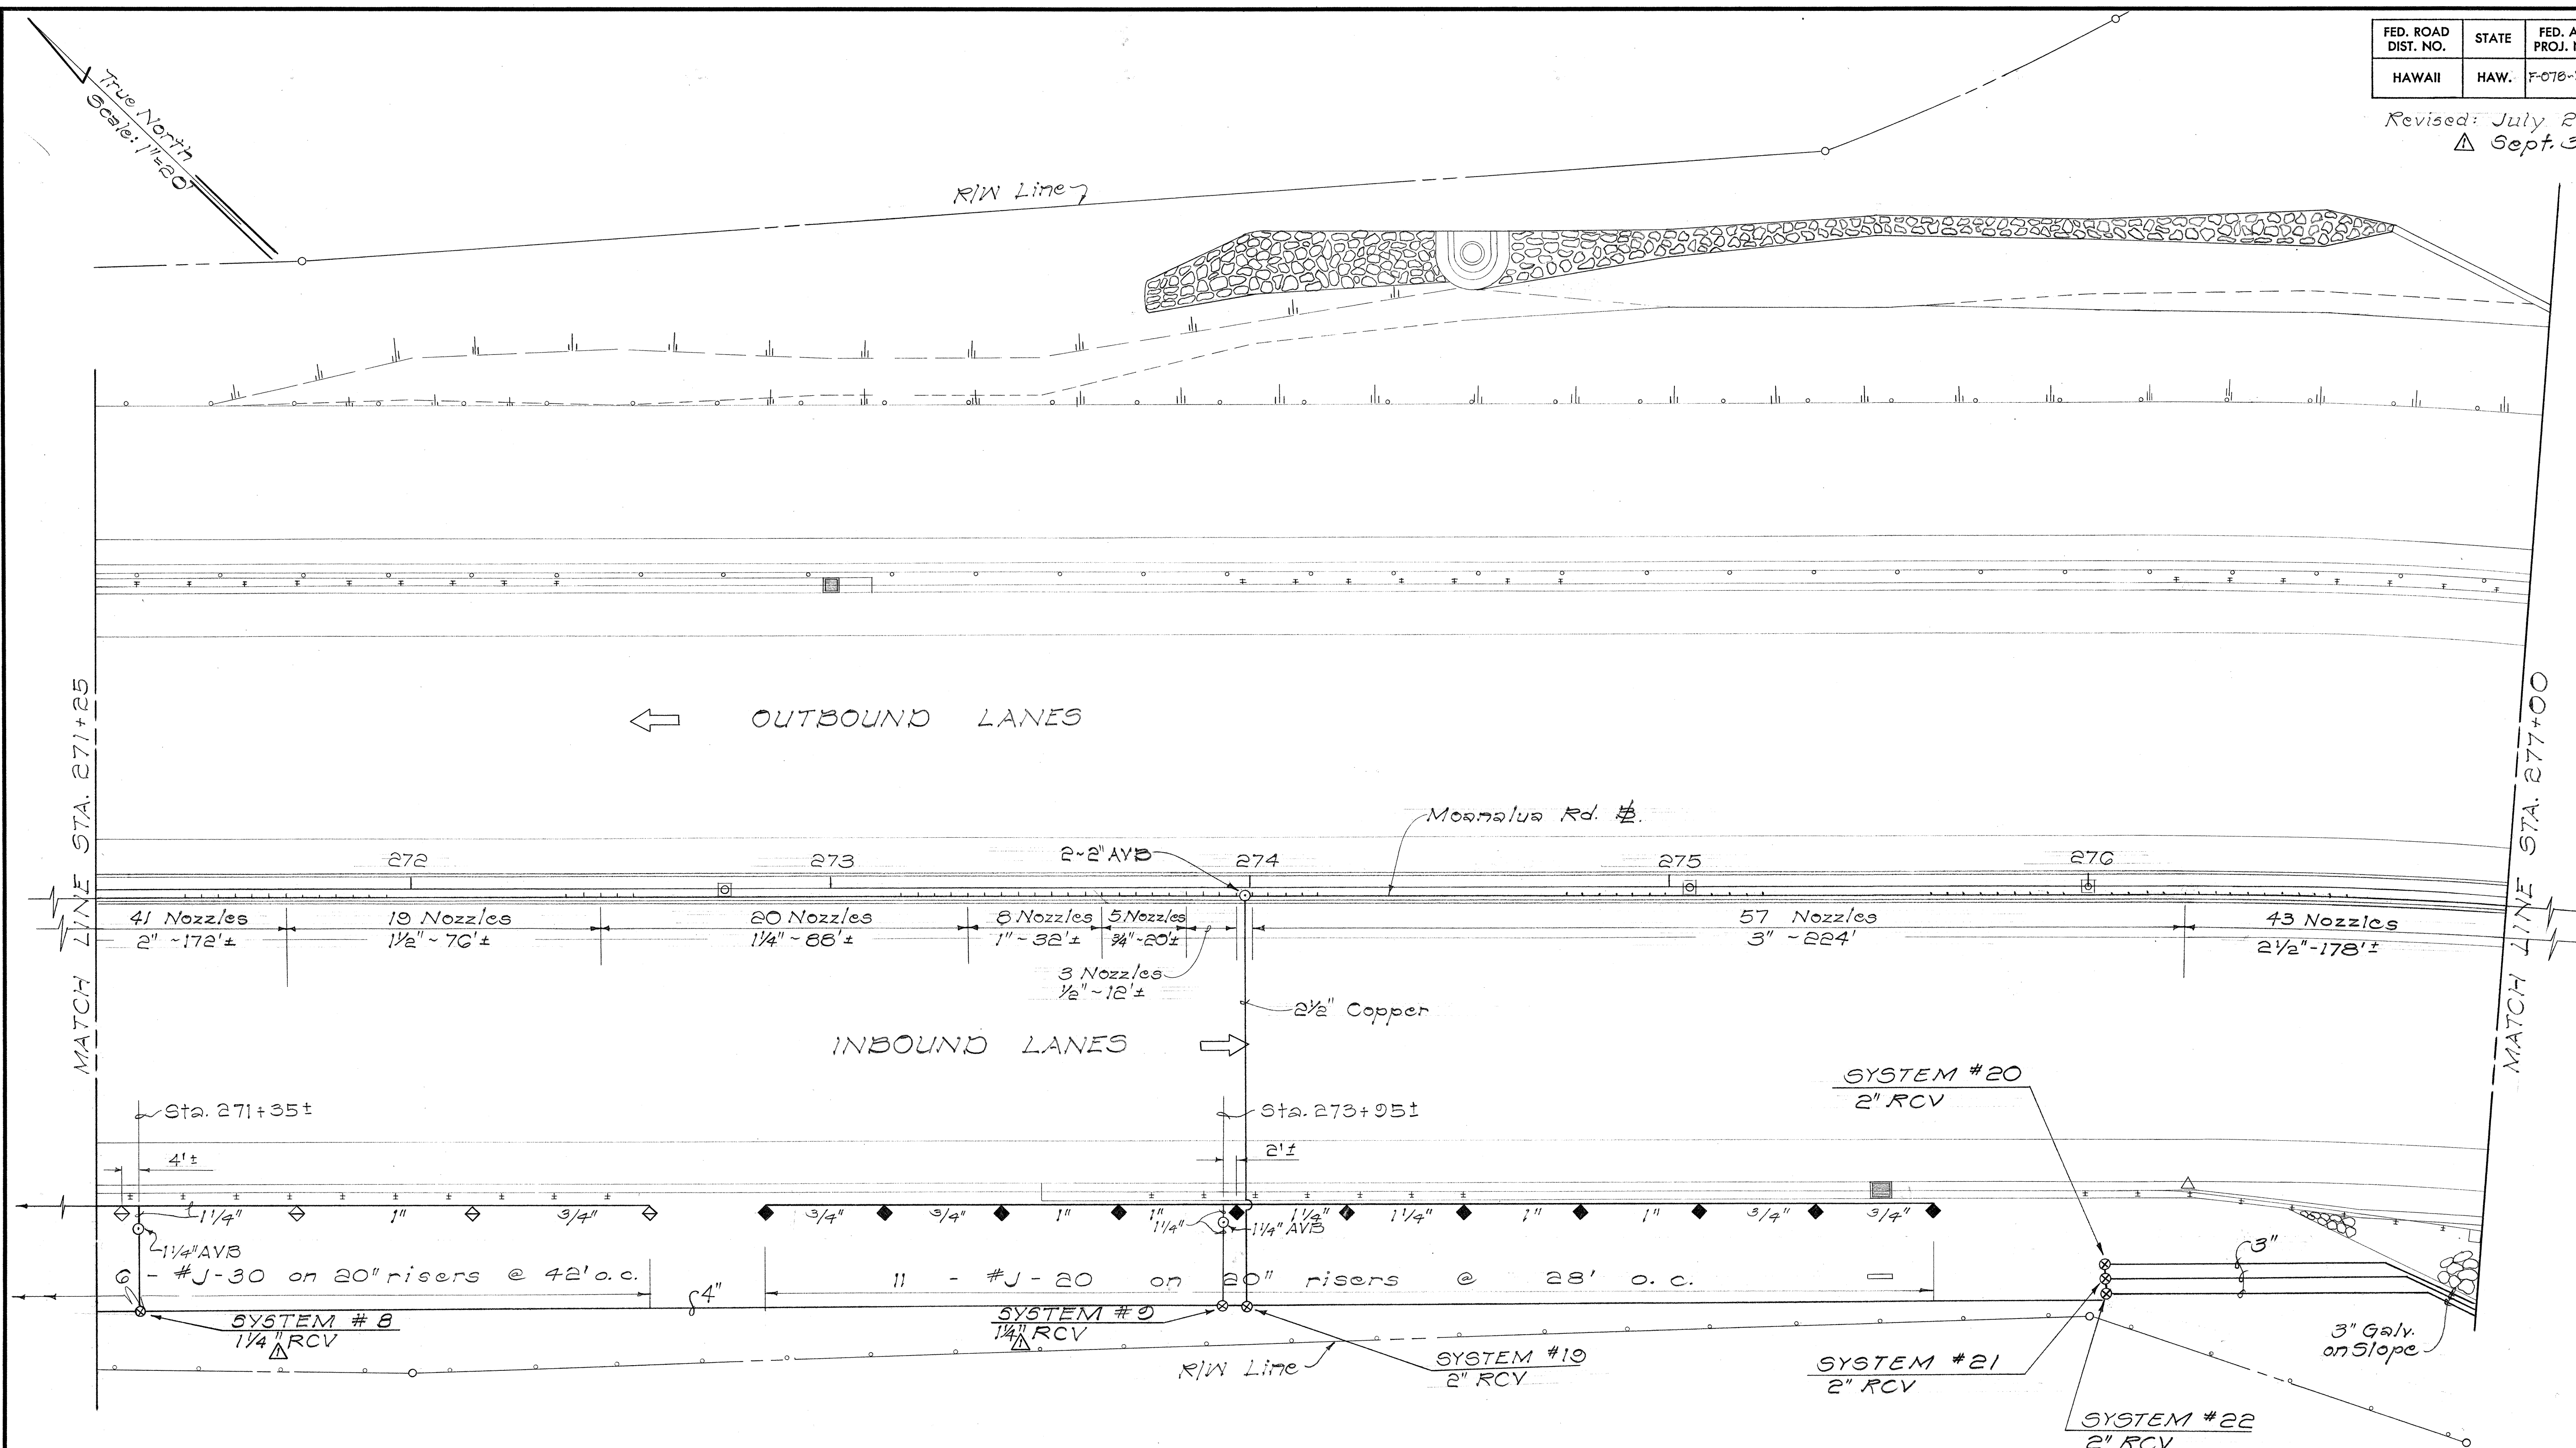

DATE	
SURVEYED BY	
DRAWN BY	
CHECKED BY	
NOTE BOOK	
No.	

5-21-73	Revised System #20 & 21. Added System #22
	Add System No. 19 and continuation of System No. 18 CCO #50
DATE	REVISION

This is a new supplemental sheet.
 THIS SHEET SUPERSEDES SHEET NO. ADD13, S-4

STATE OF HAWAII
 DEPARTMENT OF TRANSPORTATION
 HIGHWAYS DIVISION


SPRINKLER SYSTEM
 (Sta. 271+25 to Sta. 277+00)
 MOANALUA ROAD
 (Ala Aolani To Puuloa Interchange)
 F.A.P. PROJECT NO. F-07B-1(7)

Scale: 1" = 20' Date: July 1971
 SHEET No. 7 OF 11 SHEETS

C.O. ADD. 131 S-4

FED. ROAD DIST. NO.	STATE	FED. AID PROJ. NO.	FISCAL YEAR	SHEET NO.	TOTAL SHEETS
HAWAII	HAW.	F-078-1(7)	1971	C.O. ADD. 131 S-6	302

Revised: July 20, 1971
 Sept. 30, 1971
 July 14, 1972

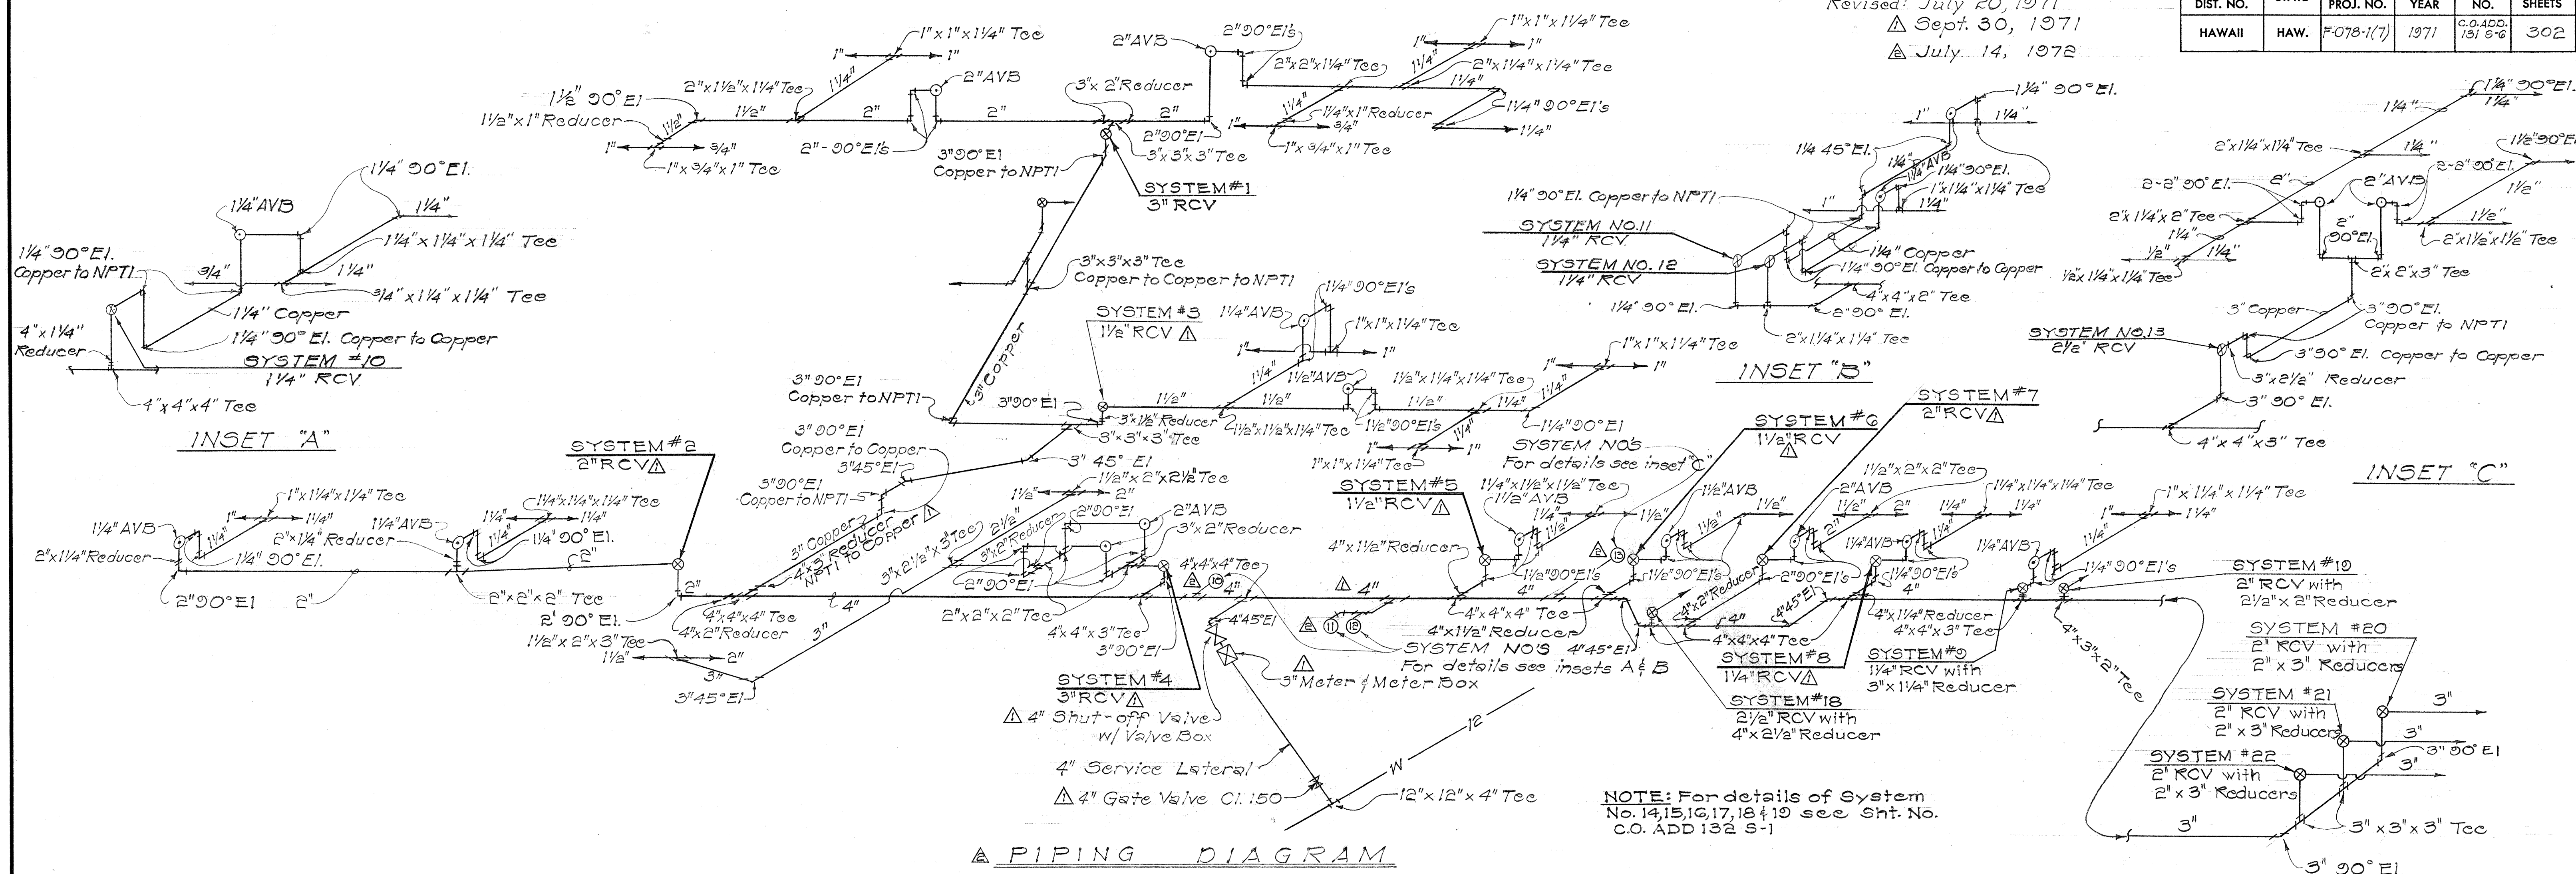

NOTE: For details of System No. 14, 15, 16, 17, 18 & 19 see Sht. No. C.O. ADD 132 S-1

ESTIMATED QUANTITIES

△ Structural Exc.	=	642 C.Y.
△ Furnish and install Valve Box	=	1 Ea.
Furnish and installing 4" Gate Valve (Class 150)	=	1 Ea.
1" Remote Control Valve w/Type A Valve Box	=	1 Ea.
1/4" Remote Control Valve w/Type A Valve Box	=	6 Ea.
1/2" Remote Control Valve w/Type A Valve Box	=	4 Ea.
2" Remote Control Valve w/Type A Valve Box	=	6 Ea.
2 1/2" Remote Control Valve w/Type A Valve Box	=	3 Ea.
3" Remote Control Valve w/Type A Valve Box	=	2 Ea.
1/4" Atmospheric Vacuum Breaker	=	8 Ea.
1/2" Atmospheric Vacuum Breaker	=	3 Ea.
2" Atmospheric Vacuum Breaker	=	21 Ea.
1/2" Diameter Galv. Steel Pipe	=	330 L.F.
4" Diameter Cast Iron Pipe*	=	250 L.F.
1/2" Diameter Pipe	=	90 L.F.
3/4" Diameter Pipe	=	1750 L.F.
1" Diameter Pipe	=	2265 L.F.
1 1/4" Diameter Pipe	=	1674 L.F.
1 1/2" Diameter Pipe	=	1032 L.F.
2" Diameter Pipe	=	1428 L.F.
2 1/2" Diameter Pipe	=	46 L.F.
3" Diameter Pipe	=	478 L.F.
4" Diameter Pipe	=	2149 L.F.
3" Diameter Pipe Roadway	=	358 L.F.
2 1/2" Diameter Pipe Roadway	=	98 L.F.
1 1/2" Diameter Pipe Roadway	=	120 L.F.
S-15 Sprinkler Head	=	22 Ea.

S-10 Sprinkler Head	=	40 Ea.
J-20 Jet Sprinkler	=	33 Ea.
J-30 Jet Sprinkler	=	66 Ea.
J-40 Jet Sprinkler	=	20 Ea.
J-50 Jet Sprinkler	=	44 Ea.
2" PVC Conduit	=	320 L.F.
18-Station Controller	=	1 Ea.
#14 Gage Direct	=	1 Ea.
Burial Wire	=	25,200 L.F.
Concrete, Cl. B	=	10 C.Y.
Reinf. Steel	=	24 lbs.
Brick Wall	=	6 L.F.
C.I. Manhole Frame & Cover, 20" size	=	1 Ea.
Nozzle Line	=	5568 L.F.
Restoration of Pavement	=	60 S.F.

△ For Electric Service Connection	
Struct. Exc.	21 C.Y.
1 1/2" PVC Conduit	210 L.F.
1 1/2" Steel Conduit	8 L.F.
1-2C #8	800 L.F.
Type "B" Pull Box	4 Ea.

3/4" Galv. Pipe	=	80 L.F.
1" Galv. Pipe	=	54 L.F.
1 1/4" Galv. Pipe	=	106 L.F.
1 1/2" Galv. Pipe	=	106 L.F.
2" Galv. Pipe	=	268 L.F.
2 1/2" Galv. Pipe	=	234 L.F.
3" Galv. Pipe	=	726 L.F.
Plug existing riser connections	=	4 Ea.
Saddle Tee Connection	=	17 Ea.
Anchor Rings	=	150 Ea.

Approved for cross connection control requirements.
 Sprinkler system to conform with Uniform plumbing code.
 Takuhi Uyama
 Board of Water Supply
 9-30-71
 Date

5-21-73 Revised estimated quantities & piping diagram for system 20, 21 & 22. Change estimated quantities, Add note for Systems No. 14, 15, 16, 17, 18 & 19, add Systems No. 20 & 21, removed Wire Diagram. CCO #50


DATE REVISION
 STATE OF HAWAII
 DEPARTMENT OF TRANSPORTATION
 HIGHWAYS DIVISION
 SPRINKLER SYSTEM
 MOANALUA ROAD
 (Ala Aolani To Puuloa Interchange)
 F.A.P. PROJECT NO. F-078-1(7)

Date: July, 1971
 SHEET No. 9 OF 11 SHEETS

C.O. ADD. 131 S-6

FED. ROAD DIST. NO.	STATE	FED. AID PROJ. NO.	FISCAL YEAR	SHEET NO.	TOTAL SHEETS
HAWAII	HAW.	F-076-1(7)	1971	C.O. ADD 131 S-7	308



Revised July 20, 1971
 Sept. 30, 1971
 July 14, 1972

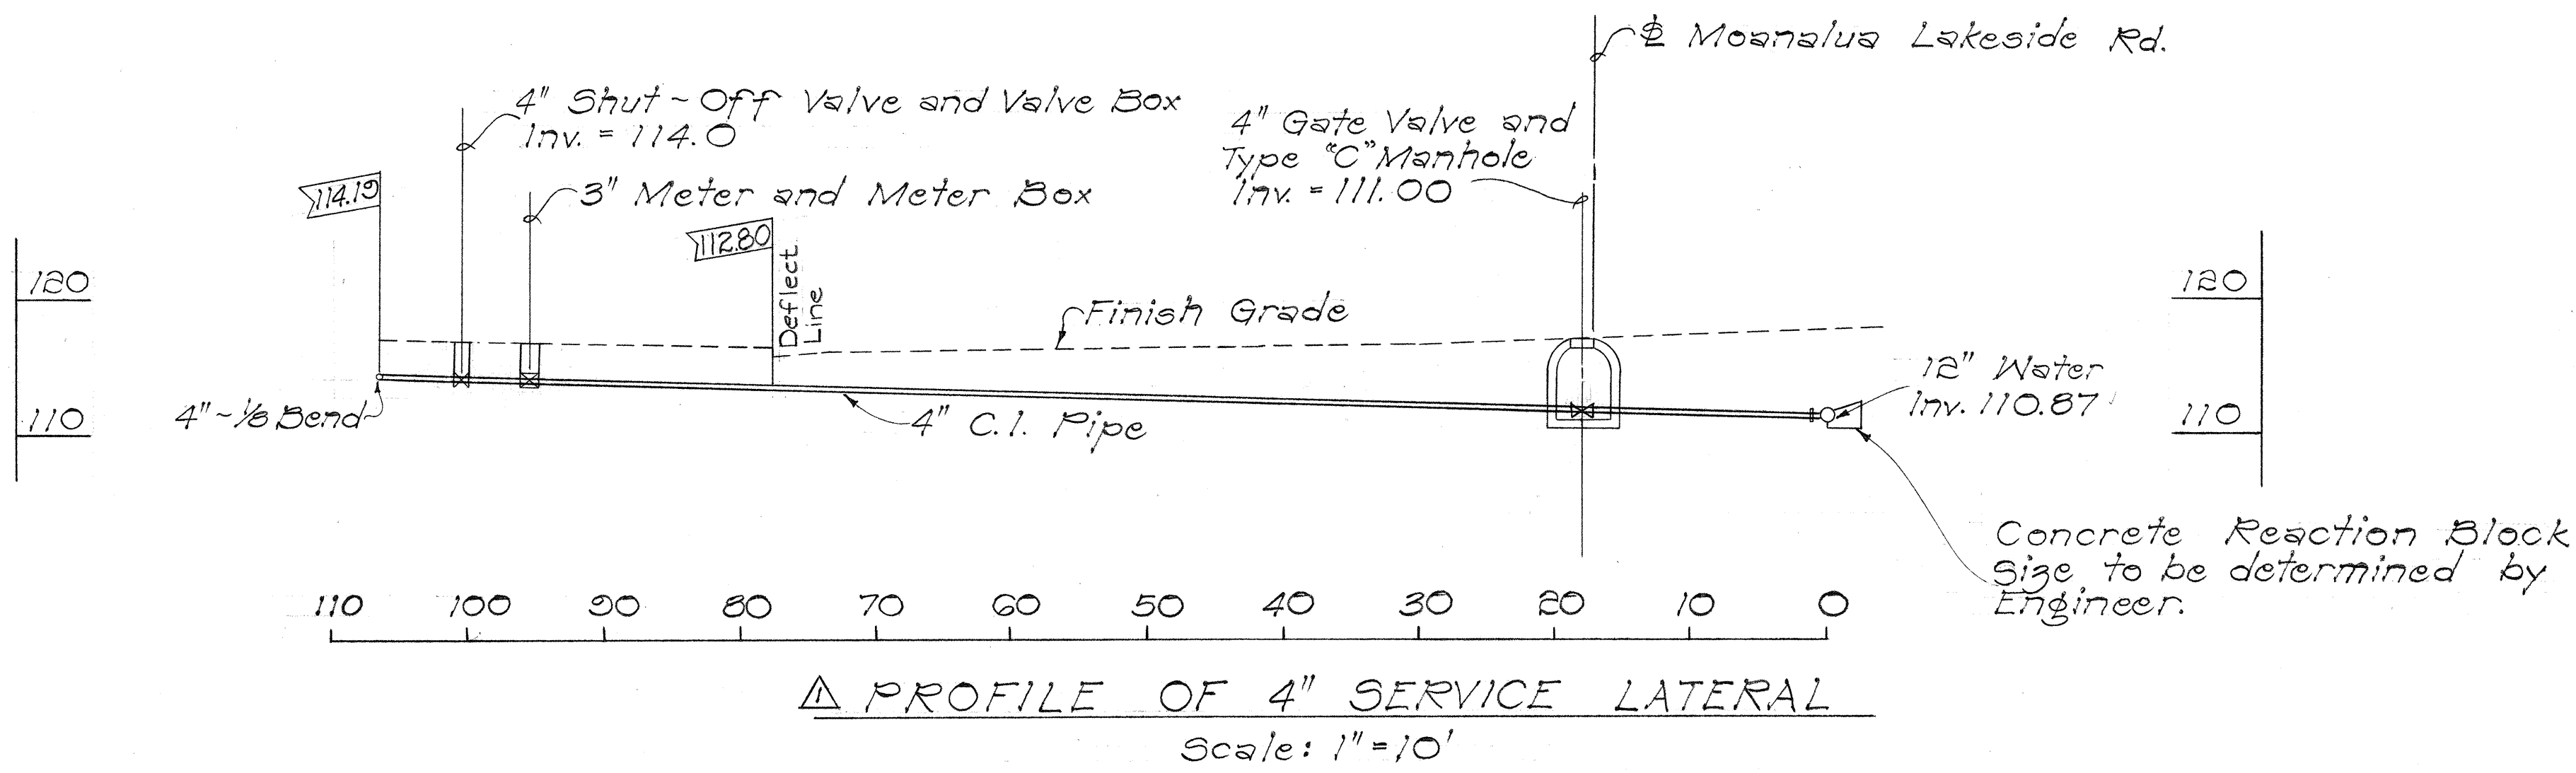

OPERATING TIME SCHEDULE

STA. NO.	VALVE NO.	TIME IN MIN.
1	14	5
2	10	45
3	15	5
4	16	5
5	17	5
6	4	45
7	1	5
8	2 & 3	45
9	13	5
10	18	5
11	22	18
12	8, 11 & 12	45
13	7	60
14	19	5
15	5 & 6	60
16	9	60
17	21	18
18	20	18

Start cycle @ 6:00 P.M. everyday

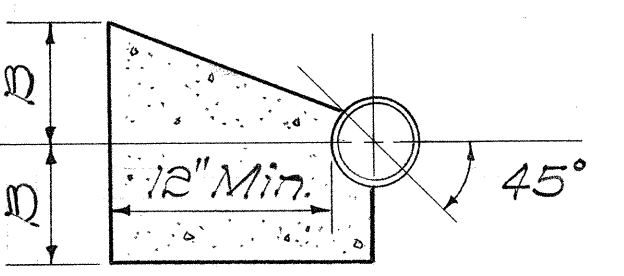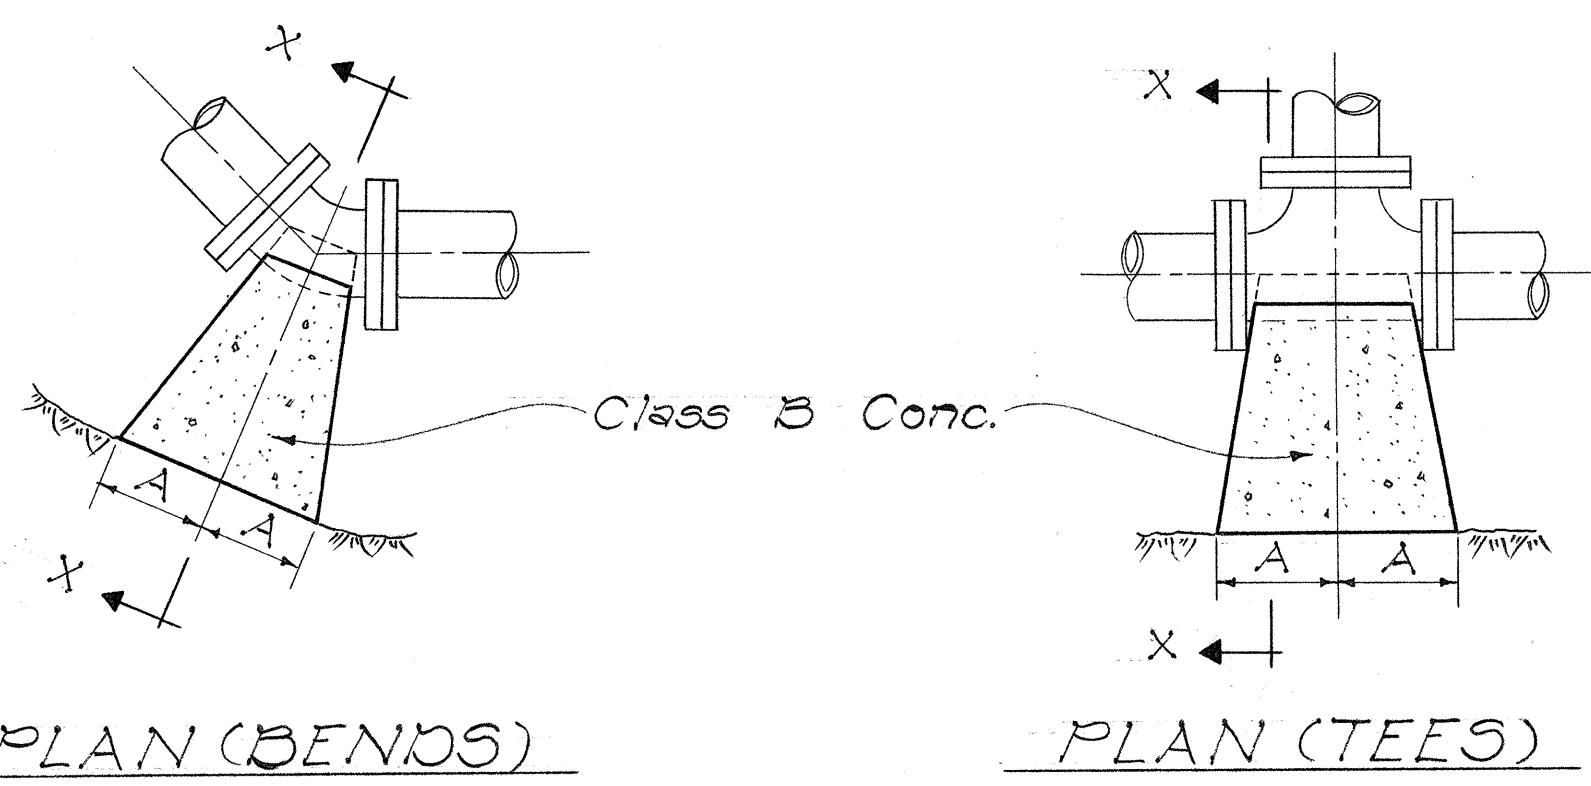

SIZE	1/4 BEND		1/2 BEND		TEES	
	A	B	A	B	A	B
3"	5"	5"	3.5"	3.5"	4"	4"
4"	6"	6"	5"	5"	6"	6"


- NOTES:
- All bearing surfaces to be carried to undisturbed ground.
 - Design based on 110 p.s.i. static pressure plus 120 p.s.i. water hammer pressure and 4000 p.s.f. soil bearing pressure.
 - Concrete Reaction Blocks are recommended sizes. Engineer may change requirements to meet field conditions.

DETAIL OF CONCRETE BLOCKS
 Not to Scale

5-21-73	Revised timing schedule for systems 20, 21, & 22 Add Operating Time Schedule CCO#50
DATE	REVISION
STATE OF HAWAII DEPARTMENT OF TRANSPORTATION HIGHWAYS DIVISION SPRINKLER SYSTEM MOANALUA ROAD (Aiea to Puuloa Interchange) F.A.P. PROJECT NO. F-076-1(7)	
Not to Scale	Date: July 1971
SHEET No. 10 OF 11 SHEETS	


THIS SHEET SUPERSEDES AND REPLACES SHEET NO. ADD 131 S-7
 THIS SHEET SUPERSEDES SHEET NO. C.O. ADD 131 S-7

FED. ROAD DIST. NO.	STATE	FED. AID PROJ. NO.	FISCAL YEAR	SHEET NO.	TOTAL SHEETS
HAWAII	HAW.	F-078-1(7)	1971	C.O. ADD 132 S-1	302

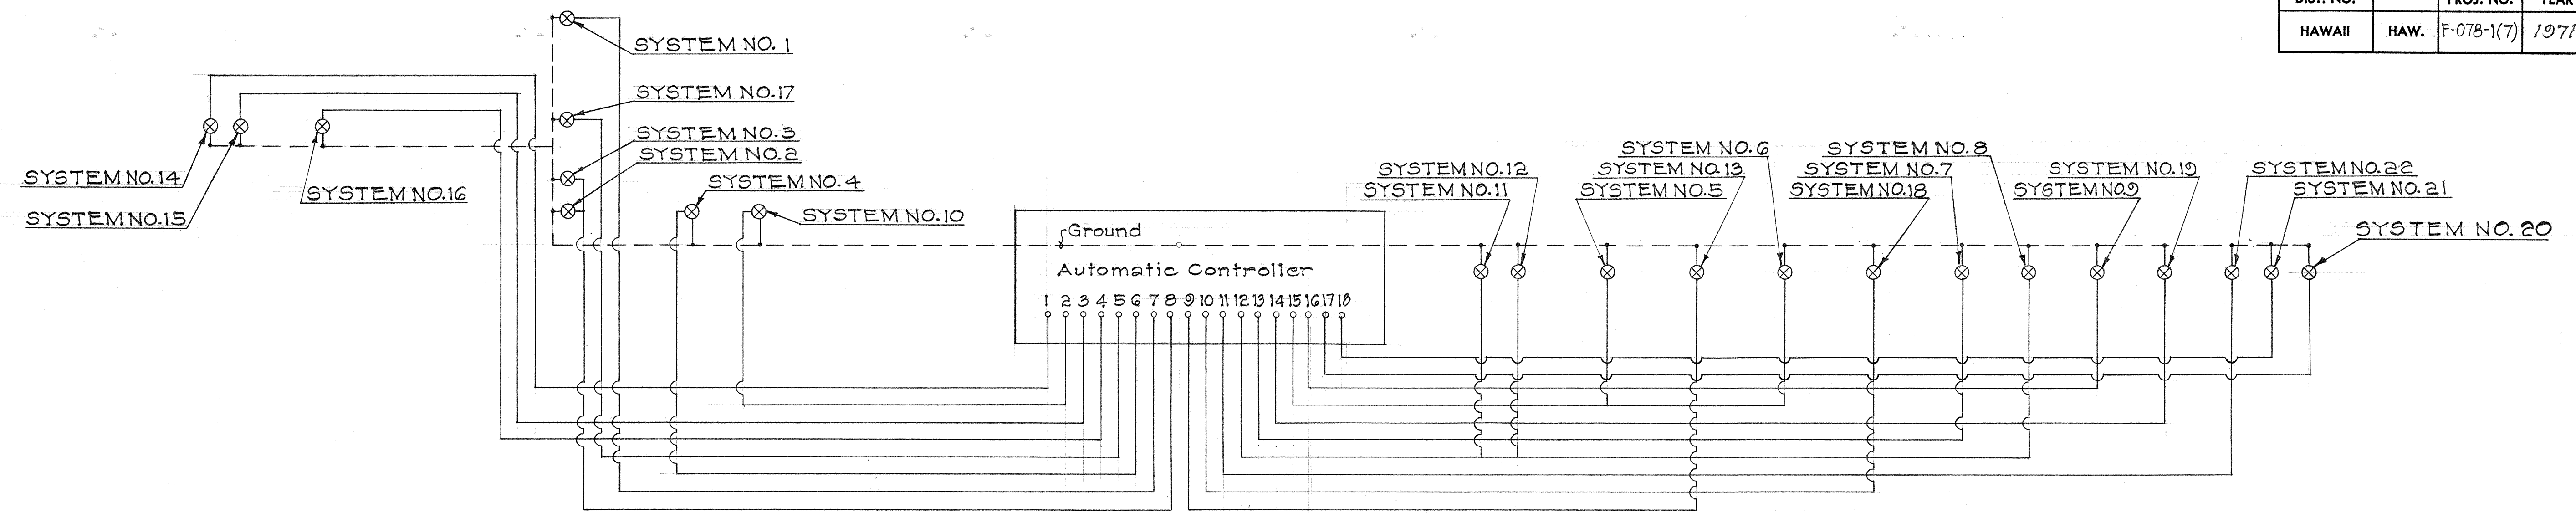

NOTE: All wire shall be No. 14 gage
(wire size for 3.5 watts, 24 volts solenoid)

SCHEMATIC WIRE DIAGRAM FOR AUTOMATIC SPRINKLING

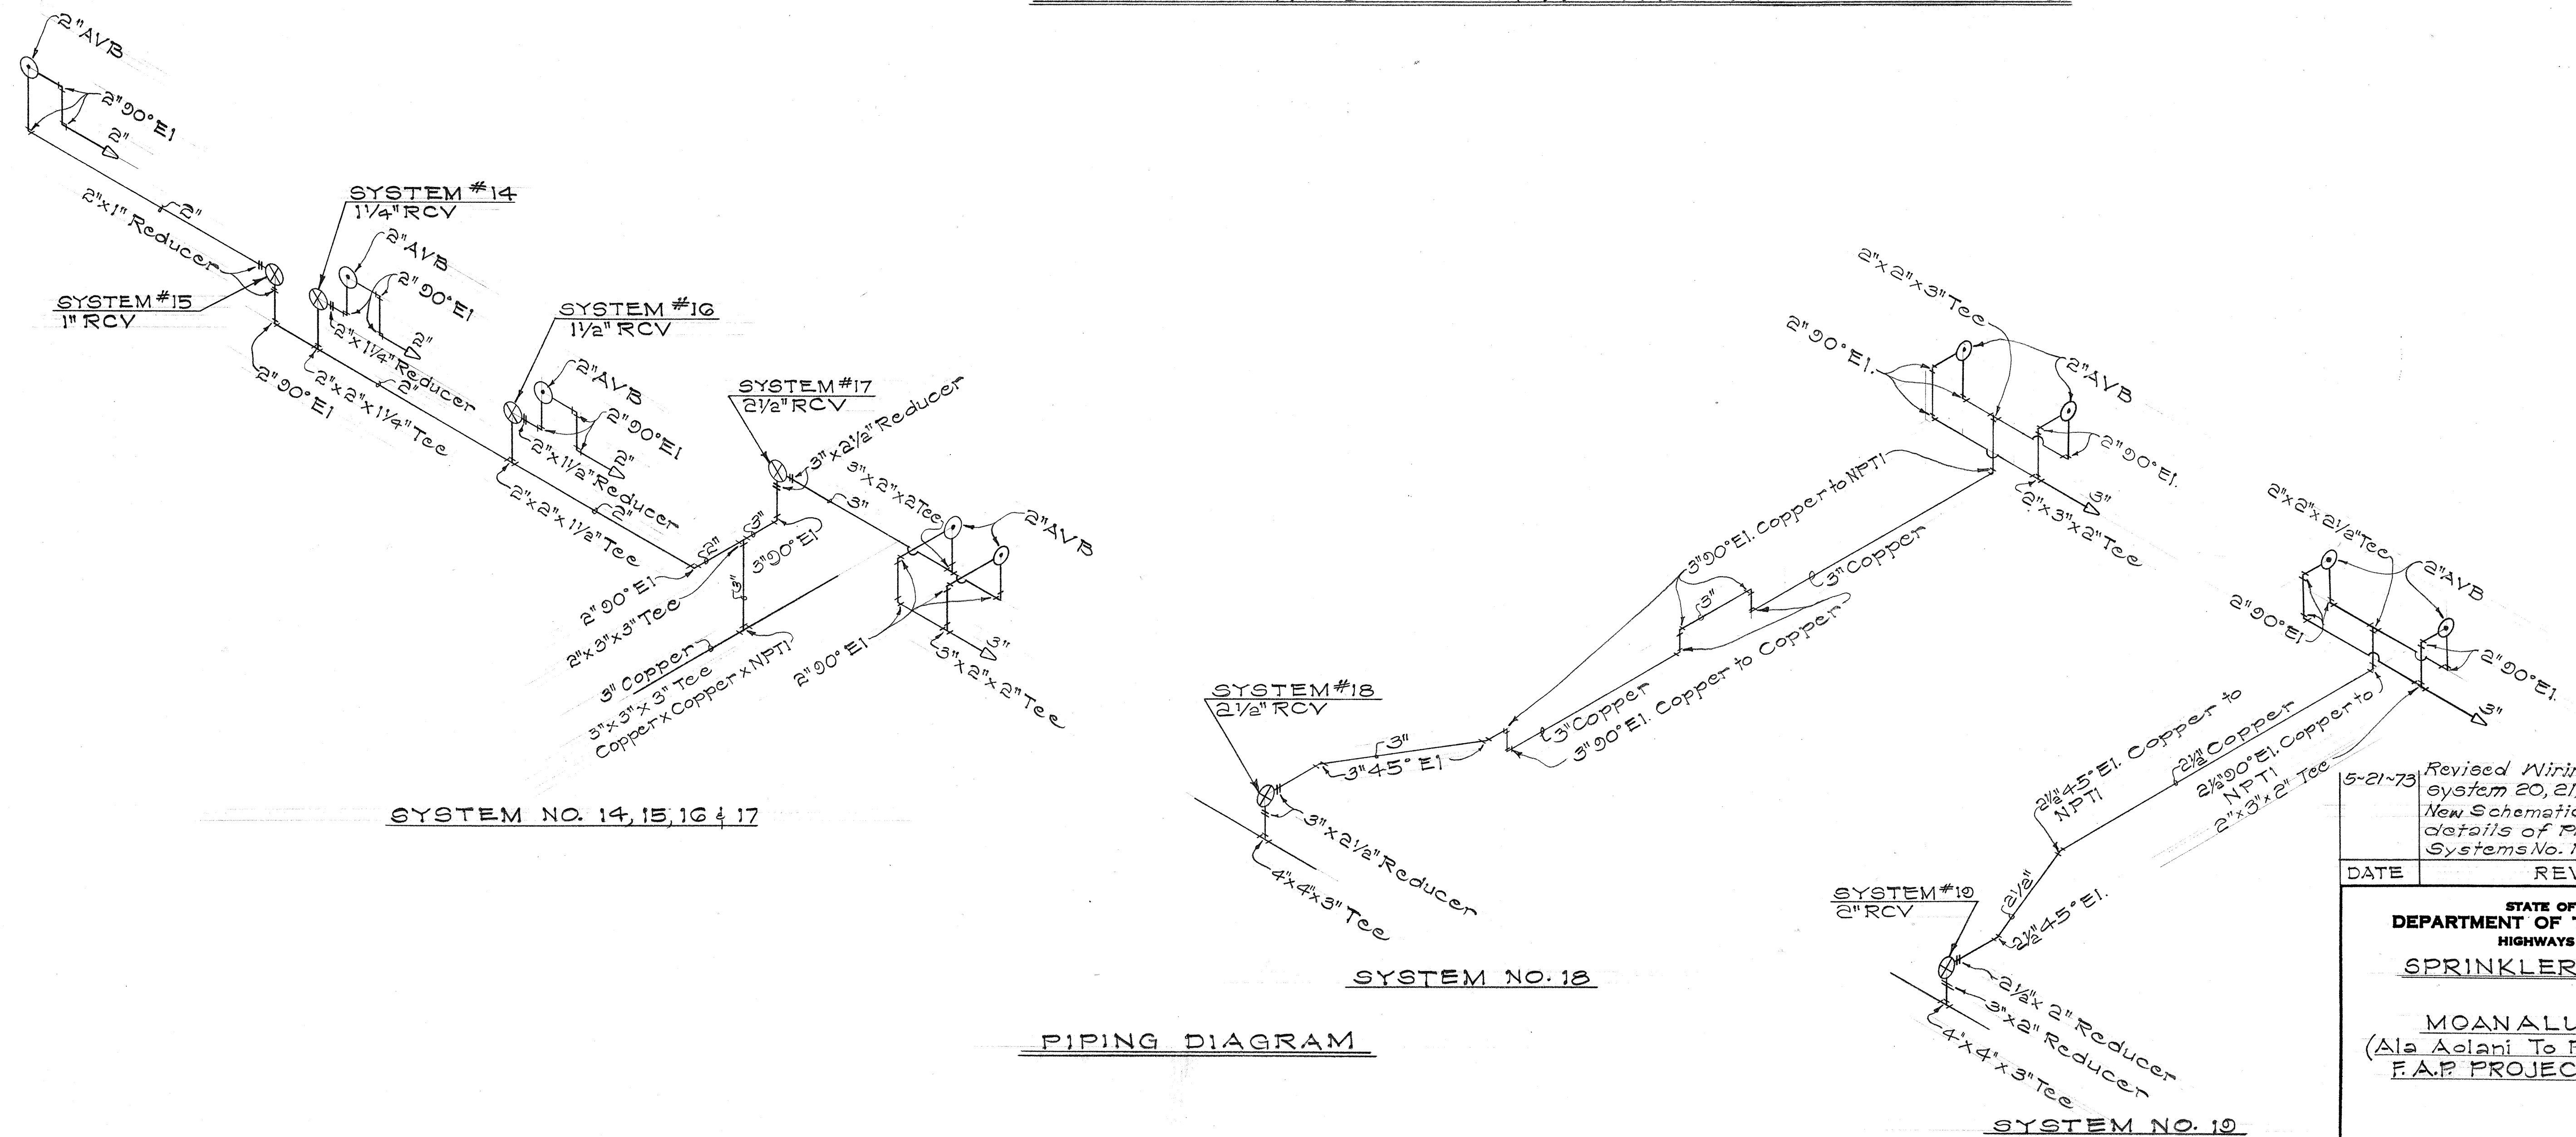

PIPING DIAGRAM

DATE	REVISION
5-21-73	Revised Wiring Diagram for system 20, 21, & Added System 22 New Schematic Wire Diagram and details of Piping Diagram for Systems No. 14, 15, 16, 17, 18 & 19

STATE OF HAWAII
HIGHWAYS DIVISION
SPRINKLER SYSTEM

MOANALUA ROAD
(Ala Aolani To Puuioa Interchange)
F.A.P. PROJECT NO. F-078-1(7)

Date: Dec. 1972

SHEET No. 11A OF 11 SHEETS

C.O. ADD 132 S-1

ORIGINAL	DATE
PLAN	
DESIGNED BY	
CHECKED BY	
NOTED BY	
.....	