

INDEX TO DRAWINGS	
SHEET NO.	DESCRIPTION
1	TITLE SHEET
2-9	TYPICAL SECTIONS
10-17	PLAN & PROFILE
18-20	SUPER ELEVATION DIAGRAMS
21-22	ROADWAY BORING LOGS
23-35	DETAIL PLAN OF ROADWAY
36-49	CONSTRUCTION DETOUR
*50-55	MISC. ROADWAY PLANS
56-73	MISC. & STANDARD DETAILS
74-98	DRAINAGE SYSTEM
99-125	SIGNING & PAVEMENT MARKINGS
126-128	LANDSCAPING
129-132	SPRINKLER SYSTEM
133-139	HIGHWAY LIGHTING
	UTILITIES
140-142	General
143-176	Gas, Electric, Telephone Trans-Pac & Joint Trunking
177-193	Sewer - Water
194-199	Army
200-213	CONCRETE RETAINING-WALLS
214-232	MOANALUA STREAM BRIDGE
233-252	NORTH FRONTAGE & MOANALUA- LAKESIDE SEPARATION STRUCTURES
253-258	MISC. STRUCTURE DETAILS
259-269	STANDARD STRUCTURE DETAILS
270-302	CROSS SECTIONS

* SHEET NO. 50 HAS BEEN DELETED FROM THE PLANS.

(a) SHEET NO. 213A ADDED TO PLANS

FOR NOTES ON INDEX REVISION BY ADDENDUM SEE SHEET NO. ADD. 5



STATE OF HAWAII
DEPARTMENT OF TRANSPORTATION
HIGHWAYS DIVISION
HONOLULU, HAWAII
"AS BUILT"
PLANS FOR
MOANALUA ROAD
VICINITY OF ALA AOLANI STREET (BASELINE STA. 239+00)
TO PUULOA INTERCHANGE
FED. AID PRIMARY PROJECT NO. F-078-1(7)

DISTRICT OF HONOLULU
ISLAND OF OAHU

FOR LIST OF SUPPLEMENTARY SHEETS (b) TO (j) SEE SHEET NO. ADD. 5
TOTAL SHEET COUNT AFTER "AS-BUILT" POSTING = 330 SHEETS.

REVISED: JULY 20, 1971

FED. ROAD DIST. NO.	STATE	FED. AID PROJ. NO.	FISCAL YEAR	SHEET NO.	TOTAL SHEETS
HAWAII	HAW.	F-078-1(7)	1971	1	302

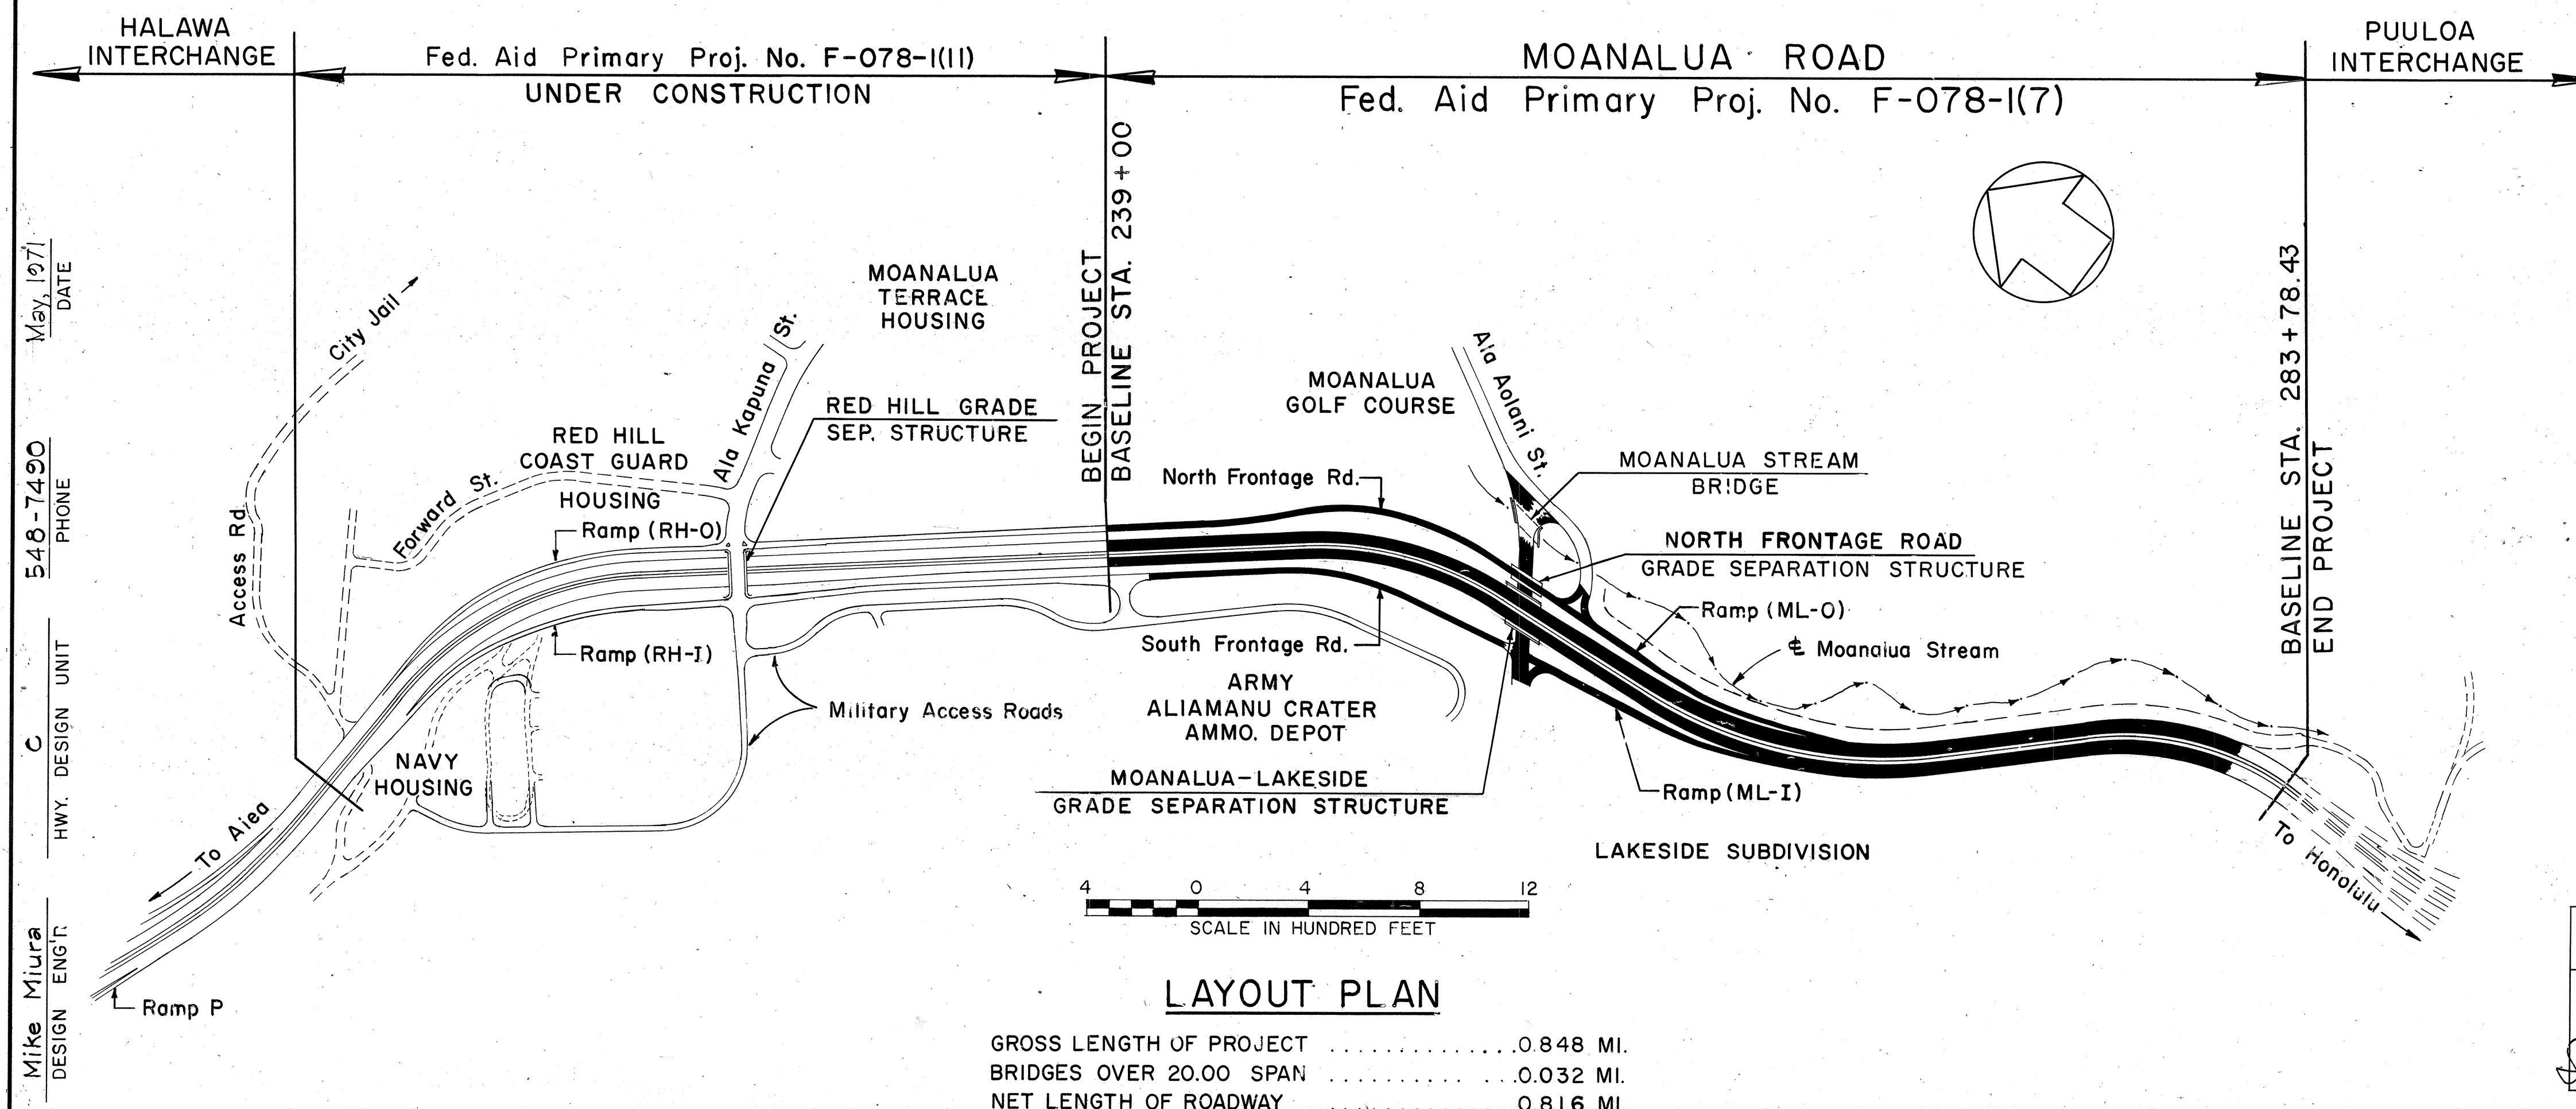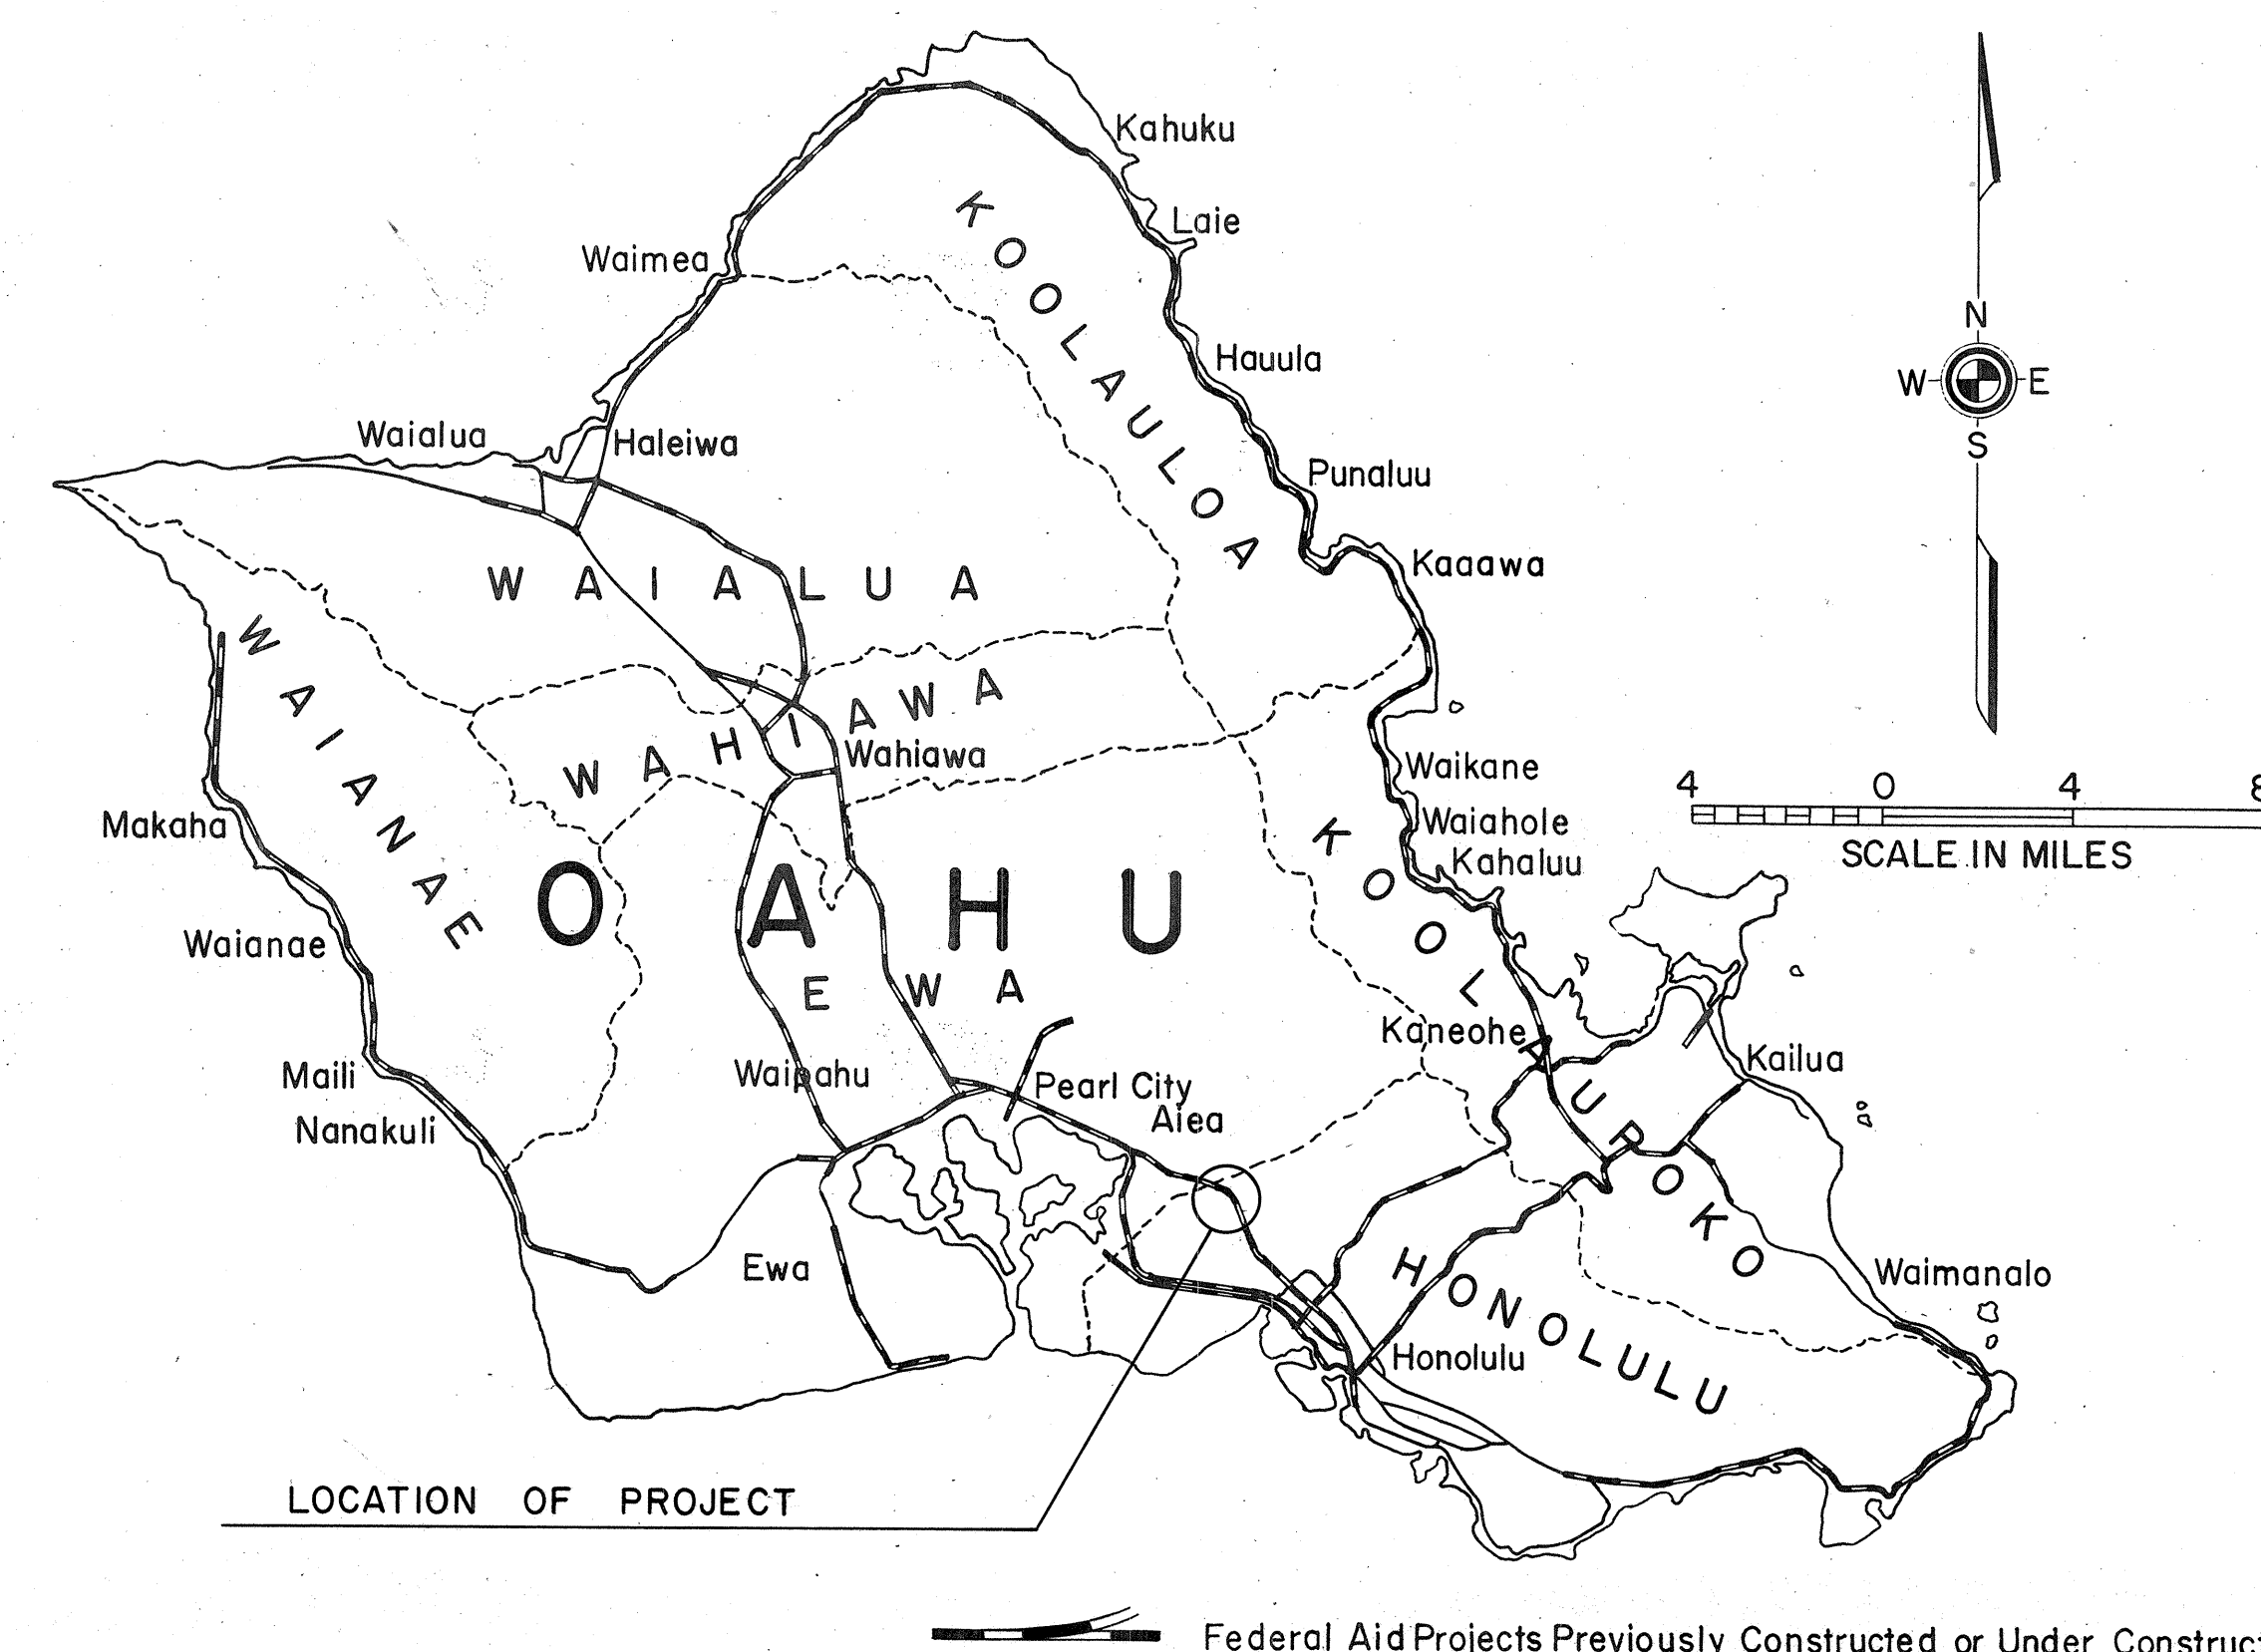

ALL CHANGES MADE DURING CONSTRUCTION HAVE BEEN INCORPORATED ON THESE PLANS IN RED EXCEPT CHANGES IN THE ORIGINAL THEORETICAL QUANTITIES. FOR ACTUAL QUANTITIES, REFER TO PROJECT LEDGER AND/OR COMPUTATION BOOK.

Barry J. Ratto 8-12-81
RESIDENT ENGINEER DATE

DESIGN CLASSIFICATION

CURRENT ADT (1969) ... 52,000

DESIGN ADT (1990) 71,900
DHV 11%
D 60/40
T 3%
V 50 m.p.h.

THIS SHEET SUPERSEDES
SHEET NO. 1

DEPARTMENT OF TRANSPORTATION
FEDERAL HIGHWAY ADMINISTRATION
APPROVED: *[Signature]* 6-3-81
DIVISION ENGINEER DATE

DEPARTMENT OF TRANSPORTATION
STATE OF HAWAII
APPROVED: *[Signature]* 8-12-81
DIR. OF TRANSPORTATION DATE

ADD. 1