

LEGEND
 = Existing Pavement to be Removed

—Begin 6' High Chain Link Fence w/o Top Rail
S.R. Sta. 15+90±

— R/W Line


~~SEE~~

—End Type 2D Cur.
U.E. Sta. 37+12±

~~Remove Existing Detour Pavement~~

Remove Existing Bituminous Curb

Begin Type 2D Curb
Meet Existing Curb
S.R. Sta. 12+70±

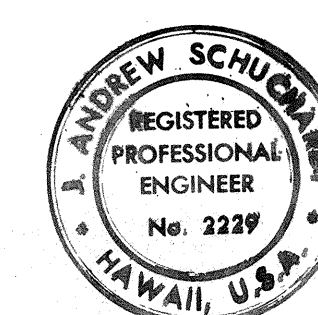

THIS WORK WAS PREPARED BY
ME OR UNDER MY SUPERVISION

J. Andrew Schuchard

STATE OF HAWAII
DEPARTMENT OF TRANSPORTATION
HIGHWAYS DIVISION

INTERSTATE ROUTE H-1
PROJECT NO I-HI-1(89):13


SCALE: 1" = 50' DATE: OCT. 30, 1970
SHEET No. 13 OF 25 SHEETS

22

CONSTRUCTION #

FED. ROAD DIST. NO.	STATE	FED. AID PROJ. NO.	FISCAL YEAR	SHEET NO.	TOTAL SHEETS
HAWAII	HAW.	I-HI(89):13	1971	28	362

ORIGINAL PLAN	DATE
DRAWN BY	
TRACED BY	
NOTES BY	
CHECKED BY	

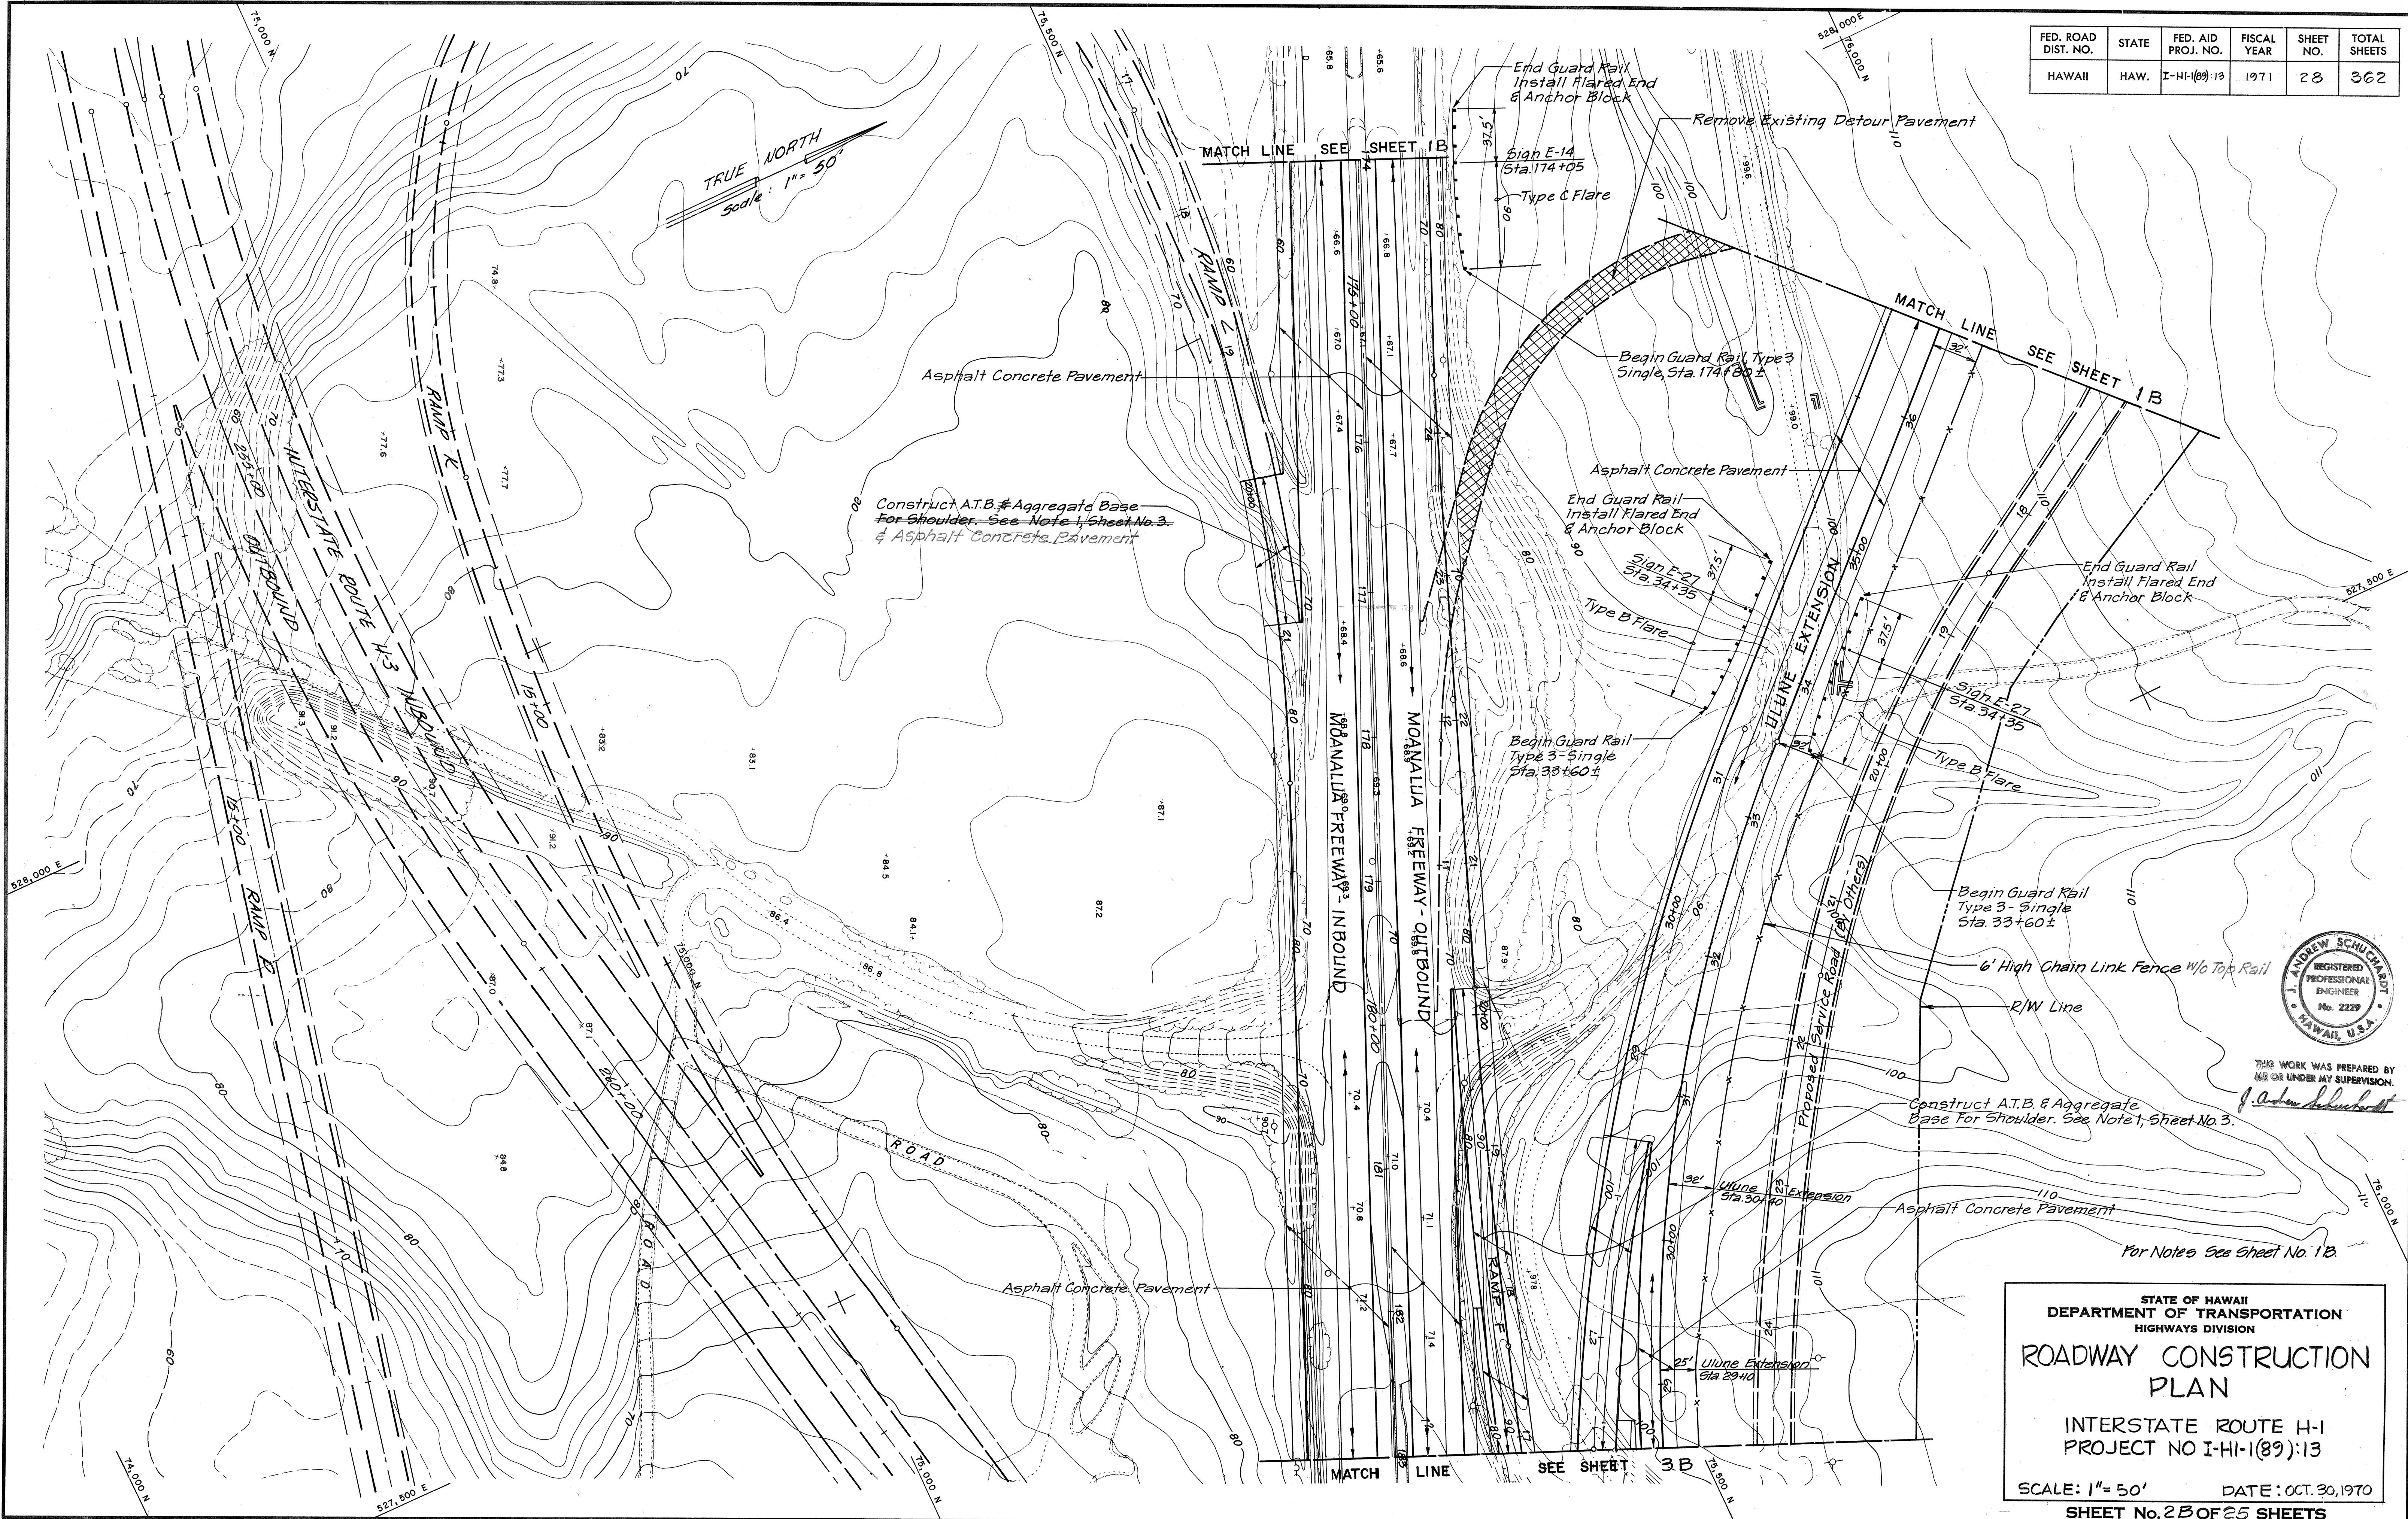

STATE OF HAWAII
DEPARTMENT OF TRANSPORTATION
HIGHWAYS DIVISION

ROADWAY CONSTRUCTION
PLAN


INTERSTATE ROUTE H-1
PROJECT NO I-HI-1(89):13

SCALE: 1"= 50'
DATE: OCT. 30, 1970

SHEET No. 28 OF 25 SHEETS

FED. ROAD DIST. NO.	STATE	FED. AID PROJ. NO.	FISCAL YEAR	SHEET NO.	TOTAL SHEETS
HAWAII	HAW.	I-H-1(89):13	1971	27	362

DATE	*****
DESIGNED BY	*****
CHECKED BY	*****
NOTED BY	*****
ORIGINAL PLAN	*****

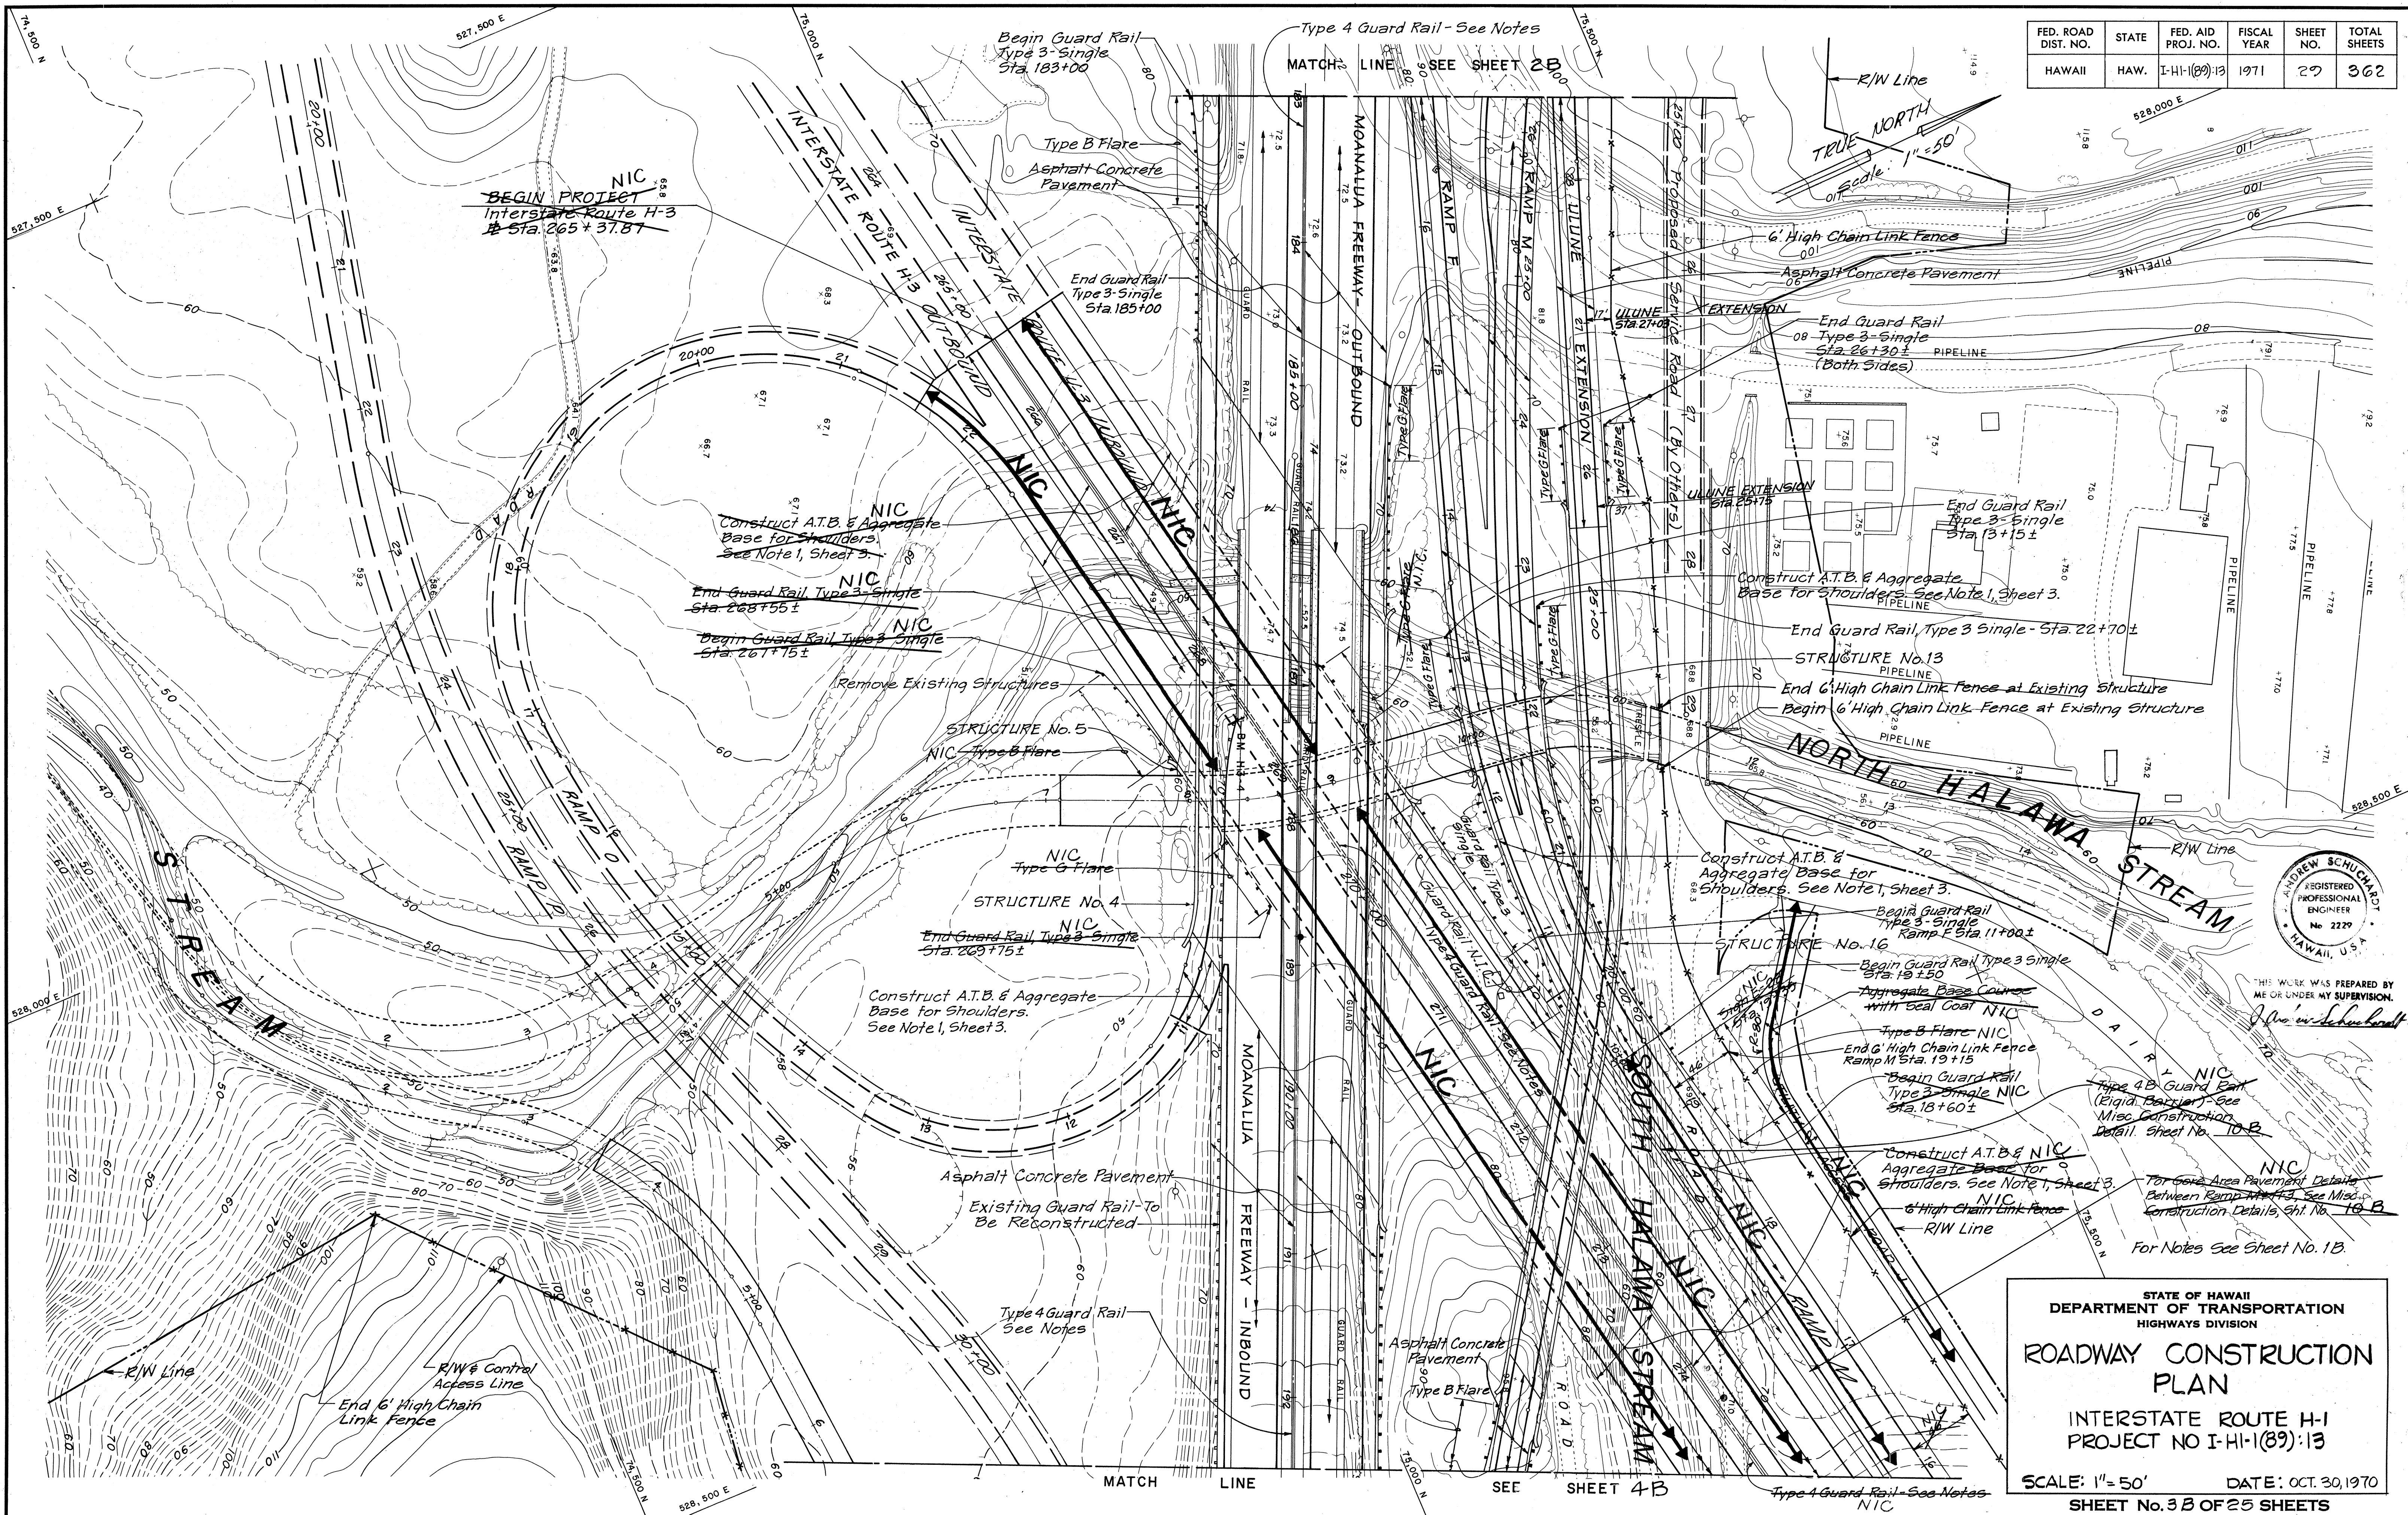

STATE OF HAWAII
DEPARTMENT OF TRANSPORTATION
HIGHWAYS DIVISION


ROADWAY CONSTRUCTION PLAN

INTERSTATE ROUTE H-1
PROJECT NO. I-H-1(89):13

SCALE: 1"=50' DATE: OCT. 30, 1970

SHEET No. 3B OF 25 SHEETS

FED. ROAD DIST. NO.	STATE	FED. AID PROJ. NO.	FISCAL YEAR	SHEET NO.	TOTAL SHEETS
HAWAII	HAW.	I-HI-1(89):13	1971	30	362

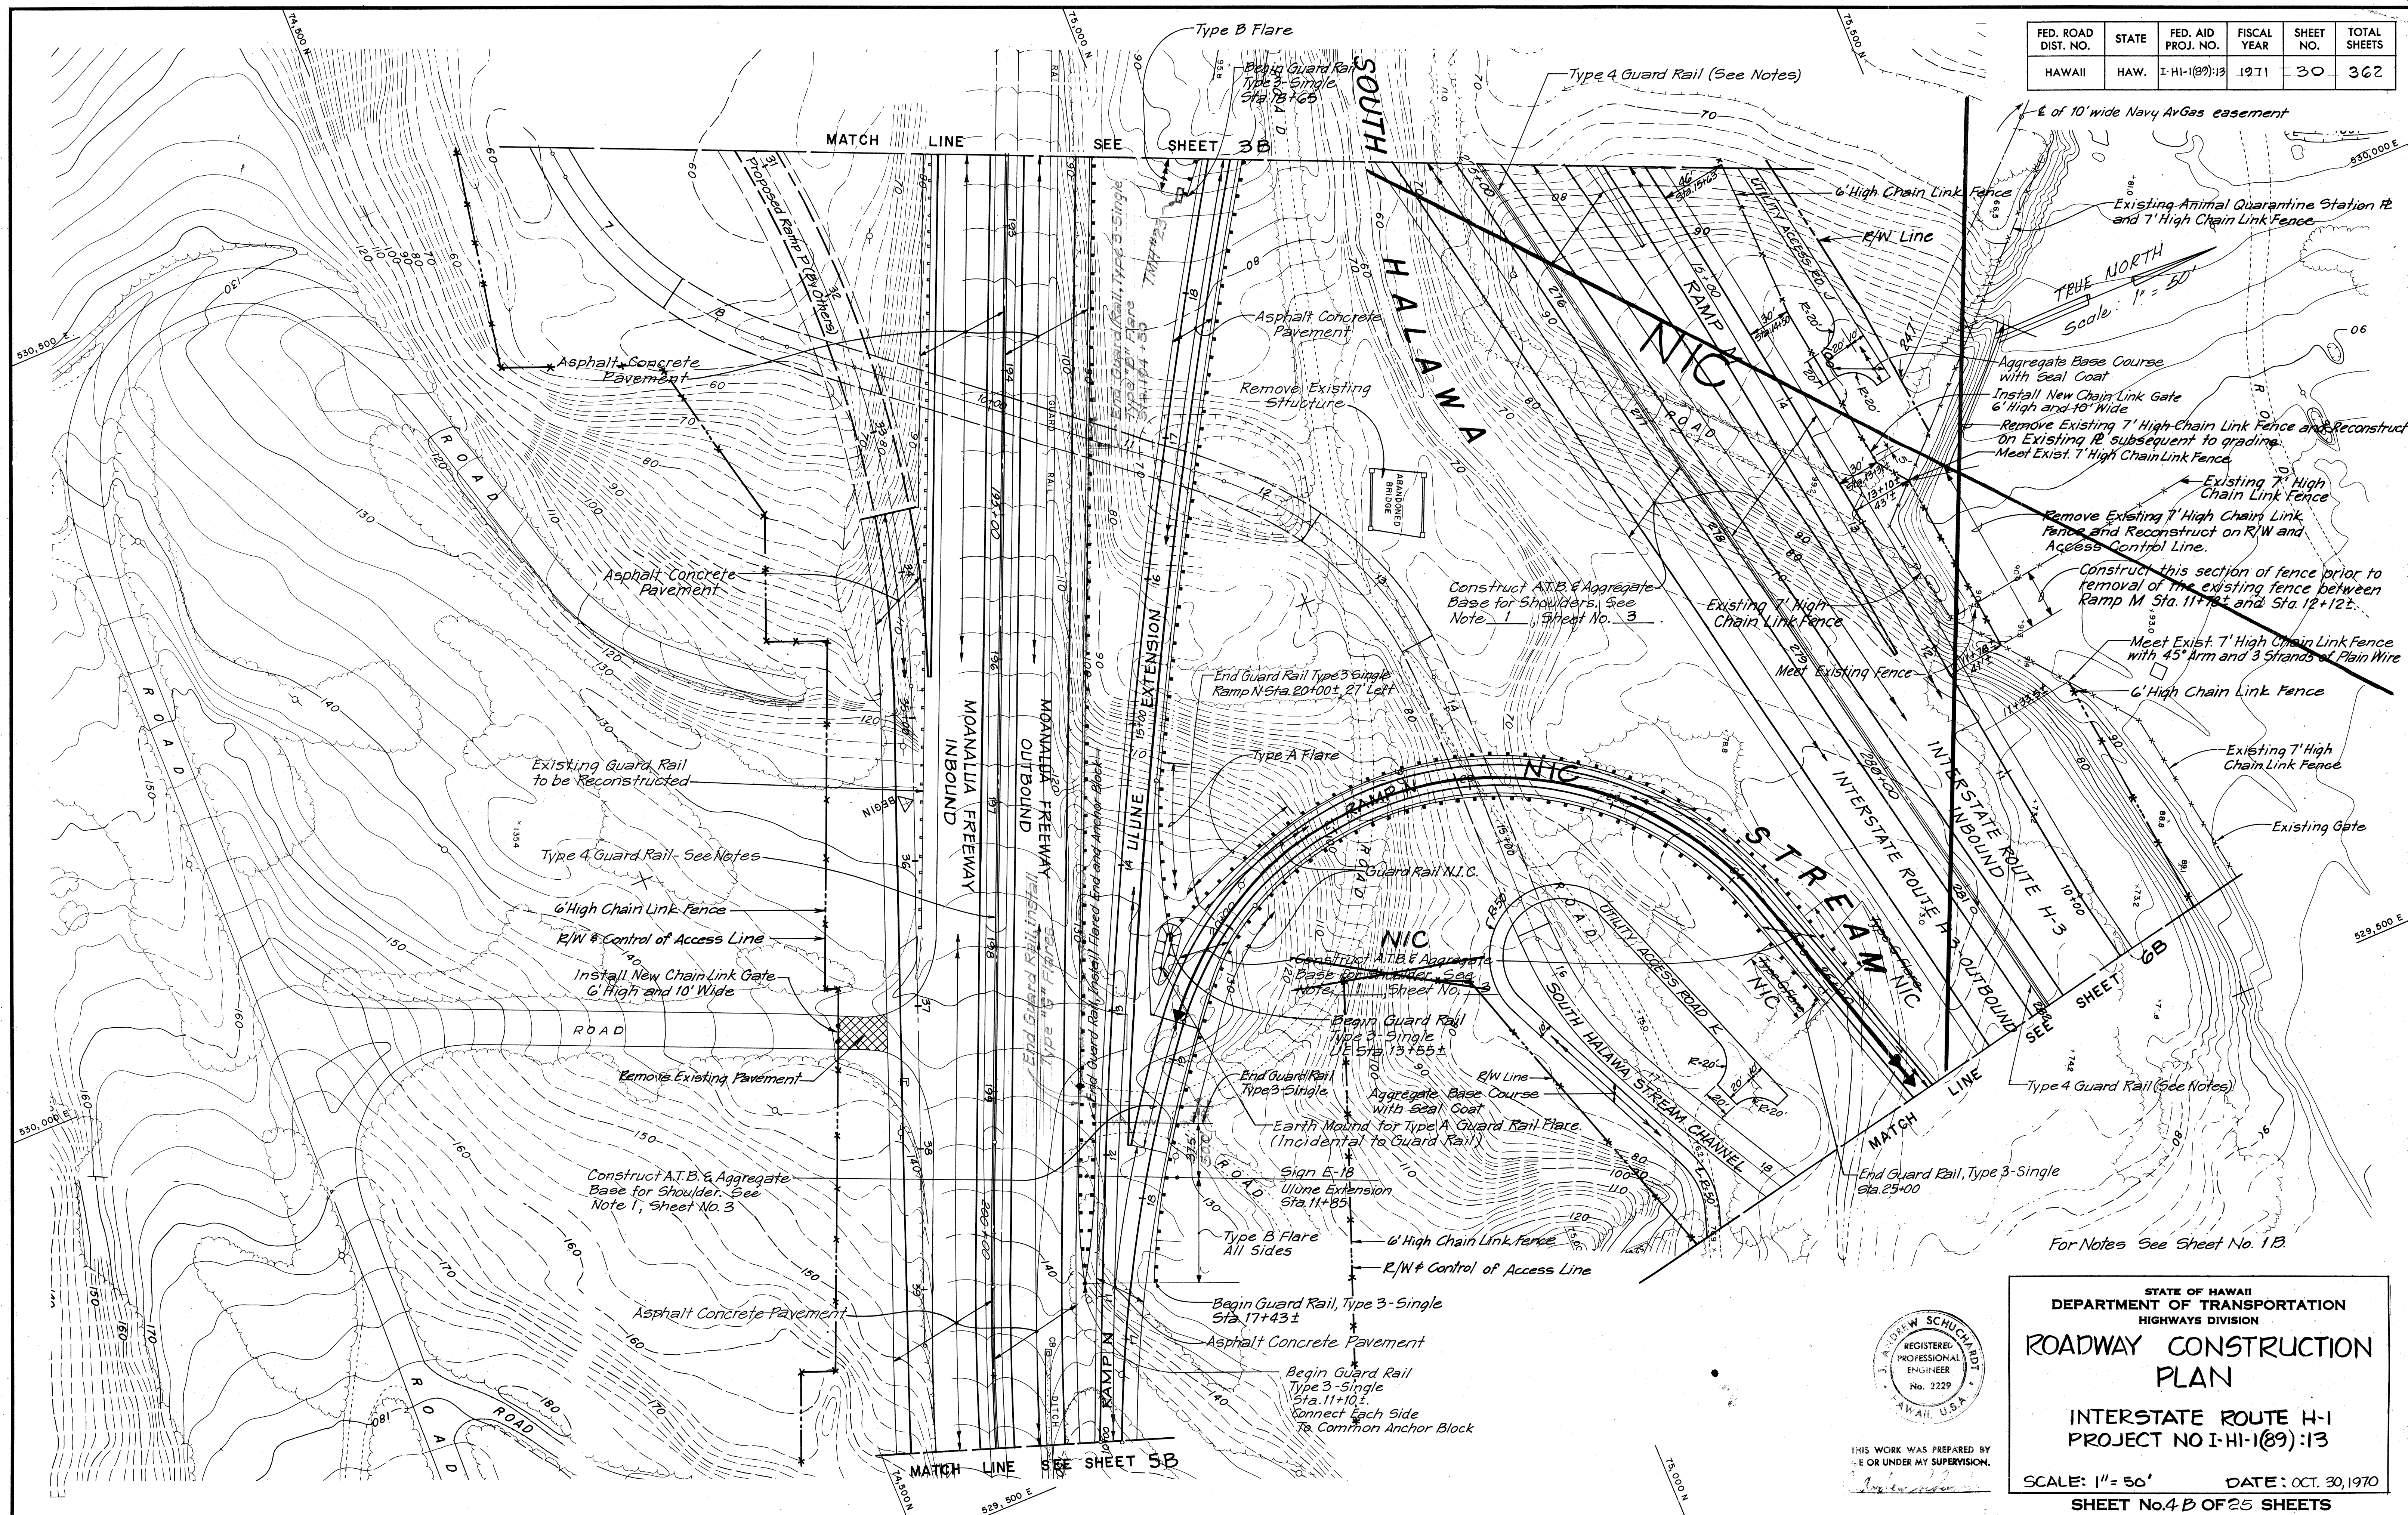

ORIGINAL PLAN	SURVEY PLOTTED BY _____	DATE _____
NOTE BOOK	DRAWN BY _____	" _____
	TRACED BY _____	" _____
	DESIGNED BY _____	" _____
	QUANTITIES BY _____	" _____
No. _____	CHECKED BY _____	" _____



THIS WORK WAS PREPARED BY
ME OR UNDER MY SUPERVISION.


STATE OF HAWAII
DEPARTMENT OF TRANSPORTATION
HIGHWAYS DIVISION

ROADWAY CONSTRUCTION
PLAN

INTERSTATE ROUTE 4-1
PROJECT NO I-HI-1(89):13

SCALE: 1" = 50' DATE: OCT. 30, 1970
SHEET No. 4B OF 25 SHEETS

FED. ROAD DIST. NO.	STATE	FED. AID PROJ. NO.	FISCAL YEAR	SHEET NO.	TOTAL SHEETS
HAWAII	HAW.	I-HI-1(89):13	1971	31	362

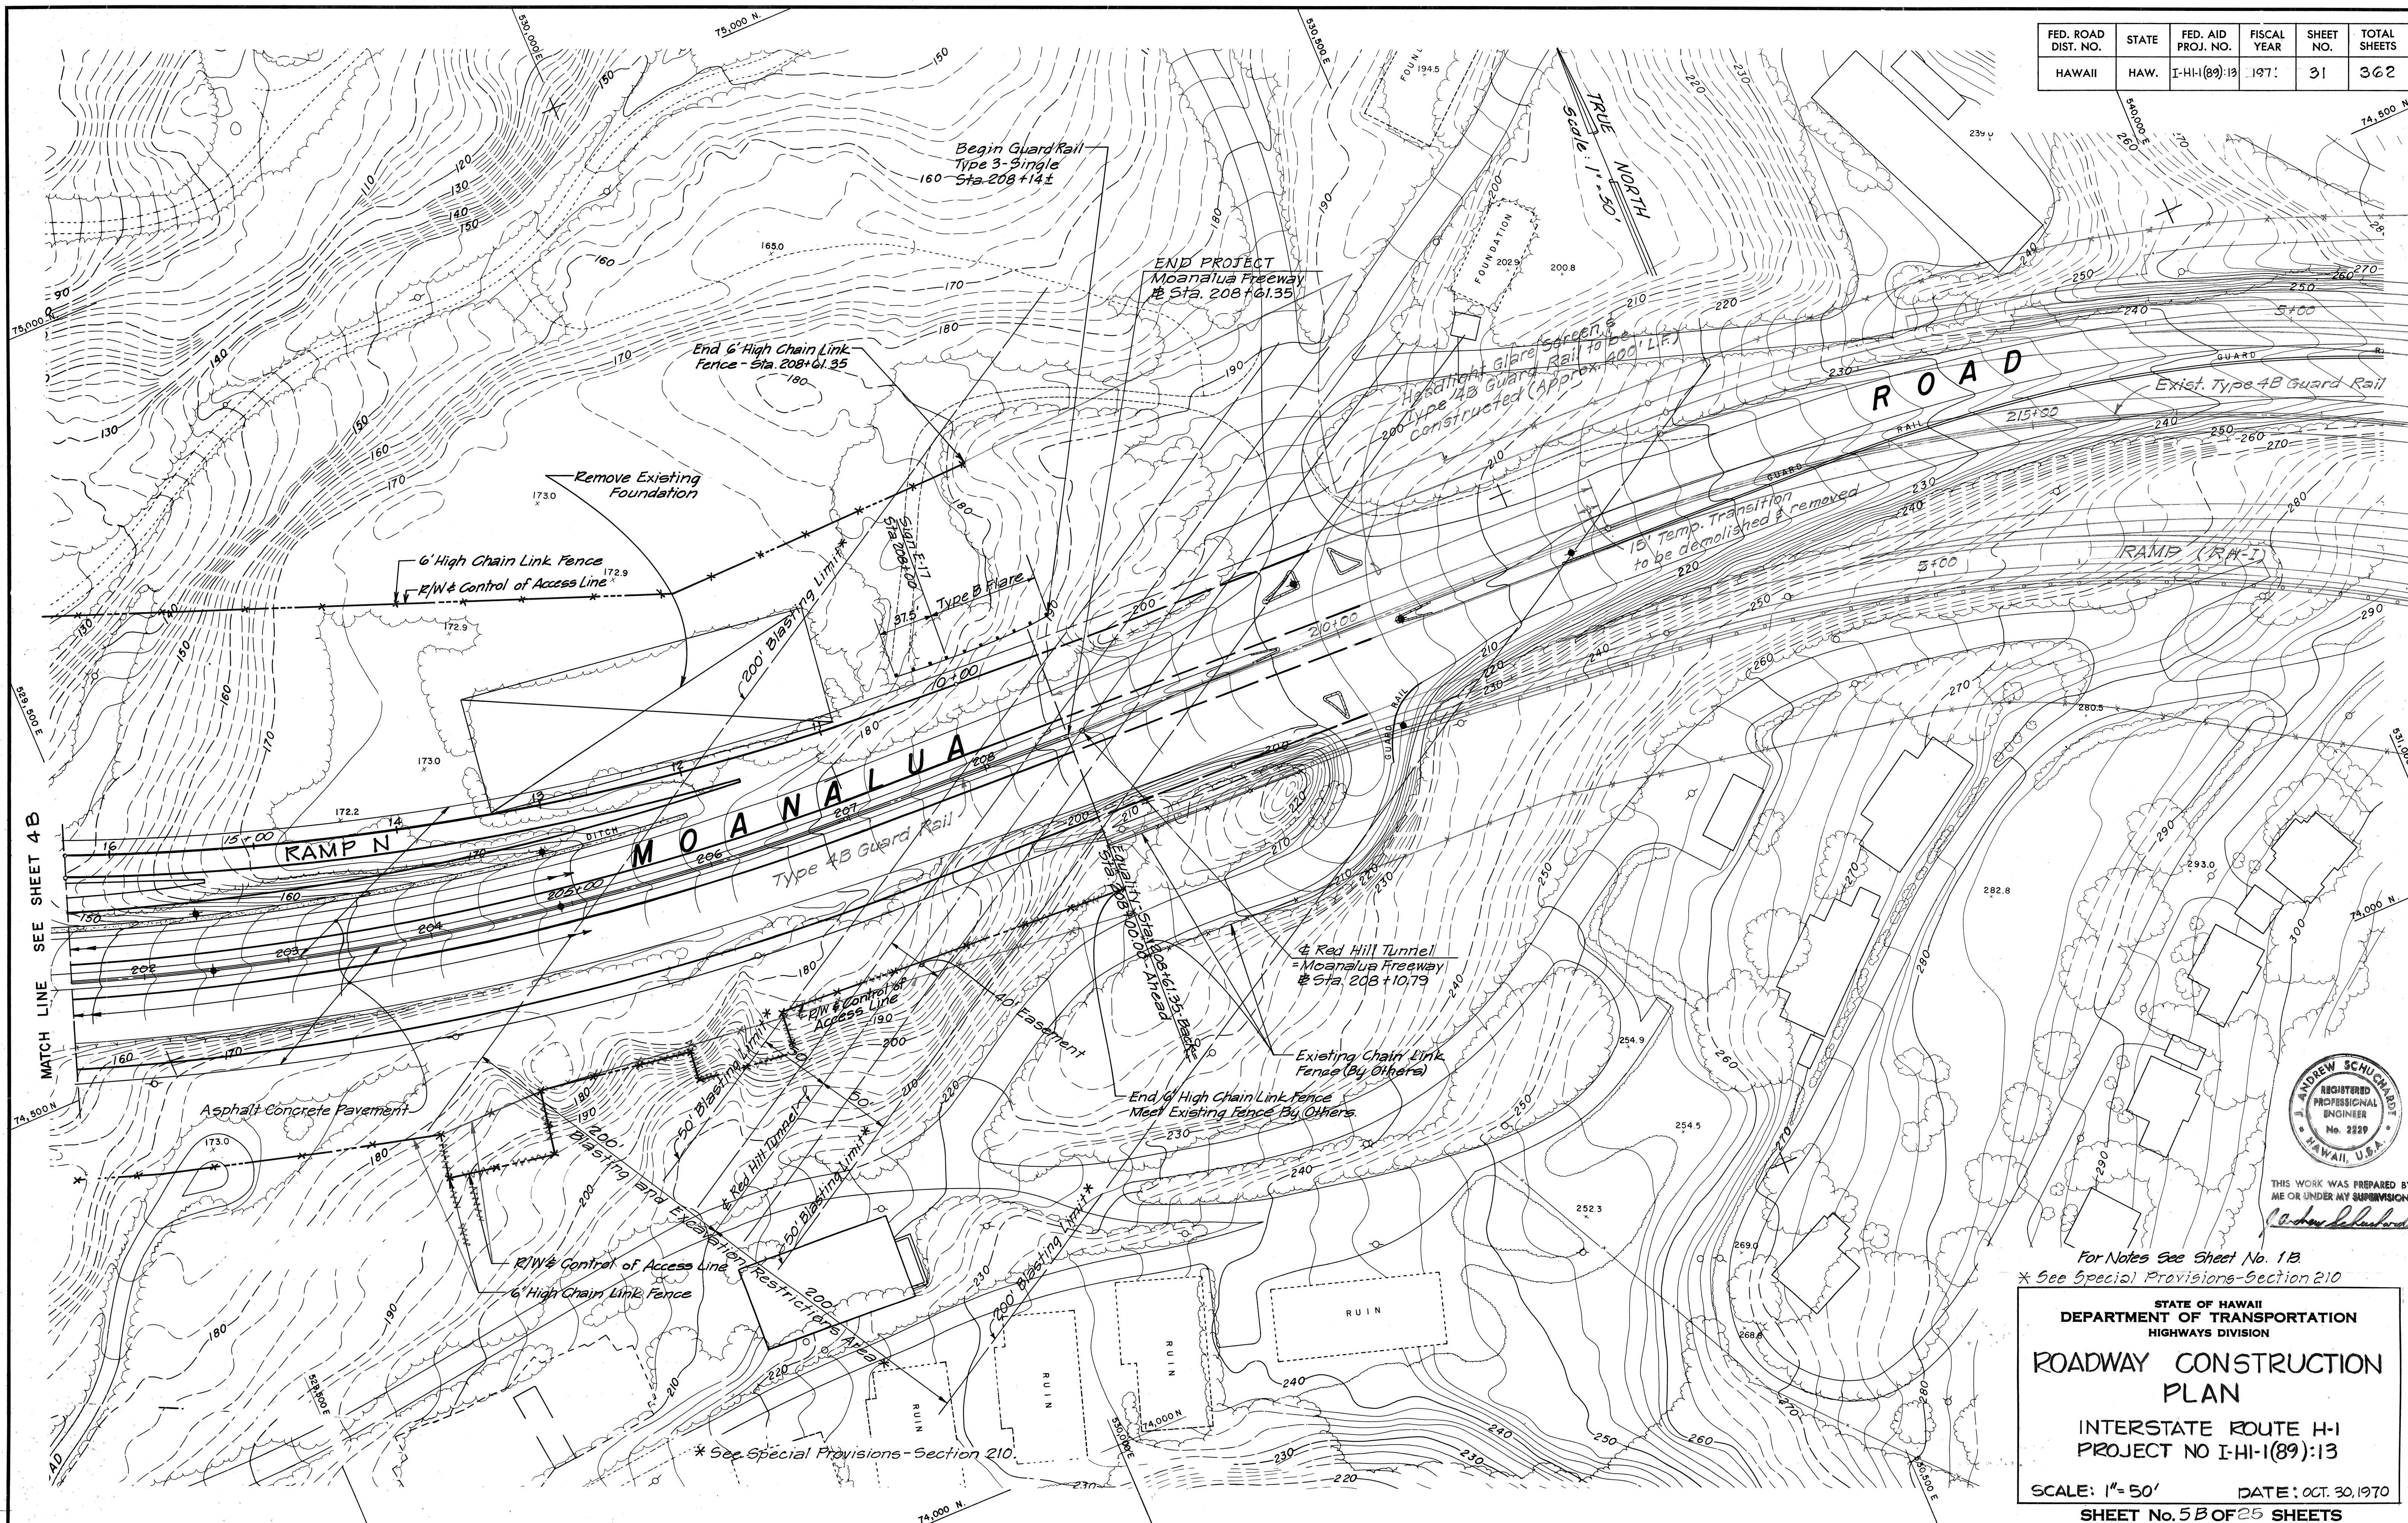

ORIGINAL PLAN	SURVEY PLOTTED BY _____ DATE _____ DRAWN BY _____ TRACED BY _____ DESIGNED BY _____ QUANTITIES BY _____ CHECKED BY _____
No. _____	



THIS WORK WAS PREPARED BY
ME OR UNDER MY SUPERVISION
Arthur Schuchard

For Notes See Sheet No. 1B.
* See Special Provisions-Section 210


STATE OF HAWAII
DEPARTMENT OF TRANSPORTATION
HIGHWAYS DIVISION

ROADWAY CONSTRUCTION
PLAN

INTERSTATE ROUTE H-1
PROJECT NO T-HI-1(89):13

SCALE: 1" = 50' DATE: OCT. 30, 1970
SHEET No. 5B OF 25 SHEETS

FED. ROAD DIST. NO.	STATE	FED. AID PROJ. NO.	FISCAL YEAR	SHEET NO.	TOTAL SHEETS
HAWAII	HAW.	I-HI-1(89)-13	1971	32	362

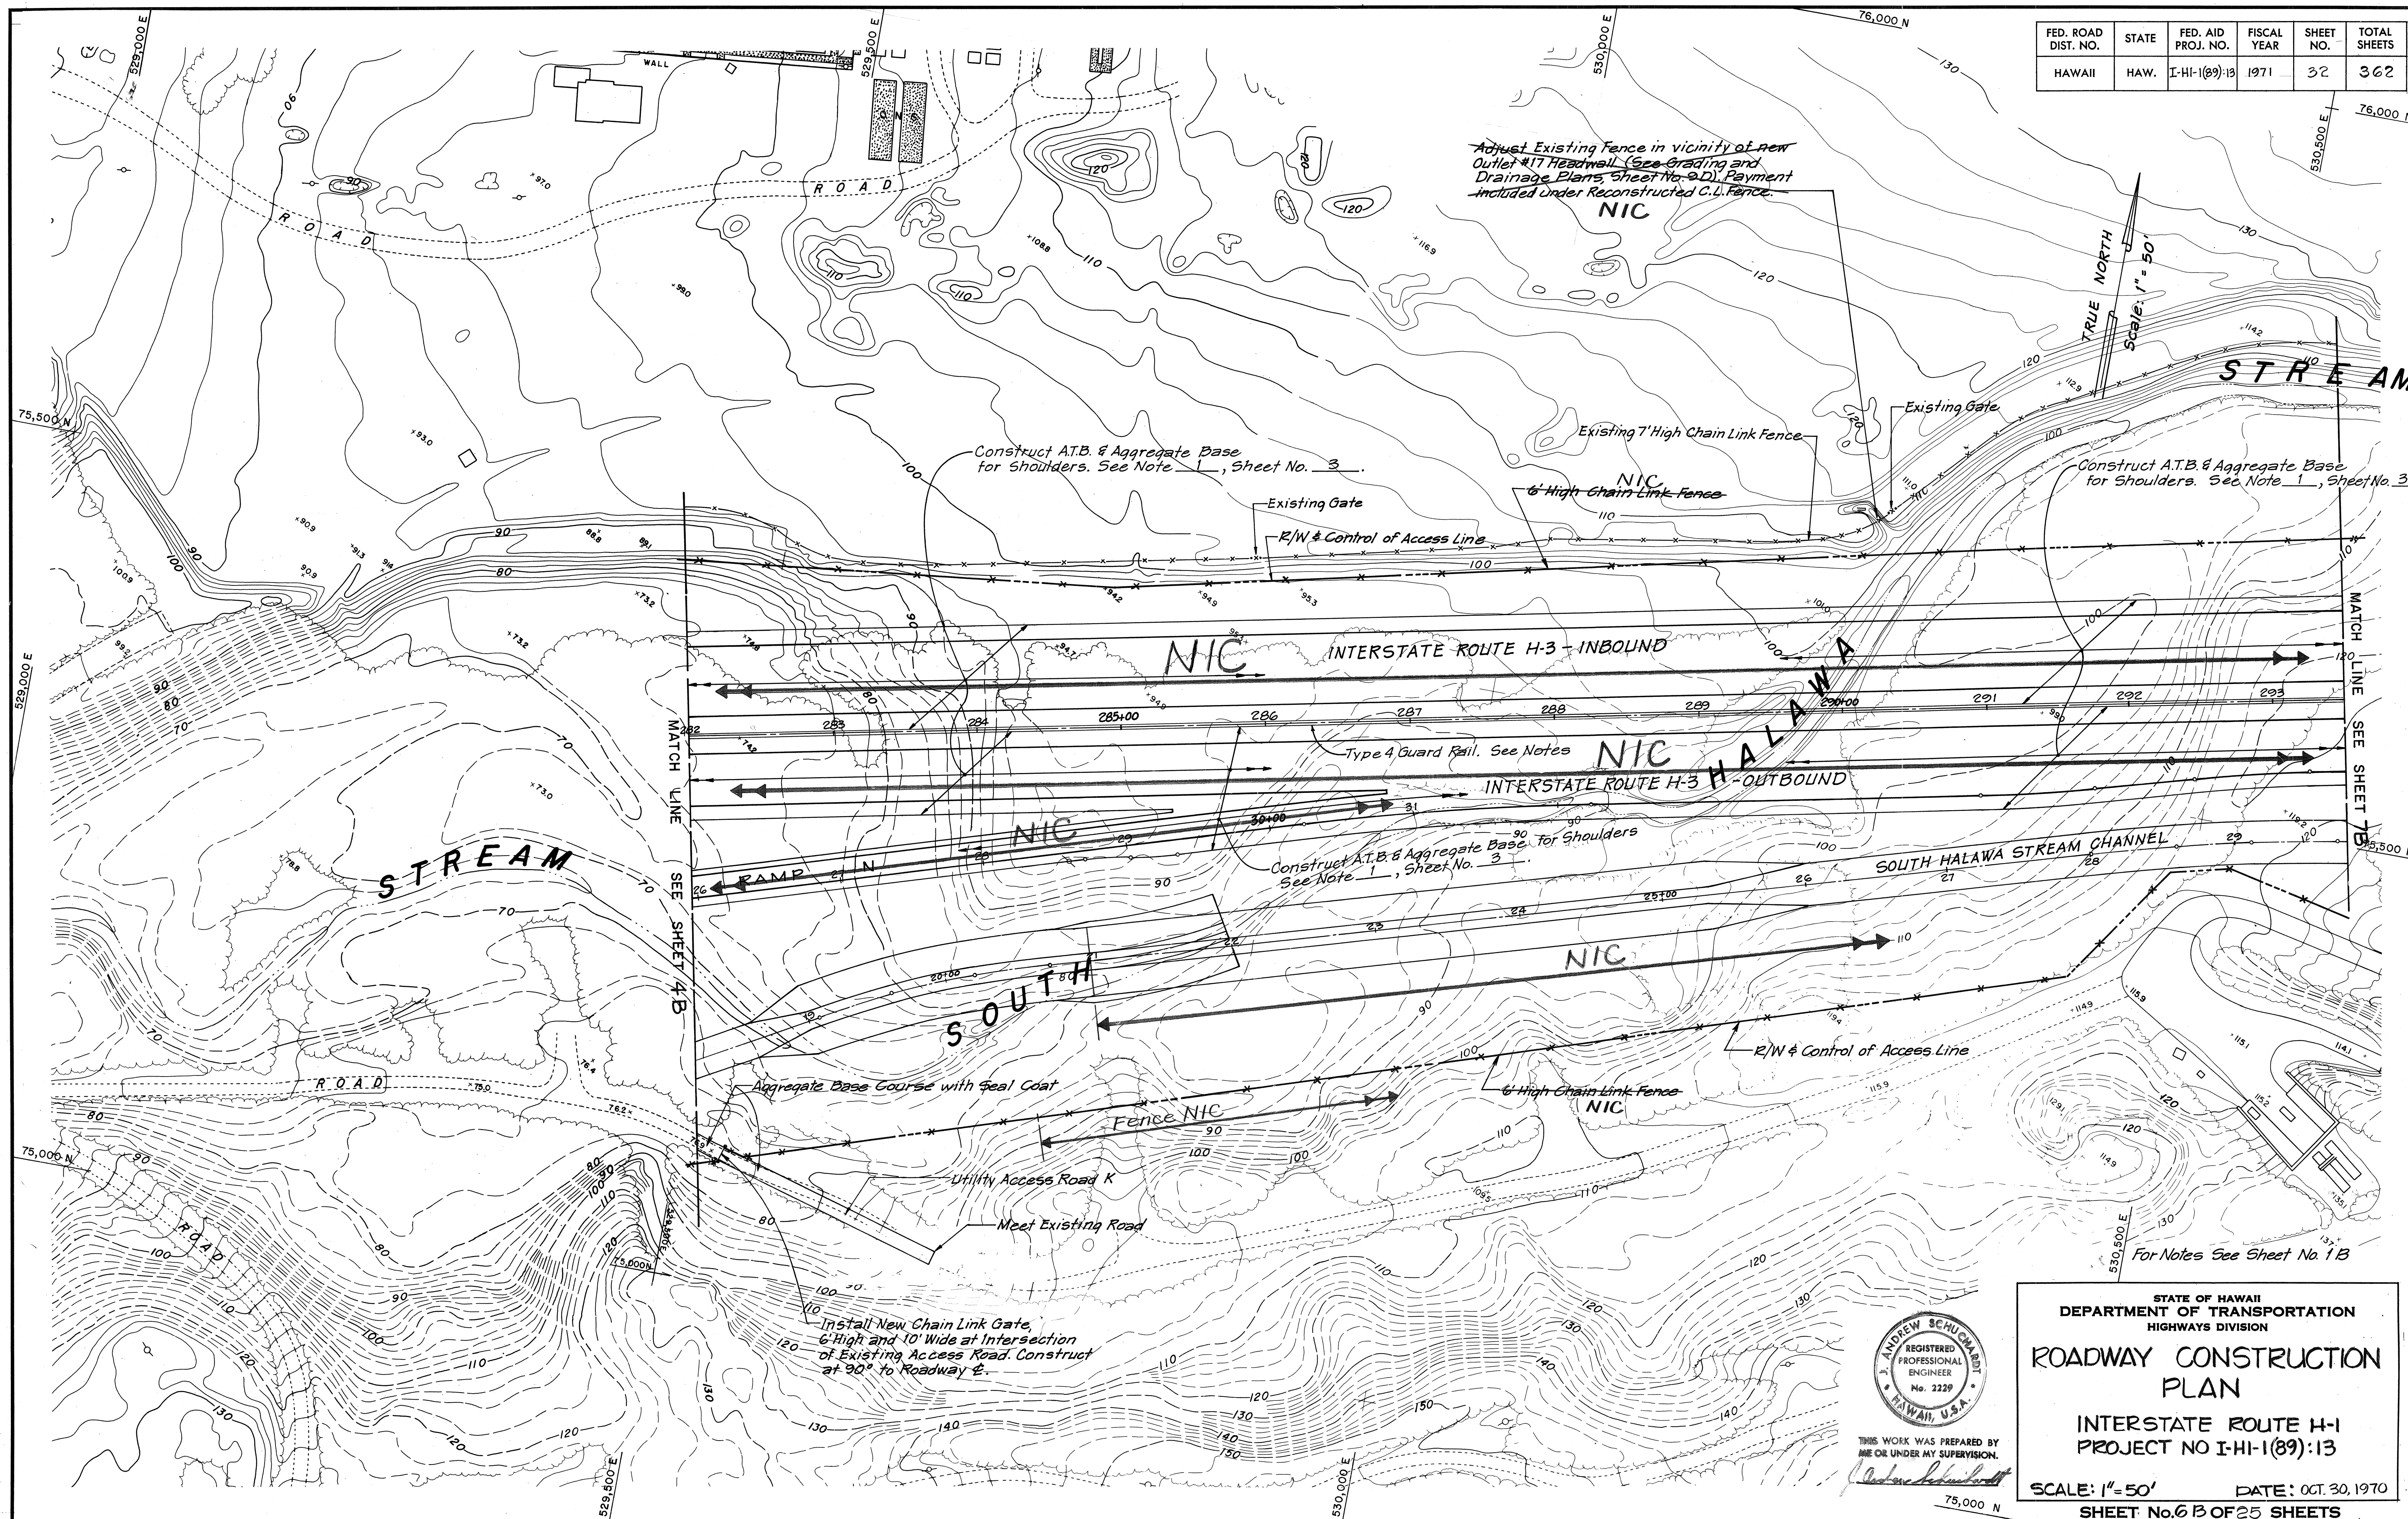

ORIGINAL	SURVEY PLOTTED BY	DATE
PLAN	DRAWN BY	"
	TRACED BY	"
NOTE BOOK	DESIGNED BY	"
	QUANTITIES BY	"
	CHECKED BY	"
No. _____		



THIS WORK WAS PREPARED BY
ME OR UNDER MY SUPERVISION


**STATE OF HAWAII
DEPARTMENT OF TRANSPORTATION
HIGHWAYS DIVISION**

ROADWAY CONSTRUCTION PLAN


INTERSTATE ROUTE 4-1
PROJECT NO I-HI-1(89):13

SCALE: 1"=50' DATE: OCT. 30, 1970
SHEET No. 63 OF 25 SHEETS

FED. ROAD DIST. NO.	STATE	FED. AID PROJ. NO.	FISCAL YEAR	SHEET NO.	TOTAL SHEETS
HAWAII	HAW.	I-H-1(89):13	1971	33	362

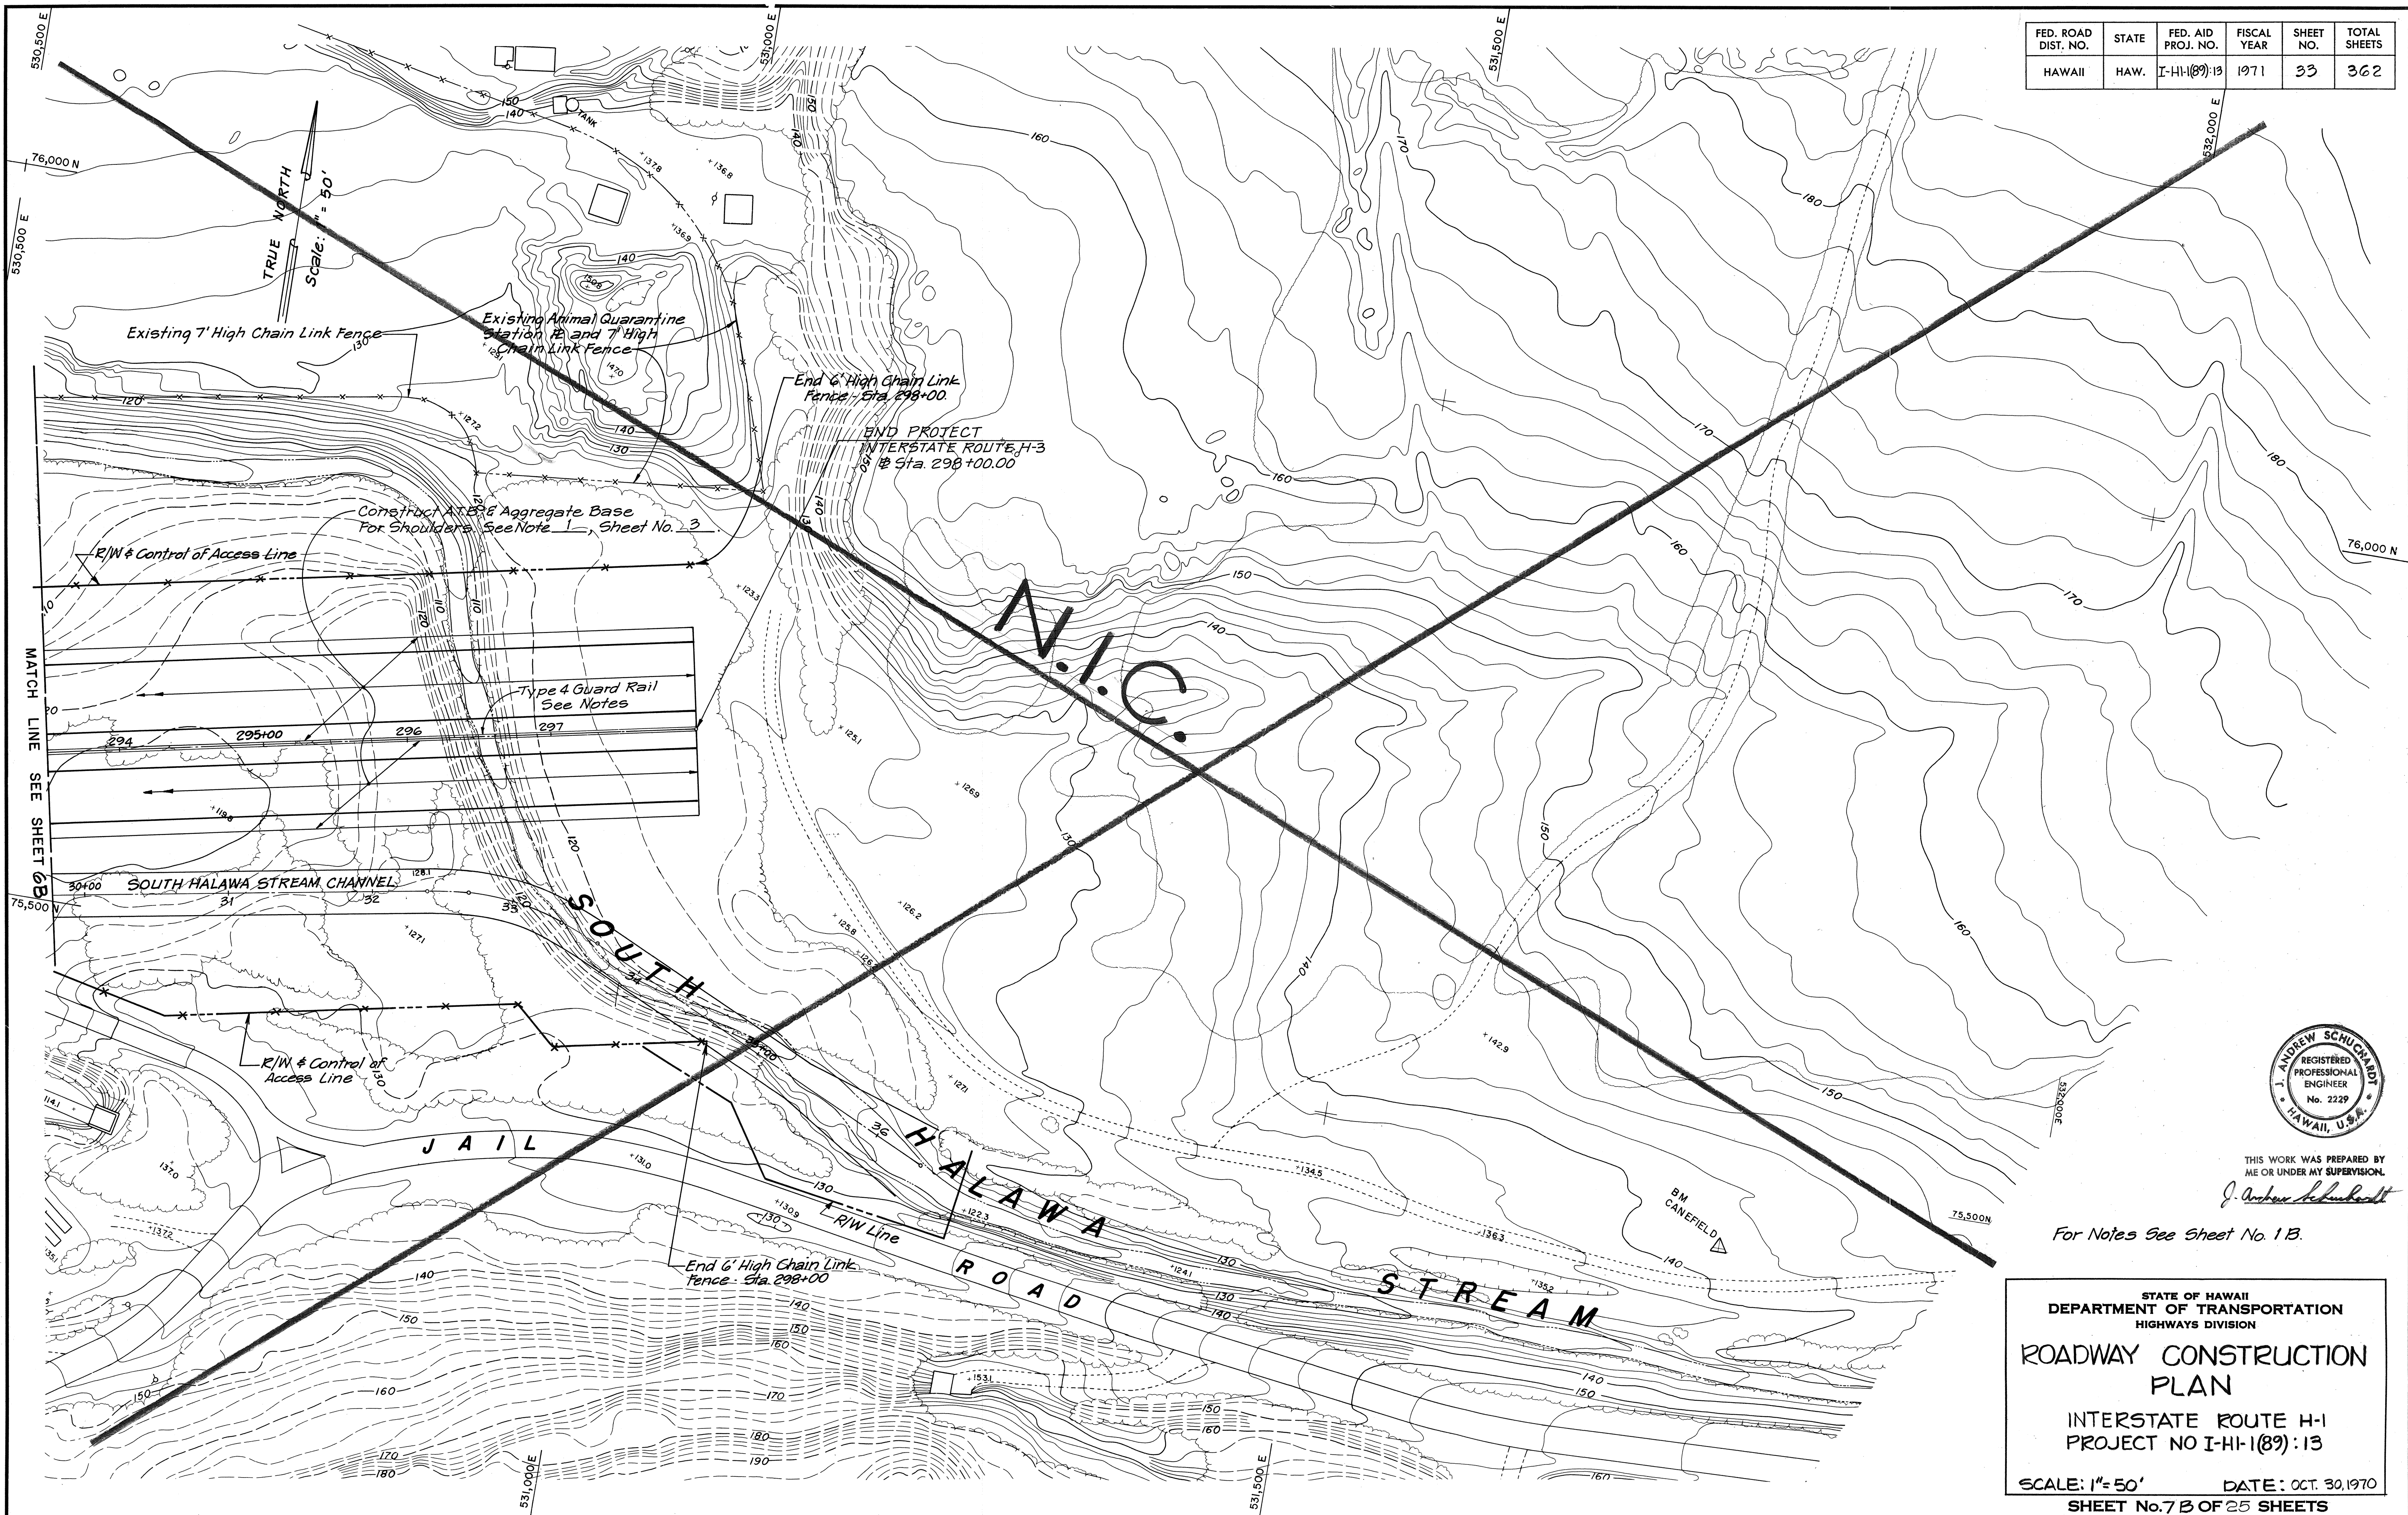

DATE	_____
SURVEY PLOTTED BY	_____
DRAWN BY	_____
DESIGNED BY	_____
CHECKED BY	_____
ORIGINAL PLAN	_____
NOTE BOOK	_____
No.	_____

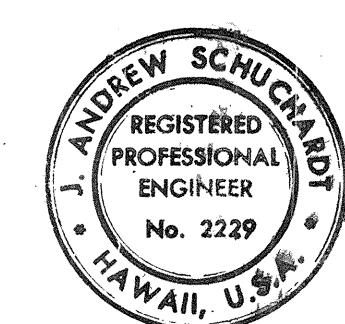


THIS WORK WAS PREPARED BY
ME OR UNDER MY SUPERVISION.
J. Andrew Schuchardt

For Notes See Sheet No. 1 B.

STATE OF HAWAII
DEPARTMENT OF TRANSPORTATION
HIGHWAYS DIVISION

ROADWAY CONSTRUCTION
PLAN
INTERSTATE ROUTE H-1
PROJECT NO I-H-1(89):13
SCALE: 1" = 50' DATE: OCT. 30, 1970
SHEET No. 7 B OF 25 SHEETS

FED. ROAD DIST. NO.	STATE	FED. AID PROJ. NO.	FISCAL YEAR	SHEET NO.	TOTAL SHEETS
HAWAII	HAW.	I-HI-(89):13	1971	34	302

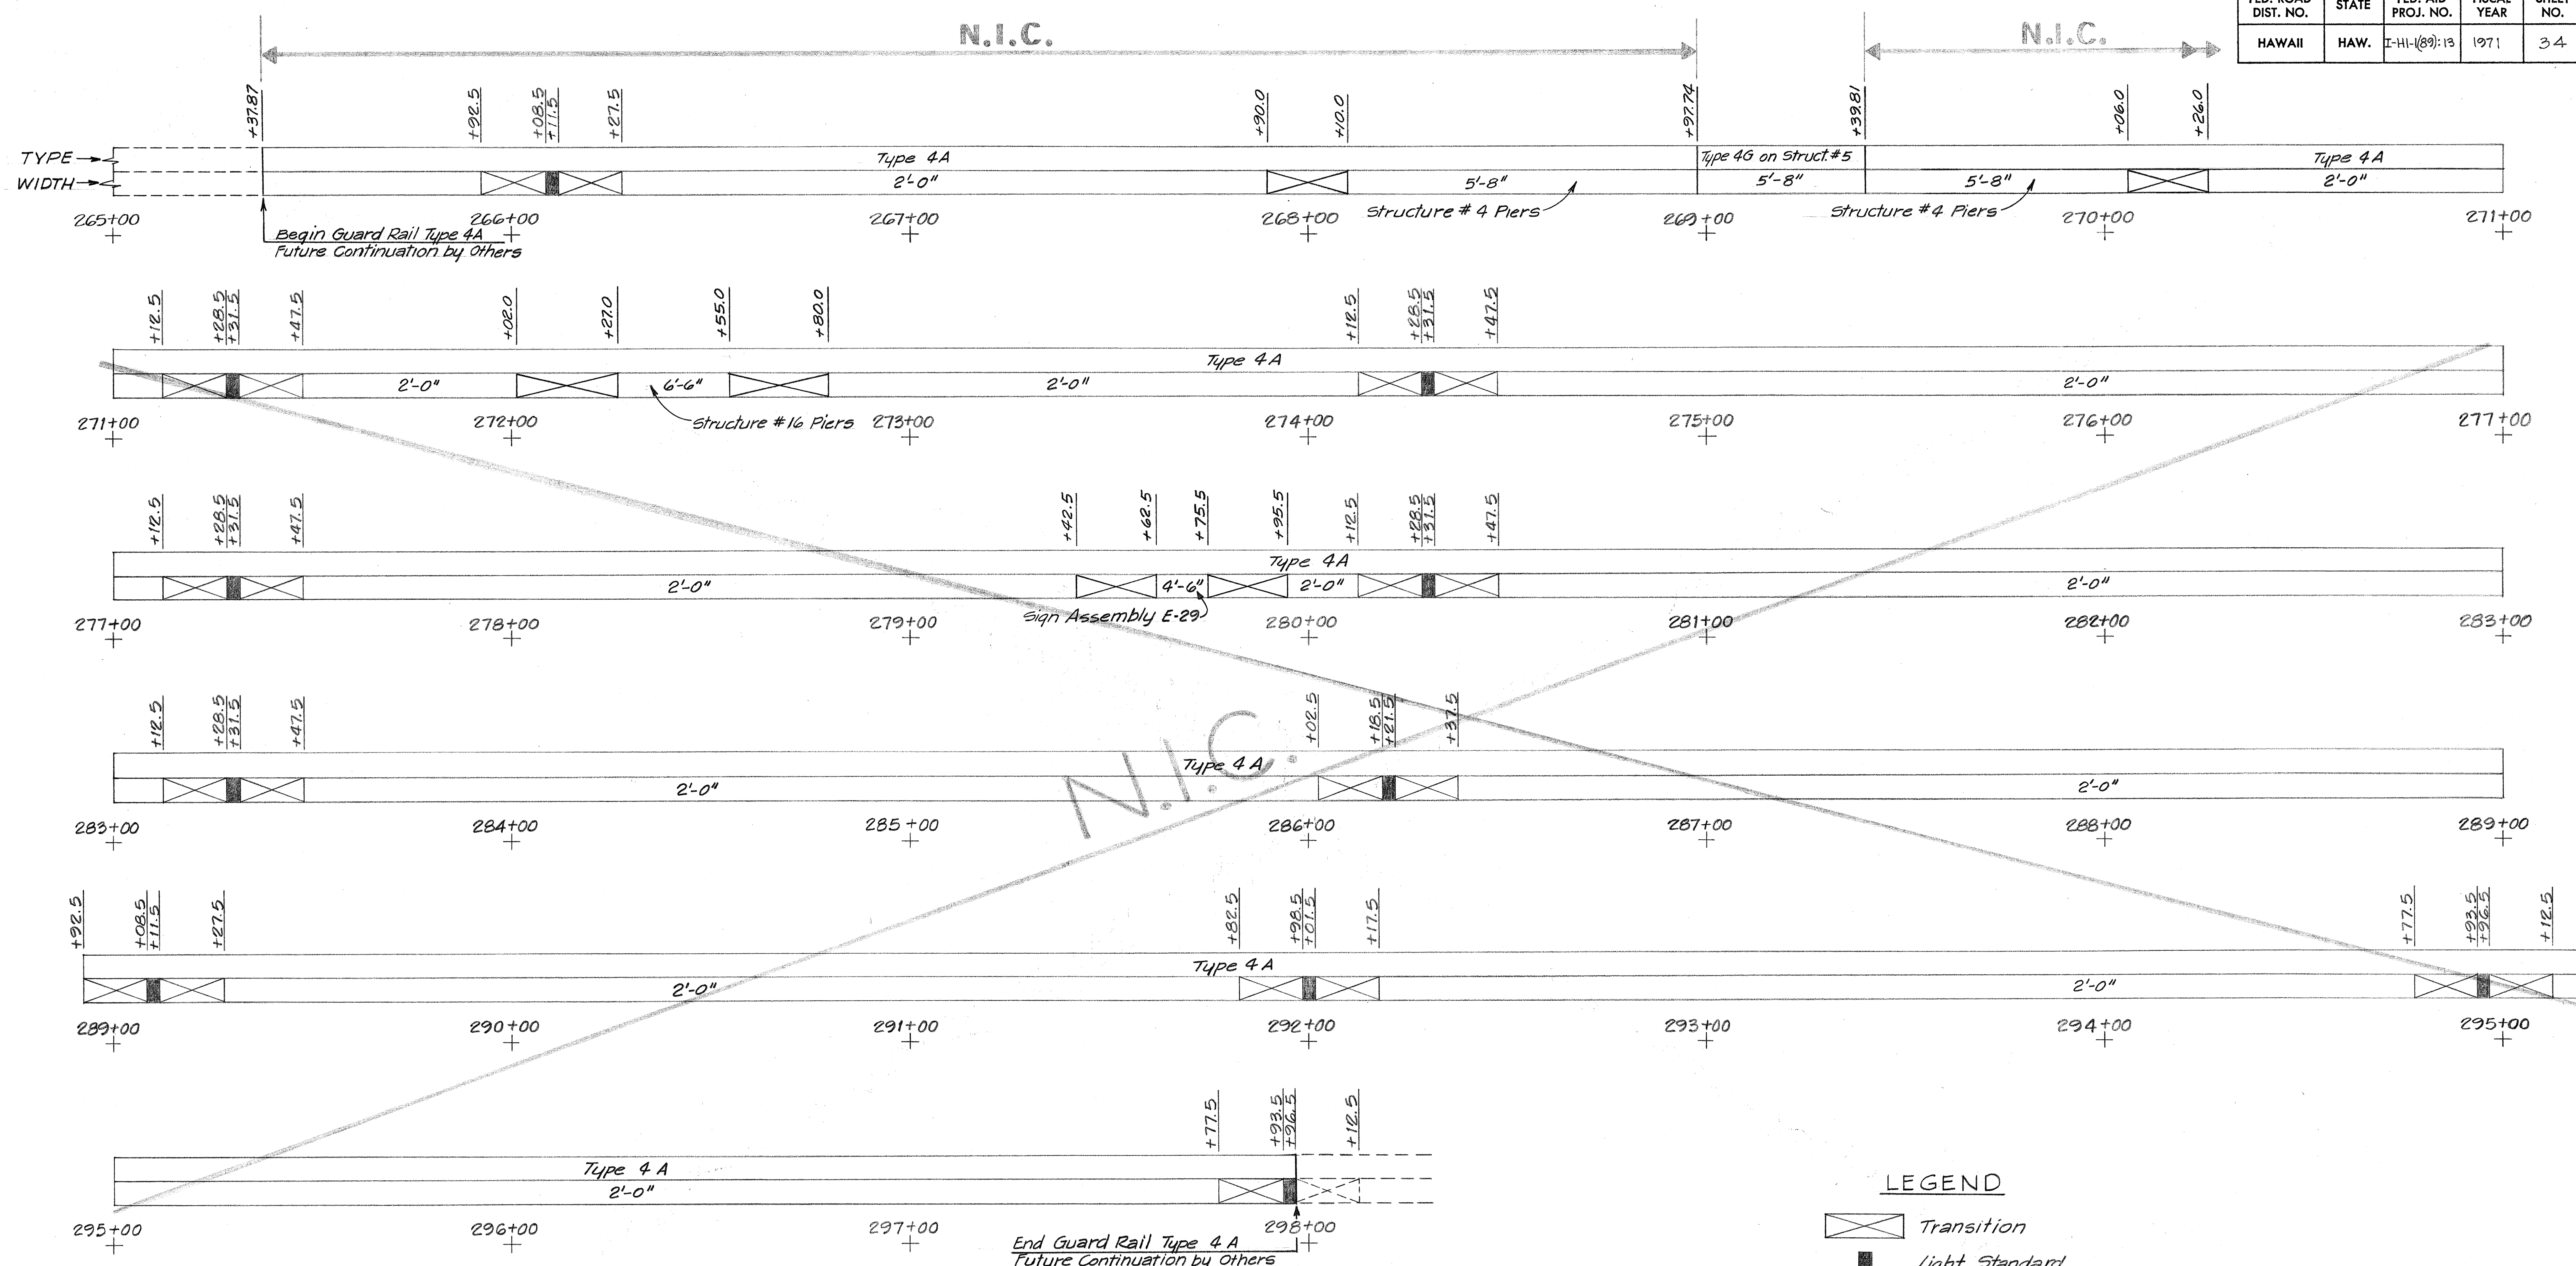

INTERSTATE ROUTE H-3 STATIONING

LEGEND

- Transition
- Light Standard

NOTES:

- Guard Rail Types 4A, 4B and 4C to be paid on a linear foot basis, including transitions and widened sections around bridge piers and overhead sign support structures.
- The three (3) foot widened section of Rigid Barrier around a lighting standard is to be included in the cost of the lighting standard mounting. See Highway Lighting Details.
- Guard Rail Types 4F and 4G are paid for as bridge items. For details see Structure Drawings.
- See Structure Drawings for widened sections of Rigid Barriers at piers.
- See Signing Plans, Sheet 19T, and Highway Lighting Plans, Sheet 10E, for Rigid Barrier Details at Sign Foundations and Lighting Standard Foundations.




THIS WORK WAS PREPARED BY
ME OR UNDER MY SUPERVISION.
J. Andrew Schuchardt

STATE OF HAWAII
DEPARTMENT OF TRANSPORTATION
HIGHWAYS DIVISION
MISCELLANEOUS ROADWAY DETAILS
RIGID BARRIER
VARIATIONS
INTERSTATE ROUTE H-1
PROJECT NO. I-HI-(89):13
NOT TO SCALE DATE: OCT. 30, 1970
SHEET No. 88 OF 25 SHEETS

ORIGINAL PLAN	SURVEY PLOTTED BY	DATE
NOTE BOOK	DRAWN BY	
	CHECKED BY	
	QUANTITIES BY	
	CHECKED BY	

FED. ROAD DIST. NO.	STATE	FED. AID PROJ. NO.	FISCAL YEAR	SHEET NO.	TOTAL SHEETS
HAWAII	HAW.	I-HI-1(89):13	1971	35	362

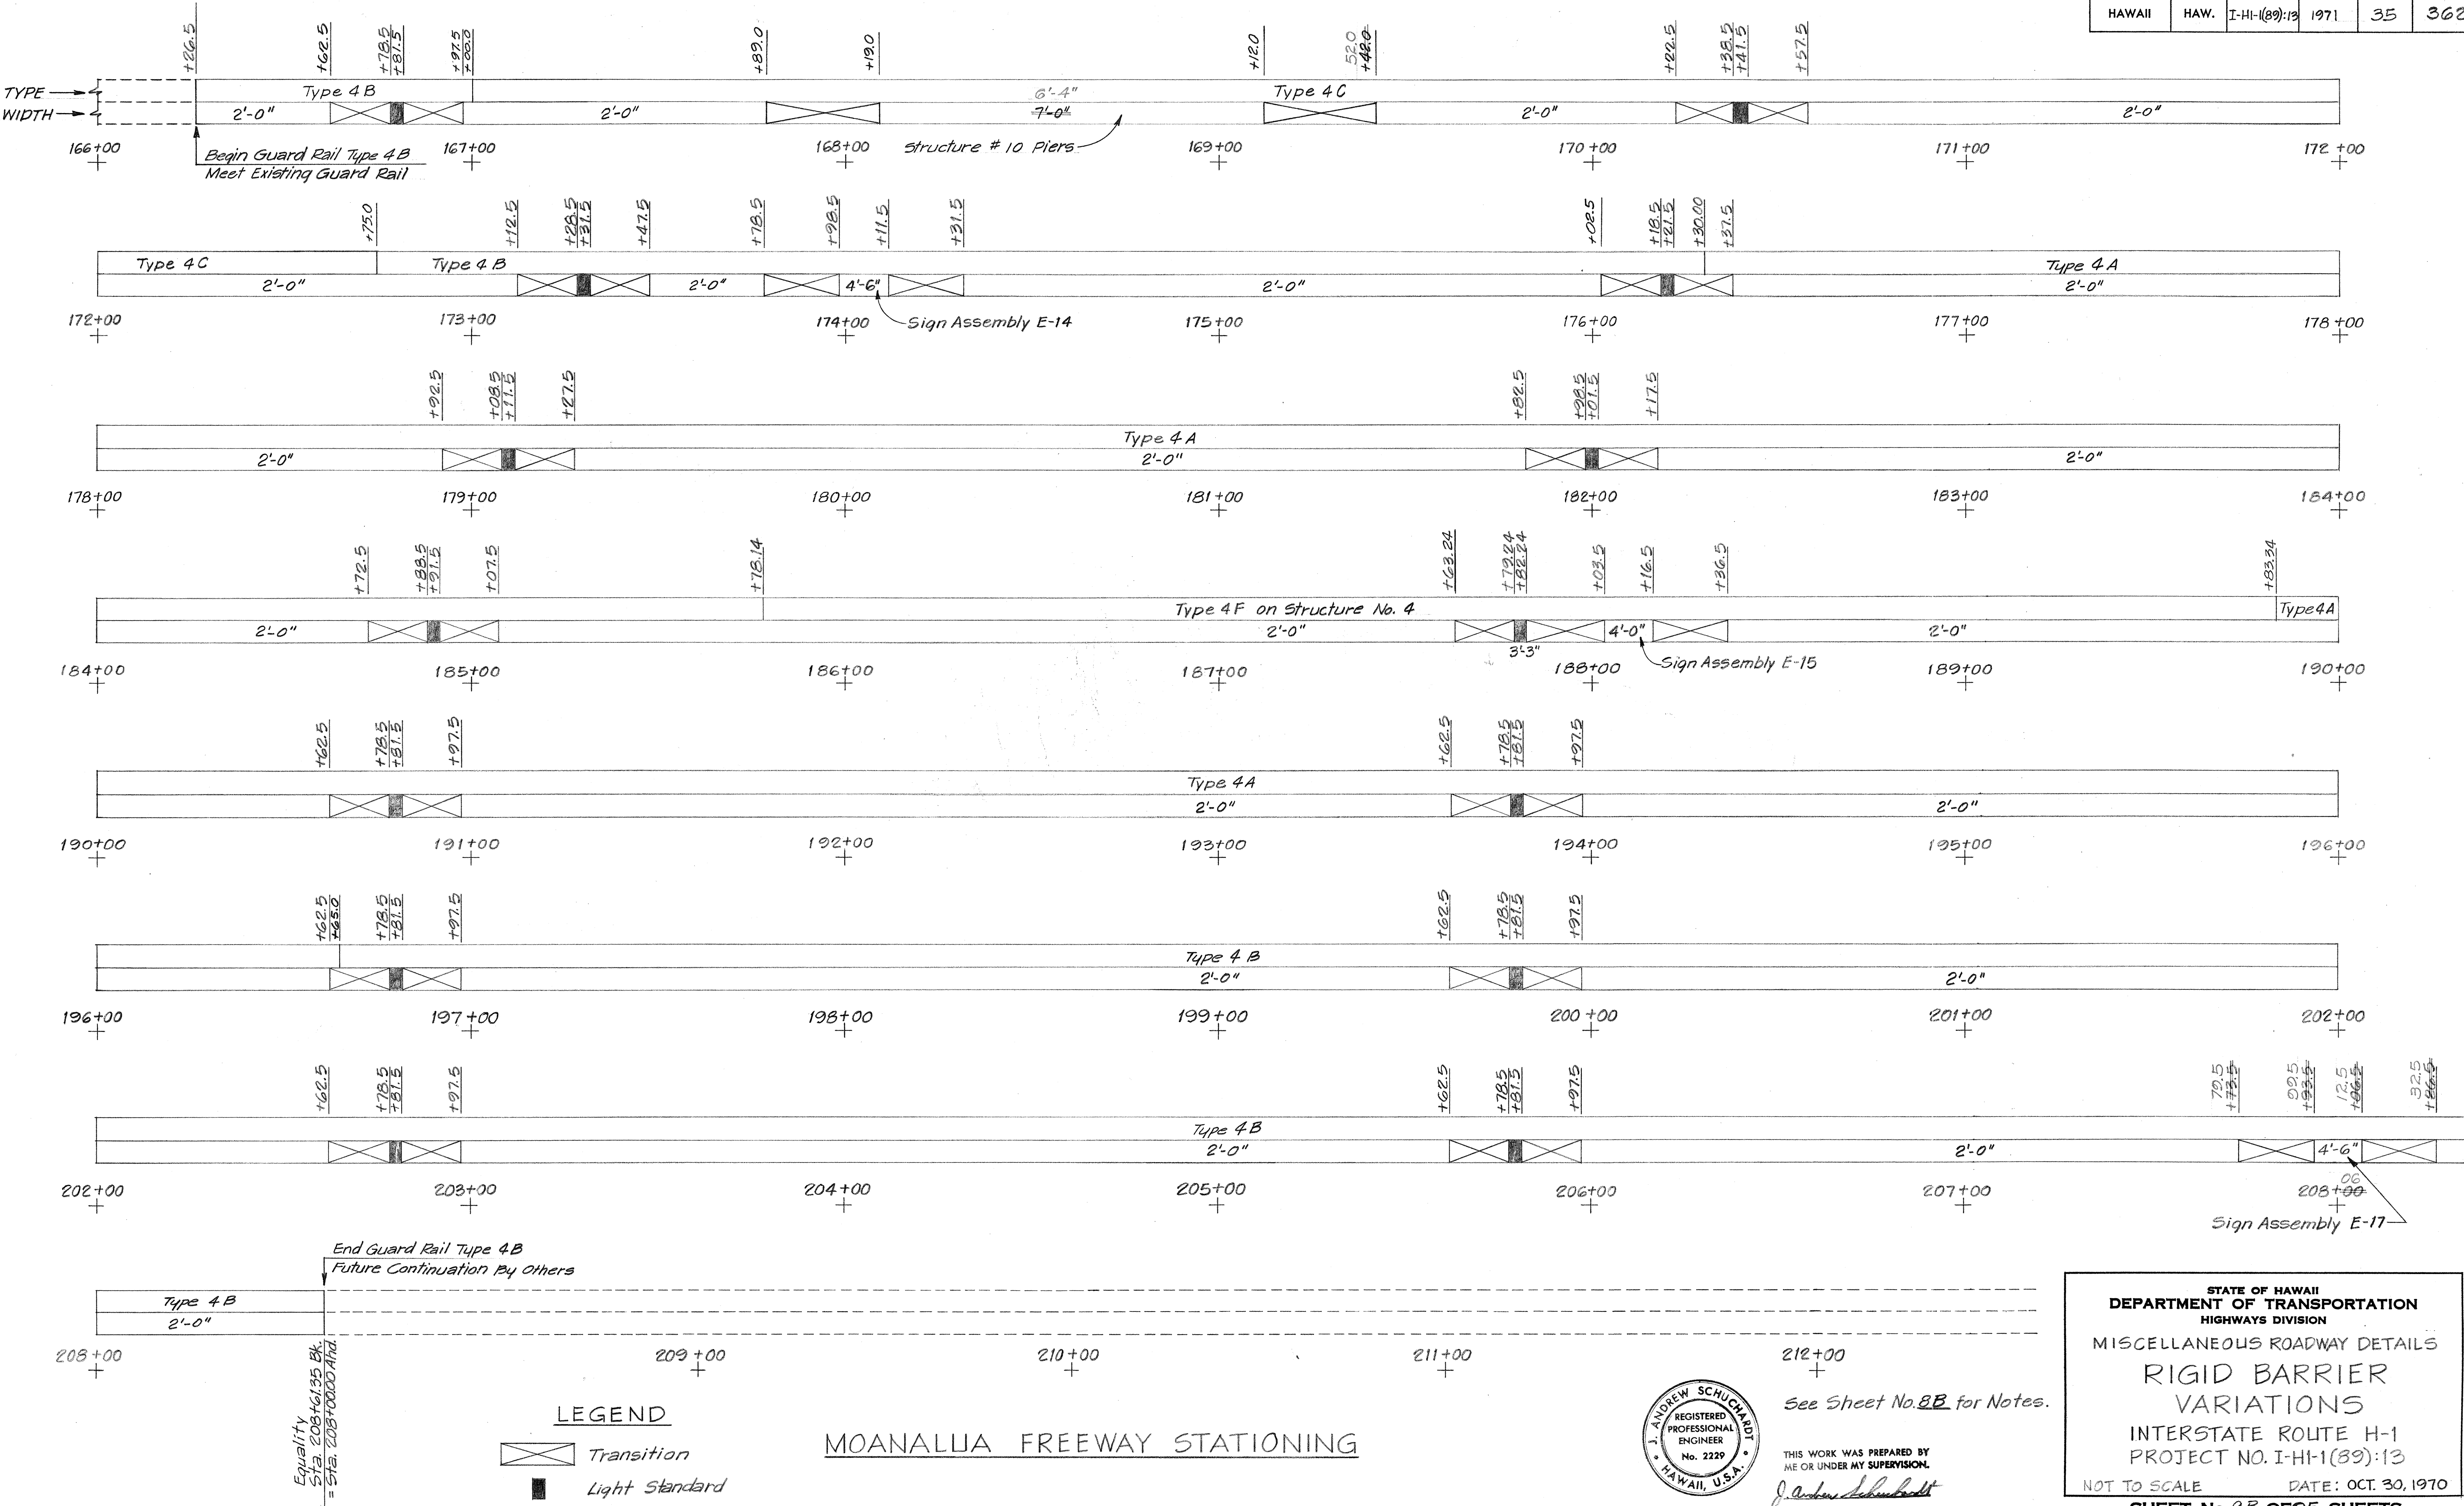


ORIGINAL PLAN	SURVEY PLOTTED BY	DATE
NOTE BOOK	DESIGNED BY	
	QUANTITIES BY	
	CHECKED BY	

LEGEND

Transition

Light Standard

MOANALUA FREEWAY STATIONING

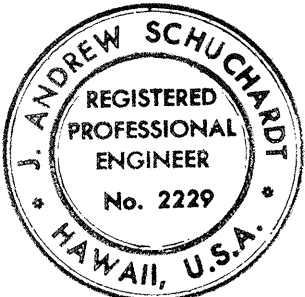

212+00
See Sheet No. 8B for Notes.

THIS WORK WAS PREPARED BY
ME OR UNDER MY SUPERVISION.

J. Andrew Schuchardt

STATE OF HAWAII
DEPARTMENT OF TRANSPORTATION
HIGHWAYS DIVISION

MISCELLANEOUS ROADWAY DETAILS

RIGID BARRIER VARIATIONS


INTERSTATE ROUTE H-1
PROJECT NO. I-HI-1(89):13

NOT TO SCALE DATE: OCT. 30, 1970


SHEET No. 9B OF 25 SHEETS

FED. ROAD DIST. NO.	STATE	FED. AID PROJ. NO.	FISCAL YEAR	SHEET NO.	TOTAL SHEETS
HAWAII	HAW.	I-HI-1(89):13	1972	355-1	362


8"x24" Sign Plates back to back and fastened together with two rivets or bolts top and bottom diagonally at every emergency panel. Sign shall also be centered on the panel. See Detail "A" for Letter Size.

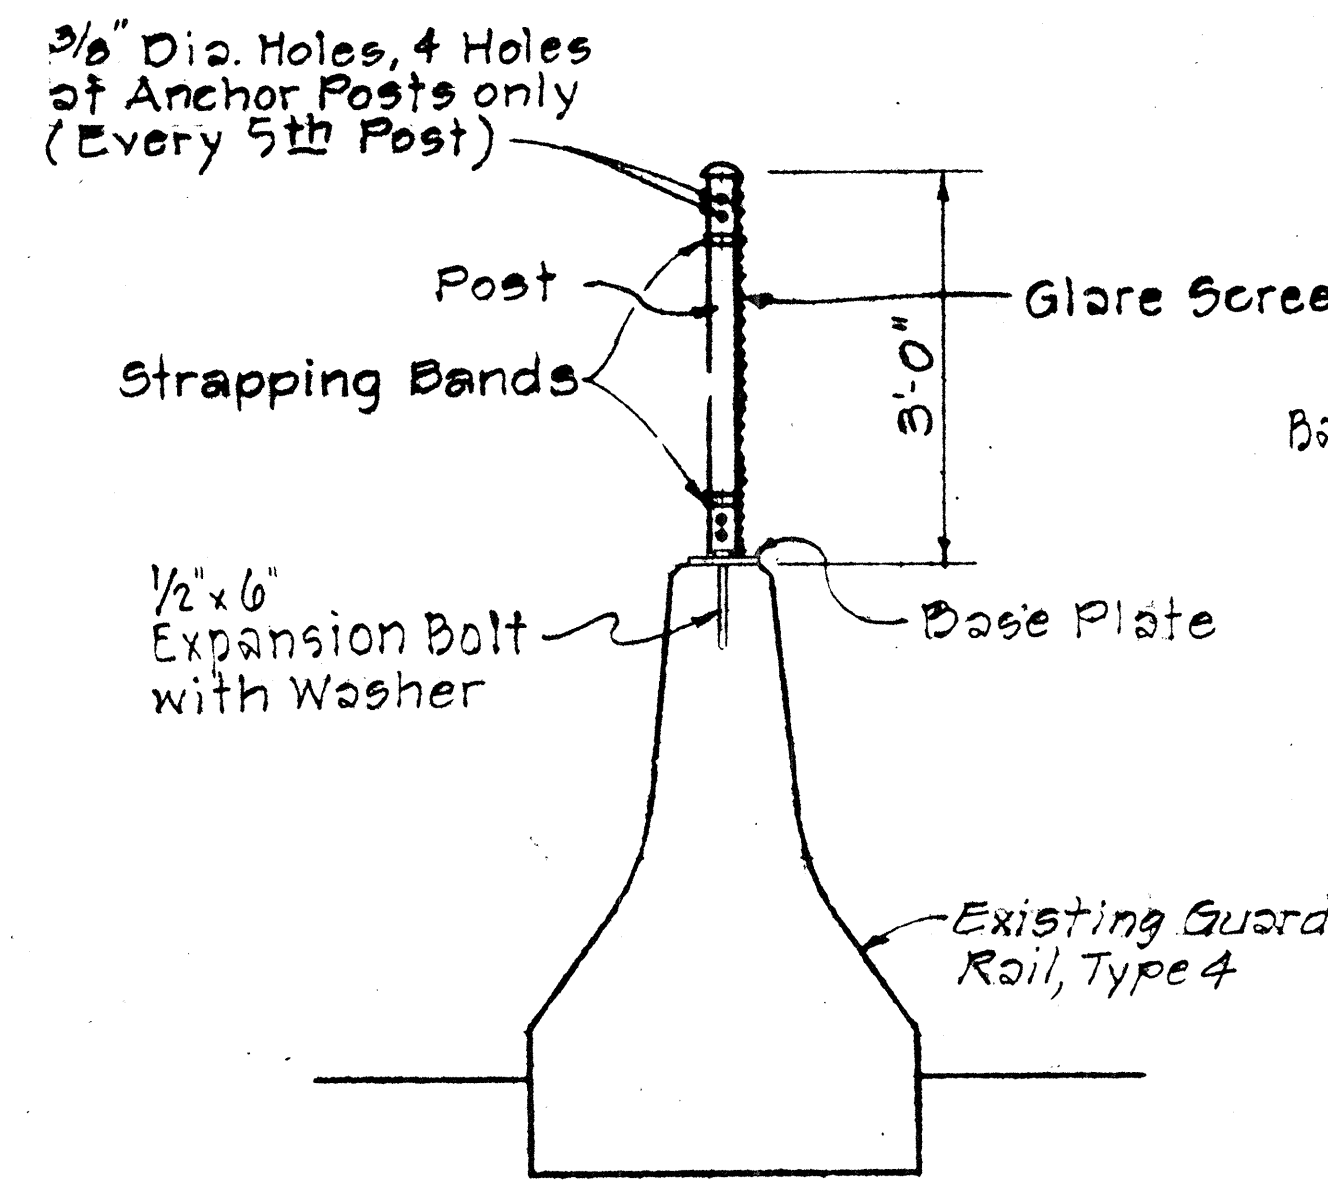


SECTION A-A
Not To Scale

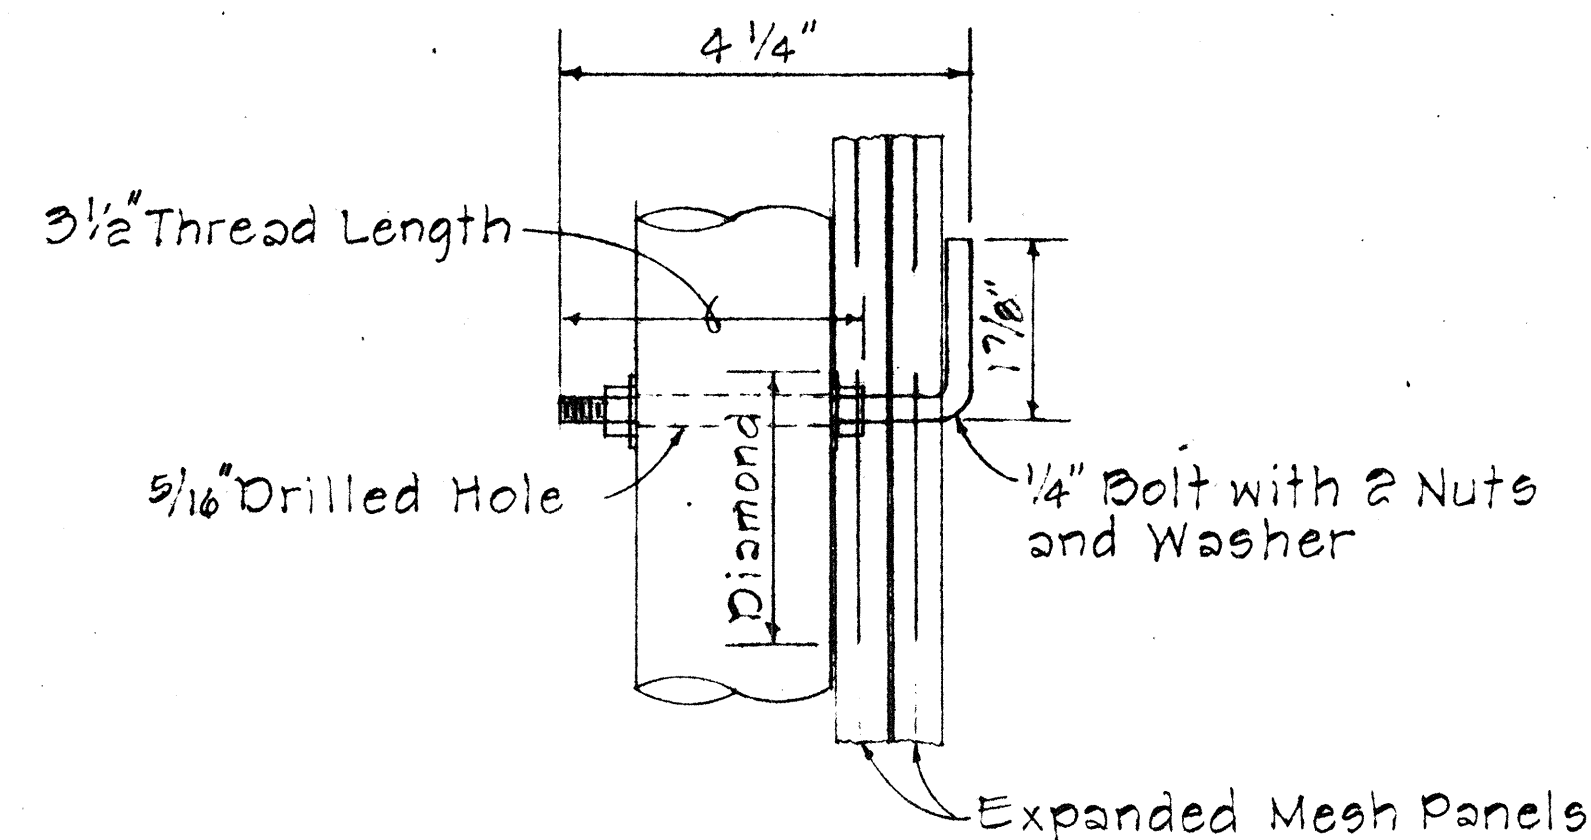


DETAIL B
Half Full Size

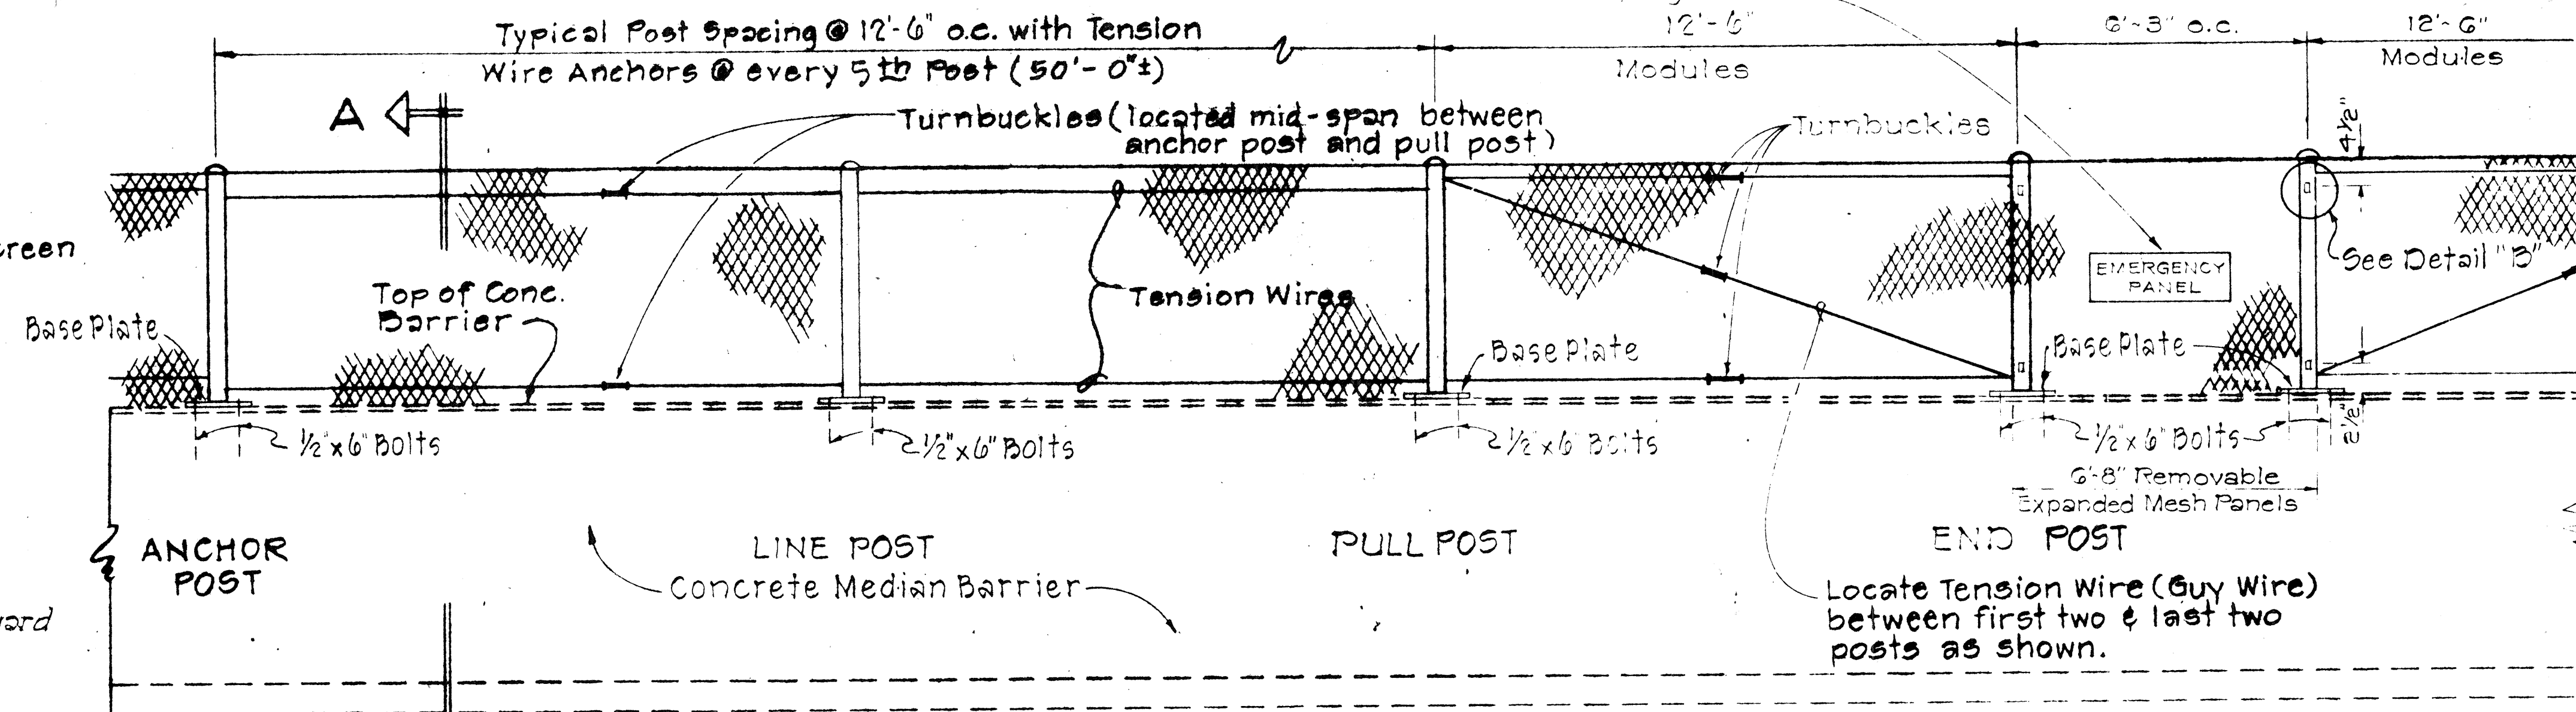


TYPICAL ELEVATION
Not to Scale

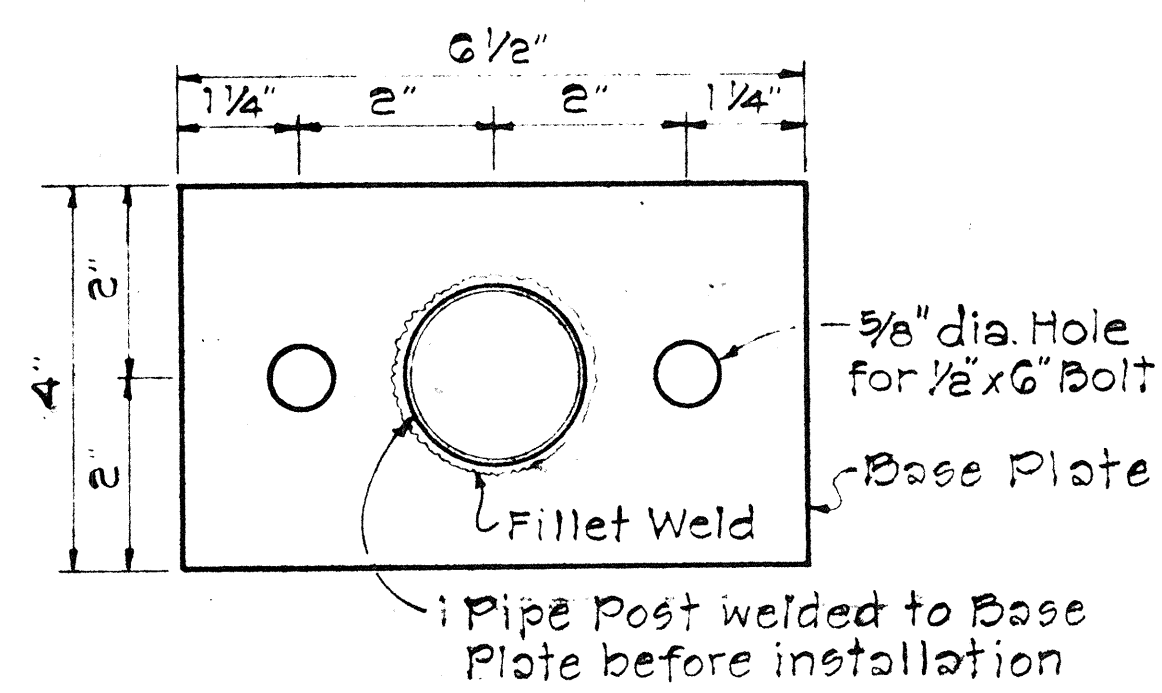


BASE PLATE DETAIL

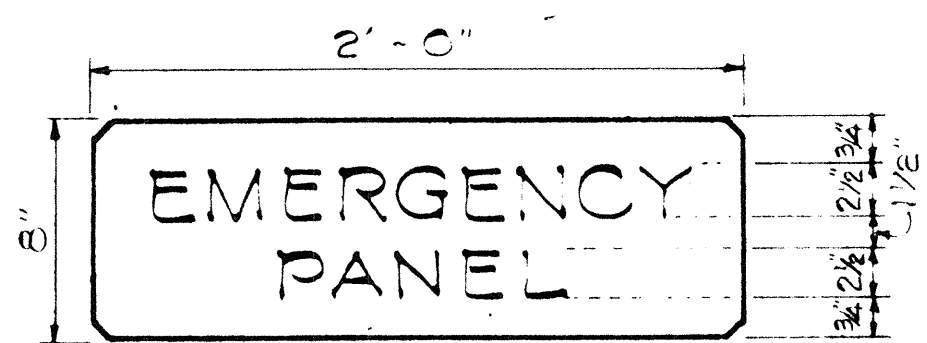


DETAIL A
NOT TO SCALE

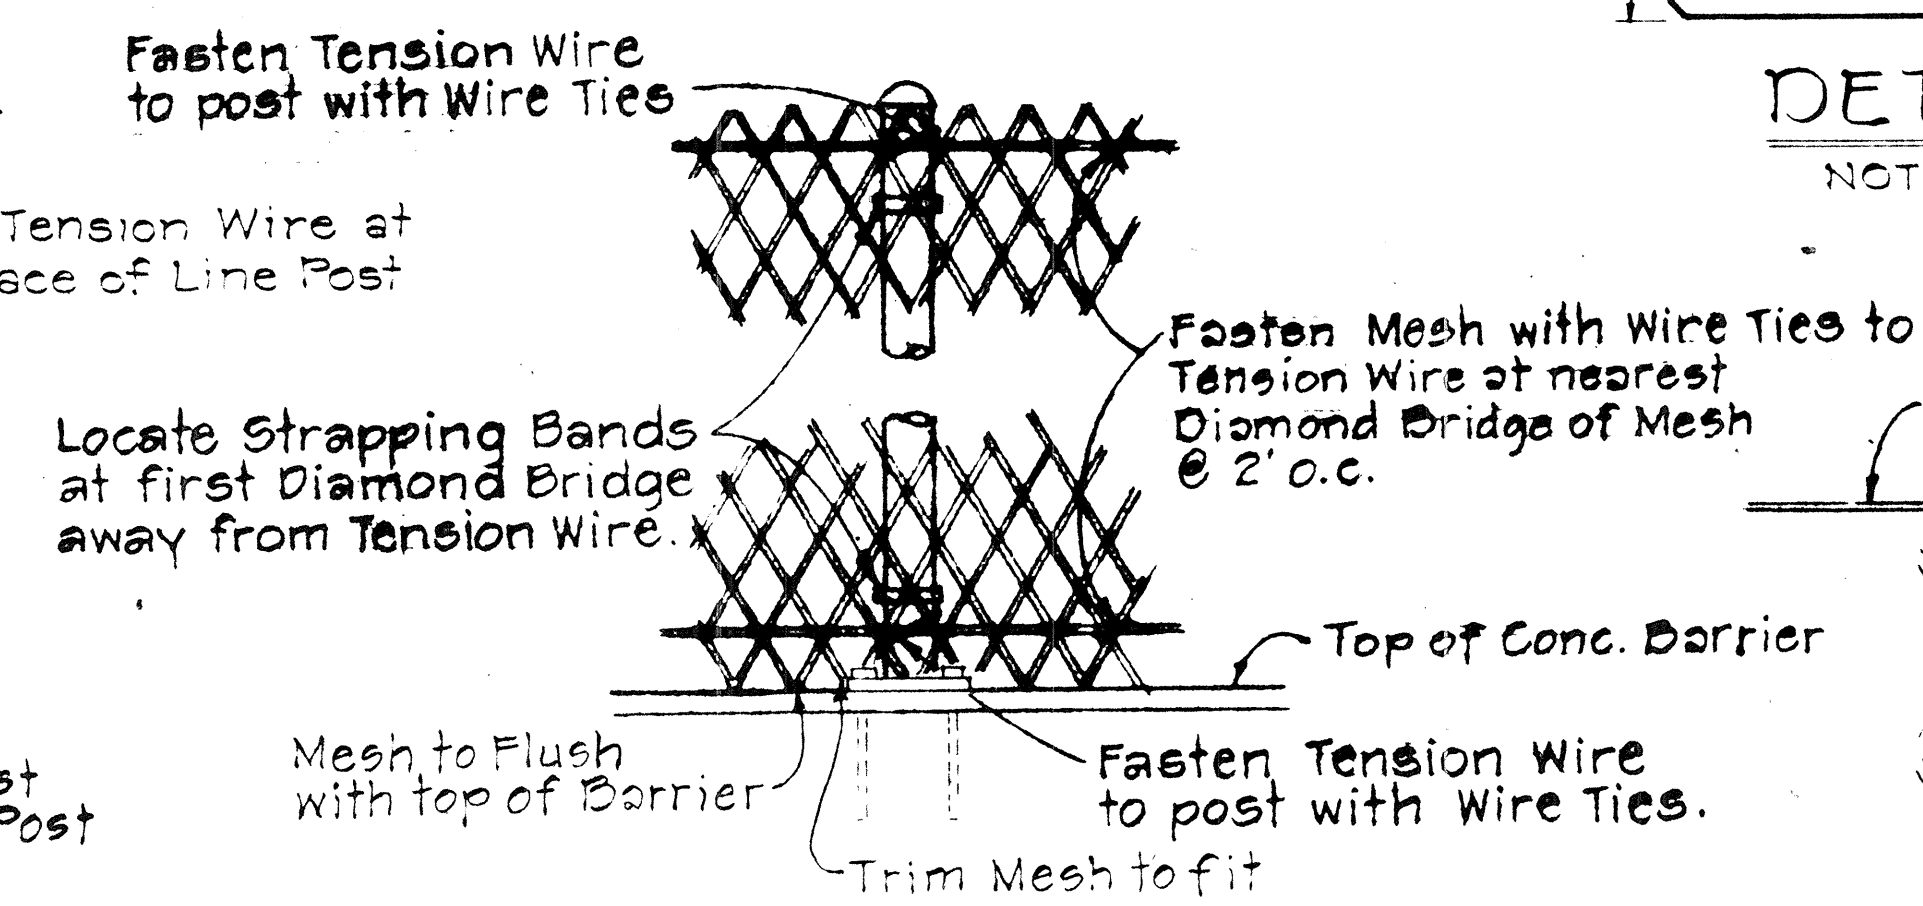


LINE POST CONNECTIONS
(Viewed from Mesh Side)
Scale: 1 1/2" = 1'-0"

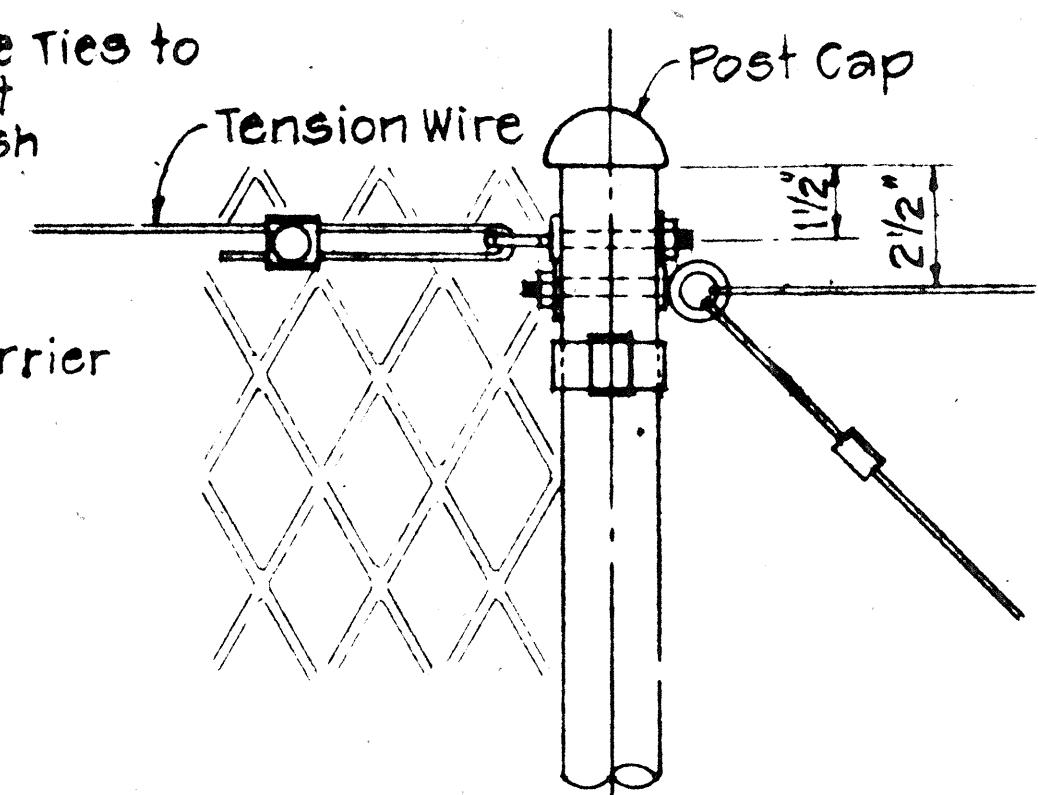

PULL POST DETAIL
Scale: 3" = 1'-0"

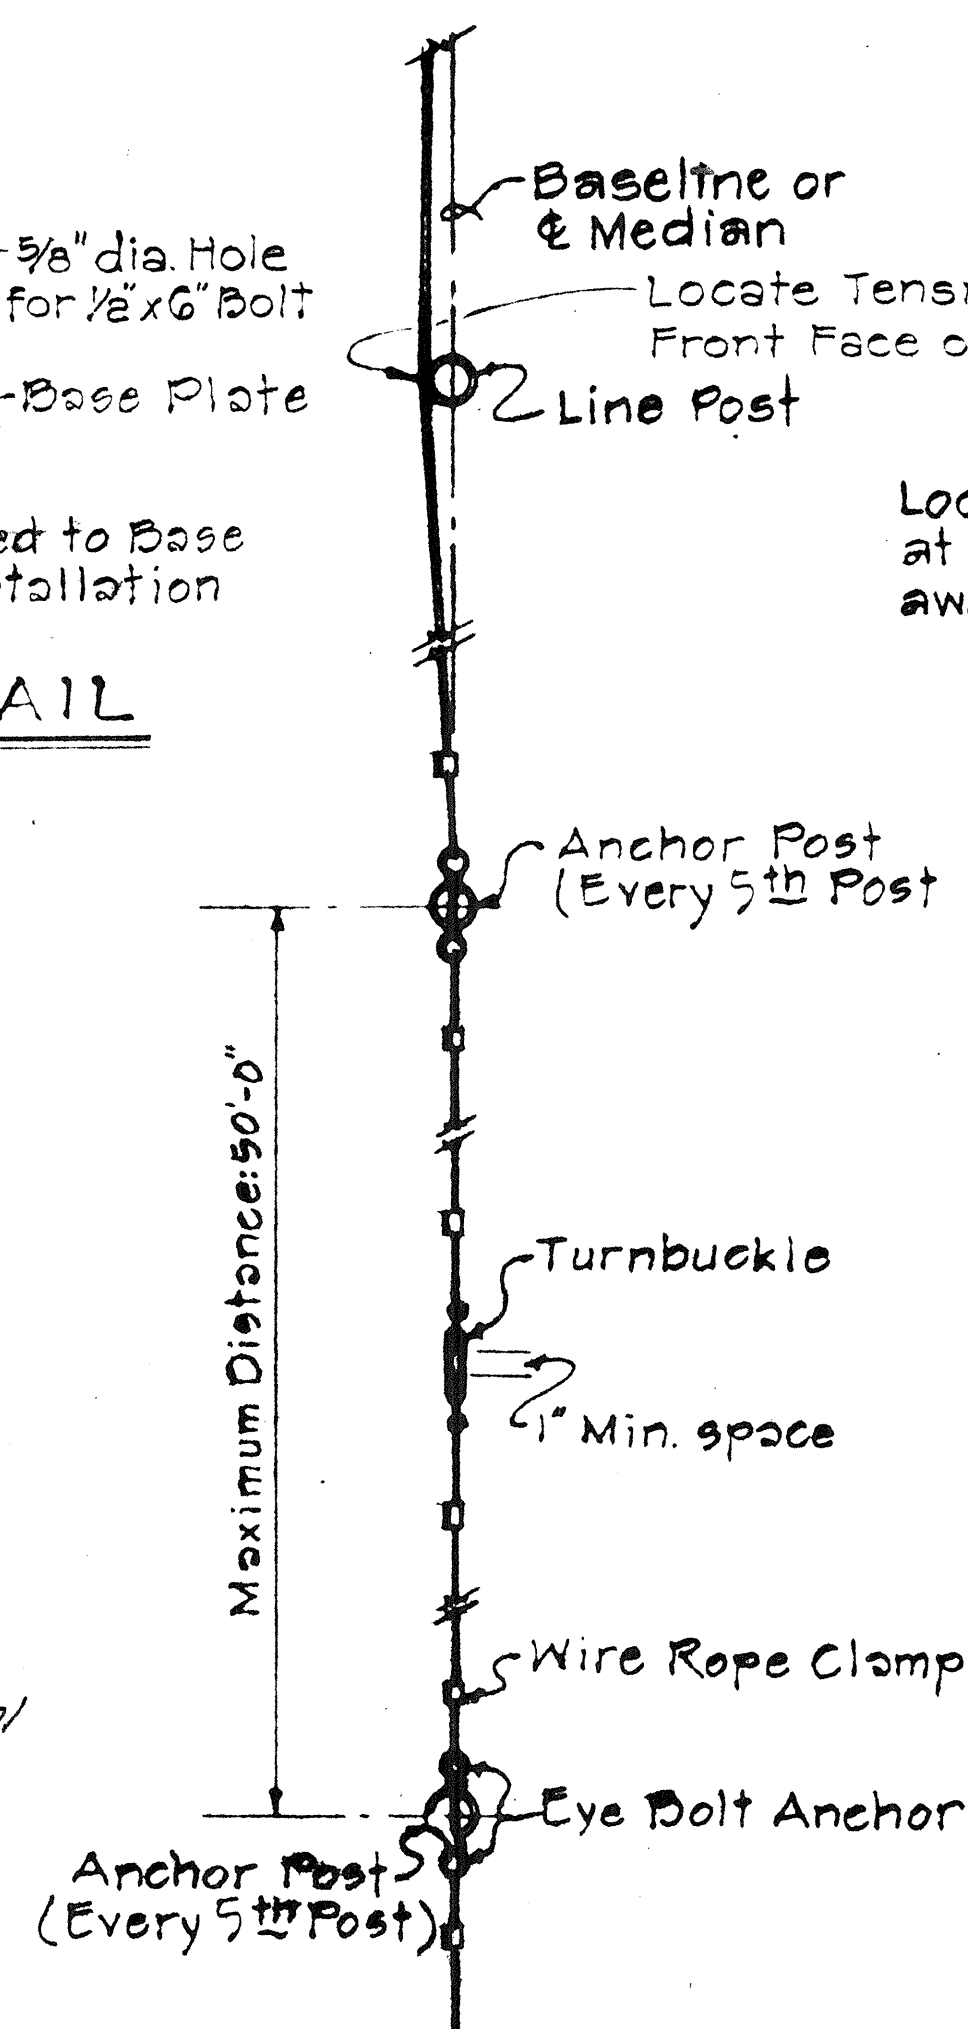

TENSION WIRE CONNECTIONS
Scale: 1 1/2" = 1'-0"

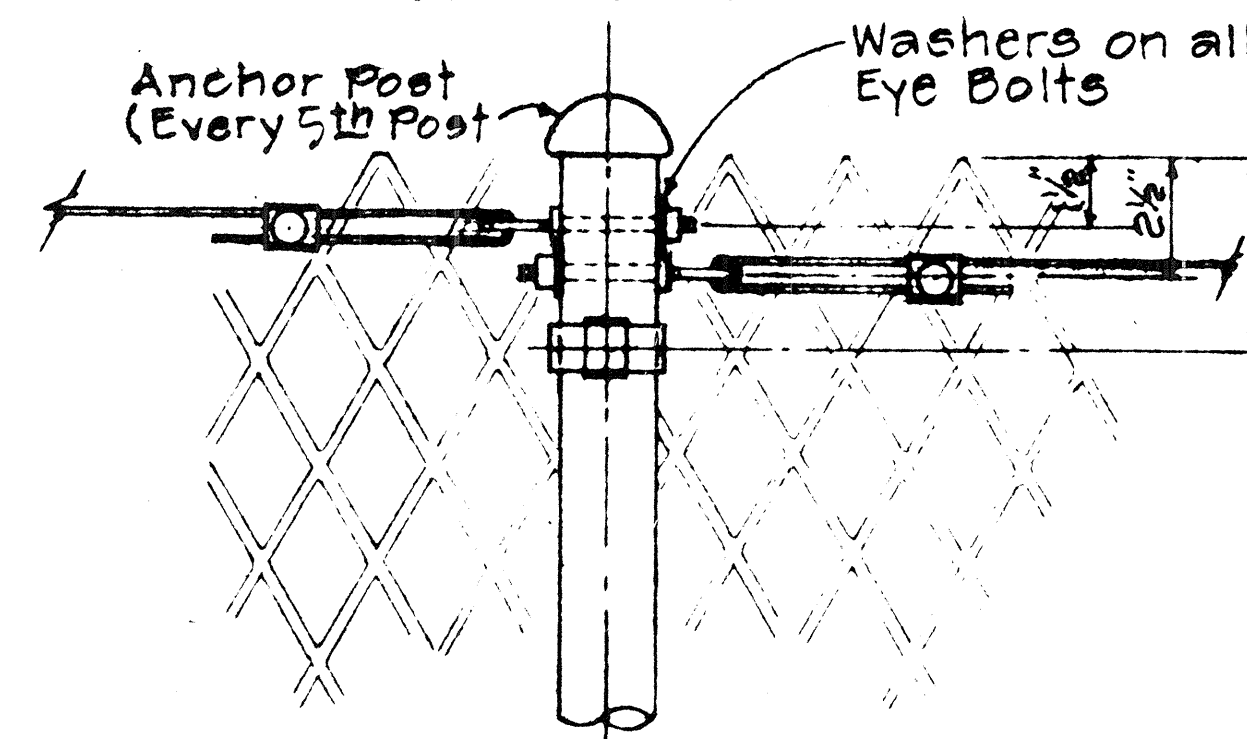

TENSION WIRE ANCHOR DETAIL
Scale: 3" = 1'-0"

NOTES:

1. Install Removable Expanded Mesh Panels at approximately 600 ft. intervals. Vary spacing to provide a removal panel at each structure crossing over Highway.
2. Removable Expanded Mesh Panels will be paid for under pay item 660.01-Headlight Glare Screen.
3. The words "EMERGENCY PANEL" shall be black on reflectorized yellow background panel, 0.063" thick aluminum.
4. "EMERGENCY PANEL" sign plates shall not be paid for separately but shall be incidental to Headlight Glare Screen. Approximate quantity of sign plates is 6.
5. Removable connections shall be designed so that the panels can be removed easily but also snug enough to prevent shaking or accidental removal.
6. Removable Expanded Mesh Panels shall also be reinforced by stiffeners at the upper and lower ends of the panels. Six (6) sets of the shop drawings shall be submitted to the Engineer for approval.

STATE OF HAWAII
DEPARTMENT OF TRANSPORTATION
HIGHWAYS DIVISION



**HEADLIGHT
GLARE SCREEN**

FAI PROJ. No. I-HI-1(89):13
SCALE: AS NOTED AUG. 1972
SHEET No. OF SHEETS


C035S-1

11/1/73

FED. ROAD DIST. NO.	STATE	FED. AID PROJ. NO.	FISCAL YEAR	SHEET NO.	TOTAL SHEETS
HAWAII	HAW.	I-41-1(89)13	1971	36	362

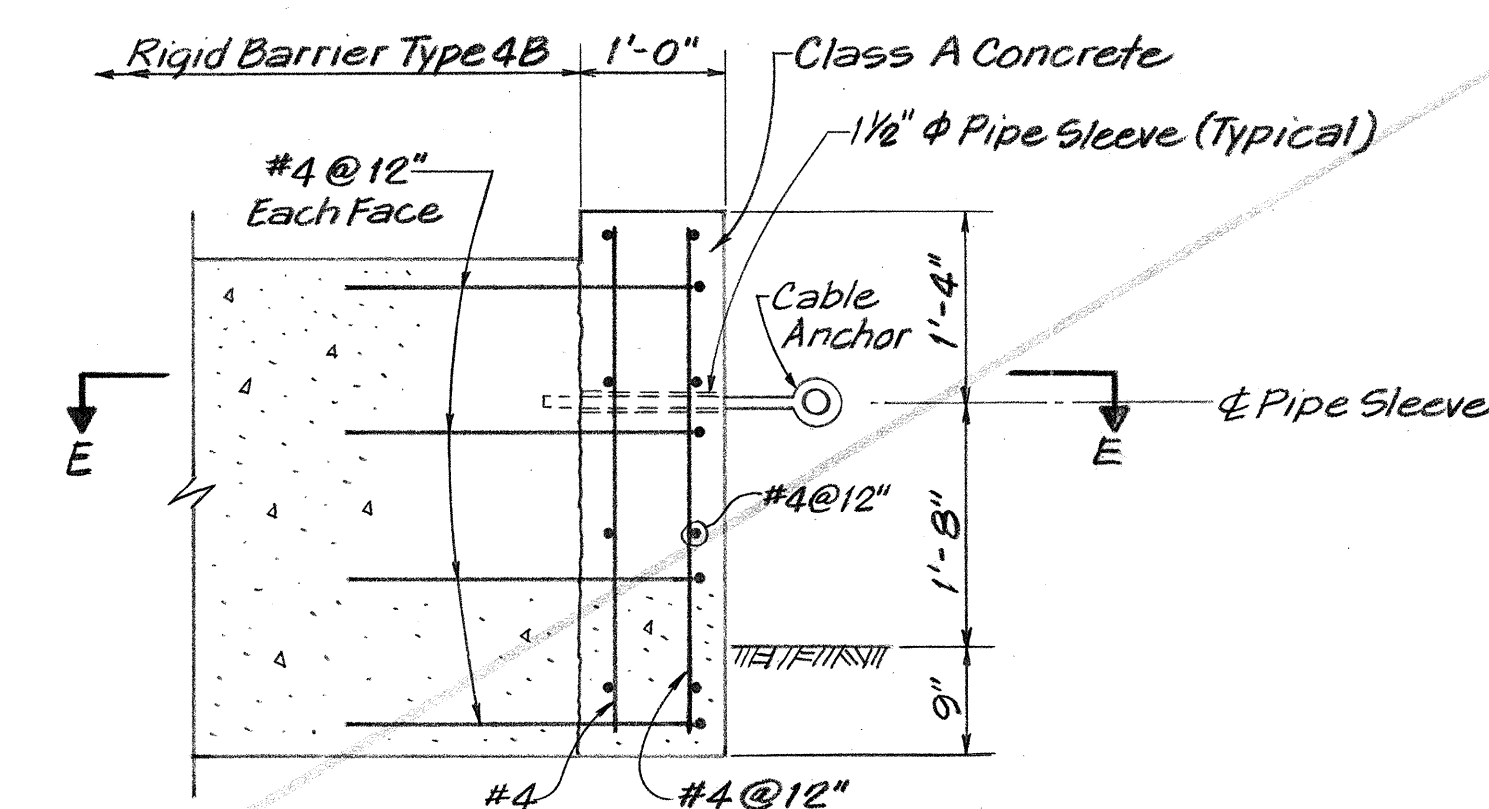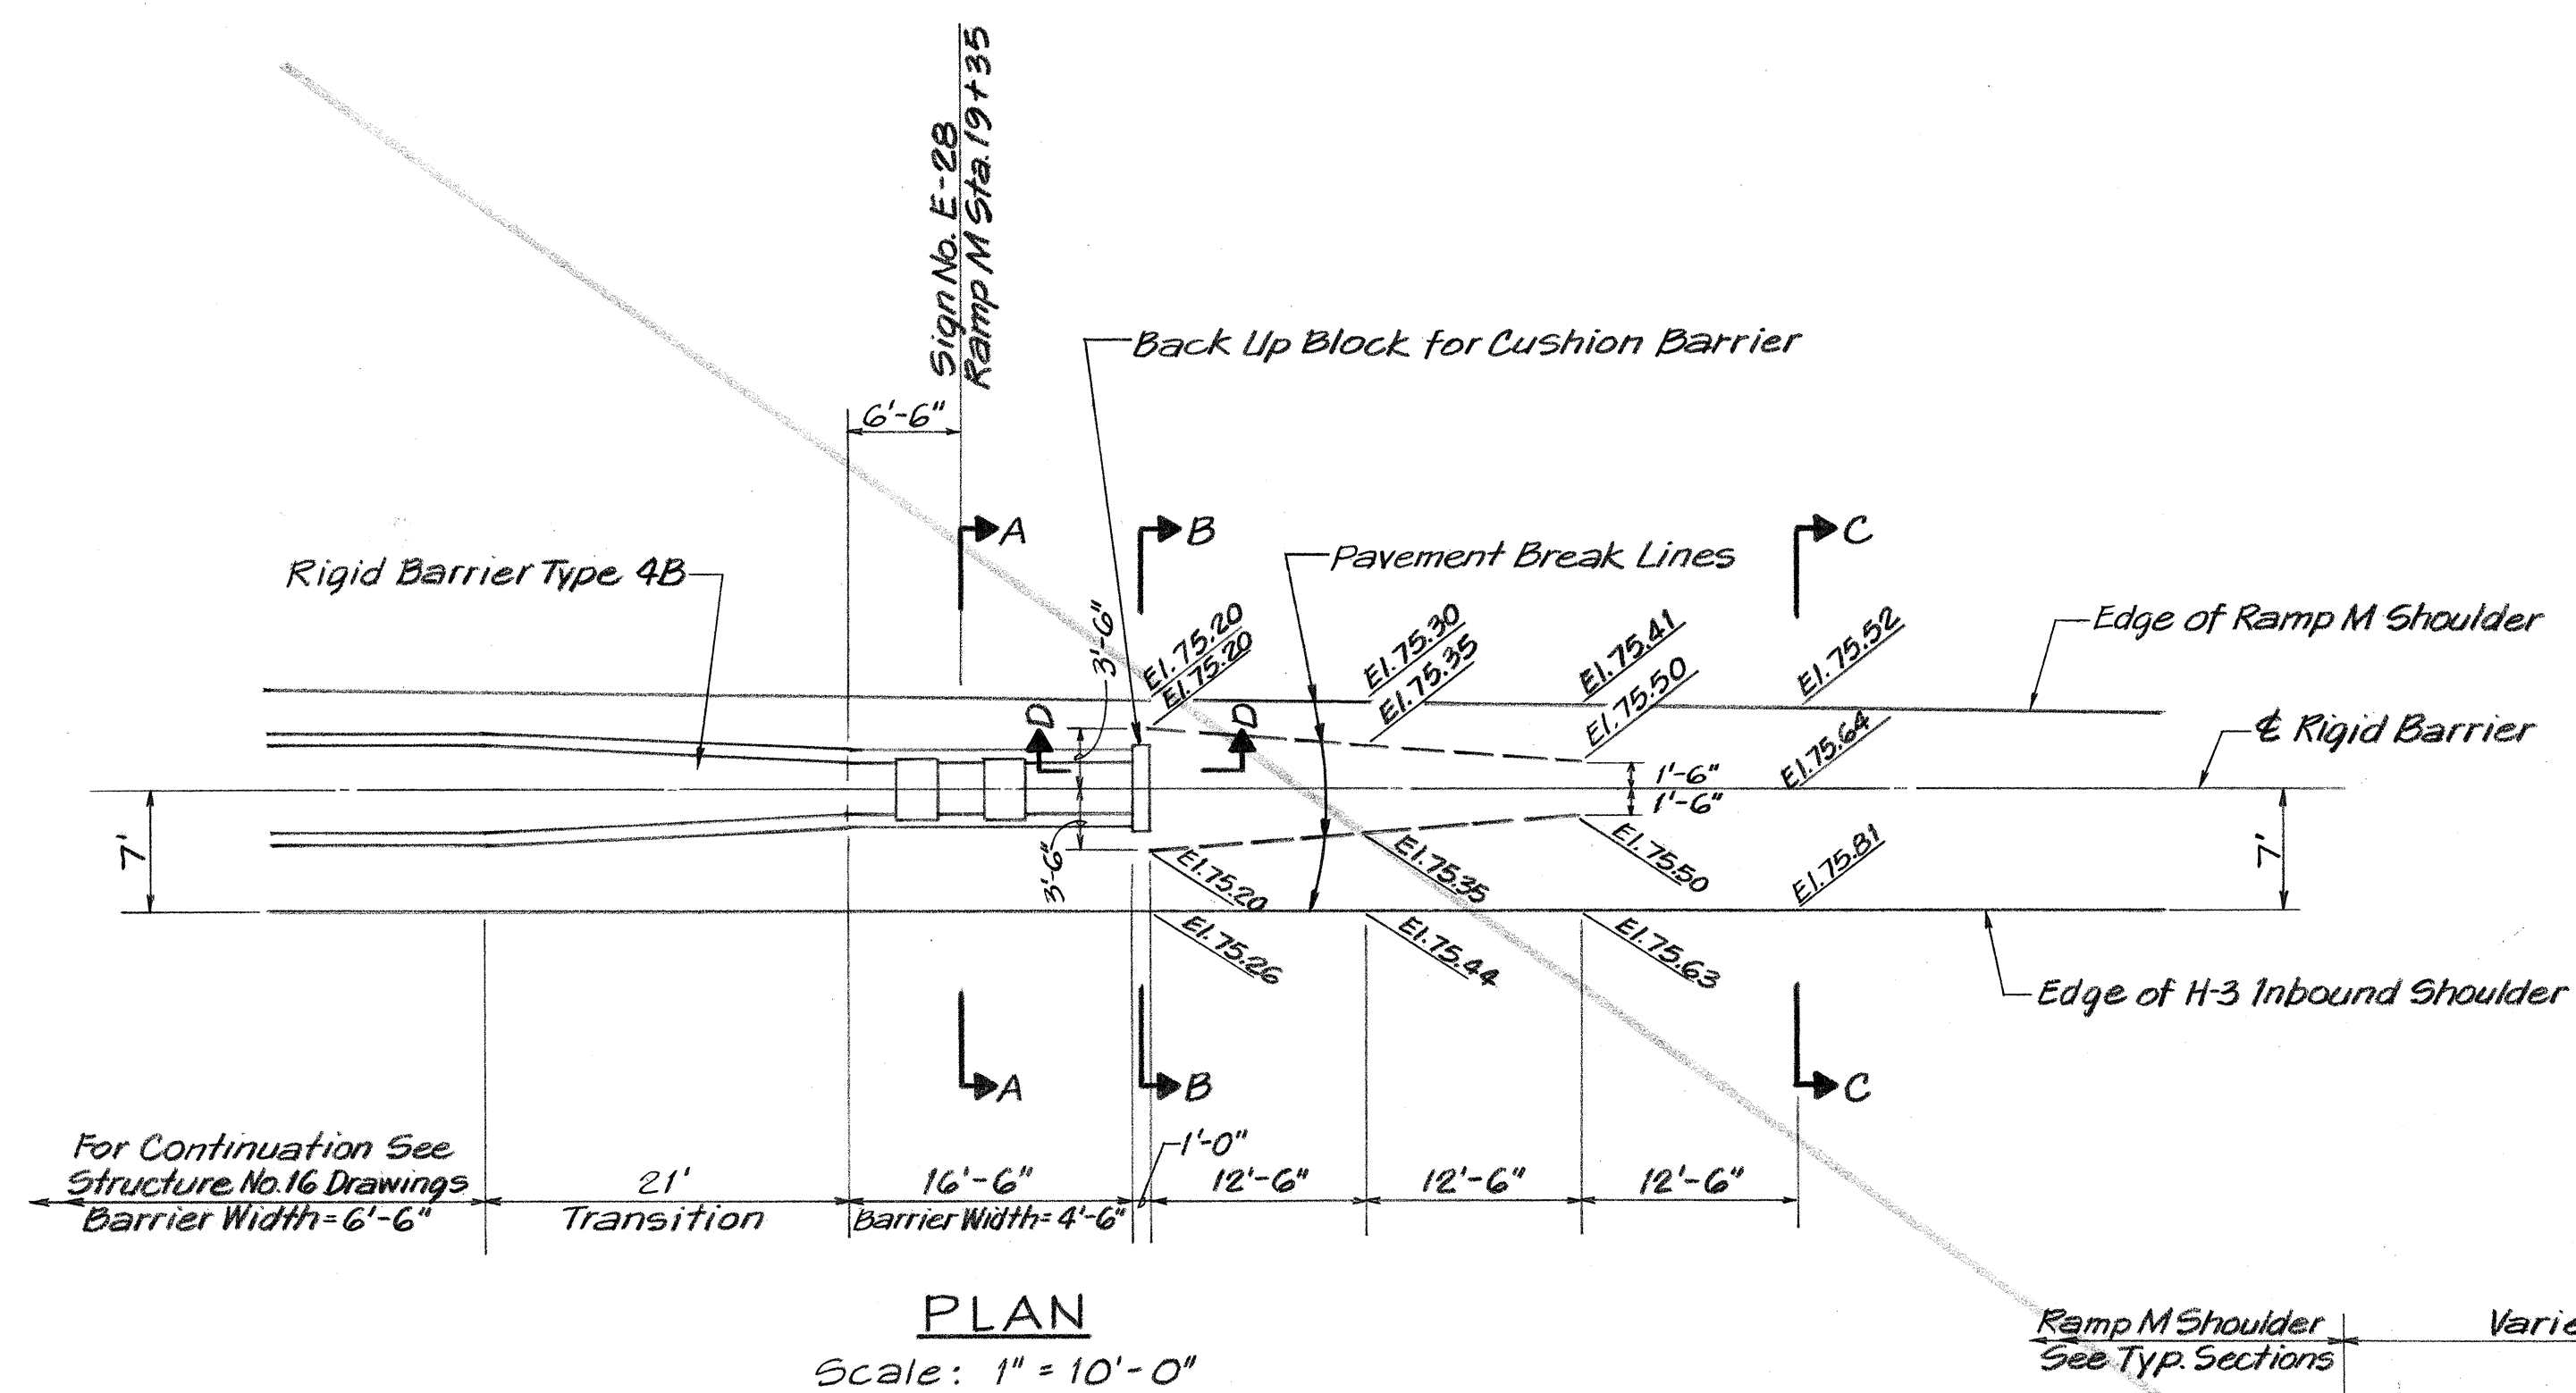


SECTION D-D (BACK UP BLOCK DETAIL)
Scale: $\frac{3}{4}" = 1' - 0"$

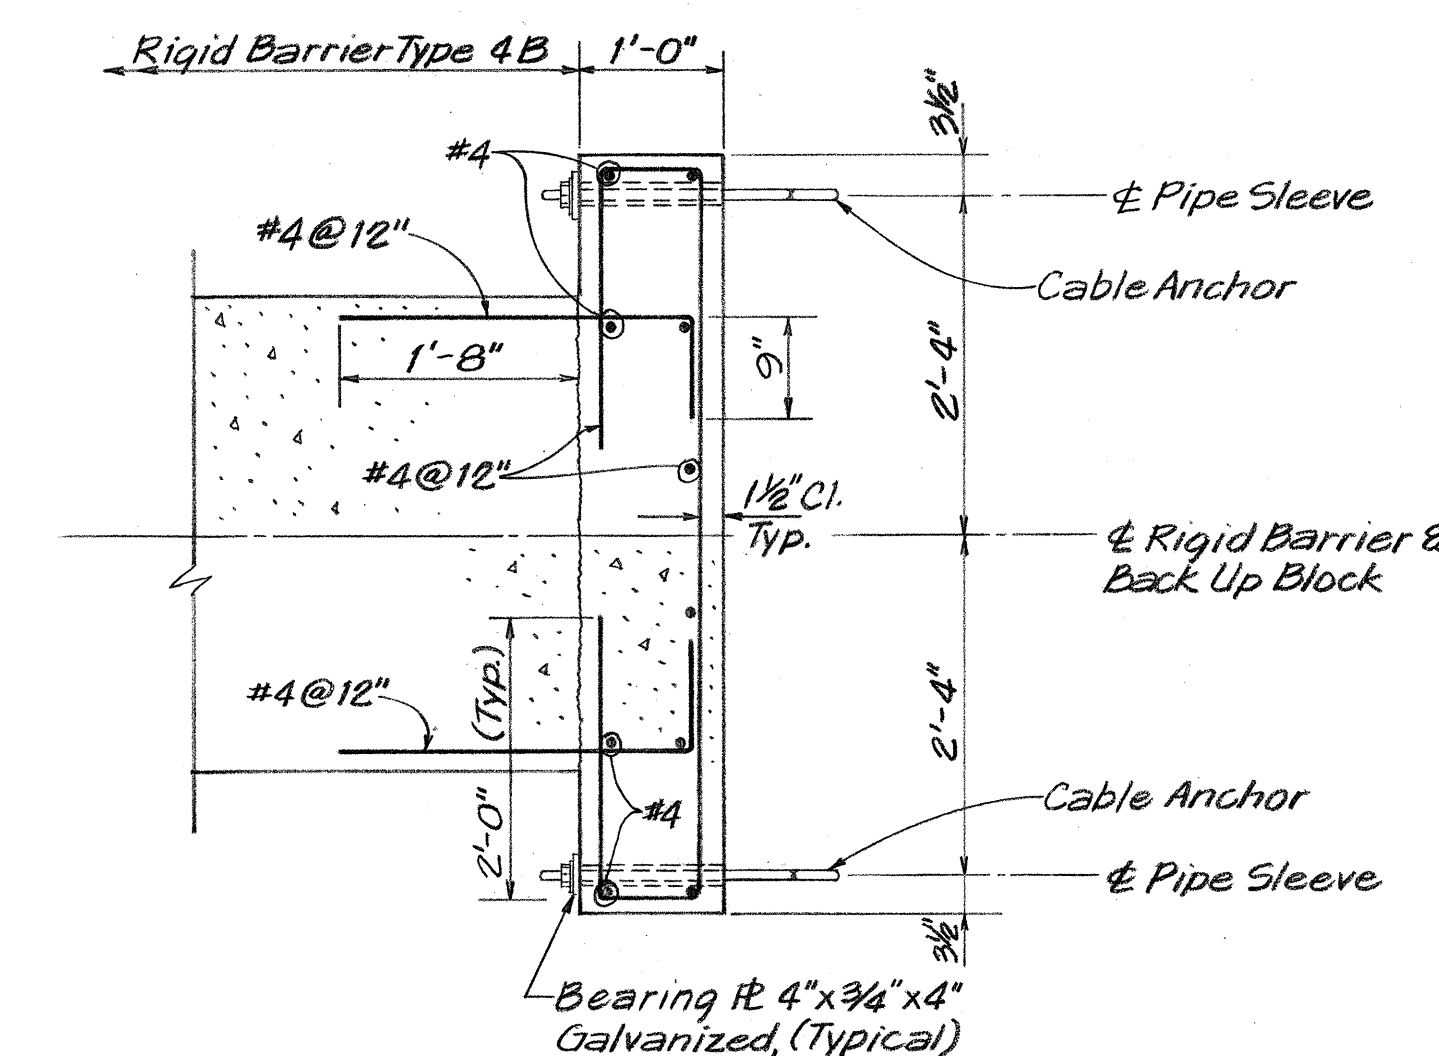


SECTION E-E (BACK UP BLOCK DETAIL)
Scale: $\frac{3}{4}" = 1'-0"$

NOTE:


Payment for Back Up Block and Cable Anchorage shall be incidental to the Cost of Cushion Barrier.

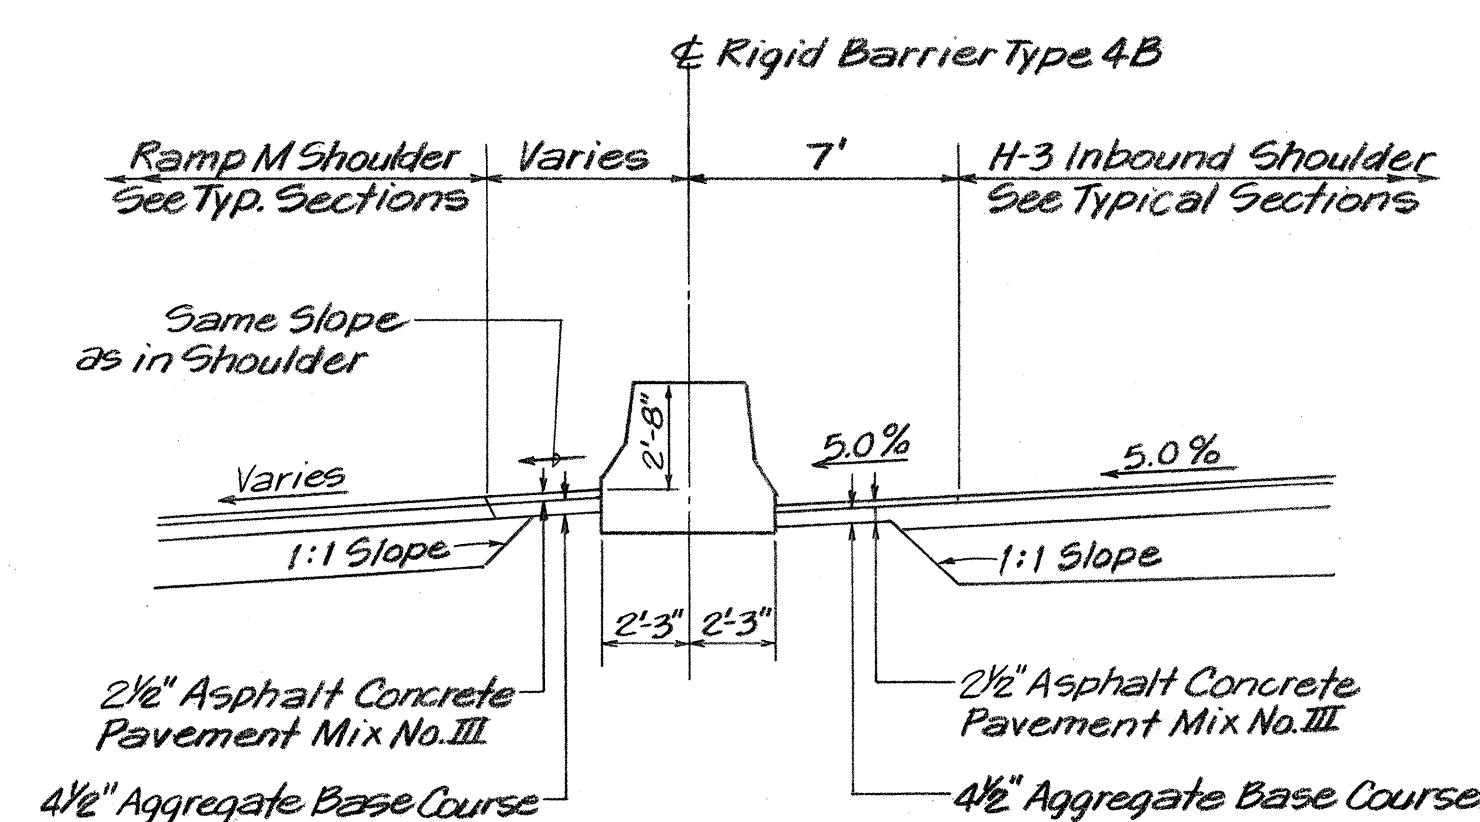

SECTION A-A
Scale: 1" = 5'-0"

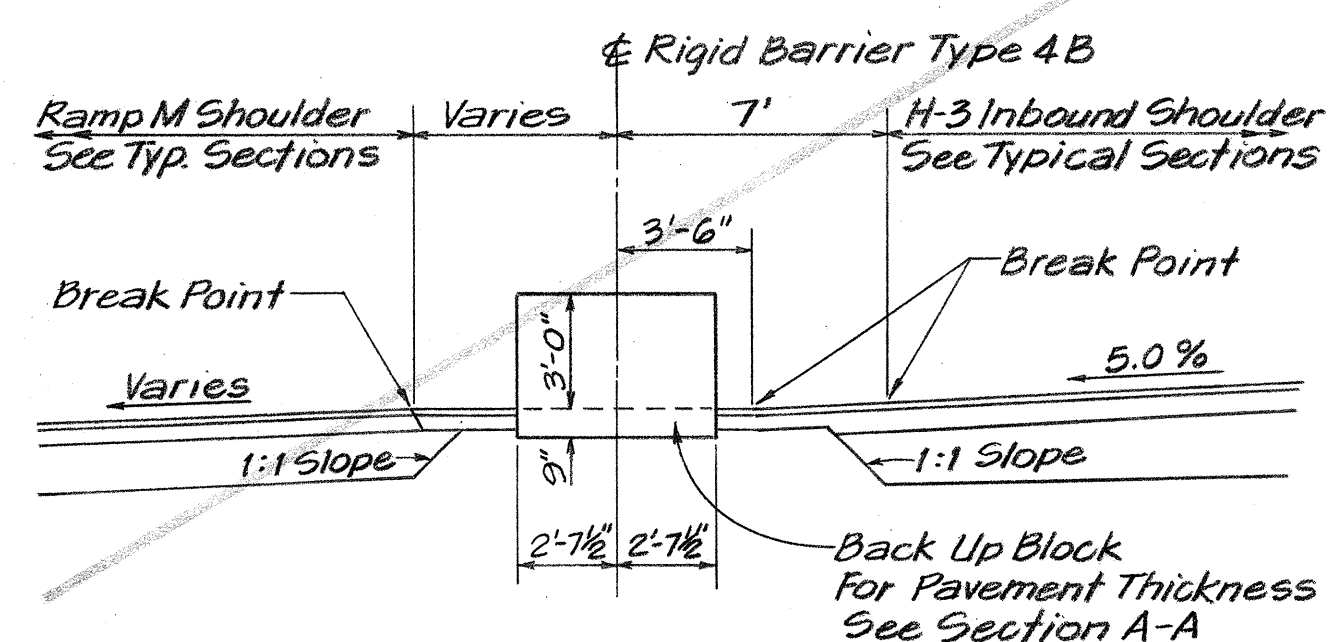


SECTION B-B
Scale: 1" = 5' - 0"

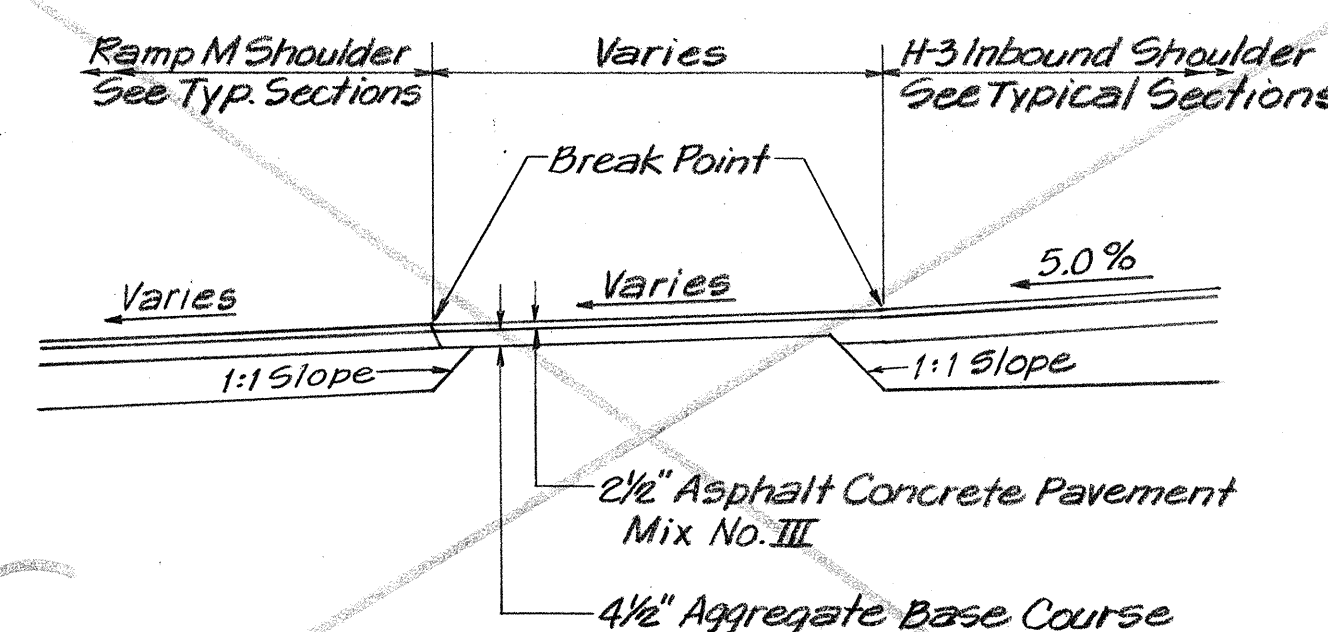


SECTION C-C
Scale: 1" = 5'-0"

DETAILS OF RIGID BARRIER AND BACK UP BLOCK
AT INTERSTATE ROUTE H-3 & RAMP M GORE

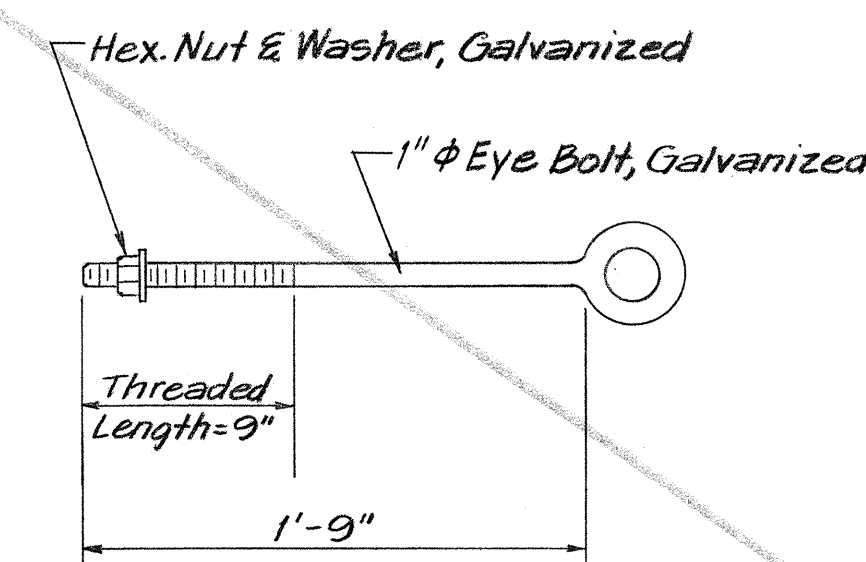

CABLE ANCHOR DETAIL
Scale: $1\frac{1}{2}" = 1'-0"$

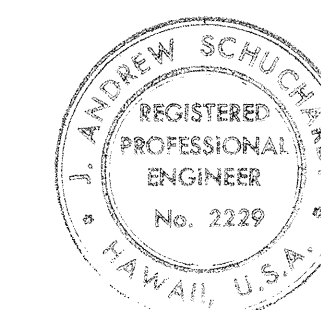

THIS WORK WAS PREPARED BY
ME OR UNDER MY SUPERVISION.

J. Andrew Schuchardt



STATE OF HAWAII
DEPARTMENT OF TRANSPORTATION
HIGHWAYS DIVISION

MISCELLANEOUS ROADWAY DETAILS
RIGID BARRIER & BACK UP BLOCK
INTERSTATE ROUTE H-1
PROJECT NO. I-H1-1 (89):13

SCALE: AS SHOWN DATE: Oct. 30, 1970

SHEET No. 10 B OF 25 SHEETS

FED. ROAD DIST. NO.	STATE	FED. AID PROJ. NO.	FISCAL YEAR	SHEET NO.	TOTAL SHEETS
HAWAII	HAW.	I-HI-1(89)13	1971	37	362

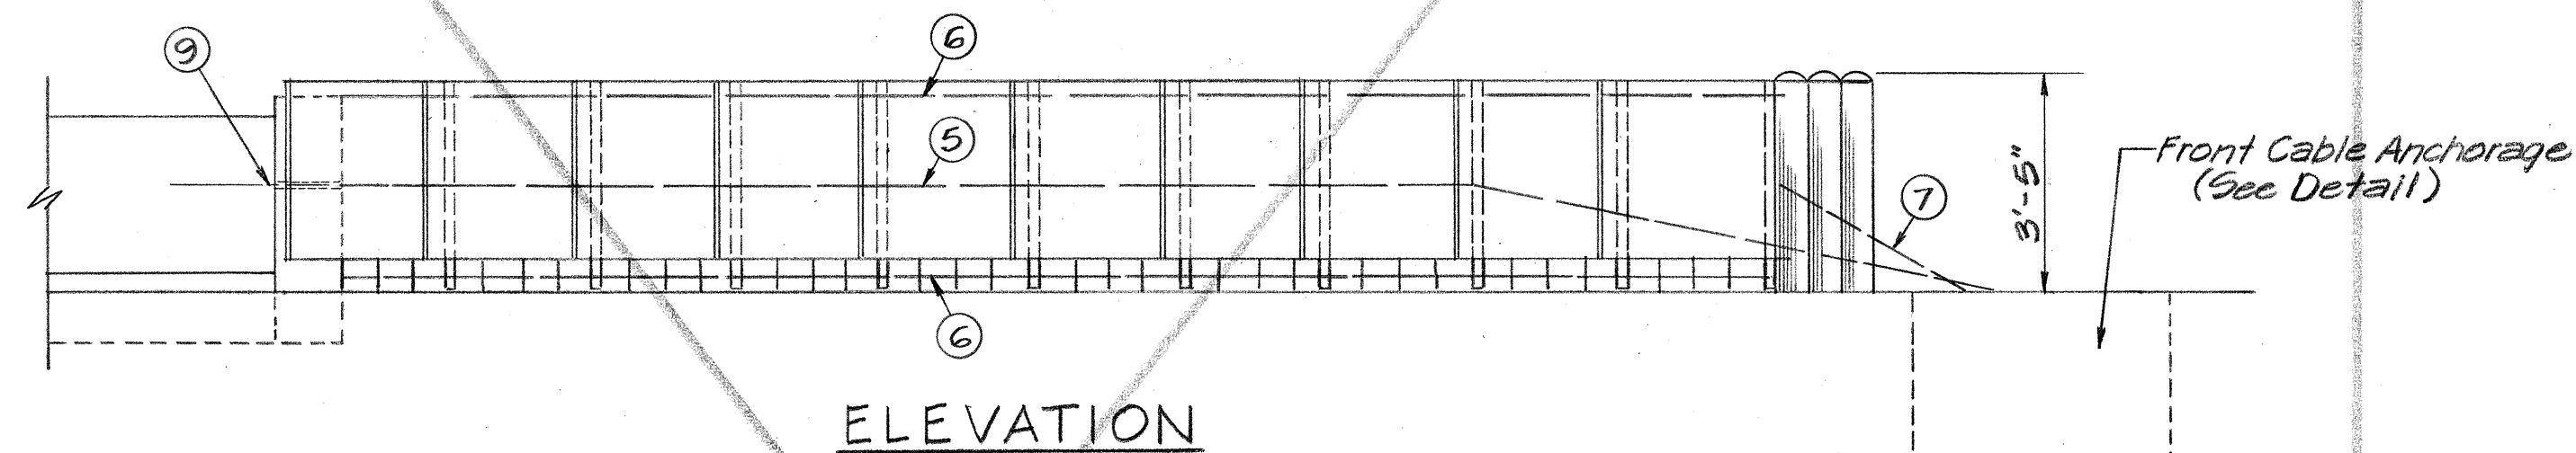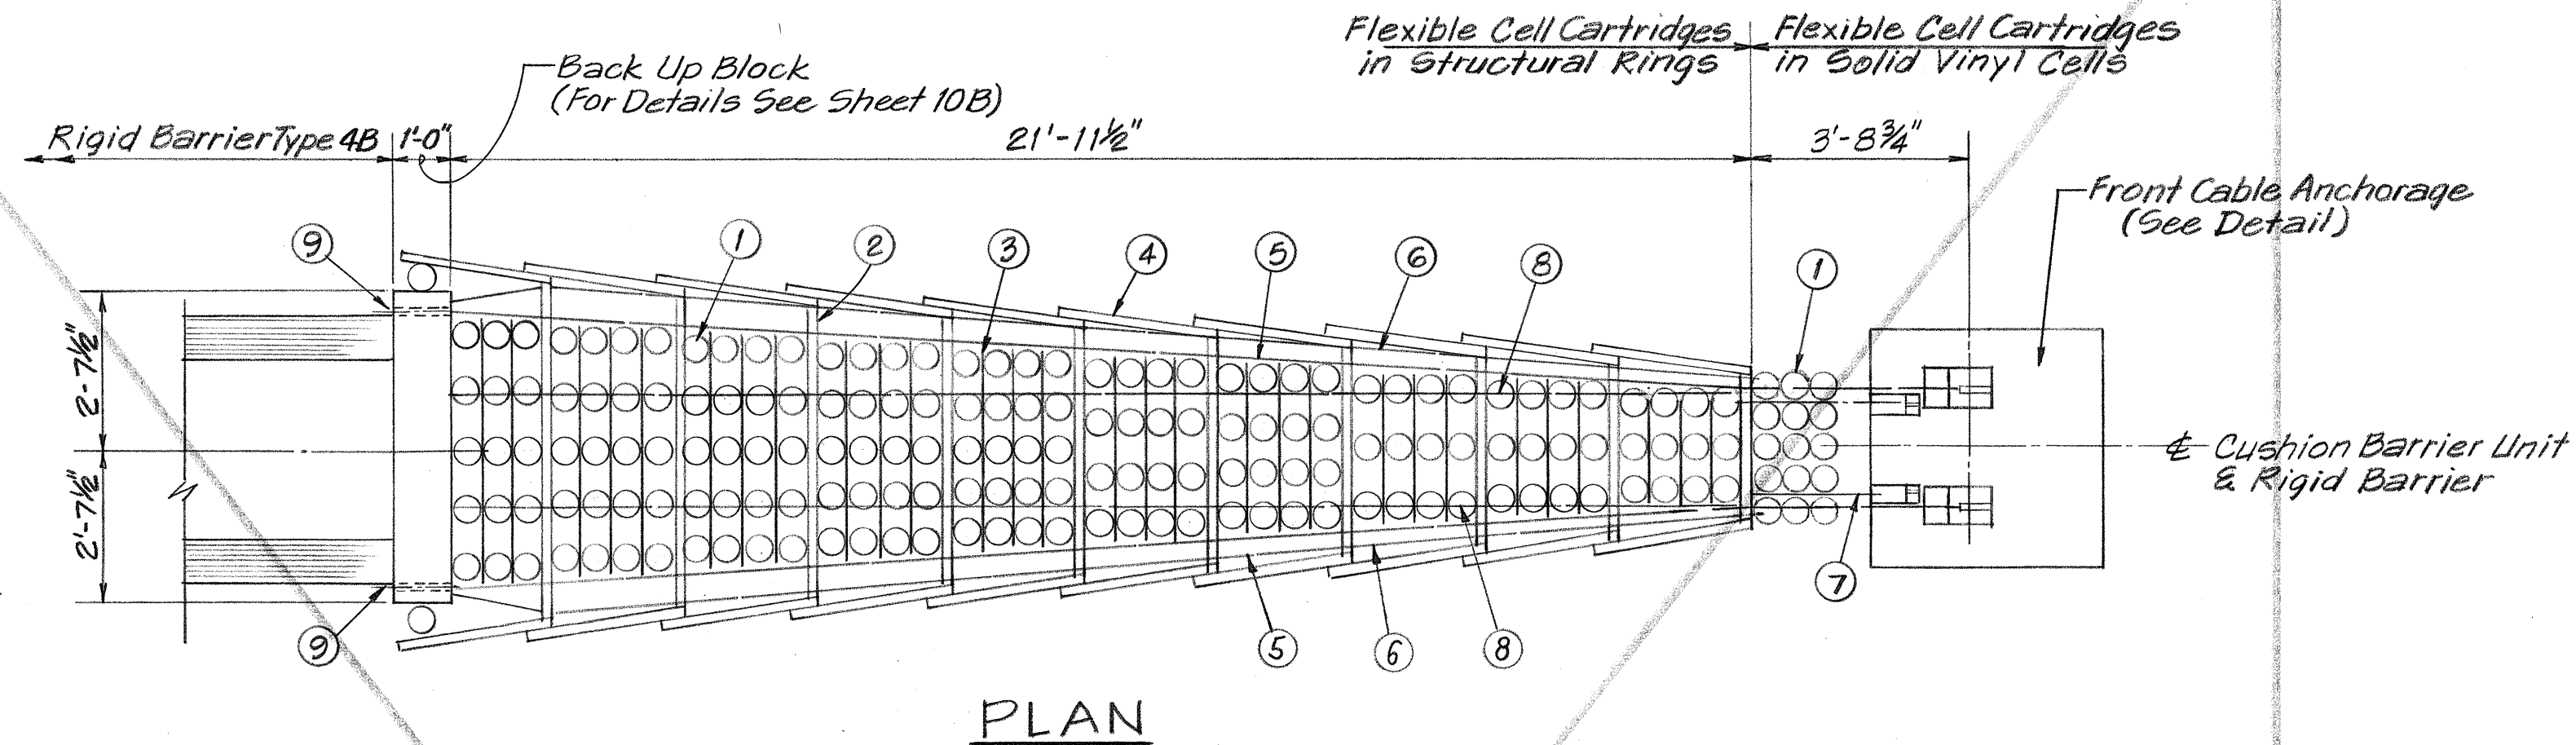


Legend:

- ① Cushion Cells (6"± O.D.)
- ② Diaphragms
- ③ Interior Panels
- ④ Fender Panels
- ⑤ Restraining Cable
- ⑥ Pull-Out Cable
- ⑦ Secondary Cable
- ⑧ Slide Straps
- ⑨ Rear Cable Anchor

CUSHION BARRIER LAYOUT

Scale: 3/8"=1'-0"

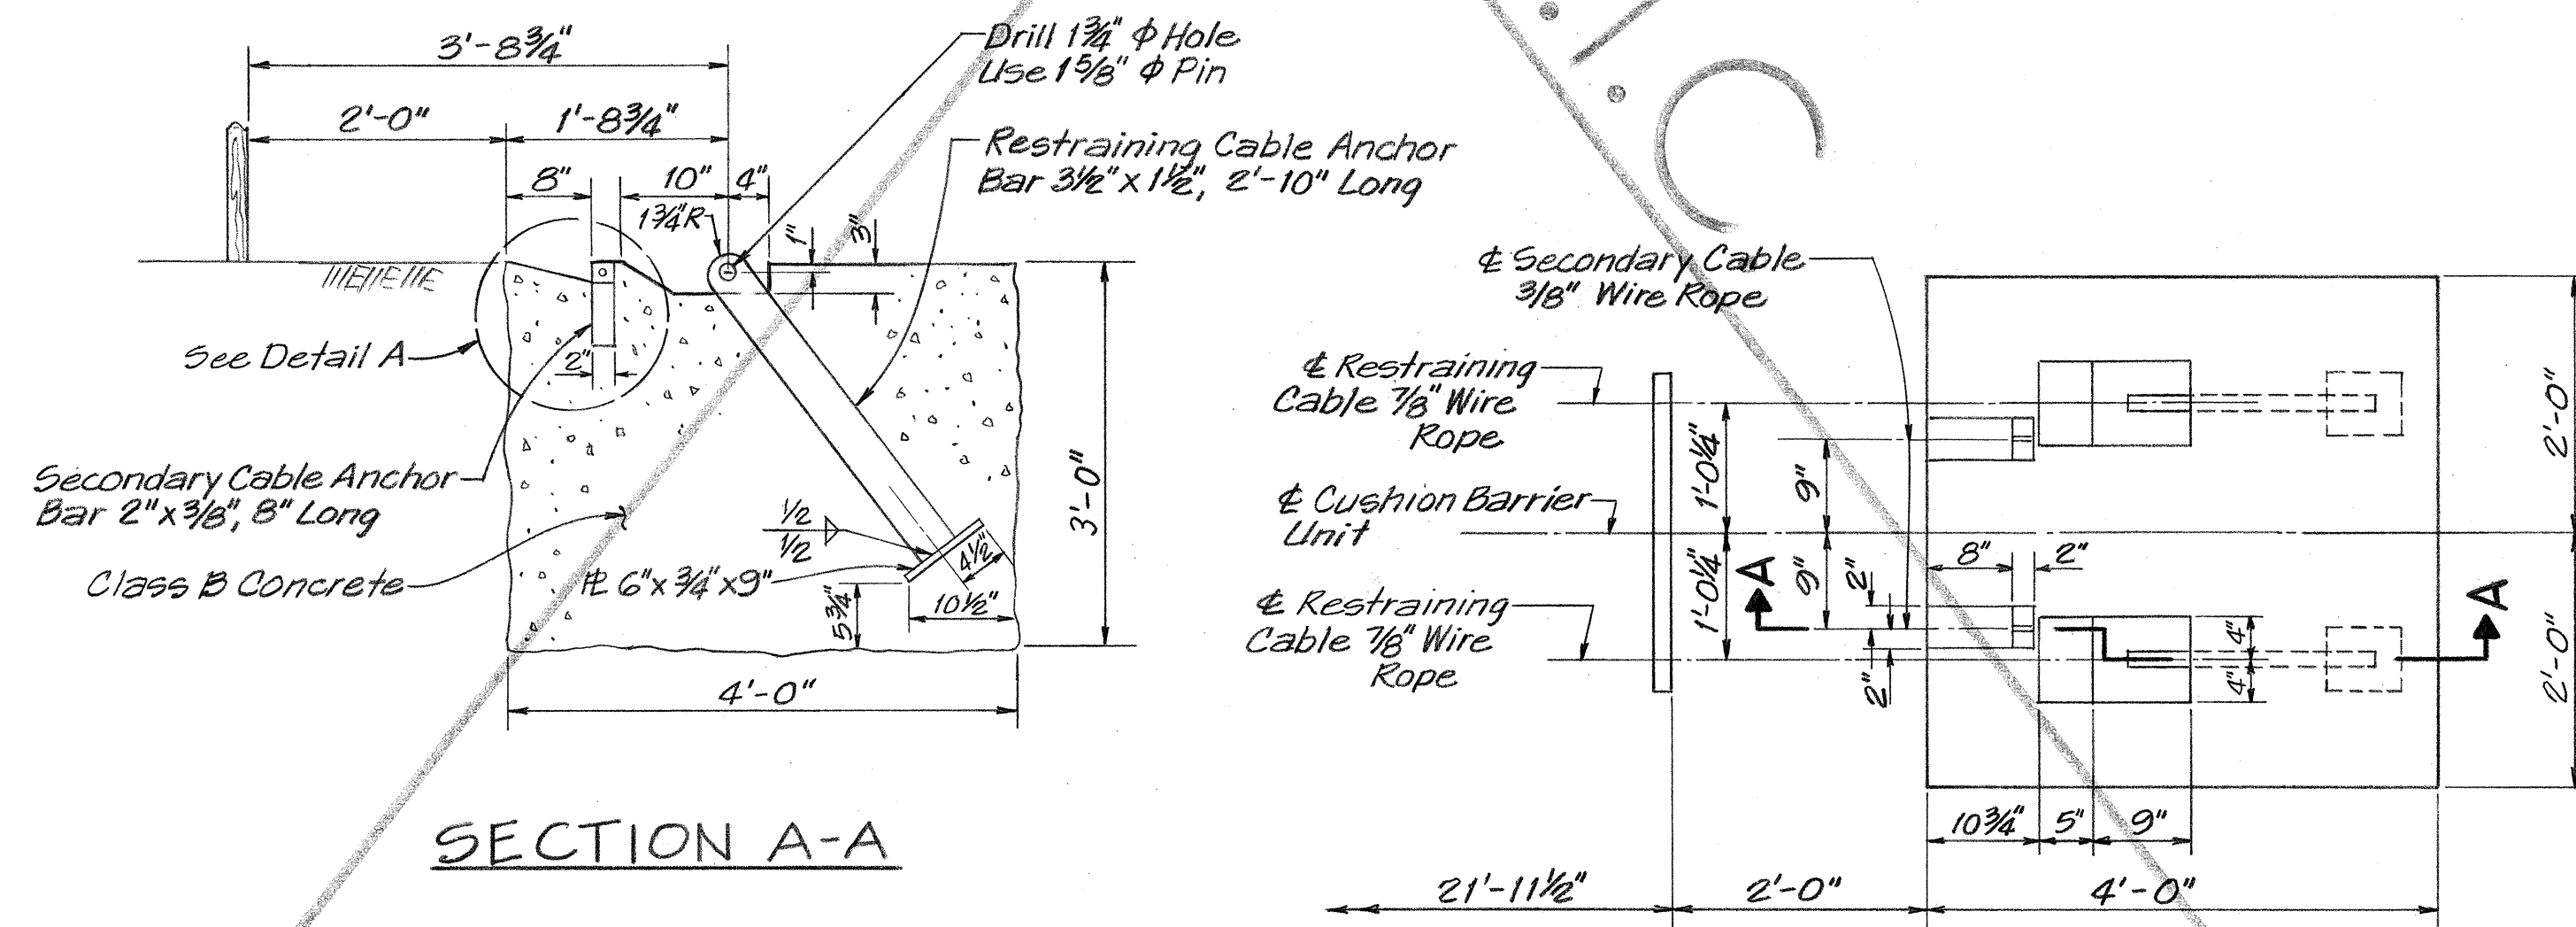

SECTION A-A

PLAN


FRONT CABLE ANCHORAGE DETAILS

Scale: 3/4"=1'-0"

NOTES:


1. Payment for Front Cable Anchorage shall be incidental to the Cost of Cushion Barrier.
2. All Structural Steel shall be Galvanized after Fabrication.

TABLE OF CENTERLINE & REFERENCE SURVEY MONUMENTS				
ROADWAY	STATION	OFFSET	QUANTITIES	
			# MONUMENTS	REF. SURVEY MON.
MOANALUA FRWY.	166+43.90	6.00' RT.		1
"	173+30.77	6.00' RT.		1
"	199+35.01	6.00' RT.		1
"	200+38.76	6.00' RT.		1
"	206+97.69	6.00' RT.		1
"	208+01.43	6.00' RT.		1

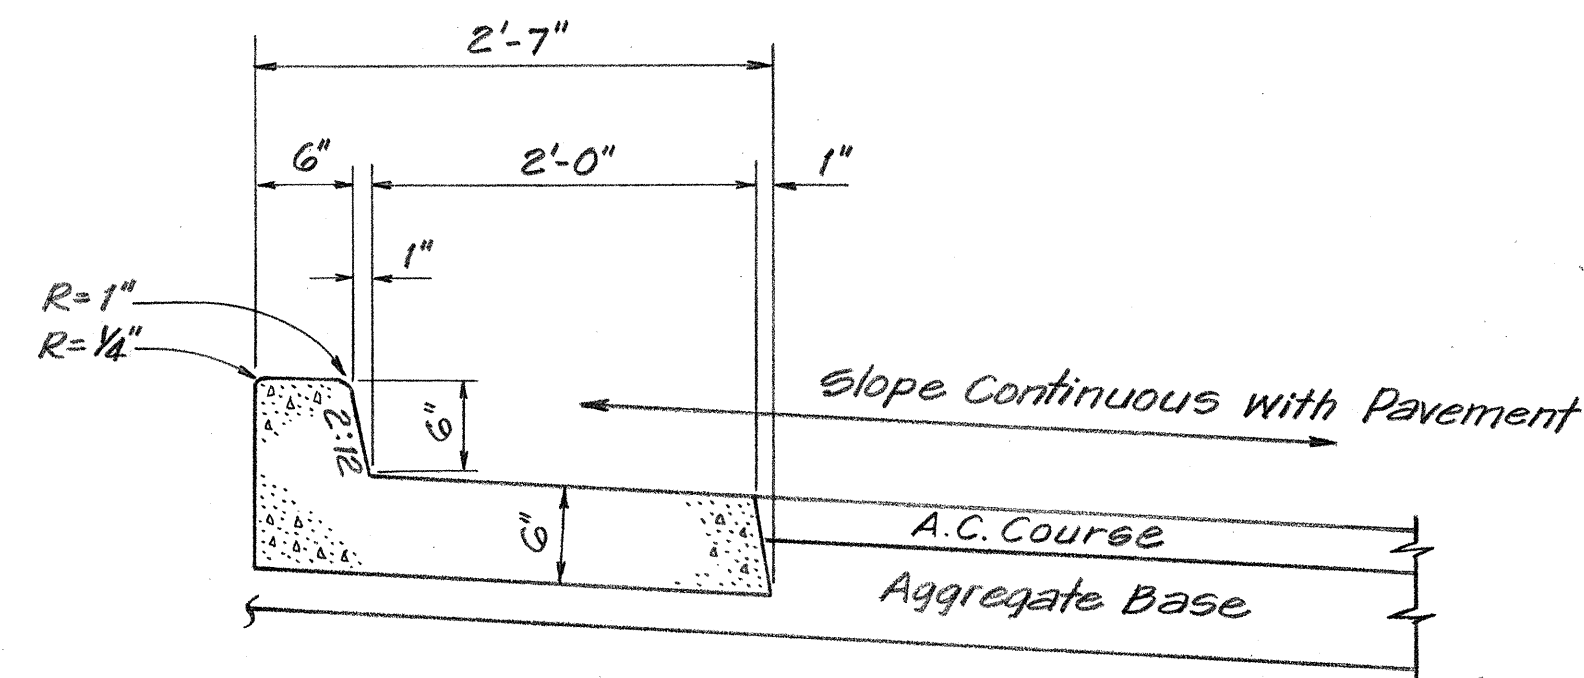


TYPE "2CG" CAST-IN-PLACE CONCRETE CURB & GUTTER

Scale: 1"=1'-0"

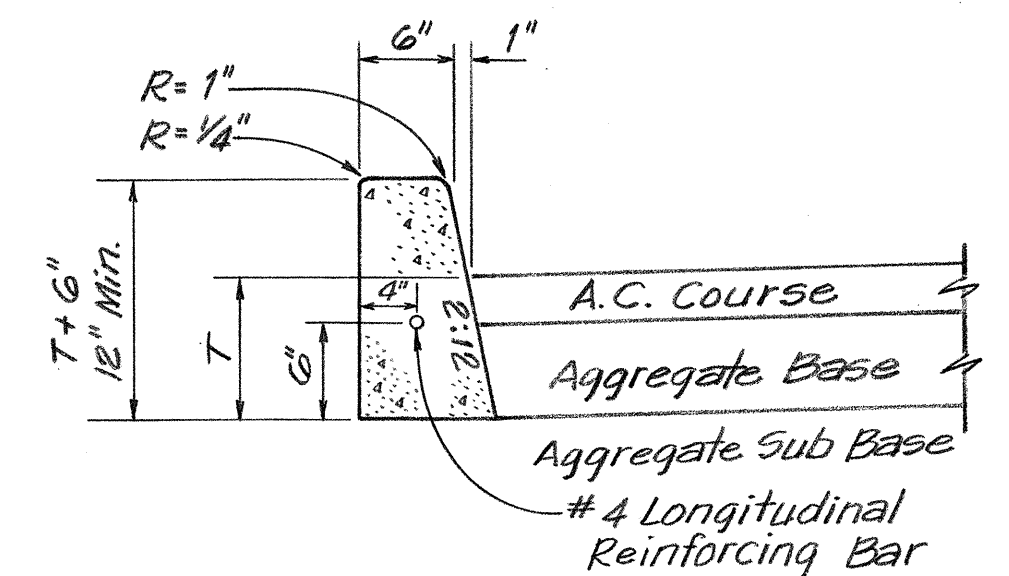


CURB, TYPE "2D"

Scale: 1"=1'-0"

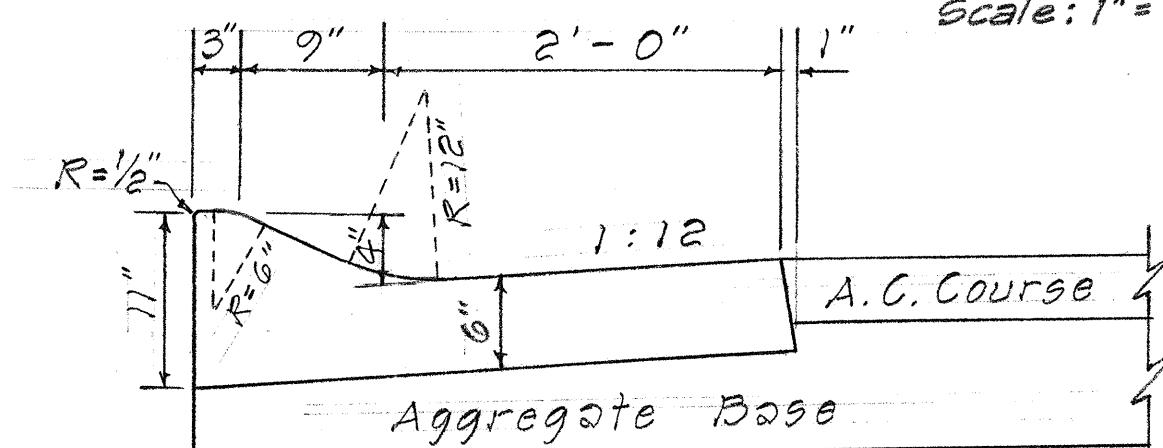


TYPE "2EG" CAST-IN-PLACE CONCRETE CURB & GUTTER

Scale: 1"=1'-0"

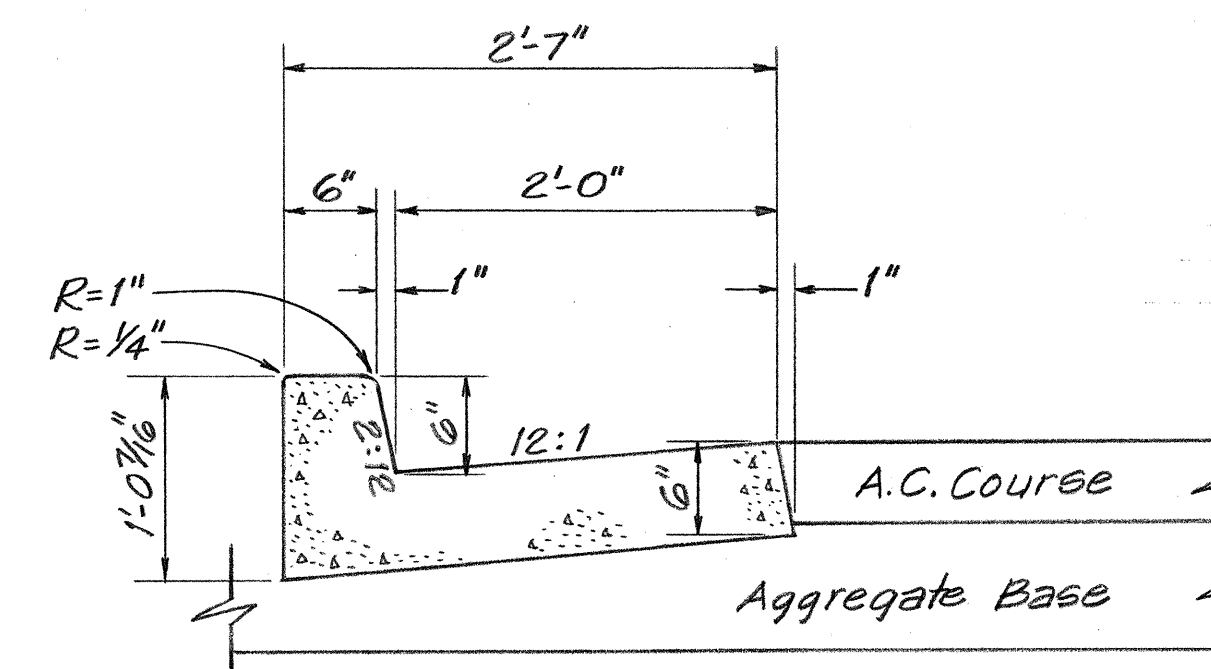

TYPE "2DG" CAST-IN-PLACE CONCRETE CURB & GUTTER

Scale: 1"=1'-0"

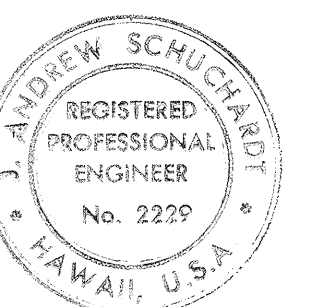

THIS WORK WAS PREPARED BY ME OR UNDER MY SUPERVISION.

J. Andrew Schuchardt

STATE OF HAWAII
DEPARTMENT OF TRANSPORTATION
HIGHWAYS DIVISION

MISCELLANEOUS ROADWAY DETAILS
CUSHION BARRIER, CURB & GUTTER


INTERSTATE ROUTE H-1
PROJECT NO. I-HI-1(89)13

SCALE: AS SHOWN


DATE: Oct 30, 1970

SHEET No. 11B OF 25 SHEETS

FED. ROAD DIST. NO.	STATE	FED. AID PROJ. NO.	FISCAL YEAR	SHEET NO.	TOTAL SHEETS
HAWAII	HAW.	1-H-1(89)-13	1971	38	362

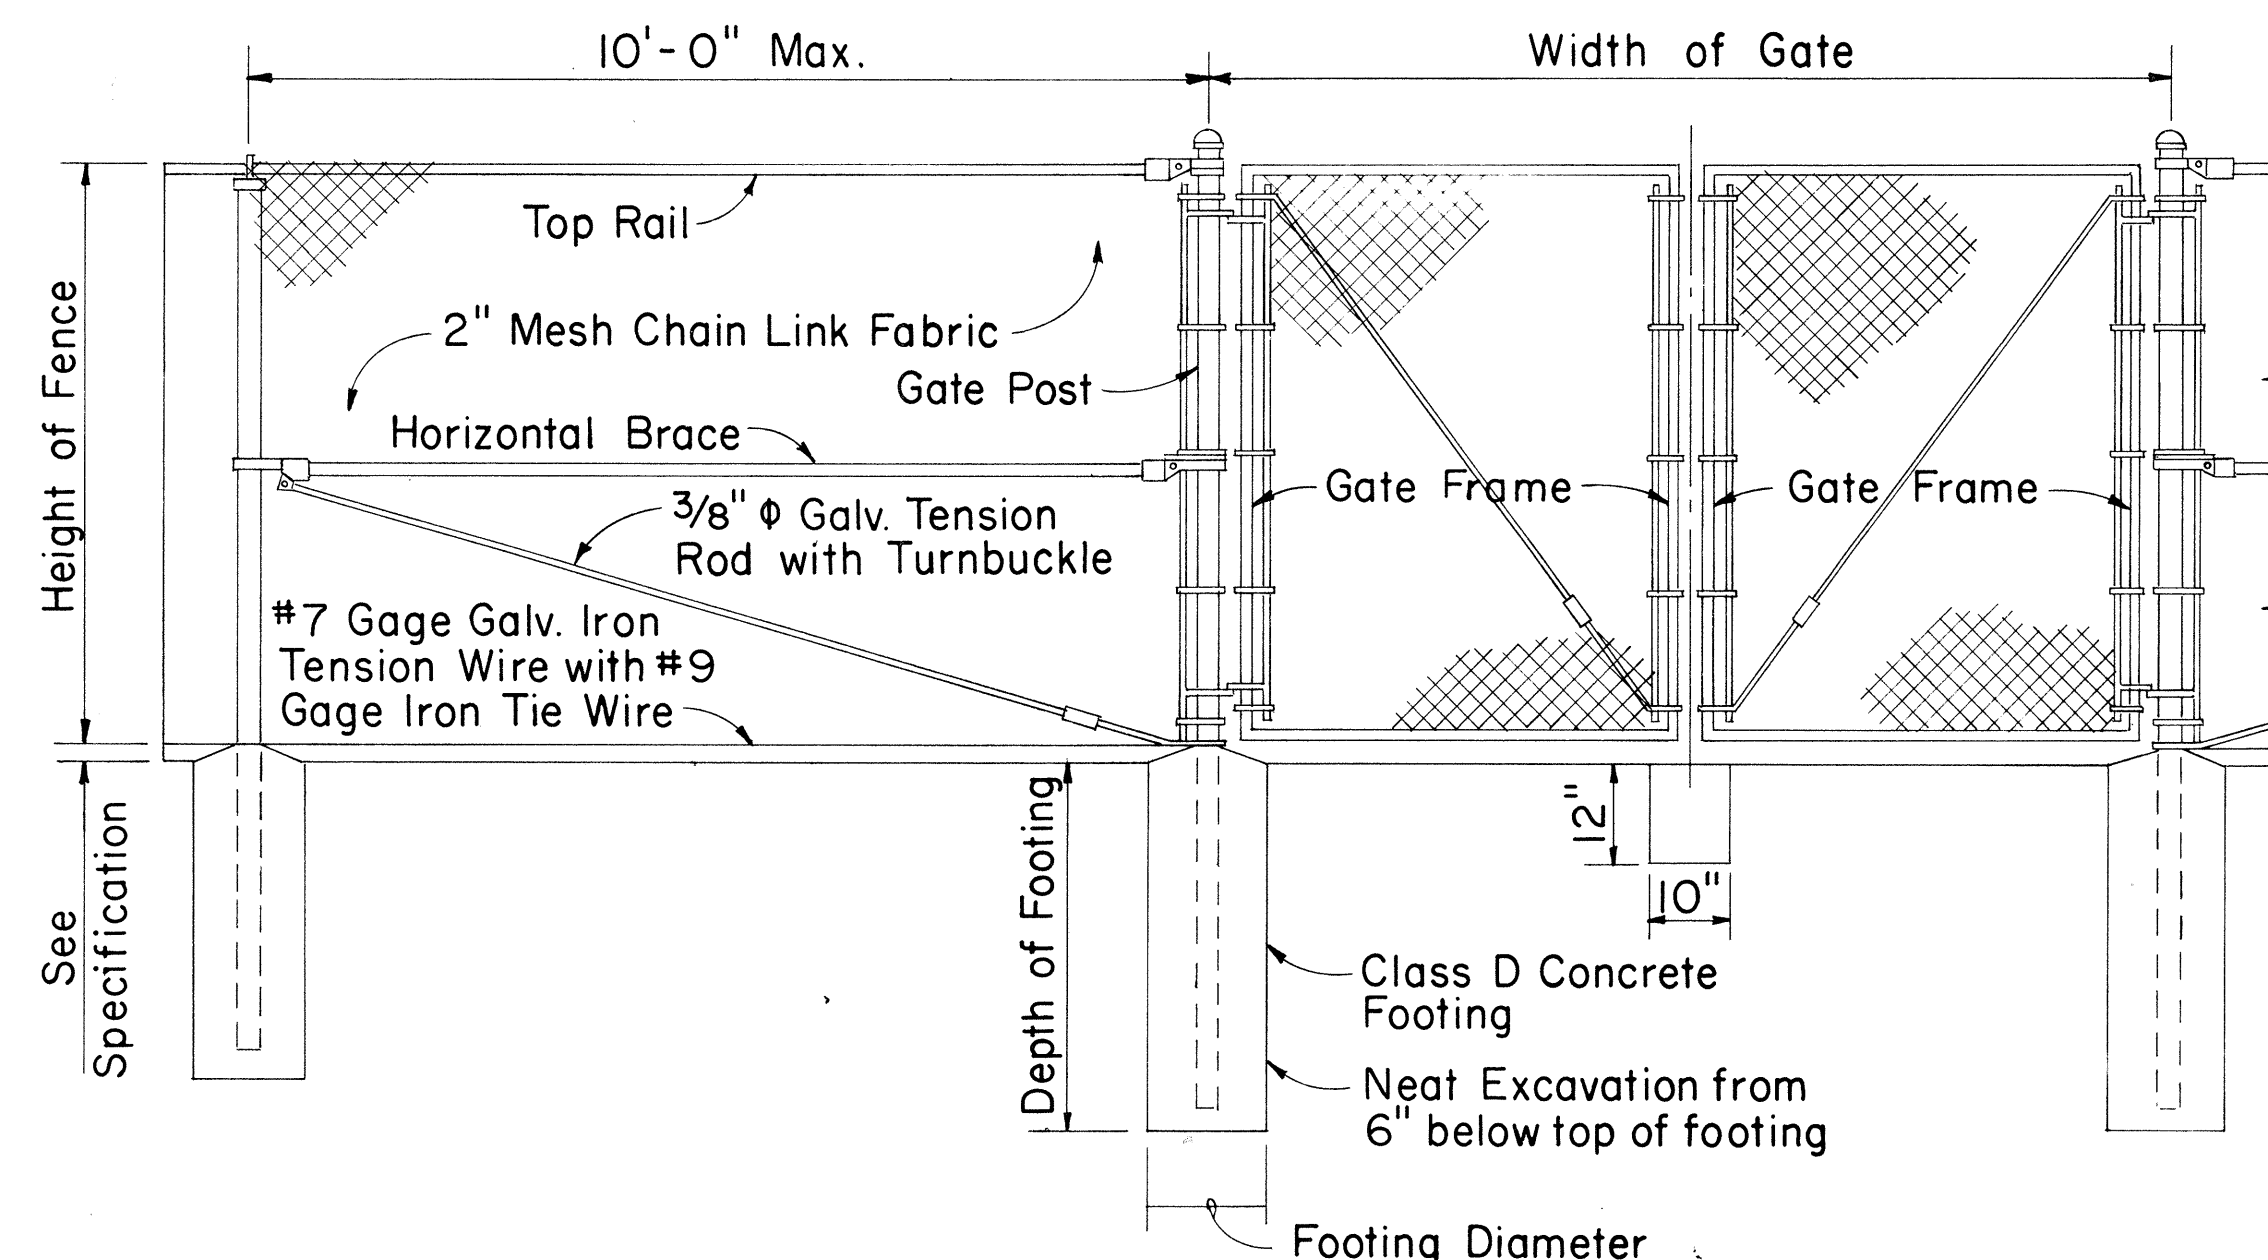

LINE POST GATE POST GATE POST

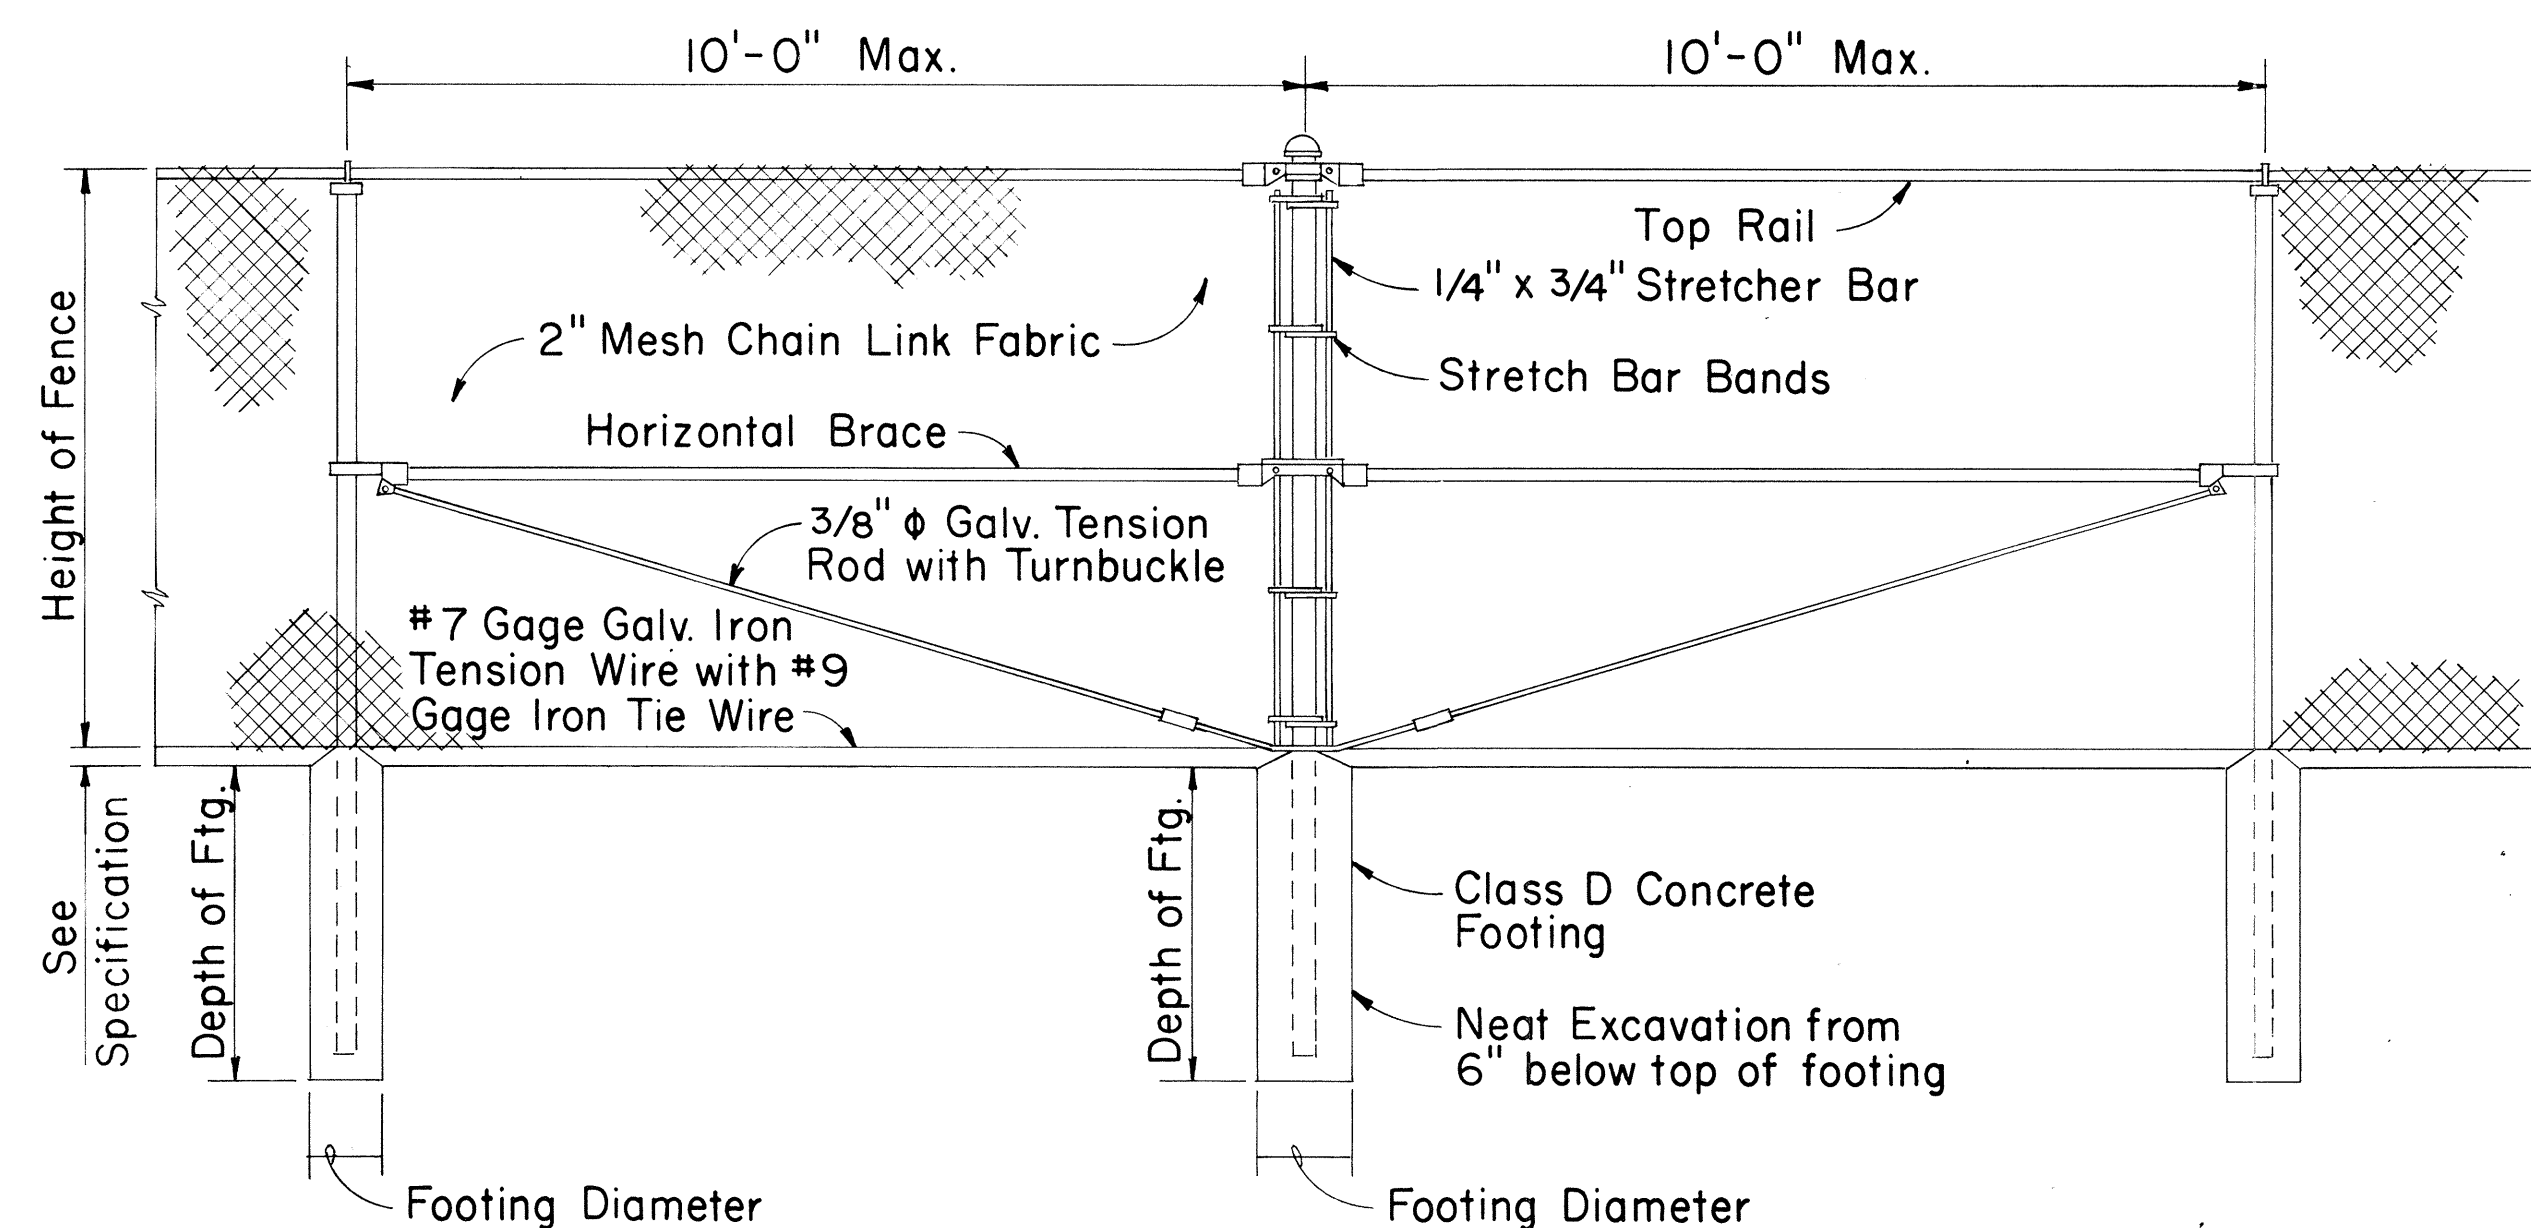


LINE POST PULL POST LINE POST

TYPICAL SECTION
(WITH CONCRETE FOOTING)


DETAIL OF CHAIN LINK GATE

- NOTE: 1. Gate fork latch and lock, flush plate and anchor, and plunger shall be installed with Gates, and shall be considered as incidental to Chain Link Fence Gate.
2. Gate frames shall be mitered and welded at corners.
3. Fence detail not shown shall be in accordance with the Standard Specifications.
4. Padlock (Combination type) shall be provided, and shall be considered as incidental to Chain Link Gate.

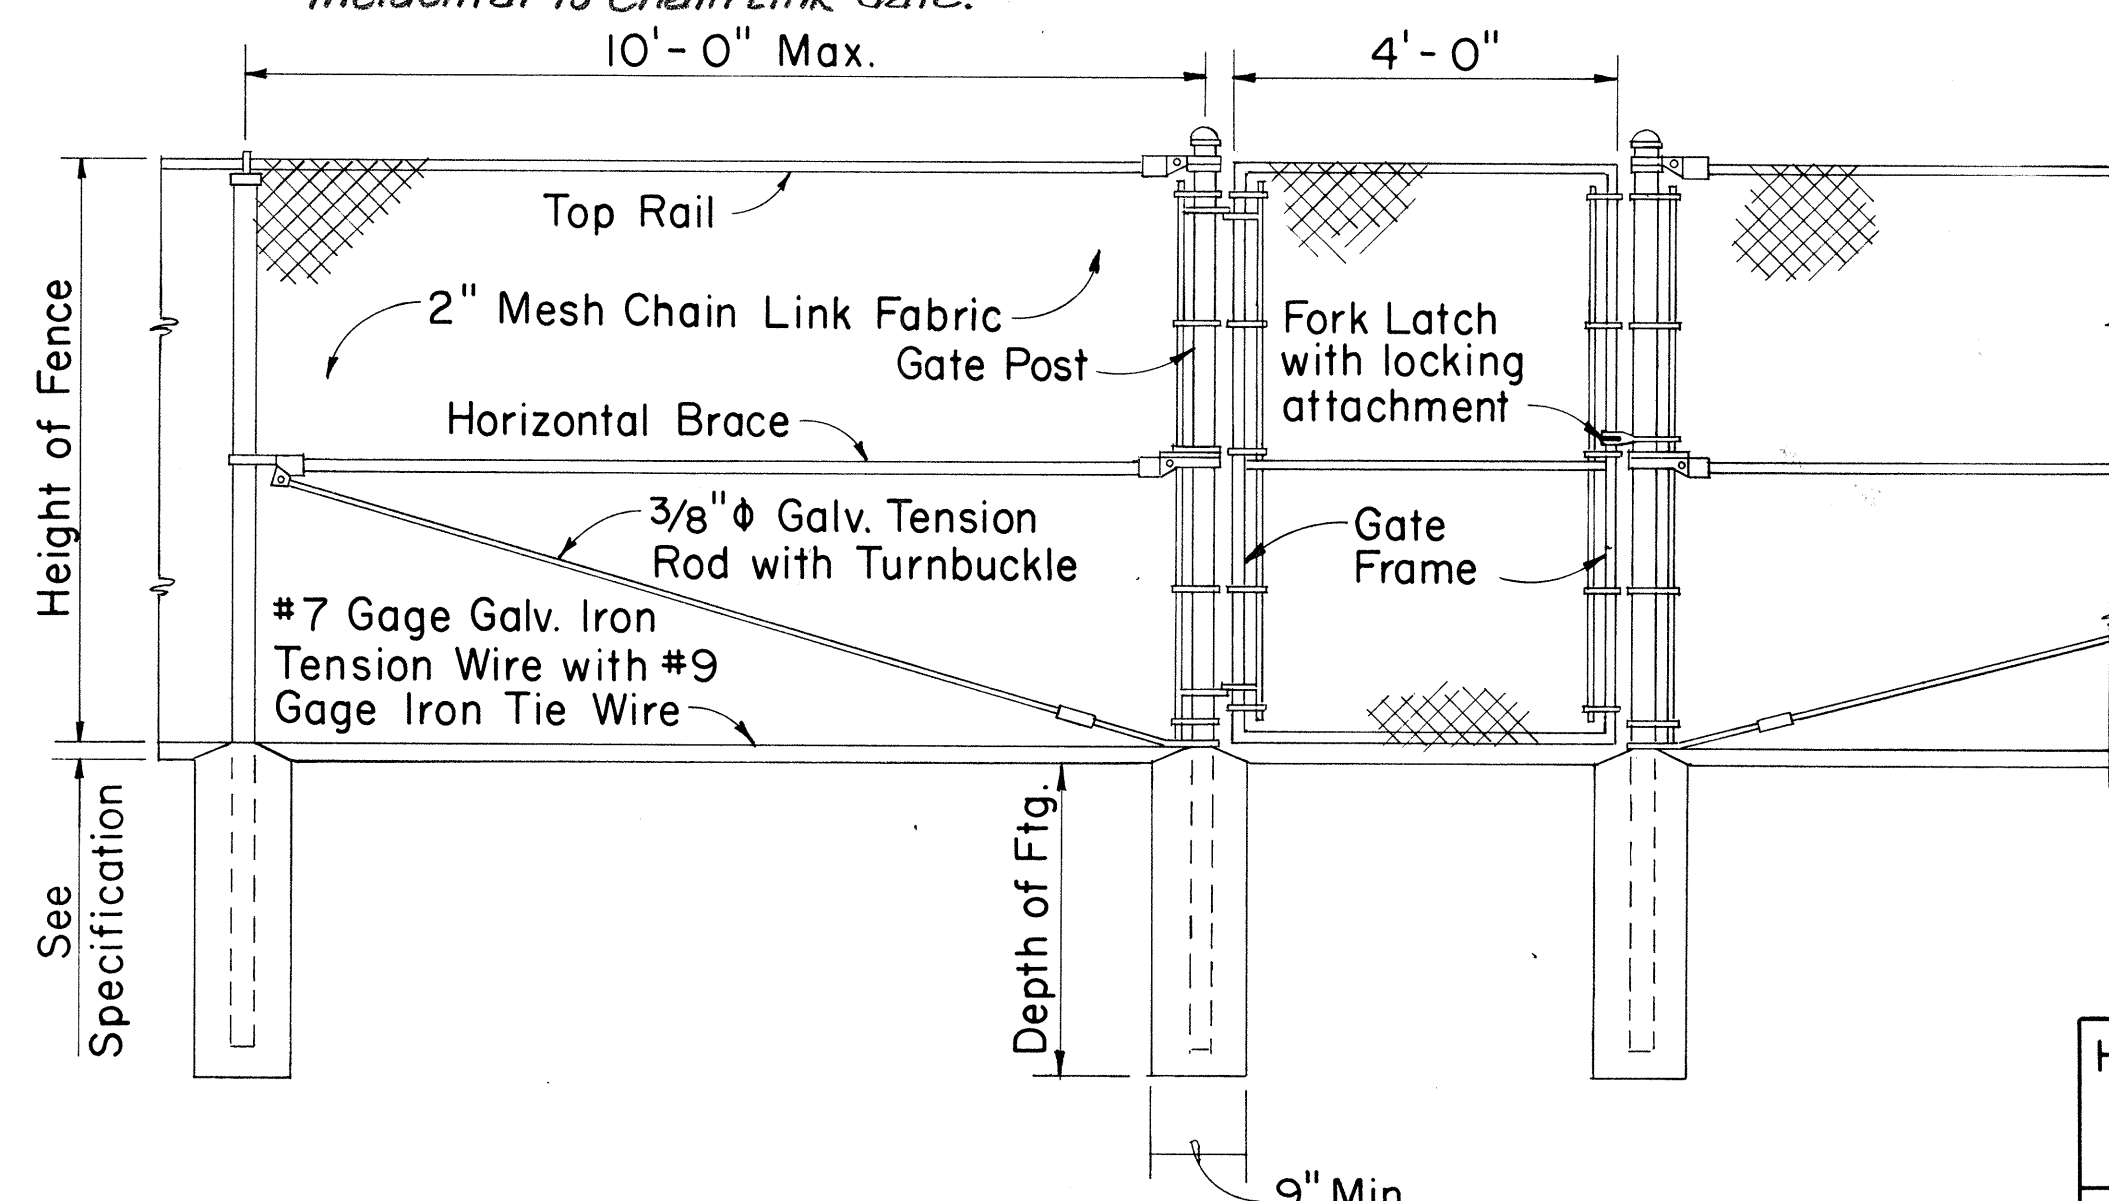


LINE POST GATE POST GATE POST

DETAIL OF 4 FT. CHAIN LINK GATE

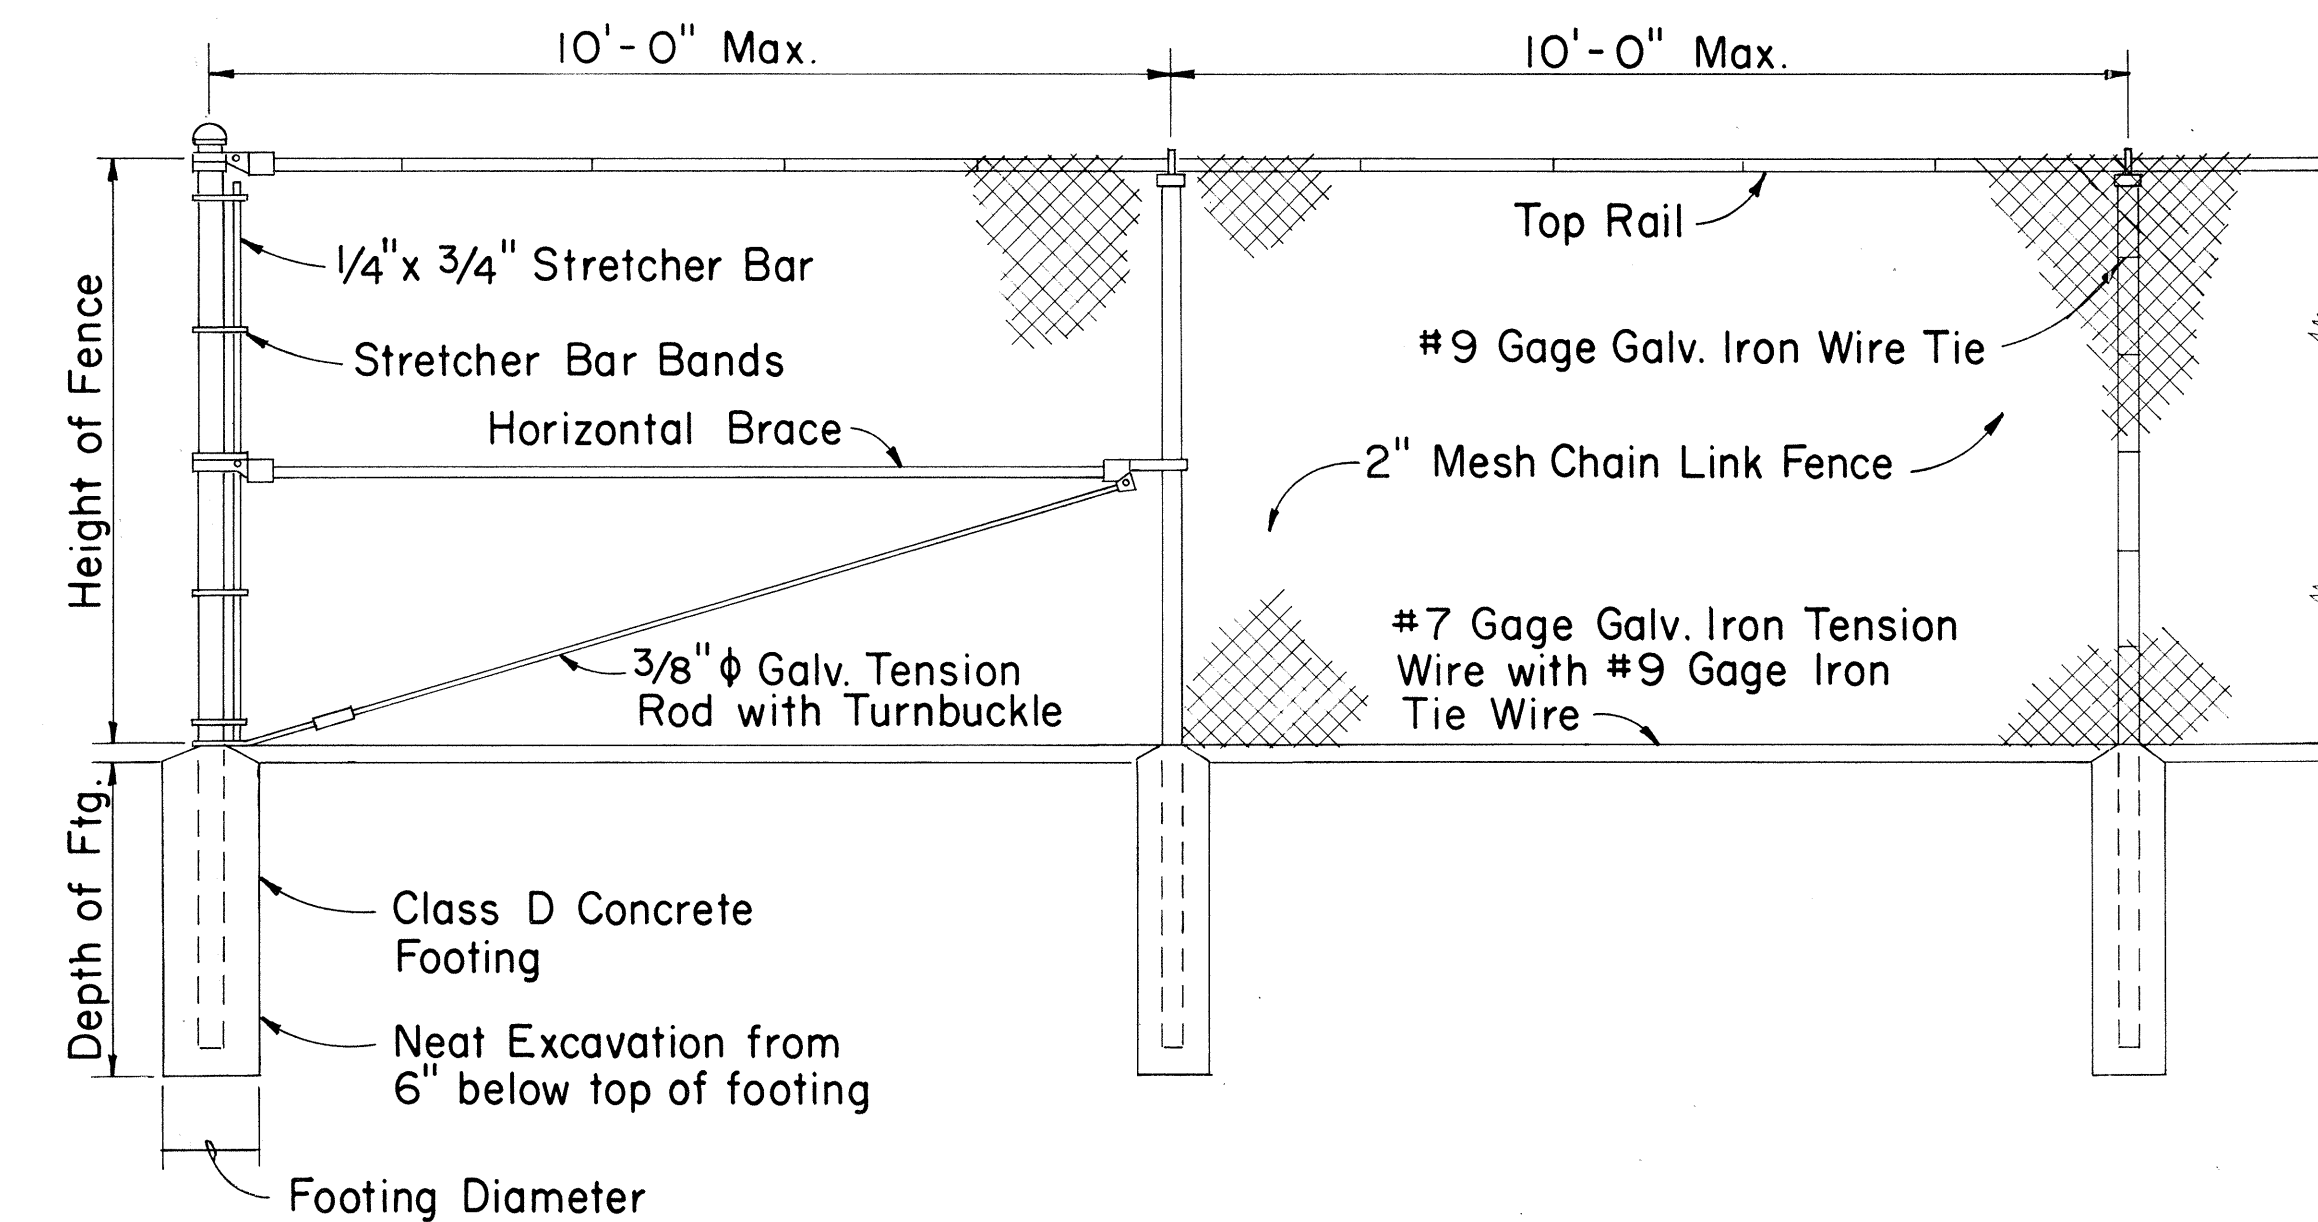

END POST LINE POST LINE POST

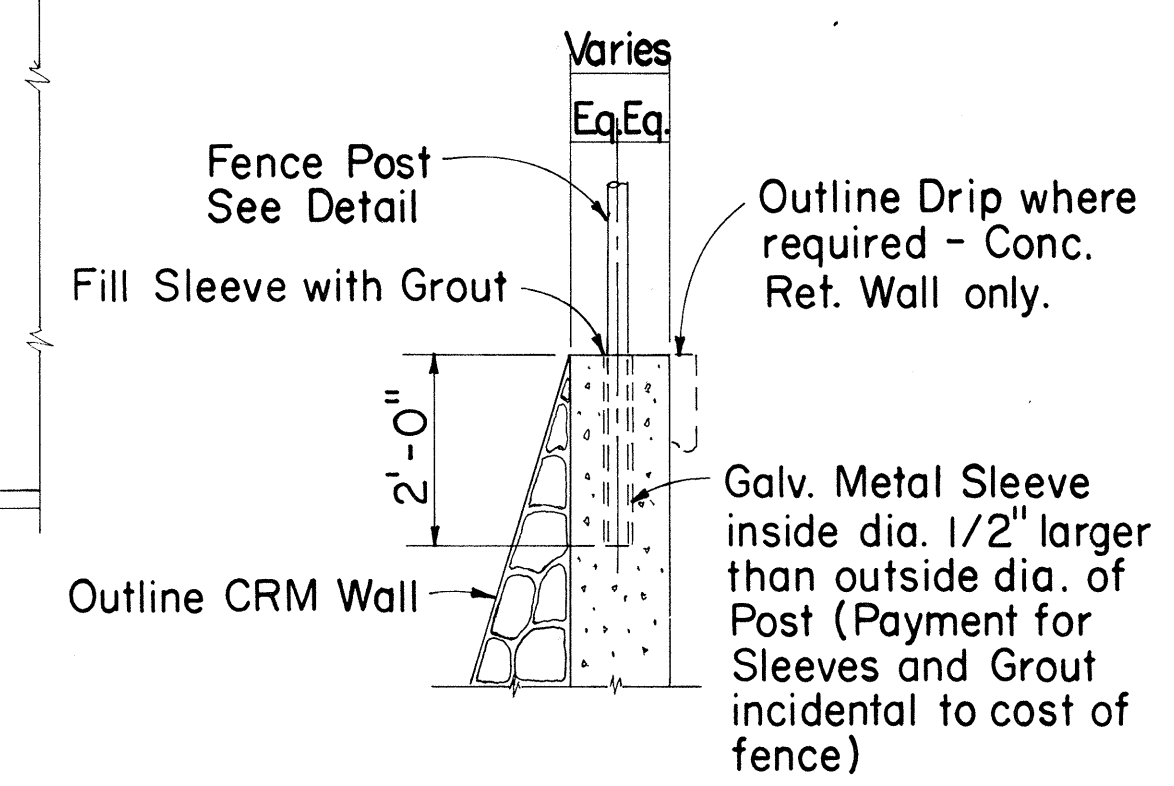

TYPICAL SECTION
(ON CRM & CONC. RET. WALL)

CHAIN LINK FENCE DETAILS

Height of Fence	Minimum Depth of Footing		Minimum Footing Diameter	
	Line Post	Corner, Pull, End and Gate Posts	Line Post	Corner, Pull and End Posts
3'	2'-0"	2'-6"	8"	8"
4'	2'-6"	2'-6"	8"	8"
5'	3'-0"	3'-0"	8"	8"
6'	3'-0"	3'-0"	8"	9"

APPROVAL, RECOMMENDED:
HIGHWAY DESIGN ENGINEER 12-4-69
DATE

APPROVED:
ASSISTANT CHIEF, ENGINEERING 12-10-69
DATE


NO.	REVISION	APPROVED BY	DATE

STATE OF HAWAII
DEPARTMENT OF TRANSPORTATION
HIGHWAYS DIVISION


STANDARD DETAILS
CHAIN LINK FENCE
(WITH TOPRAIL)

Scale: 1/2" = 1'-0"
Date: OCT. 30, 1970


FED. ROAD DIST. NO.	STATE	FED. AID PROJ. NO.	FISCAL YEAR	SHEET NO.	TOTAL SHEETS
HAWAII	HAW.	HA-1(89)13	1971	37	362

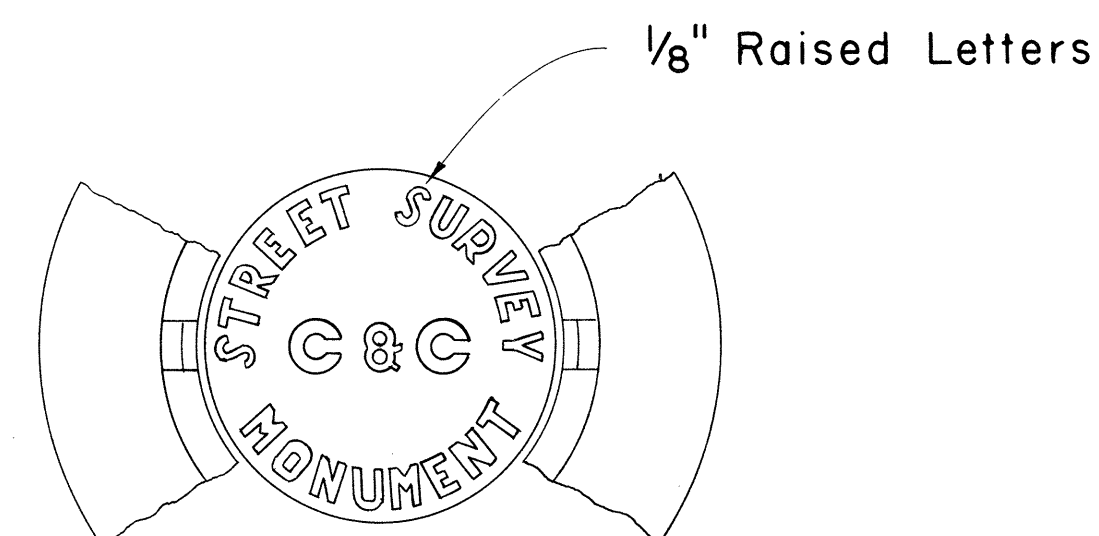

TOP VIEW OF COVER
AND PORTION OF FRAME

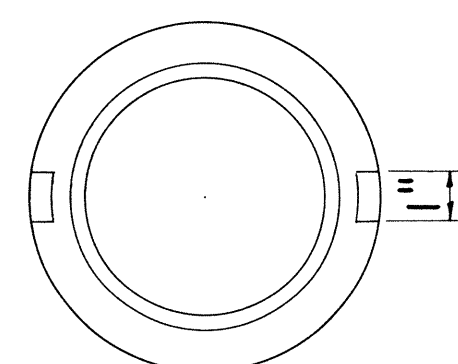


BOTTOM OF COVER

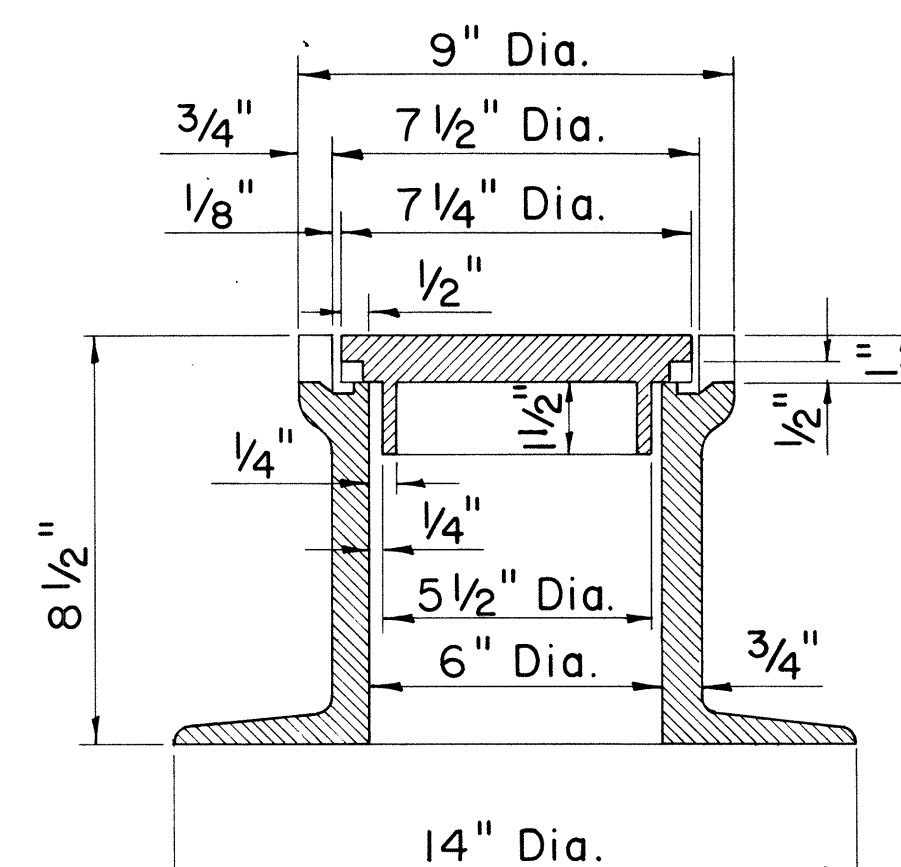

SECTIONAL VIEW OF
FRAME AND COVER

STREET SURVEY MONUMENT CASTINGS

Scale: 3" = 1'-0"

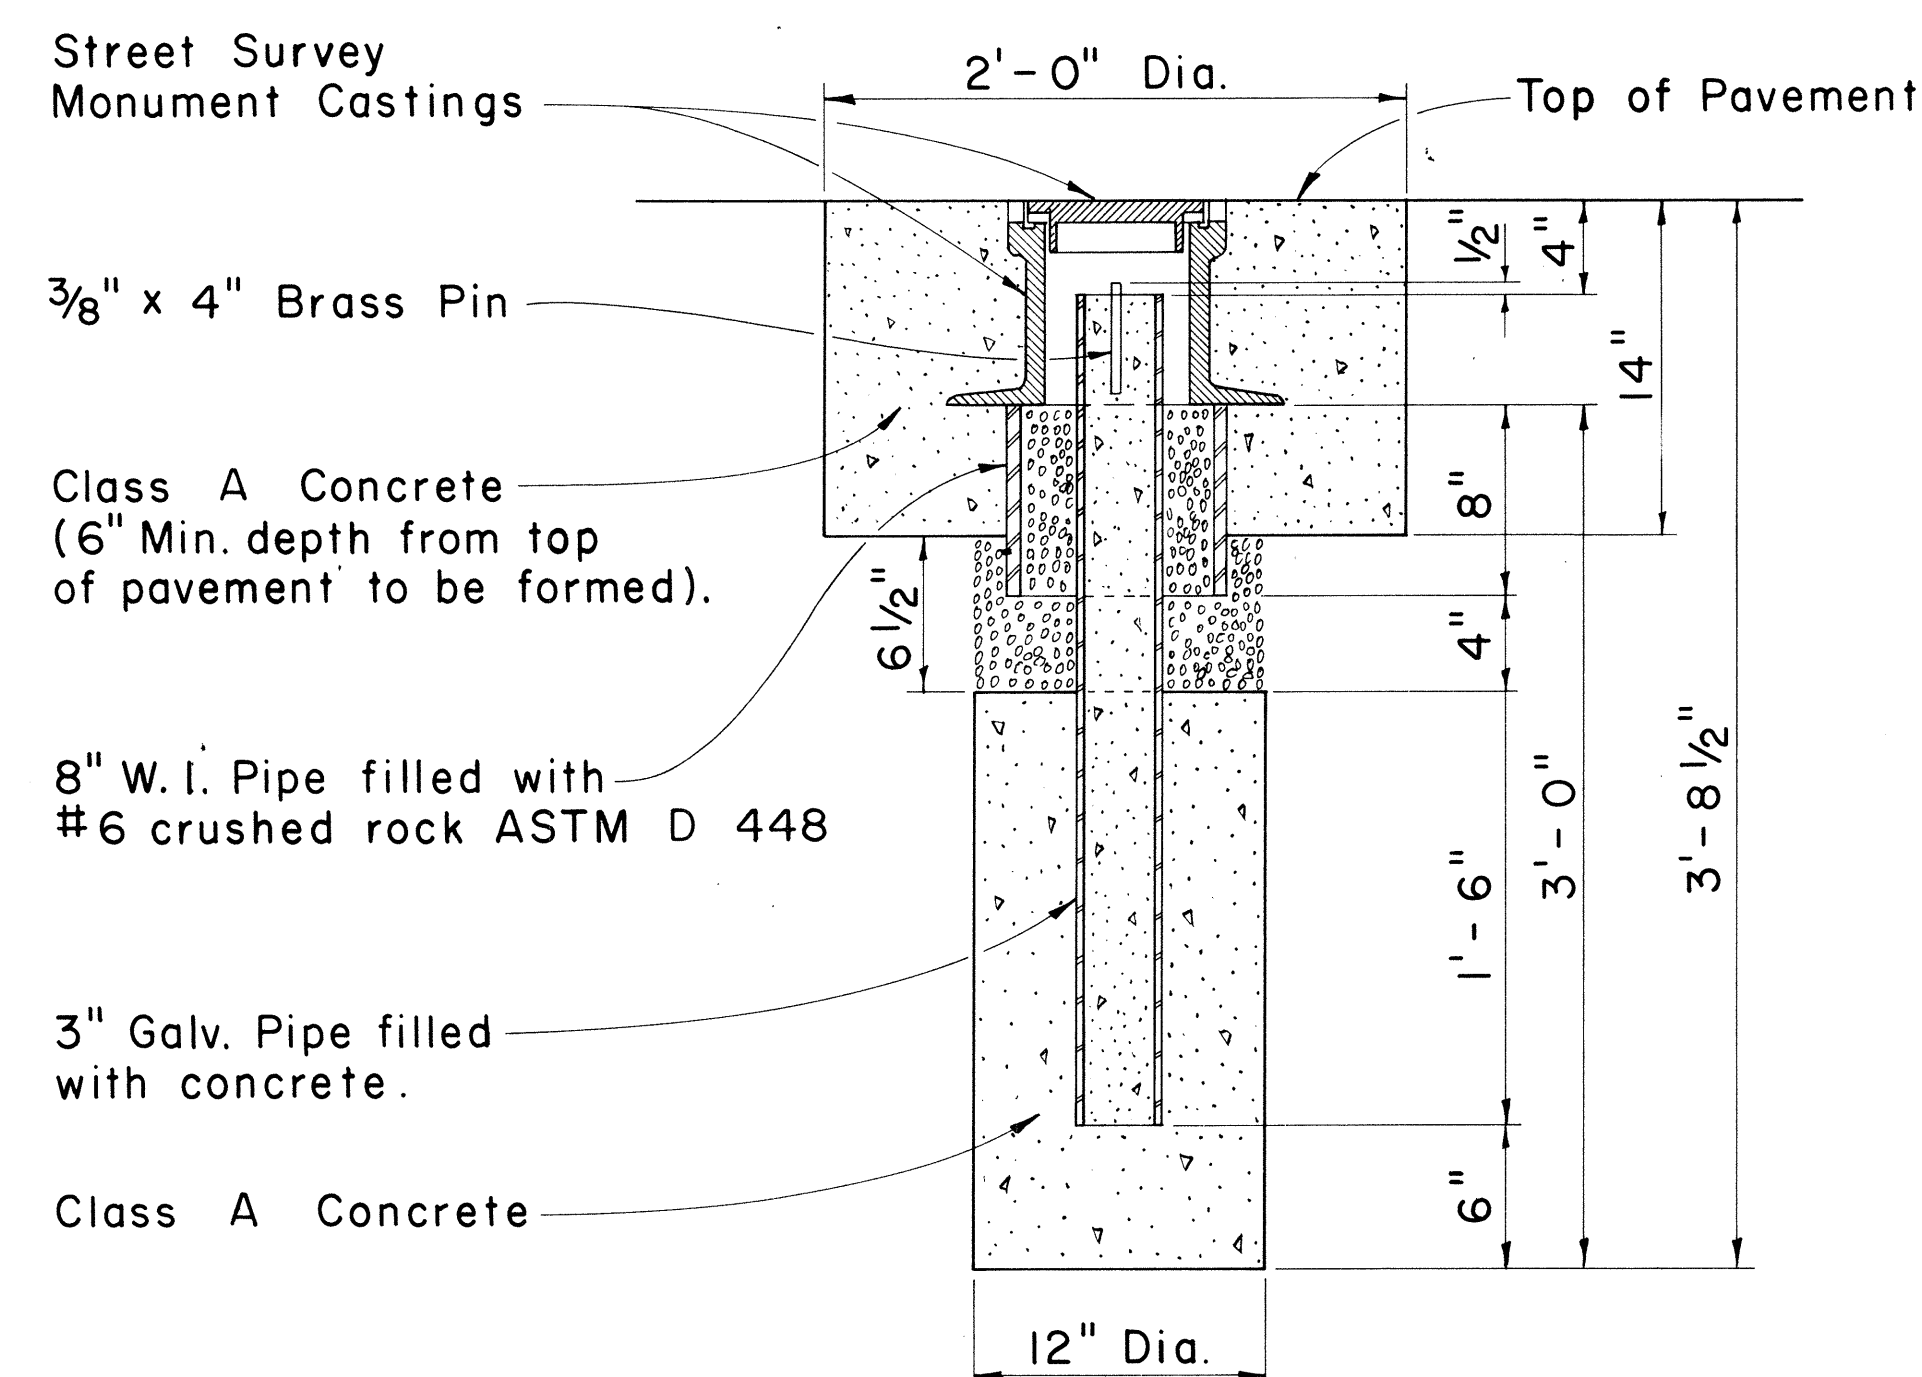


NOTE:

Where the excavation extends into solid rock the depth may be decreased if approved by the Engineer.

STREET SURVEY MONUMENT

Scale: 1 1/2" = 1'-0"

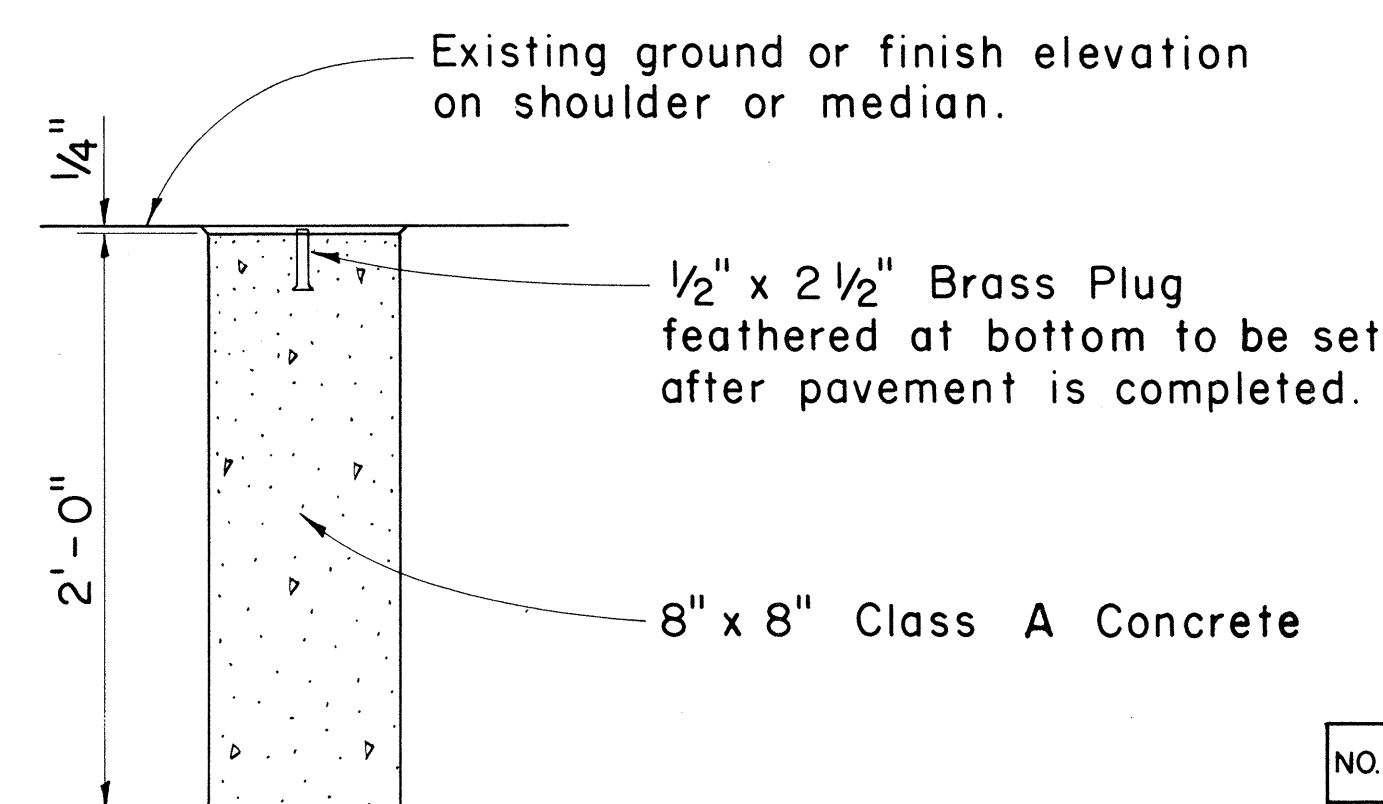

DETAIL FOR CENTERLINE AND REFERENCE SURVEY MONUMENT

Scale: 1 1/2" = 1'-0"

APPROVAL RECOMMENDED:
M. Hironaka 12-4-69
HIGHWAY DESIGN ENGINEER DATE

APPROVED:
John E. Sabido 12-10-69
ASSISTANT CHIEF, ENGINEERING DATE

NO.	REVISION	APPROVED BY	DATE



STATE OF HAWAII
DEPARTMENT OF TRANSPORTATION
HIGHWAYS DIVISION

STANDARD DETAILS
CENTERLINE, REFERENCE SURVEY
AND C & C STREET SURVEY
MONUMENTS




Scale: As Shown DATE: OCT. 30, 1970
SHEET No. 37 OF 25 SHEETS DD 613.1

DATE	
SURVEY PLOTTED BY	
DRAWN BY	
DESIGNED BY	
NOTE BOOK	
QUANTITIES BY	
CHECKED BY	
NO.	



FED. ROAD DIST. NO.	STATE	FED. AID PROJ. NO.	FISCAL YEAR	SHEET NO.	TOTAL SHEETS
HAWAII	HAW.	HA-1(89)13	1971	40	362

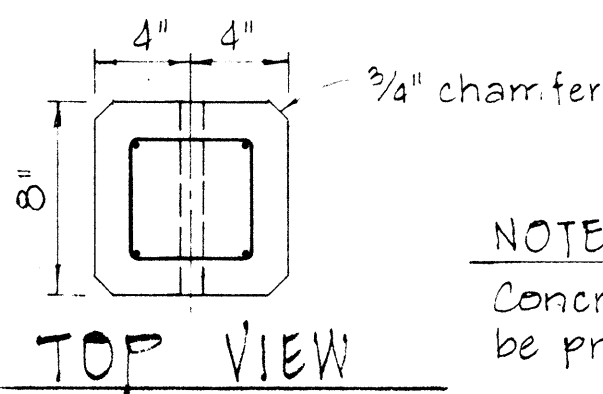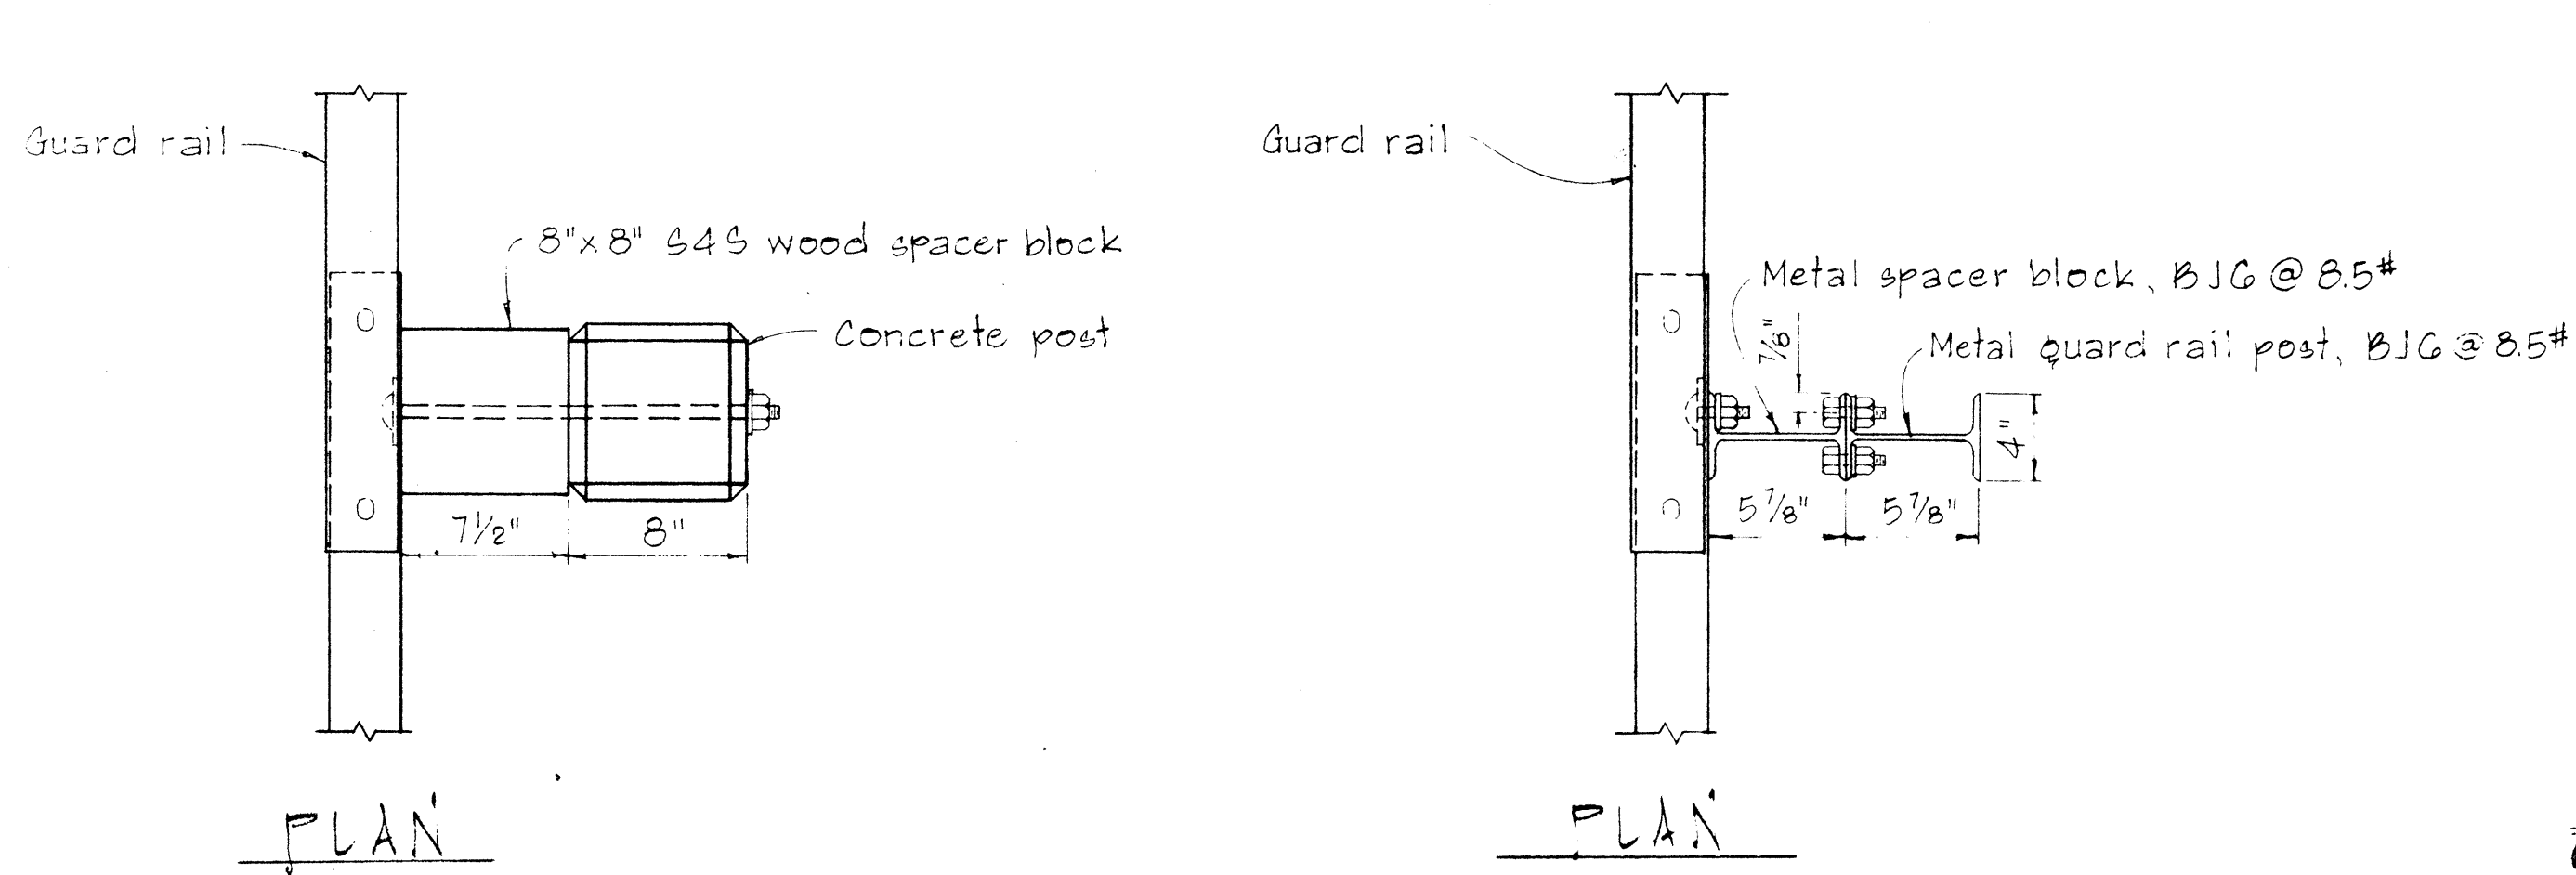


NOTE:
Concrete post shall be precast

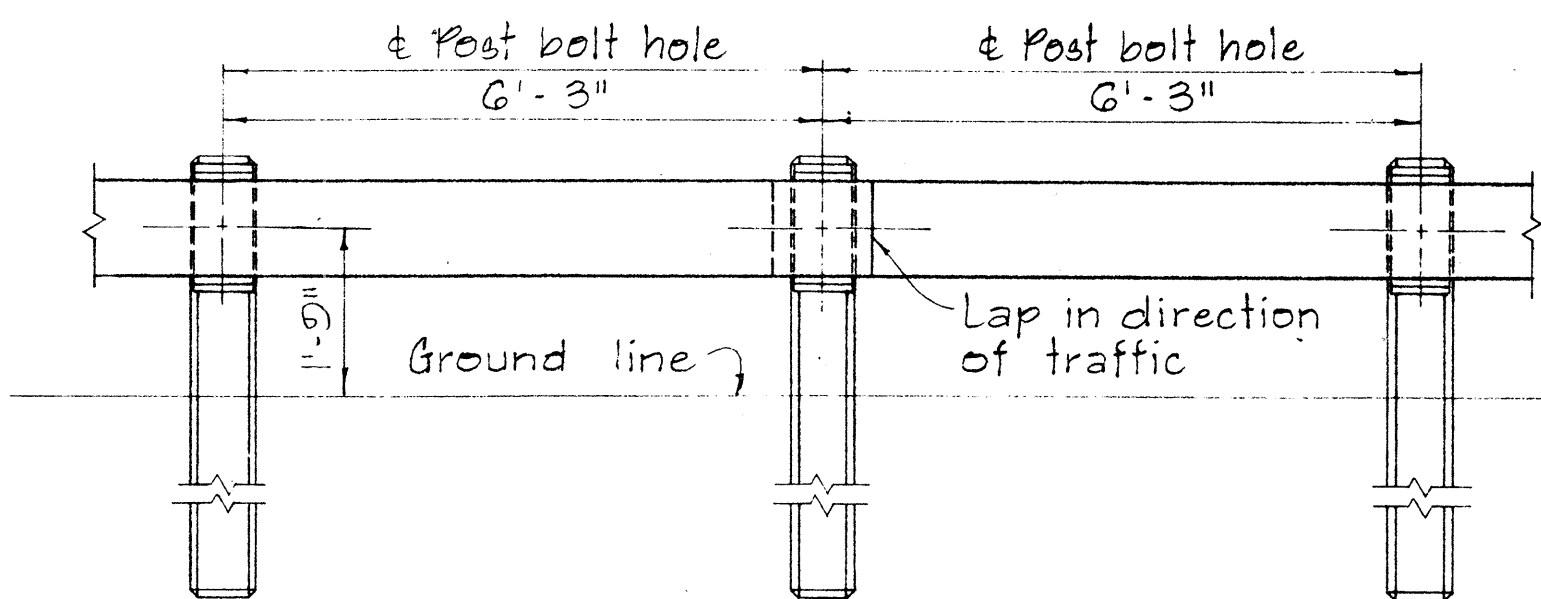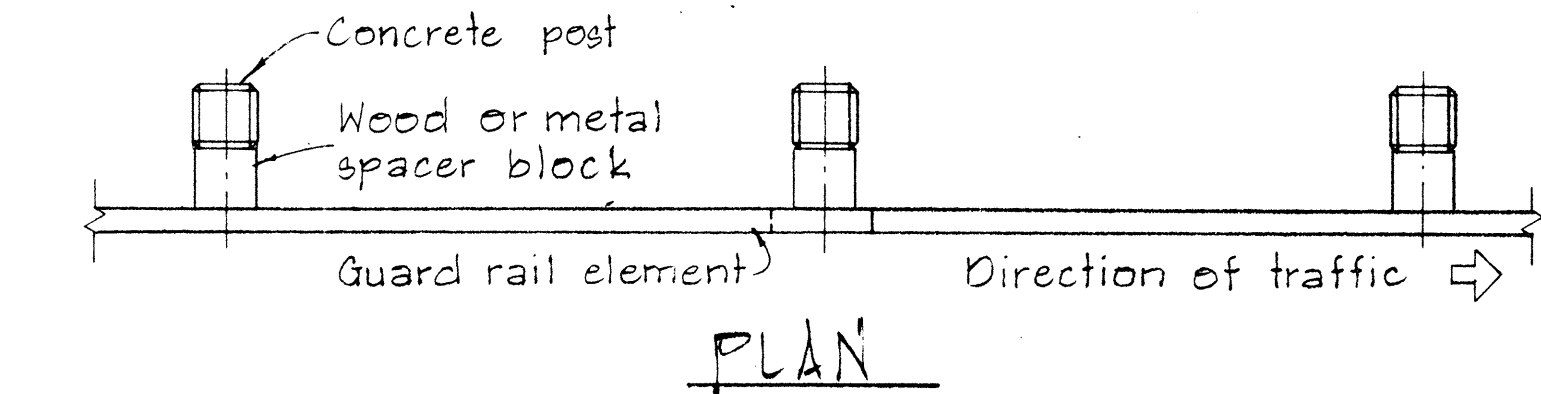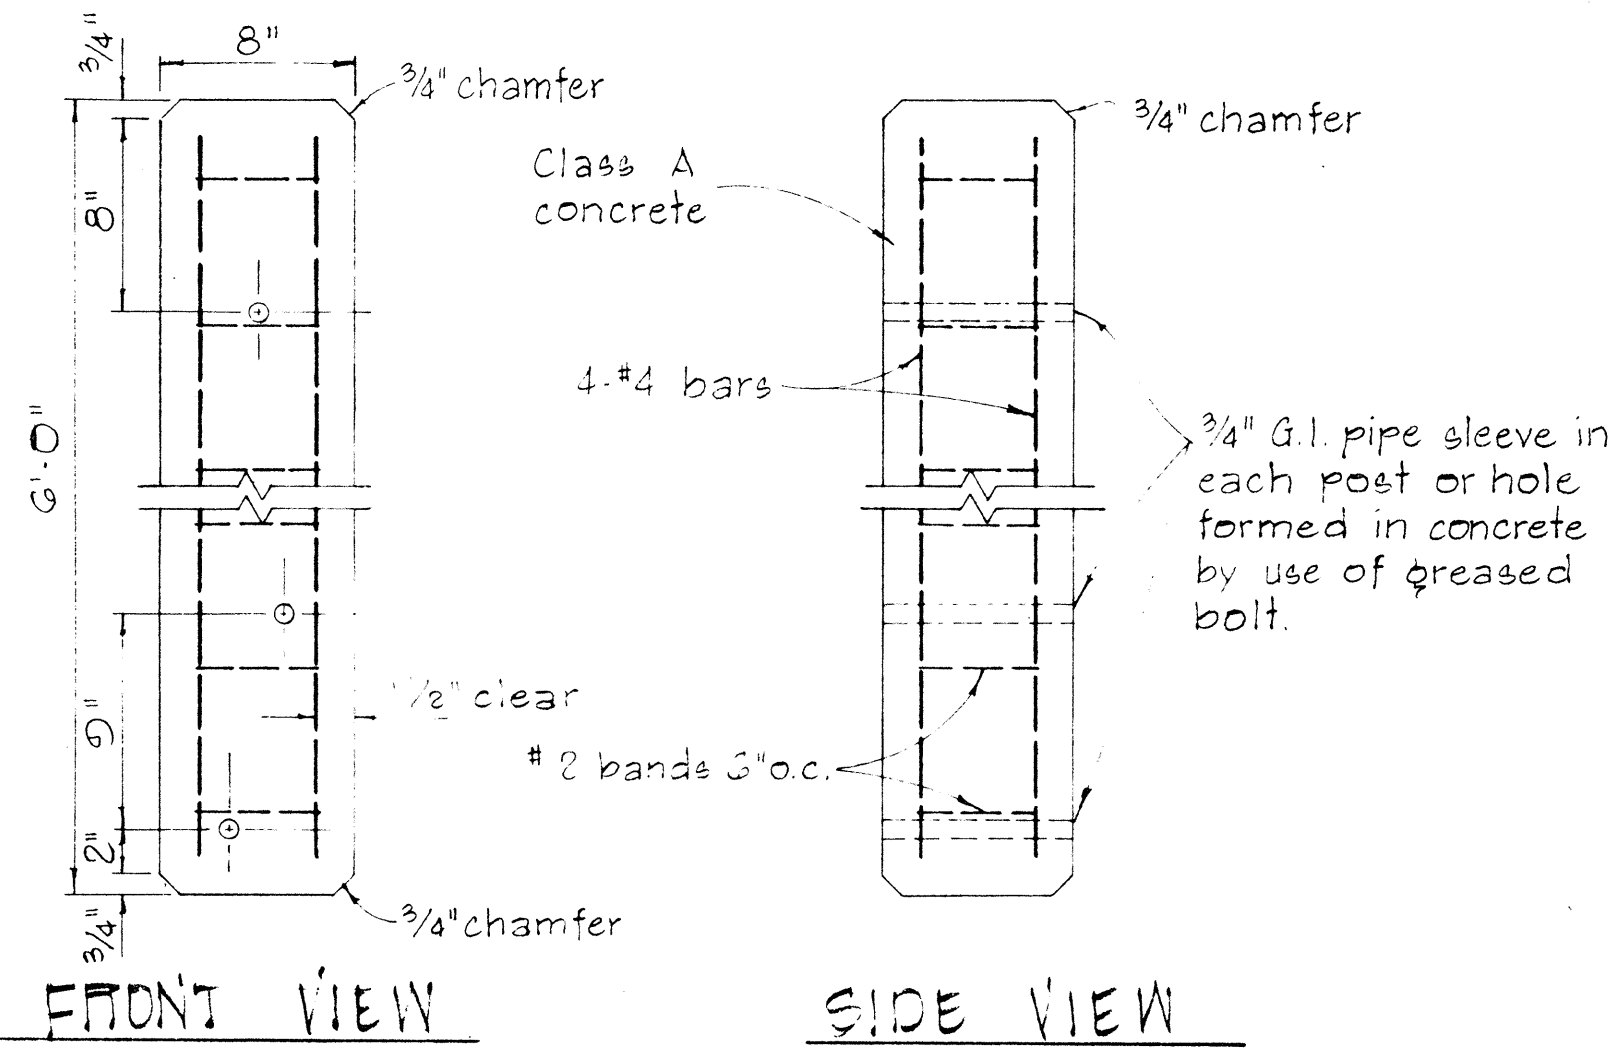


METAL GUARD RAIL ON CONCRETE POST WITH WOOD OR METAL SPACER BLOCK.

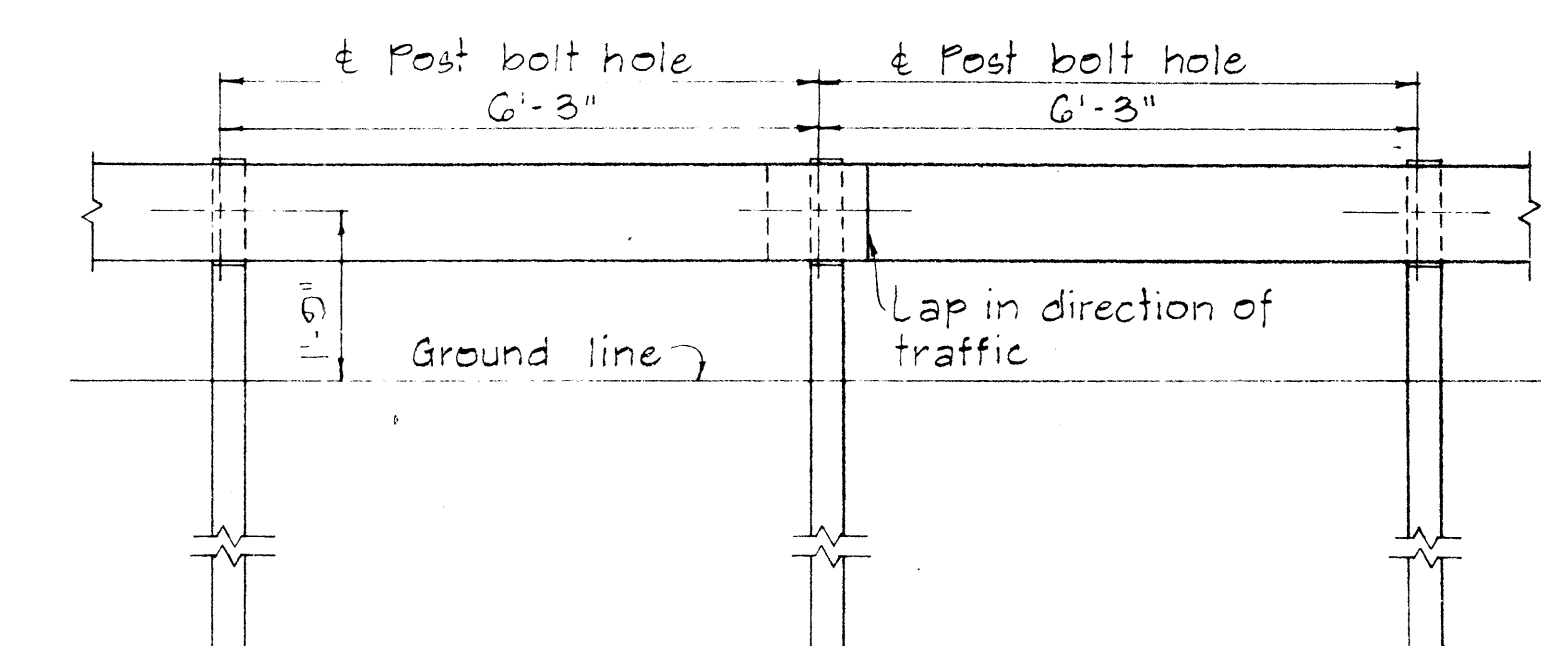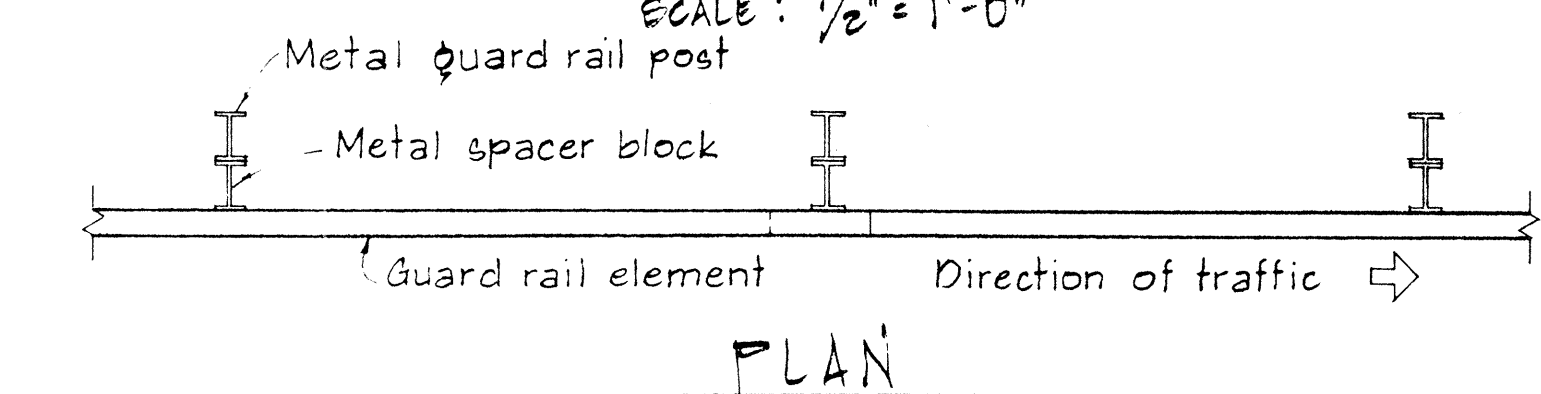

METAL GUARD RAIL ON METAL POST WITH METAL SPACER BLOCK

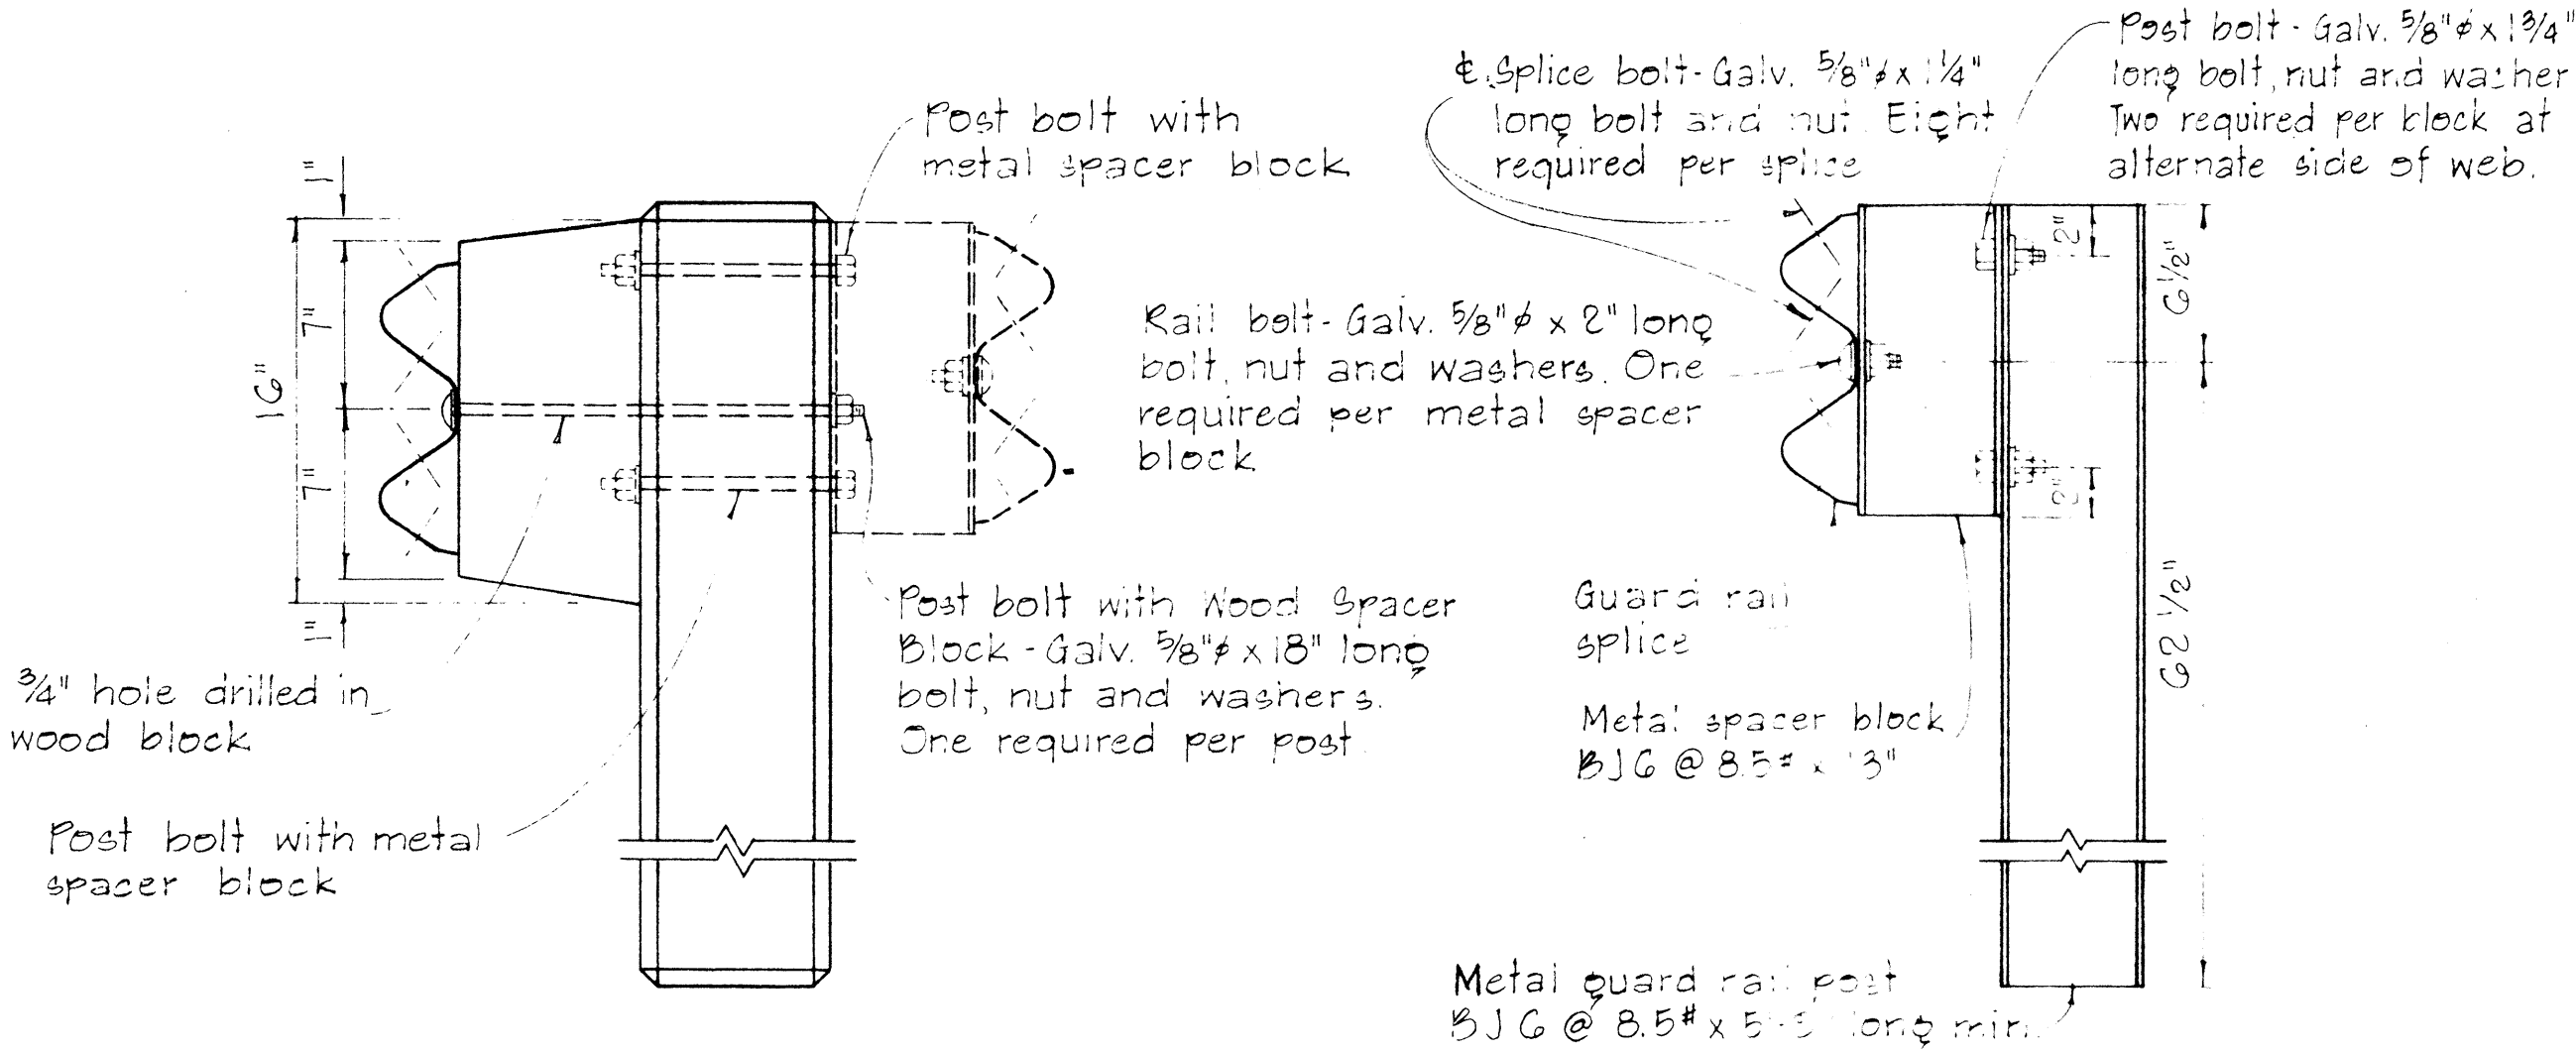

SINGLE METAL GUARD RAIL ON METAL POST WITH METAL SPACER BLOCK

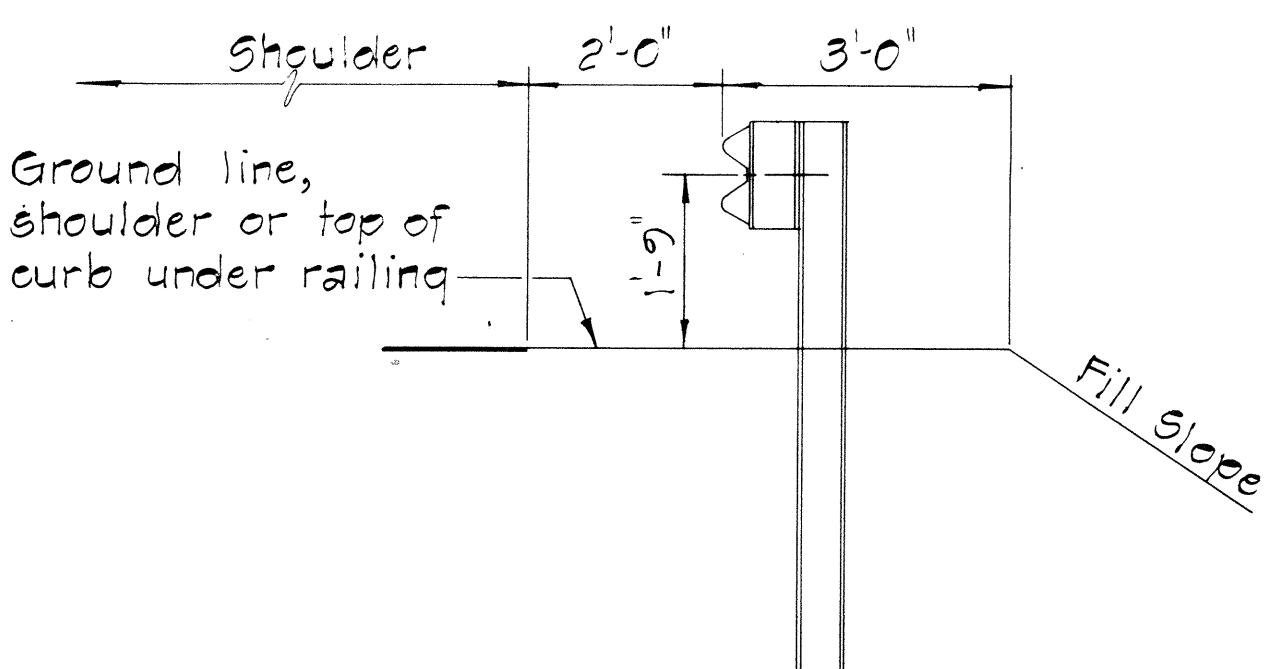

TYPICAL METAL GUARD RAIL DETAIL

APPROVAL RECOMMENDED:
Erich Tanaka
TRAFFIC ENGINEER
DATE: 12/29/62

APPROVED:
Robert J. DeLeon
ASSISTANT CHIEF, ENGINEERING
DATE: 12-30-69

NO.	REVISION	APPROVED BY	DATE

STATE OF HAWAII
DEPARTMENT OF TRANSPORTATION
HIGHWAYS DIVISION

STANDARD DETAILS
METAL GUARD RAIL

SCALE: AS SHOWN NOV. 1968

SHEET No. 48 OF 25 SHEETS DT 500












SINGLE METAL GUARD RAIL ON PRECAST CONCRETE POST WITH WOOD OR METAL SPACER BLOCK

SCALE: 1 1/2" = 1'-0"

DATE	
SURVEY PLOTTED BY	
DRAWN BY	
TRACED BY	
ENGINEER BY	
CHECKED BY	
NO.	

FED. ROAD DIST. NO.	STATE	FED. AID PROJ. NO.	FISCAL YEAR	SHEET NO.	TOTAL SHEETS
HAWAII	HAW.	FHT-1(89)/13	1971	42	362

NOTE:
Metal guard rail connection to structures requires End Post Connection. See structure plans.

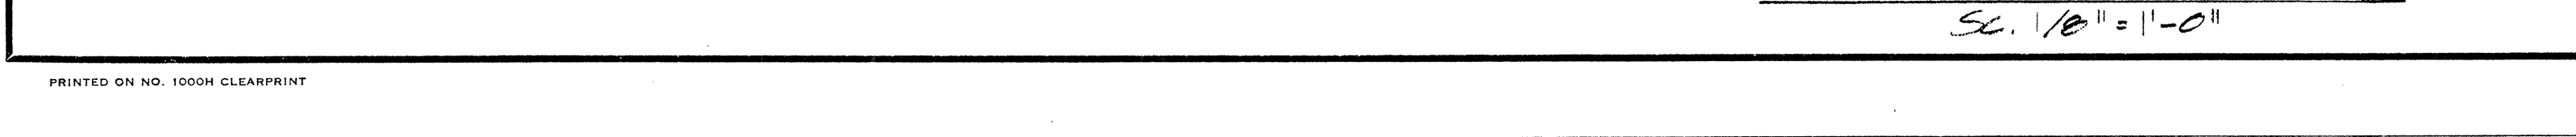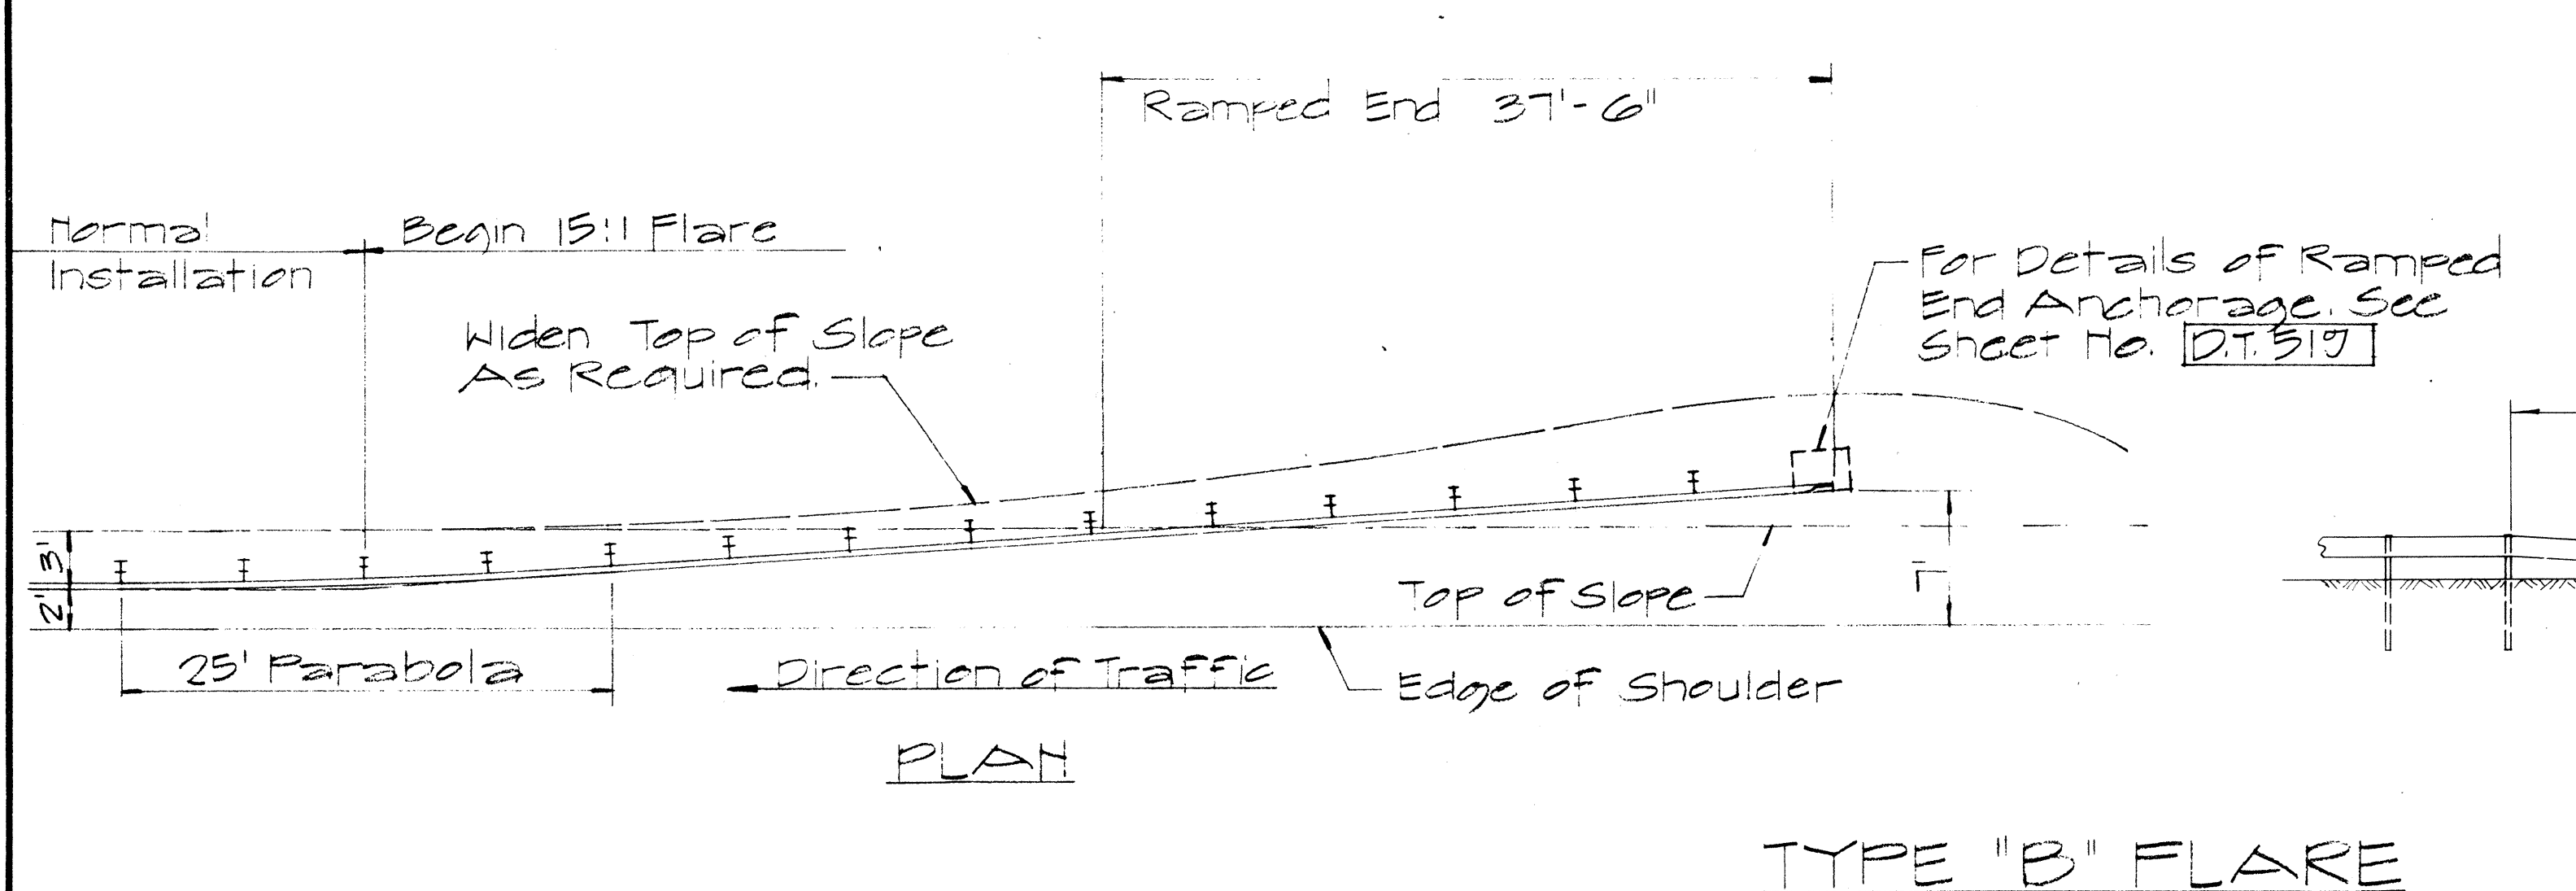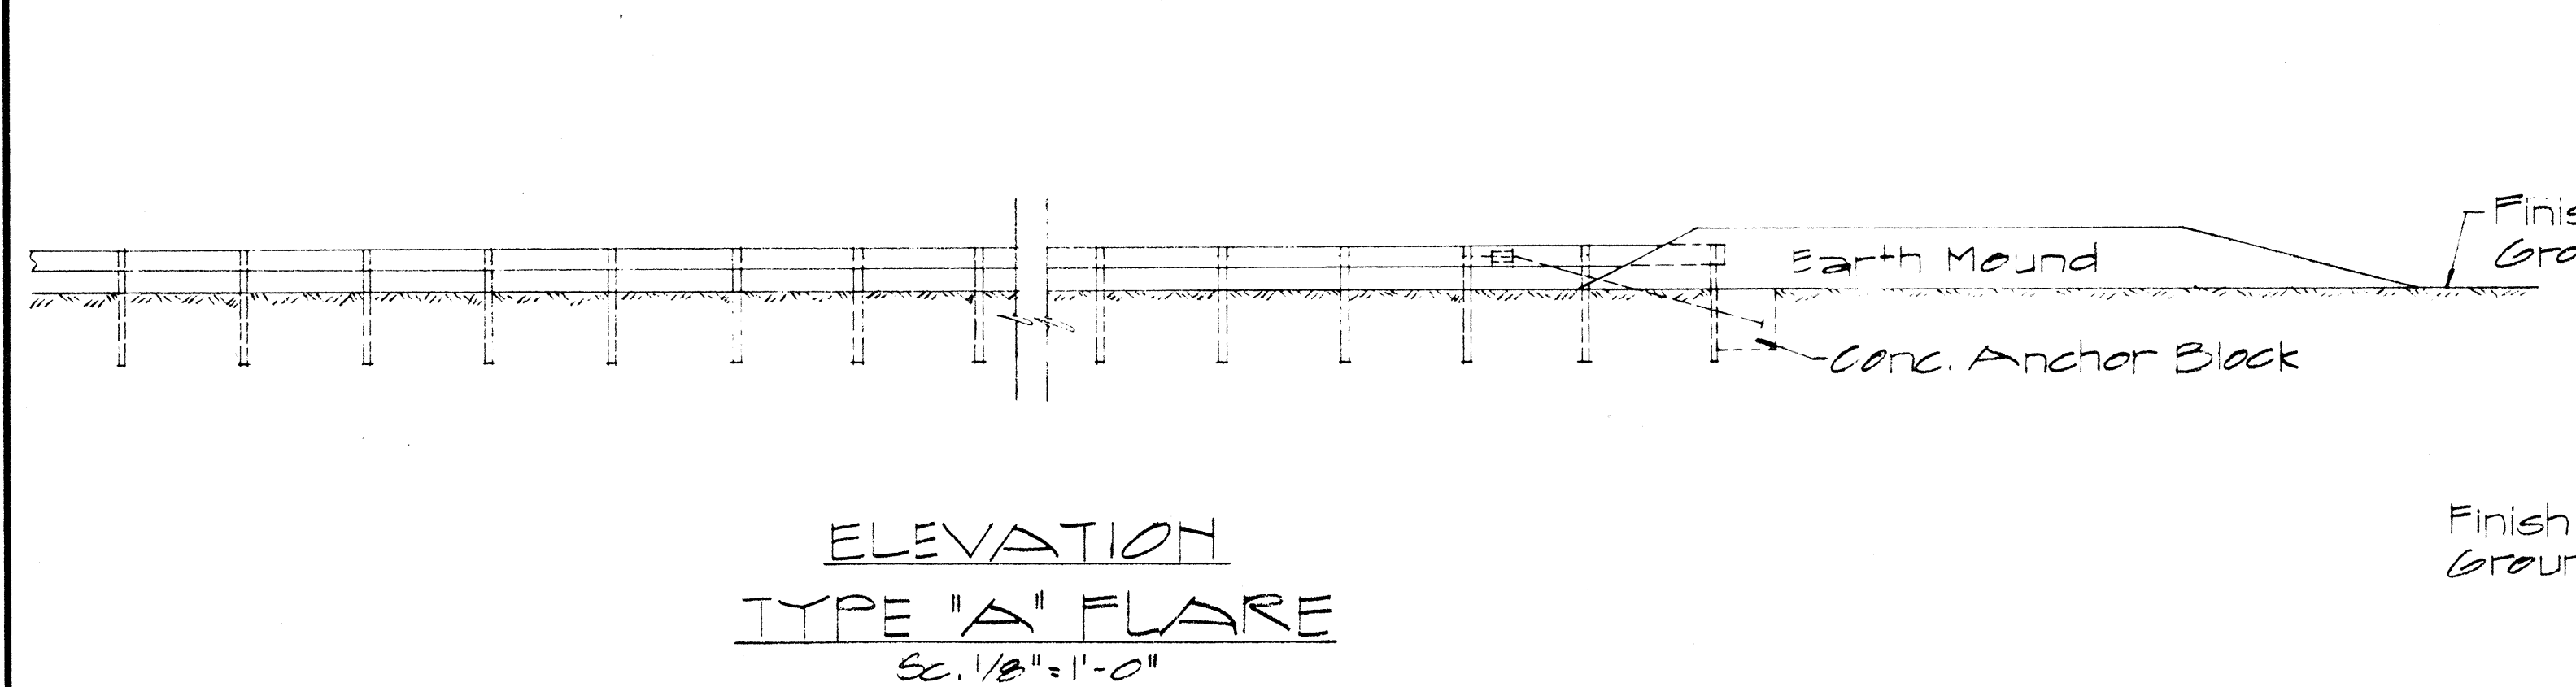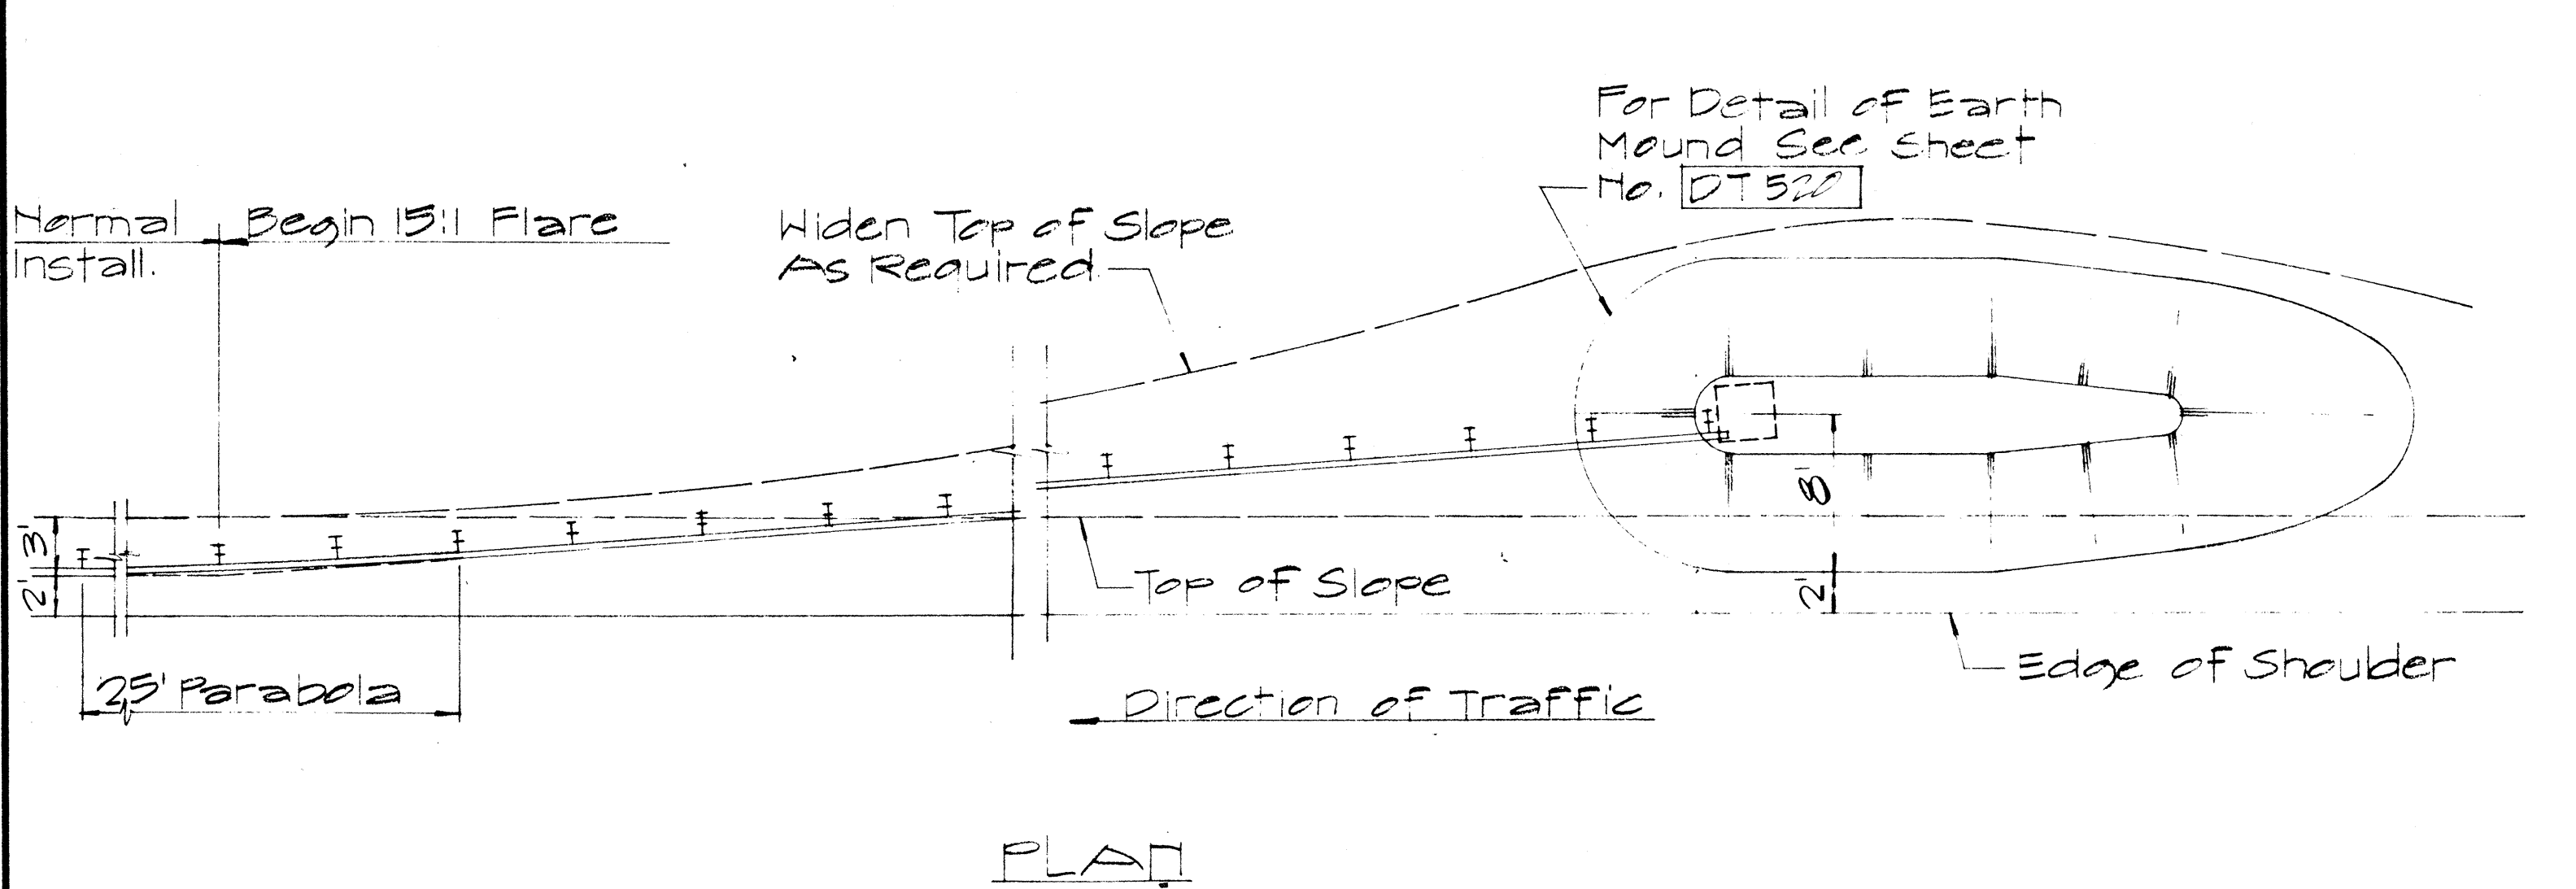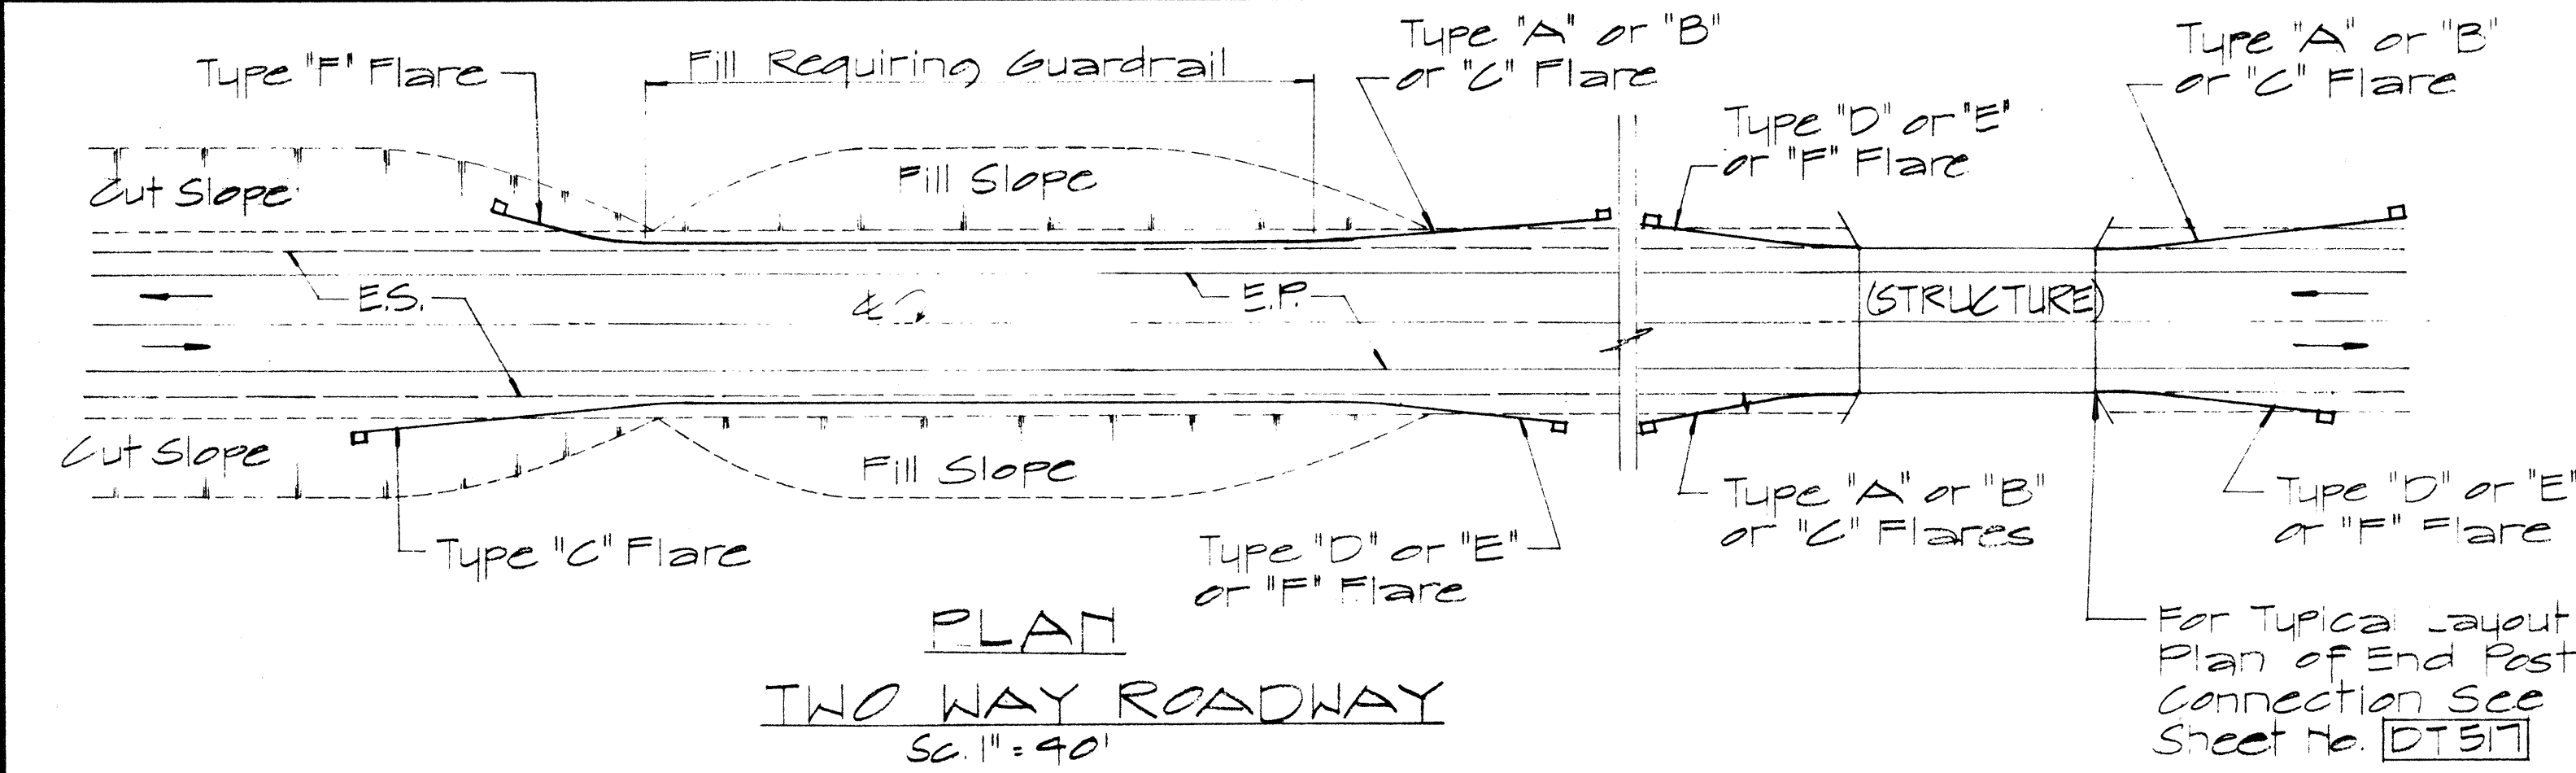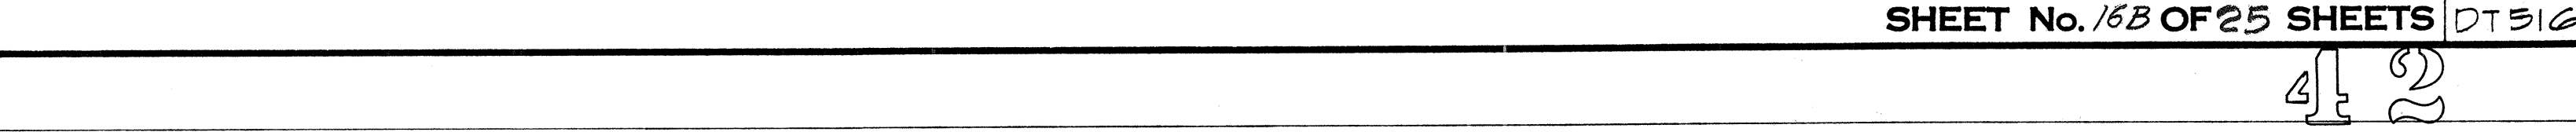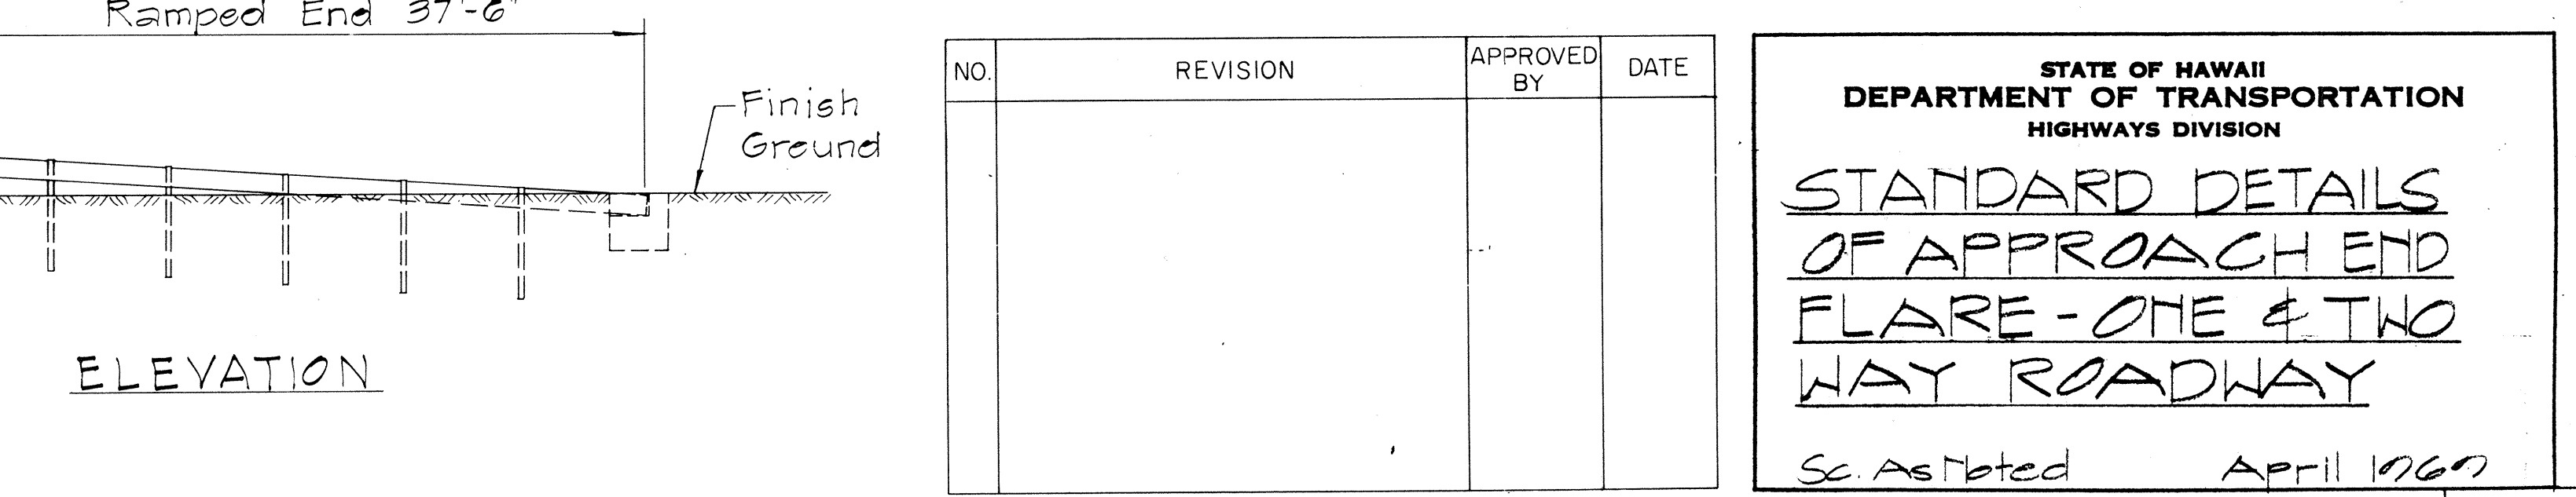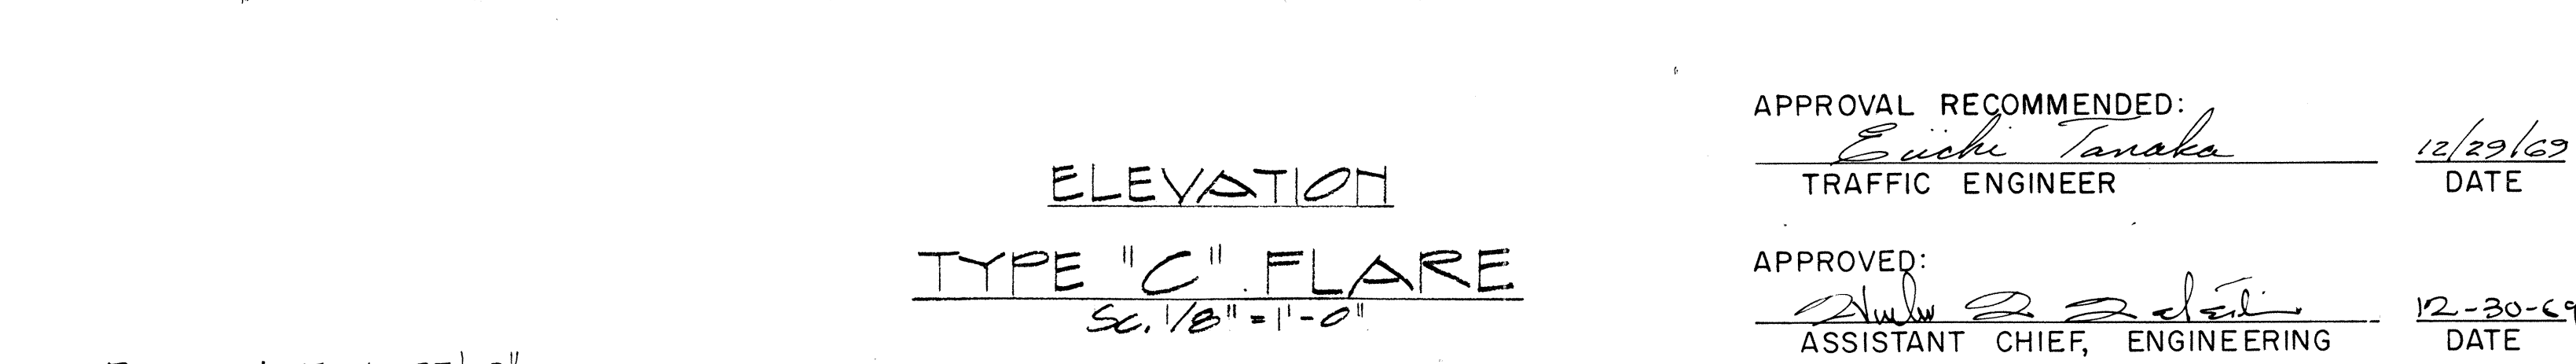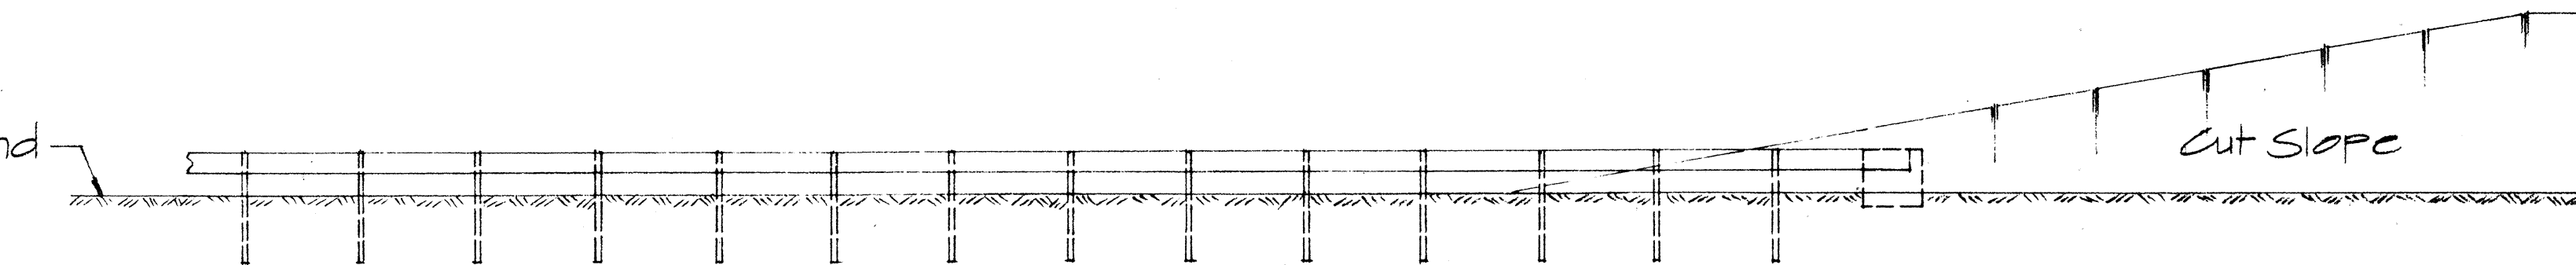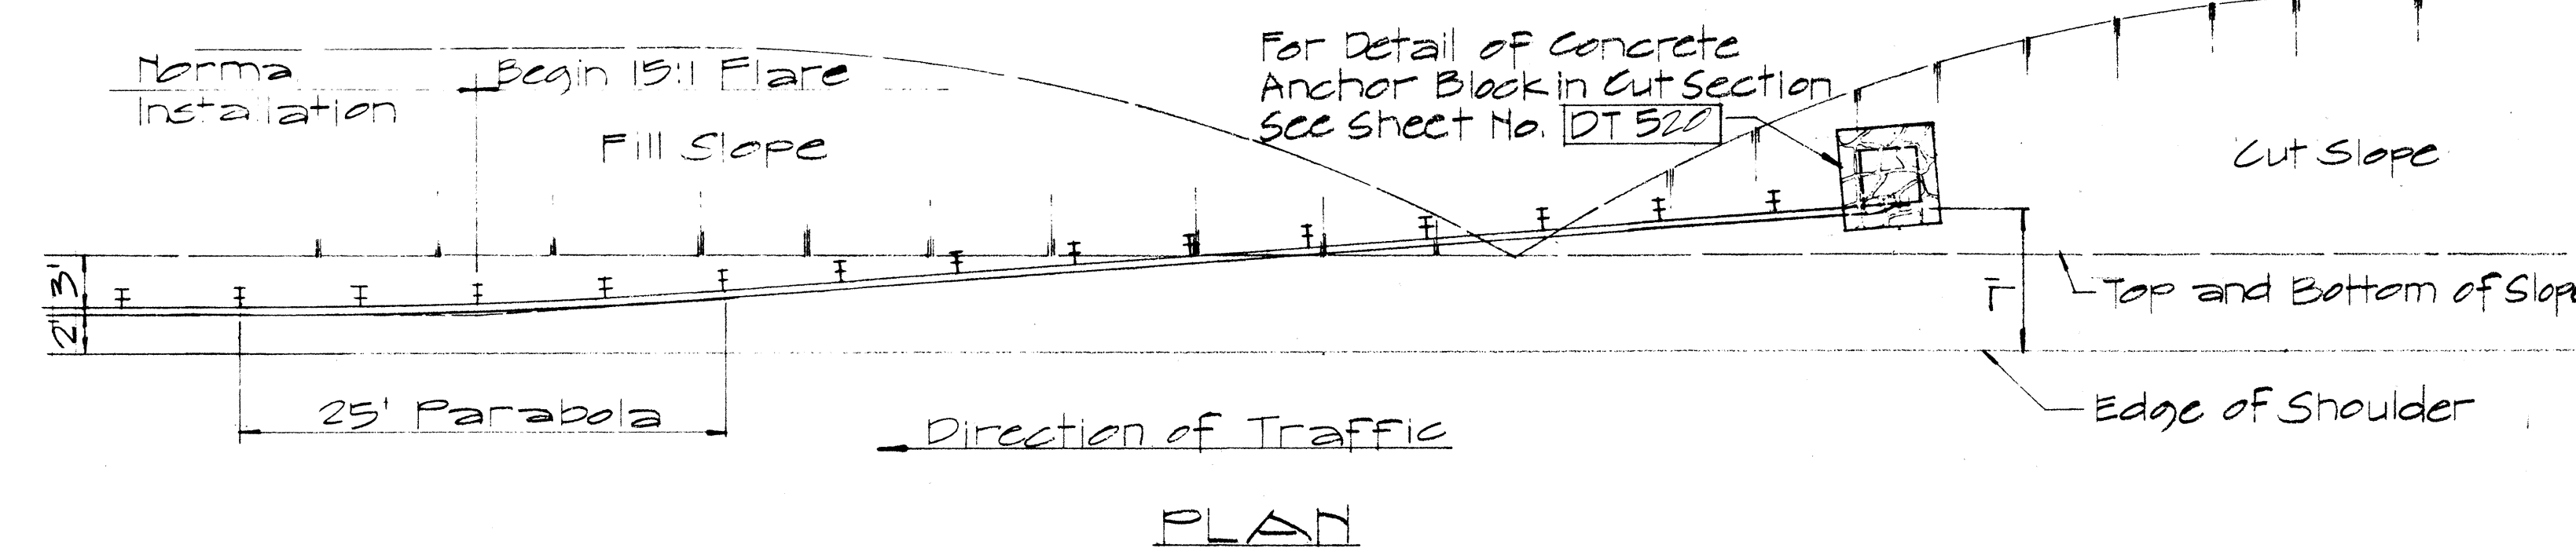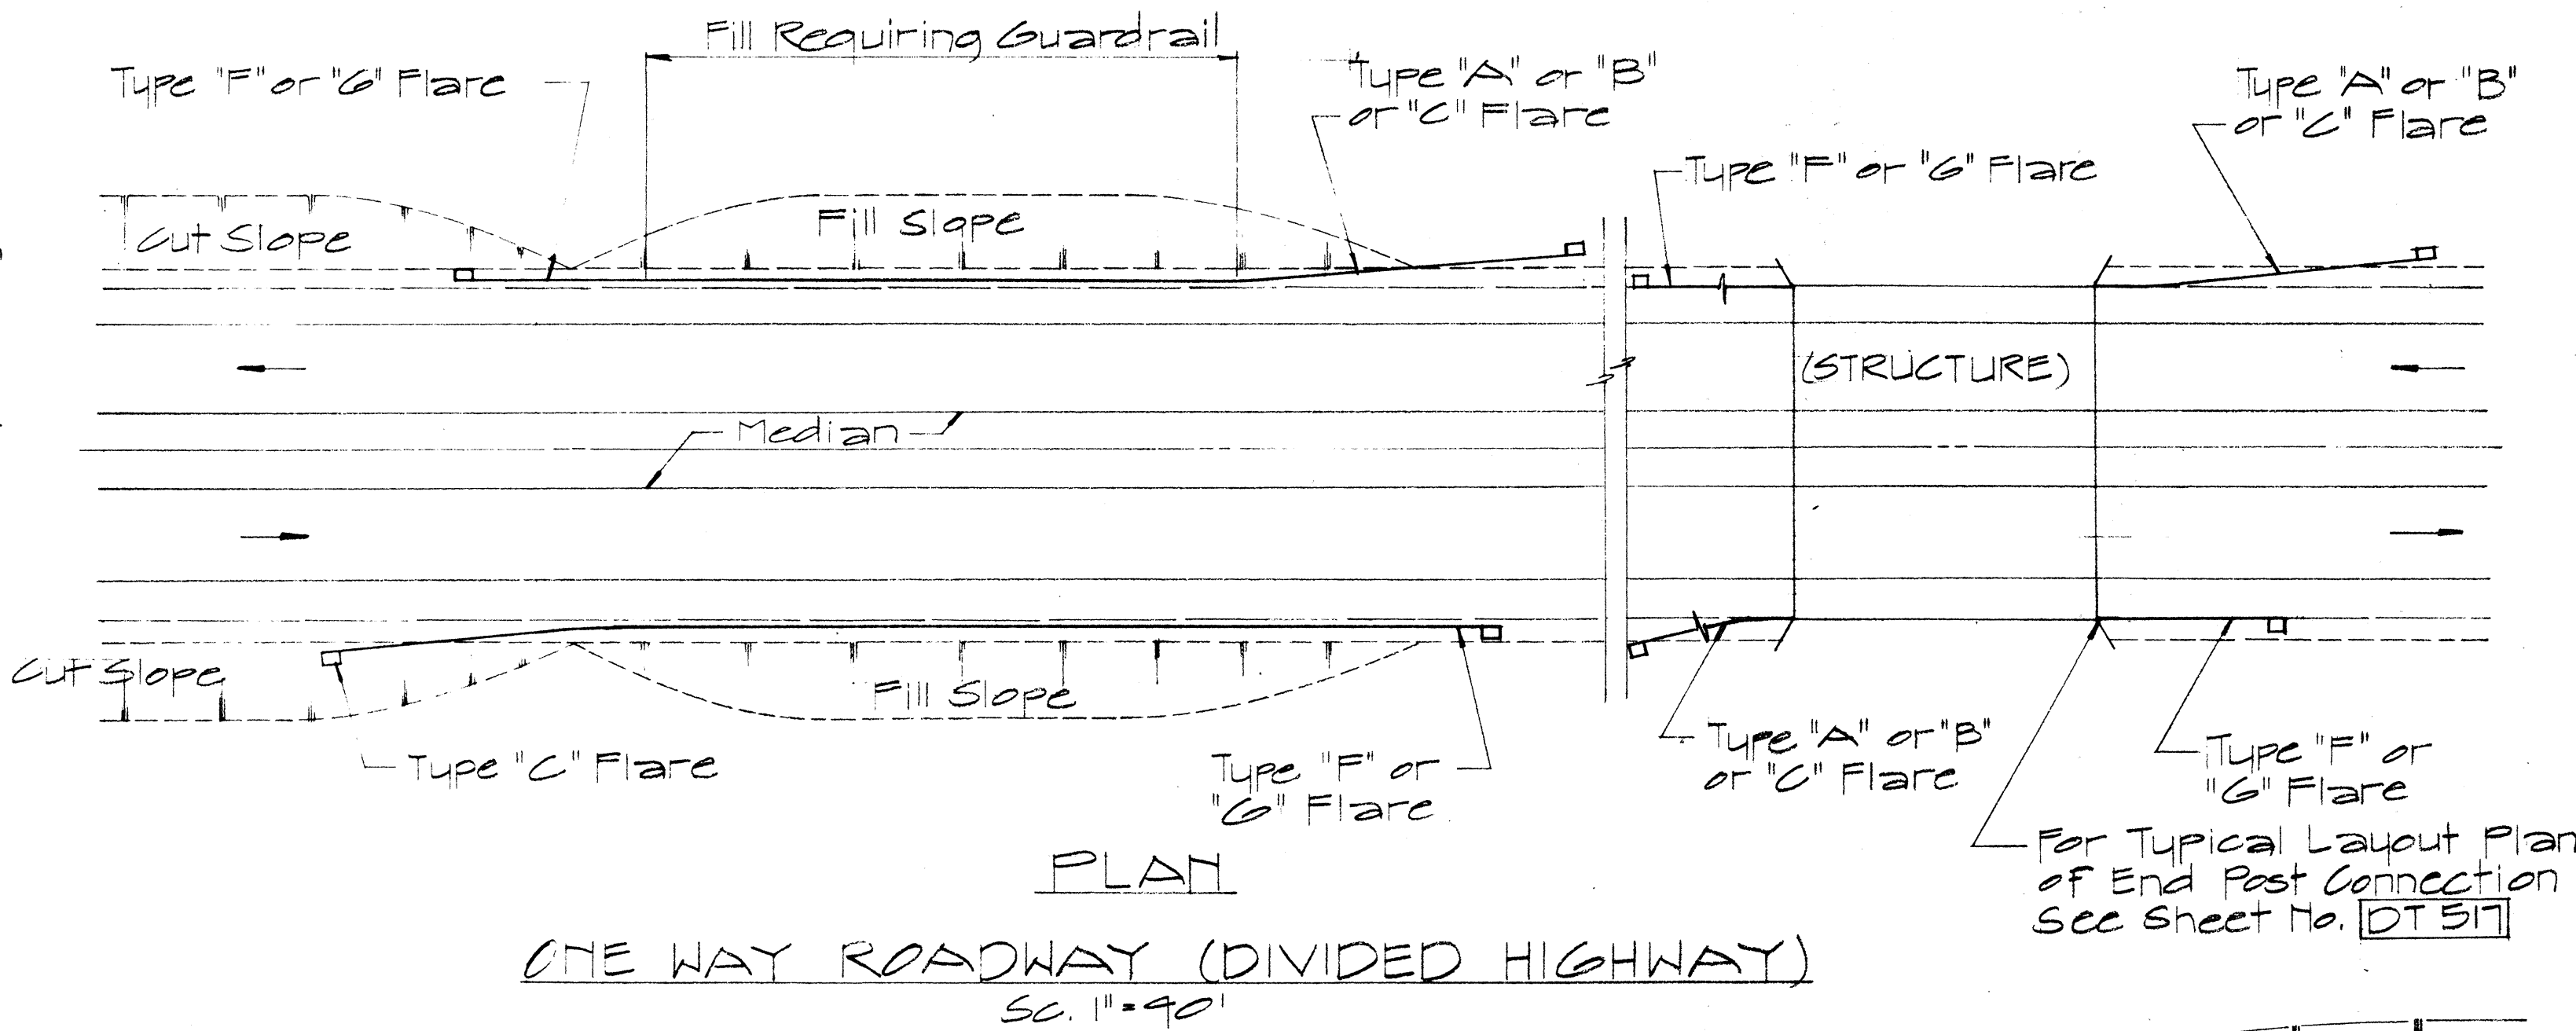

APPROVAL RECOMMENDED:
TRAFFIC ENGINEER
DATE 12/29/69










APPROVED:
ASSISTANT CHIEF, ENGINEERING
DATE 12-30-69

NO.	REVISION	APPROVED BY	DATE

STATE OF HAWAII
DEPARTMENT OF TRANSPORTATION
HIGHWAYS DIVISION
STANDARD DETAILS
OF APPROACH END
FLARE - ONE & TWO
WAY ROADWAY
SC. AS NOTED
APRIL 1969
SHEET No. 168 OF 25 SHEETS DT 516

DATE
SURVEY PLATTED BY
DRAWN BY
CHECKED BY
ORIGINAL PLAN
NOTE BOOK
No.

FED. ROAD DIST. NO.	STATE	FED. AID PROJ. NO.	FISCAL YEAR	SHEET NO.	TOTAL SHEETS
HAWAII	HAW.	I-11-1(89)/13	1971	43	362

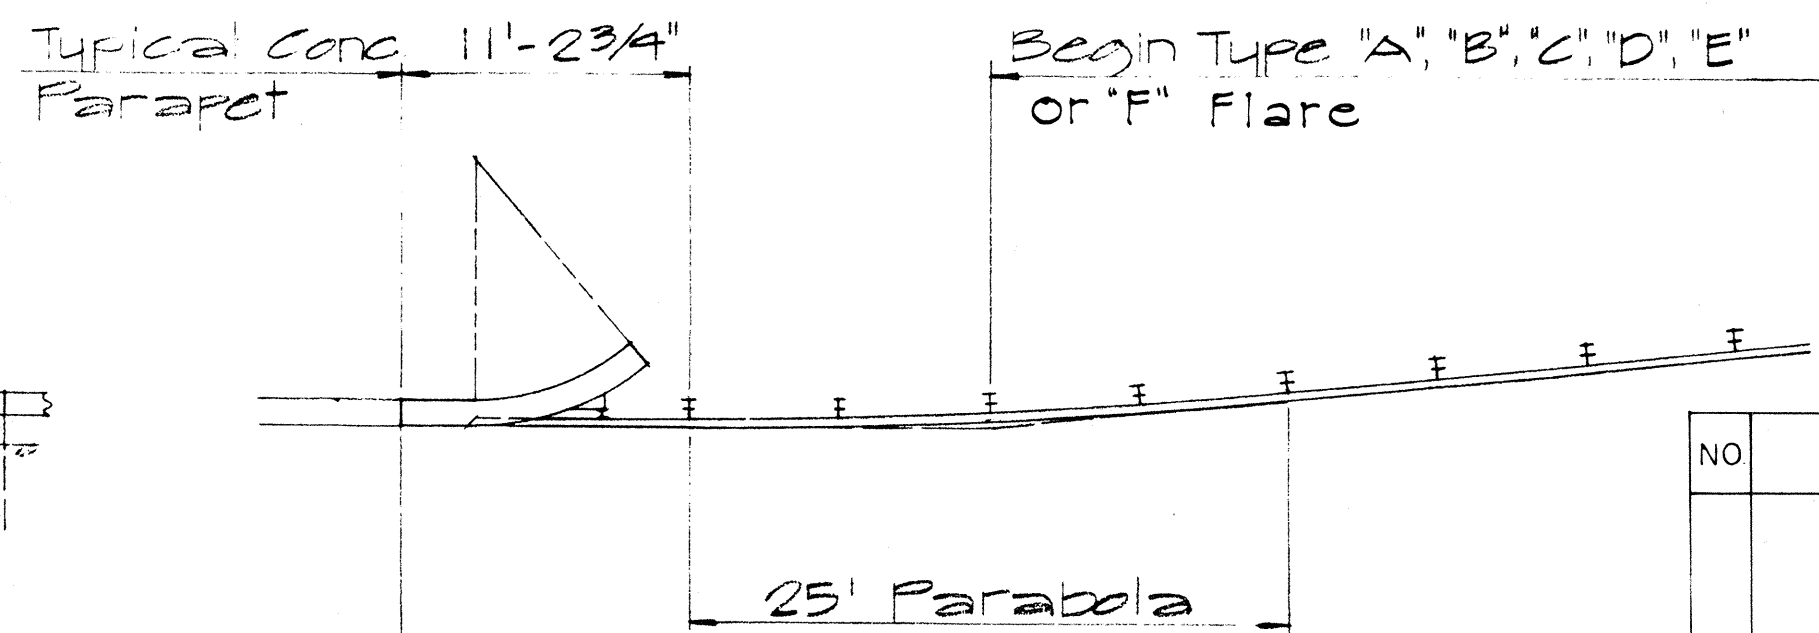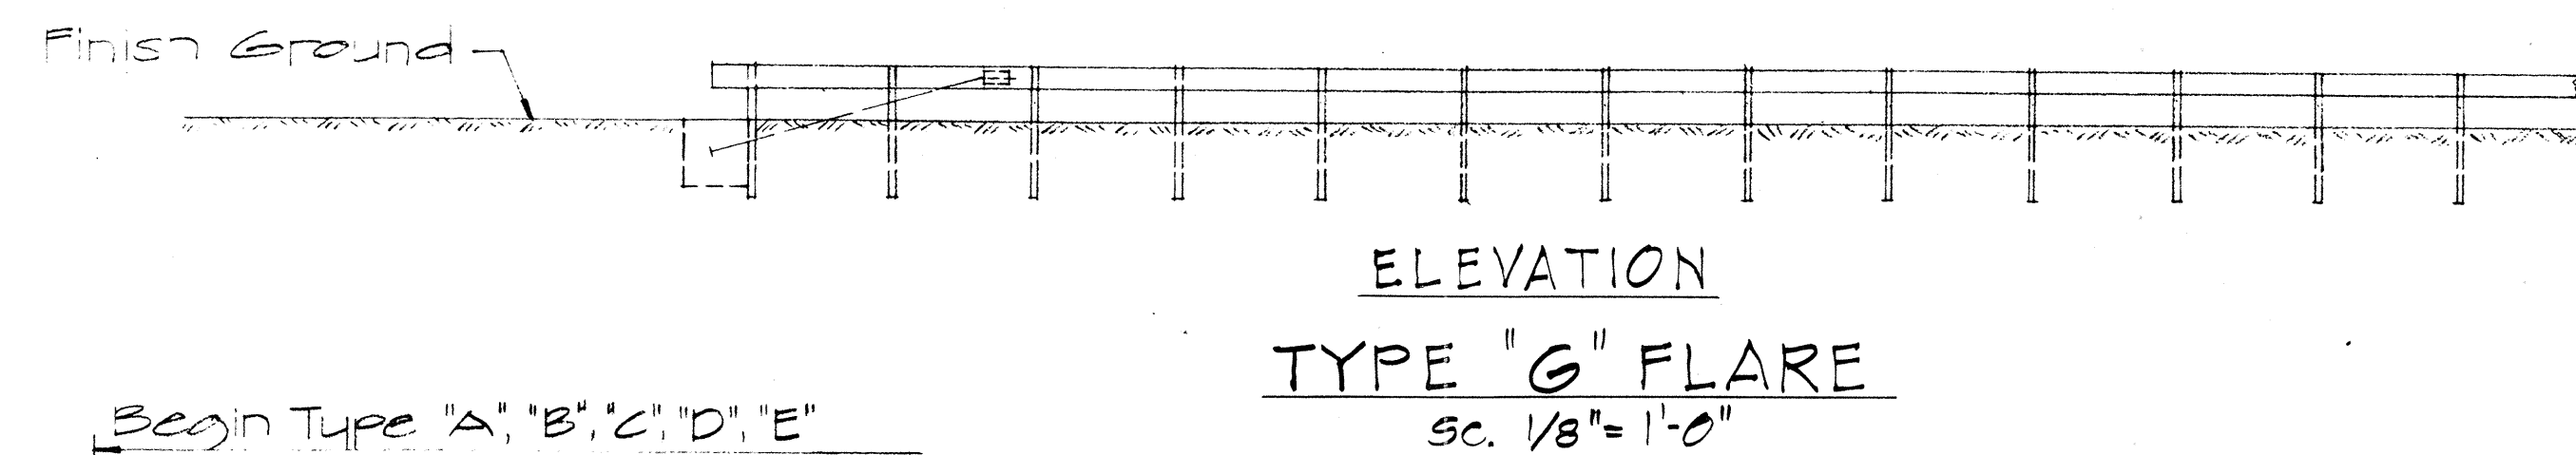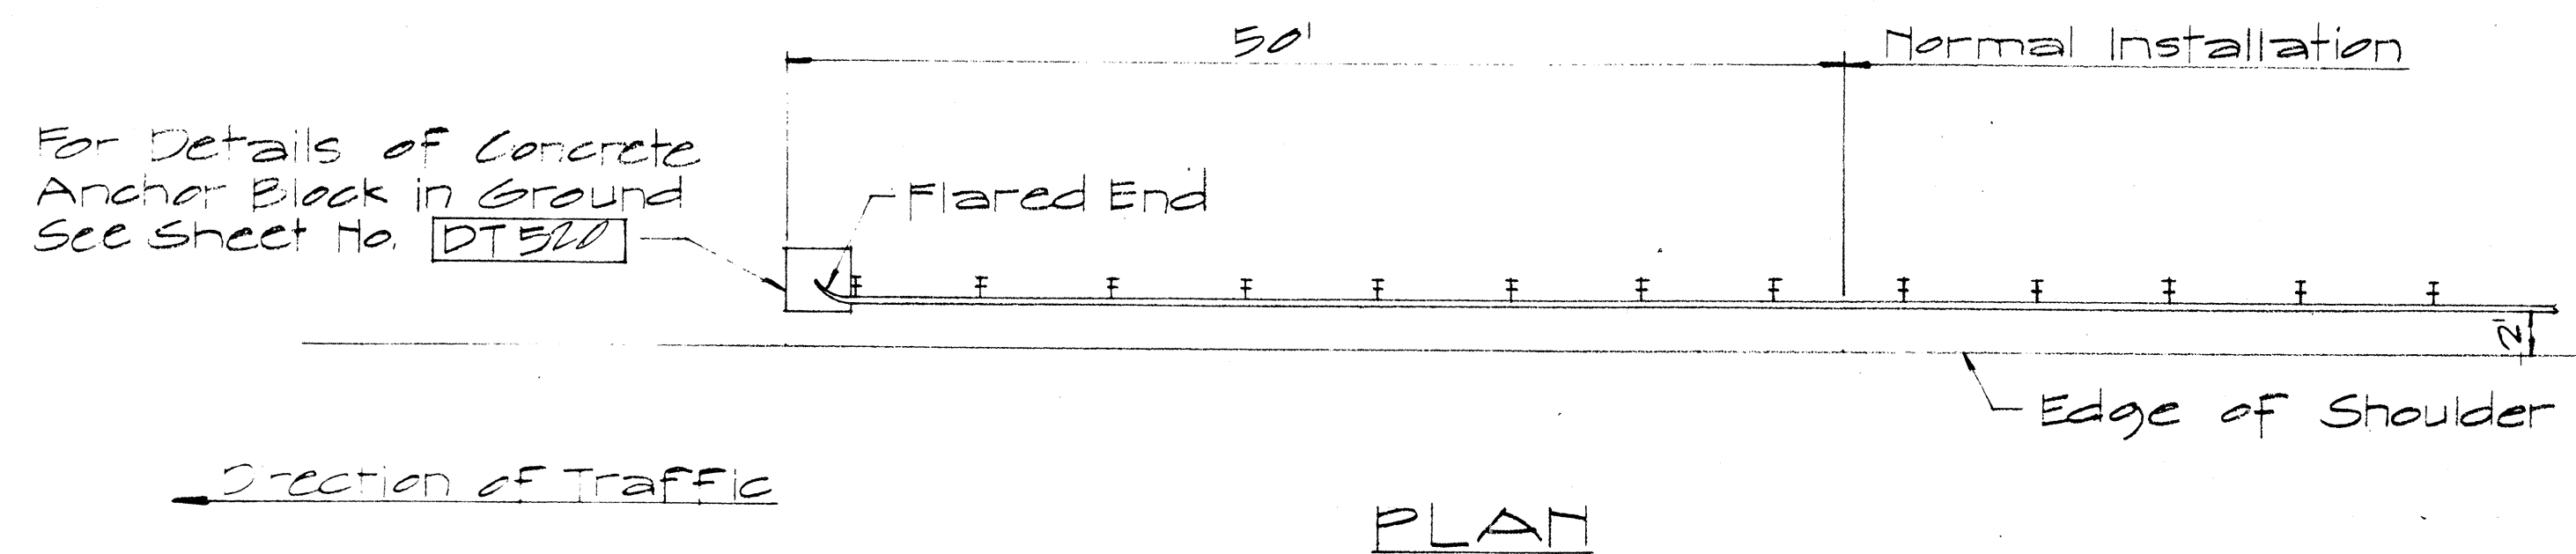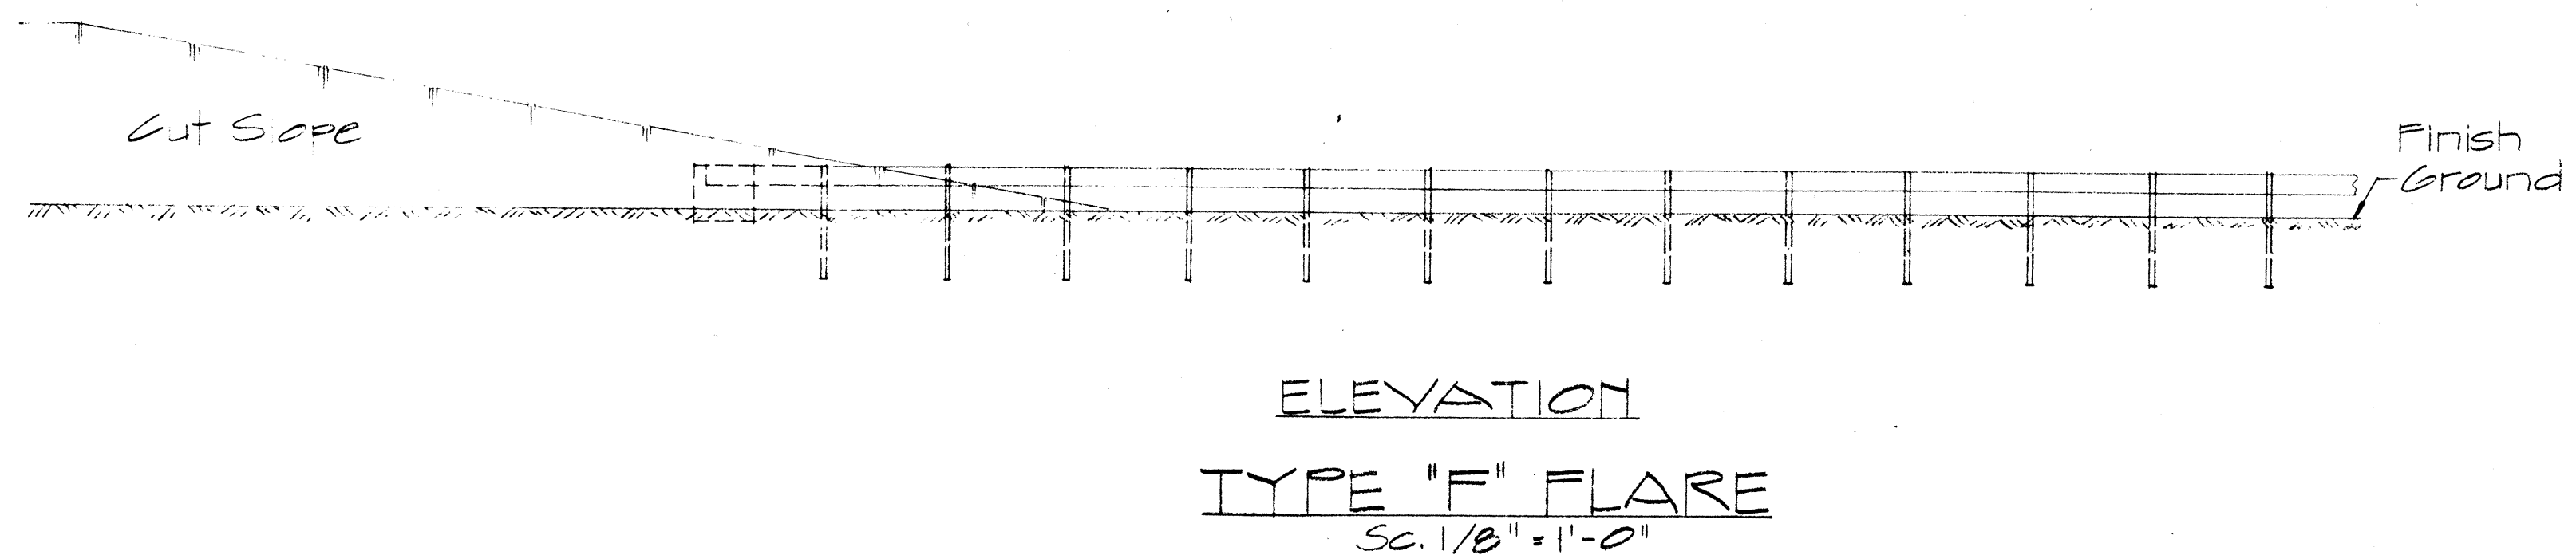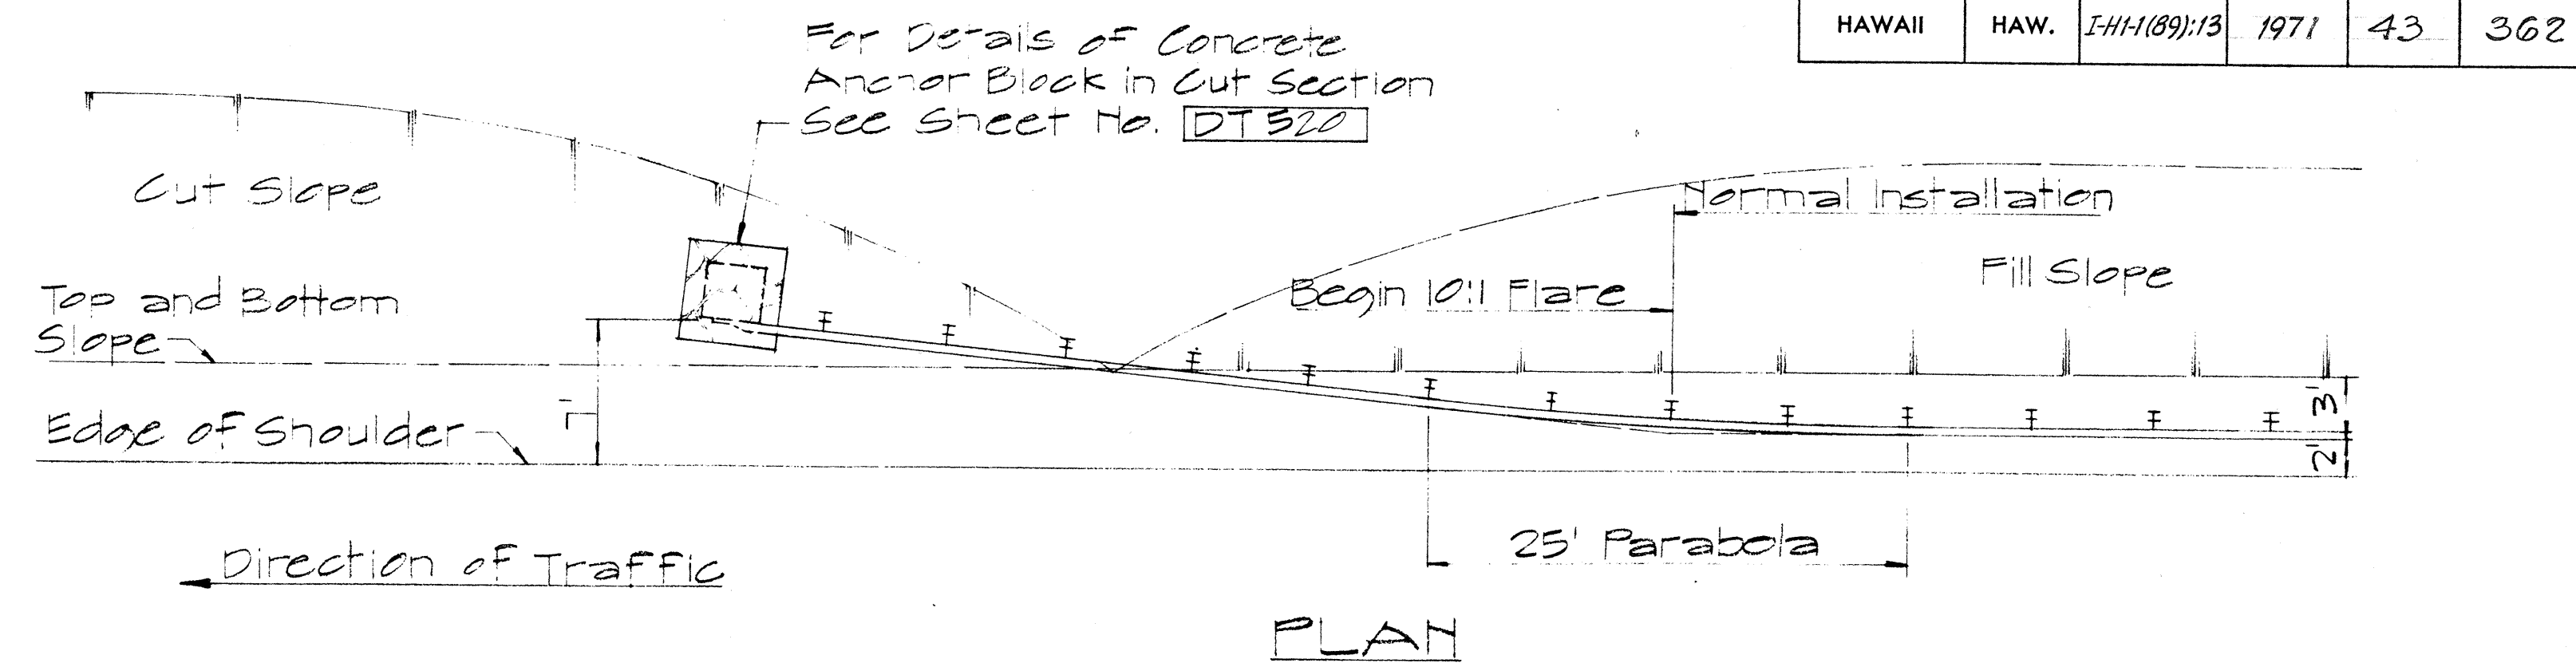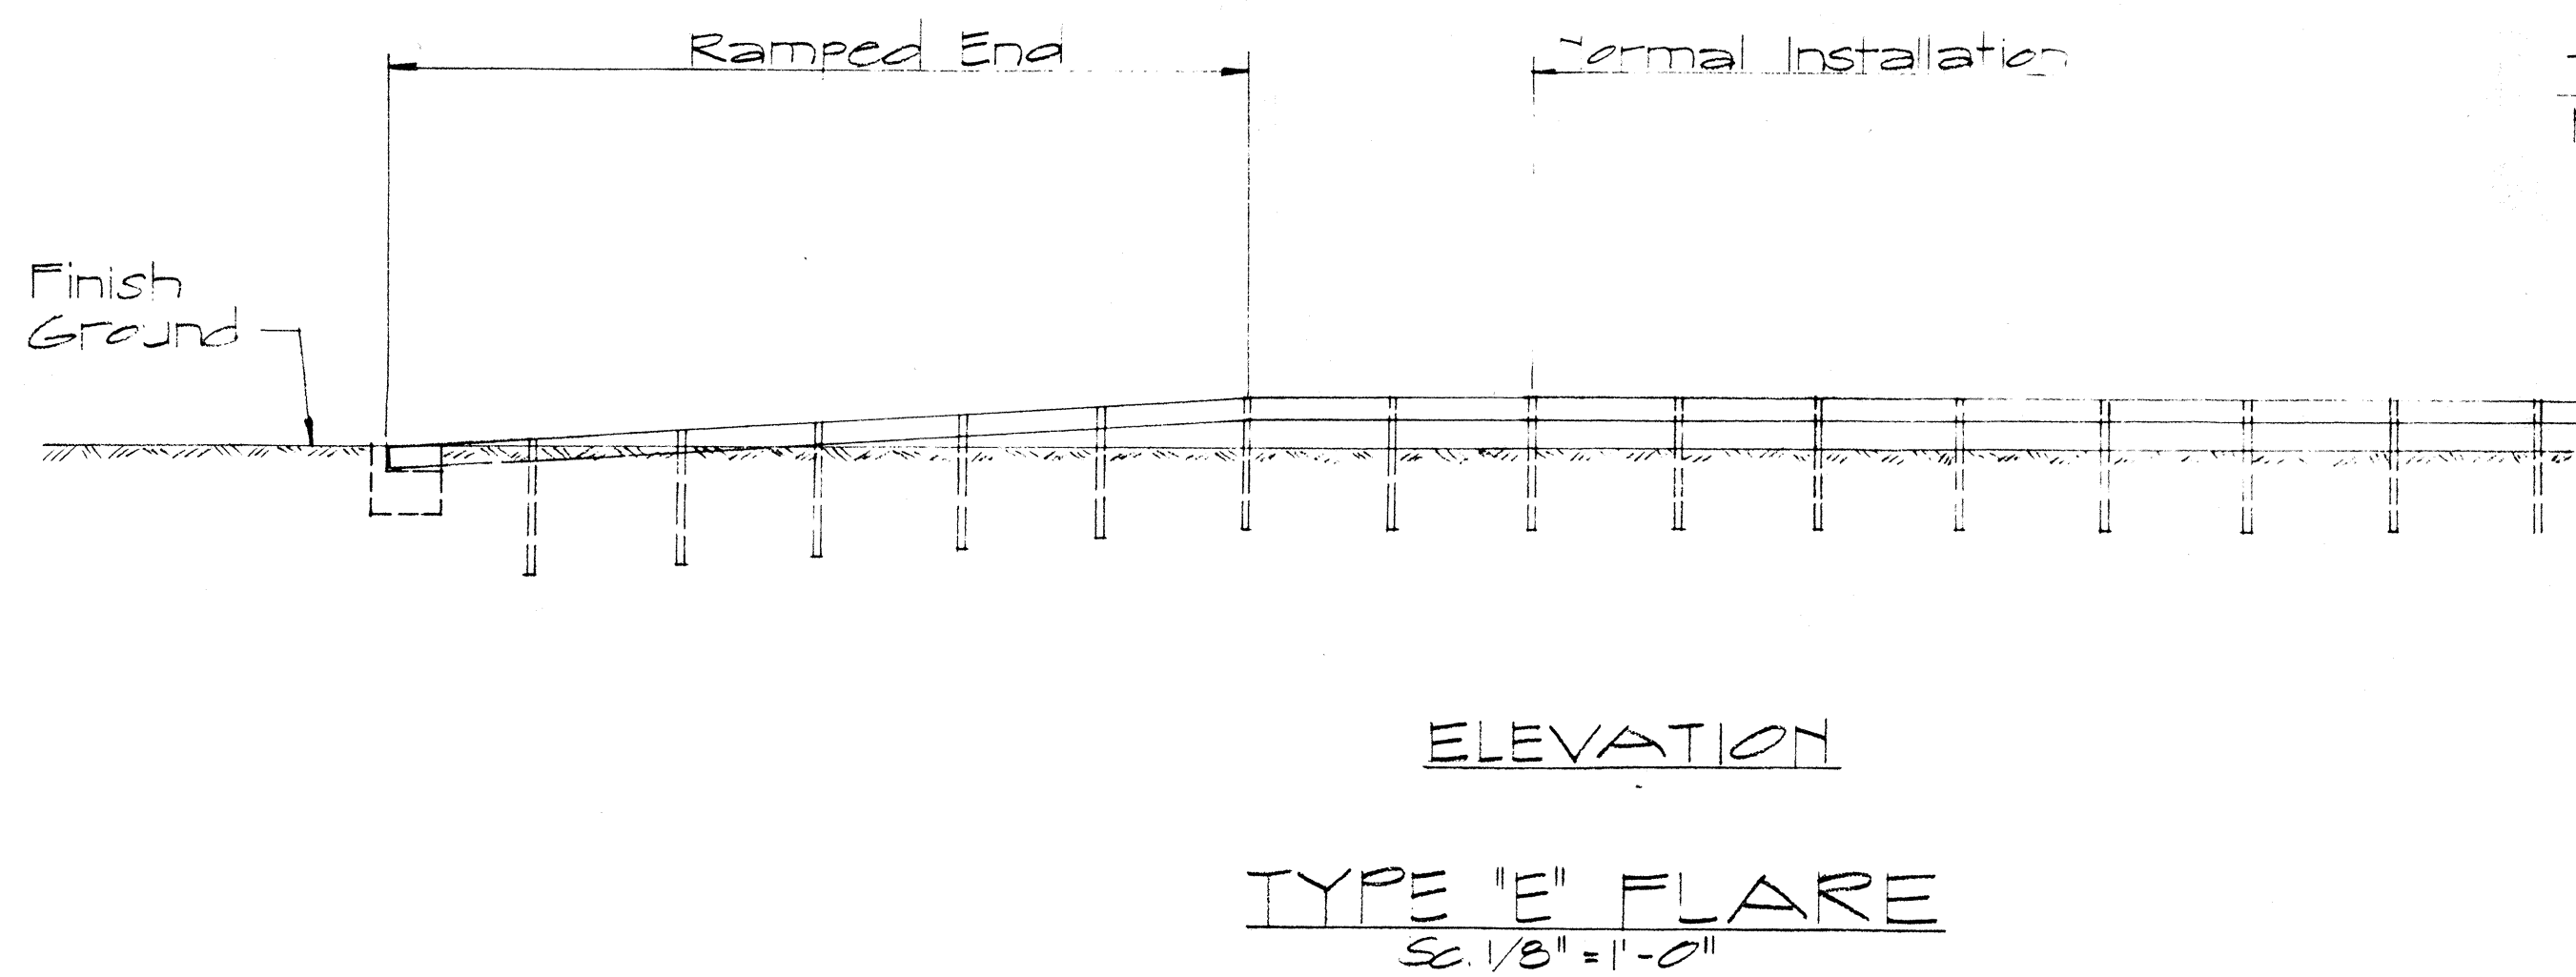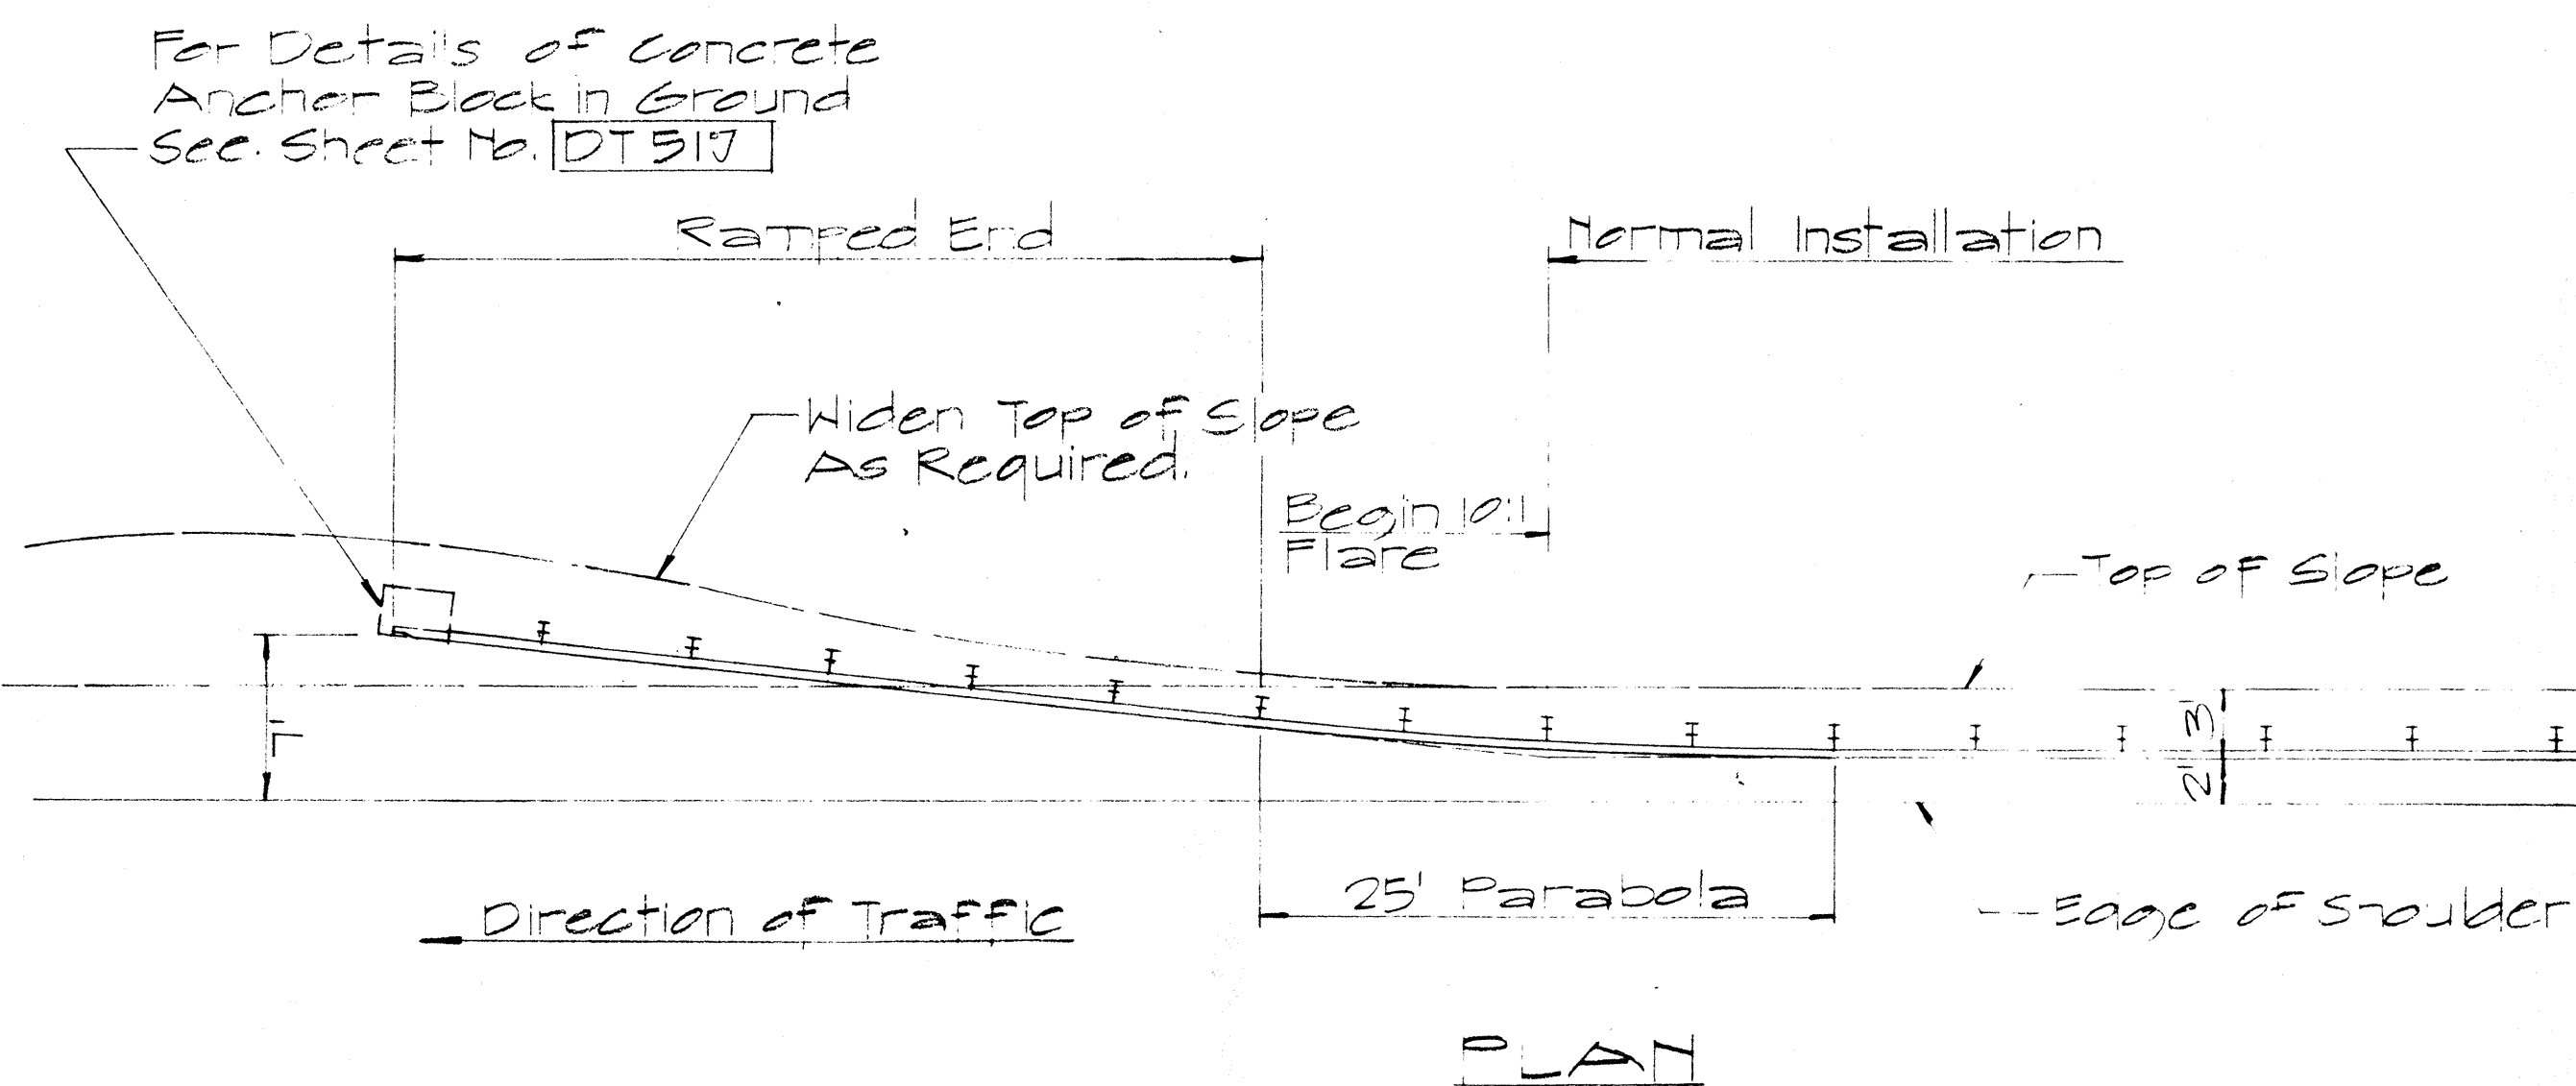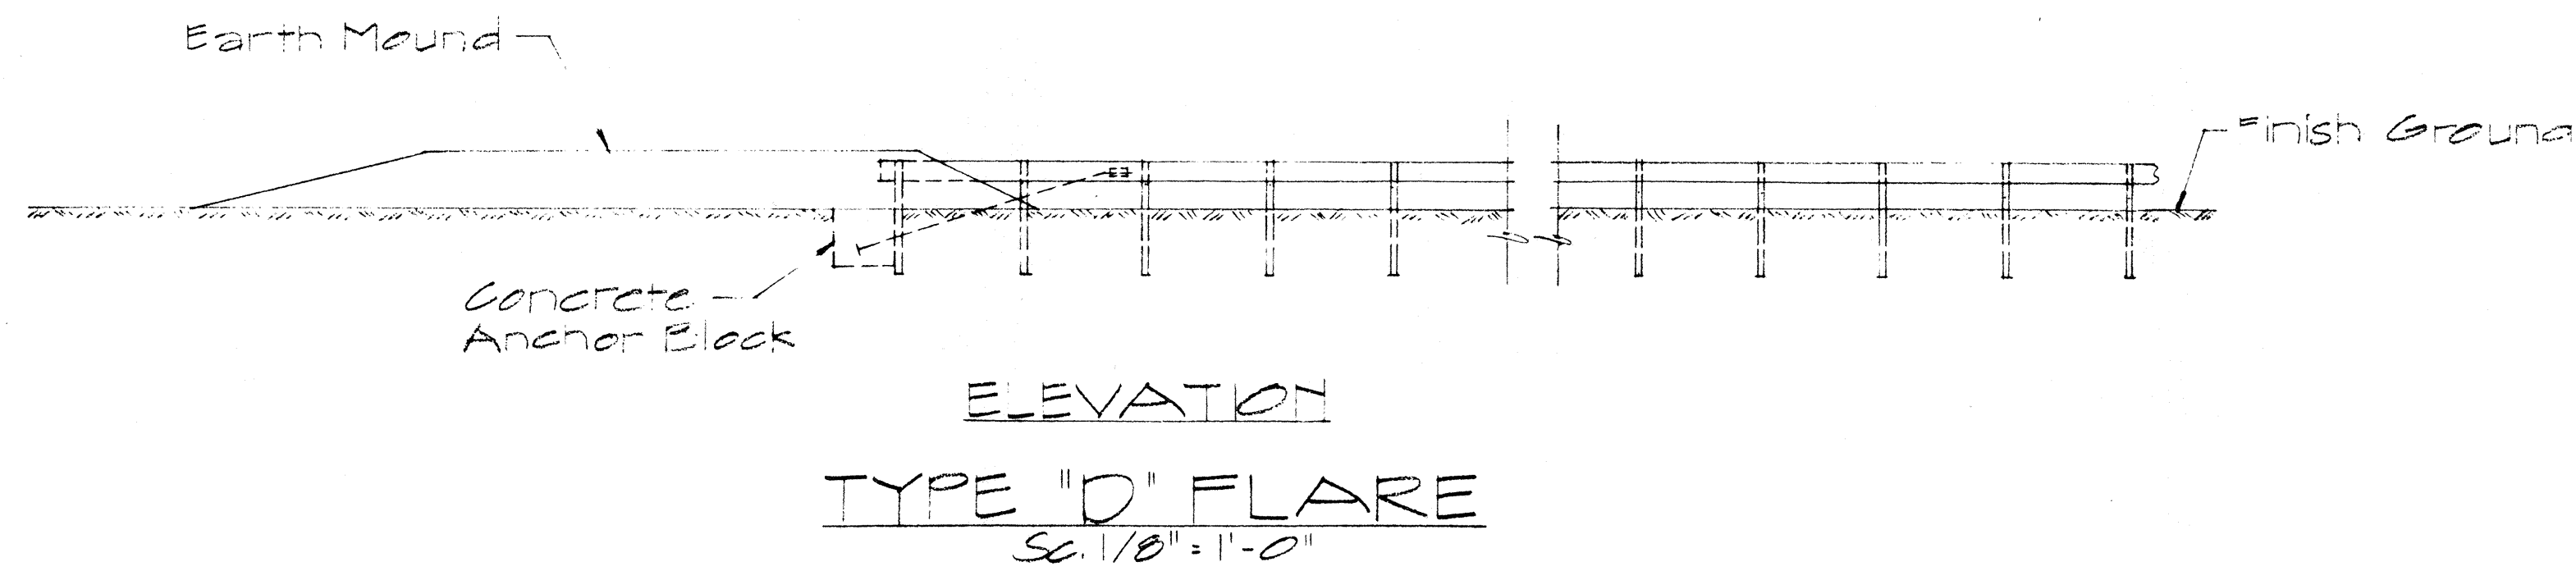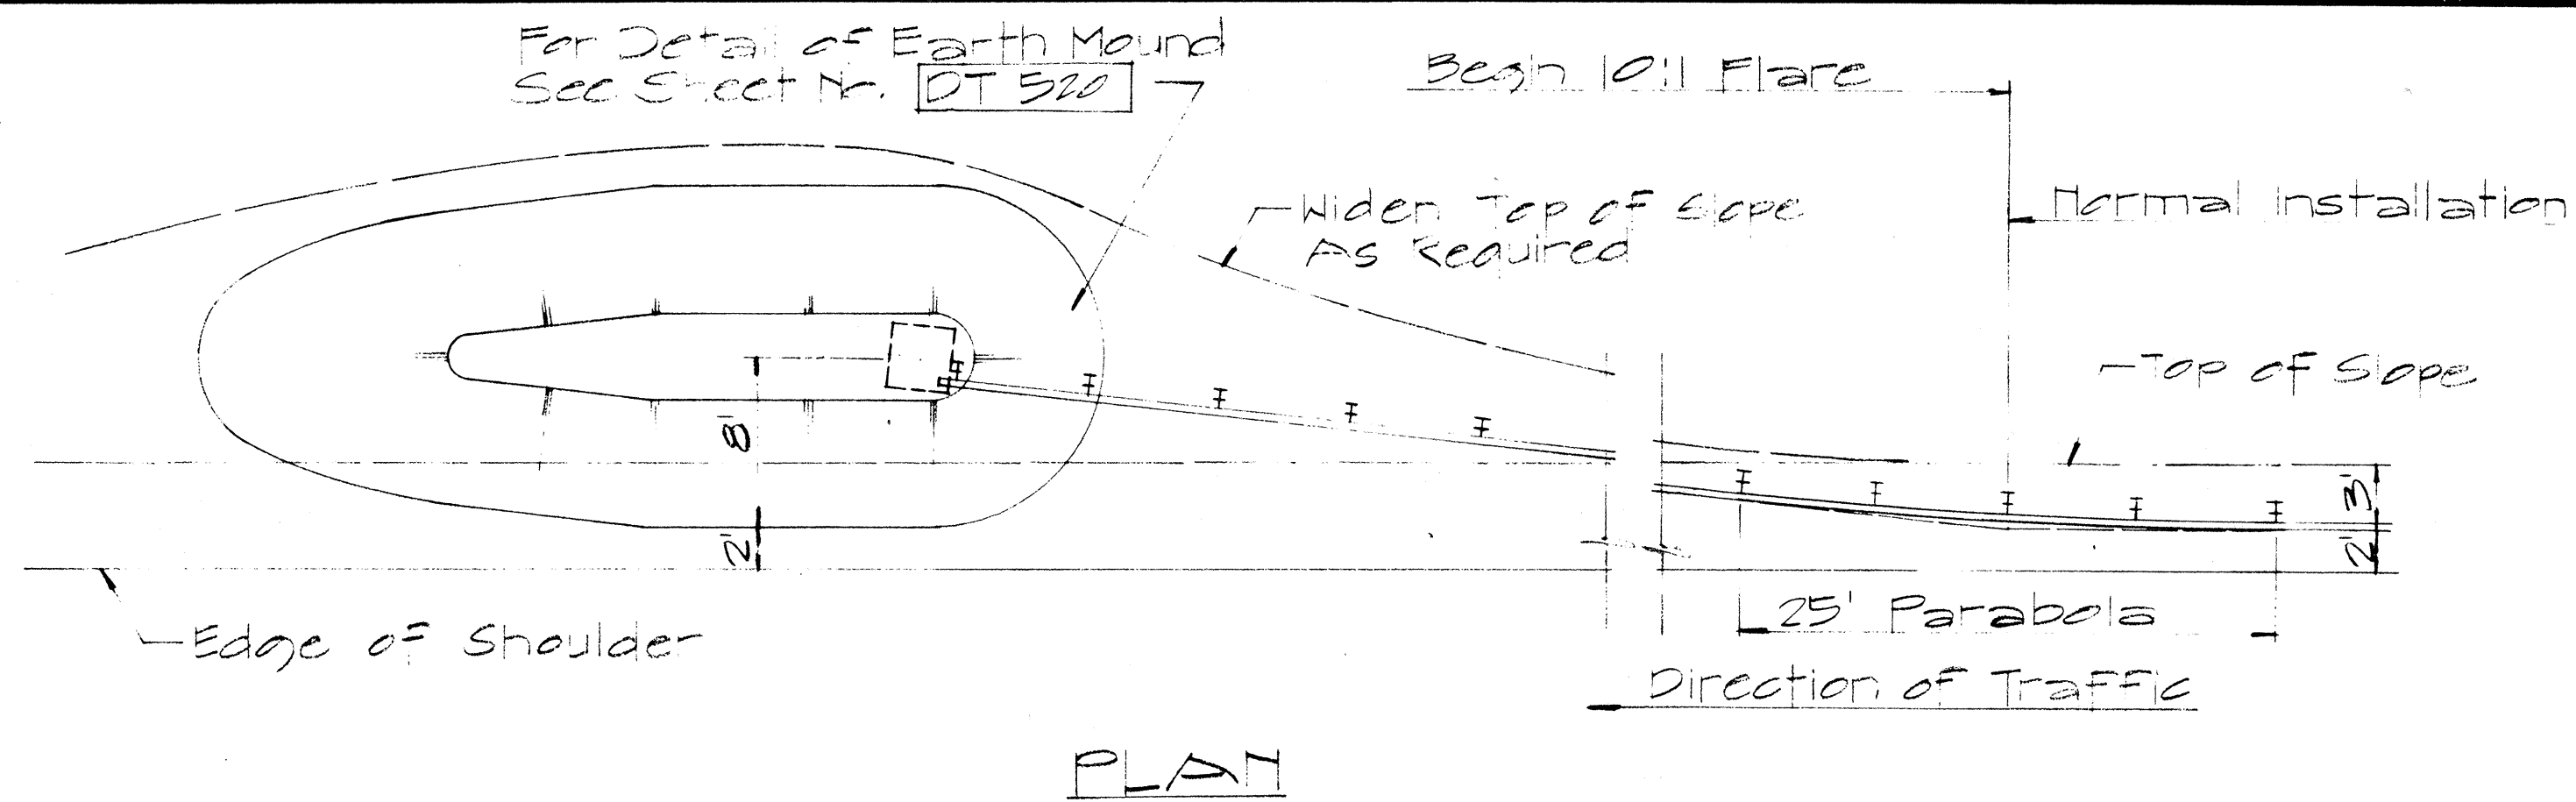

TYPICAL LAYOUT PLAN OF END POST CONNECTION

Sc. 1/8" = 1'-0"

APPROVAL RECOMMENDED:
Erich Tanaka 12/29/69
TRAFFIC ENGINEER DATE

APPROVED:
W. S. Kal 12-29-69
ASSISTANT CHIEF, ENGINEERING DATE

NO	REVISION	APPROVED BY	DATE

STATE OF HAWAII
DEPARTMENT OF TRANSPORTATION
HIGHWAYS DIVISION


STANDARD DETAILS
OF TRAILING END
FLARE - ONE & TWO
WAY ROADWAY

Sc. As Noted APRIL 1969


SHEET No. 78 OF 25 SHEETS DT 517

SURVEY PLOTTED BY	DATE
DESIGNED BY	
TRACED BY	
NOTED BY	
CHECKED BY	
ORIGINAL PLAN	
NOTE BOOK	
NO.	


Hand-drawn plan view of a guard rail assembly. The diagram shows a series of vertical posts connected by a top rail and a bottom rail. The top rail has eight "POST BOLT HOLE" locations marked with arrows. The spacing between these holes is labeled as "6'-3\"". The bottom rail is supported by "GUARD RAIL POST" and "SPACER BLOCK" components, which are labeled "BLK AT 8.5\"". The overall length of the assembly is indicated as "6'-3\"". Dimensions for the post holes are given as "1'-0\""

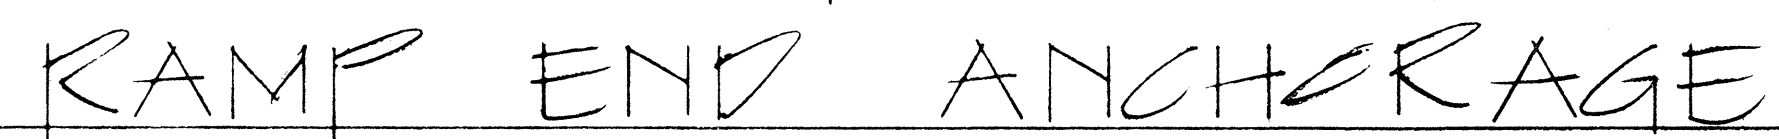

Hand-drawn plan view of a mechanical assembly. The drawing shows a rectangular base with a horizontal slot on the right side. Dimensions are given in feet and inches: a total height of 2'-0", a base thickness of 3 1/2", a slot width of 9", and a total width of 3'-0". Two vertical pins are shown in the center, with arrows pointing to them labeled 'A'. An arrow points to the slot labeled 'SLOT FOR GUARD RAIL'. The word 'PLAN' is written at the bottom.

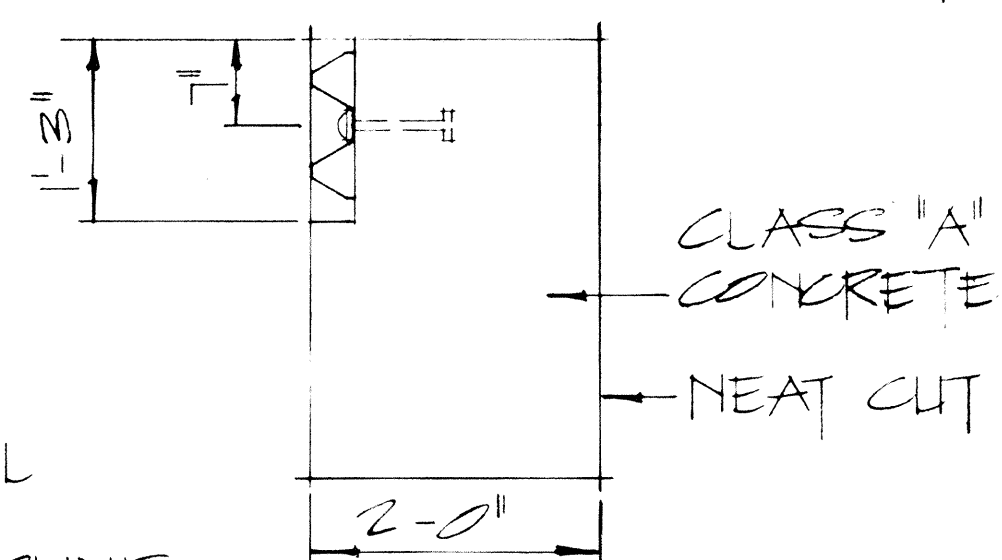

TOP OF ANCHOR BLOCK
TO BE FLUSH
W/ GROUND.

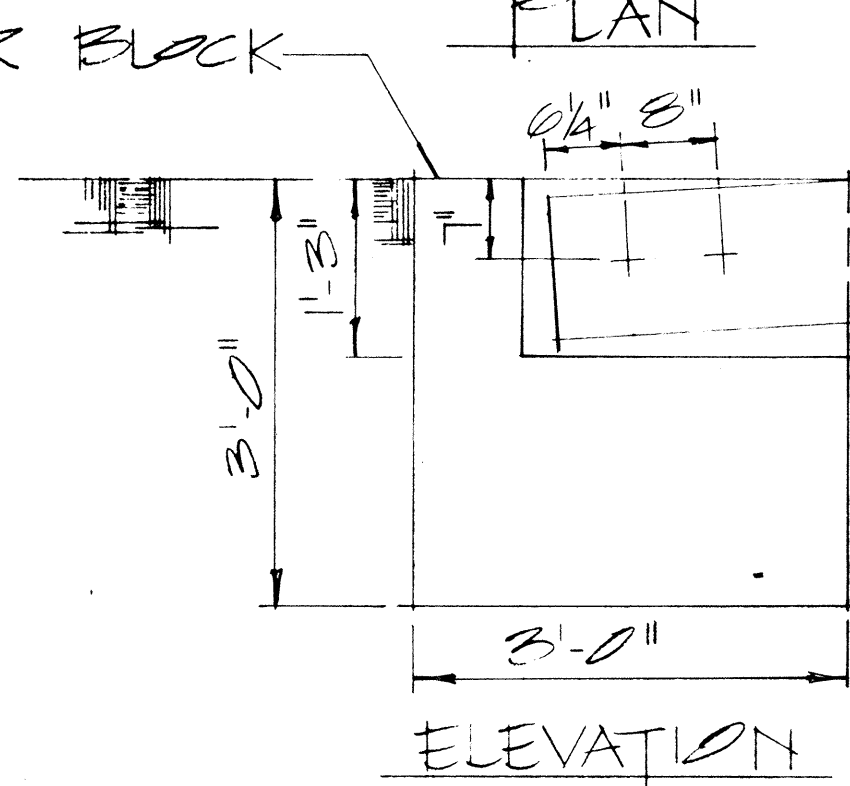

GROUND
- LINE

SECTION "A-A"

NOTE:
CONCRETE, EXCAVATION AND
MISCELLANEOUS APPURTENANCES
NECESSARY TO ANCHOR THE GUARD
RAIL ENDS, SHALL BE INCIDENTAL
TO THE METAL GUARD RAIL.

CONCRETE ANCHOR BLOCK

APPROVAL RECOMMENDED:
Eischi Tanaka
TRAFFIC ENGINEER

12/29/69
DATE

APPROVED: John J. J. J. 12-30-69
ASSISTANT CHIEF, ENGINEERING DATE

STATE OF HAWAII
DEPARTMENT OF TRANSPORTATION
HIGHWAYS DIVISION






STANDARD DETAILS

GUARD RAIL, TYPE 3
RAMP END ANCHORAGE


SCALE: AS SHOWN DATE: OCT. 30, 1970

SHEET No. 188 OF 25 SHEETS DT519

FED. ROAD DIST. NO.	STATE	FED. AID PROJ. NO.	FISCAL YEAR	SHEET NO.	TOTAL SHEETS
HAWAII	HAW.	1-41-1(89)-13	1971	45	362

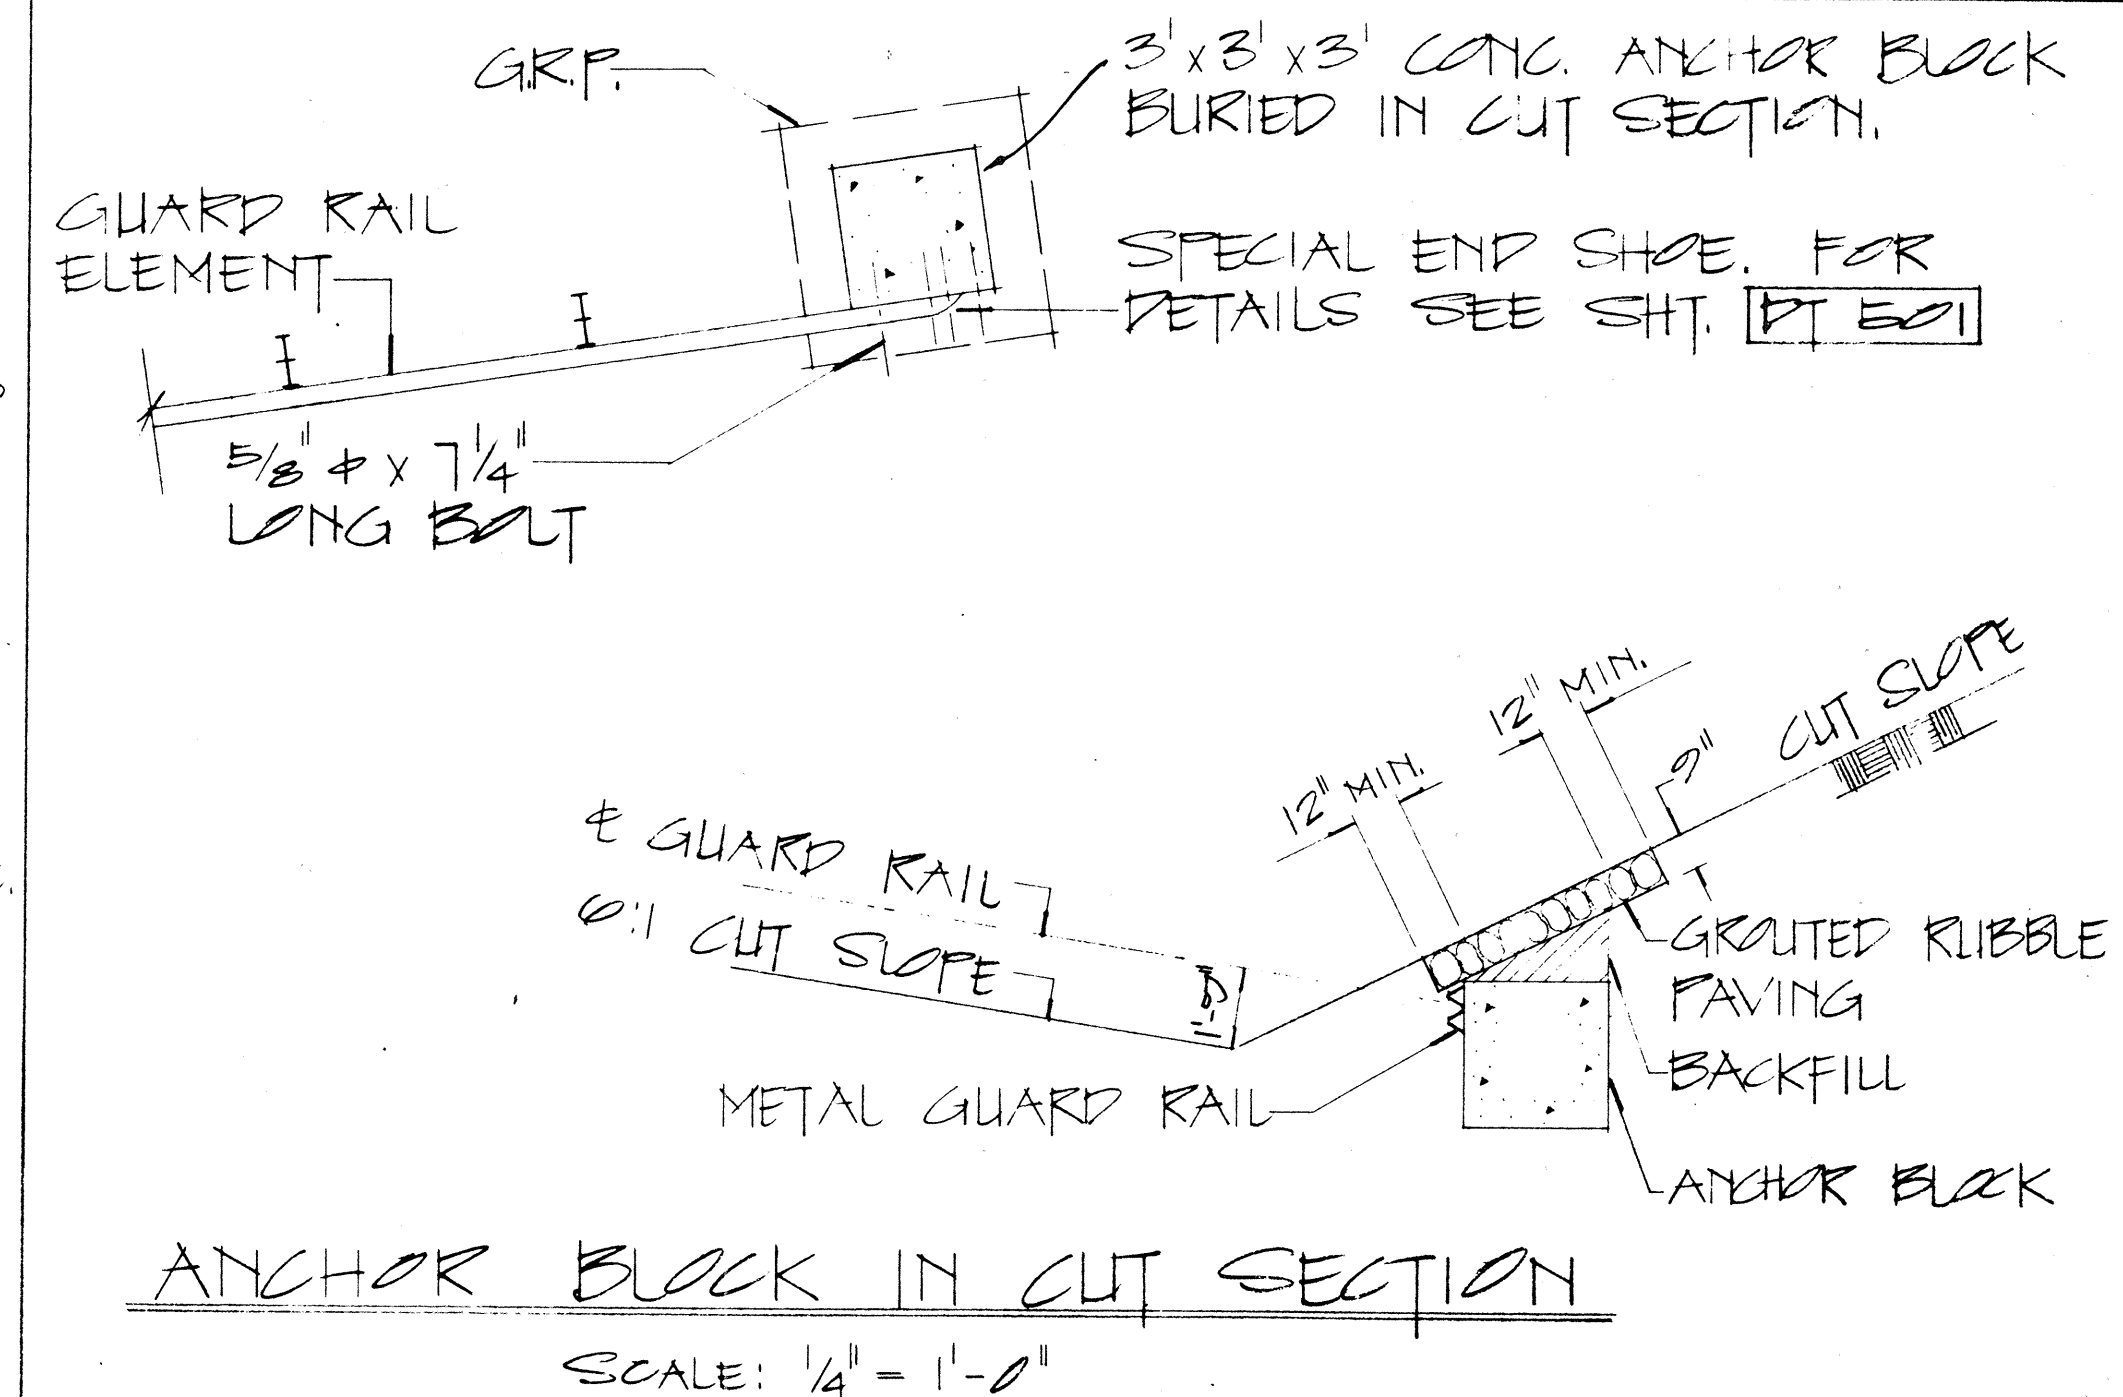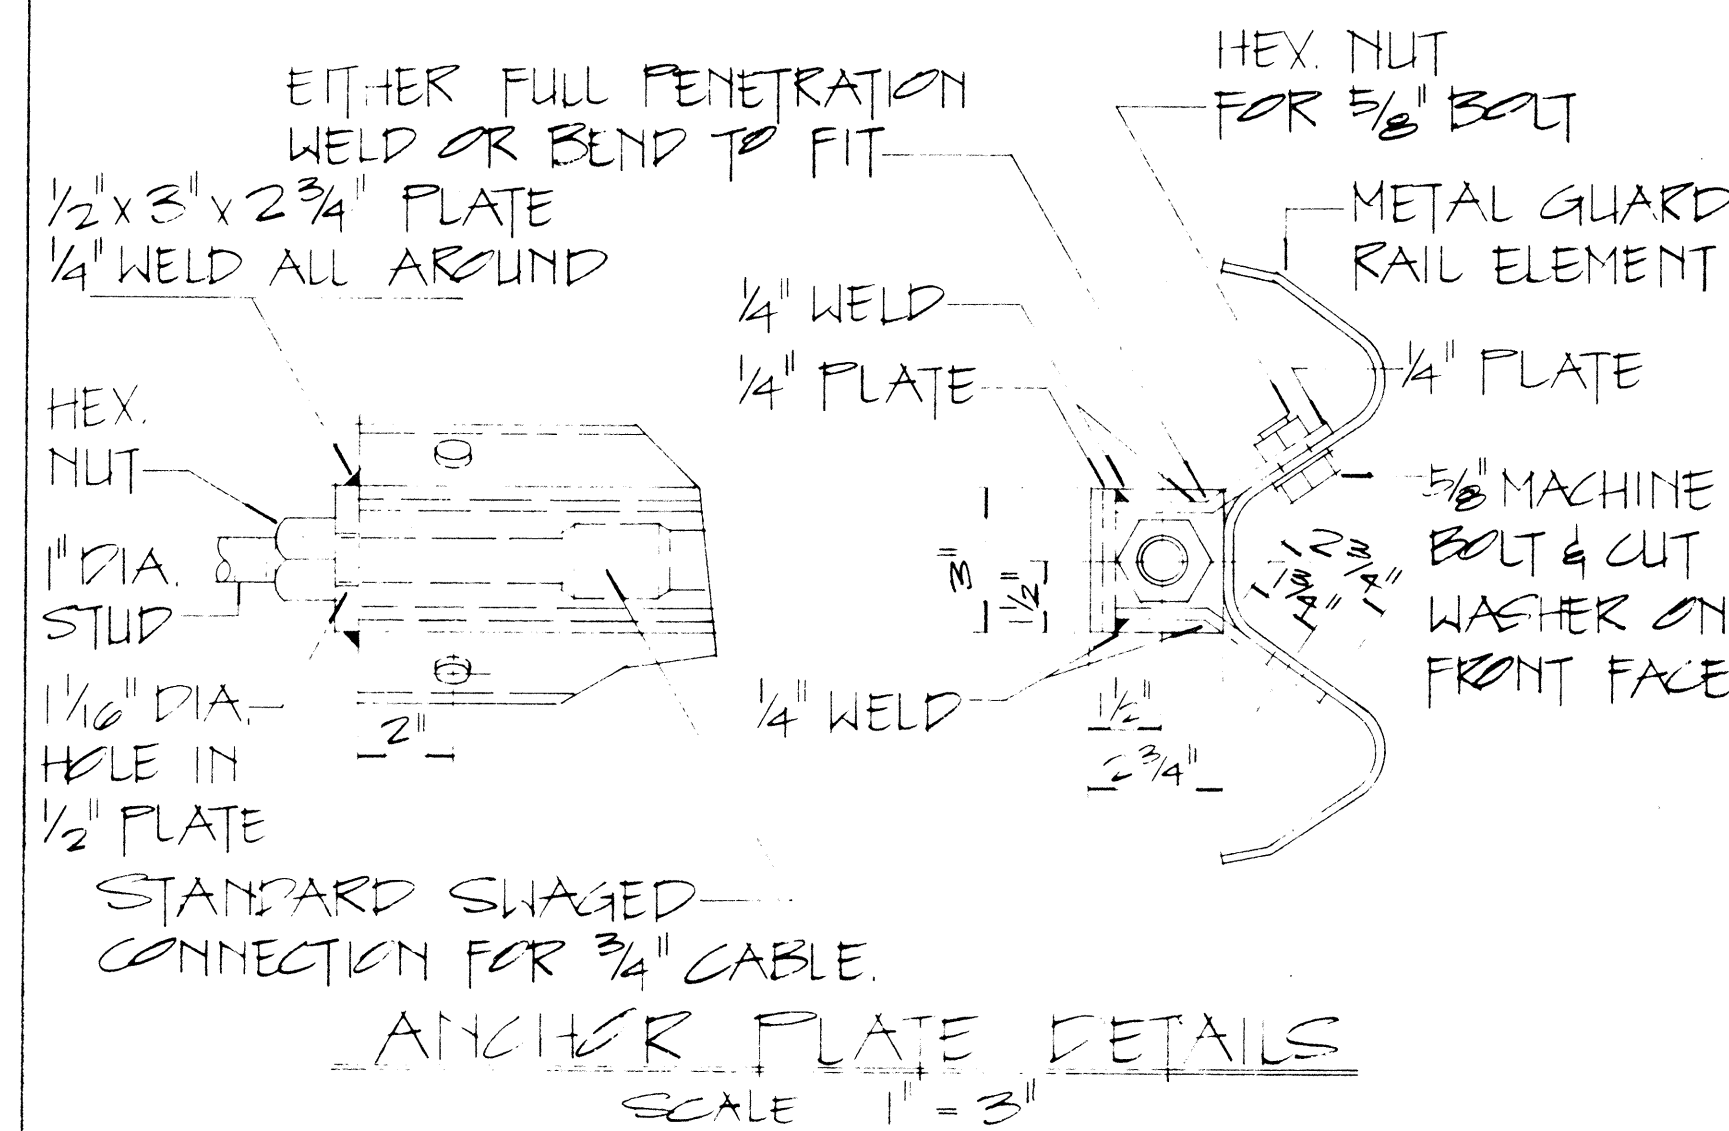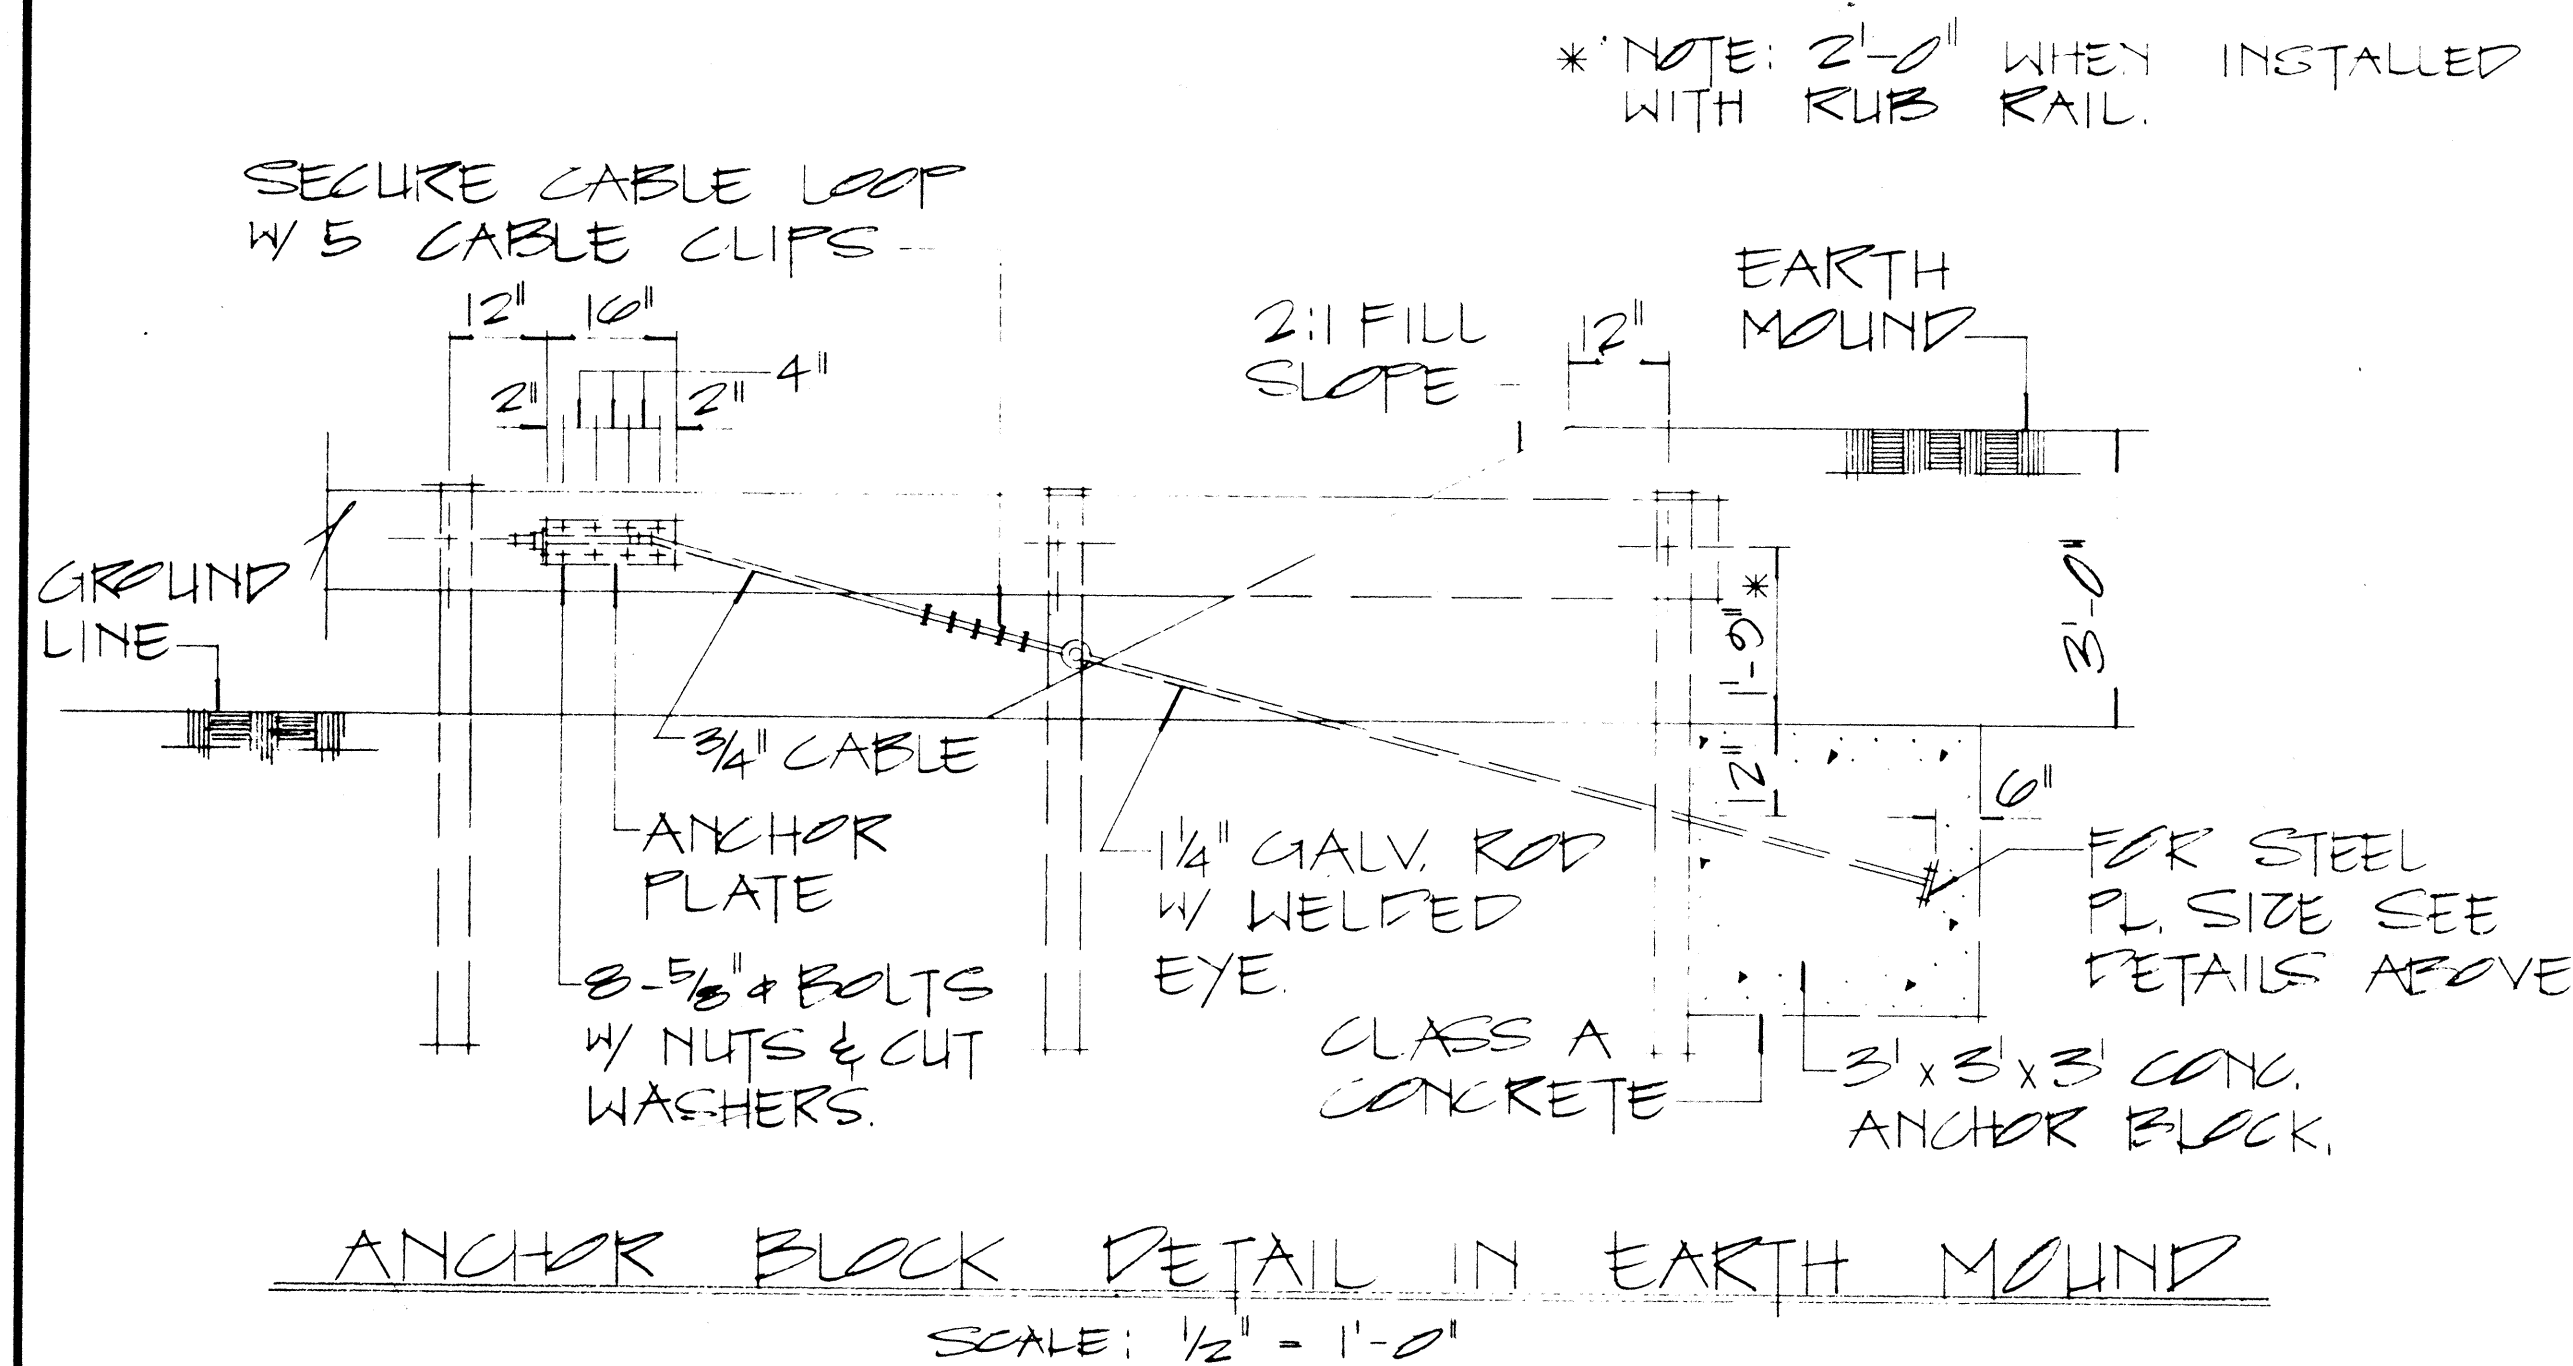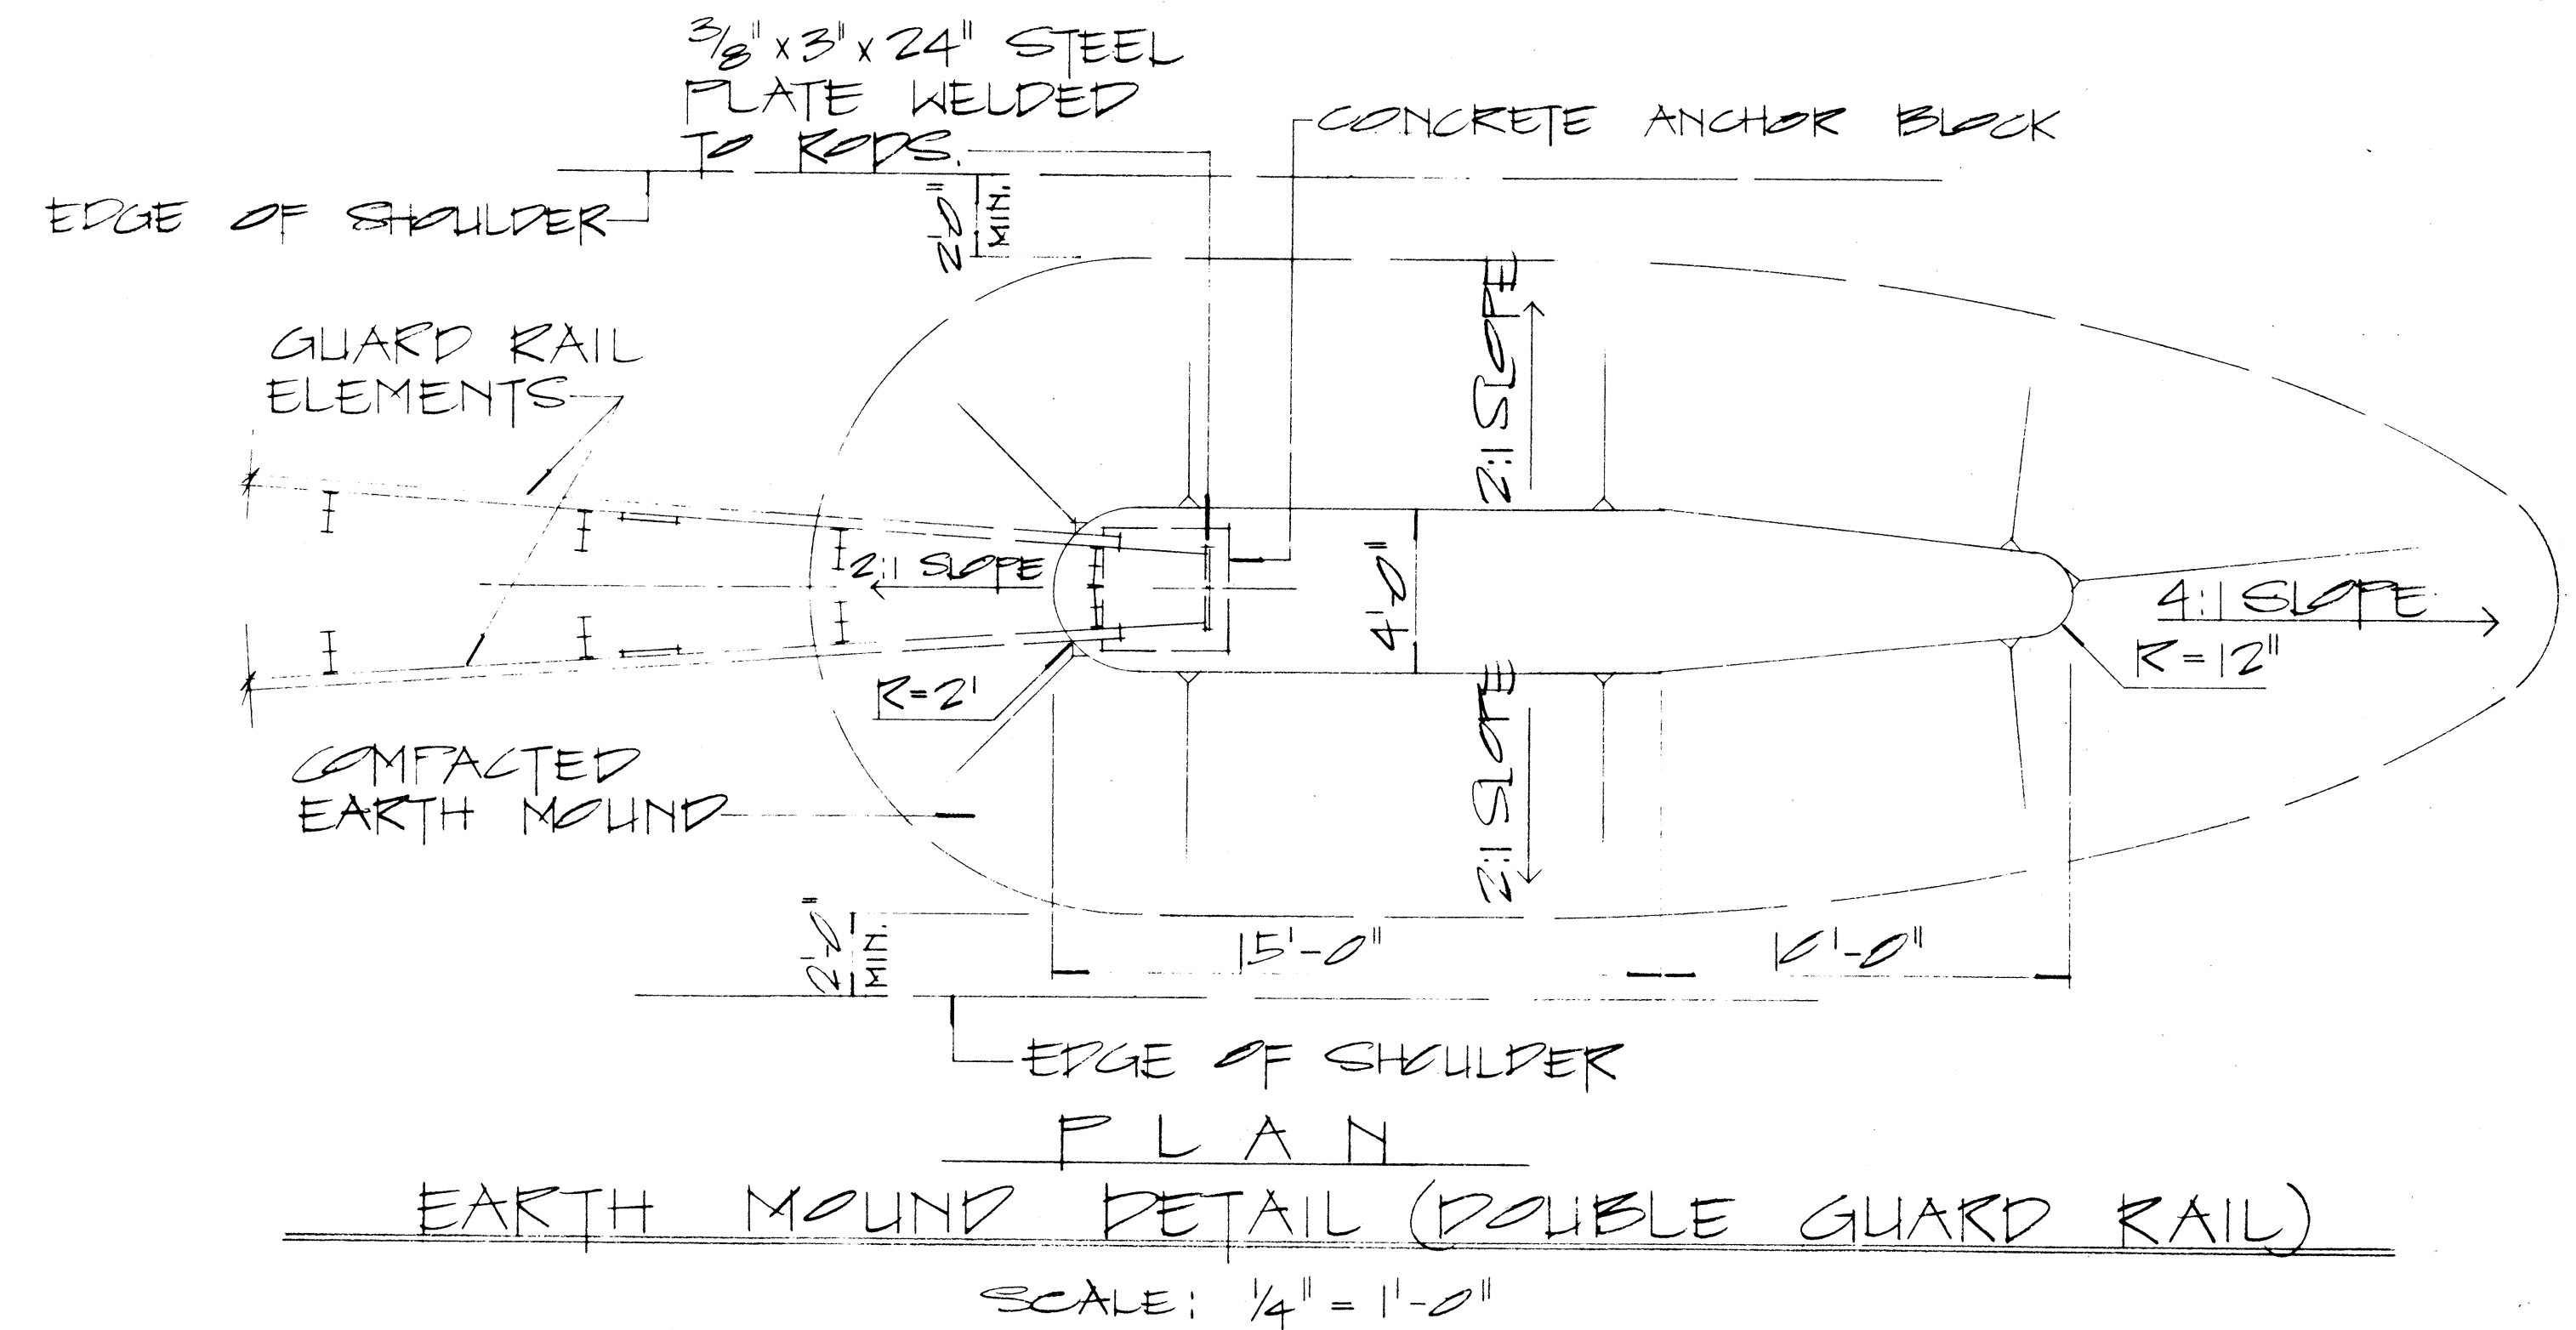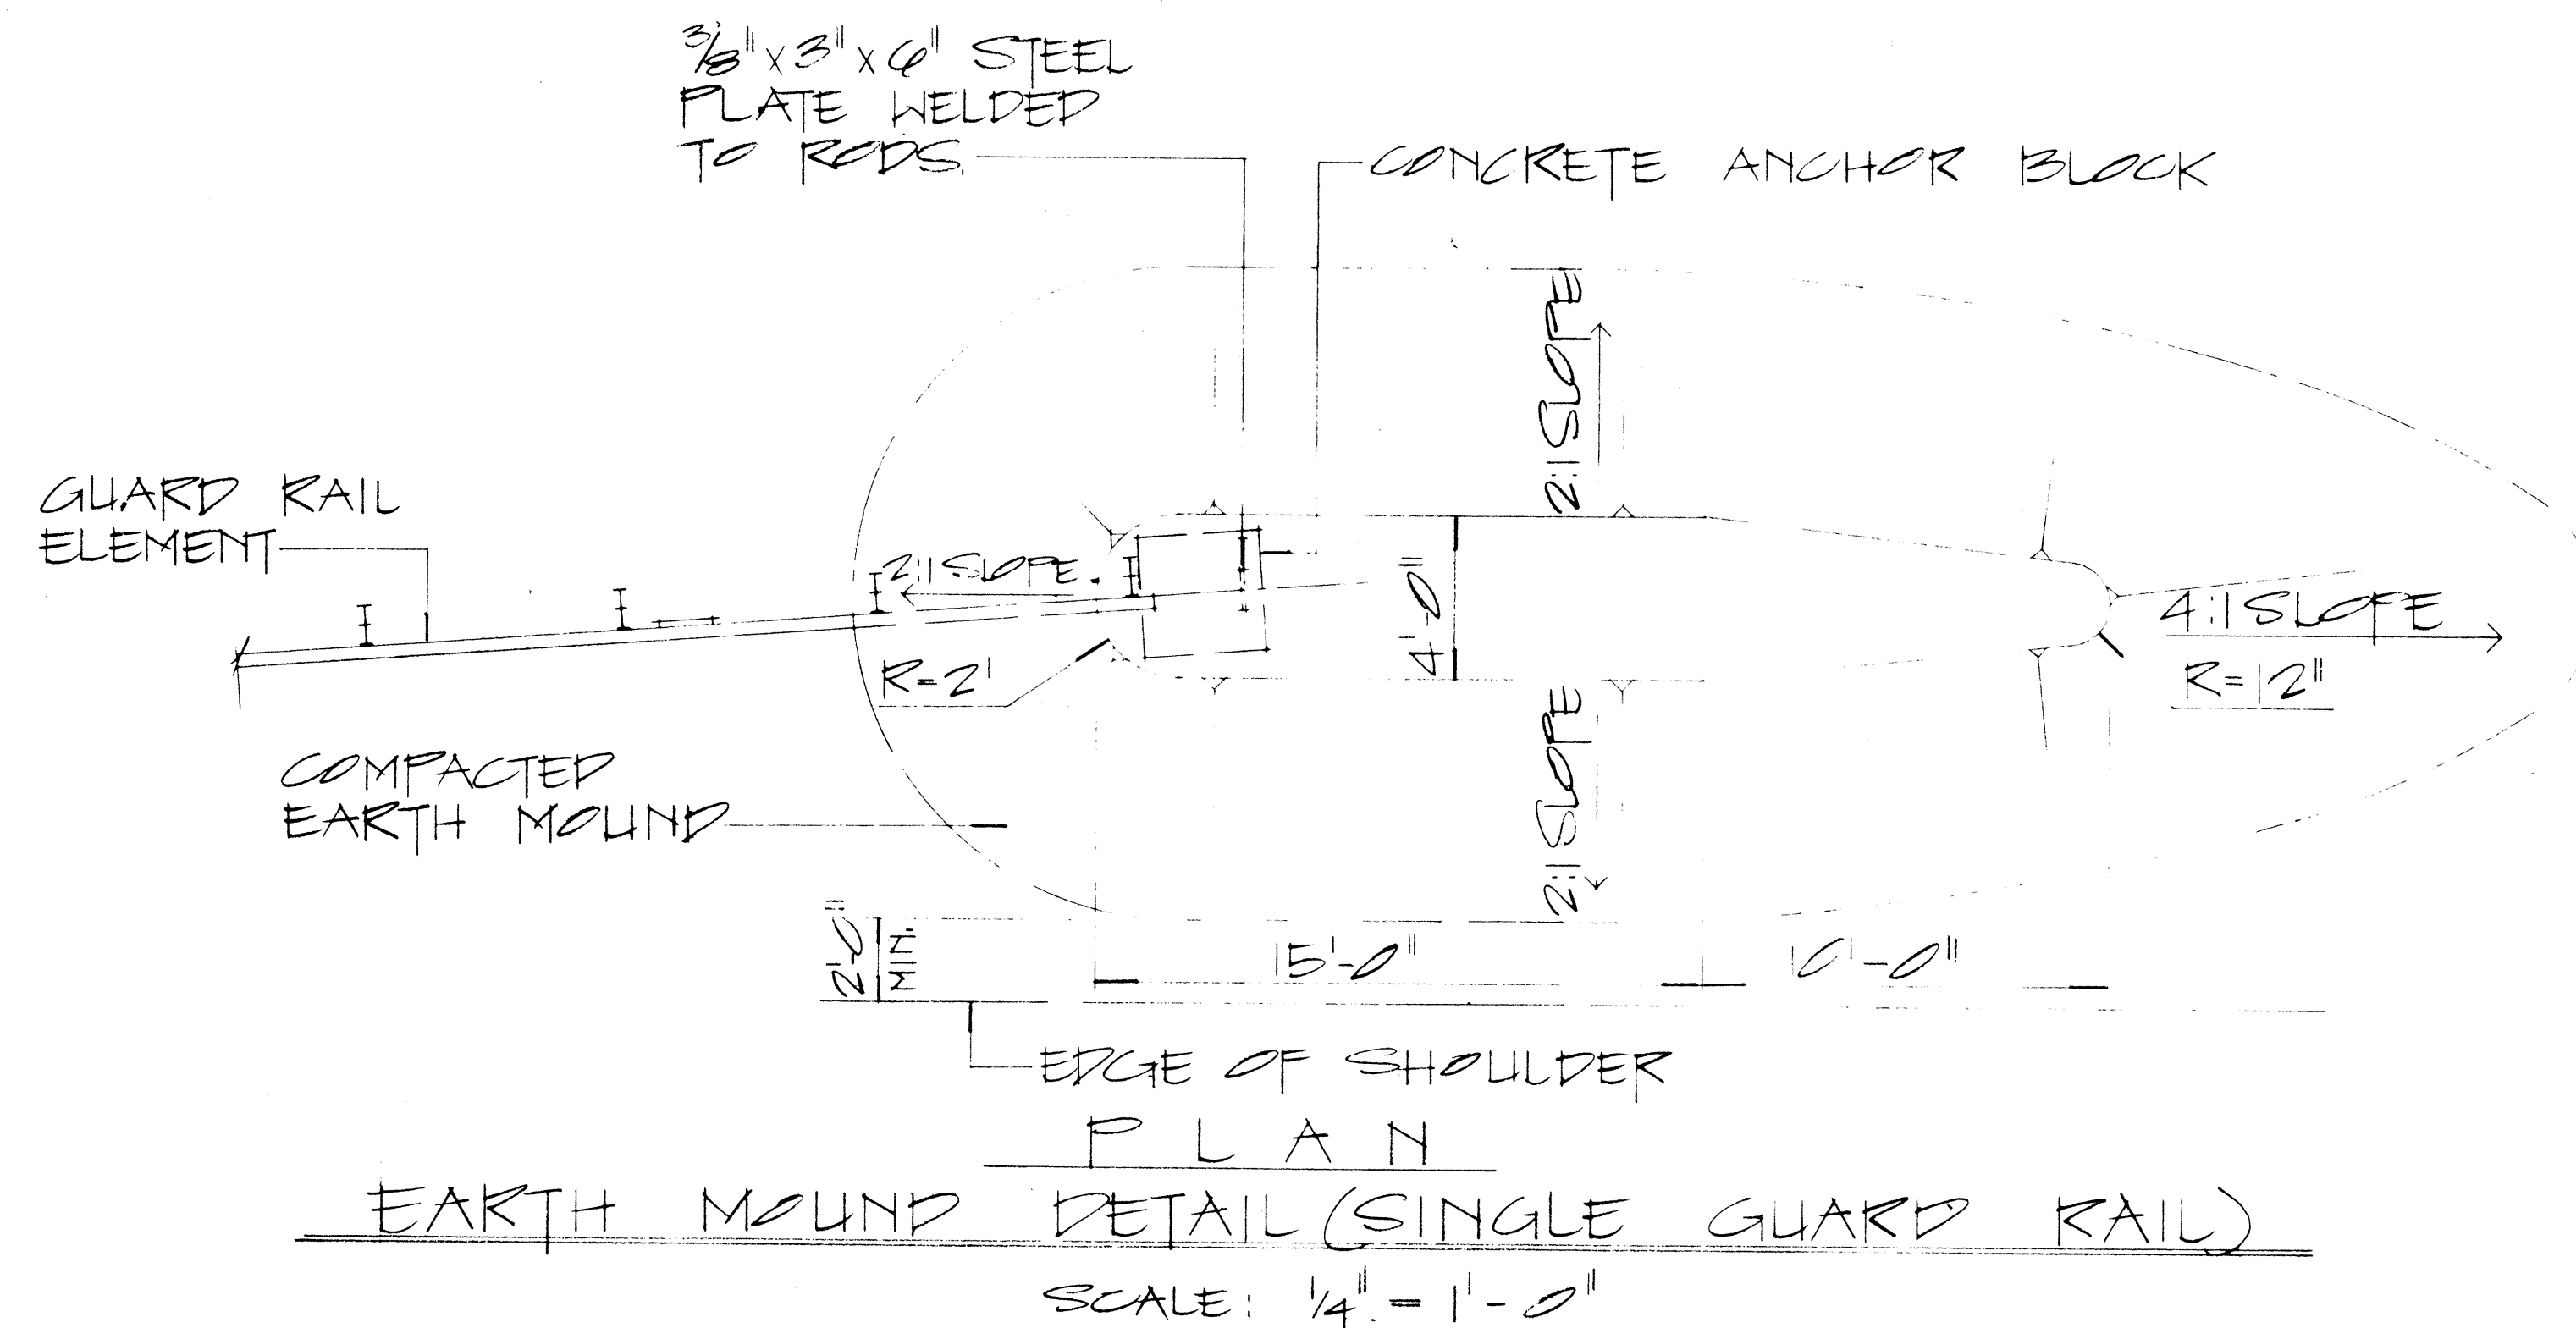


- NOTE:**
1. GALVANIZED ANCHOR ROD, METAL GUARD RAIL AND FAST BURIED IN GROUND SHALL BE COVERED WITH A MIN. 20-MIL THICKNESS OF COAL TAR ENAMEL, CONFORMING TO AWWA STANDARD: C 203
 2. CONCRETE, GRP, EXCAVATION, EARTH MOUND, ANCHOR RODS AND MISCELLANEOUS APPURTENANCES NECESSARY TO ANCHOR THE GUARD RAIL ENDS SHALL BE INCIDENTAL TO THE METAL GUARD RAIL.

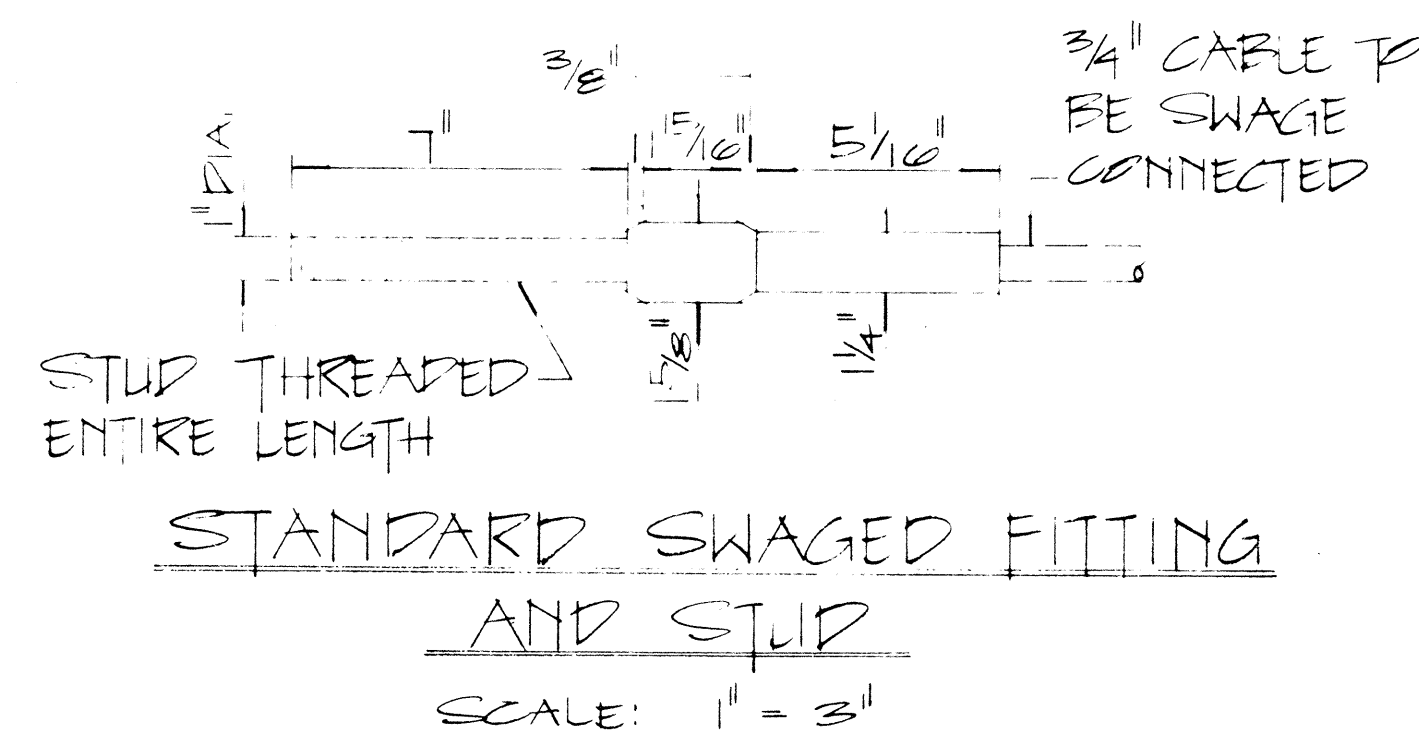

APPROVAL RECOMMENDED:			
TRAFFIC ENGINEER		DATE	
APPROVED:		DATE	
ASSISTANT CHIEF, ENGINEERING		DATE	
NO.	REVISION	APPROVED BY	DATE


STATE OF HAWAII	
DEPARTMENT OF TRANSPORTATION	
HIGHWAYS DIVISION	
STANDARD DETAILS	
EARTH MOUND AND ANCHOR BLOCK DETAILS	
SCALE: AS SHOWN	
SHEET No. 198 OF 25 SHEETS	

FED. ROAD DIST. NO.	STATE	FED. AID PROJ. NO.	FISCAL YEAR	SHEET NO.	TOTAL SHEETS
HAWAII	HAW.	HA-1(89)-13	1971	46	362

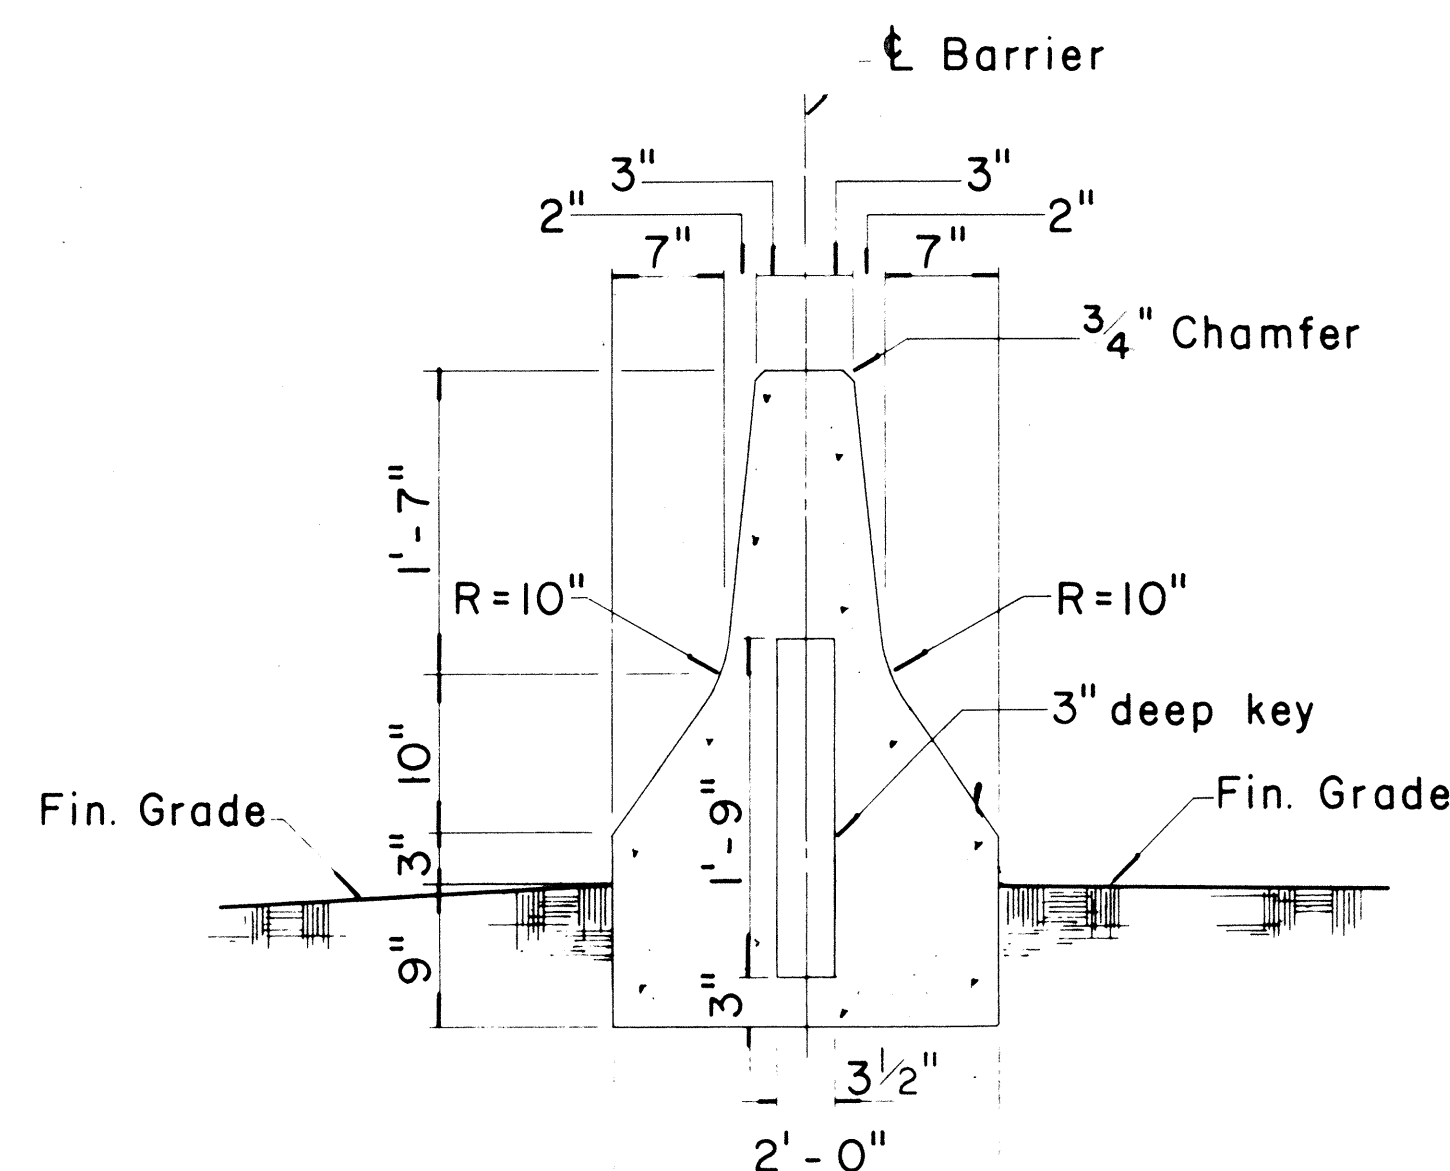


TYPE 4A

Scale: 1" = 1'-0"

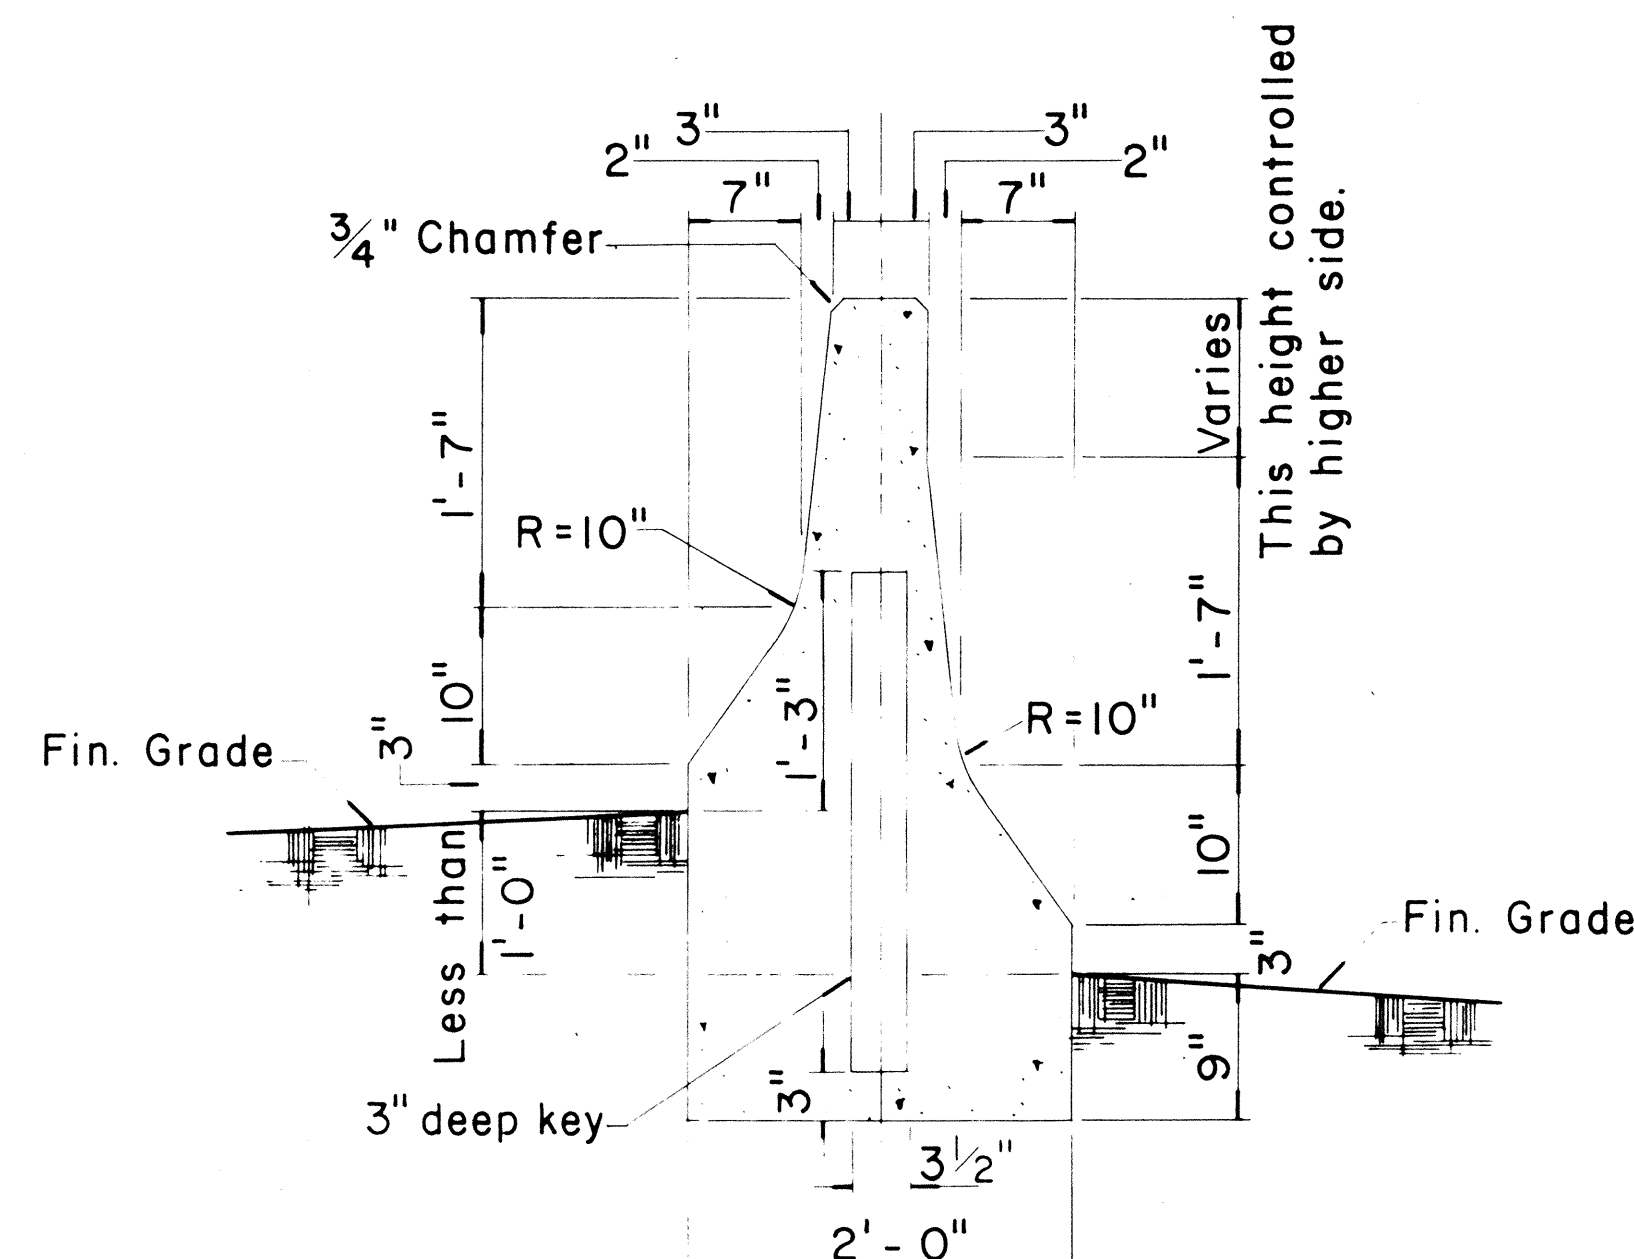


TYPE 4B

Scale: 1" = 1'-0"

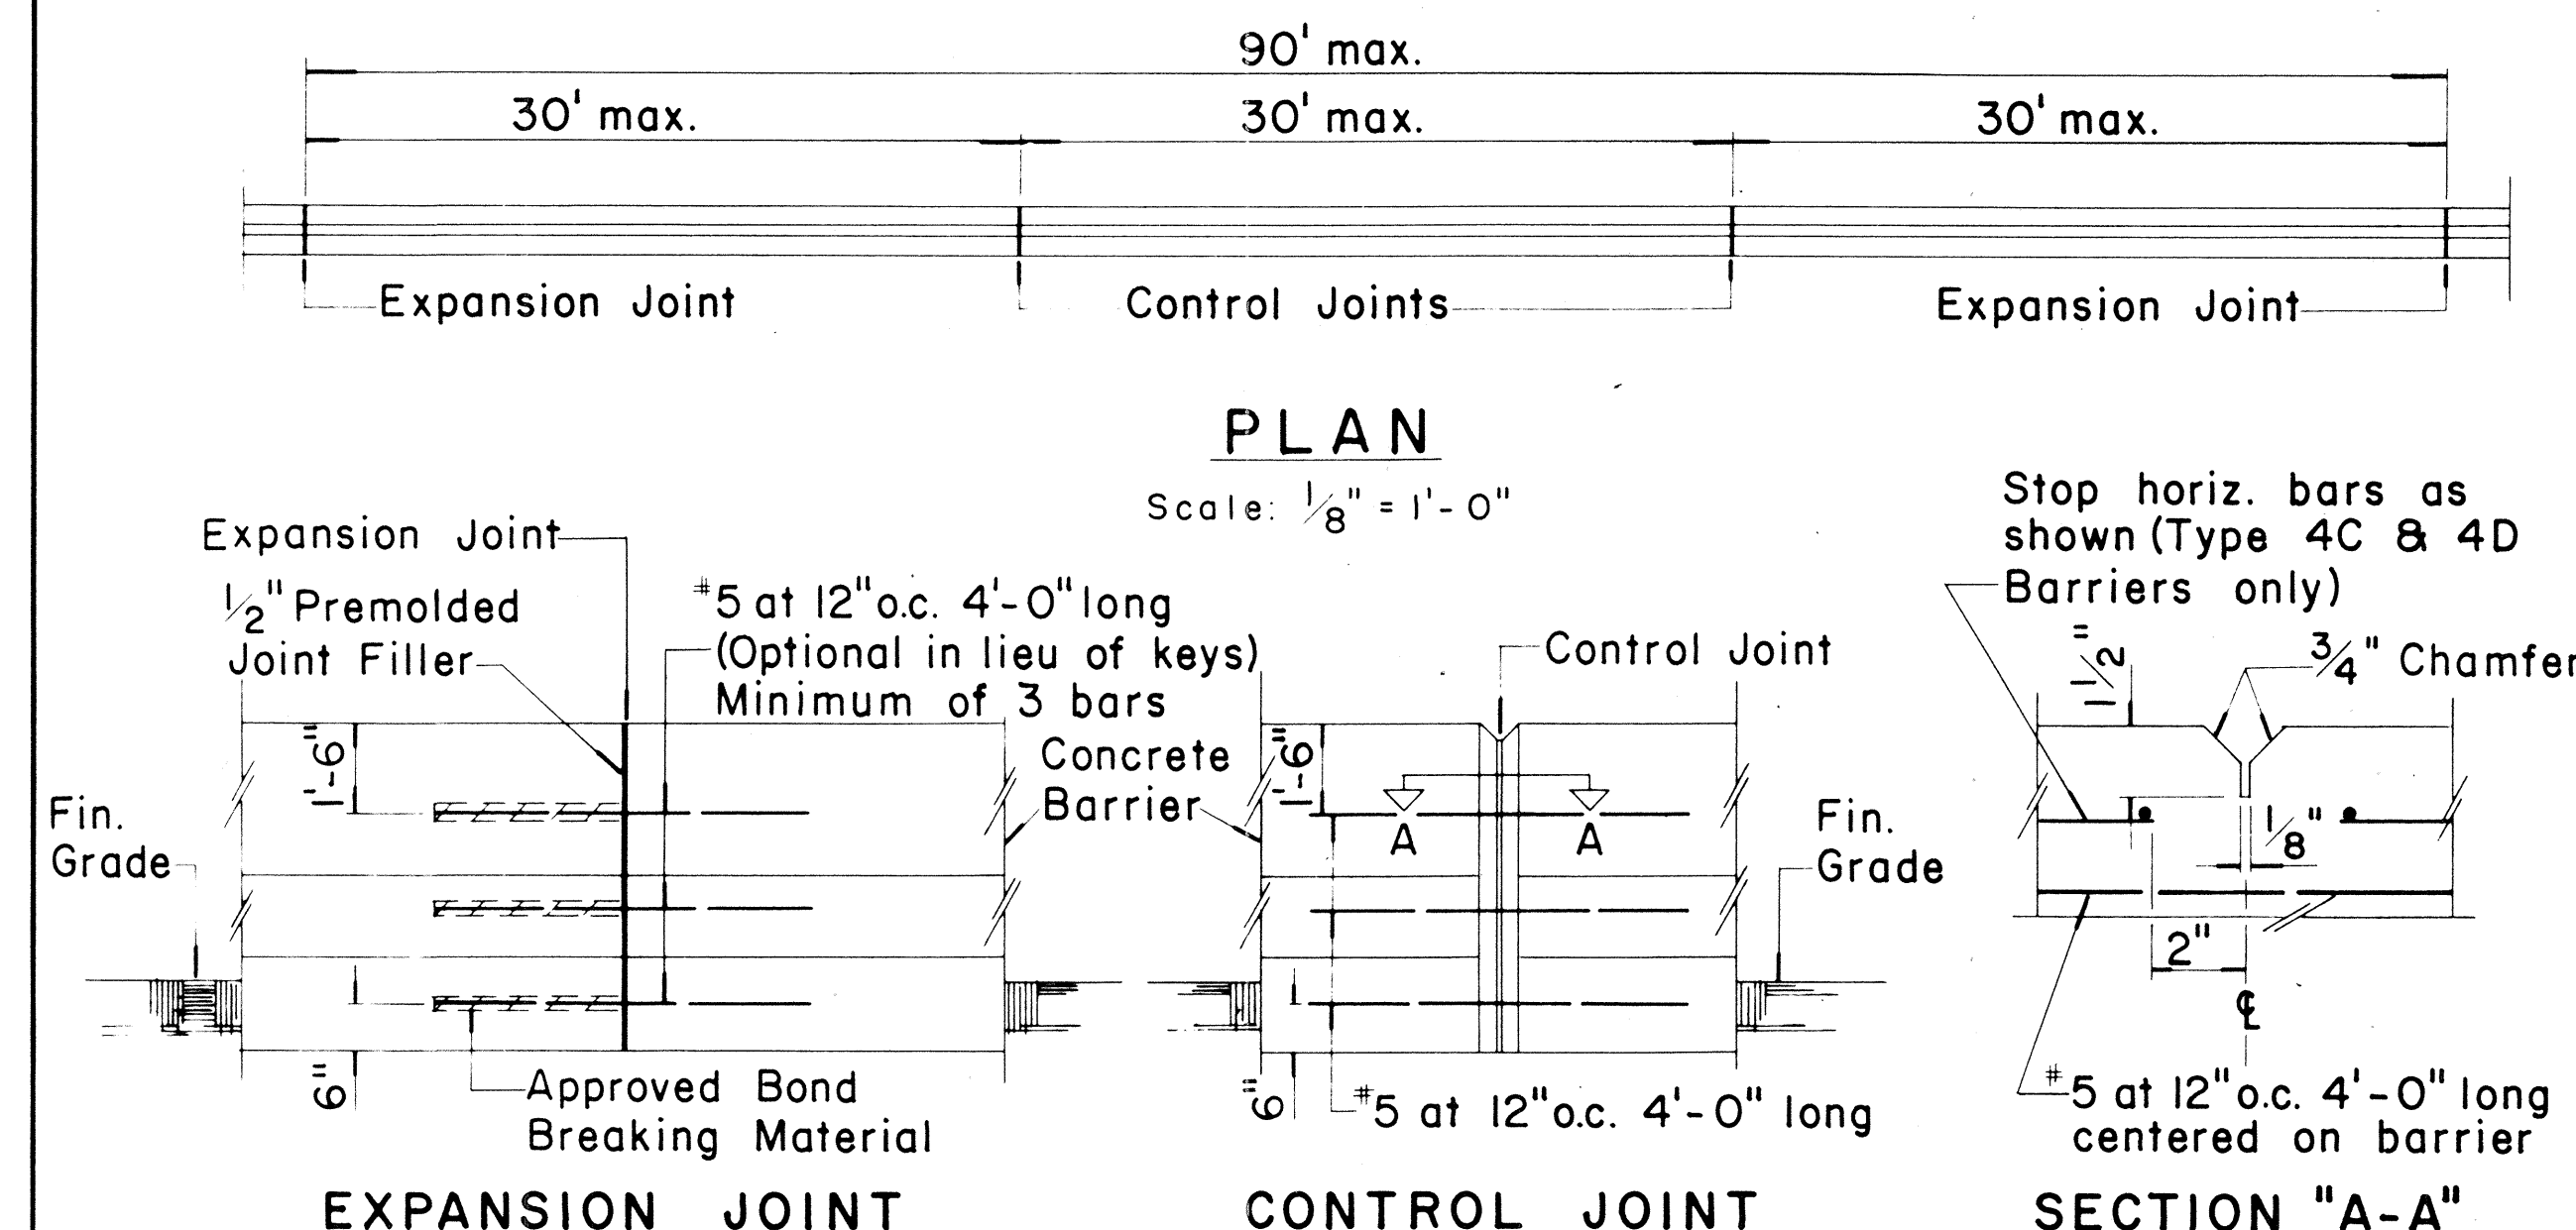


ELEVATION

Scale: 1/2" = 1'-0"

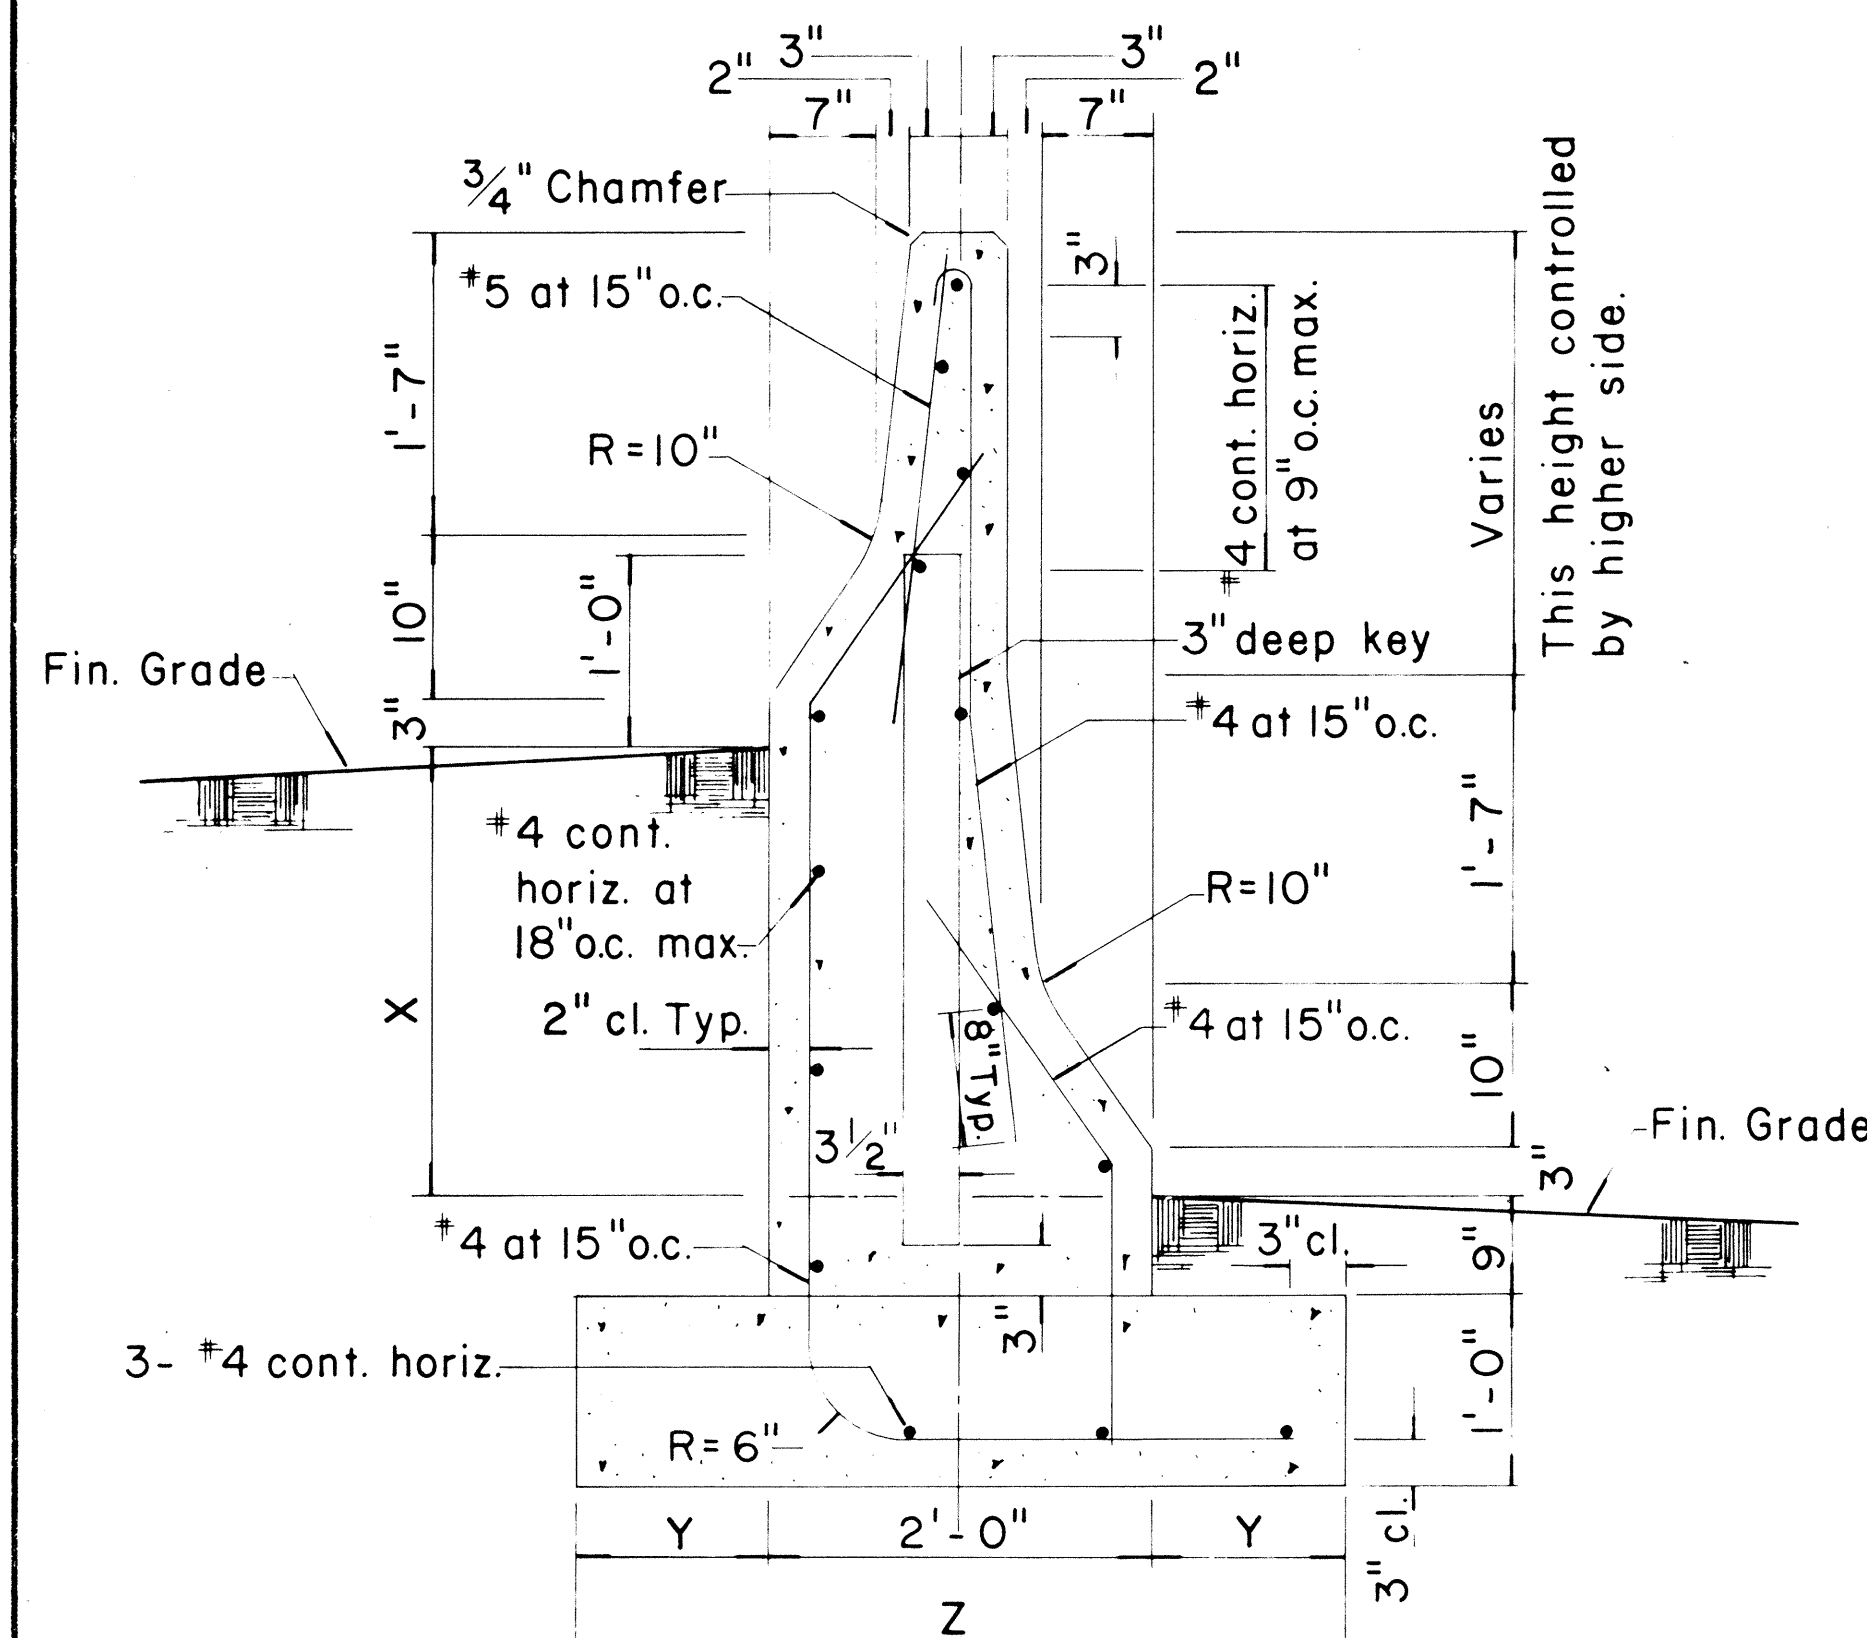

TYPE 4C & TYPE 4D

Scale: 1" = 1'-0"

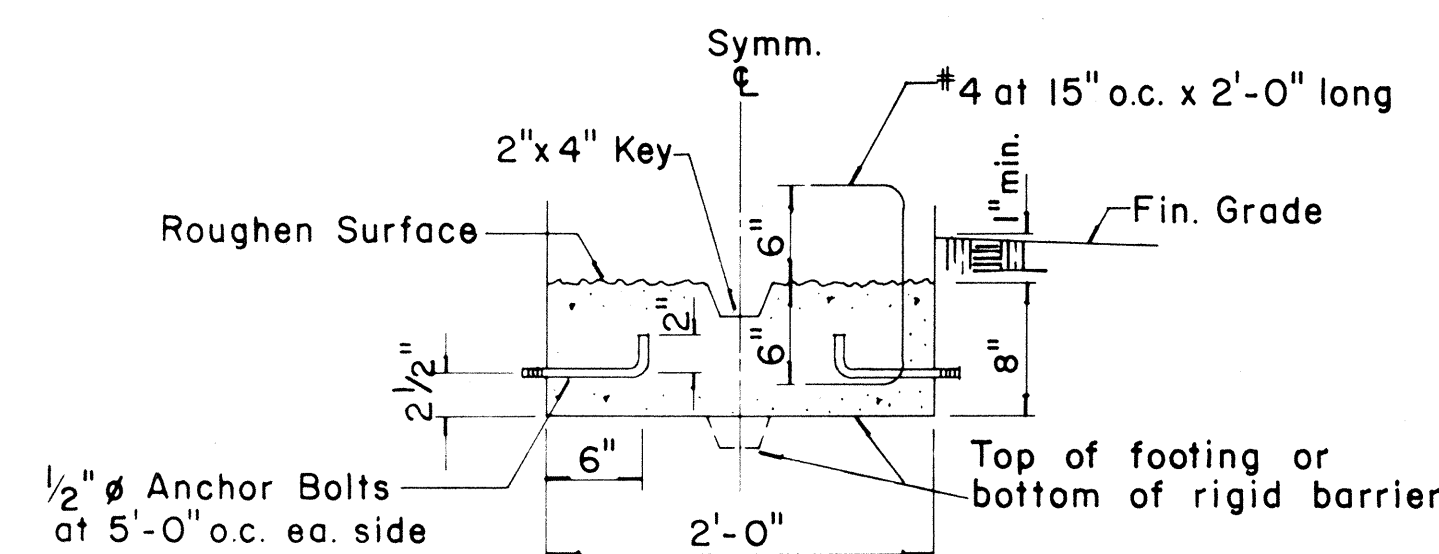

OPTIONAL CONSTRUCTION JOINT DETAILS


Scale: 1" = 1'-0"

NOTE:

The intent of the optional construction joint details for the Type 4 Rigid Barrier Guard Rail is to provide a method of securing the forms and preventing uplift so that the barrier will have a uniform and presentable appearance. The contractor may submit an alternate method of constructing the barrier for the approval of the Engineer and for use on a trial basis. Any unsatisfactory work shall be removed or corrected as directed by the Engineer and at the Contractor's expense.

GENERAL NOTES

- Precast Rigid Barrier Guard Rail may be installed as an option to cast-in-place Type 4 Rigid Barrier Guard Rail. Contractor shall submit shop drawings to Engineer for approval.
- Expansion Joints shall be constructed at ninety-foot (90 ft.) maximum intervals and at existing expansion joints of structures. (Use 1/2" premolded joint filler, incidental to Type 4 Rigid Barrier Guard Rail). Control Joints shall be placed between expansion joints at 30' maximum. Shear keys shall be required at all construction joints.
- The exterior surface and vertical alignment of the Type 4 Rigid Barrier Guard Rail shall be constructed to give a uniform and presentable appearance. Variation of more than 1/4" in 20' max. and 1/2" in 40' or more will be considered objectionable. The Engineer shall determine the acceptability of the work. During the course of the work, samples may be tested and measurements made to establish whether or not the specified values or dimensions are being met. If the specified values or dimensions are not being met, the Engineer shall determine the degree of the non-conformance, the effect on the serviceability of the project, whether the work be accepted and remain in place and, if so, the amount to be paid for such work, or whether the work shall be removed and replaced or otherwise corrected at the Contractor's expense.

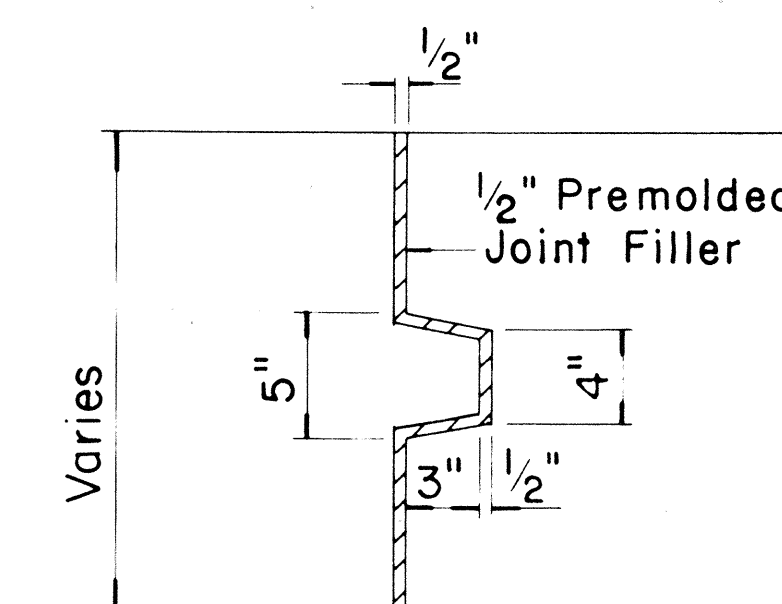

SECTION THRU KEY AT EXPANSION JOINT

Scale: 1 1/2" = 1'-0"

STATE OF HAWAII
DEPARTMENT OF TRANSPORTATION
HIGHWAYS DIVISION

**GUARD RAIL TYPE 4
(RIGID BARRIER)**

Scale: As Shown Oct. 1969

SHEET No. 208 OF 25 SHEETS

41 6




ORIGINAL PLAN	DATE
DESIGNED BY	
CHECKED BY	
NOTED BY	
NO.	

TYPE	DIFFERENCE IN FIN. GRADE	FOOTING
	X	Y Z
4C	1'-0" min., 2'-4" max.	1'-0" 4'-0"
4D	Greater than 2'-4", 4'-4" max.	1'-3" 4'-6"

NOTE:



Except where noted all dimensions shall be the same for Type 4C and Type 4D.

FED. ROAD DIST. NO.	STATE	FED. AID PROJ. NO.	FISCAL YEAR	SHEET NO.	TOTAL SHEETS
HAWAII	HAWAII	FH-1(89)-13	1971	48	302

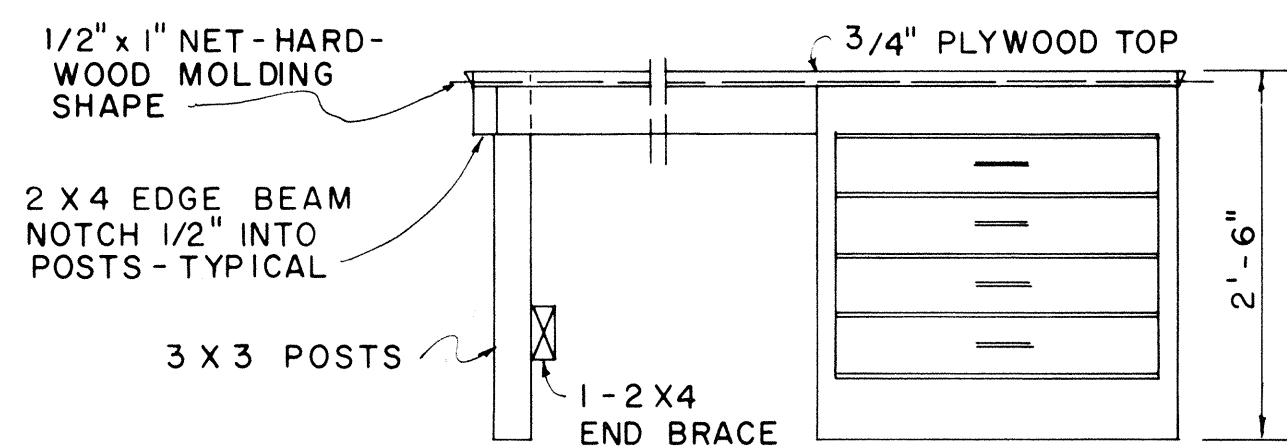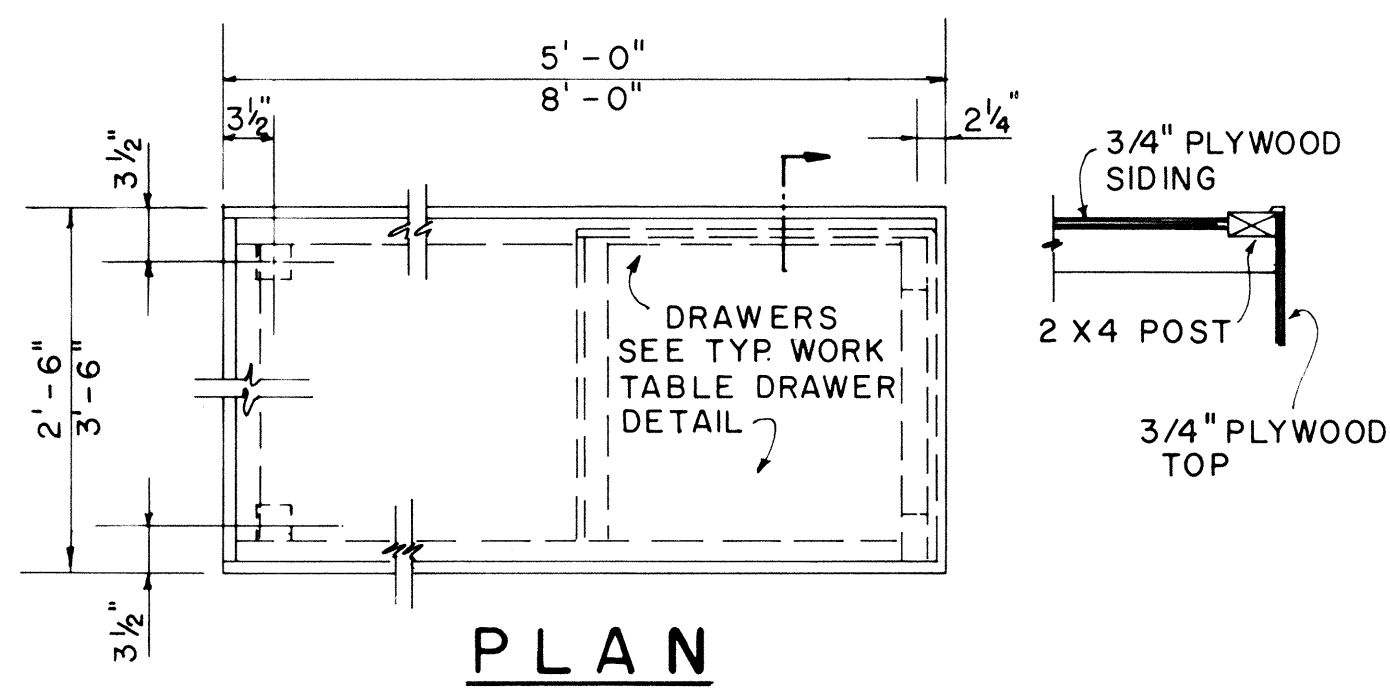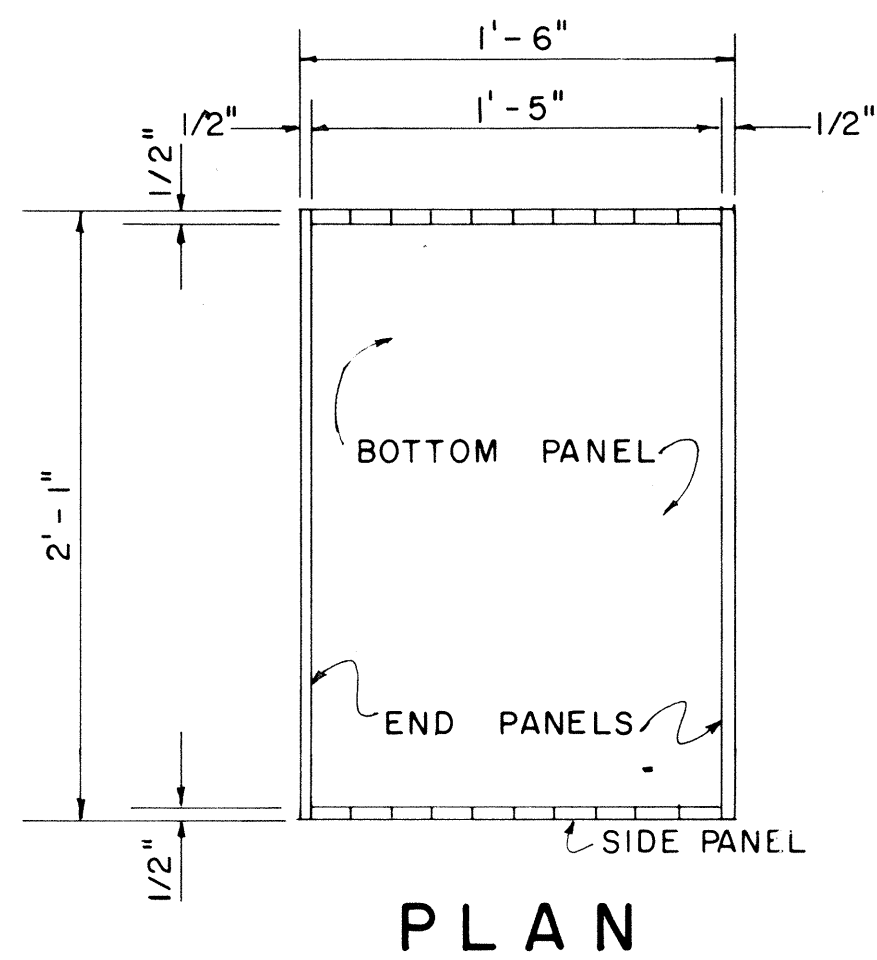


ELEVATION
 2'-6" x 5'-0" 2 REQ'D
 3'-6" x 8'-0" 1 REQ'D
 2'-6" x 8'-0" 1 REQ'D

PORTABLE WORK TABLE DETAIL
 SCALE: 3/4" = 1'-0"

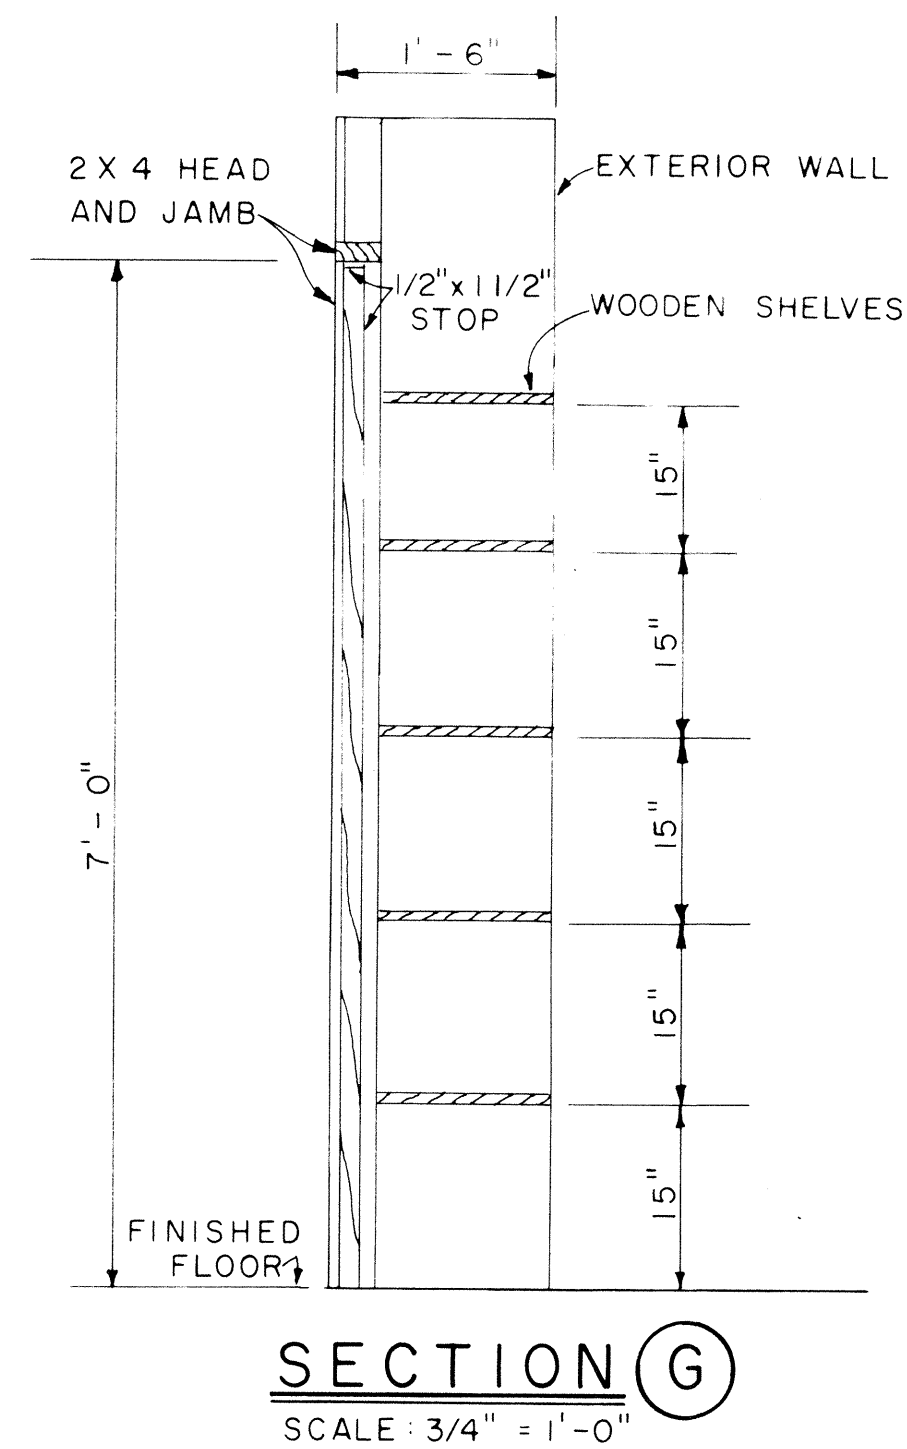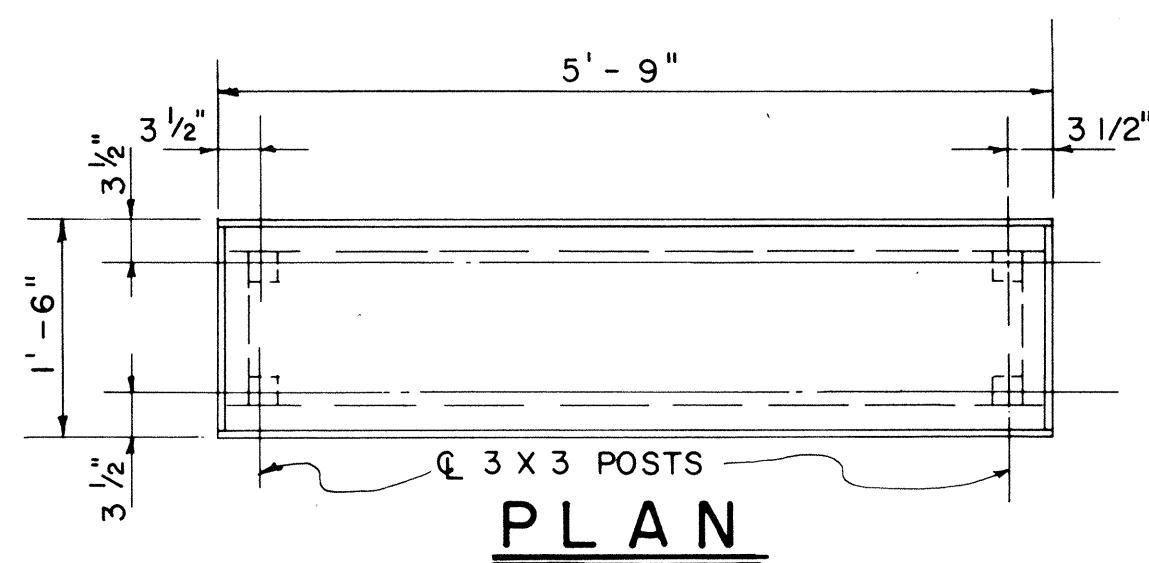


SECTION G
 SCALE: 3/4" = 1'-0"

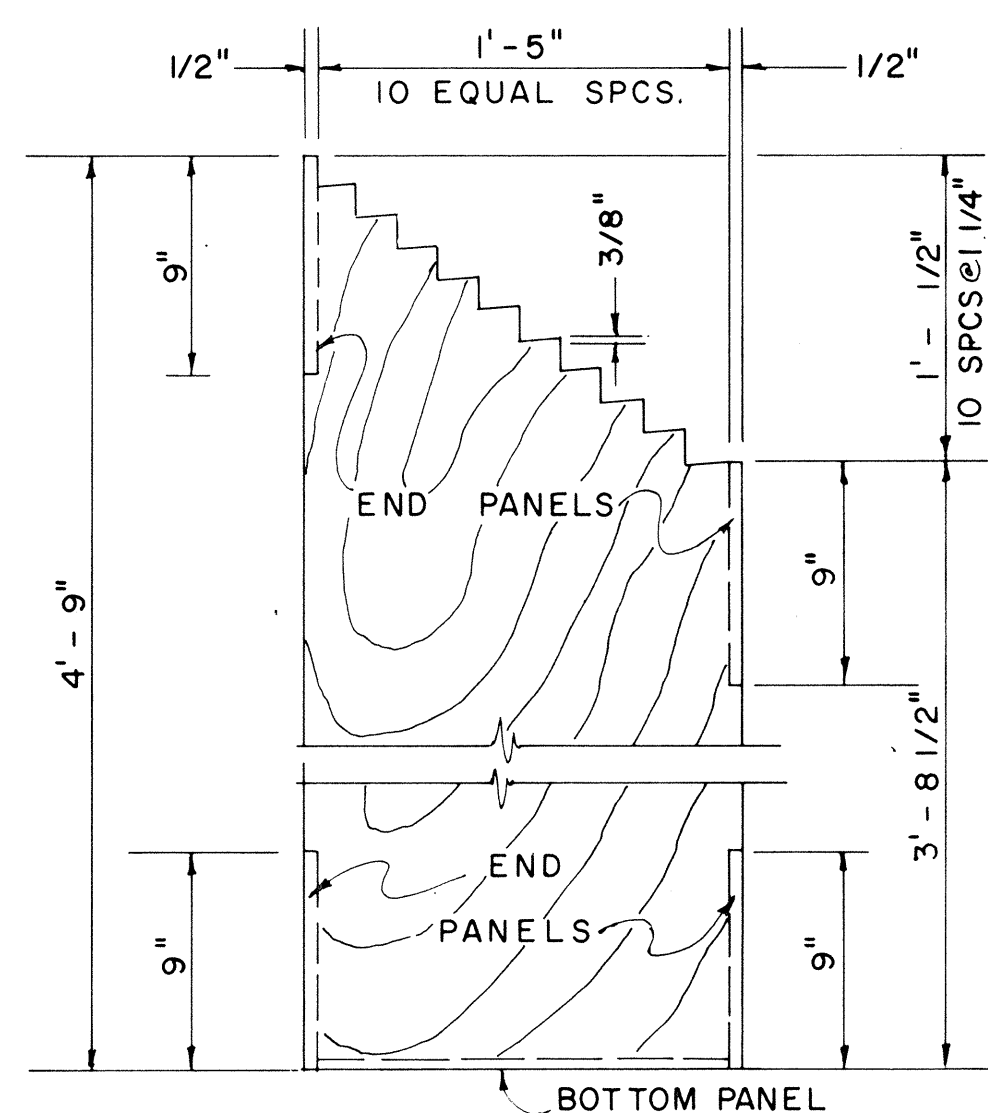


END ELEVATION


PLAN RACK DETAIL
 SCALE: 1 1/2" = 1'-0"
 (ONE REQUIRED)

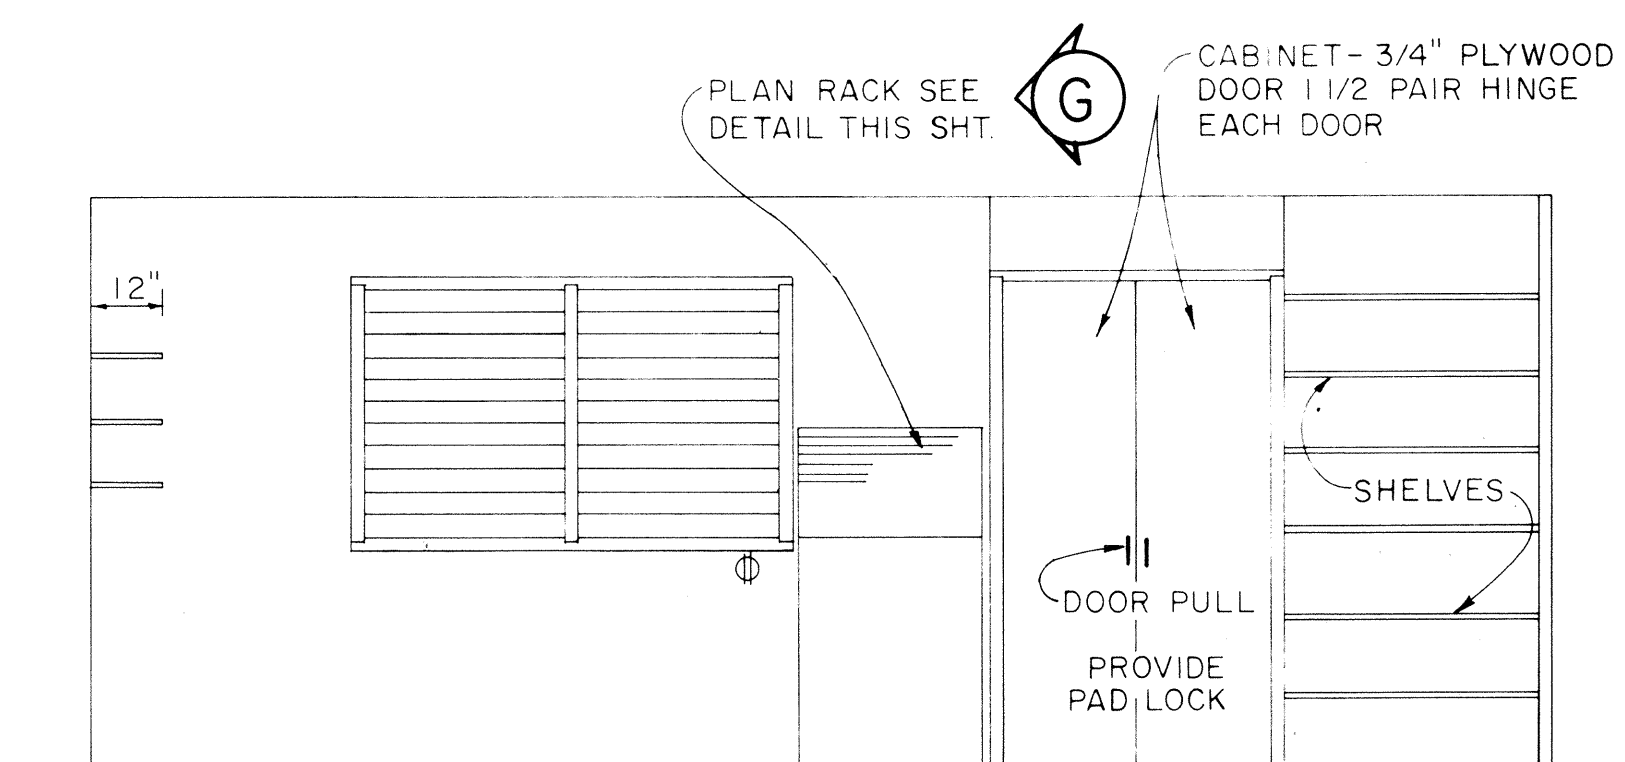


ELEVATION A1
 SCALE: 3/8" = 1'-0"

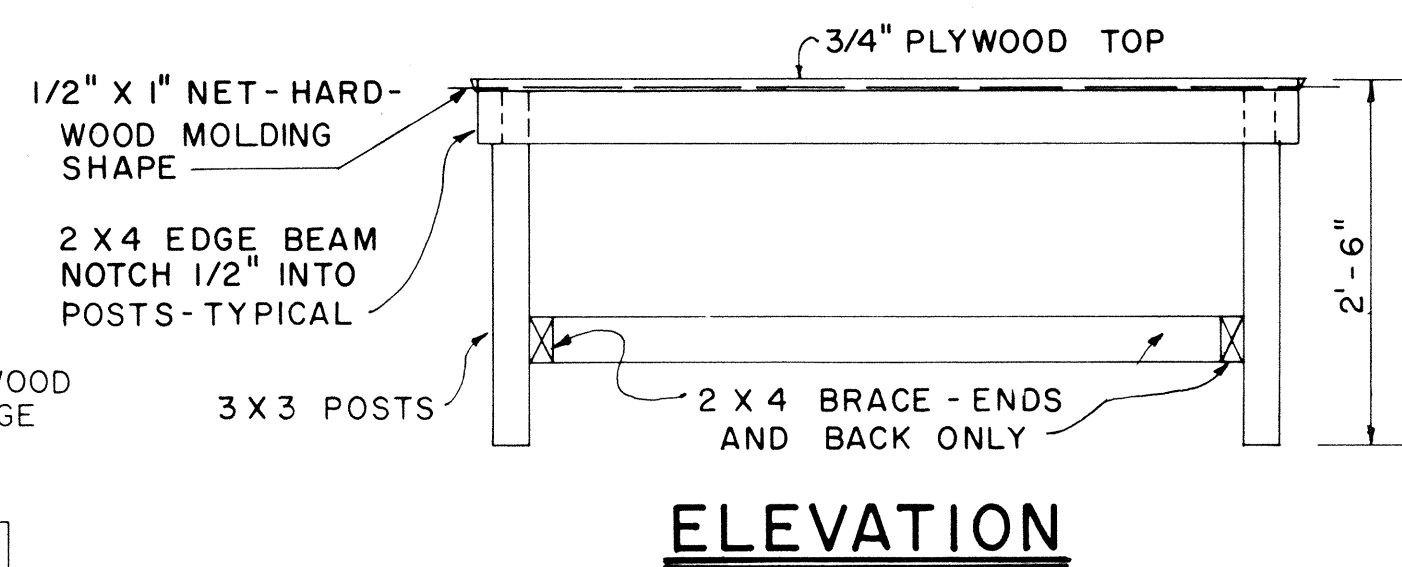

1'-6" x 5'-9" PORTABLE WORK TABLE DETAIL
 SCALE: 3/4" = 1'-0"

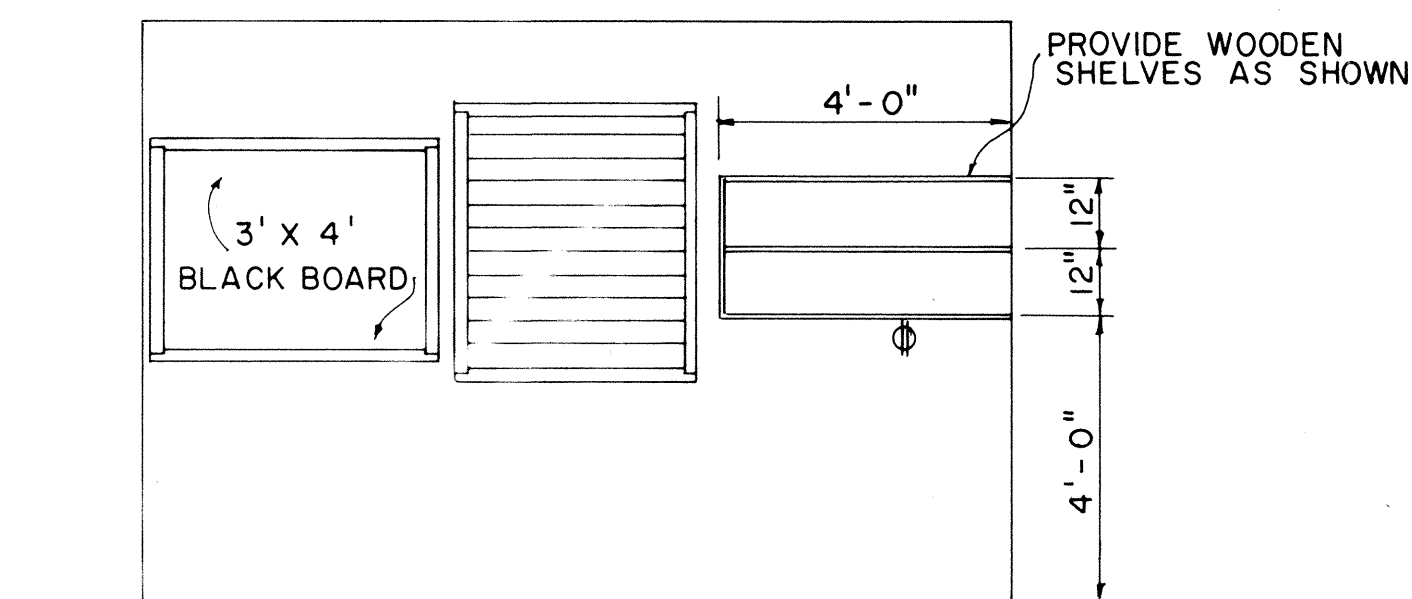

ELEVATION D1
 SCALE: 3/8" = 1'-0"

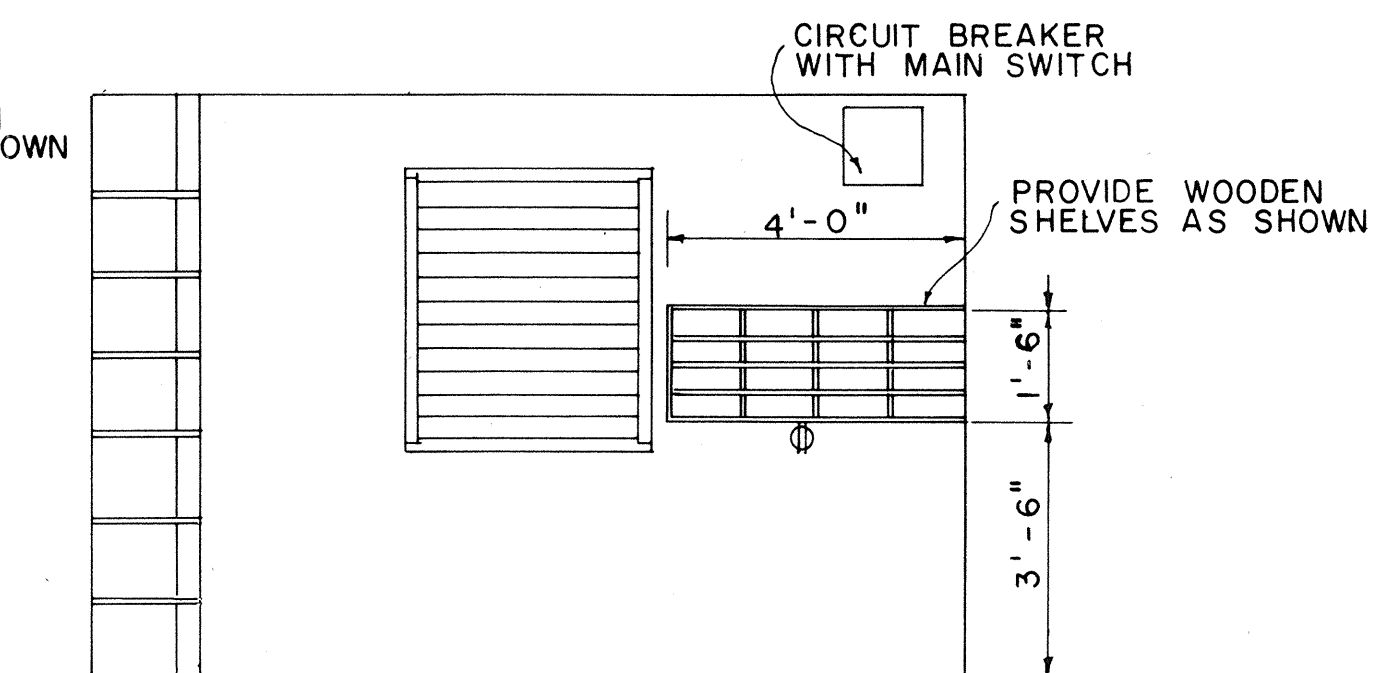

ELEVATION B1
 SCALE: 3/8" = 1'-0"

APPROVAL RECOMMENDED:
 HIGHWAY DESIGN ENGINEER
 DATE 12-4-69

APPROVED:
 ASSISTANT CHIEF, ENGINEERING
 DATE 12-10-69

NO.	REVISION	APPROVED BY	DATE




ST.ATE OF HAWAII
DEPARTMENT OF TRANSPORTATION
HIGHWAYS DIVISION

FIELD OFFICE



Scale: As Noted
Date: Oct 30, 1970
SHEET No. 228 OF 25 SHEETS DD 636.2

ORIGINAL PLAN	DATE
DESIGNED BY	
CHECKED BY	
NO.	

FED. ROAD DIST. NO.	STATE	FED. AID PROJ. NO.	FISCAL YEAR	SHEET NO.	TOTAL SHEETS
HAWAII	HAW.	1-H-1(89)13	1971	47	362

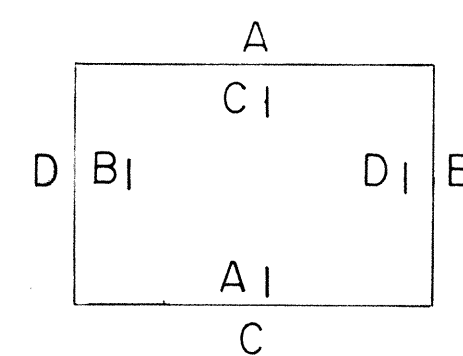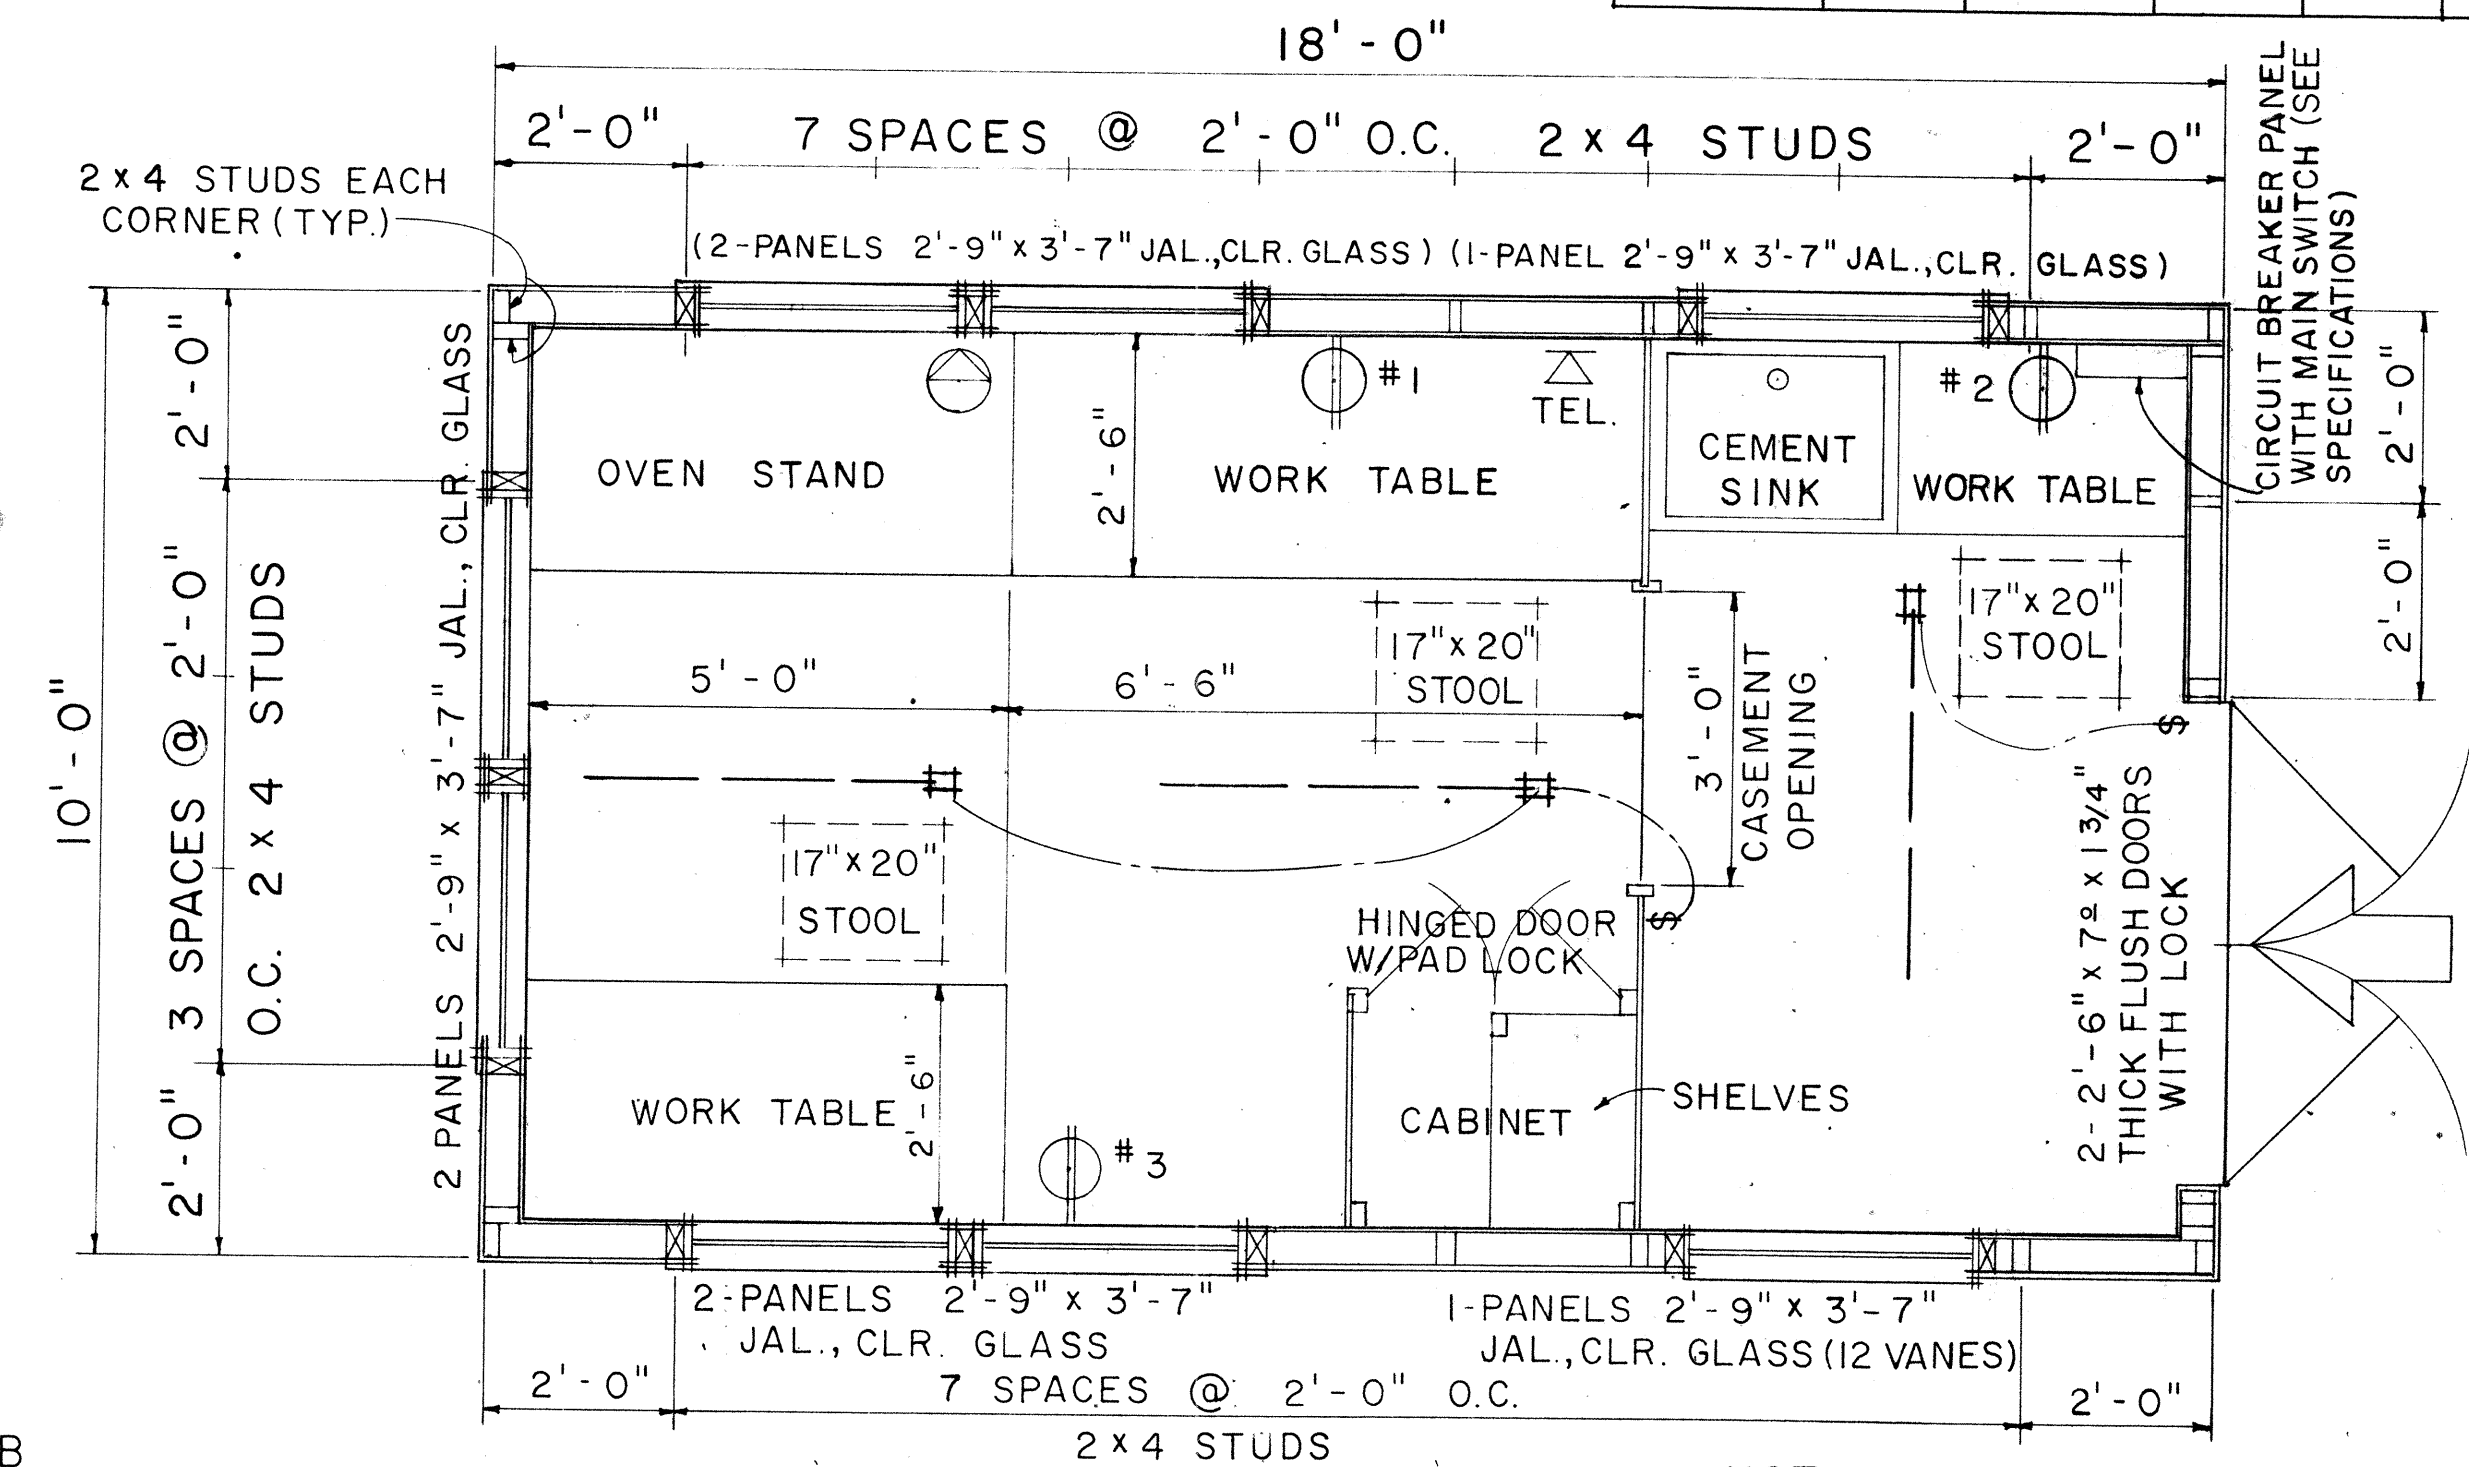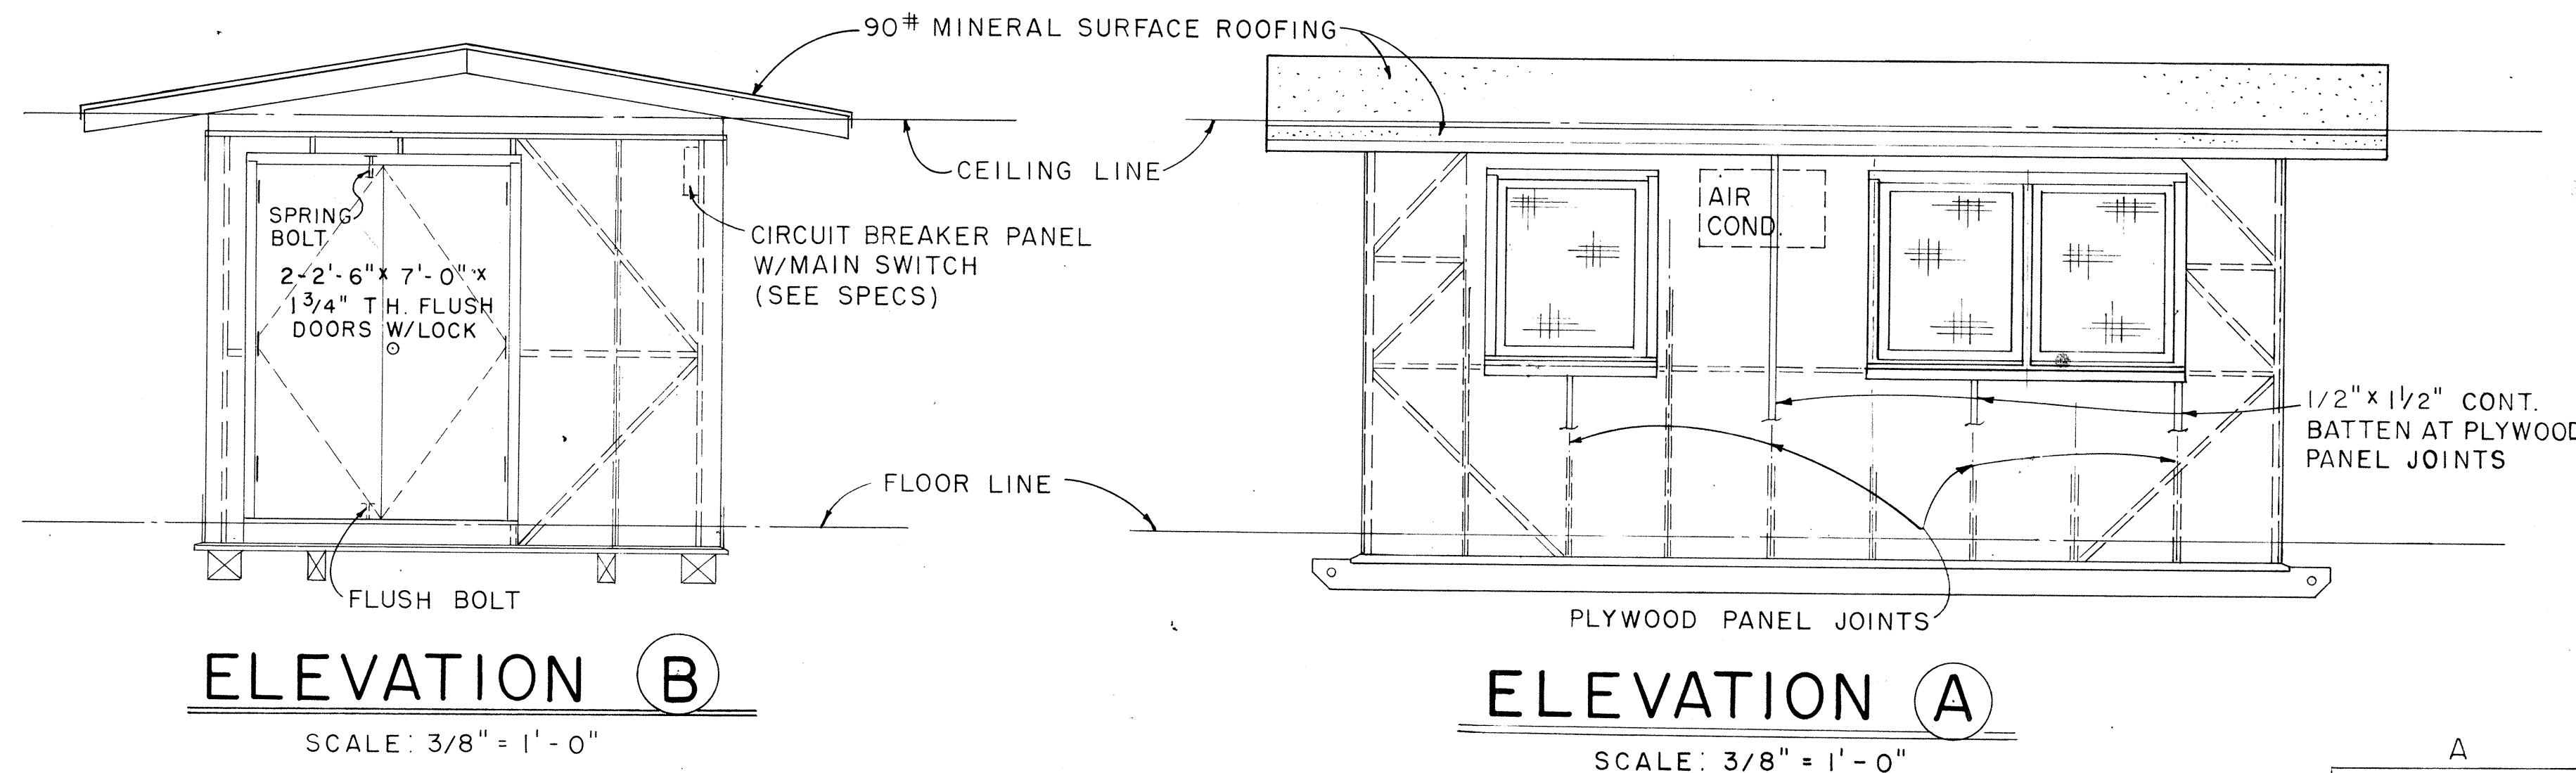

EXTERIOR & INTERIOR KEY

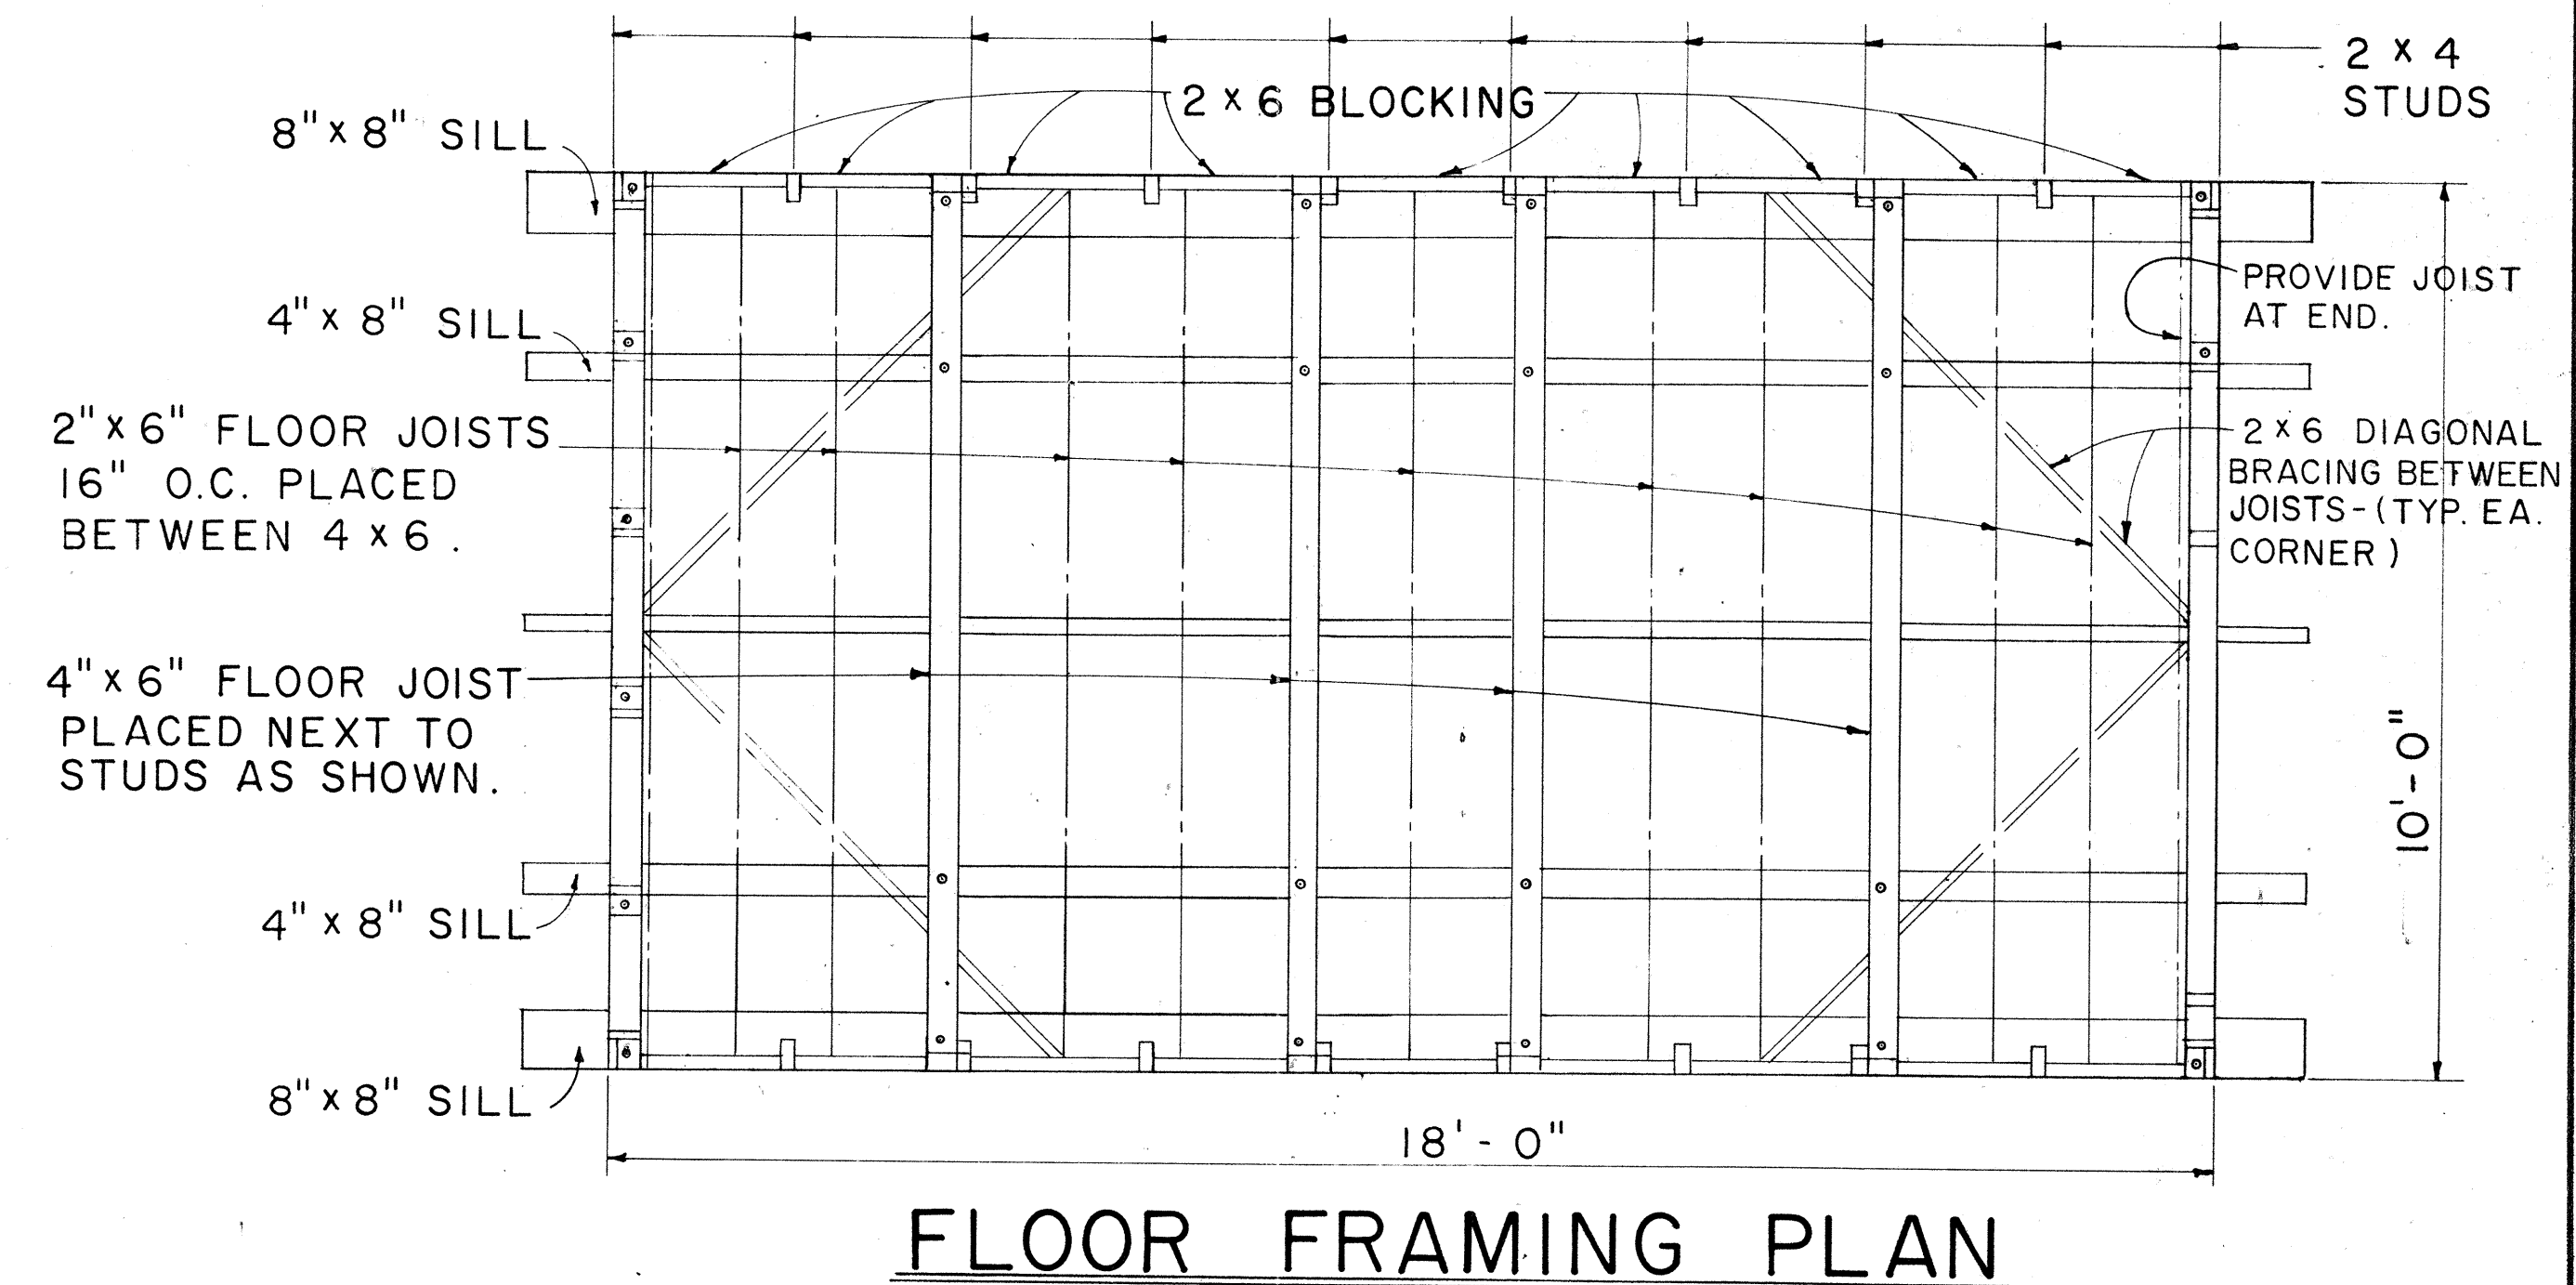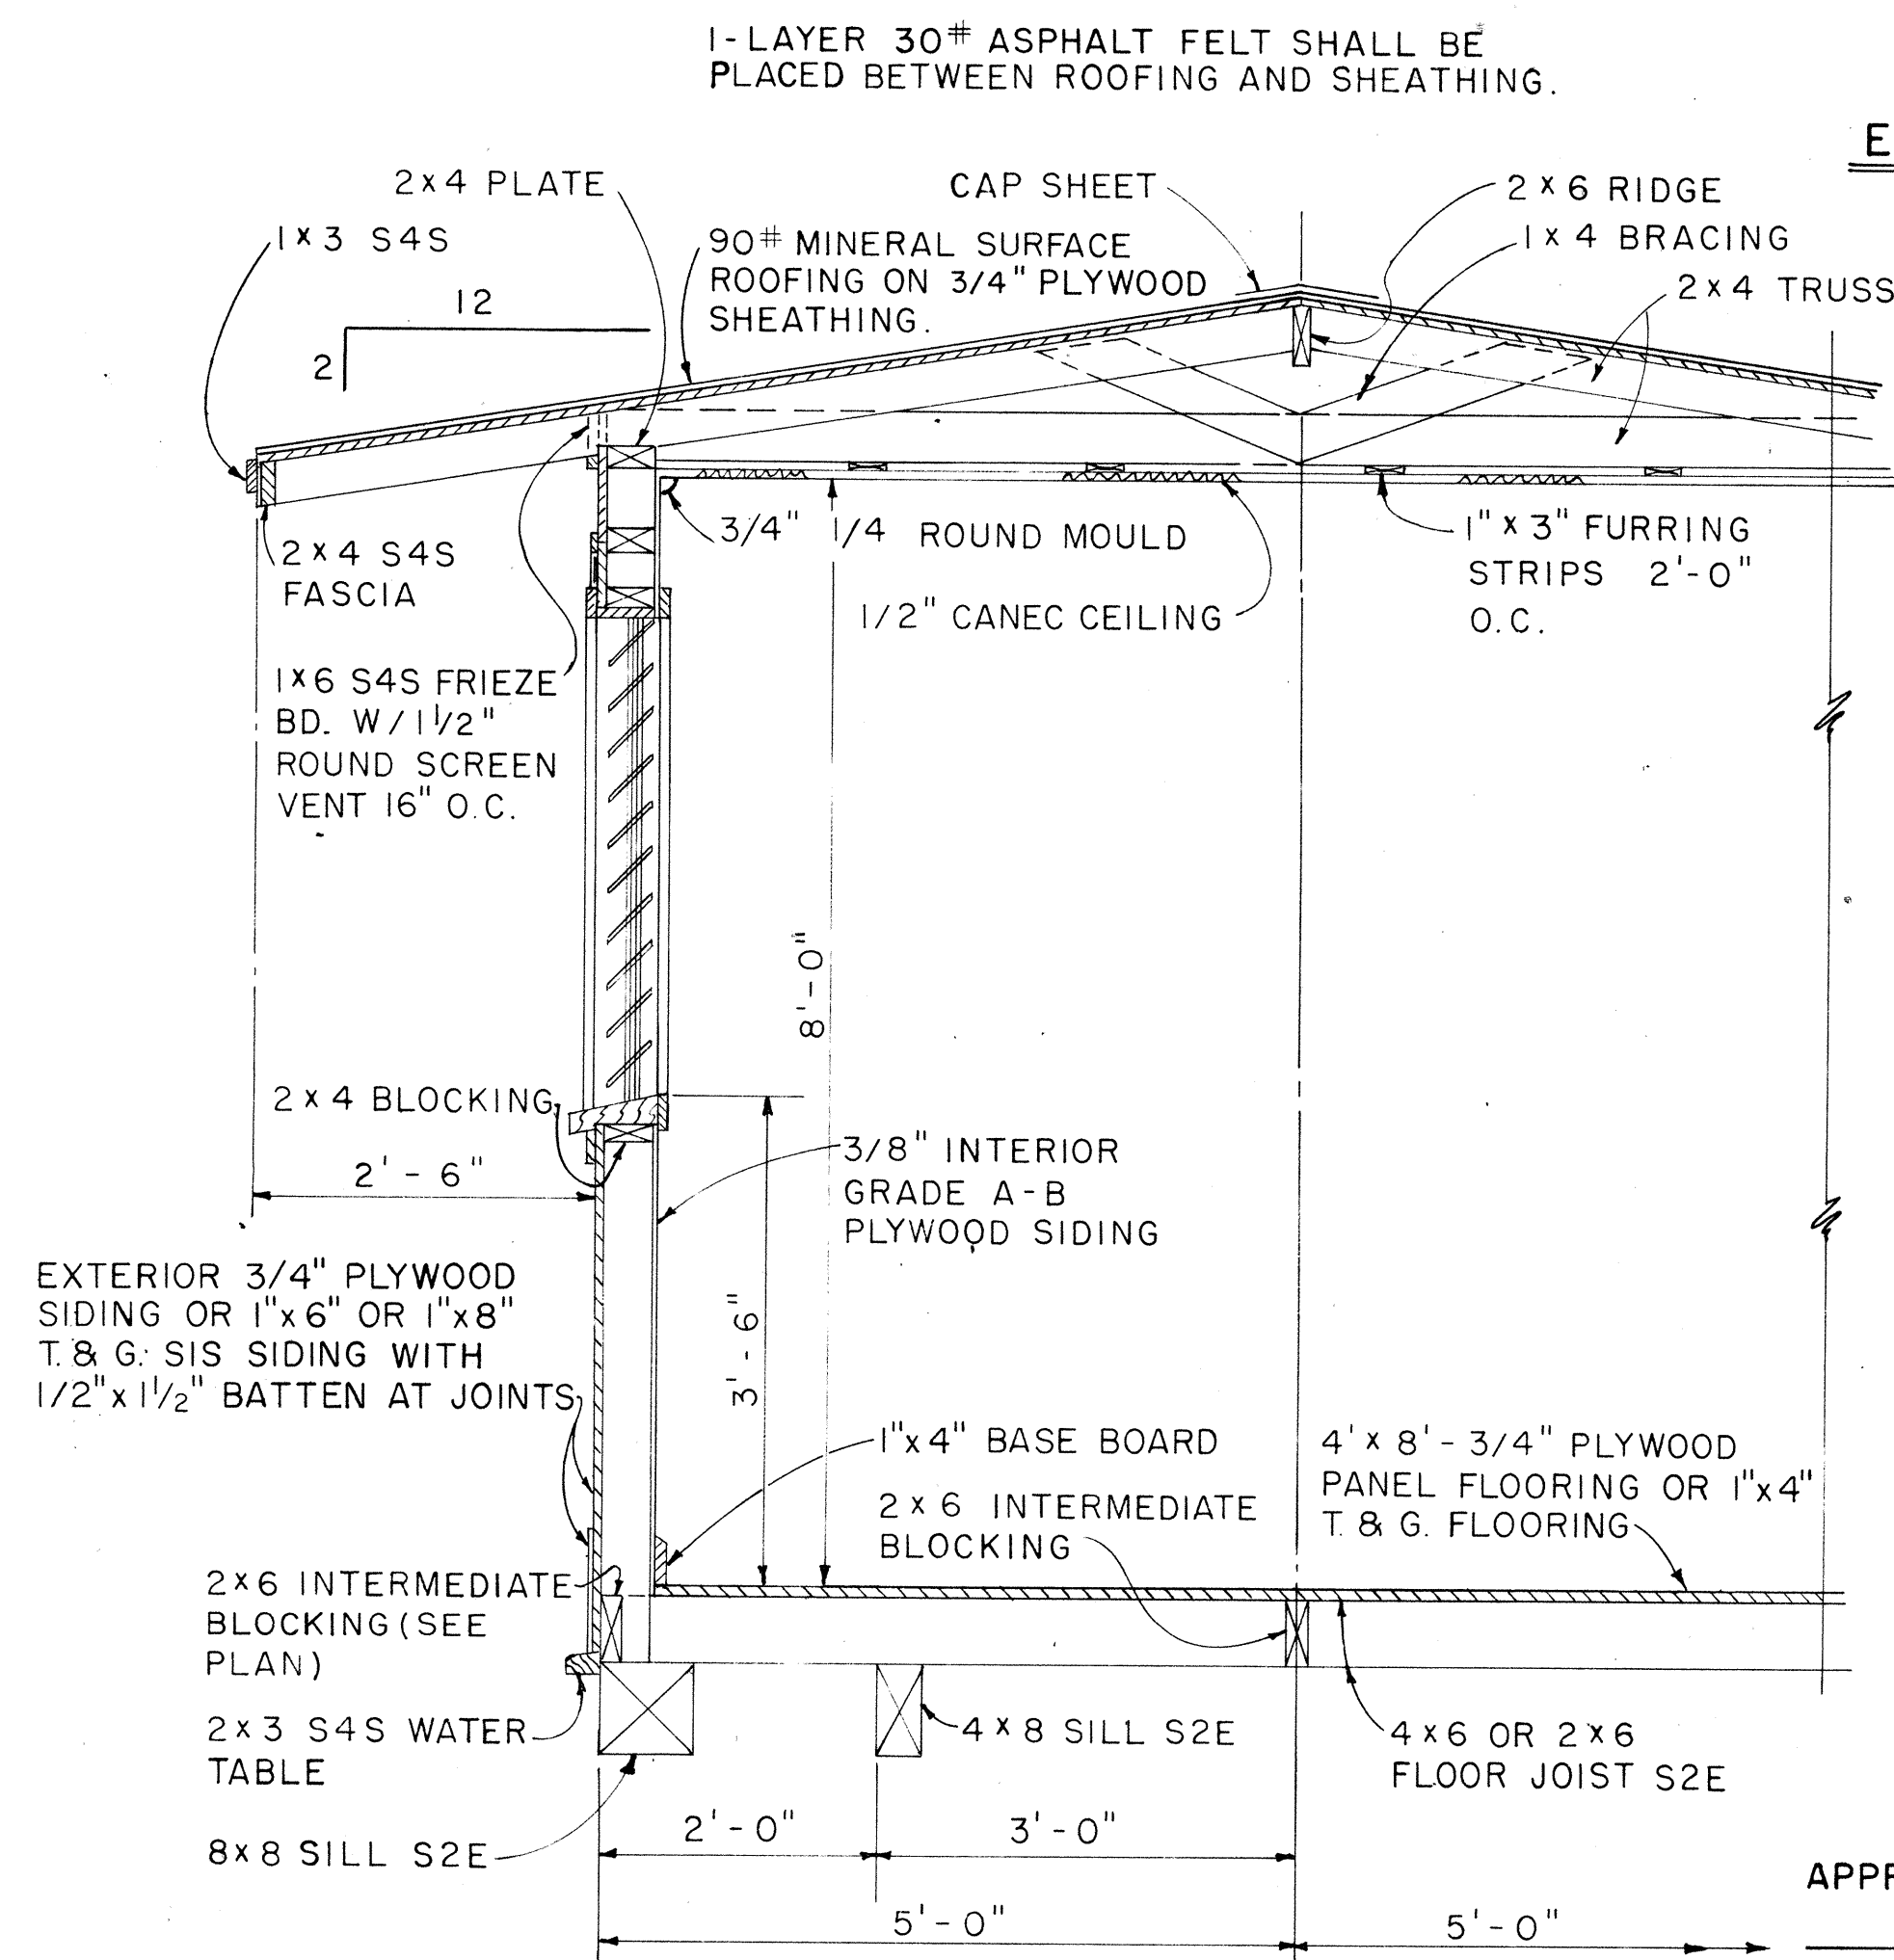

DATE	REVISION	APPROVED BY	DATE
DESIGNED BY	REVISION	APPROVED BY	DATE
NOTED BY	REVISION	APPROVED BY	DATE
CHECKED BY	REVISION	APPROVED BY	DATE
NO.			

NOTE:
ALL 3/4" PLYWOOD SHALL BE EXTERIOR GRADE A-C OR BETTER.

APPROVAL RECOMMENDED:
HIGHWAY DESIGN ENGINEER
12-4-69
DATE

APPROVED:
ASSISTANT CHIEF, ENGINEERING
12-10-69
DATE

NO.	REVISION	APPROVED BY	DATE


STATE OF HAWAII
DEPARTMENT OF TRANSPORTATION
HIGHWAYS DIVISION

PROJECT SITE LABORATORY


Scale: As Noted Date: Oct 30, 1970

SHEET No. 238 OF 25 SHEETS DD 636.3


FED. ROAD DIST. NO.	STATE	FED. AID PROJ. NO.	FISCAL YEAR	SHEET NO.	TOTAL SHEETS
HAWAII	HAW.	1-44-1(89)113	1971	50	362

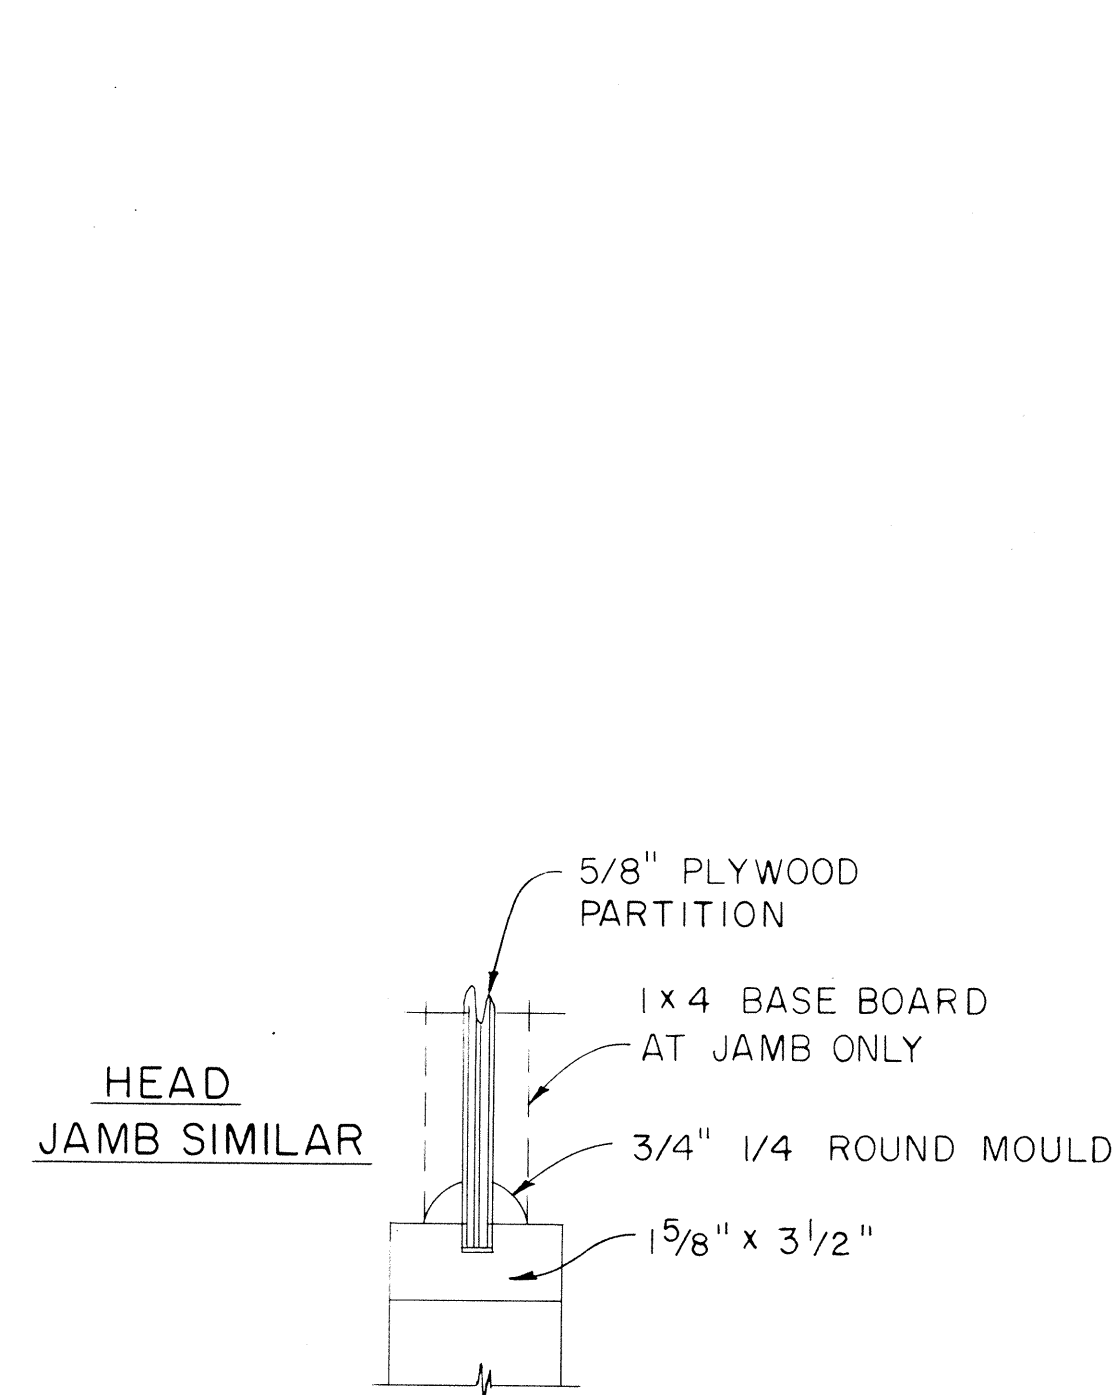


CASEMENT DETAIL
SCALE: 3" = 1'-0"

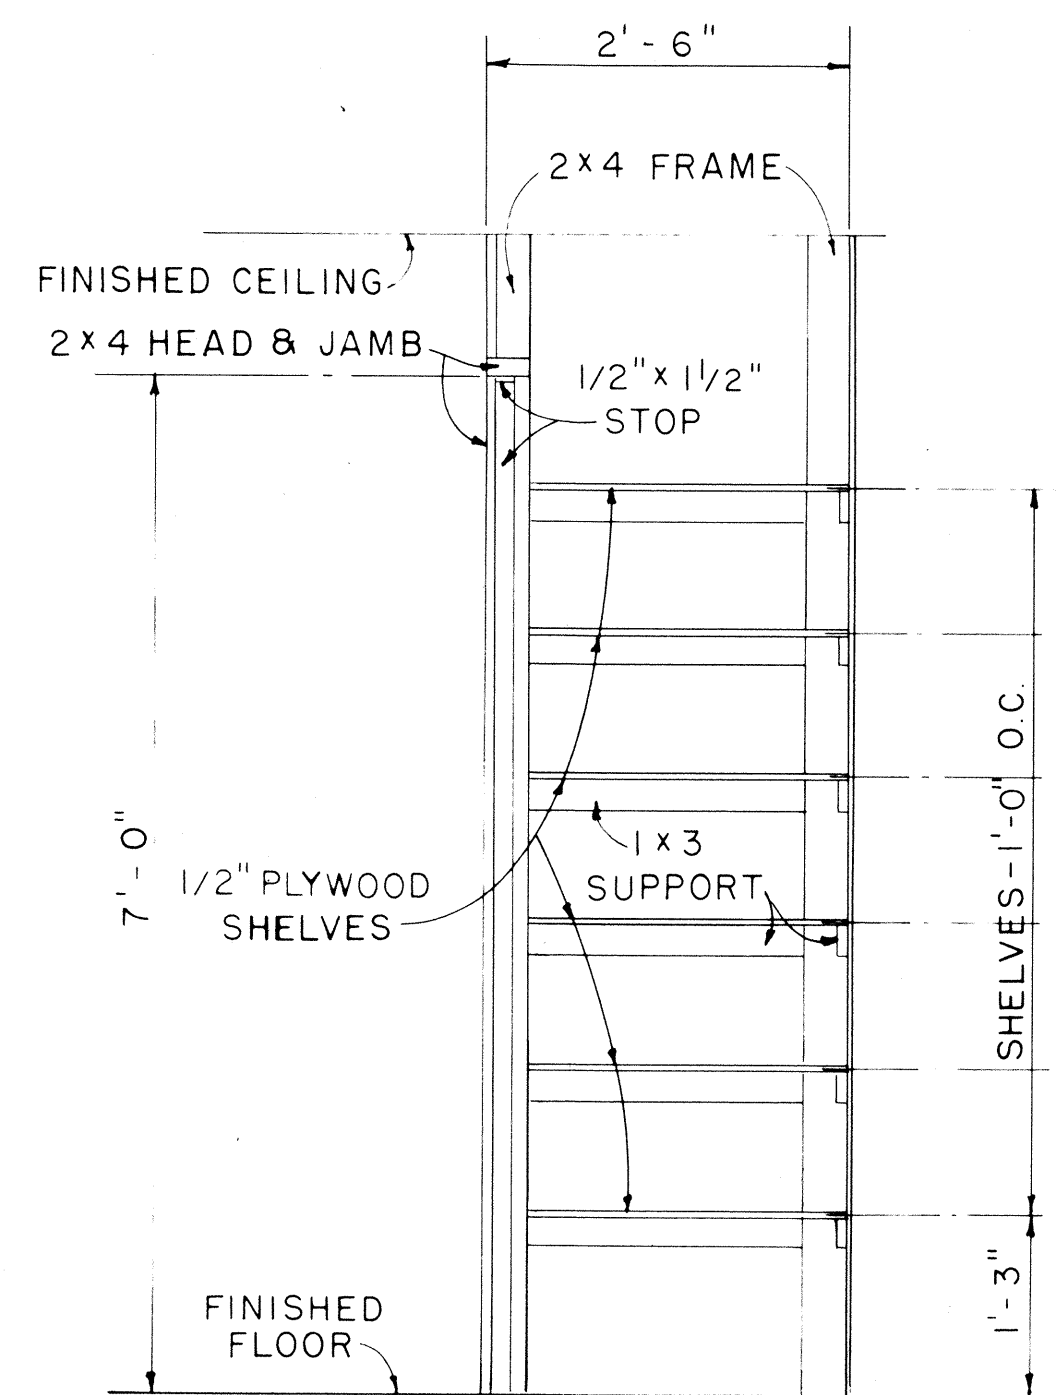


CABINET DETAIL
SCALE: 3/4" = 1'-0"

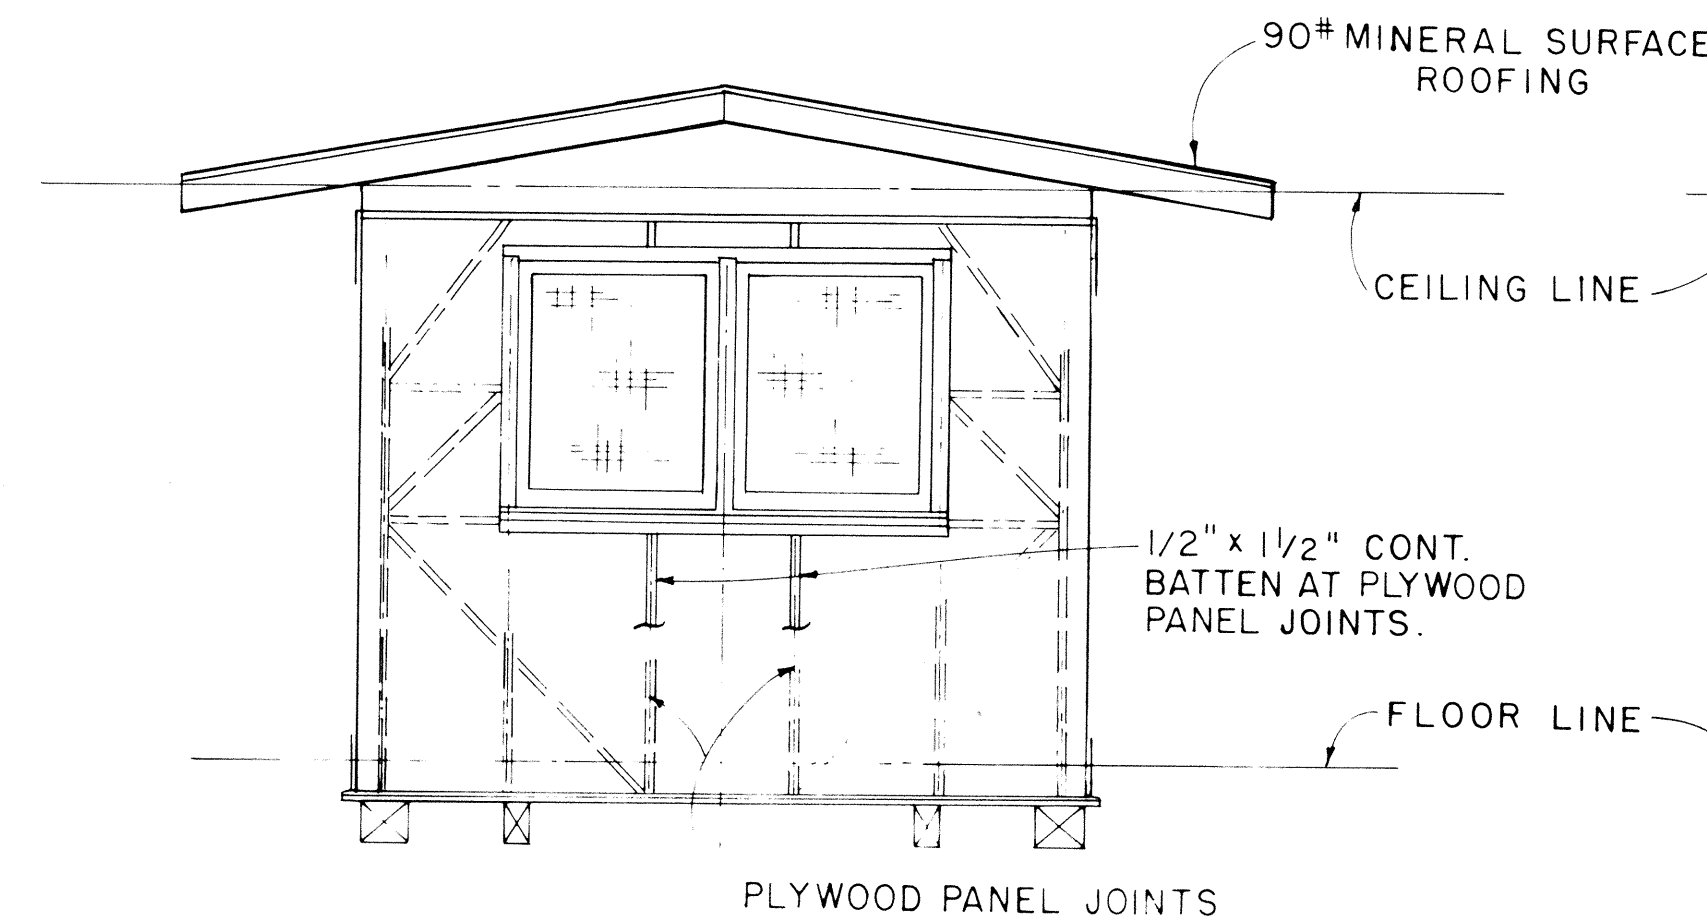


ELEVATION (D)
SCALE: 3/8" = 1'-0"

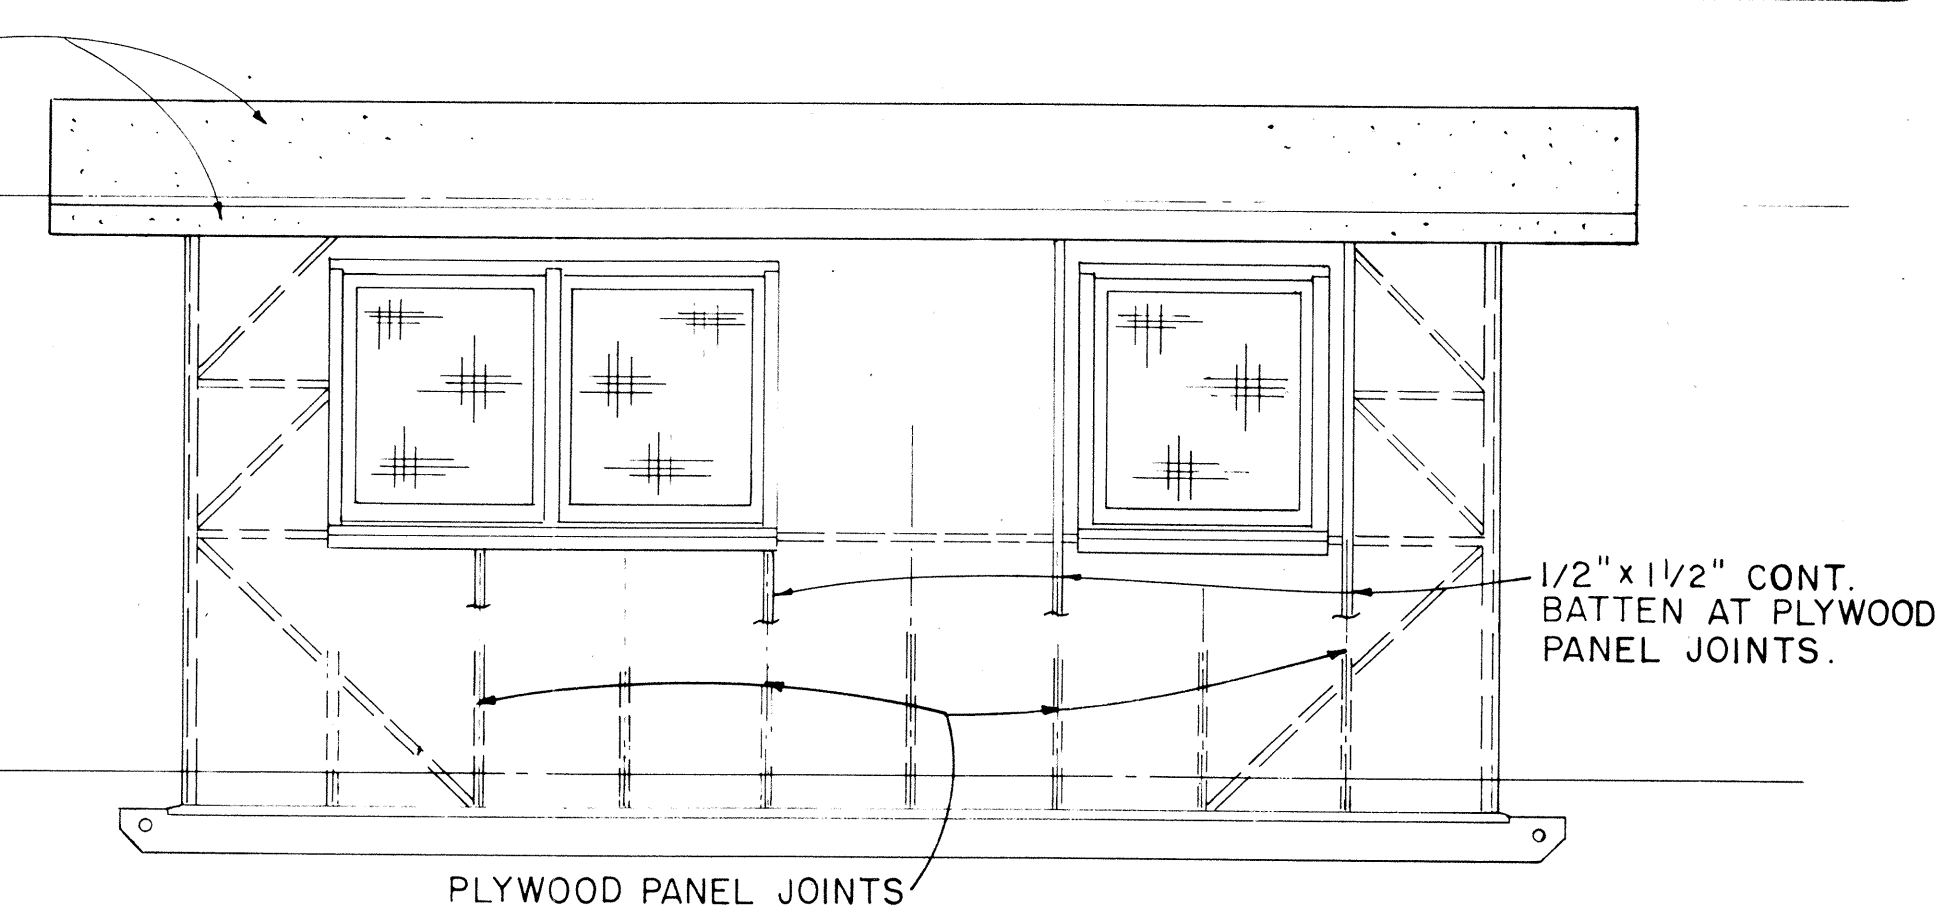

ELEVATION (C)
SCALE: 3/8" = 1'-0"

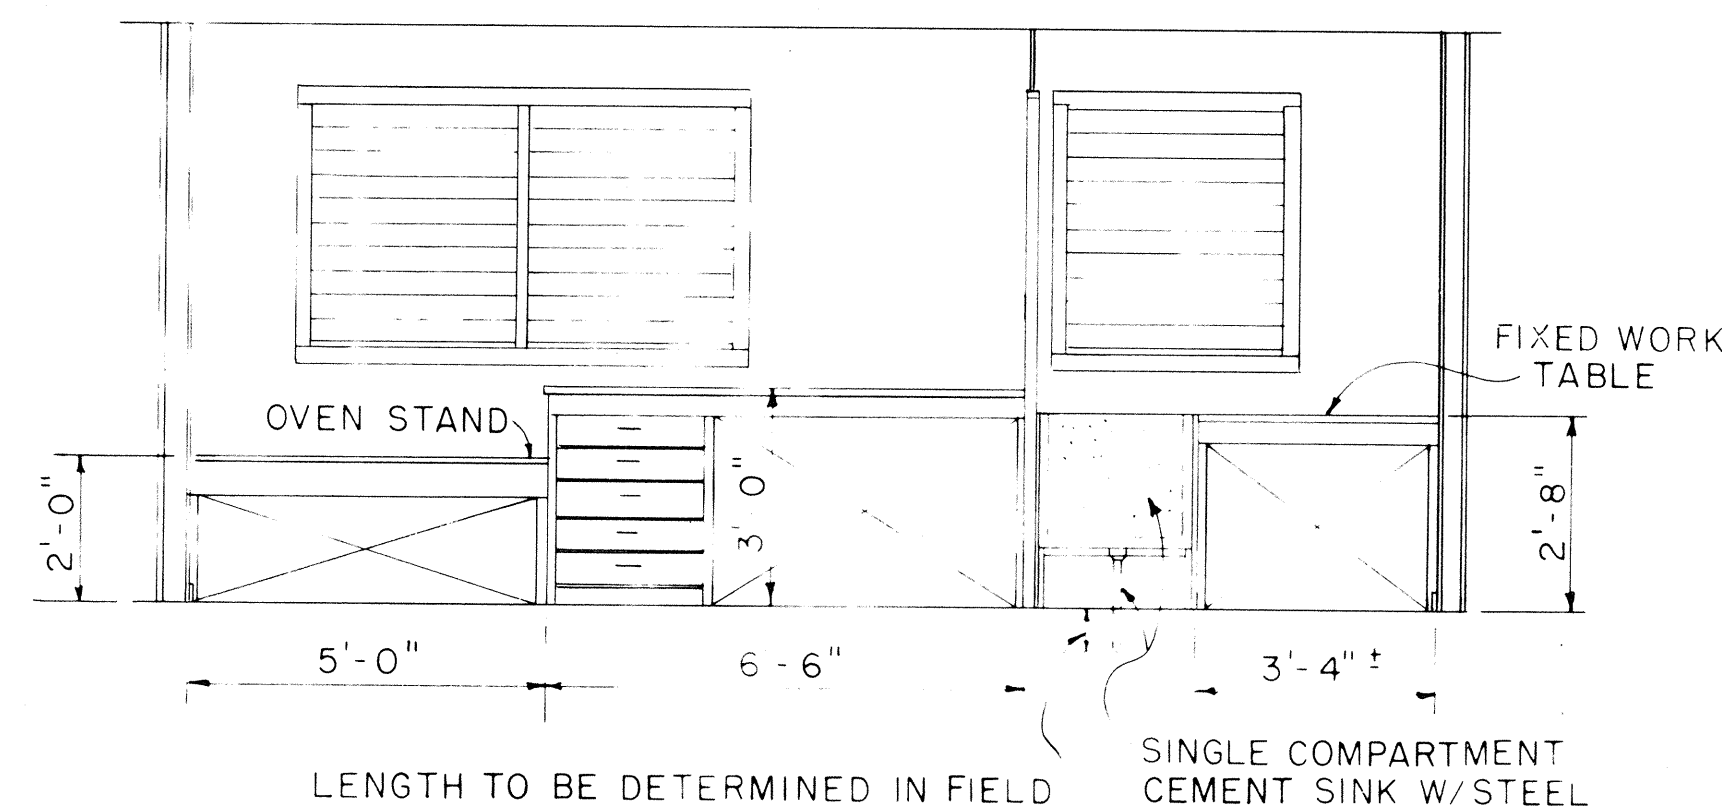


ELEVATION (C1)
SCALE: 3/8" = 1'-0"

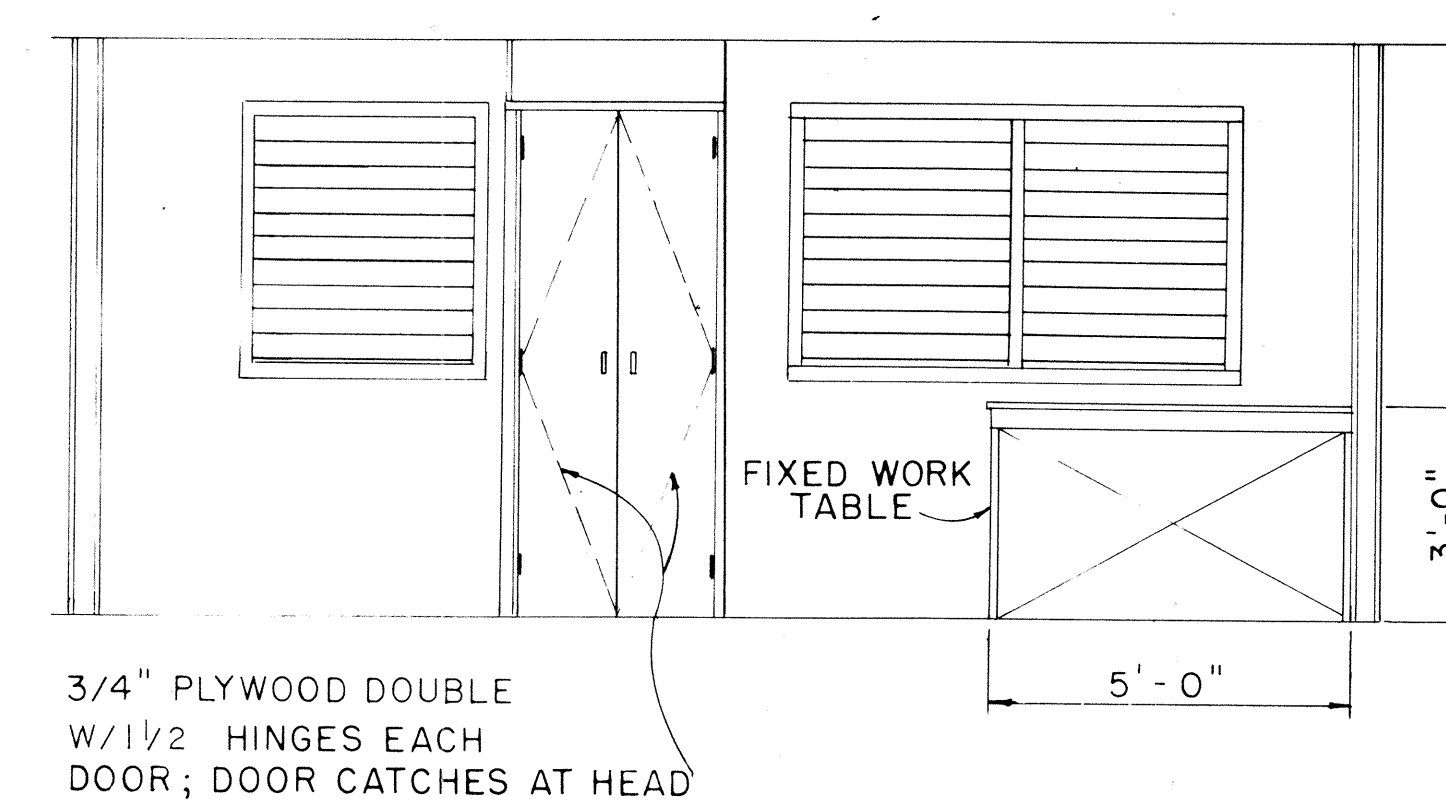

ELEVATION (A1)
SCALE: 3/8" = 1'-0"

ORIGINAL PLAN	SURVEY PLOTTED BY	DATE
NOTE BOOK	DRAWN BY	
	DESIGNED BY	
	CHECKED BY	


APPROVAL RECOMMENDED:
 12-4-69
HIGHWAY DESIGN ENGINEER DATE

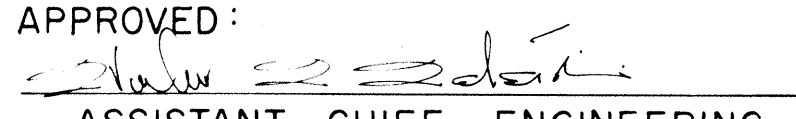APPROVED:
 12-10-69
ASSISTANT CHIEF, ENGINEERING DATE


NO.	REVISION	APPROVED BY	DATE

STATE OF HAWAII DEPARTMENT OF TRANSPORTATION HIGHWAYS DIVISION PROJECT SITE LABORATORY Scale: As Noted Date: Oct 30, 1970 SHEET No. 218 OF 25 SHEETS DD 636.4	
--	--


FED. ROAD DIST. NO.	STATE	FED. AID PROJ. NO.	FISCAL YEAR	SHEET NO.	TOTAL SHEETS
HAWAII	HAWAII	HA-11(89)13	1971	51	362

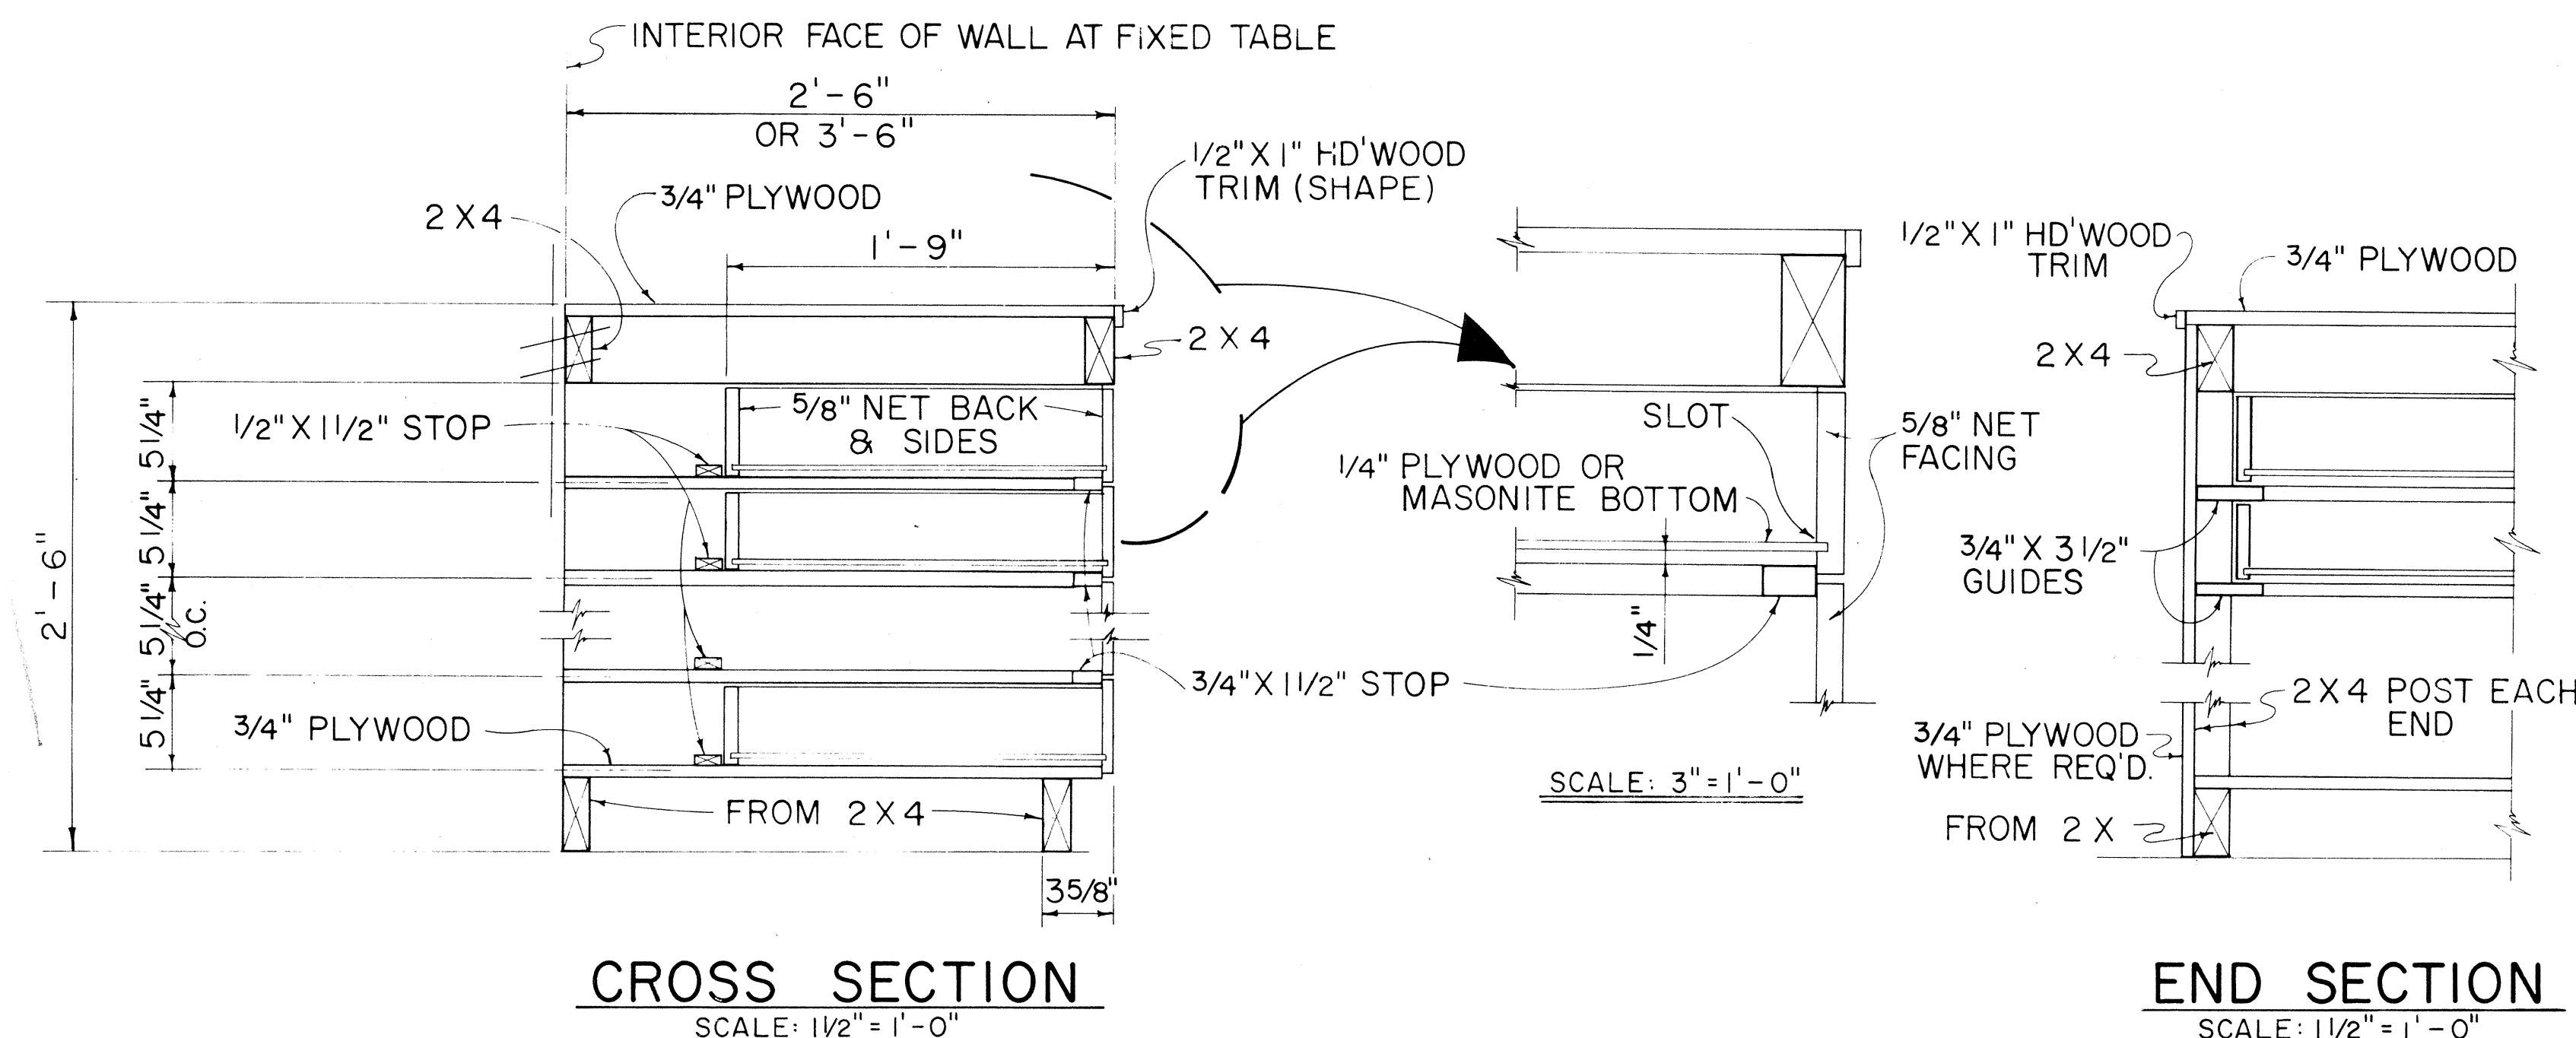


TYPICAL WORK TABLE DRAWER DETAIL

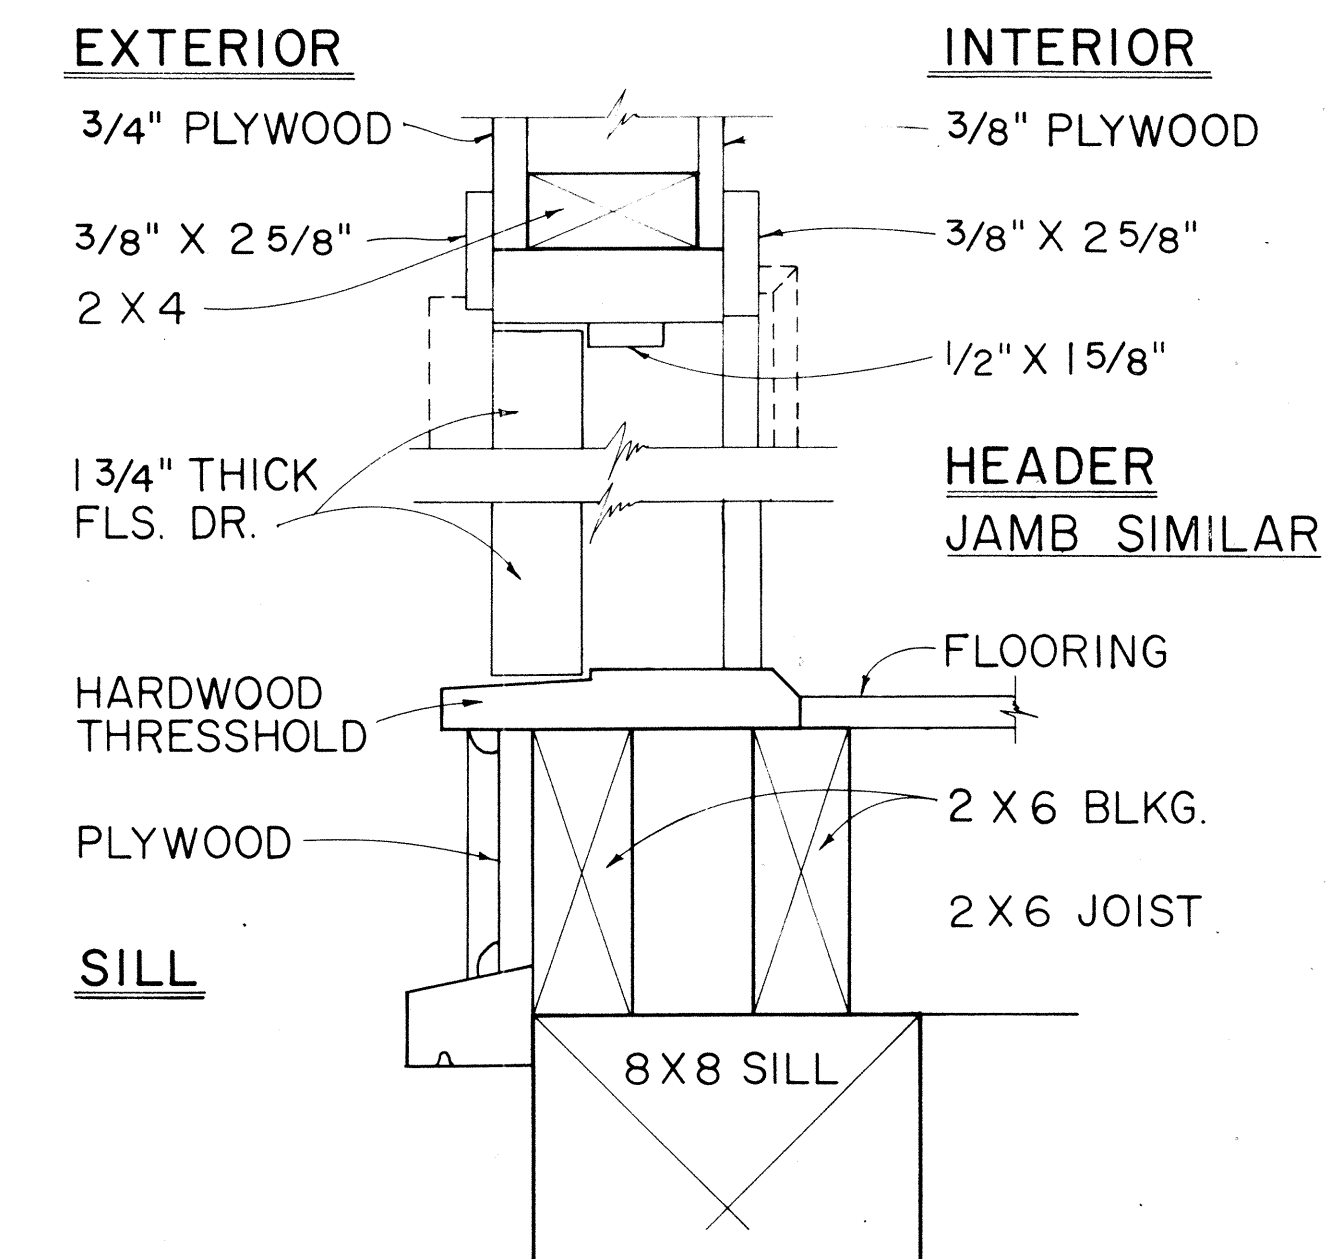

TYPICAL SINGLE OR DOUBLE EXTERIOR DOOR DETAIL

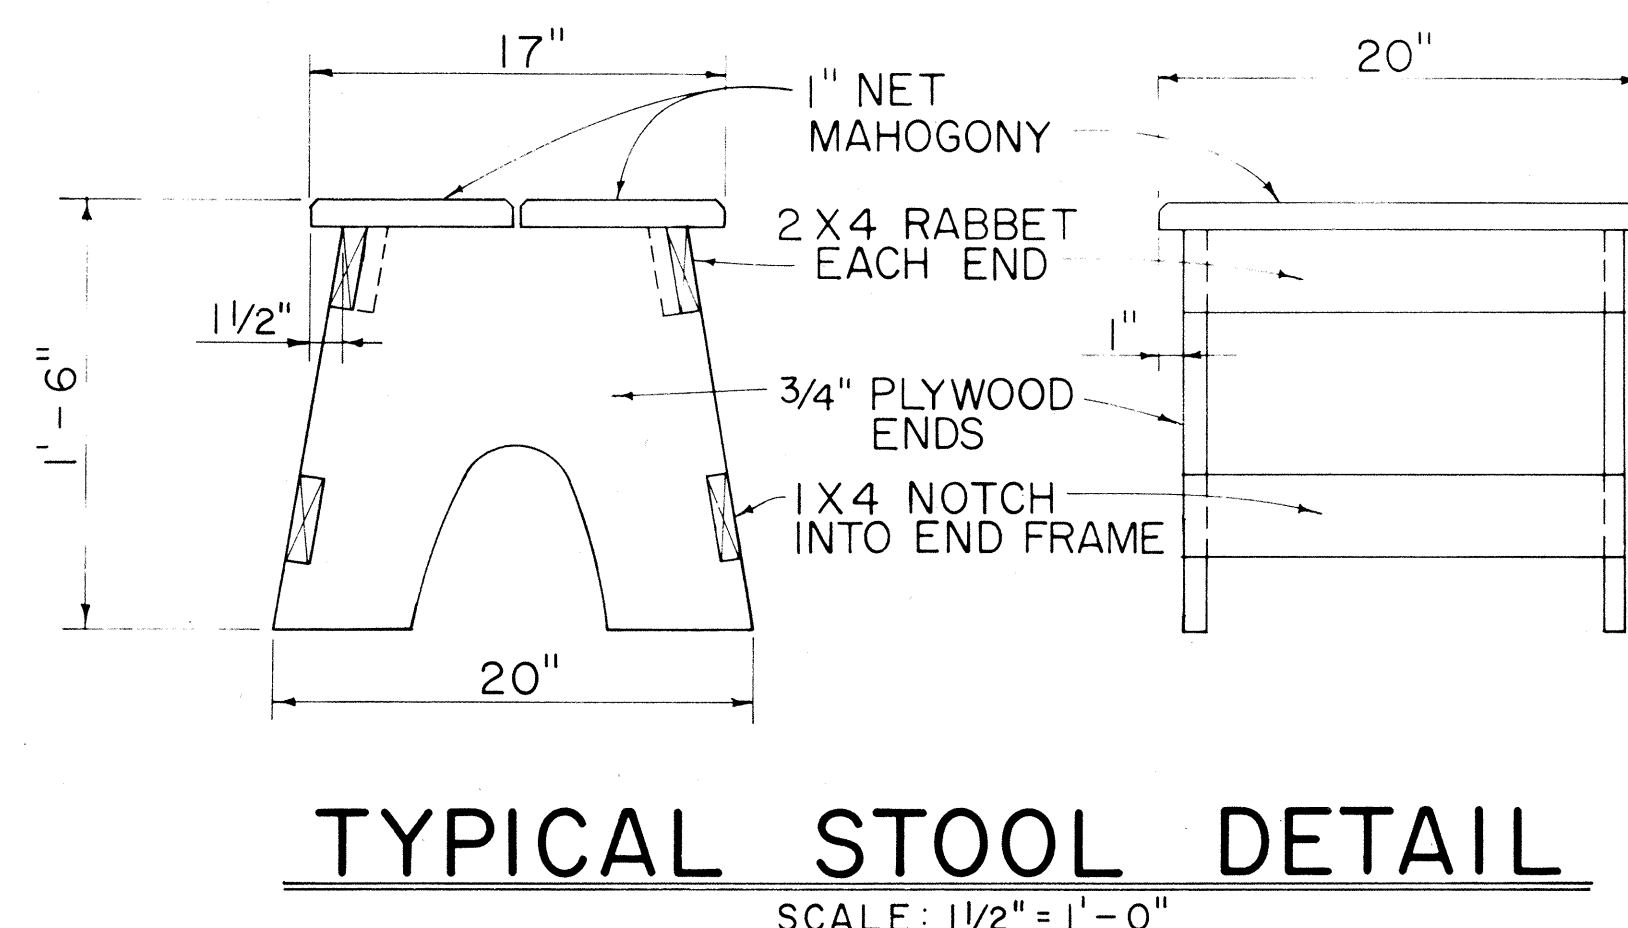


NOTE: CONTRACTOR MAY WITH THE APPROVAL OF THE ENGINEER FURNISH THE FIELD OFFICE OR PROJECT SITE LABORATORY WITH STOOLS OTHER THAN THE TYPE SHOWN IN THE DETAIL.

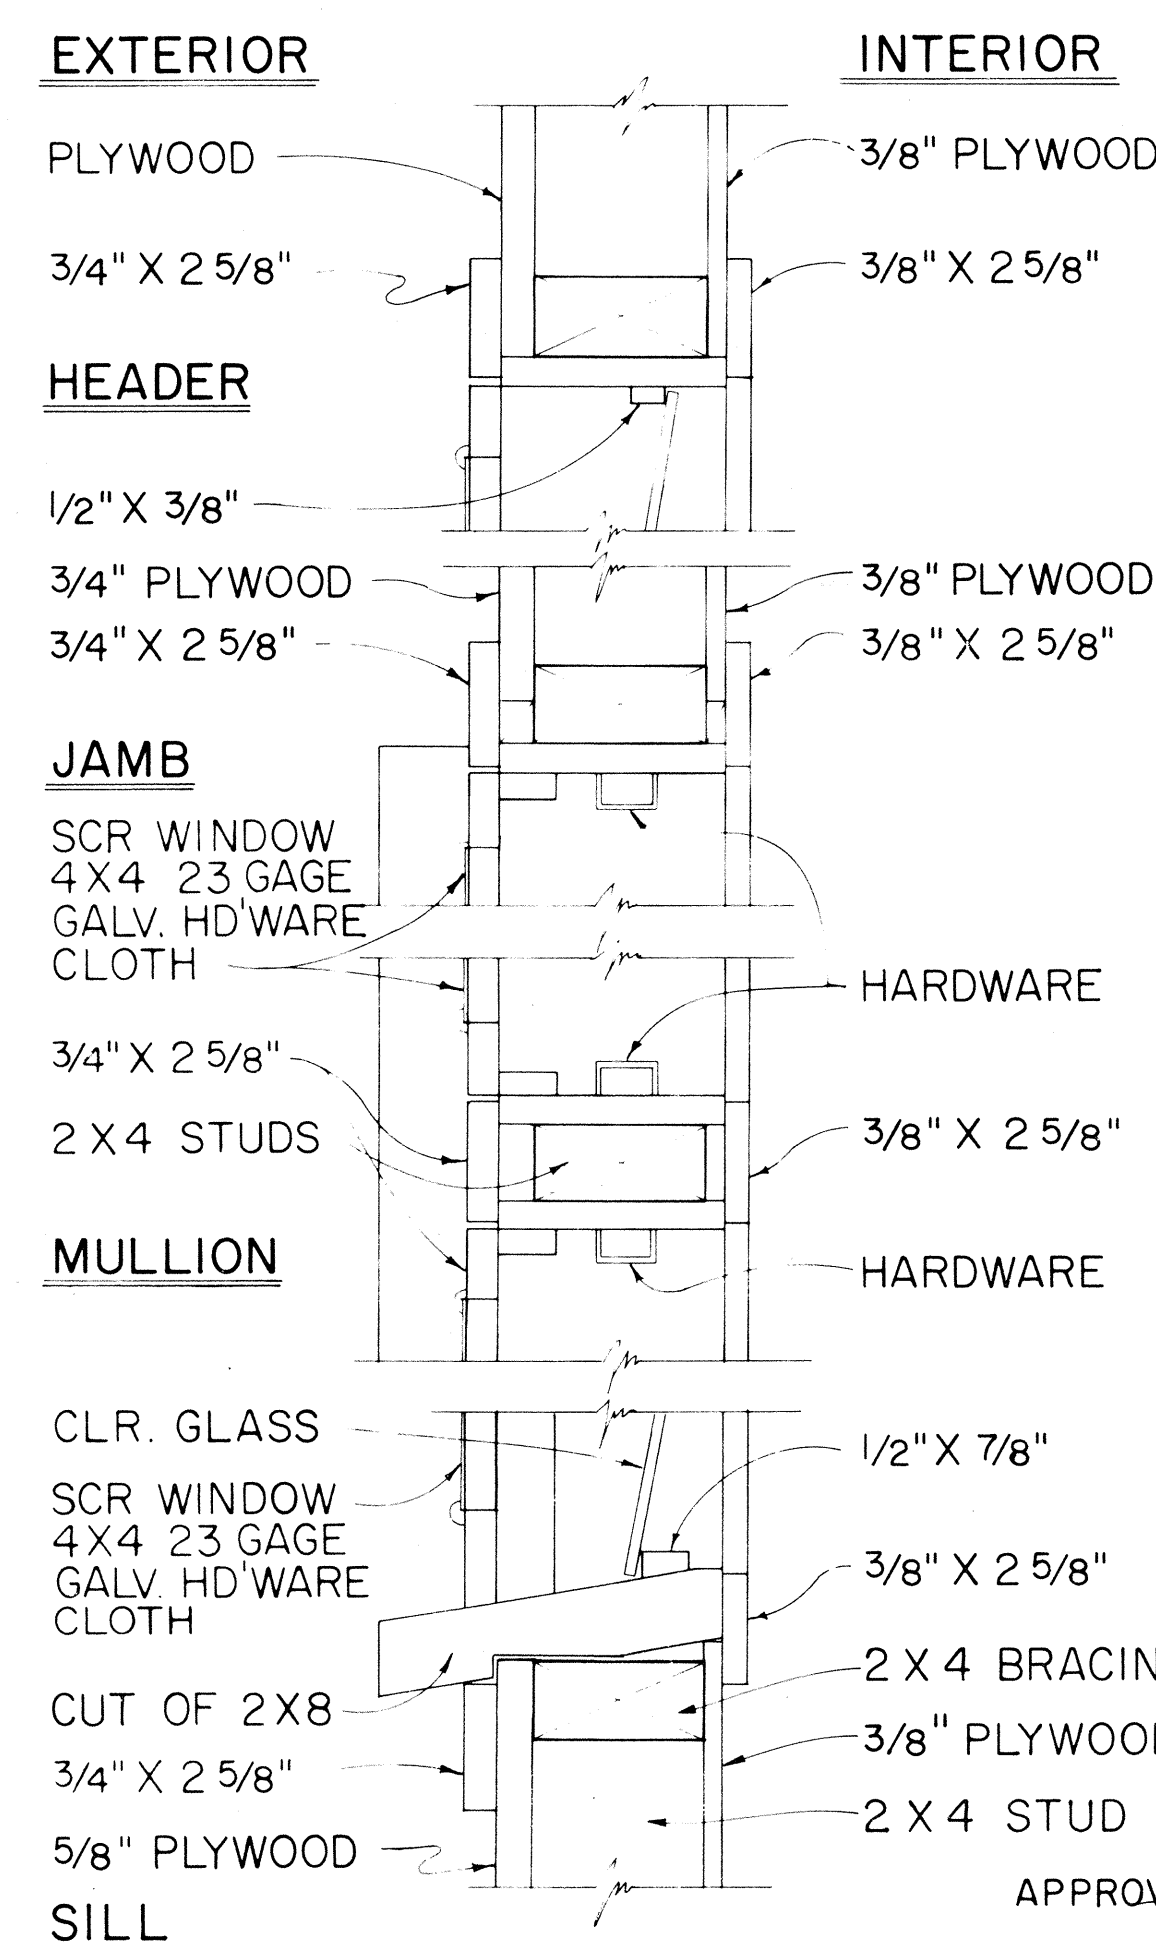

TYPICAL DETAIL JALOUSIES WINDOWS

APPROVAL RECOMMENDED:
M. H. HARRIS
 HIGHWAY DESIGN ENGINEER
 DATE: 12-4-69

APPROVED:
John J. J. J.
 ASSISTANT CHIEF, ENGINEERING
 DATE: 12-10-69

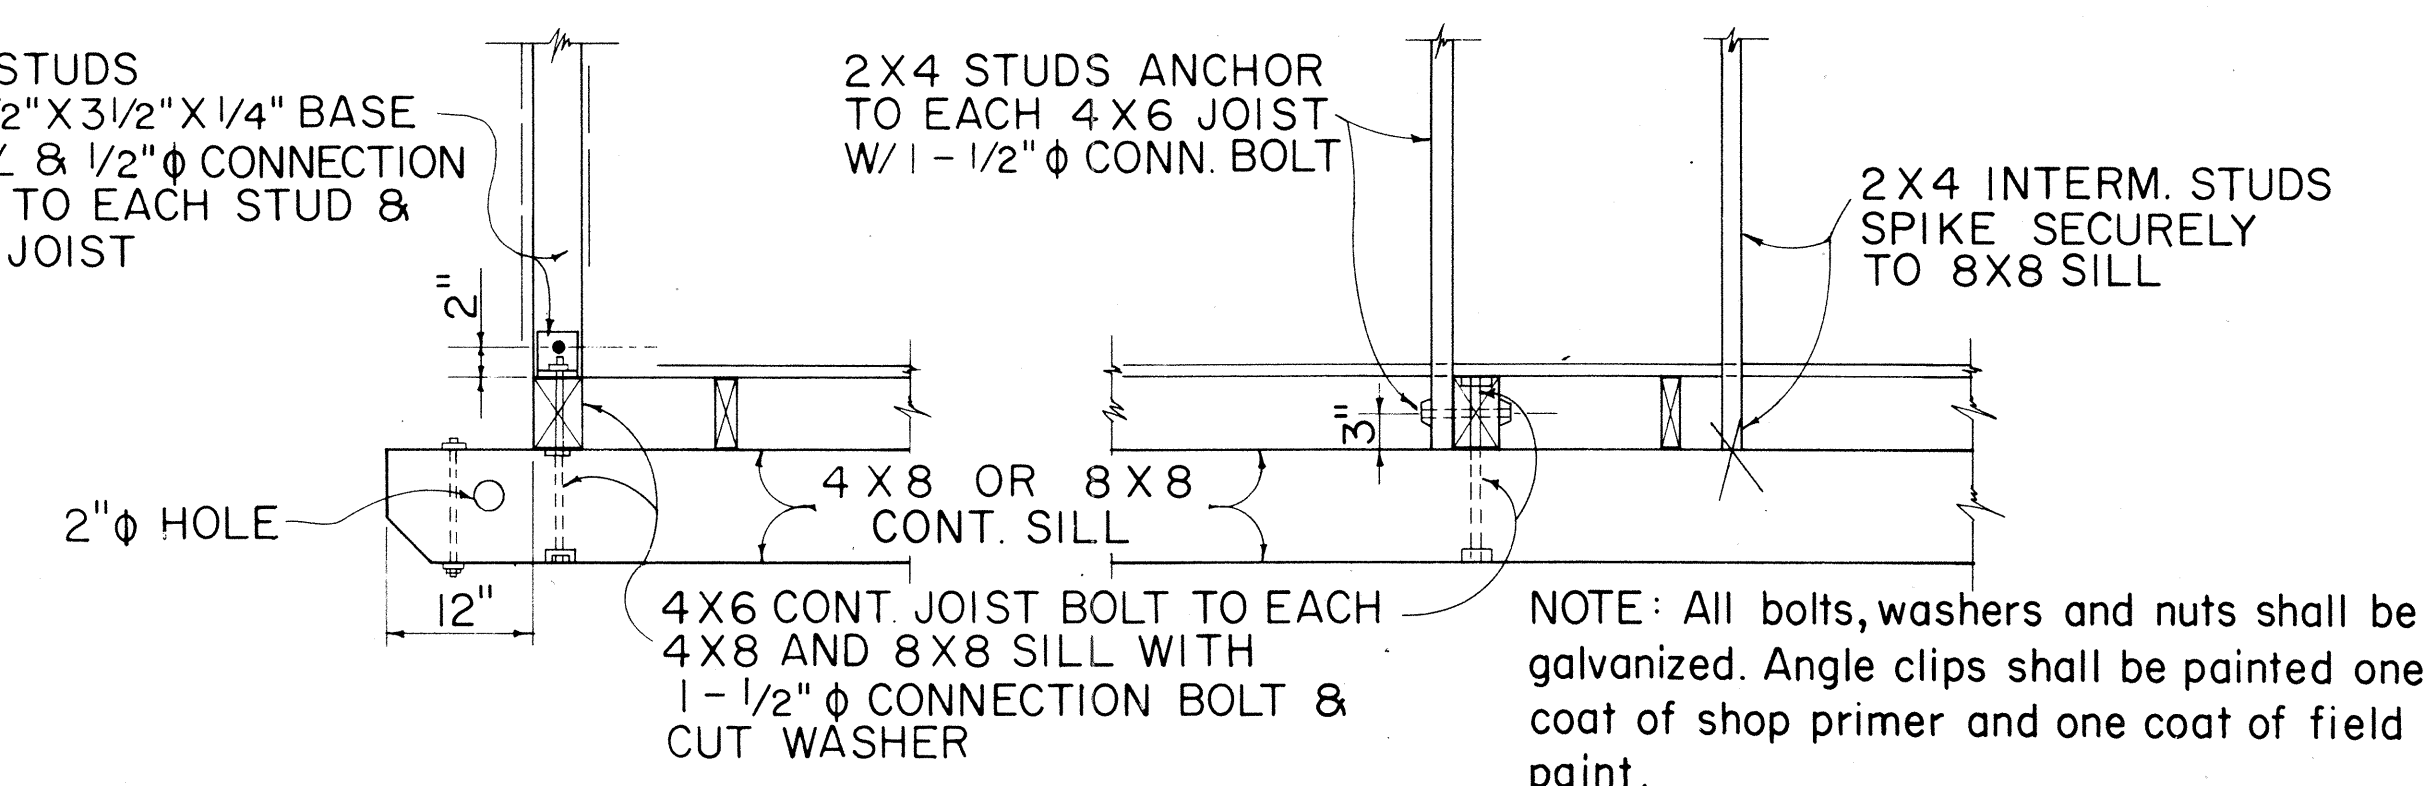

TYPICAL 2 X 4 STUD & 4 X 6 FLOOR JOIST BASE CONNECTION DETAILS

NO.	REVISION	APPROVED BY	DATE

STATE OF HAWAII DEPARTMENT OF TRANSPORTATION HIGHWAYS DIVISION	
FIELD OFFICE & PROJECT SITE LABORATORY	
Scale: As Noted	Date: Oct. 30, 1970
SHEET No. 25B OF 25 SHEETS DD 636.5	