

BRIDGE NOTES

a. DESIGN SPECIFICATIONS

"STANDARD SPECIFICATIONS FOR HIGHWAY BRIDGES," AASHTO TENTH EDITION (1969) WITH SUBSEQUENT ADDITIONS AND MODIFICATIONS BY THE STATE OF HAWAII, DEPARTMENT OF TRANSPORTATION.

b. DESIGN LIVE LOAD

HS 20-44 OR INTERSTATE LOADING

c. DESIGN STRESSES



FC = 3000 PSI SEE SHEETS 105, 145, 165 AND STANDARD PILE
 FC = 1200 PSI DRAWING FOR NOTES ON CONCRETE DESIGN
 n = 10 STRESSES & TYPES OF PRESTRESSING STEEL FOR
 FS = 20,000 PSI (TENSION) PRESTRESSED CONG. GIRDERS, C.I.P. CONG. BOX
 GIRDERS & PRESTRESSED CONG. PILES.

d. MATERIALS

ALL REINFORCING STEEL TO BE ASTM DESIGNATION A615 GRADE 40.
 SEE NOTE "C" ABOVE REGARDING PRESTRESSING STEEL.

e. PILE CAPACITY


32 TON PILES, SEE NOTES ON SHEET 35

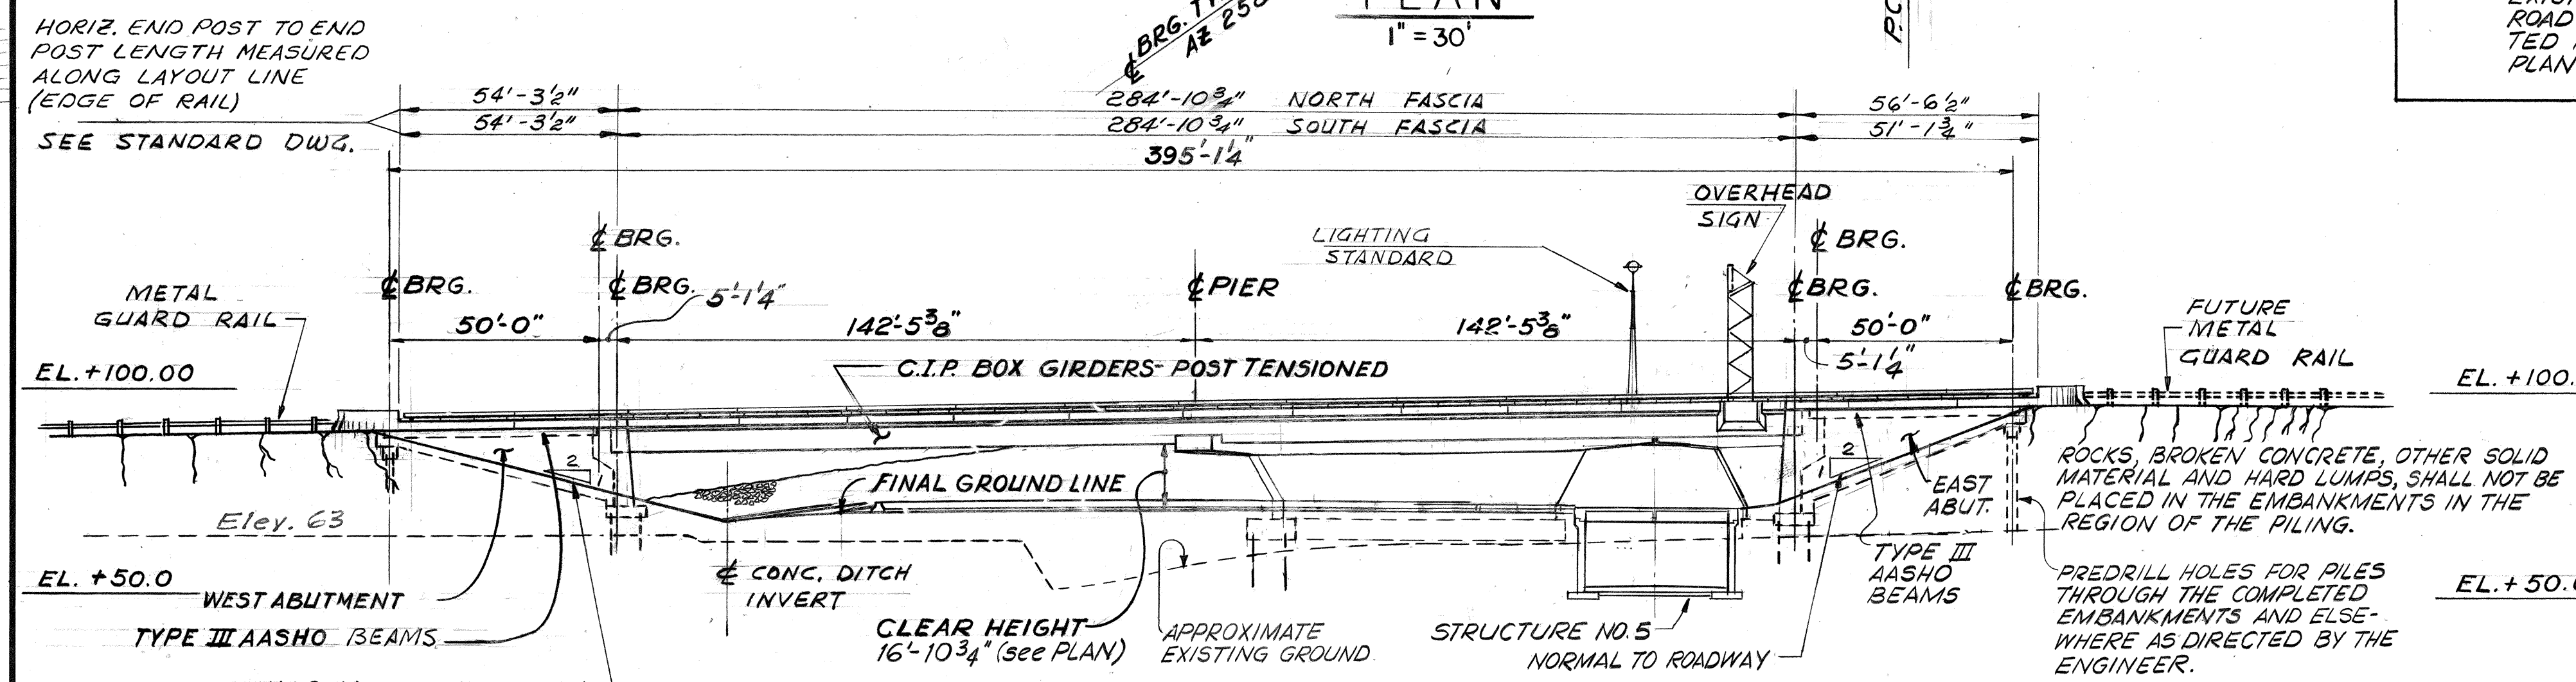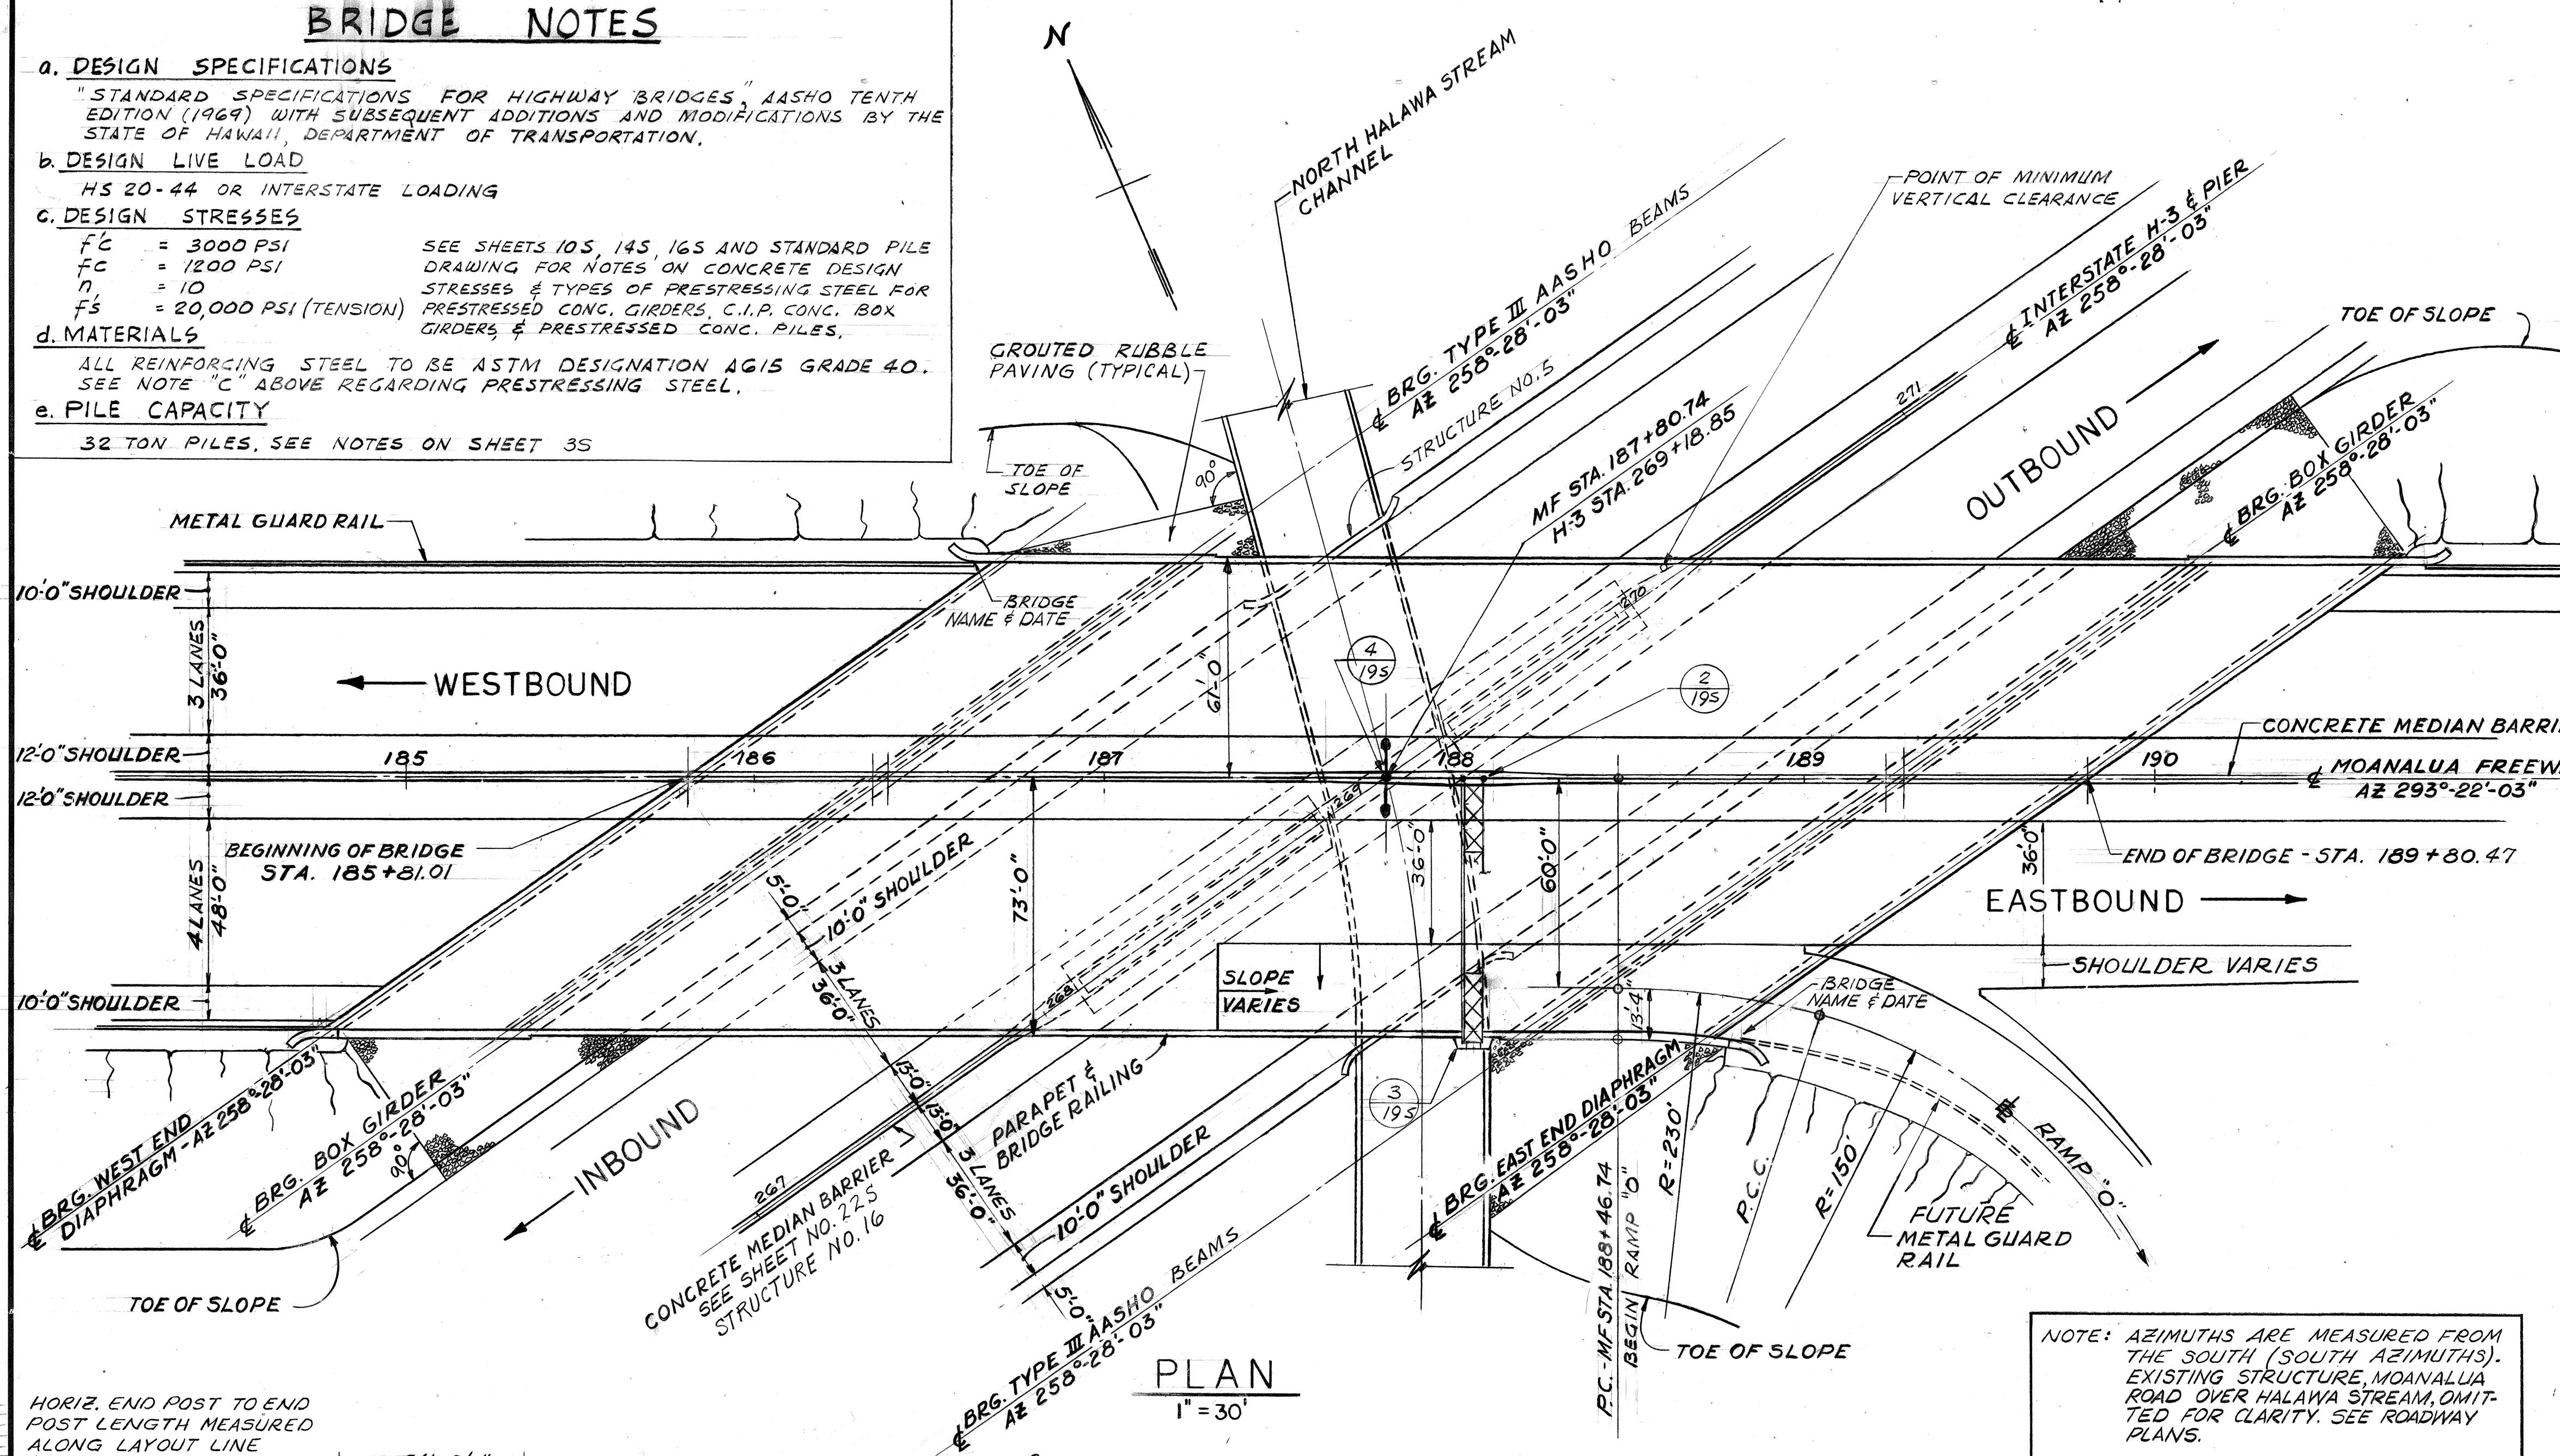

NOTE
 DIMENSIONS ON ELEVATION ARE
 MEASURED PARALLEL TO &
 MOANALUA FREEWAY UNLESS
 OTHERWISE NOTED.

ELEVATION
 1" = 30'

FED. ROAD DIST. NO.	STATE	FED. AID PROJ. NO.	FISCAL YEAR	SHEET NO.	TOTAL SHEETS
HAWAII	HAW.	I-H1-1(89):13	1971	182	362

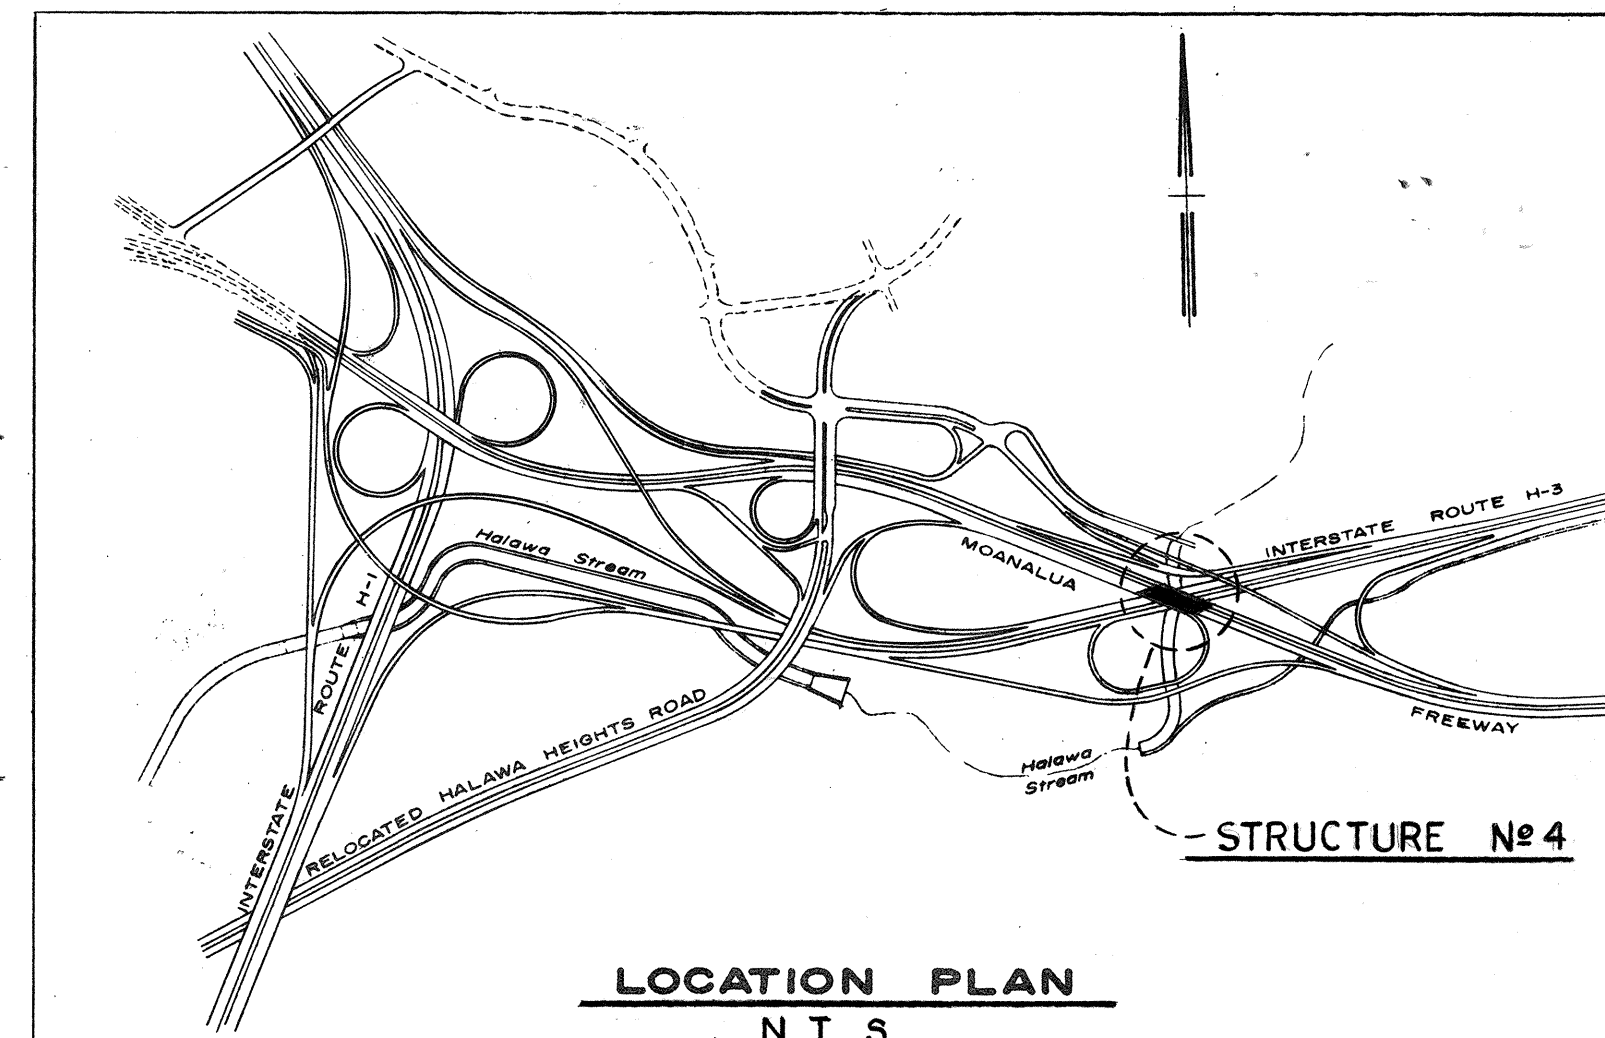


ESTIMATED QUANTITIES

ITEM NO.	ITEM	UNIT	QUANTITY
206.60	STRUCTURE EXCAVATION FOR BRIDGES	C.Y.	3010
503.071	CONCRETE IN STRUCTURE NO. 4 EXCEPT FOOTINGS & PRESTRESSED CAST-IN-PLACE STRUCTURES	L.S.	(1820 C.Y.)
503.072	CONCRETE IN STRUCTURE NO. 4 FOOTINGS	L.S.	(1220 C.Y.)
504.15	TYPE III PRESTRESSED CONCRETE GIRDERS	L.S.	(1540 L.F.)
504.50	POST TENSIONING OPERATION FOR CAST-IN-PLACE STRUCTURES	L.S.	(212,400 LBS)
504.60	CONCRETE FOR PRESTRESSED CAST-IN-PLACE STRUCTURES	L.S.	(3210 C.Y.)
505.001	PILE LOAD TESTS	EA.	4
505.040	PRECAST, PRESTRESSED CONG. PILES, FURNISHED	L.F.	42250
505.400	PRECAST, PRESTRESSED CONG. PILES, DRIVEN	L.F.	36300
507.10	METAL BRIDGE RAILING-ONE RAIL ON PARAPET	L.F.	786
507.70	CONC. BRIDGE PARAPET, INCLUDING END POST	L.F.	826
602.011	REINFORCING STEEL IN STRUCTURE NO. 4	L.S.	(1091,000 LBS)
606.415	GUARD RAIL, TYPE 4F	L.F.	405
612.01	GROUTED RUBBLE PAVING	C.Y.	460 C.Y.
505.700	DRILLED HOLES FOR STRUCTURE NO. 4	L.F.	1900
505.800	DRIVING TEST PILES FOR STRUCTURE NO. 4	L.F.	2050
506.03	TFE STRUCTURAL BEARING EXPANSION PAD ASSEMBLY	L.S.	(36 UNITS)

NOTE: AZIMUTHS ARE MEASURED FROM THE SOUTH (SOUTH AZIMUTHS). EXISTING STRUCTURE, MOANALUA ROAD OVER HALAWA STREAM, OMITTED FOR CLARITY. SEE ROADWAY PLANS.

THIS WORK WAS PREPARED BY ME OR UNDER MY SUPERVISION.
 Wm. J. Armento

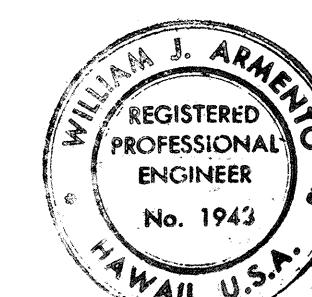

STATE OF HAWAII
 DEPARTMENT OF TRANSPORTATION
 HIGHWAYS DIVISION





HALAWA INTERCHANGE
 STRUCTURE NO. 4
 MOANALUA FREEWAY OVER H-3
 GENERAL PLAN

PROJ. No. I-H1-1(89):13 DATE: MAY 1971


SHEET No. 15 OF 195 SHEETS

182

FED. ROAD DIST. NO.	STATE	FED. AID PROJ. NO.	FISCAL YEAR	SHEET NO.	TOTAL SHEETS
HAWAII	HAW.	I-H-1(89):13	1971	183	362

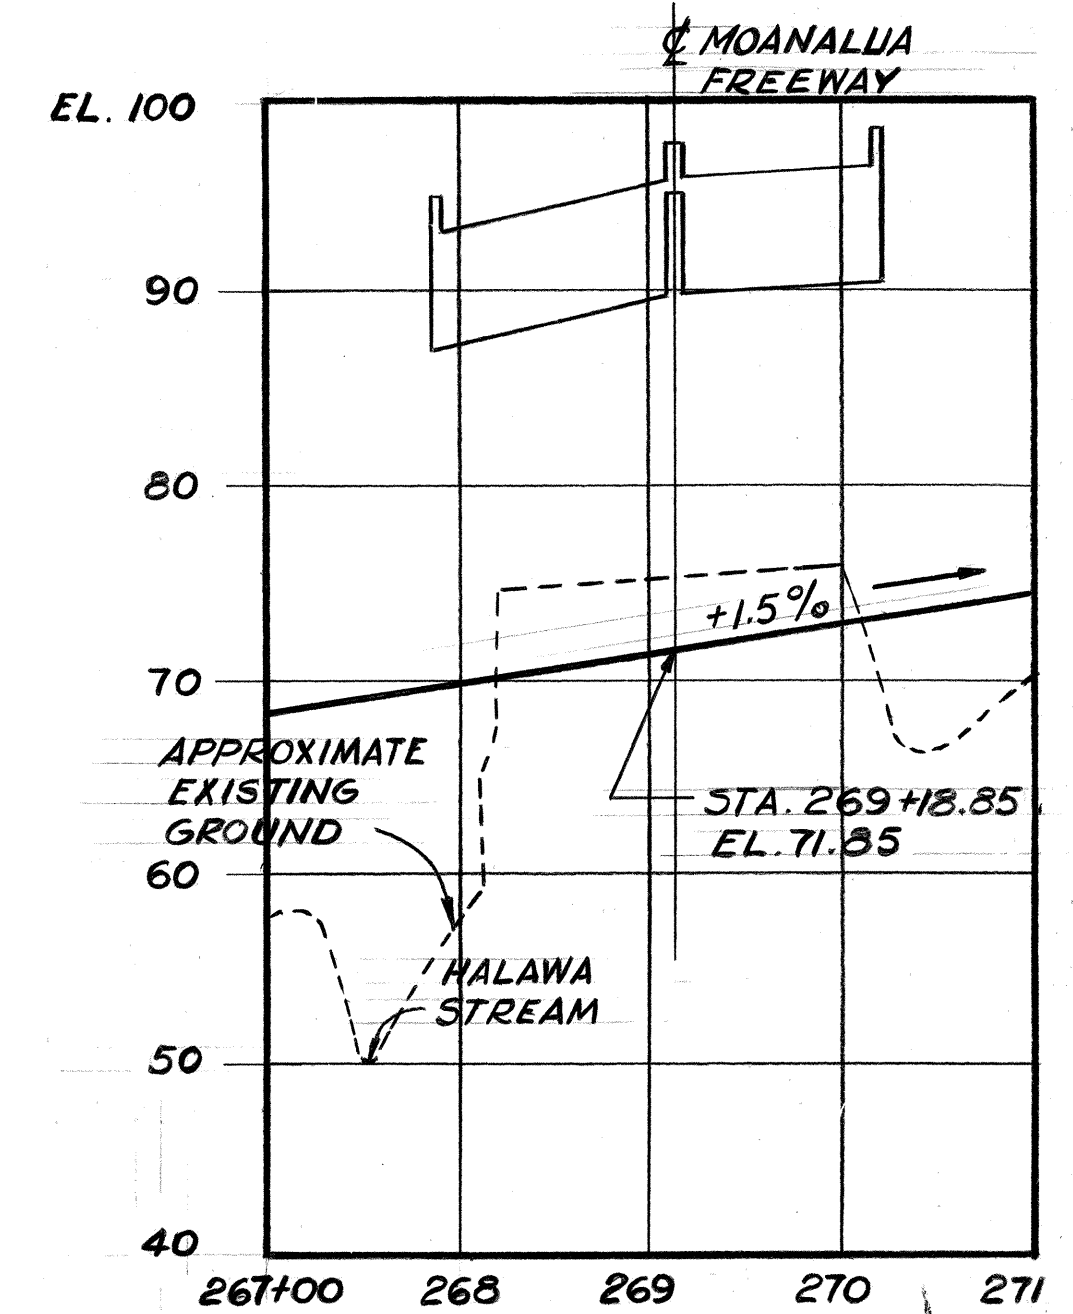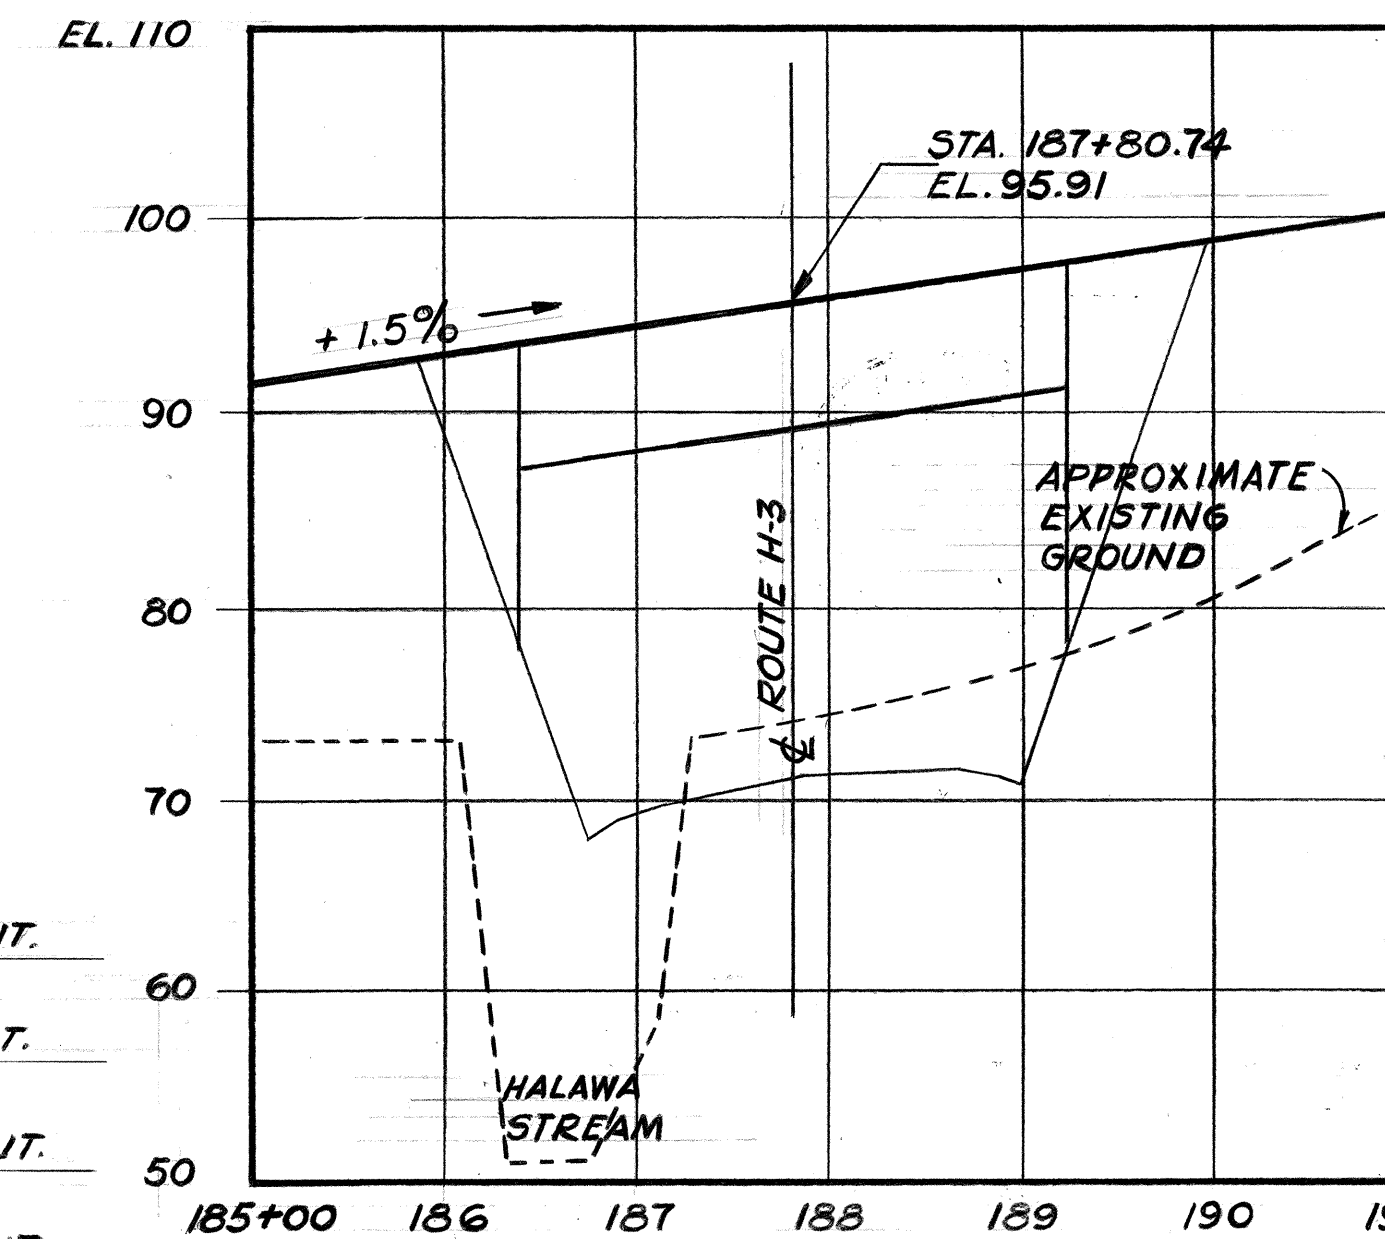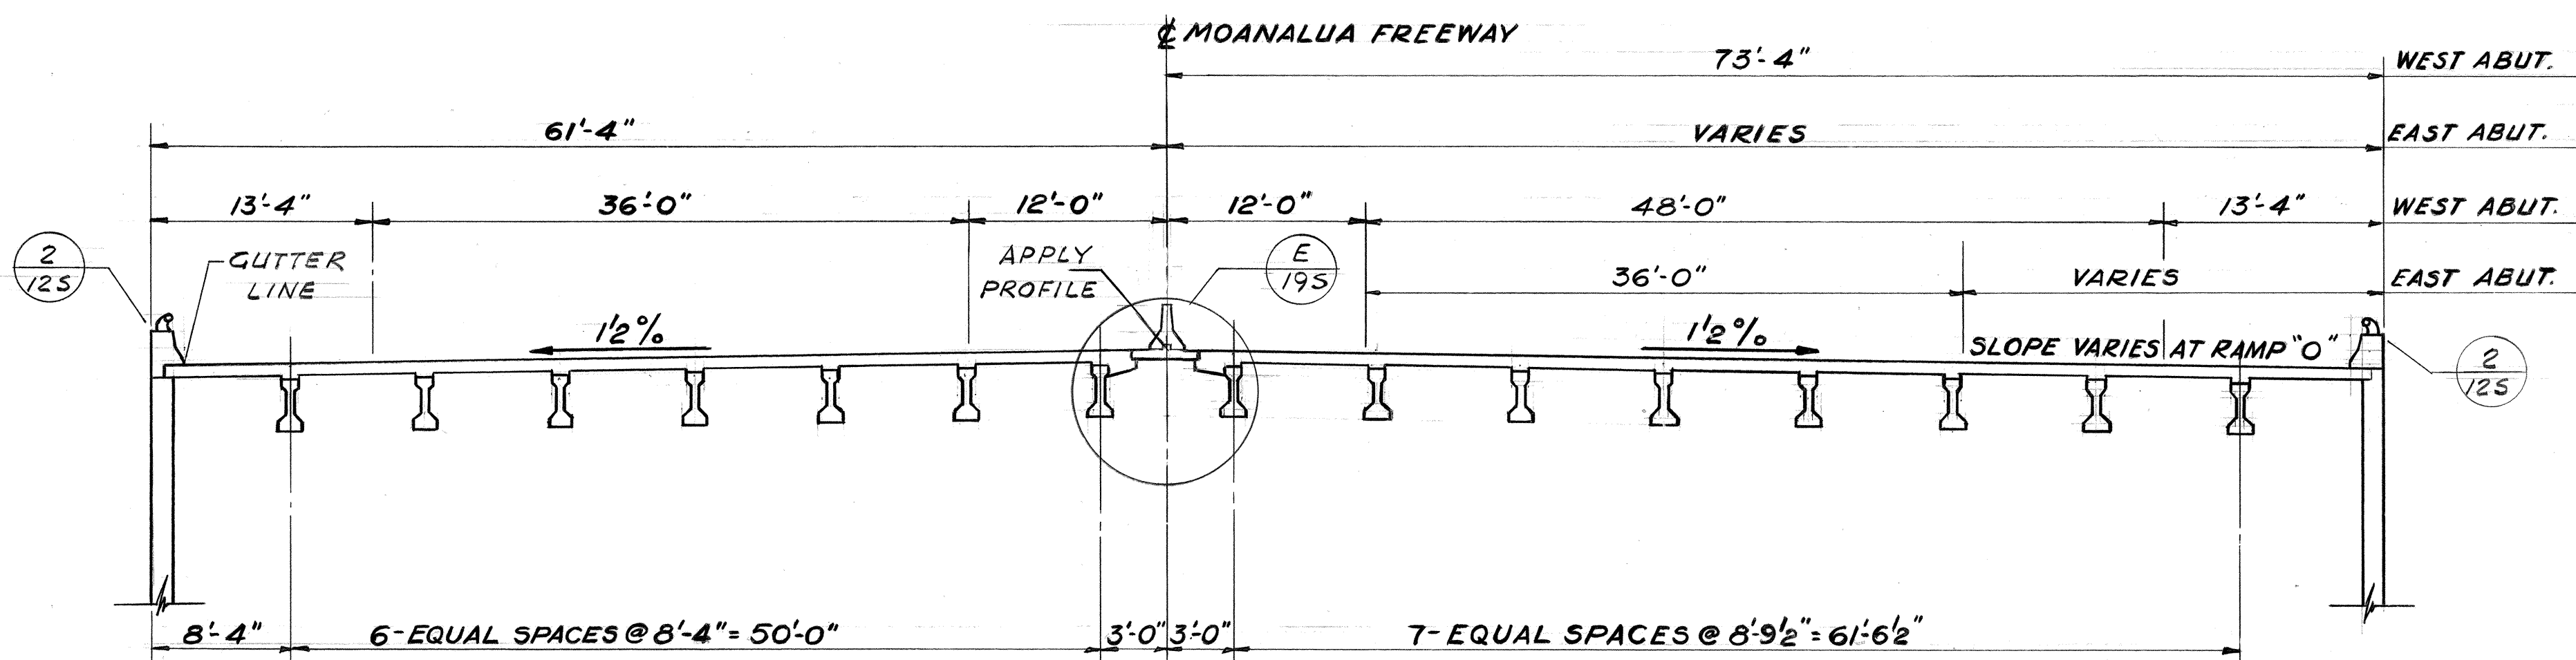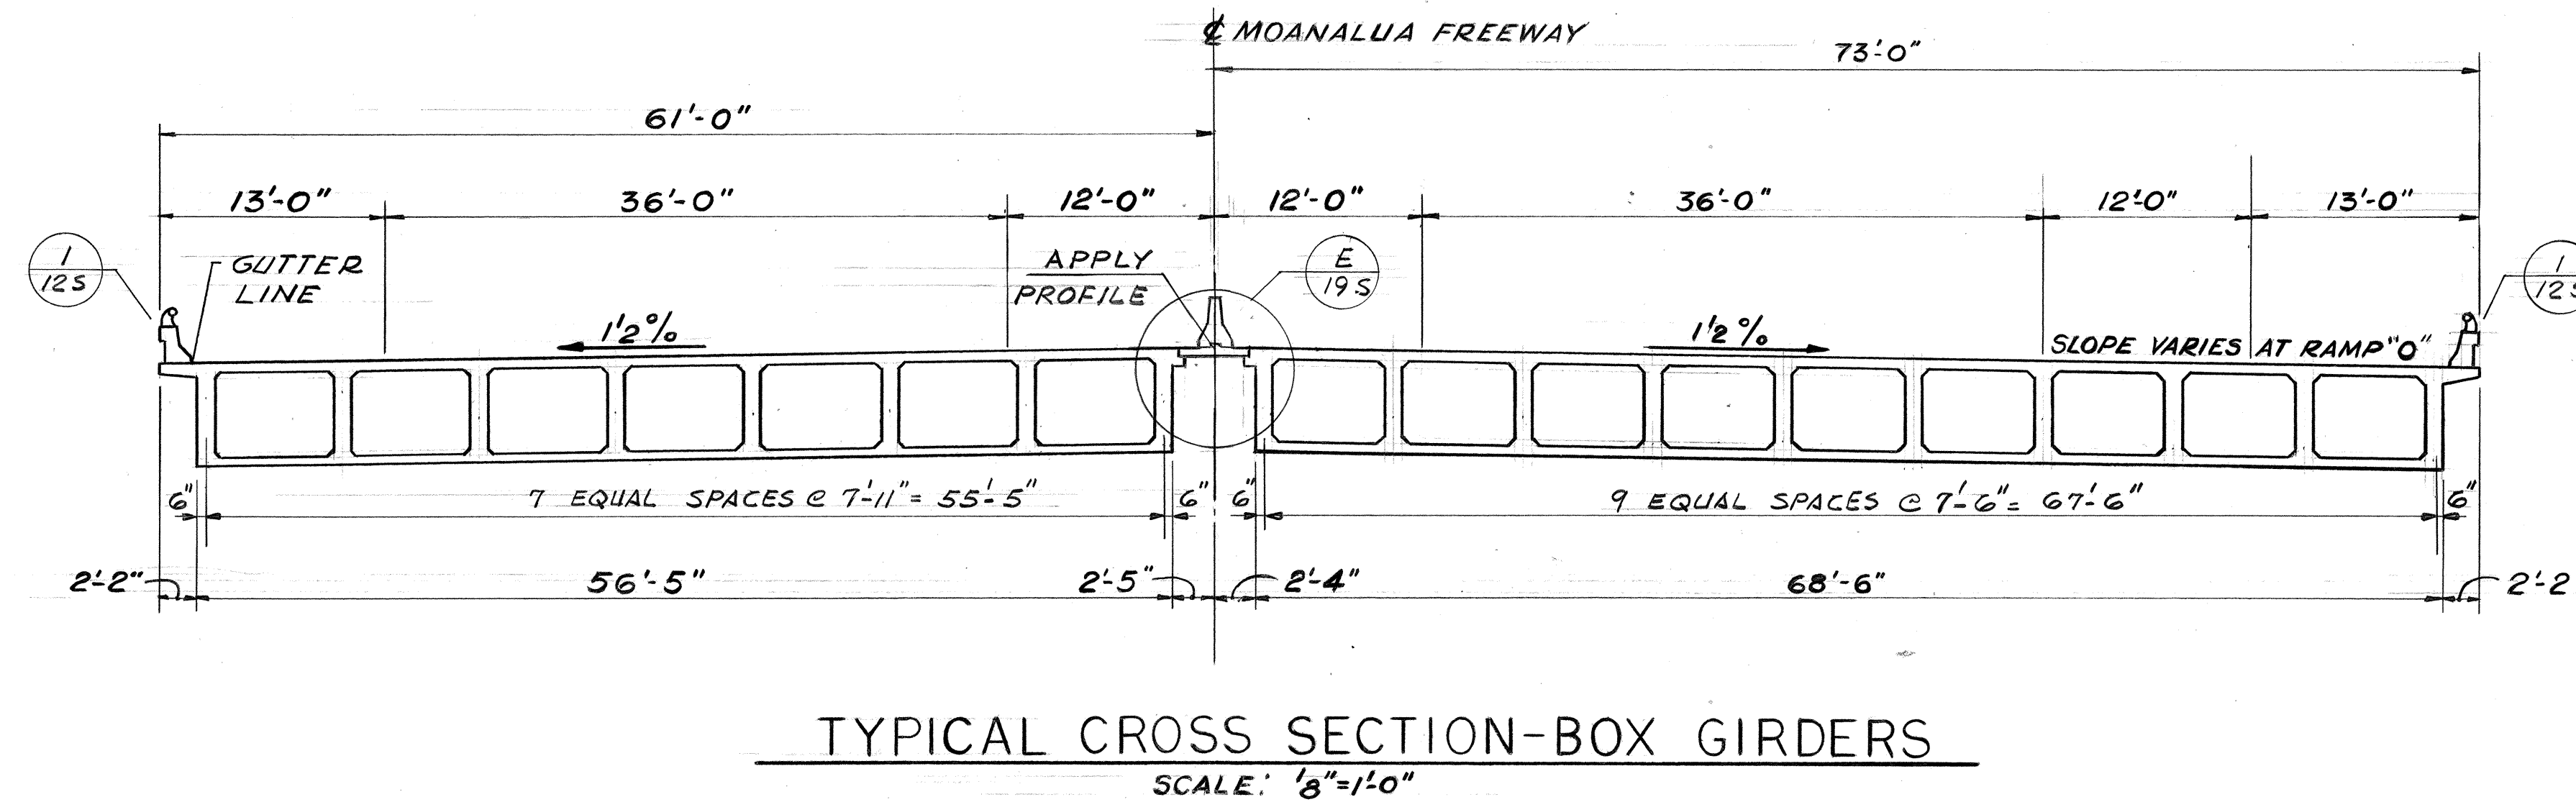


TYPICAL CROSS SECTION-TYPE III AASHO-BEAMS
SCALE: 1/8"=1'-0"

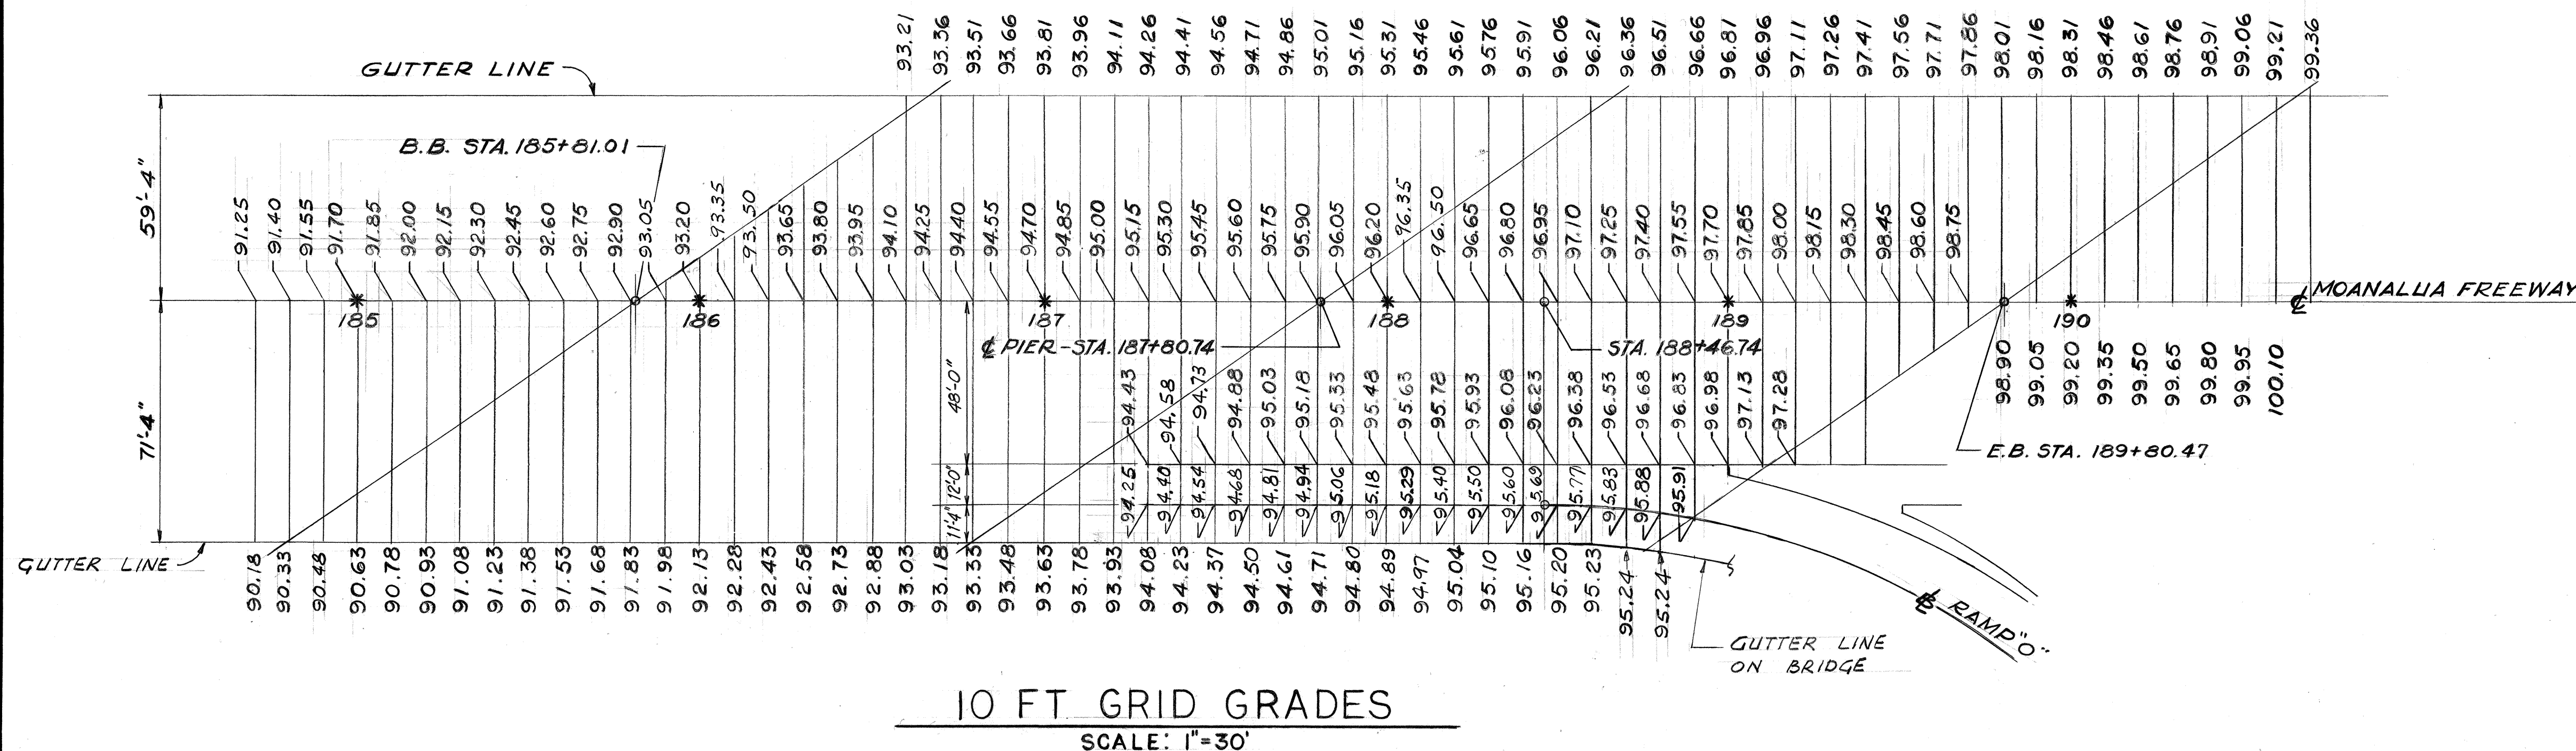

NOTES


- CROSS-SECTIONS ARE PROJECTIONS ON A PLANE NORMAL TO MOANALUA FREEWAY
- ALL DIMENSIONS ON CROSS SECTIONS ARE MEASURED NORMAL TO MOANALUA FREEWAY OR RADIAL TO RAMP "O".
- GRID GRADE ELEVATIONS DO NOT INCLUDE ANY ALLOWANCE FOR CAMBER. SEE SHT. 145 FOR CAMBER DIAGRAM.

THIS WORK WAS PREPARED BY
ME OR UNDER MY SUPERVISION
Wm. J. Armento

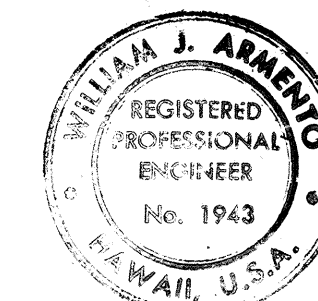

STATE OF HAWAII
DEPARTMENT OF TRANSPORTATION
HIGHWAYS DIVISION
HALAWA INTERCHANGE
STRUCTURE NO. 4
MOANALUA FREEWAY OVER H-3
TYPICAL CROSS SECTIONS, 10' GRID
GRADES & PROFILES
PROJ. No. I-H-1(89):13 DATE: MAY 1971
SHEET No. 25 OF 195 SHEETS

FED. ROAD DIST. NO.	STATE	FED. AID PROJ. NO.	FISCAL YEAR	SHEET NO.	TOTAL SHEETS
HAWAII	HAW.	I-HI-1(89):13	1971	184	362

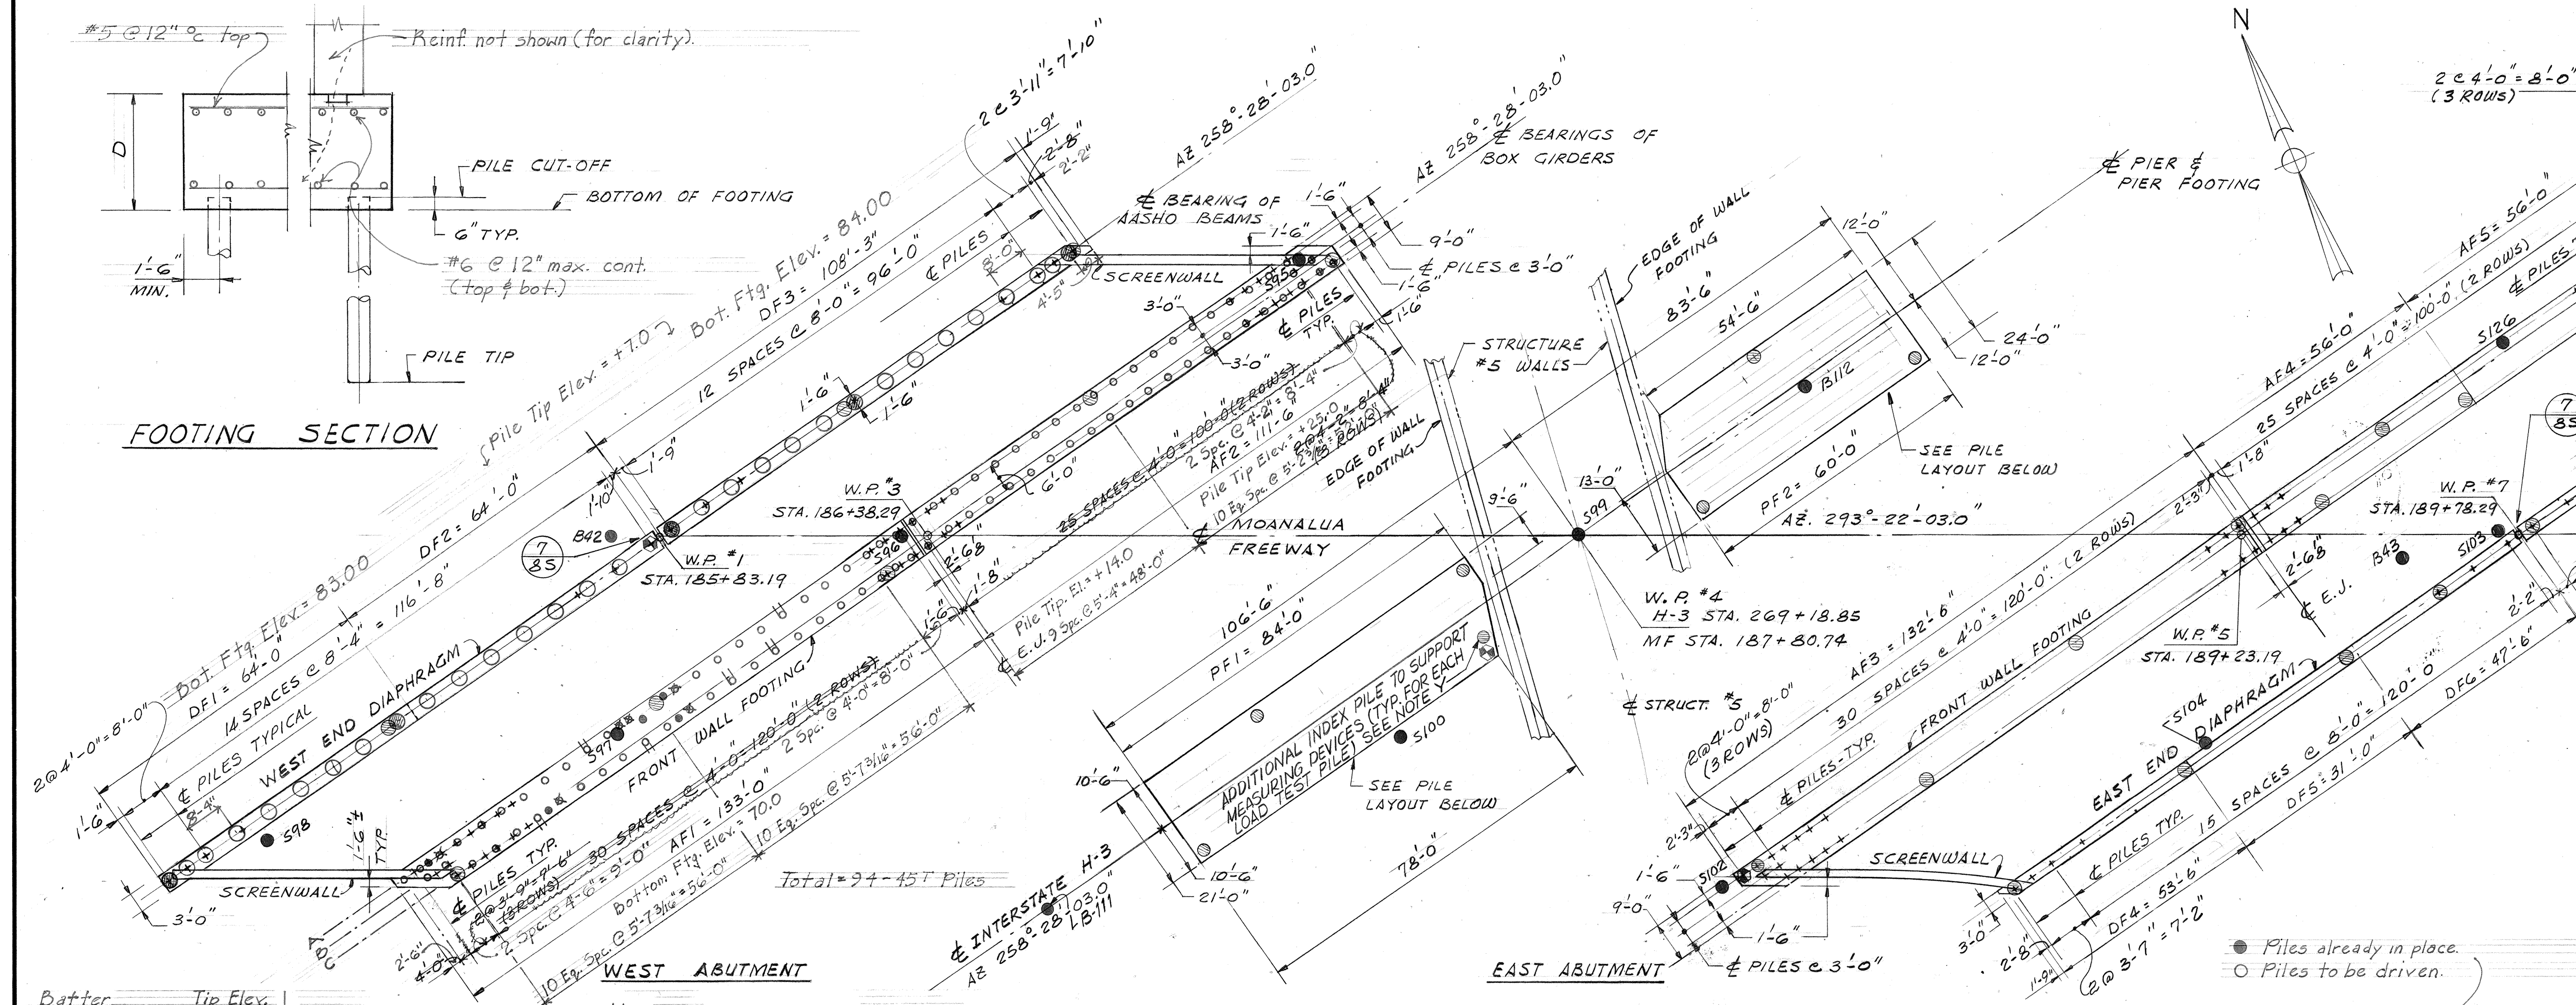

FOUNDATION NOTES

GENERAL

- INDEX PILES INDICATED THUS: (35 REQUIRED)
- LOAD TEST PILES INDICATED THUS: (4 REQUIRED)
- PILES ARE TYPE I PRECAST, PRESTRESSED CONCRETE PILES, DRIVEN TO AN ALLOWABLE BEARING CAPACITY OF 32 TONS AND AS NOTED BELOW, SEE NOTE X.
- STRANDS ARE TO EXTEND A MINIMUM OF 24 INCHES BEYOND CUT-OFF FOR EMBEDMENT IN THE FOOTING.
- DRIVE PILES TO SCHEDULED TIP ELEVATIONS EXCEPT AS MODIFIED AS A RESULT OF INFORMATION OBTAINED FROM LOAD TEST, INDEX PILES AND DIRECTED BY THE ENGINEER. PLANS SHOW ESTIMATED PILE TIP ELEVATIONS BASED ON BORING DATA.

SEQUENCE OF CONSTRUCTION

- PILES FOR PIER FOOTINGS & ALL ABUTMENT PILES WITHIN 40 FT. OF THE FACE OF ABUTMENT WALLS OF STRUCT. #5 & FACE OF CHANNEL WALLS SHALL BE DRIVEN BEFORE THE EXCAVATION OF THE CHANNEL STRUCTURES.
- PIER FOOTINGS AND ABUTMENT FOOTINGS WITHIN THE ABOVE MENTIONED LIMITS SHALL BE CAST AFTER THE CONSTRUCTION OF THE STRUCT. #5 WALLS & CHANNEL WALLS ARE COMPLETED.
- THE CONTRACTOR SHALL DRIVE THE TEMPORARY SHEET PILING IN THE AREAS SHOWN ON THE PLANS FOR THE STRUCT. #5 CONSTRUCTION PRIOR TO ANY EXCAVATION FOR THE CHANNEL STRUCTURES.

PIERS AND ABUTMENTS

- EXCAVATE TO REQUIRED ELEVATIONS.
- DRIVE LOAD TEST PILES, PERFORM LOAD TESTS AND DETERMINE DEPTH & DRIVING RESISTANCE REQUIRED TO DEVELOP SPECIFIED LOAD. (SEE NOTE X BELOW).
- DRIVE INDEX PILES & DETERMINE TIP ELEVATIONS FOR REMAINING PILES. INDEX PILES SHALL BE DRIVEN BEFORE CASTING BALANCE OF PILES.
- PREDRILL HOLES FOR PILES THROUGH THE COMPACTED EMBANKMENT AND ELSEWHERE AS DIRECTED BY THE ENGINEER. HOLES ARE TO BE 6" LARGER THAN THE PILE DIAMETER. AFTER DRIVING PILES, FILL VOID SPACE WITH FINE AGGREGATE AS SPECIFIED.



NOTE X:

LOAD TEST FOUR PILES FOR 45 TON CAPACITY (AS DIRECTED BY THE ENGINEER) BEFORE DRIVING BALANCE OF INDEX PILES. IF LOAD TESTS SHOW THAT 45 TON PILES SHOULD BE USED, ALL PILE FOUNDATIONS WILL BE REDESIGNED. (SEE SPECIFICATIONS.)

NOTE Y:

CHOICE OF TEST PILE USED TO SUPPORT MEASURING DEVICES MAY BE ALTERED UPON APPROVAL BY ENGINEER.

FOOTING SCHEDULE						
MARK	FOOTING DIMENSIONS	NUMBER OF PILES	ELEVATIONS			
	LENGTH (A)	WIDTH (B)	DEPTH (D)	BOTTOM OF FOOTG	PILE CUT OFF	PILE TIP
DF1	64'-0"	3'-0"	VARIES	83.00	83.50	+12.0
DF2	64'-0"	3'-0"	VARIES	84.00	84.50	+12.0
DF3	108'-3"	3'-0"	VARIES	85.00	85.50	+12.0
AF1	133'-0"	9'-0"	3'-0"	68.00	68.50	+14.0
AF2	111'-6"	9'-0"	3'-0"	70.00	70.50	+14.0
PF1	SEE PLAN	4'-6"	168	62.50	63.00	-3.0
PF2	SEE PLAN	5'-0"	136	64.00	64.50	-19.0
AF3	132'-6"	9'-0"	3'-0"	71.00	71.50	+6.0
AF4	56'-0"	9'-0"	3'-0"	73.00	73.50	+6.0
AF5	56'-0"	9'-0"	3'-0"	73.00	73.50	+60.0
DF4	53'-6"	3'-0"	VARIES	88.00	88.50	+6.0
DF5	31'-0"	3'-0"	VARIES	89.00	89.50	+6.0
DF6	47'-6"	3'-0"	VARIES	90.00	90.50	+6.0
DF7	53'-0"	3'-0"	VARIES	91.00	91.50	+6.0
DF8	54'-0"	3'-0"	VARIES	91.00	91.50	+56.0

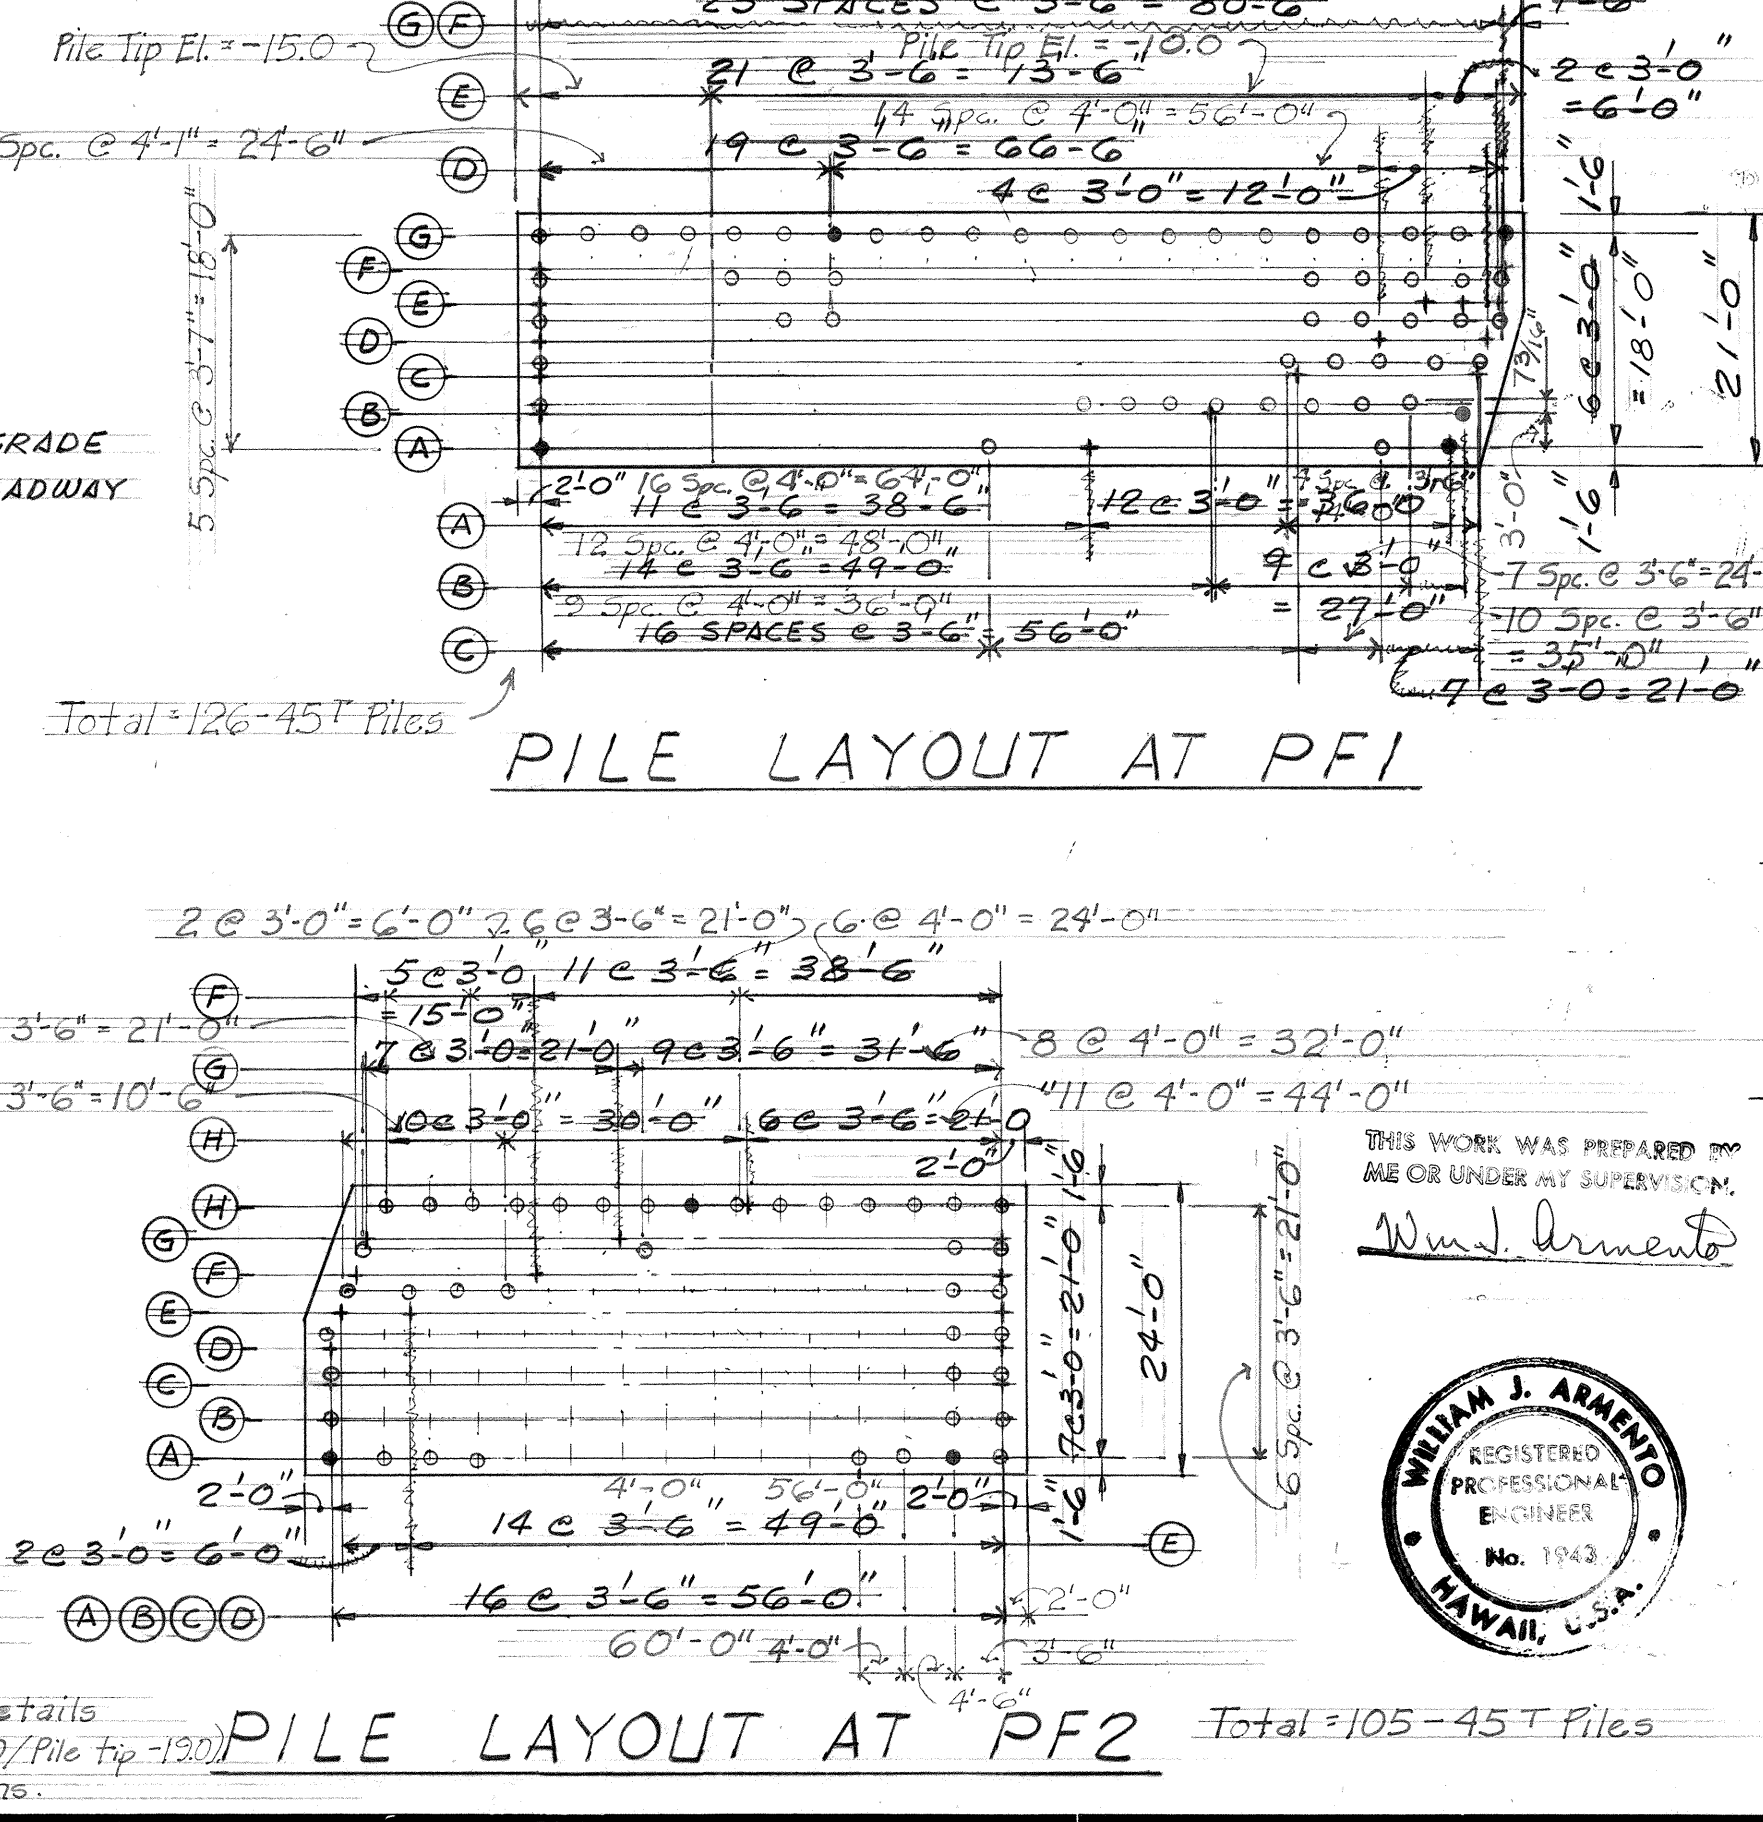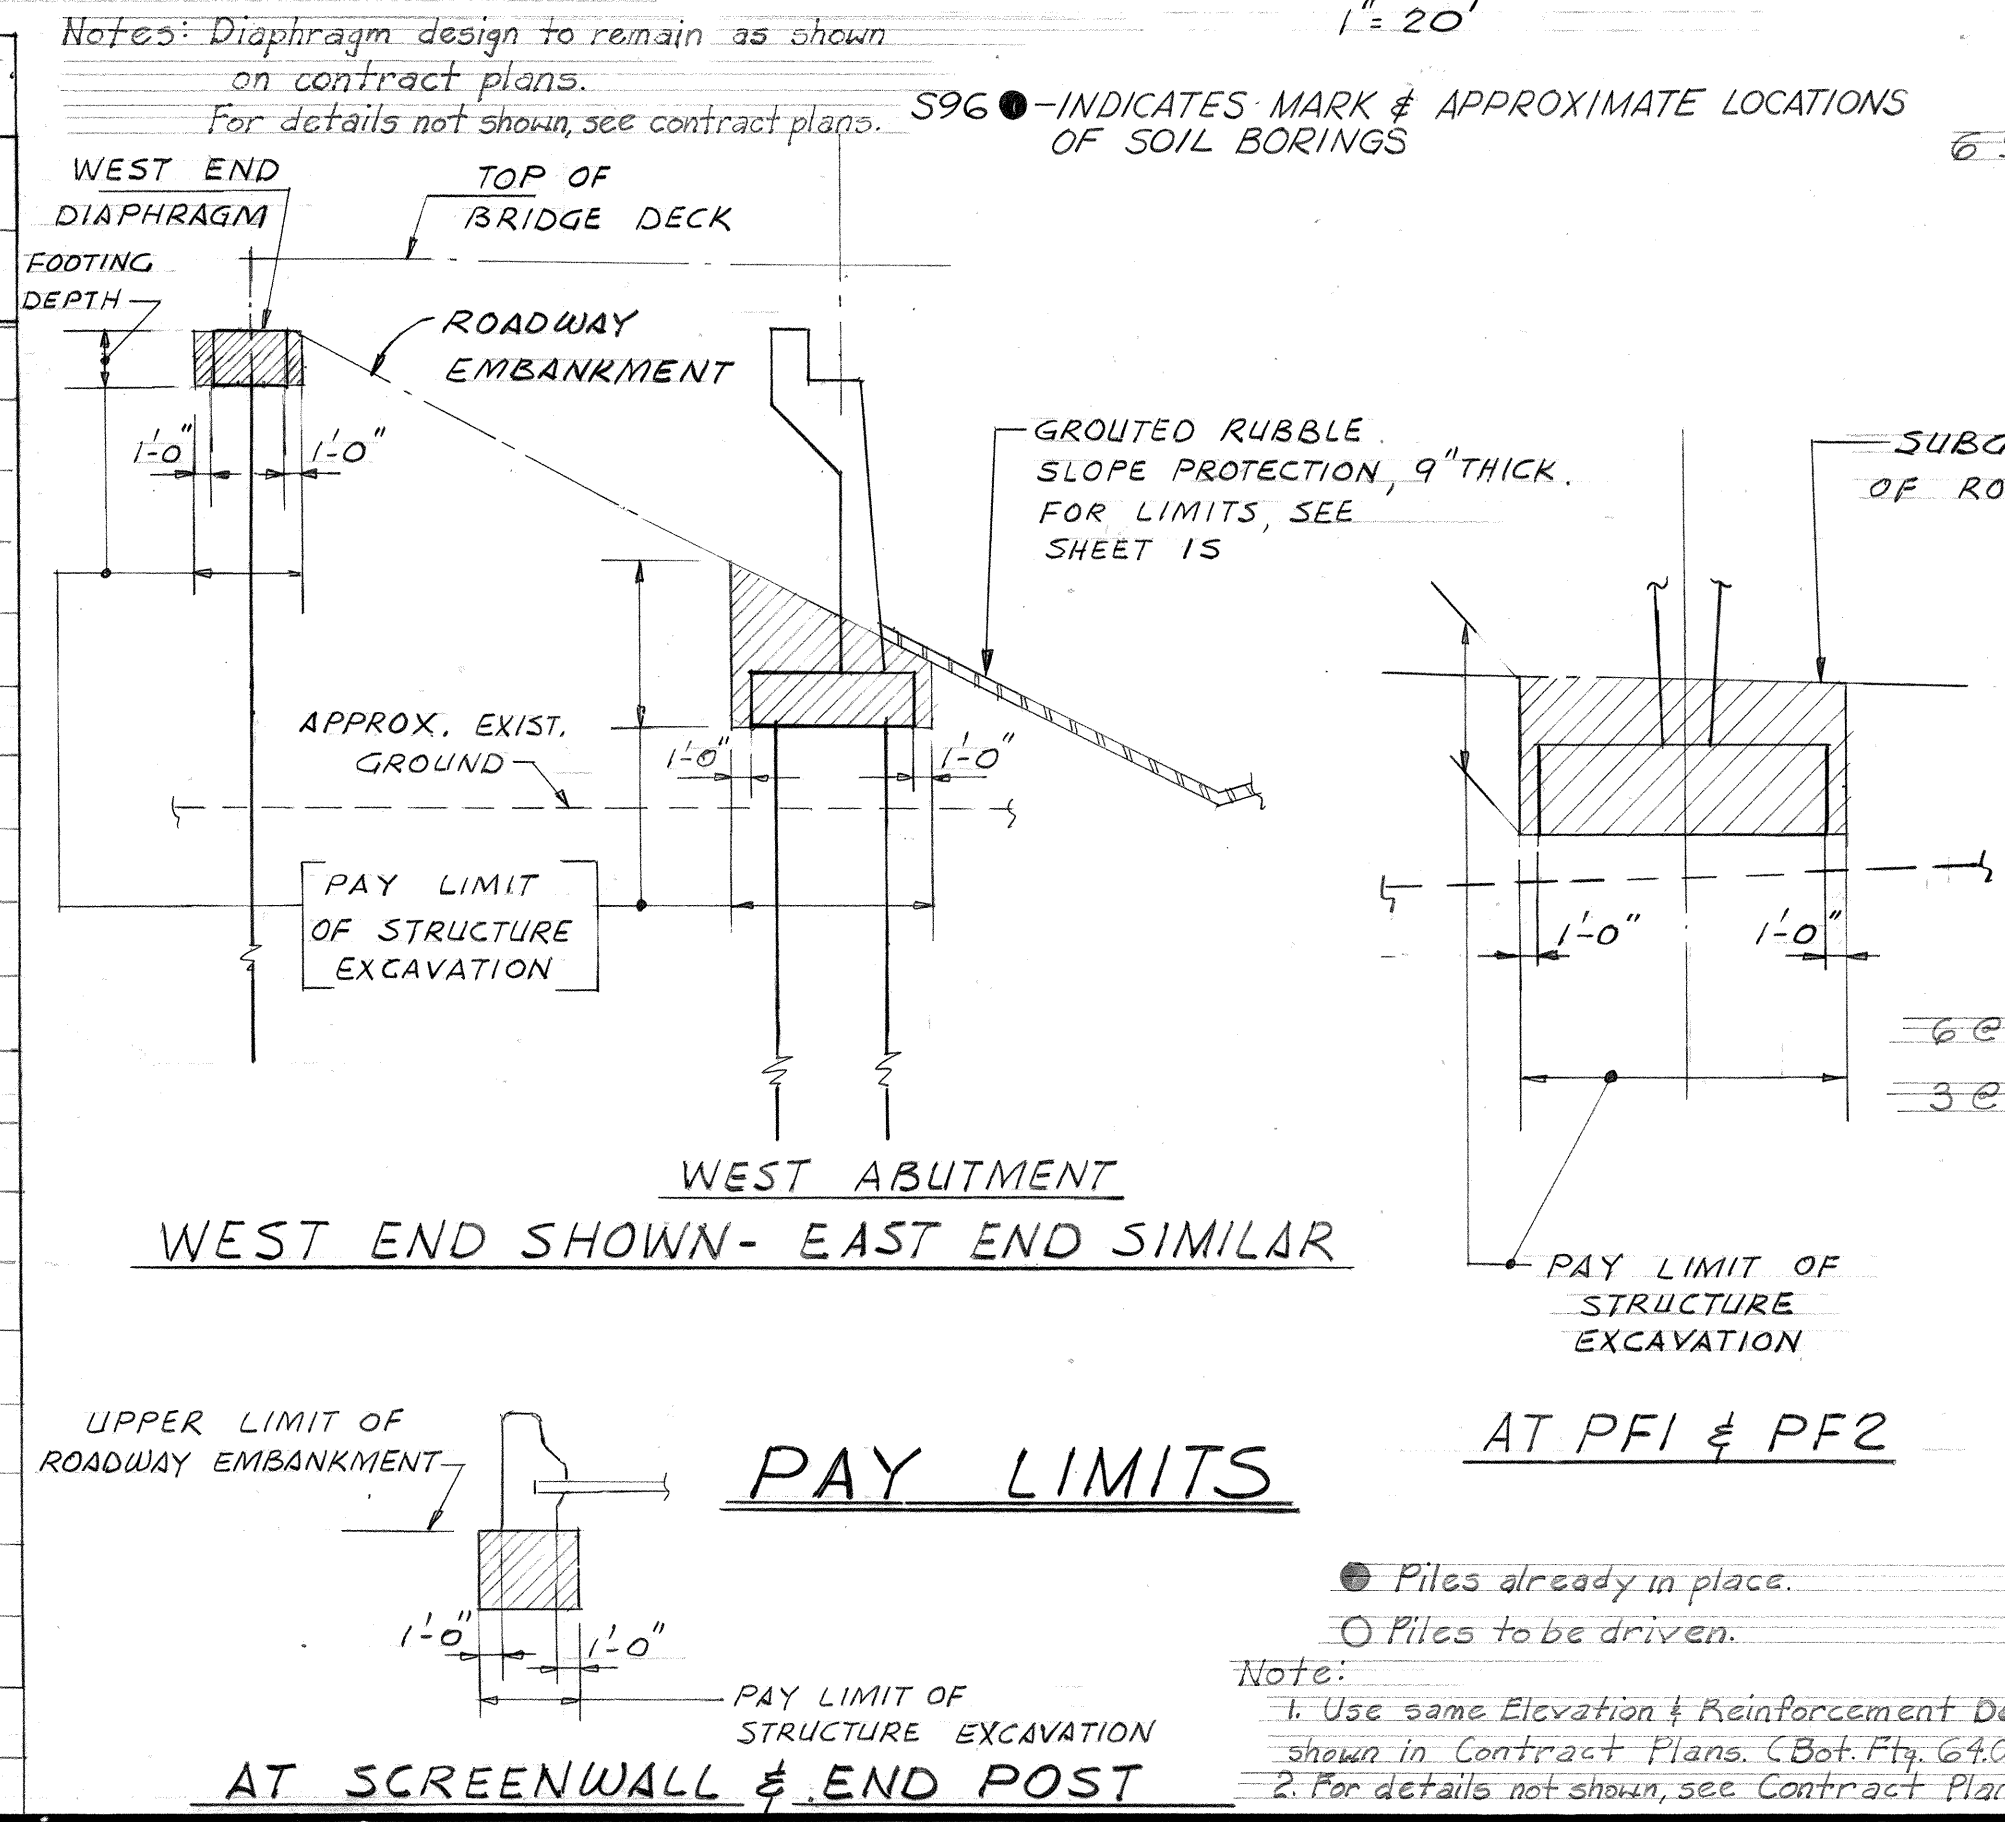

STATE OF HAWAII
DEPARTMENT OF TRANSPORTATION
HIGHWAYS DIVISION

HALAWA INTERCHANGE
STRUCTURE NO. 4
MOANALUA FREEWAY OVER H-3
FOUNDATION PLAN




PROJ. No. I-HI-1(89):13 DATE: MAY 1971

SHEET No. 35 OF 195 SHEETS

WILLIAM J. ARMENTO
REGISTERED PROFESSIONAL ENGINEER
No. 1943
HAWAII, U.S.A.

ORIGINAL PLAN
DESIGNED BY
CHECKED BY
DATE
QUANTITIES BY
NOTE BOOK
NO.

FED. ROAD DIST. NO.	STATE	FED. AID PROJ. NO.	FISCAL YEAR	SHEET NO.	TOTAL SHEETS
HAWAII	HAW.	I-H1(89)13	1971	185	362

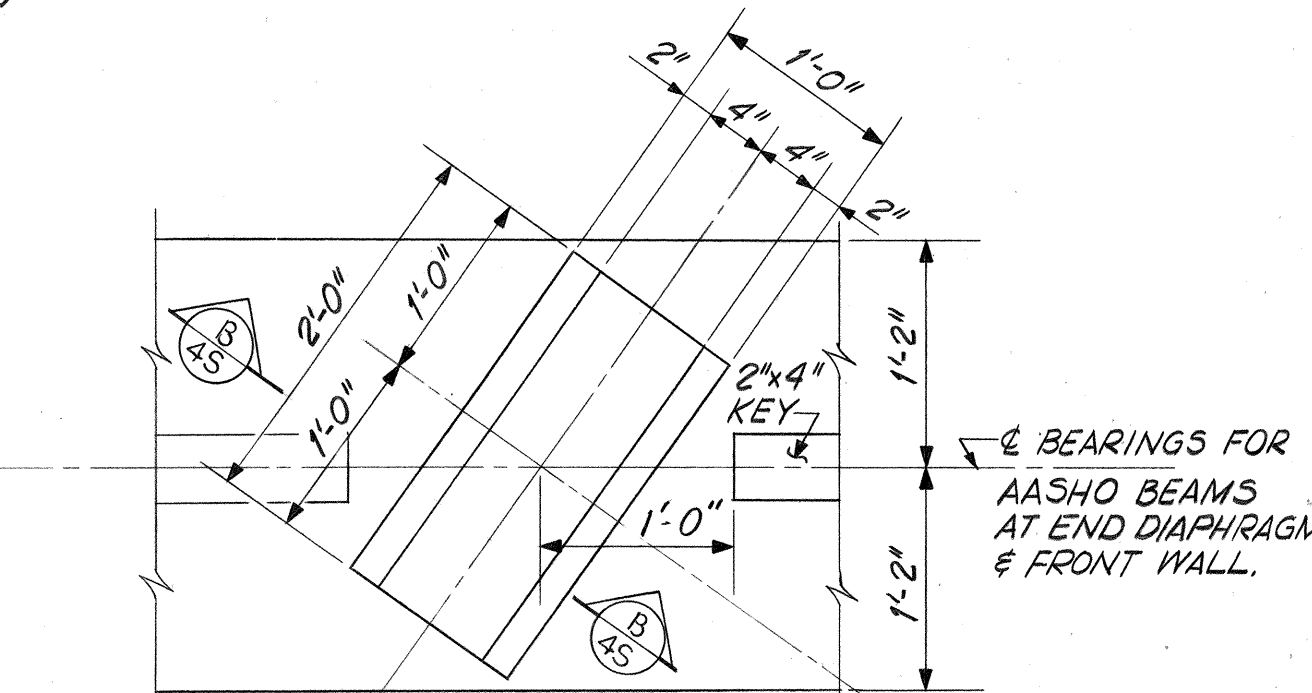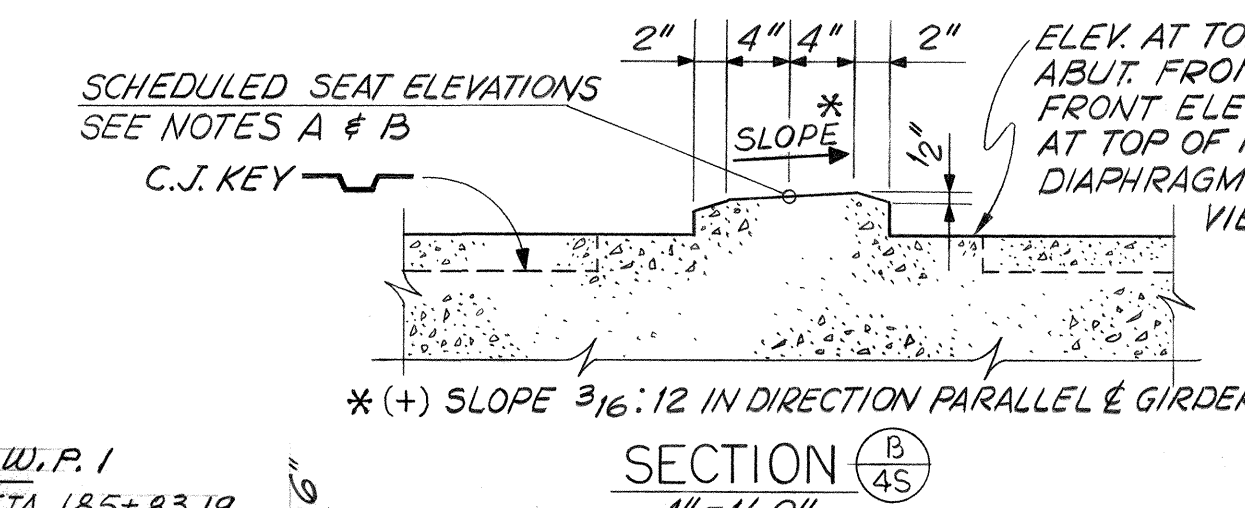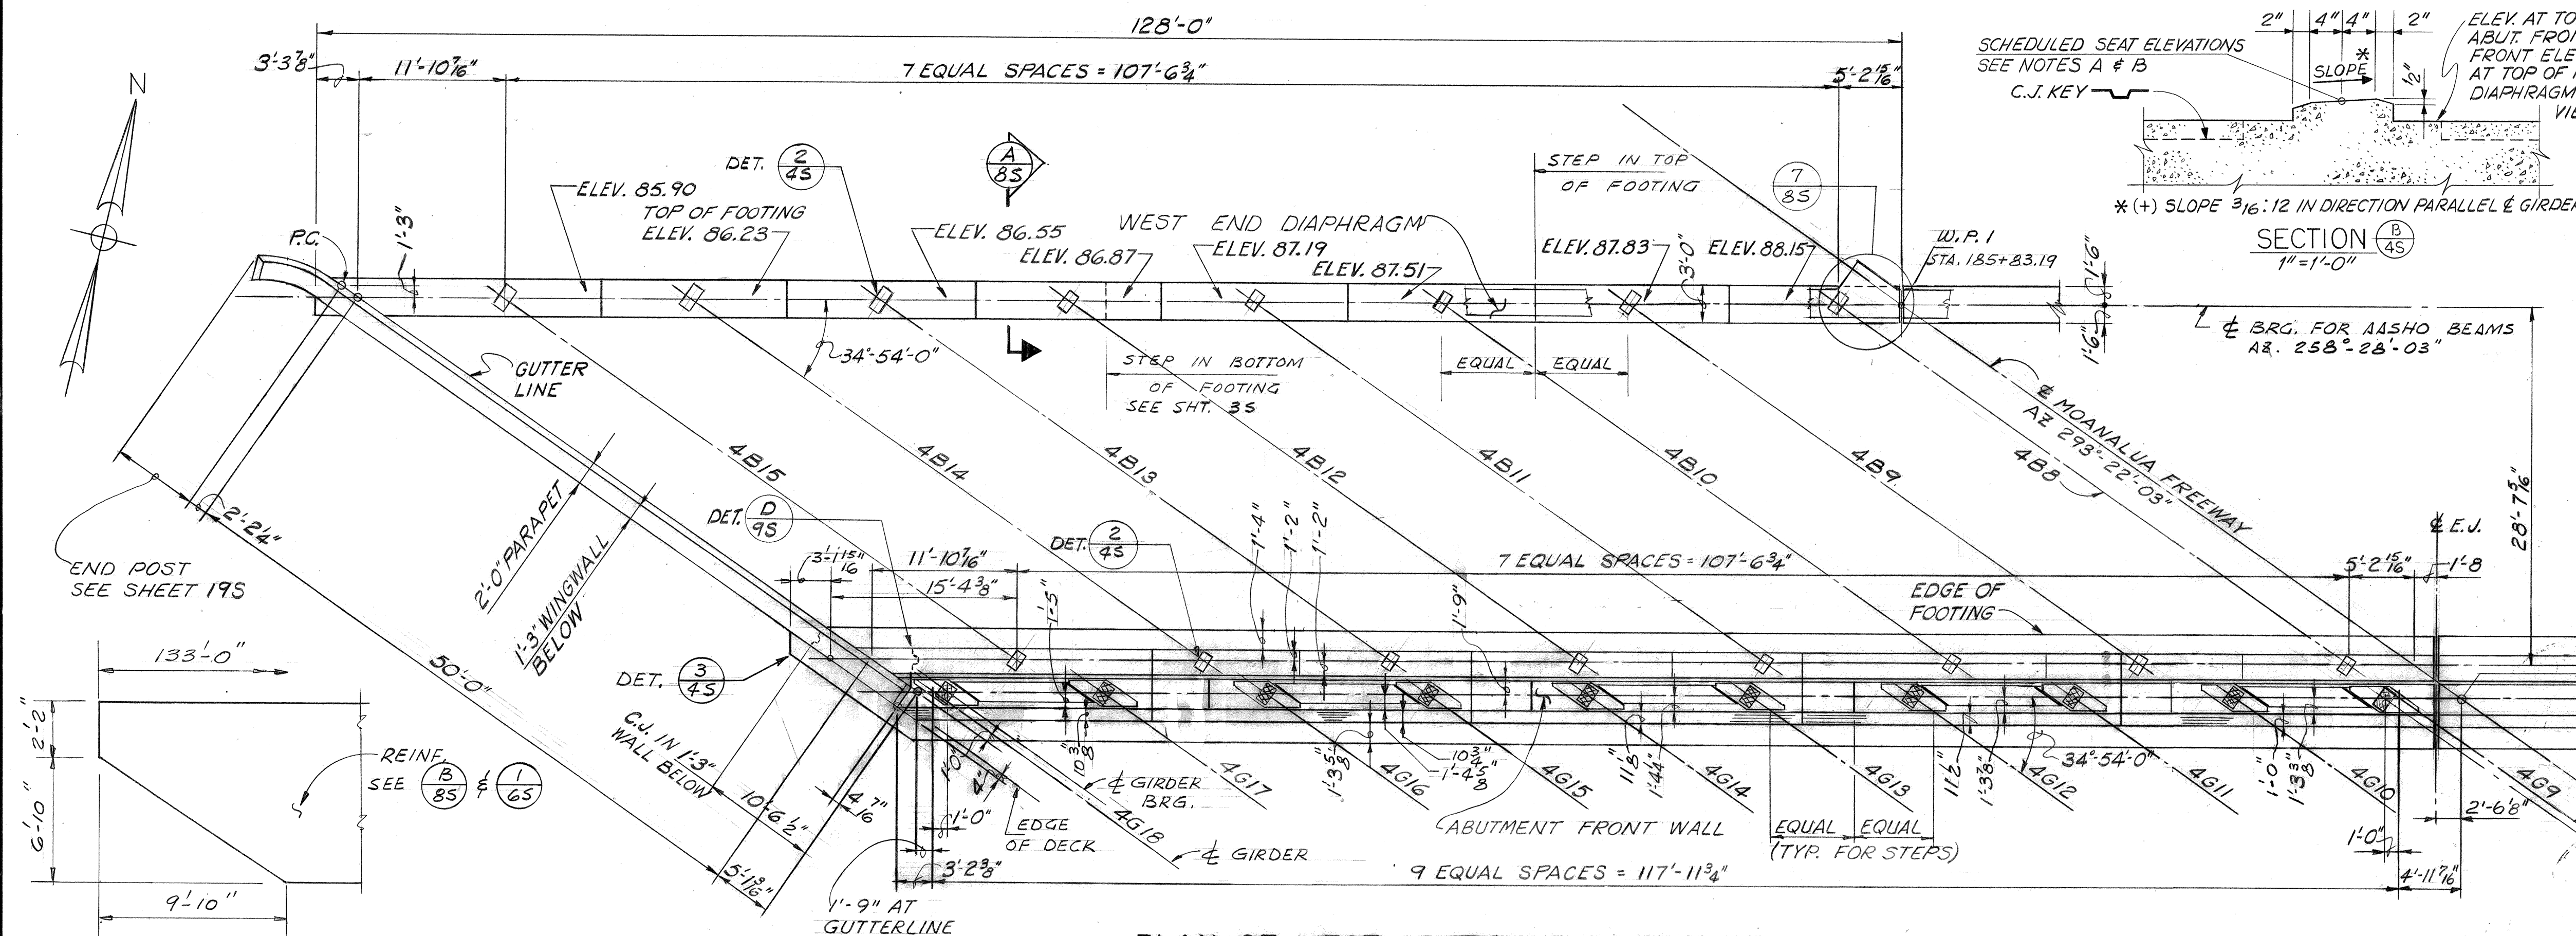


PLAN OF FOOTING
DETAIL (3/45)

PLAN OF WEST ABUTMENT-EASTBOUND
SCALE: 1/8" = 1'-0"



SEAT ELEVATIONS		
BEAM OR GIRDER MARK	ELEVATION AT TOP OF CONCRETE LEVELING PAD AND CONCRETE PEDESTAL	
	FRONT WALL	END DIAPHRAGM
4B8	89.07	88.32
4B9	88.75	88.00
4B10	88.43	87.68
4B11	88.11	87.36
4B12	87.79	87.04
4B13	87.47	86.72
4B14	87.15	86.40
4B15	86.82	86.07

4G9	87.56
4G10	87.29
4G11	87.01
4G12	86.74
4G13	86.47
4G14	86.19
4G15	85.92
4G16	85.65
4G17	85.37
4G18	85.10


SEE SECTIONS (B/45) AND (A/45)

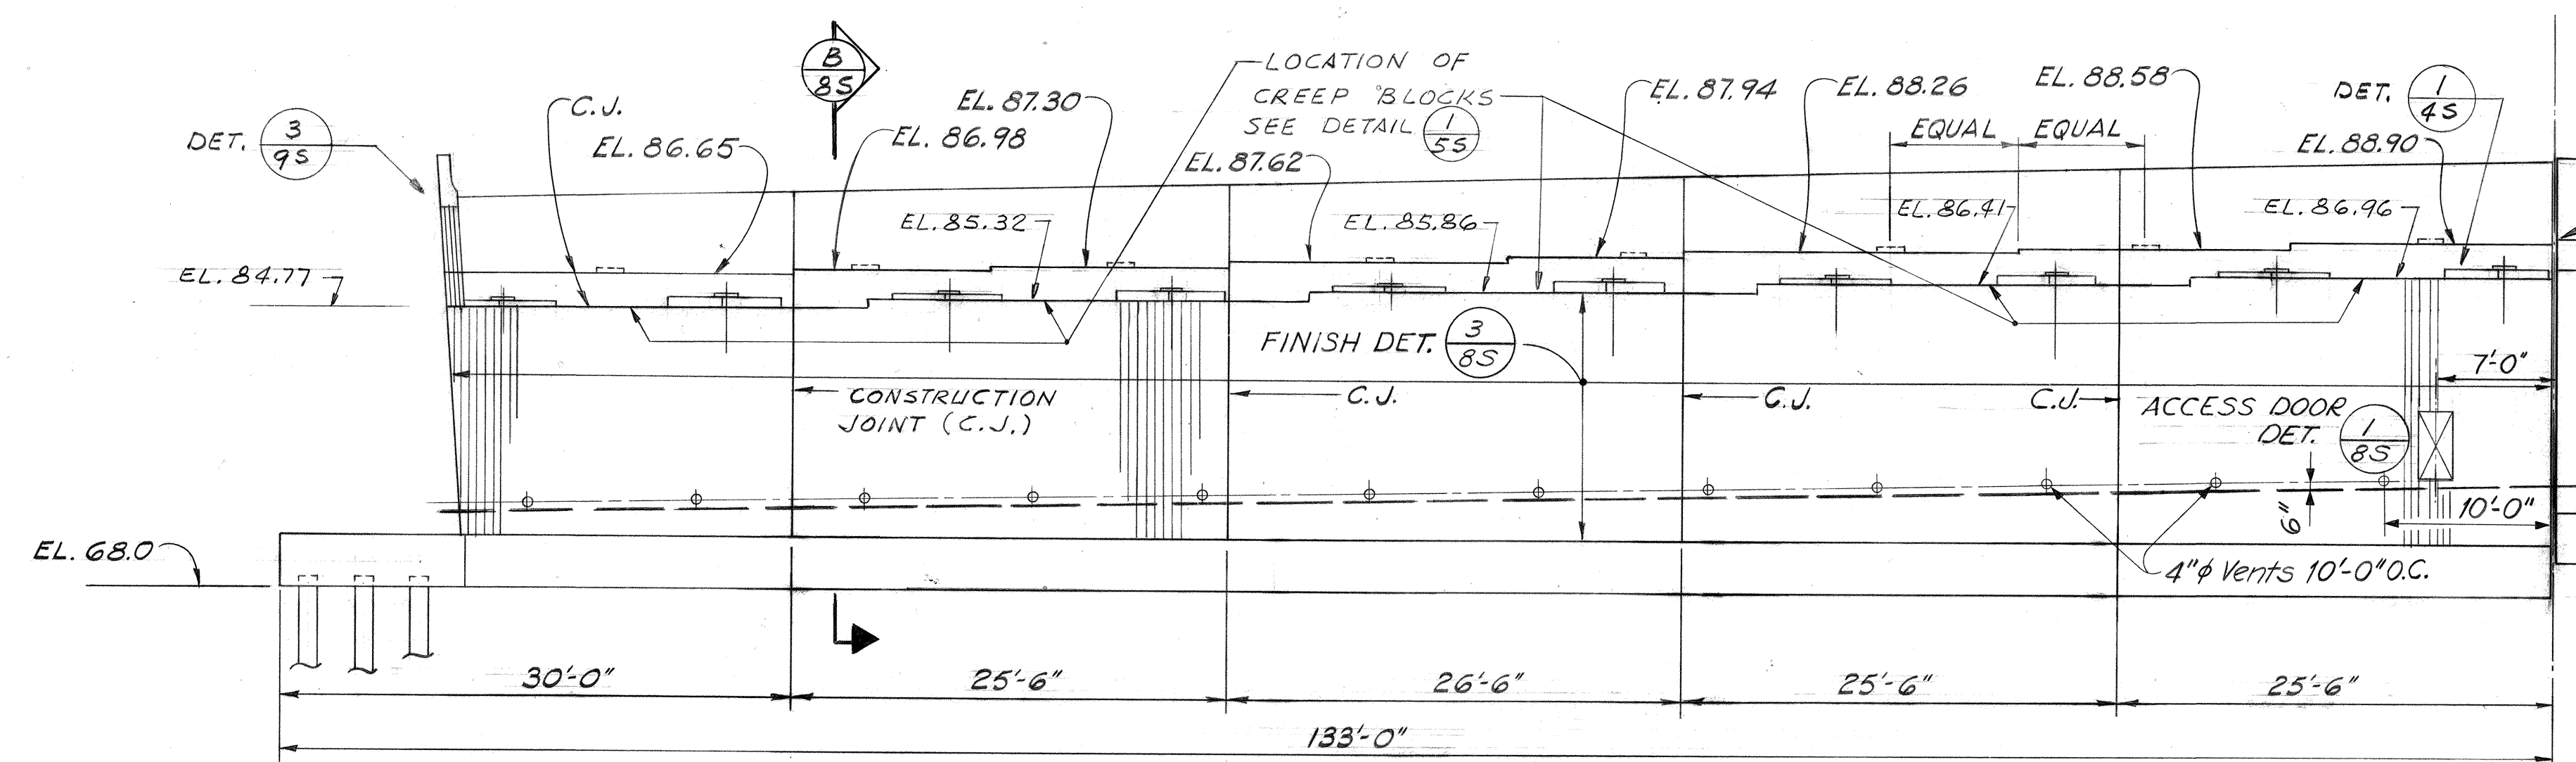

FRONT ELEVATION OF WEST ABUTMENT-EASTBOUND
SCALE: 1/8" = 1'-0"

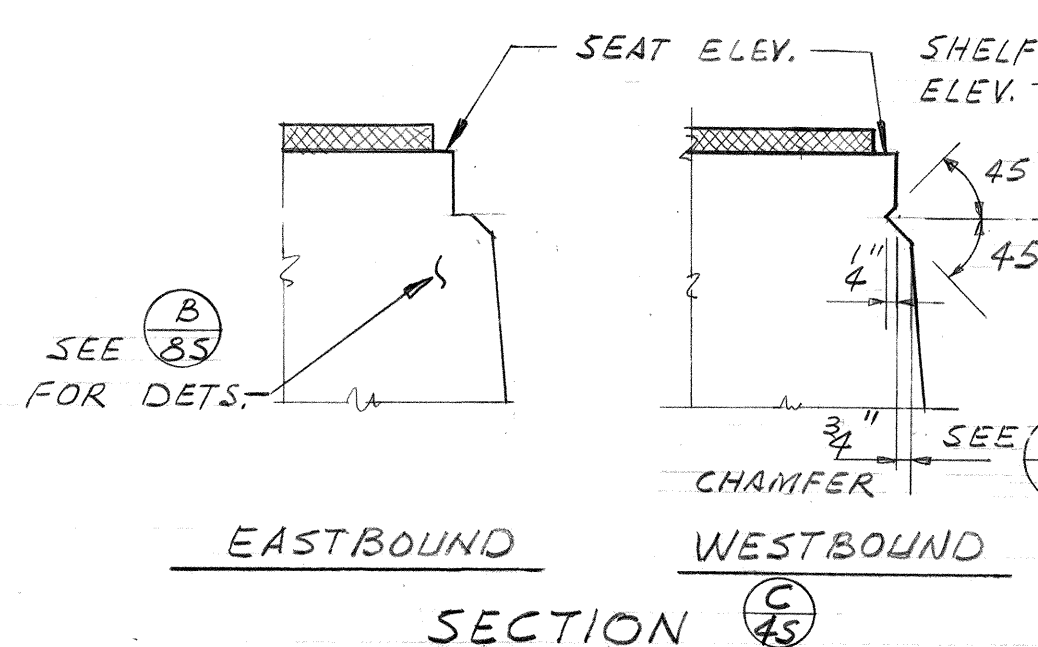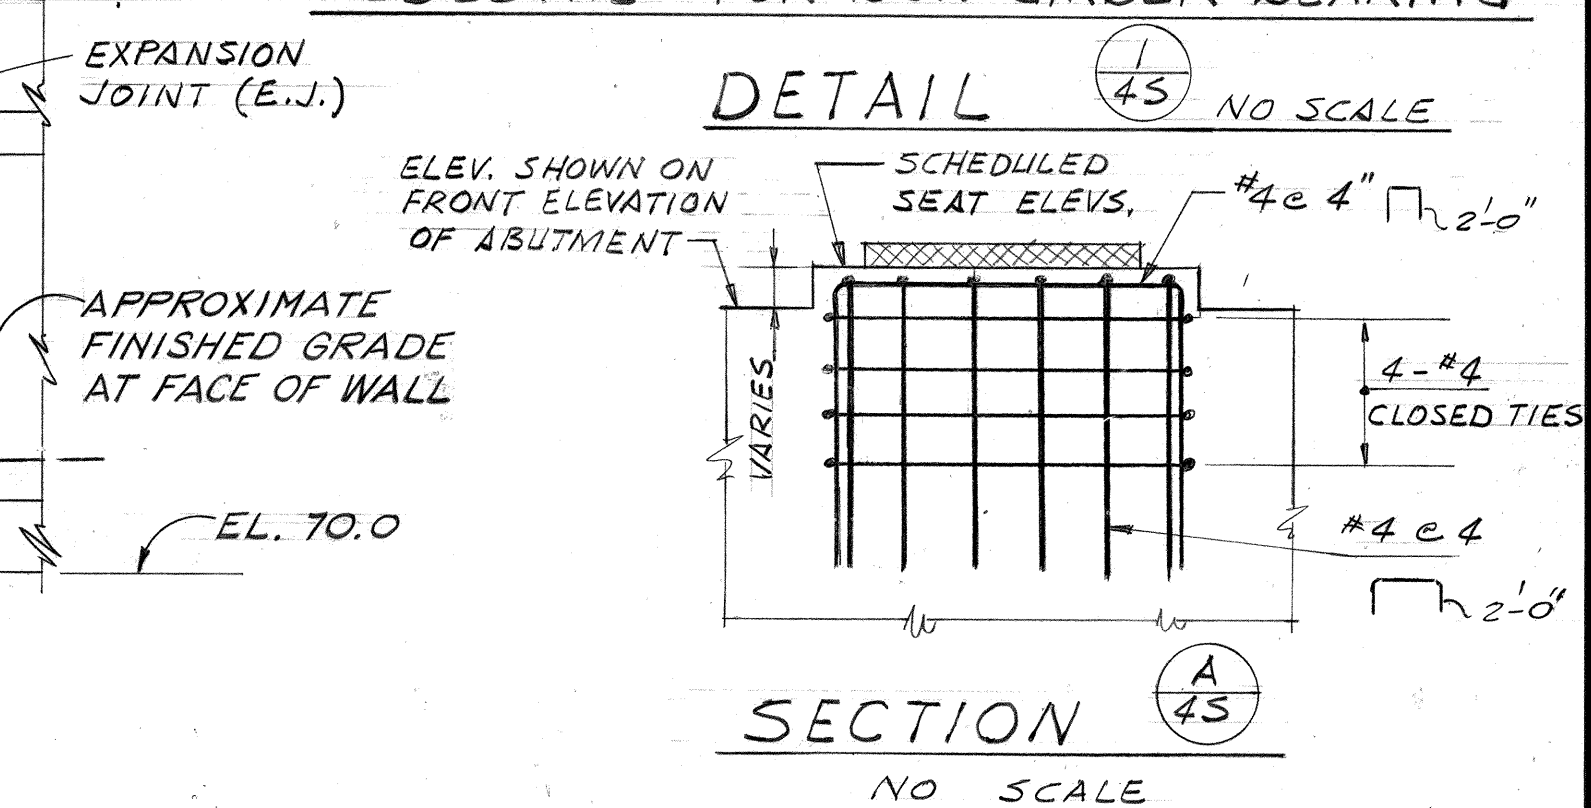




THIS WORK WAS PREPARED BY ME OR UNDER MY SUPERVISION
Wm. J. Armiento

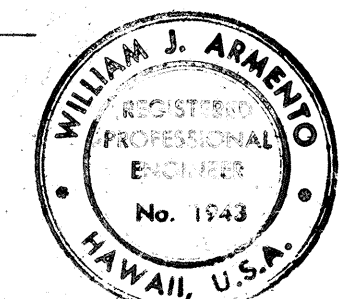

STATE OF HAWAII
DEPARTMENT OF TRANSPORTATION
HIGHWAYS DIVISION
HALAWA INTERCHANGE
STRUCTURE NO. 4
MOANALUA FREEWAY OVER H-3
WEST ABUTMENT,
EASTBOUND
PROJ. No. I-H1-1(89)13 DATE: MAY 1971
SHEET No. 45 OF 195 SHEETS

SURVEY PLOTTED BY: DATE: 2/11/72
DRAWN BY: L. H. H. H.
DESIGNED BY: J. H. H. H.
QUANTITIES BY: J. H. H. H.
CHECKED BY: J. H. H. H.

FED. ROAD DIST. NO.	STATE	FED. AID PROJ. NO.	FISCAL YEAR	SHEET NO.	TOTAL SHEETS
HAWAII	HAW.	I-H-1(89)13	1971	186	362

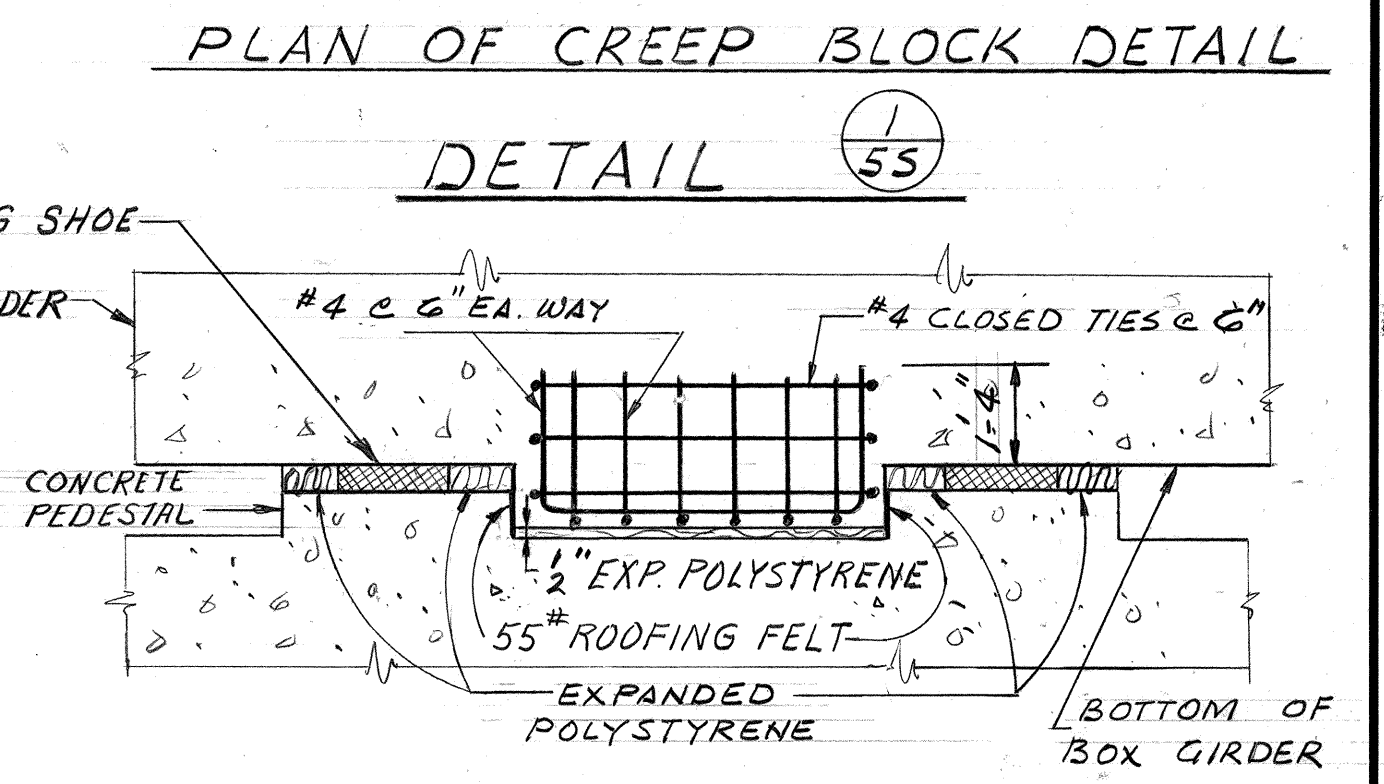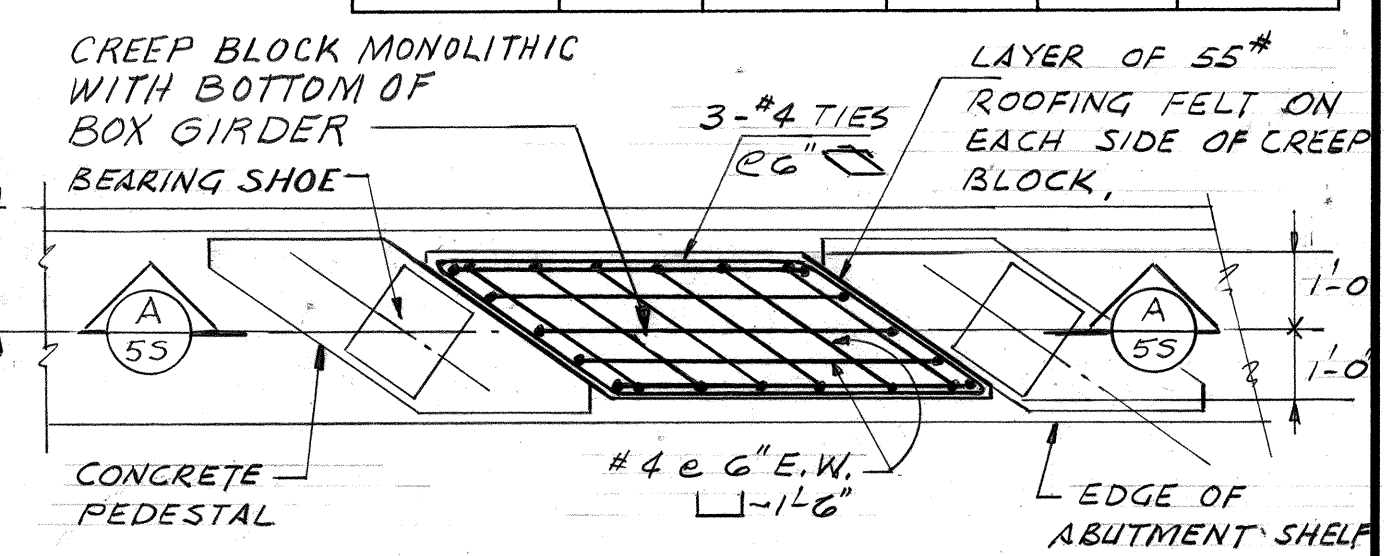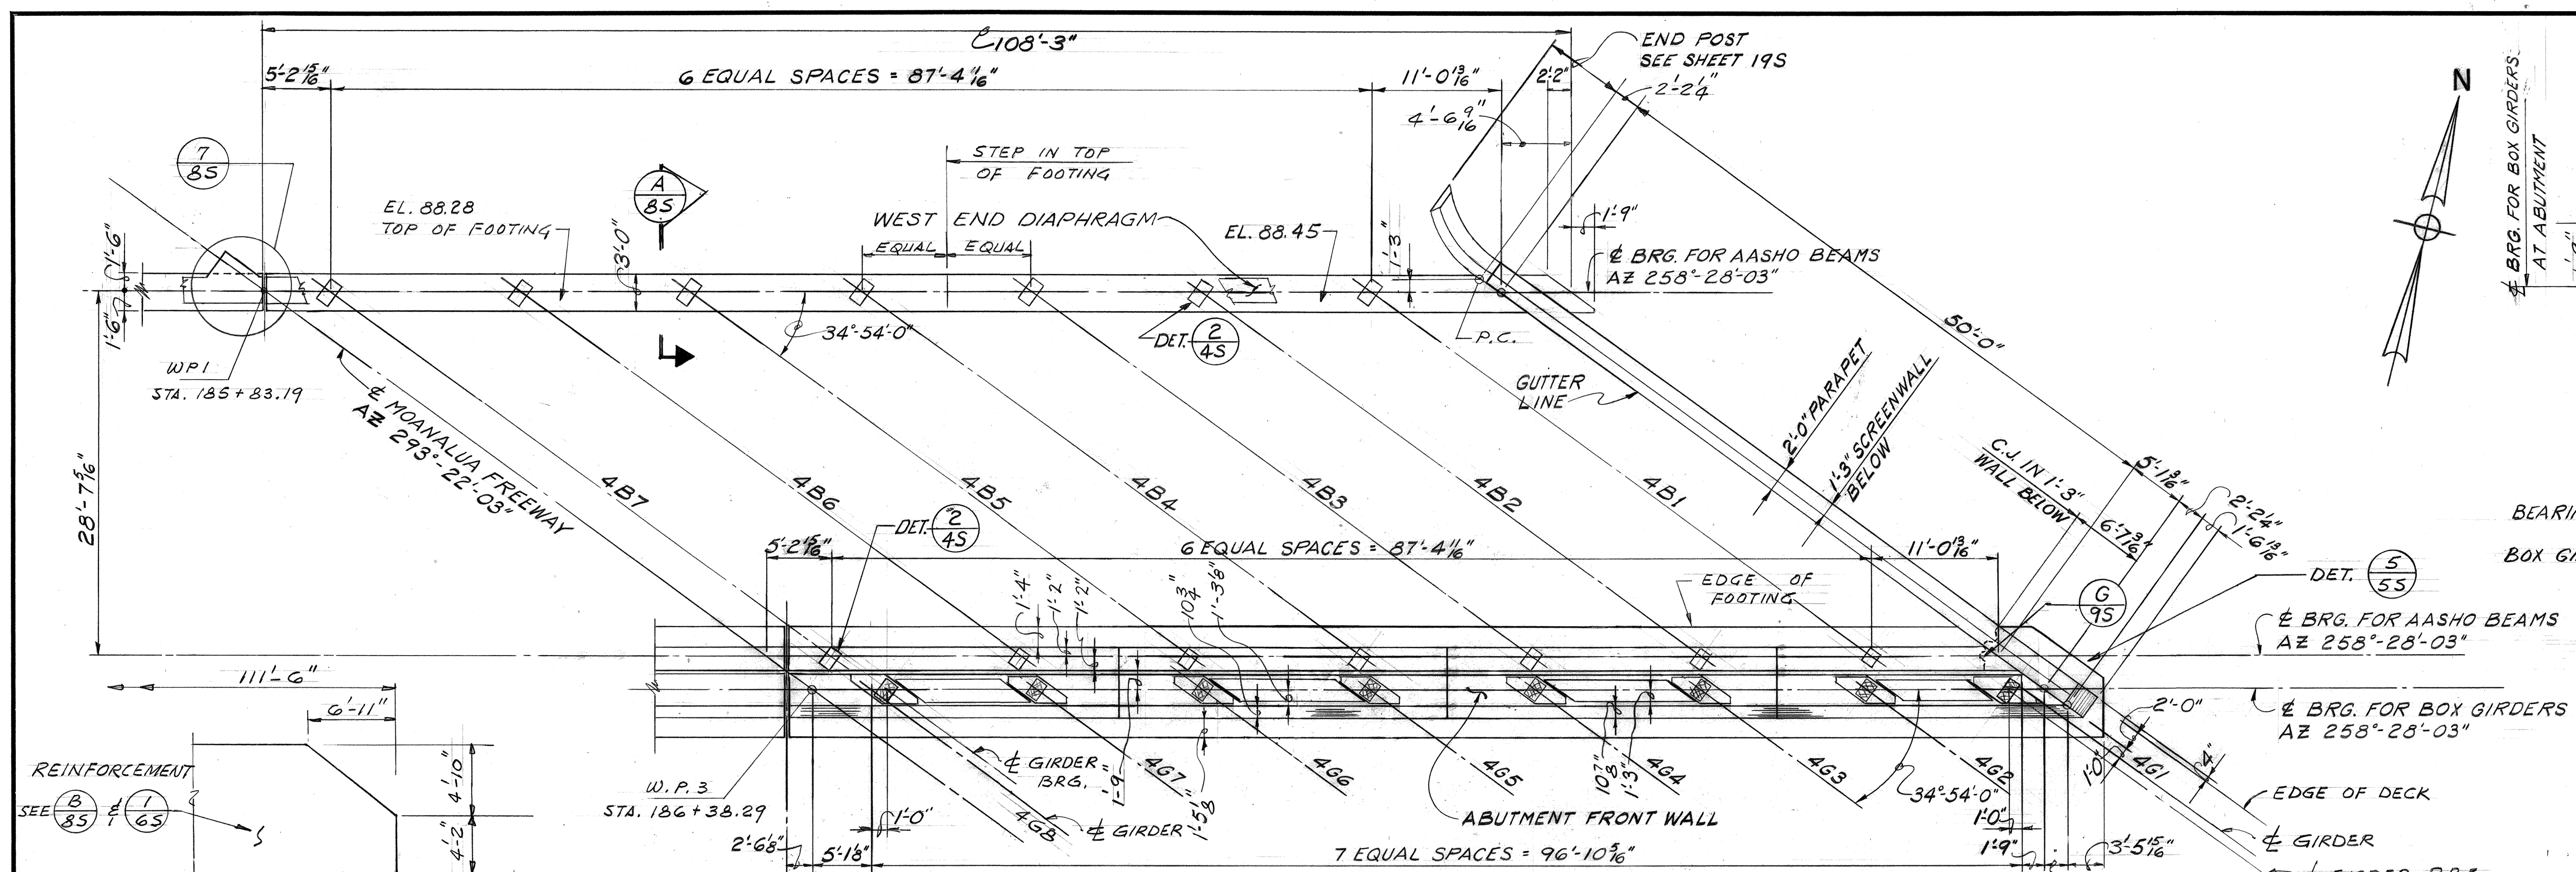


PLAN OF FOOTING
DETAIL 55

PLAN OF WEST ABUTMENT-WESTBOUND
SCALE: 3/8" = 1'-0"




BEAM OR GIRDER MARK	SEAT ELEVATIONS	
	ELEVATION AT TOP OF CONCRETE LEVELING PAD AND CONCRETE PEDESTAL	
	FRONT WALL	END DIAPHRAGM
4B1	89.53	88.78
4B2	89.47	88.72
4B3	89.42	88.67
4B4	89.36	88.61
4B5	89.31	88.56
4B6	89.25	88.50
4B7	89.20	88.45

4G1	88.04
4G2	87.99
4G3	87.94
4G4	87.89
4G5	87.84
4G6	87.79
4G7	87.74
4G8	87.68

SEE SECTIONS B 85 AND A 85

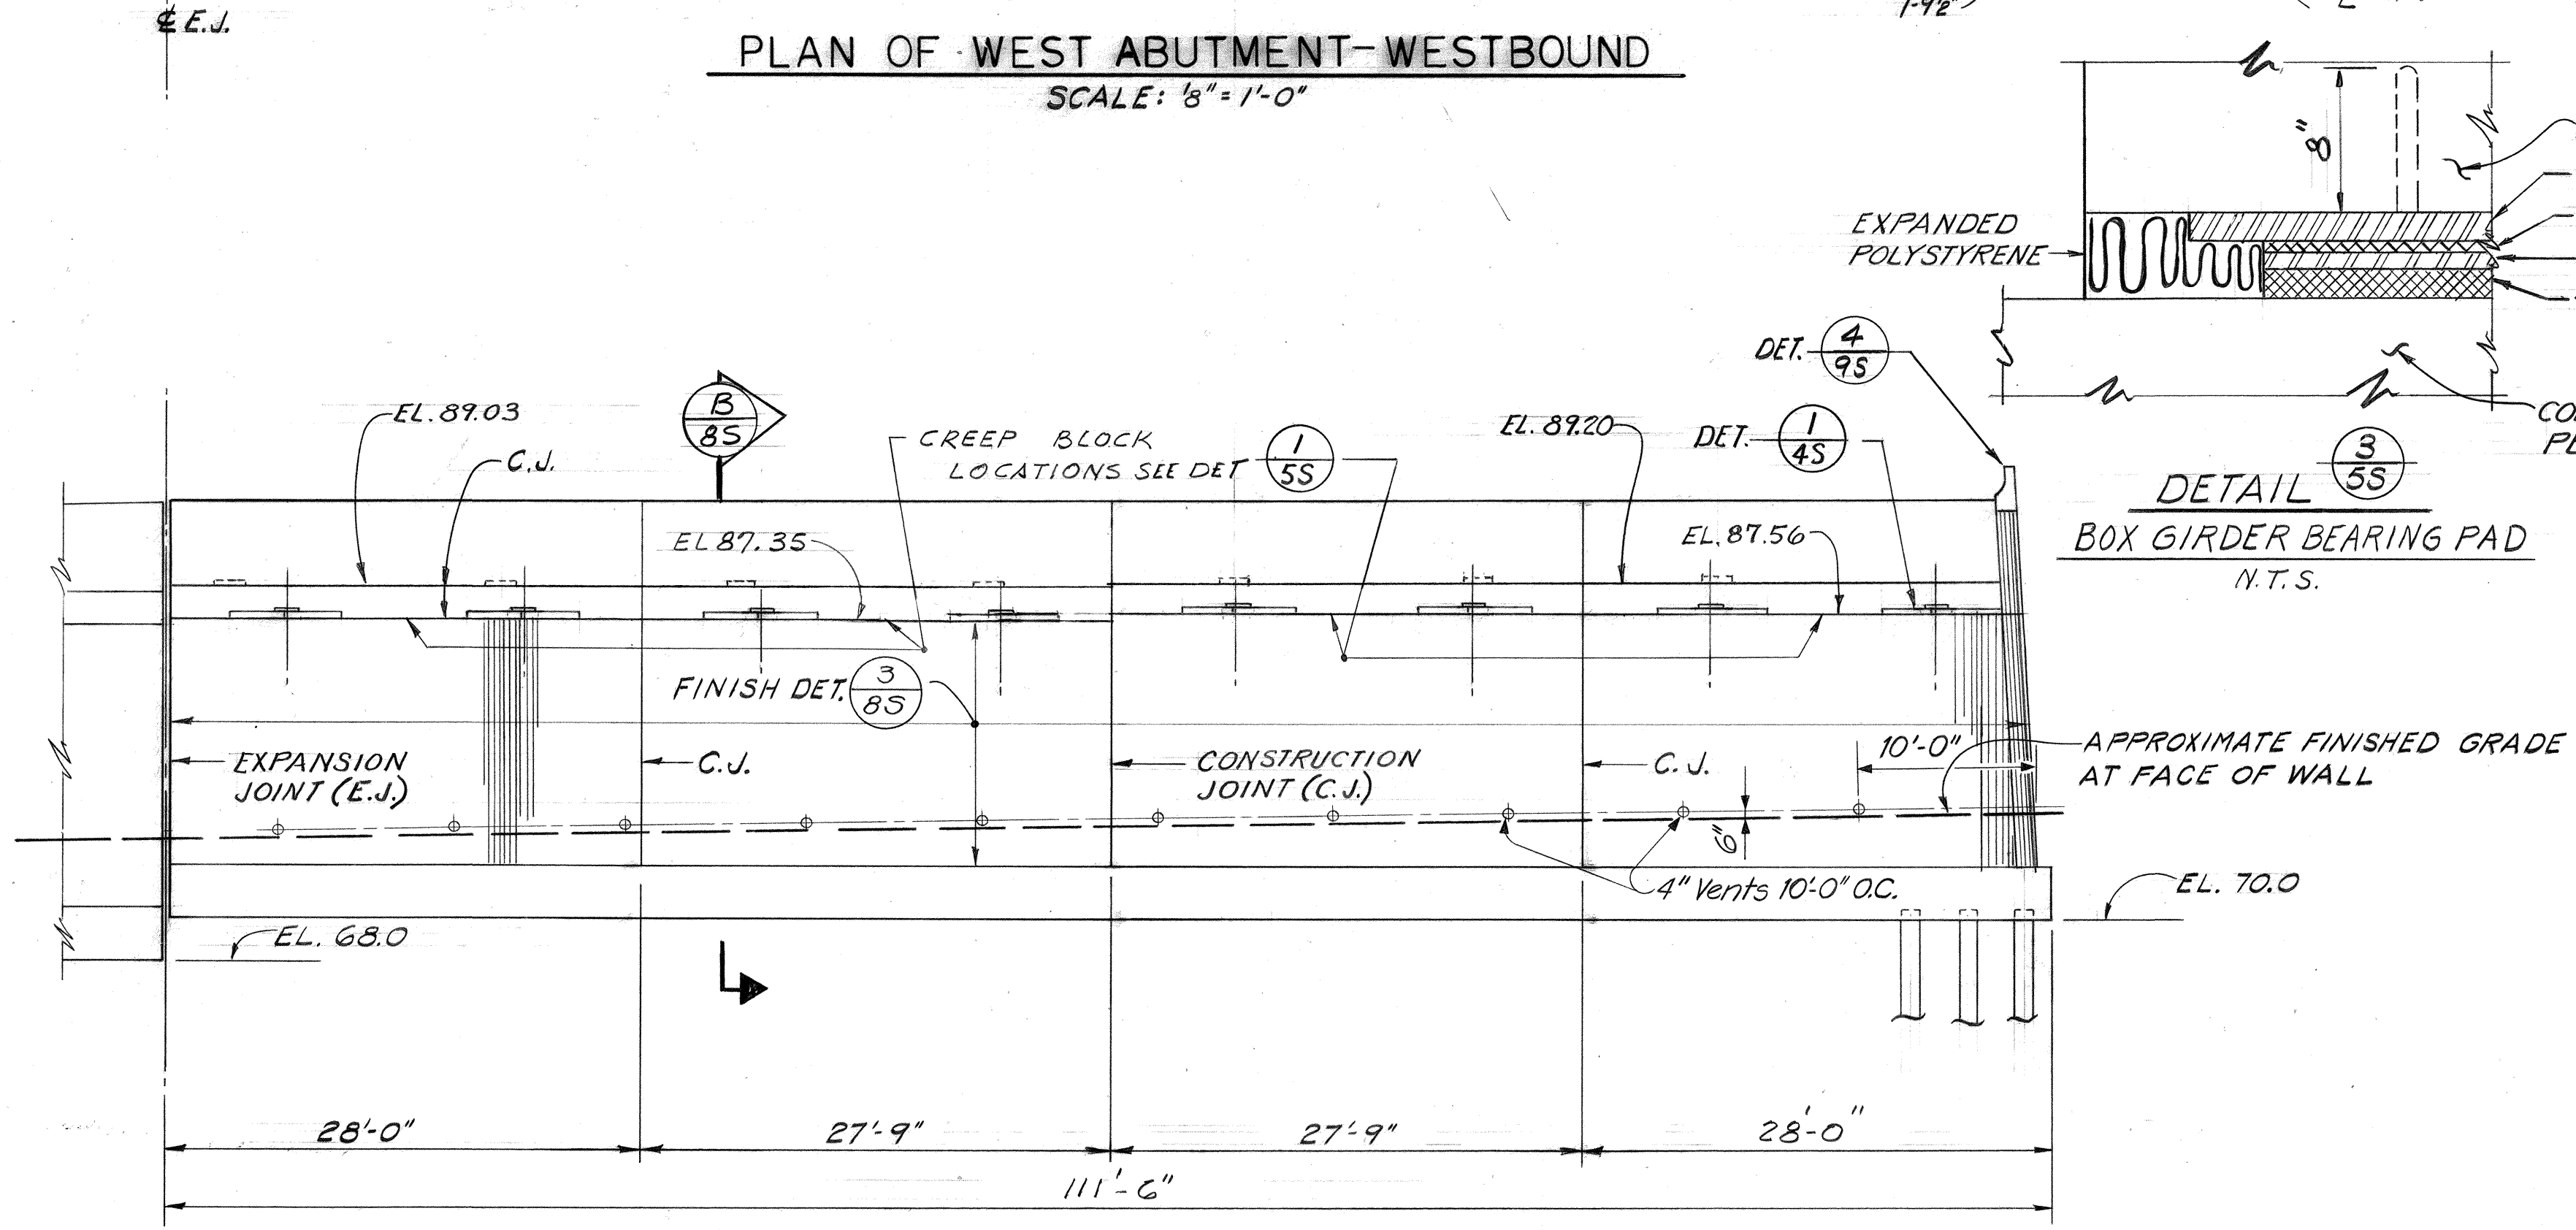

FRONT ELEVATION OF WEST ABUTMENT-WESTBOUND
SCALE: 3/8" = 1'-0"

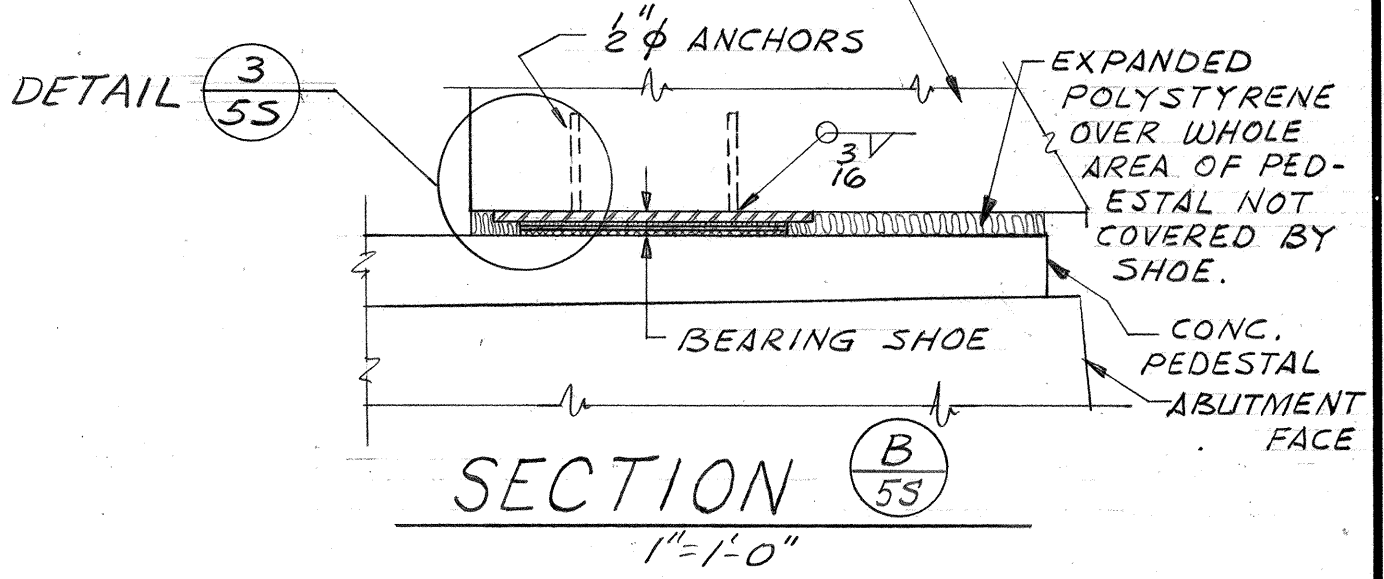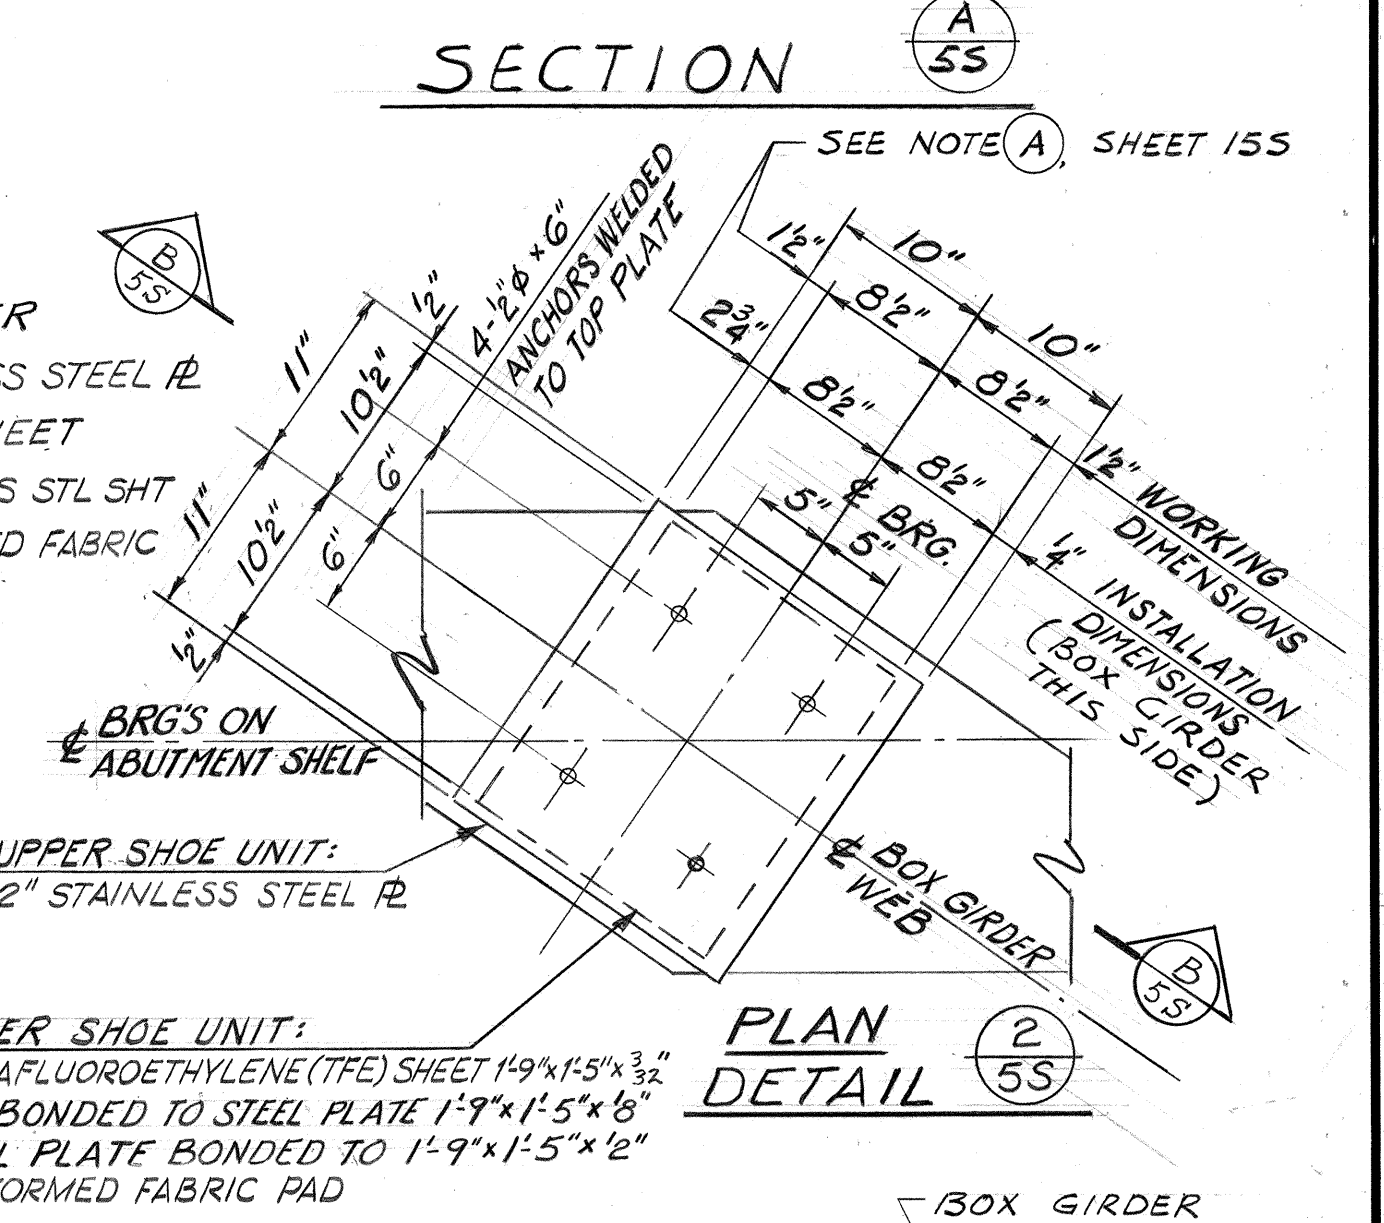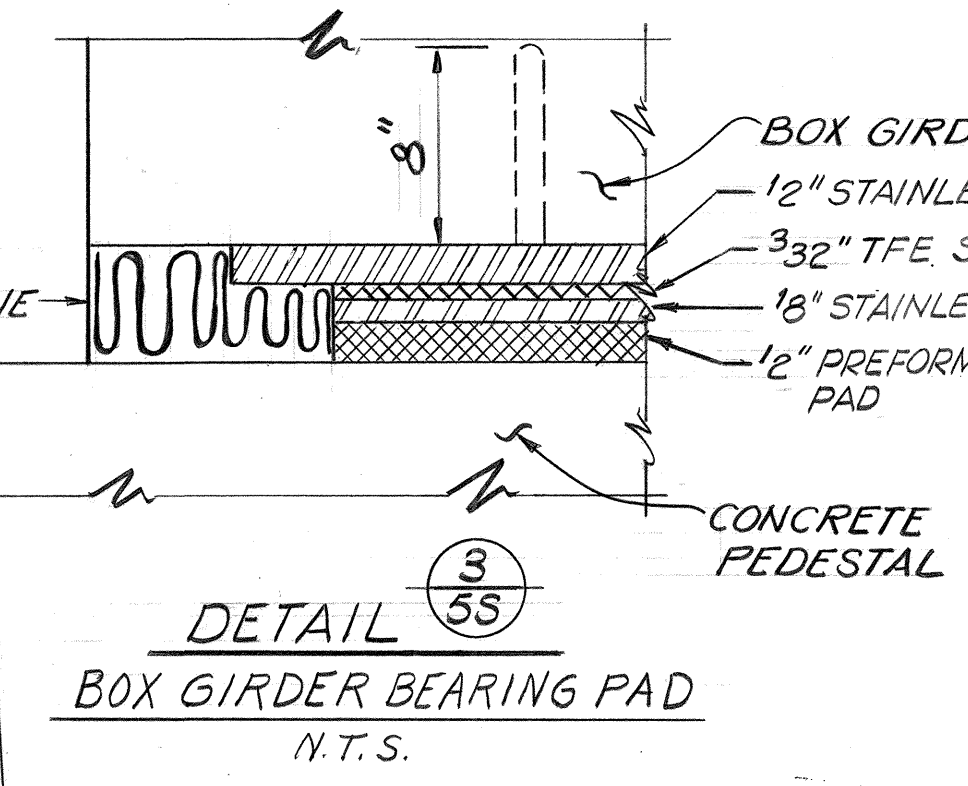

THIS WORK WAS PREPARED BY ME OR UNDER MY SUPERVISION
W. J. Armento



STATE OF HAWAII
DEPARTMENT OF TRANSPORTATION
HIGHWAYS DIVISION
HALAWA INTERCHANGE
STRUCTURE NO. 4
MOANALUA FREEWAY OVER H-3
WEST ABUTMENT,
WESTBOUND
PROJ. No. I-H-1(89)13 DATE: MAY 1971
SHEET No. 5S OF 19S SHEETS

SURVEY PLOTTED BY: [Signature]
DATE: 5/24/71
DESIGNED BY: [Signature]
CHECKED BY: [Signature]
ORIGINAL PLAN NOTE BOOK No. [Blank]

132'-6"

7'-0"


3'-6" HOOK @ LAST
3 BARS

4'-10"

4'-2"

TYP. REINF.
SEE BS

BS

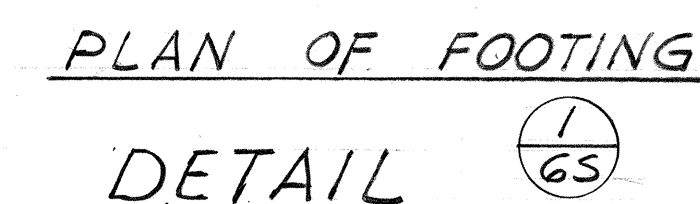

4G27	91.84
4G28	91.56
4G29	91.29
4G30	91.01
4G31	90.74
4G32	90.47
4G33	90.19
4G34	89.92
4G35	89.64
4G36	89.37



Hand-drawn cross-section of a bridge deck showing construction joints, expansion joints, and creep blocks. The drawing includes elevation data (e.g., EL. 93.33, EL. 91.23, EL. 92.69, EL. 90.68, EL. 92.36, EL. 92.04, EL. 90.14, EL. 91.72, EL. 89.59, EL. 91.16, EL. 90.70, EL. 89.04), dimensions (e.g., 27'-0", 27'-9", 22'-3", 28'-9", 26'-9", 132'-6"), and details like "FINISH DETAIL (3/85)", "CONSTRUCTION JOINT (C.J.)", "EXPANSION JOINT (E.J.)", and "APPROXIMATE FINISHED GRADE AT FACE OF WALL". A note indicates "LOCATIONS OF CREEP BLOCKS - SEE DET. 1/55". A note at the bottom right says "4" φ Vents 10'-0" O.C.". A diamond-shaped sign with "B/85" is shown above the deck.

FRONT ELEVATION OF EAST ABUTMENT-EASTBOUND
SCALE: $\frac{1}{8}'' = 1'-0''$



STATE OF HAWAII
DEPARTMENT OF TRANSPORTATION
HIGHWAYS DIVISION
HALAWA INTERCHANGE
STRUCTURE NO. 4
MOANALUA FREEWAY OVER H-3
EAST ABUTMENT,
EASTBOUND
PROJ. No. I-H-1(89)-13 DATE: MAY 1971
SHEET No. 65 OF 195 SHEETS

FED. ROAD DIST. NO.	STATE	FED. AID PROJ. NO.	FISCAL YEAR	SHEET NO.	TOTAL SHEETS
HAWAII	HAW.	I-H1-1(89):13	1971	188	362

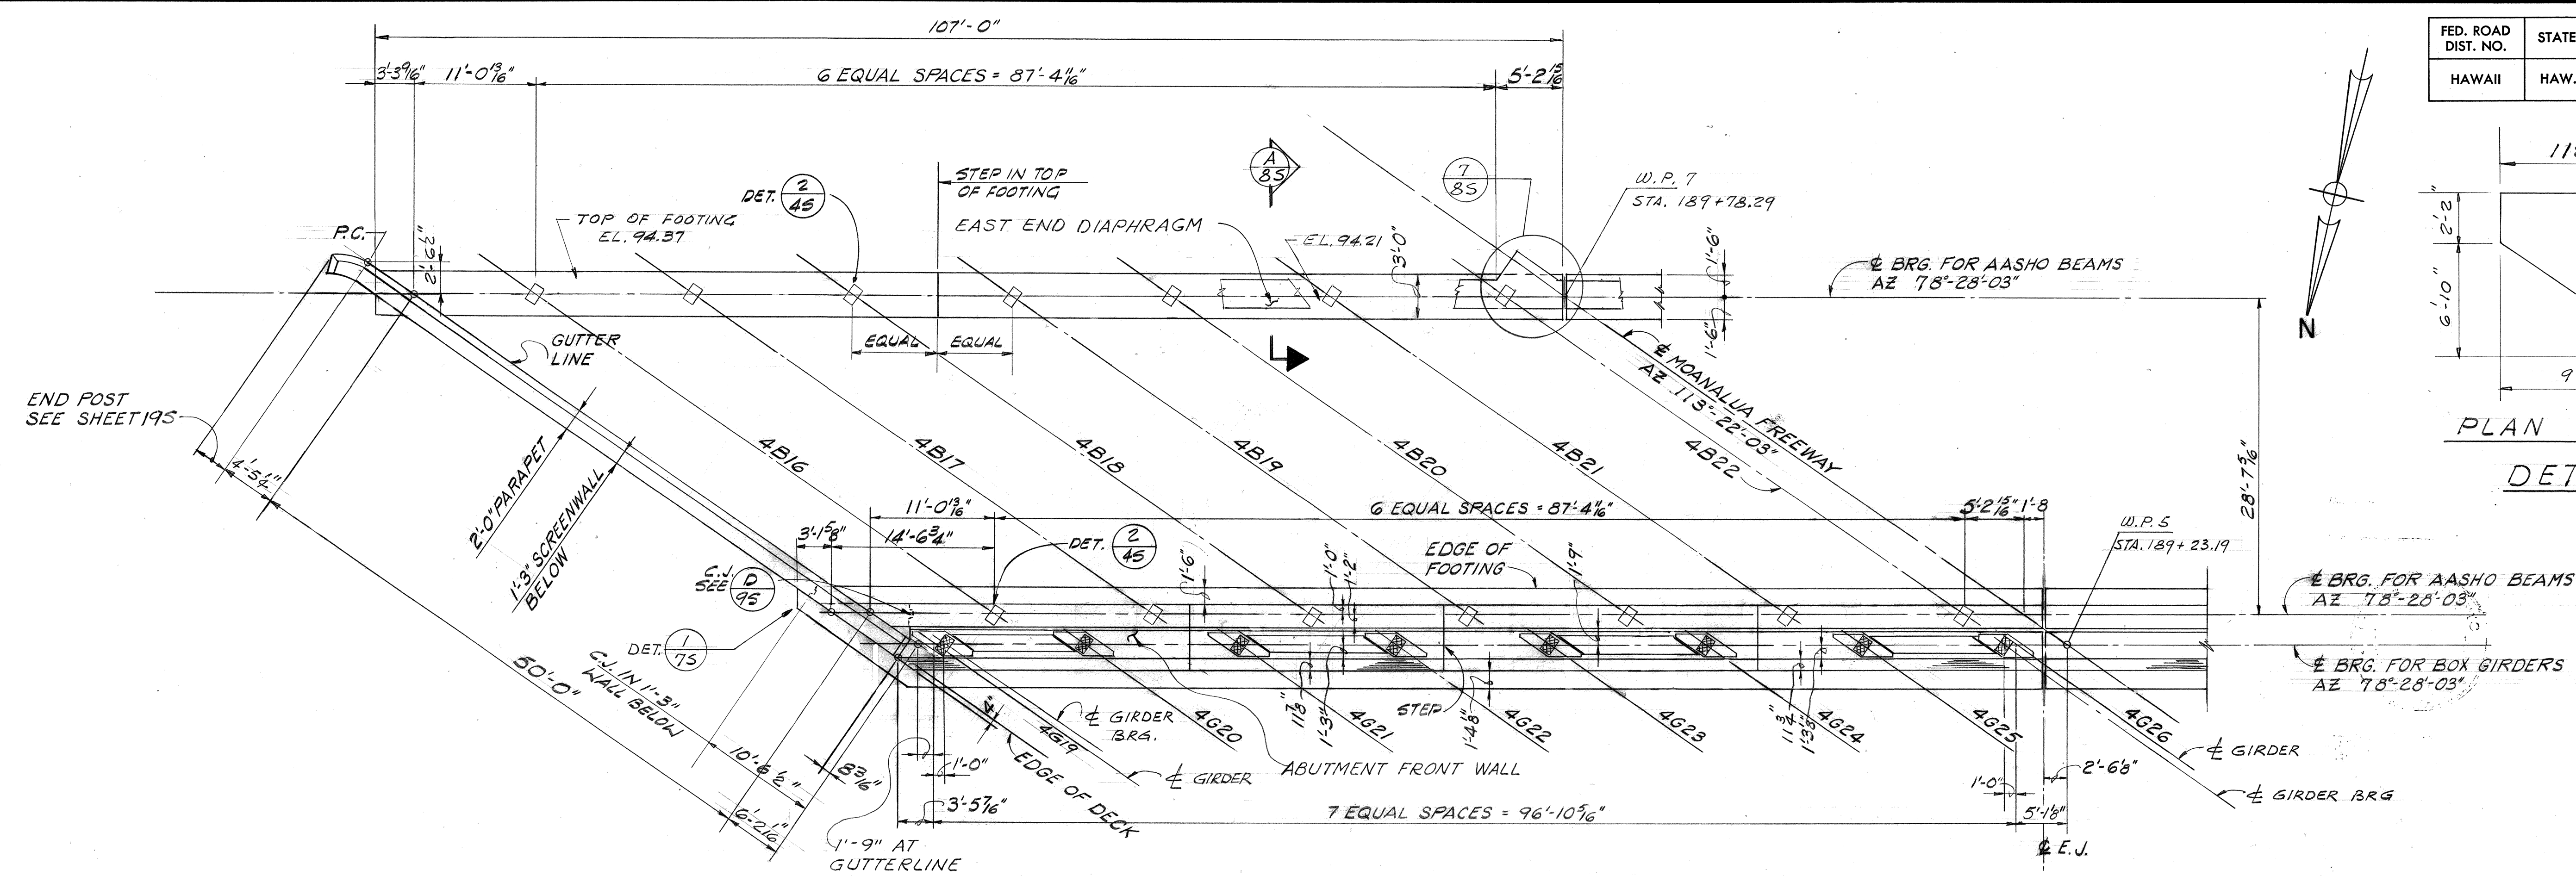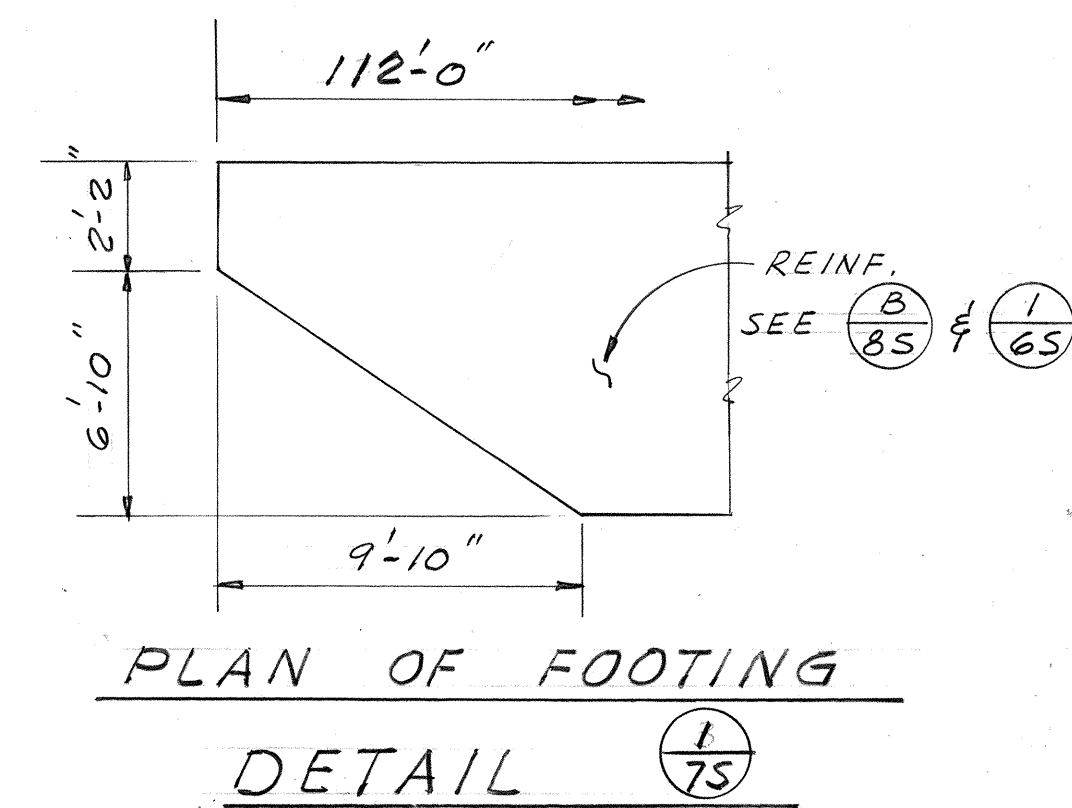


PLAN OF EAST ABUTMENT-WESTBOUND
SCALE: 1/8" = 1'-0"

SEAT ELEVATIONS		
BEAM OR GIRDER MARK	ELEVATION AT TOP OF CONCRETE LEVELING PAD AND CONCRETE PEDESTAL	
	FRONT WALL	END DIAPHRAGM
4B16	93.95	94.70
4B17	93.90	94.65
4B18	93.84	94.59
4B19	93.79	94.54
4B20	93.73	94.48
4B21	93.68	94.43
4B22	93.63	94.38

4G19	92.32
4G20	92.27
4G21	92.21
4G22	92.16
4G23	92.11
4G24	92.06
4G25	92.01
4G26	91.96

SEE SECTIONS (B/85) AND (A/85)

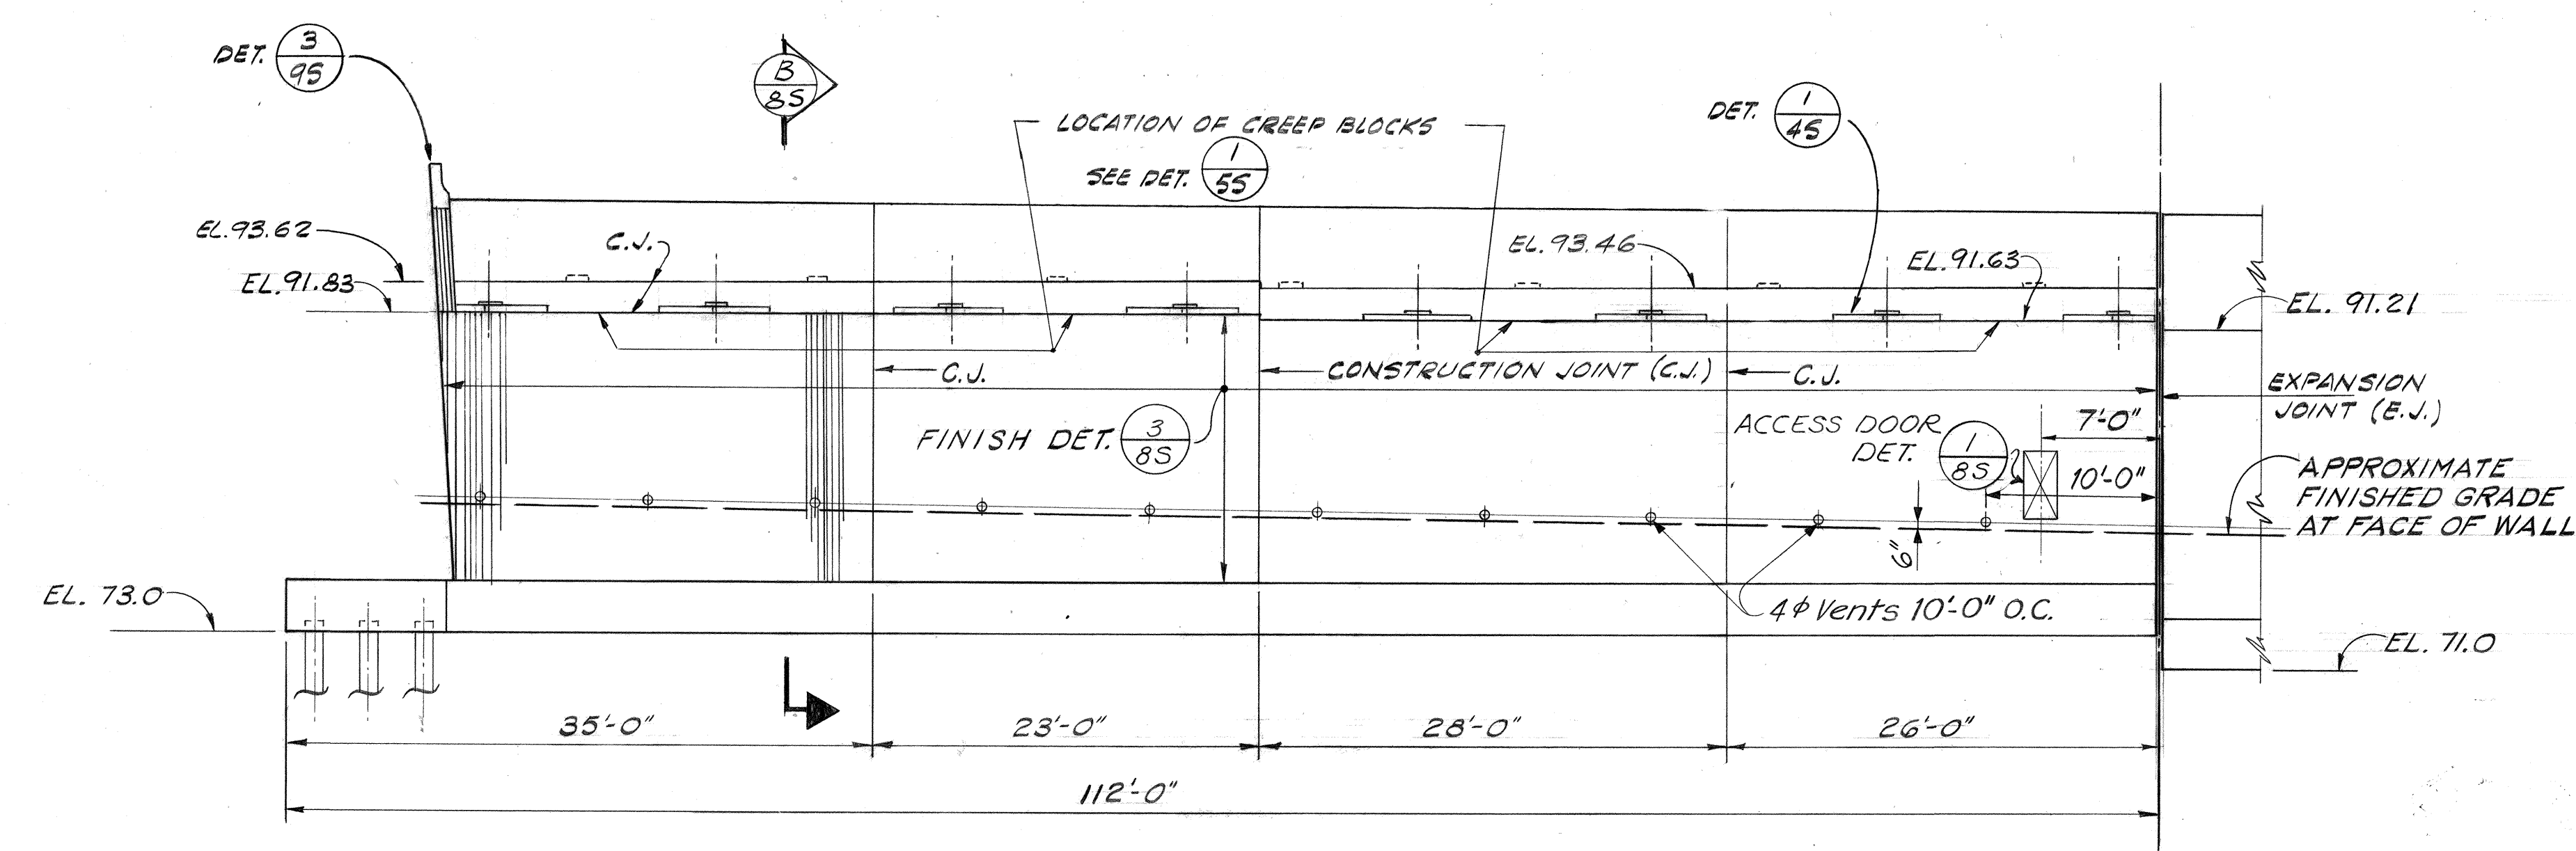

FRONT ELEVATION OF EAST ABUTMENT-WESTBOUND
SCALE: 1/8" = 1'-0"


SURVEY PLATTED BY: DATE: 1/1/72
 DRAWN BY: J. J. Armstrong
 CHECKED BY: J. J. Armstrong
 NOTE BOOK: No. 100

THIS WORK WAS PREPARED BY ME OR UNDER MY SUPERVISION.
Wm. J. Armstrong



STATE OF HAWAII
DEPARTMENT OF TRANSPORTATION
HIGHWAYS DIVISION
HALAWA INTERCHANGE
STRUCTURE NO. 4
MOANALUA FREEWAY OVER H-3
EAST ABUTMENT,
WESTBOUND
PROJ. No. I-H1-1(89):13 DATE: MAY 1971
SHEET No. 75 OF 195 SHEETS

FED. ROAD DIST. NO.	STATE	FED. AID PROJ. NO.	FISCAL YEAR	SHEET NO.	TOTAL SHEETS
HAWAII	HAW.	I-H1-1(89)13	1971	101	362


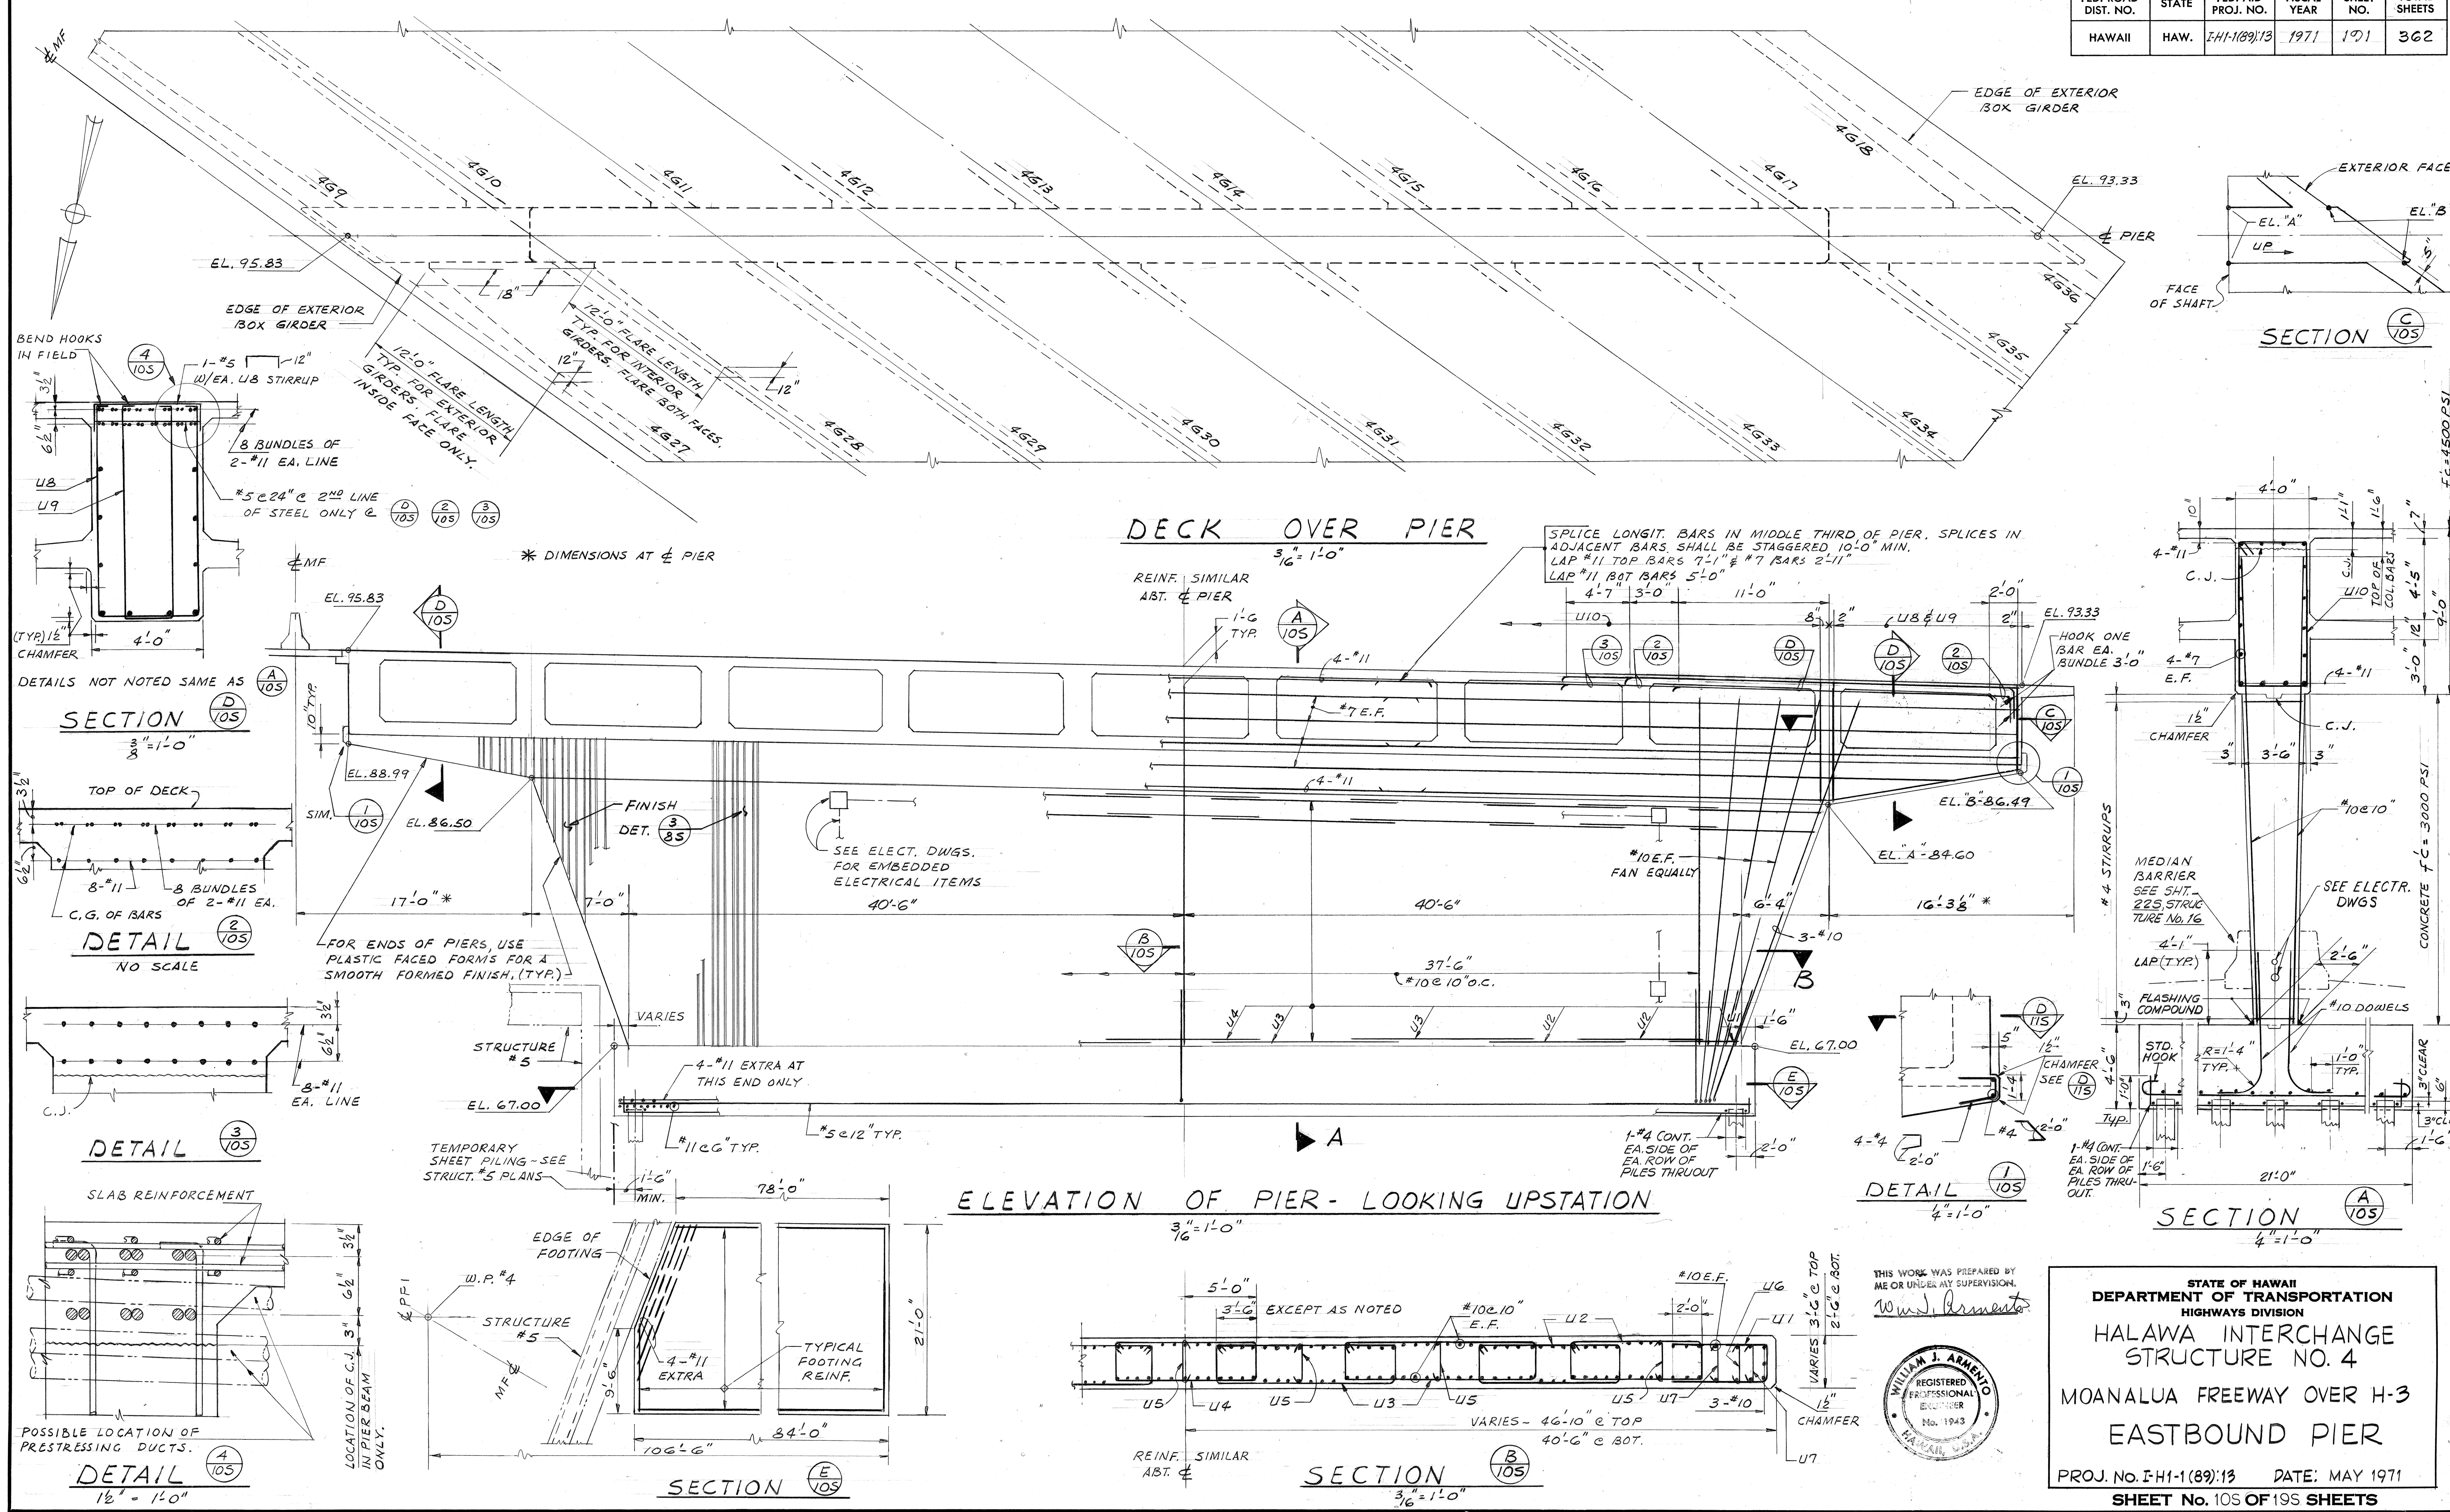


SURVEY PLATTED BY
 PLAN
 DESIGNED BY
 NOTE BOOK
 CHECKED BY



THIS WORK WAS PREPARED BY
 ME OR UNDER MY SUPERVISION.
 WILLIAM J. ARNETTO
 REGISTERED PROFESSIONAL ENGINEER
 No. 1943
 HAWAII, U.S.A.

STATE OF HAWAII
 DEPARTMENT OF TRANSPORTATION
 HIGHWAYS DIVISION
 HALAWA INTERCHANGE
 STRUCTURE NO. 4
 MOANALUA FREEWAY OVER H-3
 EASTBOUND PIER
 PROJ. NO. I-H1-1(89)13 DATE: MAY 1971
 SHEET No. 101 OF 195 SHEETS

FED. ROAD DIST. NO.	STATE	FED. AID PROJ. NO.	FISCAL YEAR	SHEET NO.	TOTAL SHEETS
HAWAII	HAW.	I-H-1(89)13	1971	192	362

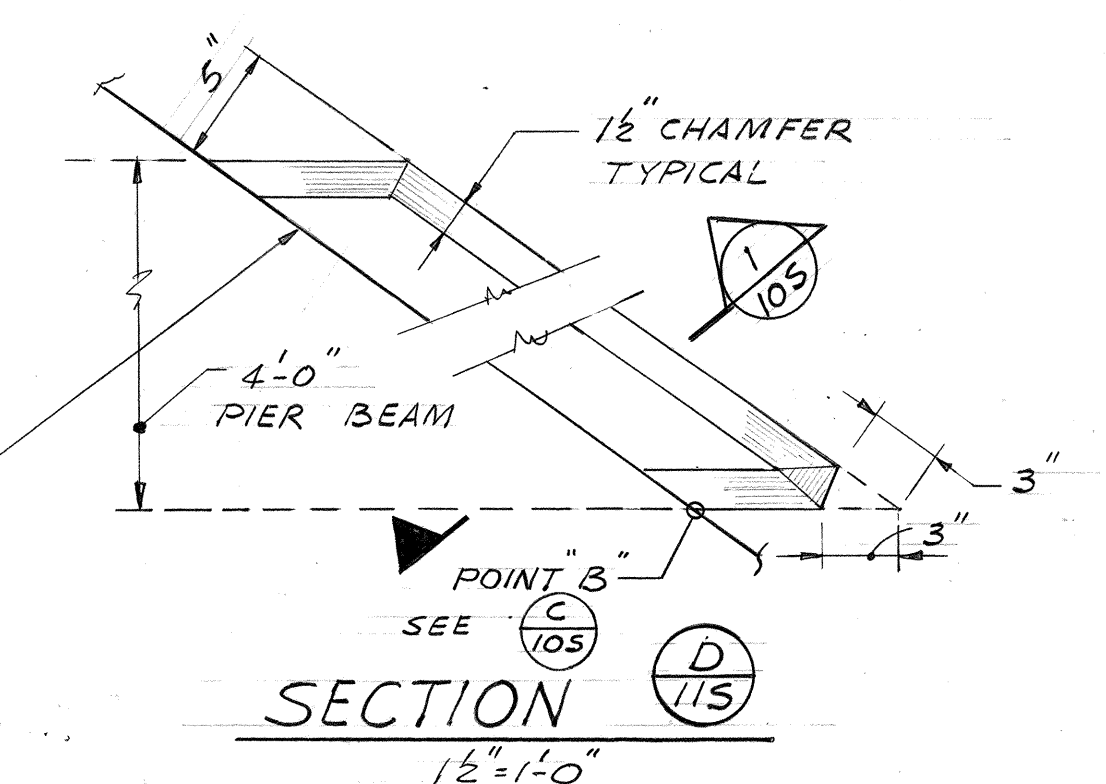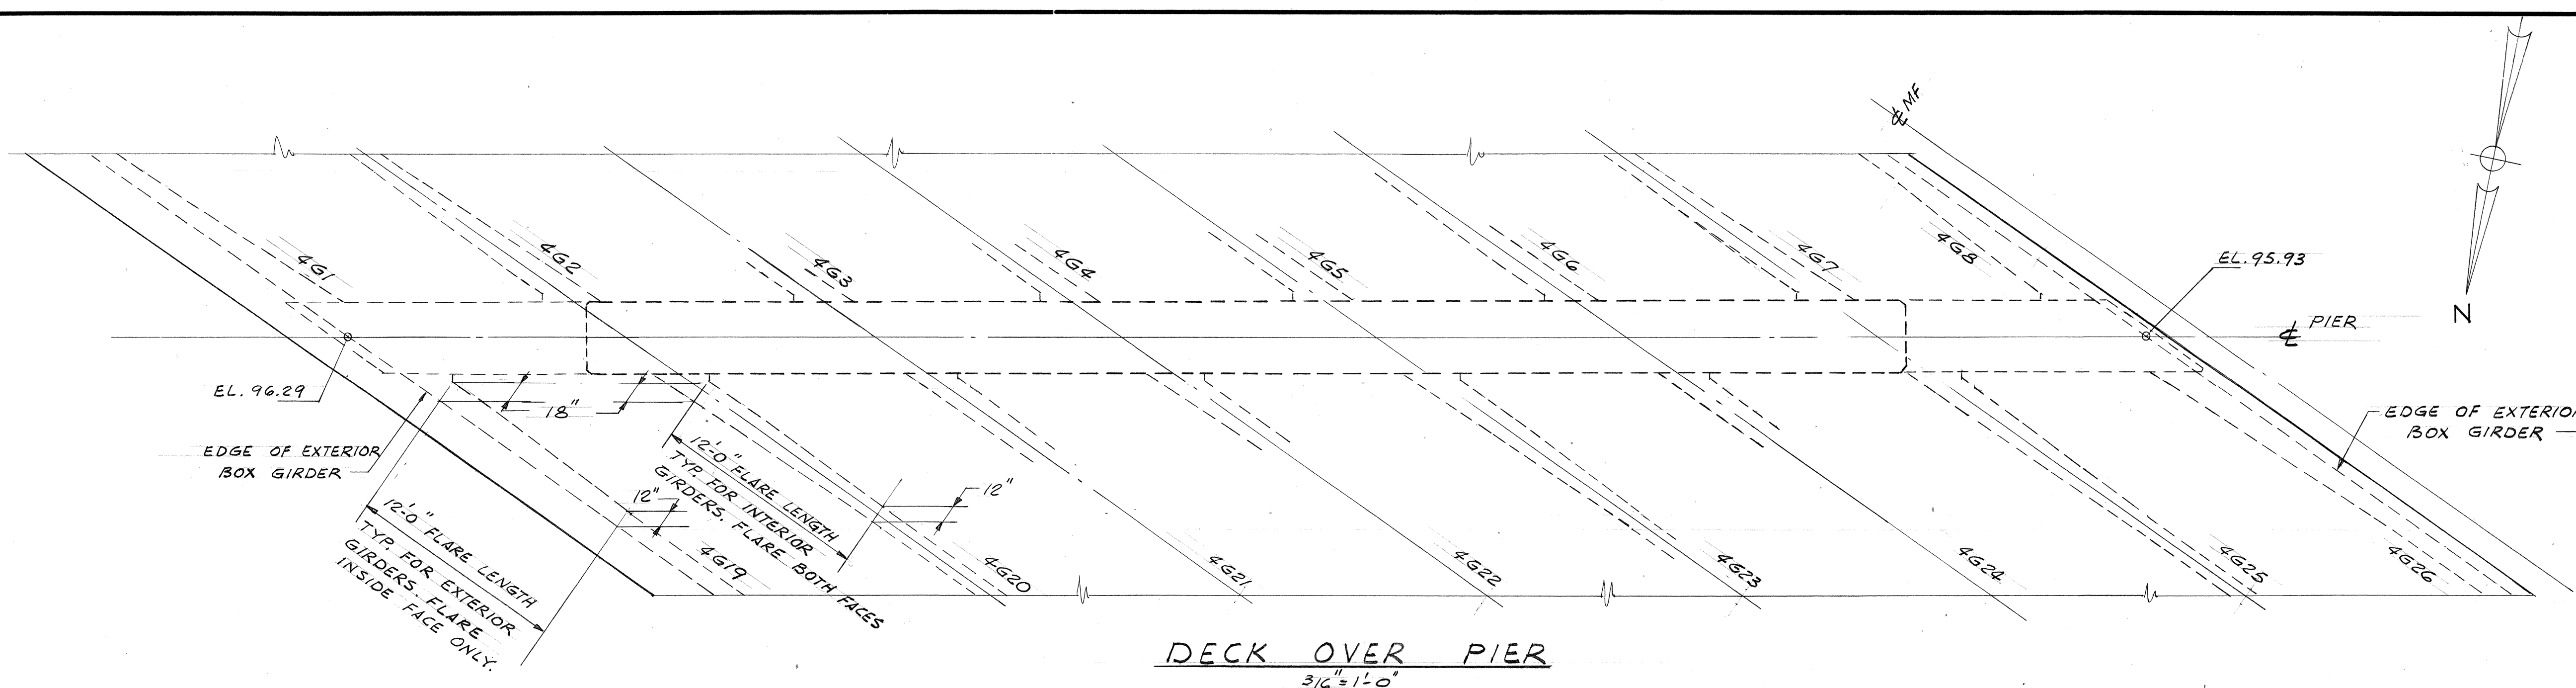


DECK OVER PIER
3/8" = 1'-0"

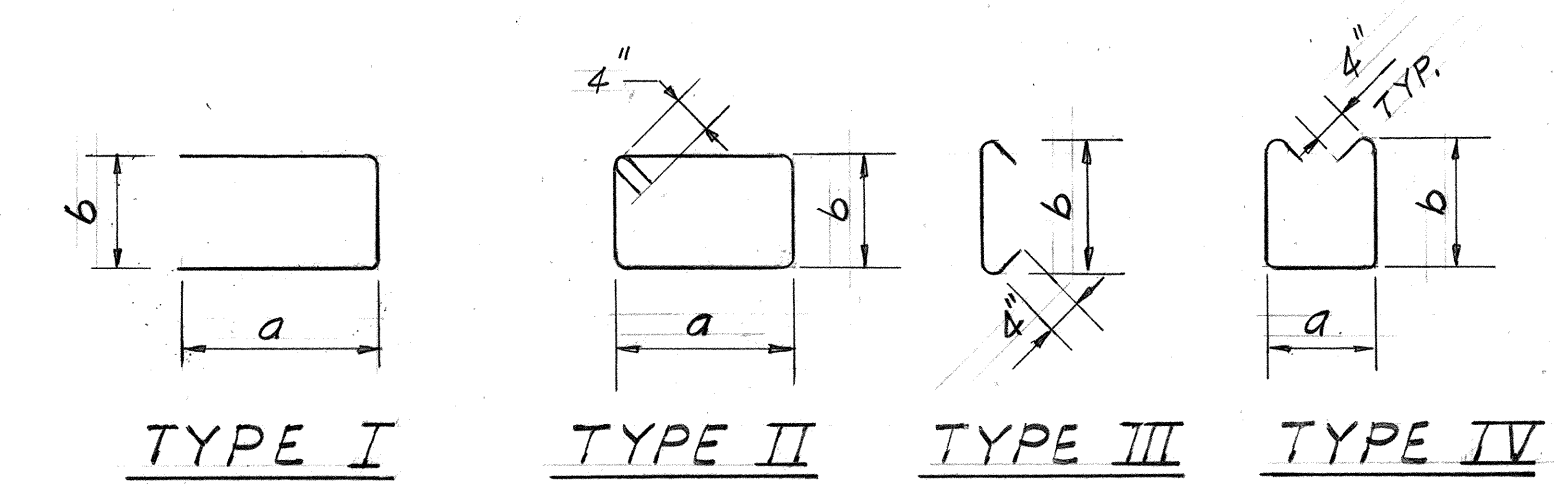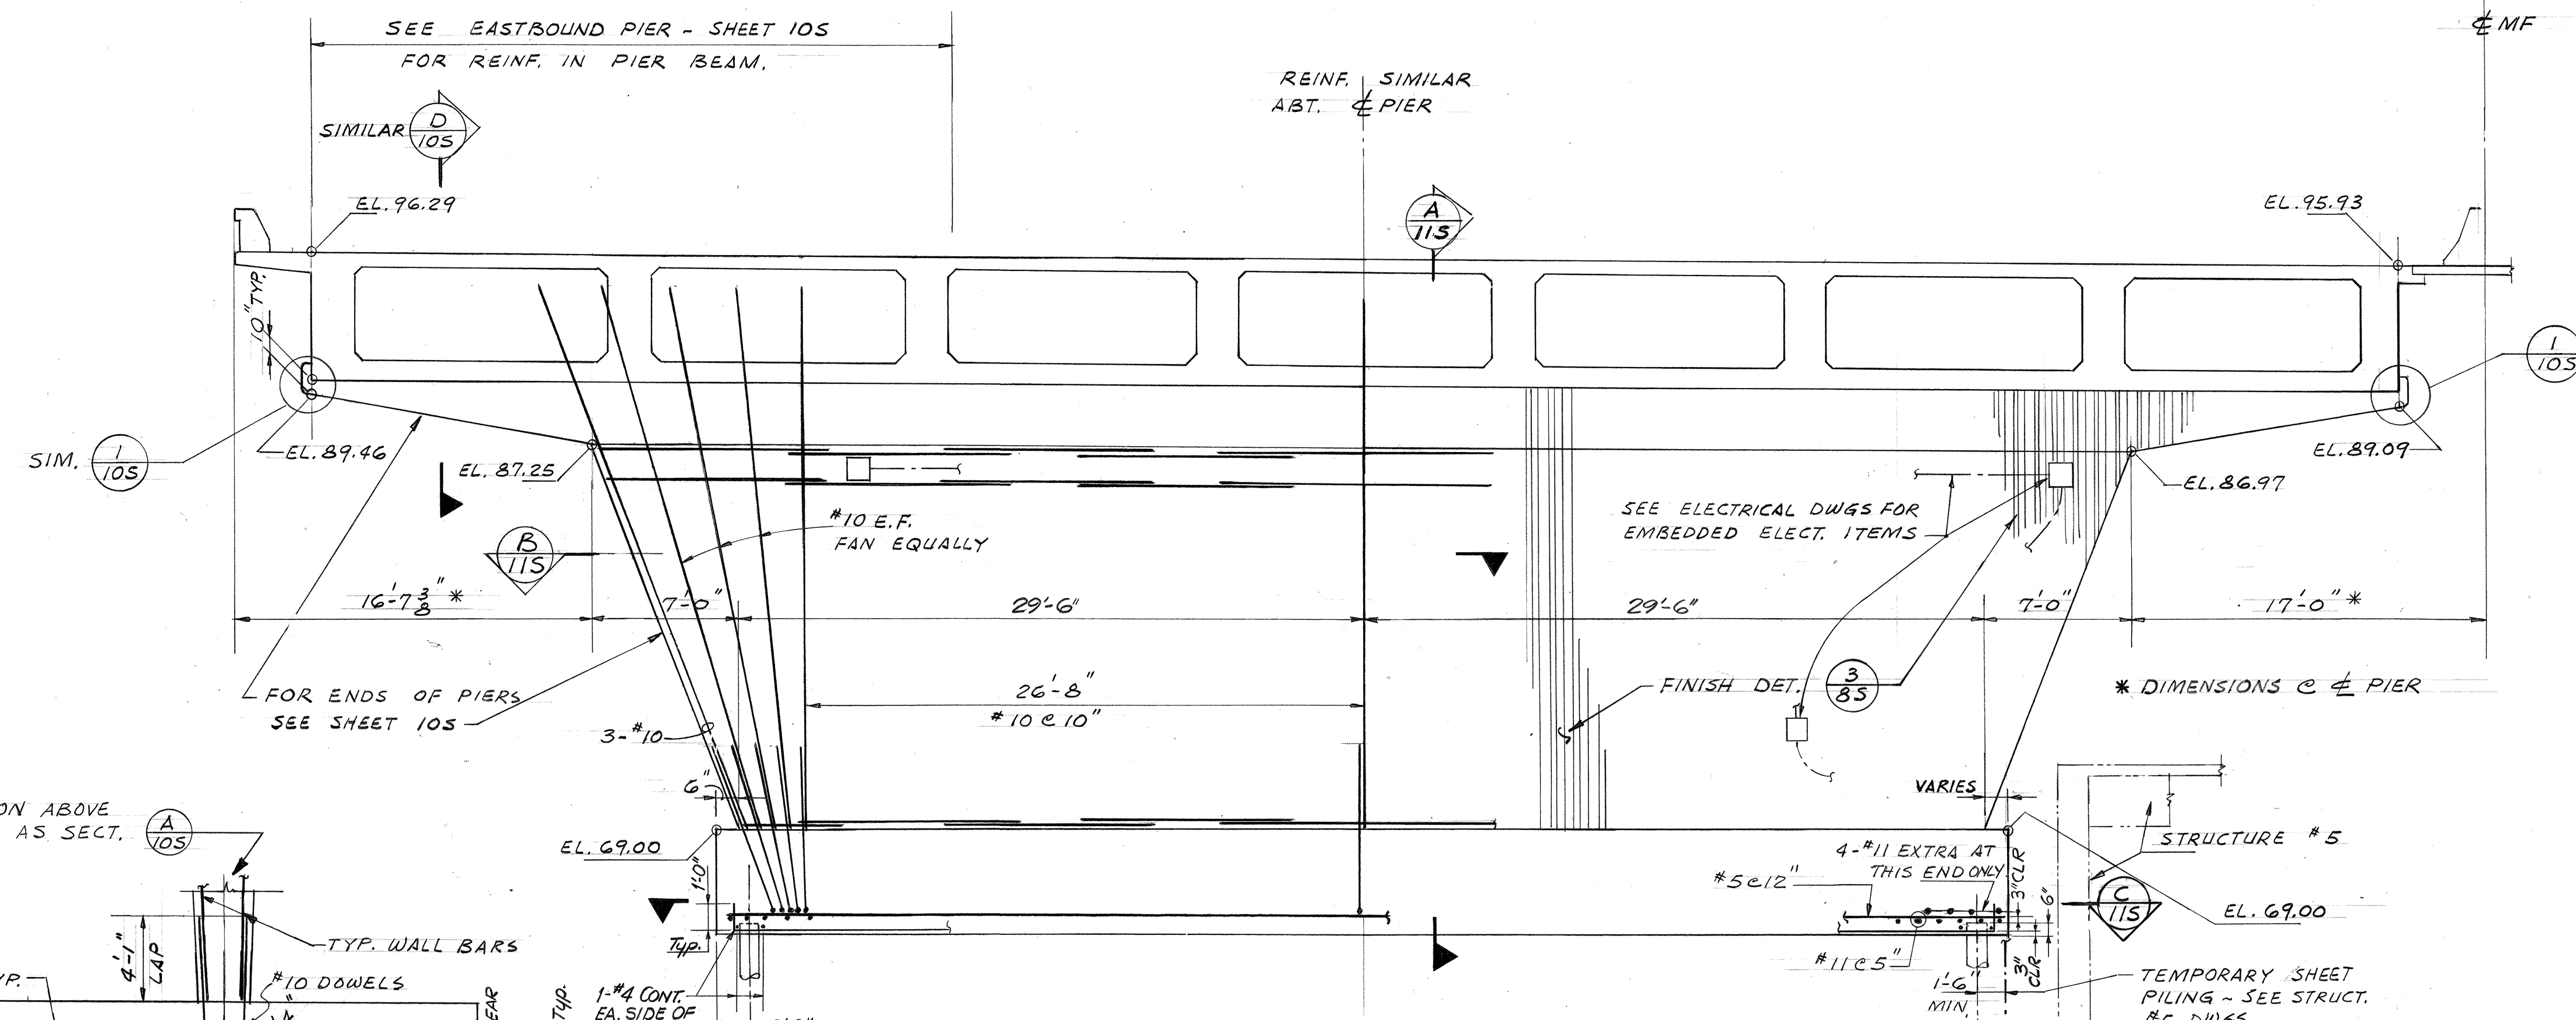


STIRRUP SCHEDULE

BAR MARK	TYPE	SIZE & SPACING	DIMENSIONS					REMARKS
			a	b	c	d	e	
U1	I	#4 @ 12"	VARIES	VARIES				
U2	II	#4 @ 12"	10'-2"	VARIES				
U3	II	#4 @ 12"	13'-6"	VARIES				
U4	II	#4 @ 12"	10'-0"	VARIES				
U5	III	#4 @ 12"	—	VARIES				
U6	III	#4 @ 12"	—					TOP 12'-0" ONLY
U7	III	#4 @ 12"	—	VARIES				TOP 5'-0" ONLY
U8	IV	#6 @ 8"	SEE (D/105)					HOOK IN FIELD
U9	IV	#6 @ 8"	SEE (D/105)					HOOK IN FIELD
U10	II	#6 @ 10"	SEE (A/105)					


ELEVATION OF PIER - LOOKING UPSTATION
3/8" = 1'-0"

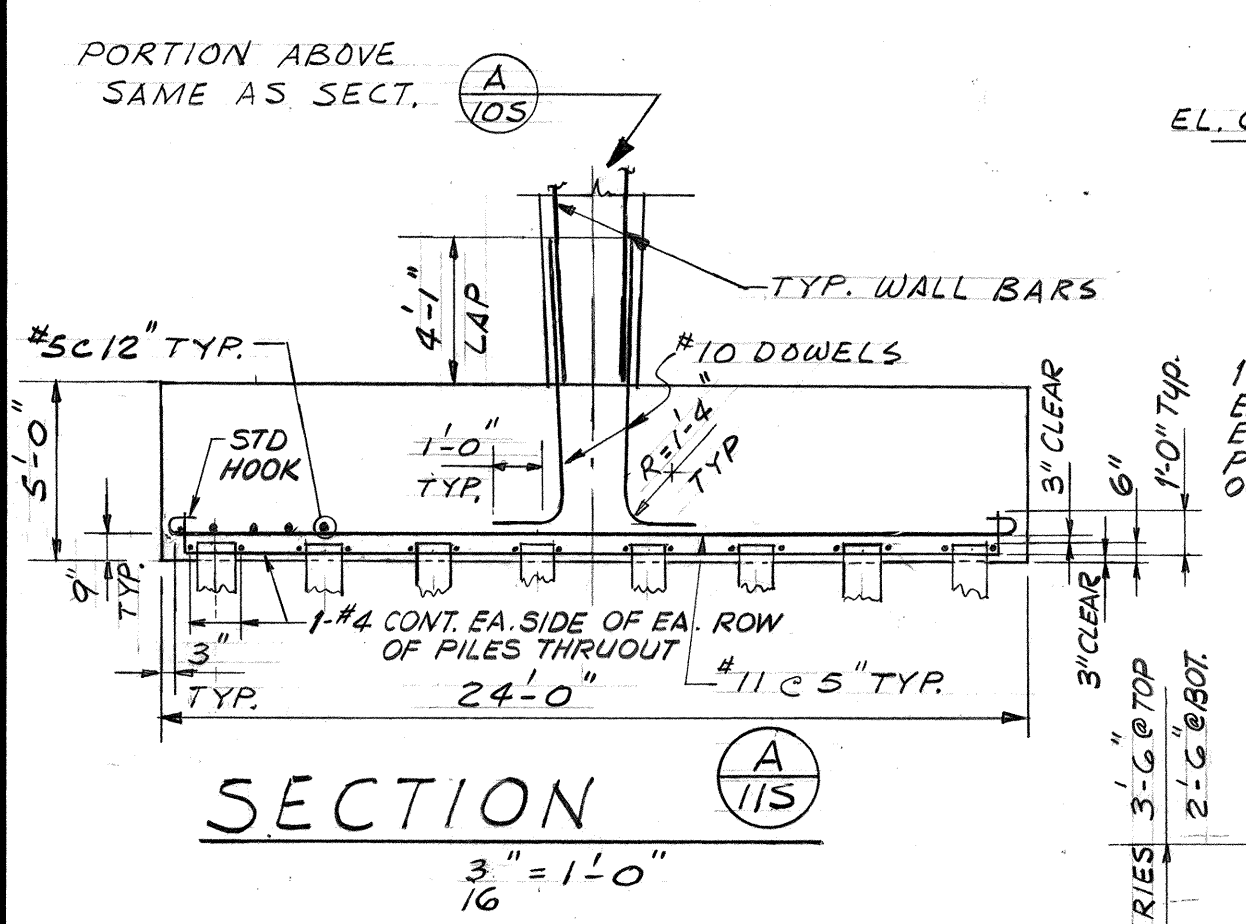

SECTION A/A
3/8" = 1'-0"

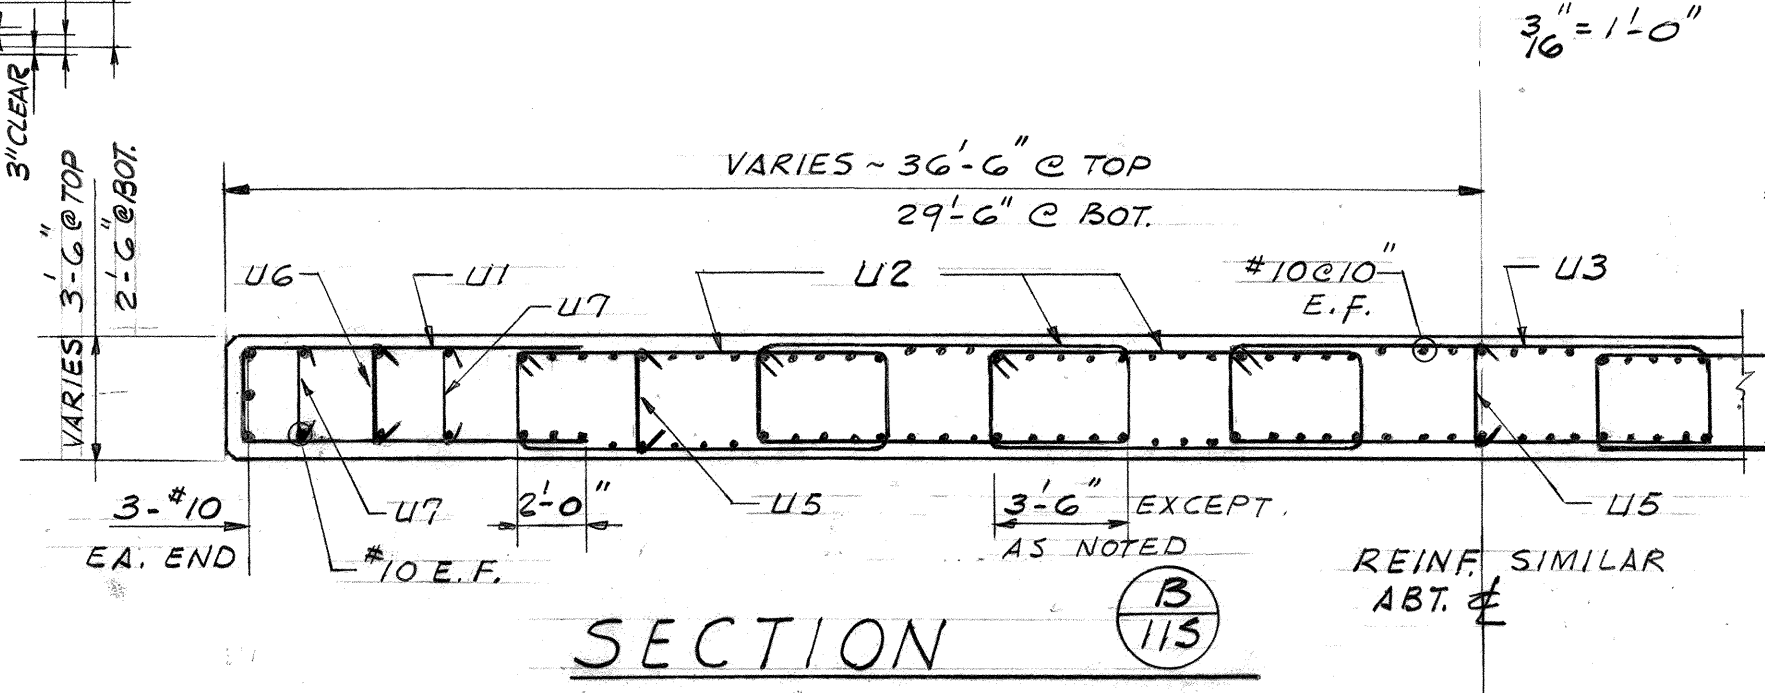

SECTION B/B
3/8" = 1'-0"

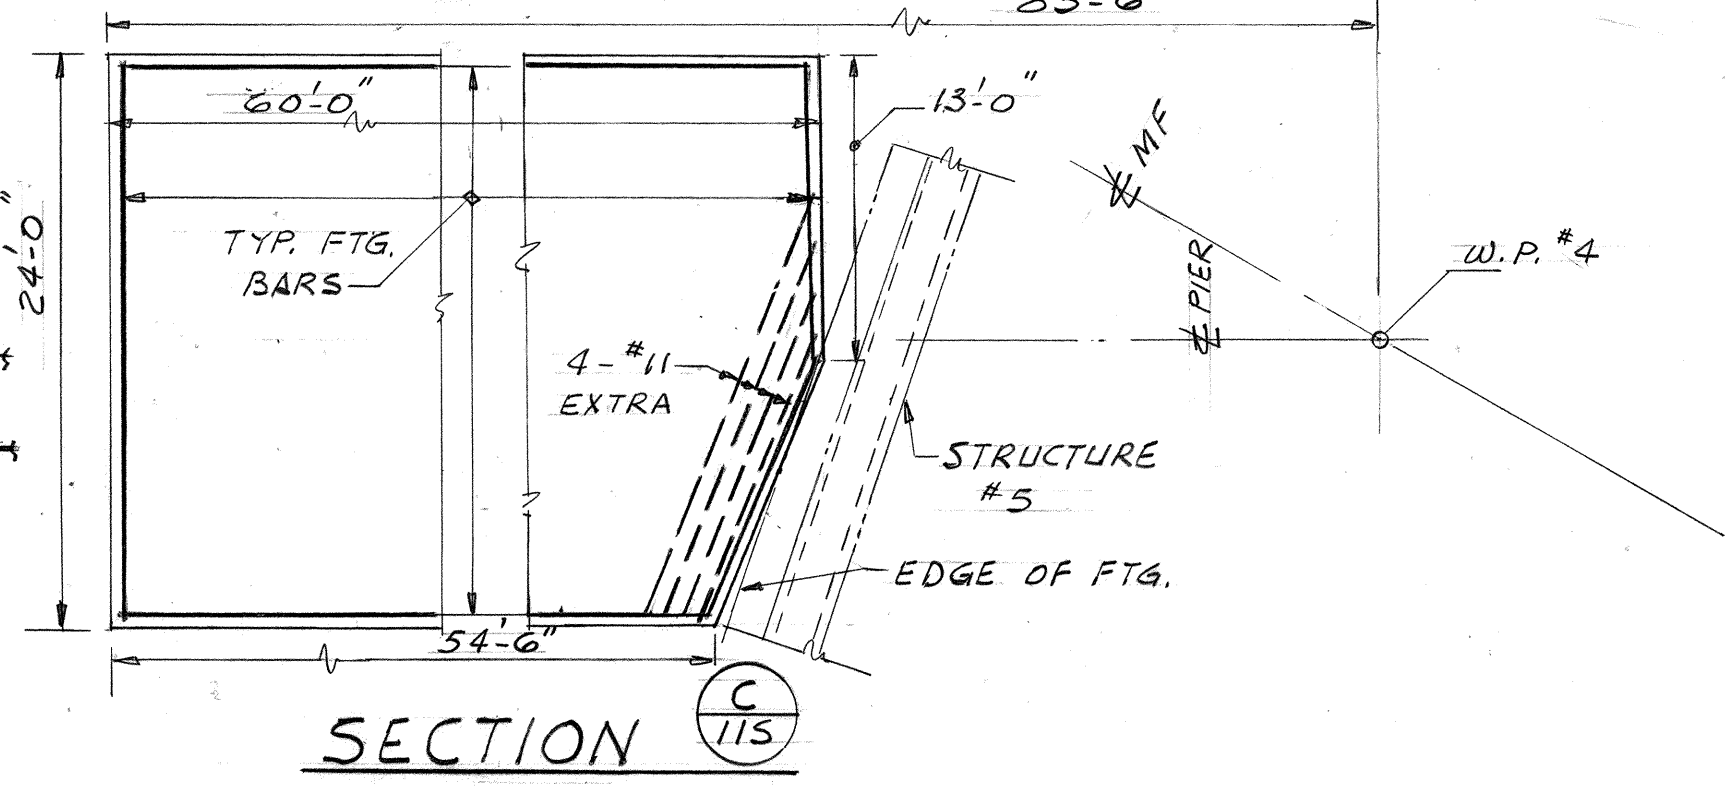

SECTION C/C
3/8" = 1'-0"


THIS WORK WAS PREPARED BY ME OR UNDER MY SUPERVISION.
W. J. Armento



STATE OF HAWAII
DEPARTMENT OF TRANSPORTATION
HIGHWAYS DIVISION
HALAWA INTERCHANGE
STRUCTURE NO. 4
MOANALUA FREEWAY OVER H-3
WESTBOUND PIER
PROJ. No. I-H-1(89)13 DATE: MAY 1971
SHEET No. 115 OF 195 SHEETS


DATE	1/24/72
DESIGNED BY	W. J. Armento
CHECKED BY	W. J. Armento
ORIGINAL PLAN	1/24/72
NOTE BOOK	1/24/72
NO.	1/24/72

FED. ROAD DIST. NO.	STATE	FED. AID PROJ. NO.	FISCAL YEAR	SHEET NO.	TOTAL SHEETS
HAWAII	HAW.	I-H-1(89)13	1971	193	362

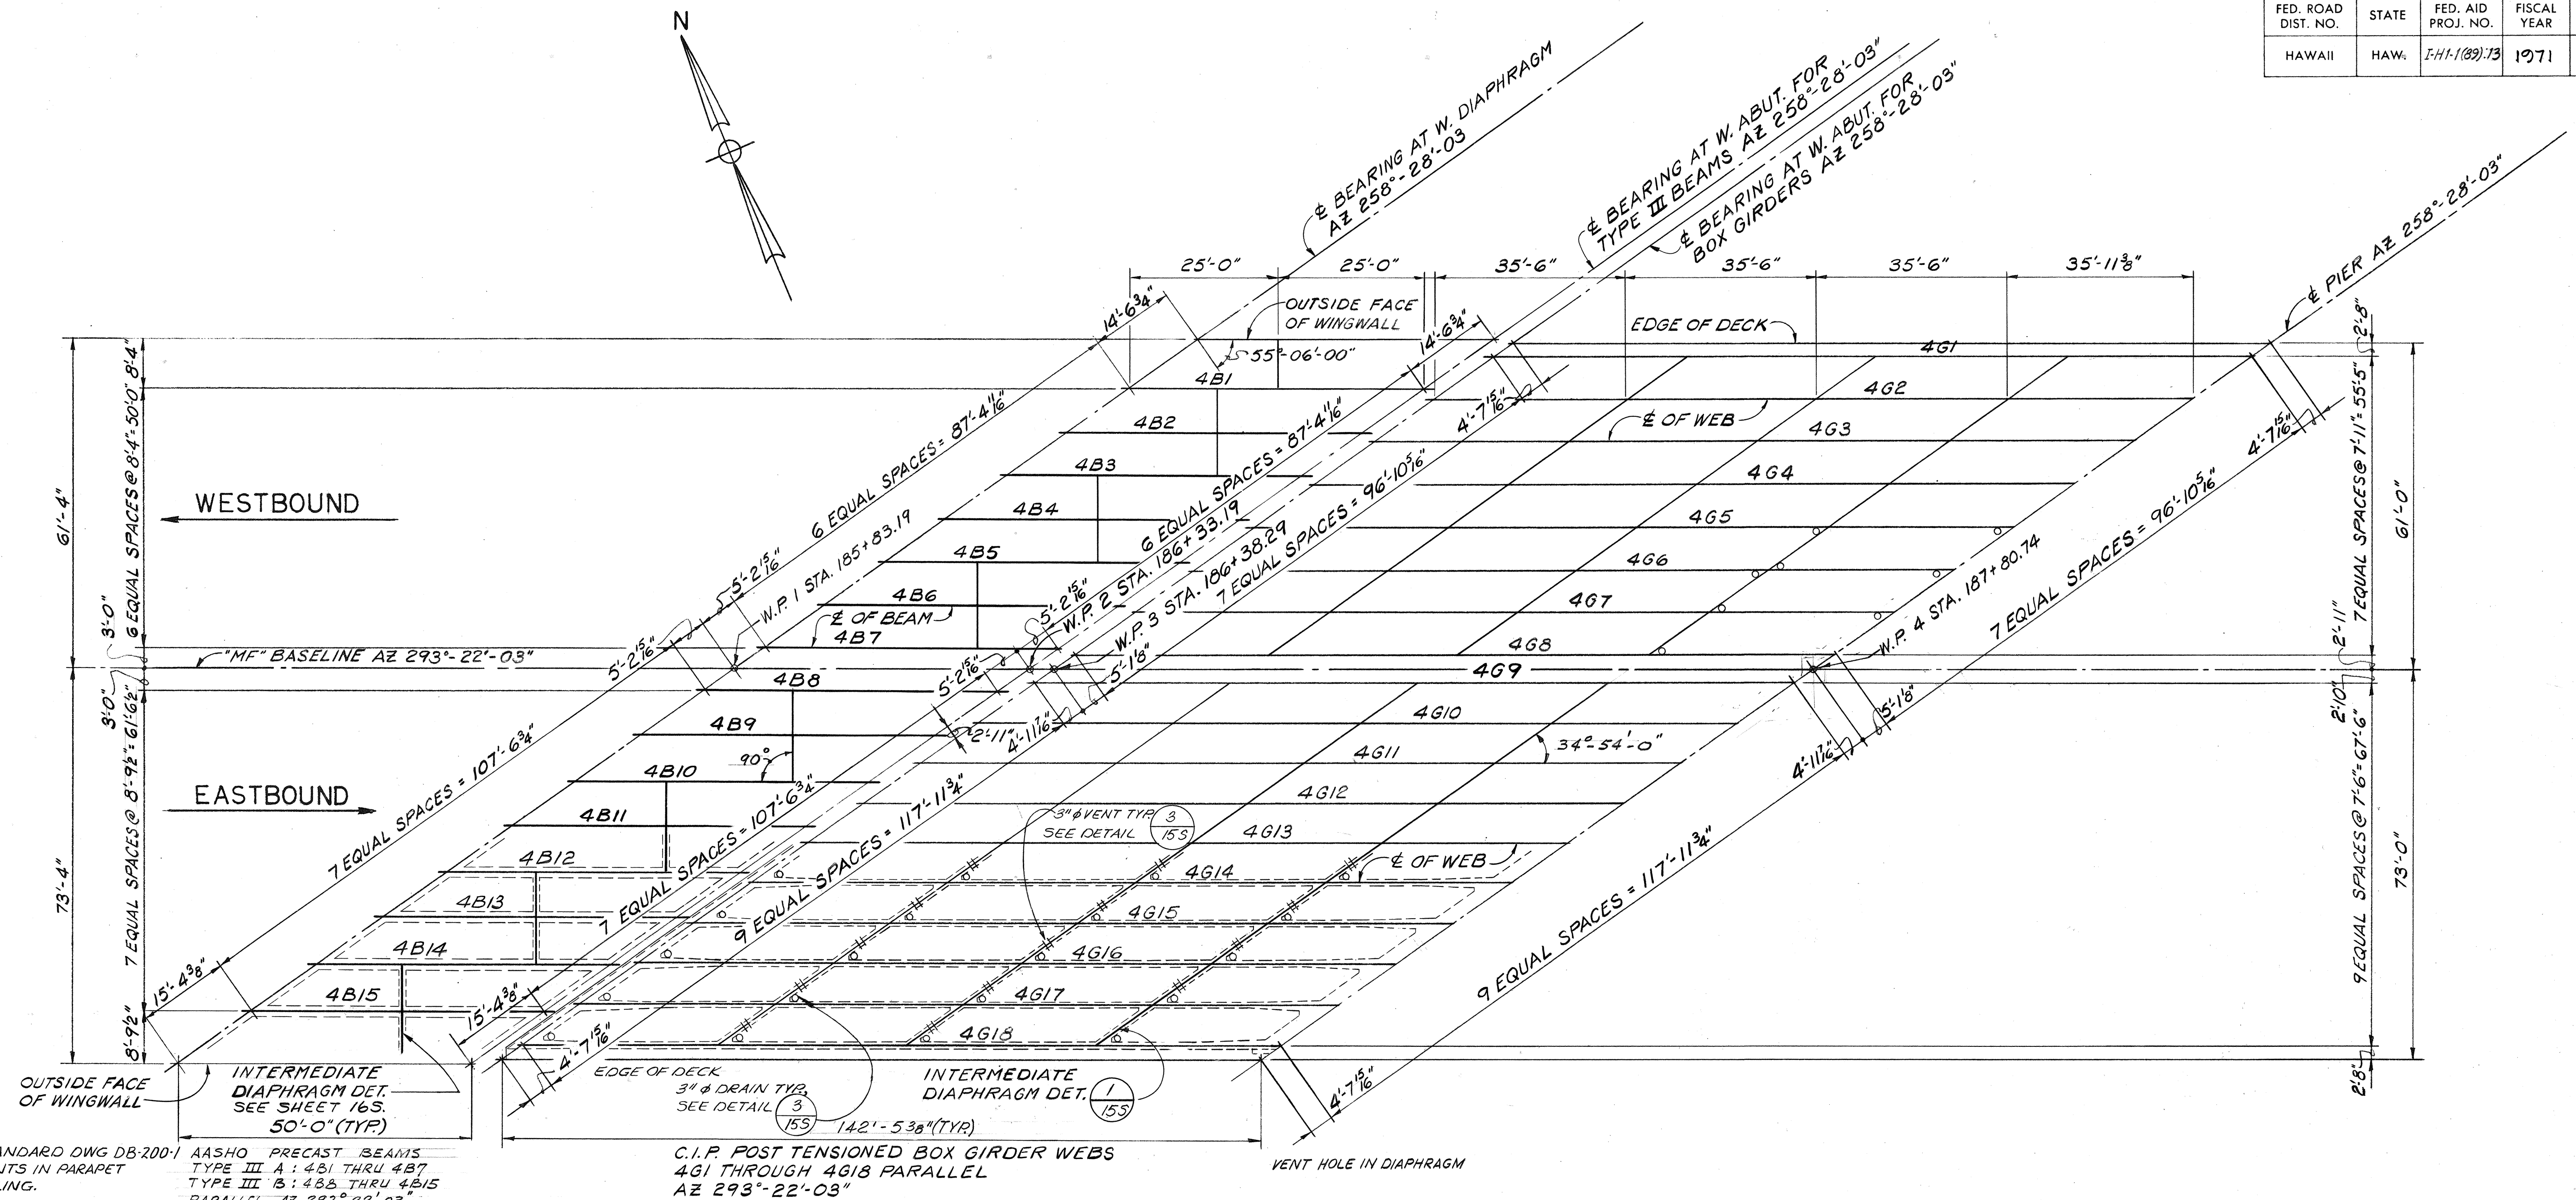


WEST FRAMING PLAN
SCALE: 1/8" = 1'-0"

NOTE:
FORMS SUPPORTING THE CONCRETE TOP SLAB OF BOX GIRDER IF LEFT IN PLACE, SHALL BE SUCH THAT THEY OFFER MINIMUM RESISTANCE TO POST TENSIONING OPERATION.

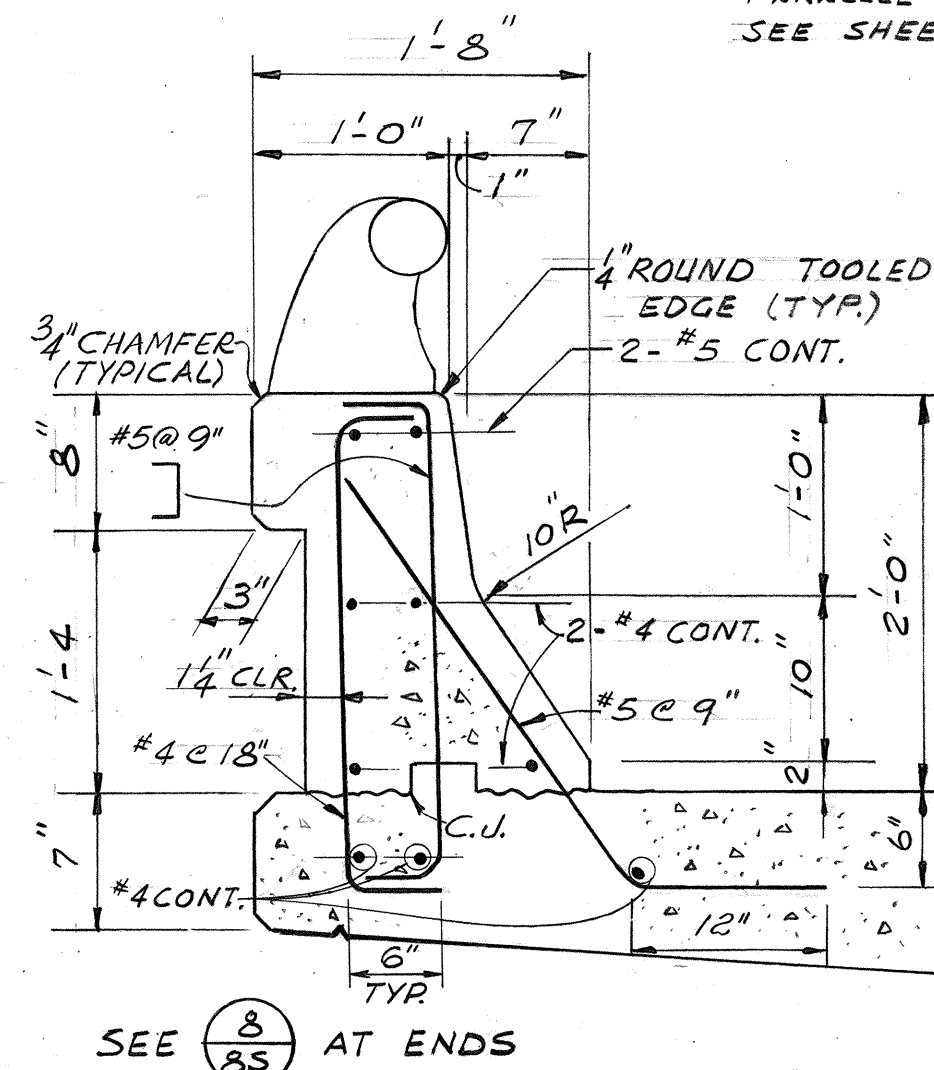


DETAIL 1/125
SCALE: 1" = 1'-0"

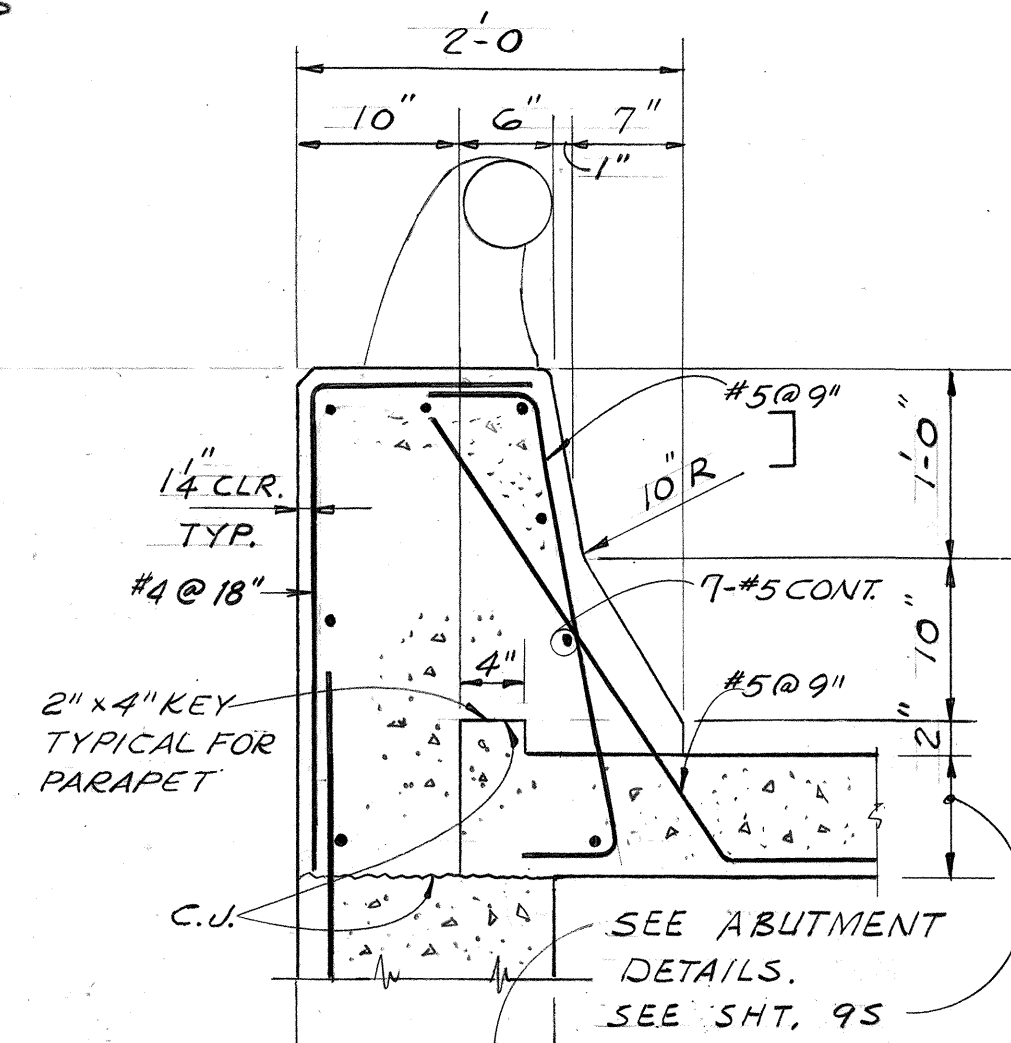


DETAIL 2/125
SCALE: 1" = 1'-0"

THIS WORK WAS PREPARED BY
ME OR UNDER MY SUPERVISION.
William J. Armento

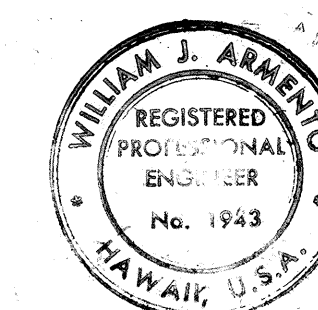

STATE OF HAWAII
DEPARTMENT OF TRANSPORTATION
HIGHWAYS DIVISION
**HALAWA INTERCHANGE
STRUCTURE NO. 4**
MOANALUA FREEWAY OVER H-3
WEST FRAMING PLAN
PROJ. No. I-H-1(89)13 DATE: MAY 1971
SHEET No. 125 OF 195 SHEETS

FED. ROAD DIST. NO.	STATE	FED. AID PROJ. NO.	FISCAL YEAR	SHEET NO.	TOTAL SHEETS
HAWAII	HAWAII	I-H-1(89):13	1971	194	362

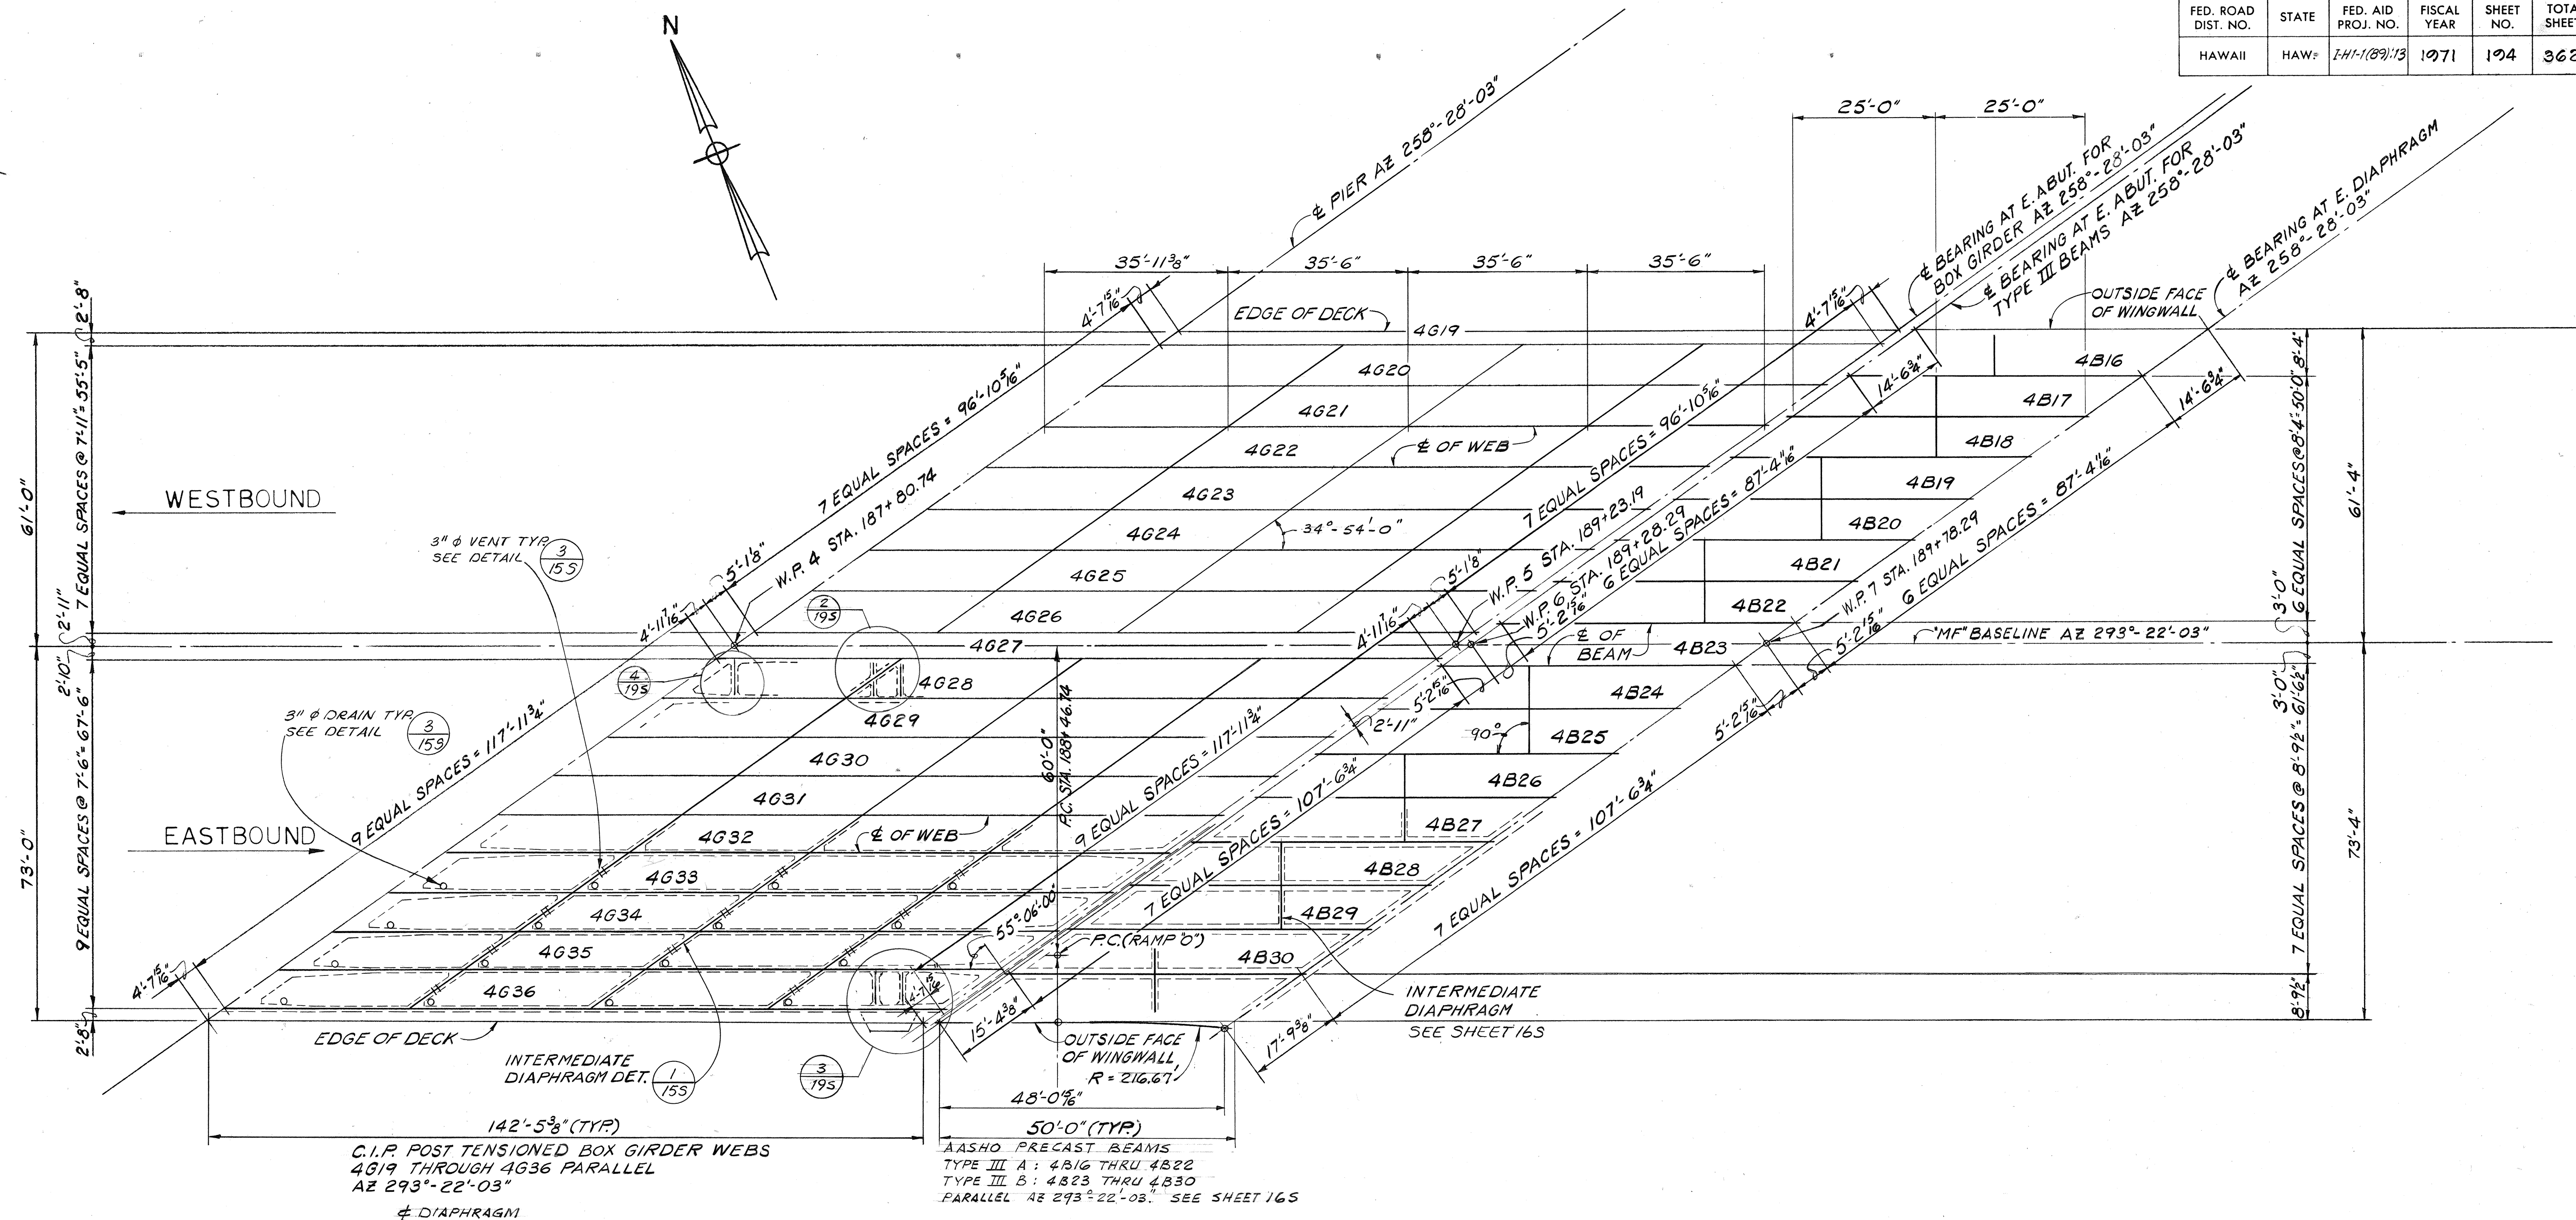

NOTES:

- POUR #2 SHALL BE MADE AFTER COMPLETION OF POUR #1 ON BOTH ENDS. POUR #2 MAY BE PLACED WITH POURS #1 WHEN APPROVED BY THE ENGINEER, PROVIDED THAT THE POUR #1 SECTIONS ADJOINING THE POUR #2 SECTIONS ARE PLACED IN THIS POUR AND THAT INITIAL SET OF POUR #2 BE RETAINED UNTIL COMPLETION OF BOTH POURS #1.
 - ALL REINF. IN SLABS, GIRDER WEBS & DIAPHRAGMS SHALL BE CONTINUOUS ACROSS CONSTRUCTION JOINTS (C.J.).
 - SLAB C.J. PARALLEL TO PIER & GIRDER WEB C.J. NORMAL TO GIRDER &.
 - SLAB C.J. SHALL BE SIMILAR TO DETAIL (S) 135.
 - CONSTRUCTION JOINTS ARE OPTIONAL.
- POUR #1: ABUTMENT TO C.J. POUR #2: C.J. TO C.J. INCLUDING PIER BEAM

DATE	BY	DATE	BY
5/1/72	W. J. Armento	5/1/72	W. J. Armento
5/1/72	W. J. Armento	5/1/72	W. J. Armento
5/1/72	W. J. Armento	5/1/72	W. J. Armento

ORIGINAL PLAN	NOTE BOOK
1	1

DETAIL (S) 135

ELEVATION OF TYPICAL TRANSVERSE C.J.
3/8" = 1'-0"


DETAIL (S) 135

ELEVATION OF TYPICAL LONGITUDINAL C.J.
3/8" = 1'-0"

EAST FRAMING PLAN

SCALE: 1/8" = 1'-0"

THIS WORK WAS PREPARED BY
ME OR UNDER MY SUPERVISION
W. J. Armento

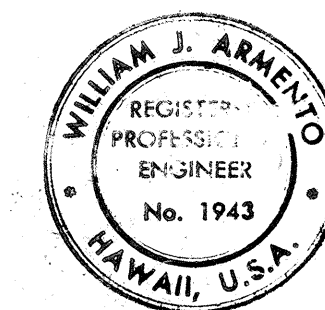

STATE OF HAWAII
DEPARTMENT OF TRANSPORTATION
HIGHWAYS DIVISION

HALAWA INTERCHANGE
STRUCTURE NO. 4

MOANALUA FREEWAY OVER H-3

EAST FRAMING PLAN

PROJ. No. I-H-1(89):13 DATE: MAY 1971


SHEET No. 135 OF 195 SHEETS

194

FED. ROAD DIST. NO.	STATE	FED. AID PROJ. NO.	FISCAL YEAR	SHEET NO.	TOTAL SHEETS
HAWAII	HAW.	J-41-1(89)13	1971	195	362

PRESTRESSING NOTES

- THE TOTAL FINAL PRESTRESSING FORCE, P_f , AT THE CENTERLINE OF PIER SHALL BE AS FOLLOWS, AFTER ALL LOSSES HAVE OCCURRED:
EASTBOUND ROADWAY = 1740 K/GIRDER X 10 GIRDERS = 17,400 K
WESTBOUND ROADWAY = 1740 K/GIRDER X 8 GIRDERS = 13,920 K
THE PRESTRESSING FORCE FOR EACH ROADWAY SHALL BE EQUALLY DISTRIBUTED IN ALL THE WEBS OF THE BOX GIRDER SUPPORTING THE ROADWAY. THE INITIAL JACKING FORCE SHALL BE DETERMINED MAKING ALLOWANCE FOR LOSSES DUE TO FRICTION, WOBBLE AND SEATING SLIP AS LISTED BELOW UNDER "DESIGN" AND FOR ALL OTHER CAUSES IN ACCORDANCE WITH THE AASHTO STANDARD SPECIFICATIONS. THE STRESS IN THE PRESTRESSING STEEL, AFTER SEATING OF THE ANCHOR, SHALL NOT AT ANY LOCATION EXCEED 0.70 f_s . IT SHALL NOT EXCEED 0.60 f_s AFTER ALL LOSSES HAVE OCCURRED.
- EACH TENDON MUST BE SIMULTANEOUSLY JACKED FROM EACH END.
- THE METALLIC ENCLOSURES AROUND THE TENDONS SHALL BE GALVANIZED RIGID DUCTS.
- THE CONTRACTOR SHALL JACK THE TENDONS IN EACH WEB IN SUCH A MANNER THAT NO MORE THAN A DIFFERENTIAL OF ONE-THIRD OF THE PRESTRESSING FORCE IN ANY WEB EXISTS BETWEEN ADJACENT WEBS AND AT NO TIME DURING THE STRESSING OPERATION MAY MORE THAN ONE-SIXTH OF THE TOTAL PRESTRESSING FORCE BE APPLIED ECCENTRICALLY ABOUT THE LONGITUDINAL CENTERLINE OF EACH ROADWAY.
- THE QUANTITY OF PRESTRESSING STEEL REQUIRED FOR POST-TENSIONING SHALL BE COMPUTED ON THE BASIS THAT THE MAXIMUM TENSILE STRESS IN THE PRESTRESSING STEEL AT THE JACKING END SHALL NOT EXCEED TO PERCENT OF THE SPECIFIED MINIMUM ULTIMATE TENSILE STRENGTH OF THE PRESTRESSING STEEL.
- THE CONTRACTOR SHALL SUBMIT FOR APPROVAL, ELONGATION AND JACKING COMPUTATIONS, BASED ON THE COEFFICIENT OF FRICTION AND WOBBLE AS LISTED BELOW.
- DESIGN
 - THE MINIMUM CYLINDER STRENGTH IN THE CONCRETE AT THE TIME OF PRESTRESSING SHALL BE 4000 PSI. THE MINIMUM 28 DAY STRENGTH OF THE CONCRETE IN THE BOX GIRDER SHALL BE 4500 PSI.
 - THE HORIZONTAL CLEARANCE BETWEEN UNITS SHALL BE 2" MINIMUM. THE UNITS MAY BE BUNDLED VERTICALLY IN GROUPS OF 3 MAXIMUM EXCEPT IN THE OUTER THIRD OF EACH SPAN ADJACENT TO THE ANCHORAGE. VERTICAL CLEARANCE BETWEEN THE BUNDLED UNITS SHALL BE 3" MINIMUM.
 - SEATING LOSS OR SLIPPAGE AT THE ANCHORAGES SHALL NOT EXCEED 1/2 INCH.
 - GIRDERS SHALL BE FLARED AS NECESSARY NEAR THE ANCHORAGE TO PROVIDE A MINIMUM OF 2" CONCRETE COVERING THE DUCTS ONLY THE INTERIOR FACE MAY BE FLARED ON THE EXTERIOR GIRDER WEBS, WHERE INDIVIDUAL UNITS ARE FLARED HORIZONTALLY, THEY SHALL BE TIED TOGETHER AT THE POINT OF FLARE. BAR REINFORCEMENT THAT INTERFERES WITH THE PRESTRESSING TENDON ALIGNMENT MAY BE ADJUSTED AS DIRECTED BY THE ENGINEER.
 - FOR THE DESIGN OF THE JACKING FORCE THE COEFFICIENT OF FRICTION "K" IS TO BE ASSUMED EQUAL TO 0.25 AND THE WOBBLE COEFFICIENT "W" IS TO BE ASSUMED EQUAL TO 0.0002. THESE FIGURES SHALL BE VERIFIED IN THE FIELD BY FRICTION TESTS AS DIRECTED BY THE ENGINEER. HOWEVER THESE FIGURES SHALL BE USED AS A LOWER LIMIT REGARDLESS OF FIELD MEASUREMENT.

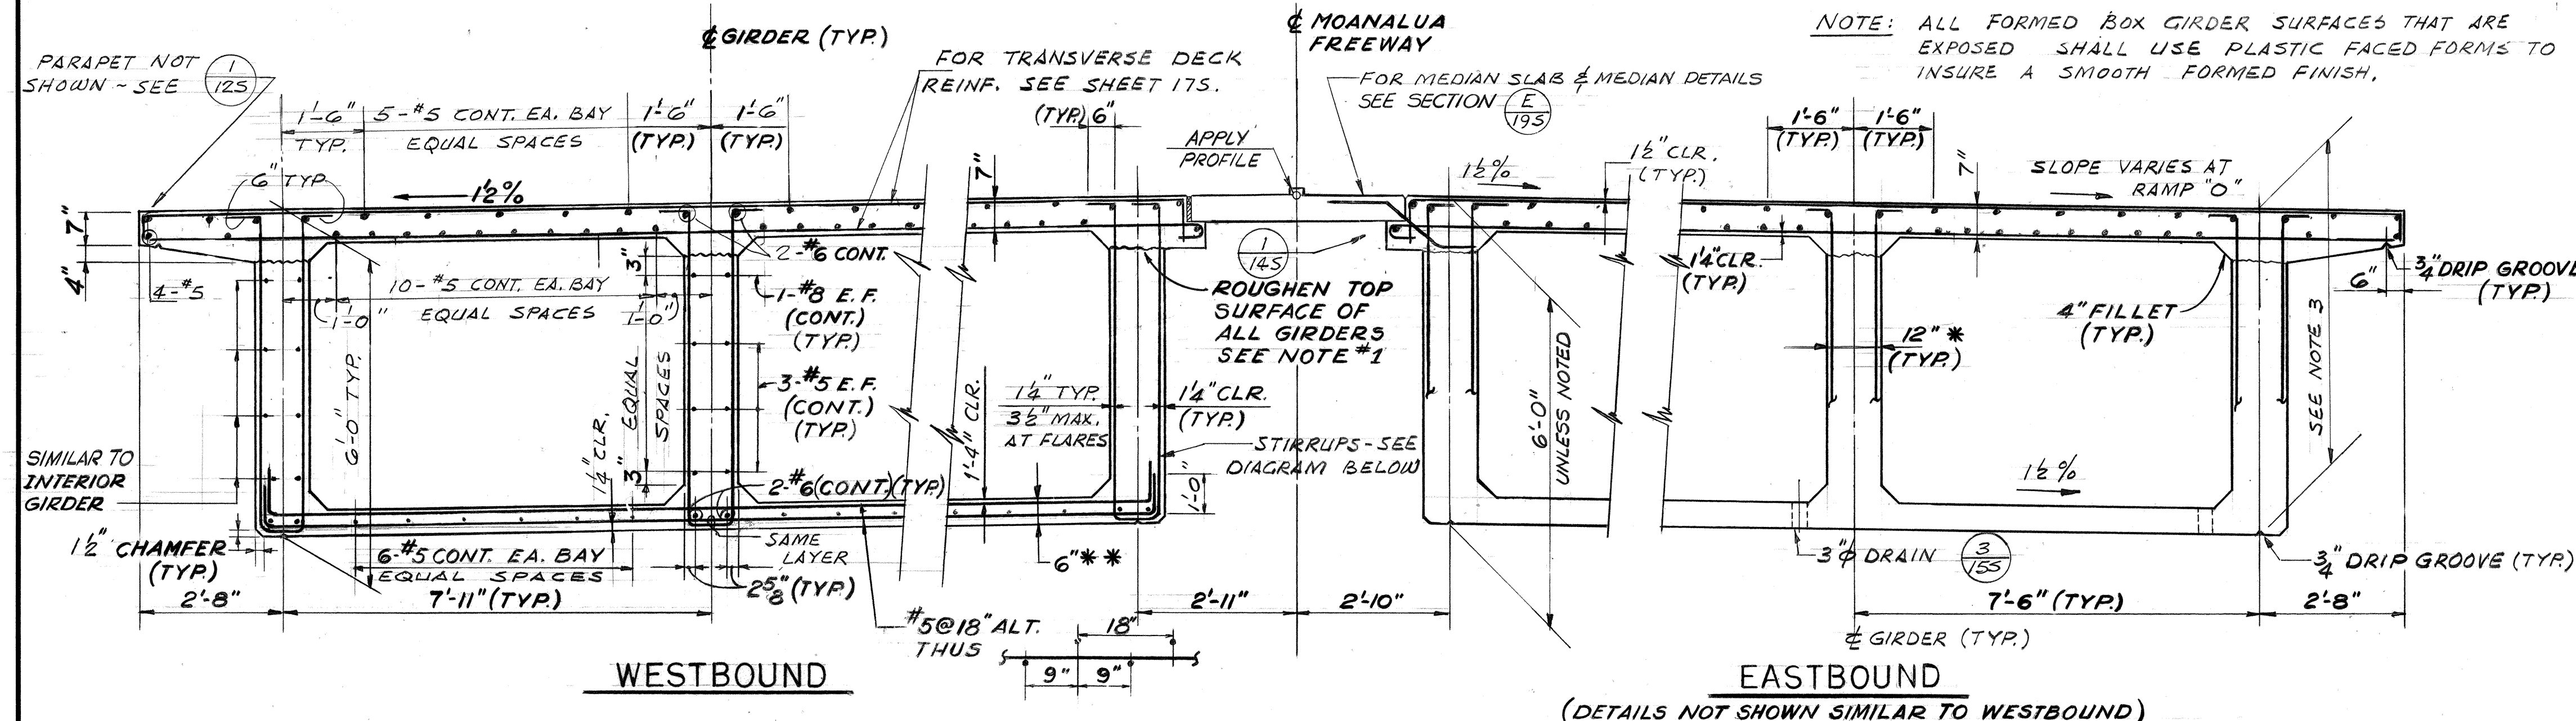

TYPICAL NORMAL BOX GIRDER SECTION


(LOOKING UPSTATION)

SCALE: 1/2" = 1'-0"

NOTES


- THE ENTIRE SURFACE OF THE JOINT SHALL BE THOROUGHLY CLEANED OF SURFACE LAITANCE, CURING COMPOUND, AND OTHER MATERIAL FOREIGN TO THE CONCRETE. UNTIL CLEAN AGGREGATE IS EXPOSED, USE ABRASIVE BLAST CLEANING AFTER THE CURING PERIOD OR IMMEDIATELY BEFORE PLACING CONCRETE AT THE JOINT.
- FOR TOP SLAB TRANSVERSE REINFORCEMENT SEE SHEET 175.
- FOR GIRDERS 4G34, 4G35 & 4G36 THE OVERALL DEPTH IS REDUCED BY THE INCREASED CROSS SLOPE UNDER RAMP 0. SEE SHEET 25.

- * WEB THICKNESS VARIES AT ABUTMENT AND PIER. SEE SHEET NOS 105, 115 & 155
- * SOFFIT THICKNESS VARIES AT PIER. SEE DIAGRAM THIS SHEET.

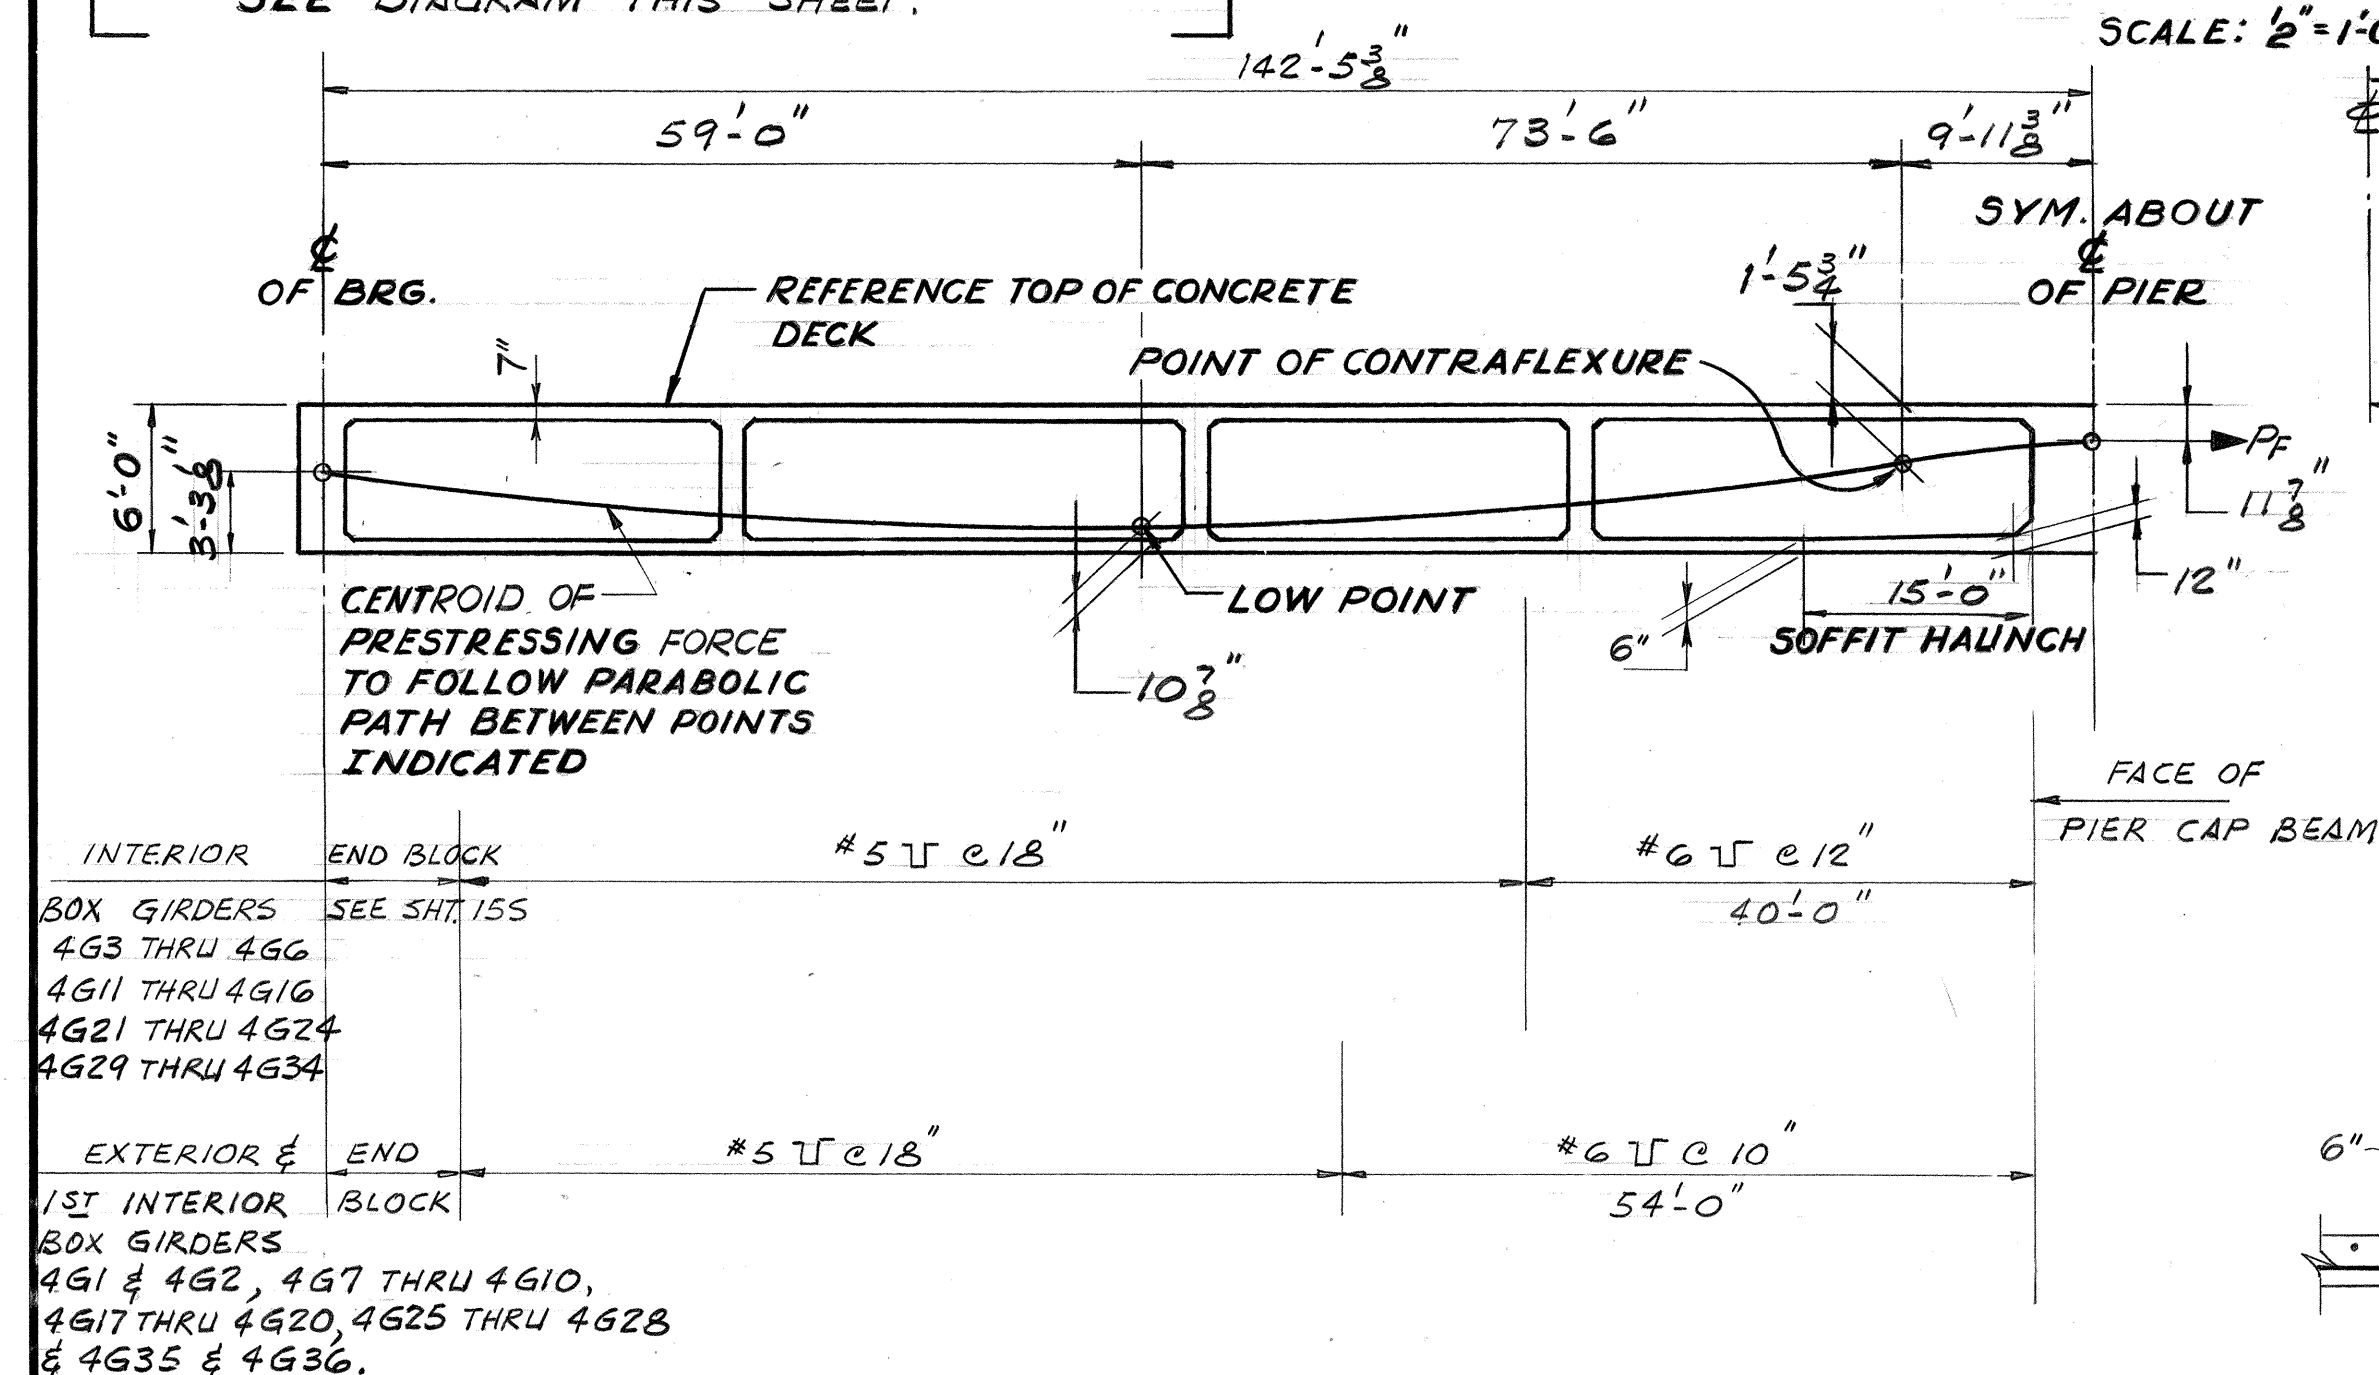


PRESTRESSING PATH & STIRRUP SPACING

NO SCALE

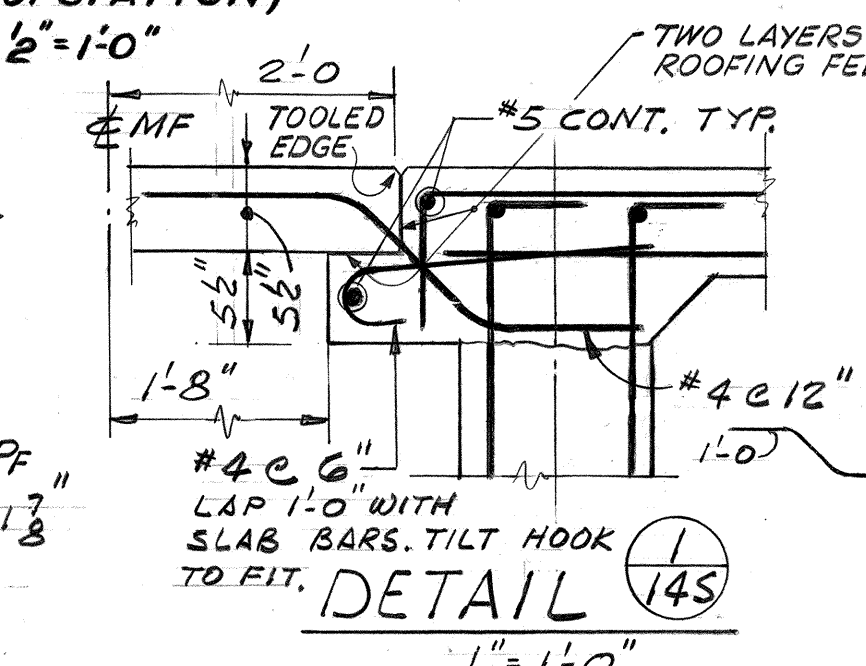

SOFFIT HAUNCH DETAIL

1/2" = 1'-0"

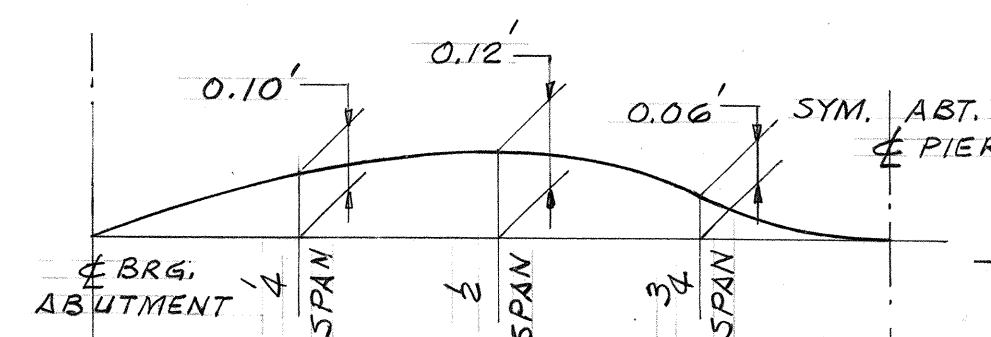


CAMBER DIAGRAM

NO SCALE

NOTE:

THEORETICAL DOWNWARD DEAD LOAD DEFLECTION PLUS UPWARD PRESTRESS DEFLECTION SUM IS ZERO, HENCE AN UPWARD CAMBER INDICATED IN DIAGRAM WILL BE BUILT INTO THE GIRDER FOR ARCHITECTURAL REASON ONLY.

THIS WORK WAS PREPARED BY
ME OR UNDER MY SUPERVISION.
Wm. J. Armenta

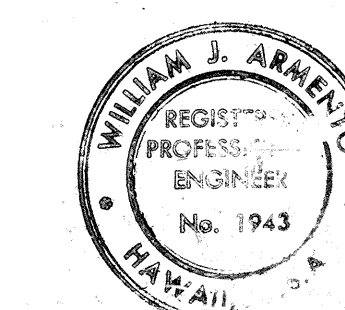

STATE OF HAWAII
DEPARTMENT OF TRANSPORTATION
HIGHWAYS DIVISION

HALAWA INTERCHANGE
STRUCTURE NO. 4

MOANALUA FREEWAY OVER H-3

BOX GIRDER DETAILS




PROJ. No. I-H-1(89)13 DATE: MAY 1971

SHEET No. 145 OF 195 SHEETS

195

SURVEY PLOTTED BY	DATE
PLAN	12/1/70
DRAWN BY	12/1/70
DESIGNED BY	12/1/70
QUANTITIES BY	12/1/70
CHECKED BY	12/1/70
ORIGINAL	
PLAN	
NOTE BOOK	
No.	

FED. ROAD DIST. NO.	STATE	FED. AID PROJ. NO.	FISCAL YEAR	SHEET NO.	TOTAL SHEETS
HAWAII	HAW.	I-H-1(89):13	1971	196	362

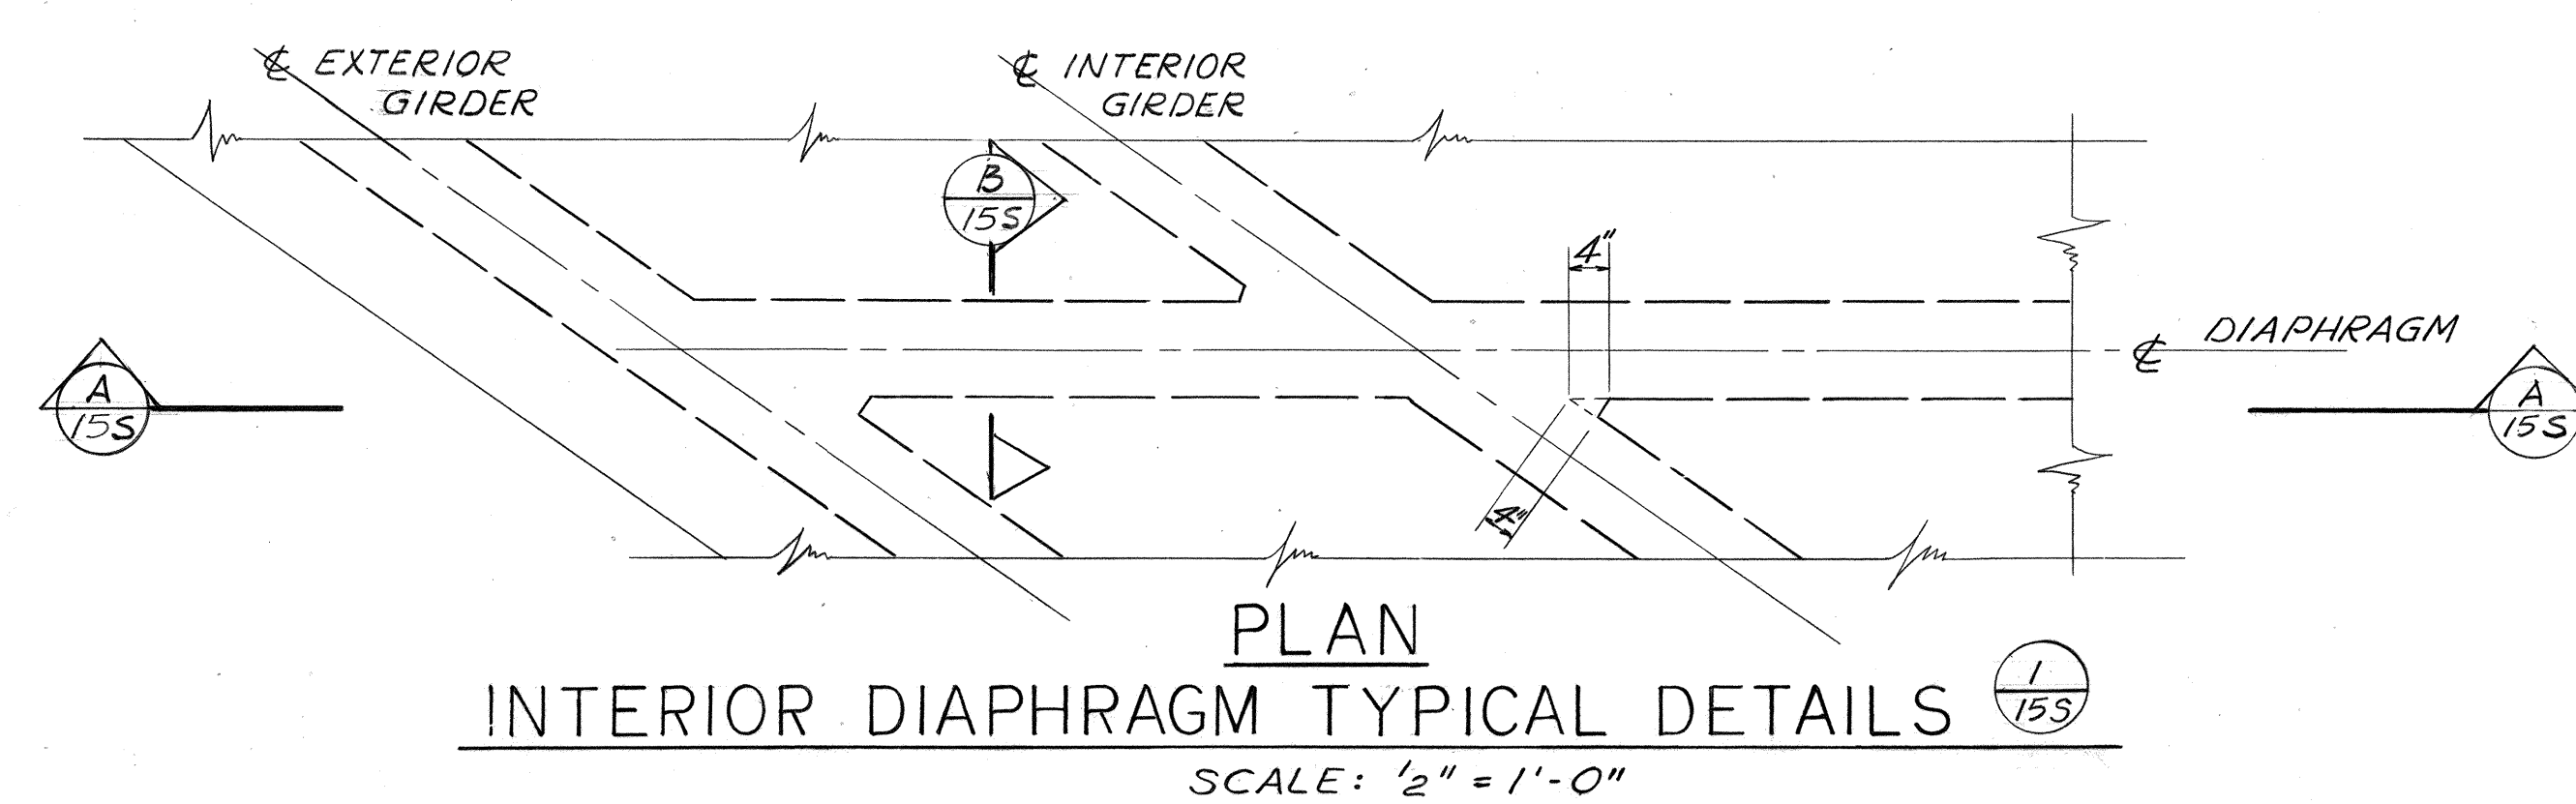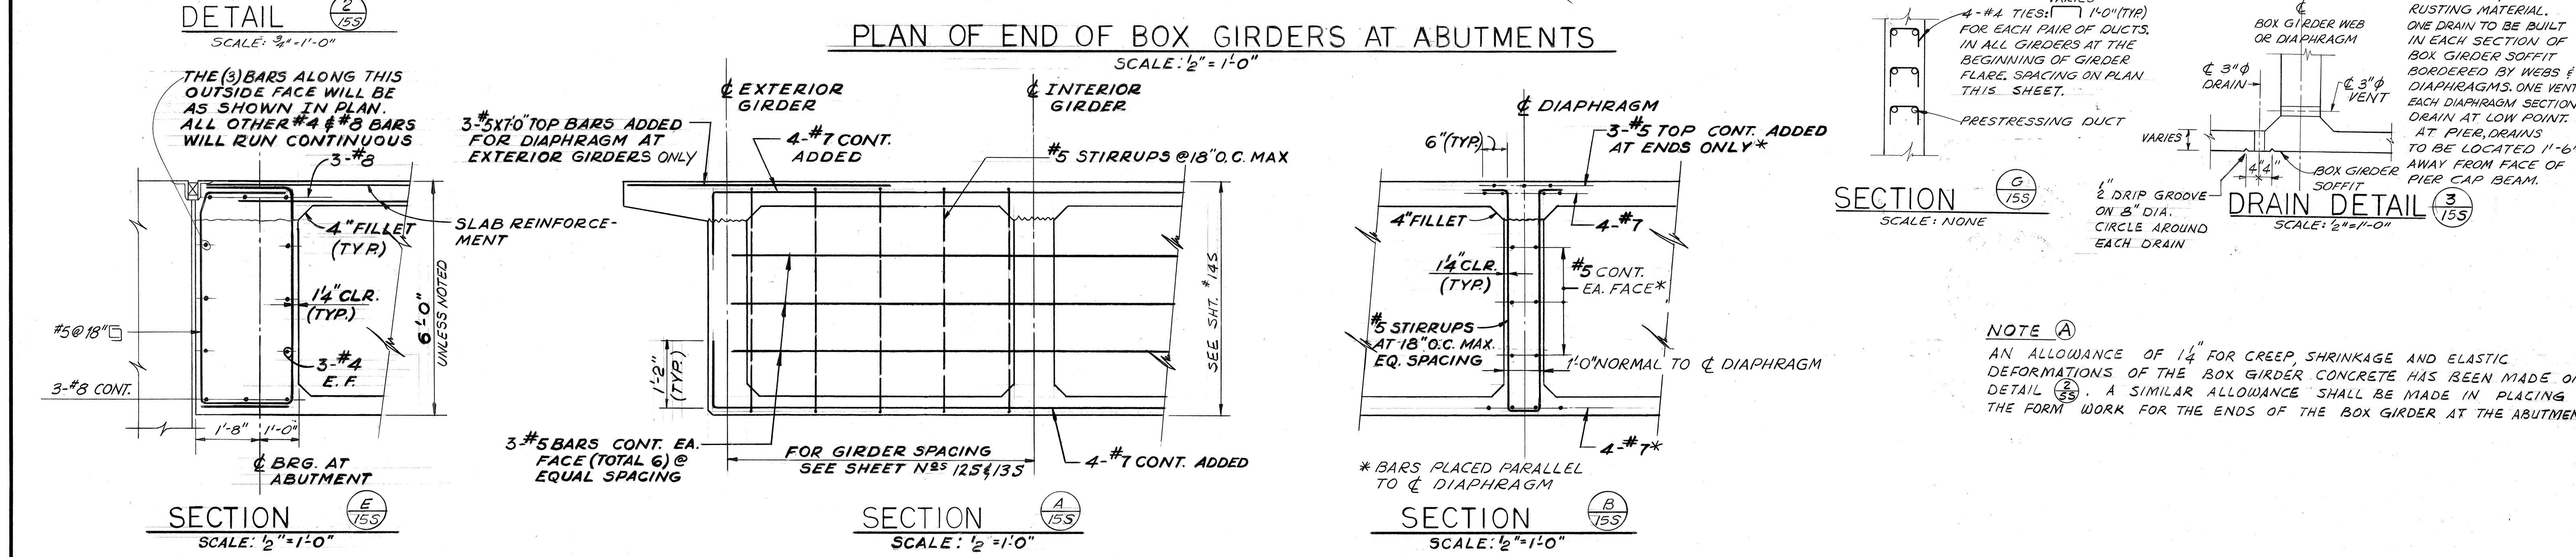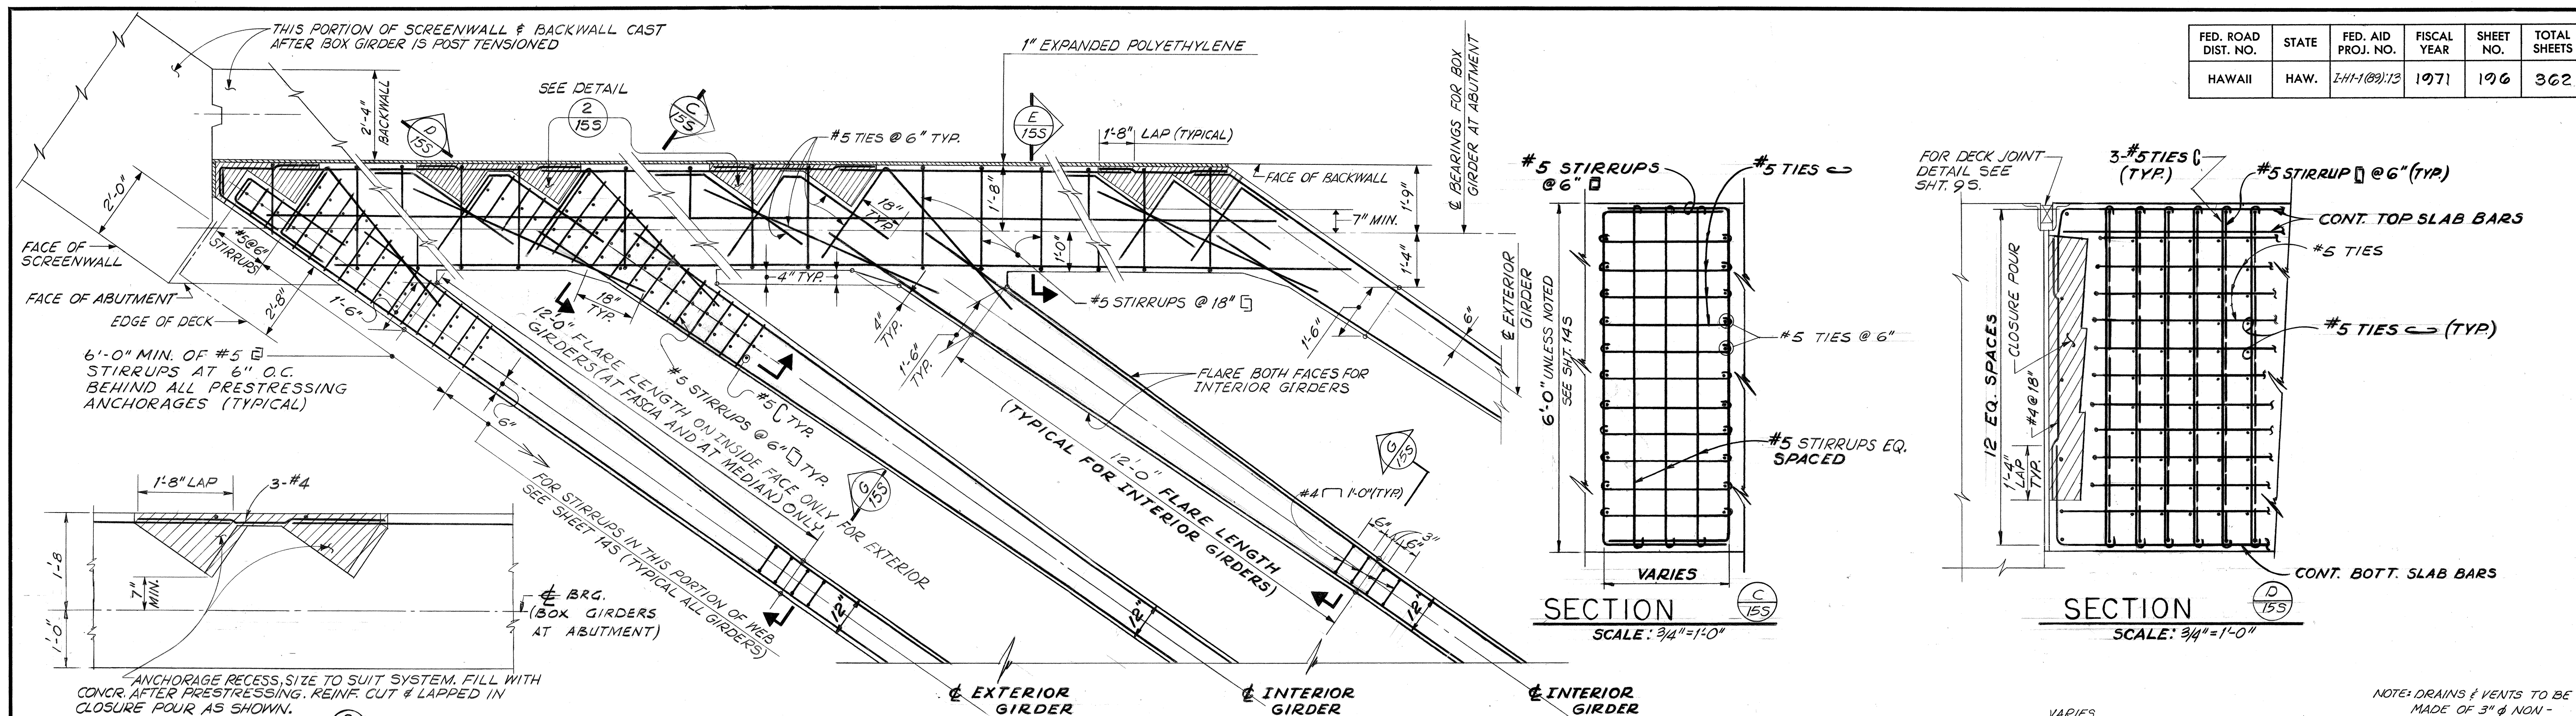

SURVEY PLATTED BY	DATE
DESIGNED BY	
QUANTITIES BY	
CHECKED BY	
ORIGINAL PLAN	
NOTE BOOK	

THIS WORK WAS PREPARED BY ME OR UNDER MY SUPERVISION.

Wm. J. Armento

STATE OF HAWAII
DEPARTMENT OF TRANSPORTATION
HIGHWAYS DIVISION

HALAWA INTERCHANGE
STRUCTURE NO. 4


MOANALUA FREEWAY OVER H-3

BOX GIRDER END DETAILS

PROJ. NO. I-H-1(89):13 DATE: MAY 1971




SHEET No. 155 OF 195 SHEETS

FED. ROAD DIST. NO.	STATE	FED. AID PROJ. NO.	FISCAL YEAR	SHEET NO.	TOTAL SHEETS
HAWAII	HAW.	I-H-1(89):13	1971	198	362

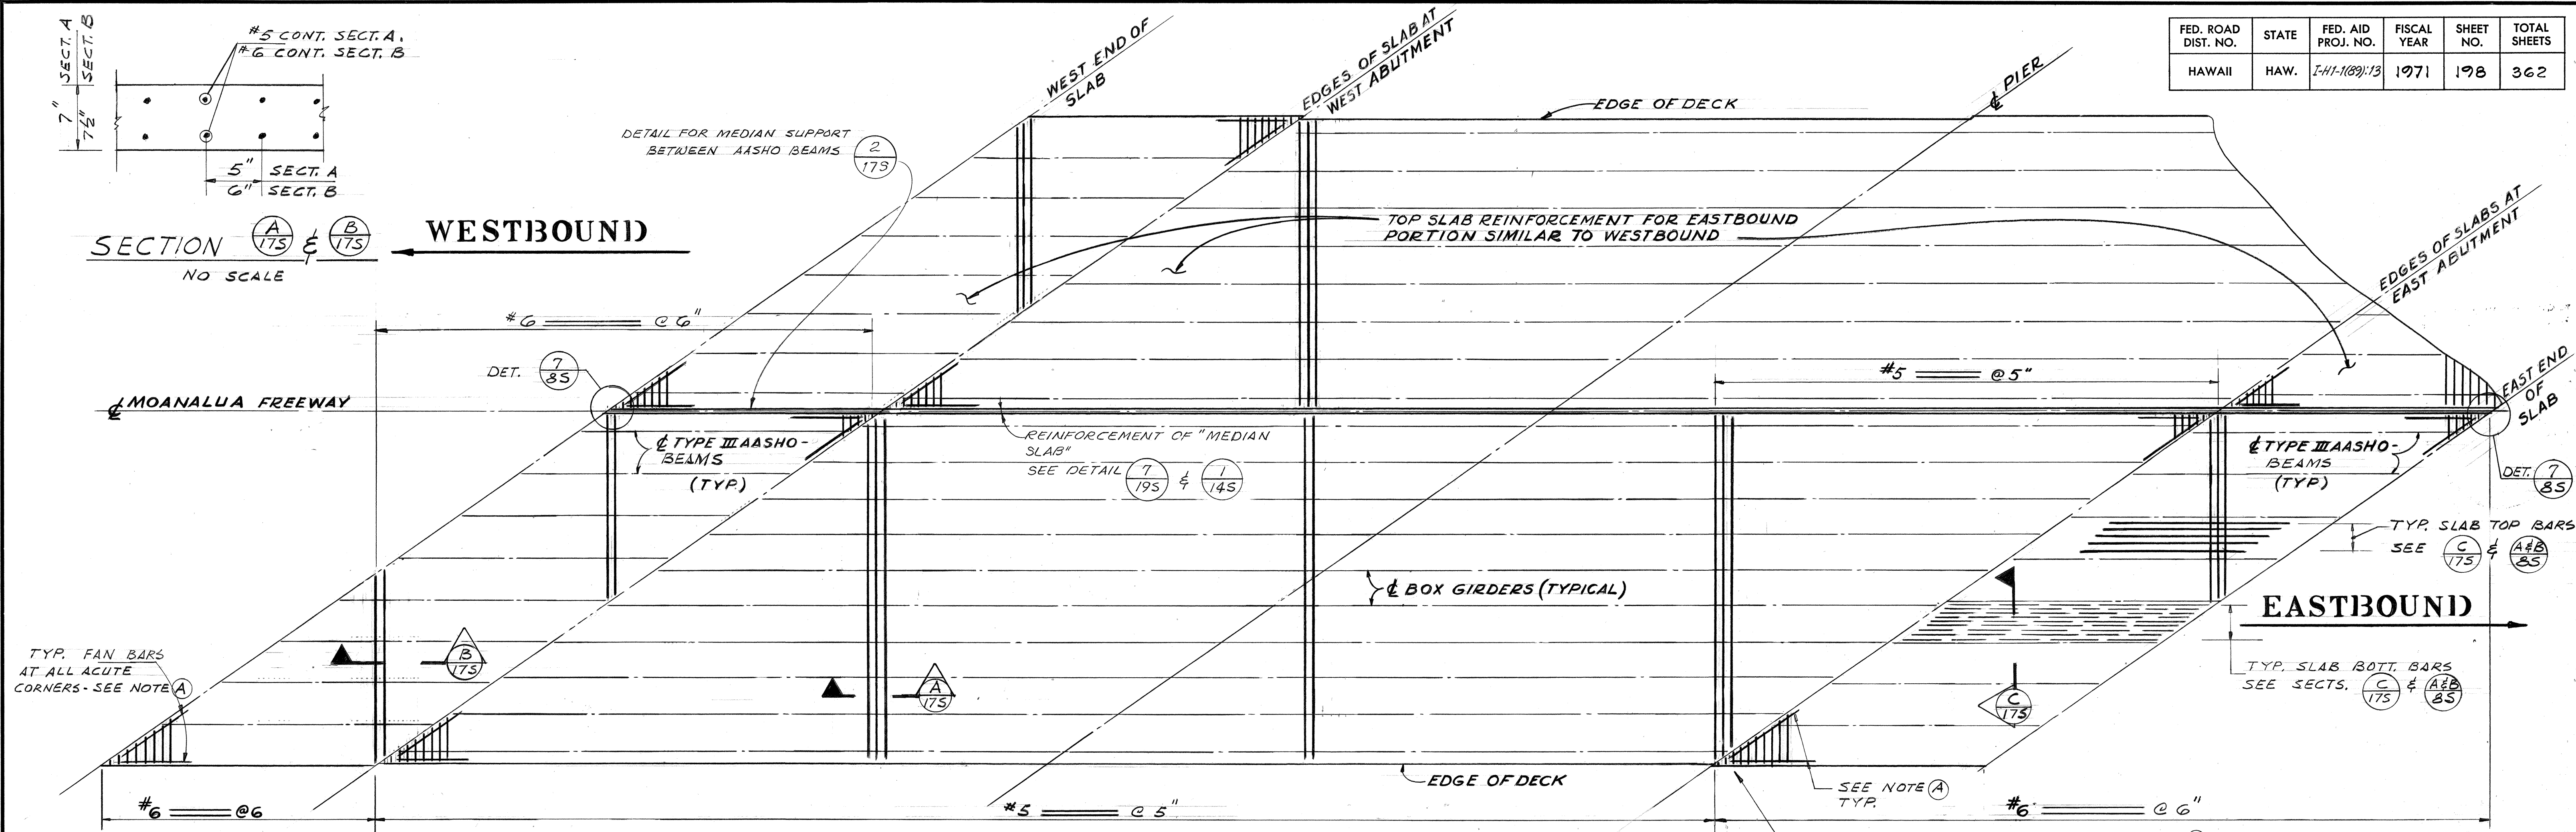

TOP SLAB TRANSVERSE REINFORCING

SCALE: NONE

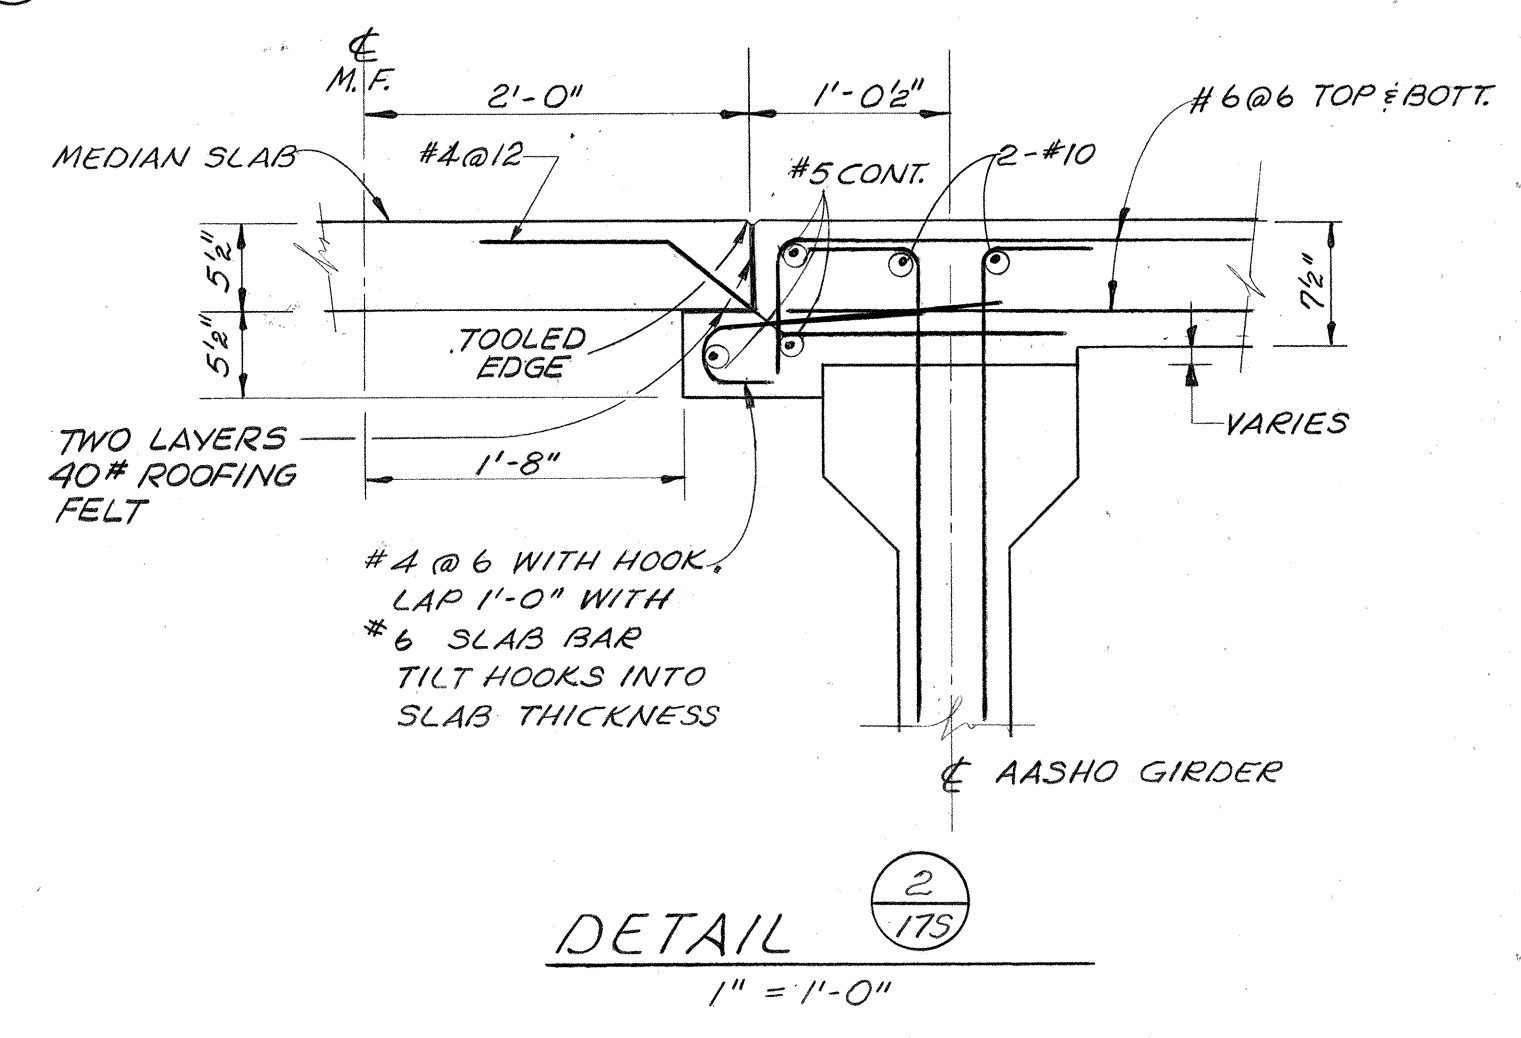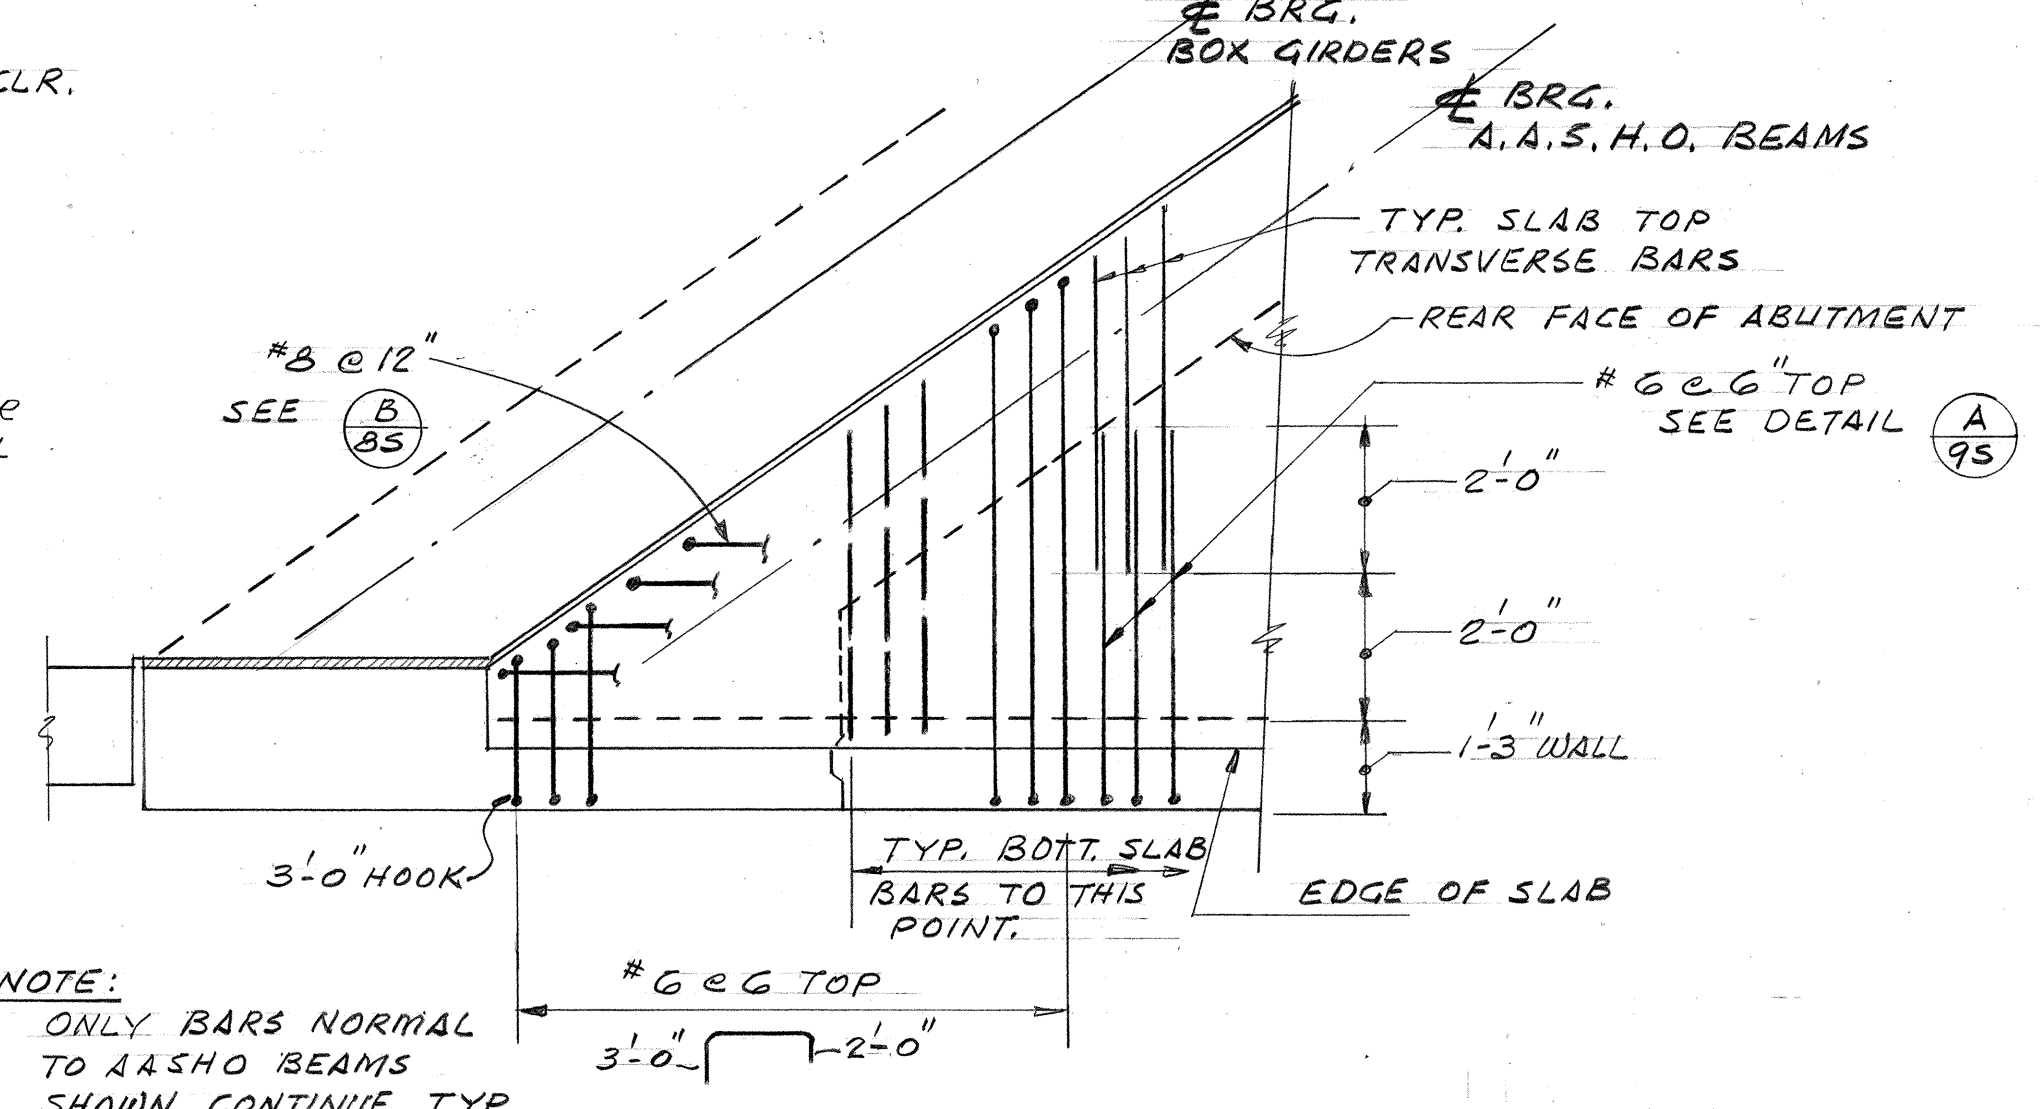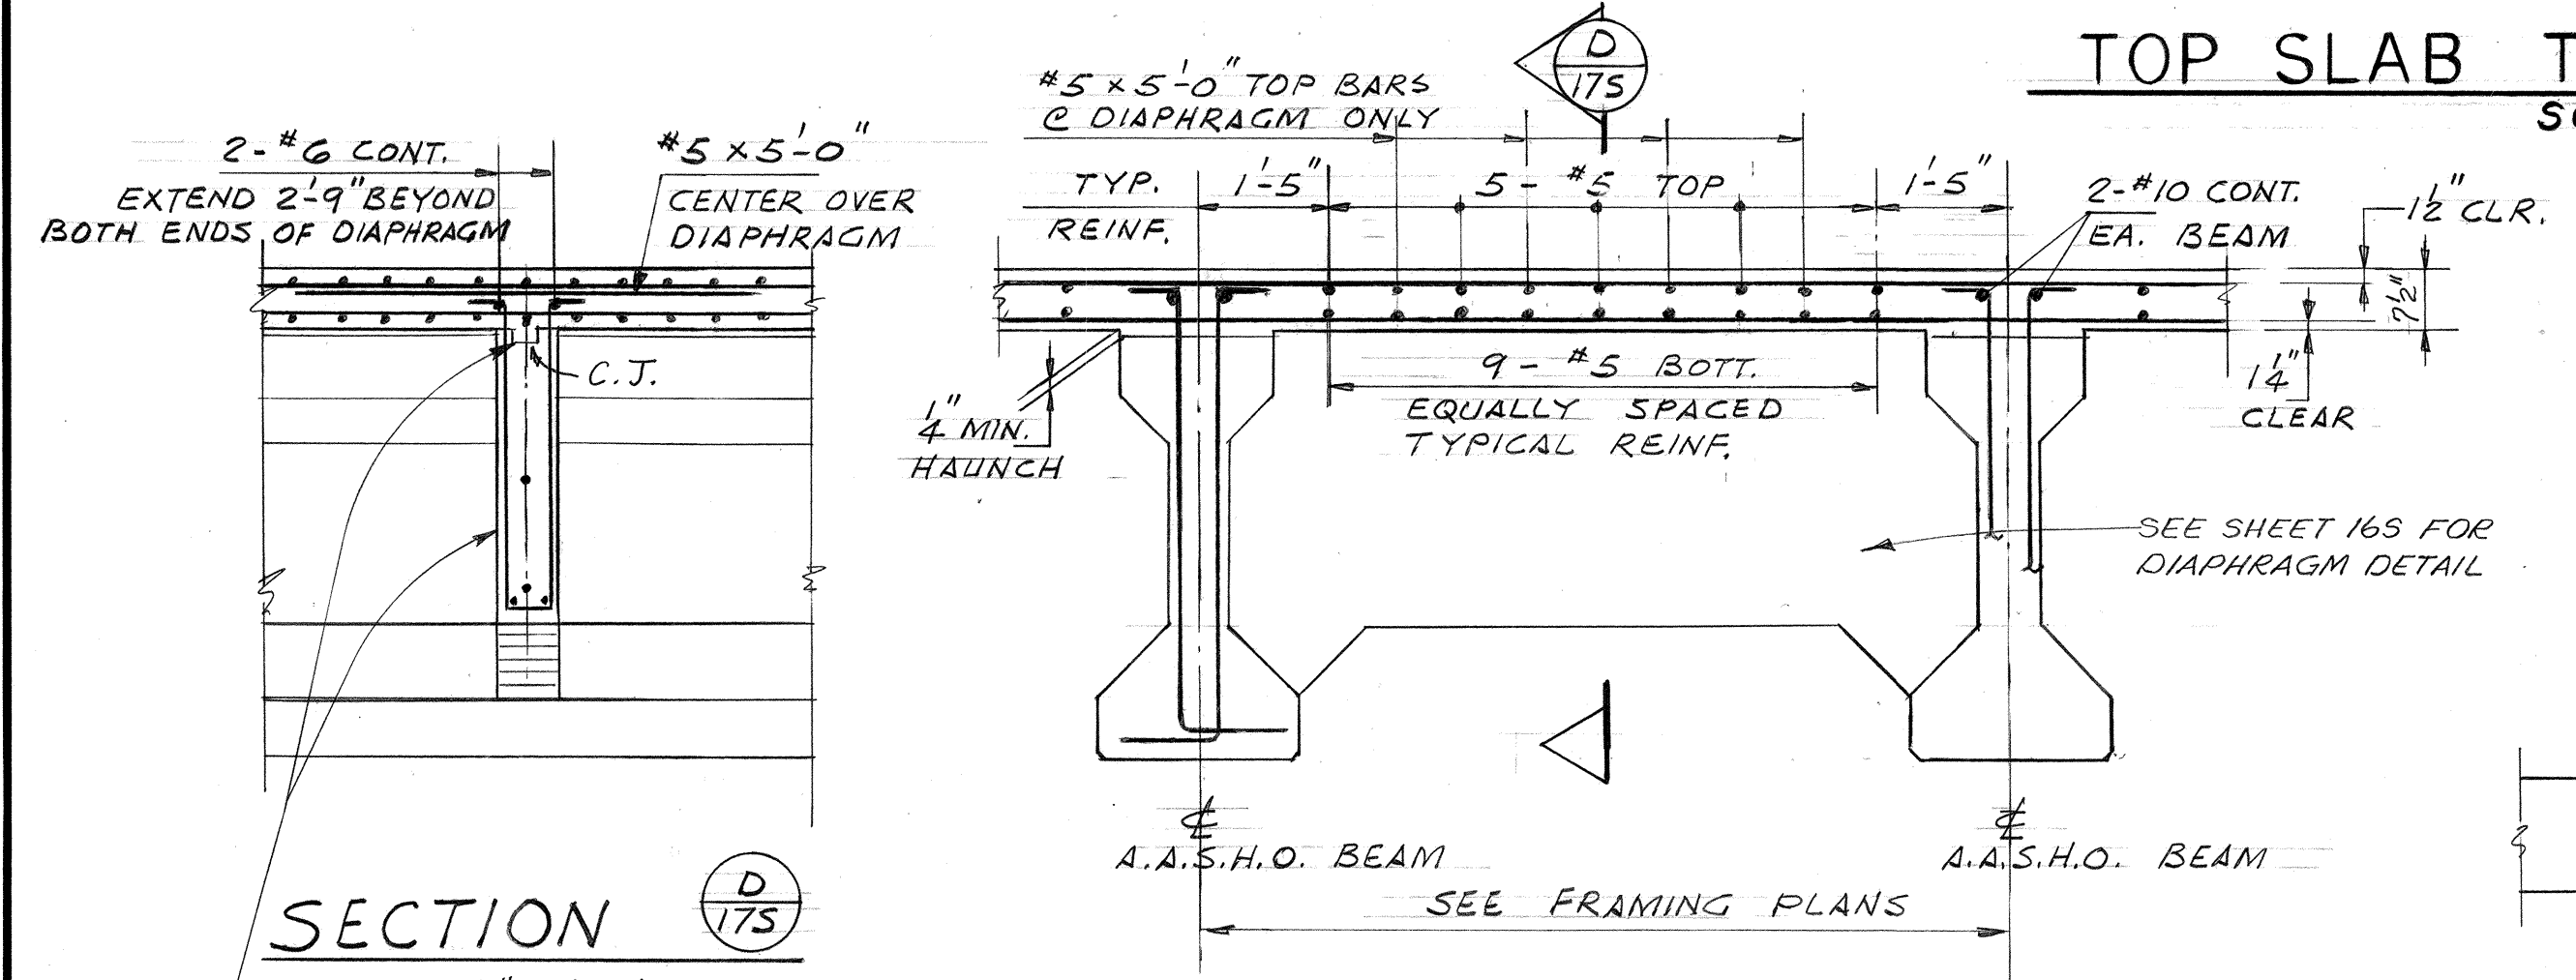

SURVEY PLANNED BY	DATE
DRAWN BY	
TRACED BY	
QUANTITIES BY	
CHECKED BY	
ORIGINAL PLAN	
NOTE BOOK	
No.	

THIS WORK WAS PREPARED BY
ME [Signature]
SUPERVISOR

WILLIAM J. ARMENTO
No. 1543
HAWAII, U.S.A.

STATE OF HAWAII
DEPARTMENT OF TRANSPORTATION
HIGHWAYS DIVISION

HALAWA INTERCHANGE
STRUCTURE NO. 4

MOANALUA FREEWAY OVER H-3

SLAB REINFORCING PLAN

PROJ. No. I-H-1(89):13 DATE: MAY 1971

SHEET No. 17S OF 19S SHEETS

ORIGINAL PLAN	SURVEY PLOTTED BY	DATE
NOTE BOOK	DRAWN BY <i>P. Palmer</i>	<i>3/24/70</i>
No. _____	TRACED BY _____	
	DESIGNED BY <i>W. C. Longyear</i>	<i>5/23/70</i>
	QUANTITIES BY _____	
	CHECKED BY <i>L. G. Gaudin</i>	<i>5/24/70</i>

