

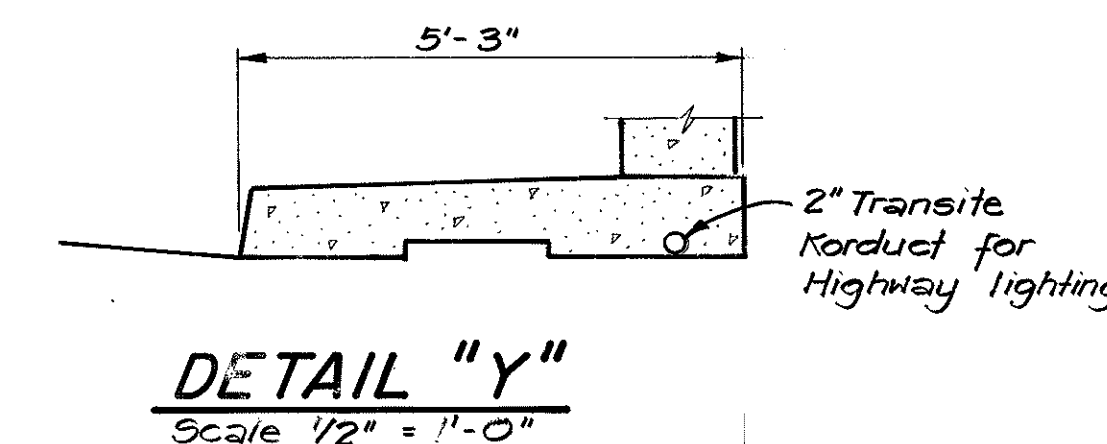
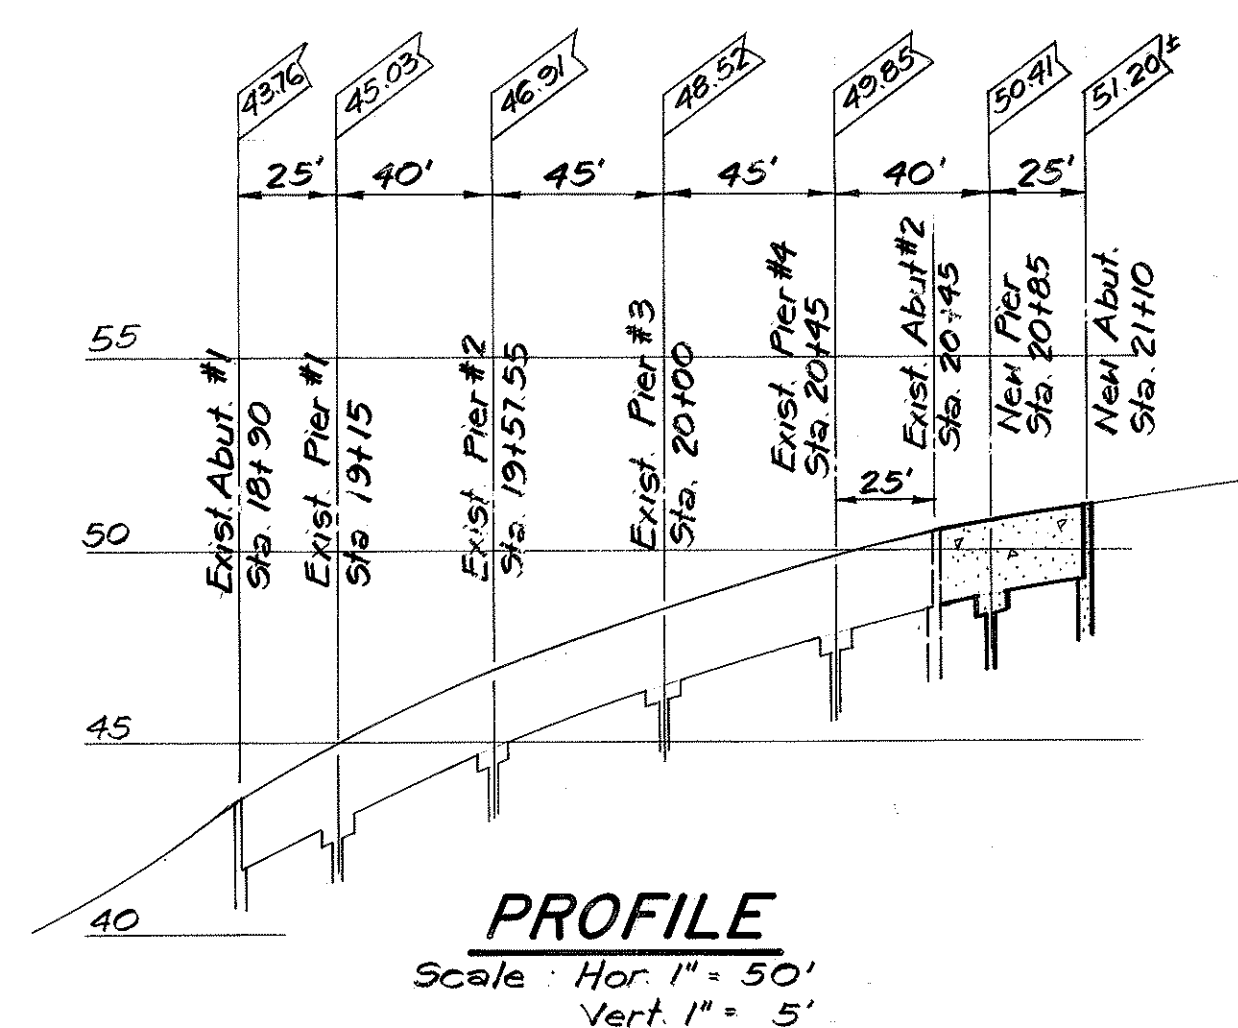
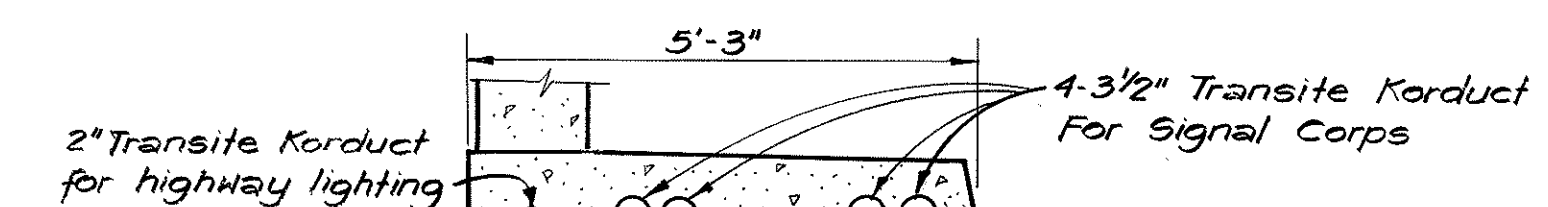
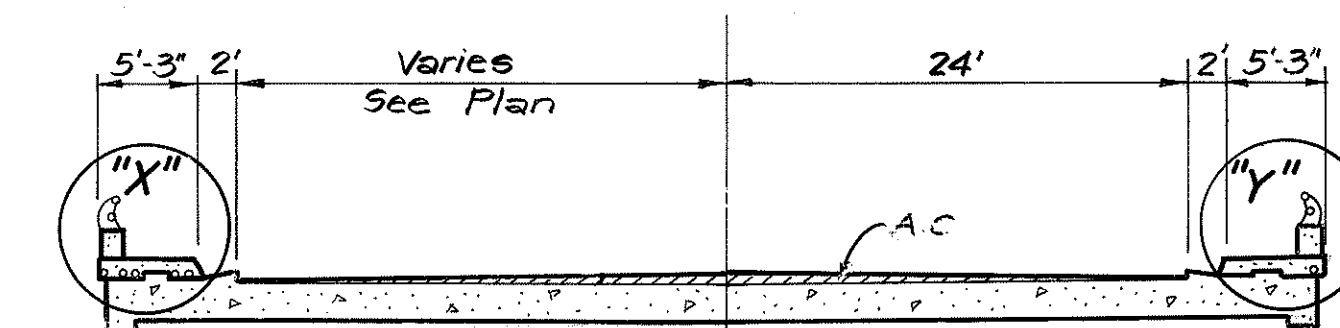
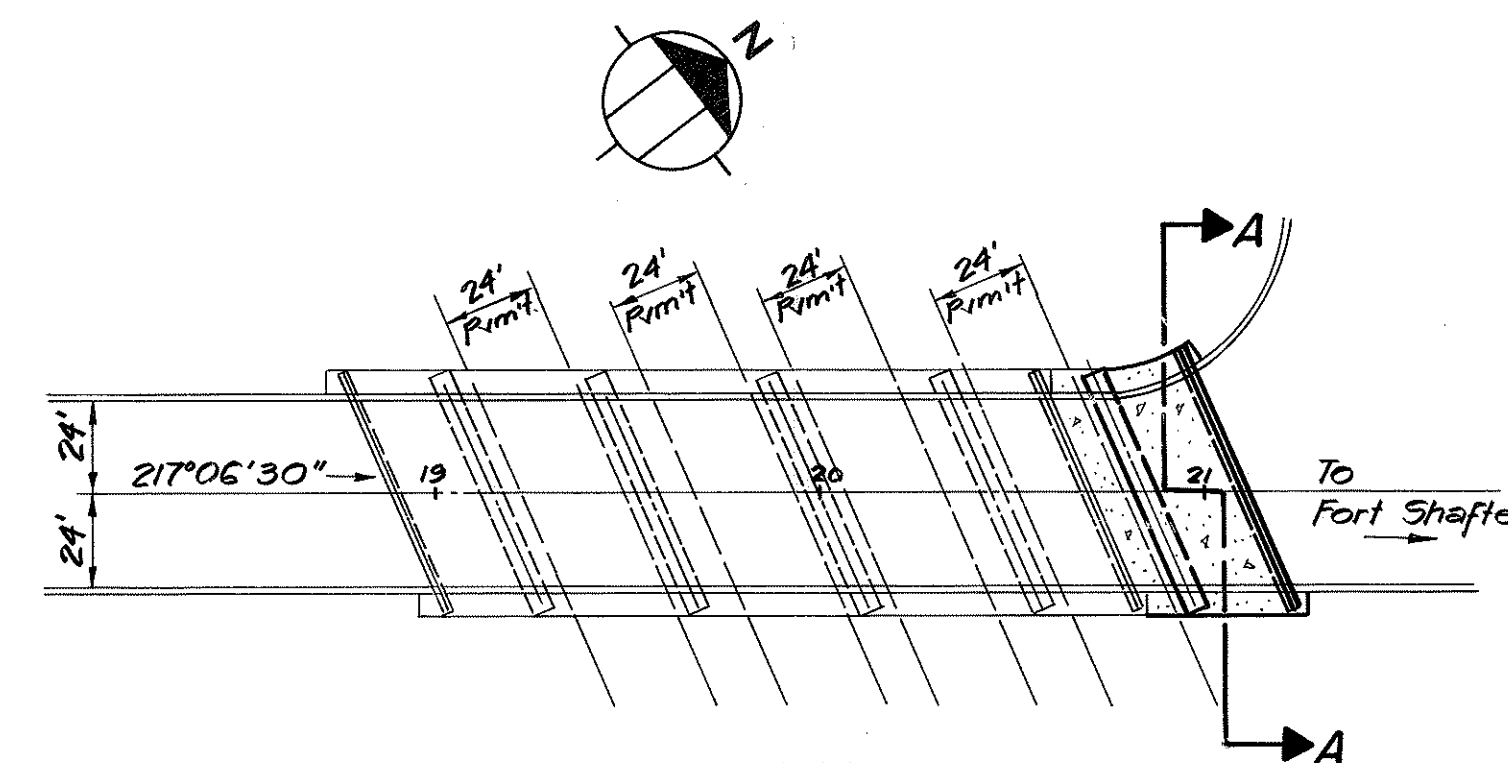
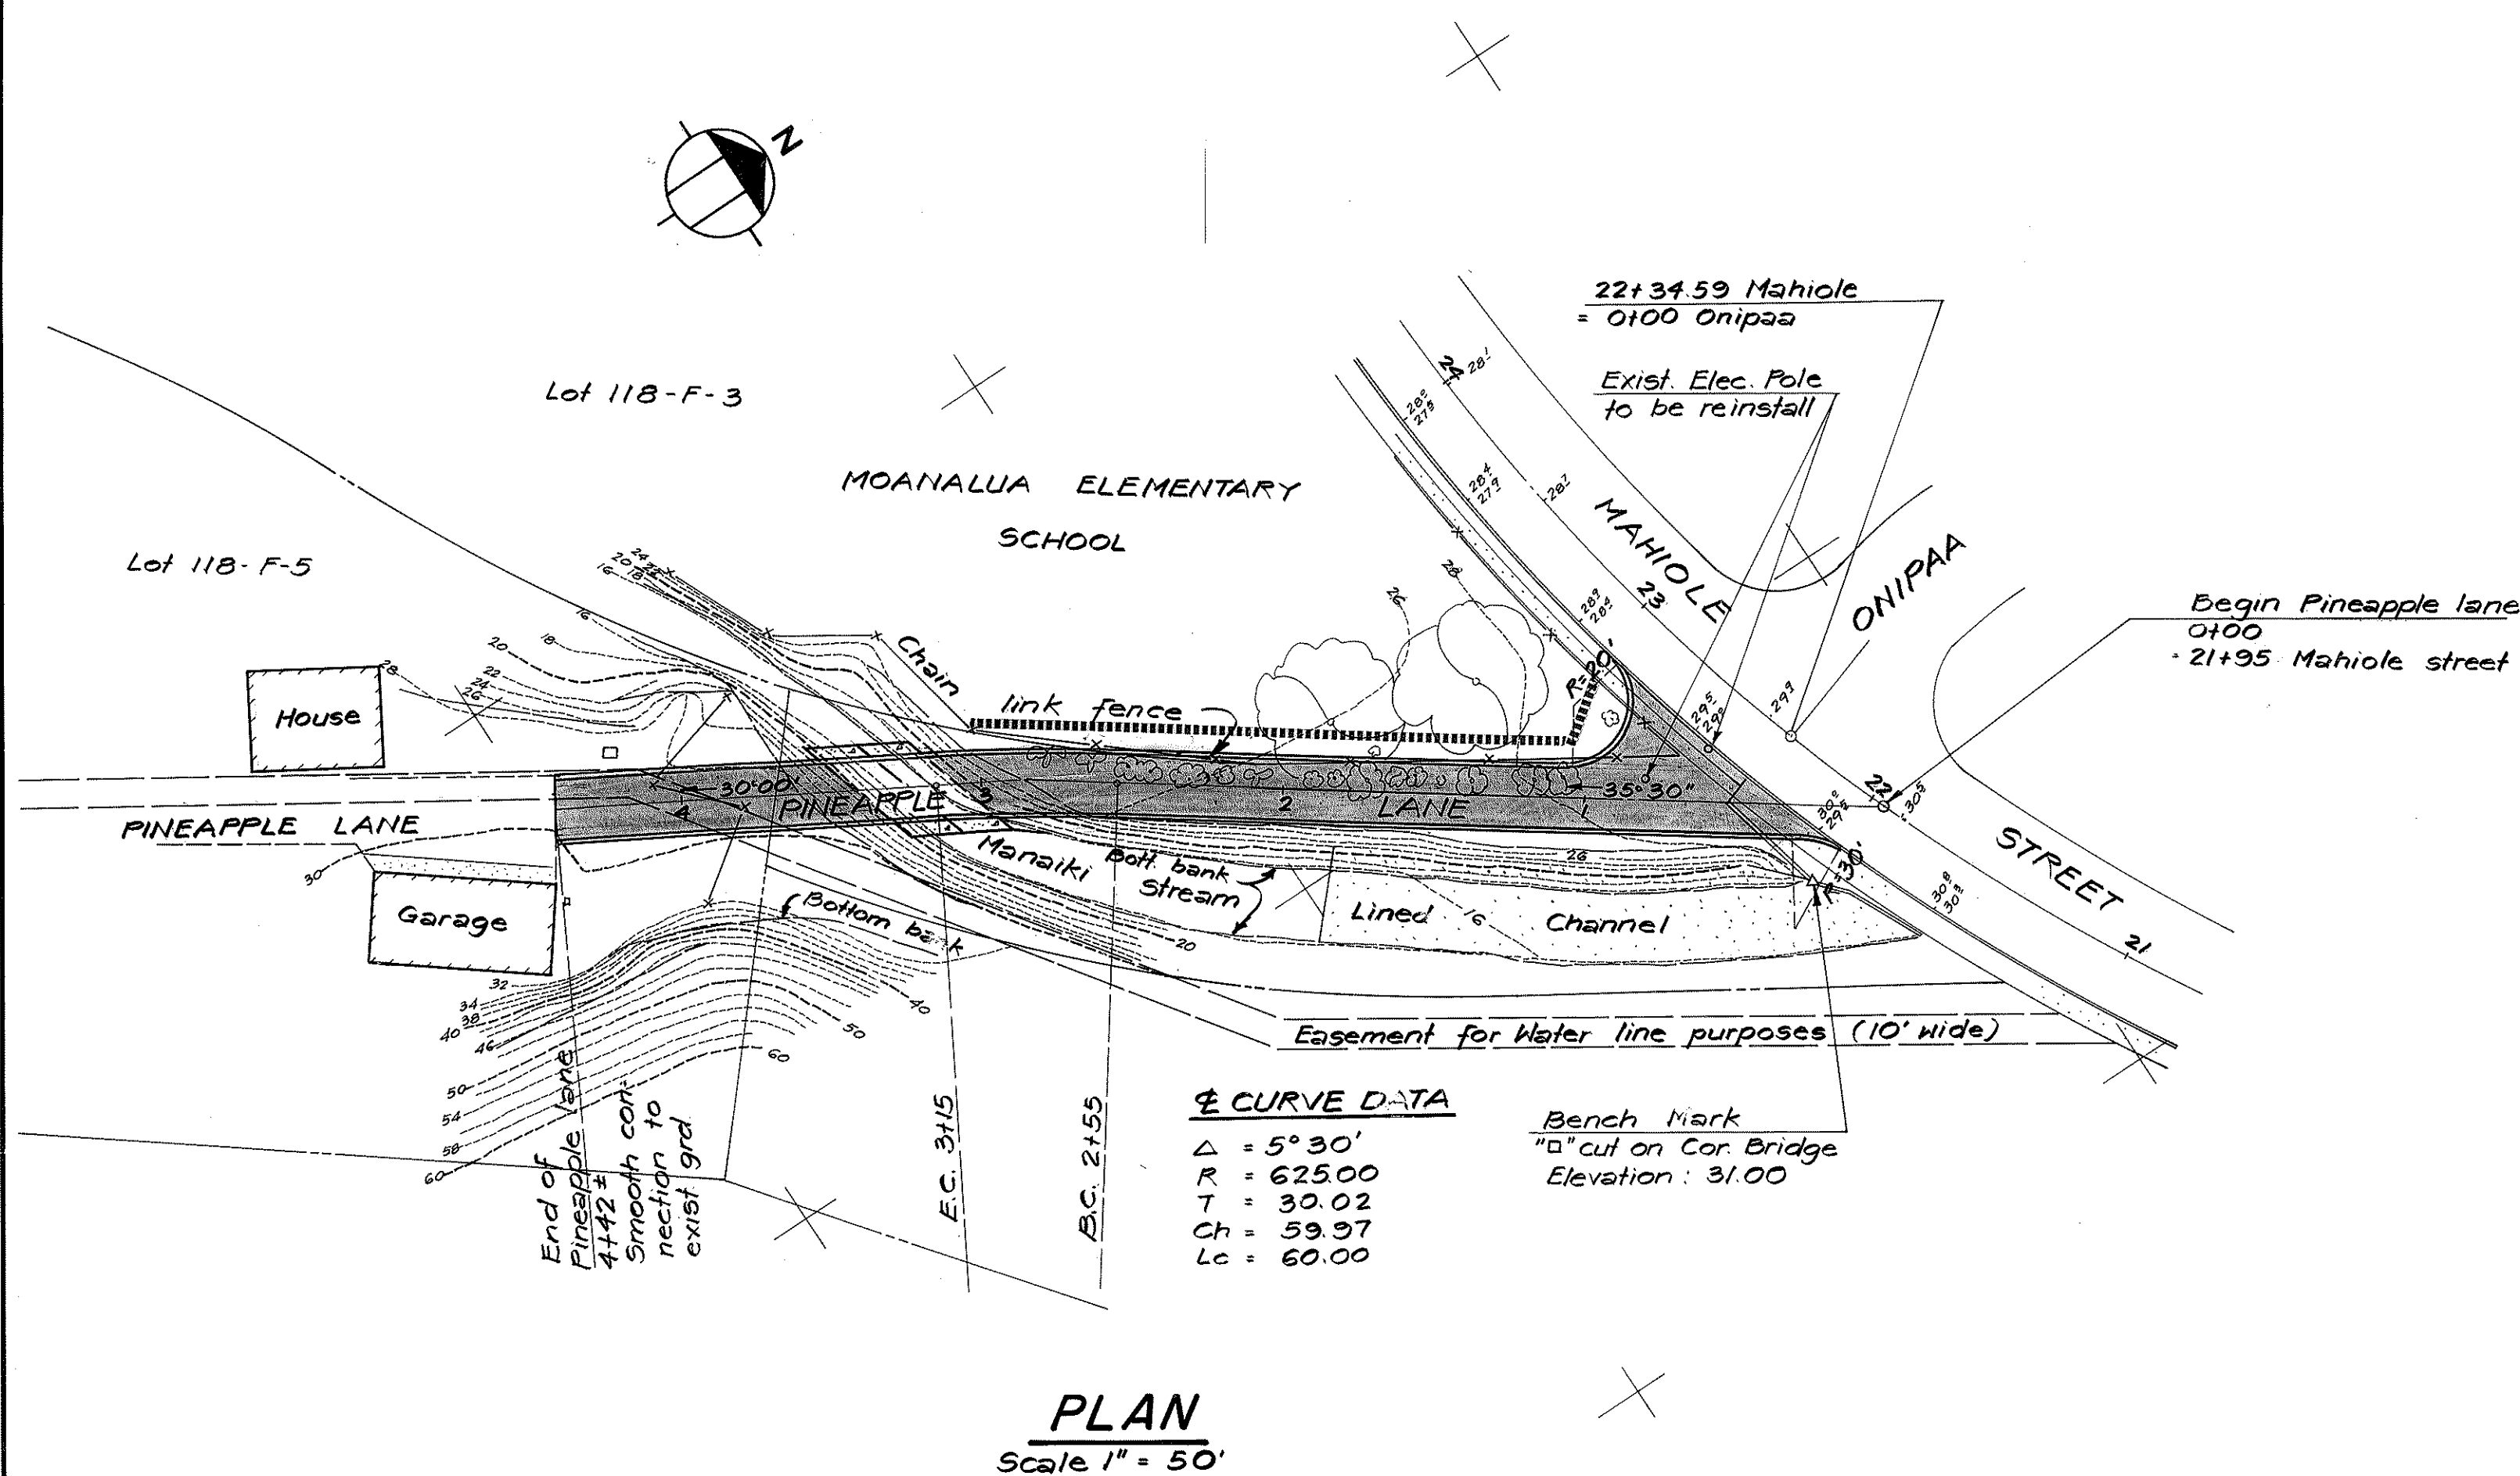


FED. ROAD DIST. NO.	STATE	FED. AID PROJ. NO.	FISCAL YEAR	SHEET NO.	TOTAL SHEETS
HAWAII	HAW.	U-078-1(3)	1973	12	36

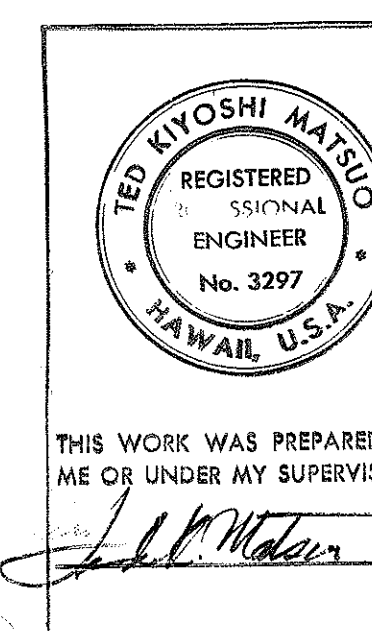

FORT SHAFTER SEPARATION

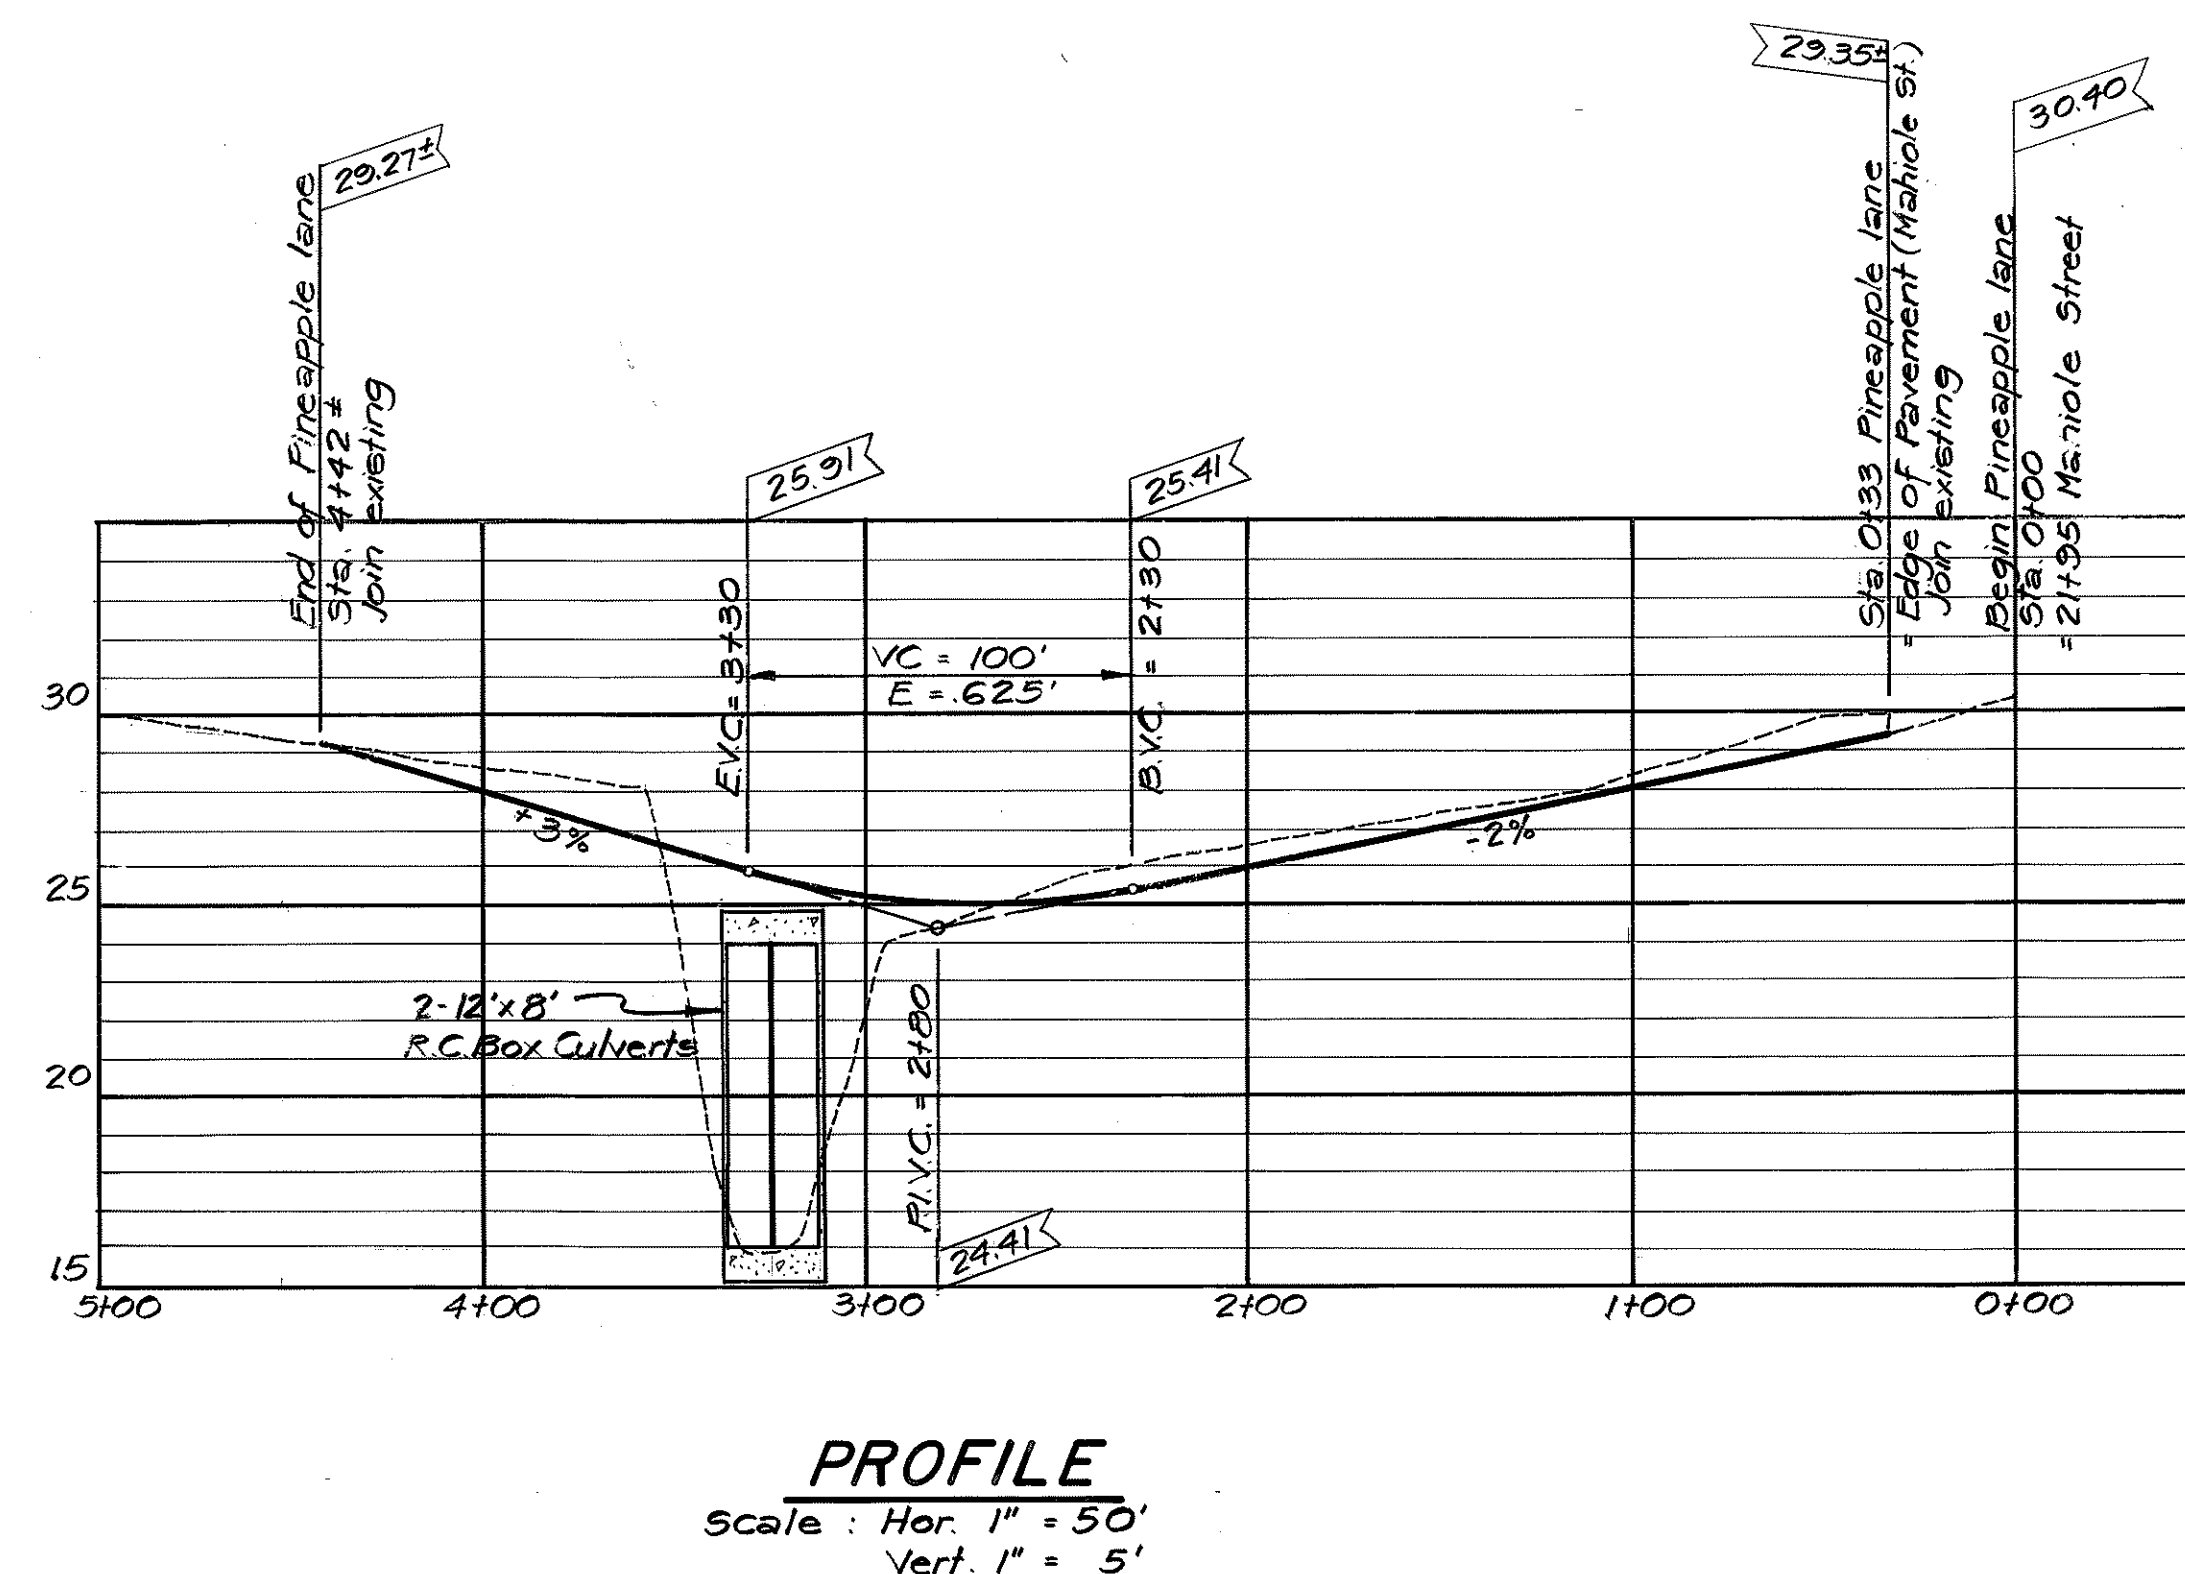

STATE OF HAWAII
DEPARTMENT OF TRANSPORTATION
HIGHWAYS DIVISION

PRELIMINARY DESIGN
PLANS, PROFILES & SECTIONS
PINEAPPLE LANE &
FORT SHAFTER SEPARATION

SCALE: AS SHOWN

DATE: AUG 24 1973

SHEET NO. 7 OF 14 SHEETS