



FED. ROAD DIST. NO.	STATE	FED. AID PROJ. NO.	FISCAL YEAR	SHEET NO.	TOTAL SHEETS
HAWAII	HAW.	U-078-1(14)	1976	4	6





BORING S-3

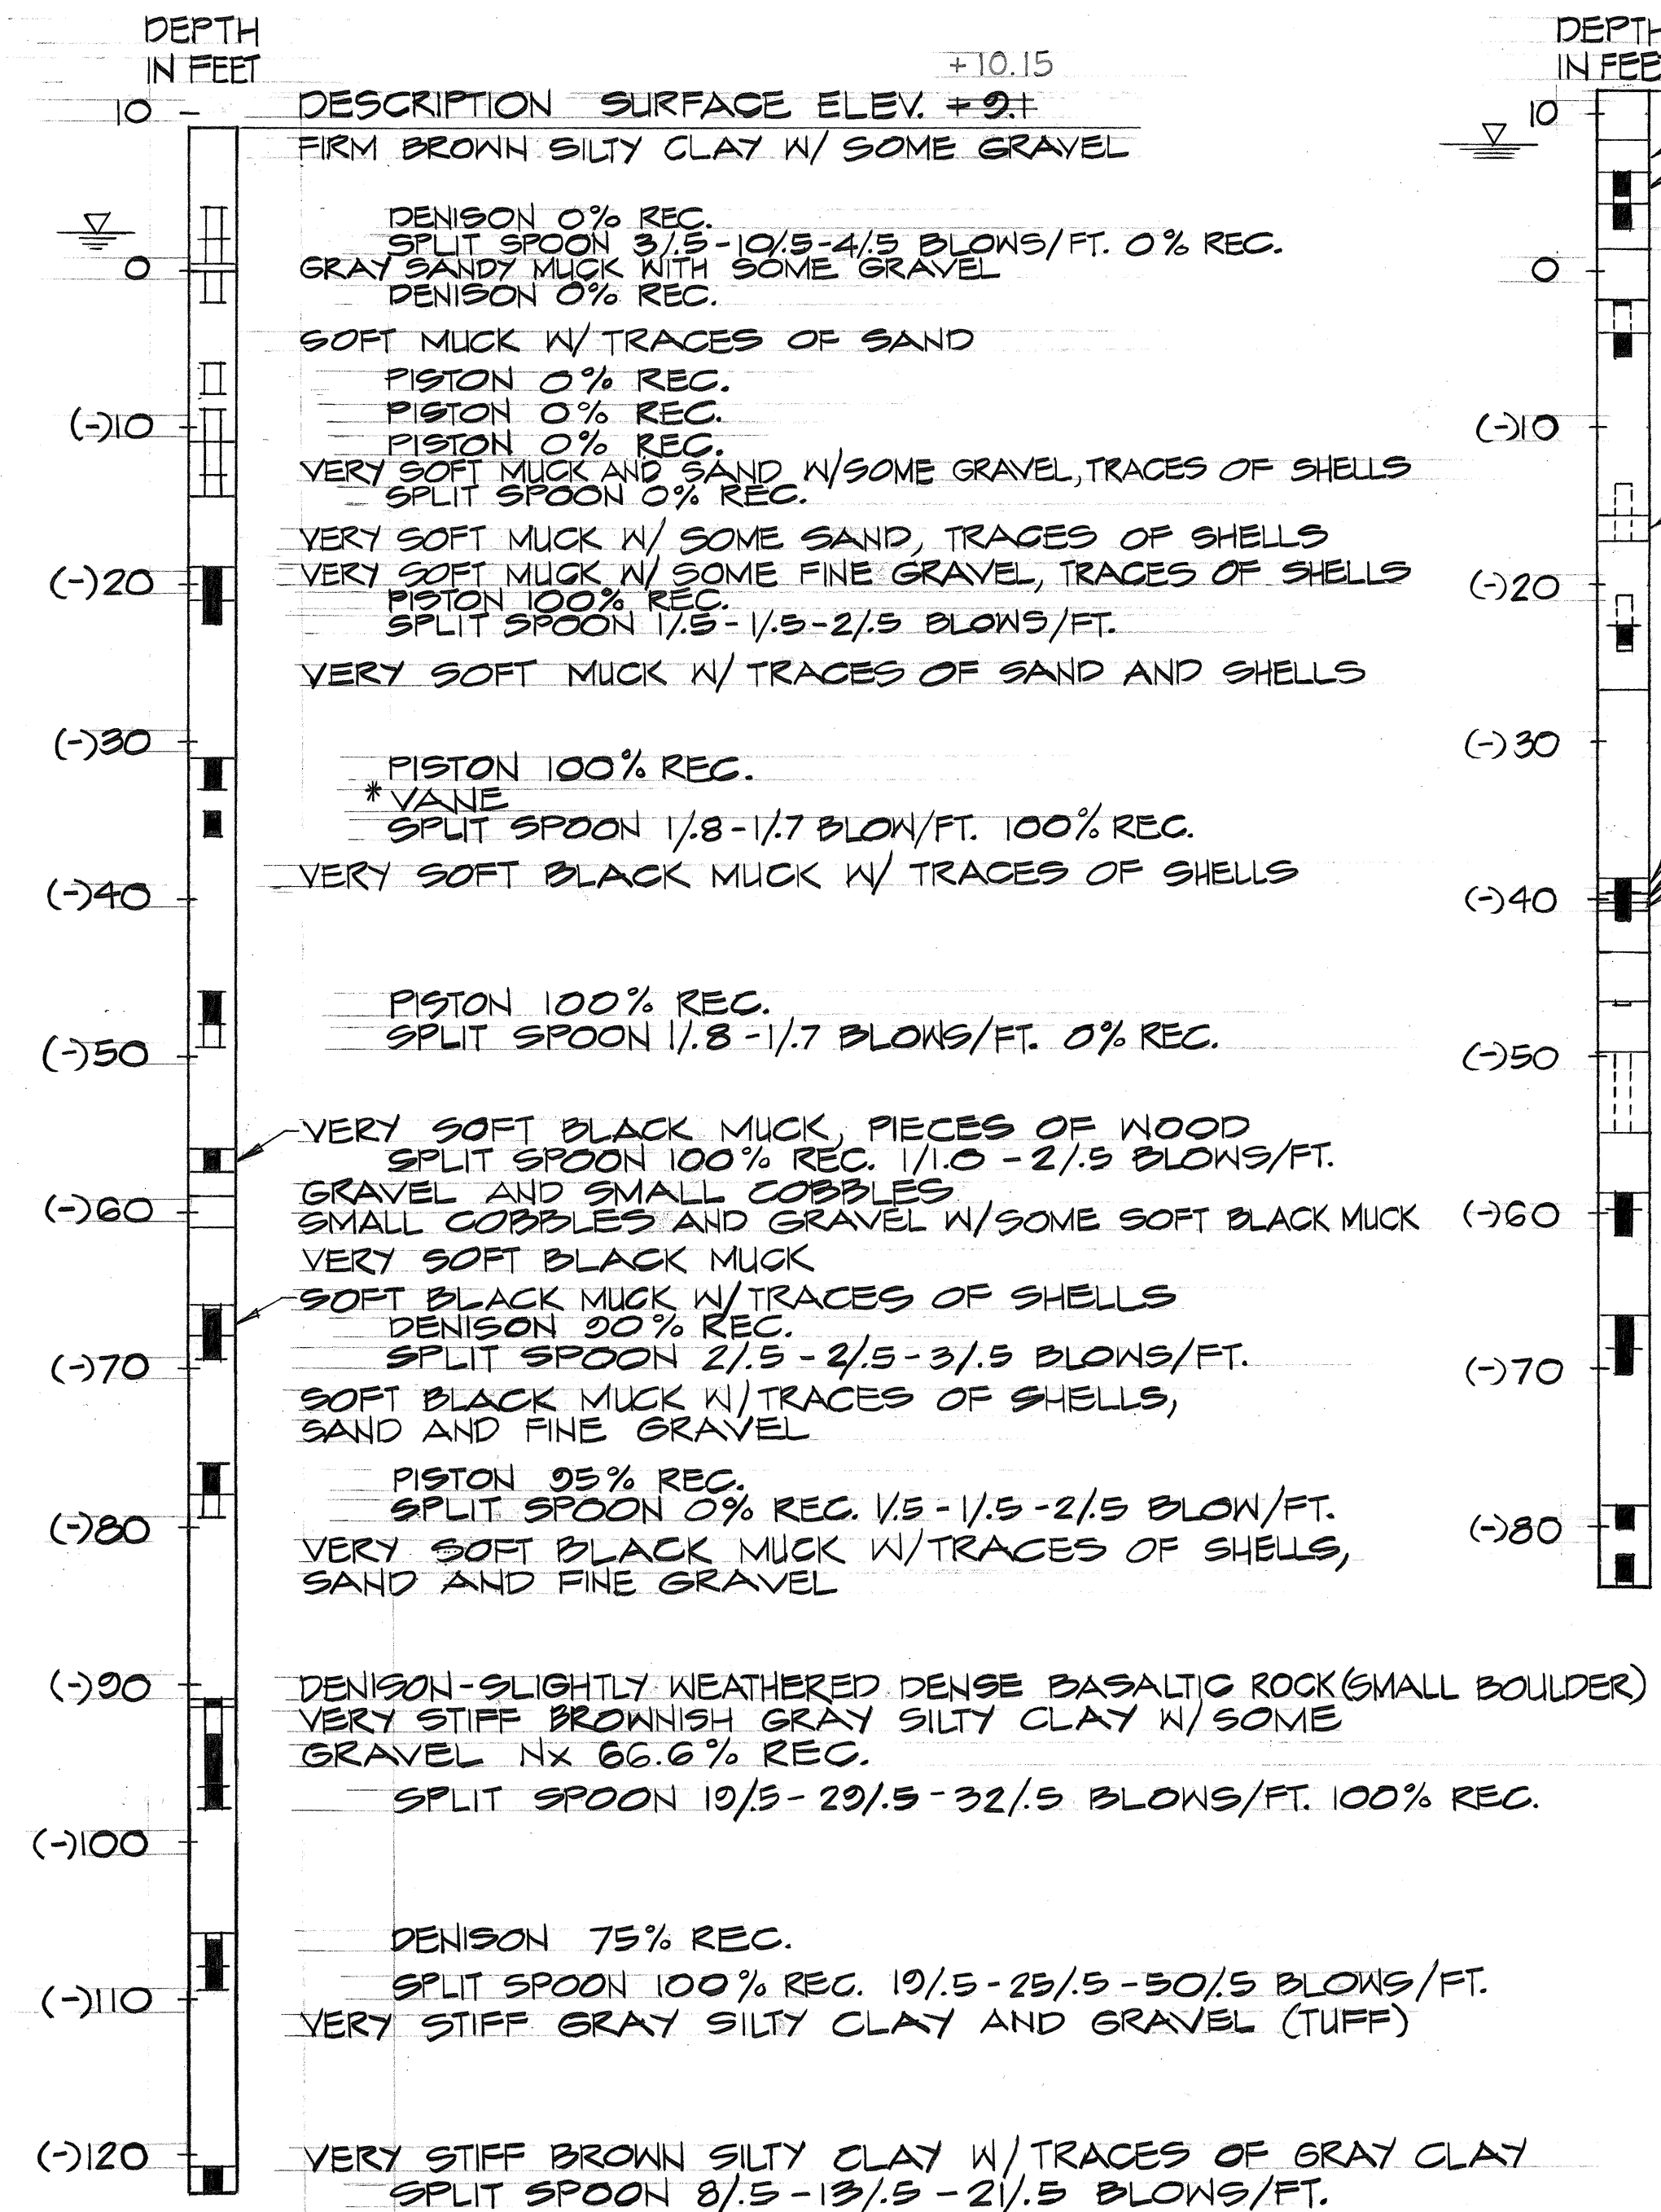


BORING M-11

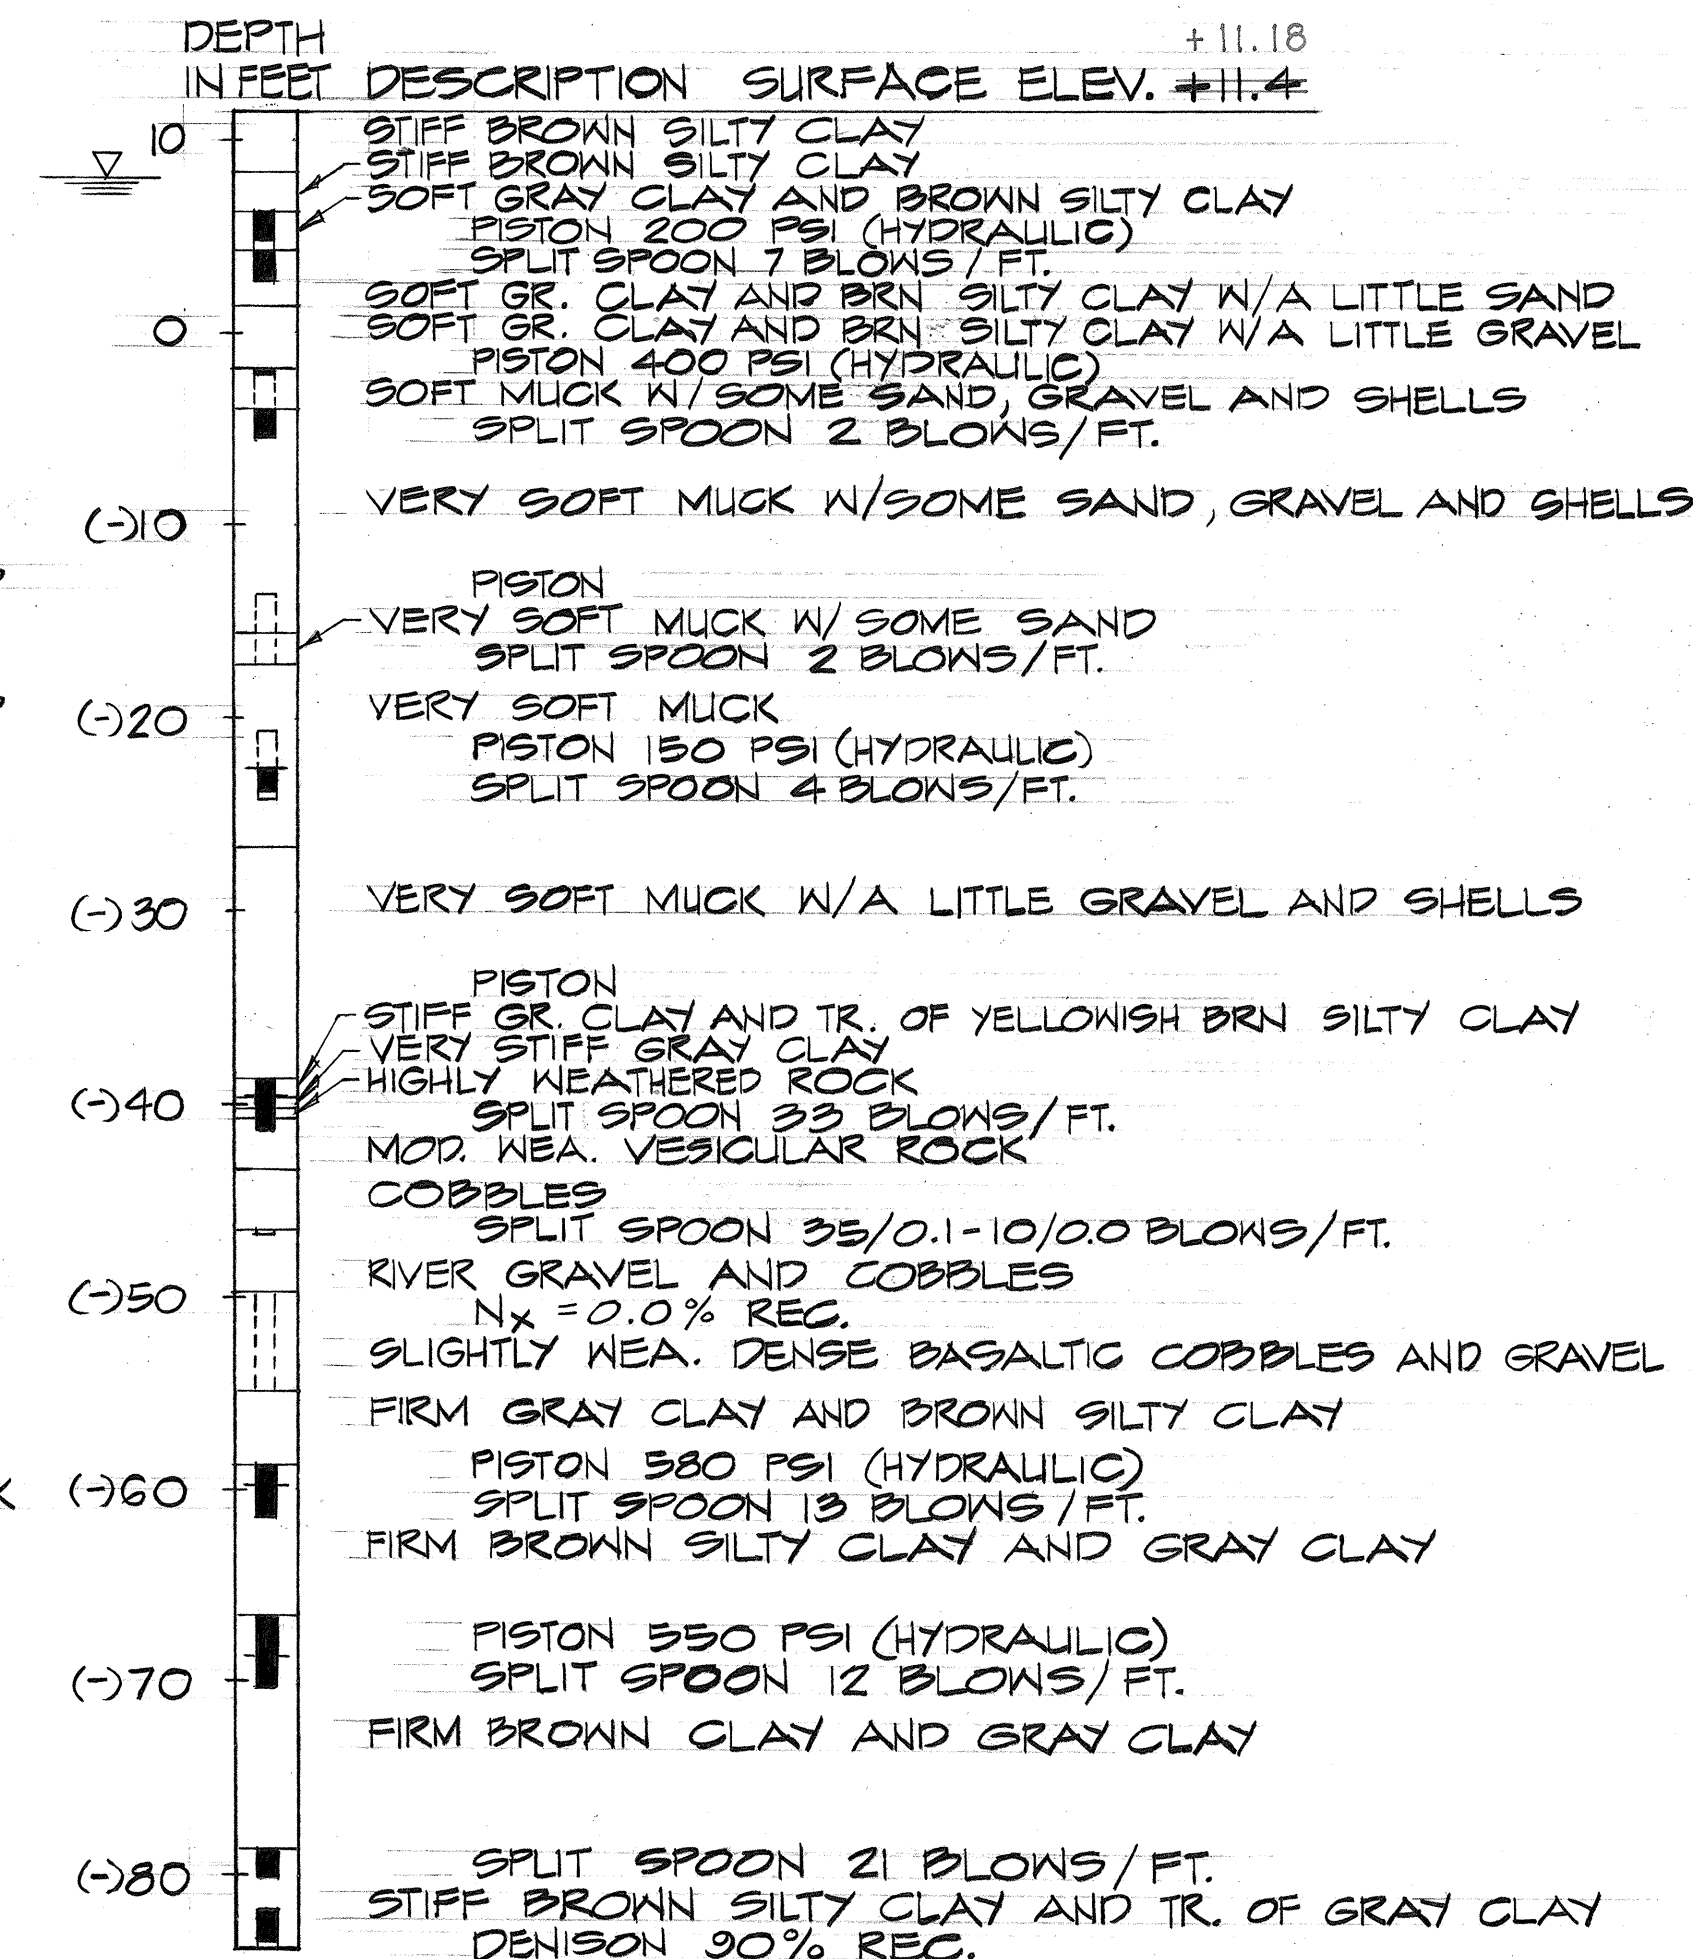

BORING M-12

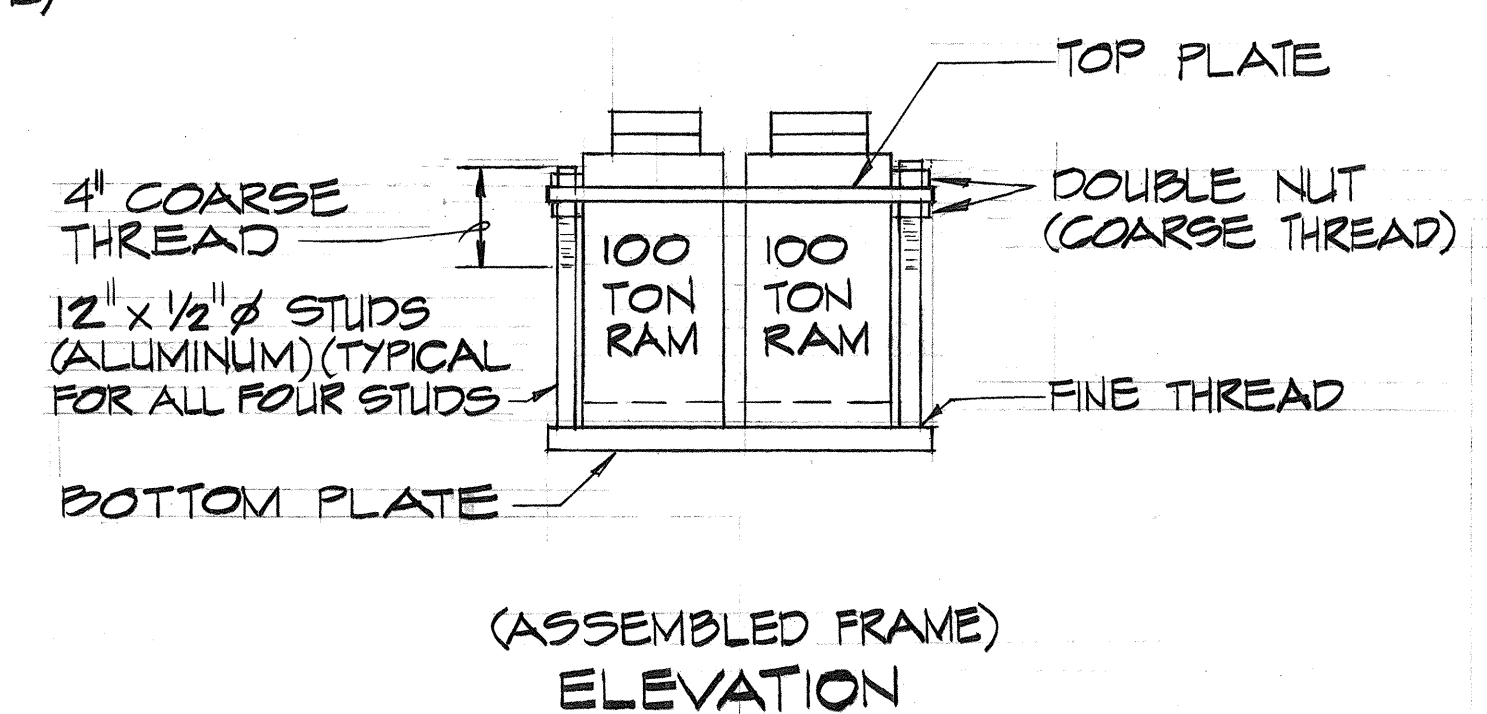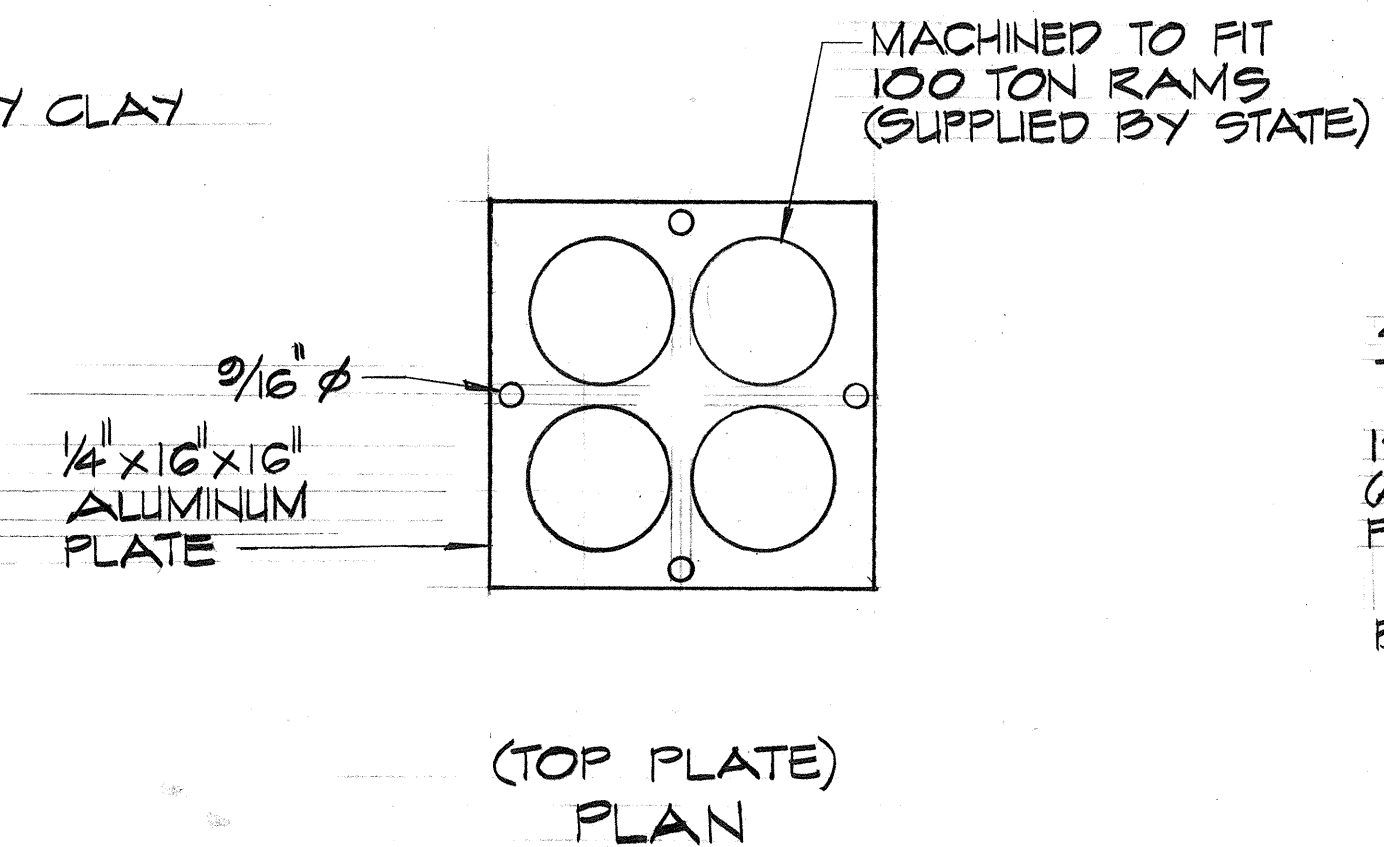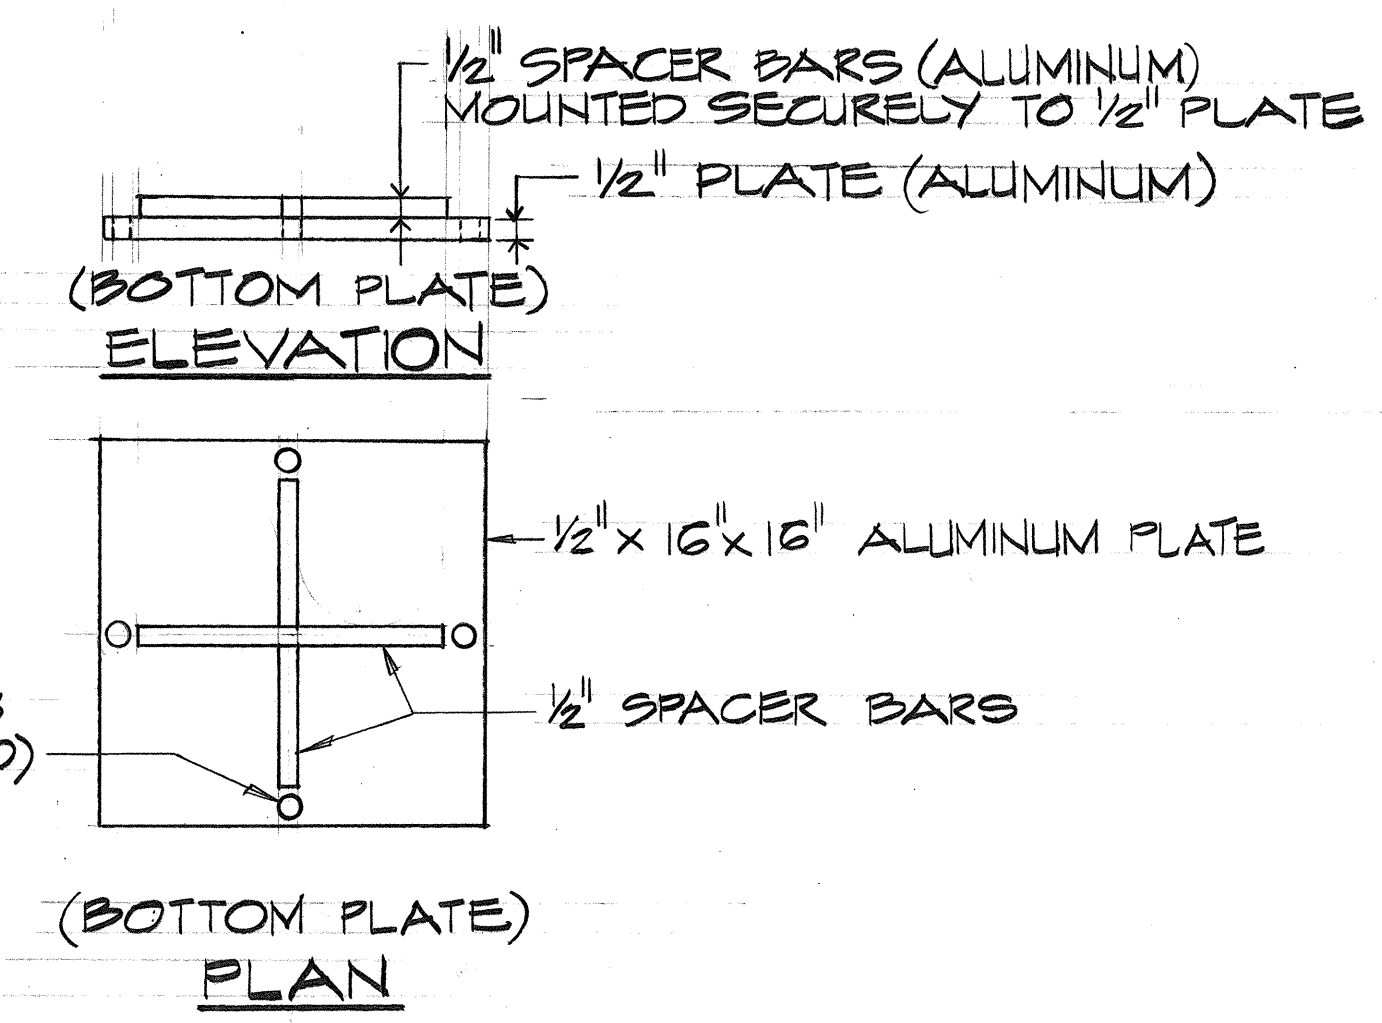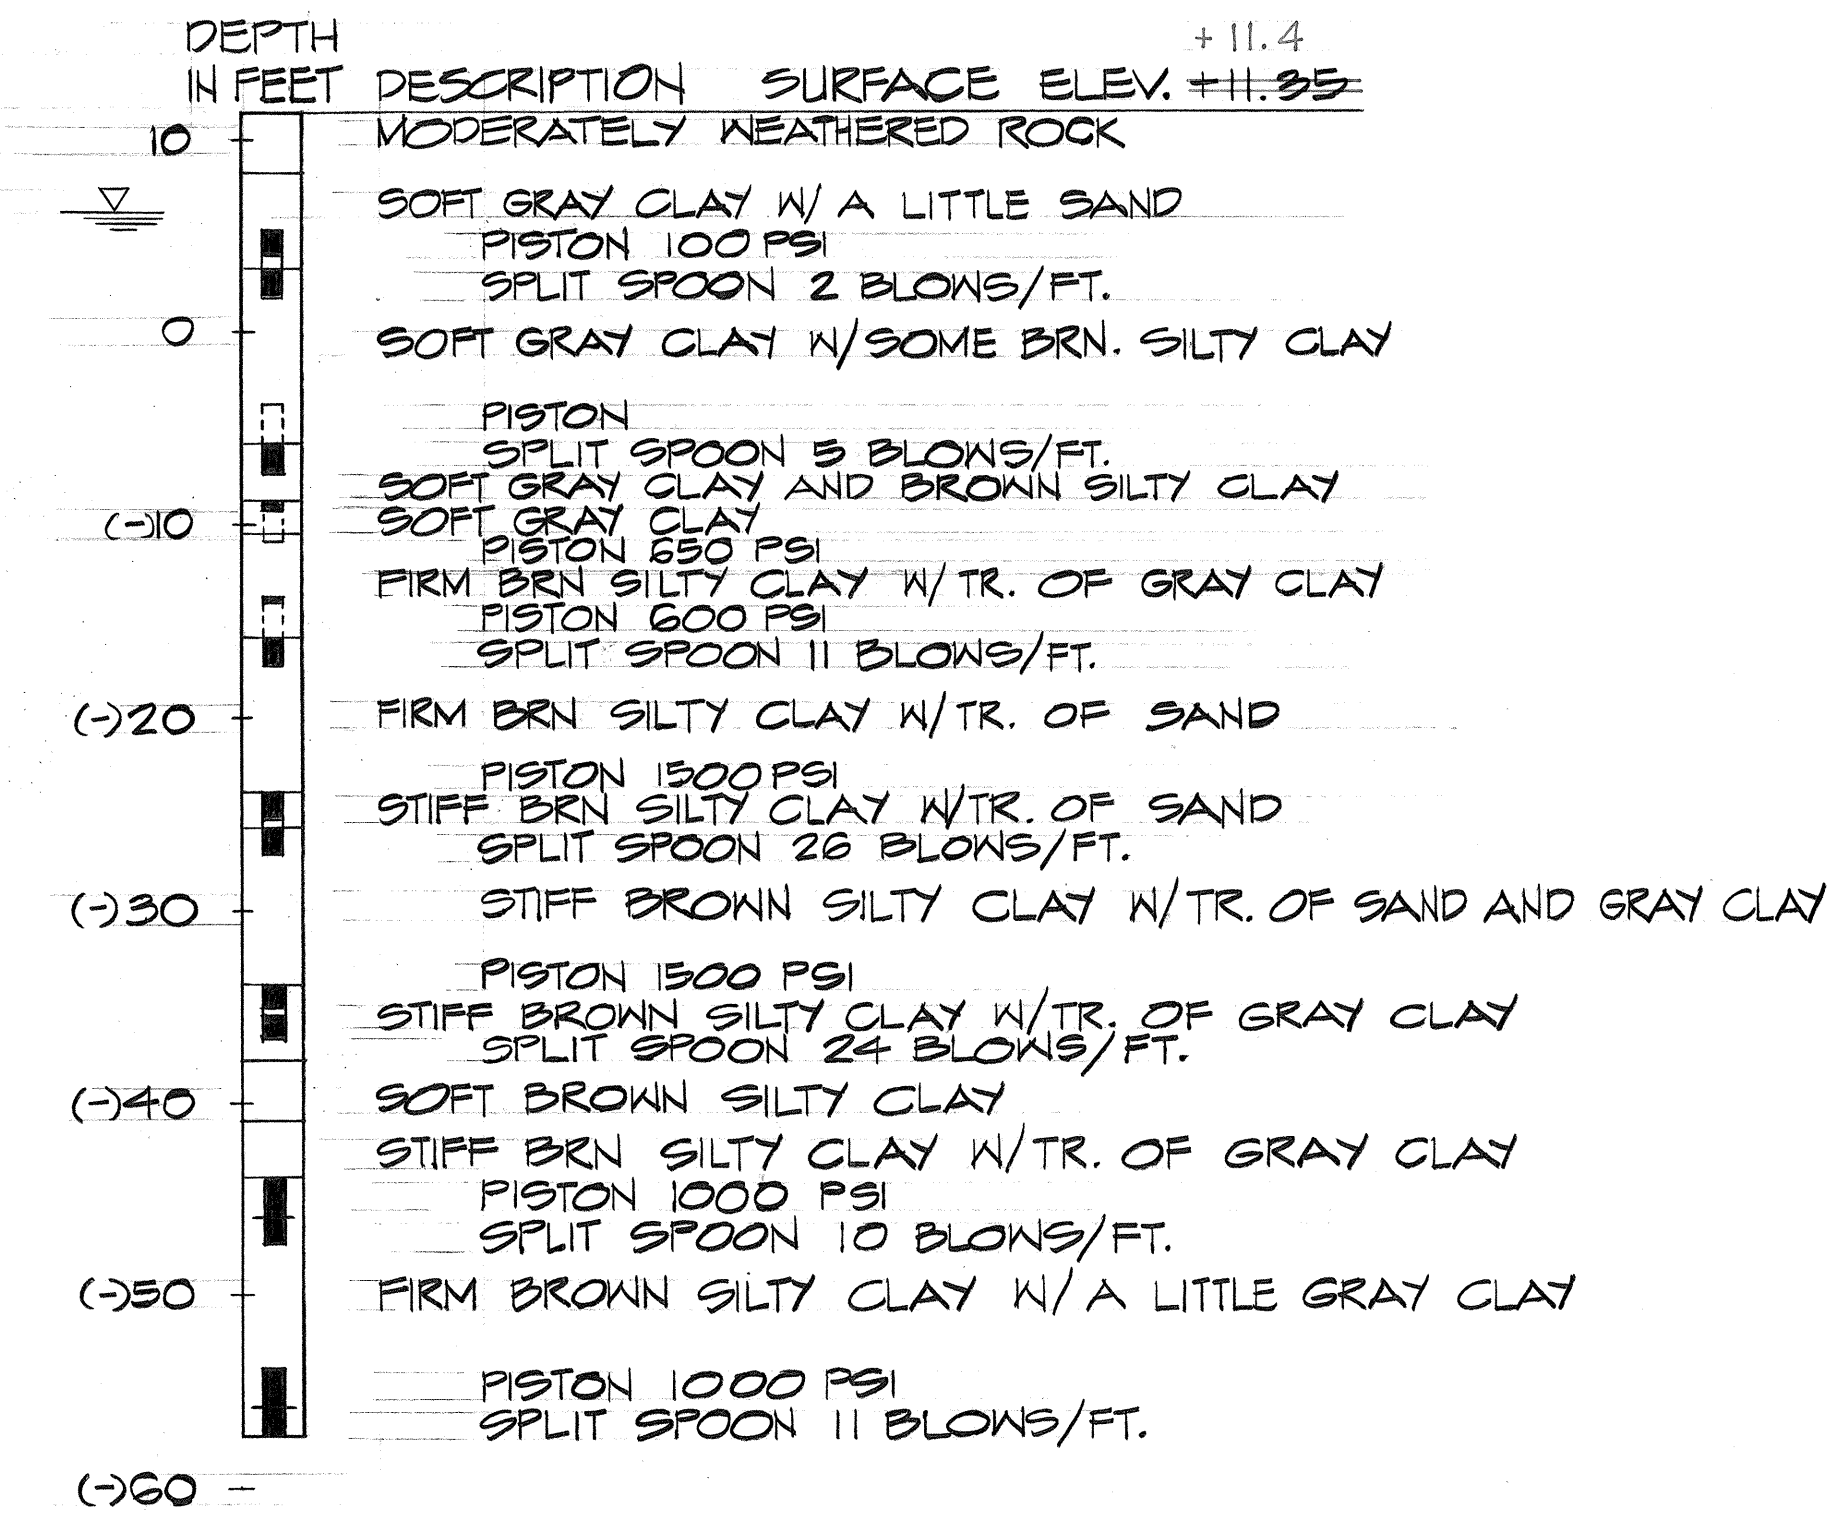

LOAD TEST CLAMPING DEVICE
NO SCALE

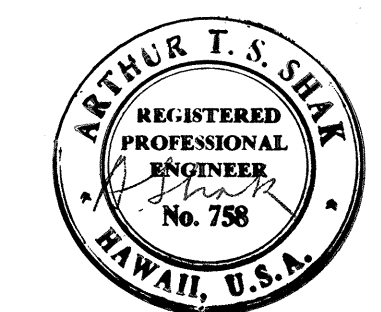

STATE OF HAWAII
DEPARTMENT OF TRANSPORTATION
HIGHWAYS DIVISION

BORING LOGS AND DETAILS

MOANALUA ROAD
F.A. Proj. No. U-078-1(14)

SCALE: AS SHOWN DATE: APRIL 8, 1976

THIS WORK WAS PREPARED BY ME
OR UNDER MY SUPERVISION