


[illegible]

FED. ROAD DIST. NO.	STATE	PROJ. NO.	FISCAL YEAR	SHEET NO.	TOTAL SHEETS
HAWAII	HAW.	HWY-D-01-76M	1976	1	26

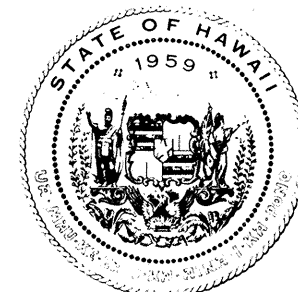


STATE OF HAWAII

DEPARTMENT OF TRANSPORTATION
HIGHWAYS DIVISION

PROJECT NO. HWY-0-01-76M

ISLAND OF OAHU

LOCATION PLAN

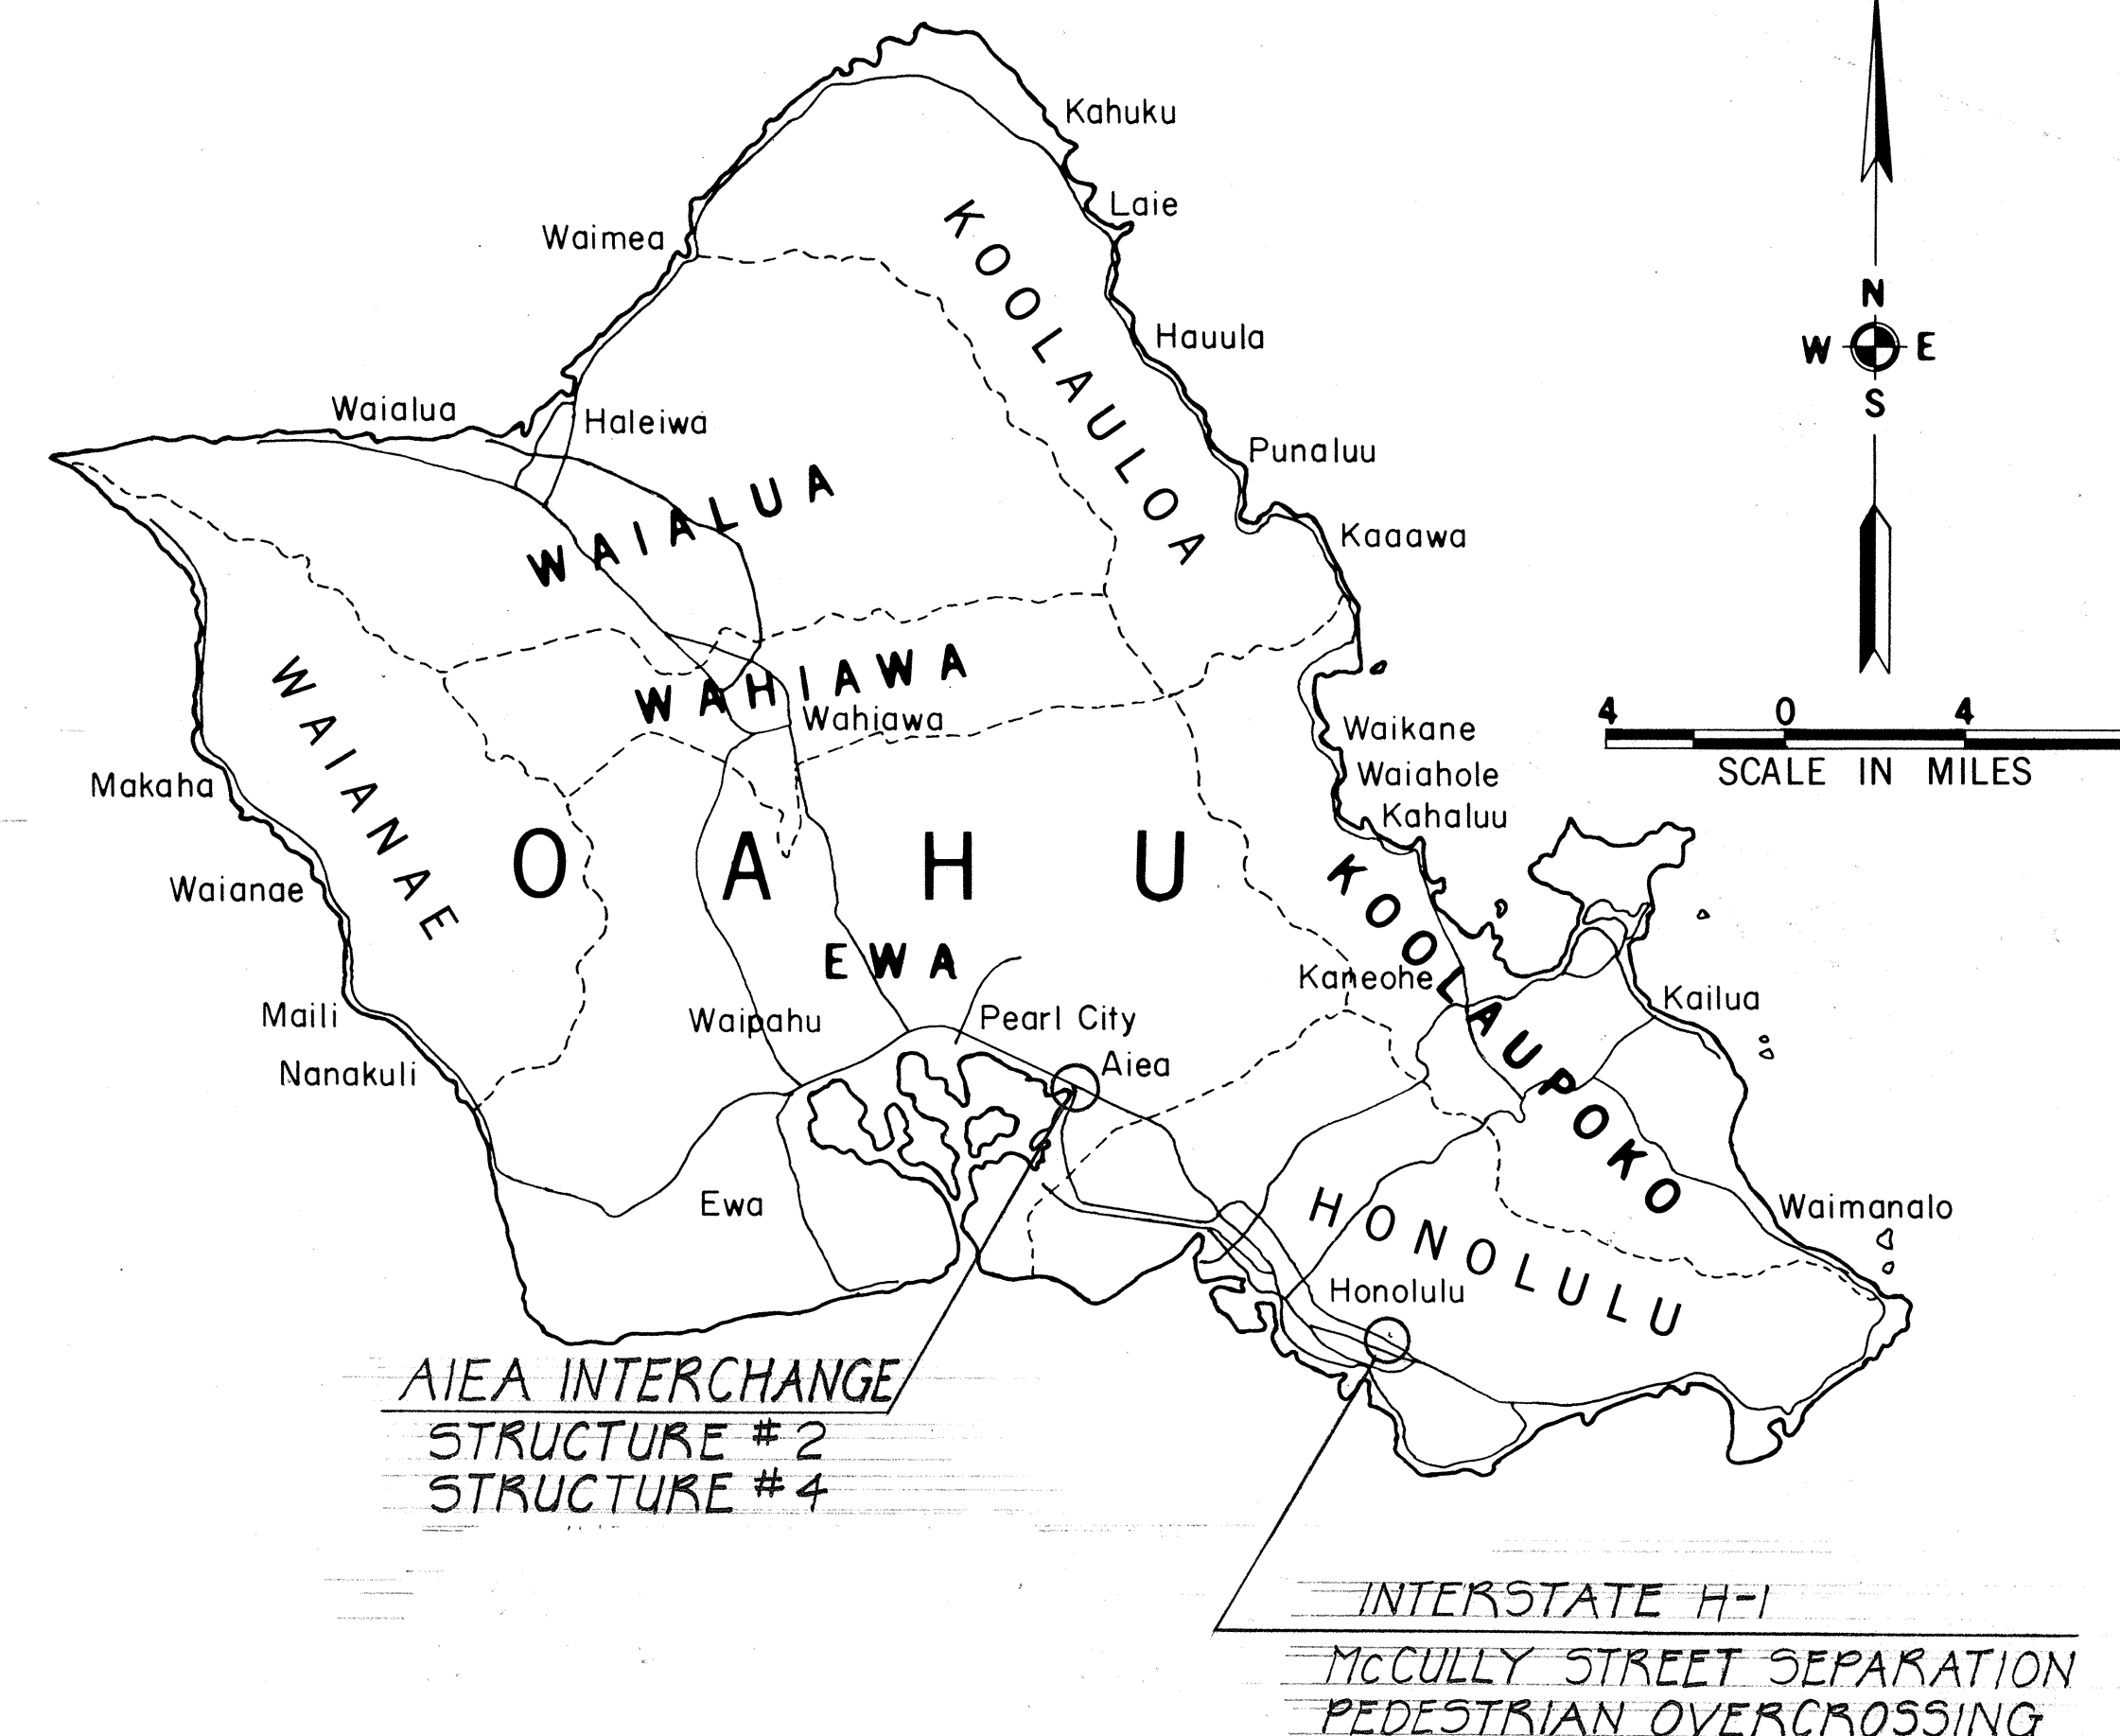

NO CHANGES WERE MADE DURING CONSTRUCTION
ON THESE PLANS EXCEPT CHANGES IN THE
ORIGINAL THEORETICAL QUANTITIES. FOR ACTUAL
QUANTITIES, REFER TO PROJECT LEDGER AND/OR
COMPUTATION BOOK.

Glenn A. Matsumoto
PROJECT ENGINEER

for