

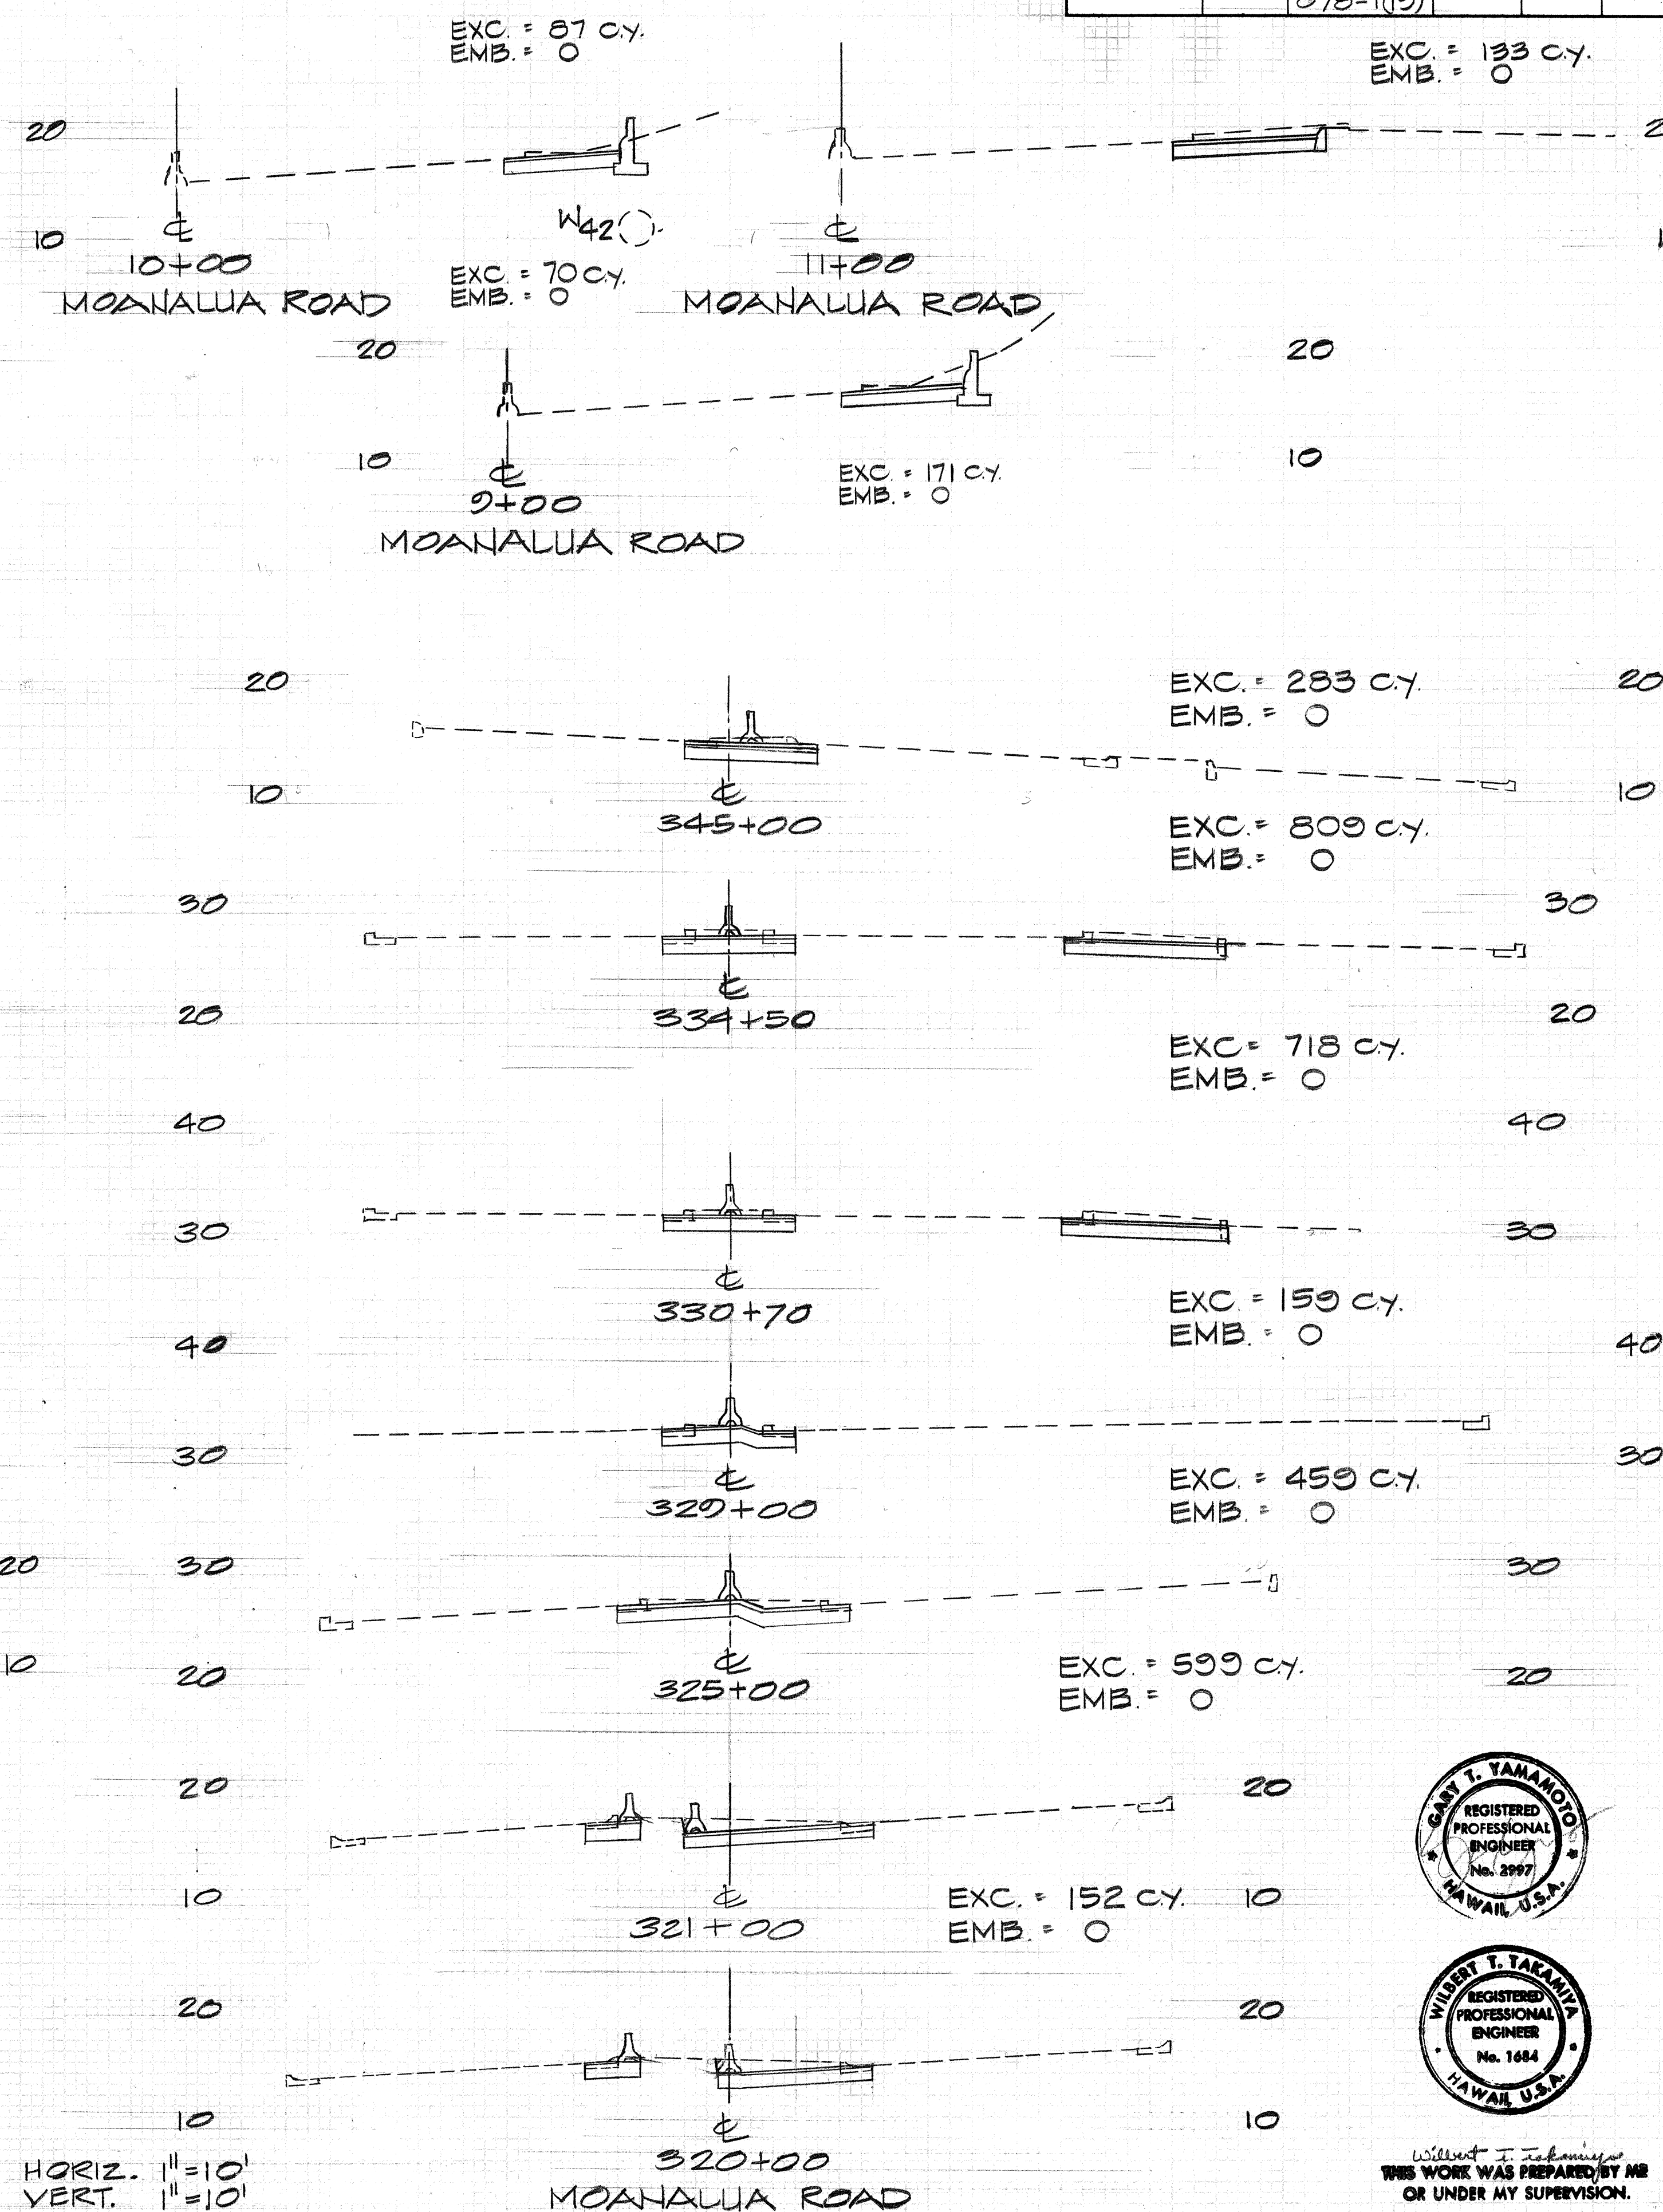
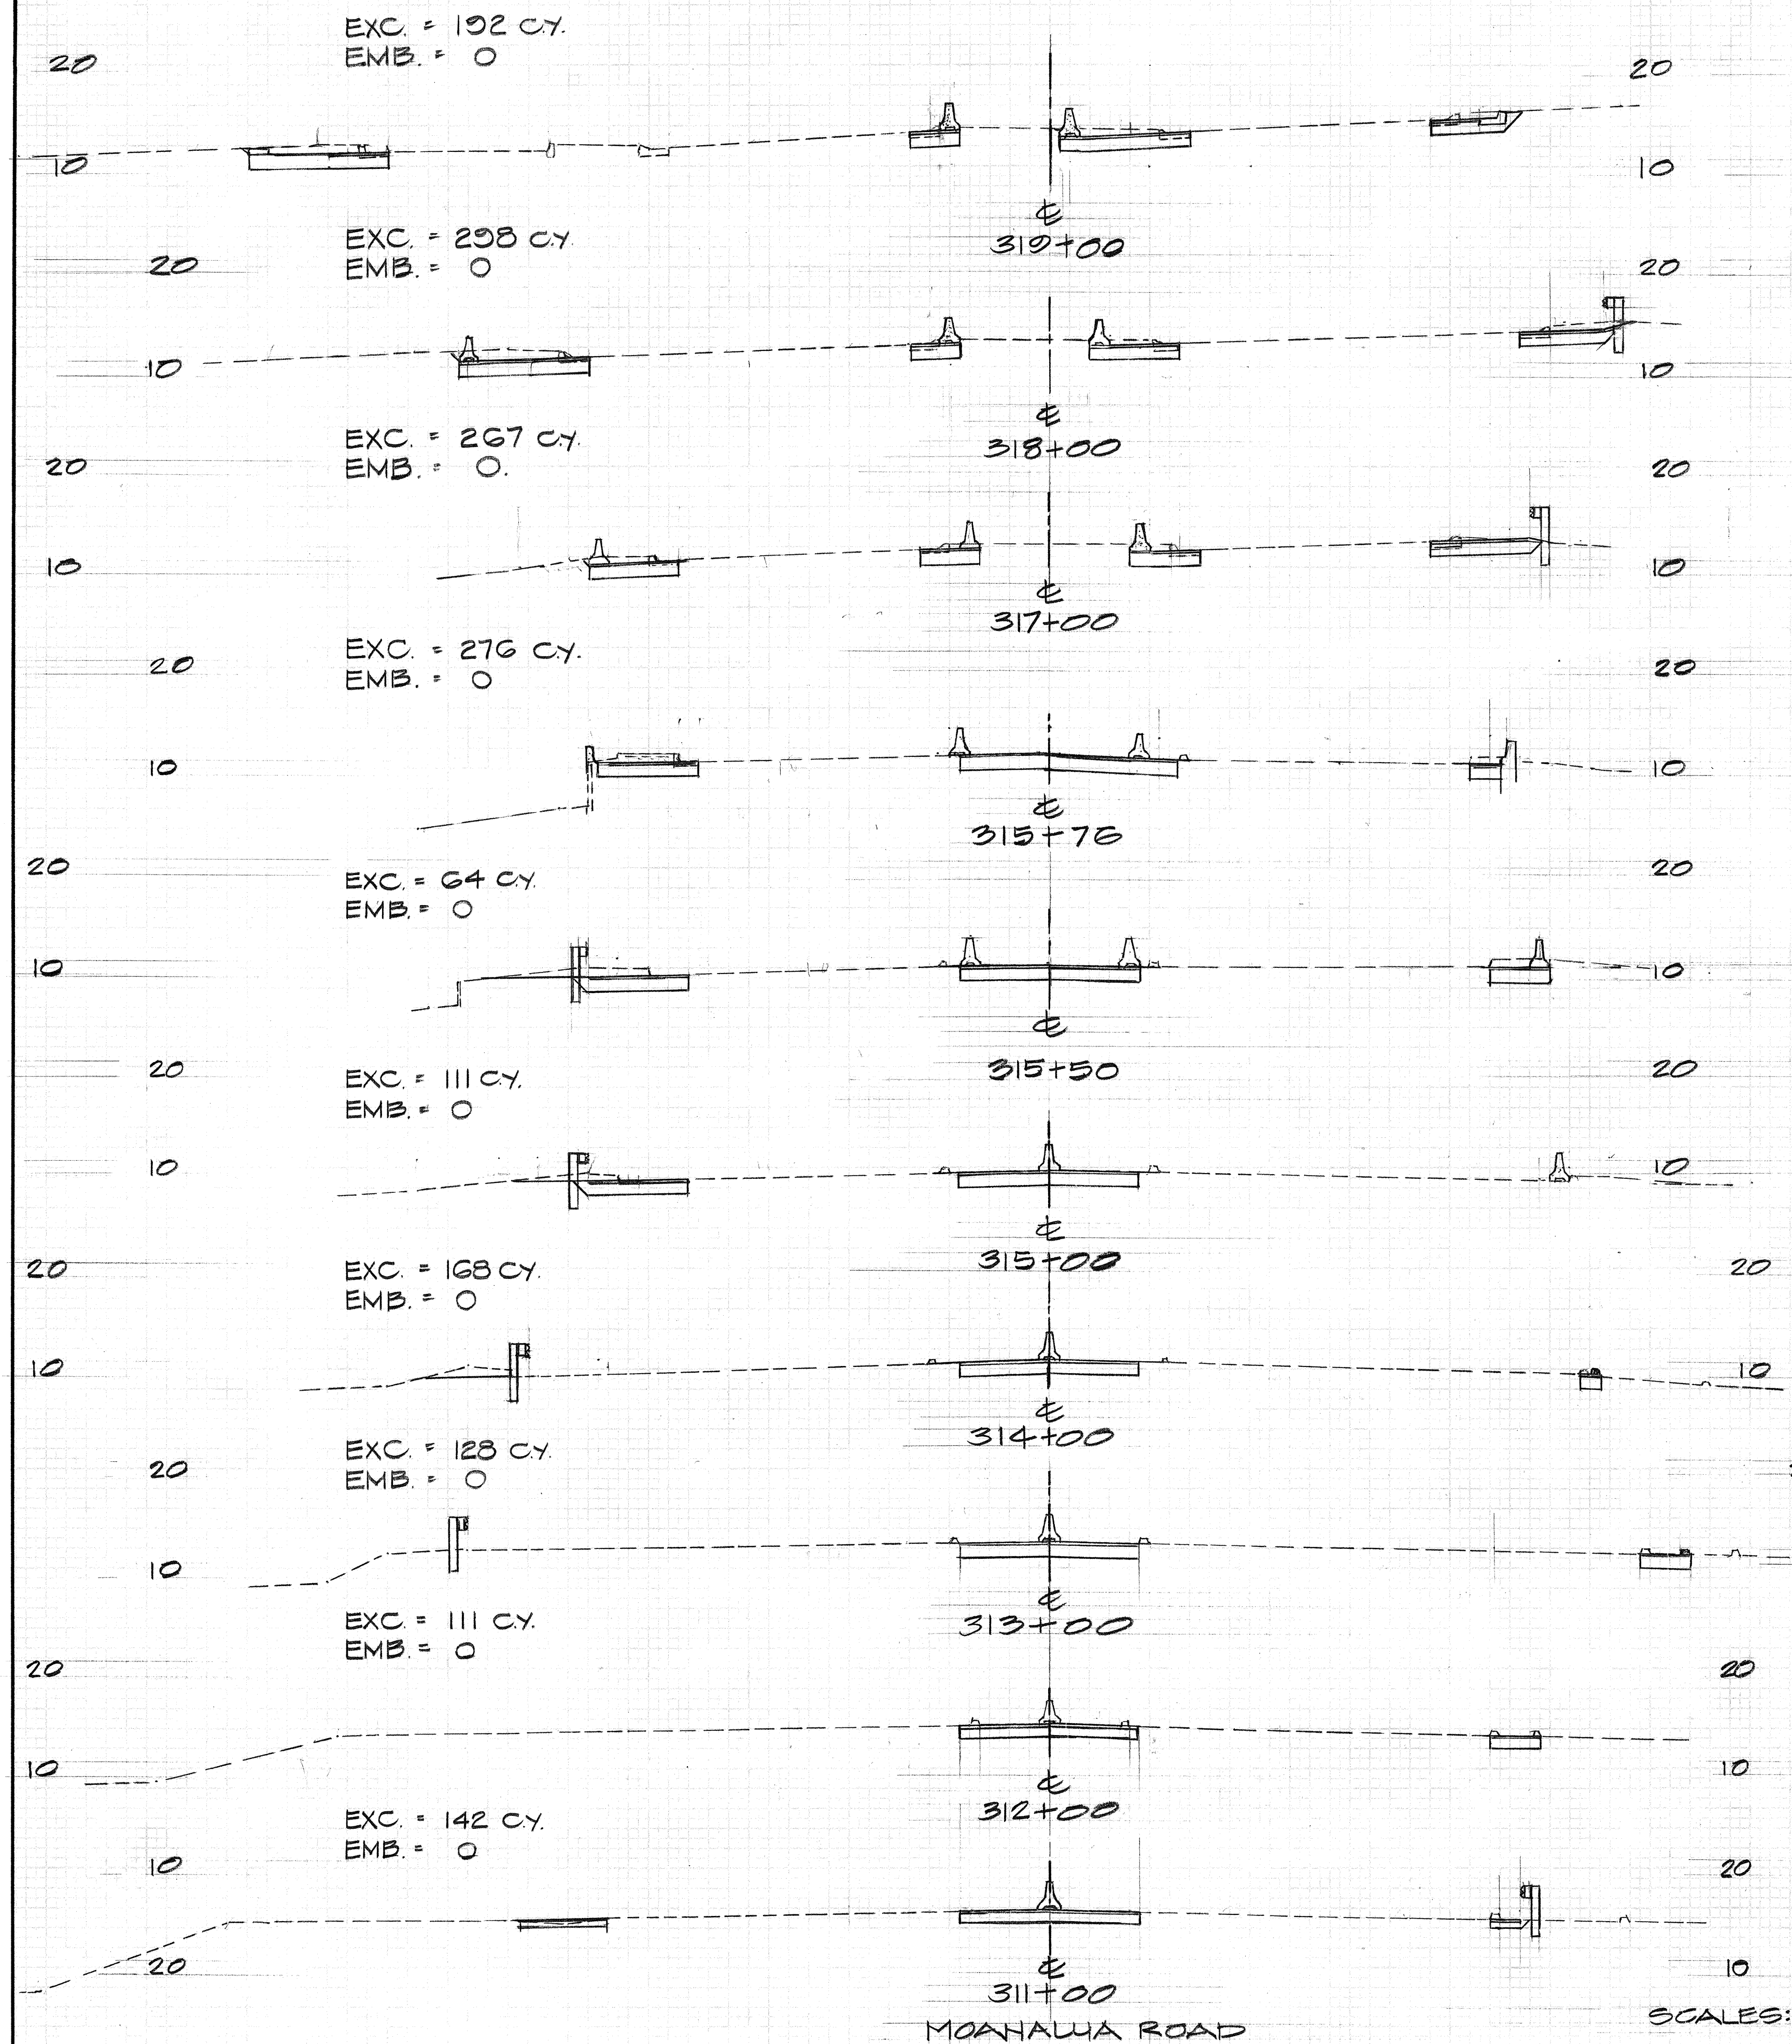


FED. ROAD DIST. NO.	STATE	FED. AID PROJ. NO.	FISCAL YEAR	SHEET NO.	TOTAL SHEETS
HAWAII	HAW.	HHS-078-1(19)	1977	147	147

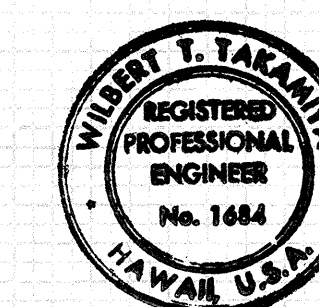

SCALES: HORIZ. 1"=10'
VERT. 1"=10'

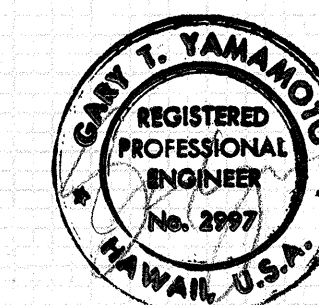

WILBERT T. TAKAMIYA
THIS WORK WAS PREPARED BY ME
OR UNDER MY SUPERVISION.