



FED. ROAD DIST. NO.	STATE	FED. AID PROJ. NO.	FISCAL YEAR	SHEET NO.	TOTAL SHEETS
HAWAII	HAW.				

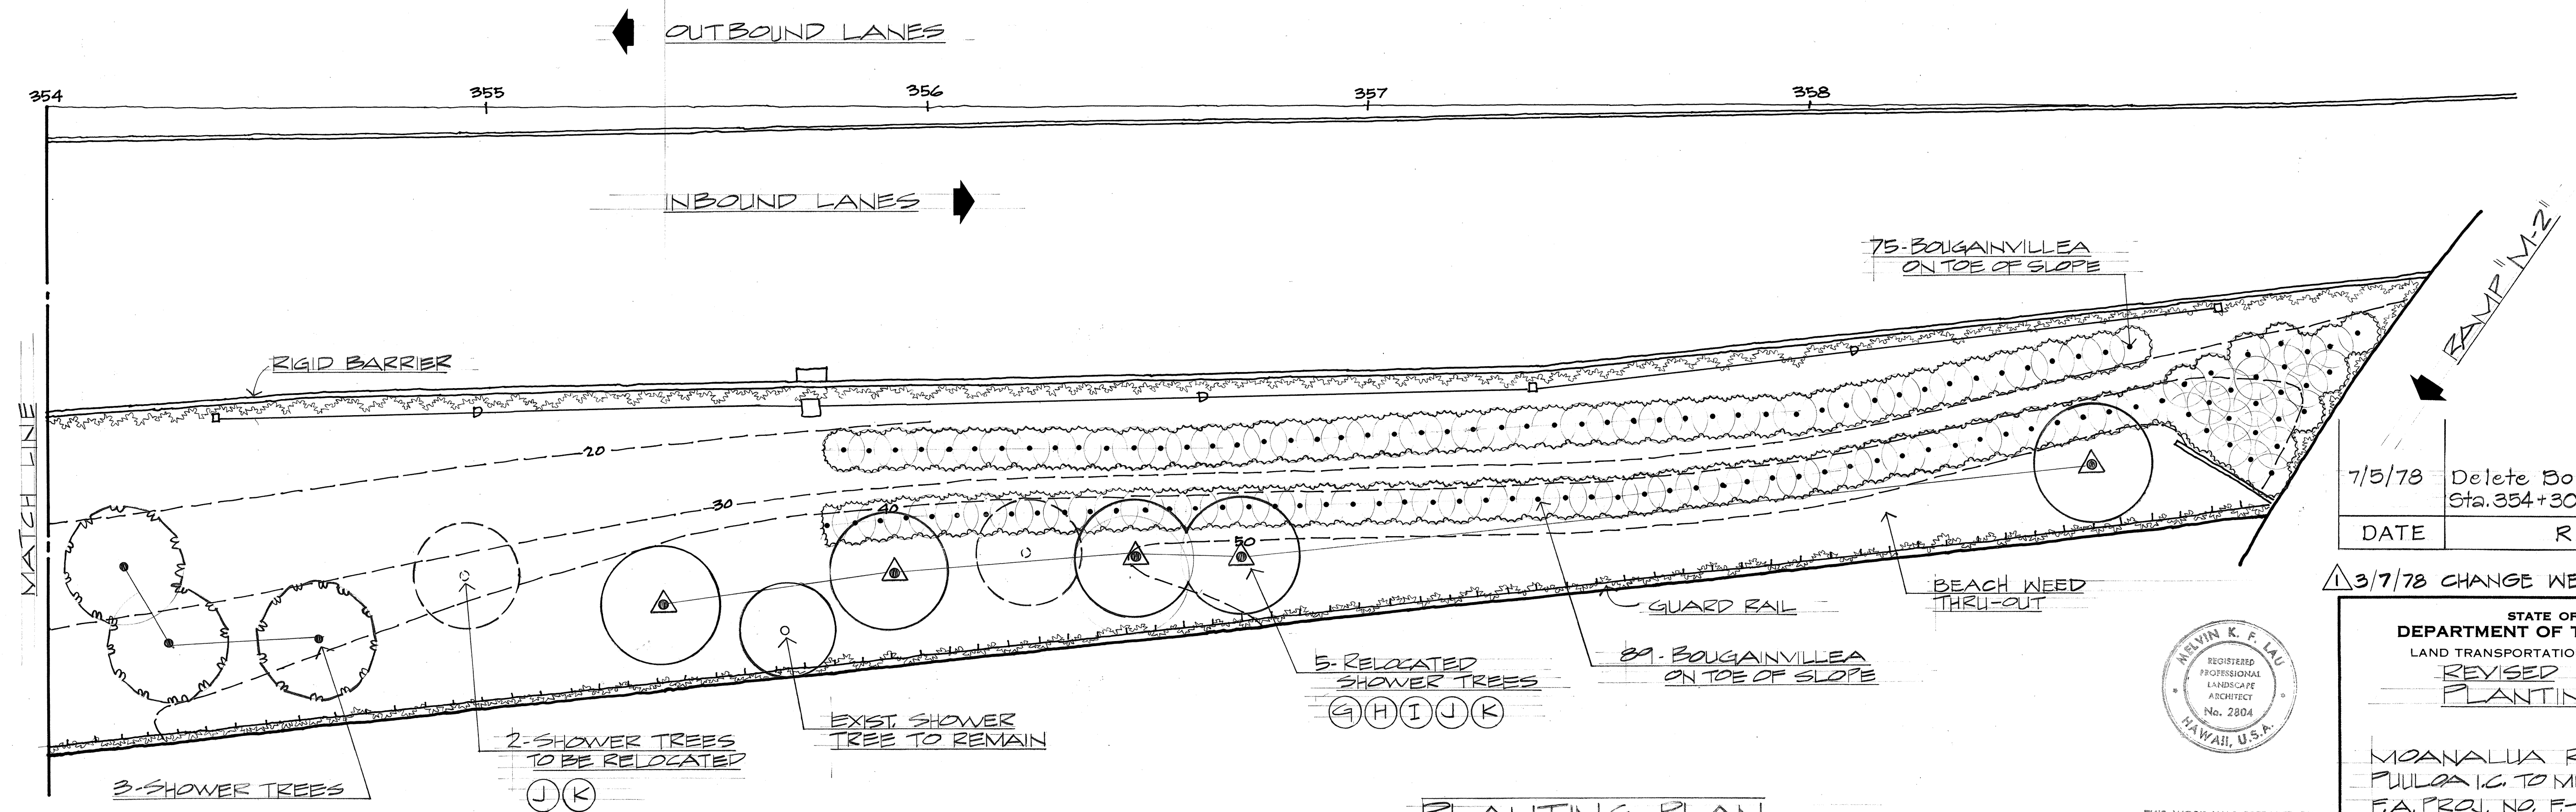

PLANTING PLAN
SCALE: 1"=20'

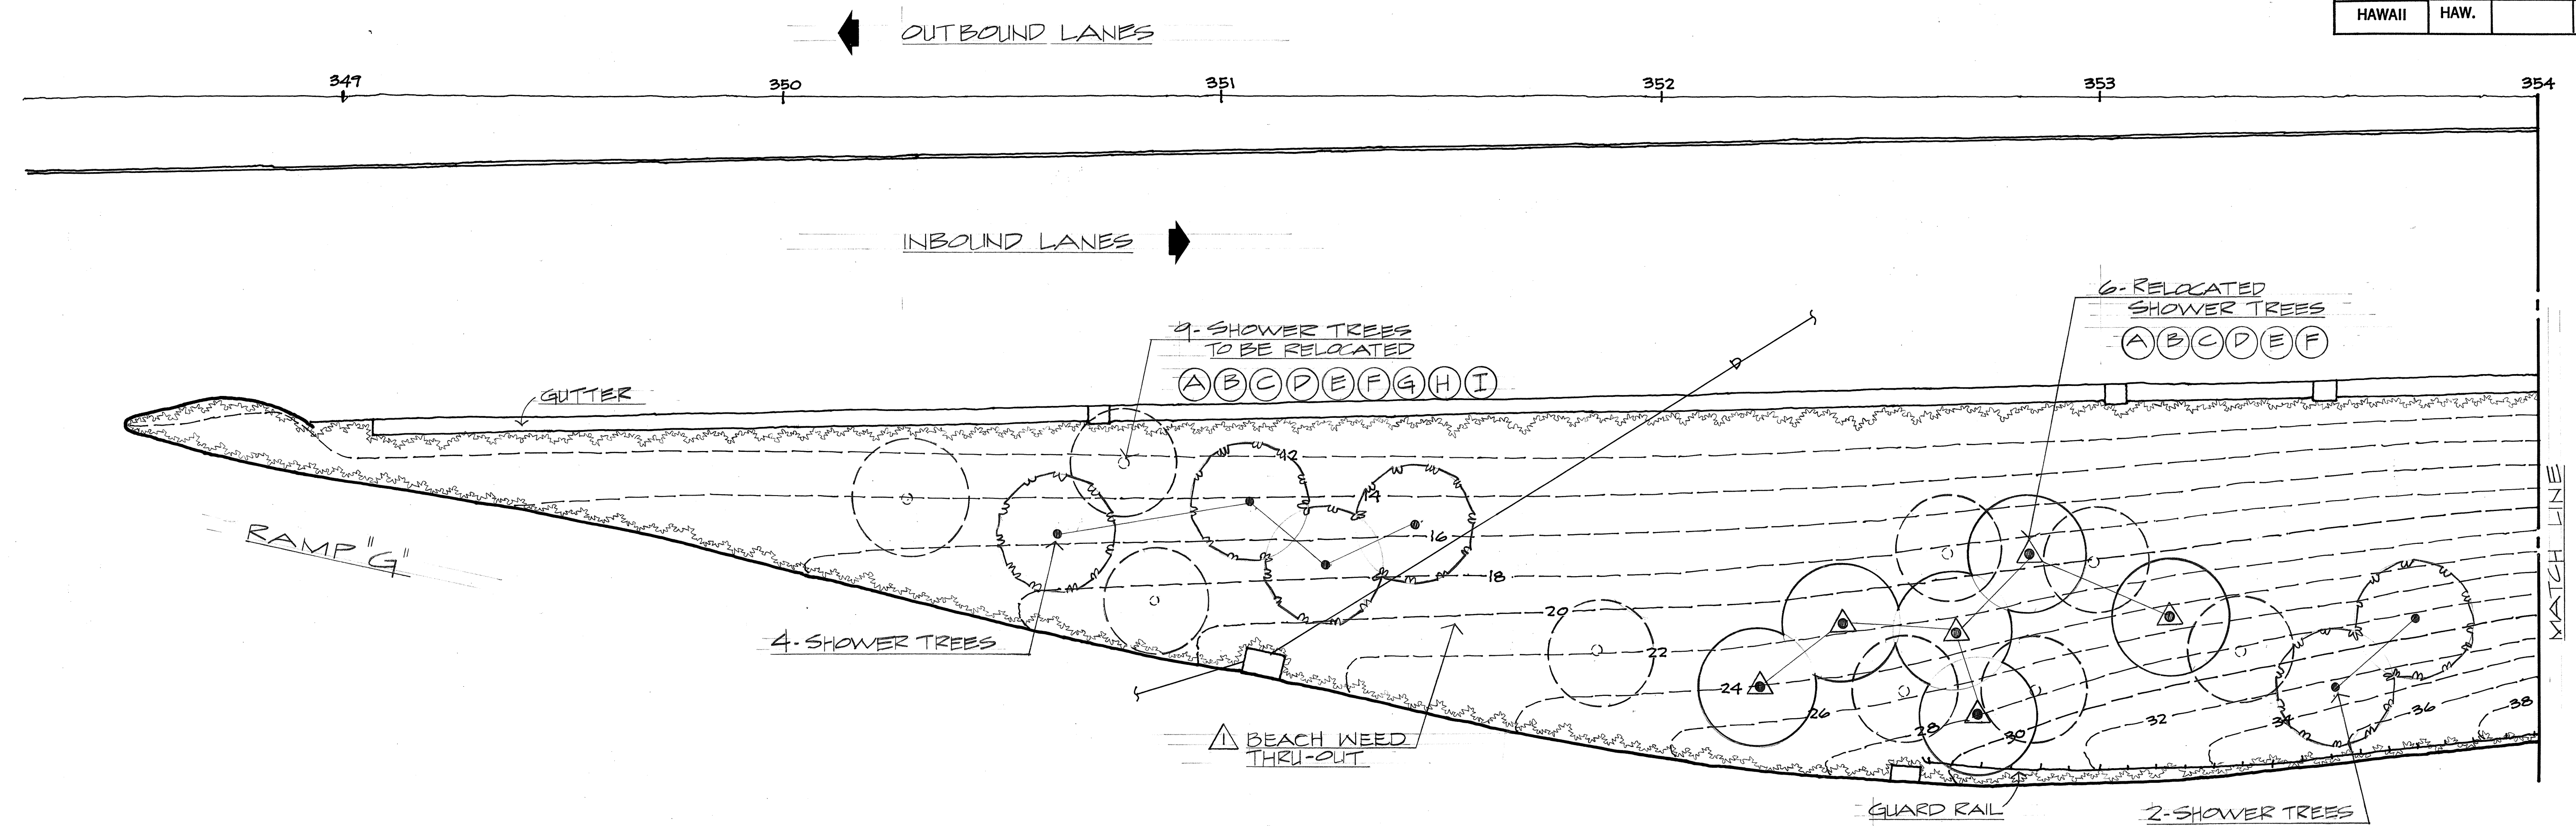

THIS WORK WAS PREPARED BY
ME OR UNDER MY SUPERVISION.
Melvin K. F. Lau

7/5/78	Delete Bougainvillea at Sta. 354+30± to Sta. 355+75
DATE	REVISION

3/7/78 CHANGE WEDELIA TO BEACH WEED



STATE OF HAWAII
DEPARTMENT OF TRANSPORTATION
LAND TRANSPORTATION FACILITIES DIVISION
REVISED
PLANTING PLAN

MOANALUA ROAD
PULUA I.C. TO MIDDLE ST.-UNIT I-A
F.A. PROJ. NO. F-FF-078-1(16)
SCALE AS SHOWN NOV. 4, 1977

SHEET No. 1 OF 2 SHEETS


ORIGINAL PLAN	SURVEY PLOTTED BY	DATE
DESIGNED BY		
NOTED BY		
CHECKED BY		
No.		

FED. ROAD DIST. NO.	STATE	FED. AID PROJ. NO.	FISCAL YEAR	SHEET NO.	TOTAL SHEETS
HAWAII	HAW.	FF-078-1(16)	1977	69	147

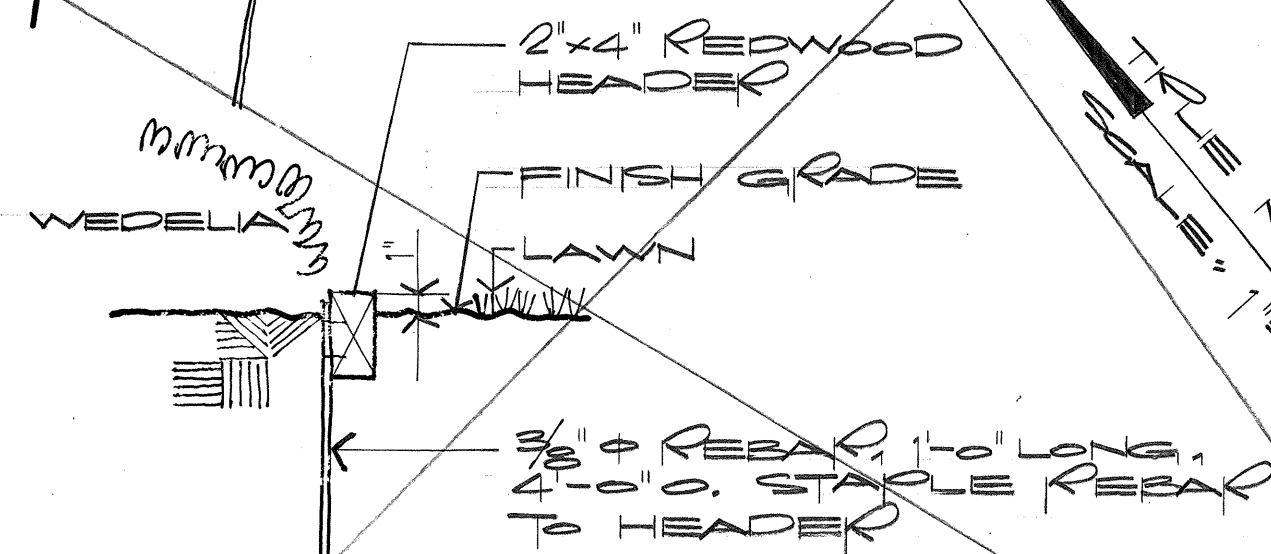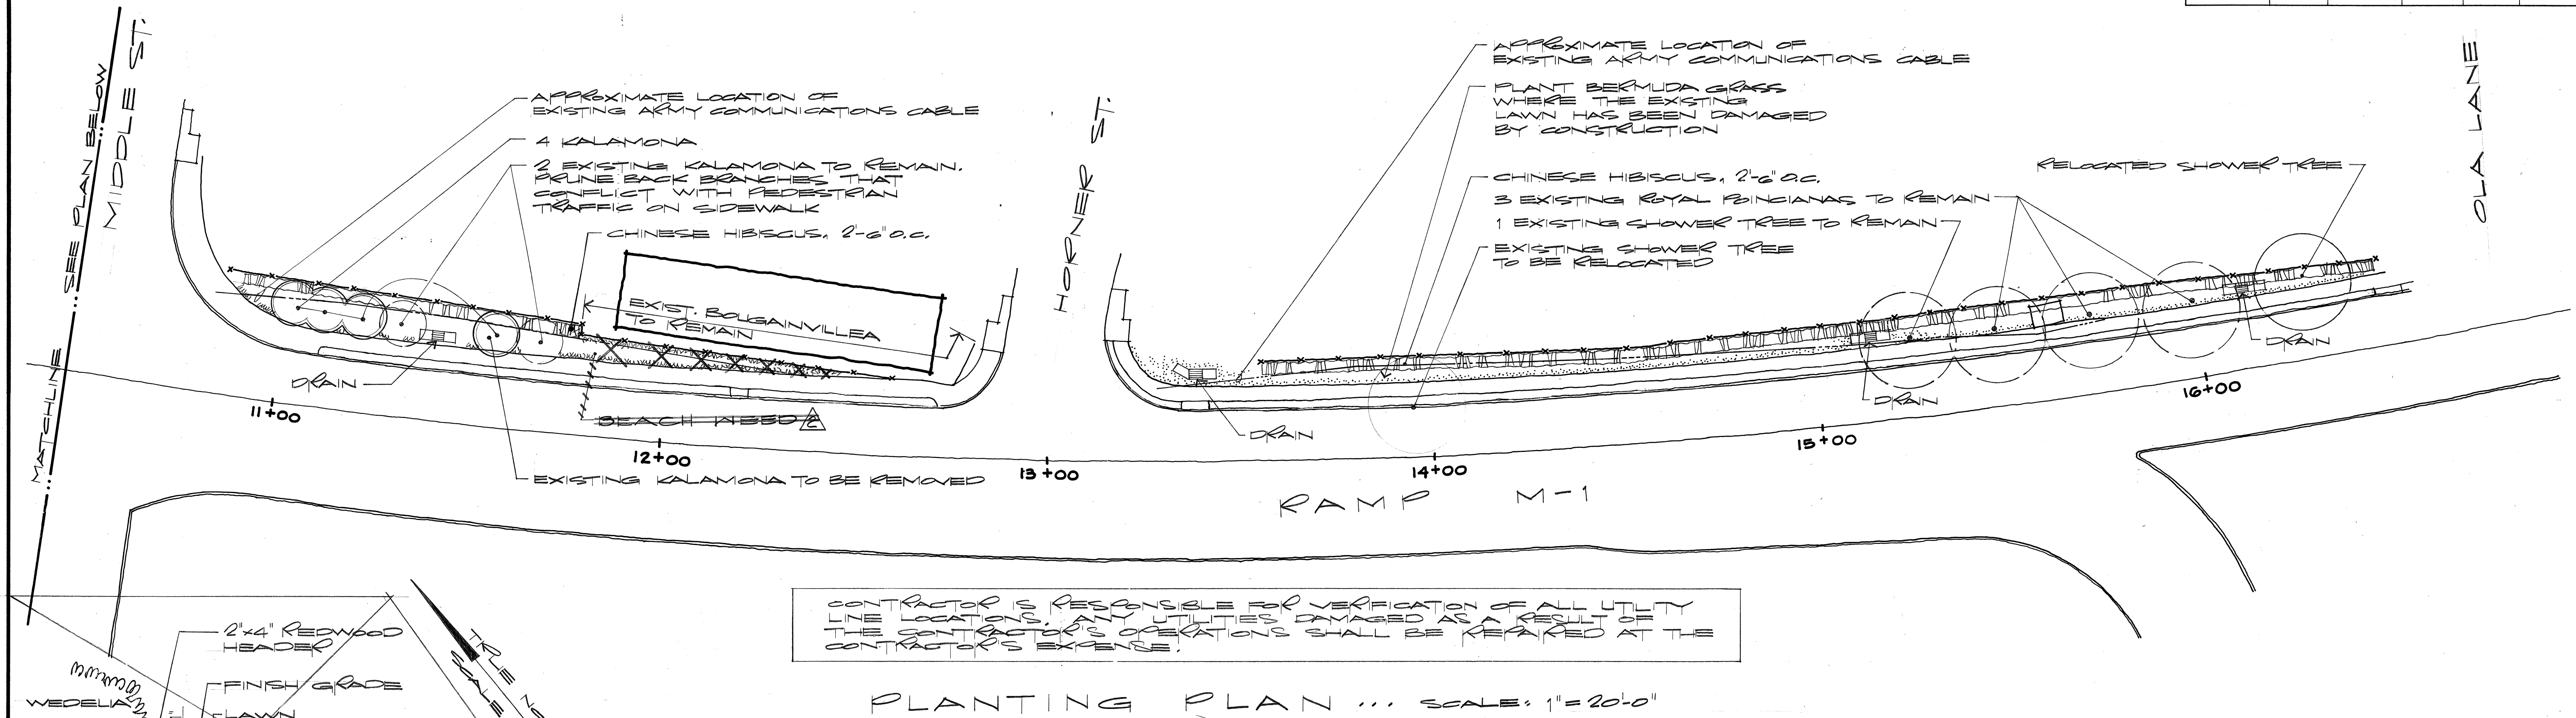


REDWOOD HEADER DETAIL
ELEVATION - NO SCALE

△ DELETE

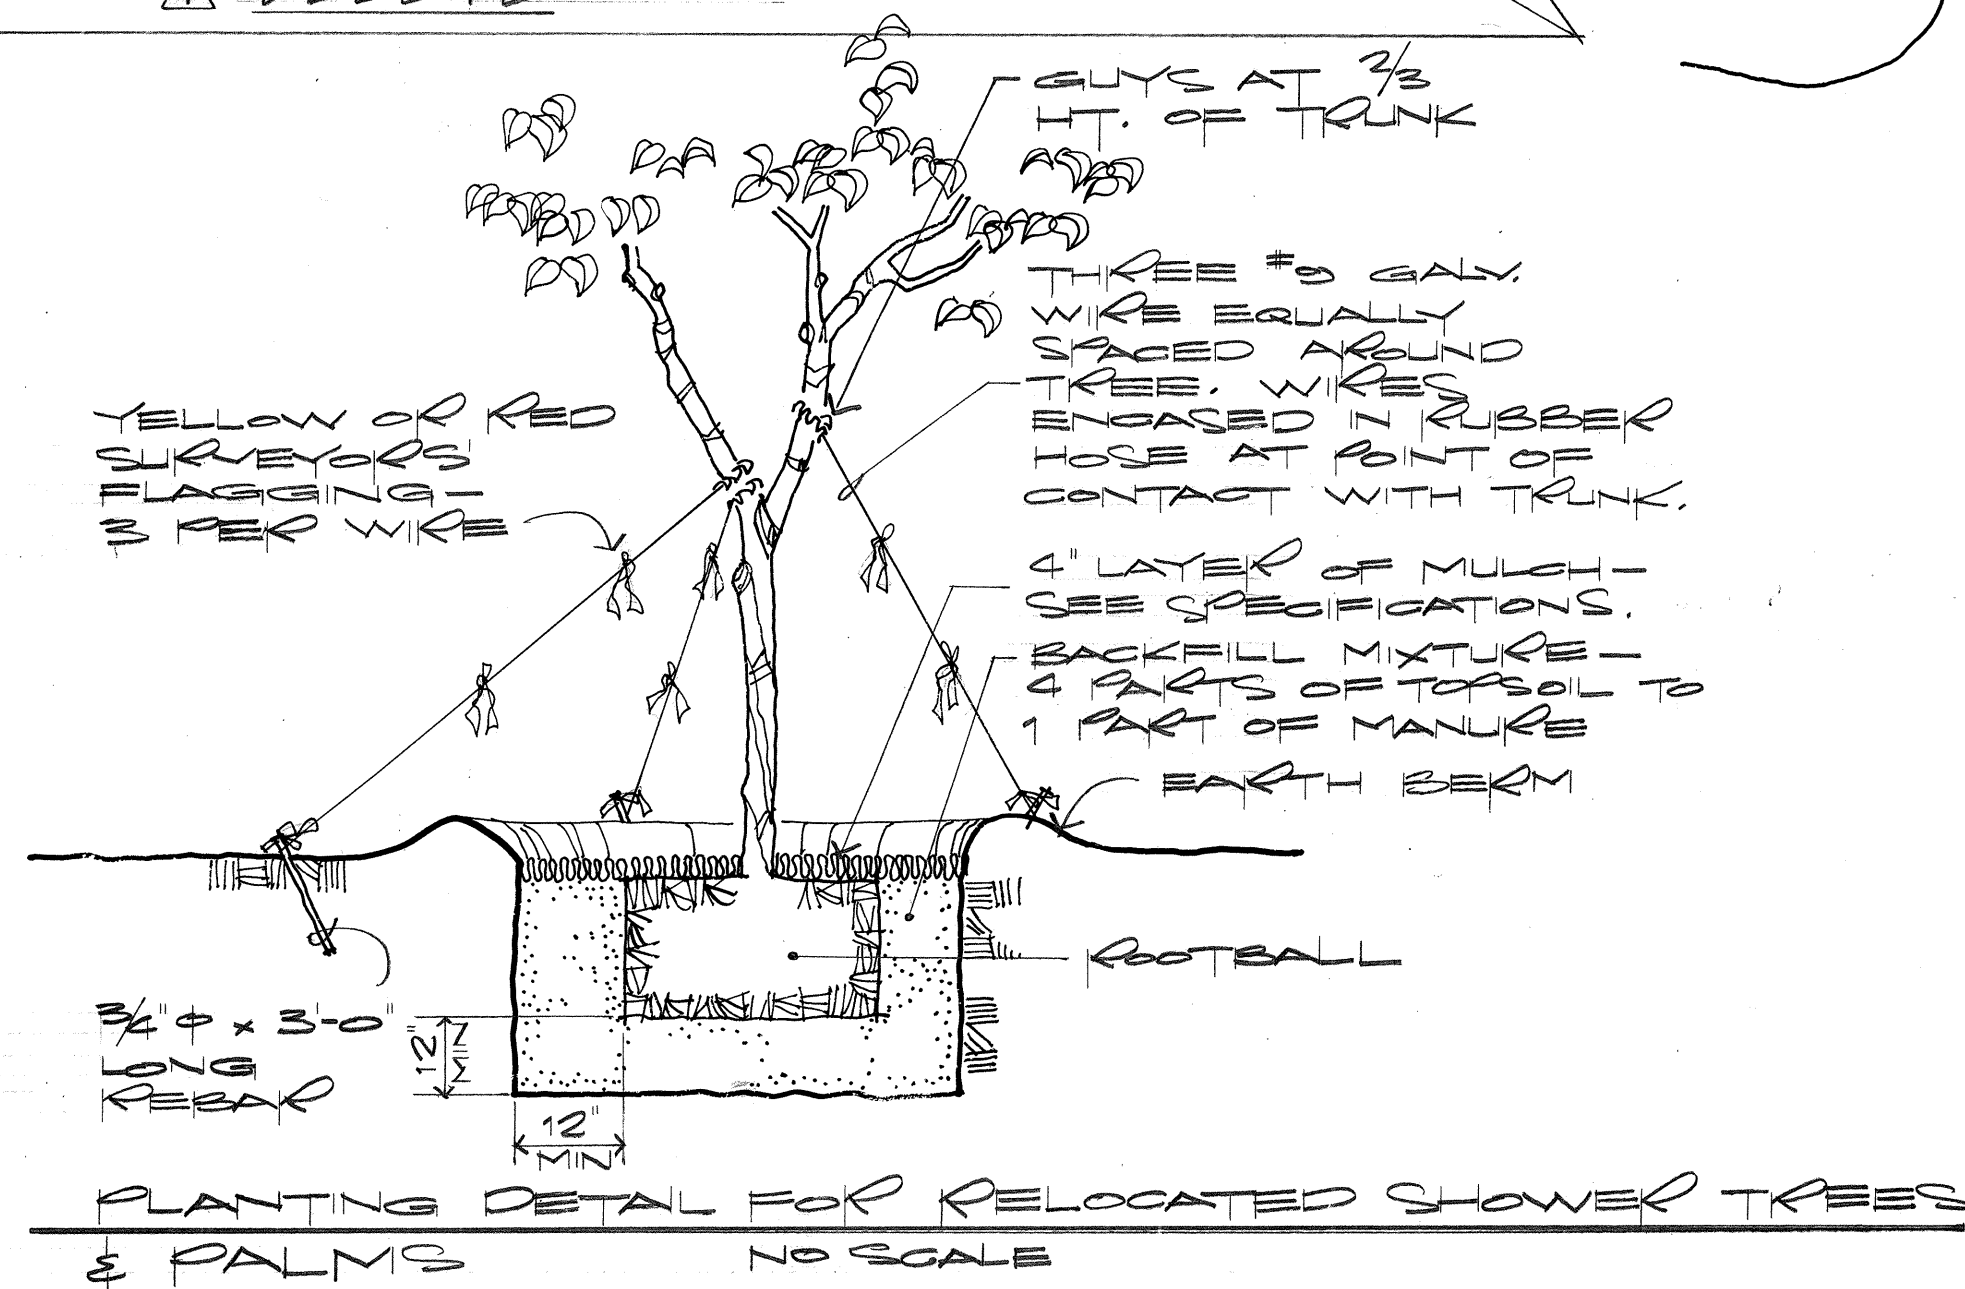

PLANTING DETAIL FOR RELOCATED SHOWER TREES & PALMS
NO SCALE

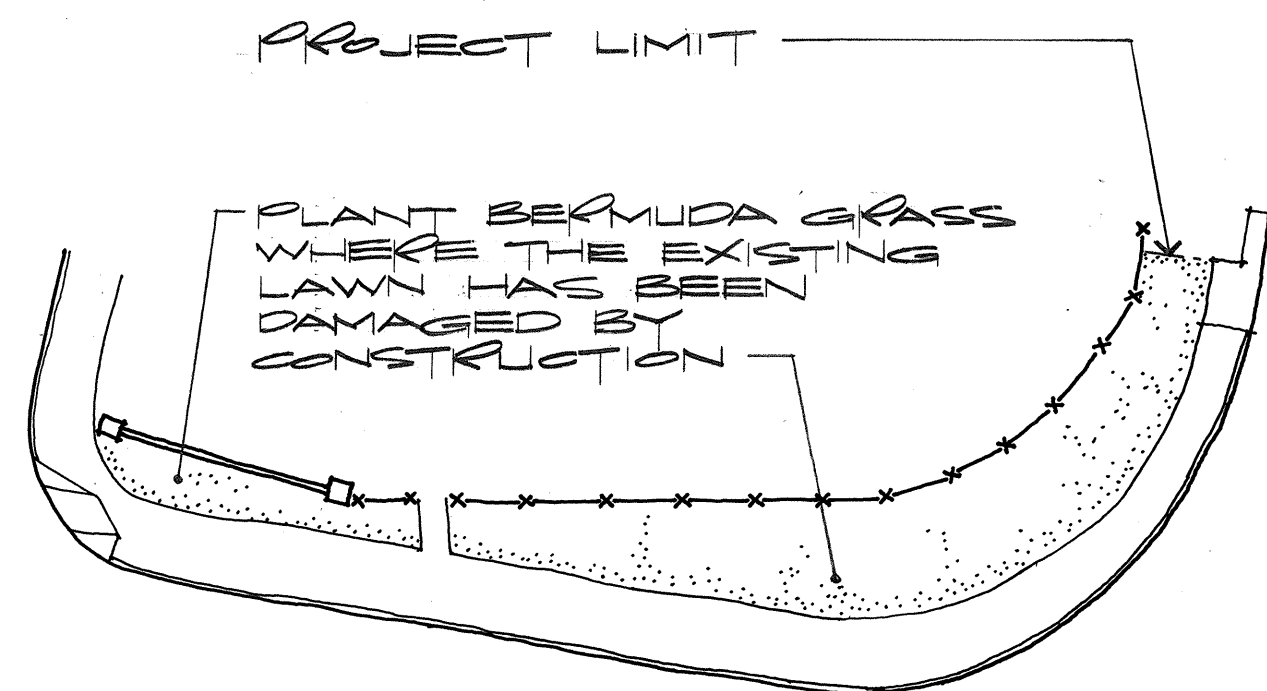


KALUA ST.

MIDDLE ST. SEE PLAN ABOVE


PLANT LIST		
QUANTITY	COMMON NAME BOTANICAL NAME	SIZE (IN PLACE)
9	RAINBOW SHOWER CASSIA FISTULA x C. JAVANICA	25 G.C., 8' HT.
164	BOUGAINVILLEA (VARIOUS COLORS) BOUGAINVILLEA HYBRID	2 1/2 G.C., 2' LONG STEMS
4	KALAMONA CASSIA GLAUDA	5 G.C., 4' HT.
1551	CHINESE HIBISCUS HIBISCUS ROSA-SINENSIS	1 G.C., 2' HT.
62,500 S.F.	BEACH NEED DIMORPHOTHECA OPP.	5' LONG ROOTED CUTTINGS, 12" O.C.
700 S.F.	BERMUDA GRASS CYNODON DACTYLON	SEEDS OR SPRIGS

CONTRACTOR IS RESPONSIBLE FOR VERIFICATION OF ALL QUANTITIES INDICATED ON THIS PLAN.

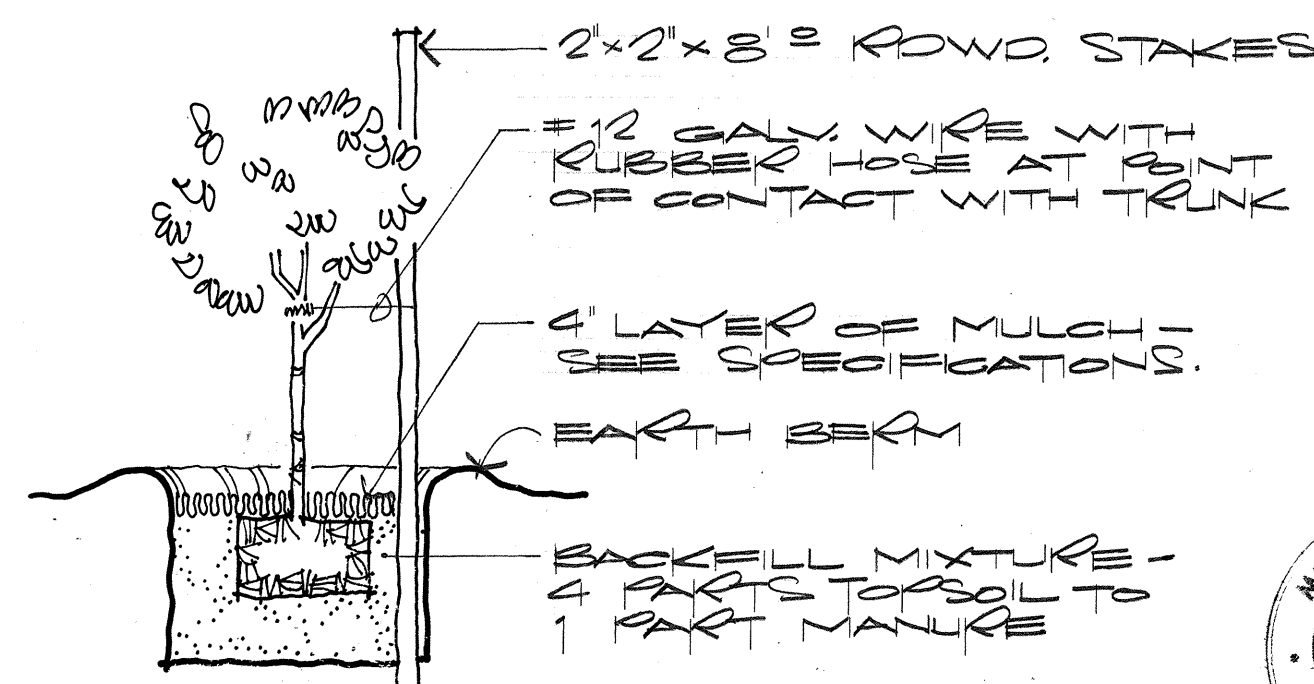

PLANTING DETAIL FOR 5 G.C.
NO SCALE

△ 3/7/78 REV. PLANT LIST. DELETE WEDELIA, ADD BEACH NEED
△ 11/9/77 REV. PLANT LIST, DELETE HEADER

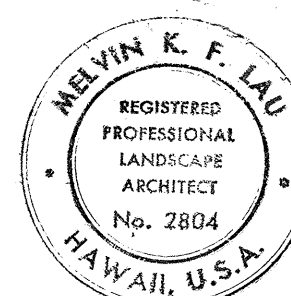

THIS WORK WAS PREPARED BY
ME OR UNDER MY SUPERVISION.
Melvin K. F. Lau

STATE OF HAWAII
DEPARTMENT OF TRANSPORTATION
HIGHWAYS DIVISION

PLANTING PLAN & DETAILS

MOANALUA ROAD
PUULOA I.C. TO MIDDLE ST - UNIT 1A
FA. PROJ. NO. F-FF-078-1(16)

SCALE: AS SHOWN DEC. 17, 1976

SURVEY PLOTTED BY	DATE
DRAWN BY	
TRACED BY	
NOTED BY	
CHECKED BY	
NO.	