


GENERAL NOTES:


- PHASE II: FWY. OUTBOUND, RAMP "M-1" &
PINEAPPLE LANE. N.T.P. TO 120
WORKING DAYS



SCALE: $\frac{1}{4}'' = 1' - 0''$

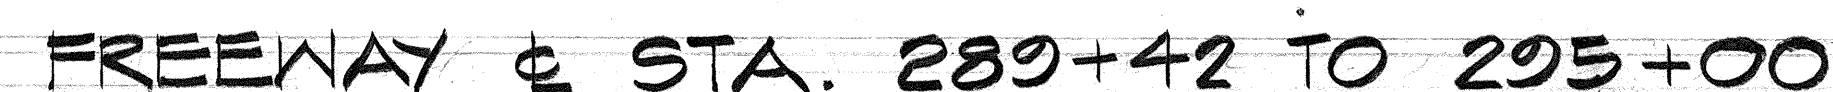

SCALE: $\frac{1}{4}'' = 1' - 0''$

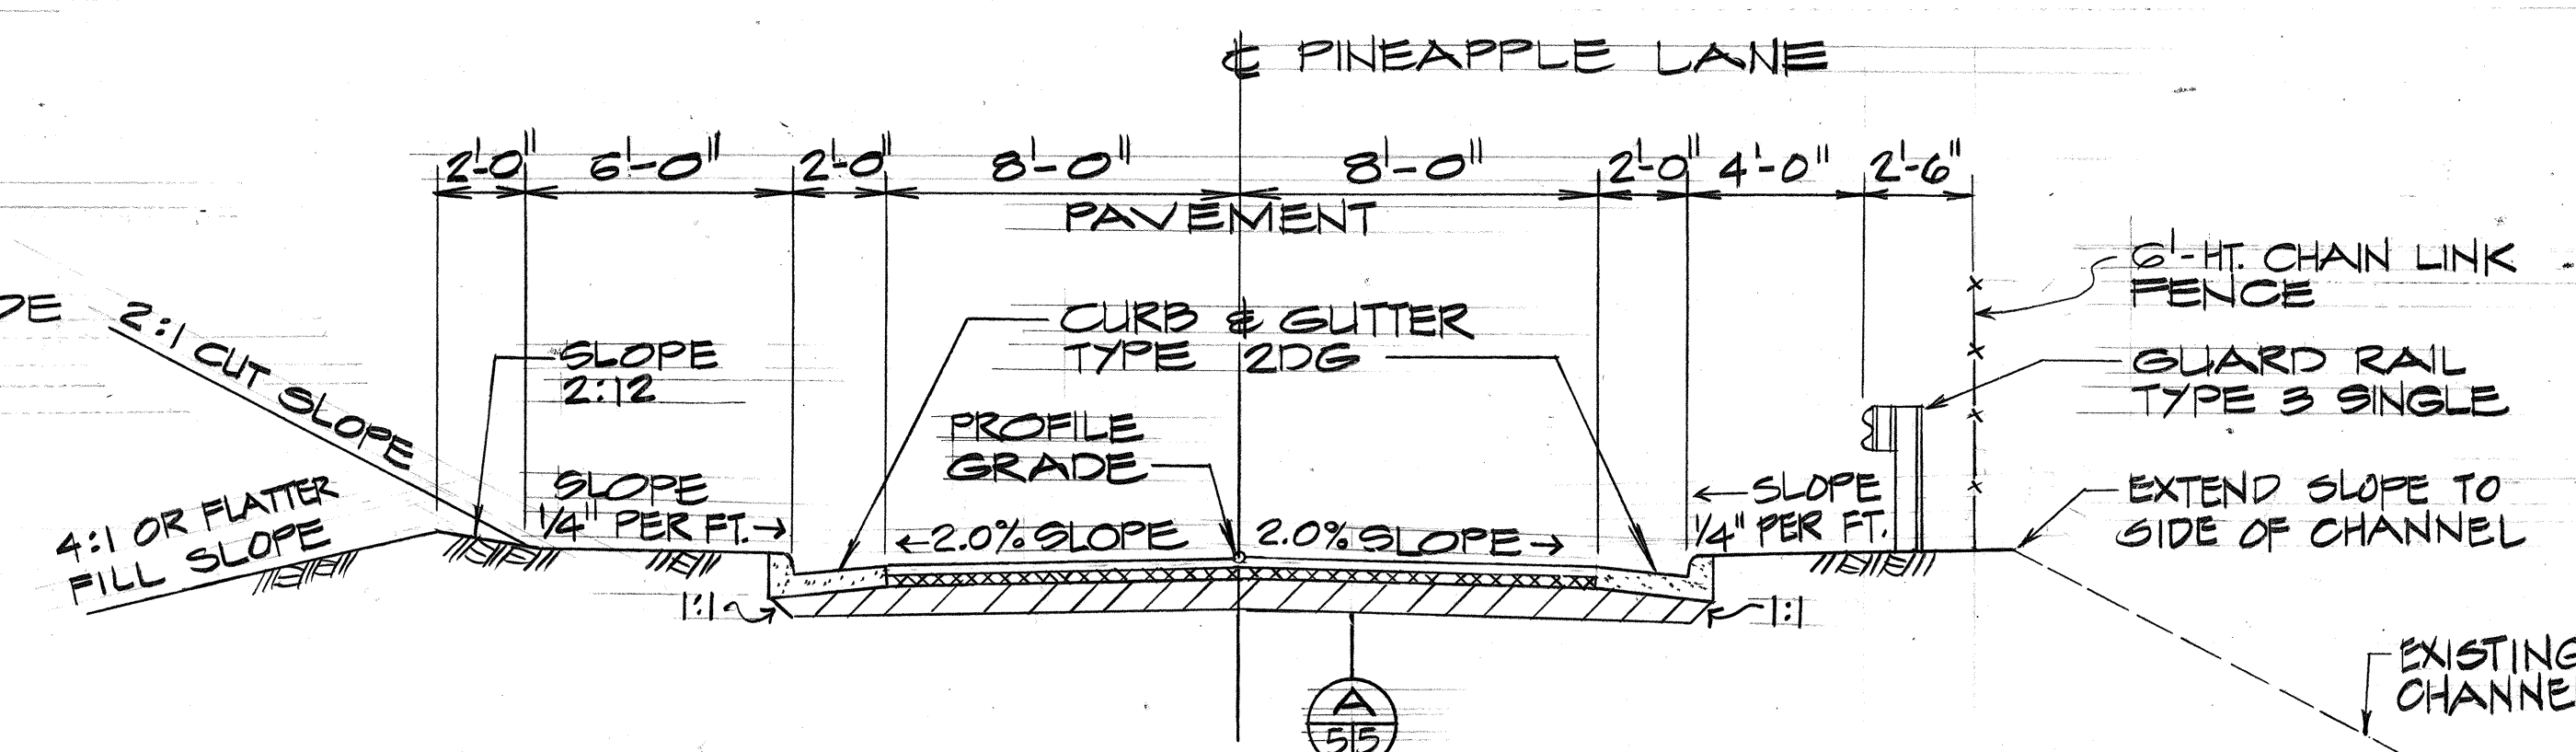


PINEAPPLE LANE


SCALE: $\frac{1}{4}'' = 1'-0''$



FOR FINISH ELEVATION
SEE DETAIL ROADWAY
PLAN.

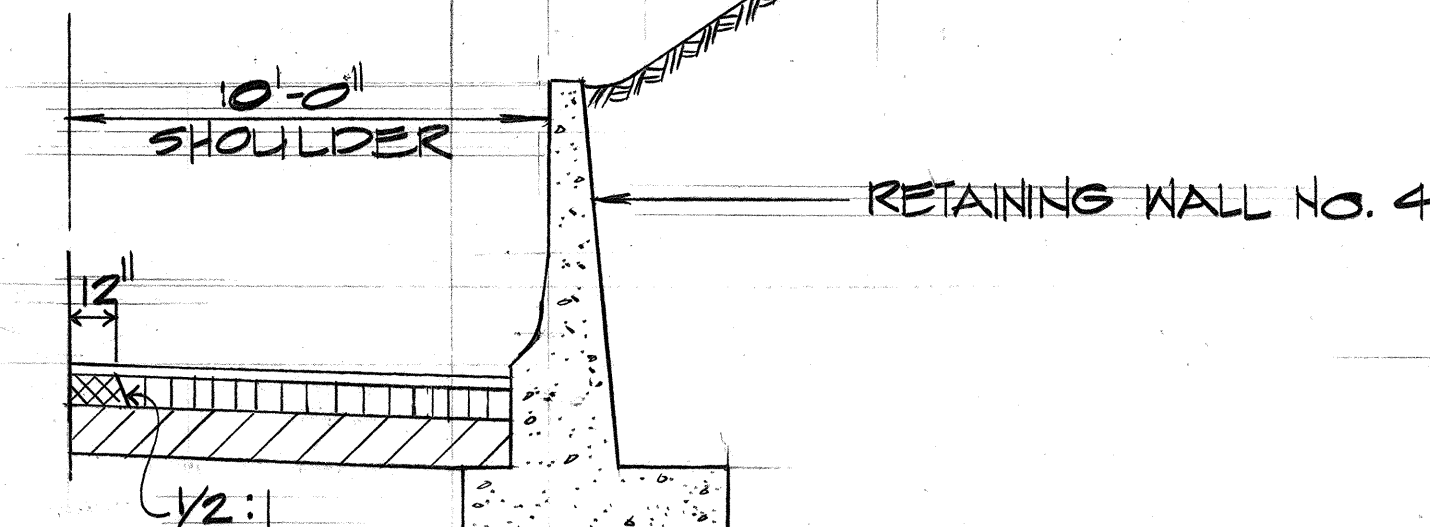

AT RETAINING WALL

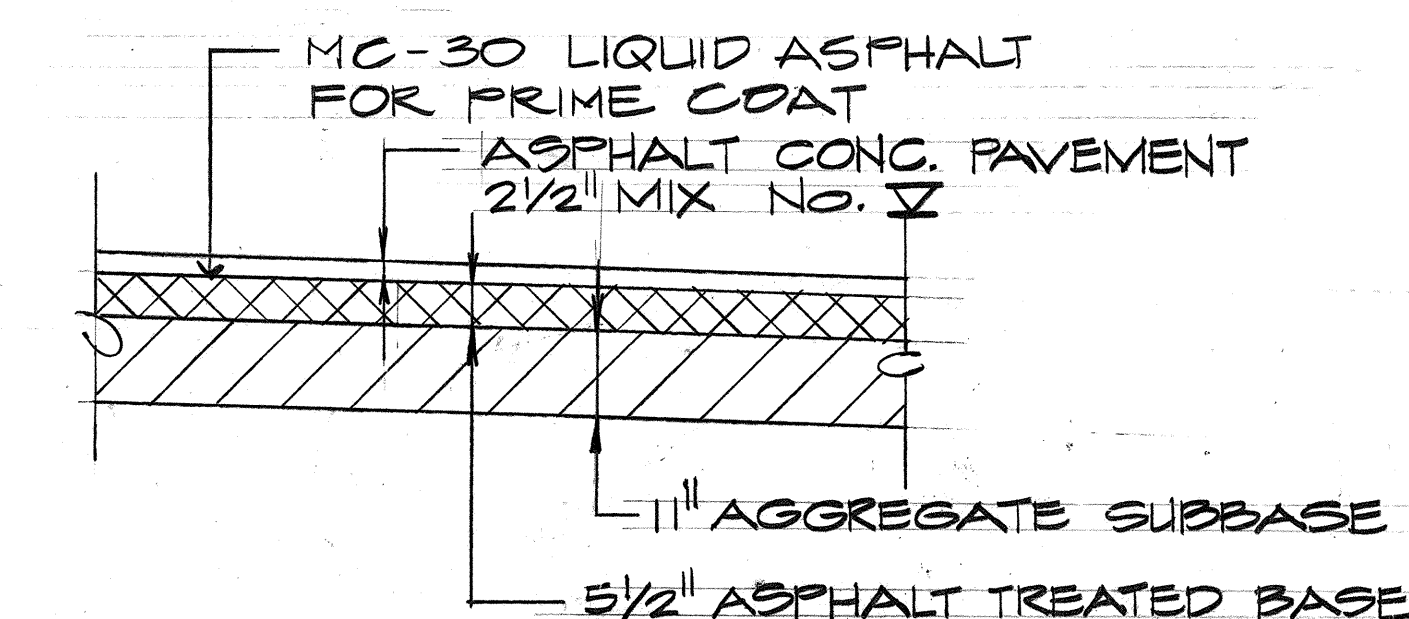

SECTION A
SCALE: $\frac{1}{2}'' = 1'-0''$ 5 5

STATE OF HAWAII
DEPARTMENT OF TRANSPORTATION
HIGHWAYS DIVISION

TYPICAL ROADWAY SECTIONS

MOANALUA ROAD
PUULOA I.C. TO MIDDLE ST.-UNIT 1A
F.A. Proj. NO. F-FF-078-1/16)

SCALE: AS SHOWN DATE: DEC. 17, 1976
SHEET NO. 1 OF 1 SHEETS

Wilbert T. Takemura
THIS WORK WAS PREPARED BY ME
OR UNDER MY SUPERVISION.

3/17/78	REVISED PINEAPPLE LANE SECTION
5/20/77	REVISED GENERAL NOTE NO.3; PHASE I & PHASE II PER ADDENDUM NO.1.
DATE	REVISION

C.O. 5R