



FED. ROAD DIST. NO.	STATE	FED. AID PROJ. NO.	FISCAL YEAR	SHEET NO.	TOTAL SHEETS
HAWAII	HAW.	FF-078-1(17) R.F. 078-1(17)	1977	162	164

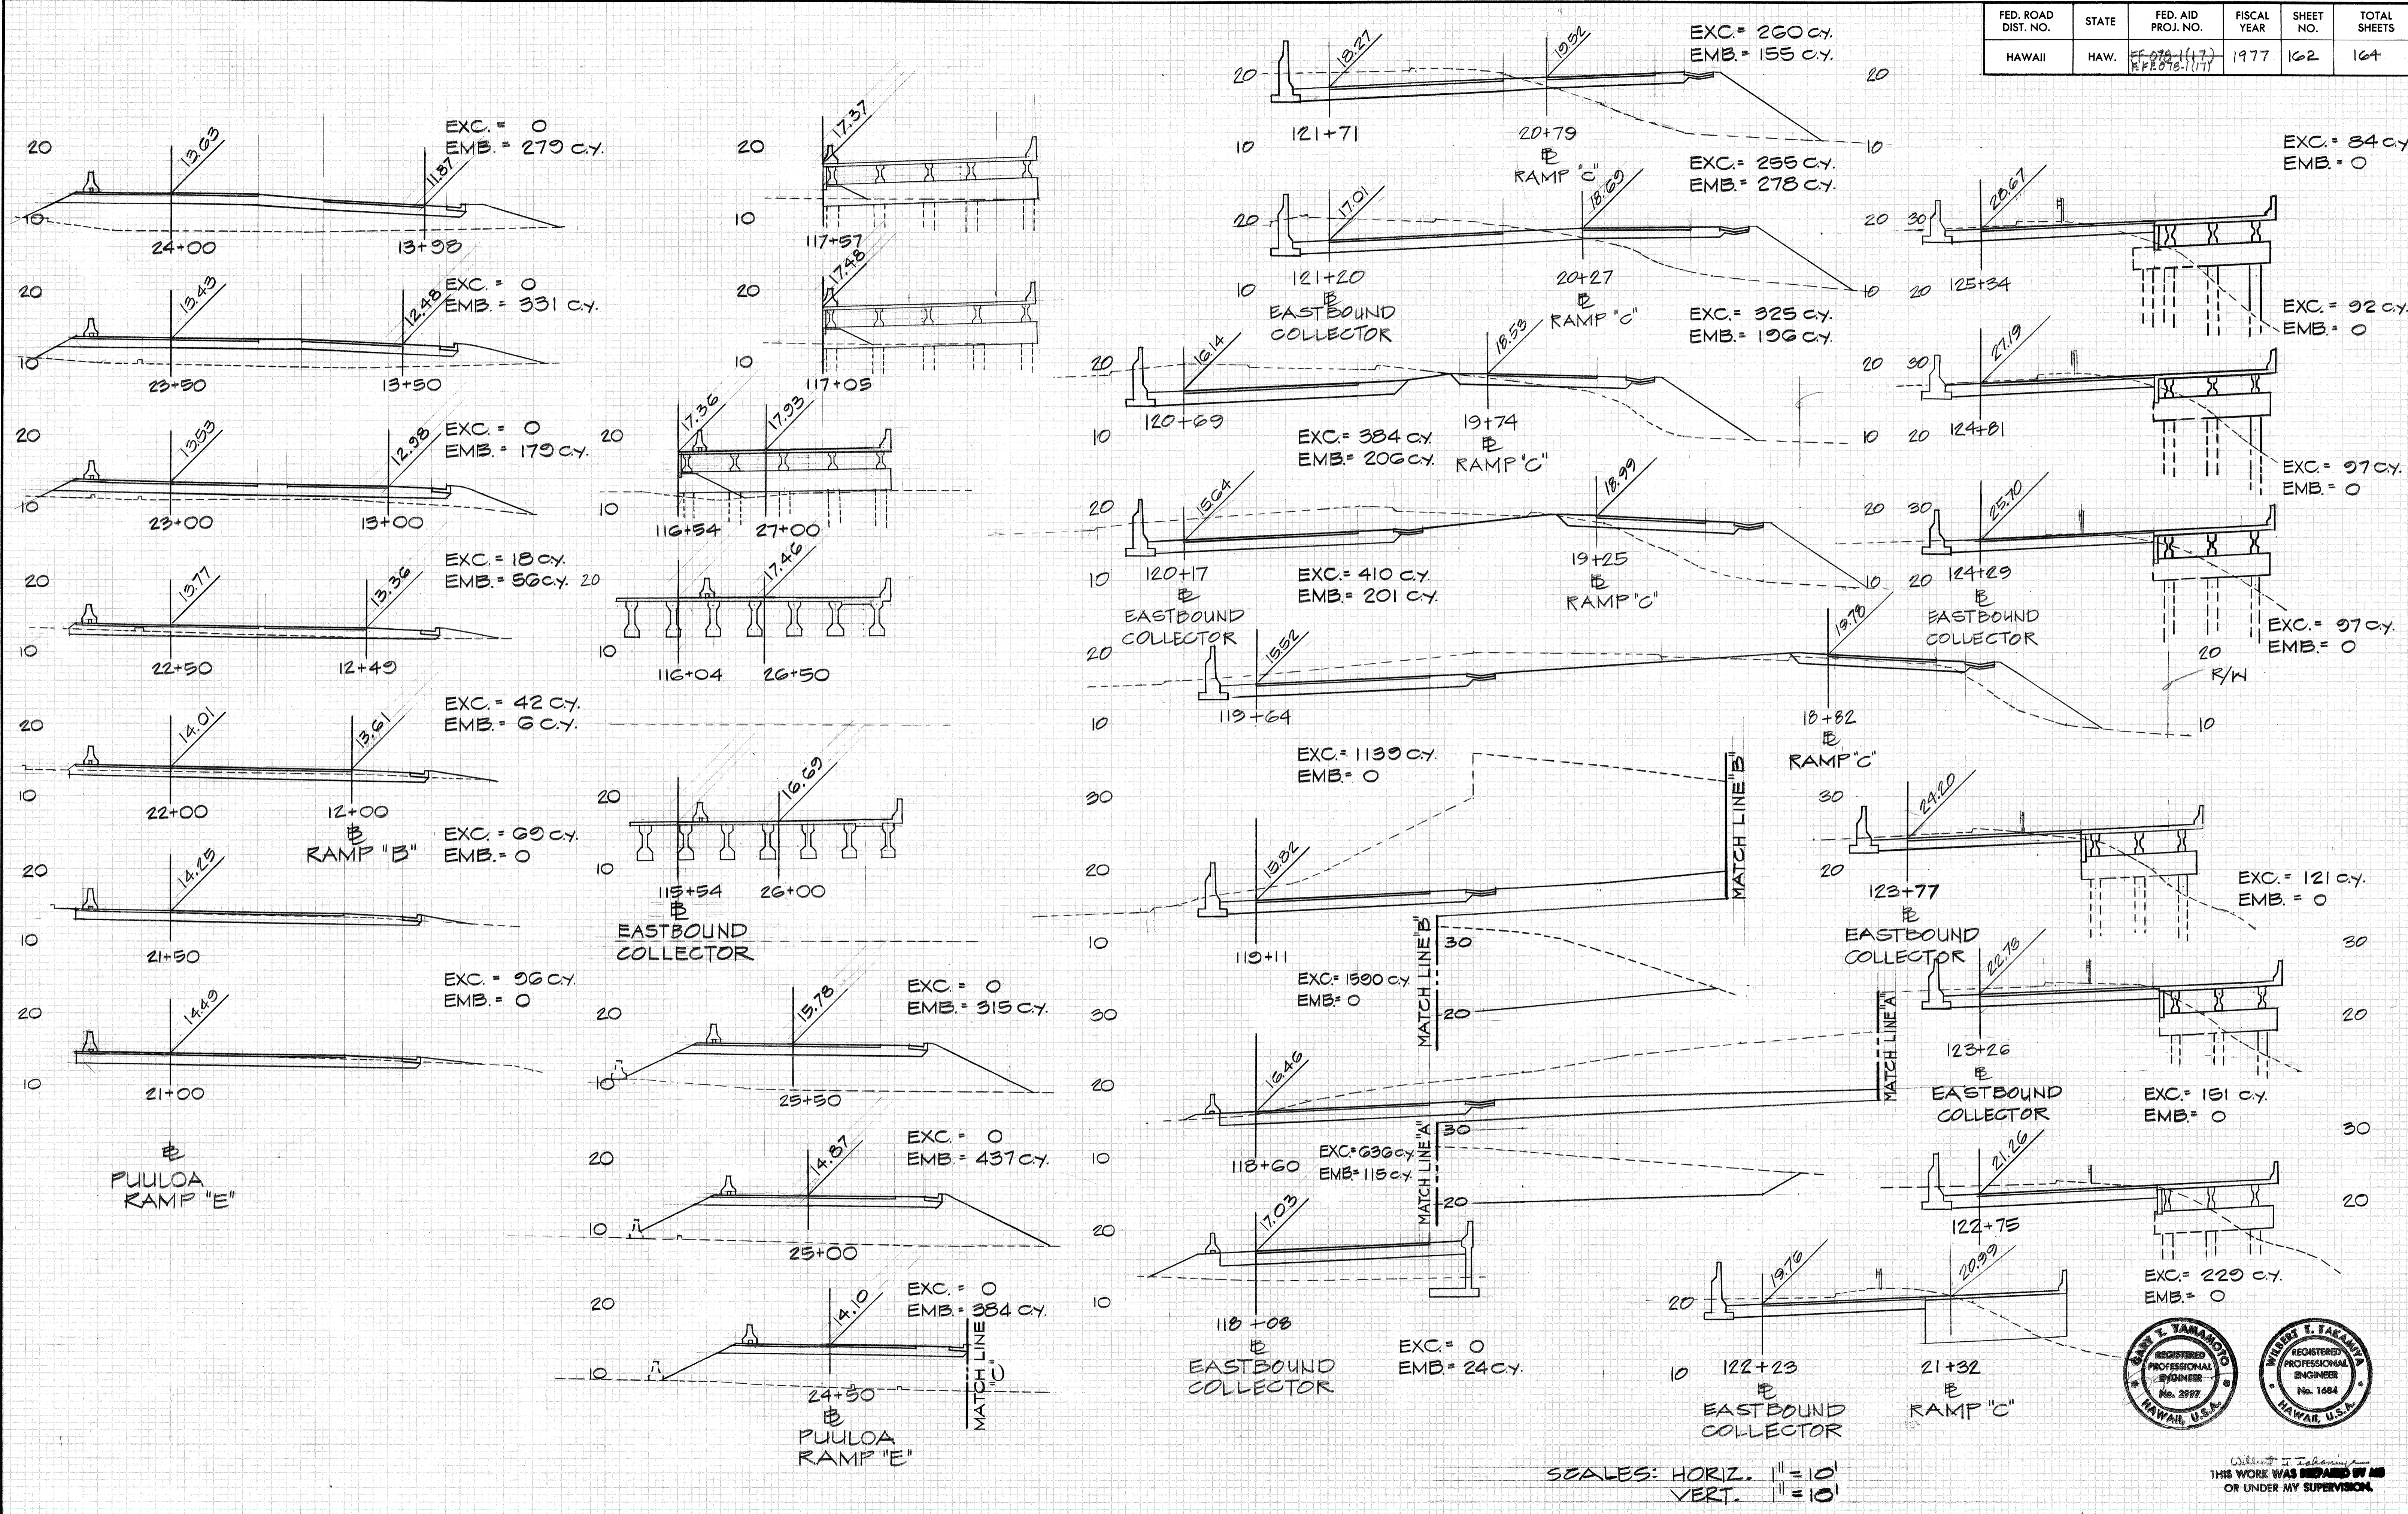

FINAL SURVEY PLOTTED
NOTE BOOK NO. 3997
AREAS CHECKED


ORIGINAL SURVEY PLOTTED
NOTE BOOK NO. 3997
AREAS CHECKED

SCALES: HORIZ. 1" = 10'
VERT. 1" = 10'

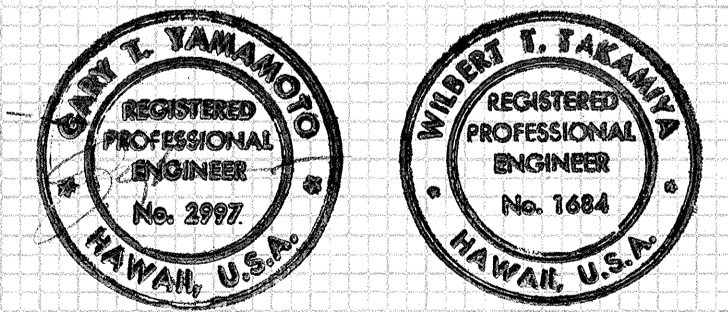



Without Testimony
THIS WORK WAS PREPARED BY ME
OR UNDER MY SUPERVISION

FED. ROAD DIST. NO.	STATE	FED. AID PROJ. NO.	FISCAL YEAR	SHEET NO.	TOTAL SHEETS
HAWAII	HAW.	FF-078 (117) K.F.F.078-1(17)	1977	163	164

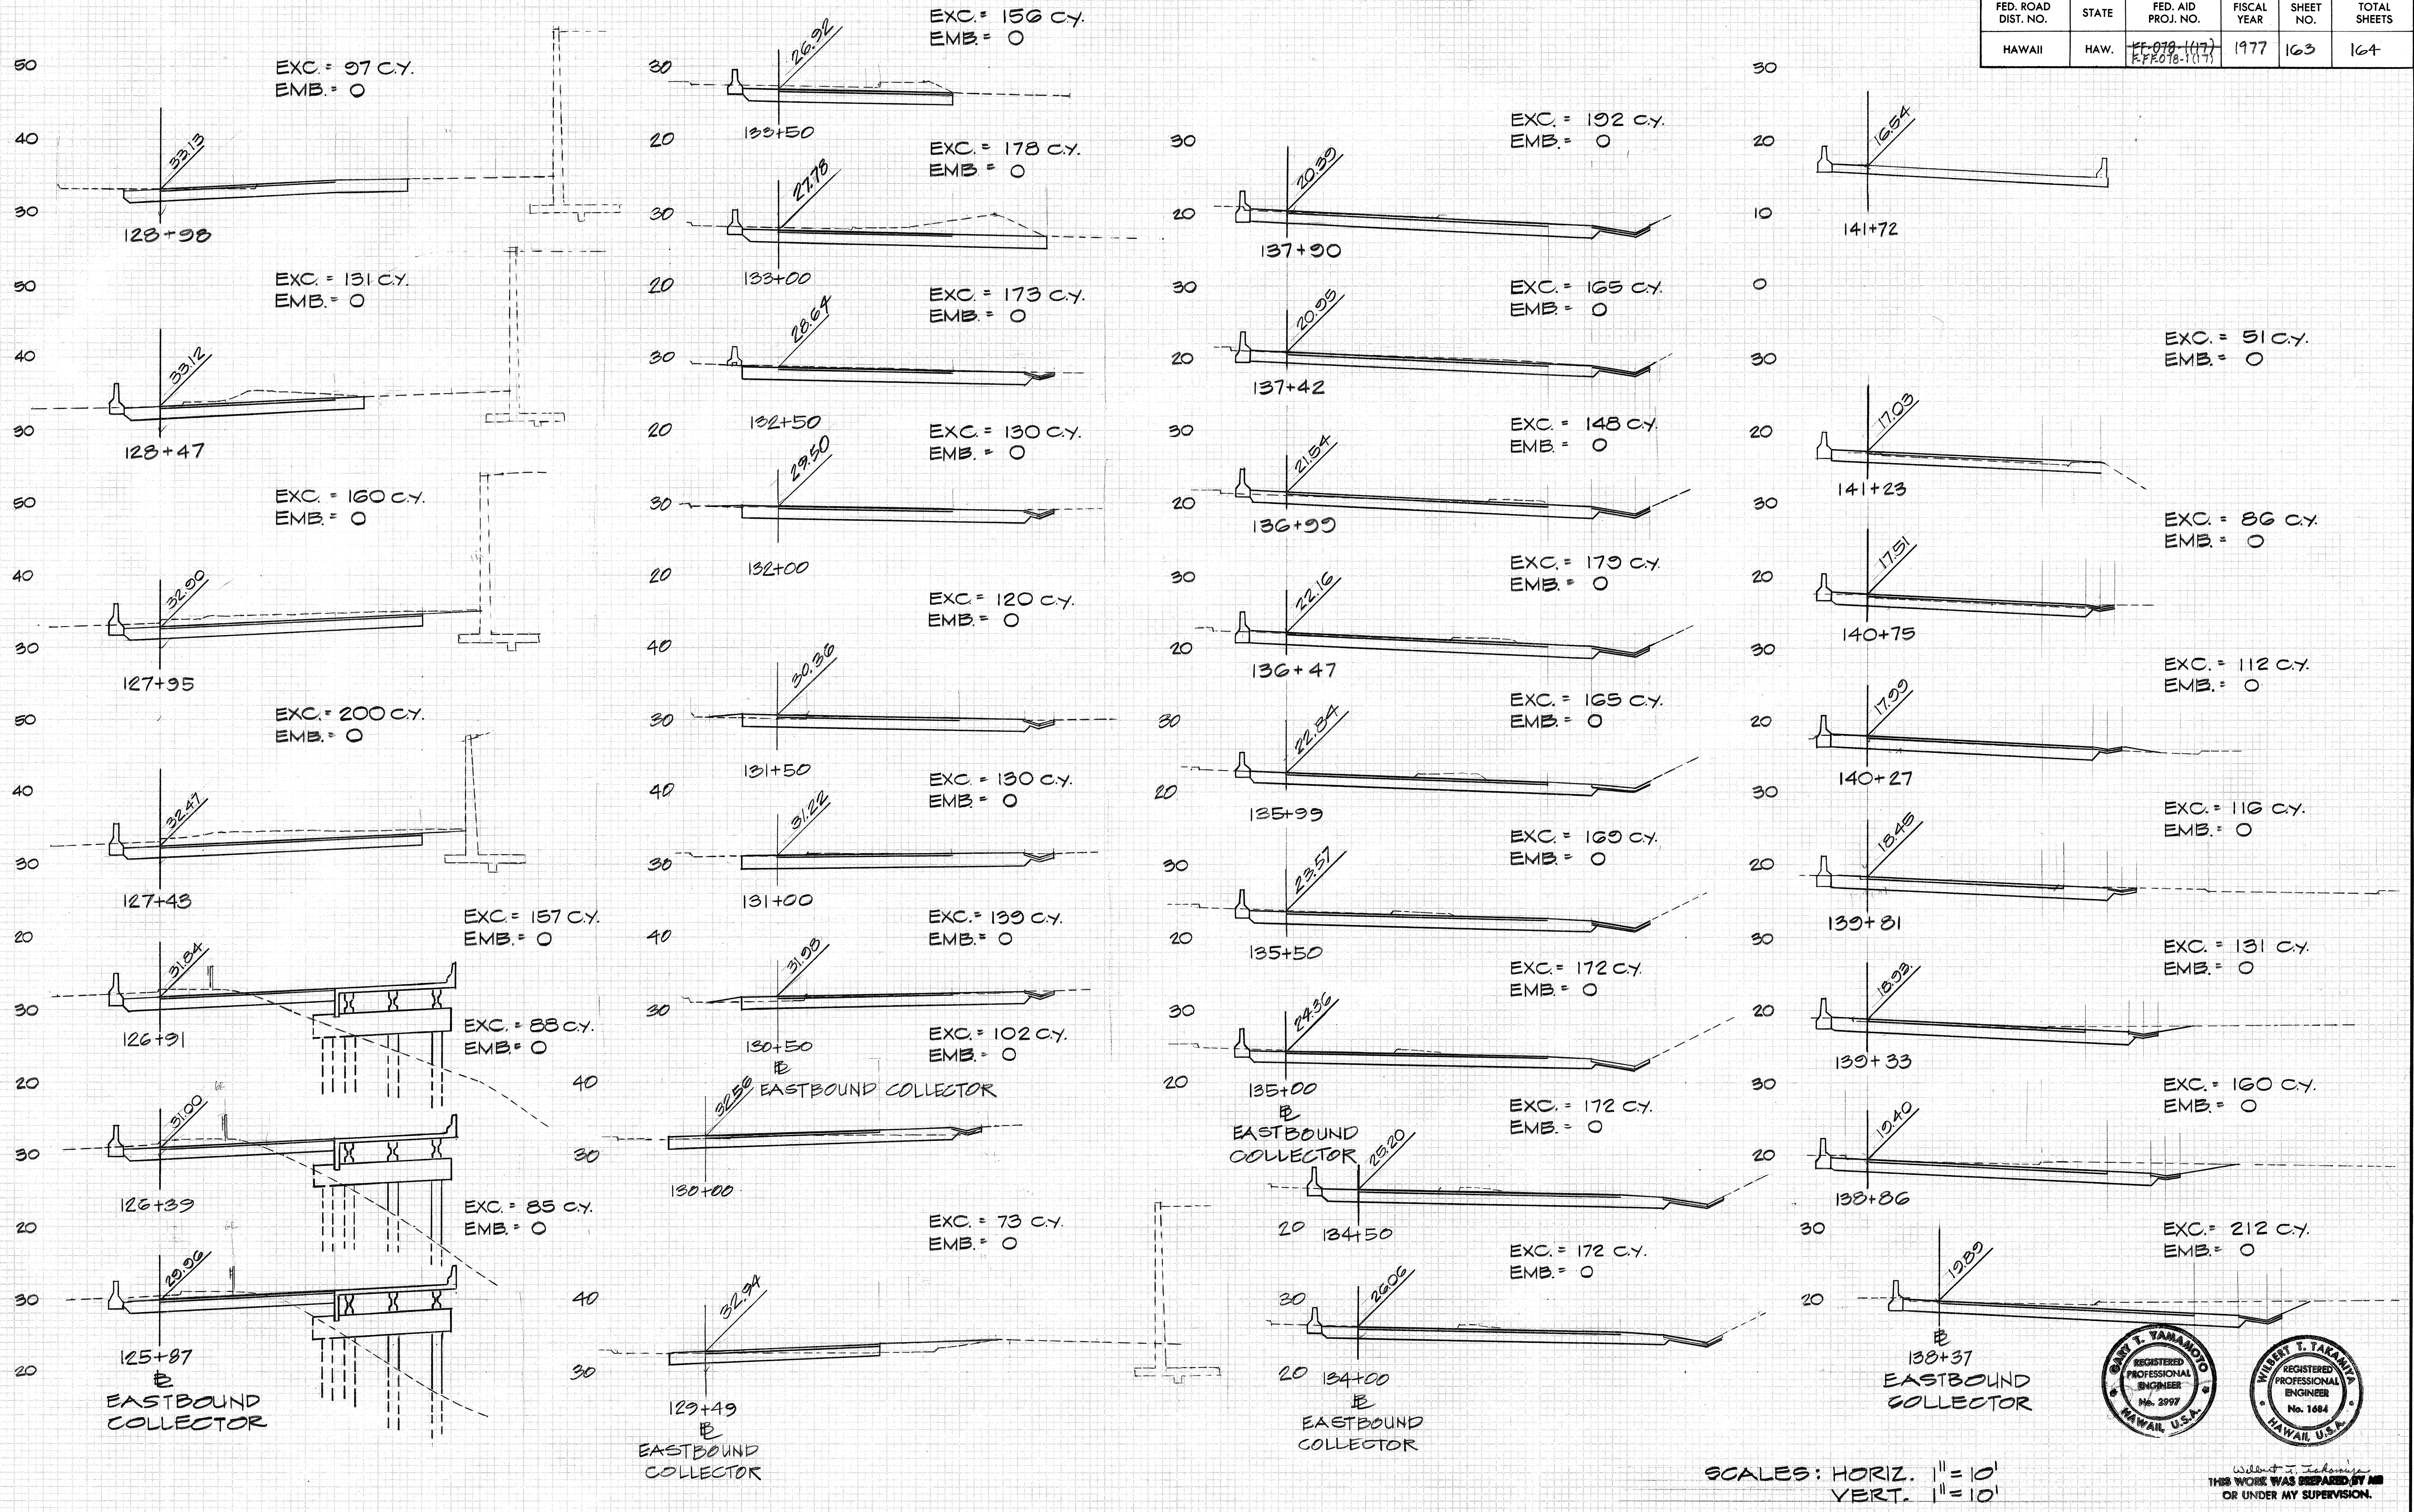

DATE: _____
 BY: _____
 SURVEYED: _____
 PLOTTED: _____
 CHECKED: _____
 DATE: _____
 BY: _____
 SURVEYED: _____
 PLOTTED: _____
 CHECKED: _____


DATE: _____
 BY: _____
 SURVEYED: _____
 PLOTTED: _____
 CHECKED: _____

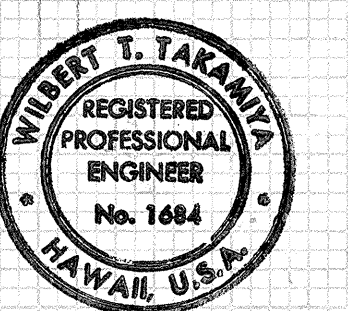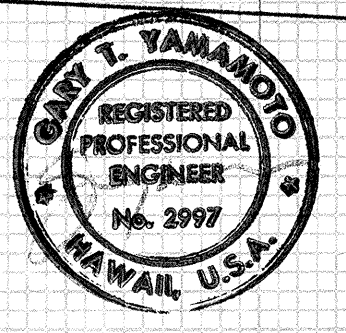

SCALES: HORIZ. 1" = 10'
 VERT. 1" = 10'


Without T. Takama
 THIS WORK WAS PREPARED BY ME
 OR UNDER MY SUPERVISION.

FED. ROAD DIST. NO.	STATE	FED. AID PROJ. NO.	FISCAL YEAR	SHEET NO.	TOTAL SHEETS
HAWAII	HAW.	FF-078-1(17) FF-078-1(17)	1977	164	164

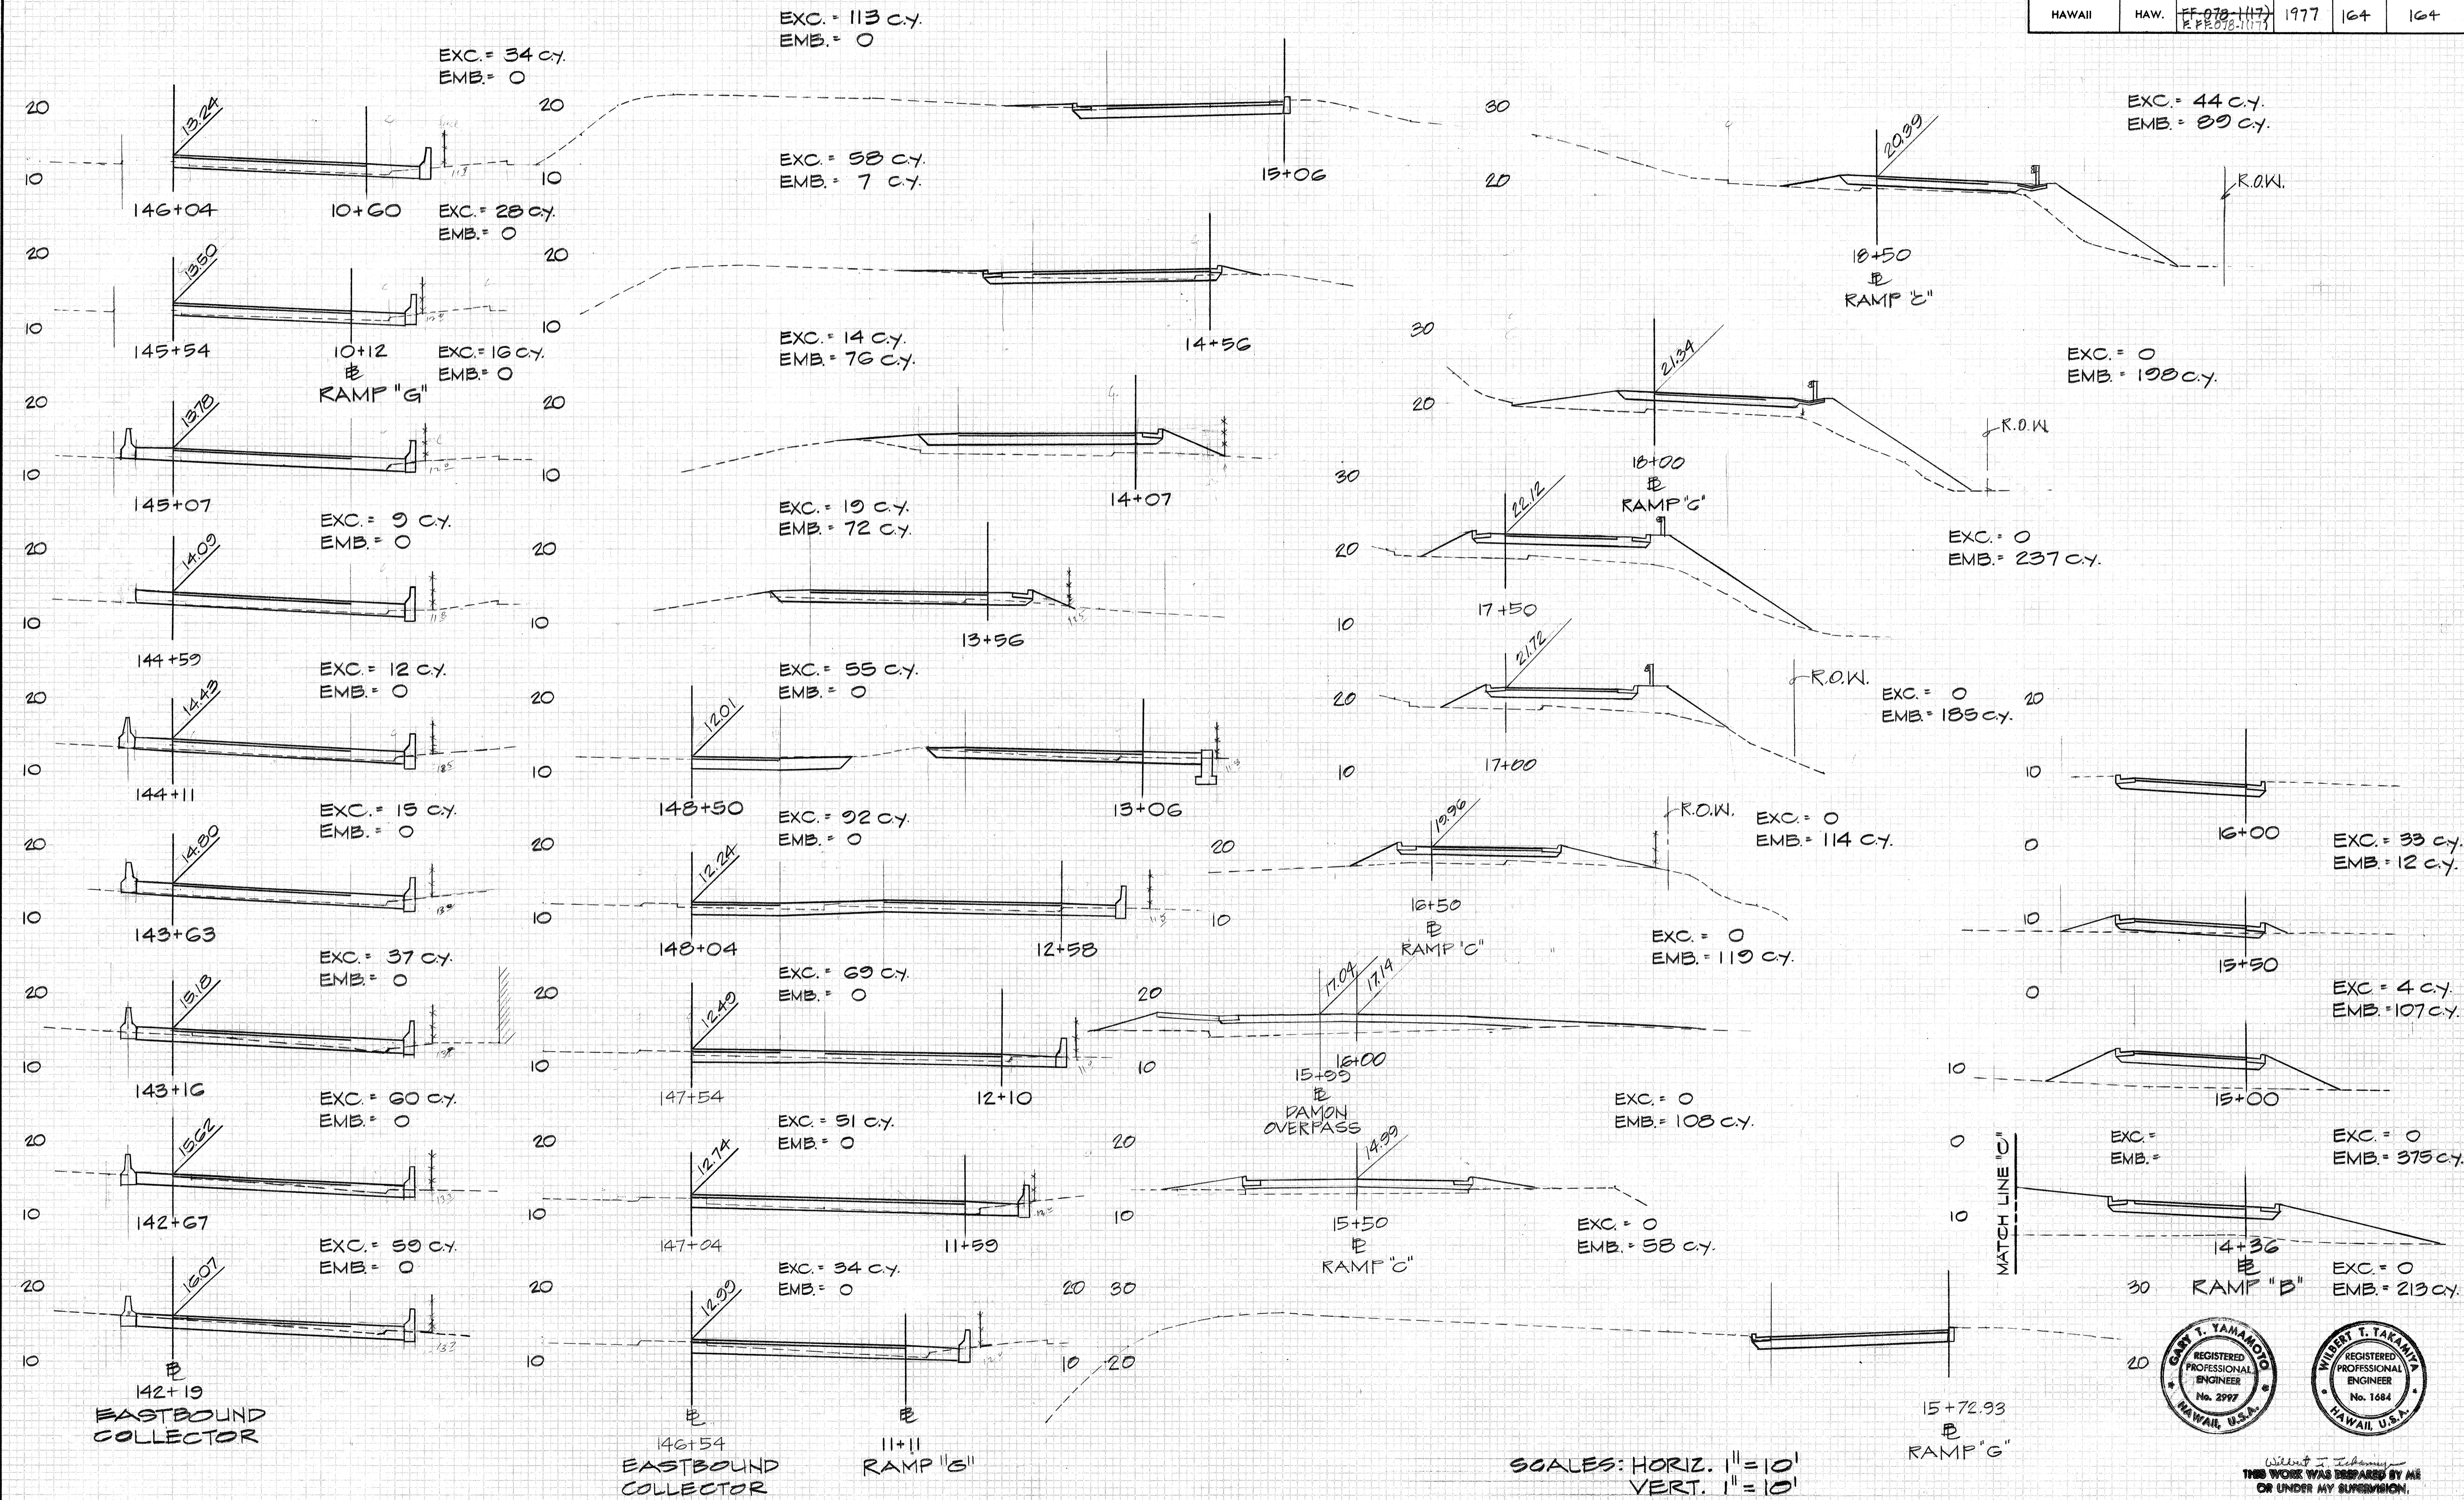

DATE: _____
 BY: _____
 SURVEYED: _____
 PLOTTED: _____
 CHECKED: _____
 DATE: _____
 BY: _____
 SURVEYED: _____
 PLOTTED: _____
 CHECKED: _____

DATE: _____
 BY: _____
 SURVEYED: _____
 PLOTTED: _____
 CHECKED: _____

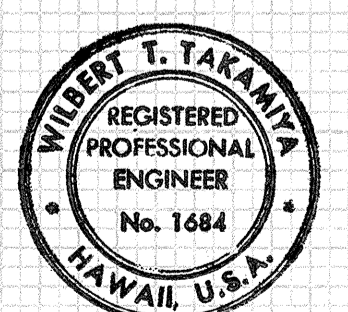

SCALES: HORIZ. 1" = 10'
 VERT. 1" = 10'

Without T. Takama
 THIS WORK WAS PREPARED BY ME
 OR UNDER MY SUPERVISION.