

TOTAL EARTHWORK QUANTITIES

	UNIT 3A
GRADED AREA	14.18 AC
EXCAVATION	73,330 CY
EMBANKMENT	12,554 CY

OWNER & DEVELOPER: STATE OF HAWAII
TAX MAP KEY: 1-1-35

GENERAL NOTES:

1. ALL GRADING AND WORK SHALL BE DONE IN ACCORDANCE WITH CHAPTER 23, GRADING, SOIL EROSION AND SEDIMENT CONTROL OF THE REVISED ORDINANCES OF HONOLULU, 1969, AS AMENDED (ORDINANCE NUMBERS 3968, 4294 & 4538) AND ALL GRADING WORK SHALL BE DONE IN ACCORDANCE WITH "SOIL ENGINEERING REPORT, MOANALUA ROAD, PUULOA ROAD TO MIDDLE STREET, PROJECT NO. 11-078-1(14), DEPARTMENT OF TRANSPORTATION, HIGHWAYS DIVISION, MATERIALS TESTING & RESEARCH BRANCH" OCTOBER 1976.

2. ABANDONED DRAINAGE STRUCTURES: SALVAGE FRAME & COVER; DEMOLISH 3' BELOW FINISH GRADE; PLUG ALL PIPES WITH CLASS D CONCRETE; DEMOLISH BOTTOM; FILL AND COMPACT ALL WORK TO BE CONSIDERED AS PART OF CONTRACT ITEM NO. 604.1430 "EXIST. DRAIN, STRUCT. TO BE COMPLETELY DEMOLISH."

3. ELEVATIONS ARE BASED ON MEAN SEA LEVEL (MSL=0). LOCATION AND BENCH MARK DATA IS SHOWN ON SHEET D-3

4. ESTIMATED GRADING STARTING DATE: FEB. 1979 COMPLETION DATE: SEPT 1980

5. REMOVE PLUG AND CONNECT TO EXISTING DRAINAGE STRUCTURE WORK SHALL BE INCIDENTAL TO VARIOUS CONTRACT ITEMS.

6. THE CONTRACTOR SHALL REMOVE ALL SILT AND DEBRIS RESULTING FROM HIS WORK AND DEPOSITED IN DRAINAGE FACILITIES, ROADWAYS AND OTHER AREAS. THE COSTS INCURRED FOR ANY NECESSARY REMEDIAL ACTION BY THE CHIEF ENGINEER SHALL BE PAYABLE BY THE CONTRACTOR.

7. THE CONTRACTOR, AT HIS OWN EXPENSE, SHALL KEEP THE PROJECT AREA AND SURROUNDING AREA FREE FROM DUST NUISANCE. THE WORK SHALL BE IN CONFORMANCE WITH THE AIR POLLUTION CONTROL STANDARDS AND REGULATIONS OF THE STATE DEPARTMENT OF HEALTH.

8. ALL SLOPES AND EXPOSED AREAS SHALL BE SODDED OR PLANTED IMMEDIATELY AFTER THE GRADING WORK HAS BEEN COMPLETED.

9. NO GRADING WORK SHALL BE DONE ON SATURDAYS, SUNDAYS AND HOLIDAYS AT ANYTIME WITHOUT PRIOR NOTICE TO THE CHIEF ENGINEER.

10. LIMITS OF GRADED AREA SHALL BE FLAGGED BEFORE THE COMMENCEMENT OF THE GRADING WORK.


11. ALL GRADING OPERATIONS SHALL BE PERFORMED IN CONFORMANCE WITH THE APPLICABLE PROVISIONS OF THE WATER POLLUTION CONTROL AND WATER QUALITY STANDARDS CONTAINED IN THE PUBLIC HEALTH REGULATIONS, STATE DEPARTMENT OF HEALTH, ON WATER POLLUTION CONTROL AND WATER QUALITY STANDARDS.

12. TEMPORARY EROSION CONTROL PROCEDURES SHALL BE SUBMITTED FOR APPROVAL PRIOR TO APPLICATION FOR A GRADING PERMIT.

LEGEND

- 10 --- EXISTING CONTOUR LINE
- == 10 == FINISH CONTOUR LINE
- 0 --- WATER FLOW DIRECTION
- 10 --- EXISTING DRAIN TO BE REMOVED OR ABANDONED WITH PLUG

TRUE NORTH
SCALE: 1" = 20'


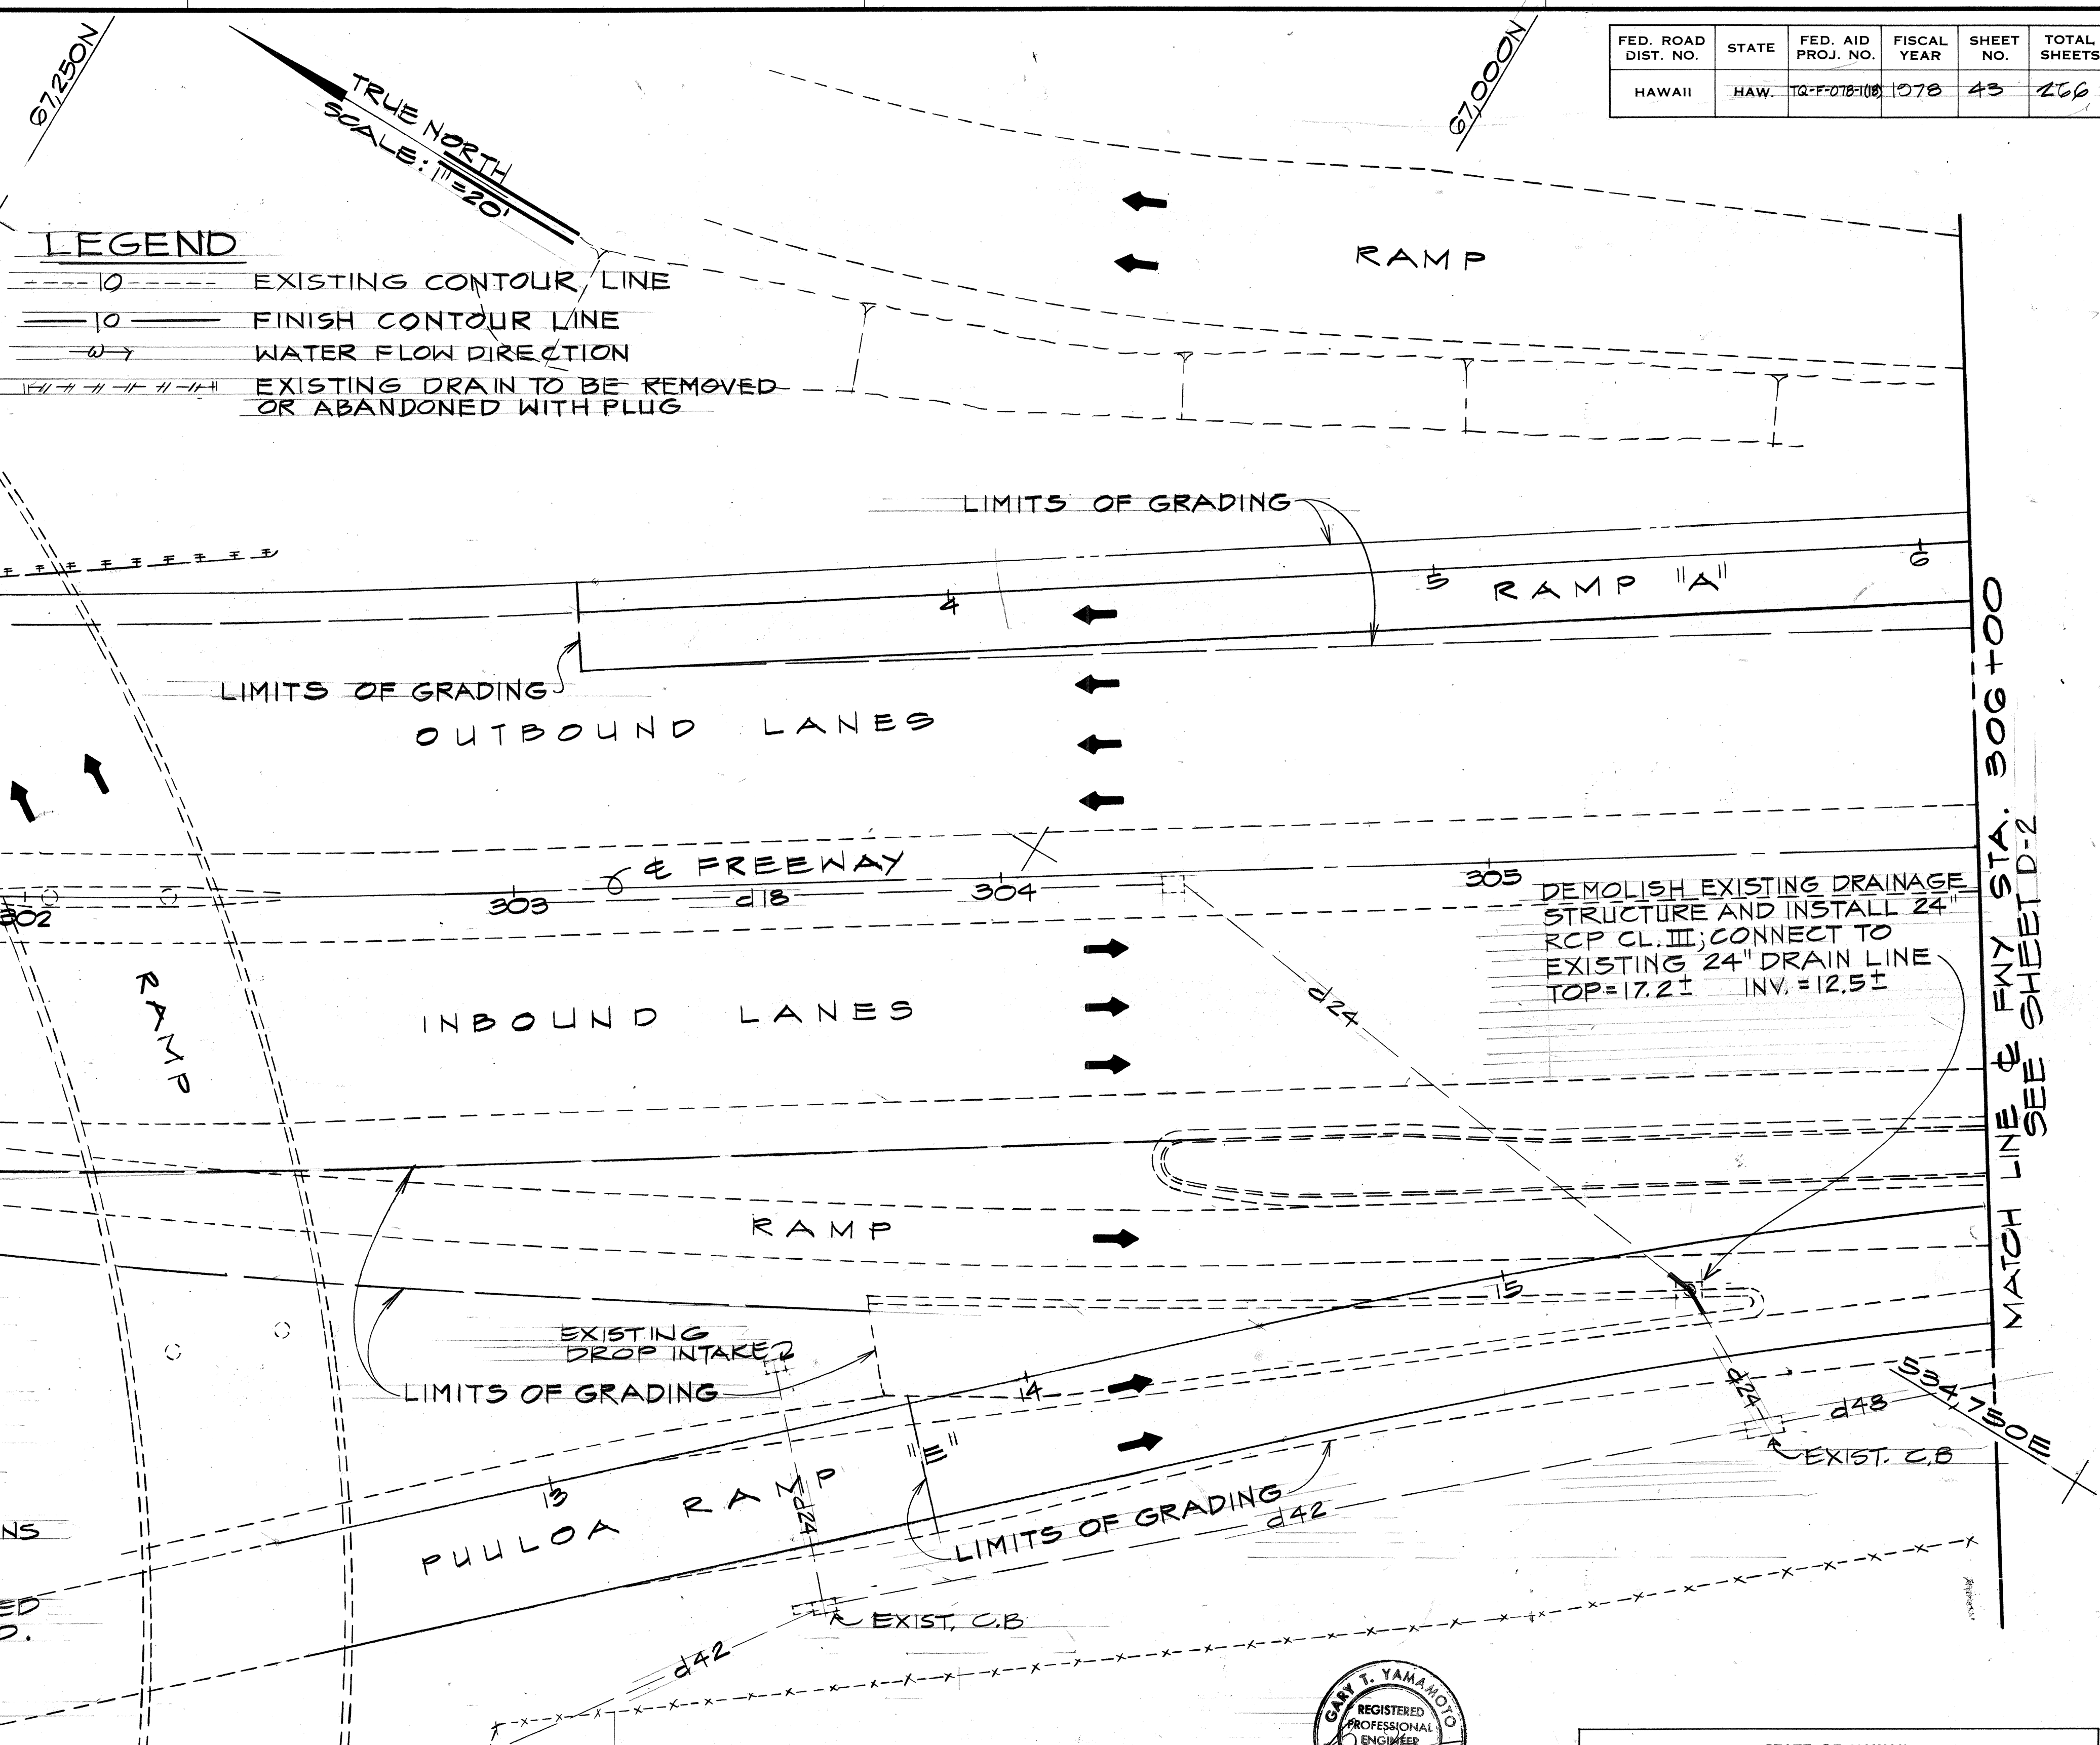


PLAN
SCALE: 1" = 20'

13. THE CITY SHALL BE INFORMED OF THE LOCATION OF THE BORROW/DISPOSAL SITE FOR THE PROJECT WHEN THE APPLICATION FOR A GRADING PERMIT IS MADE. THE BORROW/DISPOSAL SITE MUST ALSO FULFILL THE REQUIREMENTS OF THE GRADING ORDINANCE.

AREA TO BE GRADED = 0.55 ACRES
APPROVED FOR GRADING ONLY

J. J. Young 8/9/78
CHIEF, DIVISION OF ENGINEERING DATE

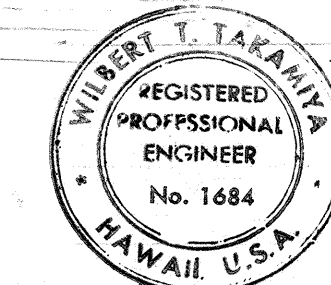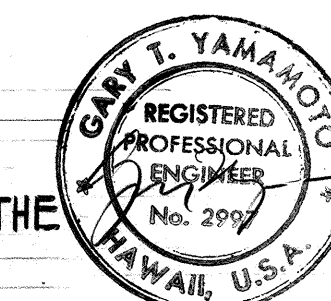


THIS WORK WAS PREPARED BY
OR UNDER MY SUPERVISION

FED. ROAD DIST. NO.	STATE	FED. AID PROJ. NO.	FISCAL YEAR	SHEET NO.	TOTAL SHEETS
HAWAII	HAW.	TQ-F-078-108	1978	43	266

STATE OF HAWAII
DEPARTMENT OF TRANSPORTATION
HIGHWAYS DIVISION
GRADING & DRAINAGE PLAN
MOANALUA ROAD
PUULOA I.C. TO MIDDLE ST.-UNIT 3A
FA. Proj. No. TQ-F-078-1 (18)
SCALE: AS SHOWN DATE: NOV. 15, 1978
SHEET No. D-1 OF 7 SHEETS

FED. ROAD DIST. NO.	STATE	FED. AID PROJ. NO.	FISCAL YEAR	SHEET NO.	TOTAL SHEETS
HAWAII	HAW.	TQ-F-078-1(18)	1978	46	266

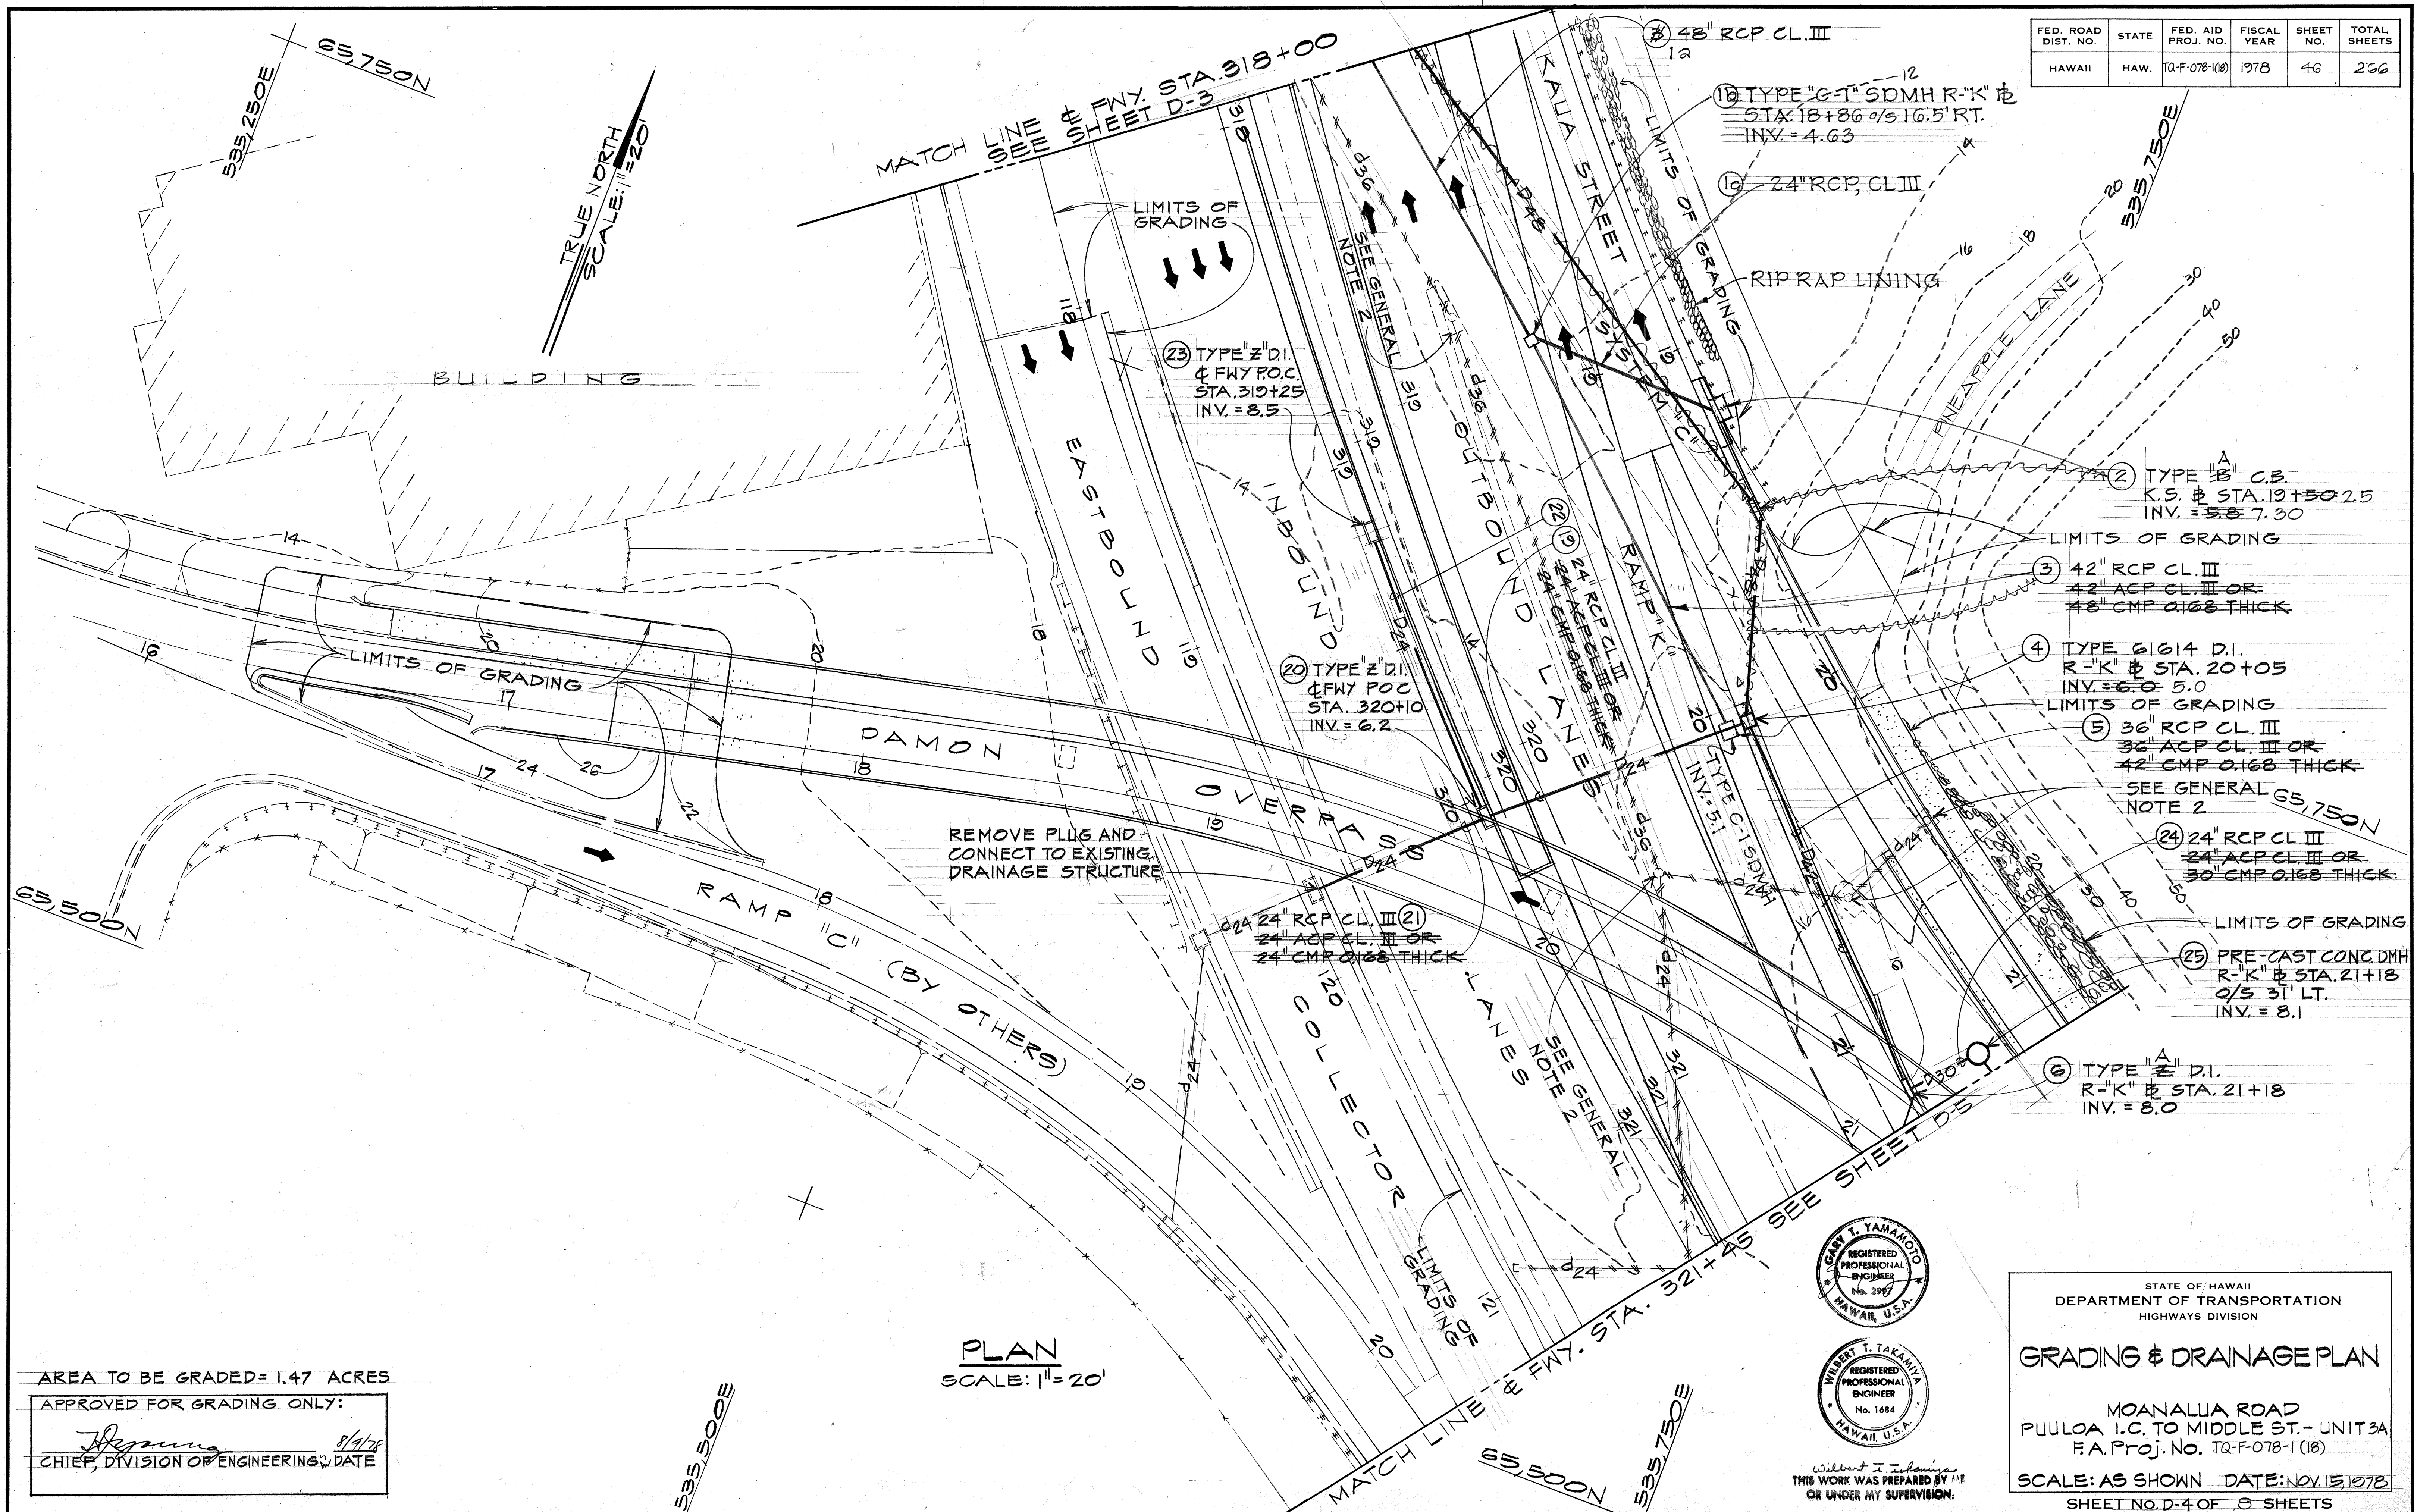



SURVEY PLOTTED BY	DATE
DRAWN BY	
DESIGNED BY	
QUANTITIES BY	
CHECKED BY	
ORIGINAL PLAN	
NOTE BOOK	
NO.	

AREA TO BE GRADED = 1.47 ACRES

APPROVED FOR GRADING ONLY:

[Signature] 8/1/78
CHIEF, DIVISION OF ENGINEERING DATE

PLAN
SCALE: 1" = 20'

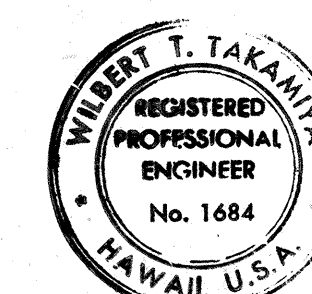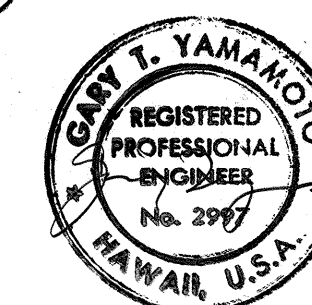

Wilbert T. Takamika
THIS WORK WAS PREPARED BY ME
OR UNDER MY SUPERVISION.

STATE OF HAWAII
DEPARTMENT OF TRANSPORTATION
HIGHWAYS DIVISION


GRADING & DRAINAGE PLAN

MOANALUA ROAD
PUULOA I.C. TO MIDDLE ST. - UNIT 3A
F.A. Proj. No. TQ-F-078-1(18)

SCALE: AS SHOWN DATE: NOV. 15, 1978

SHEET NO. D-4 OF 8 SHEETS

FED. ROAD DIST. NO.	STATE	FED. AID PROJ. NO.	FISCAL YEAR	SHEET NO.	TOTAL SHEETS
HAWAII	HAW.	TQ-F-078-1(18)	1978	48	266

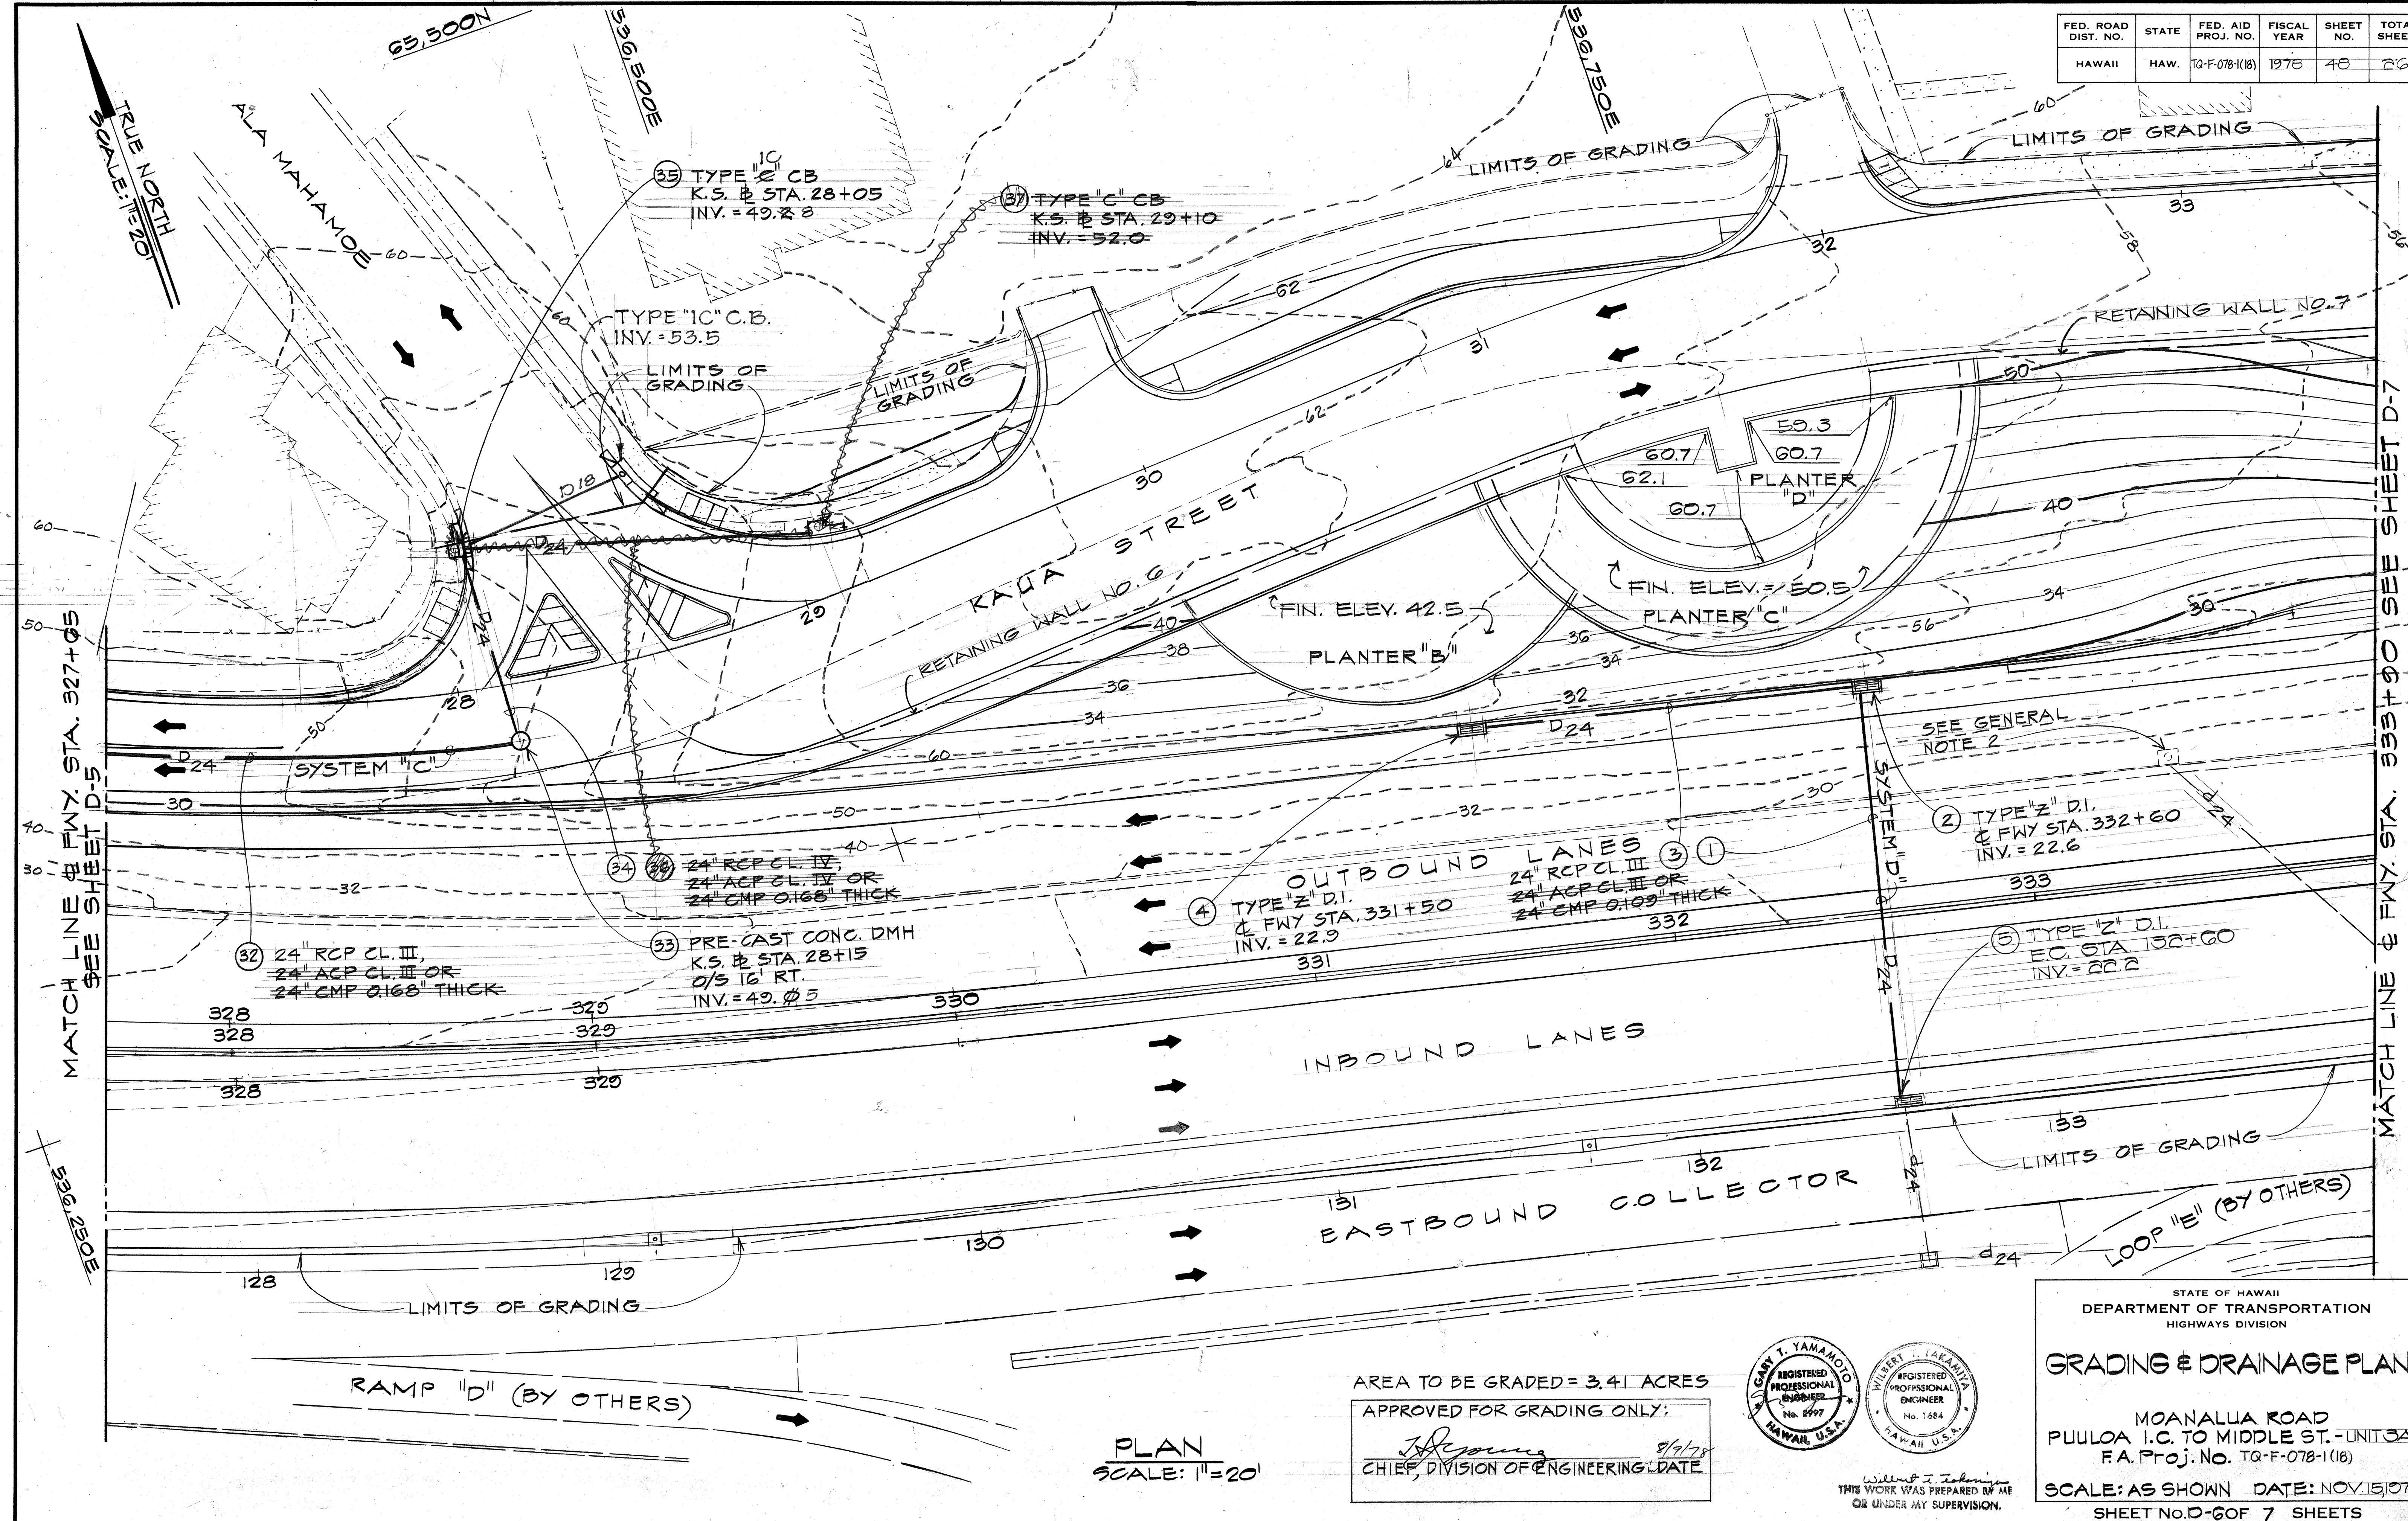


SURVEY PLOTTED BY _____ DATE _____
 DRAWN BY _____
 CHECKED BY _____
 NOTE BOOK _____
 NO. _____

PLAN
 SCALE: 1" = 20'

AREA TO BE GRADED = 3.41 ACRES


APPROVED FOR GRADING ONLY:
[Signature]
 CHIEF, DIVISION OF ENGINEERING DATE 8/9/78

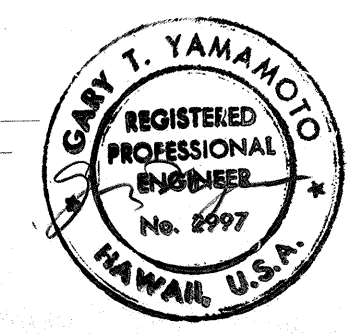

William T. Lapania
 THIS WORK WAS PREPARED BY ME
 OR UNDER MY SUPERVISION.

STATE OF HAWAII
 DEPARTMENT OF TRANSPORTATION
 HIGHWAYS DIVISION
GRADING & DRAINAGE PLAN
 MOANALUA ROAD
 PUULOA I.C. TO MIDDLE ST. - UNIT 3A
 F.A. Proj. No. TQ-F-078-1(18)
 SCALE: AS SHOWN DATE: NOV. 15, 1978
 SHEET No. D-6 OF 7 SHEETS

FED. ROAD DIST. NO.	STATE	FED. AID PROJ. NO.	FISCAL YEAR	SHEET NO.	TOTAL SHEETS
HAWAII	HAW.	TQ-F-078-1(18)	1978	49	266

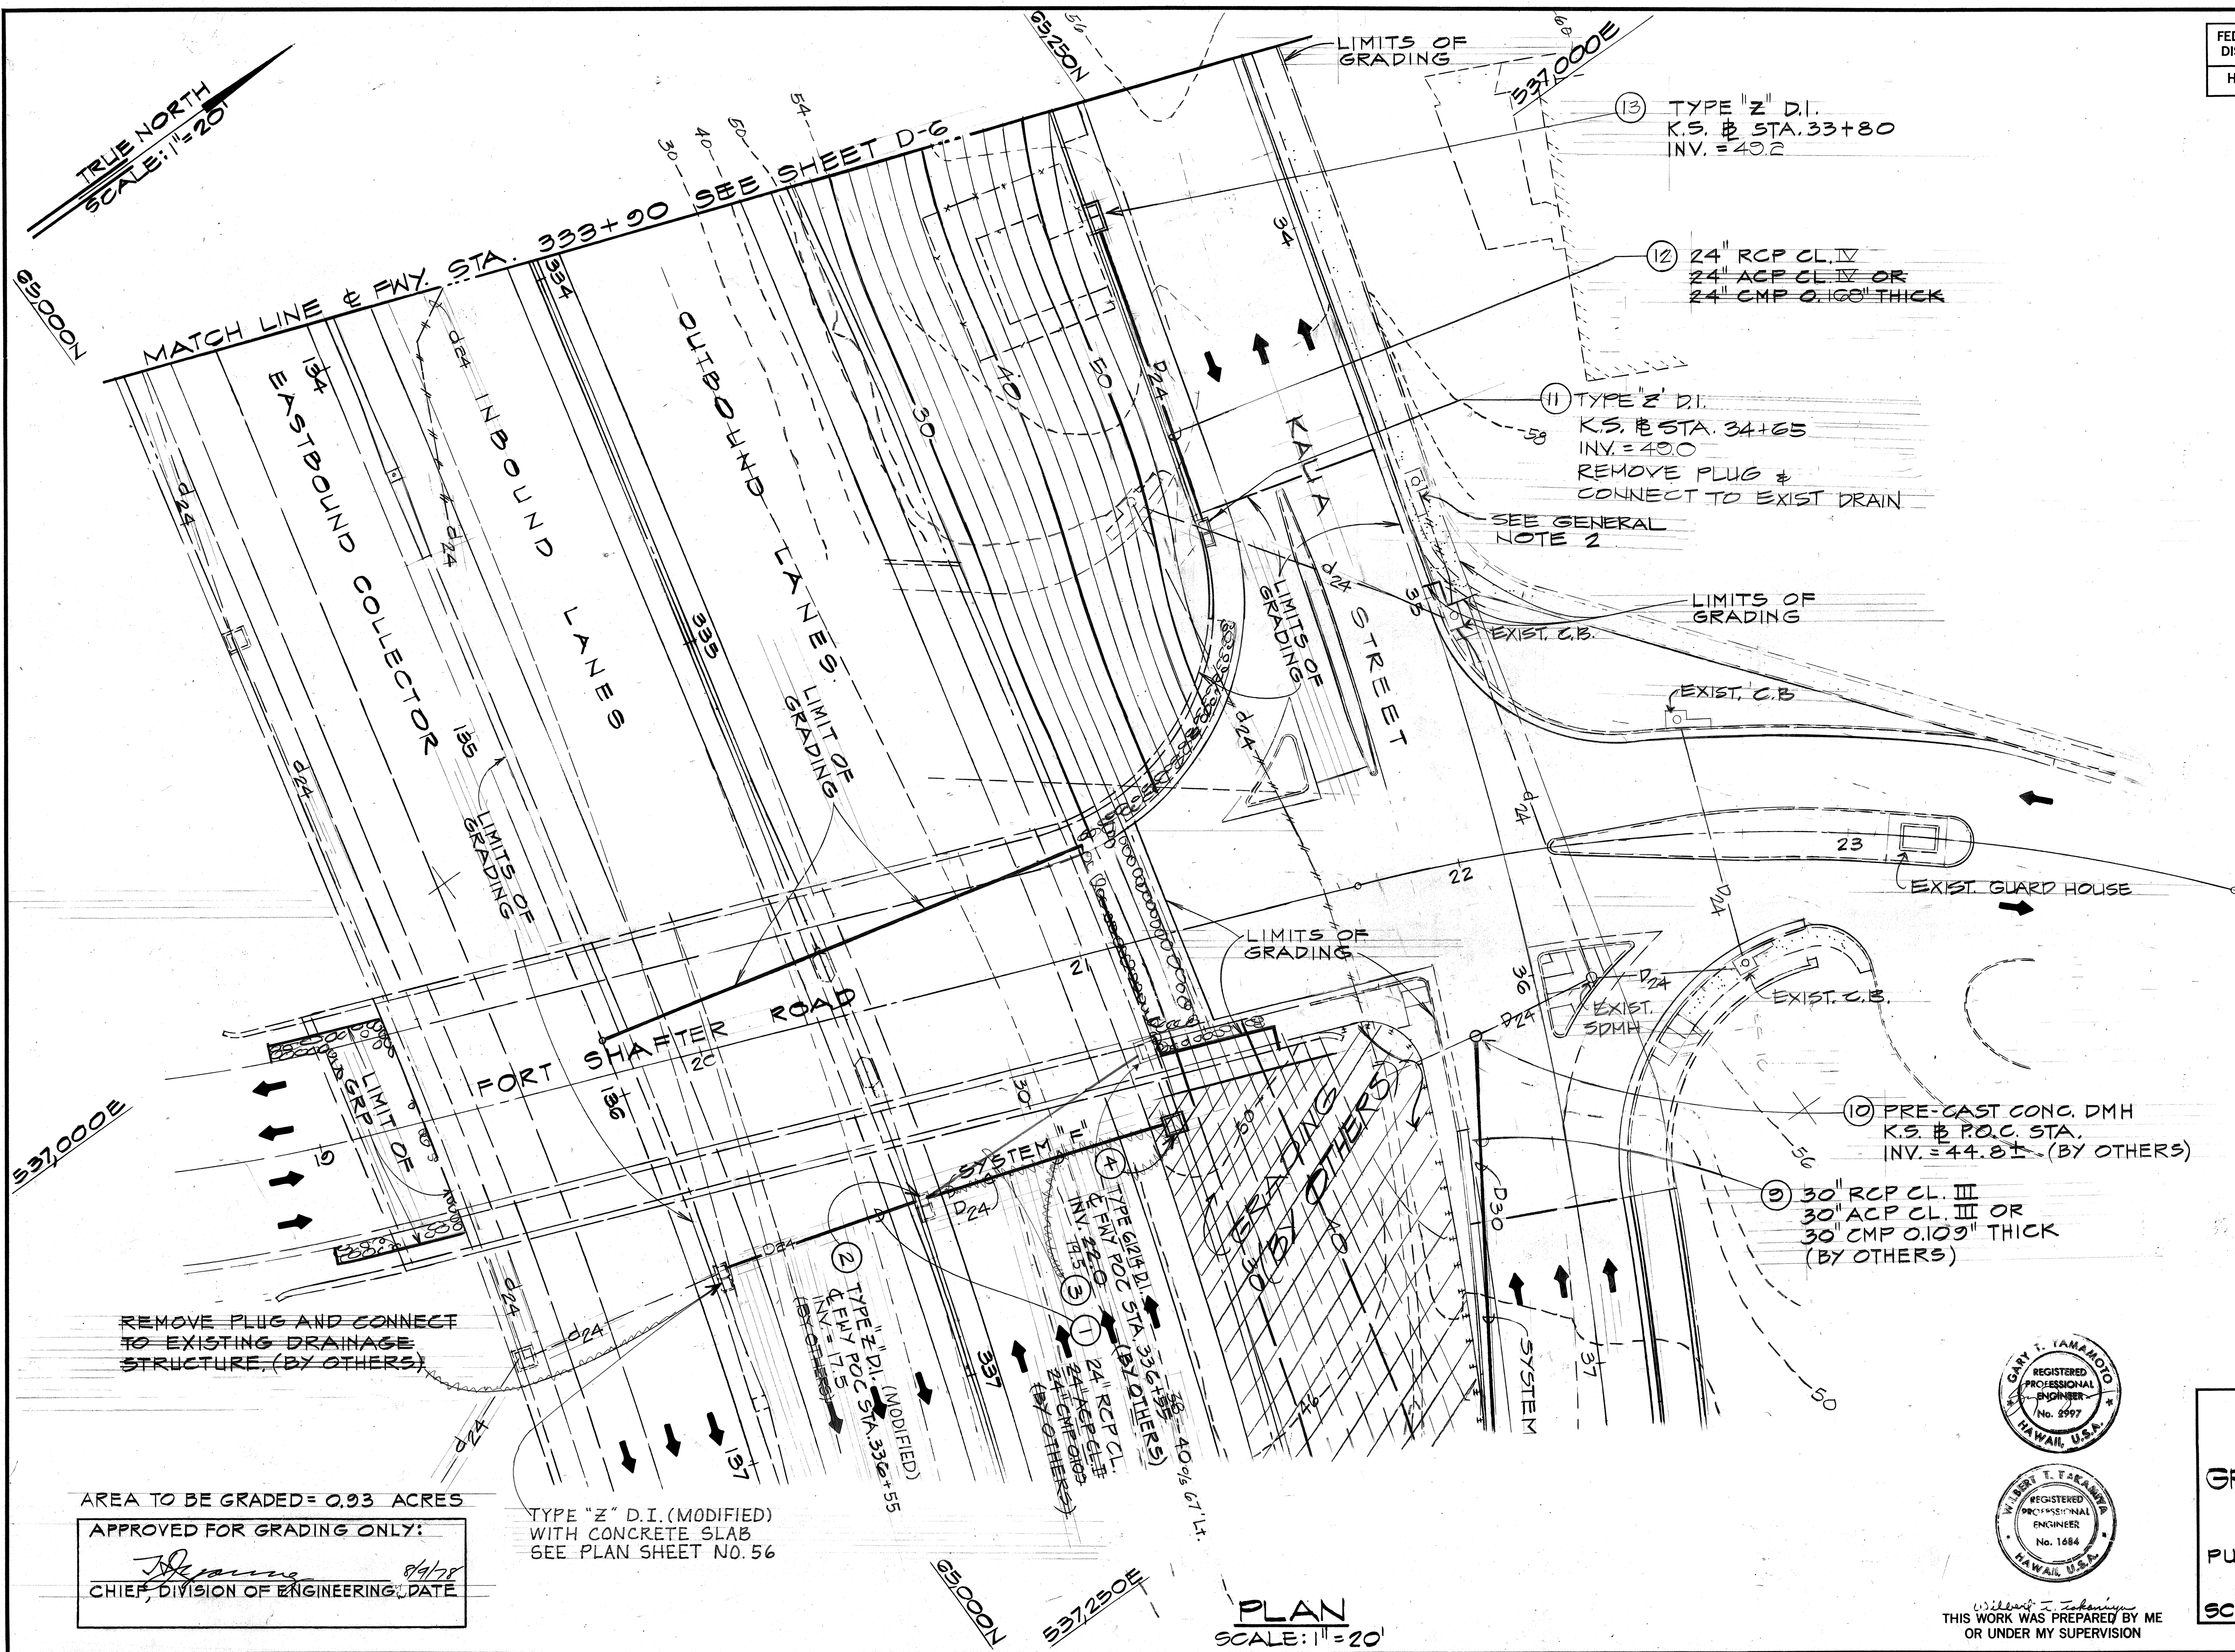

DATE	8/9/78
ORIGINAL PLAN	NO.
DRAWN BY	
DESIGNED BY	
QUANTITIES BY	
CHECKED BY	



AREA TO BE GRADED = 0.93 ACRES

APPROVED FOR GRADING ONLY:

[Signature] 8/9/78
CHIEF, DIVISION OF ENGINEERING, DATE

TYPE "Z" D.I. (MODIFIED)
WITH CONCRETE SLAB
SEE PLAN SHEET NO. 56

PLAN
SCALE: 1" = 20'

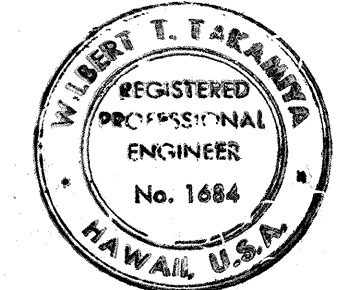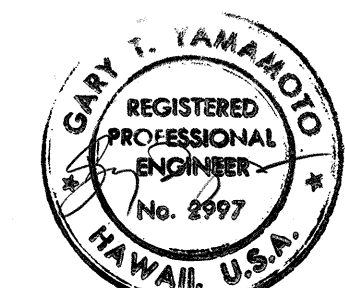

THIS WORK WAS PREPARED BY ME
OR UNDER MY SUPERVISION


STATE OF HAWAII
DEPARTMENT OF TRANSPORTATION
HIGHWAYS DIVISION

GRADING & DRAINAGE PLAN

MOANALUA ROAD
PUULOA I.C. TO MIDDLE ST. - UNIT-3A
F.A. Proj. No. TQ-F-078-1(18)

SCALE: AS SHOWN DATE: NOV. 15, 1978
SHEET NO. D-7 OF 7 SHEETS

FED. ROAD DIST. NO.	STATE	FED. AID PROJ. NO.	FISCAL YEAR	SHEET NO.	TOTAL SHEETS
HAWAII	HAW.	TQ-F-078-1(18)	1978	50	266

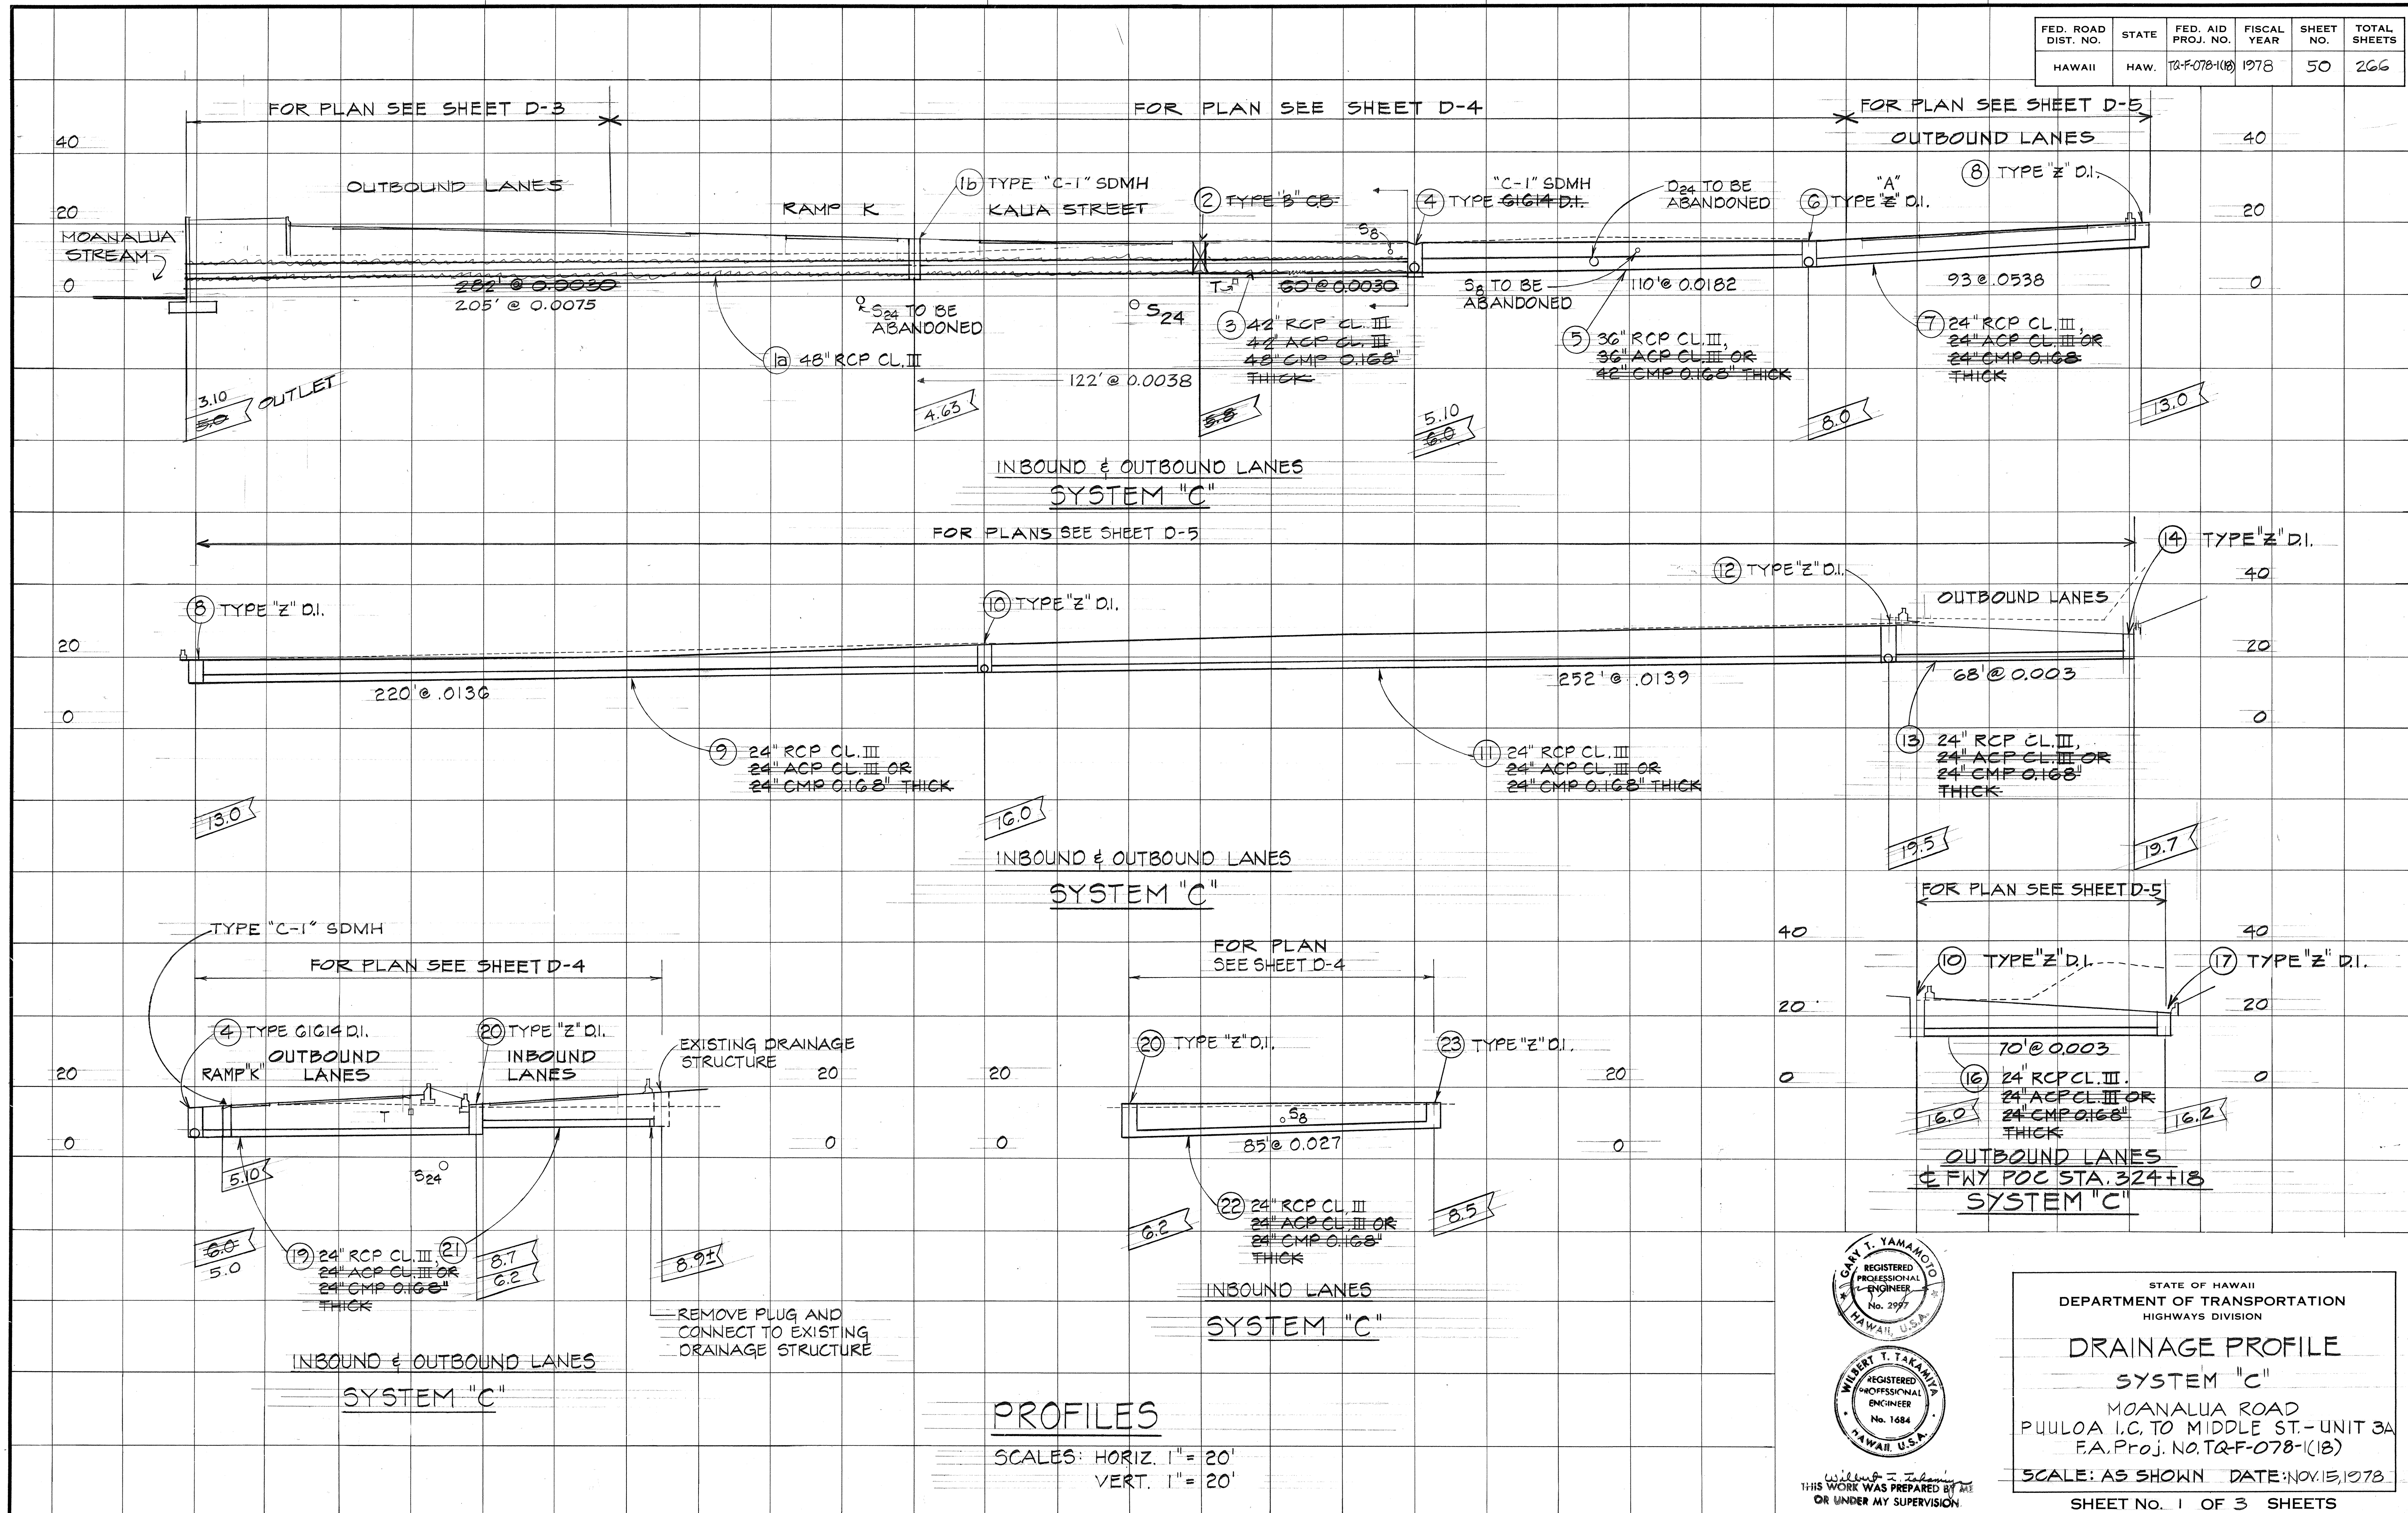

DATE: _____

SURVEY PLOTTED BY: _____



DRAWN BY: _____

DESIGNED BY: _____

NOTED BY: _____

CHECKED BY: _____

ORIGINAL PLAN NO. _____

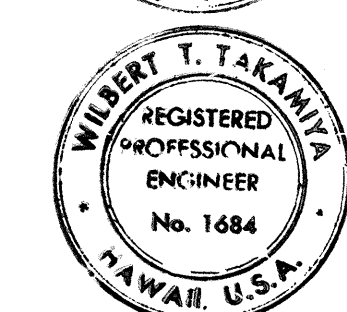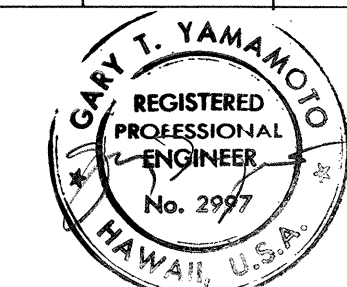

THIS WORK WAS PREPARED BY _____
OR UNDER MY SUPERVISION.

STATE OF HAWAII
DEPARTMENT OF TRANSPORTATION
HIGHWAYS DIVISION

DRAINAGE PROFILE




SYSTEM "C"

MOANALUA ROAD
PUULOA I.C. TO MIDDLE ST.-UNIT 3A
F.A. Proj. No. TQ-F-078-1(18)

SCALE: AS SHOWN DATE: NOV. 15, 1978









SHEET No. 1 OF 3 SHEETS

FED. ROAD DIST. NO.	STATE	FED. AID PROJ. NO.	FISCAL YEAR	SHEET NO.	TOTAL SHEETS
HAWAII	HAW.	TQ-F-078-1(18)	1978	51	266

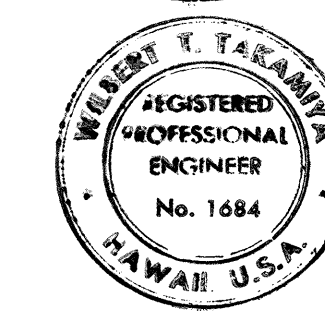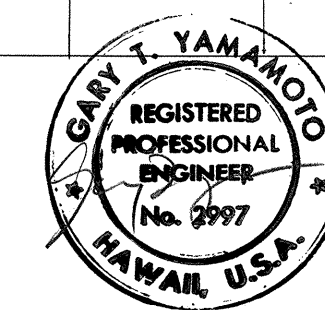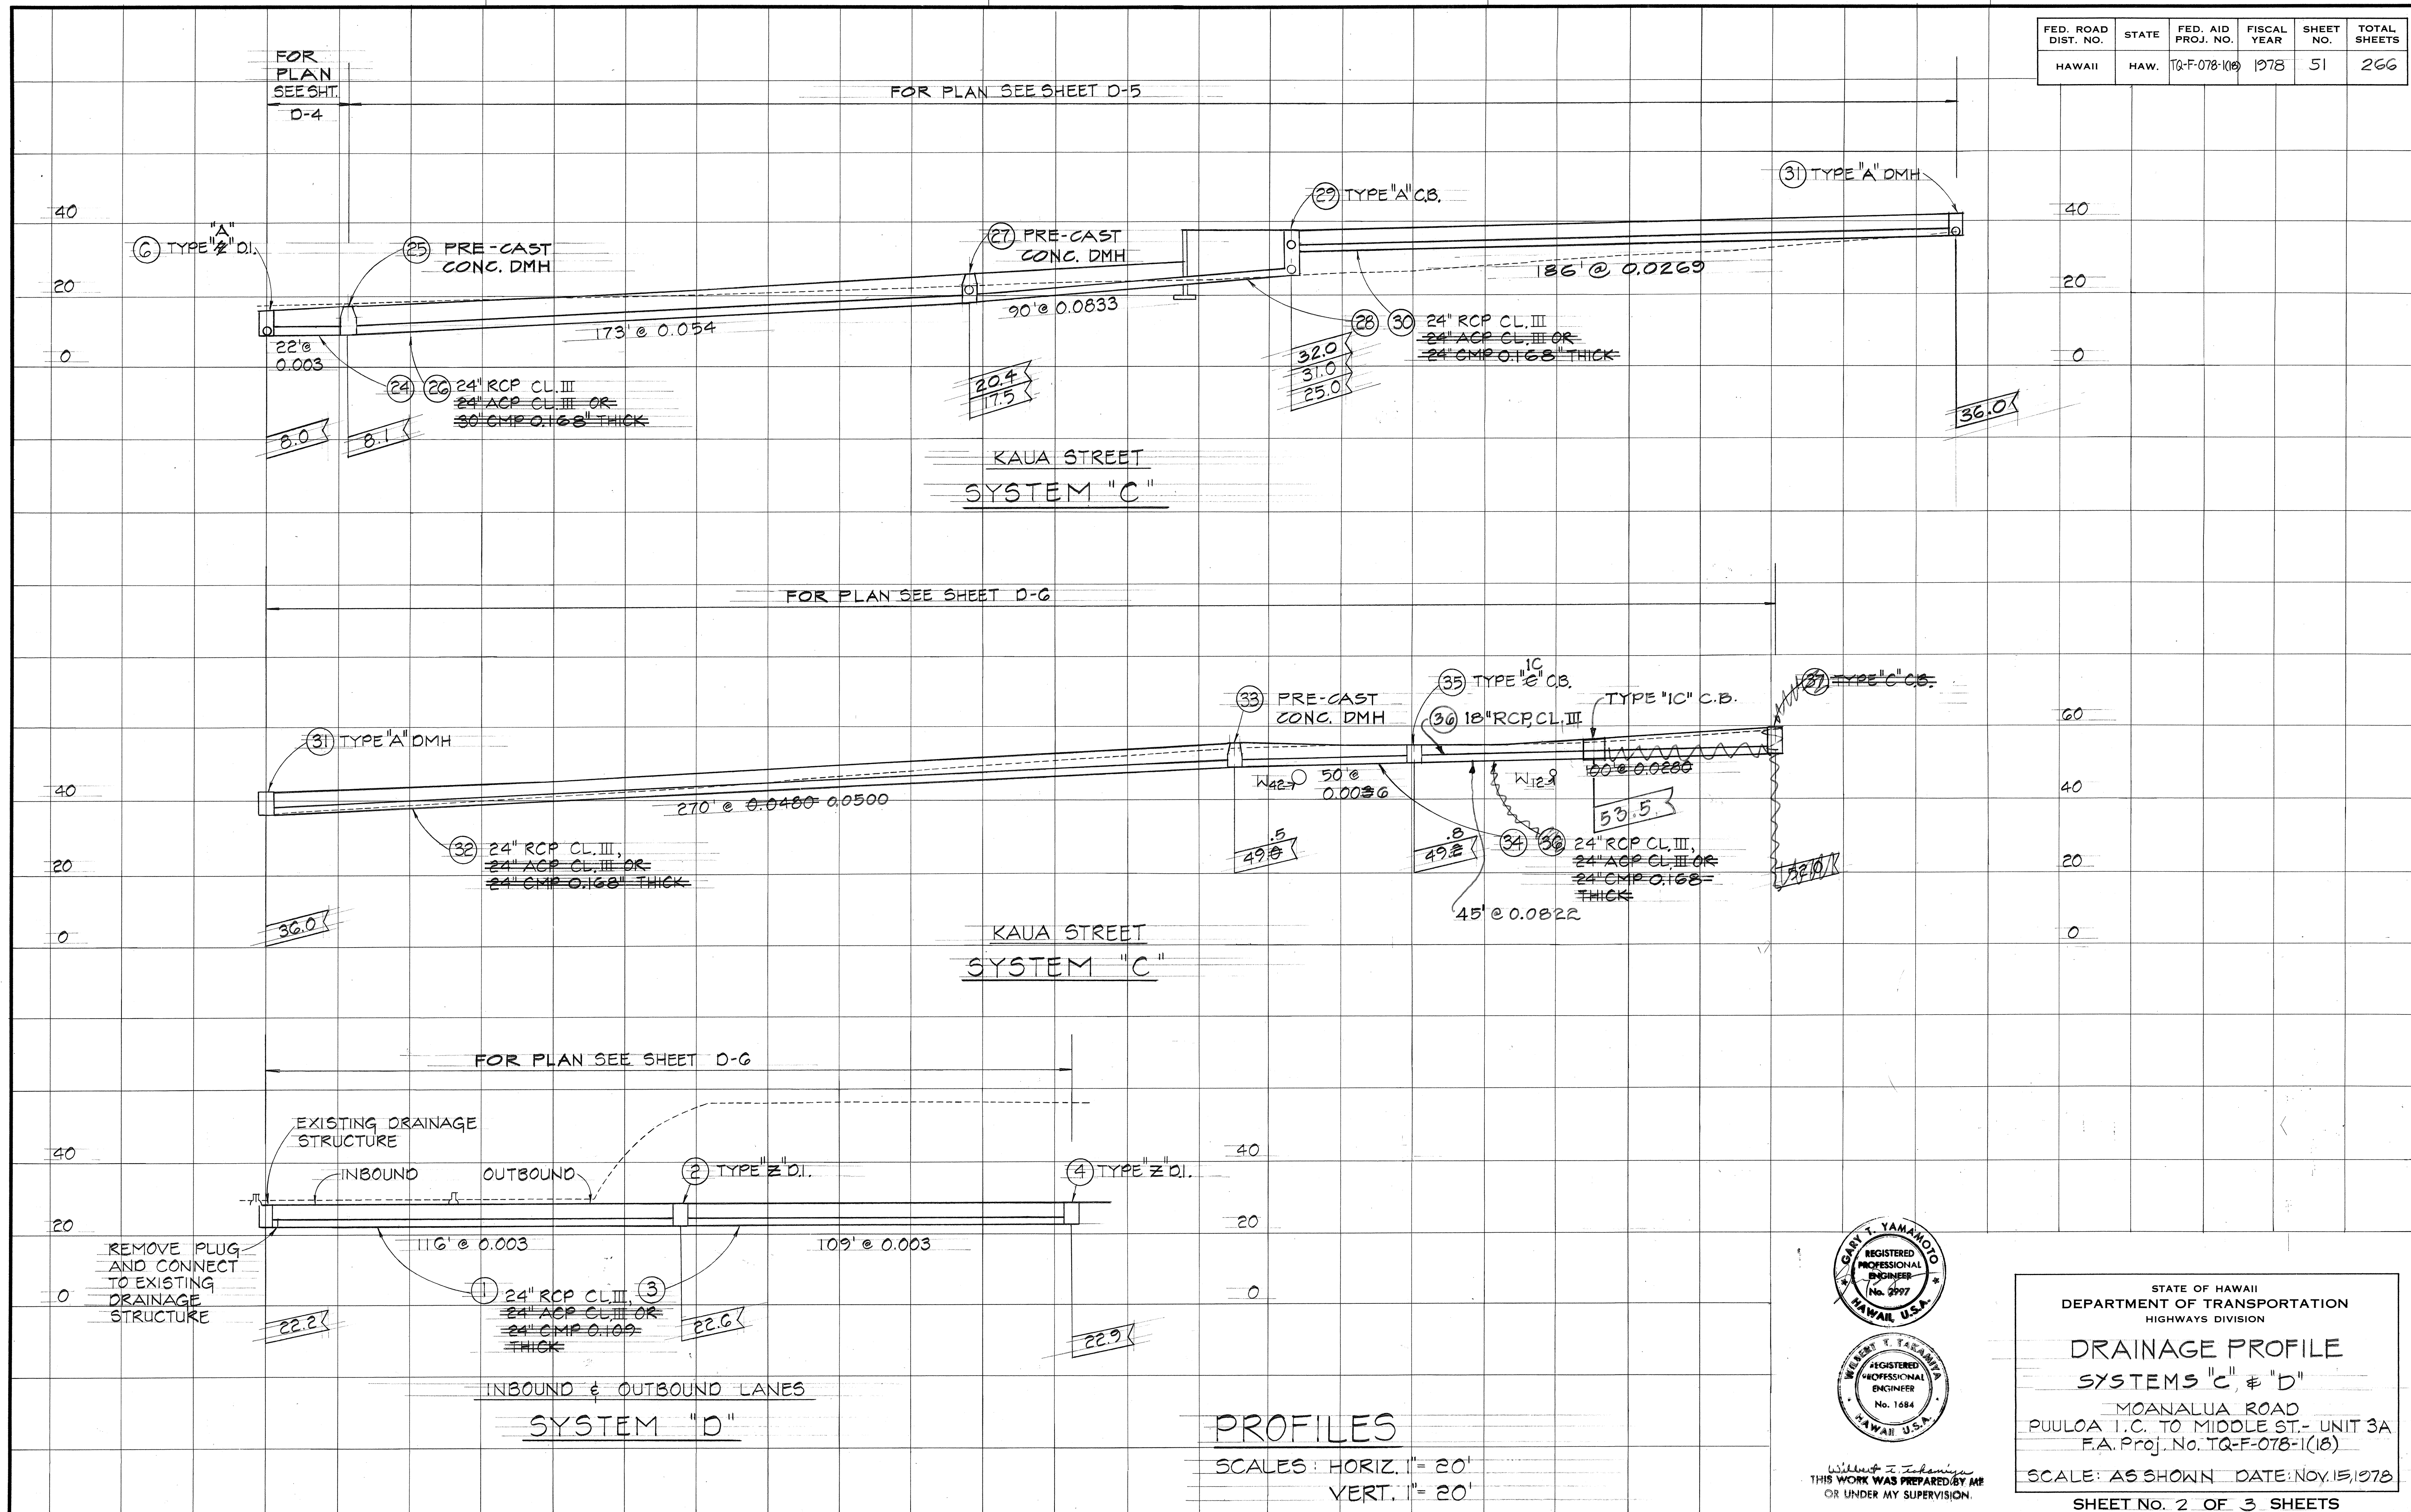



Witnessed by: *Wilbert T. Takamizawa*
THIS WORK WAS PREPARED BY ME
OR UNDER MY SUPERVISION.

FED. ROAD DIST. NO.	STATE	FED. AID PROJ. NO.	FISCAL YEAR	SHEET NO.	TOTAL SHEETS
HAWAII	HAW.	T&F-078-1(18)	1978	52	266

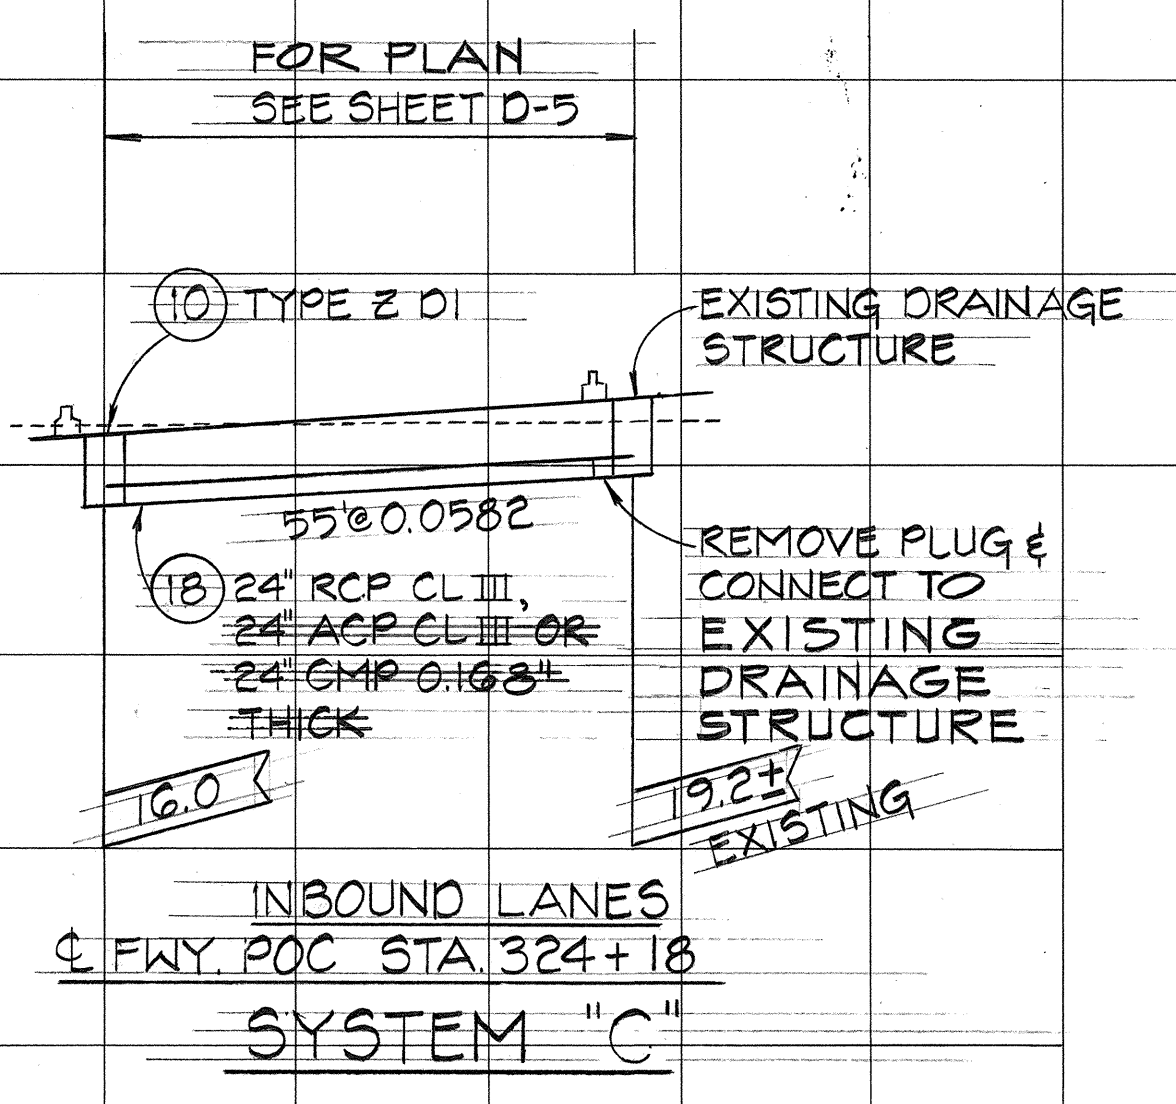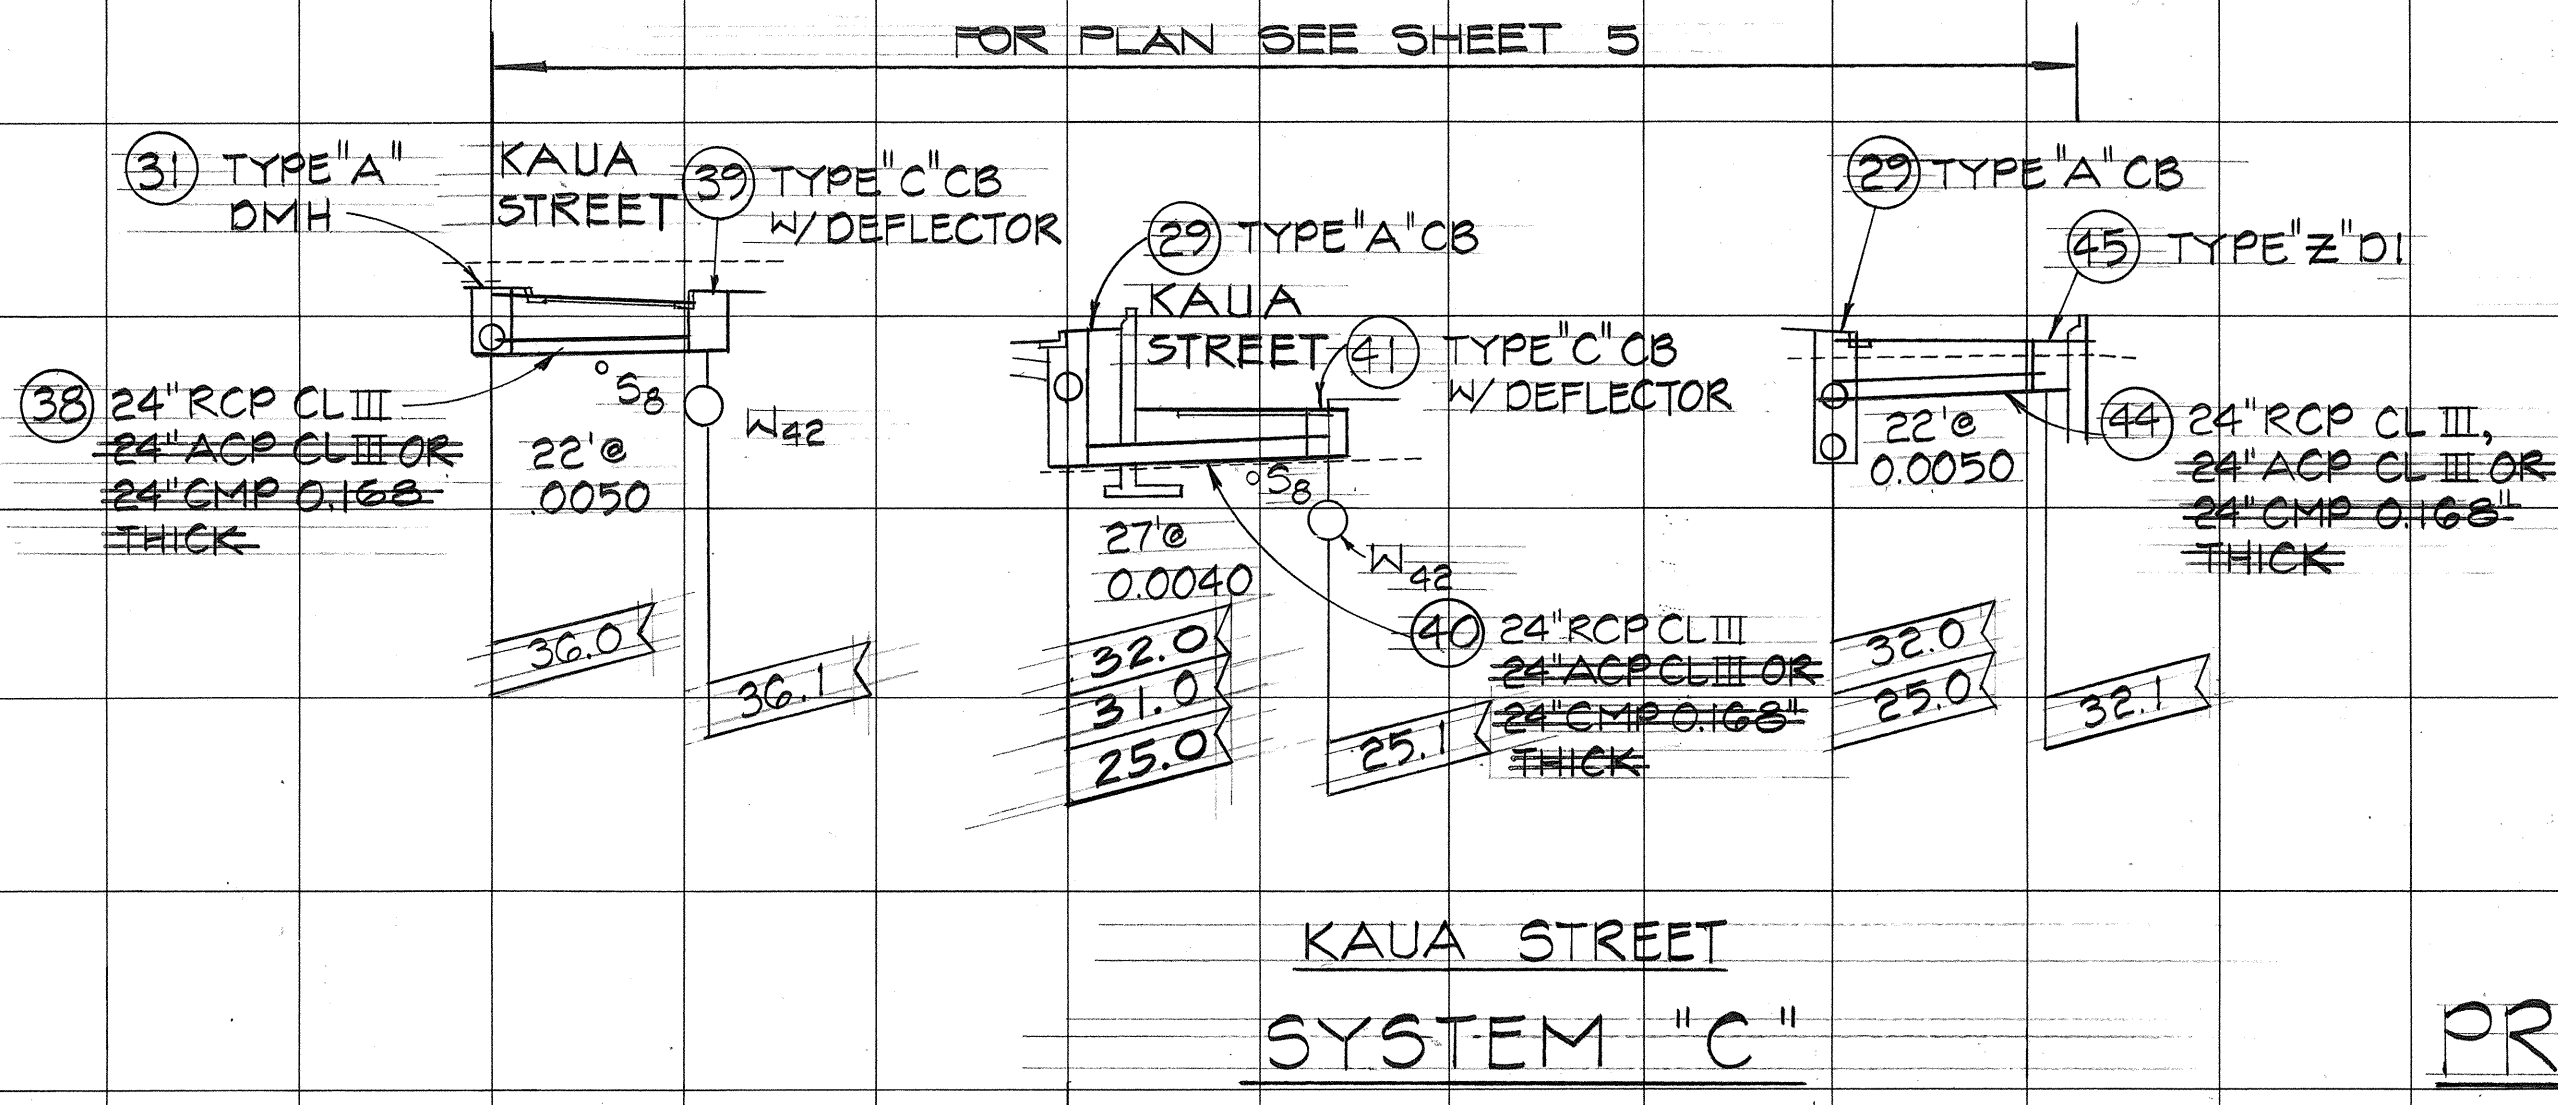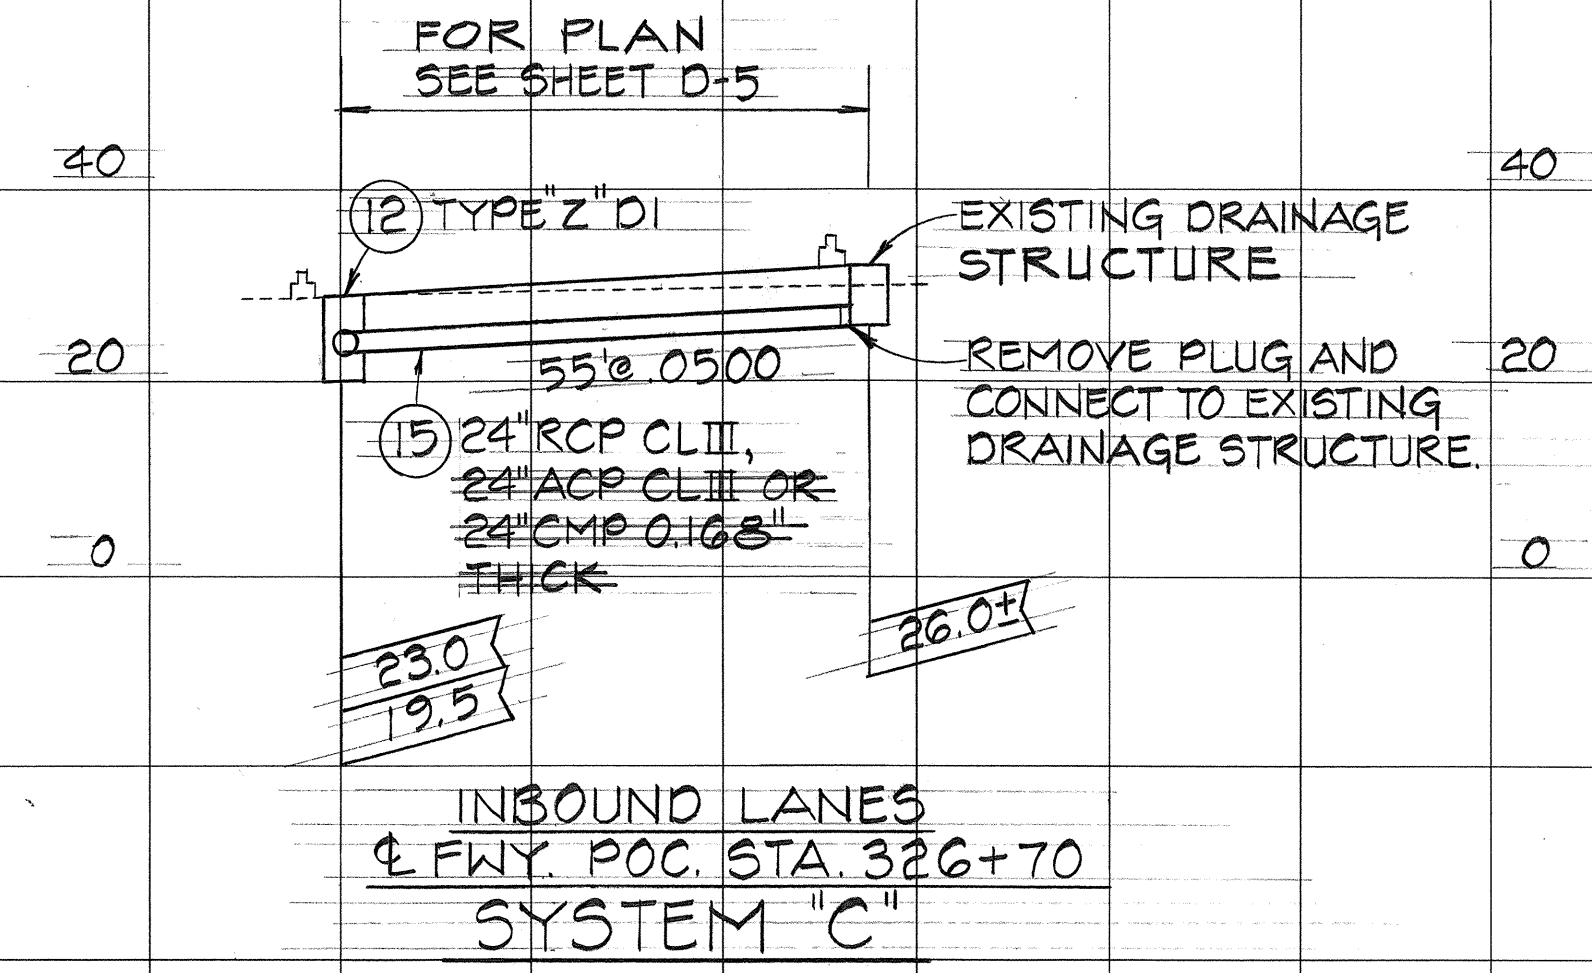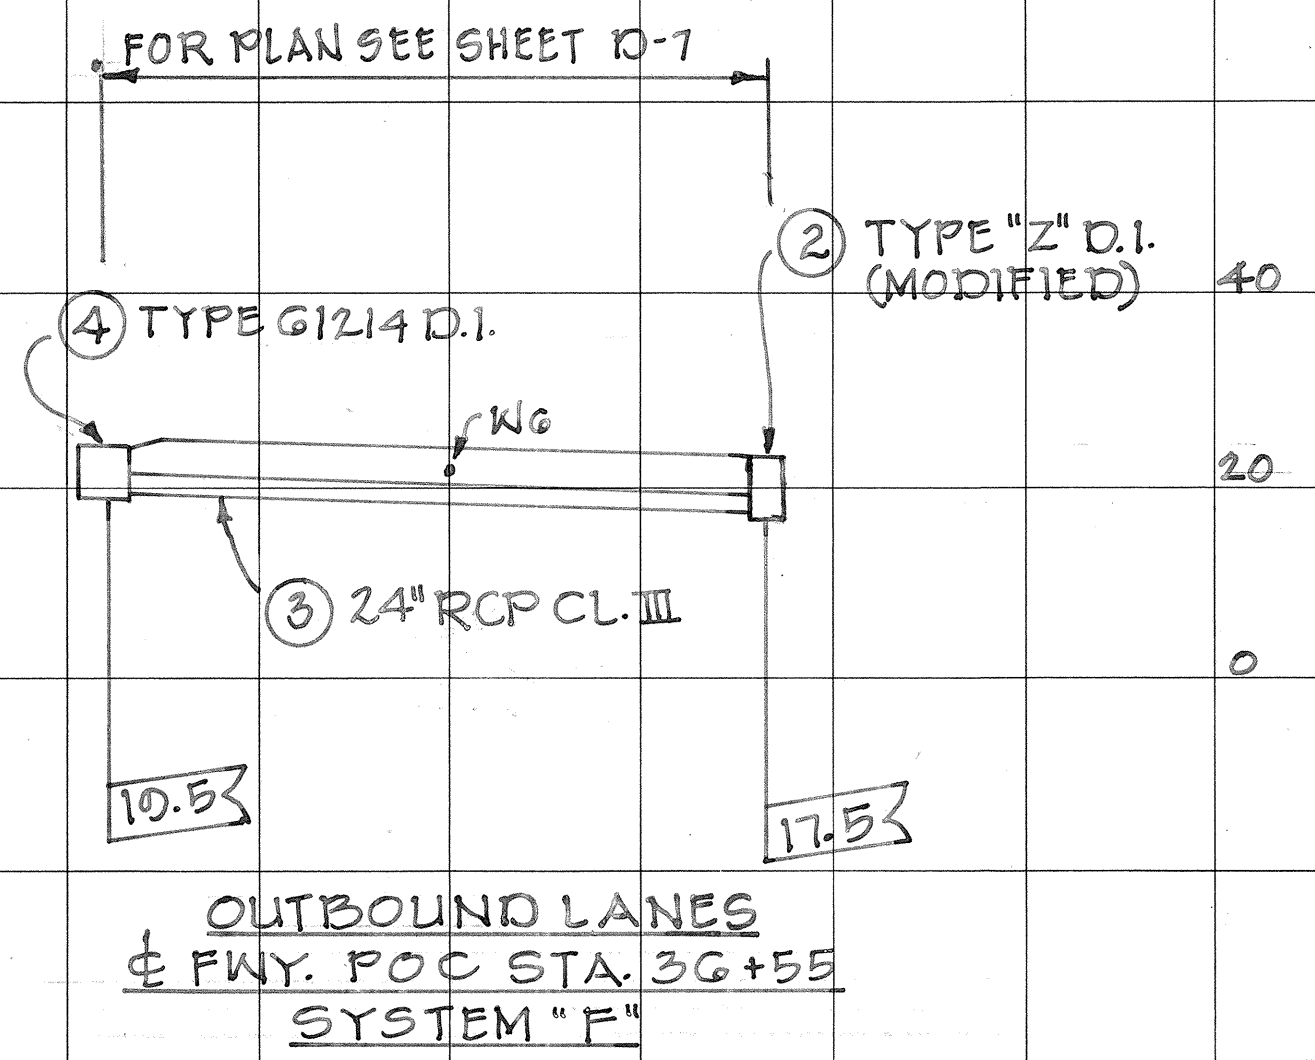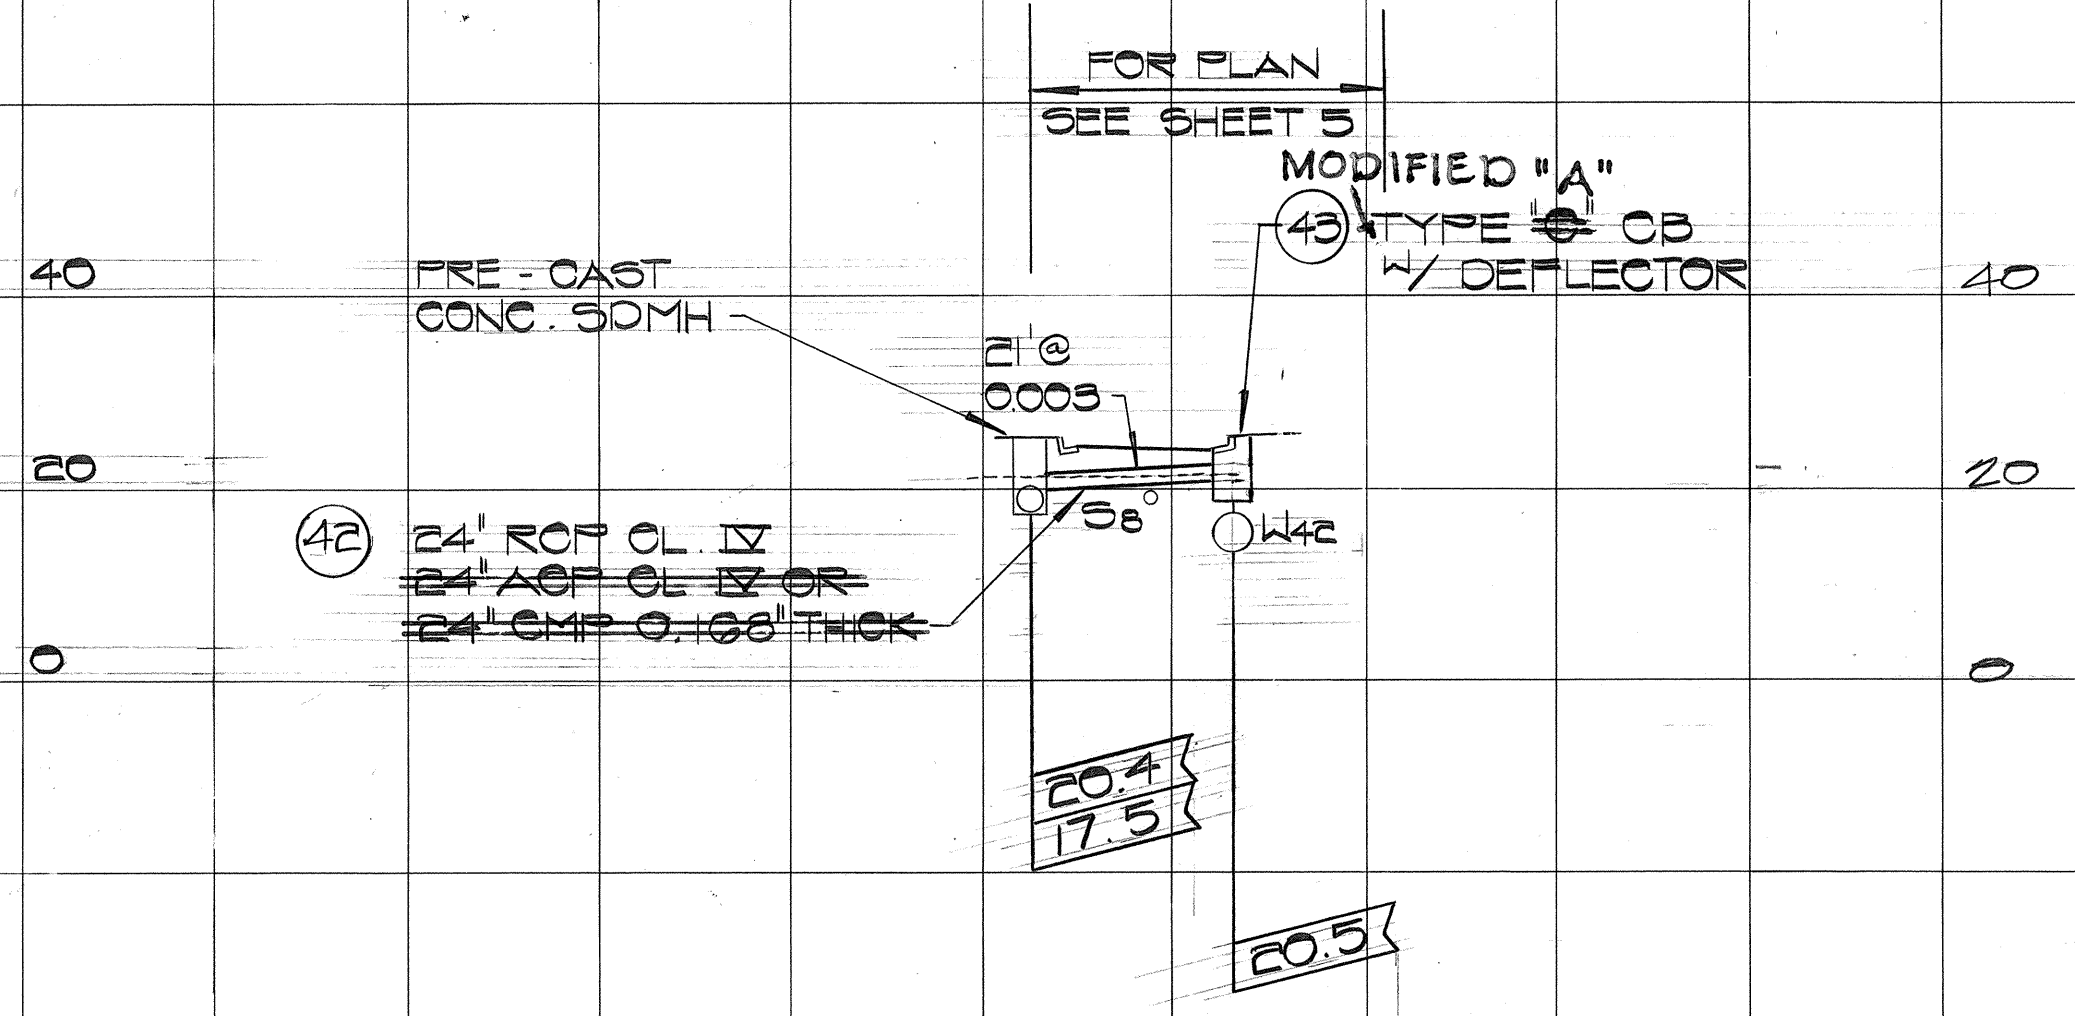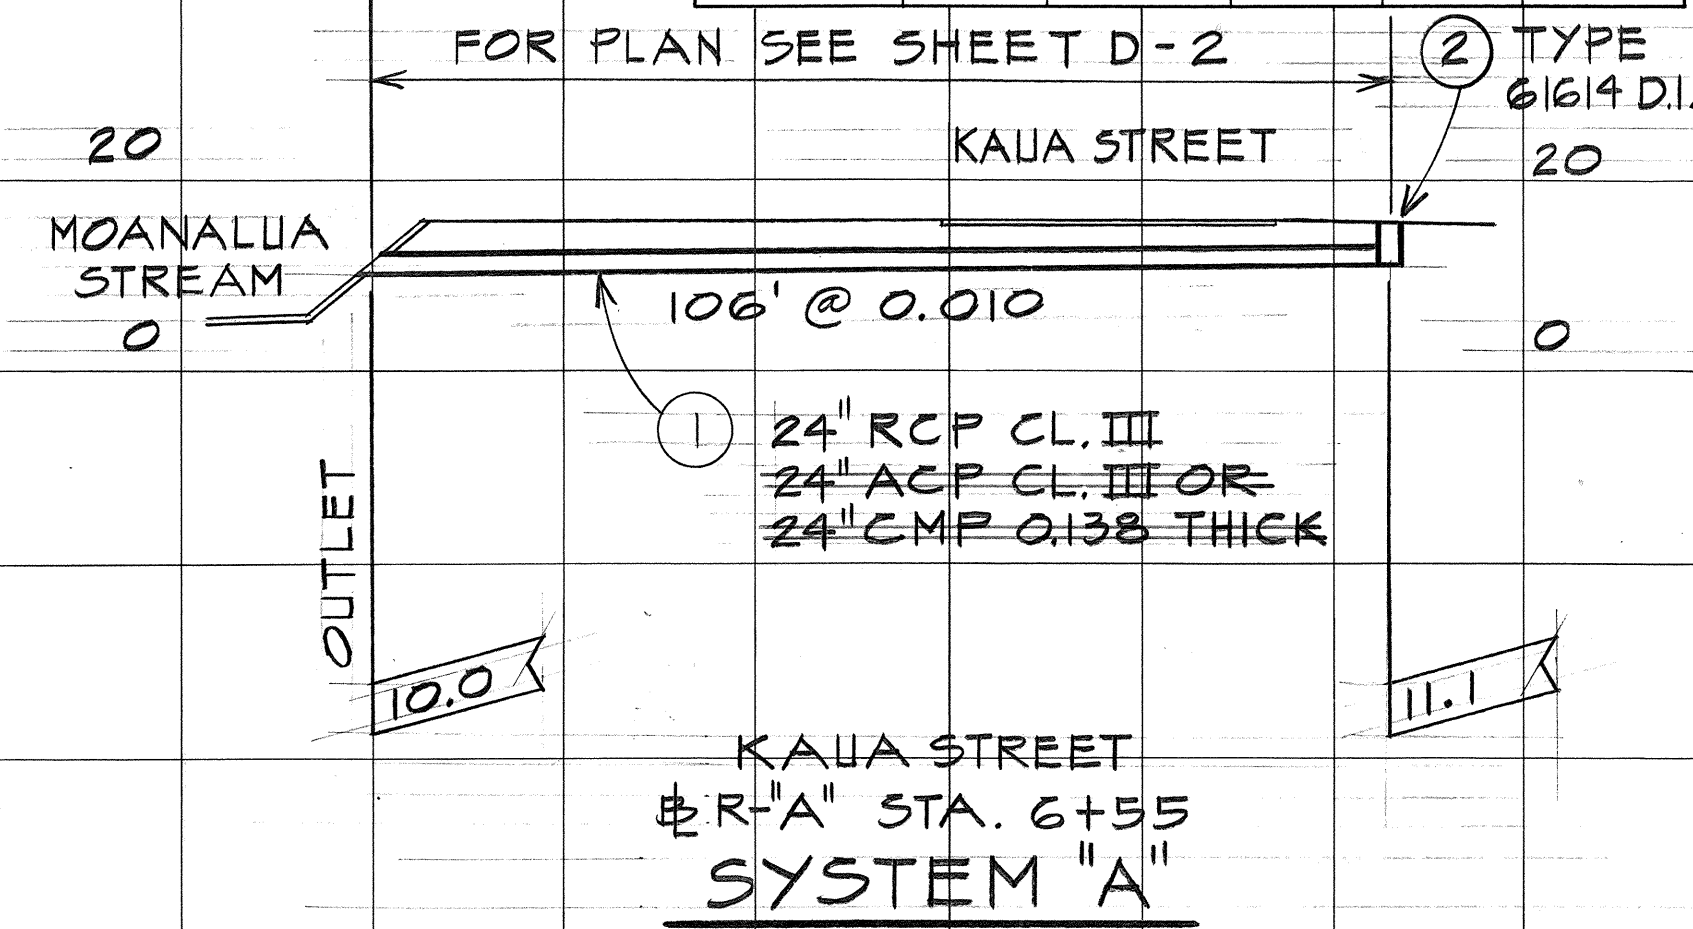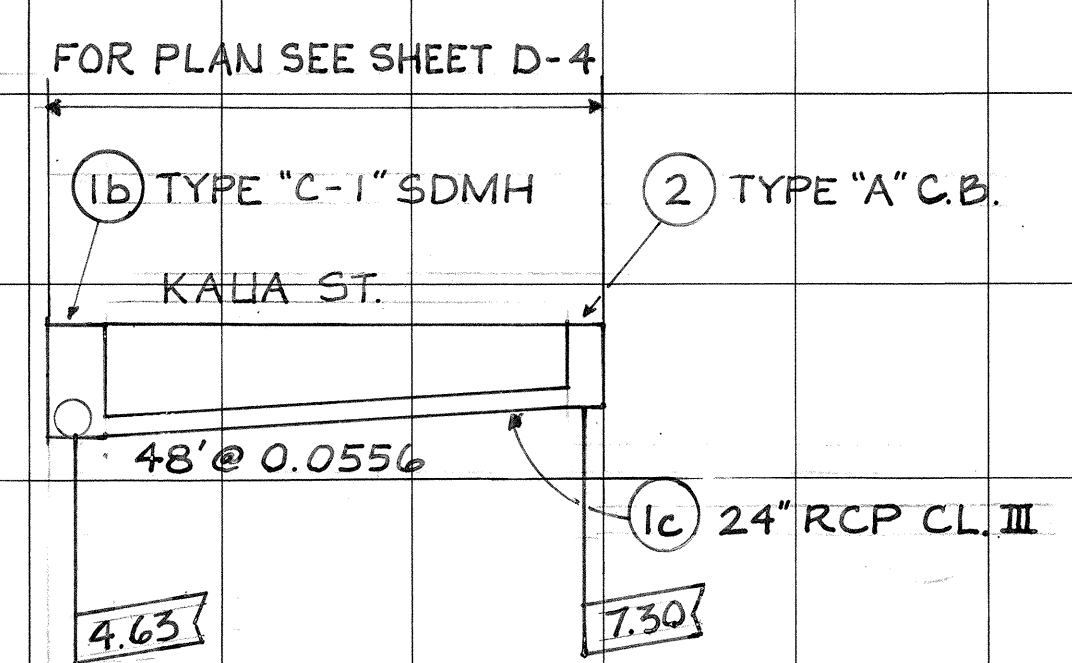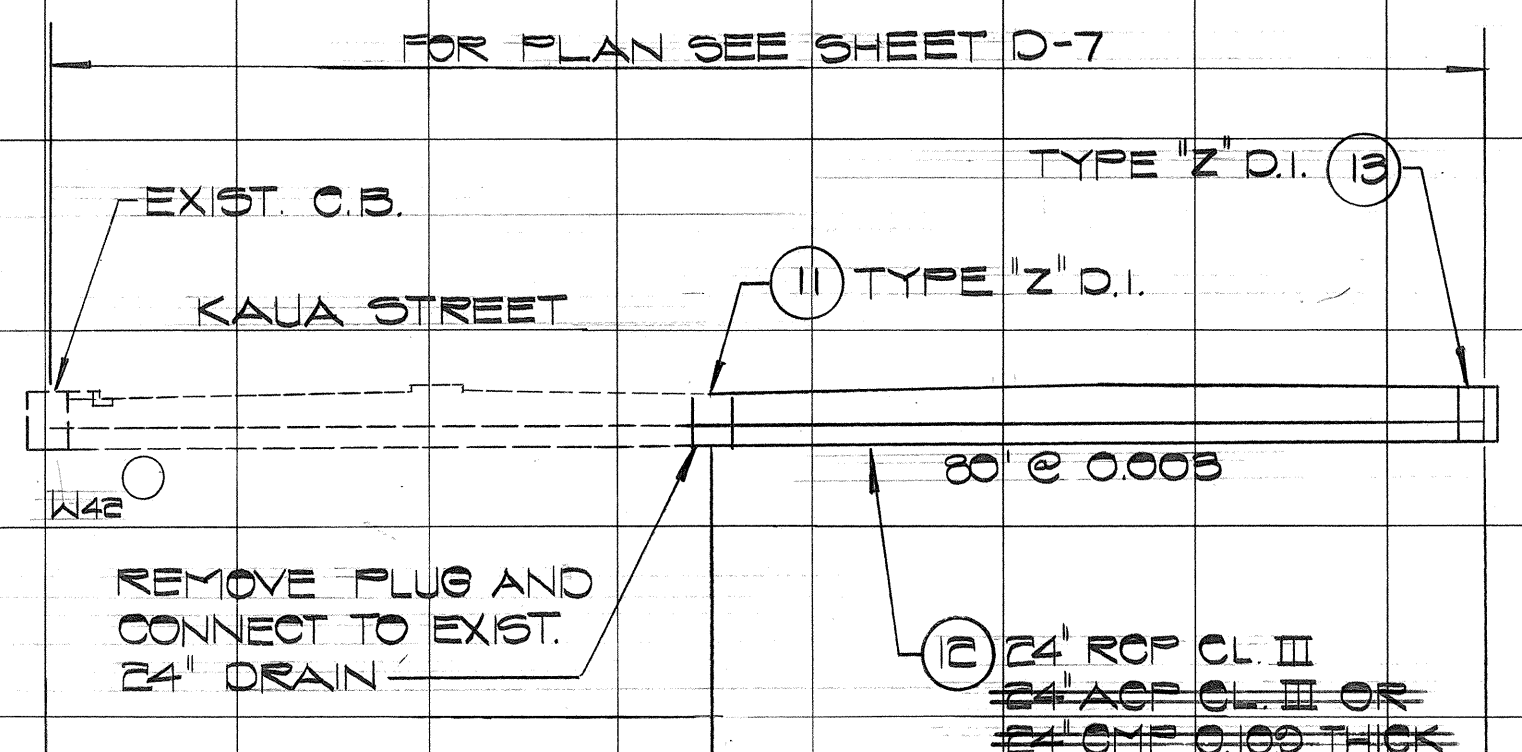

PROFILES

SCALES: 1" = 20'
1" = 20'

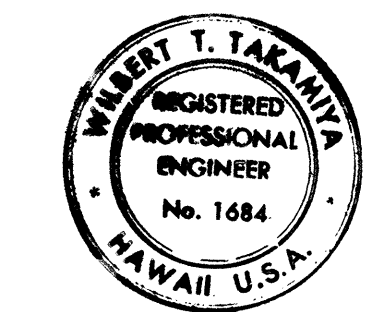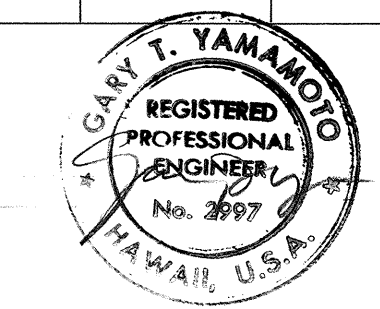

Wilbert T. Takamita
THIS WORK WAS PREPARED BY ME
OR UNDER MY SUPERVISION.

STATE OF HAWAII
DEPARTMENT OF TRANSPORTATION
HIGHWAYS DIVISION

DRAINAGE PROFILE
SYSTEMS "A," "C" & "I"

MOANALUA ROAD
PUULOA I.C. TO MIDDLE ST. - UNIT 3A
E.A. Proj. No. T&F-078-1(18)

SCALE: AS SHOWN DATE: NOV. 15, 1978

SHEET No. 3 OF 3 SHEETS

S U M M A R Y

FED. ROAD DIST. NO.	STATE	FED. AID PROJ. NO.	FISCAL YEAR	SHEET NO.	TOTAL SHEETS
HAWAII	HAW.	TQ-F-078-1(18)	078	53	266

[illegible]


S U M M A R Y

54


S U M M A R Y

55

FED. ROAD DIST. NO.	STATE	FED. AID PROJ. NO.	FISCAL YEAR	SHEET NO.	TOTAL SHEETS
HAWAII	HAW.	TQ-F-078-1(18)	1978	56	266

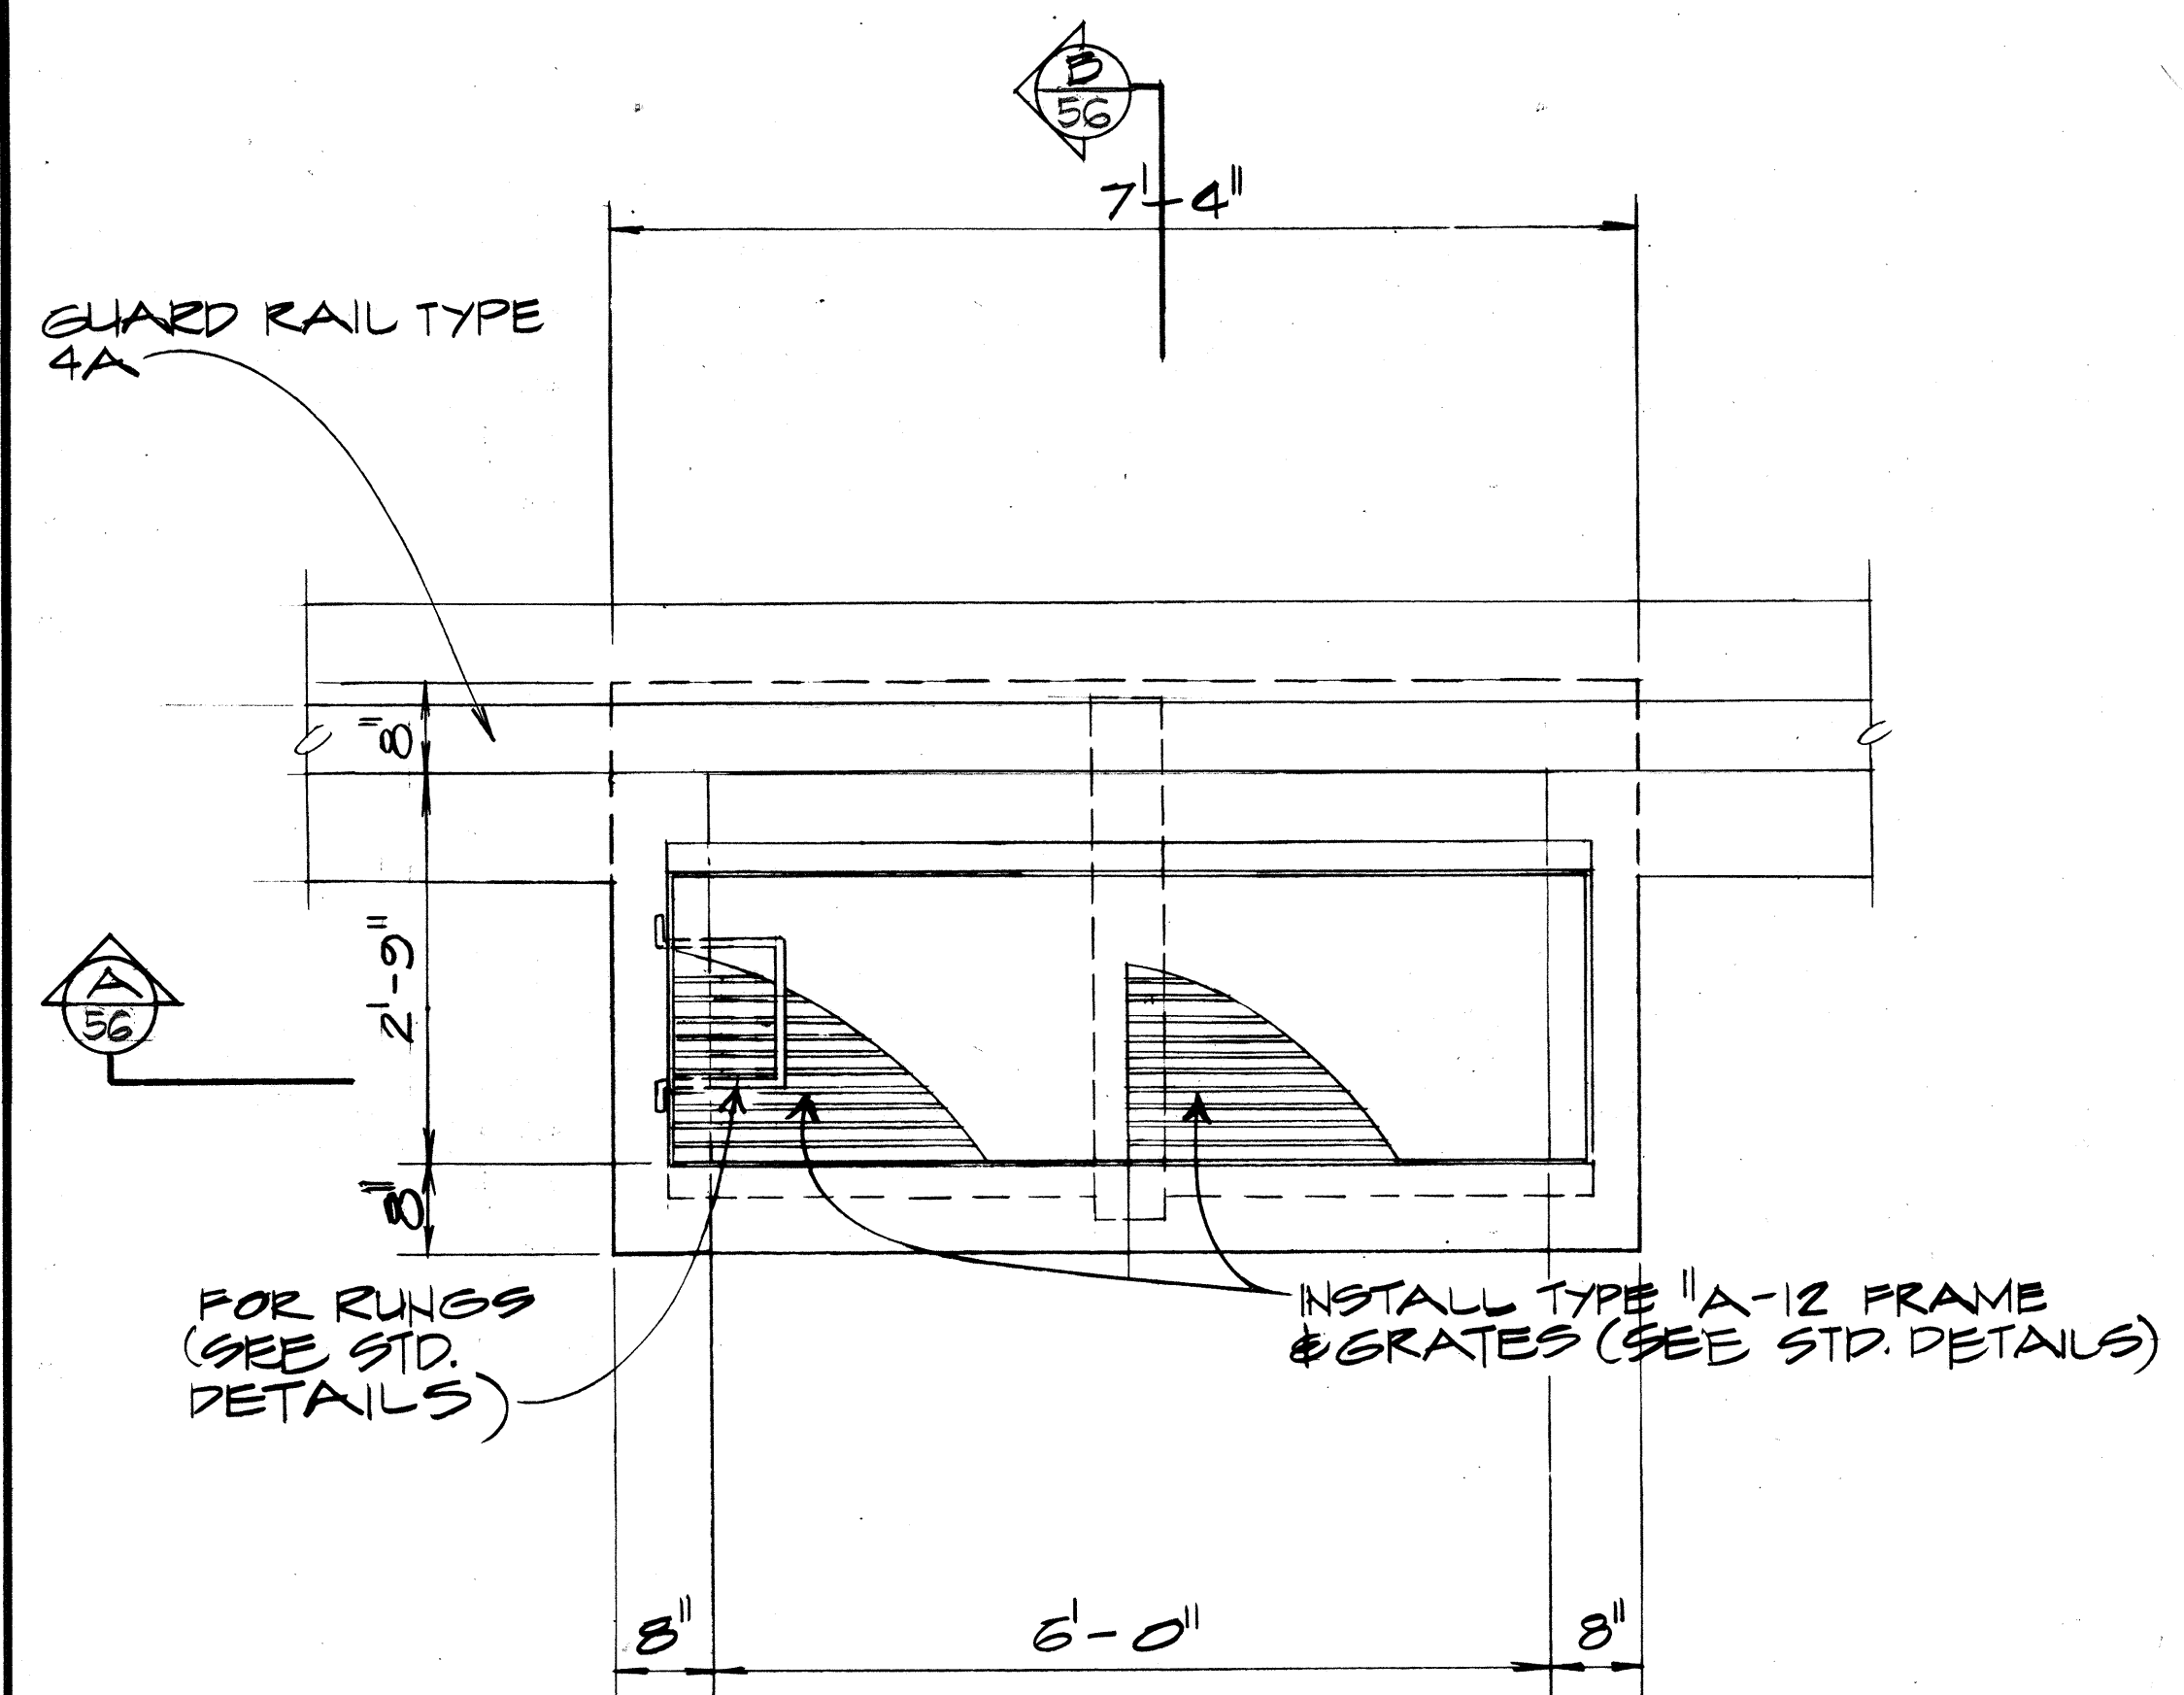


PLAN

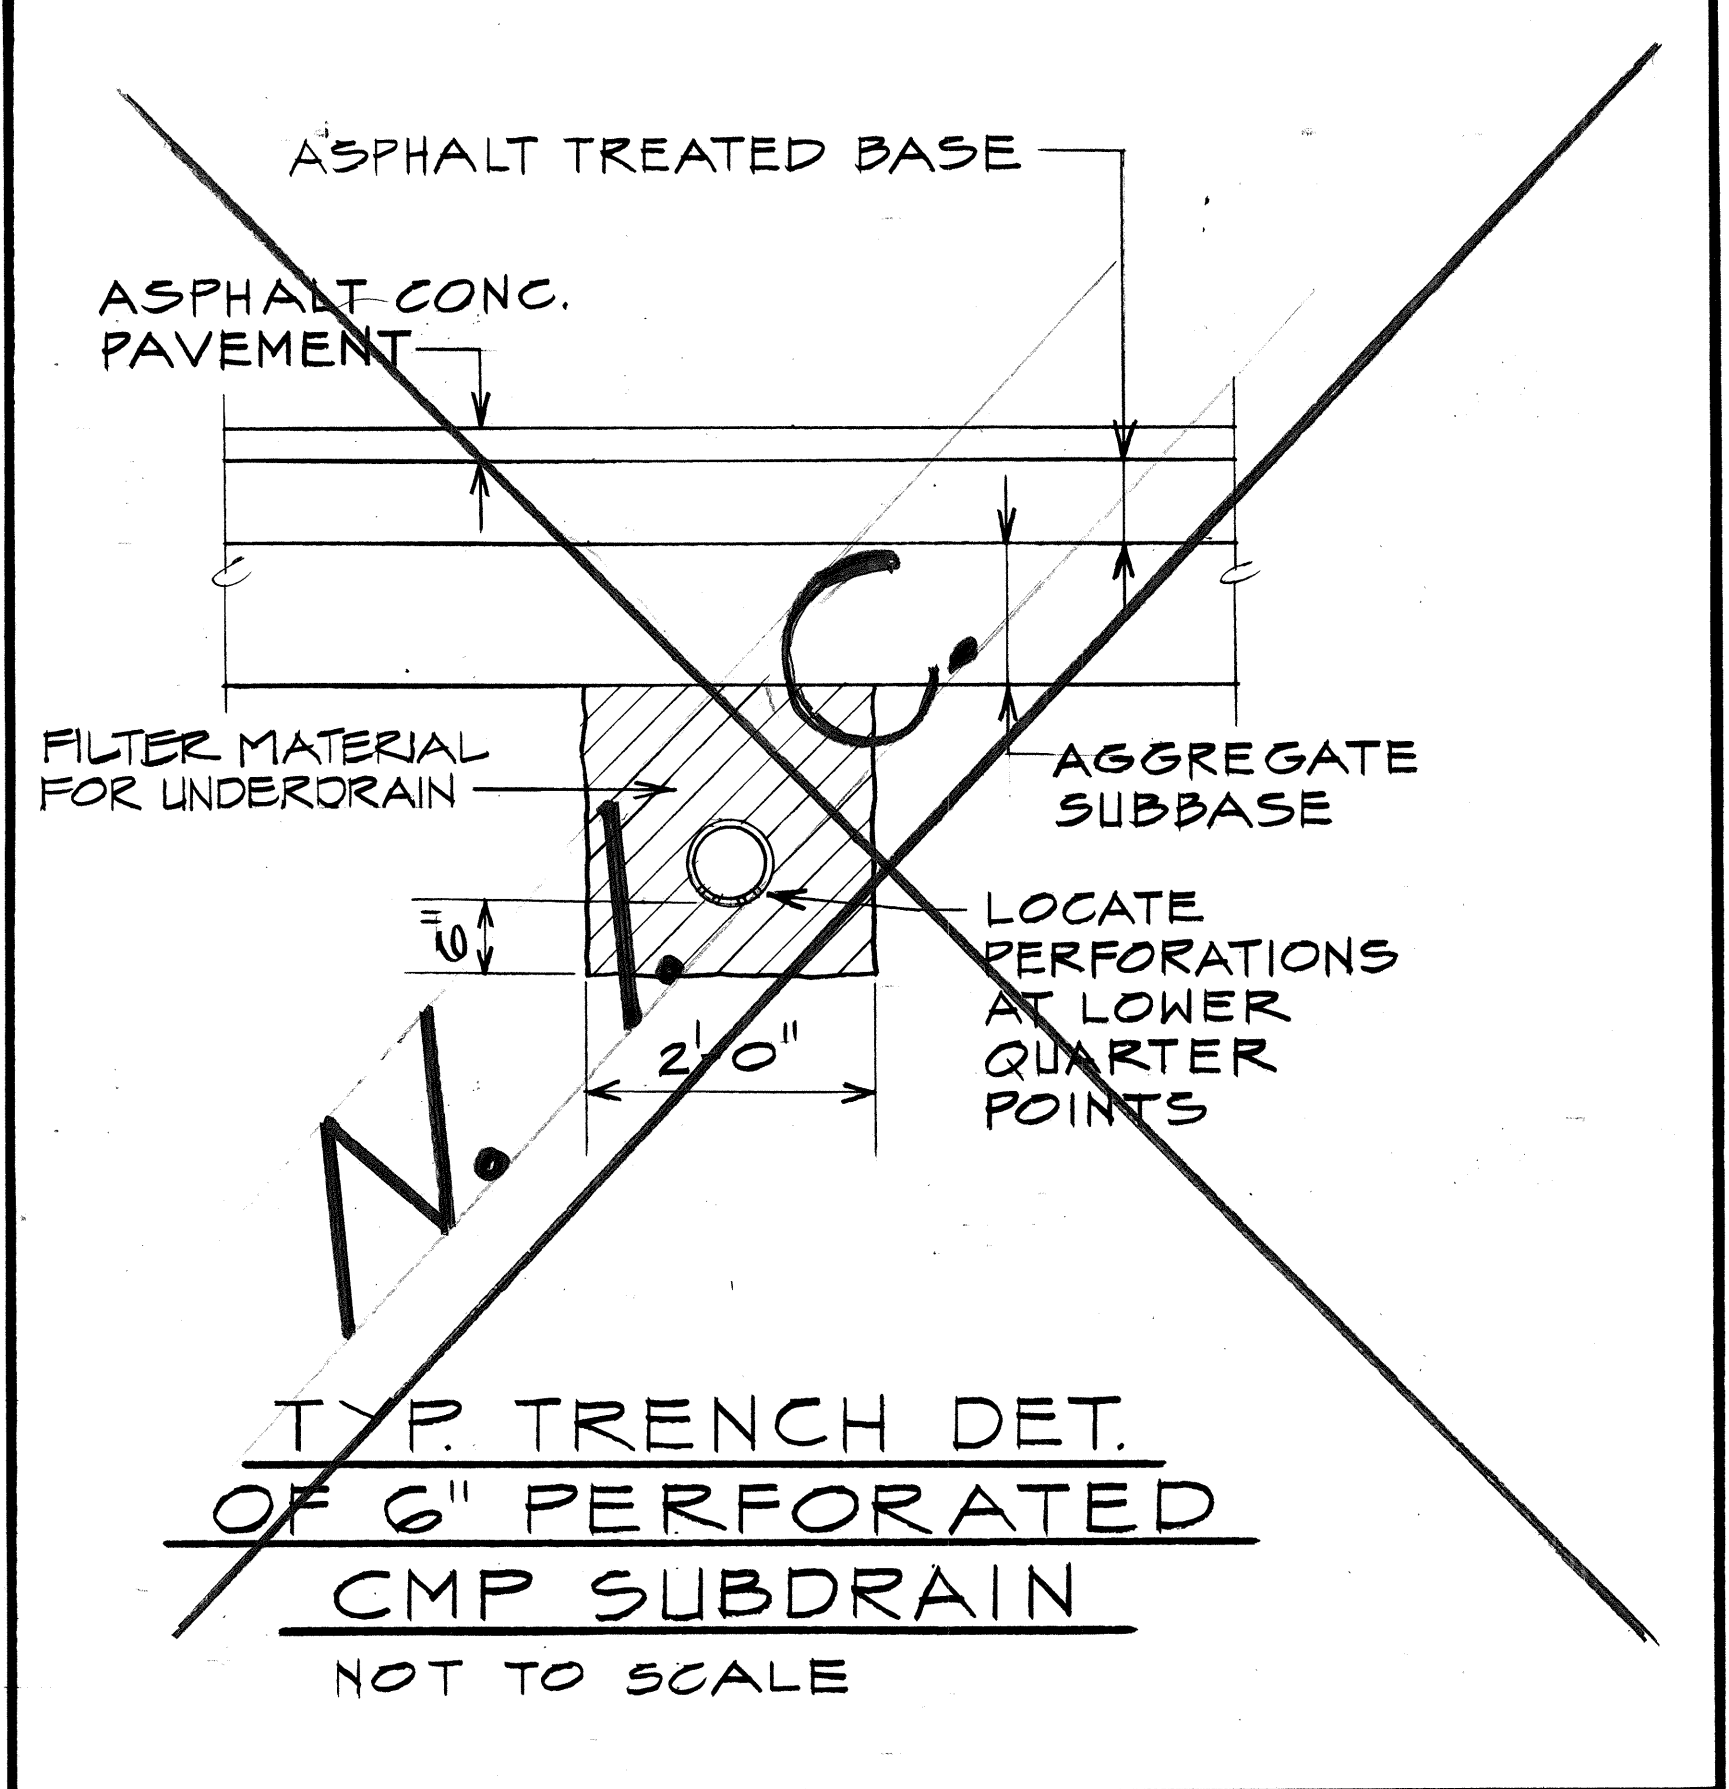


GENERAL NOTES:

1. PAYMENT FOR MISCELLANEOUS ITEMS SUCH AS ROCK SAND RUNGS ETC. IS TO BE INCIDENTAL TO CONCRETE FOR DRAINAGE SYSTEM.
2. RUNGS SHALL NOT BE INSTALLED OVER PIPE CONNECTIONS AND THE LOWEST RUNG SHALL NOT BE MORE THAN 24" ABOVE THE INVERT.
3. REINFORCED CONCRETE DESIGN DATA: $f'_c = 3,000$ PSI (28 DAYS)
 $f_y = 40,000$ PSI
DEFORMED BARS
4. FOR SPLICES NOT DETAILED, OVERLAP BARS 24 BAR DIAMETER OR 12" MINIMUM; STAGGER ALL SPLICES AS APPROVED BY THE ENGINEER.
5. UNLESS SHOWN OTHERWISE WALL REINFORCING BARS WILL BE #5 @ 12" O.C. MINIMUM BOTH DIRECTIONS CENTERED IN SLAB AND BENT INTO TOP SLAB WHERE APPLICABLE.
6. ALL VERTICAL WALL REINFORCING BARS TO BE BENT INTO TOP SLAB A MINIMUM OF 12".
7. BEND WALL REINFORCEMENT AROUND PIPE CULVERT WHERE APPLICABLE.
8. SLAB REINFORCEMENT TO BE CENTERED.
9. ALL CONCRETE SHALL BE CLASS "A" UNLESS OTHERWISE NOTED.

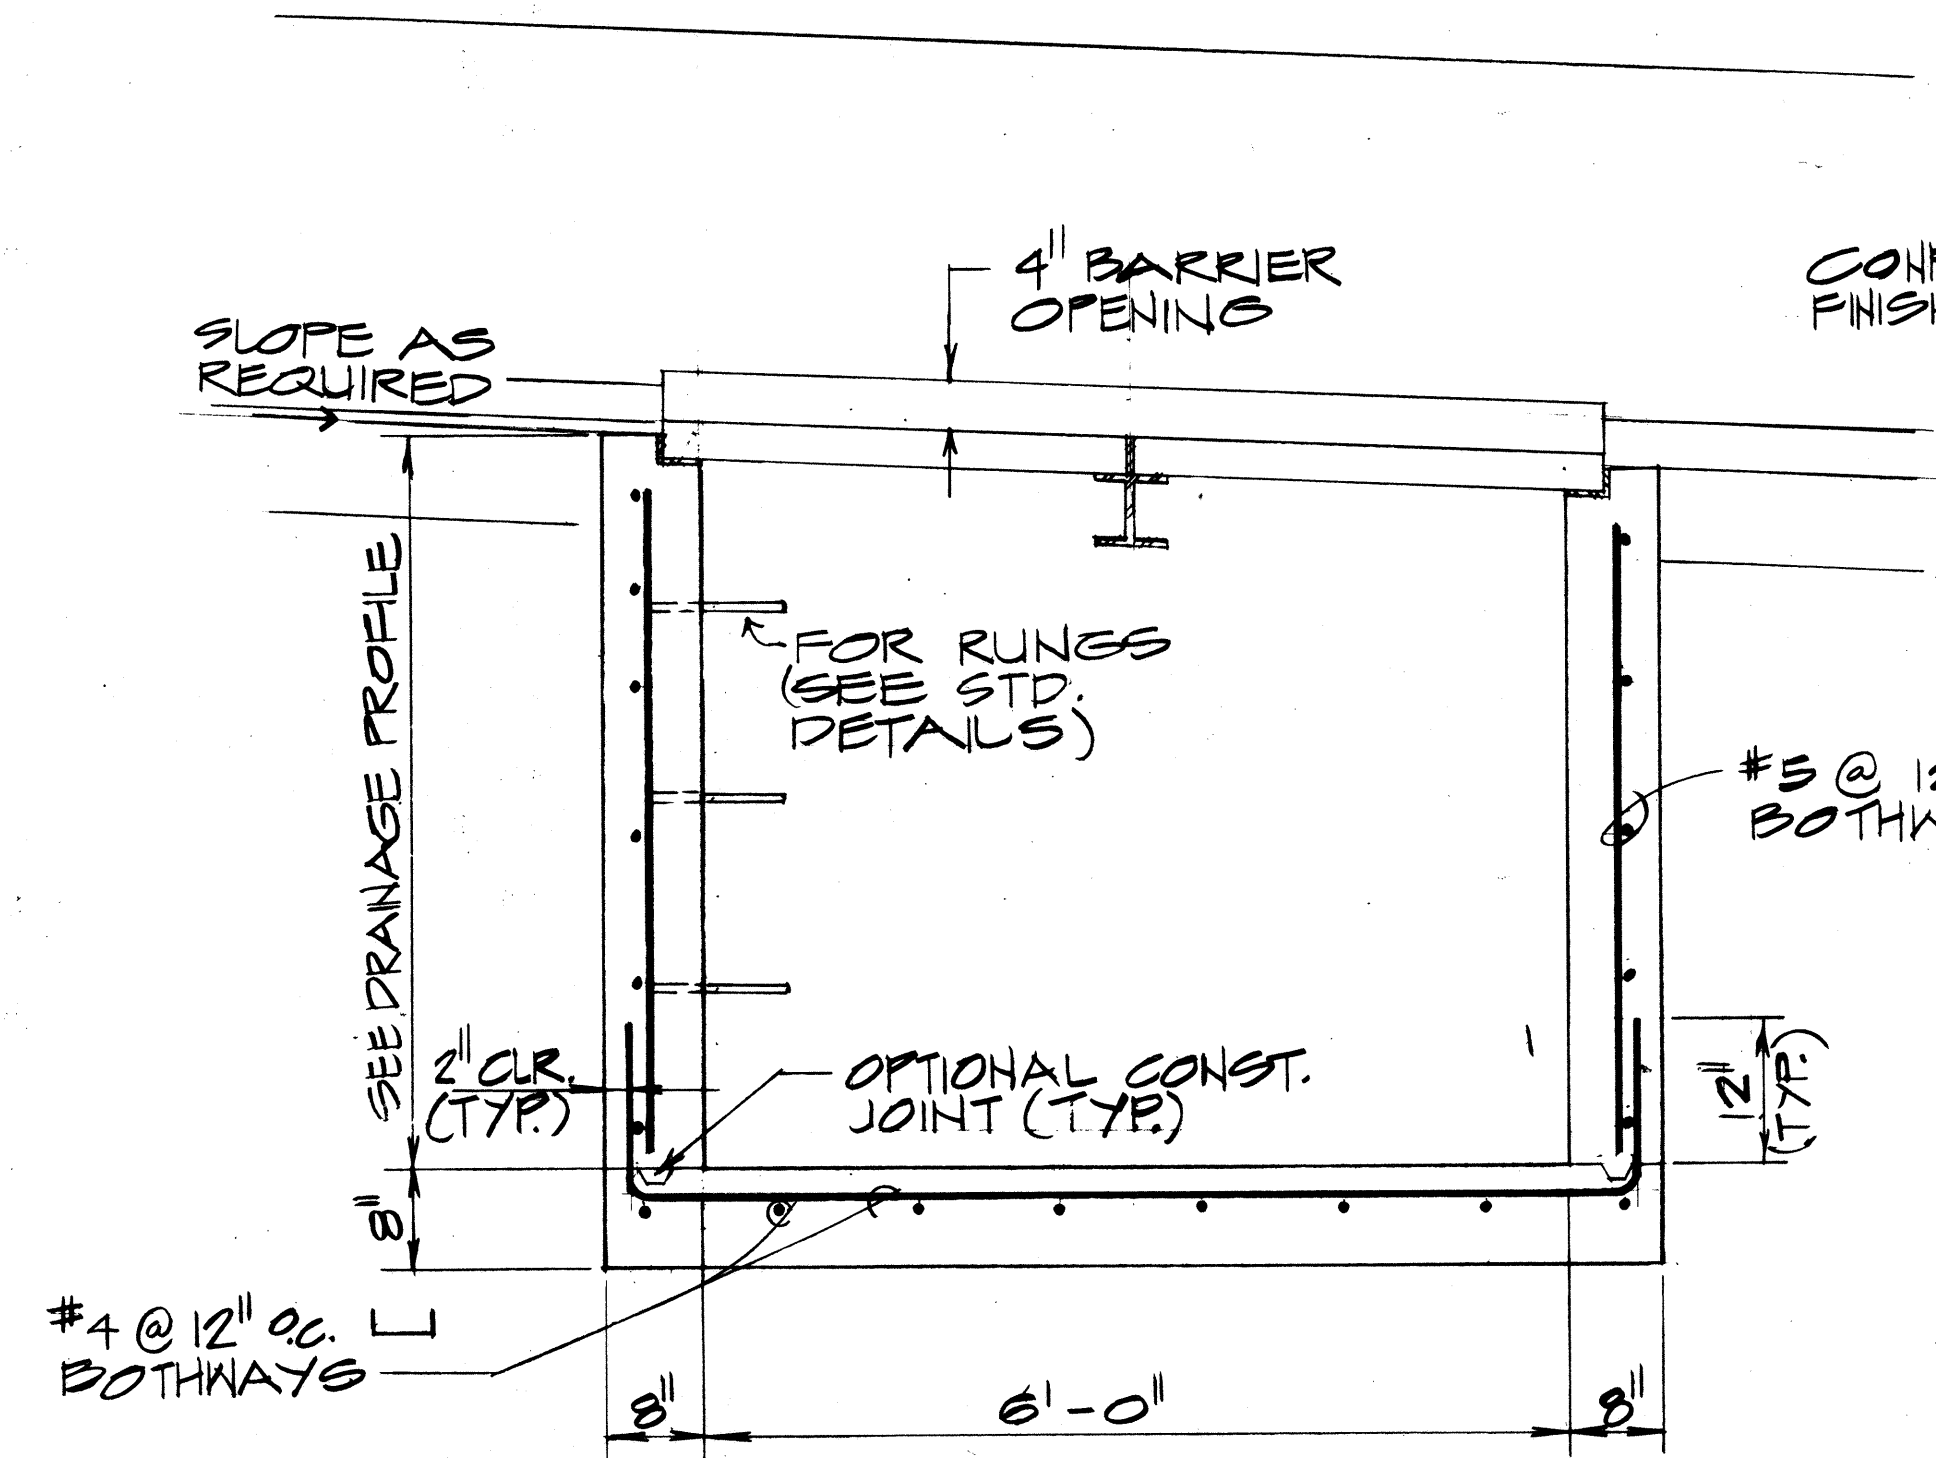


SECTION A


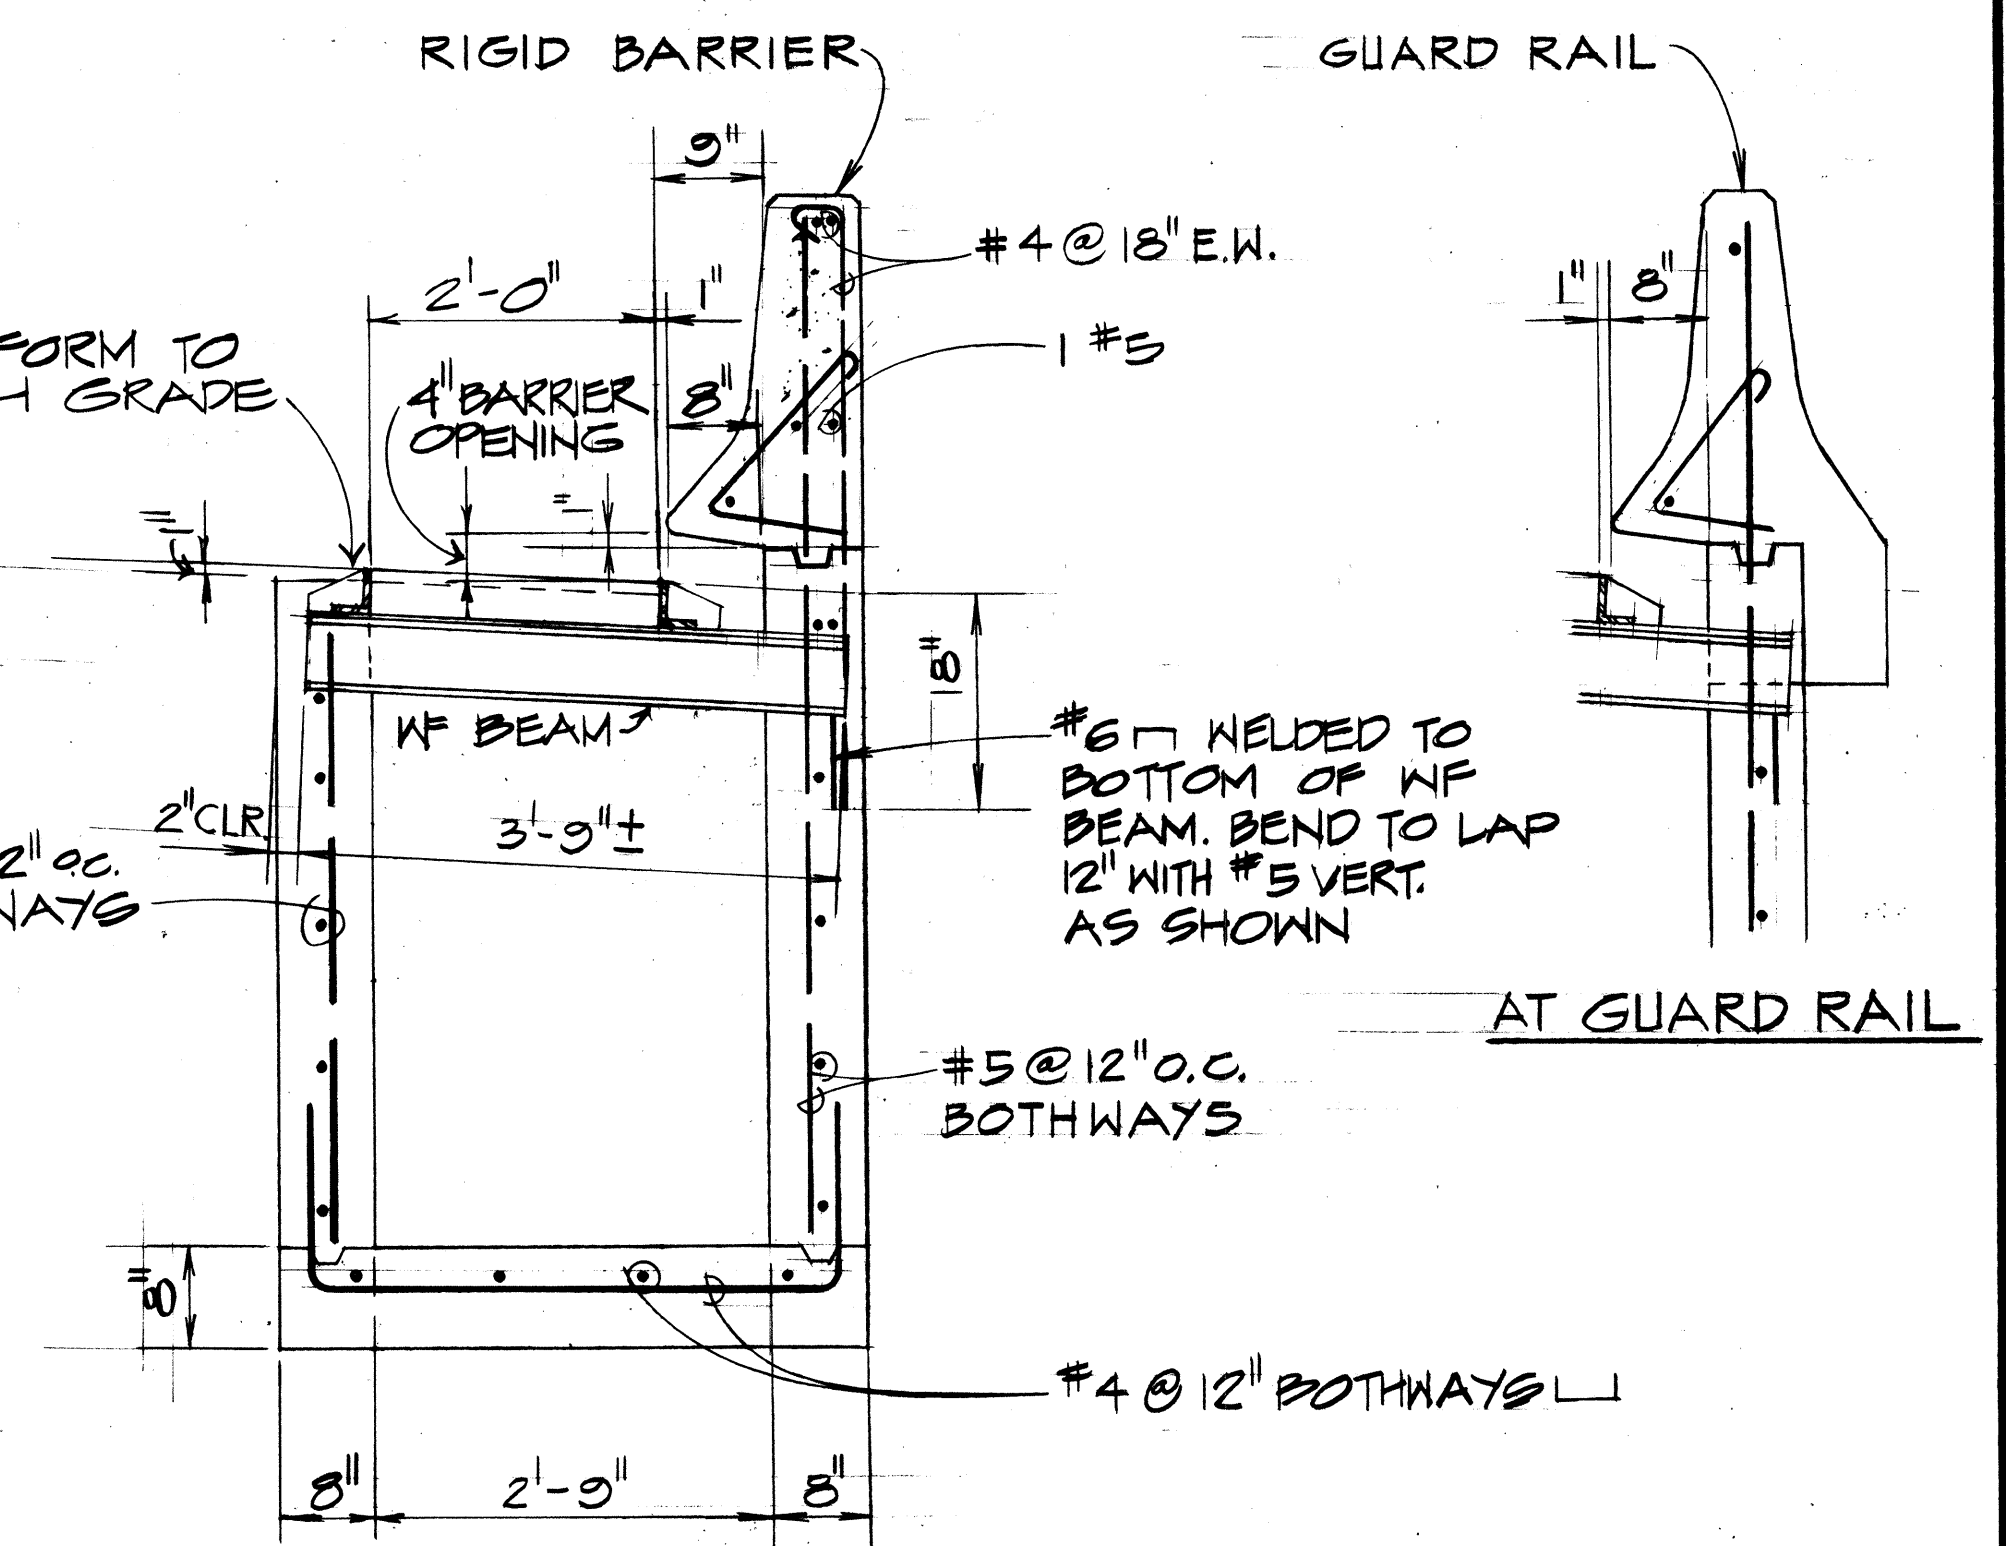


SECTION B

DROP INTAKE TYPE "Z"
SCALE: 3/4" = 1'-0"

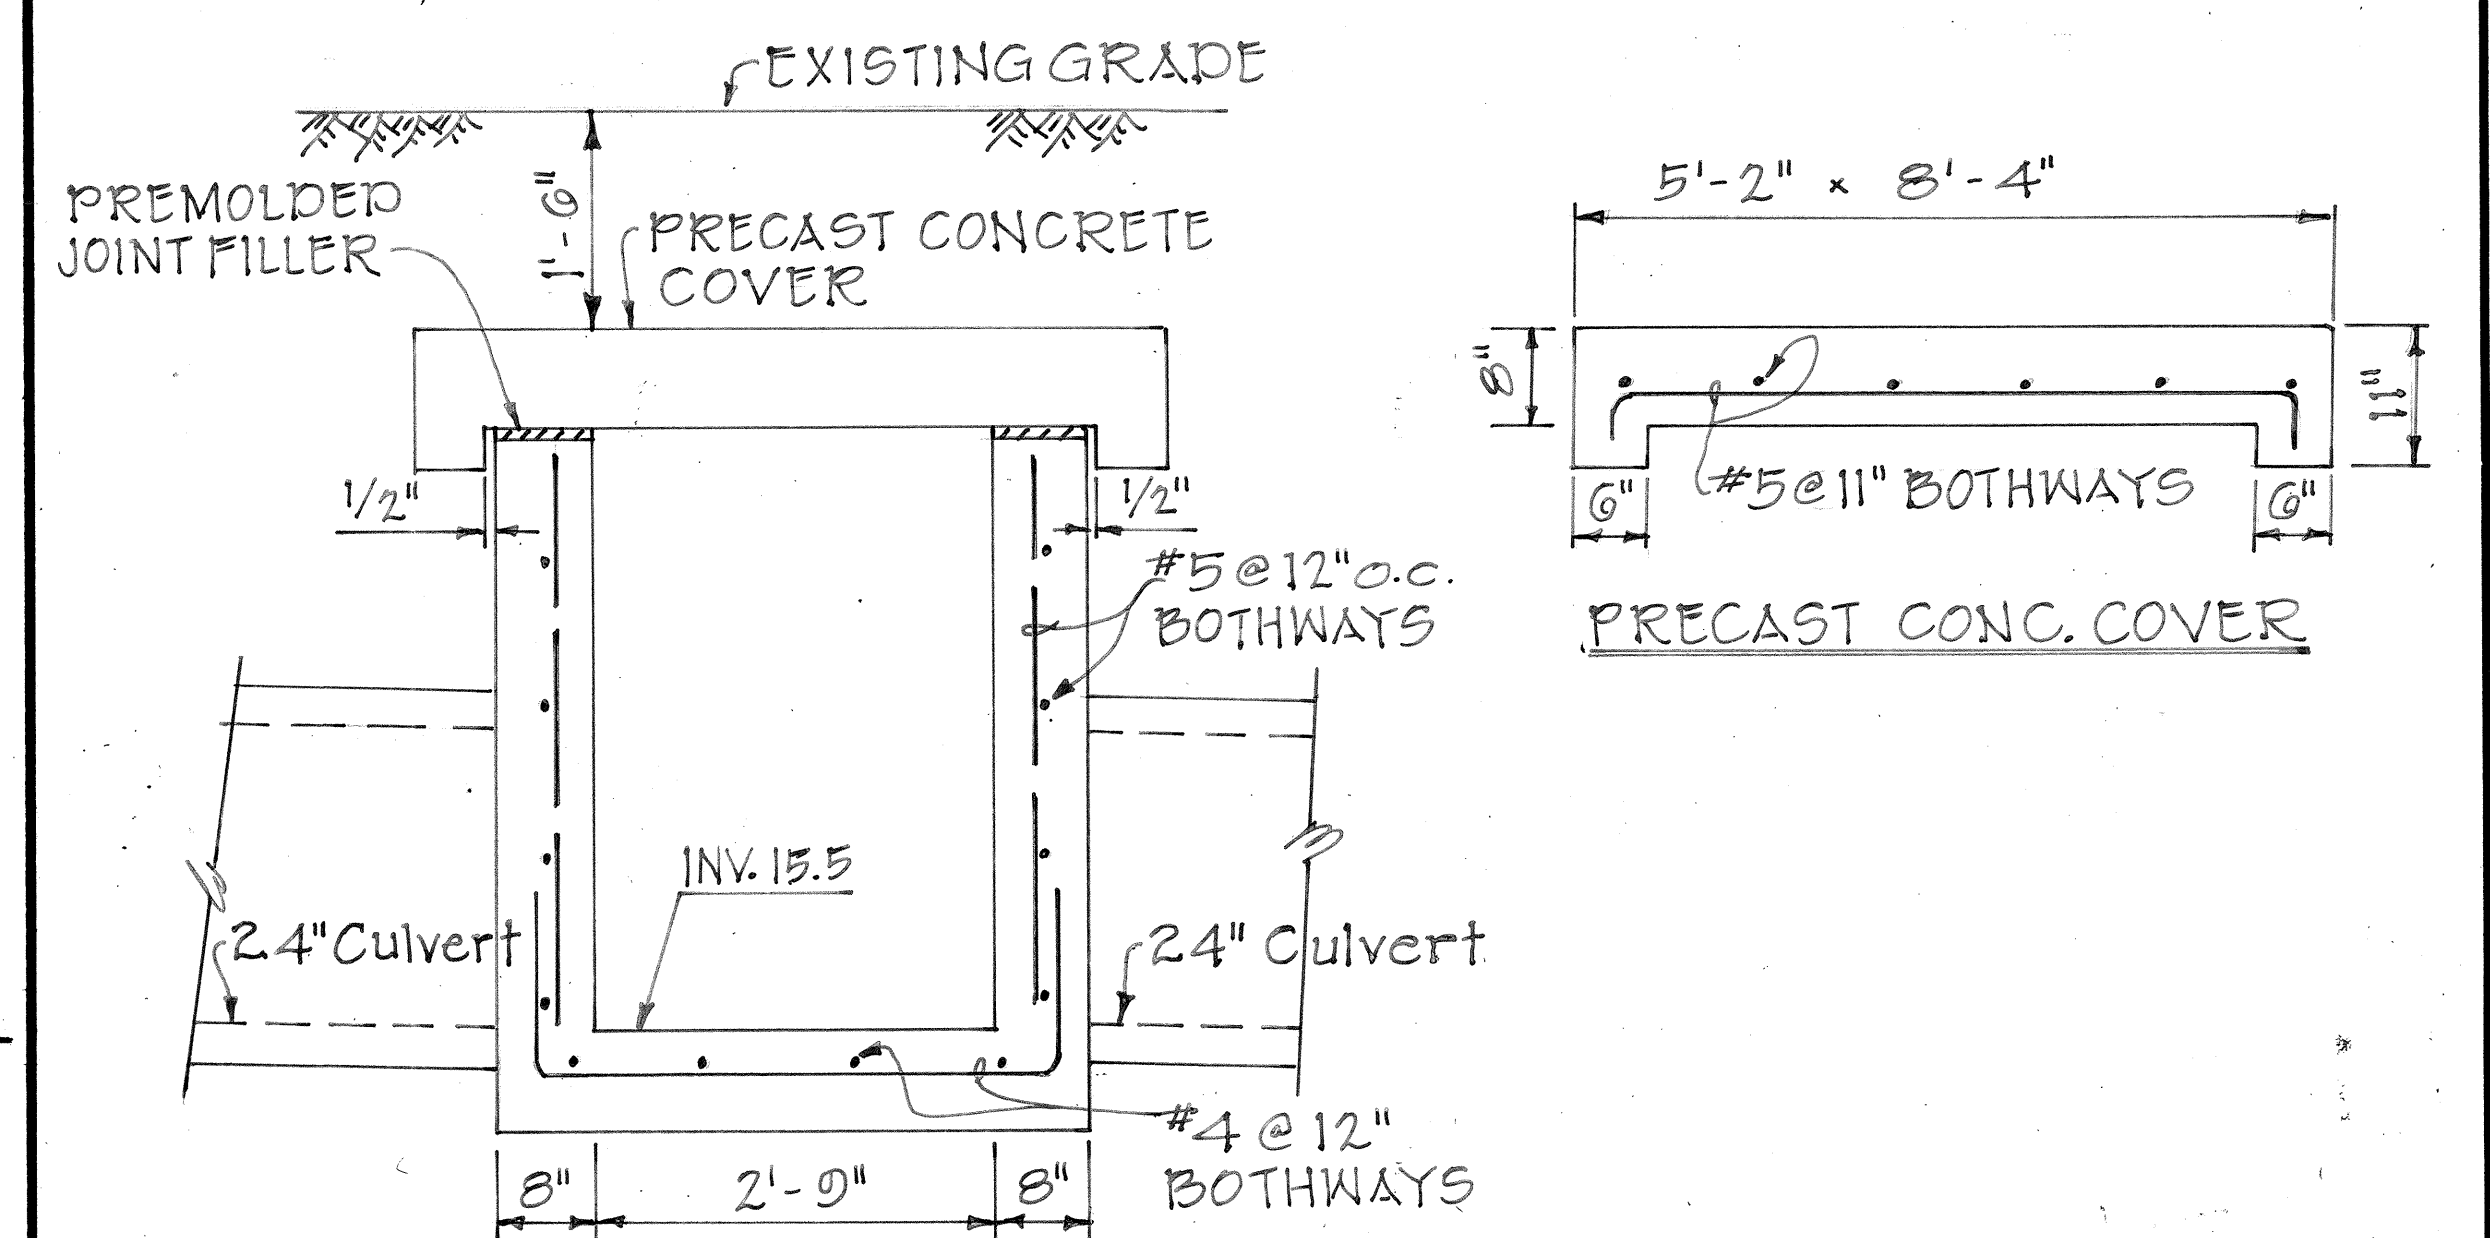

DROP INTAKE TYPE "Z" MODIFICATION FOR CONC. COVER
E.C. STA. 136+50
Scale: 3/4" = 1'-0"

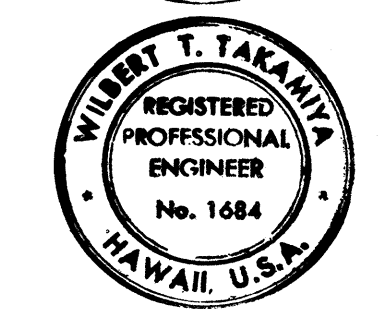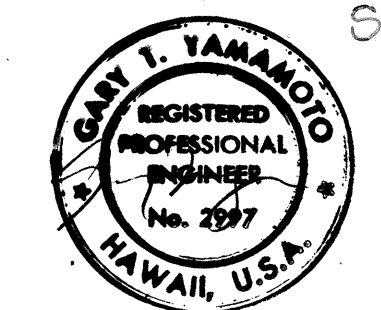

THIS WORK WAS PREPARED BY ME OR UNDER MY SUPERVISION.


STATE OF HAWAII
DEPARTMENT OF TRANSPORTATION
HIGHWAYS DIVISION

DRAINAGE DETAILS


MOANALUA ROAD
PUULOA I.C. TO MIDDLE ST. - UNIT 3A
F.A. PROJ. NO. TQ-F-078-1(18)

SCALE: AS SHOWN DATE: NOV. 15, 1978
SHEET NO. 1 OF 10 SHEETS

FED. ROAD DIST. NO.	STATE	FED. AID PROJ. NO.	FISCAL YEAR	SHEET NO.	TOTAL SHEETS
HAWAII	HAW.	TQ-F-078-1	1978	57	266

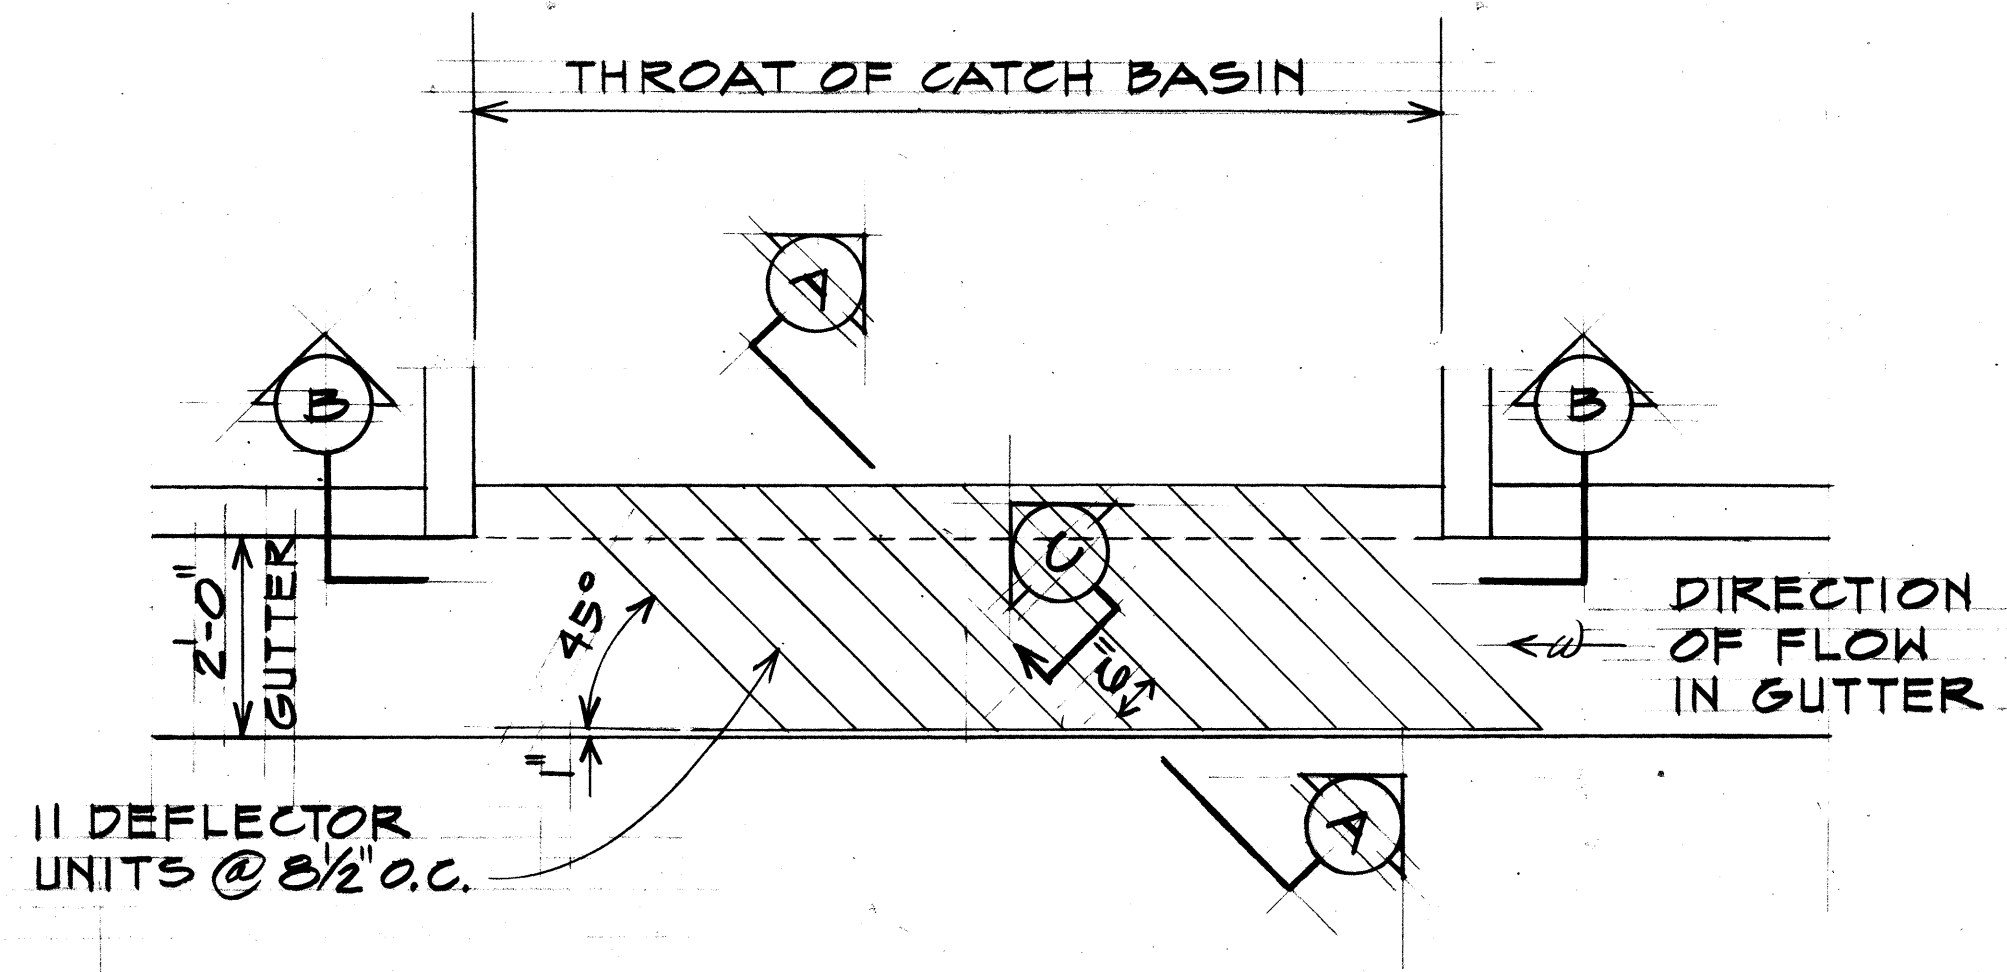


PLAN

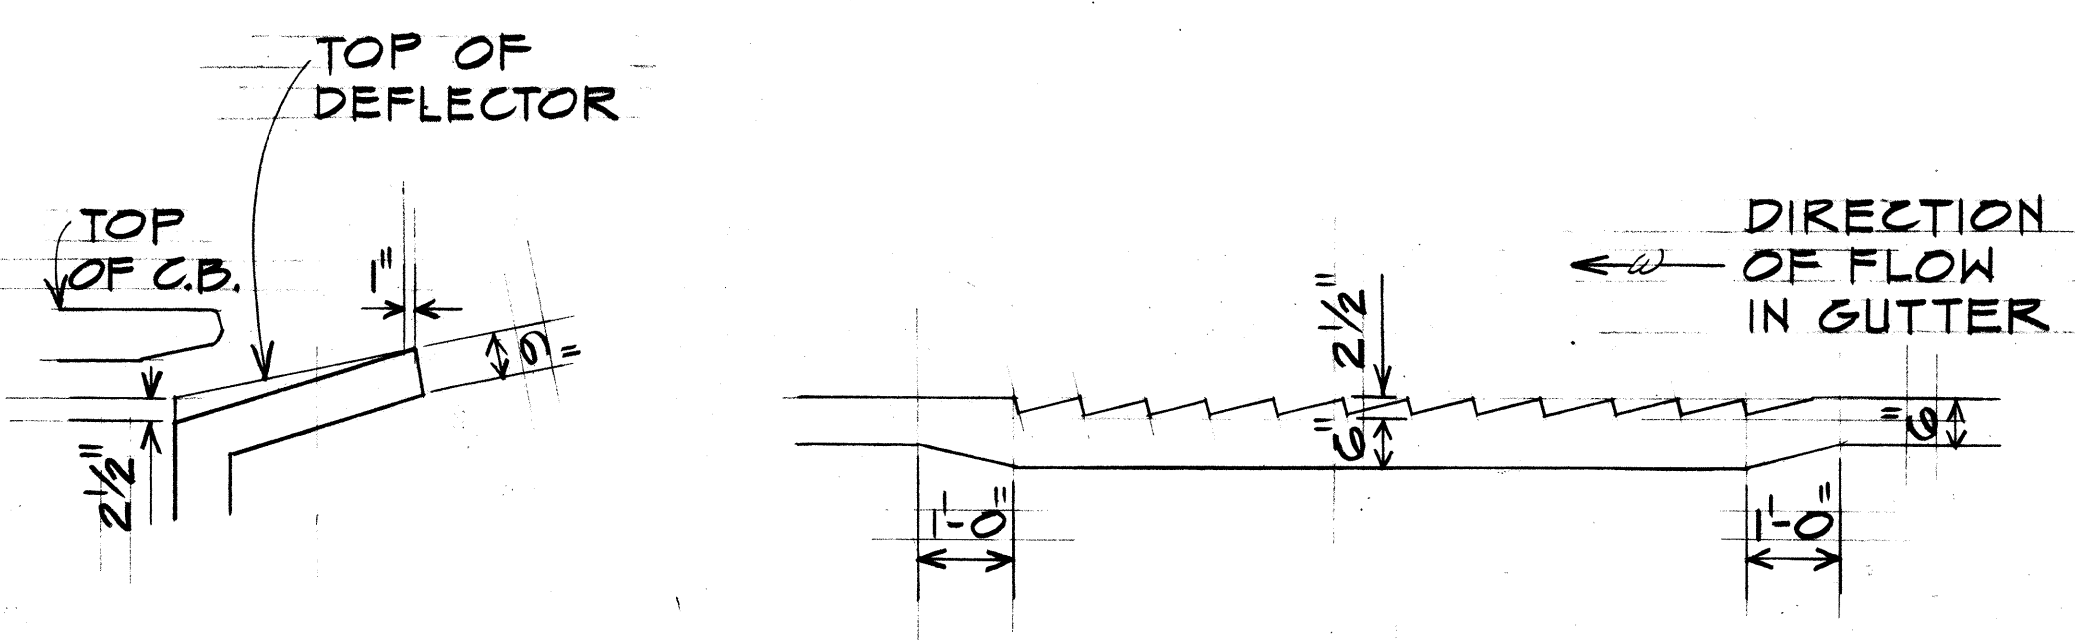


SECTION (A)

SECTION (B)

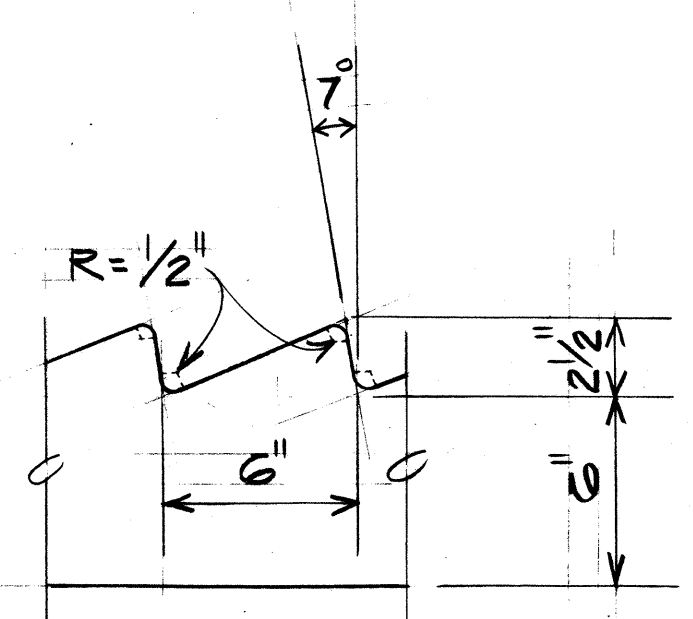


SECTION (C)

CATCH BASIN DEFLECTOR DETAILS
NOT TO SCALE

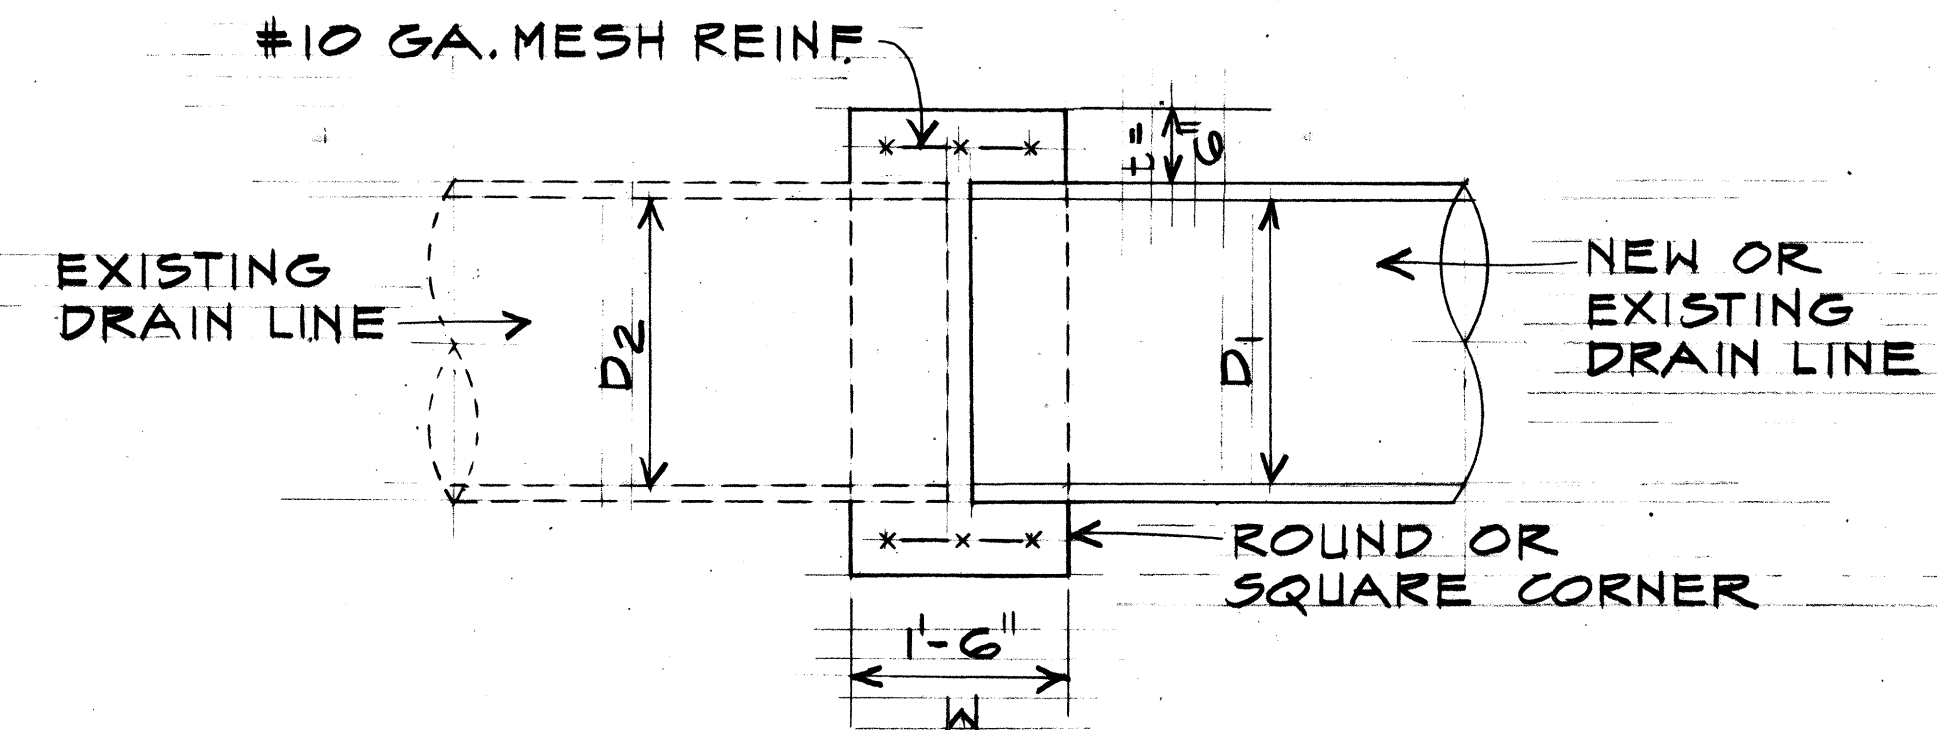



- NOTES:**
1. DRAIN LINE D₁ AND D₂ MAY BE OF DIFFERENT SIZE AND TYPE.
 2. COLLAR INSTALLATION TO BE INCIDENTAL TO PIPE COST.
 3. FOR DRAIN LINE CONNECTION TO EXISTING DRAIN BOX MAKE CONCRETE COLLAR t=6", w=6" WITH MESH REINFORCING.

CONCRETE COLLAR CONNECTION
SCALE: 3/4" = 1'-0"

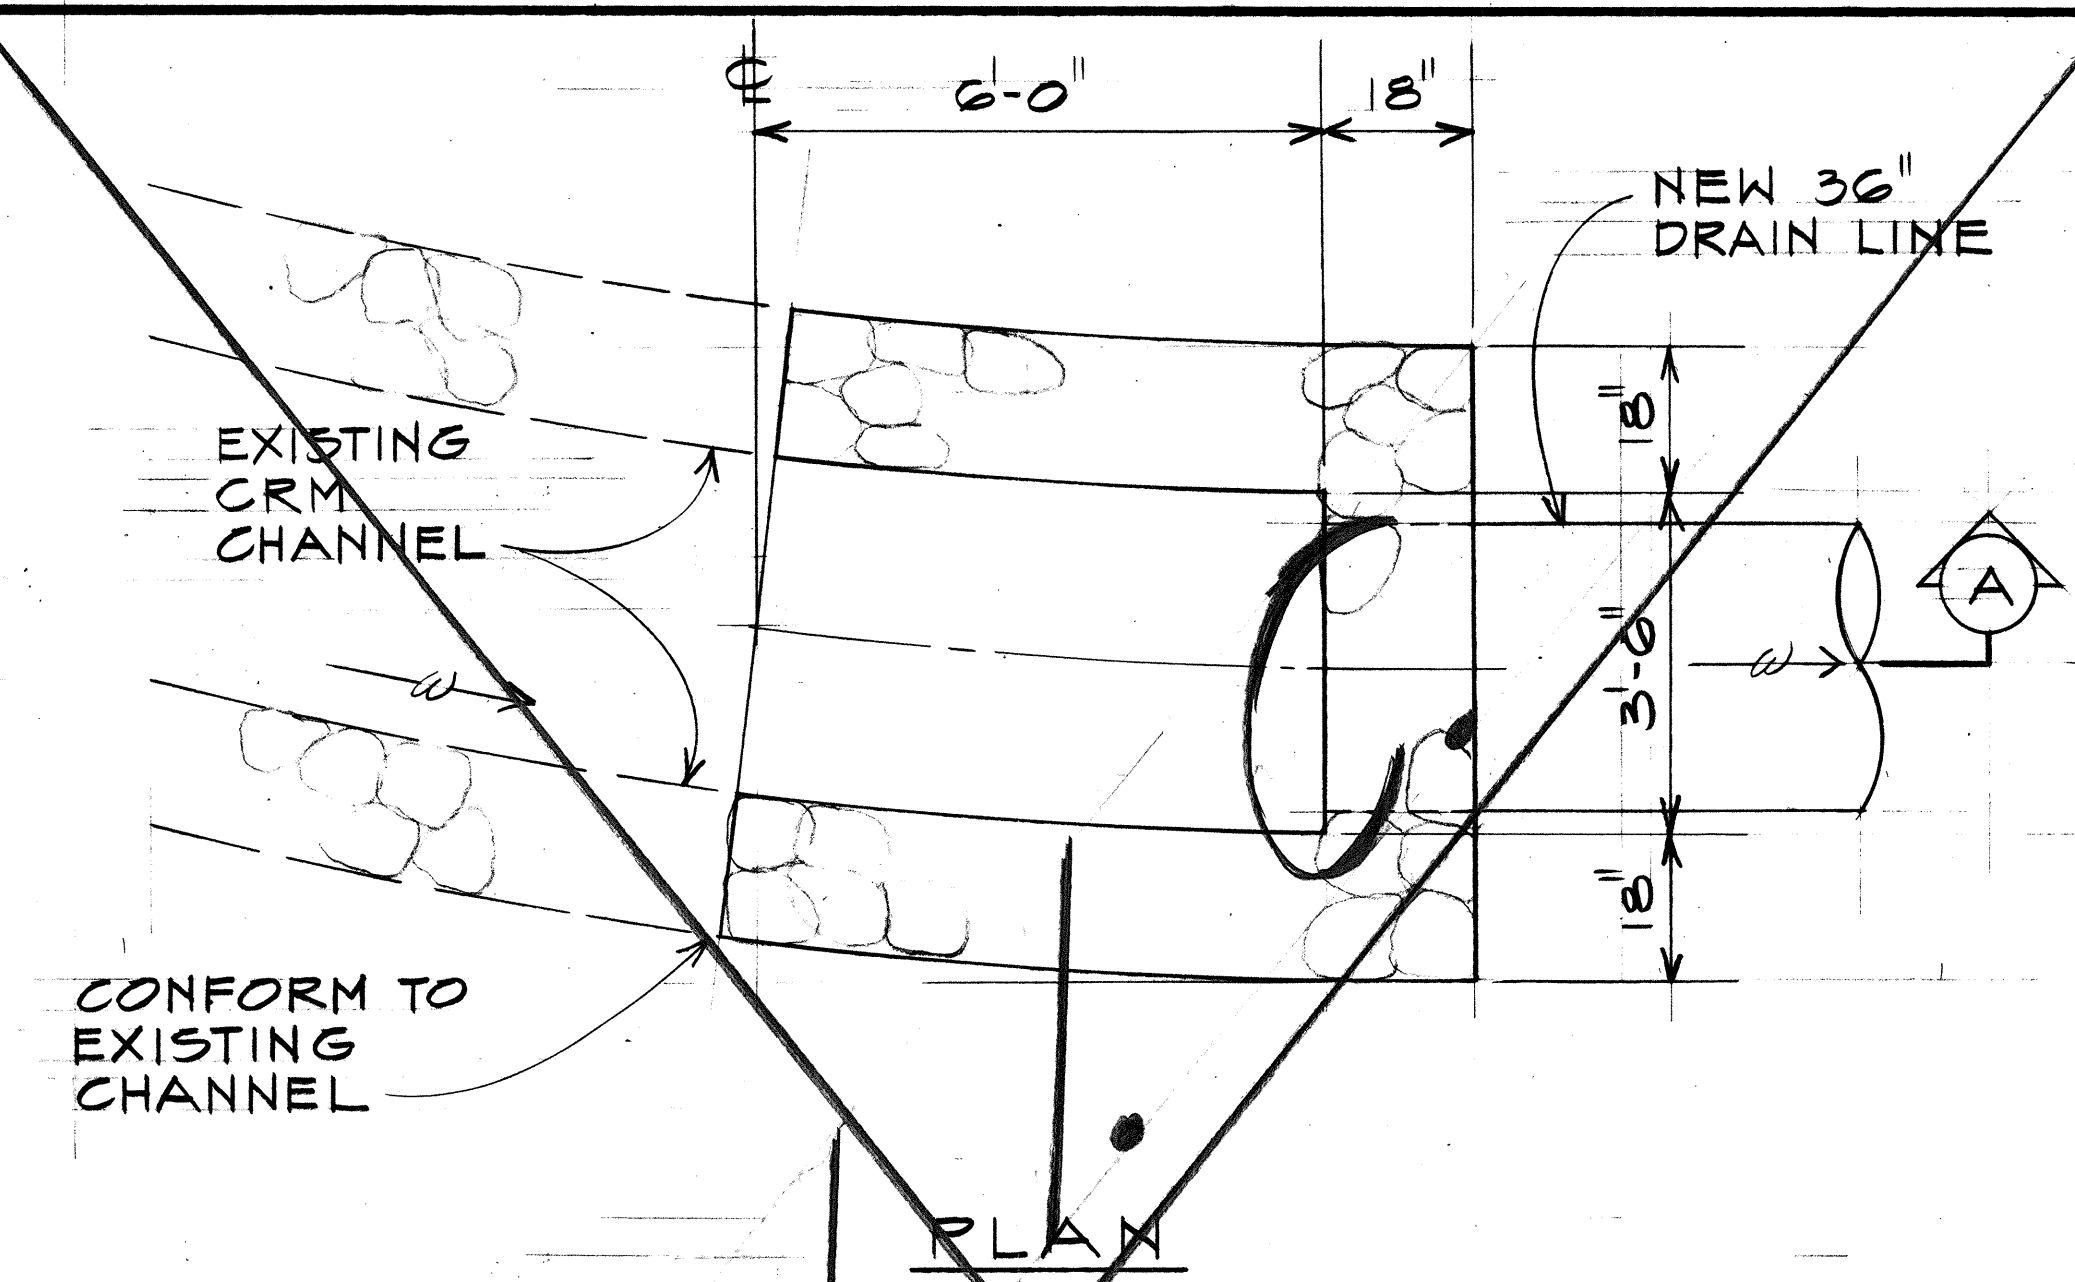


SECTION (A)

INLET SYSTEM "I"
FOR LOCATION SEE SHEET D-
SCALE: 1/2" = 1'-0"

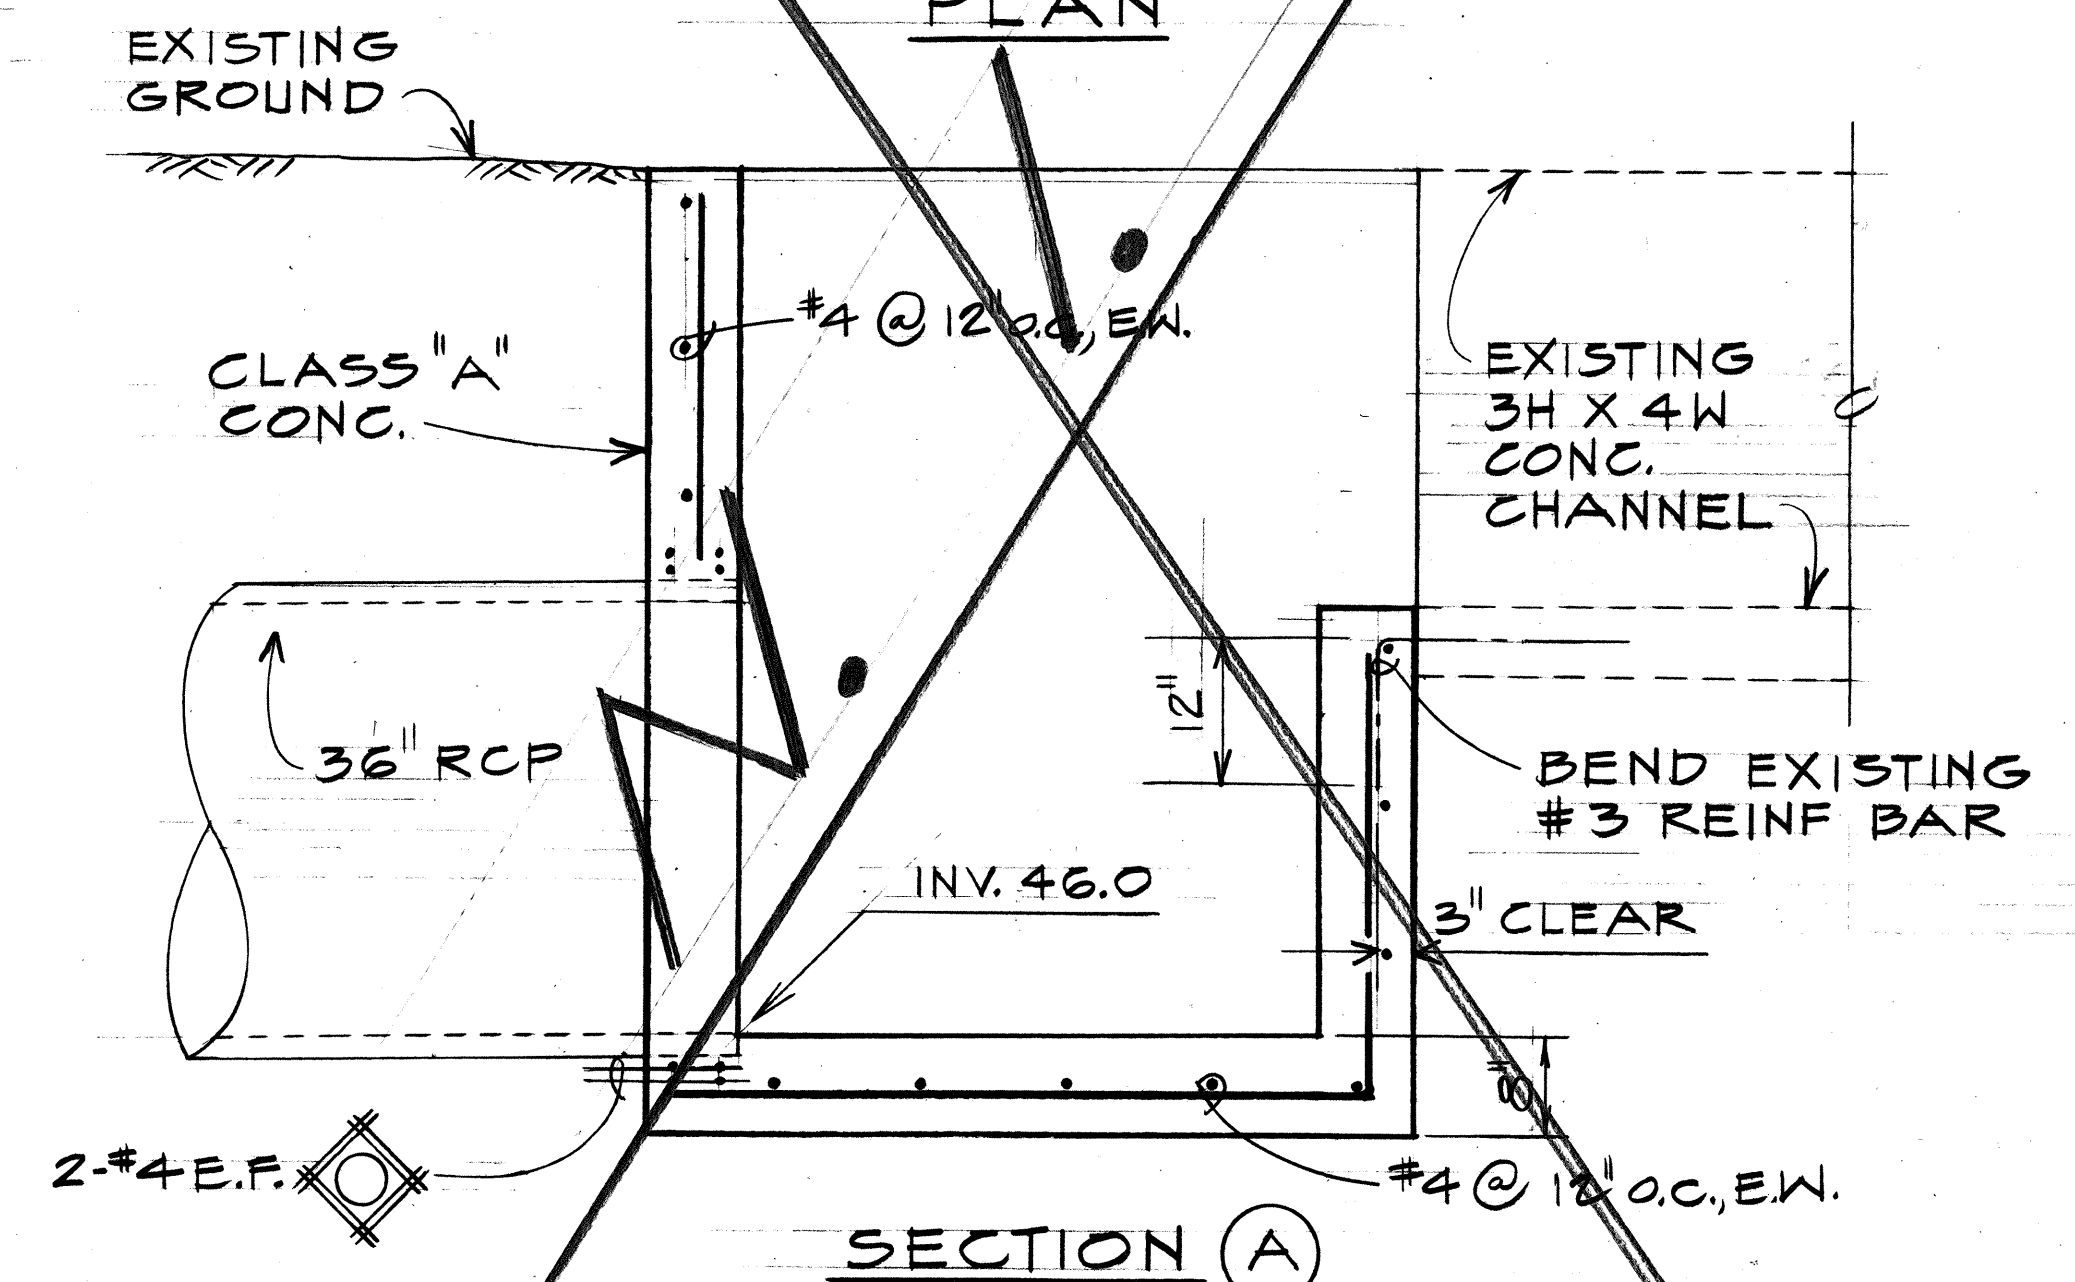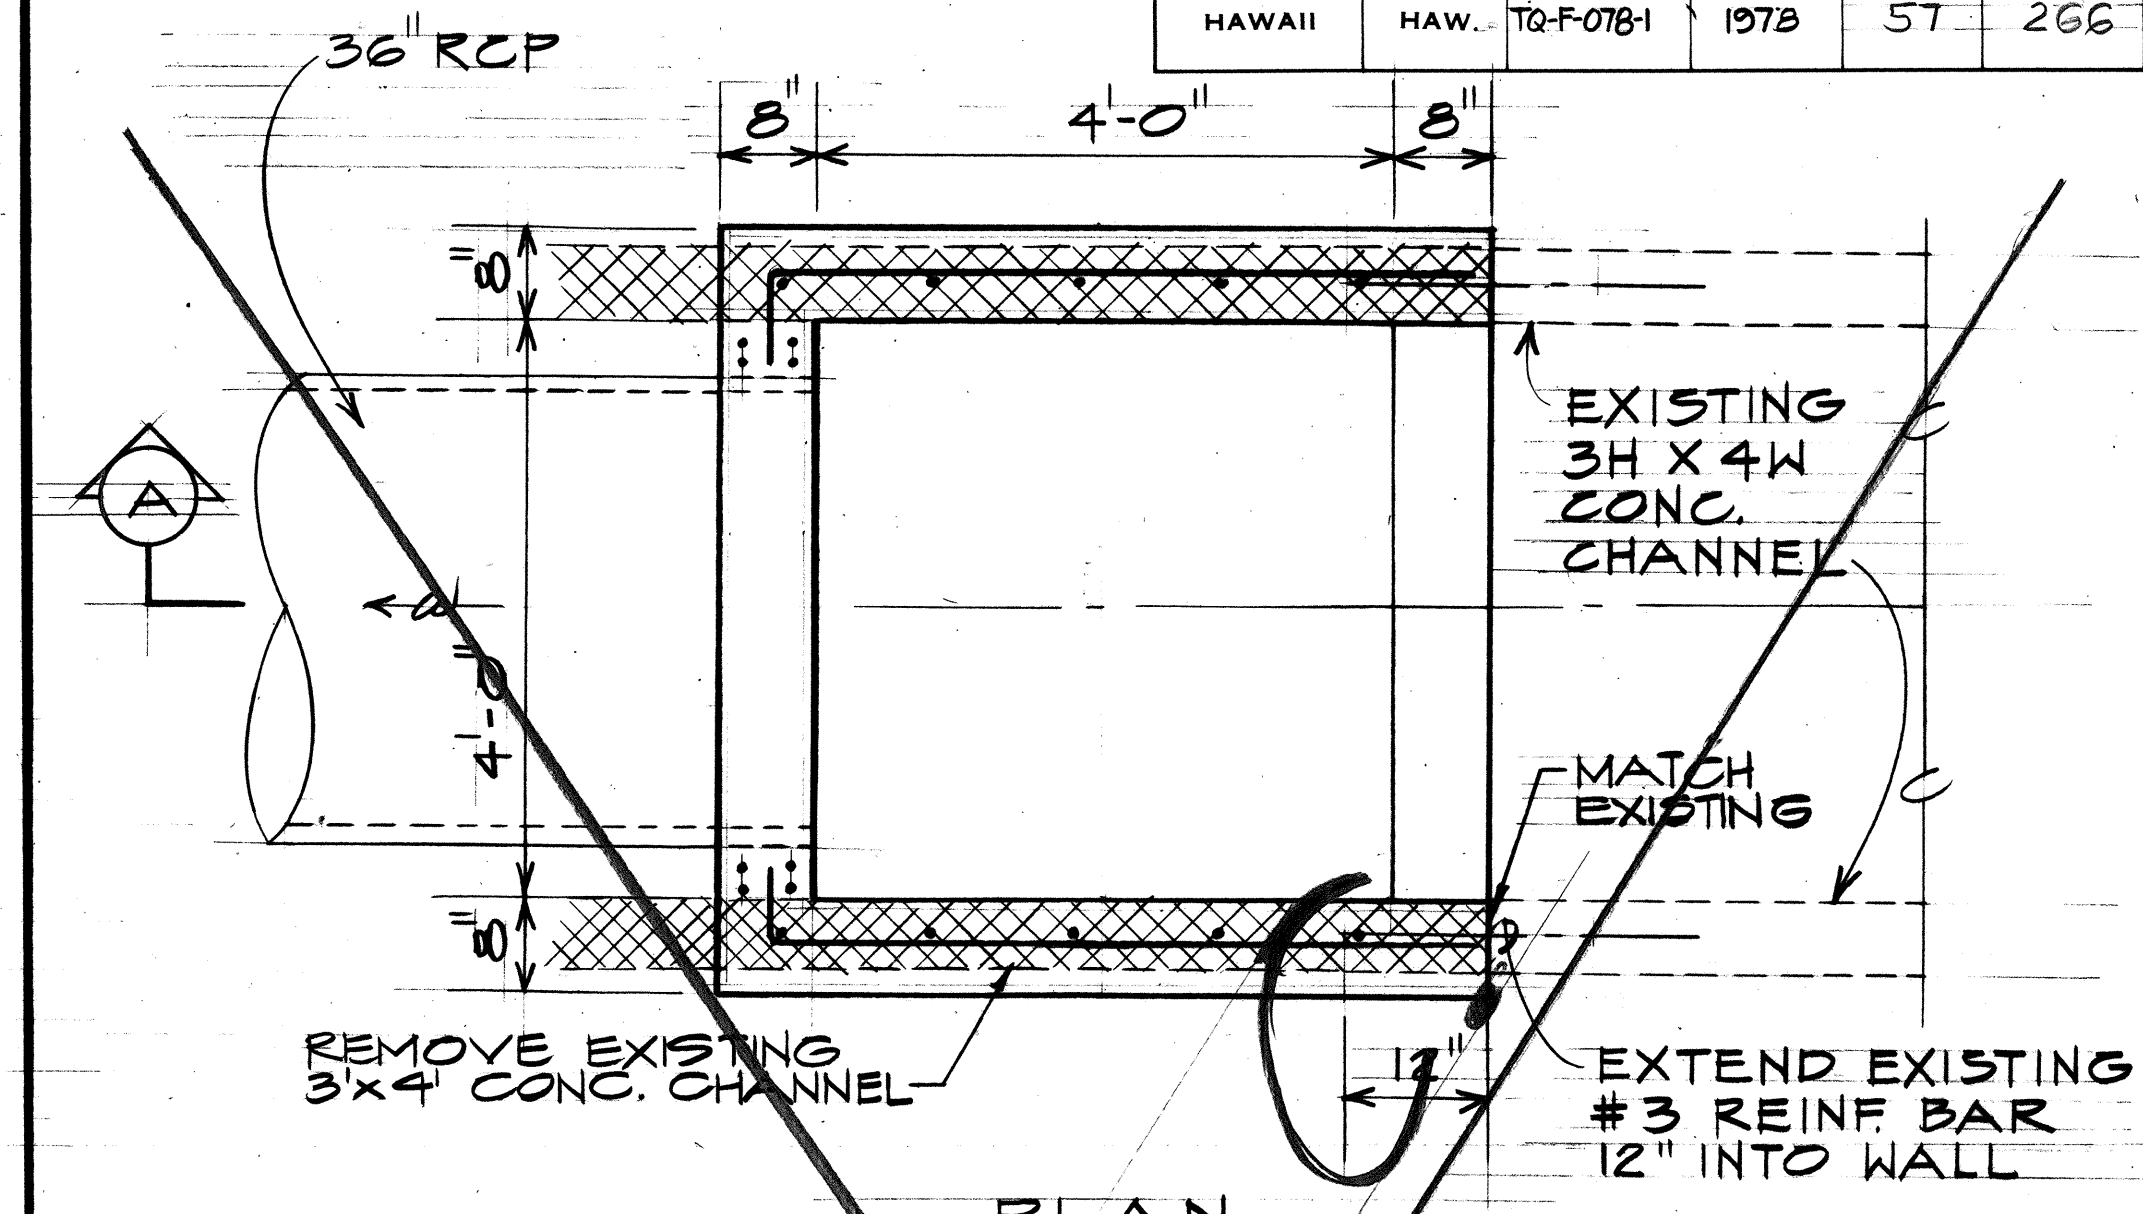

INLET SYSTEM "J"
FOR LOCATION SEE SHEET D-
SCALE: 3/4" = 1'-0"

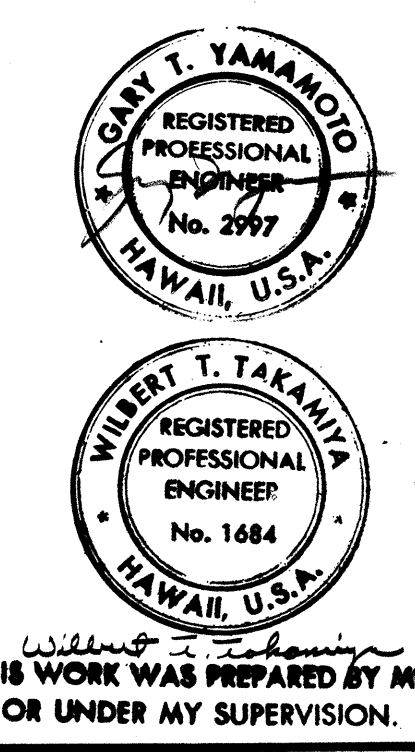

STATE OF HAWAII
DEPARTMENT OF TRANSPORTATION
HIGHWAYS DIVISION








DRAINAGE DETAILS

MOANALUA ROAD
PUULOLO I.C. TO MIDDLE ST. - UNIT 3
F.A. Proj. No. TQ-F-078-1(18)

SCALE: AS SHOWN DATE: NOV. 15, 1978

SHEET NO. 2 OF 10 SHEETS

ORIGINAL PLAN	SURVEY PLOTTED BY.....DATE.....	
	DESIGNED BY <u>G. M.</u>	
NOTE BOOK	DRAWN BY <u>J. Y.</u>	
	TRACED BY.....	
	QUANTITIES BY.....	
	CHECKED BY.....	
No.		

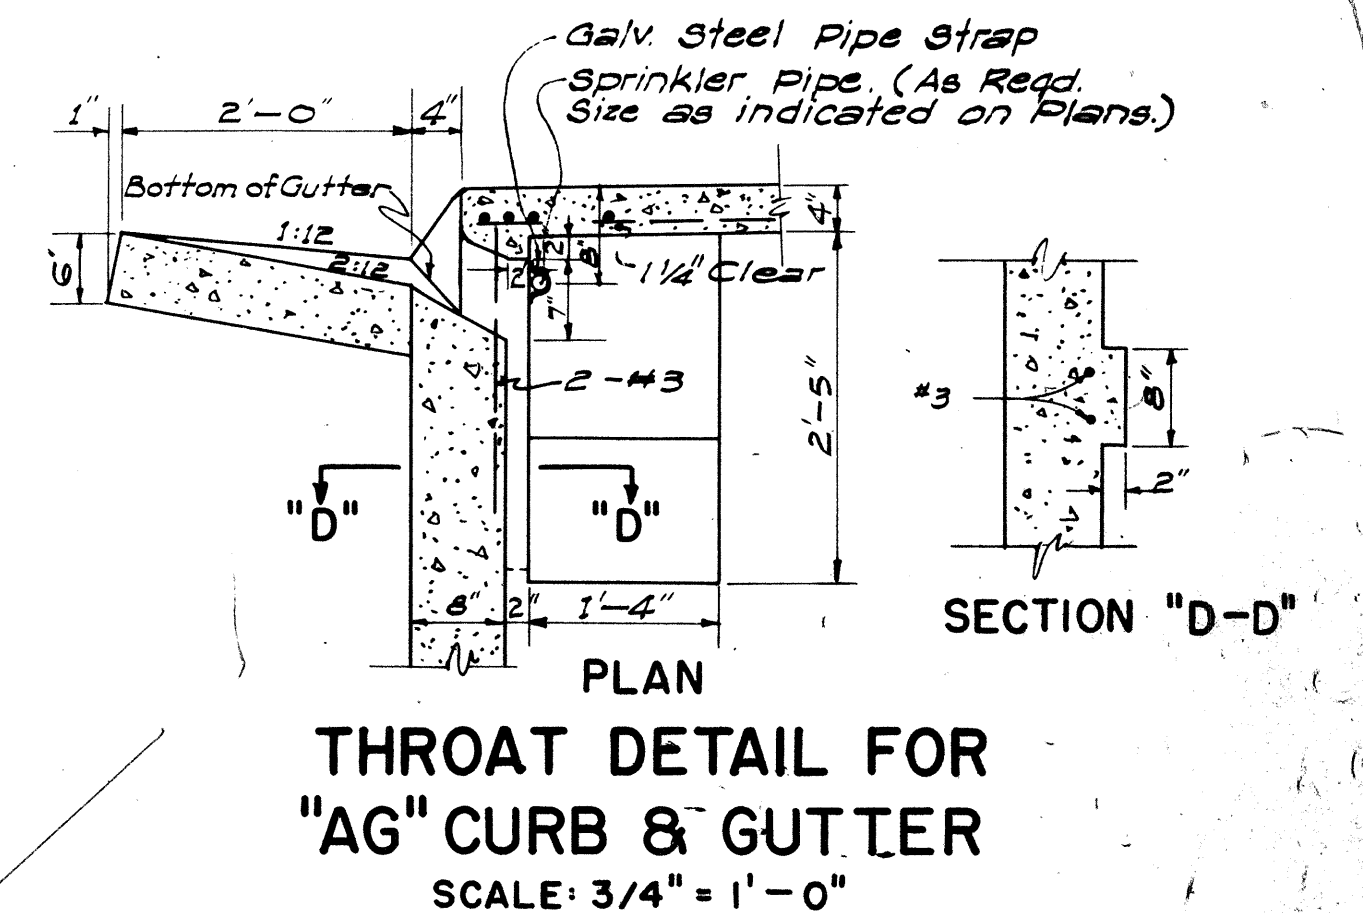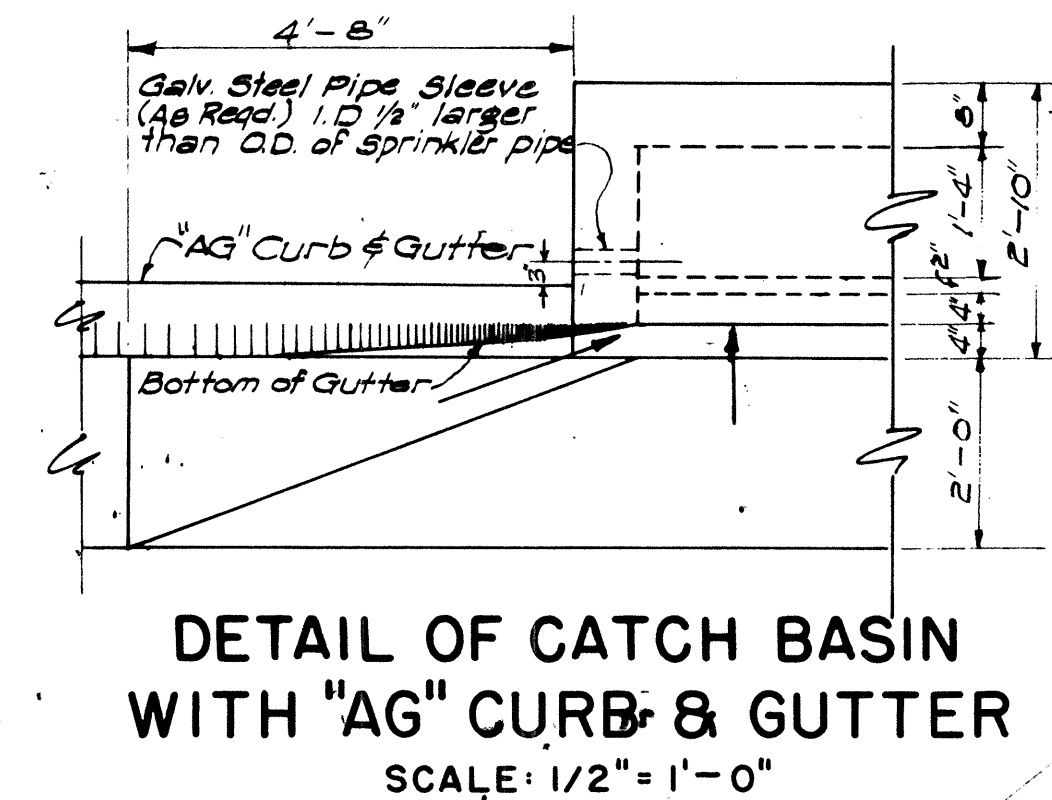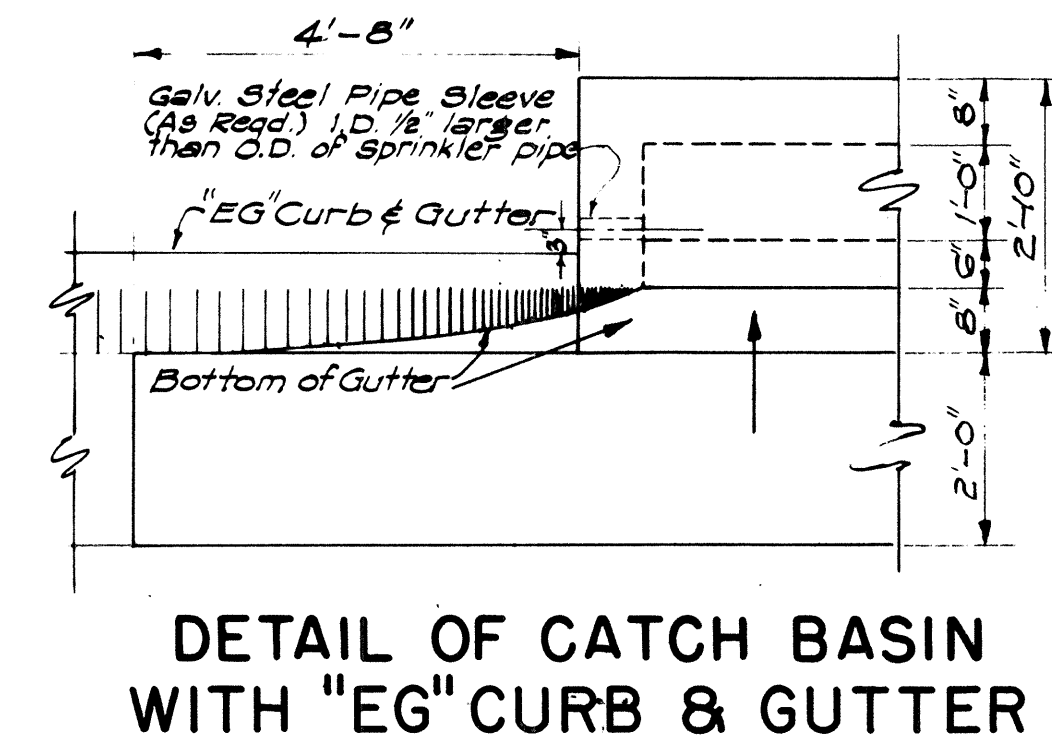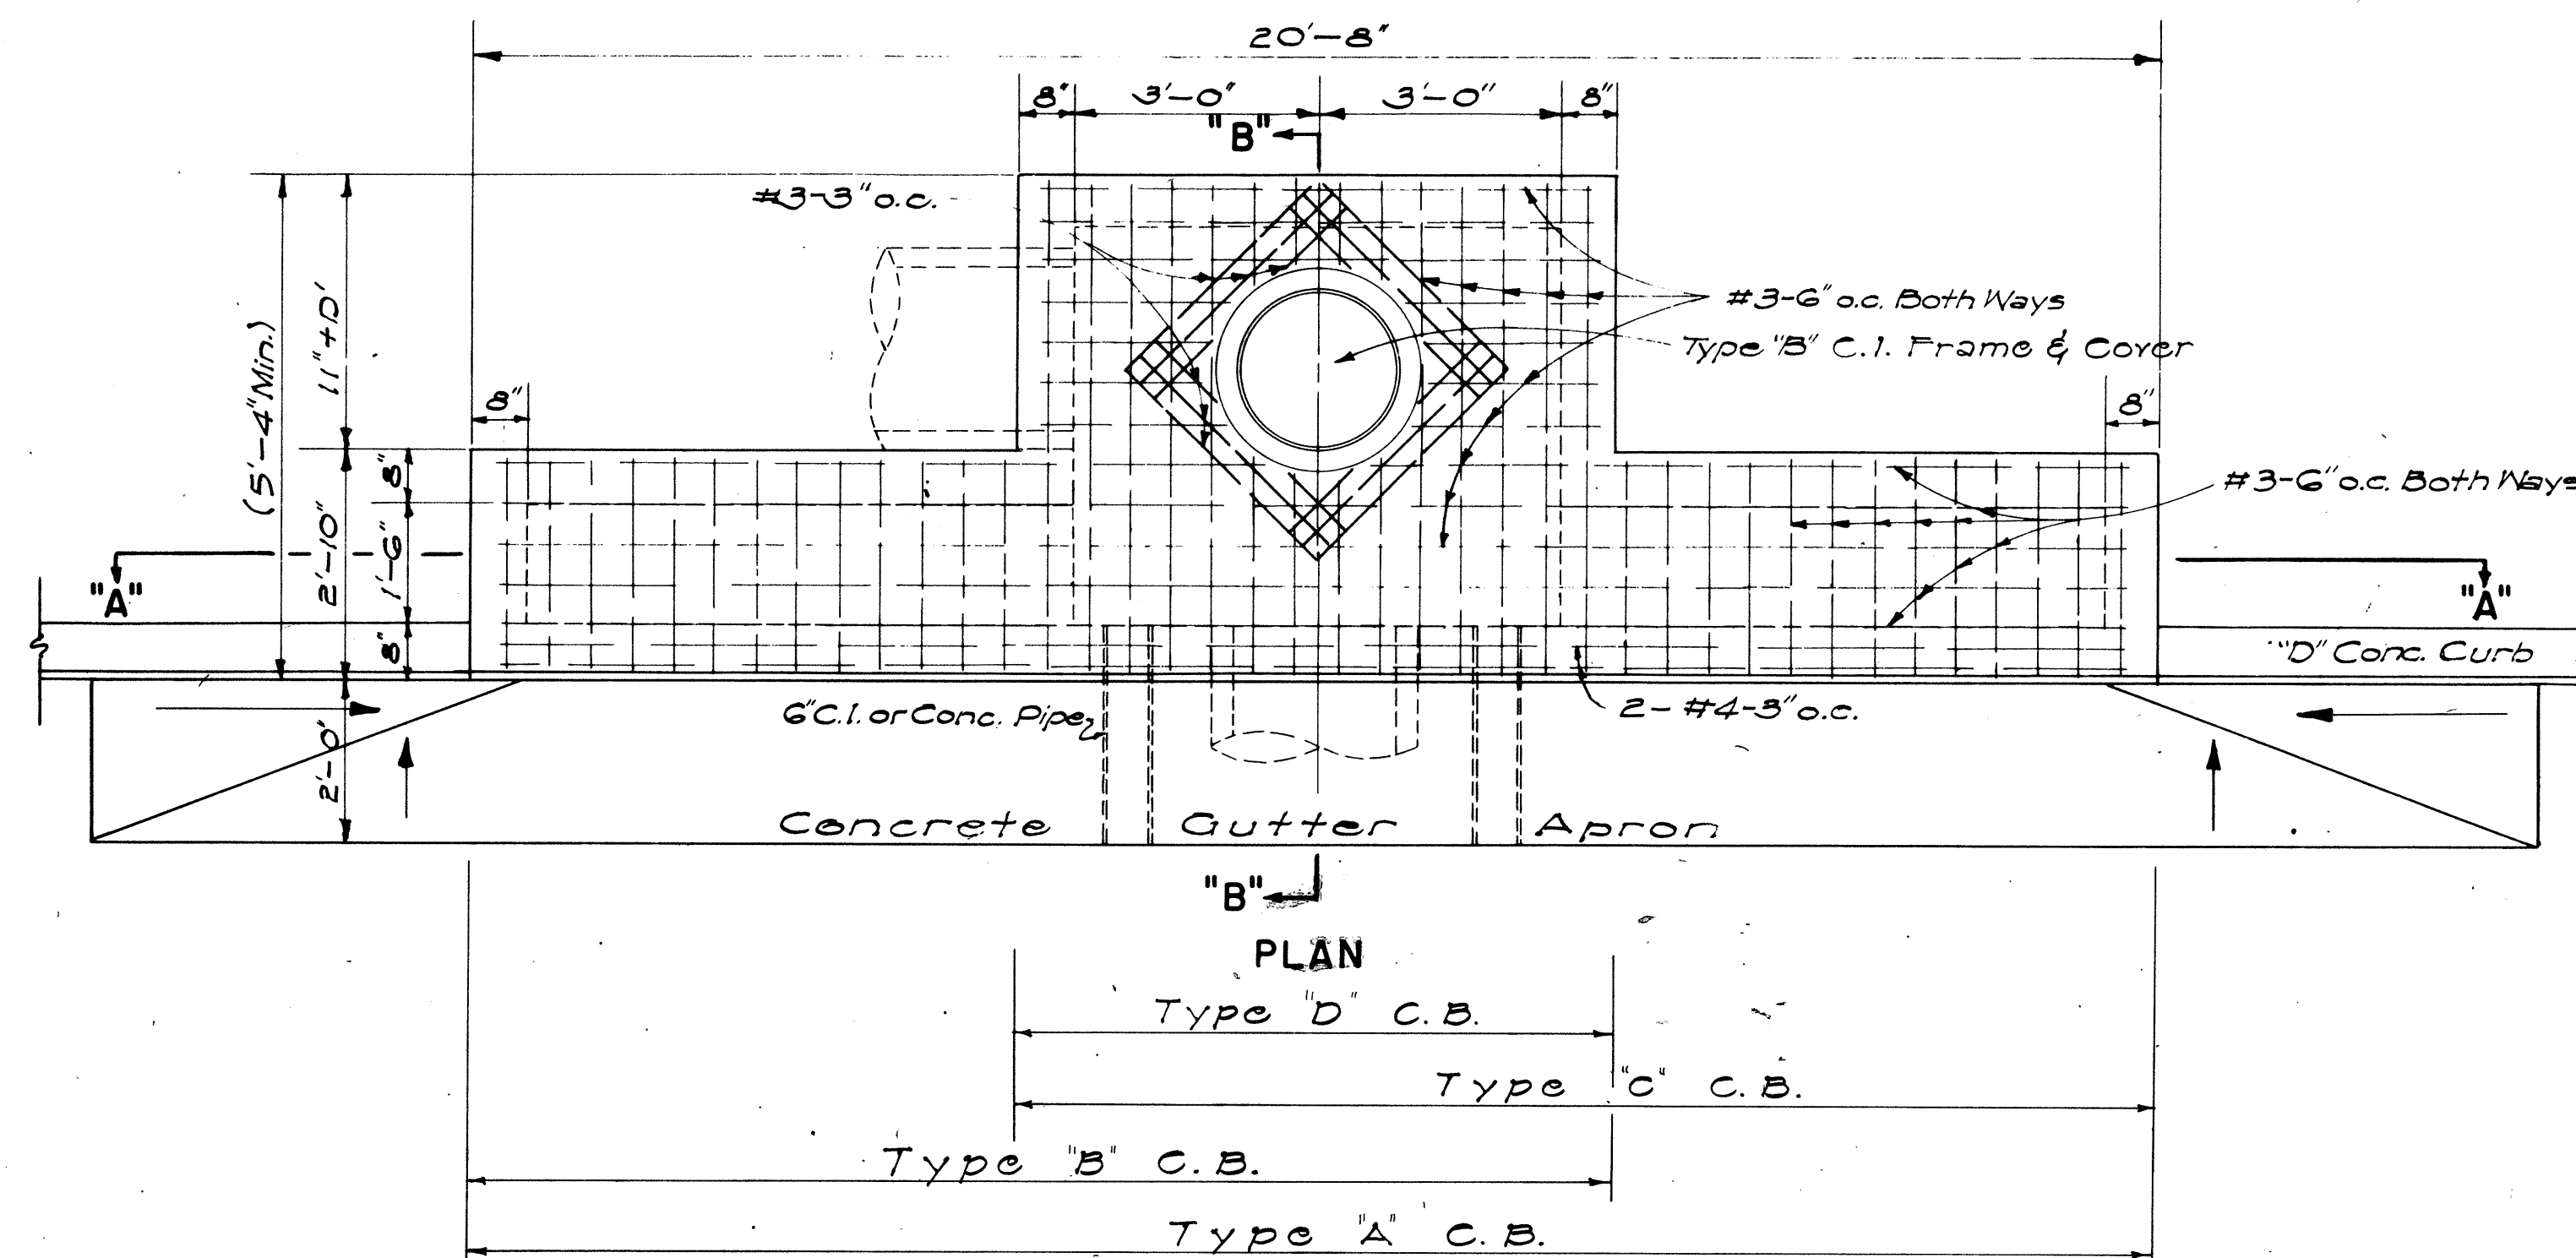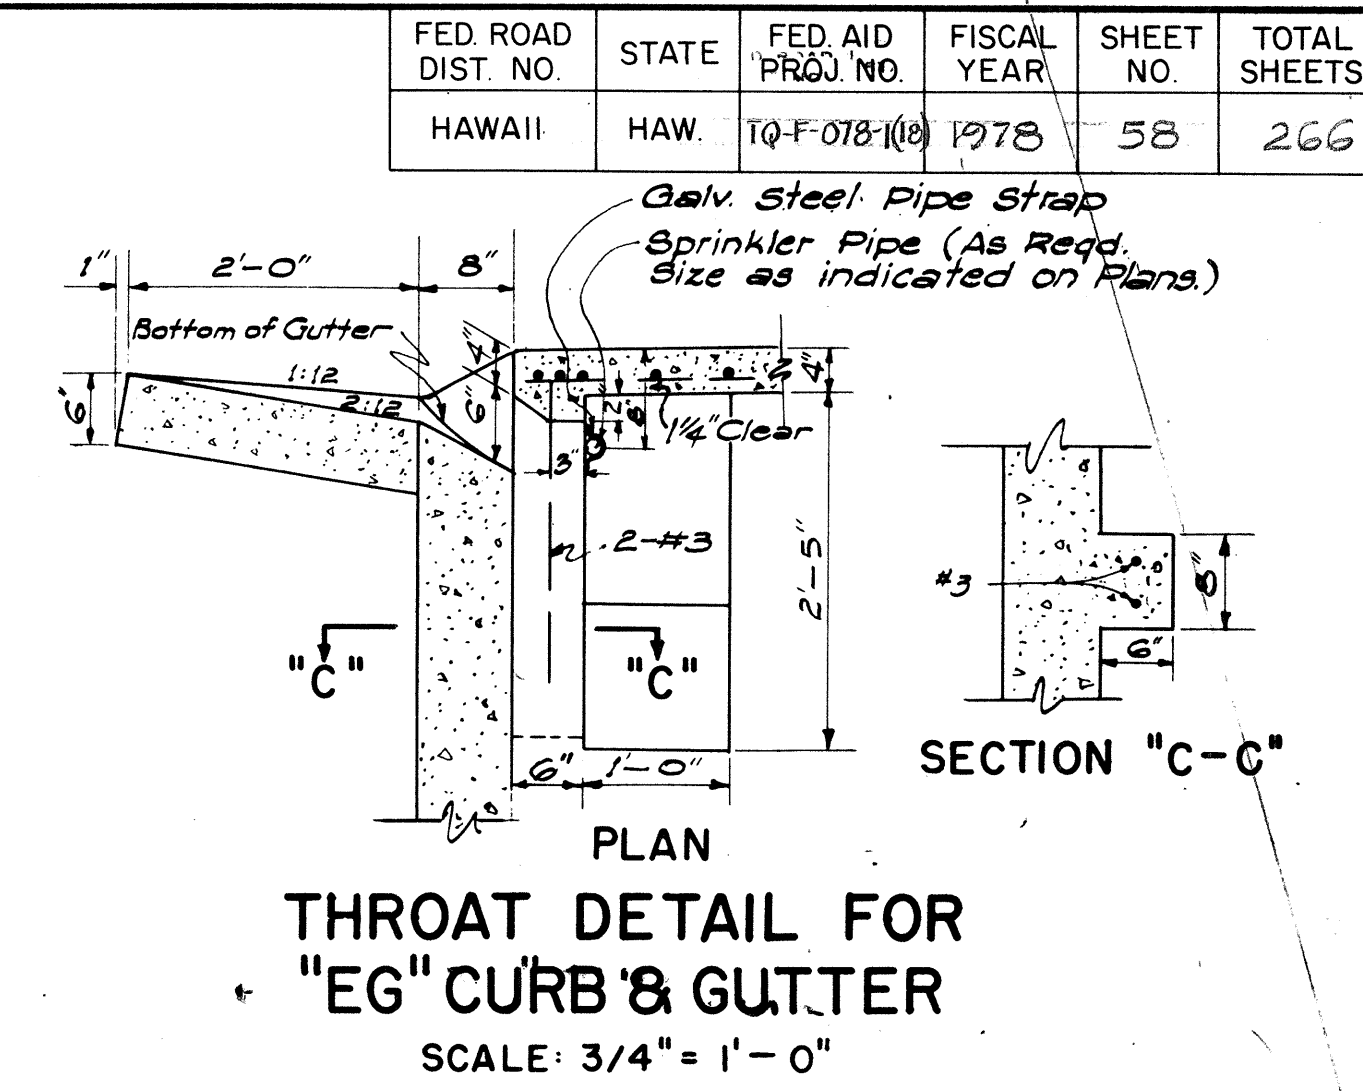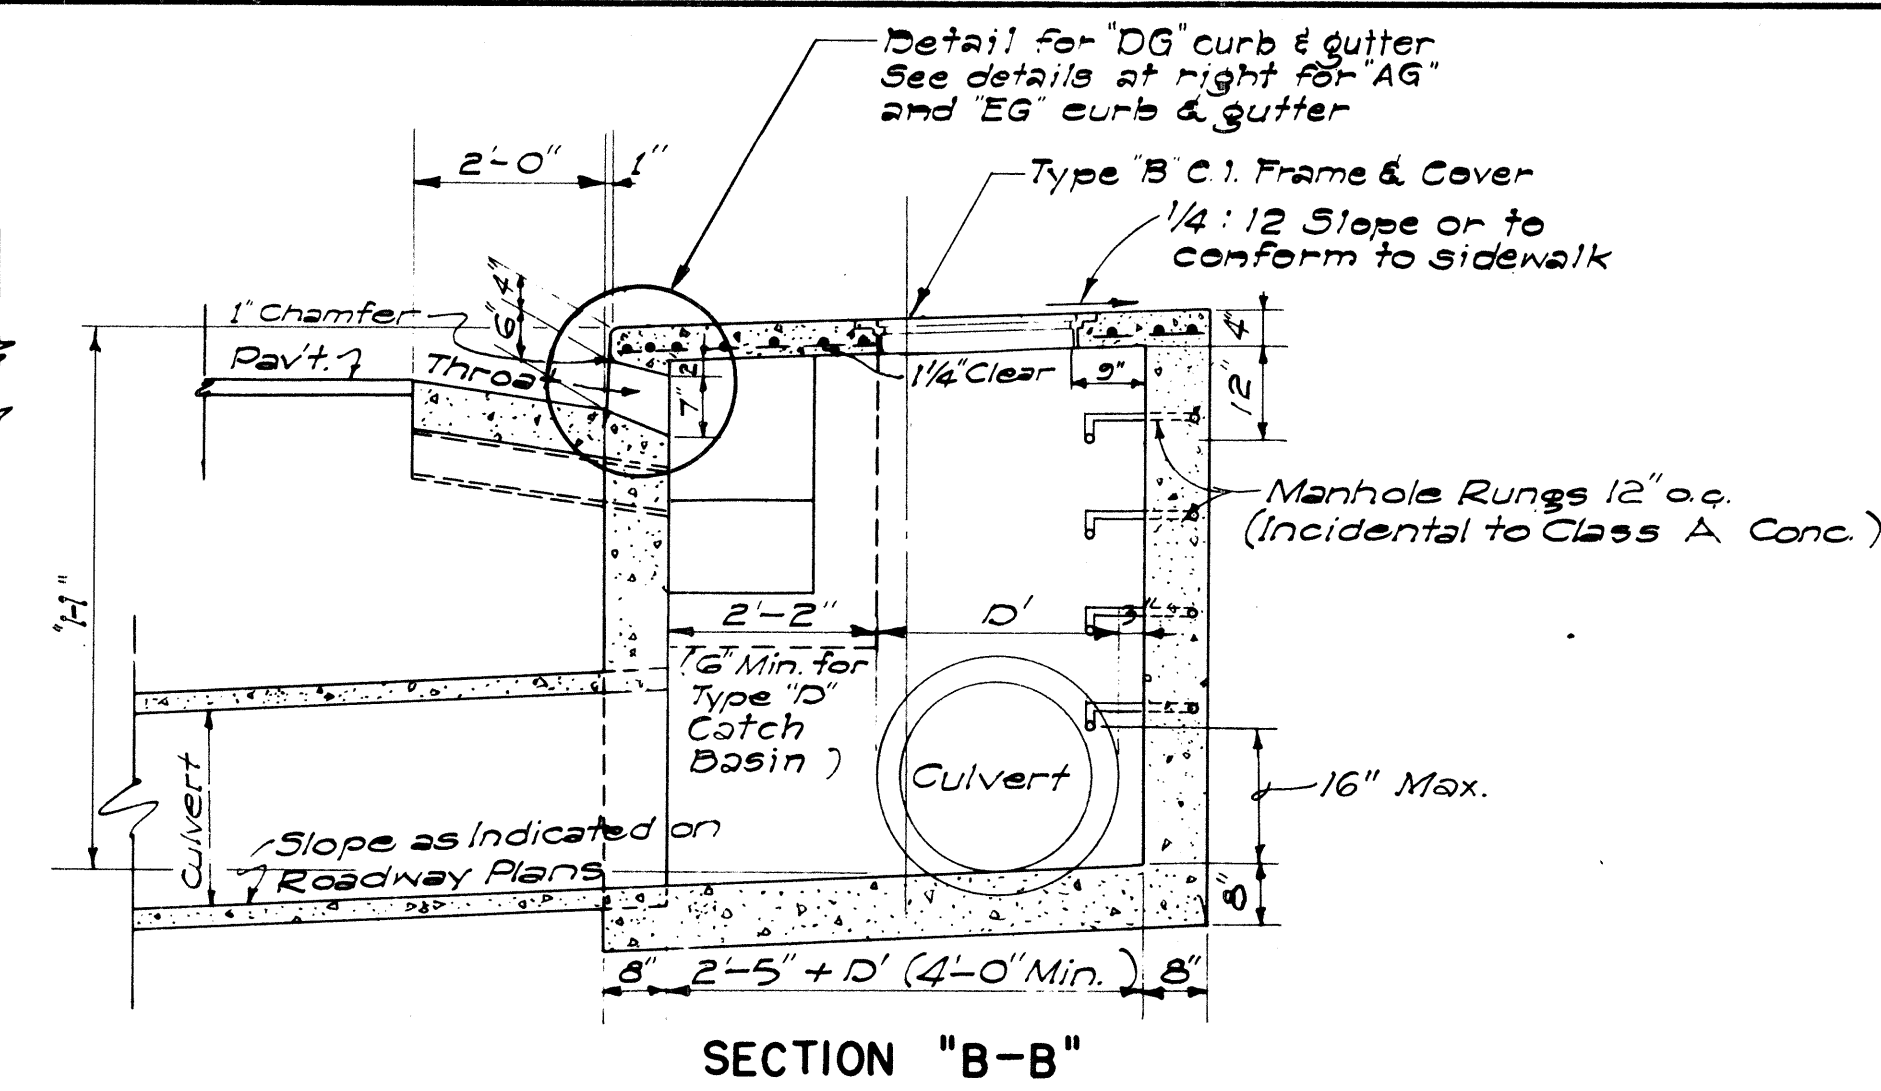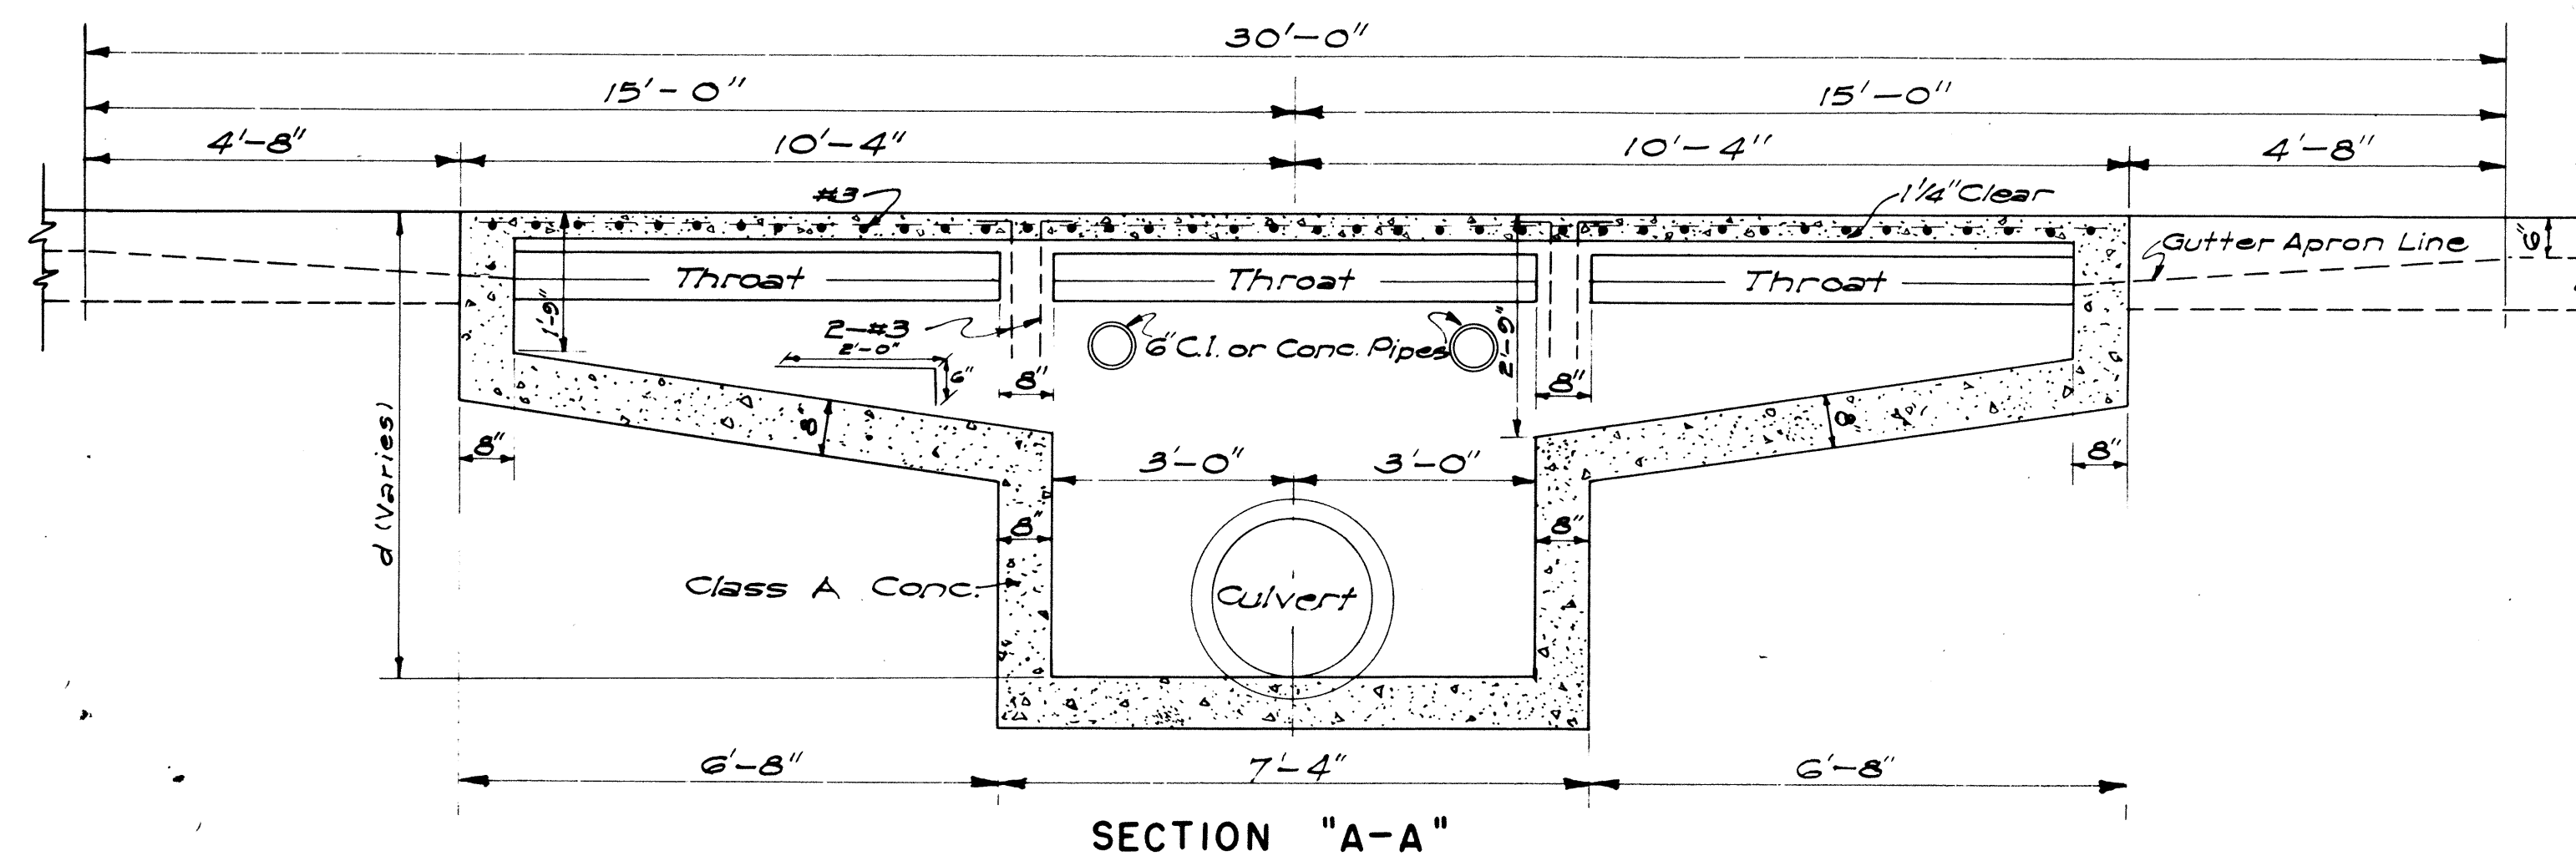

DETAILS OF TYPES "A", "B", "C" AND "D" CATCH BASINS

GENERAL NOTES

1. Quantities based on $d' = 5.75'$ and $D' = 30'$.
2. Quantities do not include Concrete for Gutter Apron.
3. The Contractor shall install two 6" Cast Iron or Concrete Pipes as incidental to Class A Concrete for Construction Drainage. The Engineer shall determine the exact location in the field.
4. Culvert shall leave C.B. from any position and any direction indicated by plans or ordered by the Engineer. Culvert may both enter and leave C.B. so that C.B. will also act as Manhole.
5. The Contractor shall install Galvanized Steel Pipe Sleeves and Straps as incidental to Sprinkler System.
6. The type of curb and/or gutter (Type 1, 2, 3, etc.) shall conform to the type specified on the roadway plans.
7. Manhole Rungs (12" o.c.) are required when "H" is greater than 4 feet 6 inches. Only one rung (16 inches from the bottom) is required if "H" is 4 feet 6 inches or less. Type "B" Cast Iron Frame and Cover and Manhole Rungs may be placed at any location as ordered by the Engineer.

ESTIMATED QUANTITIES

Type	Class A Conc.	Struct. Exc.	Reinf. Steel	Gutter Length
"A" 	7.5 c.y.	24.7 c.y.	145 lb.	30' - 0"
"B" 	6.0 c.y.	21.5 c.y.	108 lb.	23' - 4"
"C" 	6.0 c.y.	21.5 c.y.	108 lb.	23' - 4"
"D" 	4.9 c.y.	16.5 c.y.	77 lb.	16' - 8"

APPROVAL RECOMMENDED:

HYDRAULIC DESIGN ENGINEER

12-17-69
DATE

APPROVED:

ASSISTANT CHIEF, ENGINEERING


12-17-69
DATE

NO.	REVISION	APPROVED BY	DATE
1	Spacing on Manhole Rungs to conform to OSHA.	H.T.	1-21-78

STATE OF HAWAII
DEPARTMENT OF TRANSPORTATION
HIGHWAYS DIVISION
STANDARD DETAILS
CATCH BASINS

Scale: As Noted Date: July, 1969
SHEET NO 3 OF 10 SHEETS DH


FED. ROAD DIST. NO.	STATE	FED. AID PROJ. NO.	FISCAL YEAR	SHEET NO.	TOTAL SHEETS
HAWAII	HAW.	TA-F-078-1(18)	1978	C05851	266

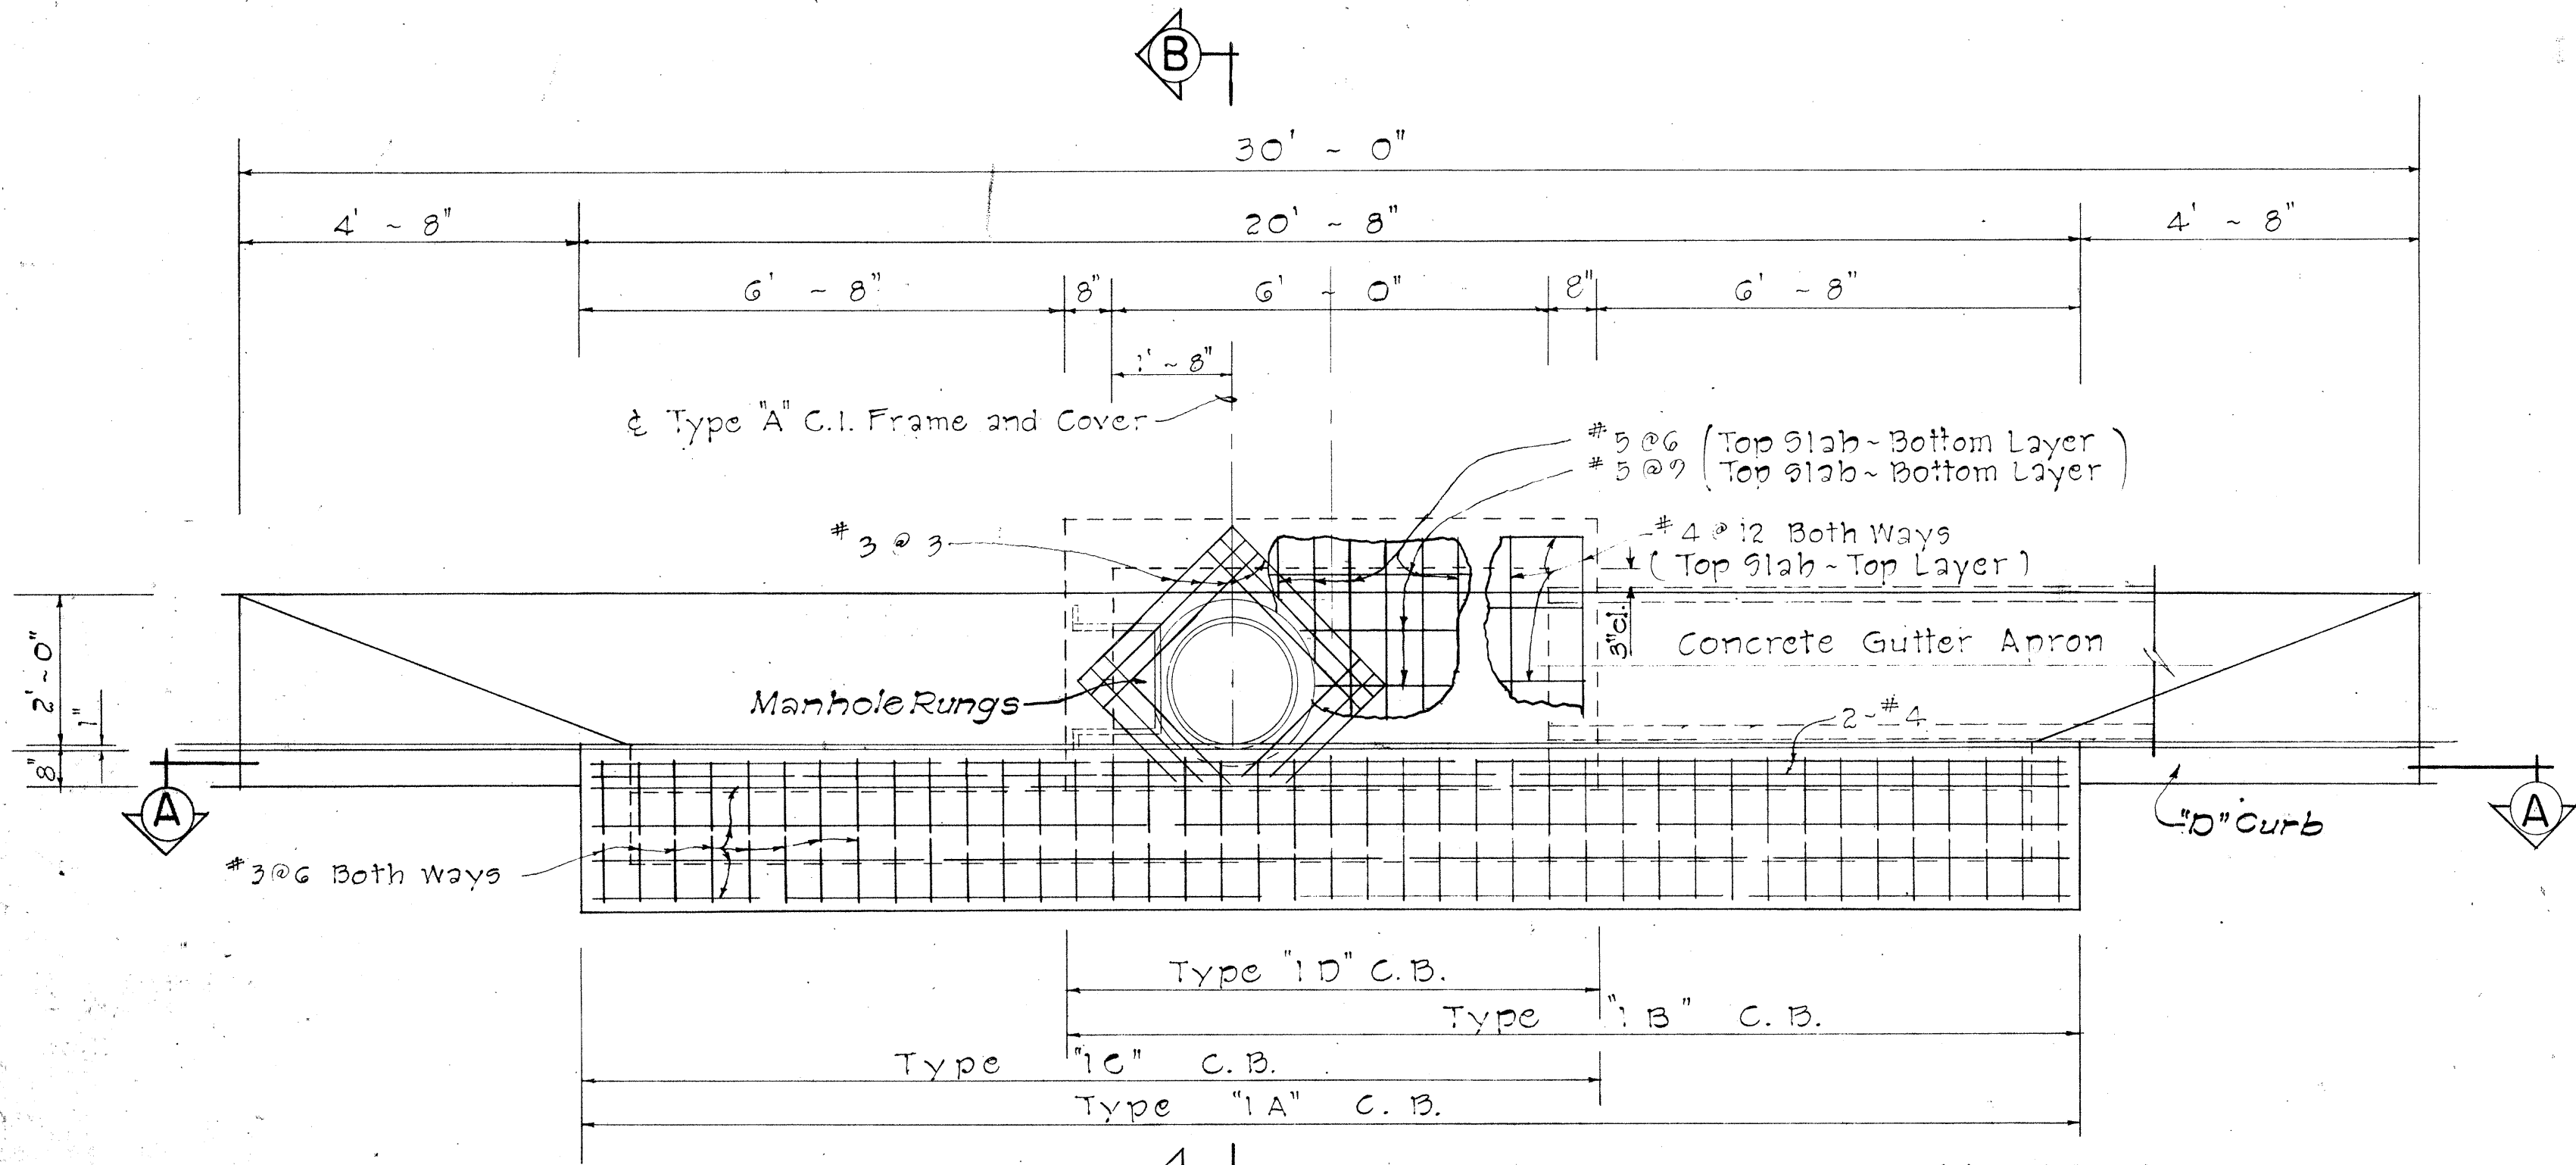

- GENERAL NOTES**
- Culvert shall enter and leave C.B. from any position and in the direction indicated by the plans or ordered by the Engineer.
 - D' shall be the maximum outside dimension of the culvert at the C.B. wall.
 - The type of curb and/or gutter (Type 1, 2, 3, etc.) shall conform to the type specified on the roadway plans.
 - Manhole Rungs (12" o.c.) are required when "H" is greater than 4 feet 6 inches. Only one rung (16 inches from the bottom) is required if "H" is 4 feet 6 inches or less. Type "A" C.I. Frame & Cover and Manhole Rungs may be placed at any location as ordered by the Engineer.


PLAN

Scale: 1/2" = 1'-0"

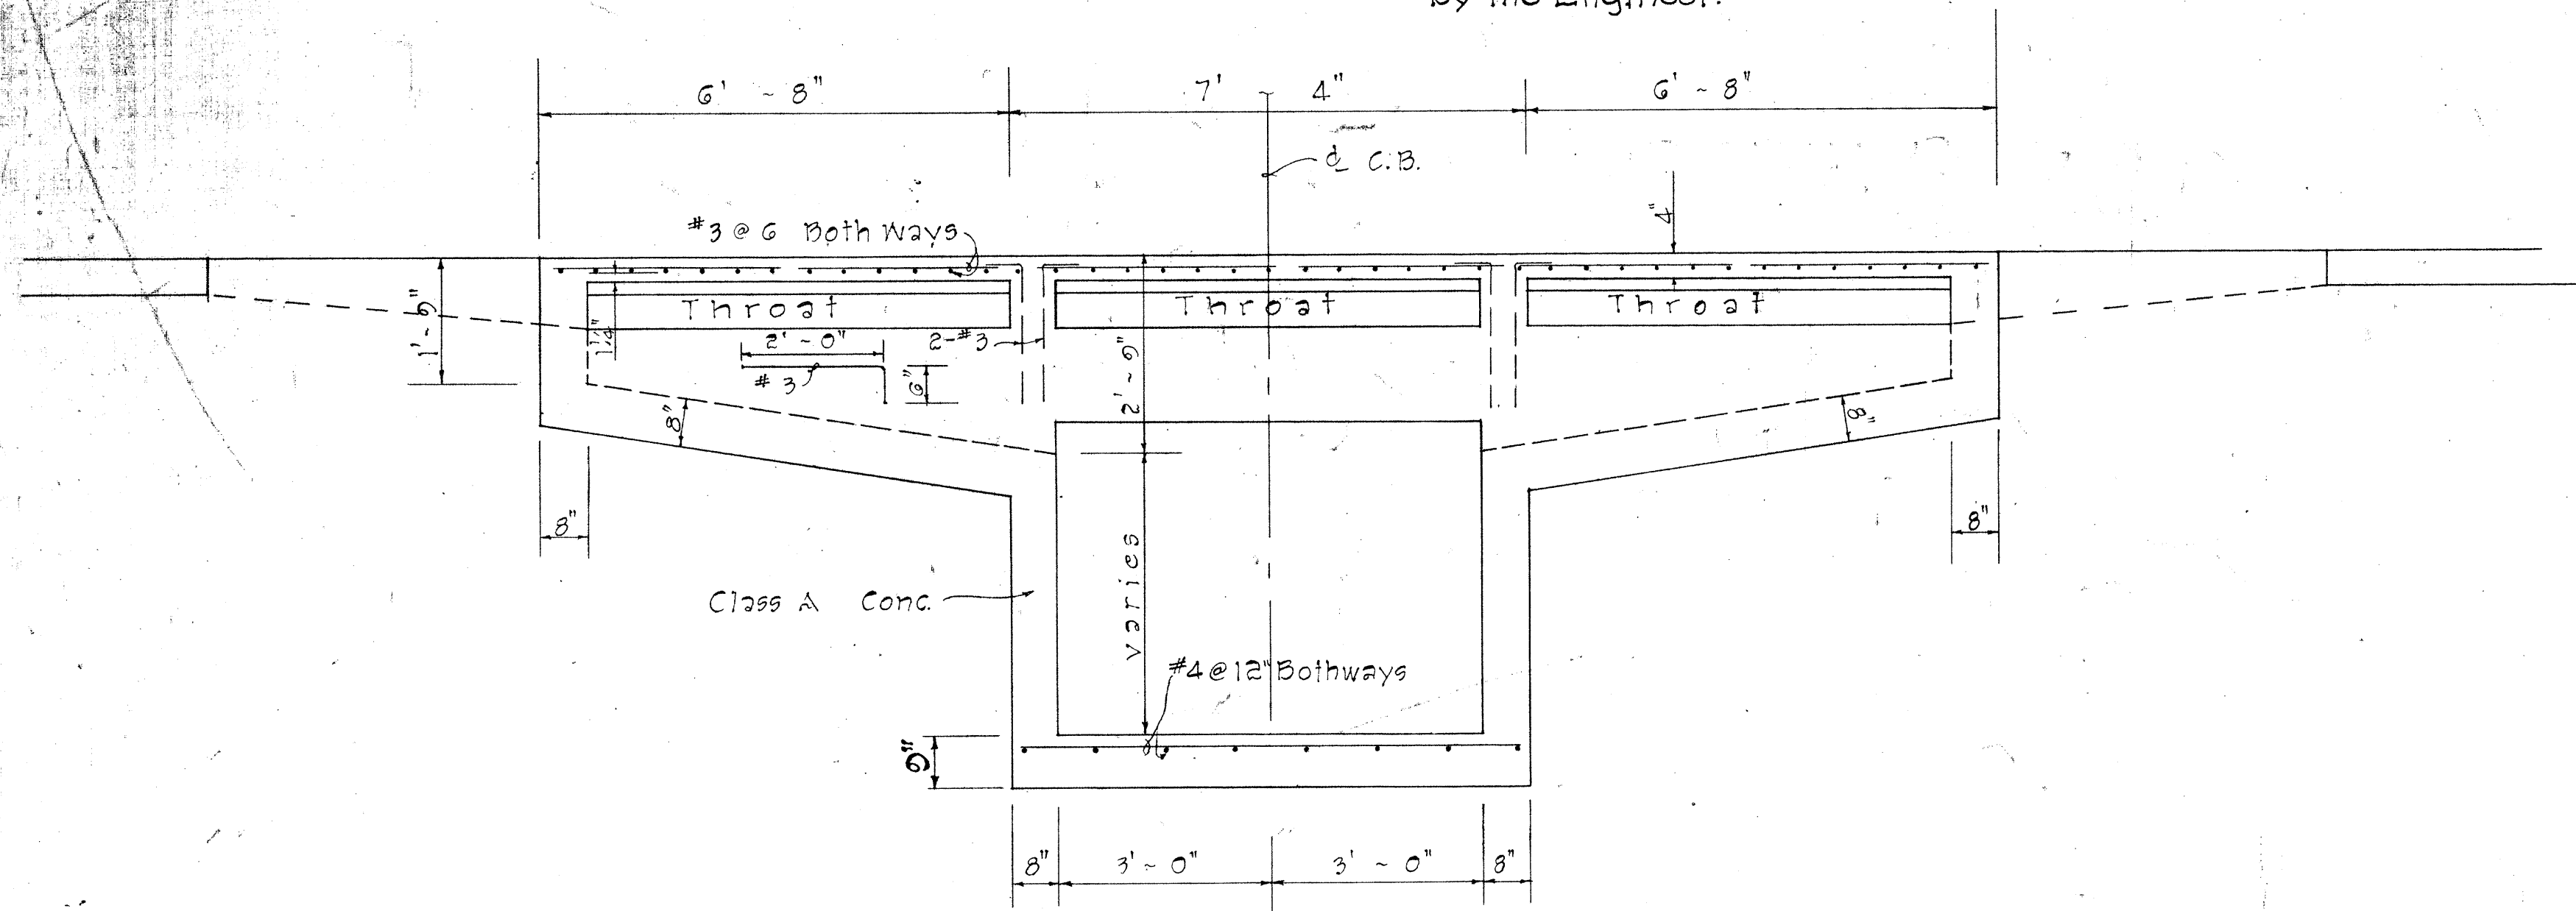

SECTION "A-A"

Scale: 1/2" = 1'-0"

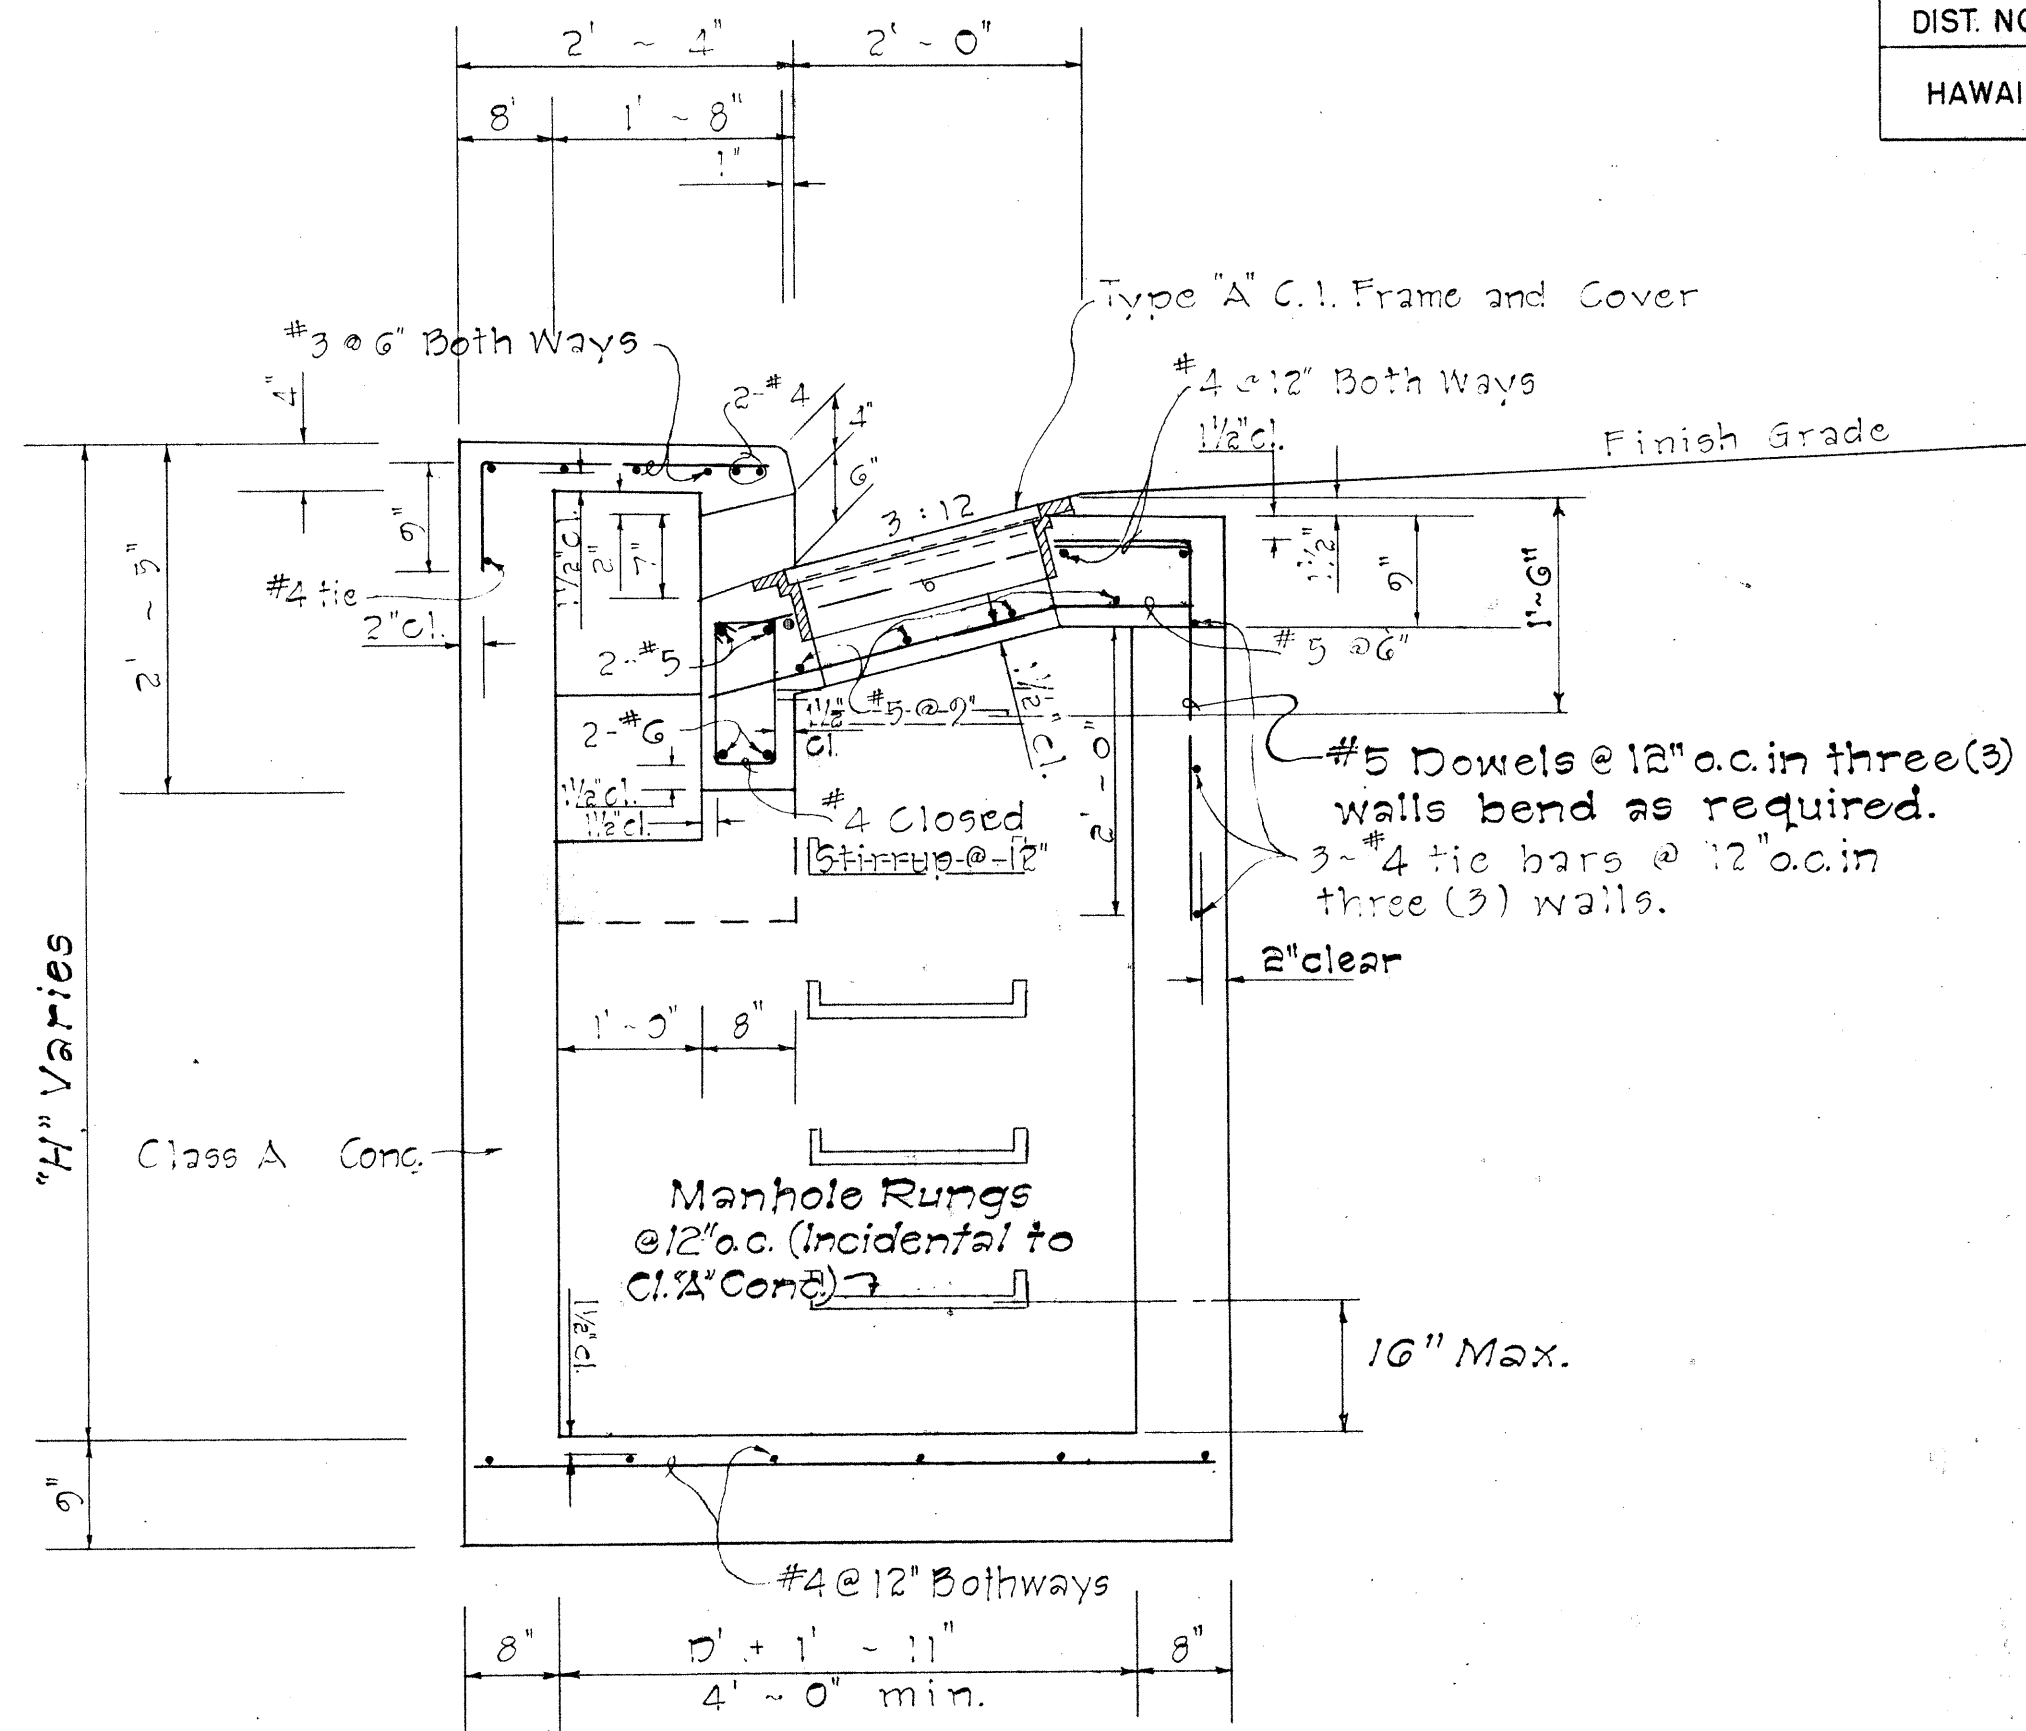

SECTION "B-B"

Scale: 3/4" = 1'-0"

APPROVAL RECOMMENDED:
 HYDRAULIC DESIGN ENGINEER
 DATE: 12-17-69

APPROVED:
 ASSISTANT CHIEF, ENGINEERING
 DATE: 12-17-69

NO.	REVISION	APPROVED BY	DATE
1	Spacing on Manhole Rungs to conform to OSHA.	H.T.	1-21-75

STATE OF HAWAII
 DEPARTMENT OF TRANSPORTATION
 HIGHWAYS DIVISION



STANDARD DETAILS
 TYPE "IA", "IB", "IC", AND "ID"
 CATCH BASINS

Scale: As Noted Date: July, 1969
 SHEET No. 3A OF 10 SHEETS DH 3

DETAILS OF TYPE "IA", "IB", "IC" AND "ID" CATCH BASIN

DATE	BY
12-17-69	H.T.
1-21-75	H.T.
12-17-69	H.T.
1-21-75	H.T.
FED. ROAD DIST. NO.	STATE	FED. AID. PROJECT	FISCAL YEAR	SHEET NO.	TOTAL SHEETS
HAWAII	HAWAII	10-F-0781(10)	1978	59	206


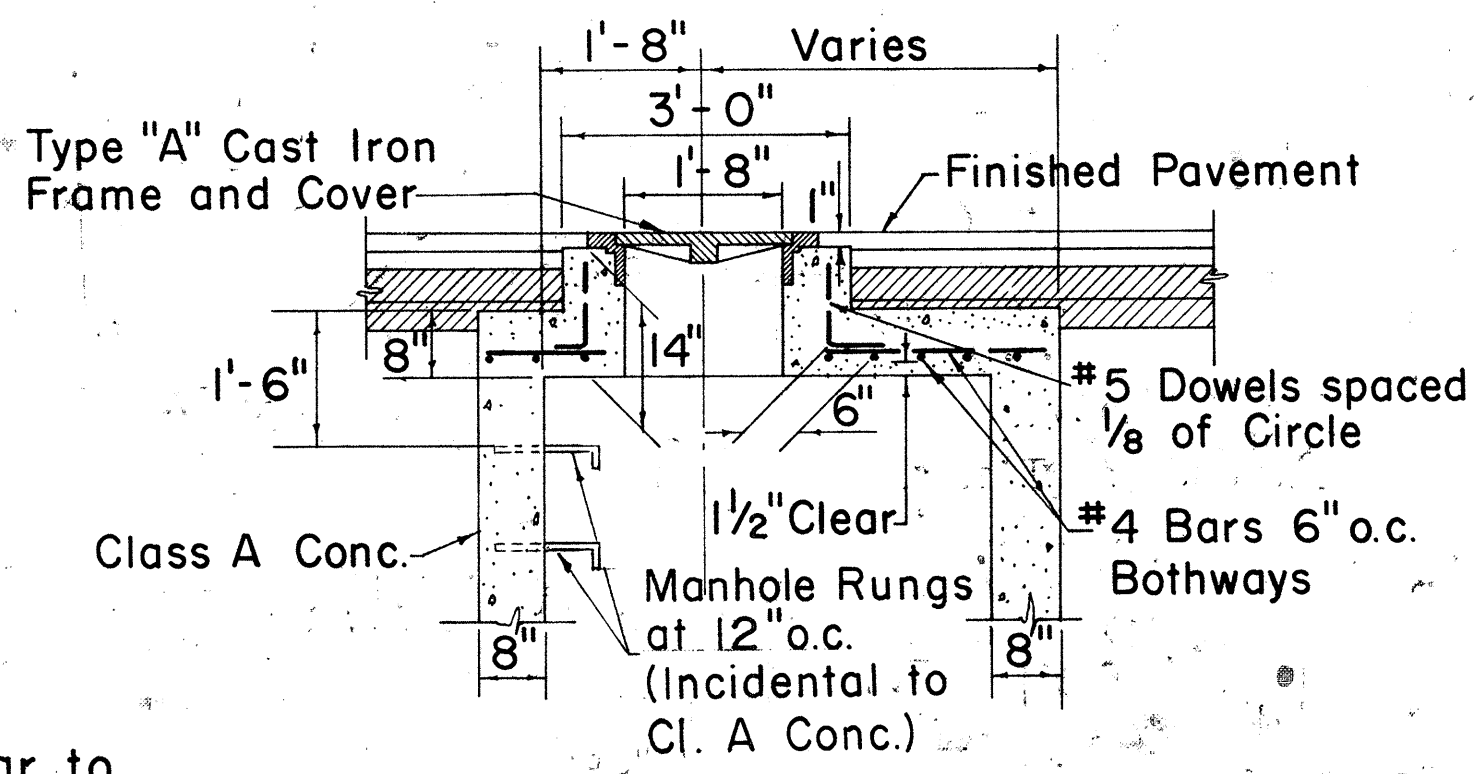
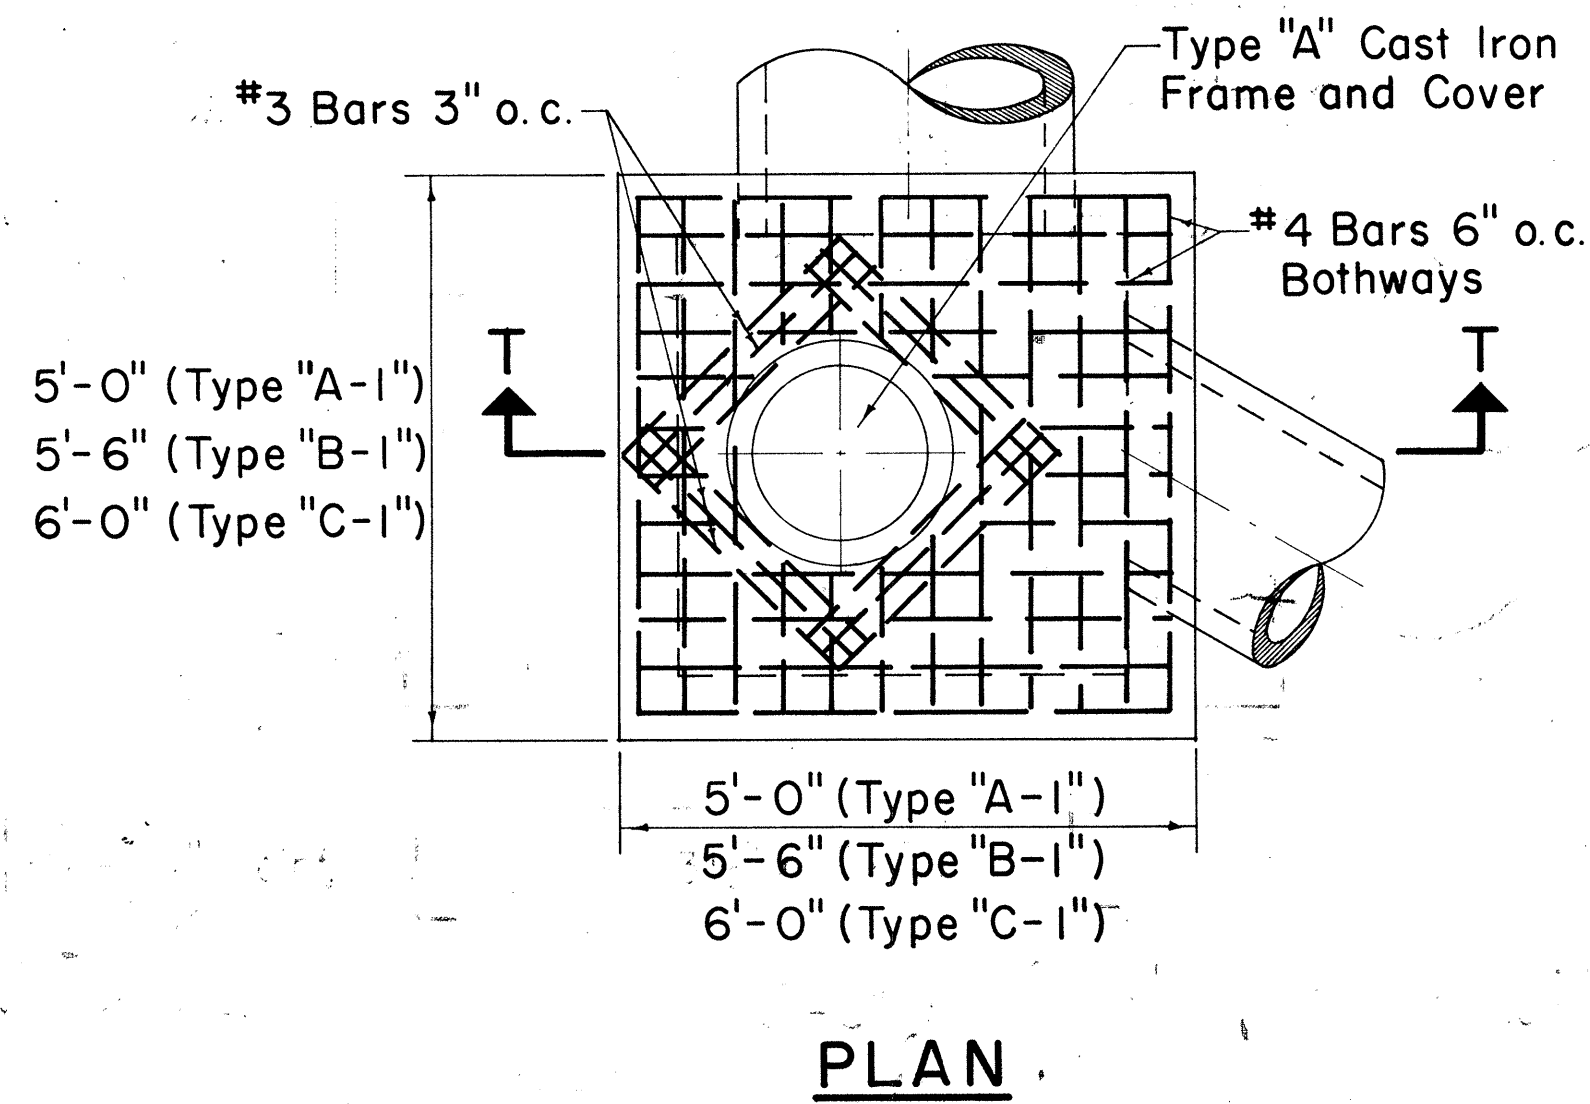


TYPE "A-1", "B-1", & "C-1"
STORM DRAIN MANHOLE
TOP DETAIL UNDER PAVEMENT
 Scale: 1/2" = 1'-0"



Note:
 Bottom detail similar to
 Type "A", "B", & "C"

GENERAL NOTES



- Culvert shall enter and leave S.D.M.H. from any position and in the direction indicated by the plans or ordered by the Engineer.
- Manhole Rungs (12" o.c.) are required when "H" is greater than 4'-6". Only one rung (16" from the bottom) is required if "H" is 4'-6" or less. Type "A" C.I. Frame and Cover and Manhole Rungs may be placed at any location as ordered by the Engineer.

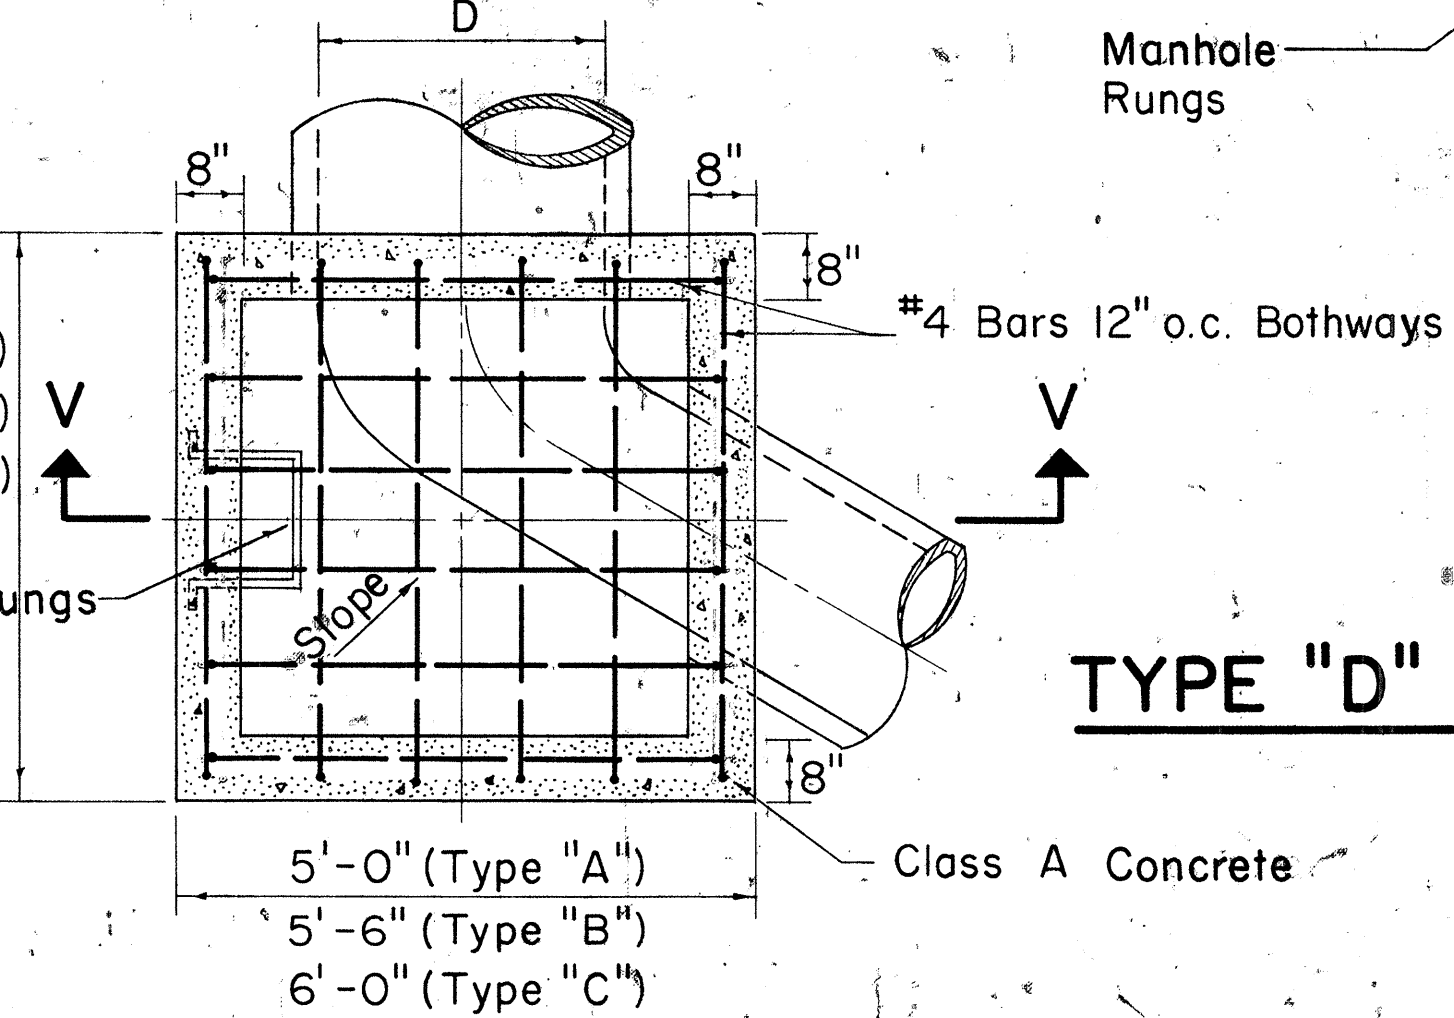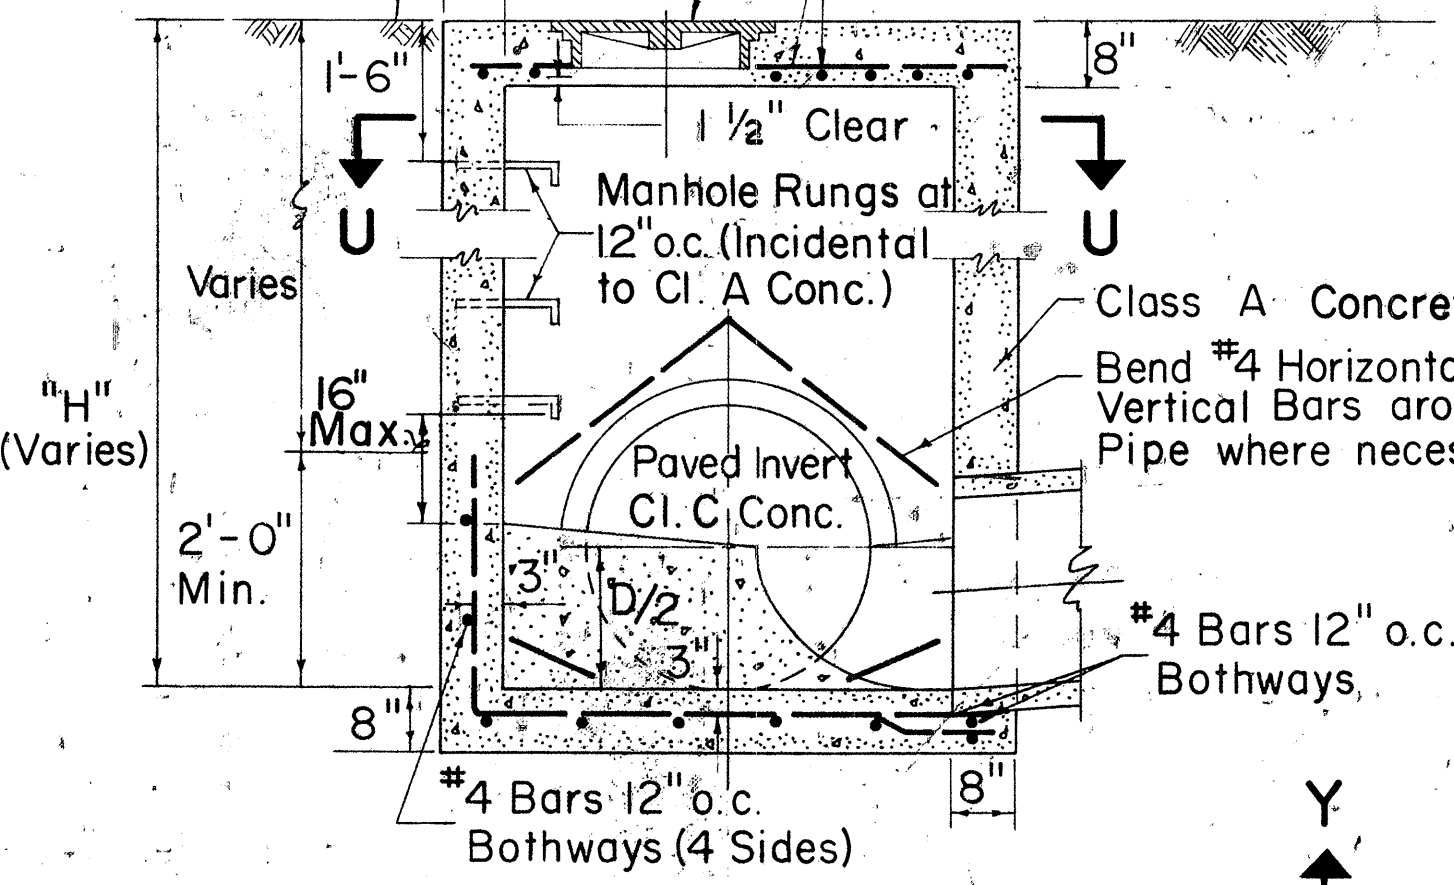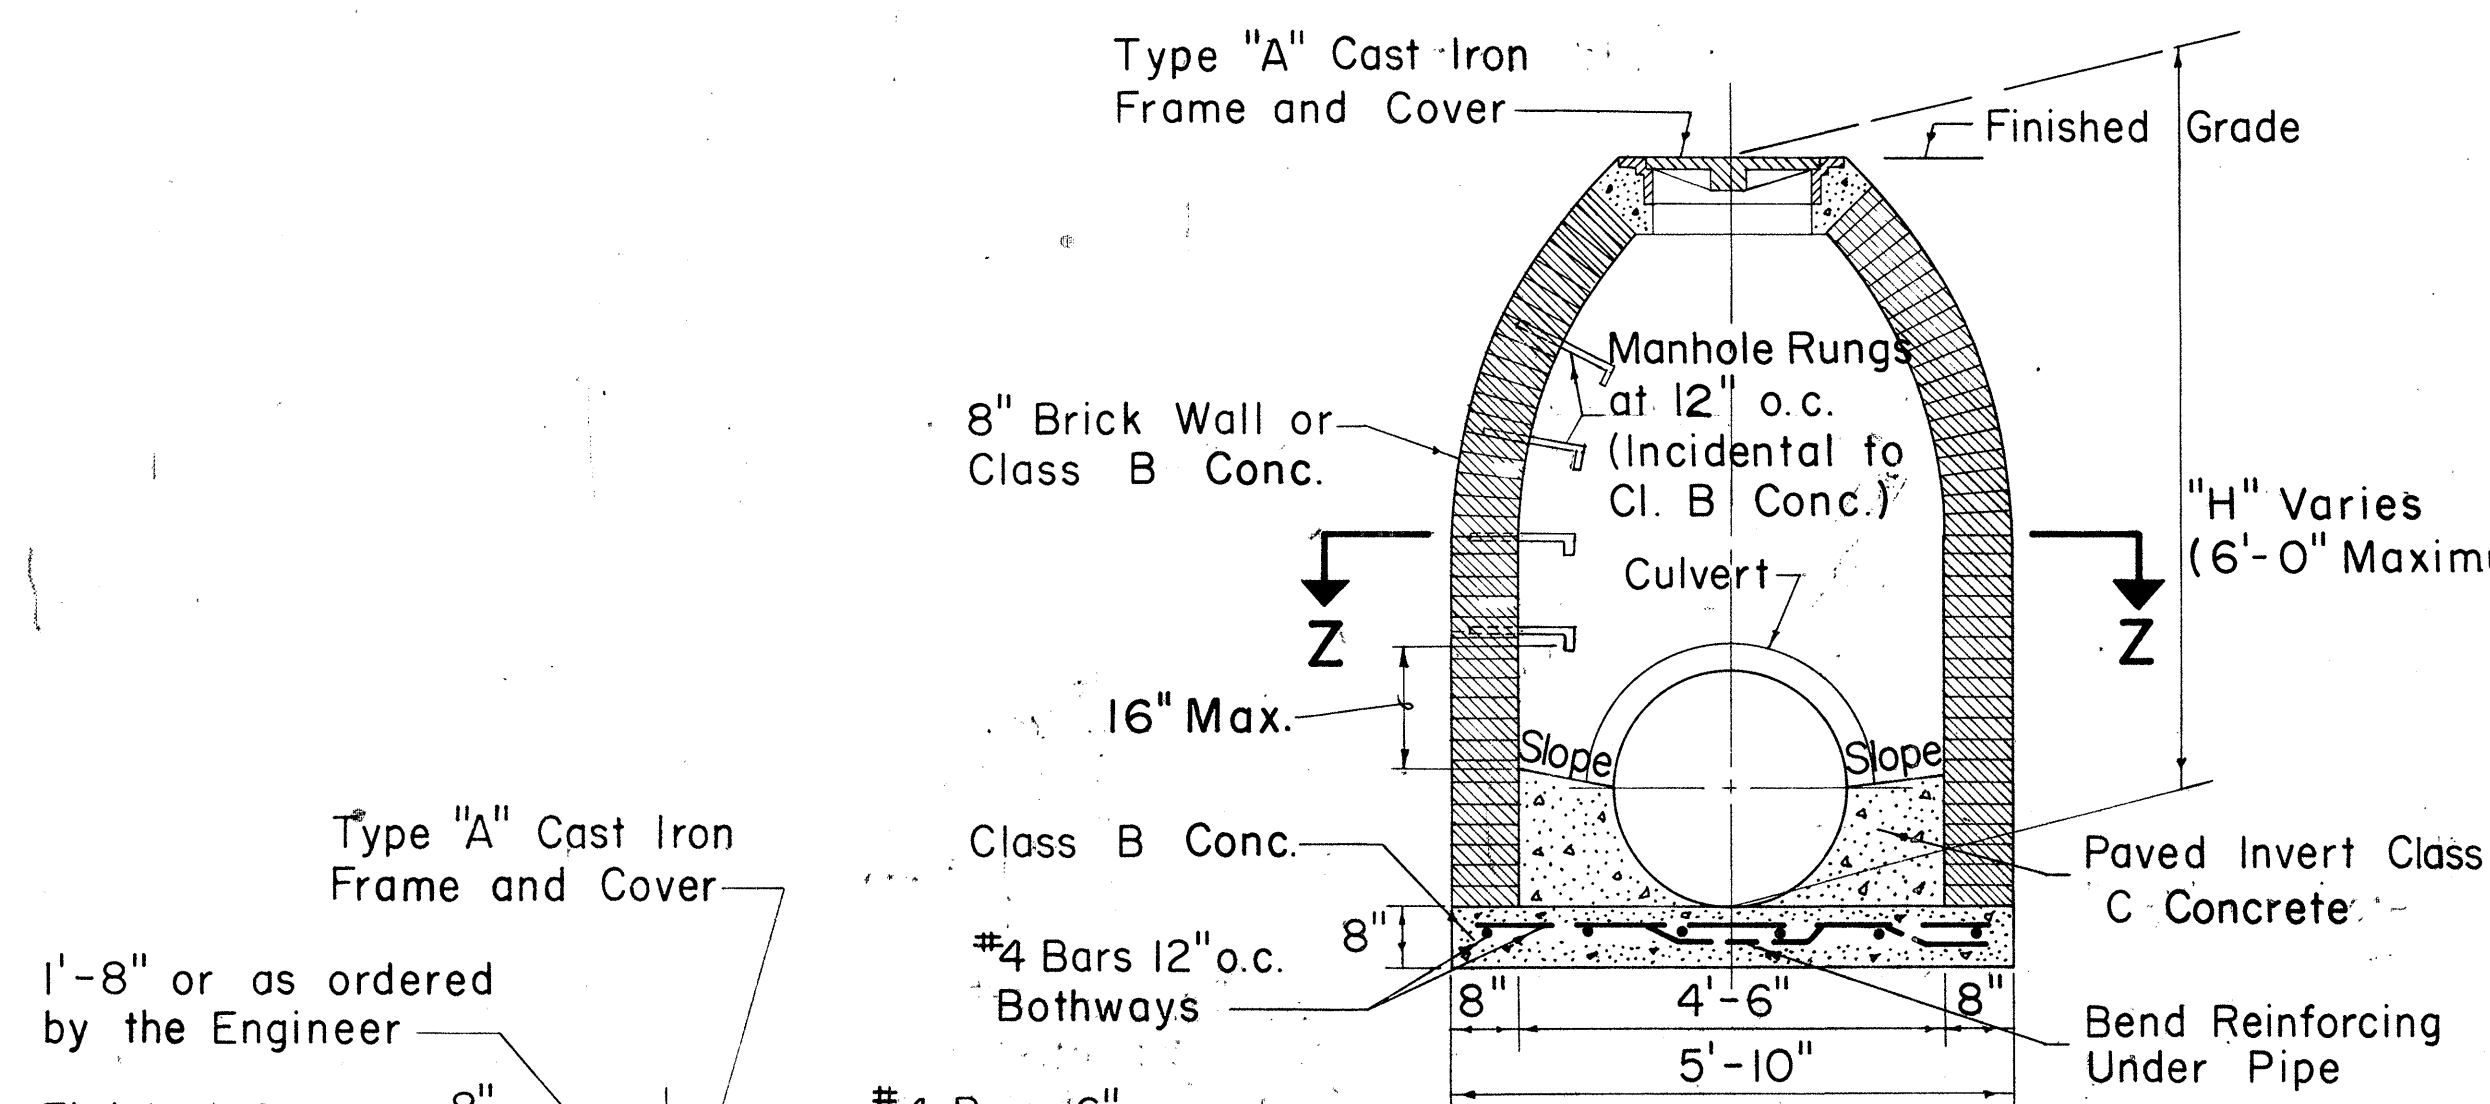

SECTION U-U
TYPE "A", "B", & "C"
S.D.M.H.
 Scale: 1/2" = 1'-0"

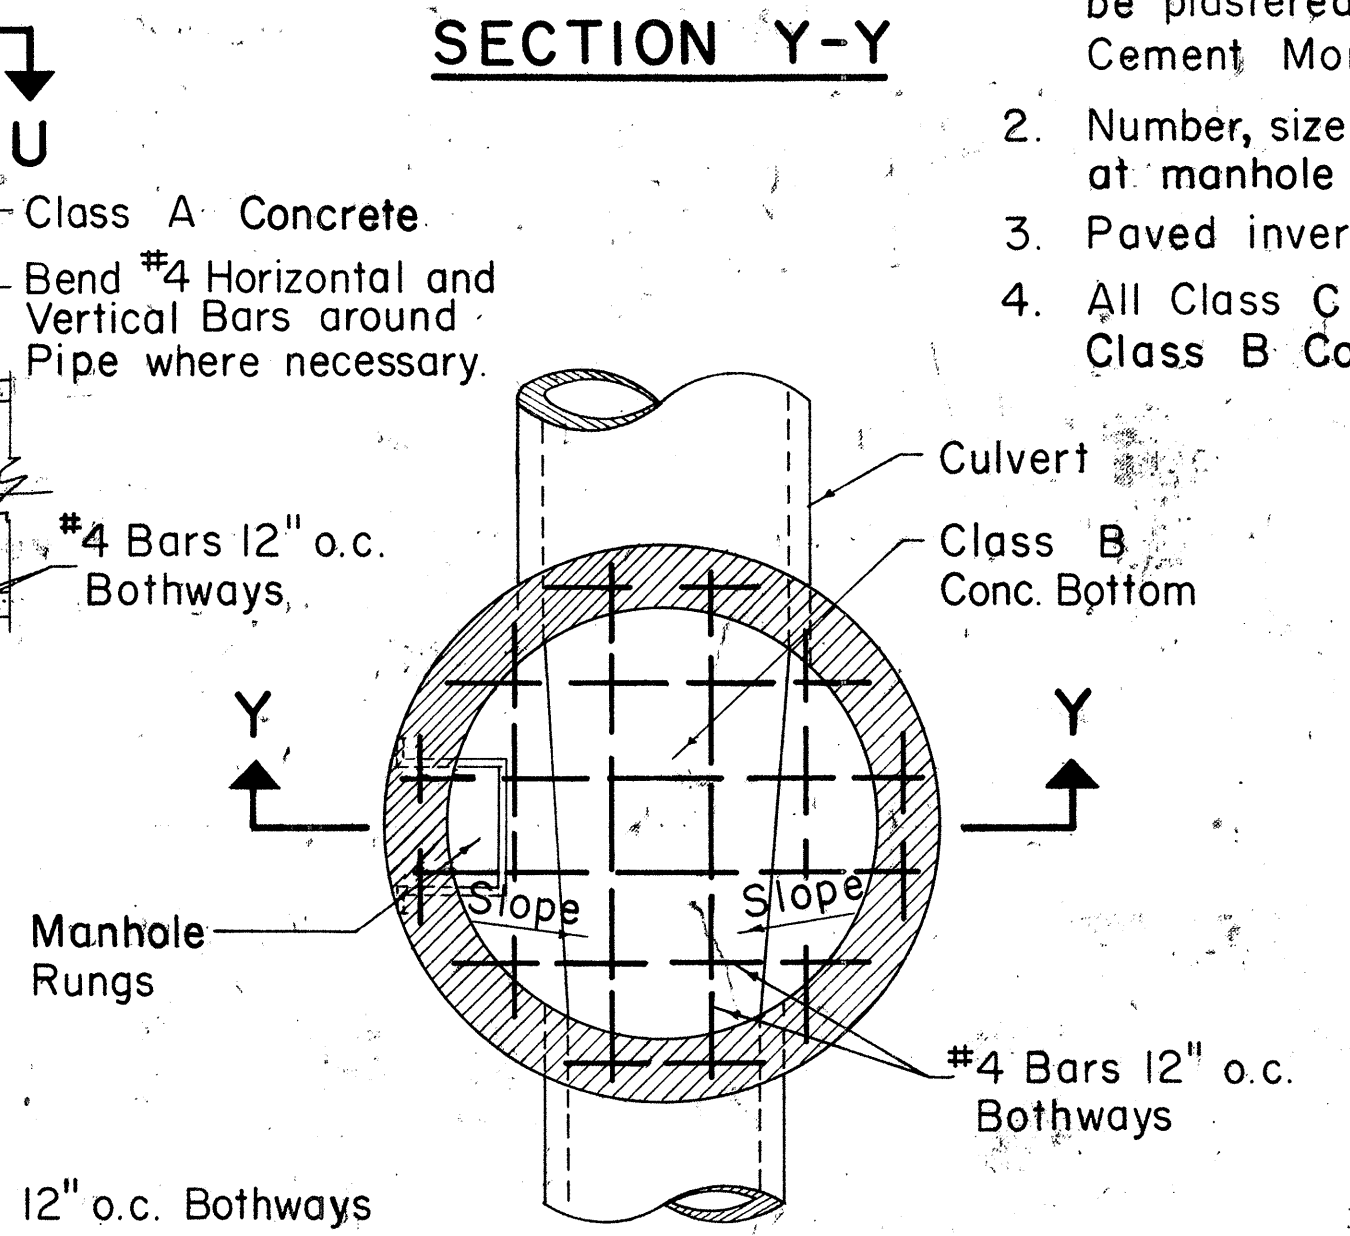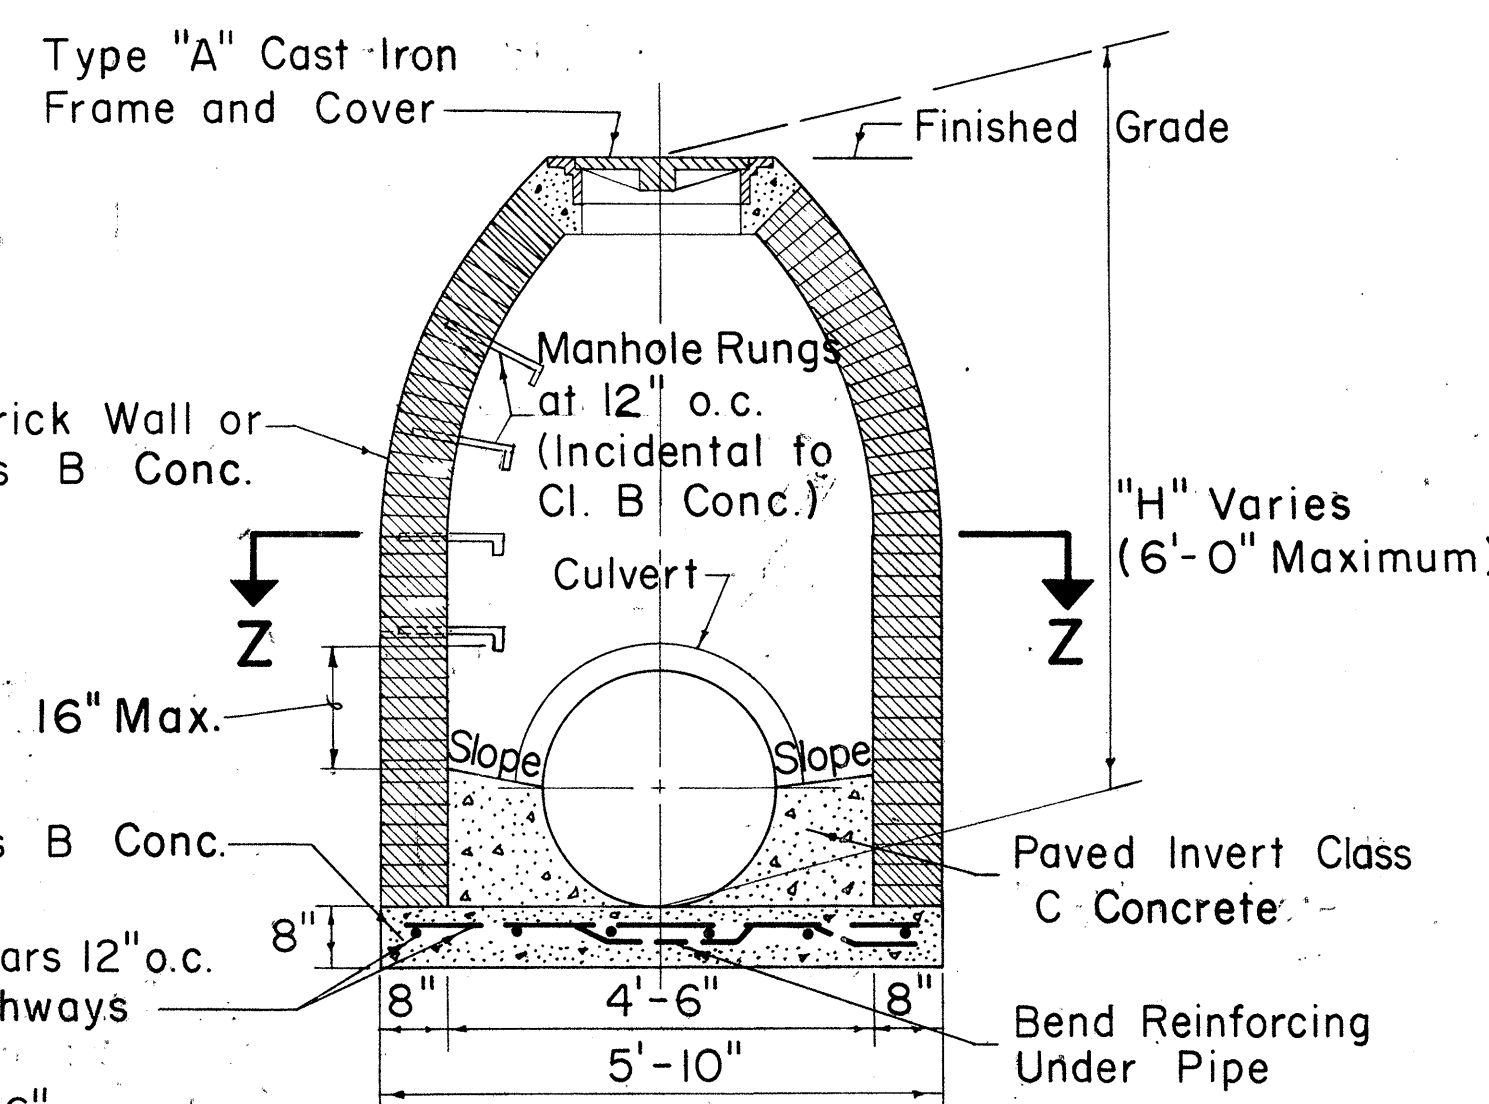

TYPE "D" STORM DRAIN MANHOLE
 Scale: 1/2" = 1'-0"

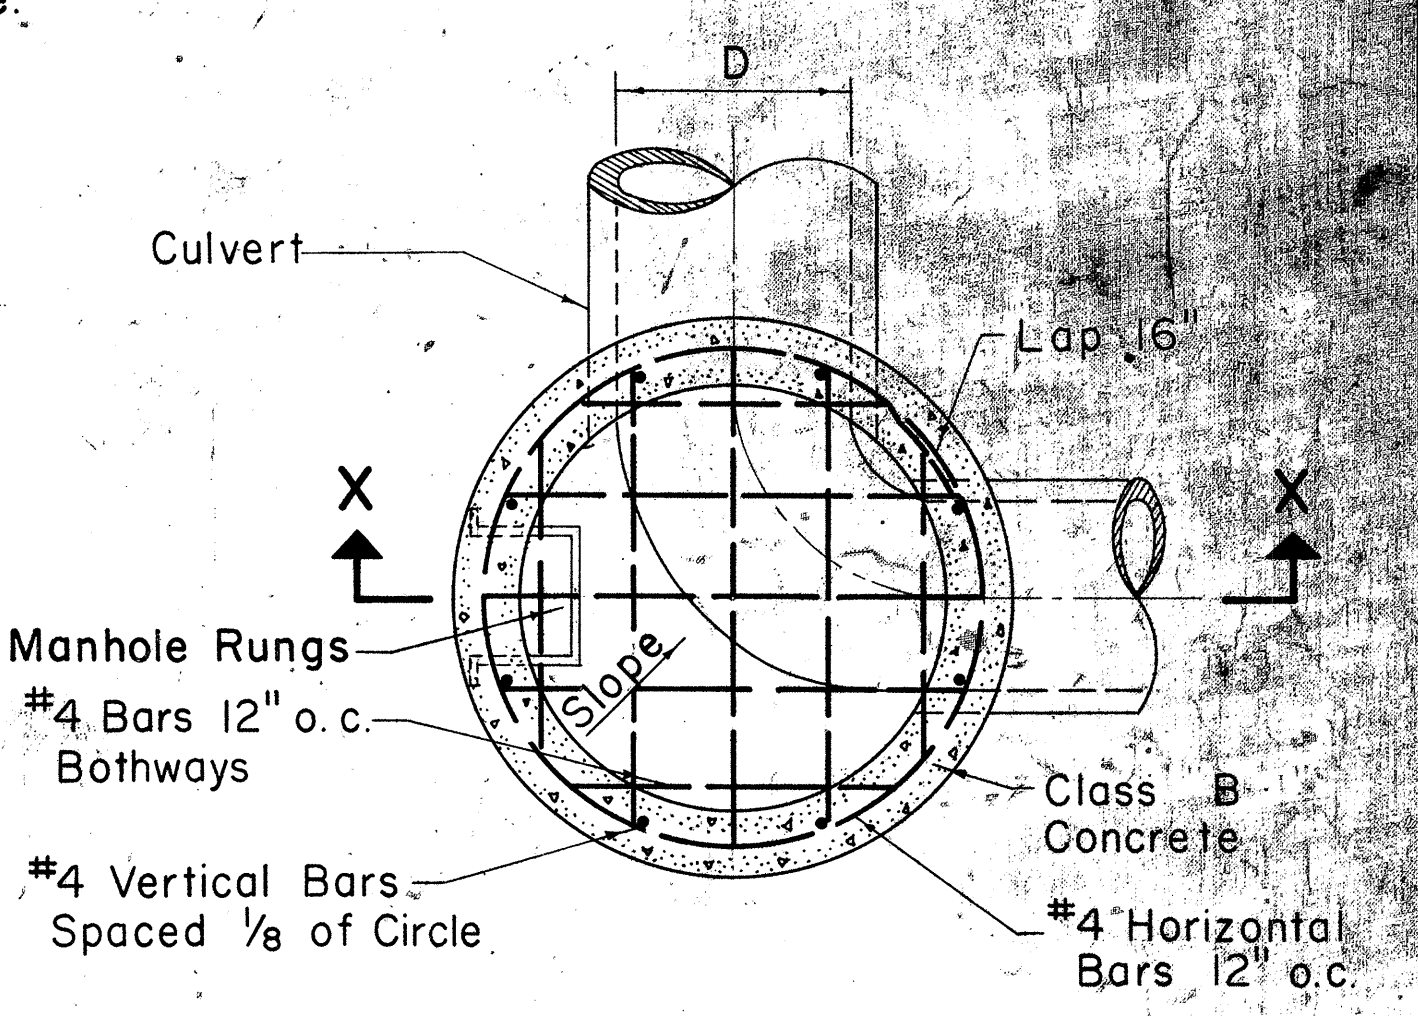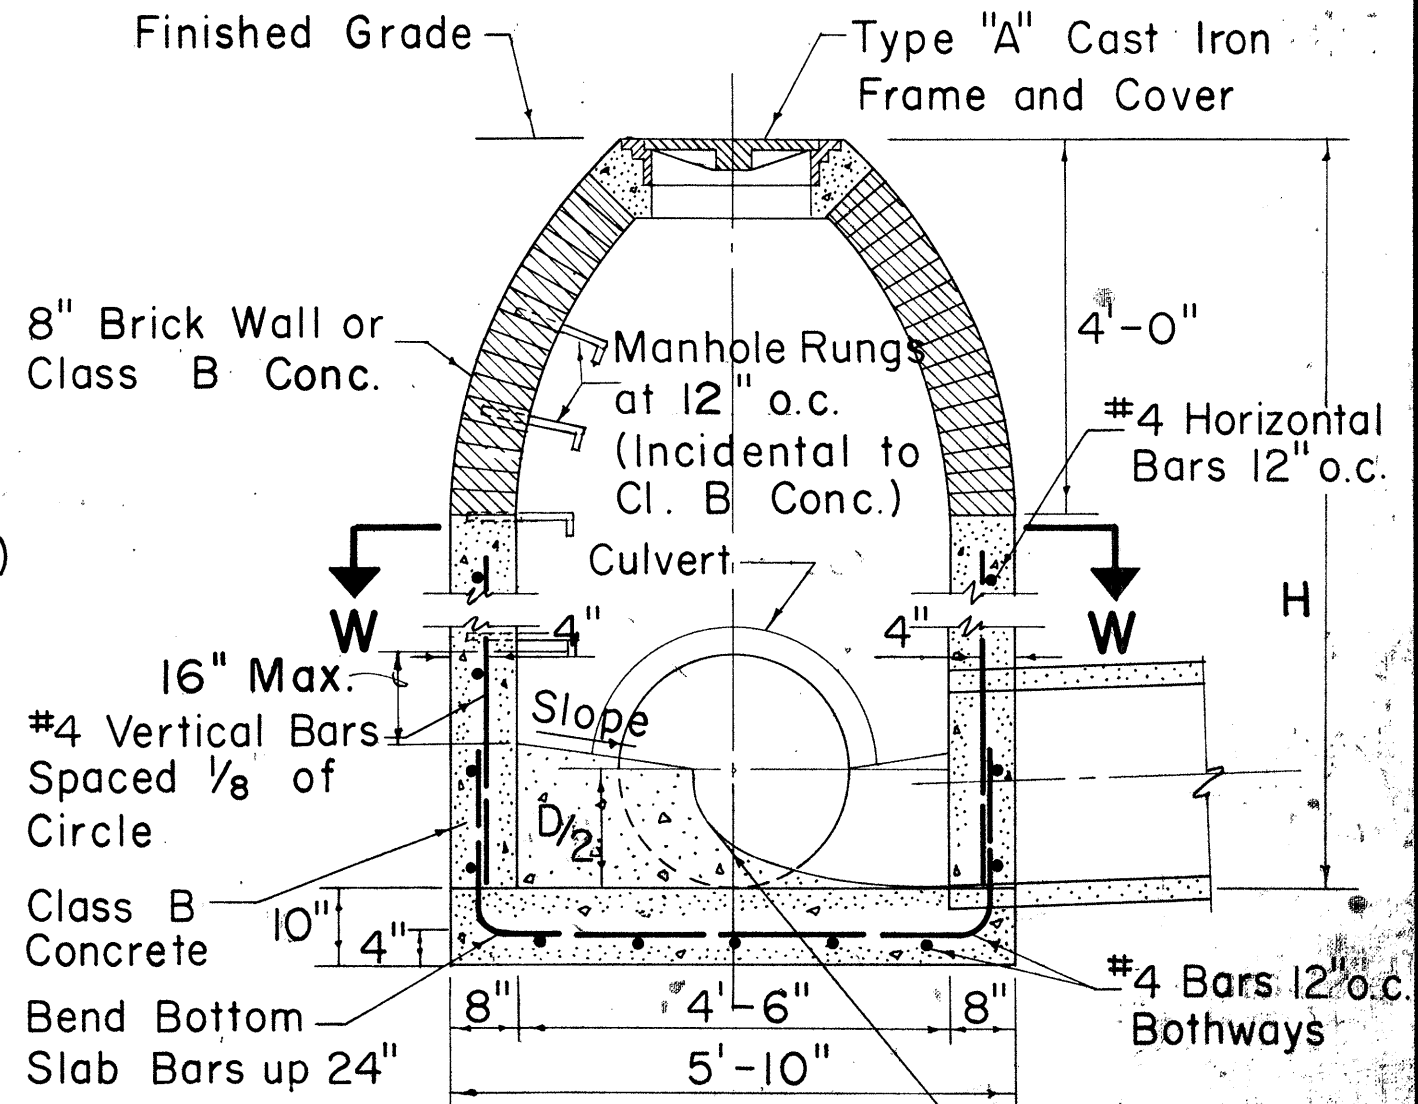

TYPE "E" STORM DRAIN MANHOLE
 Scale: 1/2" = 1'-0"

NO.	REVISION	APPROVED BY	DATE
1	Spacing on Manhole Rungs to conform to OSHA.	HT	1-21-75


APPROVAL RECOMMENDED:	DATE
<i>[Signature]</i>	12-17-69
HYDRAULIC DESIGN ENGINEER	
APPROVED:	DATE
<i>[Signature]</i>	12-17-69
ASST. CHIEF, ENGINEERING	

STATE OF HAWAII DEPARTMENT OF TRANSPORTATION HIGHWAYS DIVISION
STANDARD DETAILS STORM DRAIN MANHOLES
Scales: As Noted Date: July 1, 1969


FED. ROAD DIST. NO.	STATE	FED. AID PROJ. NO.	FISCAL YEAR	SHEET NO.	TOTAL SHEETS
HAWAII	HAW.	Tq-F-078-1(18)	1978	60	266

GENERAL NOTES


1. Manhole Rungs to be placed at 12" o.c. (Manhole Rungs incidental to Class B Concrete)
2. Select appropriate combination of risers and grade rings for required height.
3. All joints to be grouted as set.
4. The precast sections shall be constructed in accordance with the details shown on the plans and to the requirements of ASTM C 478
5. Manufacturers may submit to the Engineer for approval, prior to manufacturing, designs other than those shown on this sheet.
6. Reinforcing steel for precast sections shall be placed in accordance with the requirements of ASTM C 478
7. All Class C Concrete to be incidental to Class B Concrete.

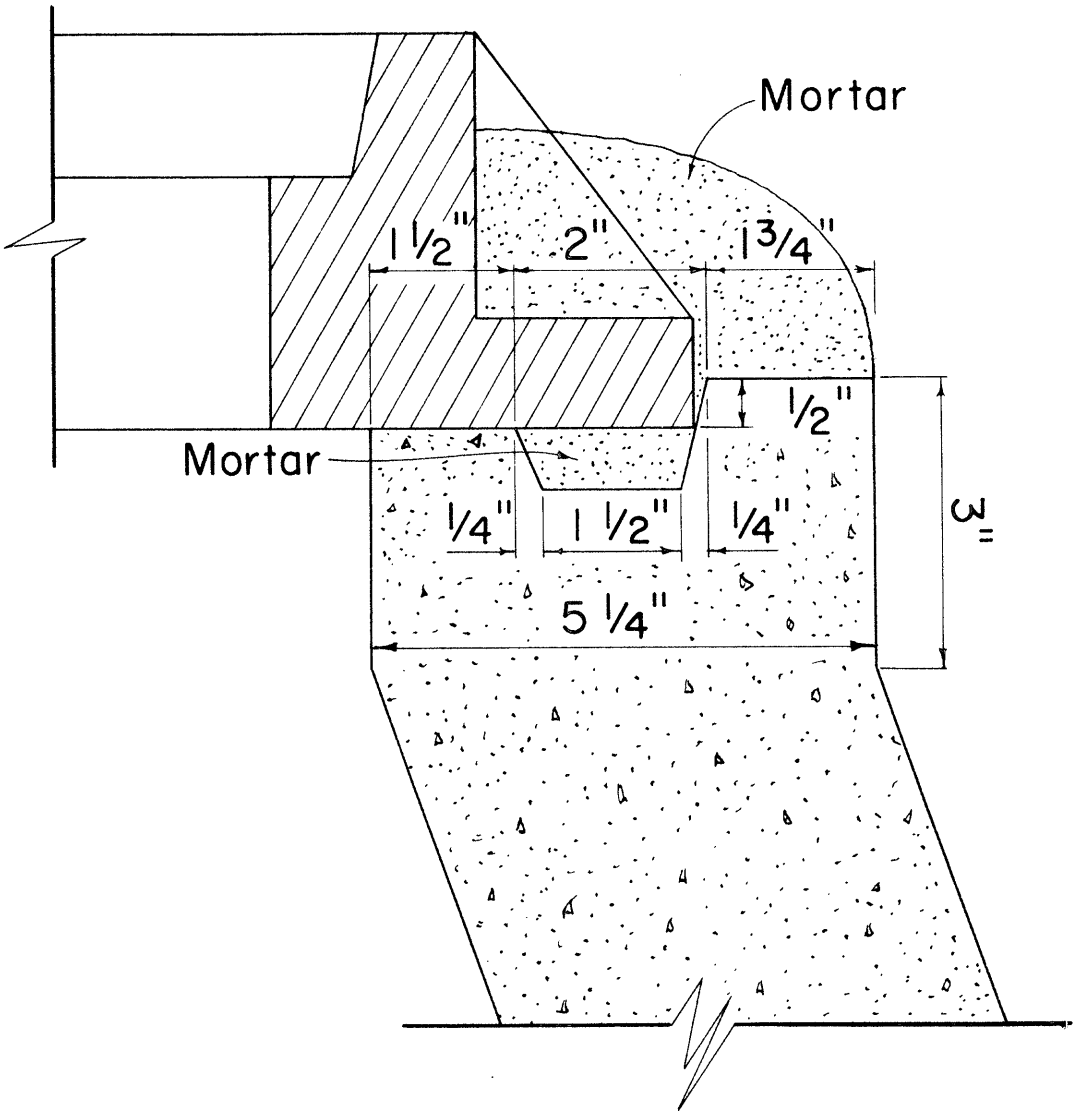


DETAIL "B"
Not to Scale

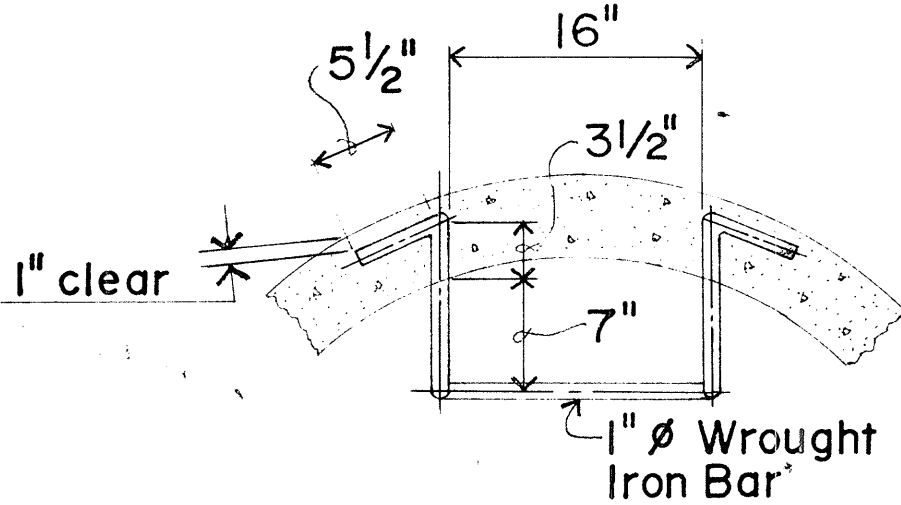

PLAN VIEW

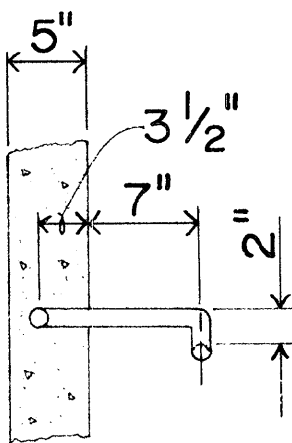


SIDE VIEW

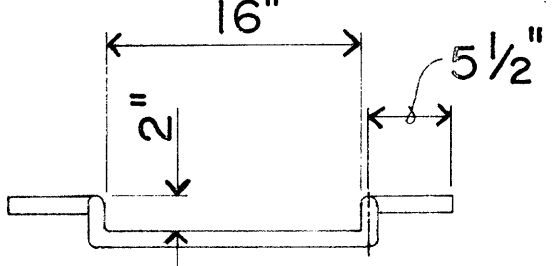


FRONT VIEW


DETAIL OF MANHOLE RUNGS
Not to Scale

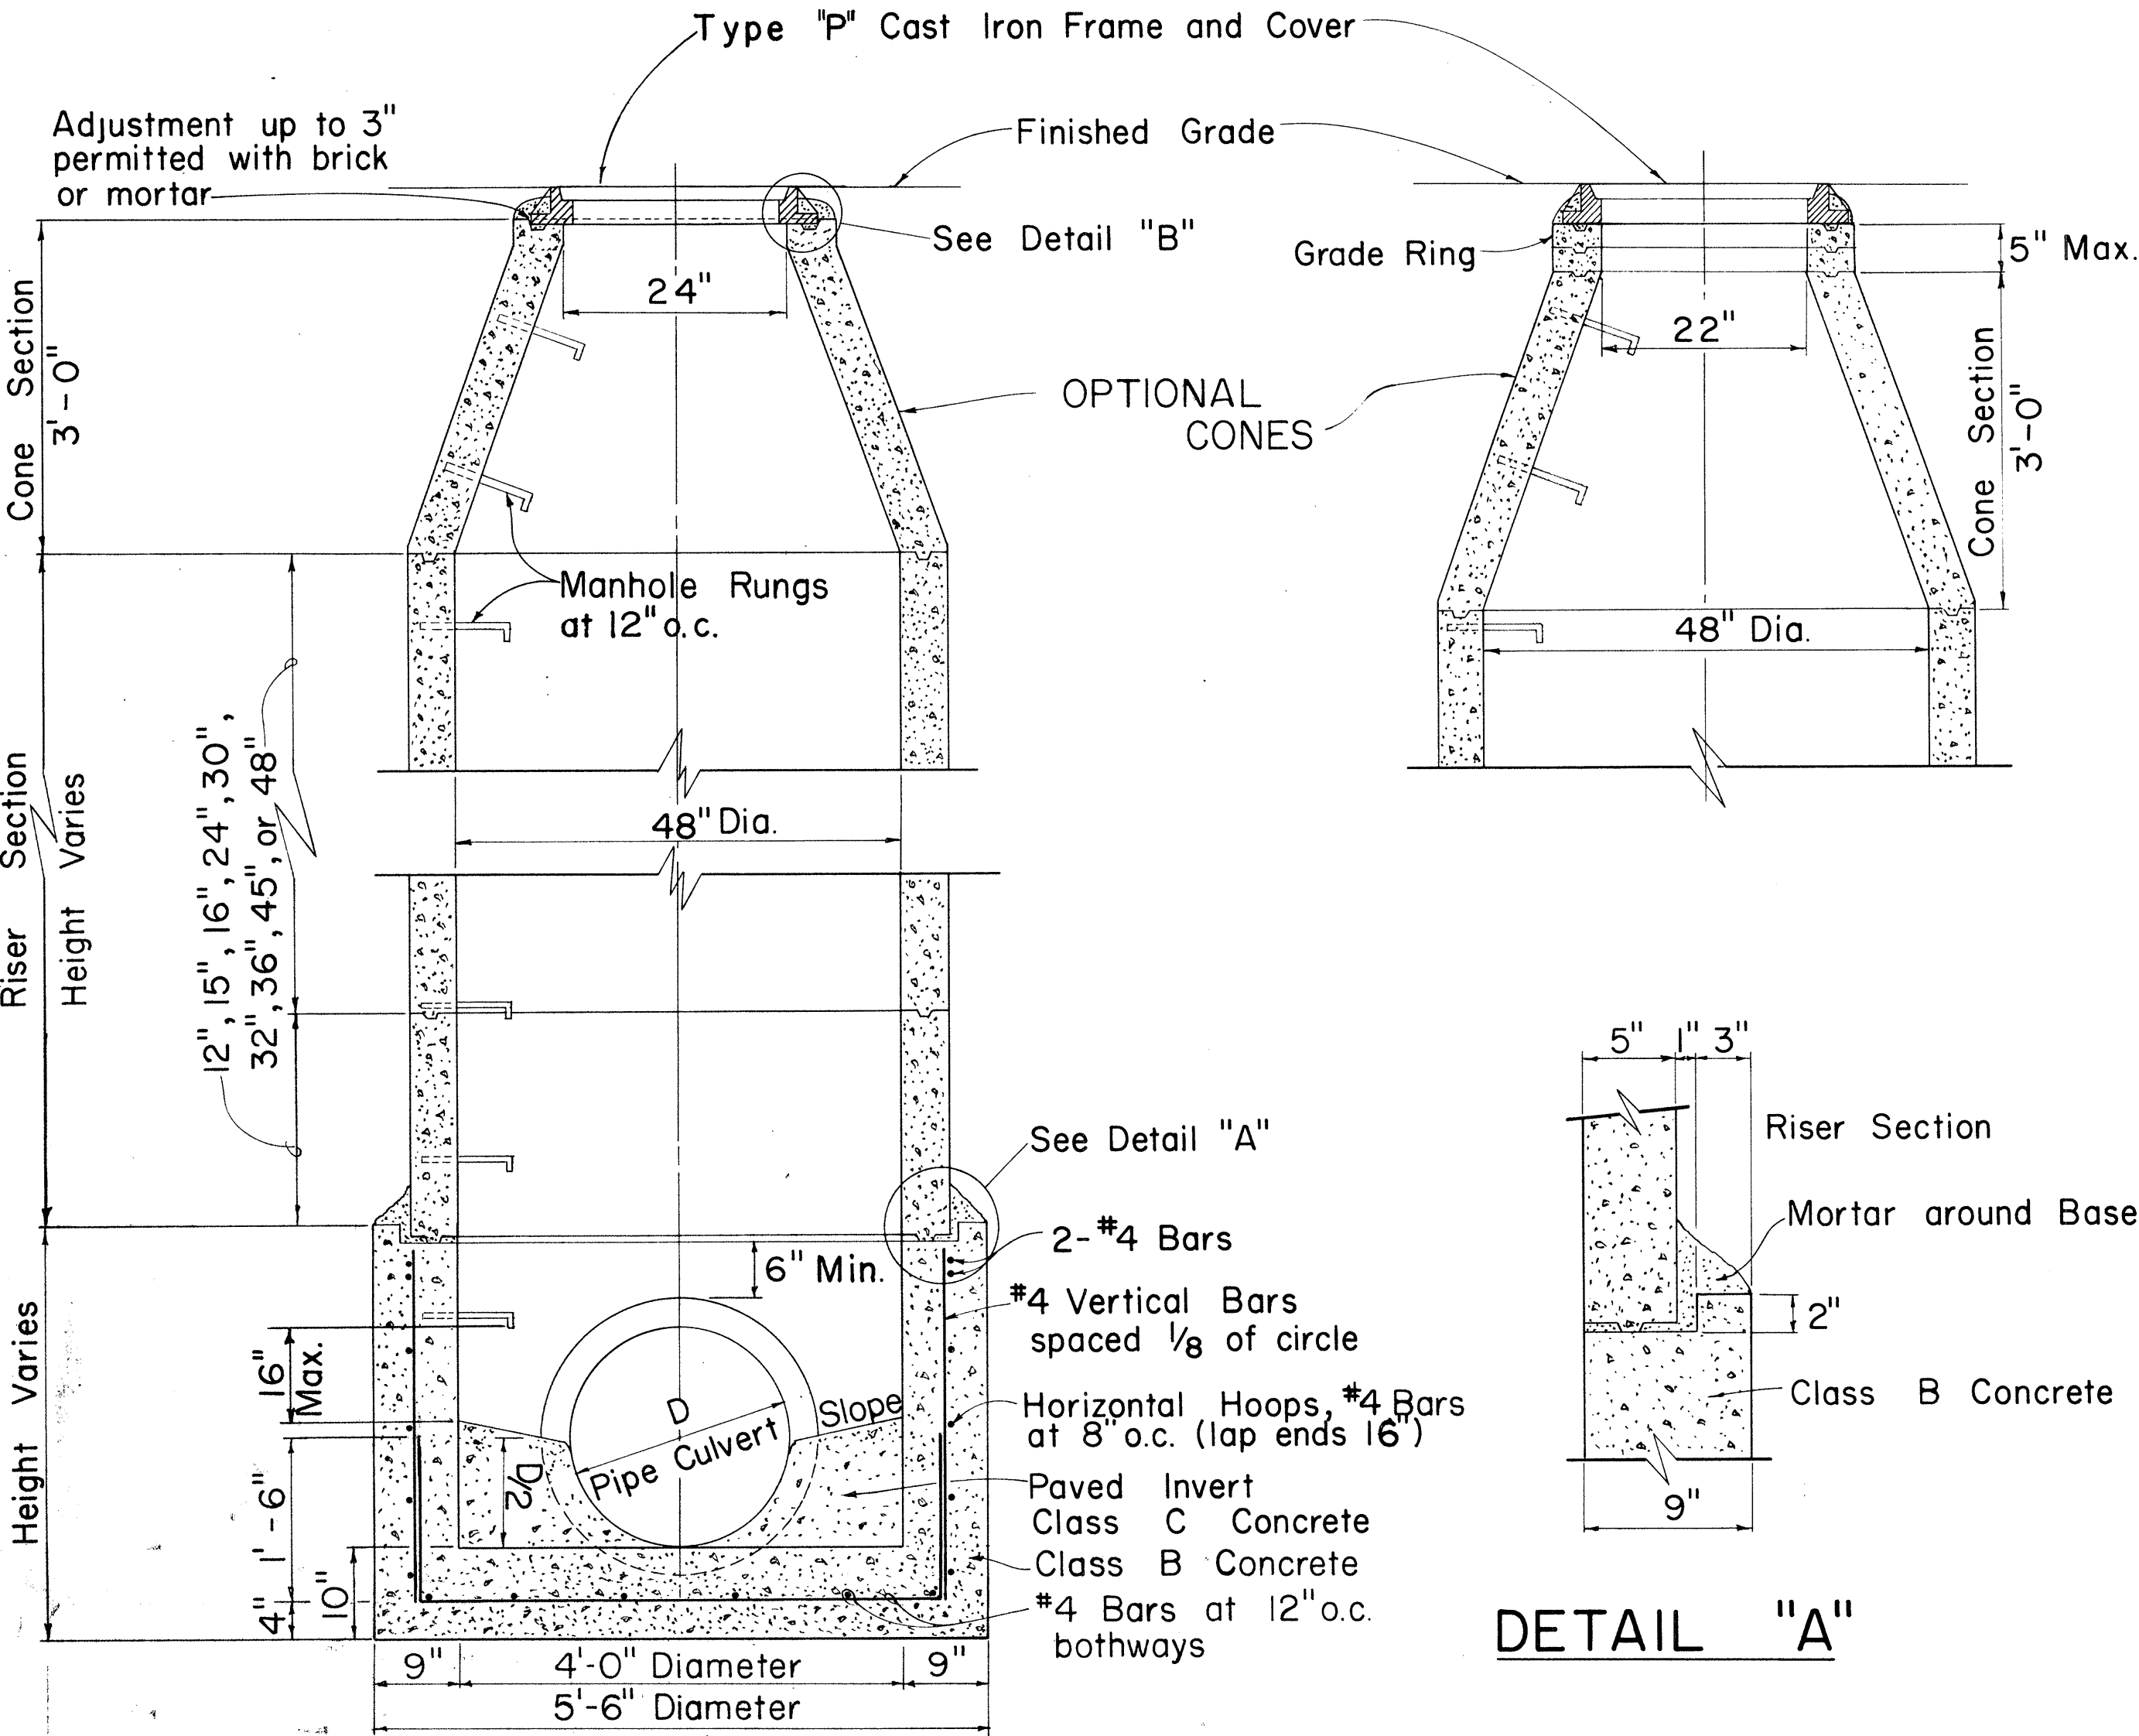

TYPICAL SECTIONS PRECAST CONCRETE MANHOLE
Not to Scale

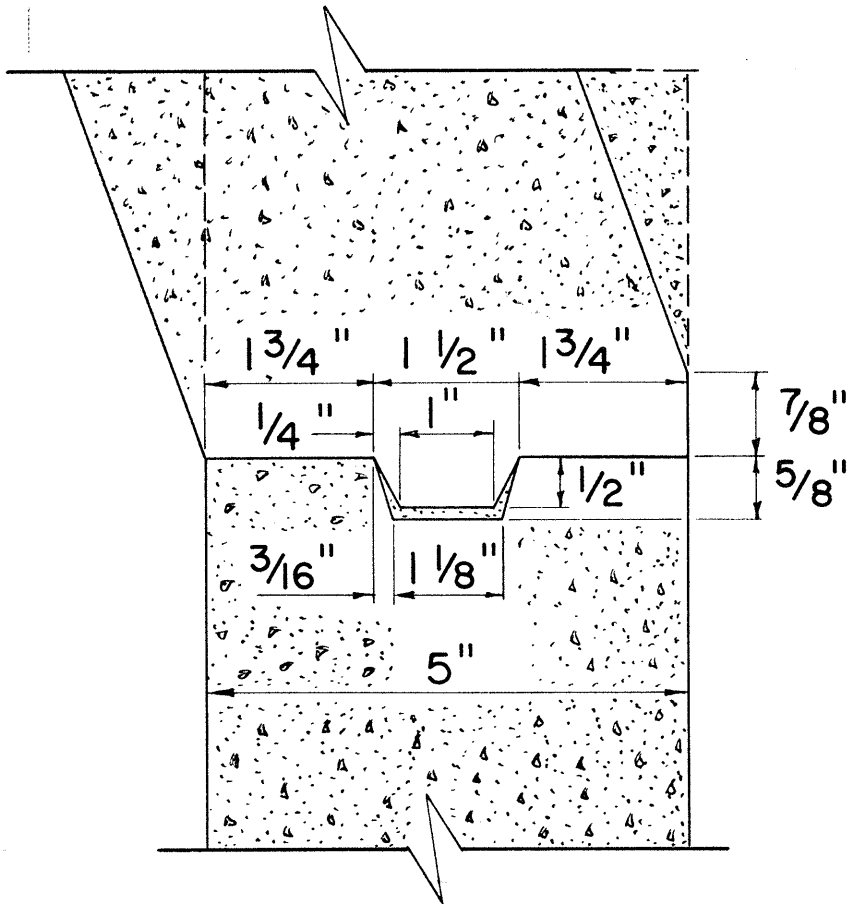

DETAIL FOR RISER JOINTS
Not to Scale

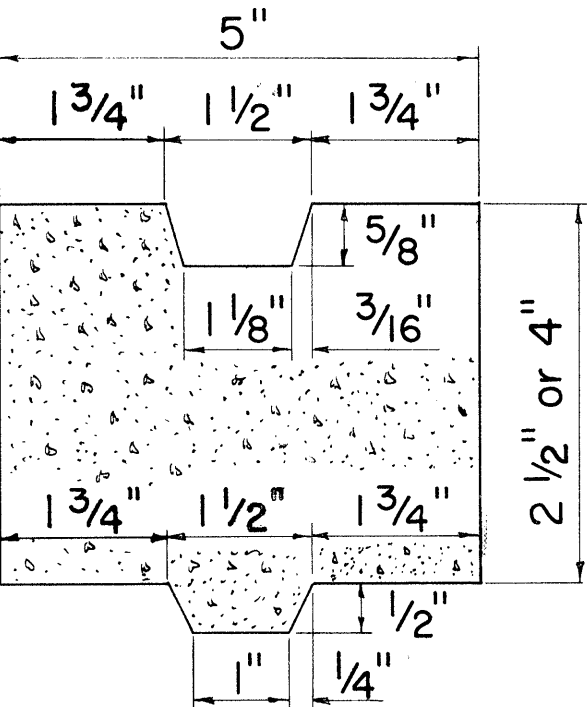

GRADE RING DETAIL
Not to Scale



APPROVAL RECOMMENDED:
[Signature] 2-2-71
HYDRAULIC DESIGN ENGINEER DATE
APPROVED:
[Signature] 2-23-71
ASSISTANT CHIEF, ENGINEERING DATE

NO.	REVISION	APPROVED BY	DATE
1	Spacing and details of Manhole Rungs to conform to OSHA	H.T.	2/23/70

STATE OF HAWAII
DEPARTMENT OF TRANSPORTATION
HIGHWAYS DIVISION
STANDARD DETAILS
PRECAST CONCRETE
STORM DRAIN MANHOLES
Not to Scale
Date: Nov. 1970
SHEET No. 5 OF 10 SHEETS DH 5A










SURVEY PLOTTED BY	DATE
PLAN	" "
DESIGNED BY	" "
NOTE BOOK	" "
QUANTITIES BY	" "
CHECKED BY	" "
NO.	" "

FED. ROAD DIST. NO.	STATE	FED. AID PROJ. NO.	FISCAL YEAR	SHEET NO.	TOTAL SHEETS
HAWAII	HAW.	TQ-F-078-1(6)	1978	61	266

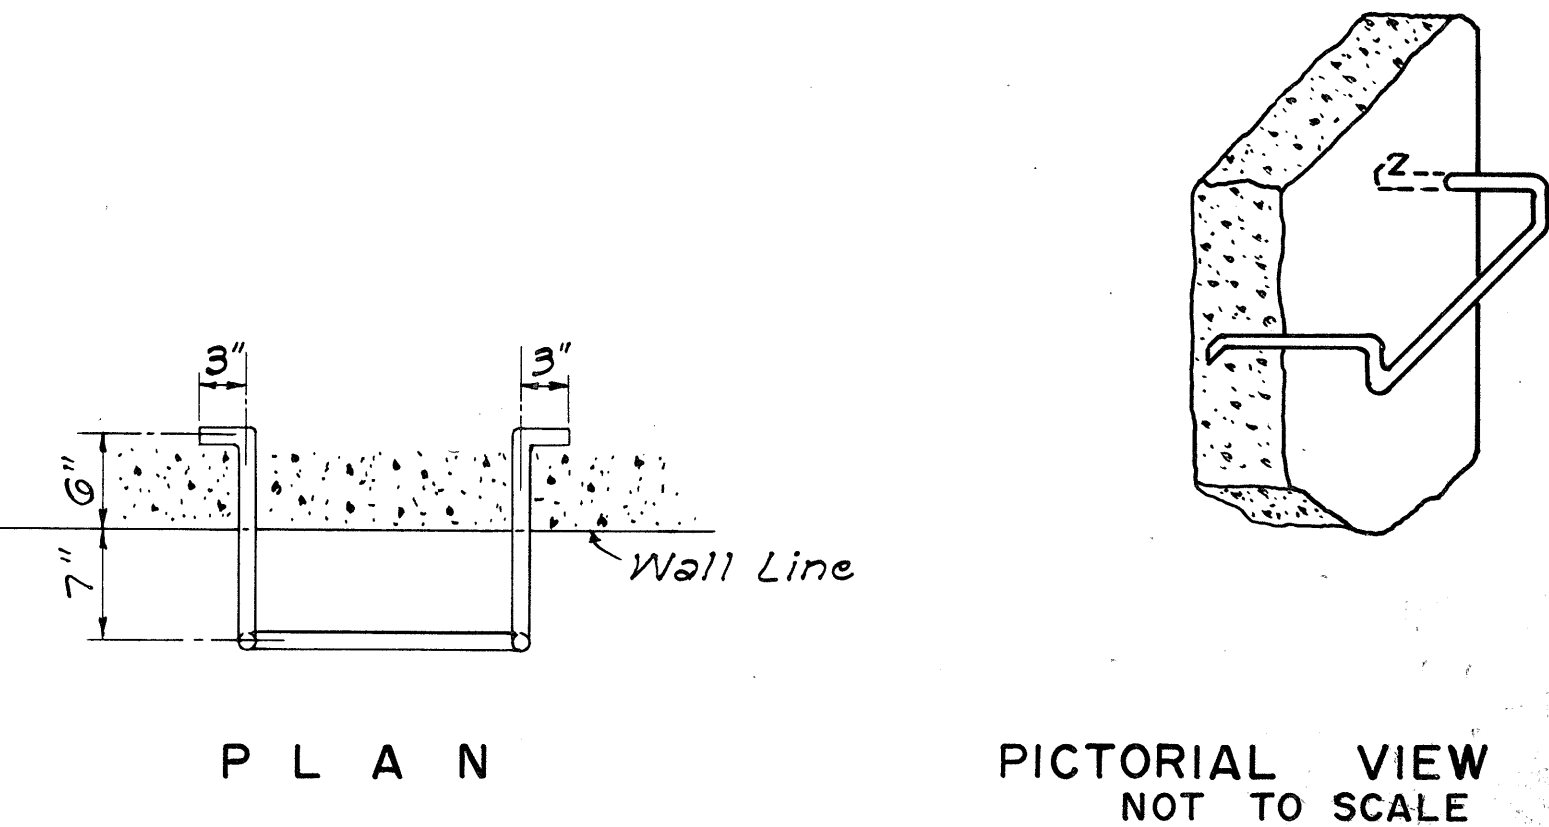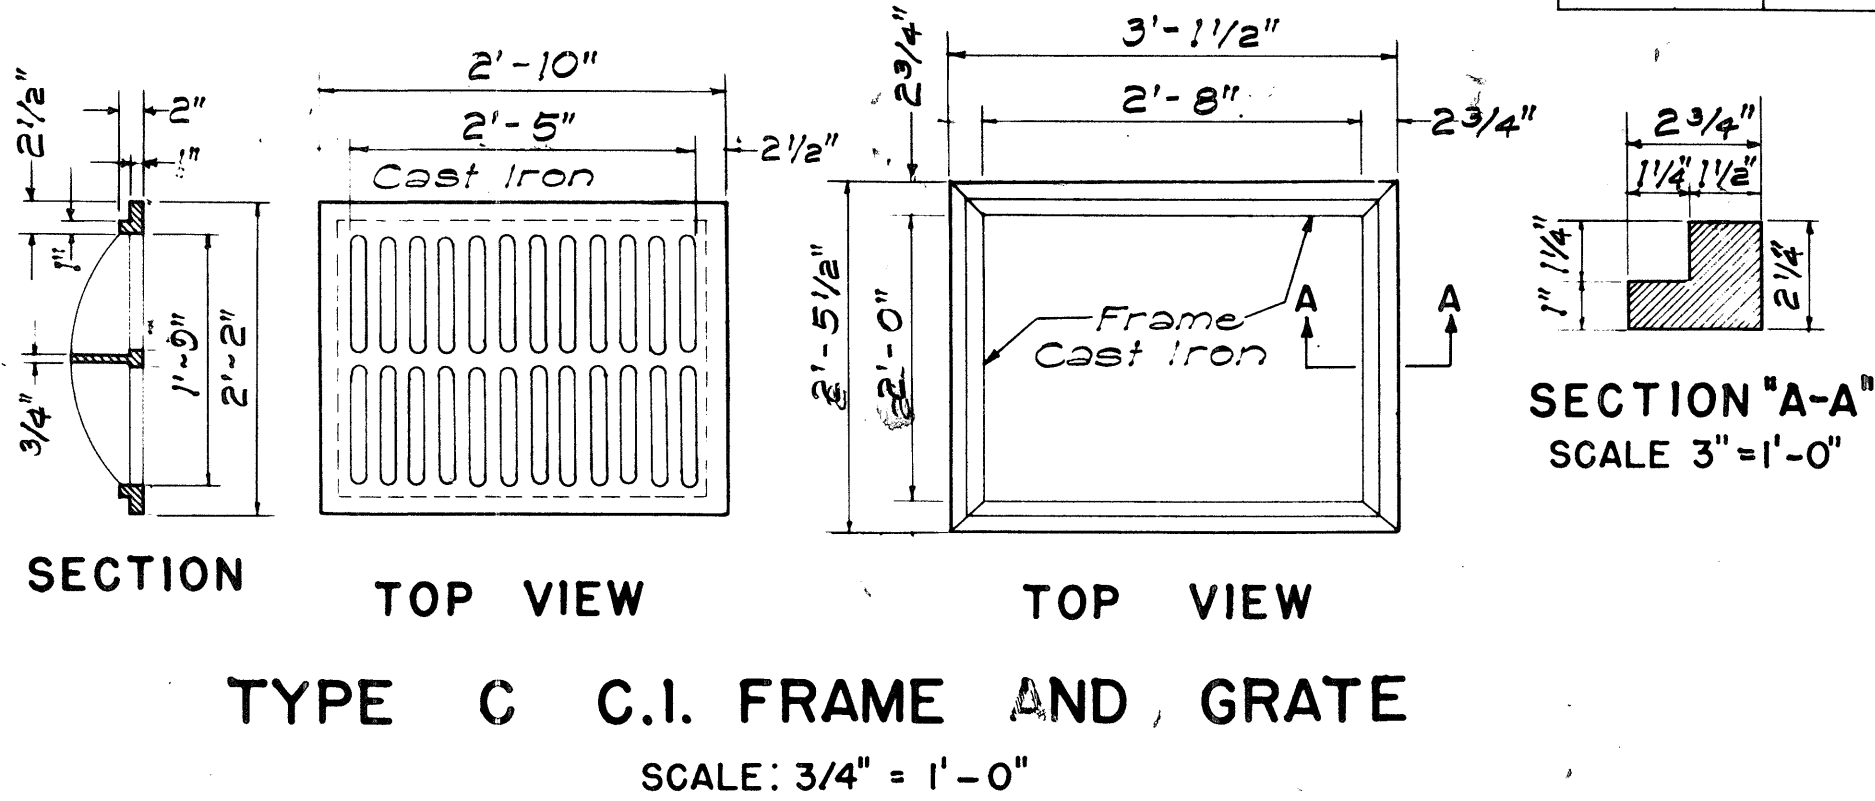

NO.	REVISION	APPROVED BY	DATE
1.	Detail of Type "P" Cast Iron Frame and Cover	H.T.	1-6-71
2.	Details of Manhole Rungs to conform to OSHA.	H.T.	1-21-75
3.	Option for Manhole Rungs	H.T.	1-18-76

STATE OF HAWAII DEPARTMENT OF TRANSPORTATION HIGHWAYS DIVISION	
STANDARD DETAILS CATCH BASIN AND MANHOLE CASTINGS	
Scale: As Noted	Date: July, 1969
SHEET NO. 61 OF 10 SHEETS	

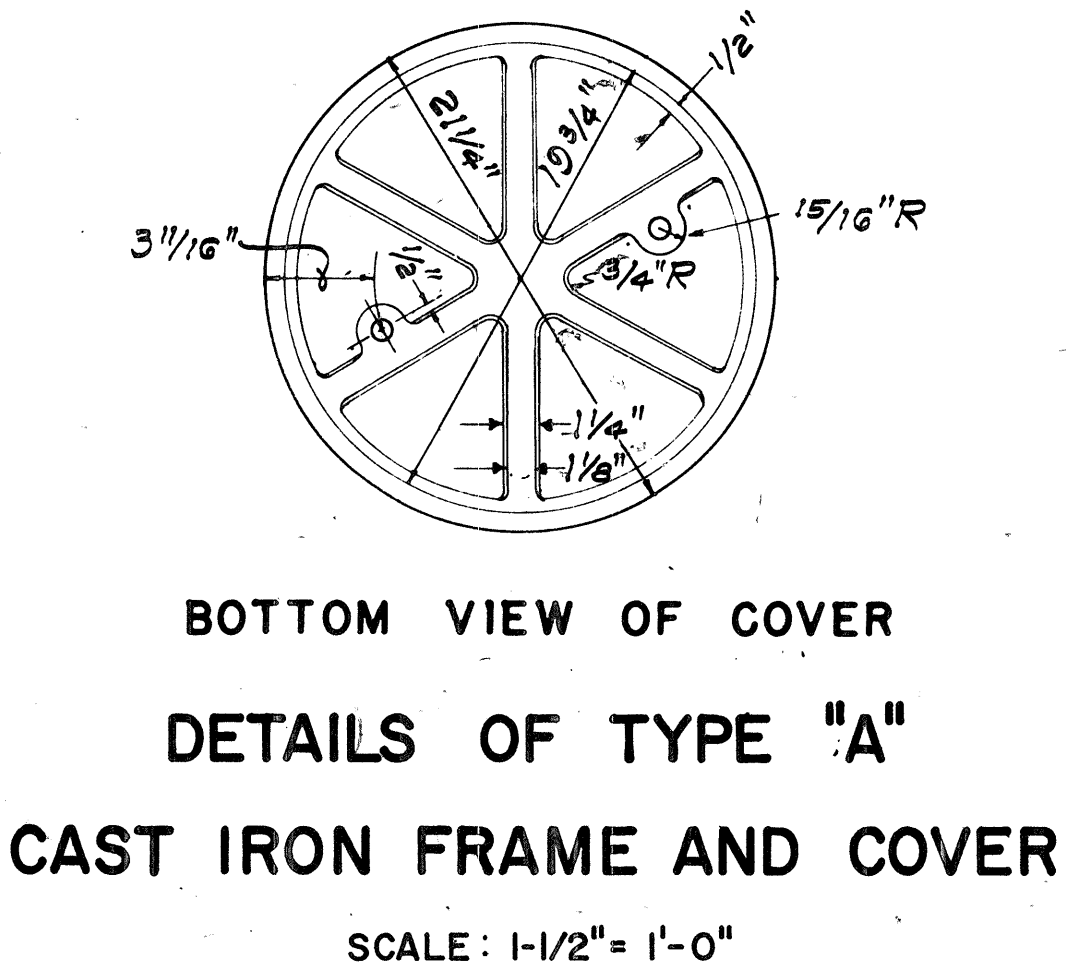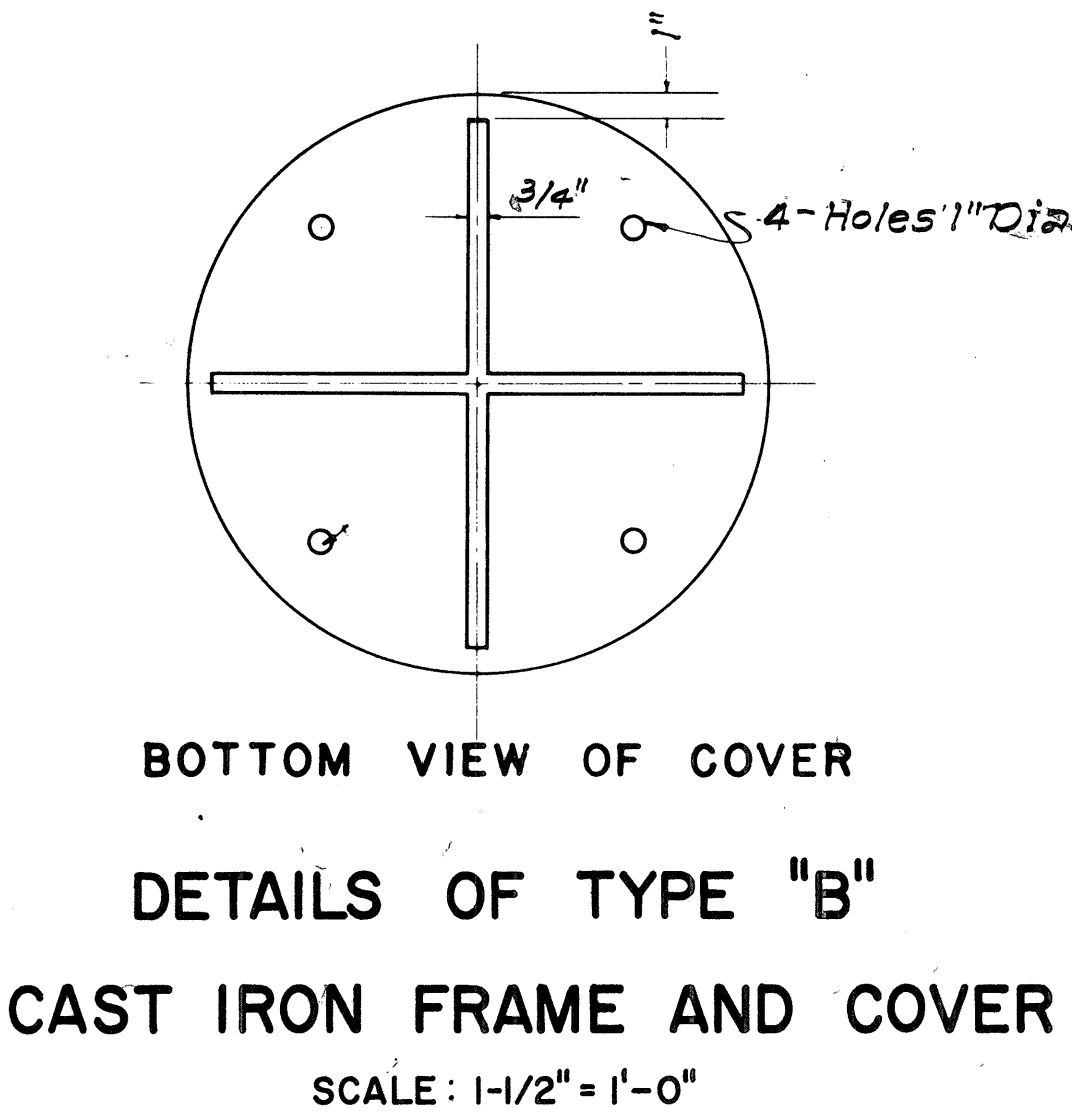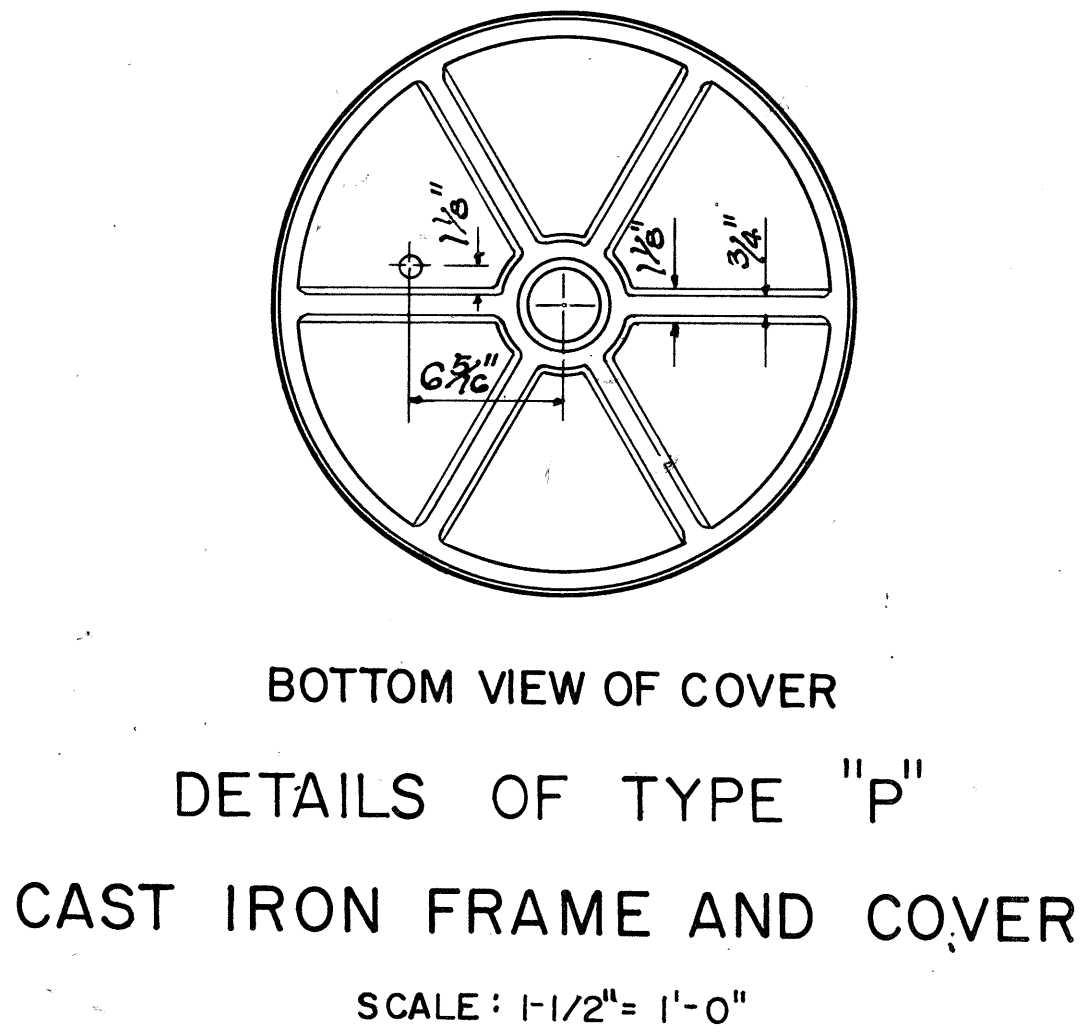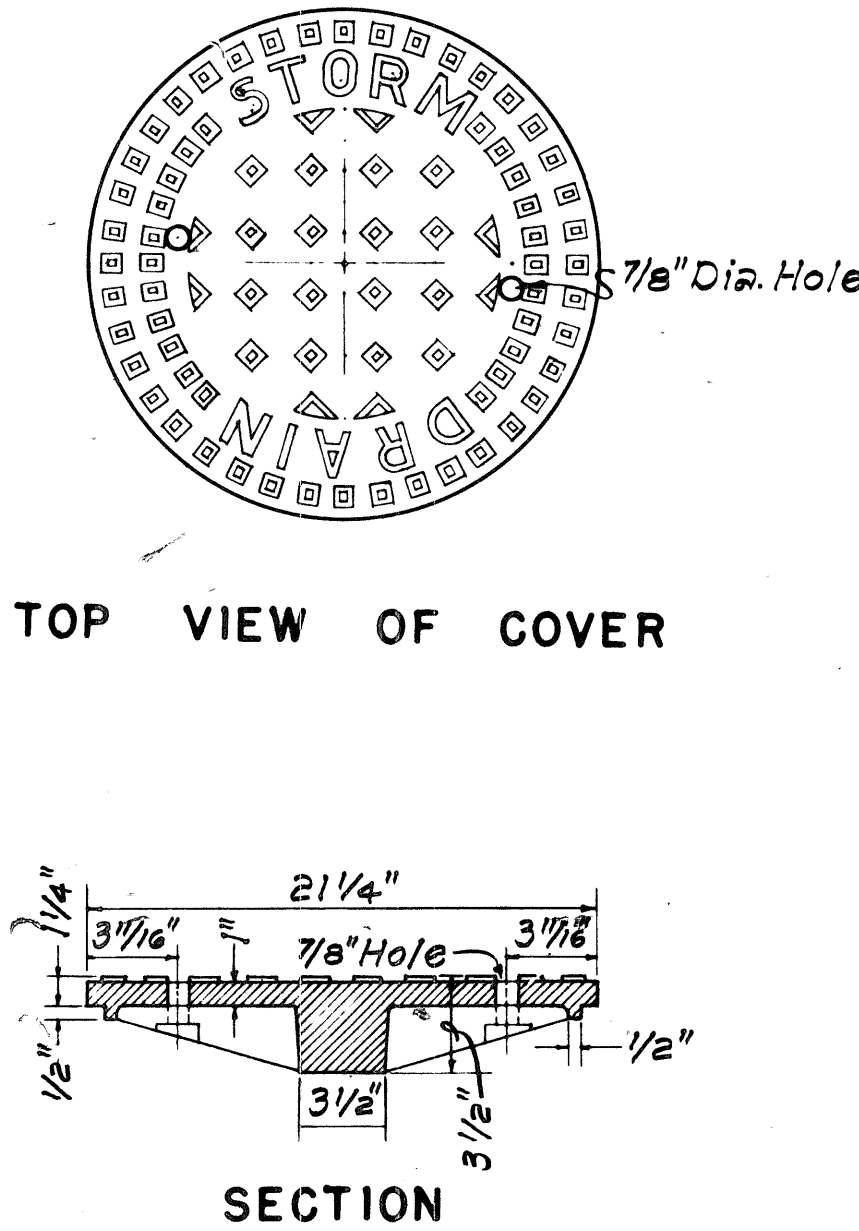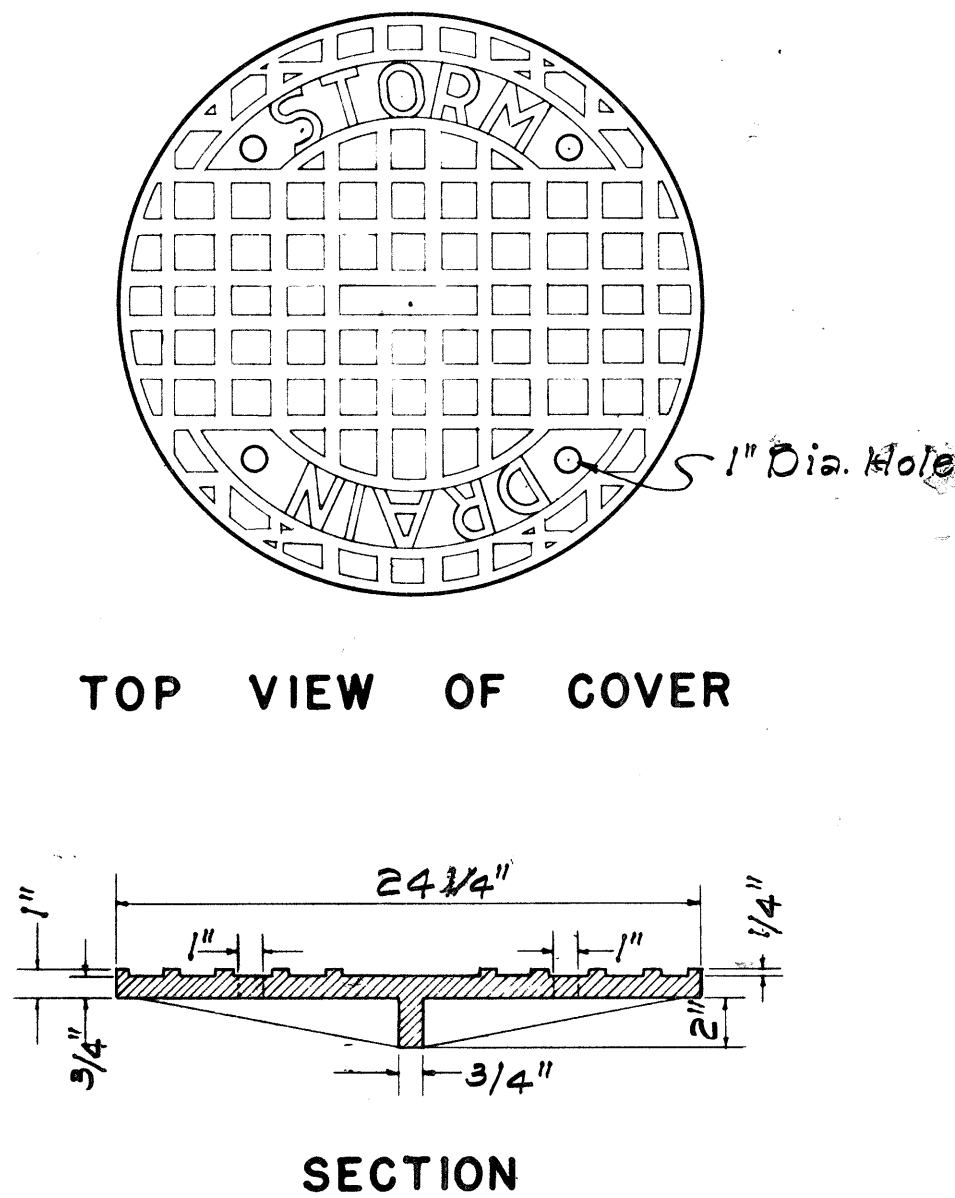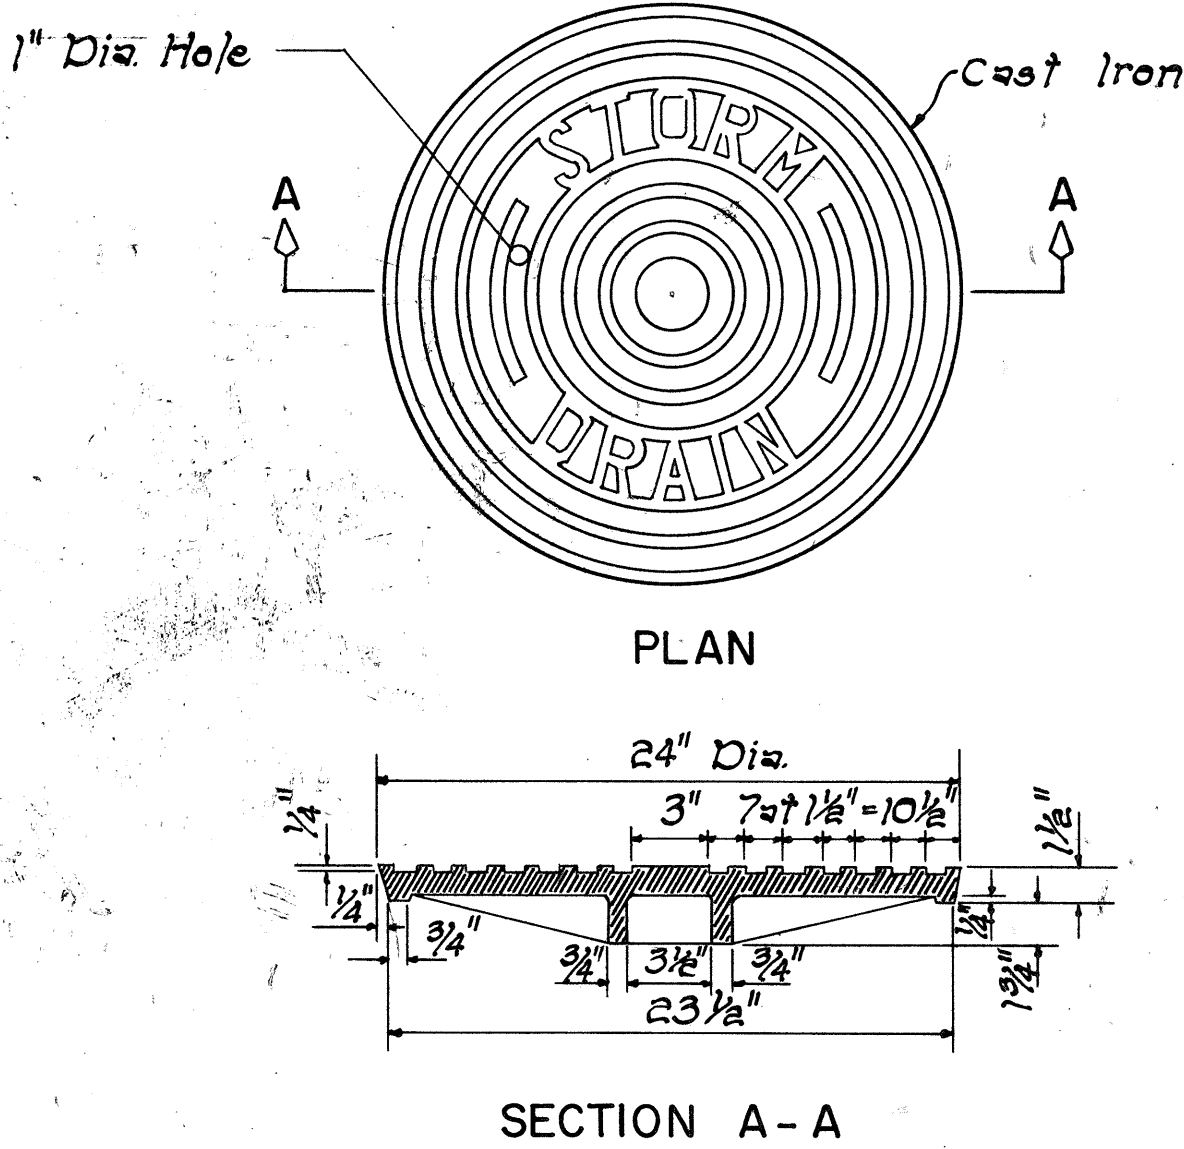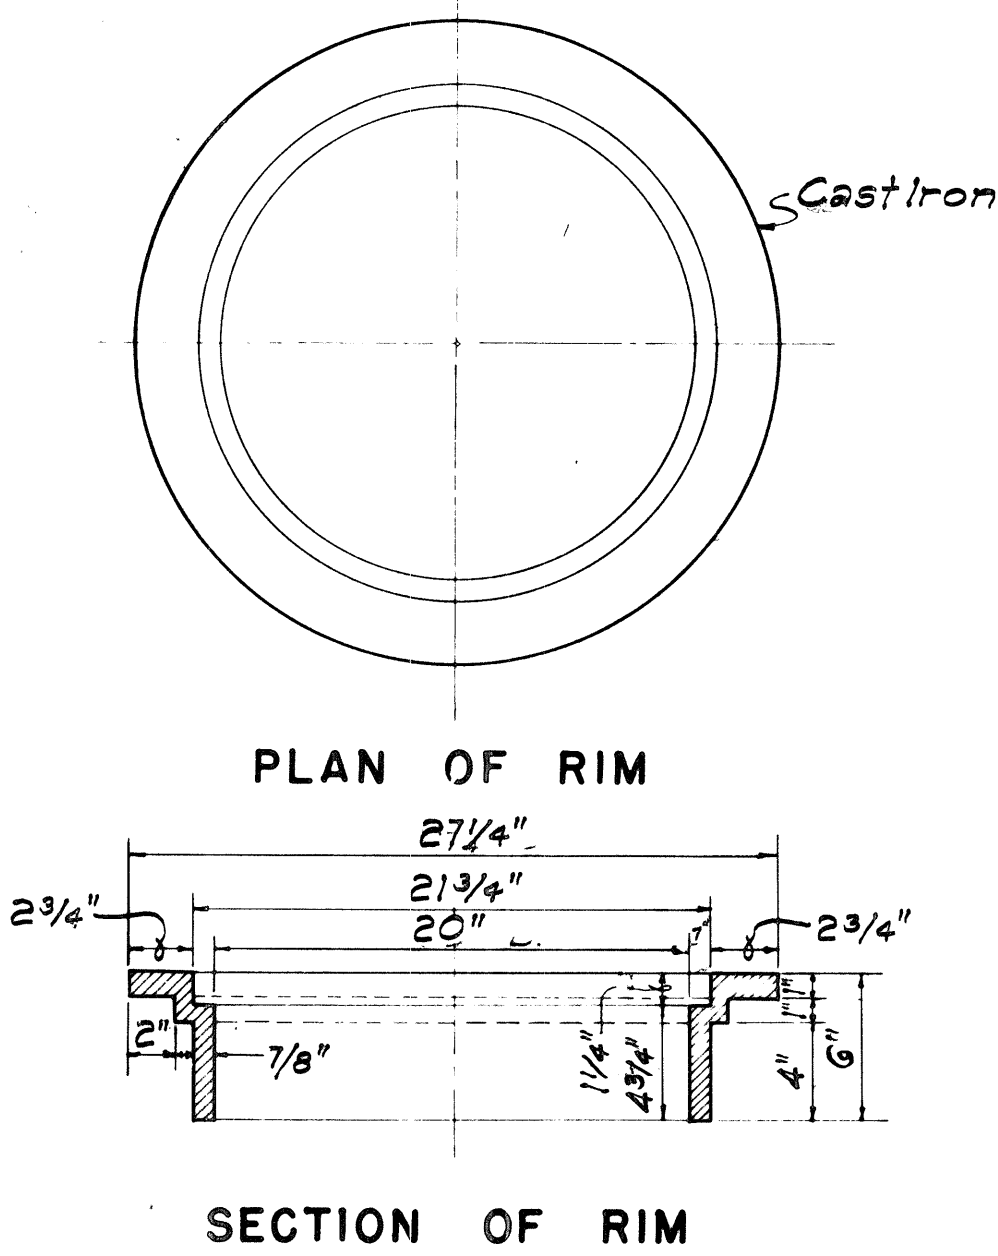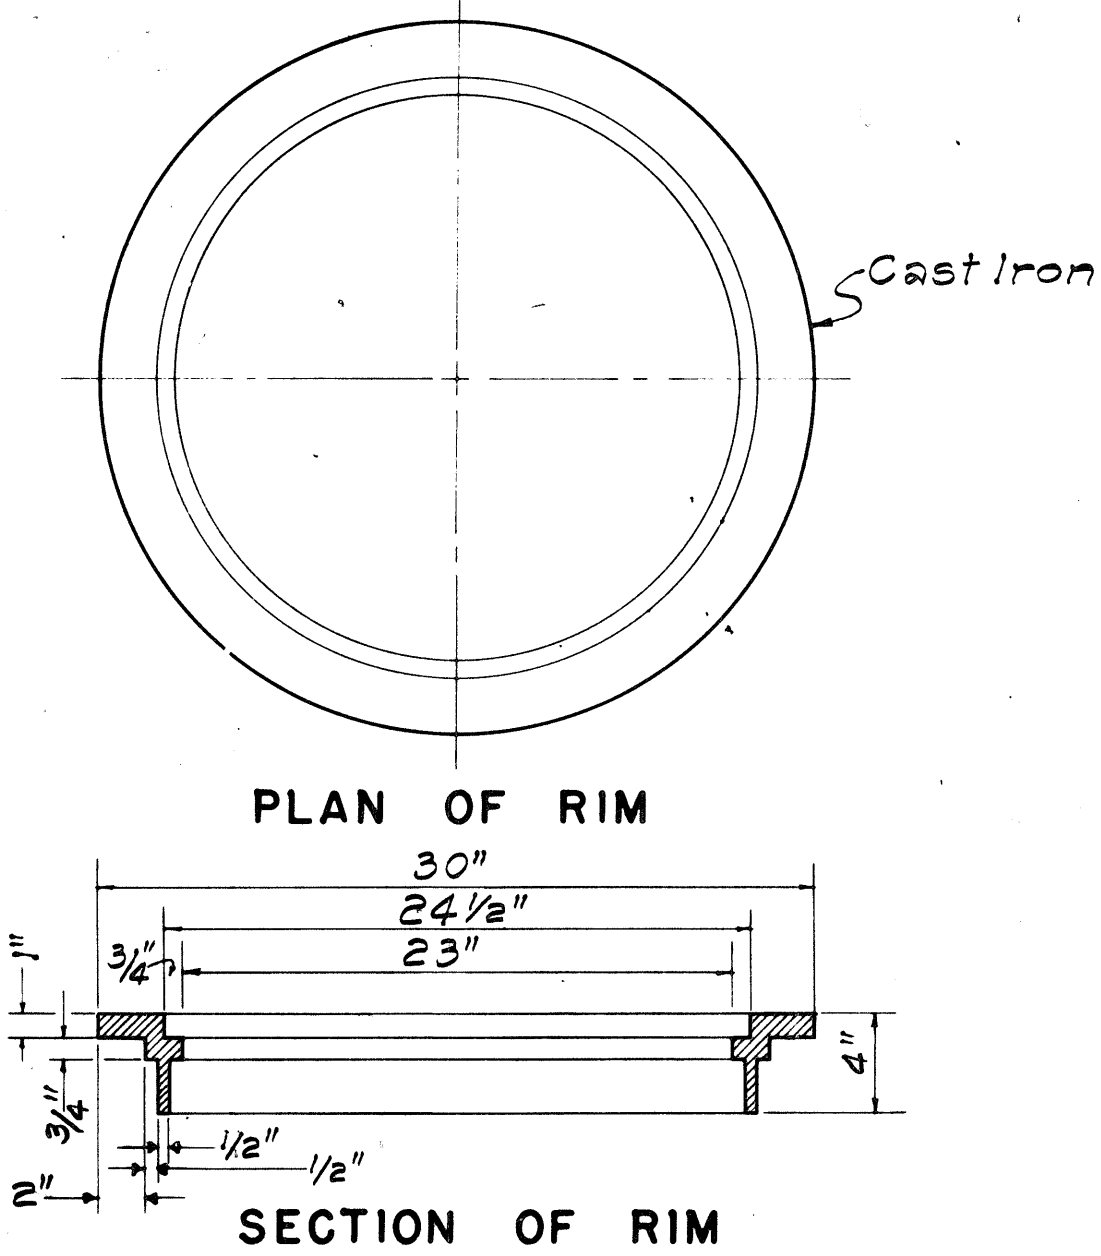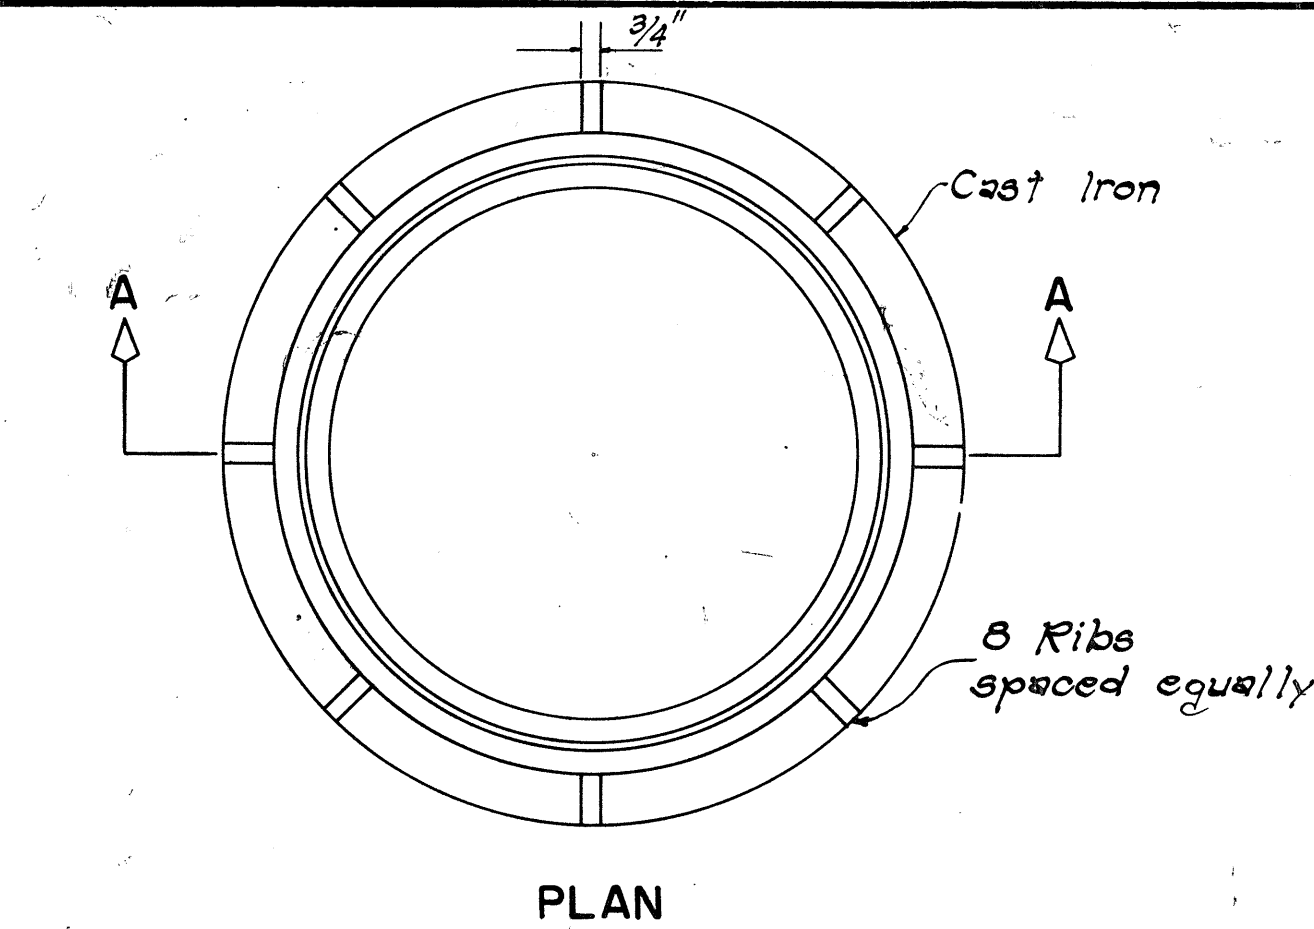

APPROVAL RECOMMENDED:		12-17-69
HYDRAULIC DESIGN ENGINEER		DATE
APPROVED:		12-17-69
ASSISTANT CHIEF, ENGINEERING		DATE

FED. ROAD DIST. NO.	STATE	FED. AID PROJ. NO.	FISCAL YEAR	SHEET NO.	TOTAL SHEETS
HAWAII	HAW.	10-F-078(10)	1978	62	266

GENERAL NOTES

- Contractor has the option of using cast malleable iron, cast steel, welded, bolted, cast malleable iron end block or cast steel end block grate.
- Grates and Frames shall be hot dip galvanized after fabrication, see specifications.
- All welds 3/8" unless otherwise noted.
- Center support assembly shall be used when two or more grates are specified. Incidental to Types A-9 or A-12 Frame and Grates.
- Refer to "Grate Bar Spacing Table" for Types A-9 and A-12 Grate dimensions.
- The various materials shall conform to the specifications of ASTM as listed in the following tabulation and the Std. Specifications.

Material	ASTM Designation
Structural Steel	A283, Grade D
Cast Steel	A27, Grade 65-35
Malleable Iron Casting	A47, Gr. No. 35018

GRATE BAR SPACING TABLE

TYPE	NO. BARS	CLEAR BAR SPACING-W	X
A-9	9	2"	1 9/16"
A-12	12	1 3/8"	1 1/4"

NOTE:

- Type A-9 - Use in locations off the roadbed on all types of highways.
- Type A-12 - Use within the roadbed on all types of highways.

APPROVAL RECOMMENDED:

[Signature] 12-17-69
HYDRAULIC DESIGN ENGINEER DATE

APPROVED:


[Signature] 12-11-69
ASSISTANT CHIEF, ENGINEERING DATE

STATE OF HAWAII
DEPARTMENT OF TRANSPORTATION
HIGHWAYS DIVISION


STANDARD DETAILS

TYPE A-9 AND A-12
FRAMES AND GRATES

Scales: As Noted Date: Aug. 1968

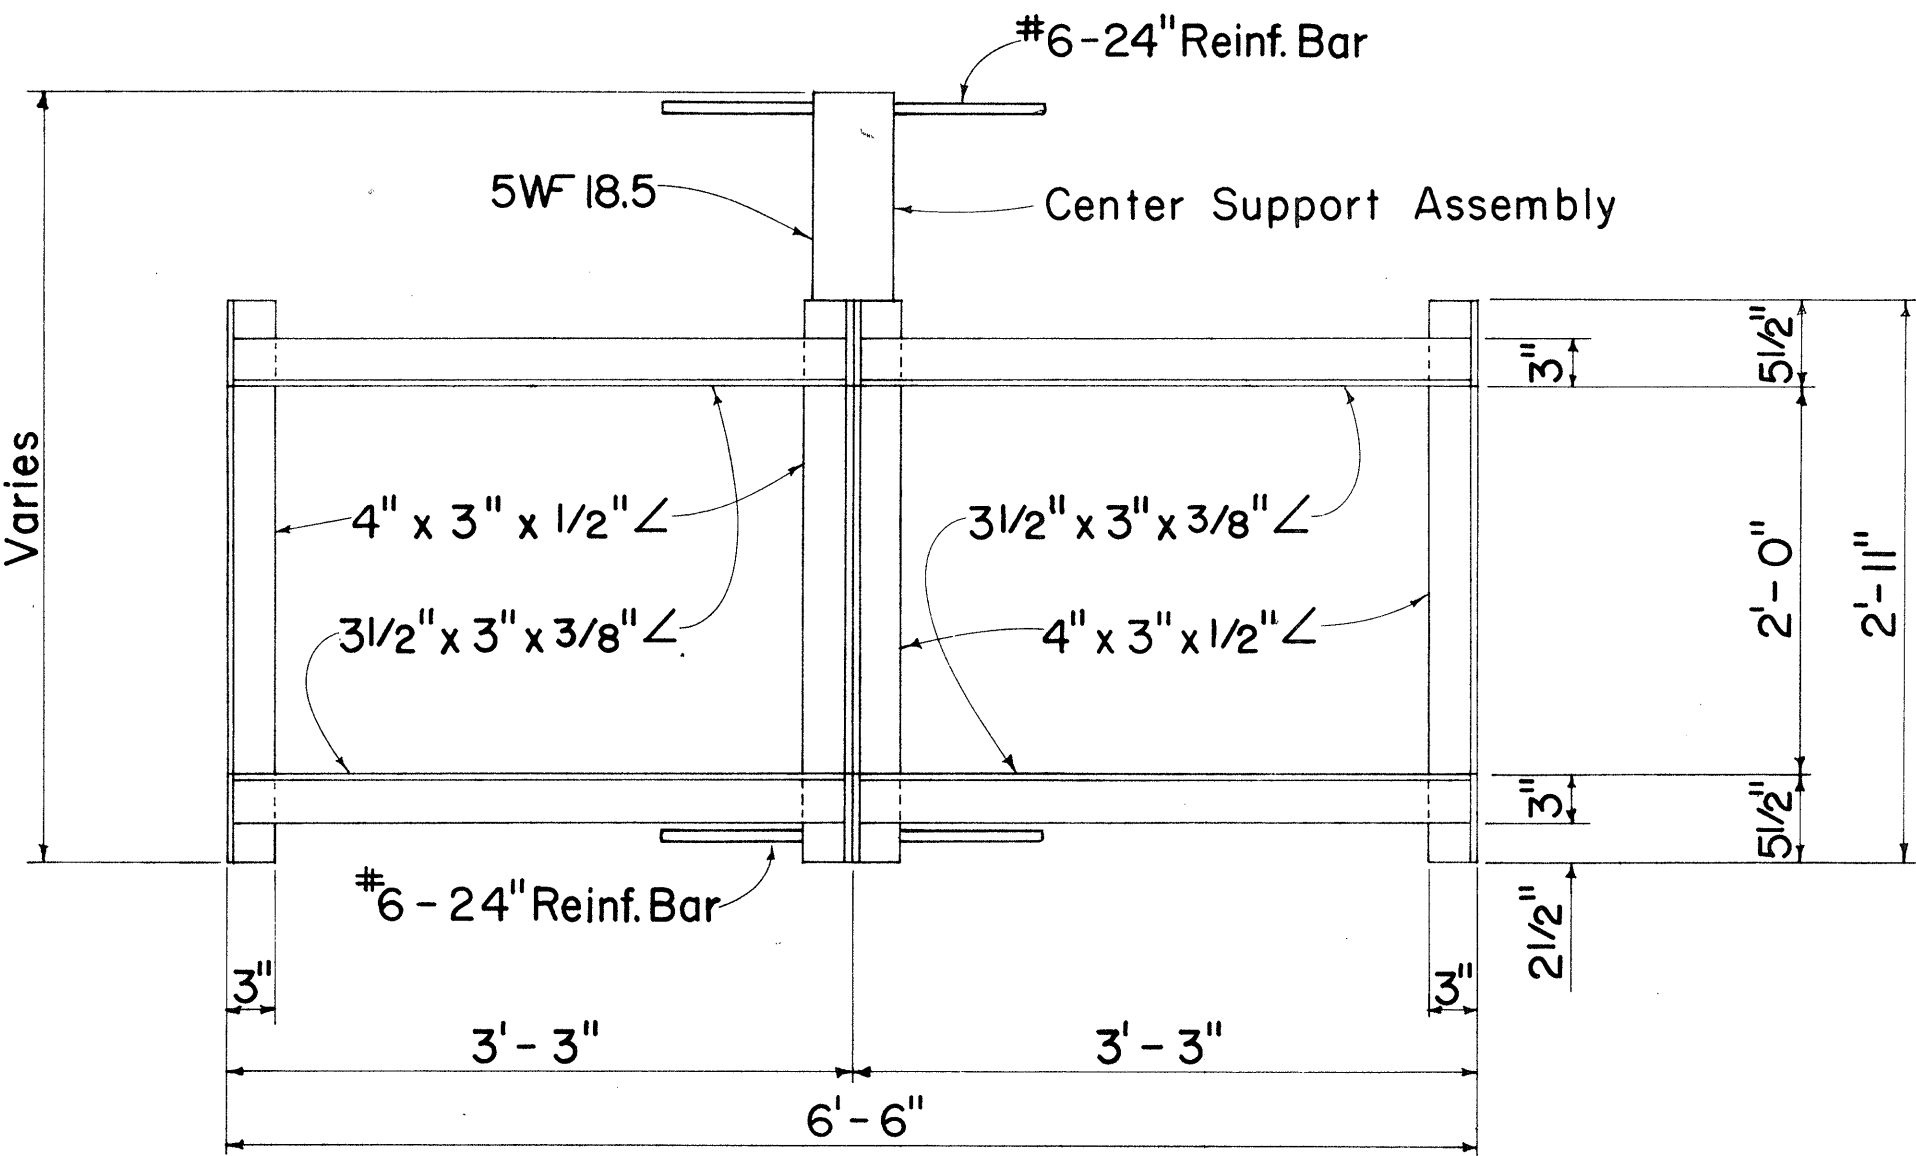


PLAN
(Two or More Grates)

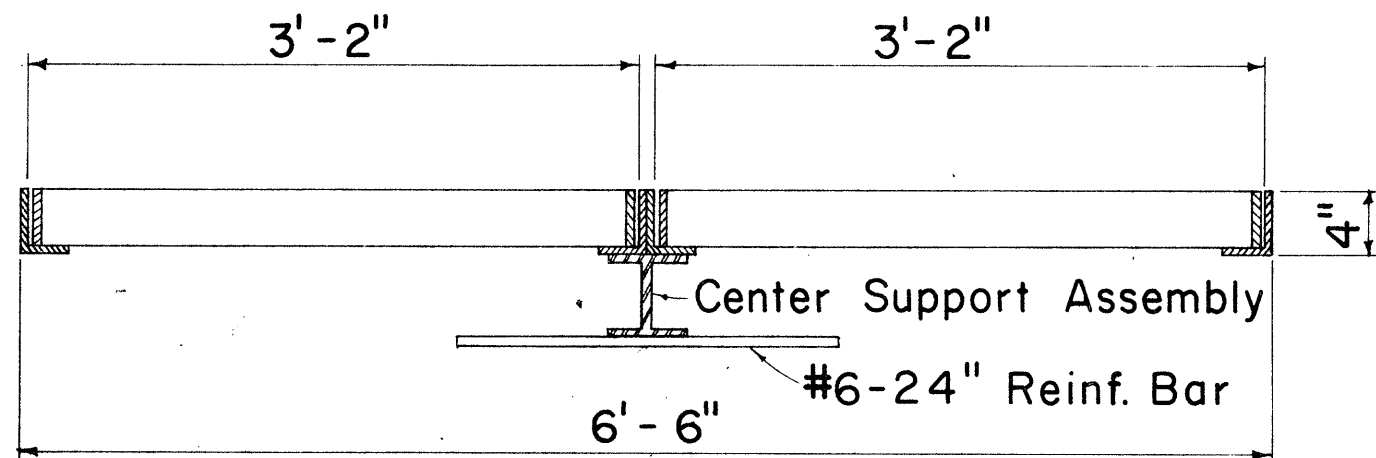

LONGITUDINAL SECTION
(Thru Frame & Grate)

FRAME DETAILS


Scale: 1"= 1'- 0"

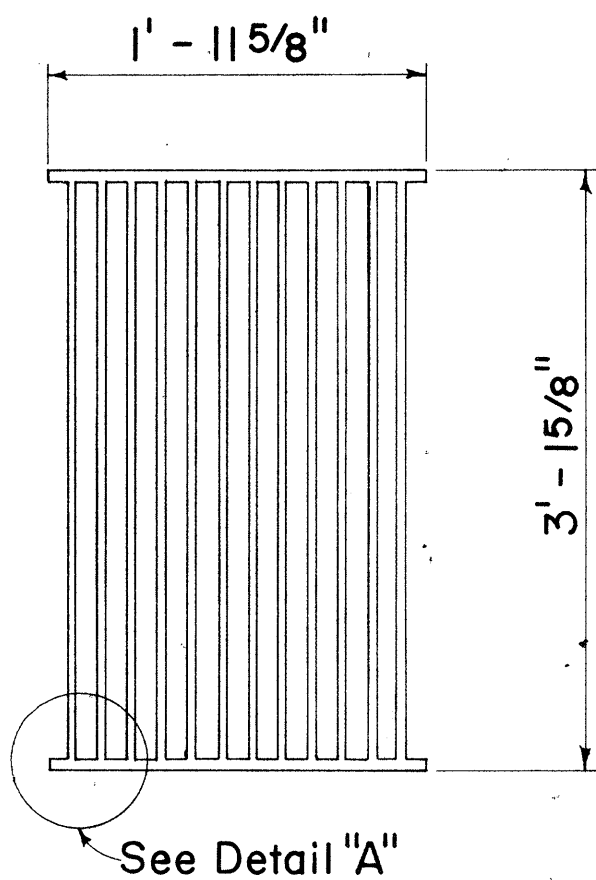

PLAN

Scale: 1"= 1'- 0"

ALTERNATIVE CAST MALLEABLE IRON
OR CAST STEEL GRATE

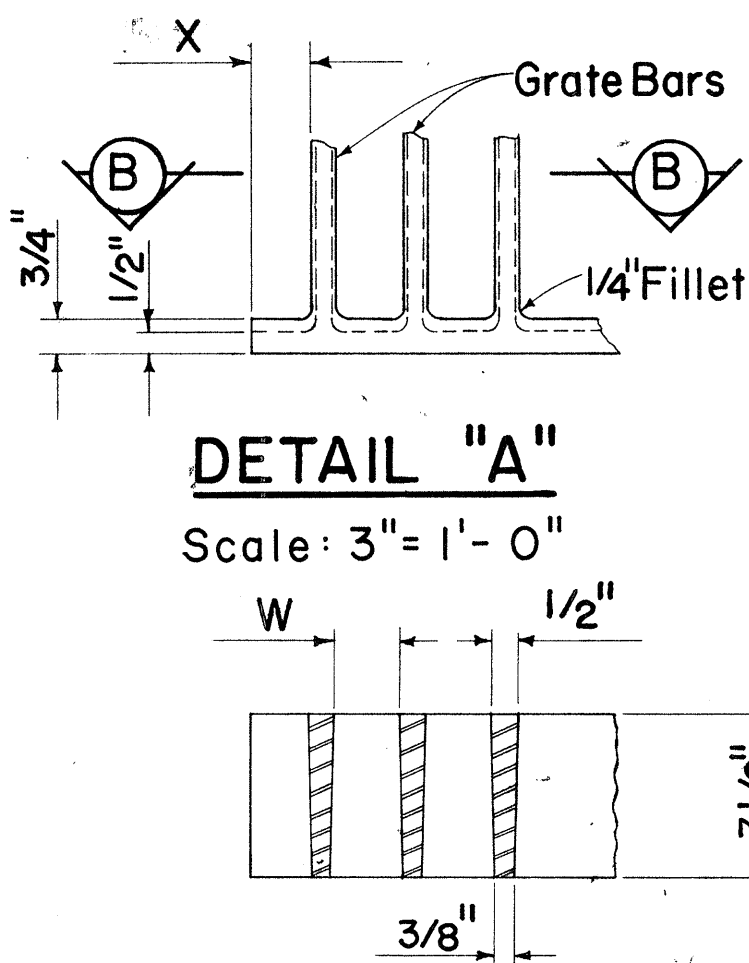


DETAIL "A"


Scale: 3"= 1'- 0"

SECTION "B-B"


Scale: 3"= 1'- 0"

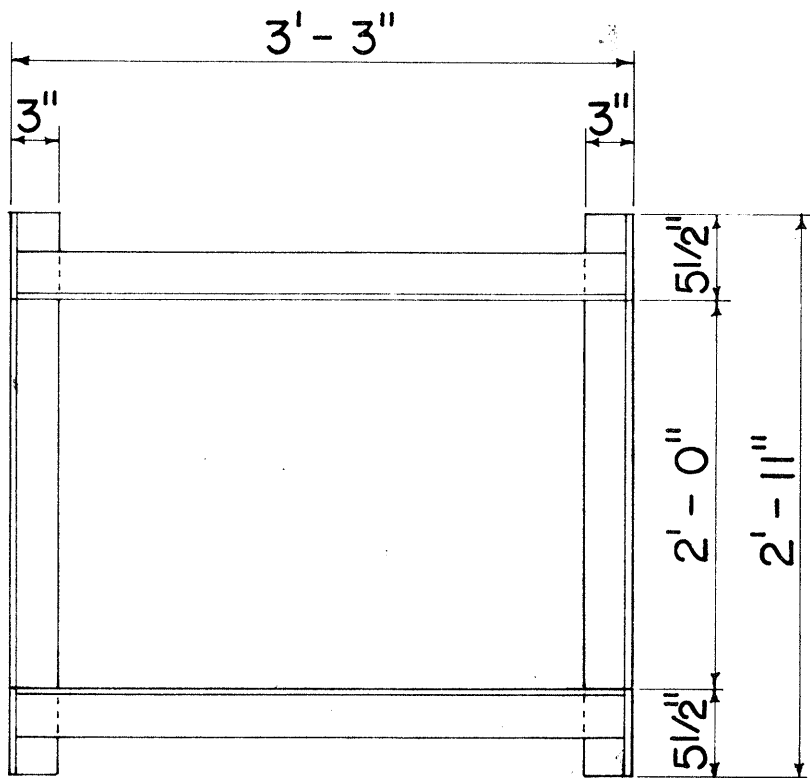

PLAN
(Single Grate)

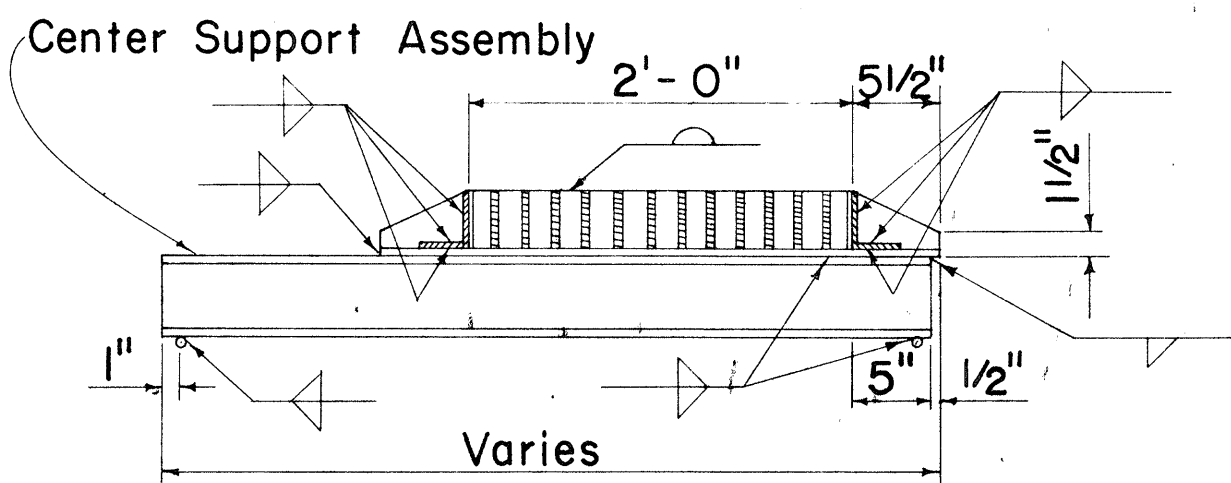


CROSS SECTION
(Thru Frame & Grate)

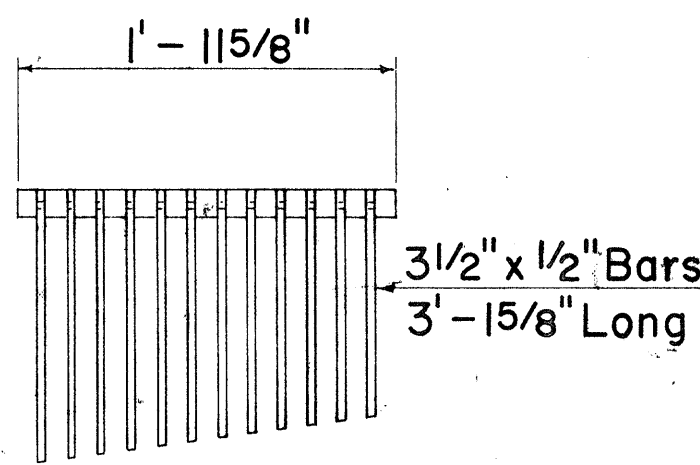

CAST END BLOCK


Scale: 1"= 1'- 0"

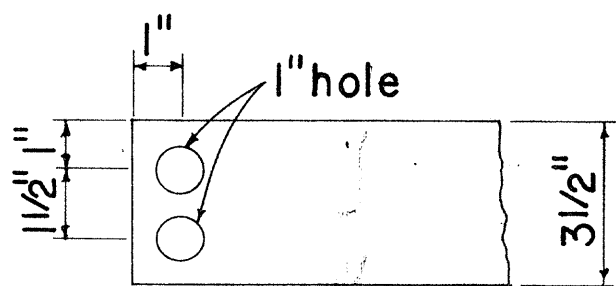

END OF BAR


Scale: 3"= 1'- 0"

ALTERNATIVE CAST MALLEABLE IRON
OR CAST STEEL END BLOCK GRATE

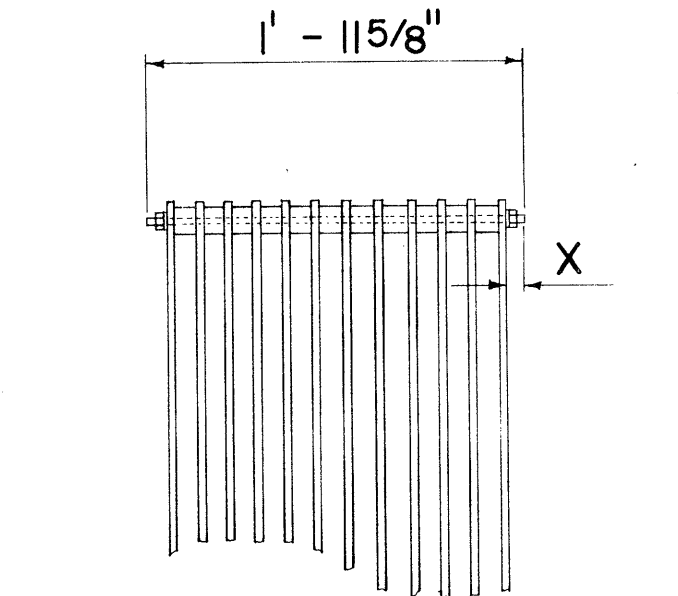

BOLTED END BLOCK


Scale: 1"= 1'- 0"

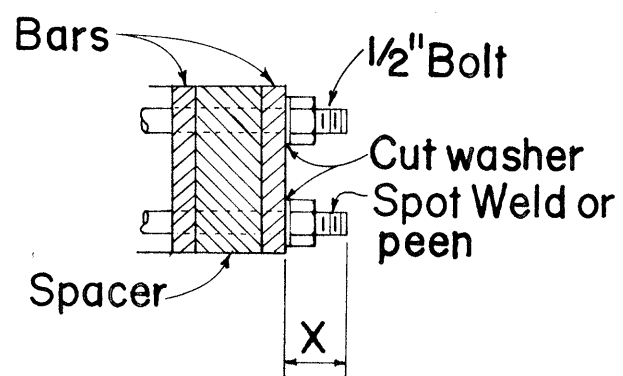

BOLTING DETAIL

Scale: 3"= 1'- 0"


ALTERNATIVE BOLTED GRATE

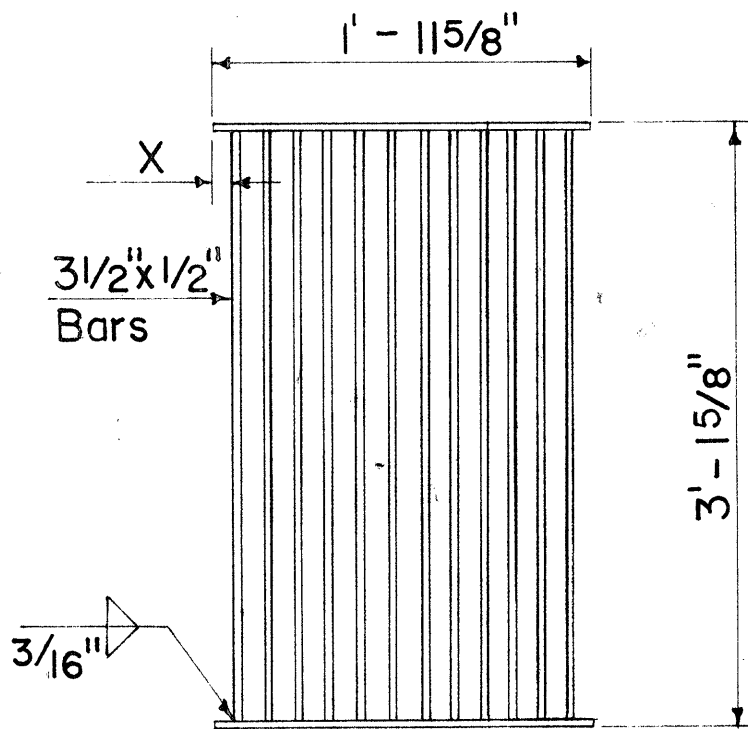


PLAN

ALTERNATIVE WELDED GRATE

Scale: 1"= 1'- 0"

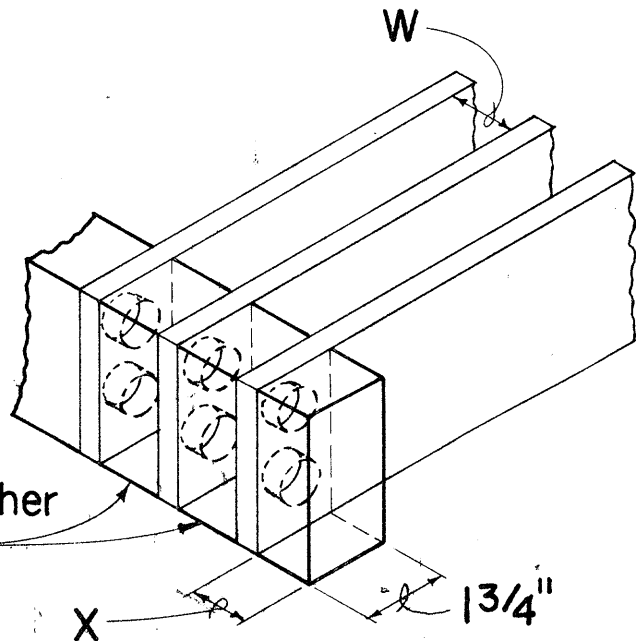


Both ends held together by solid casting

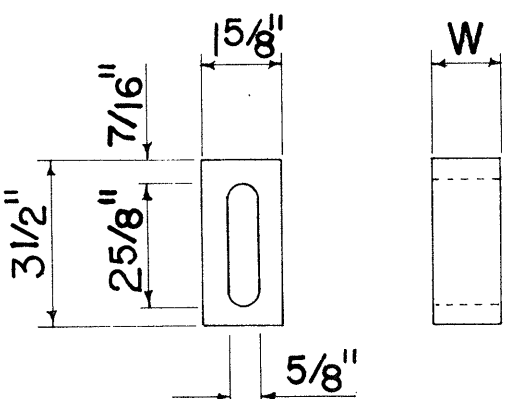


BAR SPACER

Scale: 3"= 1'- 0"

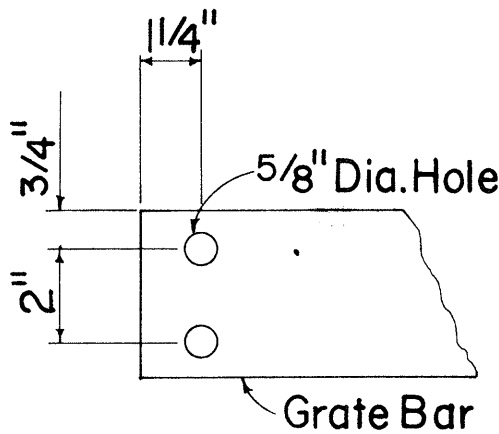

END OF BAR

Scale: 3"= 1'- 0"

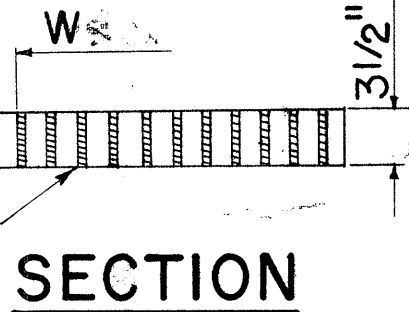

SECTION

NO.	REVISION	APPROVED BY	DATE

Scale: 1"= 1'- 0"

FED. ROAD DIST. NO.	STATE	FED. AID PROJ. NO.	FISCAL YEAR	SHEET NO.	TOTAL SHEETS
HAWAII	HAW.	TQ-F-078-1(10)	1978	63	266

GENERAL NOTES

- Grates and Frames shall be hot dip galvanized after fabrication, see specifications.
- All welds $\frac{3}{8}$ " unless otherwise noted.
- Refer to "Spacing Table" for Types 61614 & 61616 Drop Intake and Frame & Grates dimensions.
- The Frame & Grate materials shall conform to the specifications of ASTM Designation Structural Steel A283, Grade D and the Standard Specifications.
- Culvert shall leave Drop Intake from any position and any direction indicated by plans or ordered by the Engineer. Culverts may both enter and leave Drop Intake so that Drop Intake will act as manhole.
- Manhole Rungs (12" o.c.) are required when "H" is greater than 4 feet 6 inches. Only one rung (16 inches from the bottom) is required if "H" is 4 feet 6 inches or less. Manhole Rungs may be placed at any location as ordered by the Engineer.

SPACING TABLE					
TYPE	NO. BARS	A	B	C	D
61614	11	2'-0"	1'-11 1/2"	1 1/4"	1'-6"
61616	17	3'-0"	2'-11 3/8"	1 1/8"	2'-0"


NO.	REVISION	APPROVED BY	DATE
1	Curb for Top of Fill Gutters	H.H.	6-5-11
2	Spacing on manhole rungs to conform to OSHA.	H.H.	1-21-15

APPROVAL RECOMMENDED:
 HYDRAULIC DESIGN ENGINEER
 DATE 12-17-69

APPROVED:
 ASSISTANT CHIEF, ENGINEERING
 DATE 12-17-69


STATE OF HAWAII
 DEPARTMENT OF TRANSPORTATION
 HIGHWAYS DIVISION
 STANDARD DETAILS
 TYPE 61614 & 61616
 GRATED DROP INTAKES

Scales: As Noted Date: Feb. 1969
 SHEET No. 8 OF 10 SHEETS DH 8

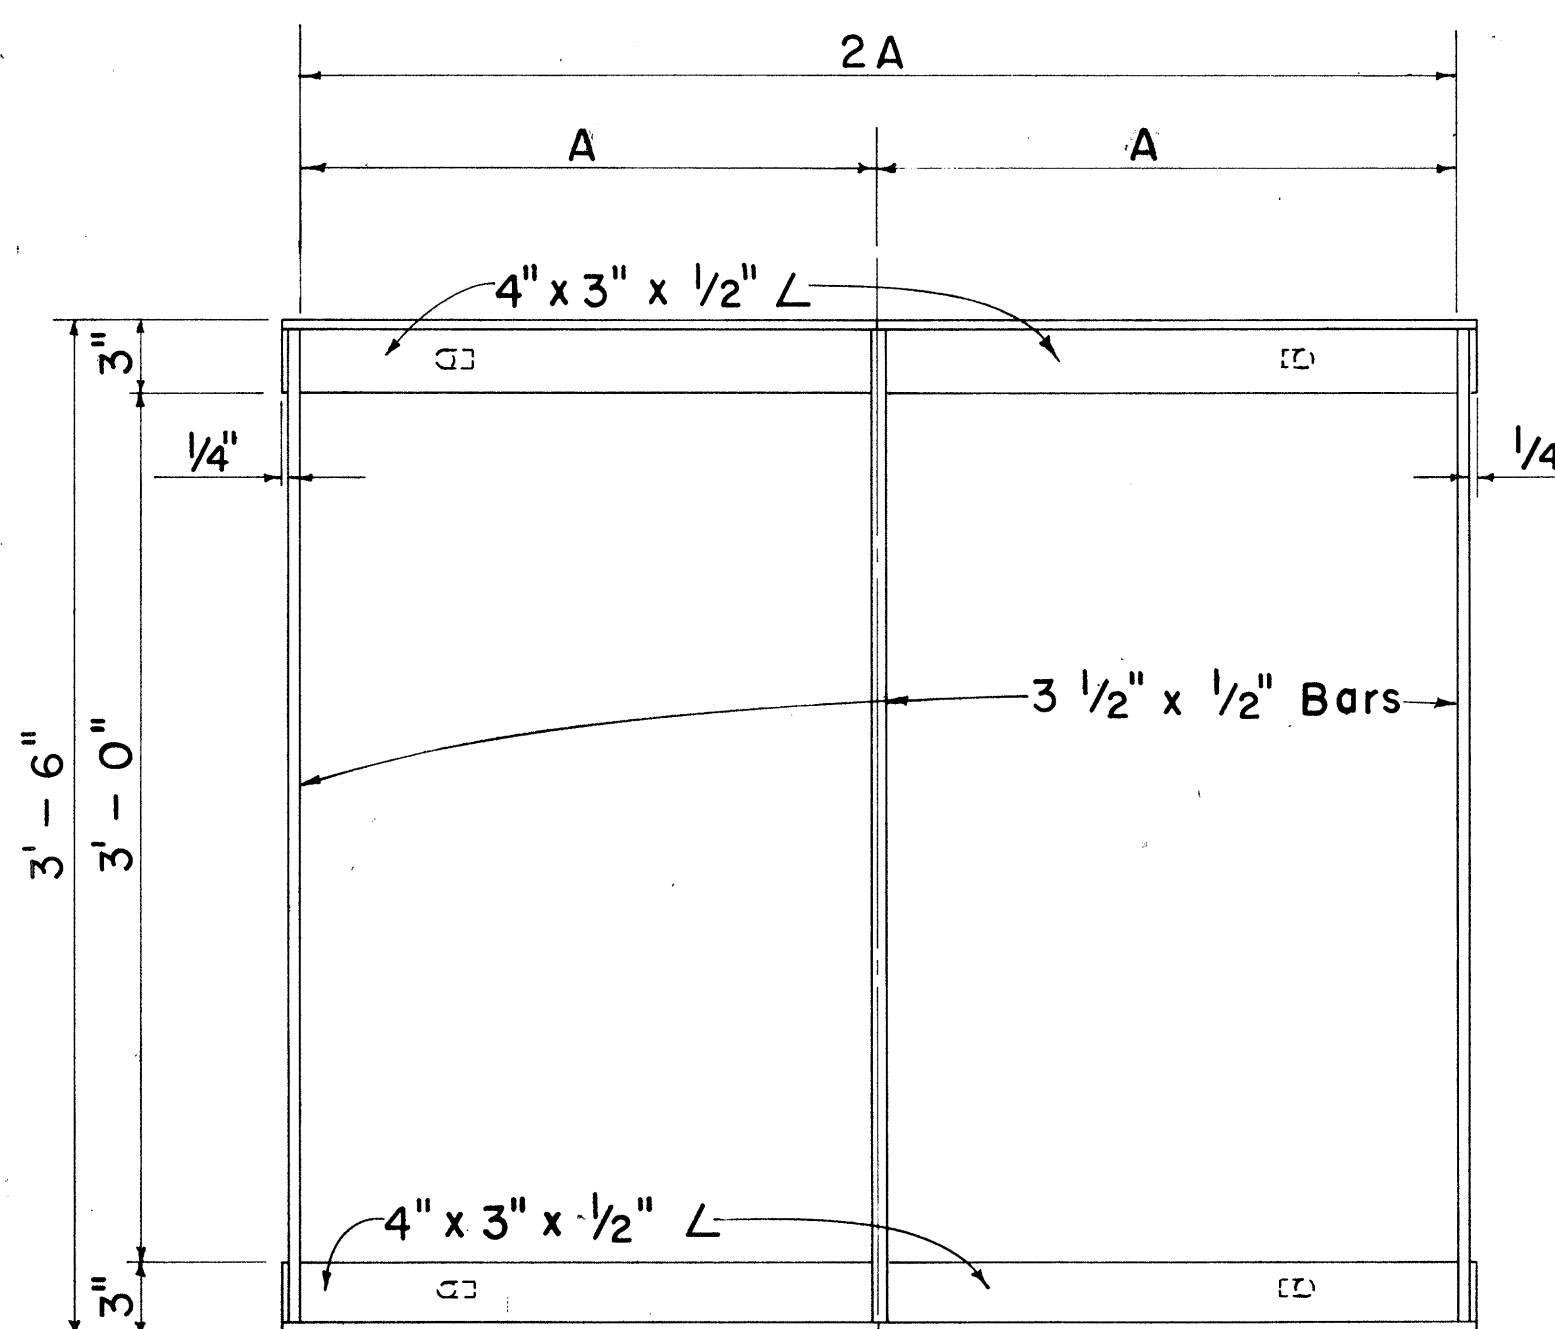


PLAN

Scale: 1 1/2" = 1'-0"

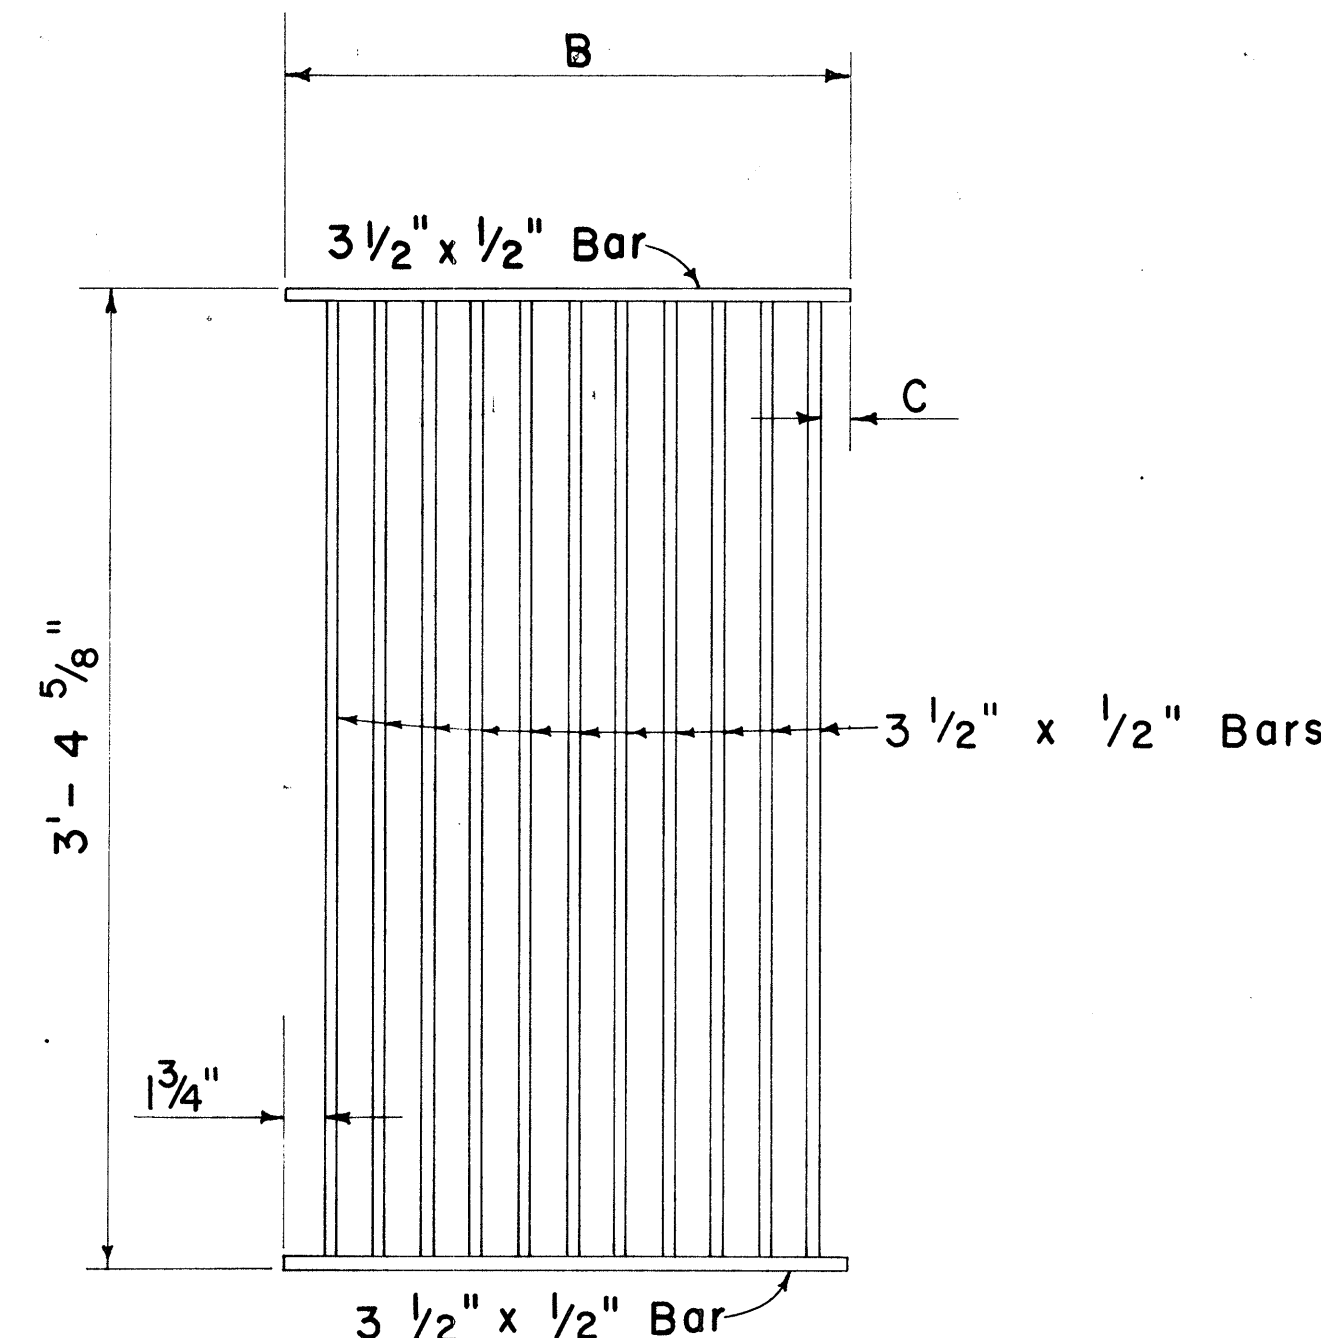


PLAN

Scale: 1 1/2" = 1'-0"

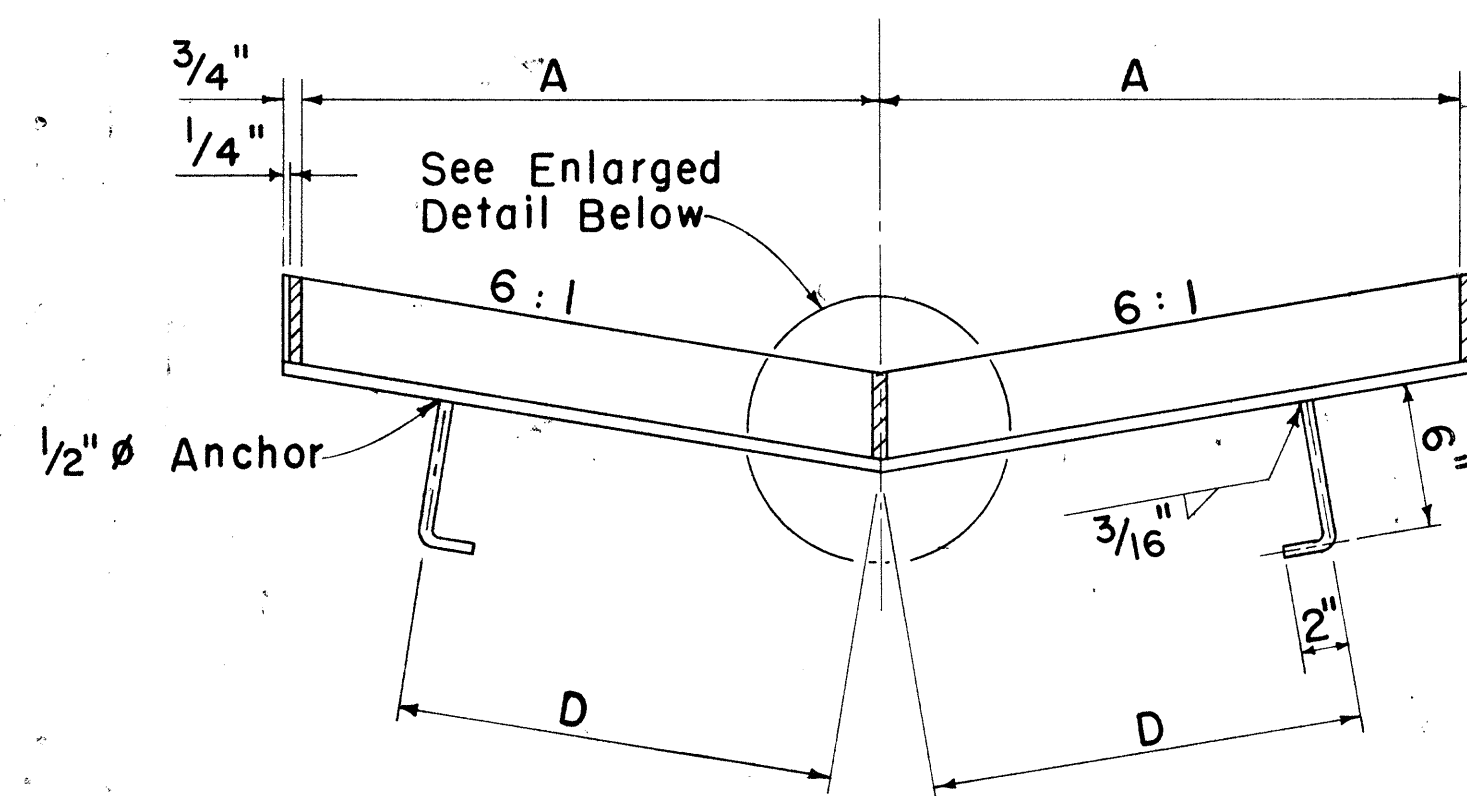


SECTION

Scale: 1 1/2" = 1'-0"

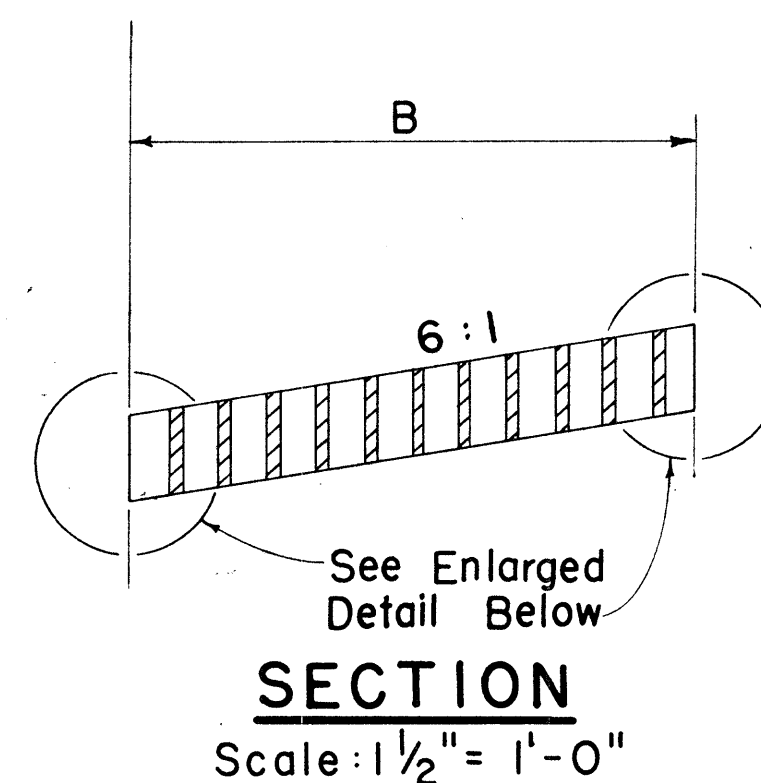


SECTION

Scale: 1 1/2" = 1'-0"

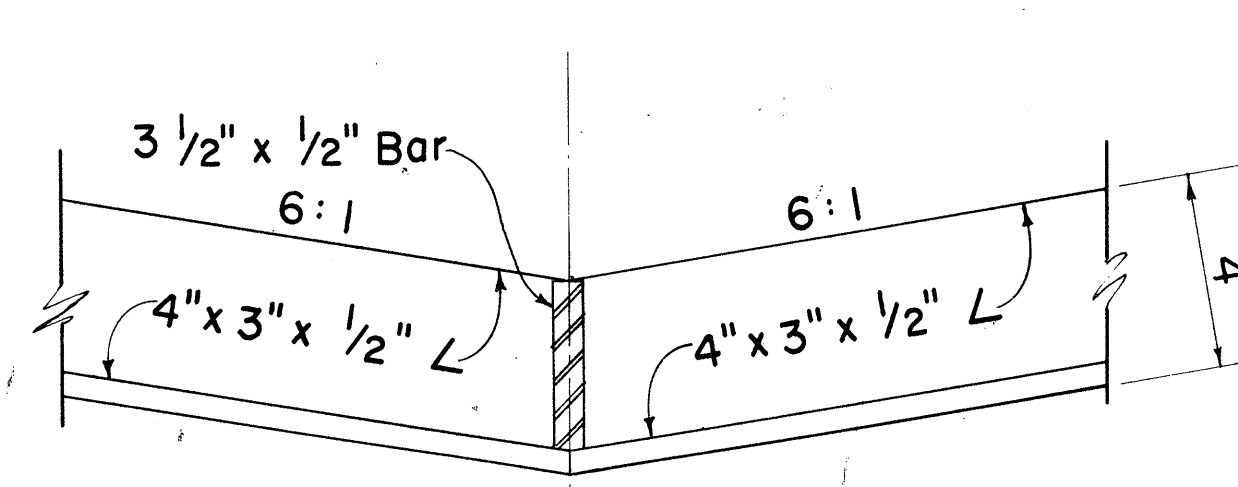

FRAME


Scale: 3" = 1'-0"

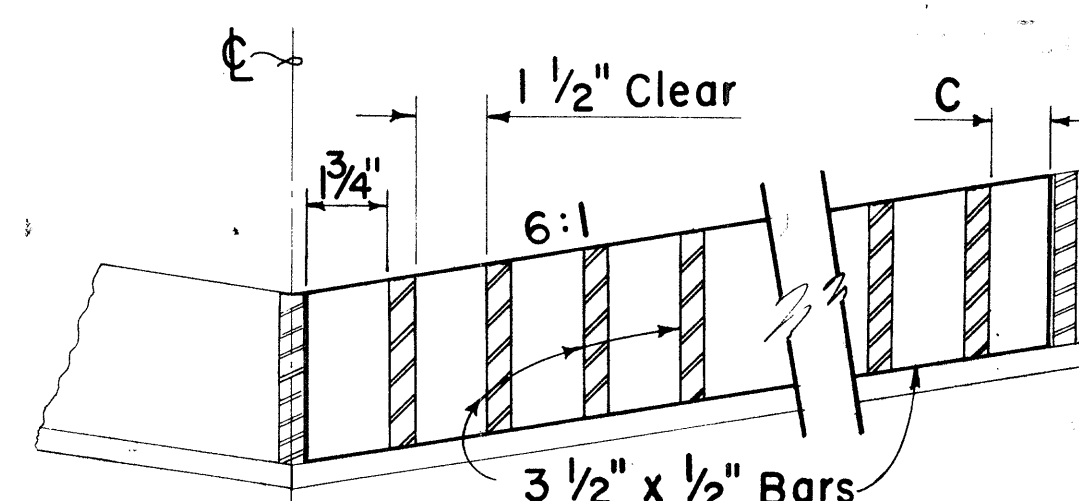


GRATE

Scale: 3" = 1'-0"


DETAILS OF TYPE 61614 OR 61616 STEEL FRAME AND GRATE

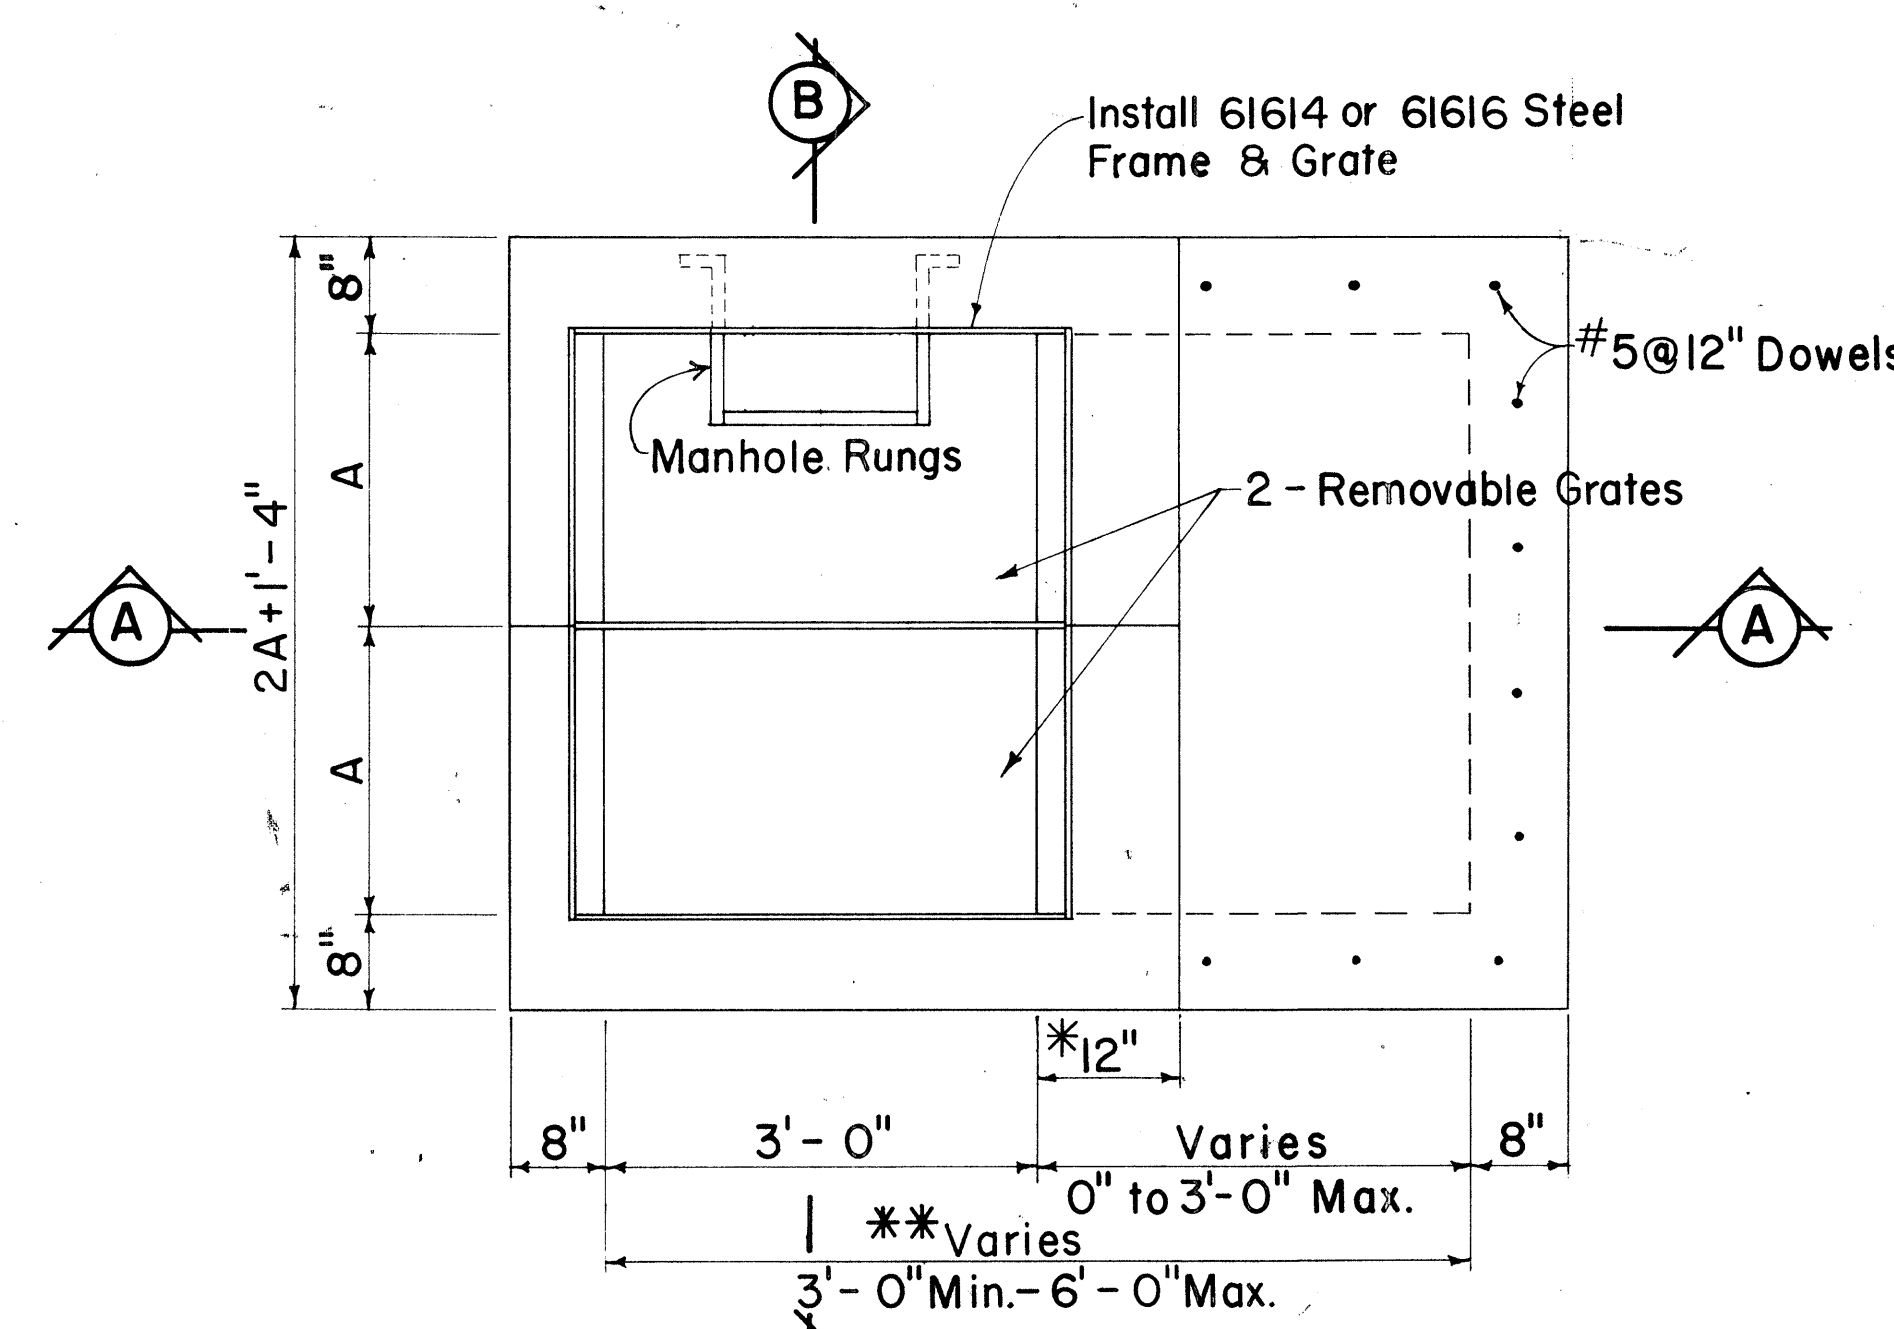

PLAN

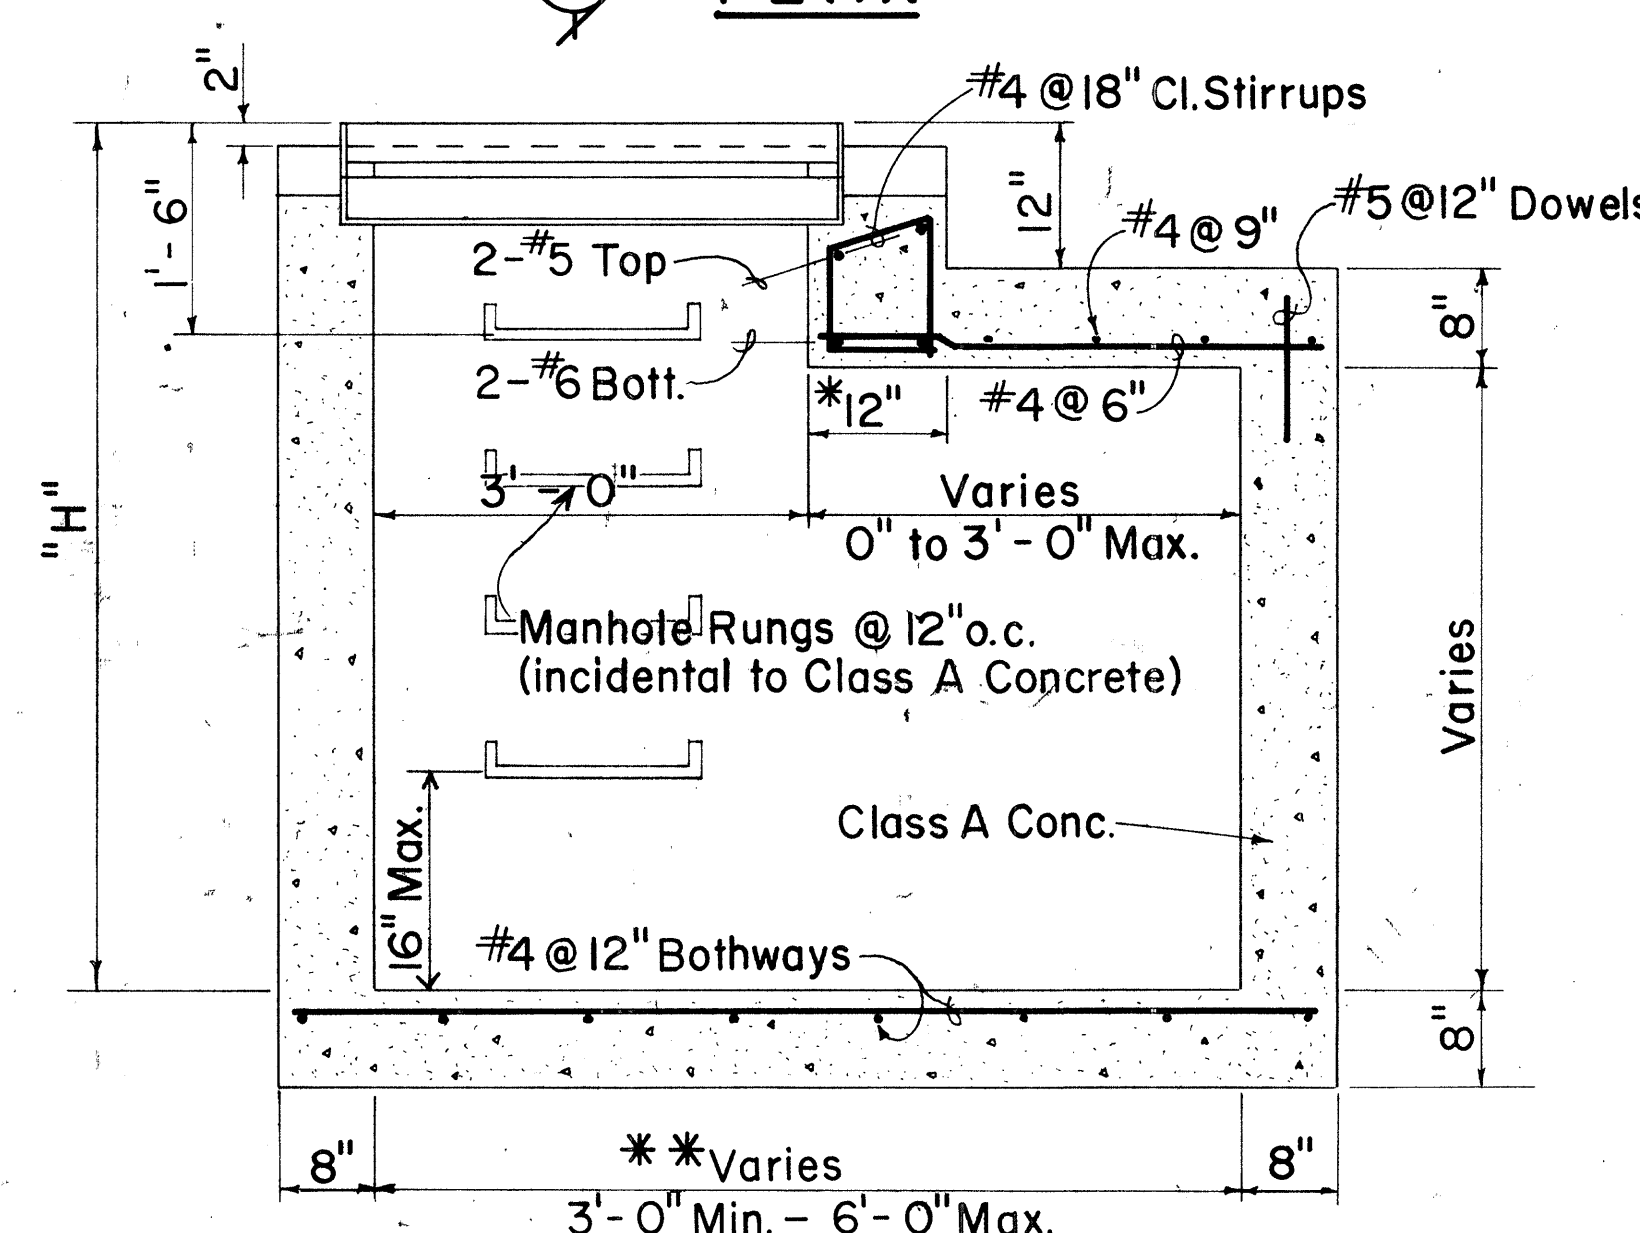

SECTION A-A

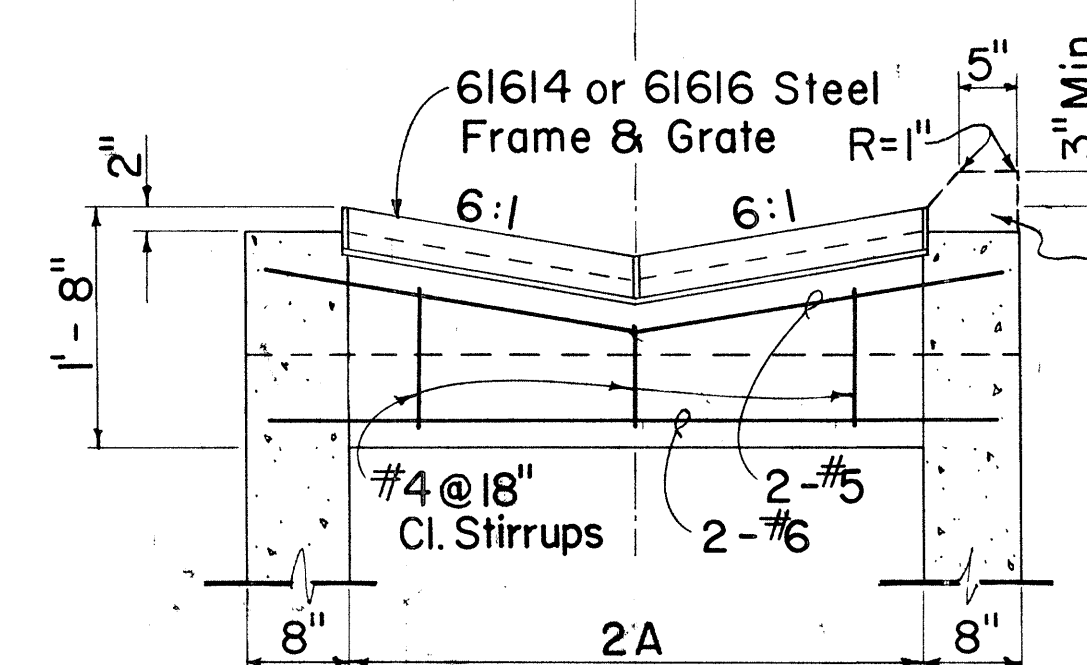

SECTION B-B

DETAILS OF 61614 OR 61616 DROP INTAKE


Scale: 3/4" = 1'-0"

- * For Minimum size box of 3'-0", use 8" and eliminate reinforcing steel shown in the top portion.
- ** For Culverts larger than 30", the minimum dimension shall be D.

FED. ROAD DIST. NO.	STATE	FED. AID PROJ. NO.	FISCAL YEAR	SHEET NO.	TOTAL SHEETS
HAWAII	HAW.	TQ F-078(10)	1978	64	286


GENERAL NOTES

1. Grates and Frames shall be hot dip galvanized after fabrication, see specifications.
2. All welds $\frac{3}{8}$ " unless otherwise noted.
3. The Frame & Grate materials shall conform to the specifications of ASTM Designation Structural Steel A283, Grade D and the Standard Specifications.
4. Culvert shall leave Drop Intake from any position and any direction indicated by plans or ordered by the Engineer. Culverts may both enter and leave Drop Intake so that Drop Intake will act as manhole.
5. Manhole Rungs (12" o.c.) are required when "H" is greater than 4 feet 6 inches. Only one rung (16 inches from the bottom) is required if "H" is 4 feet 6 inches or less. The Manhole Rungs may be placed at any location as ordered by the Engineer.

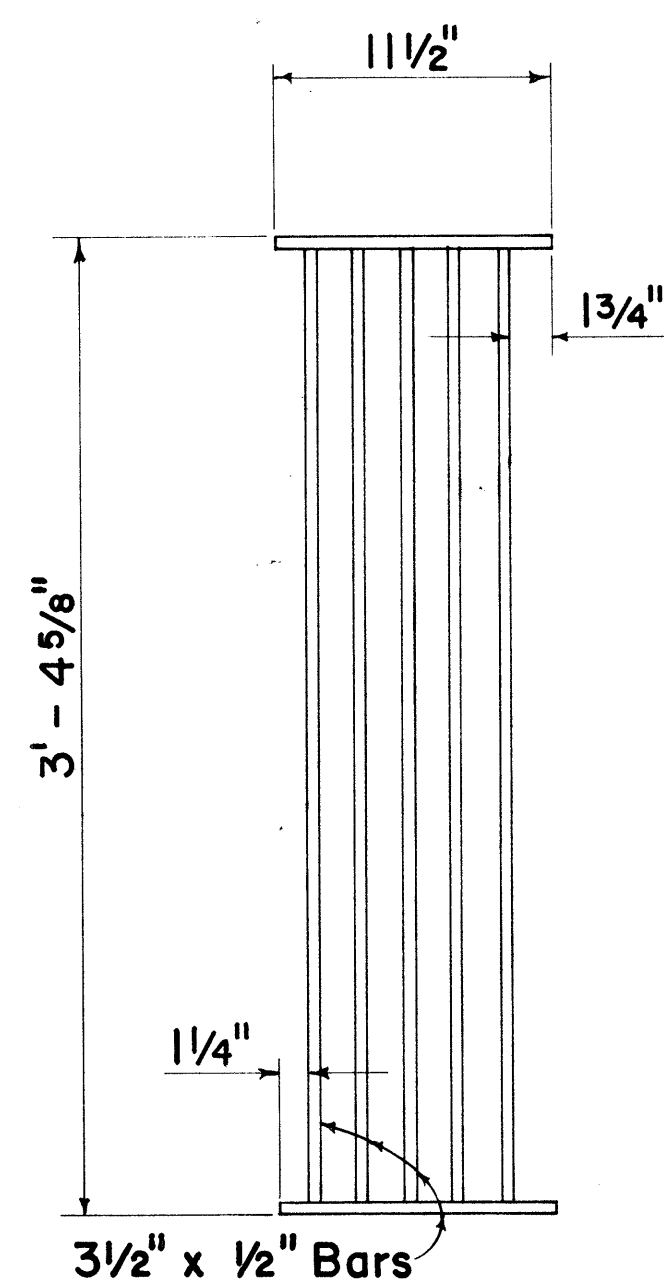


PLAN

Scale: $1\frac{1}{2}'' = 1' - 0''$

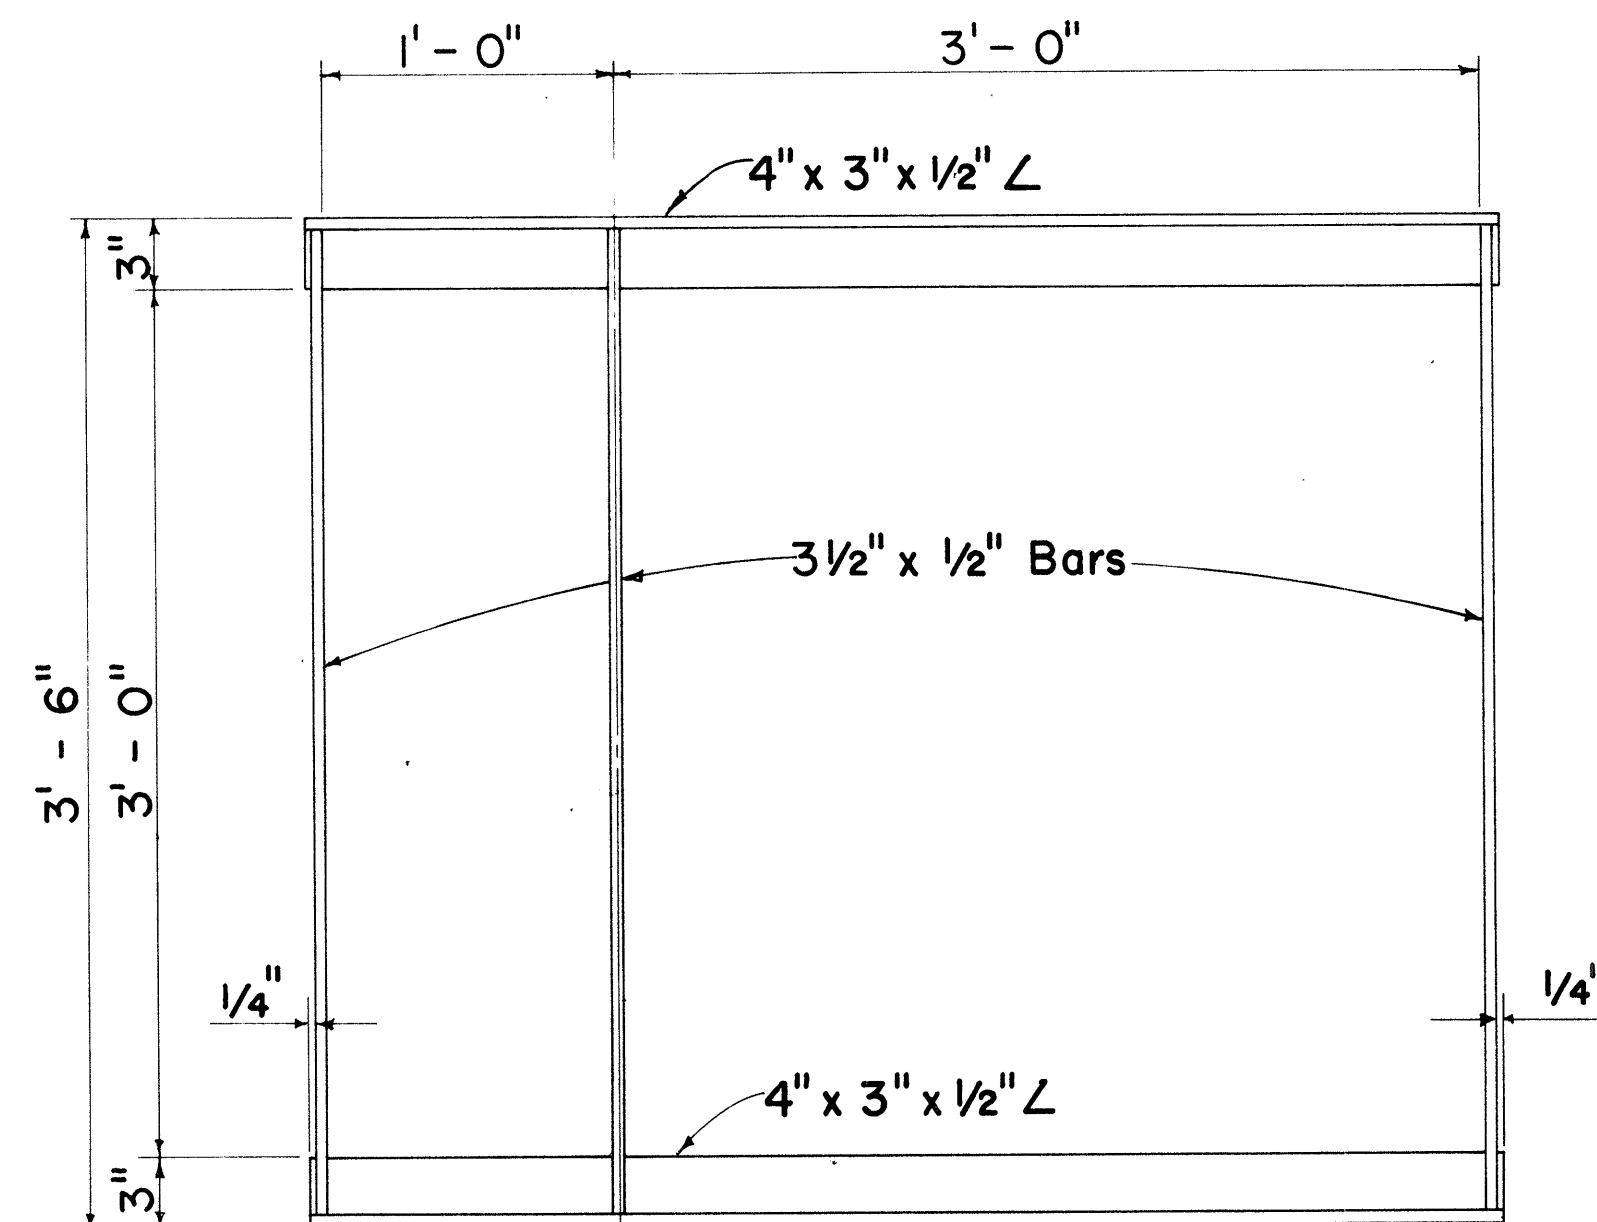


PLAN

Scale: $1\frac{1}{2}'' = 1' - 0''$

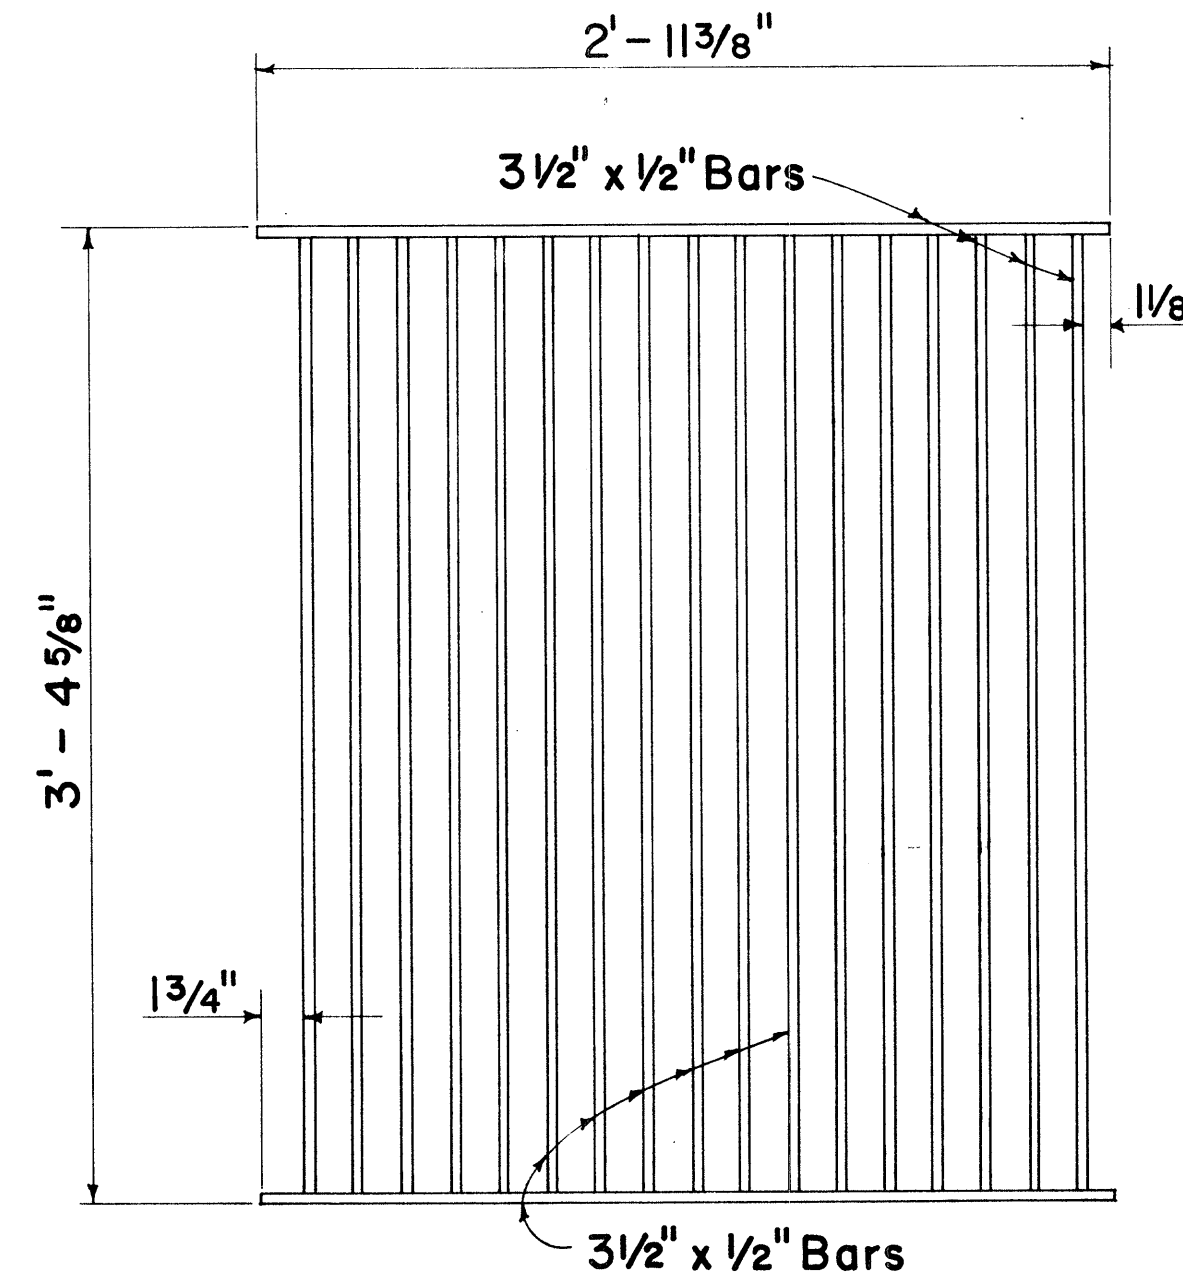


PLAN

Scale: $1\frac{1}{2}" = 1' - 0"$

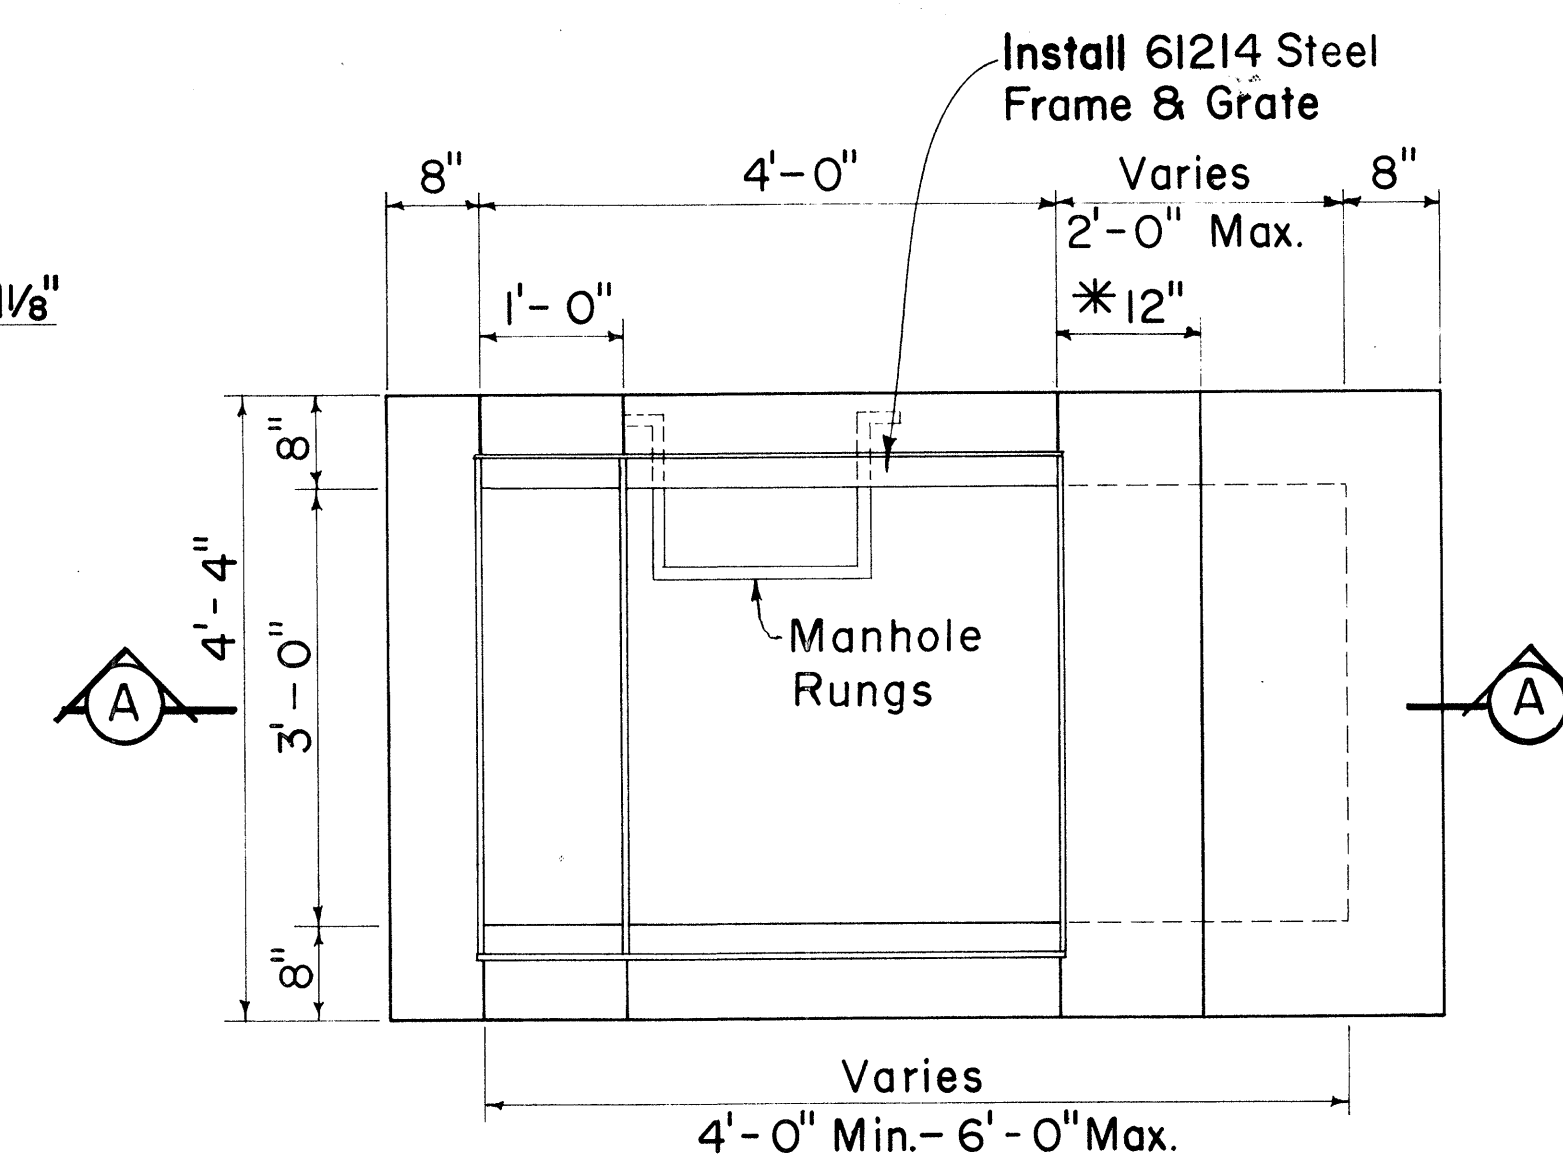


PLAN

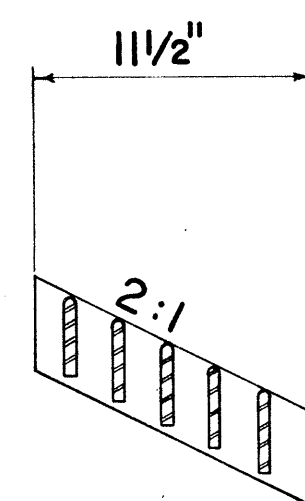


SECTION

Scale: $1\frac{1}{2}'' = 1' - 0''$

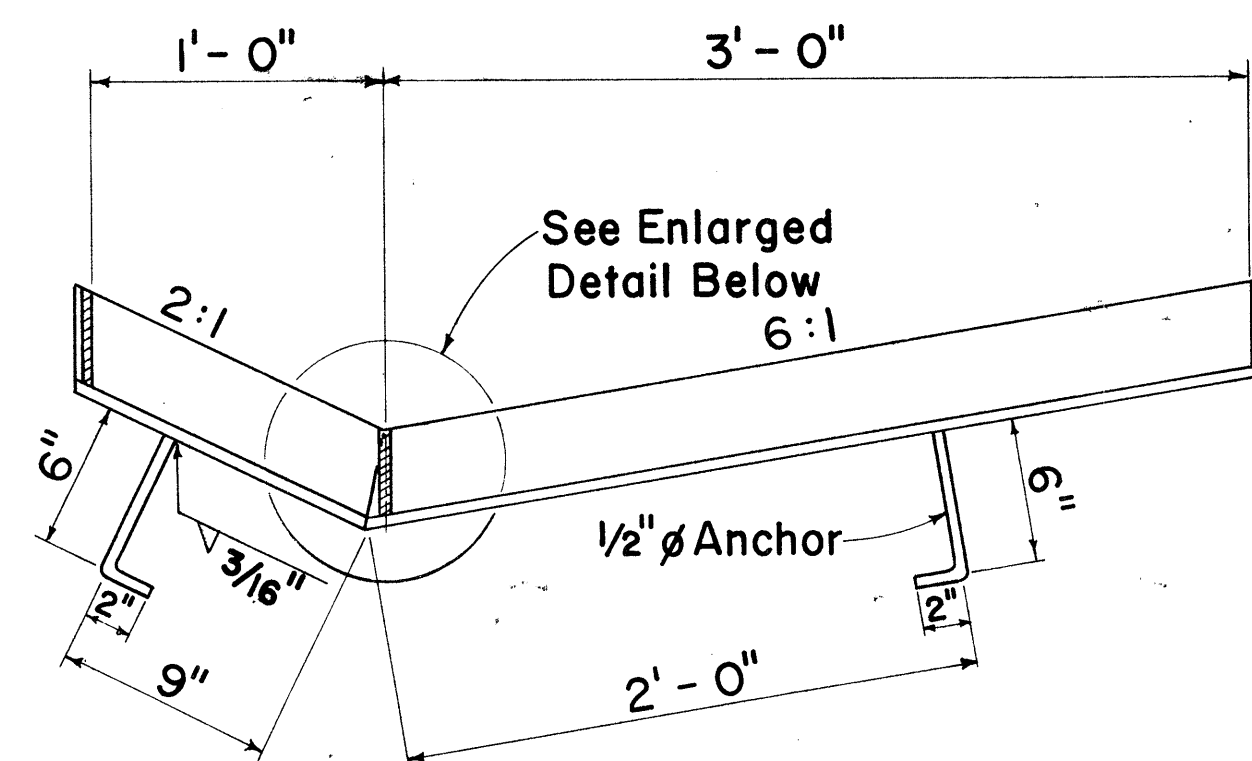


SECTION

Scale: $1\frac{1}{2}'' = 1' - 0''$

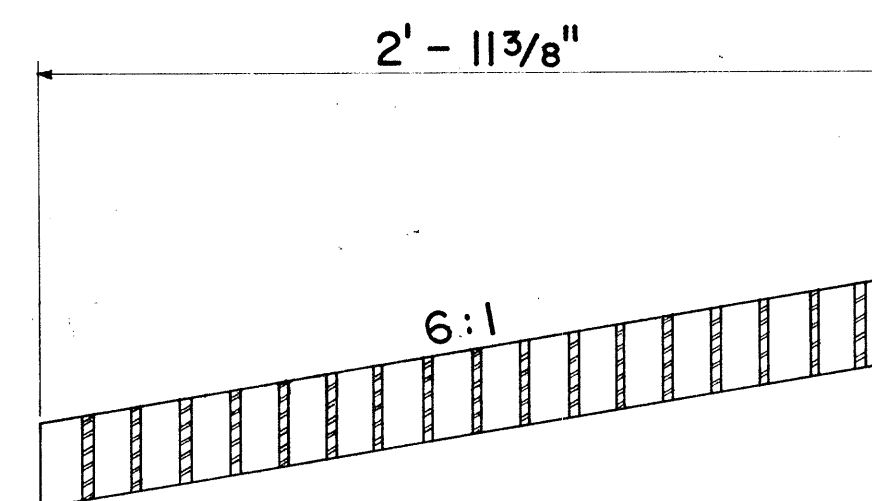


SECTION

Scale: $1\frac{1}{2}'' = 1' - 0''$

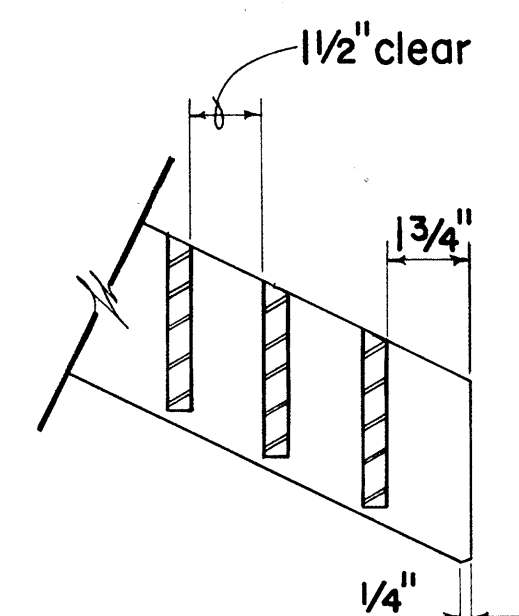


GRATE

Scale: 3" = 1' - 0"

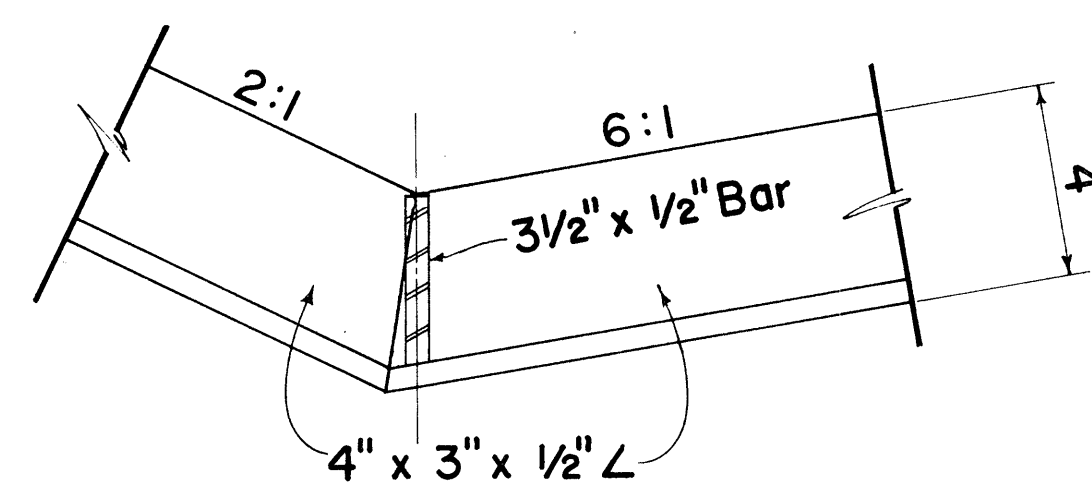


FRAME

Scale: 3" = 1'-0"

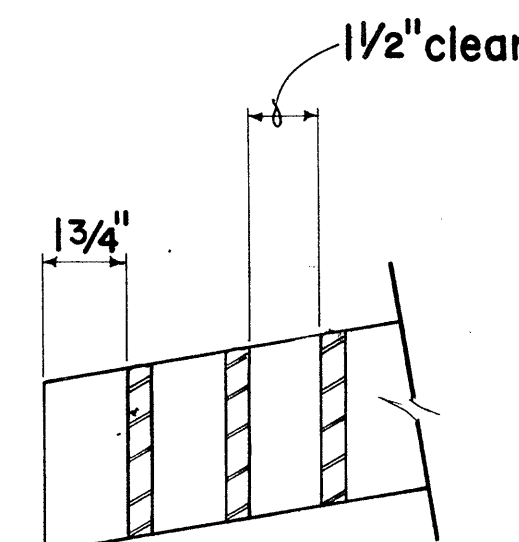

GRATE

Scale: $3'' = 1' - 0''$

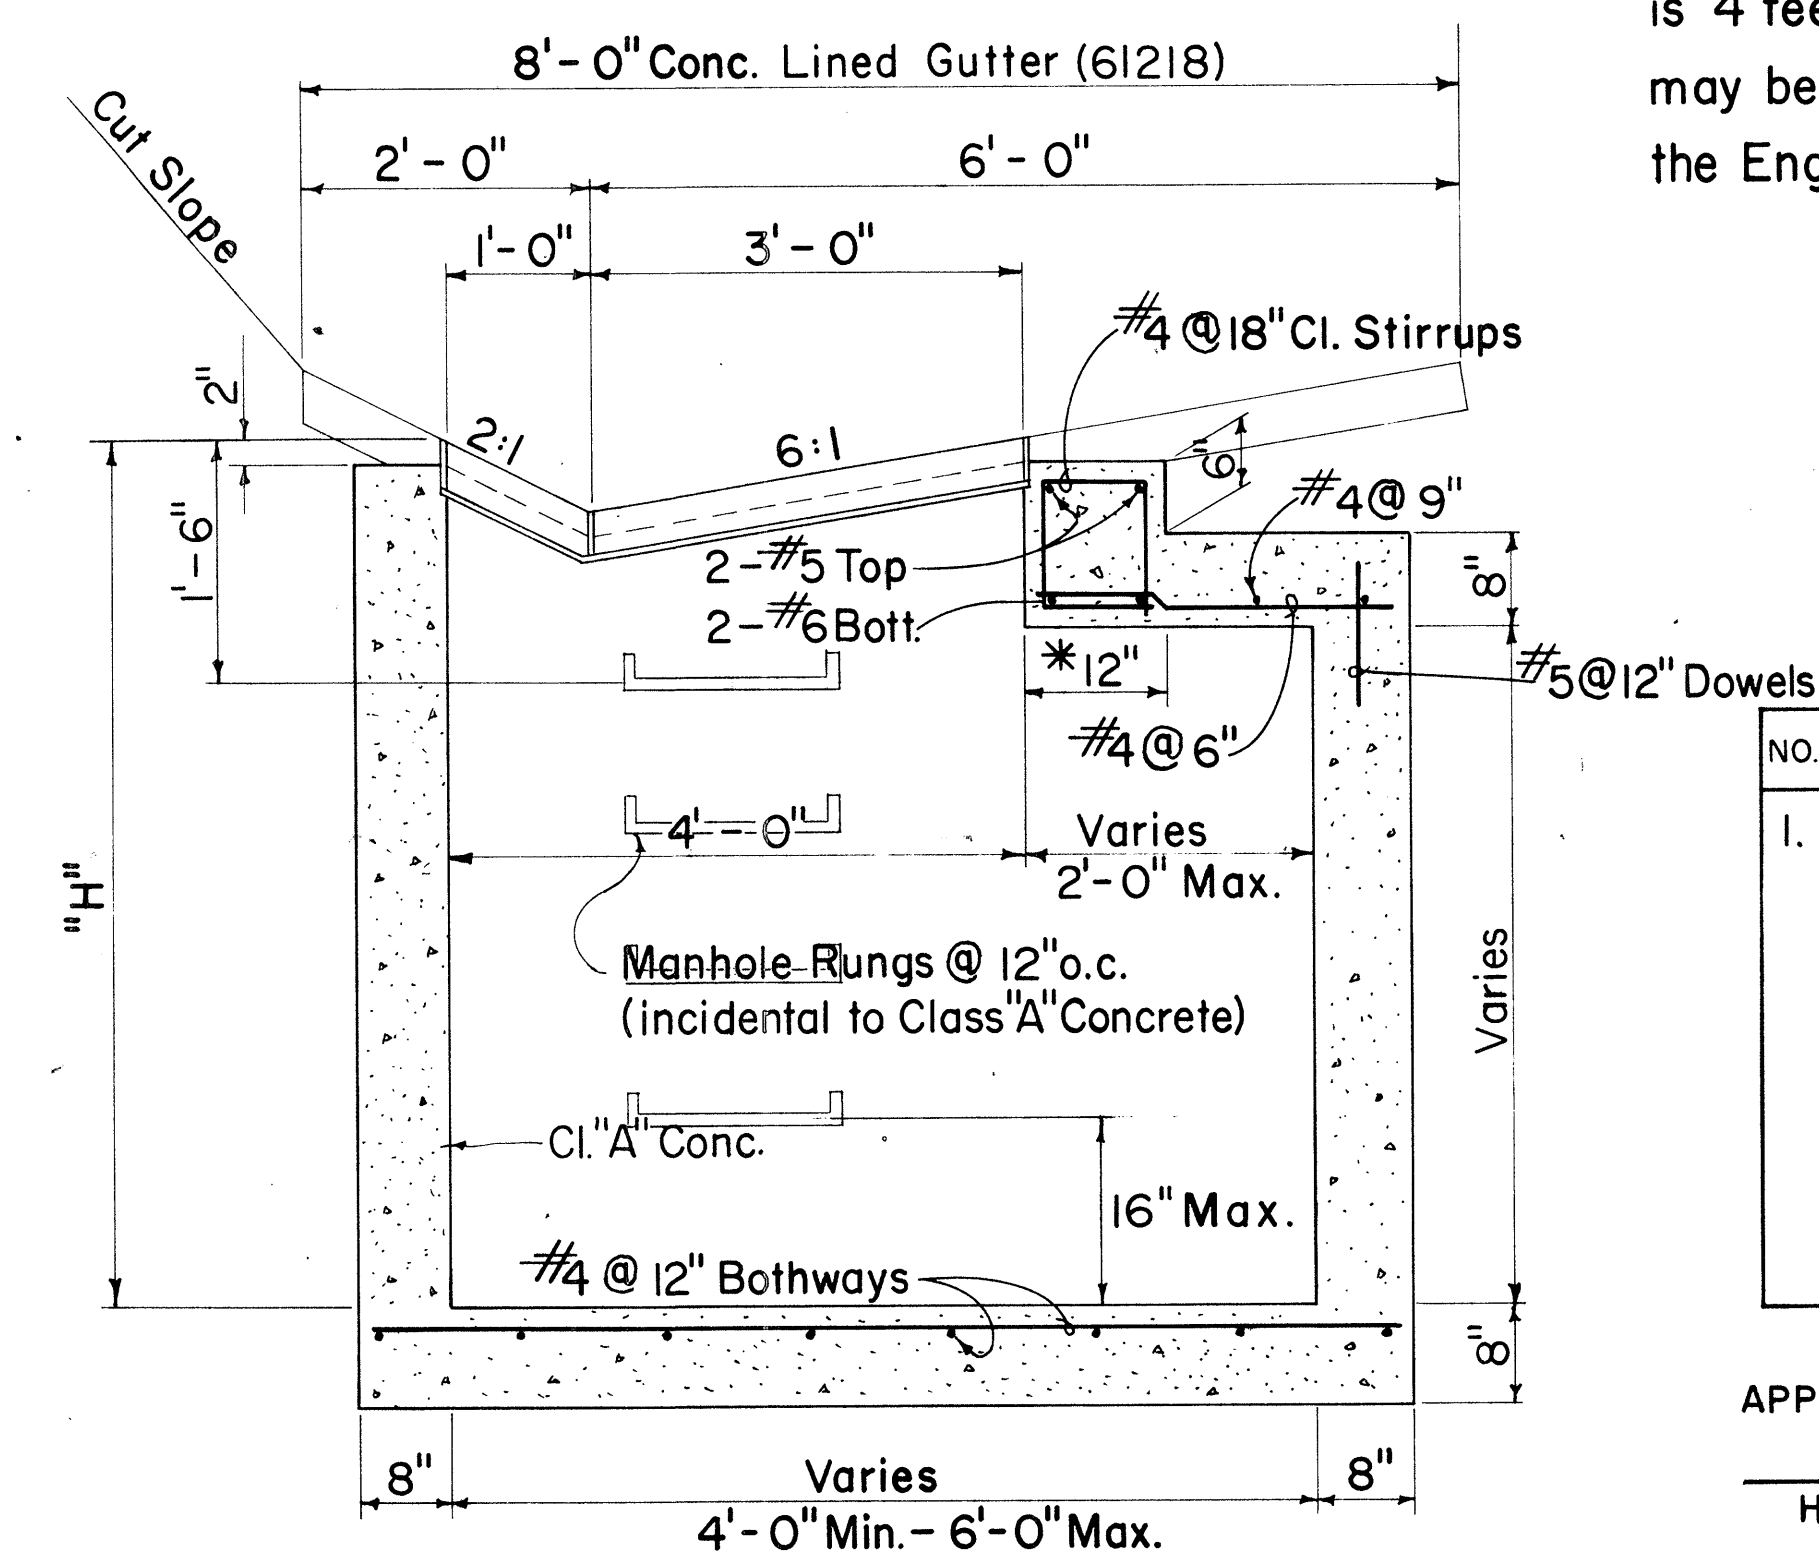

SECTION A - A

DETAIL OF 6/2/4 DROP INTAKE

Scale: $\frac{3}{4}" = 1' - 0"$

*For Minimum size box of 4'-0" only, use 8" and eliminate reinforcing steel shown in top portion.

NO.	REVISION	APPROVED BY	DATE
1.	Spacing on Manhole Rungs to conform to OSHA.	H.T.	1-21-15

APPROVAL RECOMMENDED:

P. Takano
HYDRAULIC DESIGN ENGINEER

12-17-69
DATE

APPROVED :

2 July 22 dvi
ASSISTANT CHIEF, ENGINEERING

2-17-69
DATE

STATE OF HAWAII
DEPARTMENT OF TRANSPORTATION
HIGHWAYS DIVISION

STANDARD DETAILS
TYPE 61214
GRADED DROP INTAKE

Scales: As Noted

Date: July 1969.


SHEET No. 9 OF 10 SHEETS DH 9

64


FED. ROAD DIST. NO.	STATE	FED. AID PROJ. NO.	FISCAL YEAR	SHEET NO.	TOTAL SHEETS
HAWAII	HAW.	14-F-078(10)	1978	65	266

GENERAL NOTES


1. All concrete shall be Class "B" unless otherwise noted.
2. Exposed edges of all drainage structures shall be chamfered one inch.
3. Culvert shall enter and leave Drop Intake from any position and in the direction indicated by the plans or ordered by the Engineer.
4. Manhole Rungs (12" o.c.) are req'd. when "H" is greater than 4'-6". Only one rung (16 inches from the bottom) is required if "H" is 4'-6" or less. Manhole Rungs may be placed at any location as ordered by the Engineer.

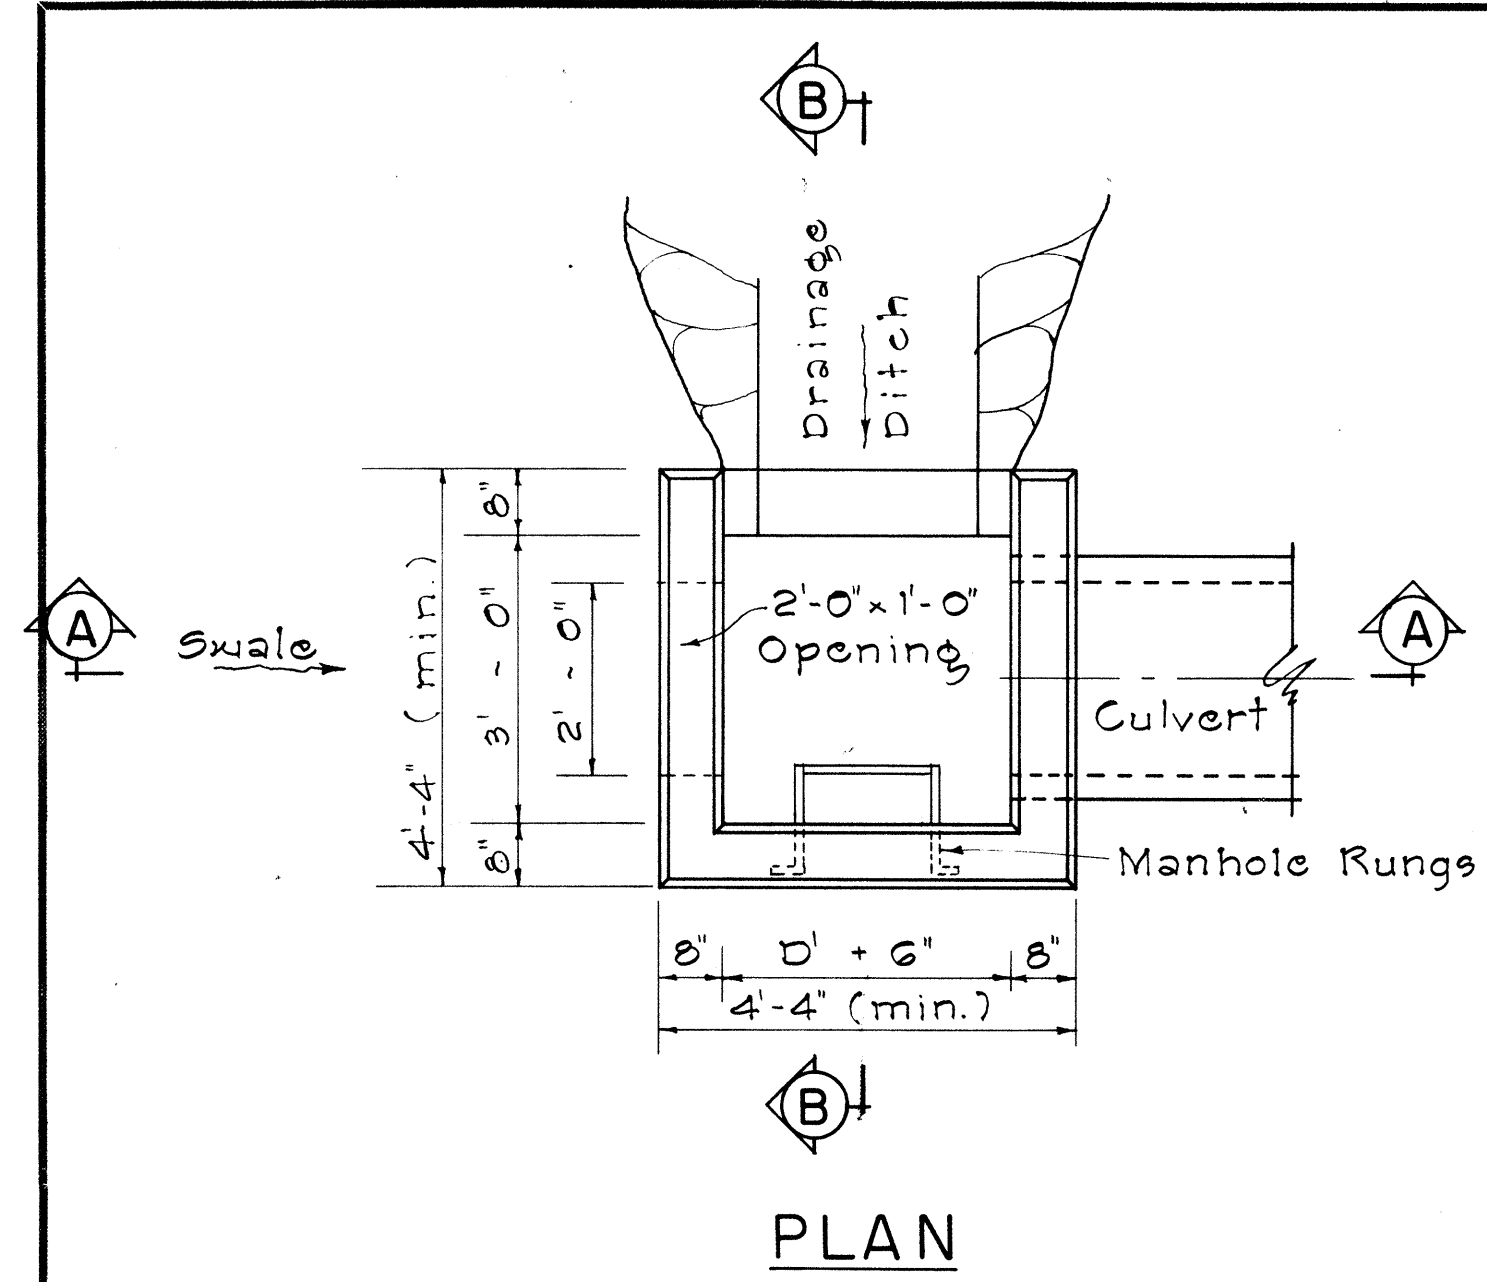


PLAN

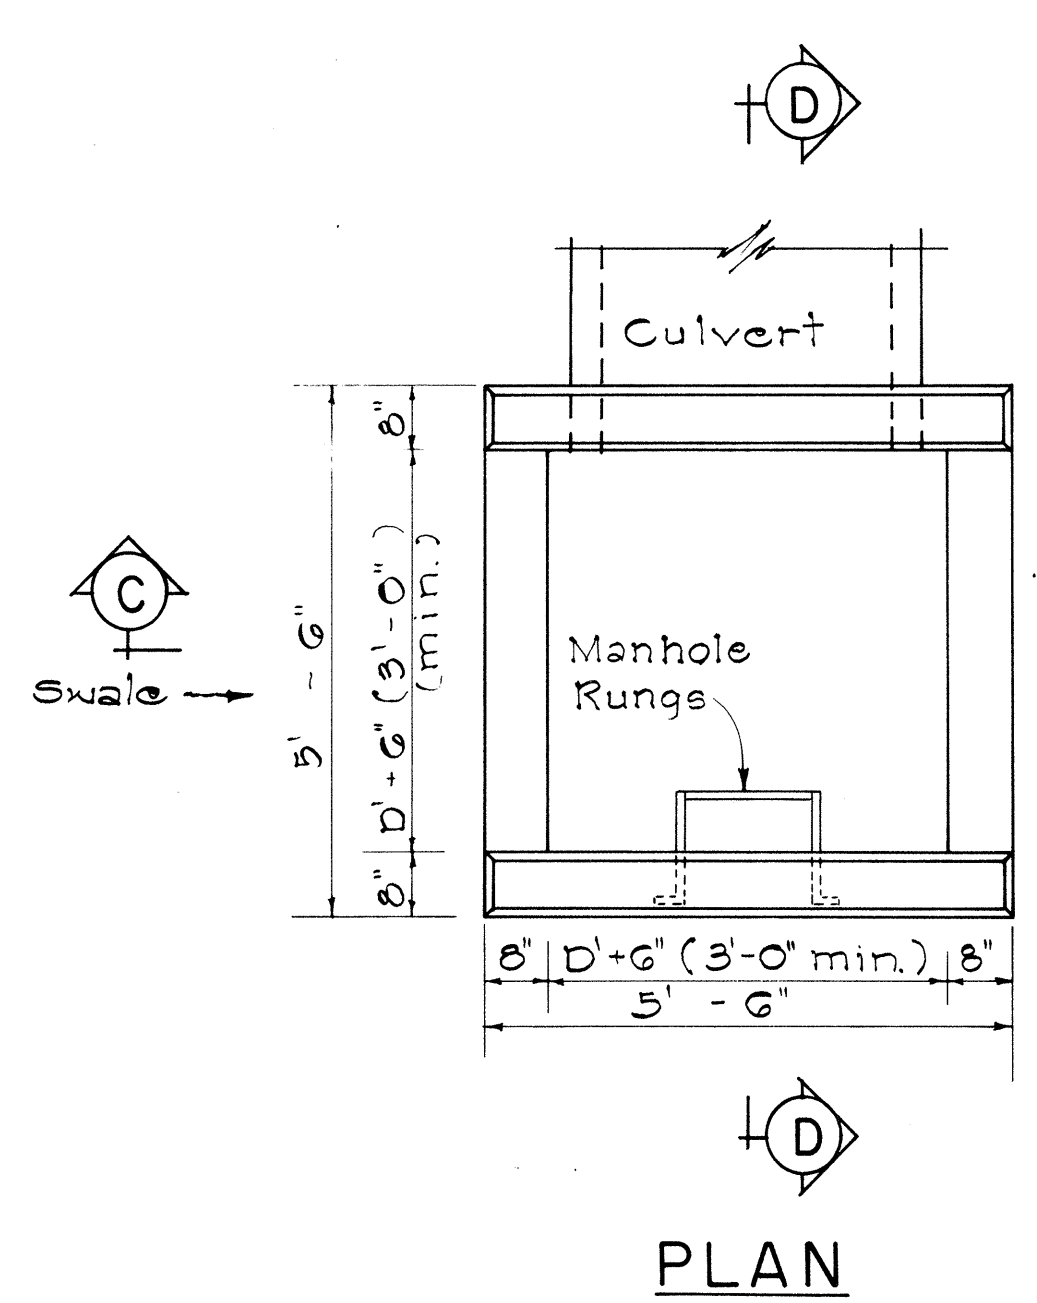


PLAN

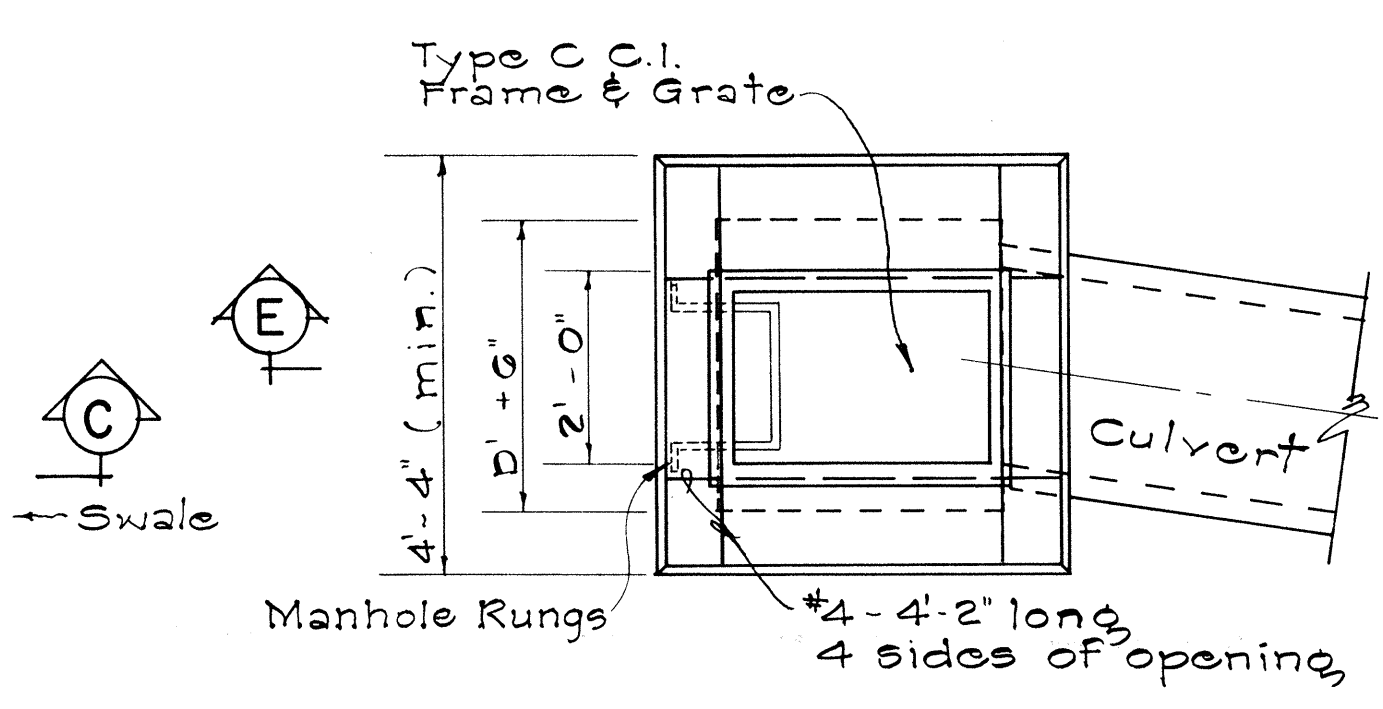


PLAN

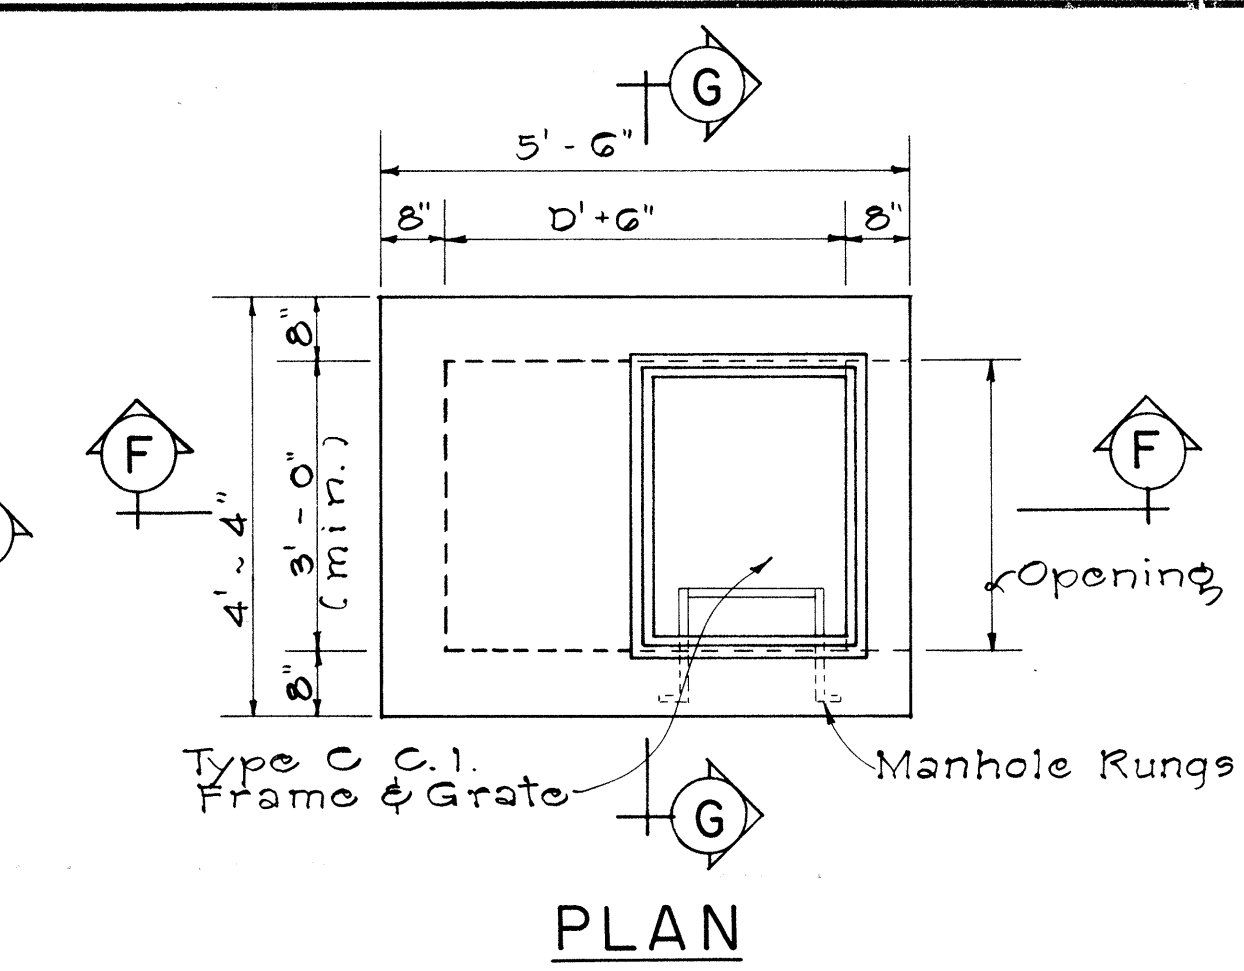

PLAN

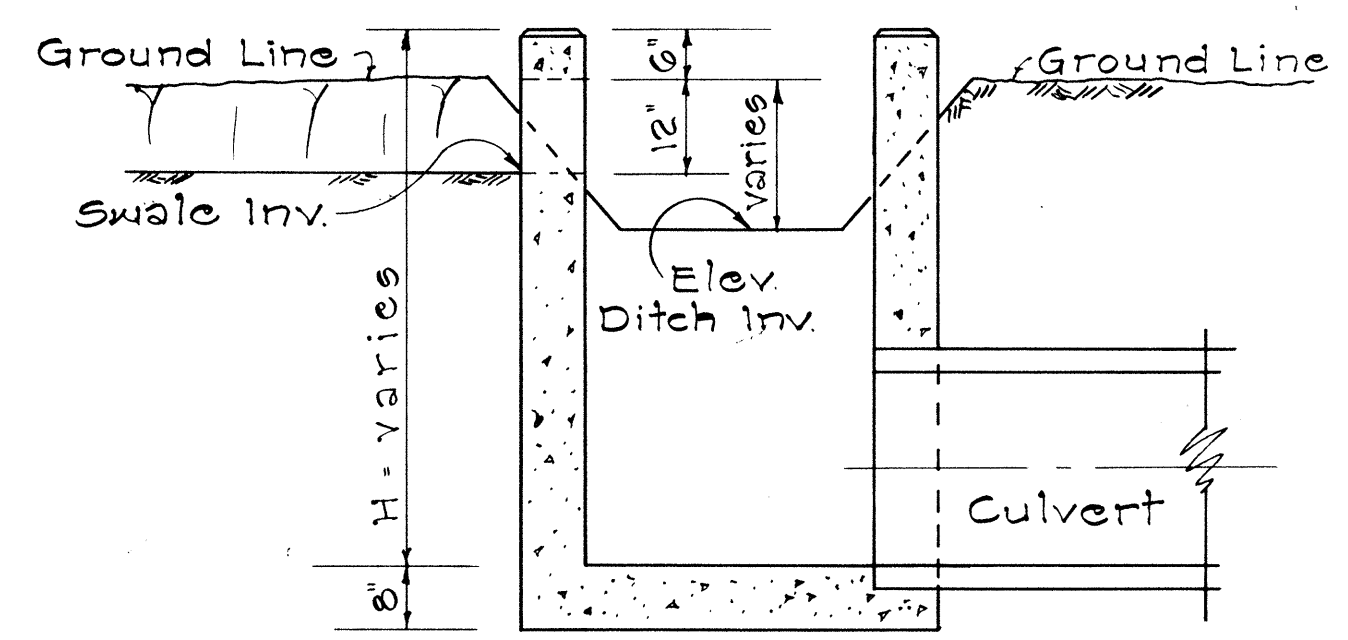


SECTION "A-A"

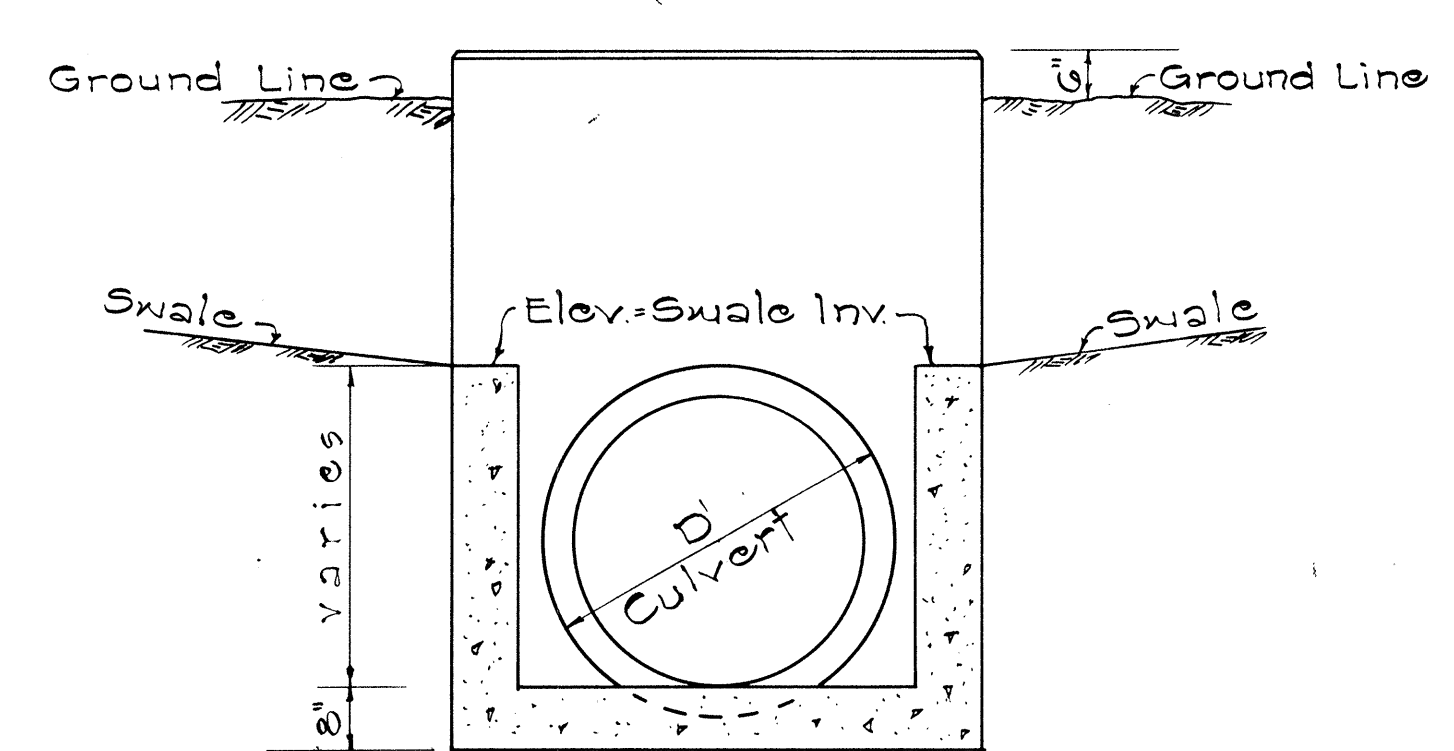


SECTION "C-C"

TYPE "C" GRATED CONCRETE DROP INTAKE


Scale: 1/2" = 1'-0"

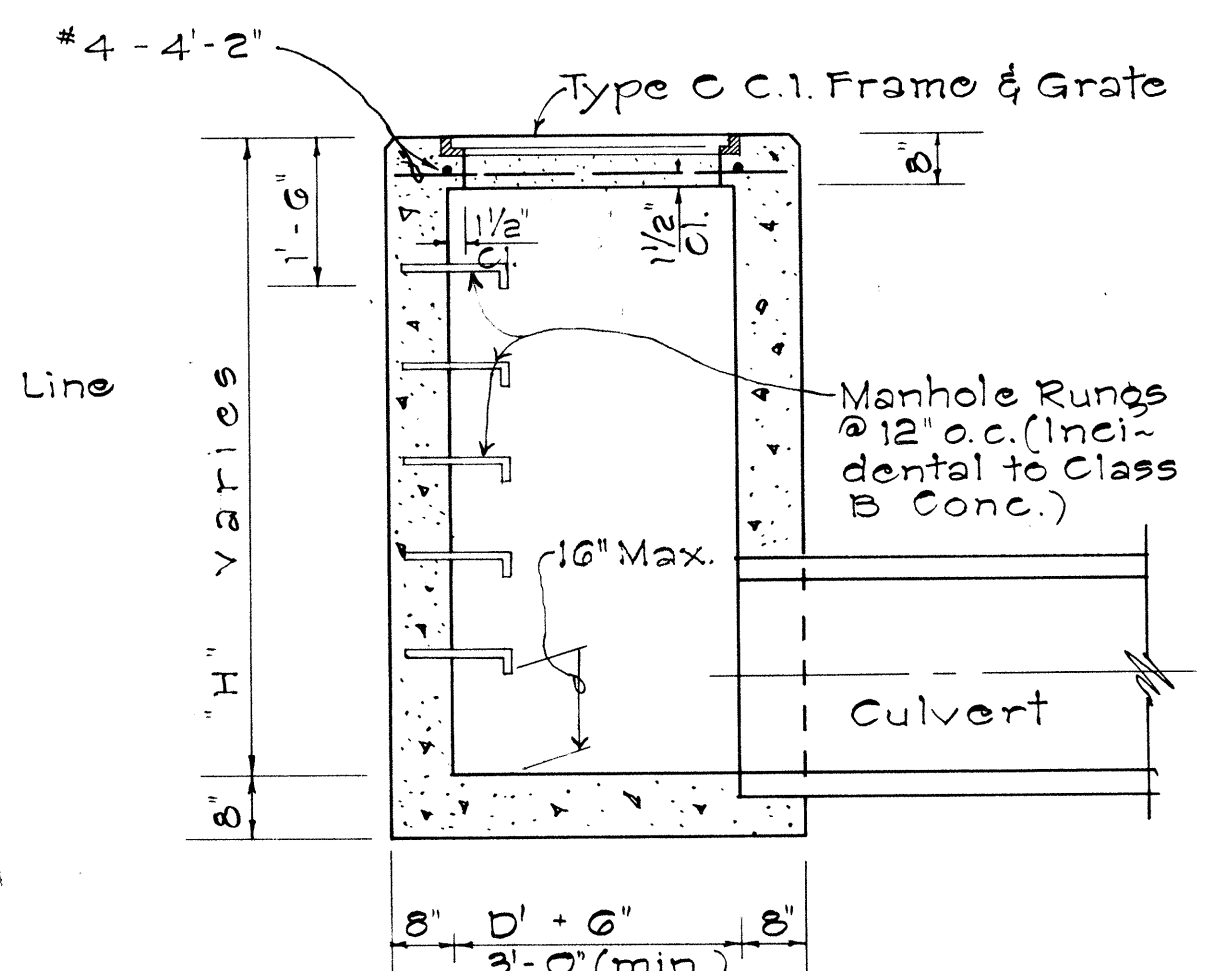

SECTION "E-E"

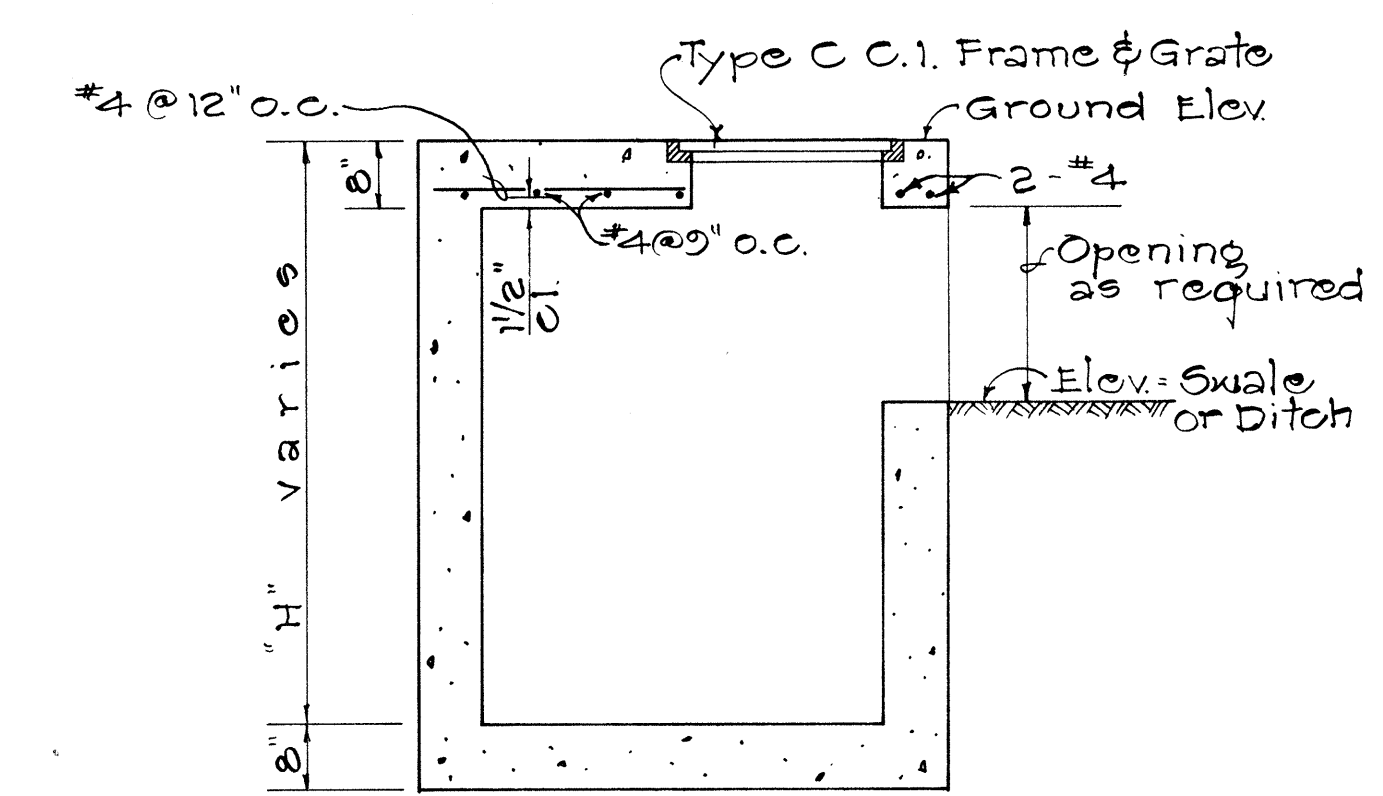

SECTION "F-F"

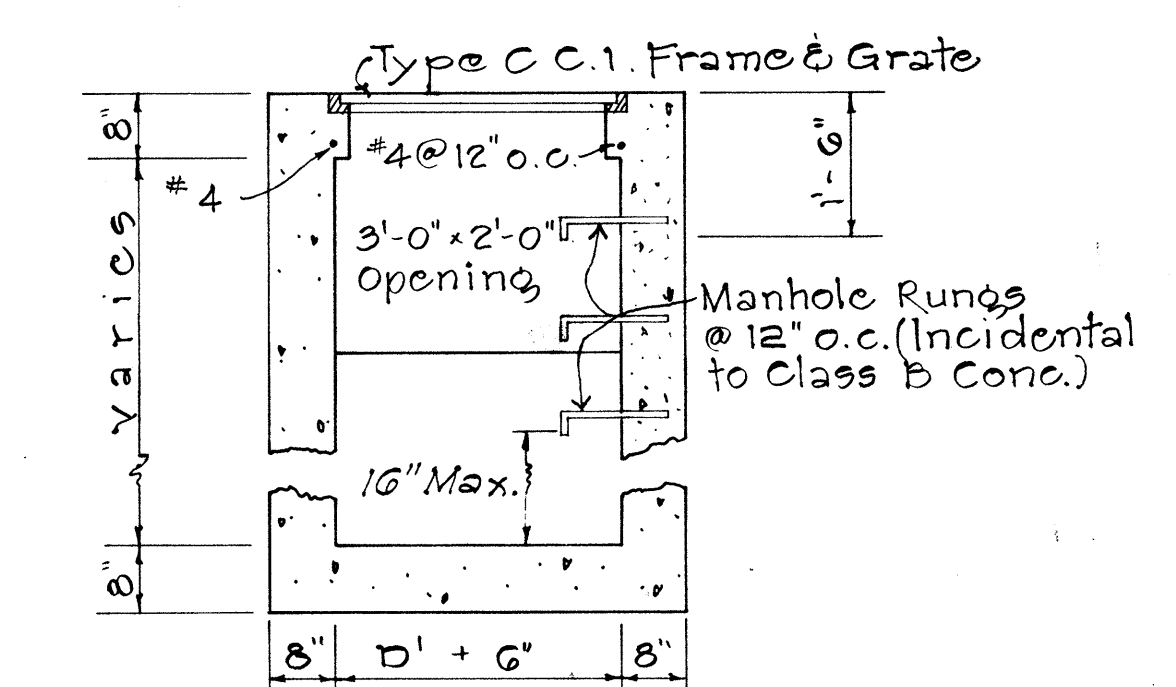

SECTION "G-G"

TYPE "D" GRATED CONCRETE DROP INTAKE


Scale: 1/2" = 1'-0"

APPROVAL RECOMMENDED:
 12-17-69
 HYDRAULIC DESIGN ENGINEER DATE


APPROVED:
 12-17-69
 ASSISTANT CHIEF, ENGINEERING DATE

NO.	REVISION	APPROVED BY	DATE
1	Spacing on Manhole Rungs to conform to OSHA.	H.C.	1-21-75

STATE OF HAWAII
 DEPARTMENT OF TRANSPORTATION
 HIGHWAYS DIVISION
 STANDARD DETAILS
 TYPE "A", "B", "C", AND "D"
 CONCRETE DROP INTAKE
 Scale: As Noted Date: July, 1969
 SHEET No. 10 OF 10 SHEETS DH19

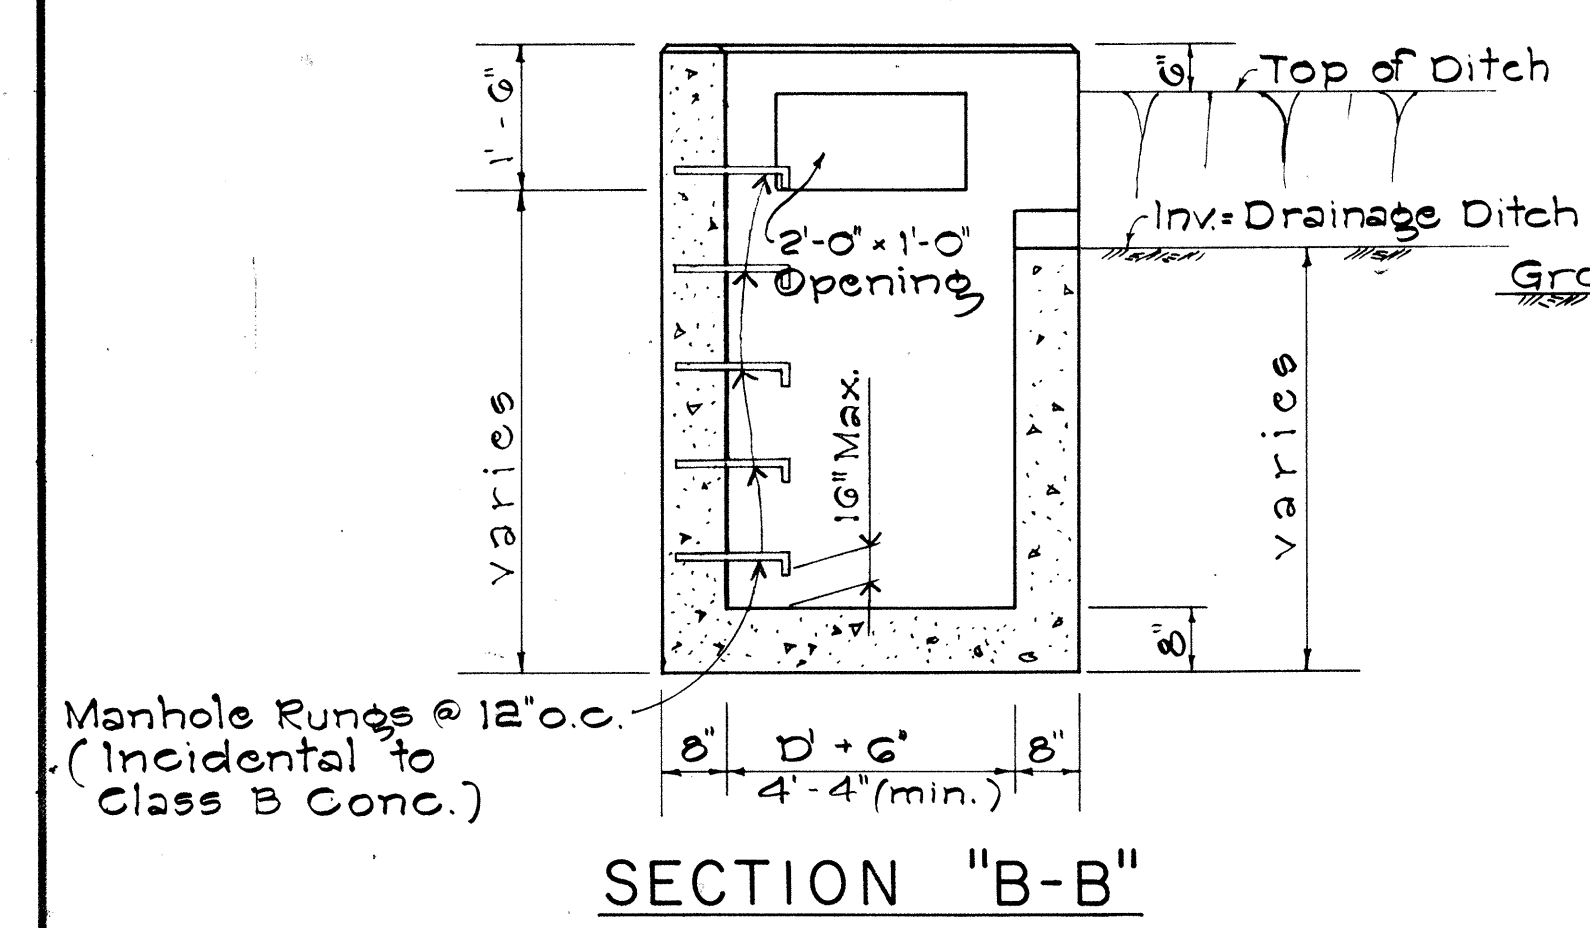

SECTION "B-B"

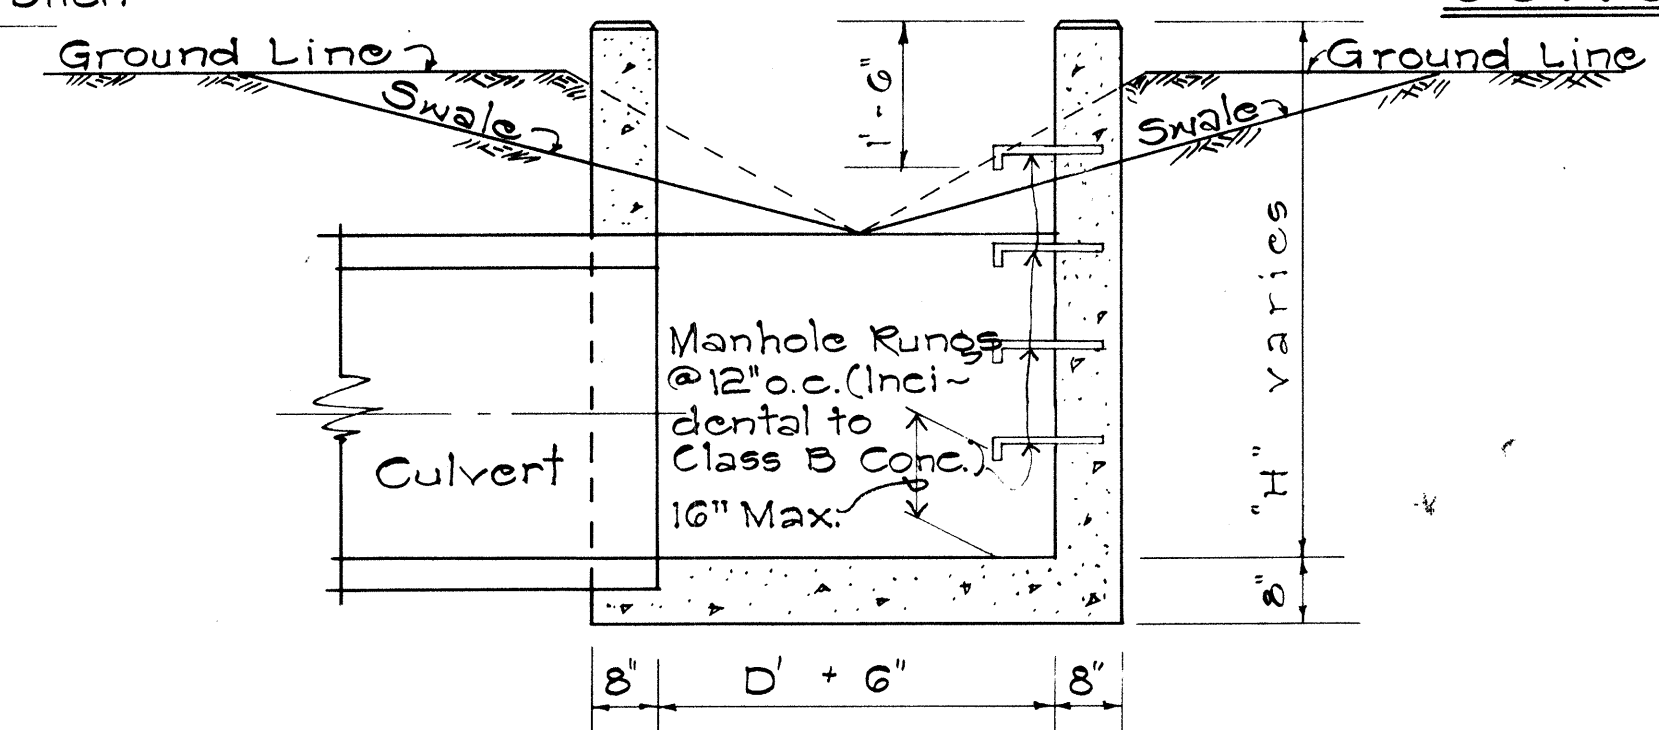

SECTION "D-D"

TYPE "A" CONCRETE DROP INTAKE

Scale: 1/2" = 1'-0"

TYPE "B" CONCRETE DROP INTAKE

Scale: 1/2" = 1'-0"

DATE	12-17-69
SURVEY PLOTTED BY	
DRAWN BY	
DESIGNED BY	
QUANTITIES BY	
CHECKED BY	
ORIGINAL	
NOTE BOOK	
No.	