<u> </u>					
IN	DEX TO DRAWINGS				
SHEET NO.	DESCRIPTION				
. 1	TITLE SHEET				
2	QUANTITIES & GEN. NOTES				
3	TYPICAL SECTIONS & DET.				
4-6	PLAN				
7 - 10	GUARD RAIL STRUCTURE				
	CONNECTION DETAILS				
11=18	TYPICAL & STANDARD				
	GUARD RAIL DETAILS				
	PLANS & DETAILS FOR				
19-21	INSTALLATION OF INDUCTIVE				
	LOOPS & WHEEL CHAIR				
	RAMPS				
22-31	PAVEMENT MARKING PLANS				
	AND DETAILS				
· · · · · · · · · · · · · · · · · · ·					



STATE OF HAWAII

DEPARTMENT OF TRANSPORTATION HIGHWAYS DIVISION

HONOLULU, HAWAII
"AS-BUILT"


PLANS FOR


MOANALUA FREEWAY RESURFACING

AIEA INTERCHANGE

FEDERAL AID PROJECT NO. FR-078-1(23)

DISTRICT OF EWA ISLAND OF OAHU

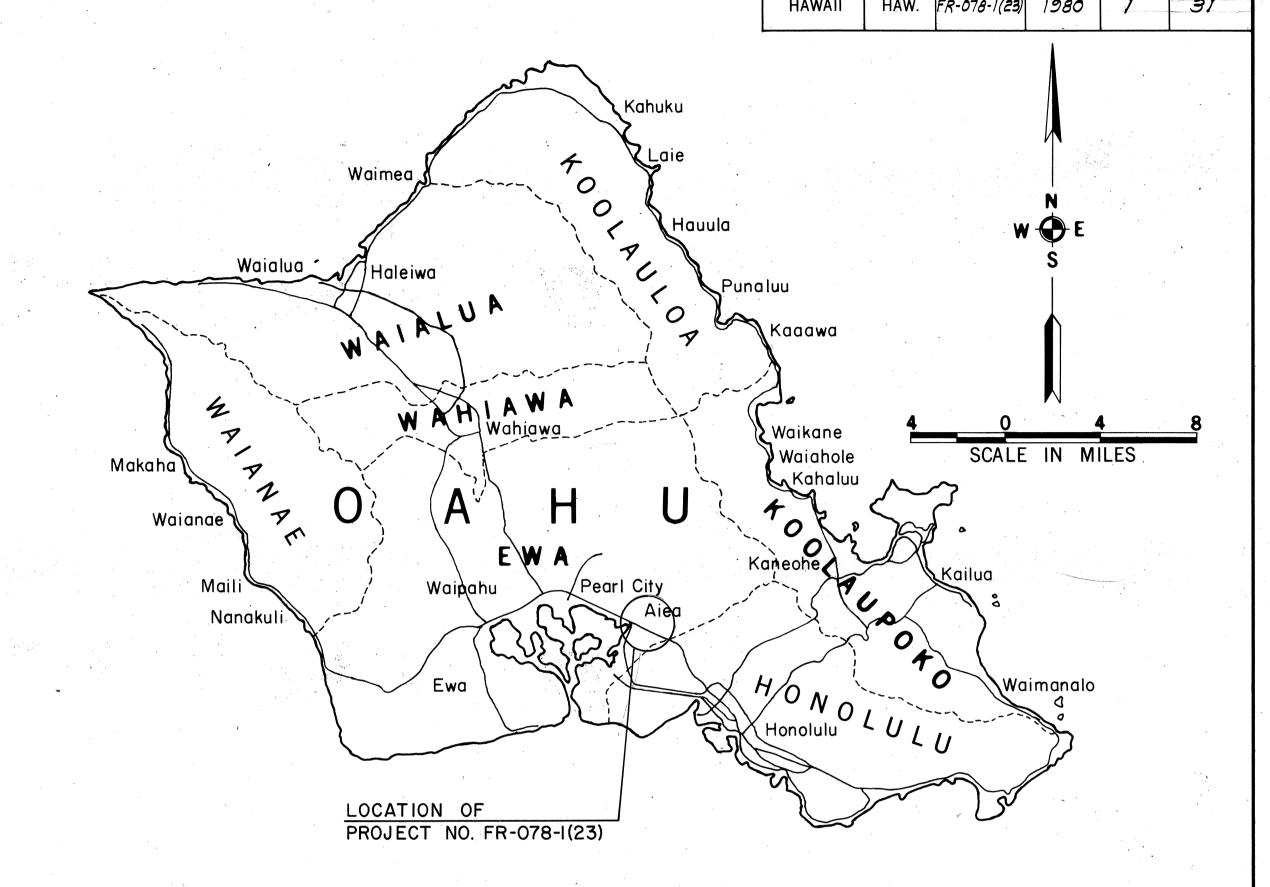

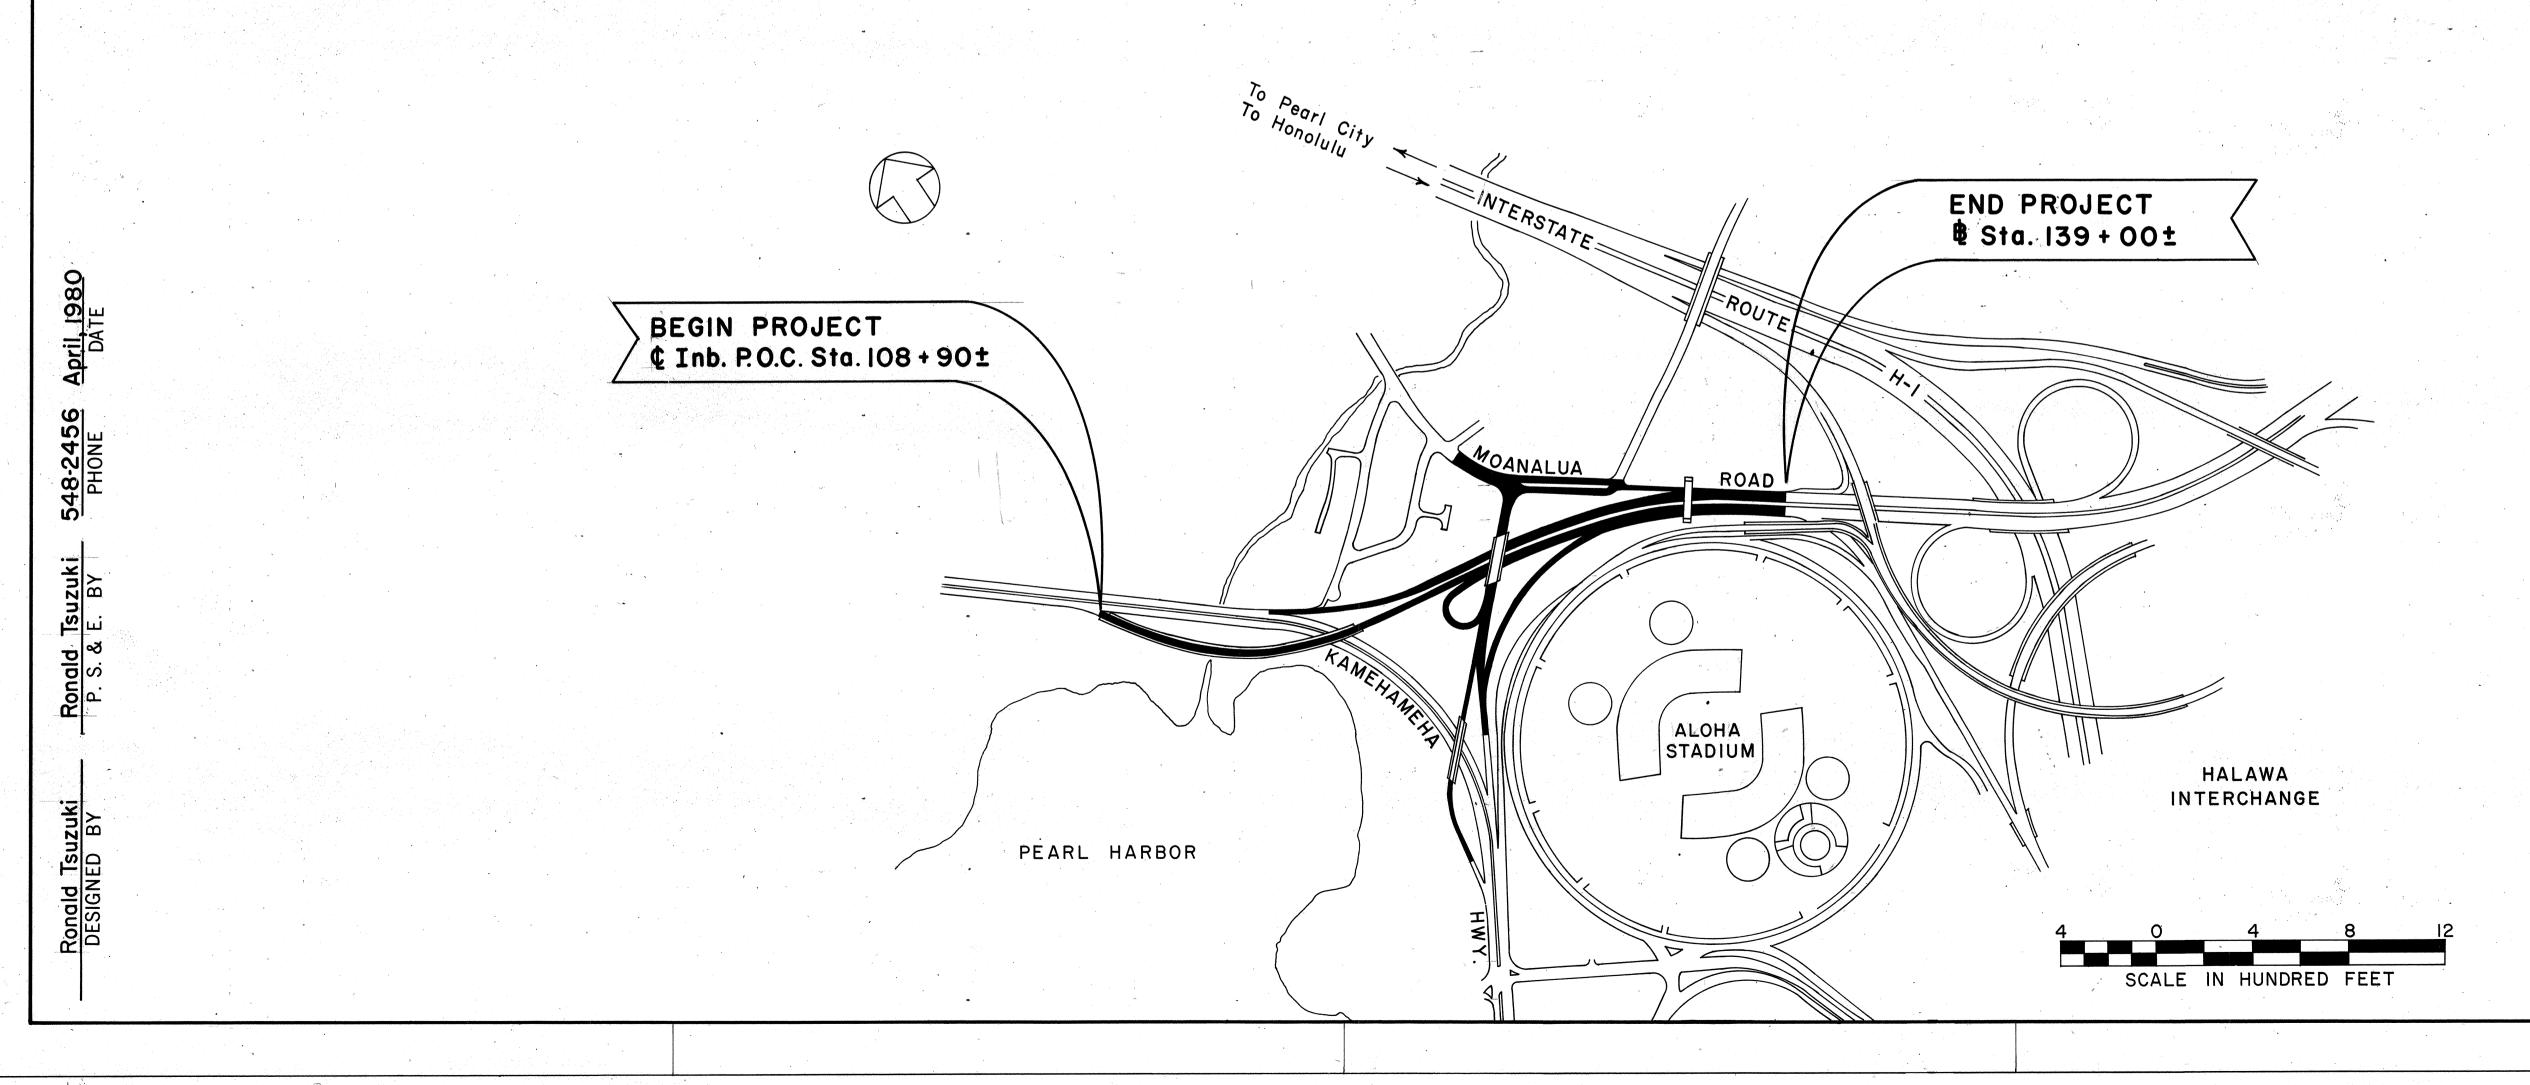

ALL CHANGES MADE DURING CONSTRUCTION HAVE BEEN INCORPORATED ON THESE PLANS IN RED EXCEPT CHANGES IN THE ORIGINAL THEORETICAL QUANTITIES. FOR ACTUAL QUANTITIES, REFER TO PROJECT LEDGER AND/OR COMPUTATION BOOK.

RESIDENT ENGINEER

DATE

9-16-81

DESIGN DESIGNATION

ADT		(1979).	g• .•: •; •,,,•	26,310	
DESIG	N ADT	(1989).		39,465	
D				65/35	
		, • • • • • •			
	• • • •		5	O MPH	

DEPARTMENT OF TRANSPORTATION
FEDERAL HIGHWAY ADMINISTRATION
APPROVED:
5.22.80
DIVISION ADMINISTRATOR DATE

DEPARTMENT OF TRANSPORTATION
STATE OF HAWAII
APPROVED:

James R. Carras and DIR. OF TRANSPORTATION

 $\frac{5/2/6}{100}$

PD-13-1-4