




FED. ROAD DIST. NO.	STATE	FED. AID PROJ. NO.	FISCAL YEAR	SHEET NO.	TOTAL SHEETS
HAWAII	HAW.	FR-078-1(23)	1980	3	31

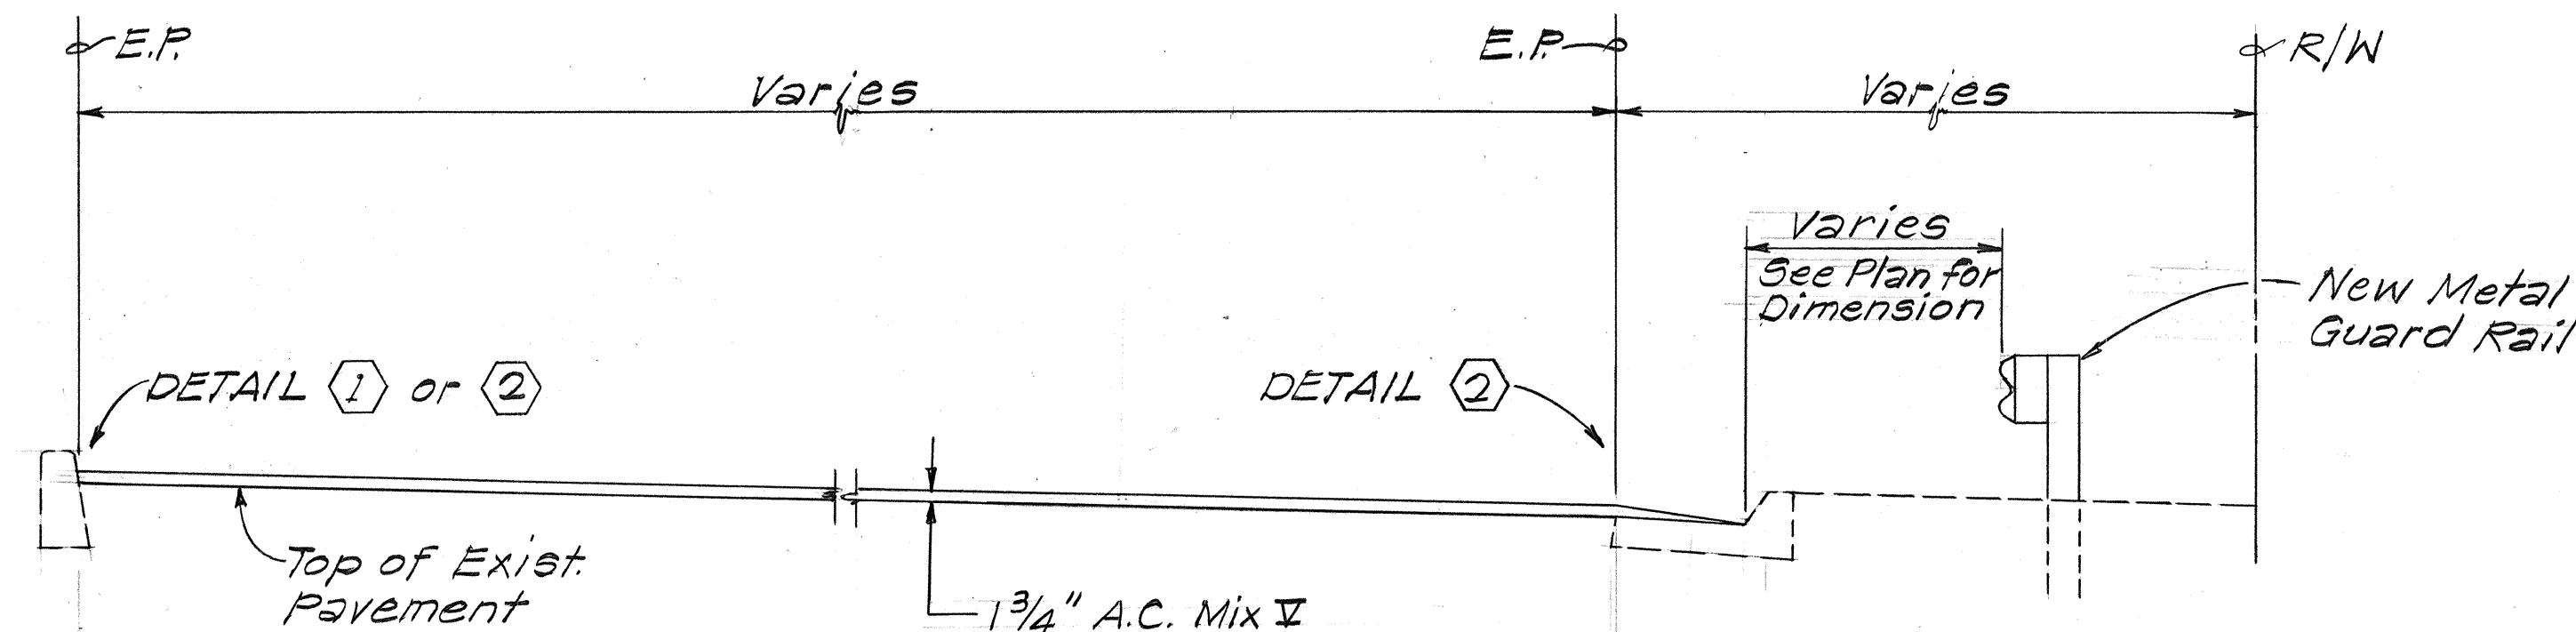


TYPICAL SECTION
Scale: 3/8" = 1'-0"

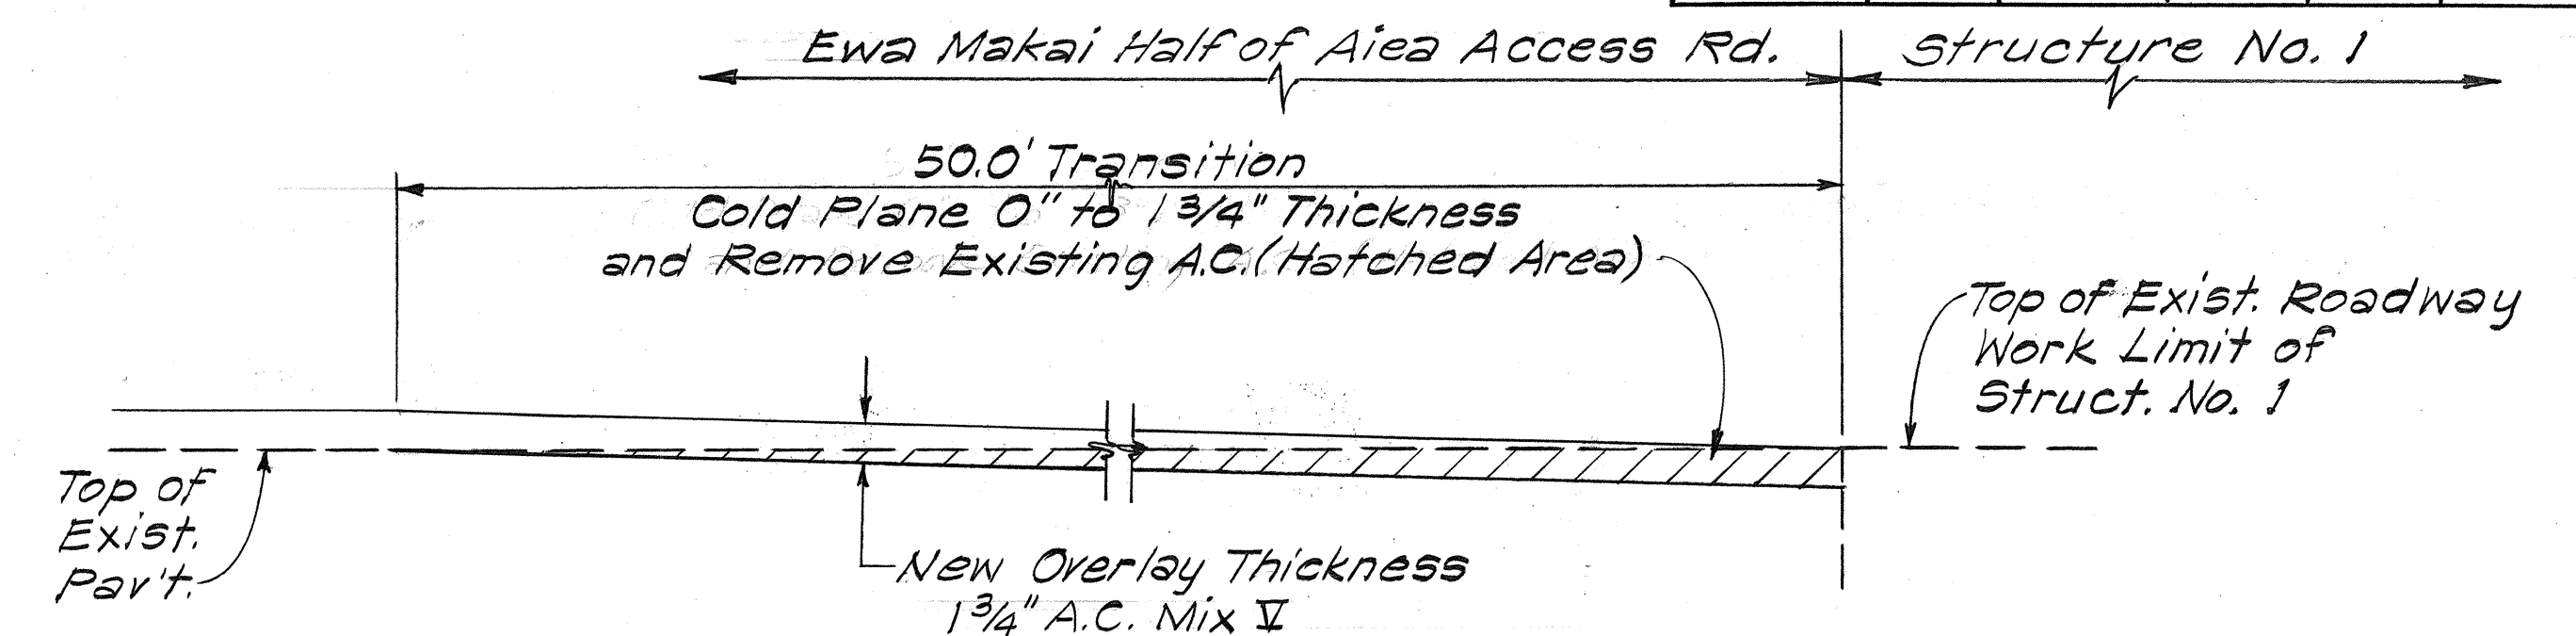


STRUCTURE NO. 1 TRANSITION DETAIL
Scale: 1/2" = 1'-0"

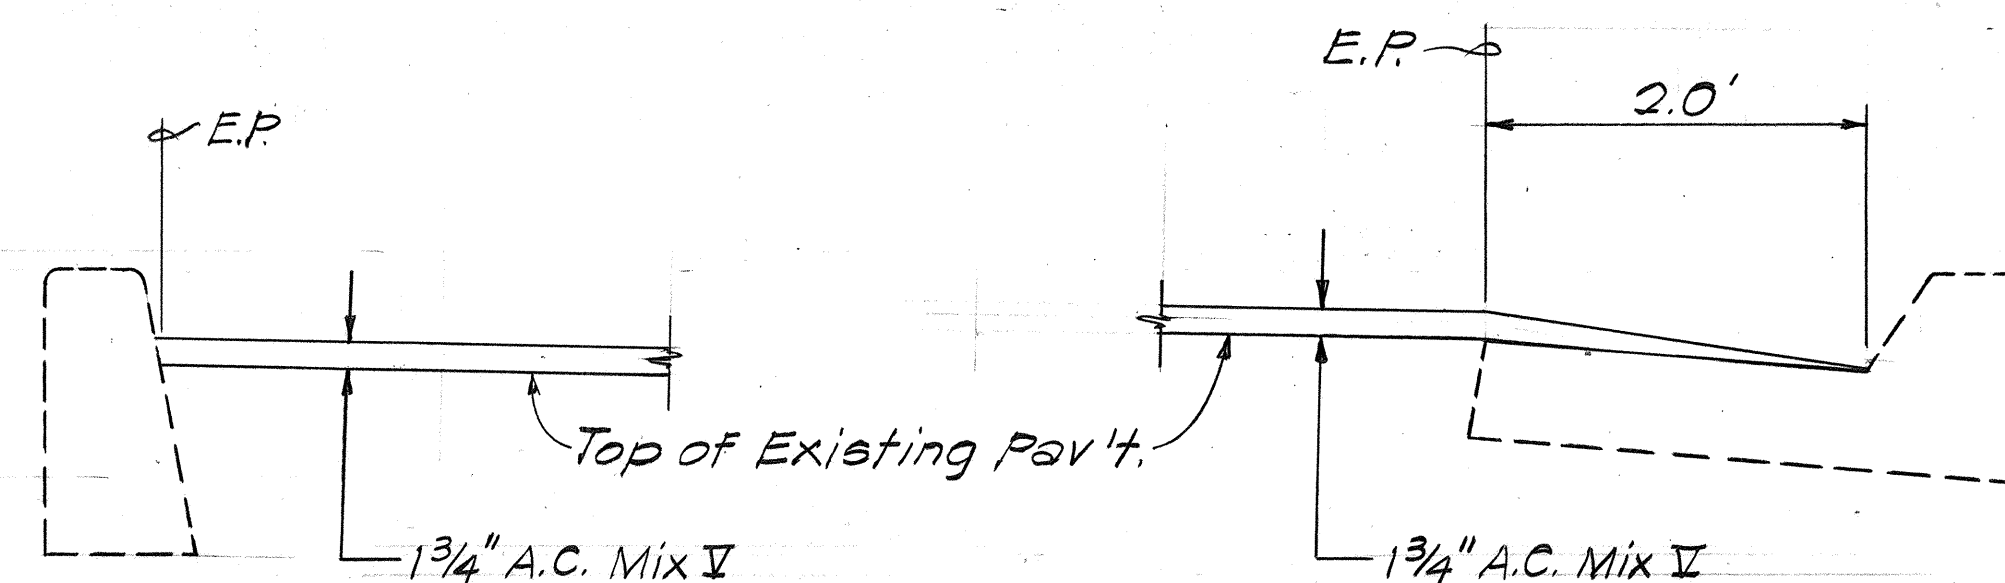


DETAIL 1
Scale: 1" = 1'-0"

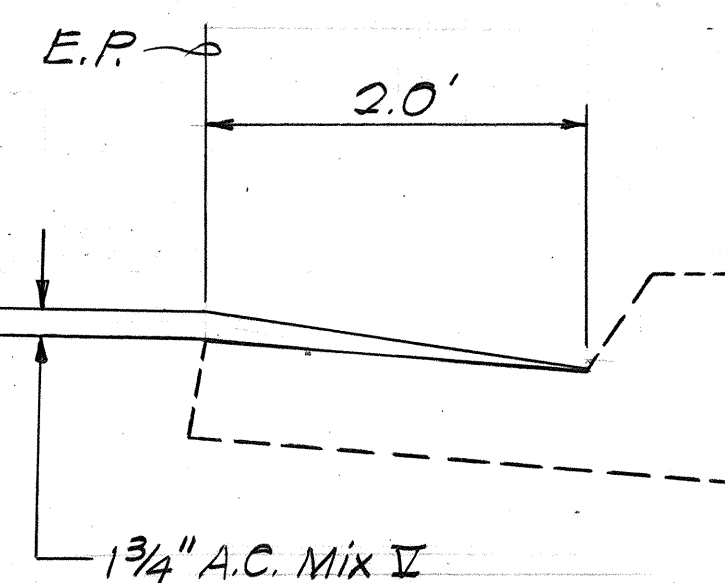


DETAIL 2
Scale: 1" = 1'-0"

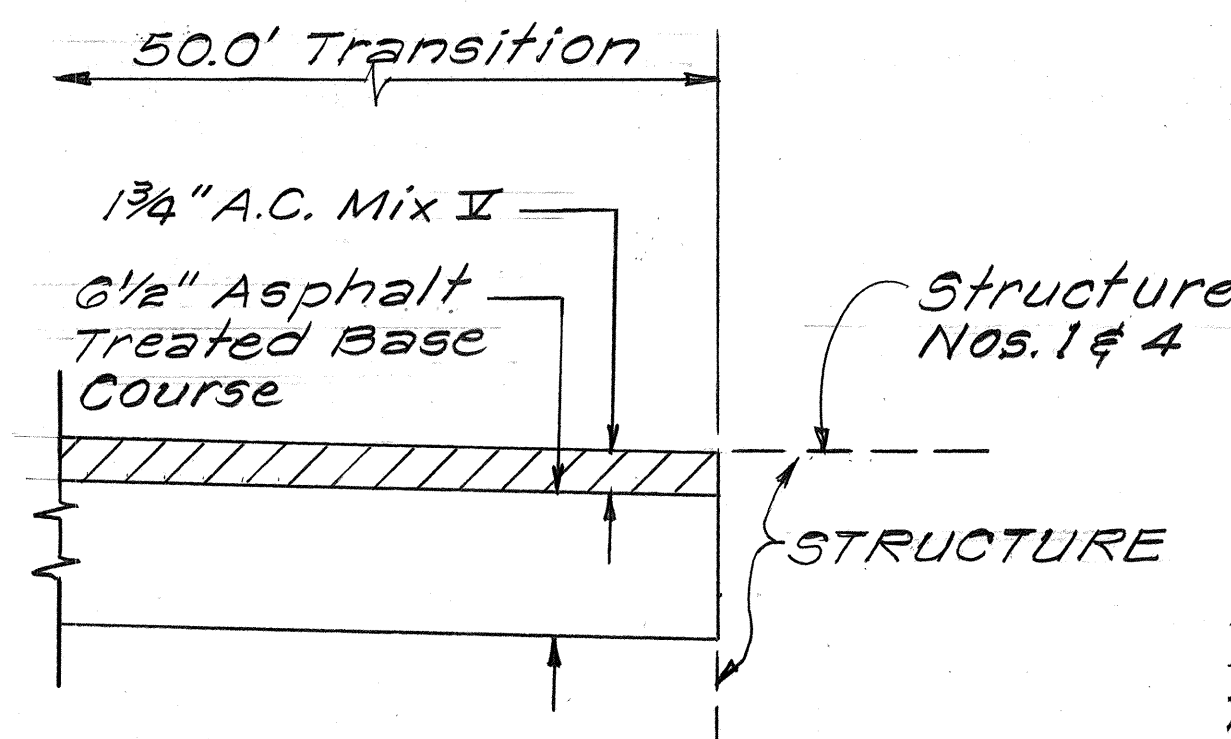


@ STRUCTURE NOS. 1 & 4 TRANSITION DETAIL
Scale: 1/2" = 1'-0"

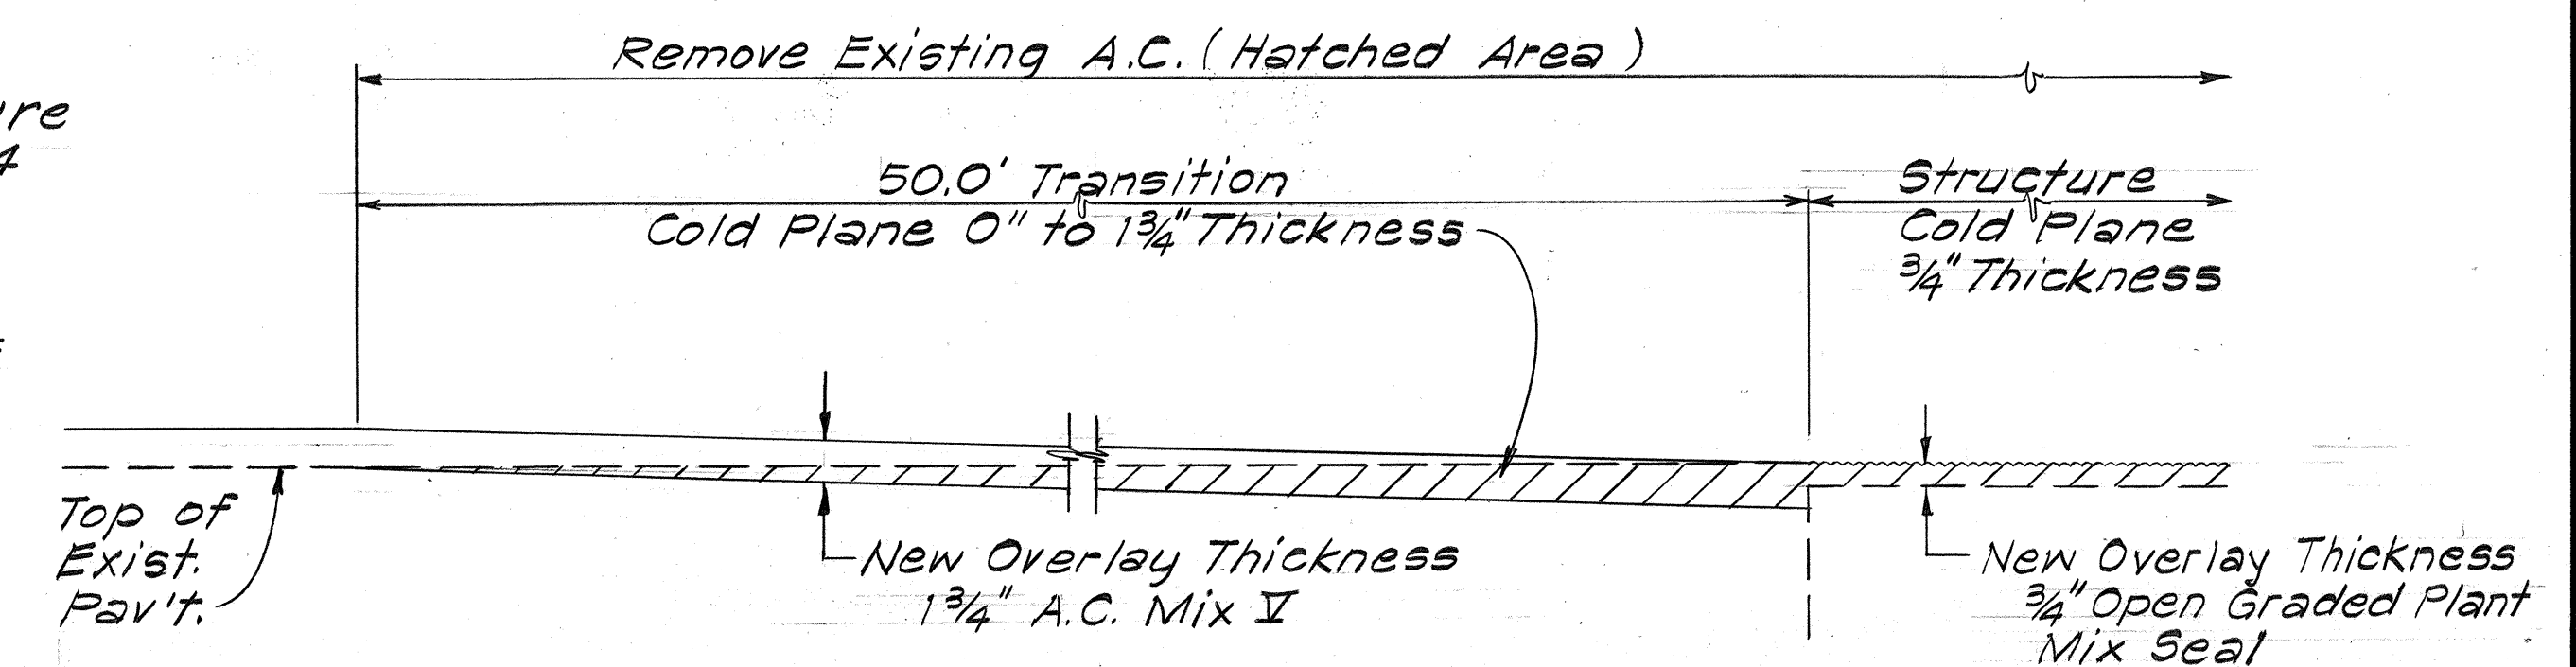

STRUCTURE NO. 2 TRANSITION DETAIL
Scale: 1/2" = 1'-0"

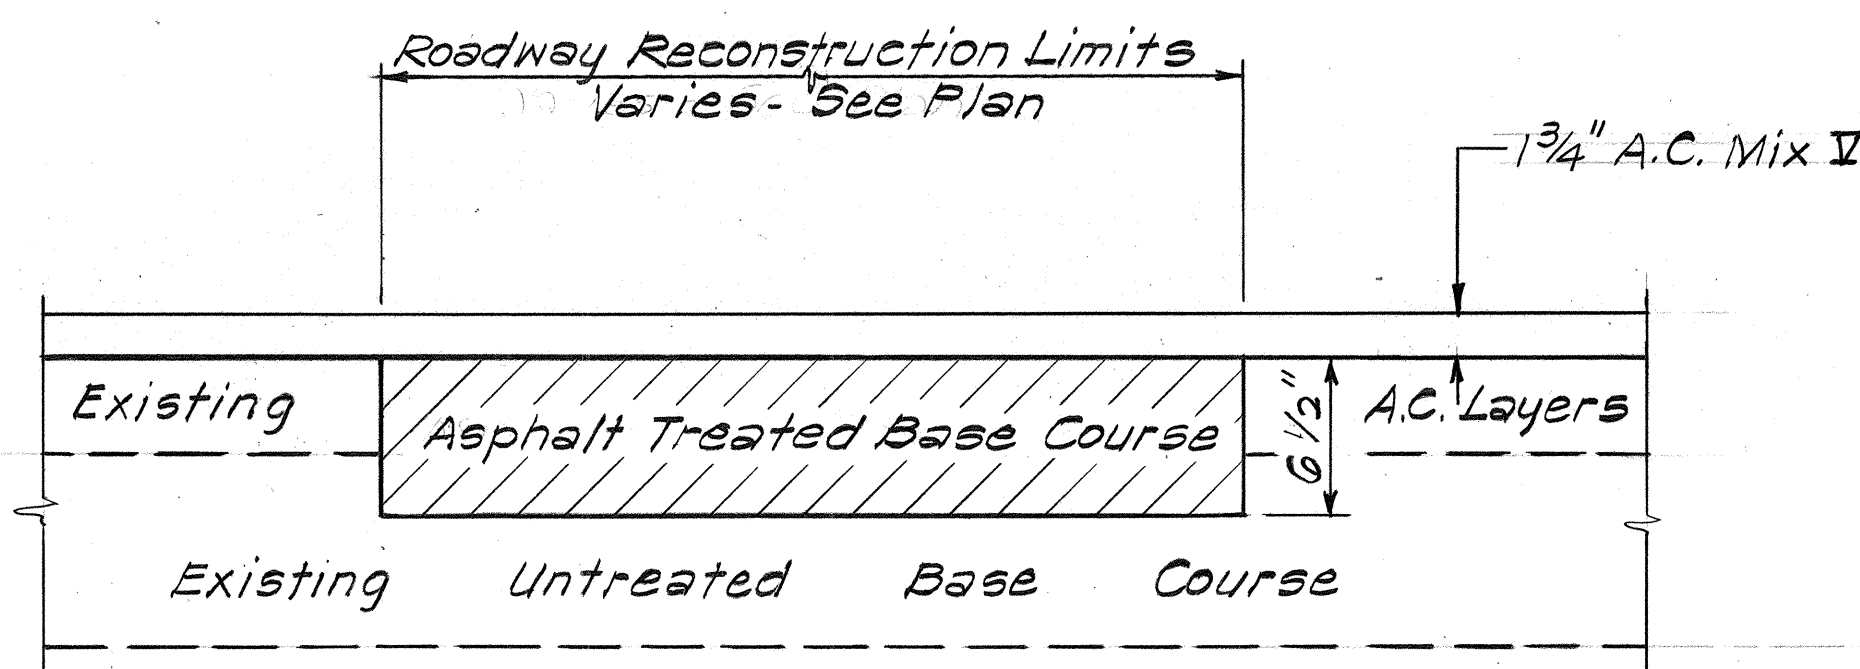


TYPICAL ROADWAY RECONSTRUCTION
Scale: 1/2" = 1'-0"

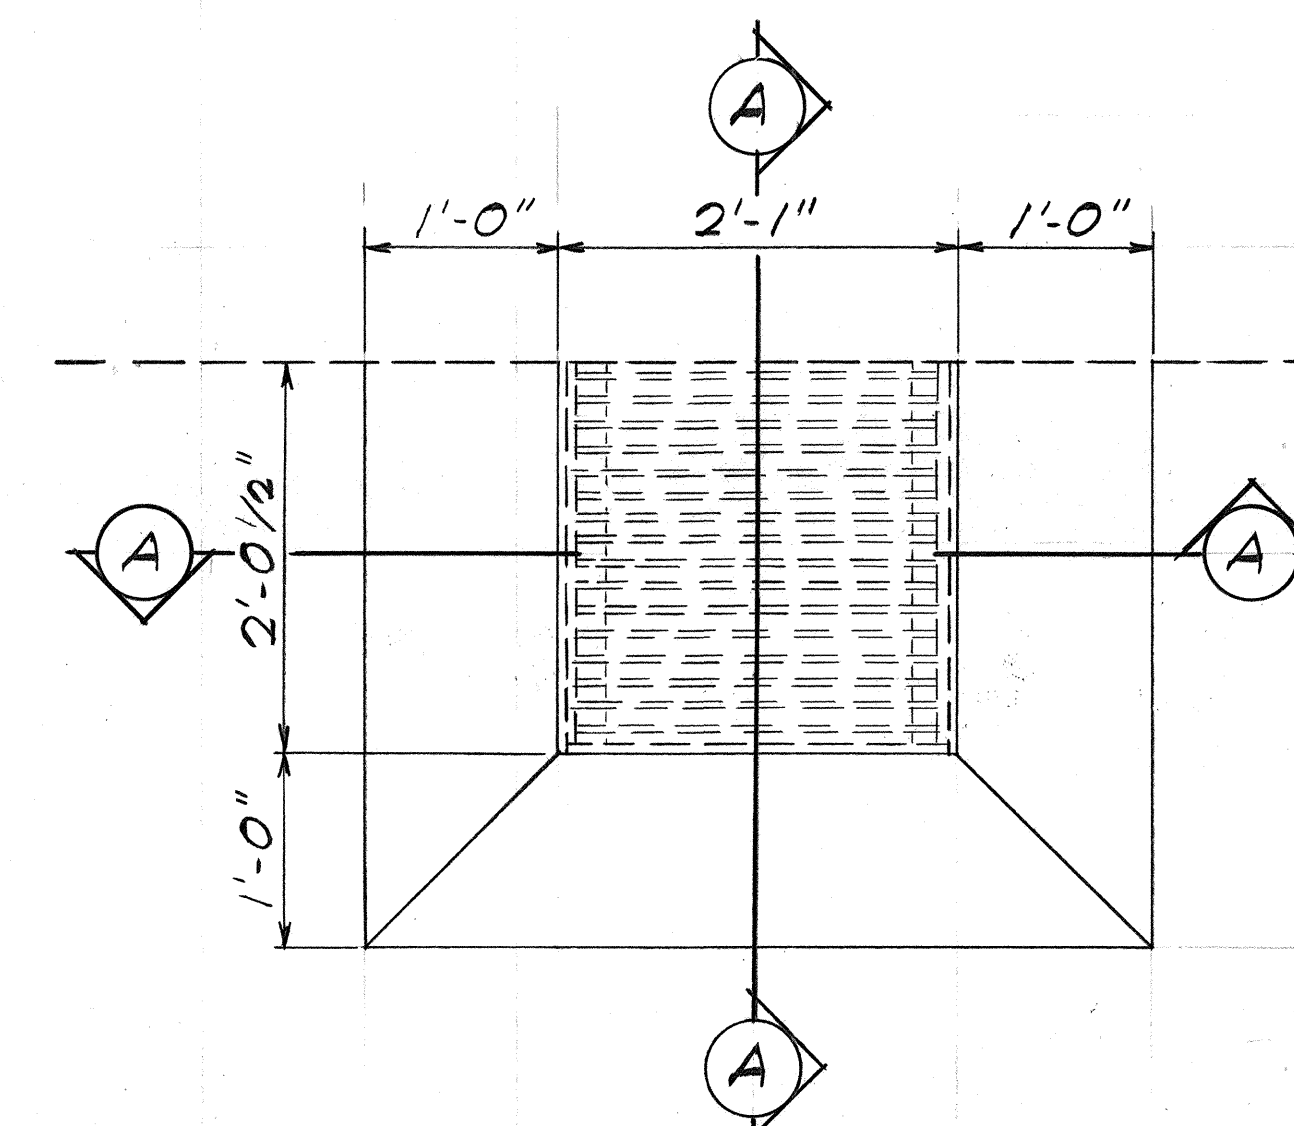

PLAN

STRUCTURE NO. 2 PAVEMENT SLOPE TO GRATING DETAILS
Scale: 1" = 1'-0"

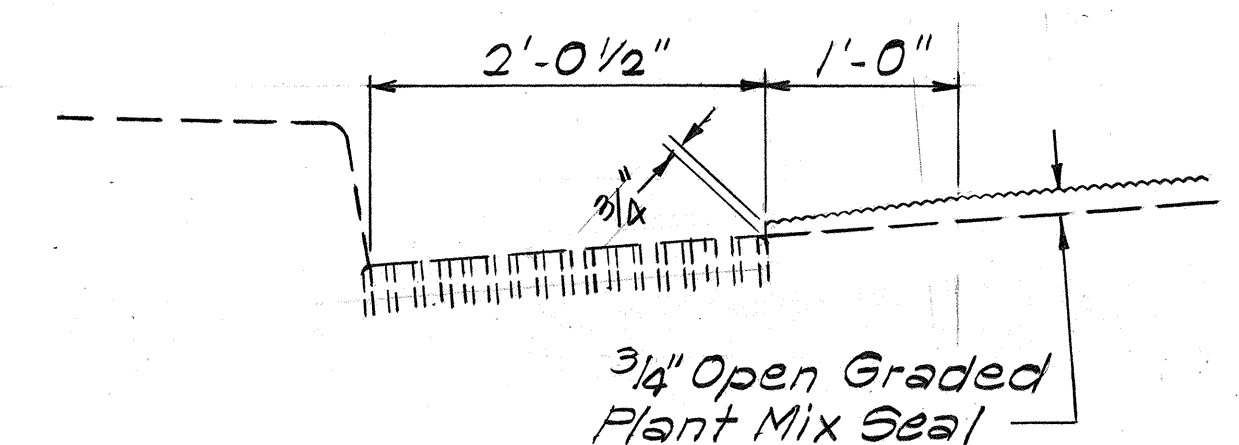

SECTION A

STATE OF HAWAII
DEPARTMENT OF TRANSPORTATION
LAND TRANSPORTATION FACILITIES DIVISION
TYPICAL SECTIONS AND DETAILS
MOANALUA FRWY. RESURFACING
AIEA INTERCHANGE
F.A. PROJ. NO. FR-078-1(23)
Scale: As Shown Date: Mar., 1980
SHEET No. 1 OF 3 SHEETS