


ORIGINAL PLAN	SURVEY PLOTTED BY _____	DATE _____
NOTE BOOK	DRAWN BY _____	" _____
	TRACED BY _____	" _____
	DESIGNED BY _____	" _____
	QUANTITIES BY _____	" _____
N _o _____	CHECKED BY _____	" _____

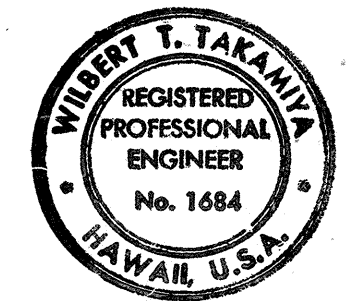

STATE OF HAWAII
DEPARTMENT OF TRANSPORTATION
HIGHWAYS DIVISION

PROFILE &
SUPERELEVATION DIAGRAM
MOANALUA ROAD
PUHLOA I.C. TO MIDDLE ST.-UNIT 3
F.A. Proj. NO. F-078-1(21)
SCALE: AS SHOWN DATE: AUG 1, 1979

SHEET No. 2 OF 3 SHEETS

FED. ROAD DIST. NO.	STATE	FED. AID PROJ. NO.	FISCAL YEAR	SHEET NO.	TOTAL SHEETS
HAWAII	HAW.	F-078-1(21)	1980	13	234

