


FED. ROAD DIST. NO.	STATE	FED. AID PROJ. NO.	FISCAL YEAR	SHEET NO.	TOTAL SHEETS
HAWAII	HAW.	F-078-1(21)	1980	19	234

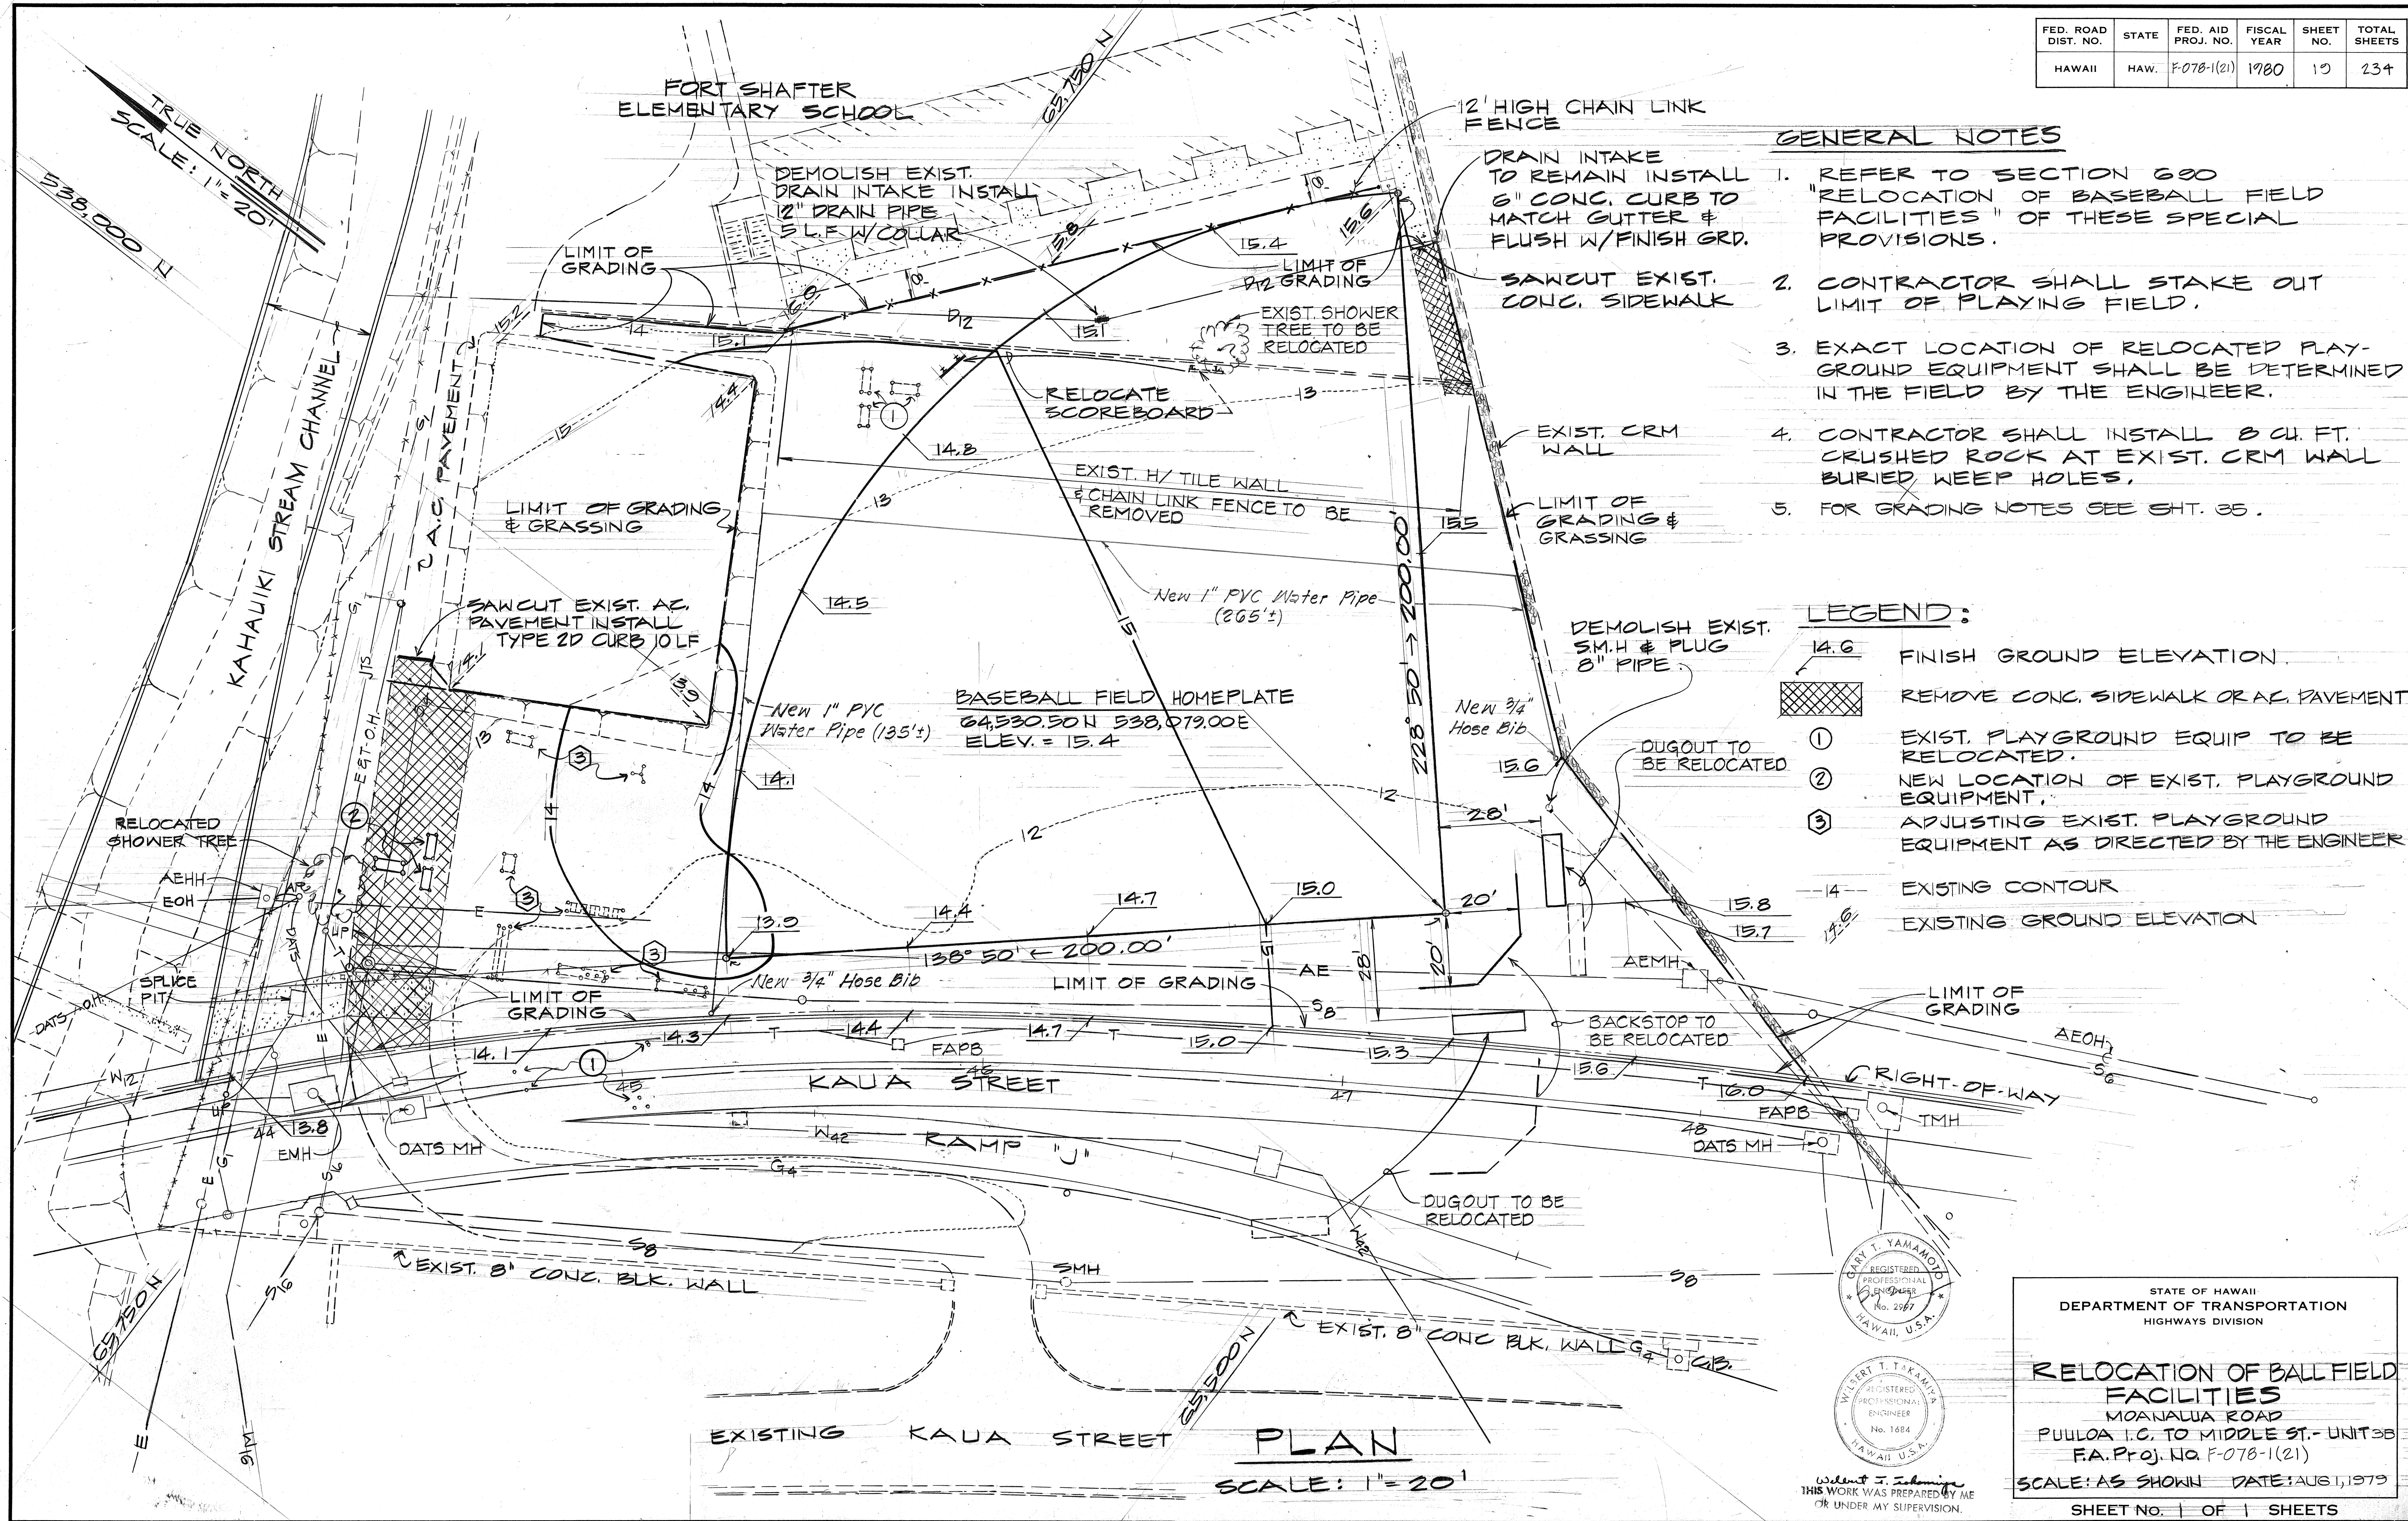



GENERAL NOTES

1. REFER TO SECTION 600 "RELOCATION OF BASEBALL FIELD FACILITIES" OF THESE SPECIAL PROVISIONS.
2. CONTRACTOR SHALL STAKE OUT LIMIT OF PLAYING FIELD.
3. EXACT LOCATION OF RELOCATED PLAYGROUND EQUIPMENT SHALL BE DETERMINED IN THE FIELD BY THE ENGINEER.
4. CONTRACTOR SHALL INSTALL 8 CU. FT. CRUSHED ROCK AT EXIST. CRM WALL BURIED WEEP HOLES.
5. FOR GRADING NOTES SEE SHT. 35.

LEGEND:

- 14.6 FINISH GROUND ELEVATION.
- [Hatched Box] REMOVE CONC. SIDEWALK OR AC. PAVEMENT.
- ① EXIST. PLAYGROUND EQUIP TO BE RELOCATED.
- ② NEW LOCATION OF EXIST. PLAYGROUND EQUIPMENT.
- ③ ADJUSTING EXIST. PLAYGROUND EQUIPMENT AS DIRECTED BY THE ENGINEER.
- 14- EXISTING CONTOUR
- 14.6 EXISTING GROUND ELEVATION

SURVEY PLOTTED BY	DATE
DESIGNED BY	
CHECKED BY	
NO.	

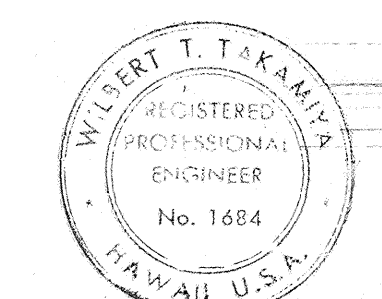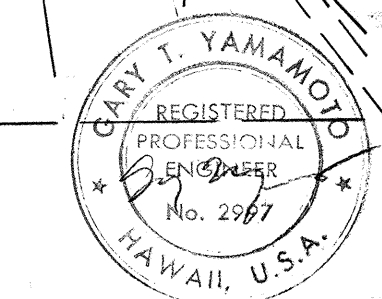

Walter J. Schmitt
THIS WORK WAS PREPARED BY ME
OR UNDER MY SUPERVISION.

STATE OF HAWAII
DEPARTMENT OF TRANSPORTATION
HIGHWAYS DIVISION

RELOCATION OF BALL FIELD FACILITIES
MOANALUA ROAD
PUULOA I.C. TO MIDDLE ST. - UNIT 38
F.A. Proj. No. F-078-1(21)

SCALE: AS SHOWN DATE: AUG 1, 1979

SHEET NO. 1 OF 1 SHEETS