	INDEX TO DRAWINGS
SHEET NO.	DESCRIPTION
1.	TITLE SHEET
2	STANDARD PLANS SUMMARY
3	GENERAL NOTES AND TYPICAL SECTIONS
4	MISCELLANEOUS DETAILS
5	MISCELLANEOUS SUMMARIES
,	
7	

TRAFFIC PAVEMENT MARKING PLANS
SPECIALLY MARKED FOR INFORMATION
ONLY AND ARE NOT PART OF ORIGINAL
CONTRACT PLANS

STATE OF HAWAII


DEPARTMENT OF TRANSPORTATION
HIGHWAYS DIVISION
HONOLULU, HAWAII
"AS BUILT"
PLANS FOR

MOANALUA ROAD RESURFACING

KAMEHAMEHA HIGHWAY TO MOANALUA STREAM BRIDGE (INBOUND LANES)

PROJECT NO. 78A-01-90M

DISTRICTS OF EWA & HONOLULU ISLAND OF OAHU

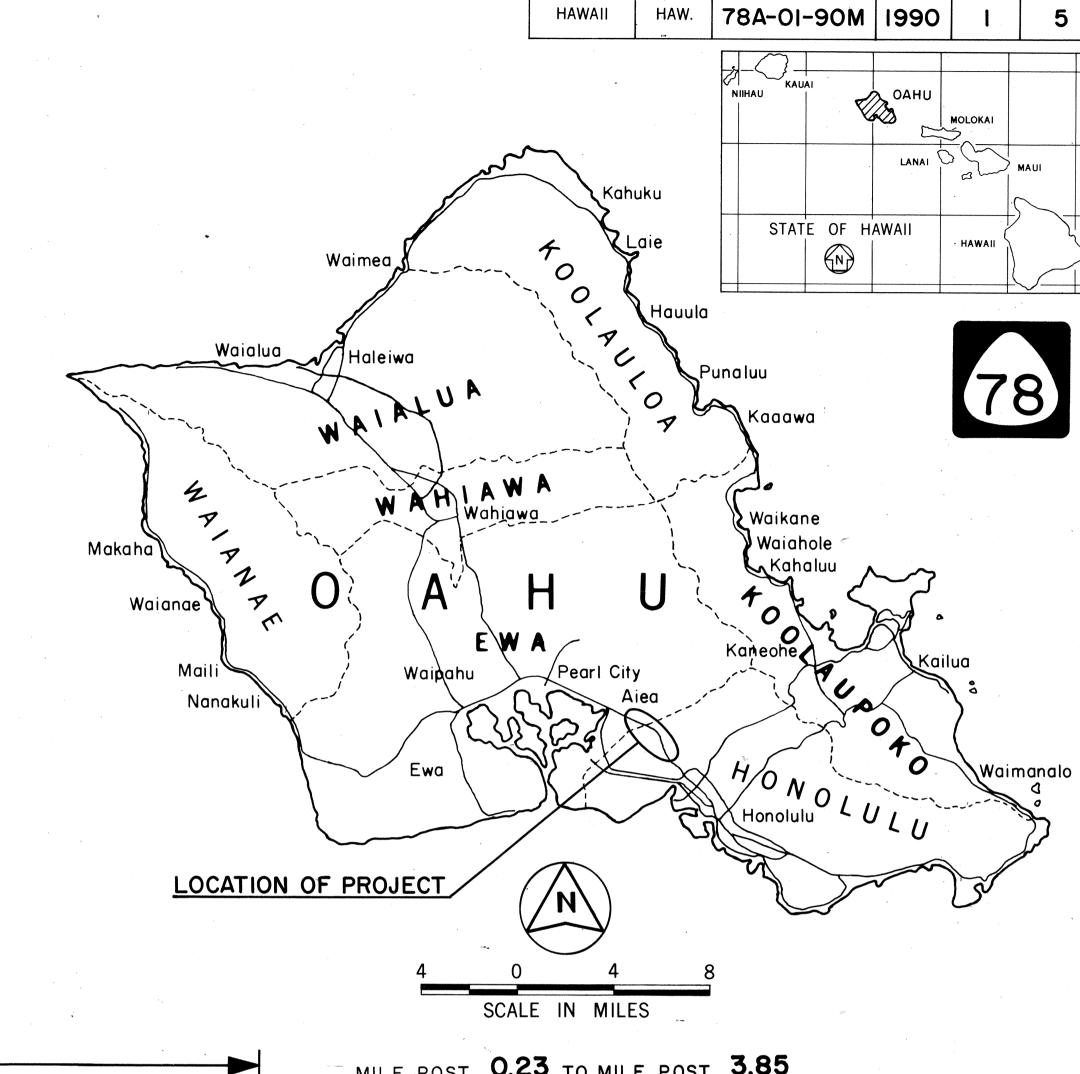

FED. ROAD DIST. NO.

PROJ. NO.

