


DESTINATION SIGN NOTES:

1. Sign details shall conform to the latest editions and amendments of the following FHWA publications: "Manual on Uniform Traffic Control Devices for Streets and Highways", "Standard Highway Signs" and "Standard Alphabets for Highway Signs."
2. Border widths and radii shall conform to Standard TE-14, except as noted.
3. For additional information of Changeable Message Signs (CMS) and Variable Message Signs (VMS), see System Plans.
4. Existing signs shown on plans are known by the Engineer through his search of existing plans and field inspections. The Contractor shall verify presence of existing signs. They shall be removed and stockpiled at DOT's Pearl City baseyard as directed by the Engineer. Removal of ground mounted destination signs shall also include the removal of post and foundation to a minimum height of 1-foot below the ground. Post and foundations shall become the property of the Contractor. Payment shall be considered incidental to various contract items.
5. The Contractor shall backfill all holes, depressions and pits left by the removal of the existing signs with embankment material and grass all areas exposed in accordance with specifications section 618-grassed surfaces. Payment shall be considered incidental to various contract items.
6. Ground Mounted Destination sign's mounting and footing shall conform to Standard Plans TE-23, TE-24, TE-26 & TE-27 except as noted on plans.
7. Payment for Type I barricade will be paid under Section 645-Traffic Control.
8. For Traffic Control Plans not shown, see Special Provision Section 621.
9. Payment for temporary relocation of signs to facilitate construction will be considered incidental to various contract items. Contractor shall obtain Engineer's approval for proposed temporary supports.
10. For gore area signs 'D', sign mounting and footing shall conform to Standard Plan TE-2.
11. See Sht. No. 6P19 for Exit Panel Details. Shop drawings for the attachment of Exit Number Panels to existing and new Destination Signs ('E') and Changeable Message Signs (CMS) shall be submitted by the Contractor to the Engineer for approval.
12. See Sht. No. 6P20 for Arrow A and Arrow C dimensions.
13. A minimum clearance of 17' must be maintained between the high point of the roadway and the bottom of the lighting fixture frame.
14. The Contractor shall trim vegetation to provide motorists a clear view of each sign. Payment for trimming of vegetation shall be considered incidental to various contract items.
15. The Contractor shall verify the span length prior to manufacturing all sign structures.

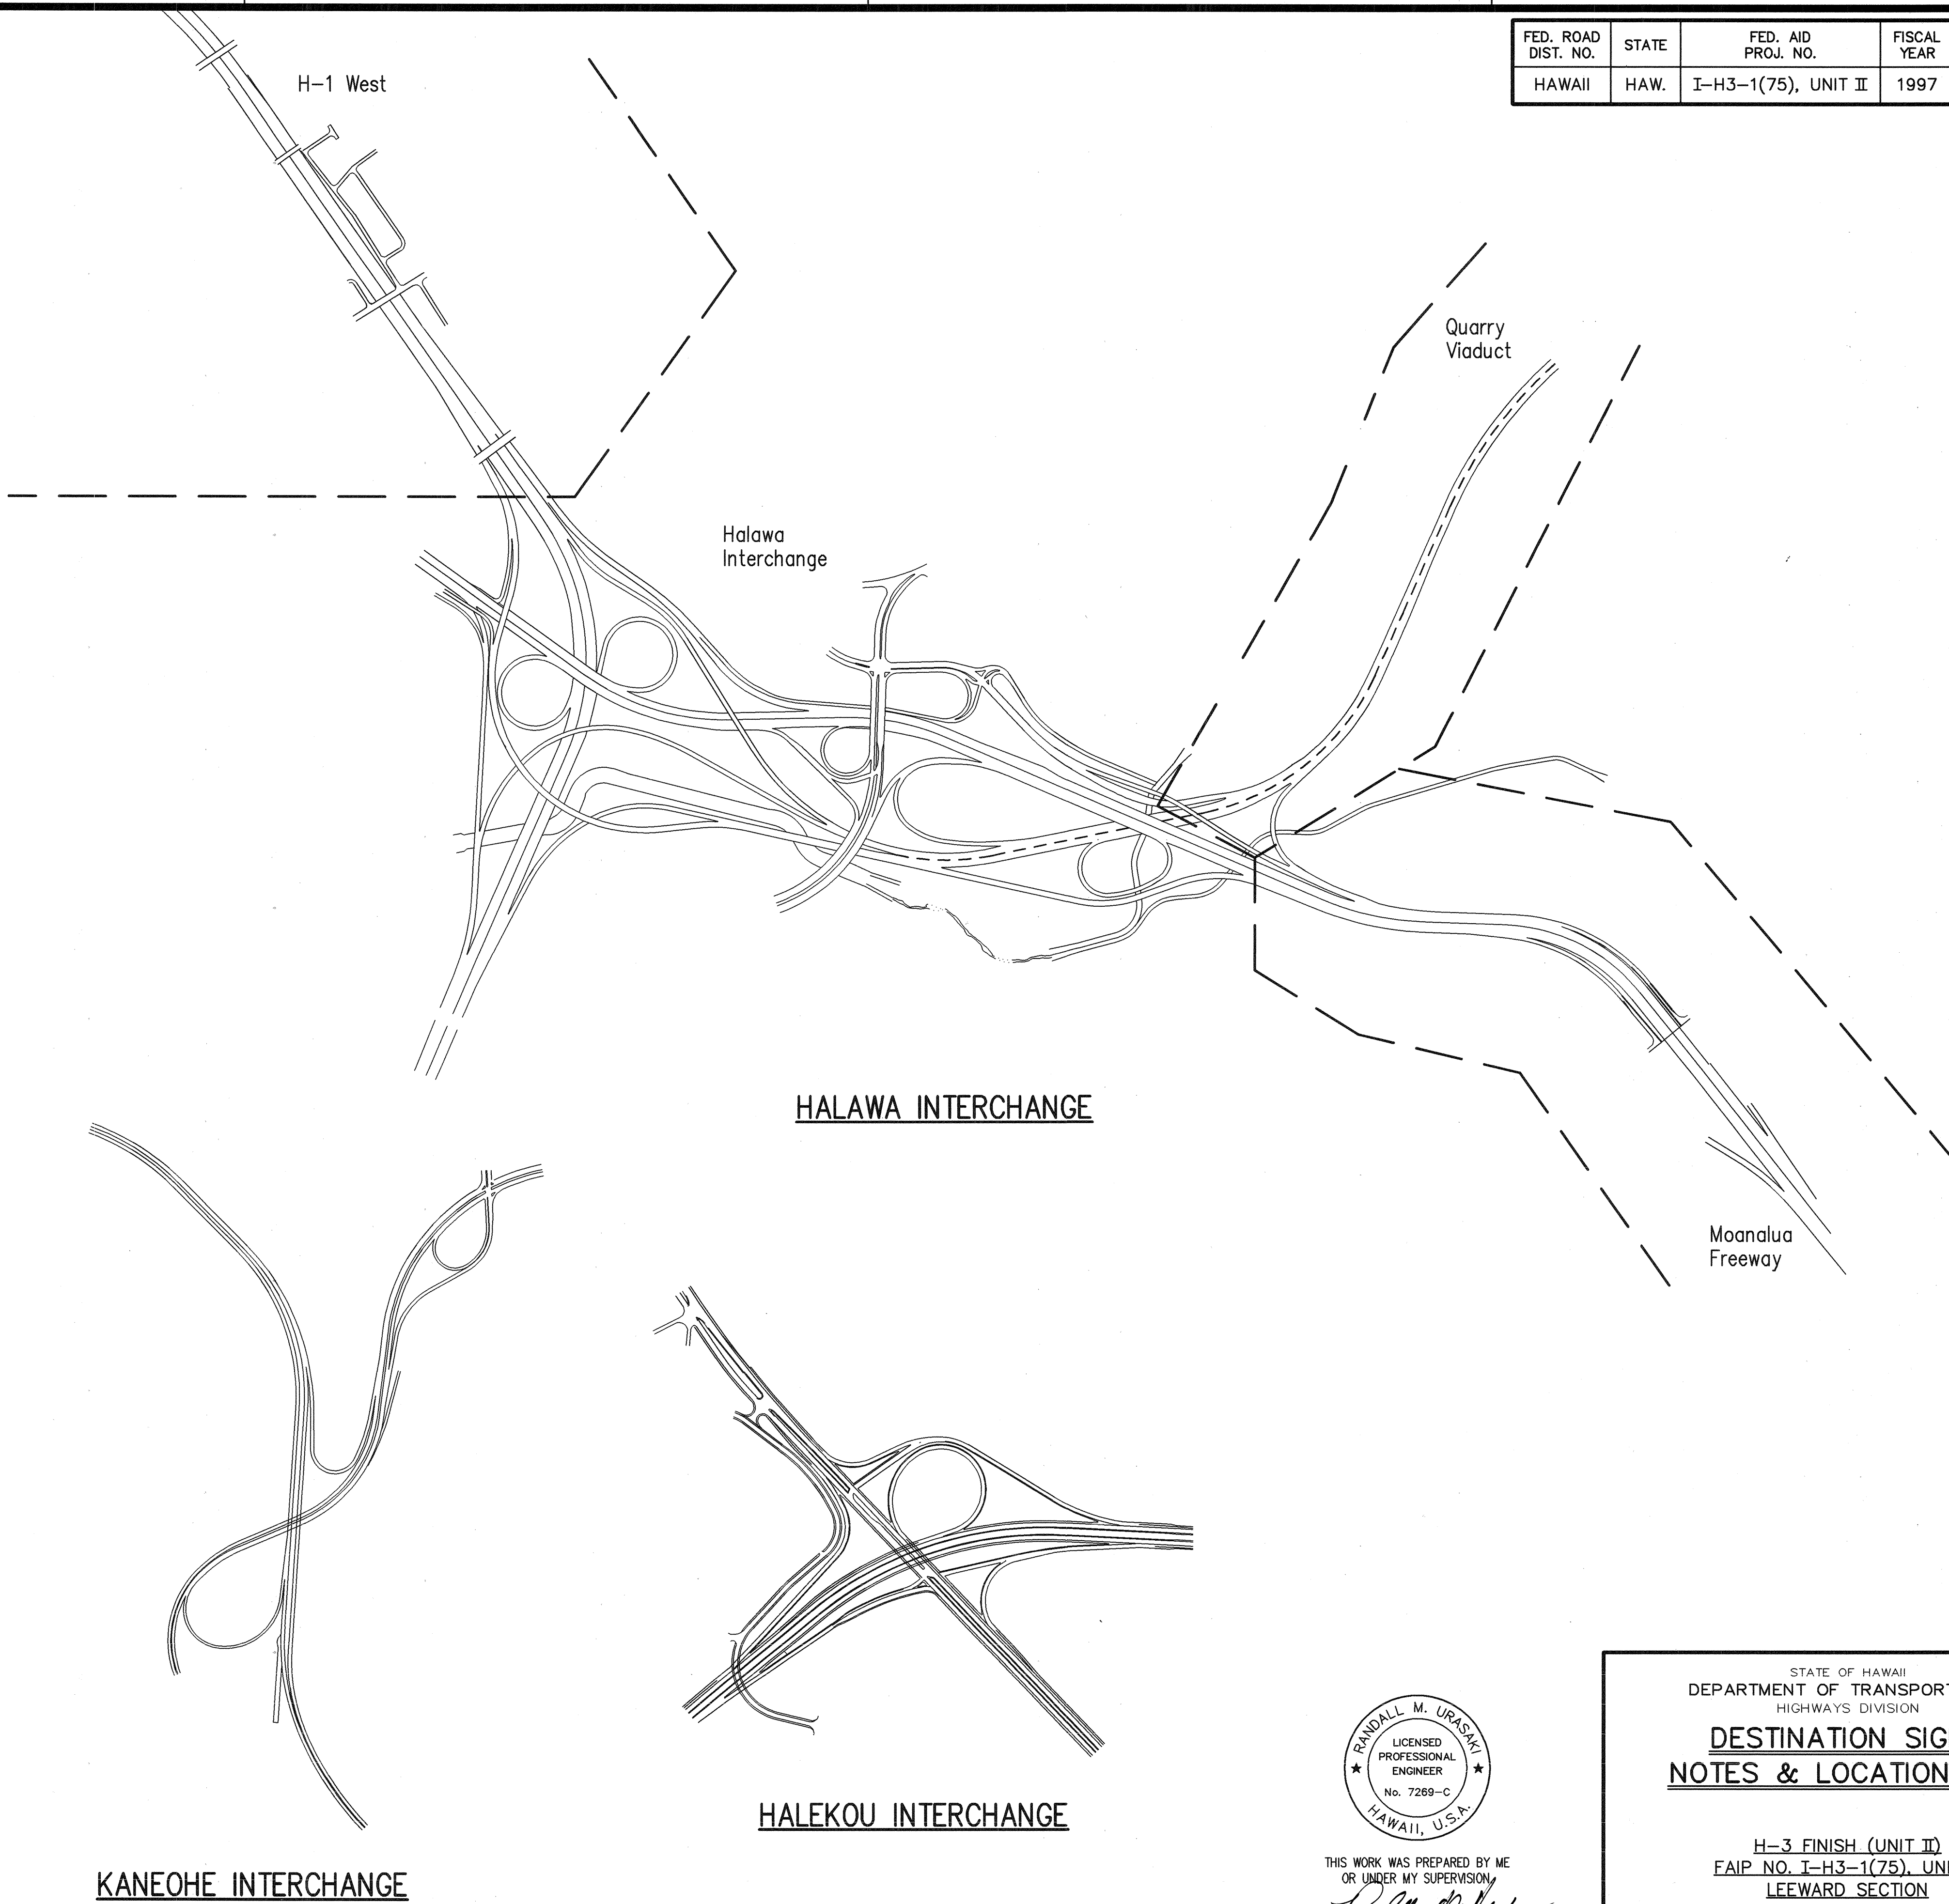


FED. ROAD DIST. NO.	STATE	FED. AID PROJ. NO.	FISCAL YEAR	SHEET NO.	TOTAL SHEETS
HAWAII	HAW.	I-H3-1(75), UNIT II	1997	845	1102

ORIGINAL PLAN	SURVEY PLOTTED BY	DATE
NOTE BOOK	DRAWN BY	
	TRACED BY	
	DESIGNED BY	
	QUANTITY BY	
	CHECKED BY	
No.		

CAD by J. Minura, 55-52


Last Saved: J:\H3RF\RFU2\SIGN\SS-NOTES.dwg 02/24/97 at 06:57

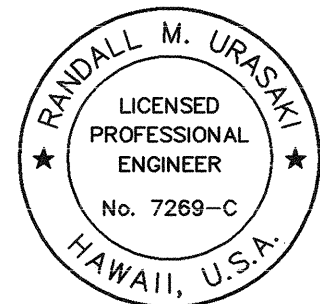

THIS WORK WAS PREPARED BY ME
OR UNDER MY SUPERVISION
Randall M. Urasaki

STATE OF HAWAII DEPARTMENT OF TRANSPORTATION HIGHWAYS DIVISION	
DESTINATION SIGNS NOTES & LOCATION MAP	
H-3 FINISH (UNIT II) FAIP NO. I-H3-1(75), UNIT II LEEWARD SECTION	
SCALE: NONE	DATE: JANUARY 1997
SHEET NO. 6G1 OF 6 SHEETS	

FED. ROAD DIST. NO.	STATE	FED. AID PROJ. NO.	FISCAL YEAR	SHEET NO.	TOTAL SHEETS
HAWAII	HAW.	I-H3-1(75), UNIT II	1997	846	1102

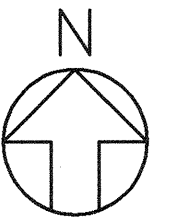

Matchline A
See Below

EXIT 10
Pearl City
Waimalu
1/2 MILE

E-72
Interstate Route H-1
Outbound Sta. 129+63±

Kaonohi St.
Bridge

↓
↓
↓
Pearl Harbor

E-68L
Interstate Route H-1 Inbound Sta. 138+75±

EXIT 13 A
HAWAII 78 EAST
Kaneohe
Honolulu
1 MILE
EXIT ↓ ONLY

EXIT 13 A
HAWAII 78 EAST
Kaneohe
Honolulu
EXIT ↓ ONLY

E-74R
Interstate Route H-1
Inbound Sta. 172+38±

Kaamilo St.
Bridge

EXIT 10
Pearl City
Waimalu
1 MILE

E-70
Interstate Route H-1
Outbound Sta. 152+80±

Matchline A
See Above

Aiea
Right Lane

E-66
Interstate Route H-1
Inbound Sta. 174+00

Aiea
Right Lane

EXIT 13 A
HAWAII 78 EAST
Kaneohe
Honolulu
EXIT ↓ ONLY

EXIT 13 A
HAWAII 78 EAST
Aiea
Honolulu
EXIT ↓ ONLY

E-64L
Interstate Route H-1
Inbound Sta. 191+88±

E-64R

Aiea Hts. Drive
Bridge

EXIT 13 B
Halawa Hts.
Stadium
NEXT RIGHT

EXIT 13 A
HAWAII 78 EAST
Kaneohe
Honolulu
EXIT ONLY

EXIT 13 A
HAWAII 78 EAST
Aiea
Honolulu
EXIT ONLY

E-8L
Interstate Route H-1 Inbound Sta. 200+65

E-8C

E-8R

↓
↓
↓
HAWAII EAST
Hickam AFB
Pearl Harbor
Airport

E-50L
See Note 1.
Interstate Route H-1 Inbound Sta. 204+10±

78 WEST
Aiea

E-50R

EXIT
13 A

Kaimakani St.
Bridge

H-1


Ramp D

Ramp WE

Ramp A

FOR DESTINATION SIGNS,
SEE LOCATION MAP,
HALAWA INTERCHANGE

FOR DESTINATION SIGNS,
SEE LOCATION MAP,
HALAWA INTERCHANGE

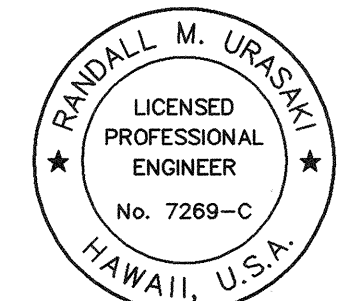

THIS WORK WAS PREPARED BY ME
OR UNDER MY SUPERVISION.
Randall M. Uraski

STATE OF HAWAII
DEPARTMENT OF TRANSPORTATION
HIGHWAYS DIVISION

DESTINATION SIGNS
LOCATION MAP
H-1 WEST

H-3 FINISH (UNIT II)
FAIP NO. I-H3-1(75), UNIT II
LEEWARD SECTION

SCALE: 1" = 200' DATE: JANUARY 1997

SHEET NO. 6G2 OF 6 SHEETS

ORIGINAL SURVEY PLOTTED BY: _____ DATE: _____
PLAN DRAWN BY: _____
NOTE BOOK DESIGNED BY: _____
CHECKED BY: _____
No. _____

CAD by J. MMURA, SS-52

NOTE:


-

FOR DESTINATION SIGNS,
SEE LOCATION MAP,
MOANALUA FREEWAY



Richard C. V. Dahilig


C.O. 847

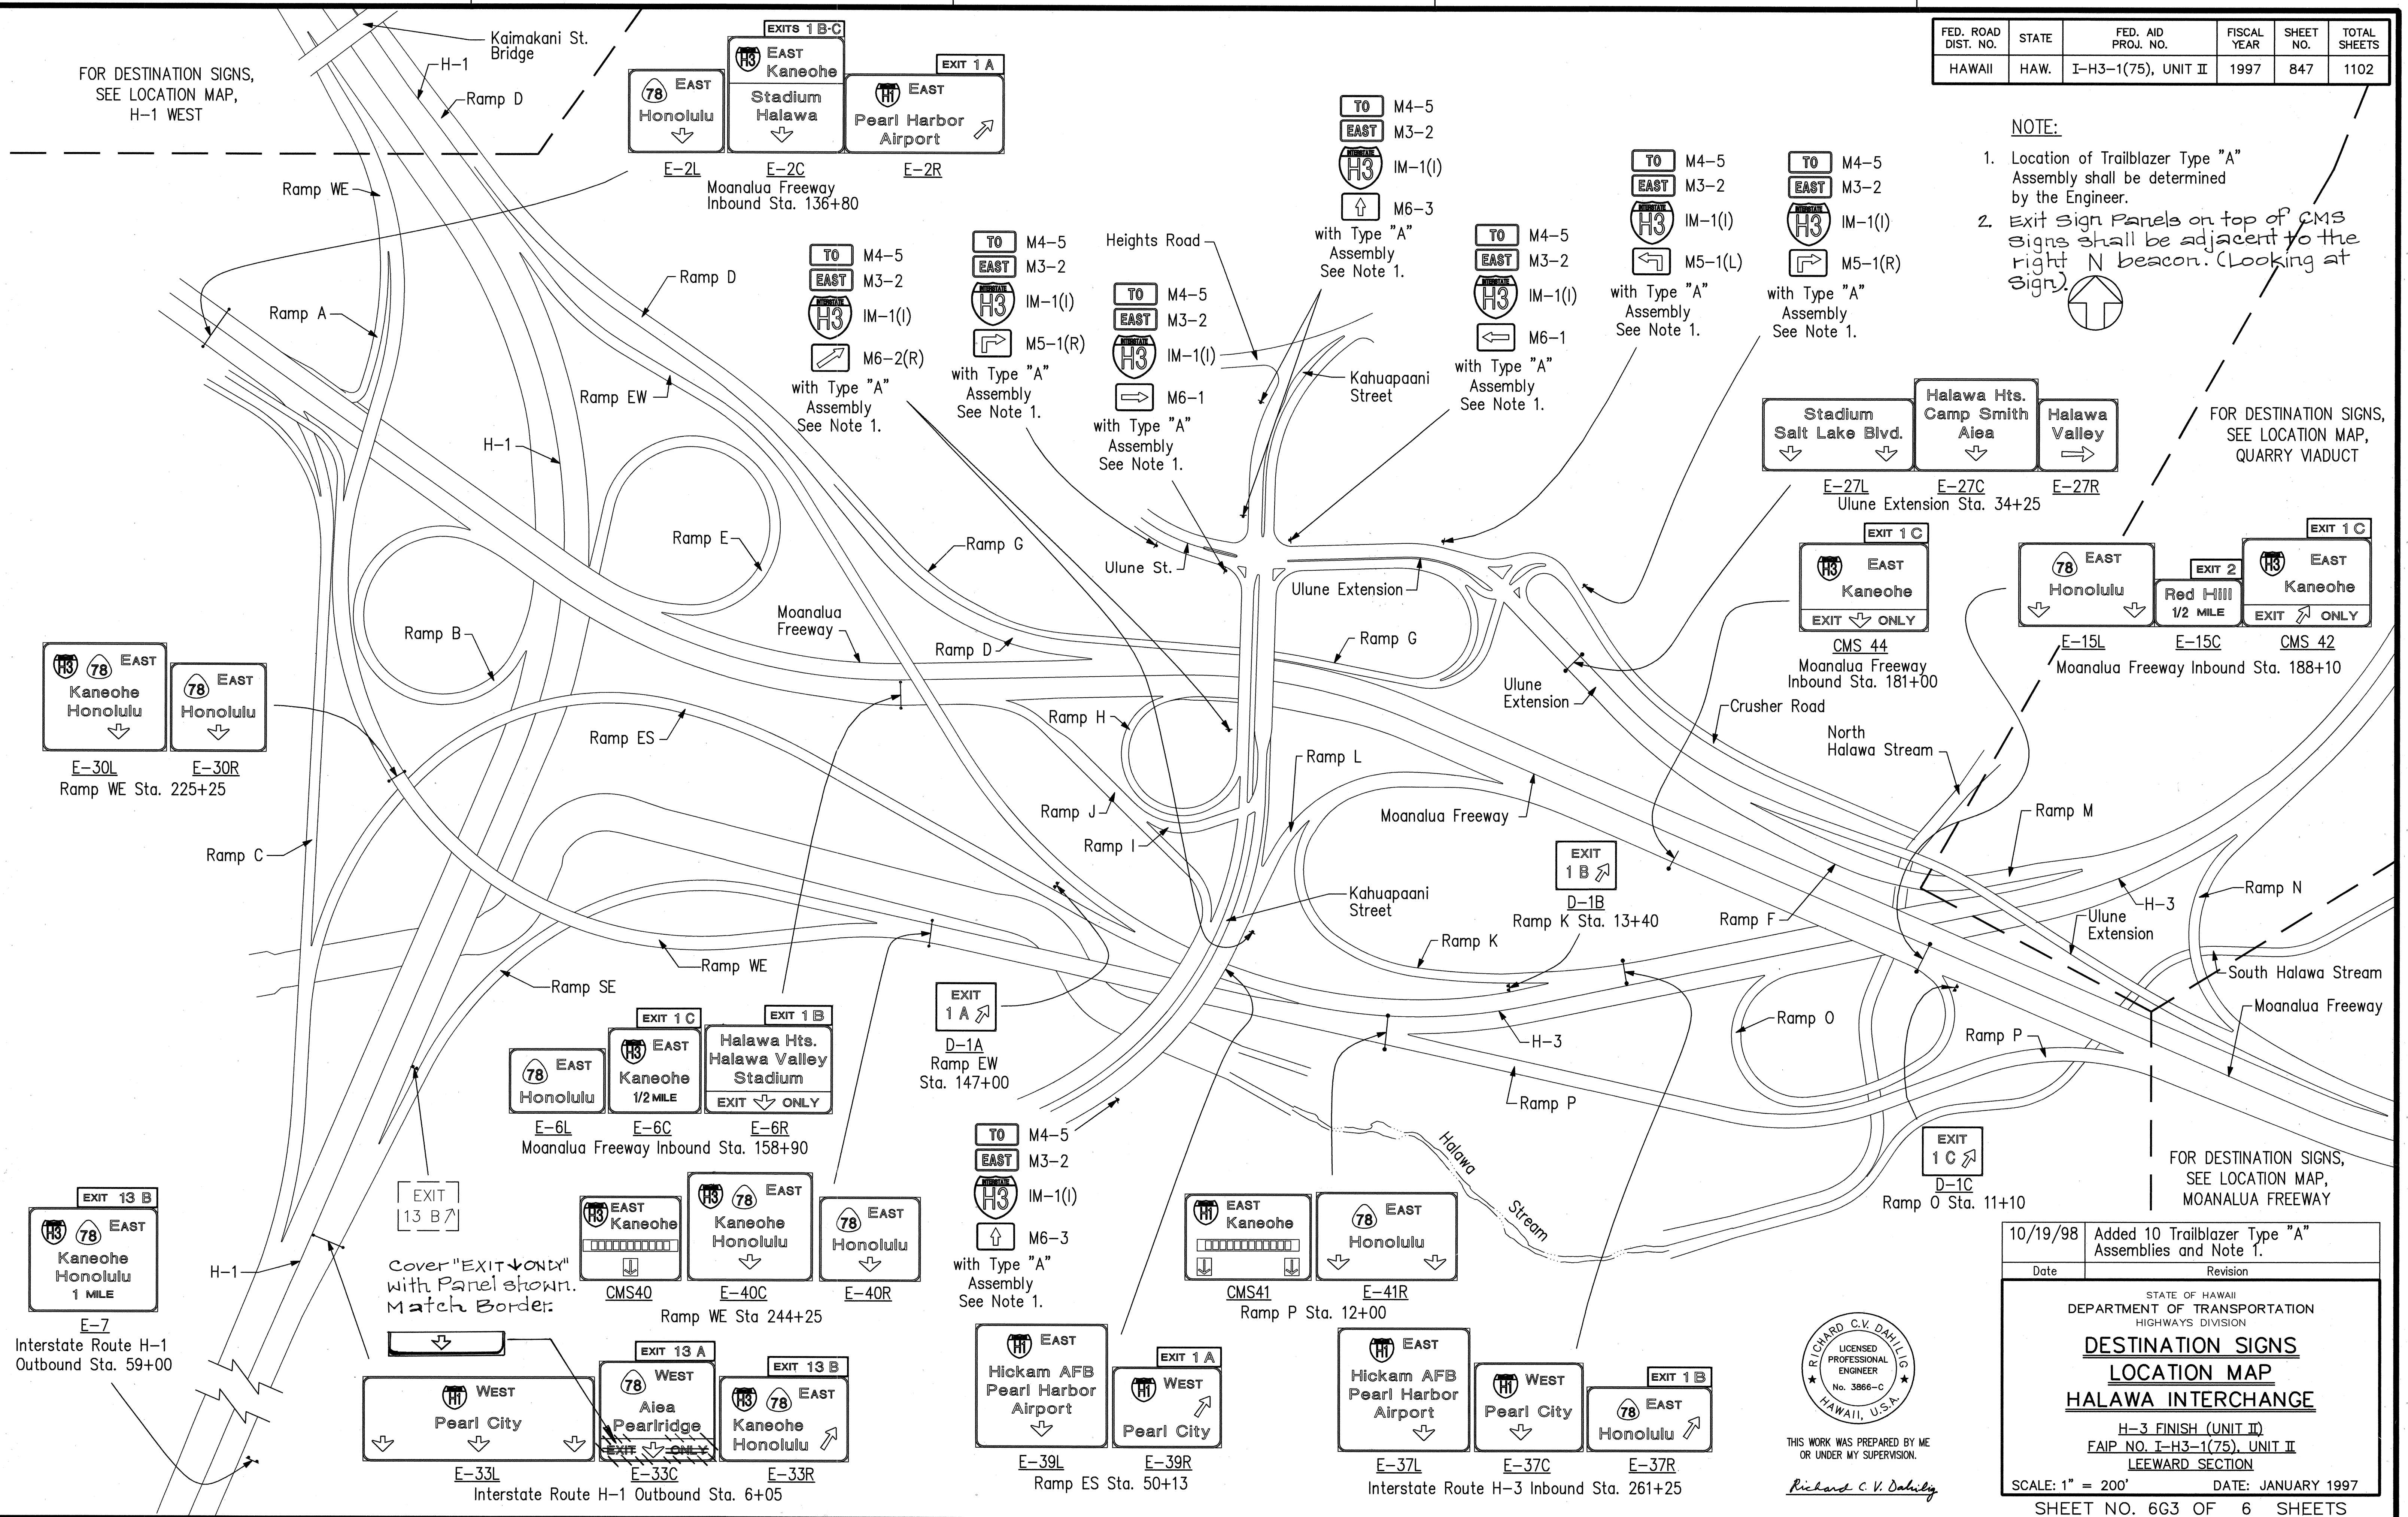

CAD by J. MIMURA, 55-52

Last Saved: J:\H3RF\RFU2\CO\SIGN\Co-h3hic.dwg.dwg 10/20/98 at 09:27

FED. ROAD DIST. NO.	STATE	FED. AID PROJ. NO.	FISCAL YEAR	SHEET NO.	TOTAL SHEETS
HAWAII	HAW.	I-H3-1(75), UNIT II	1997	C.O. 848	1102

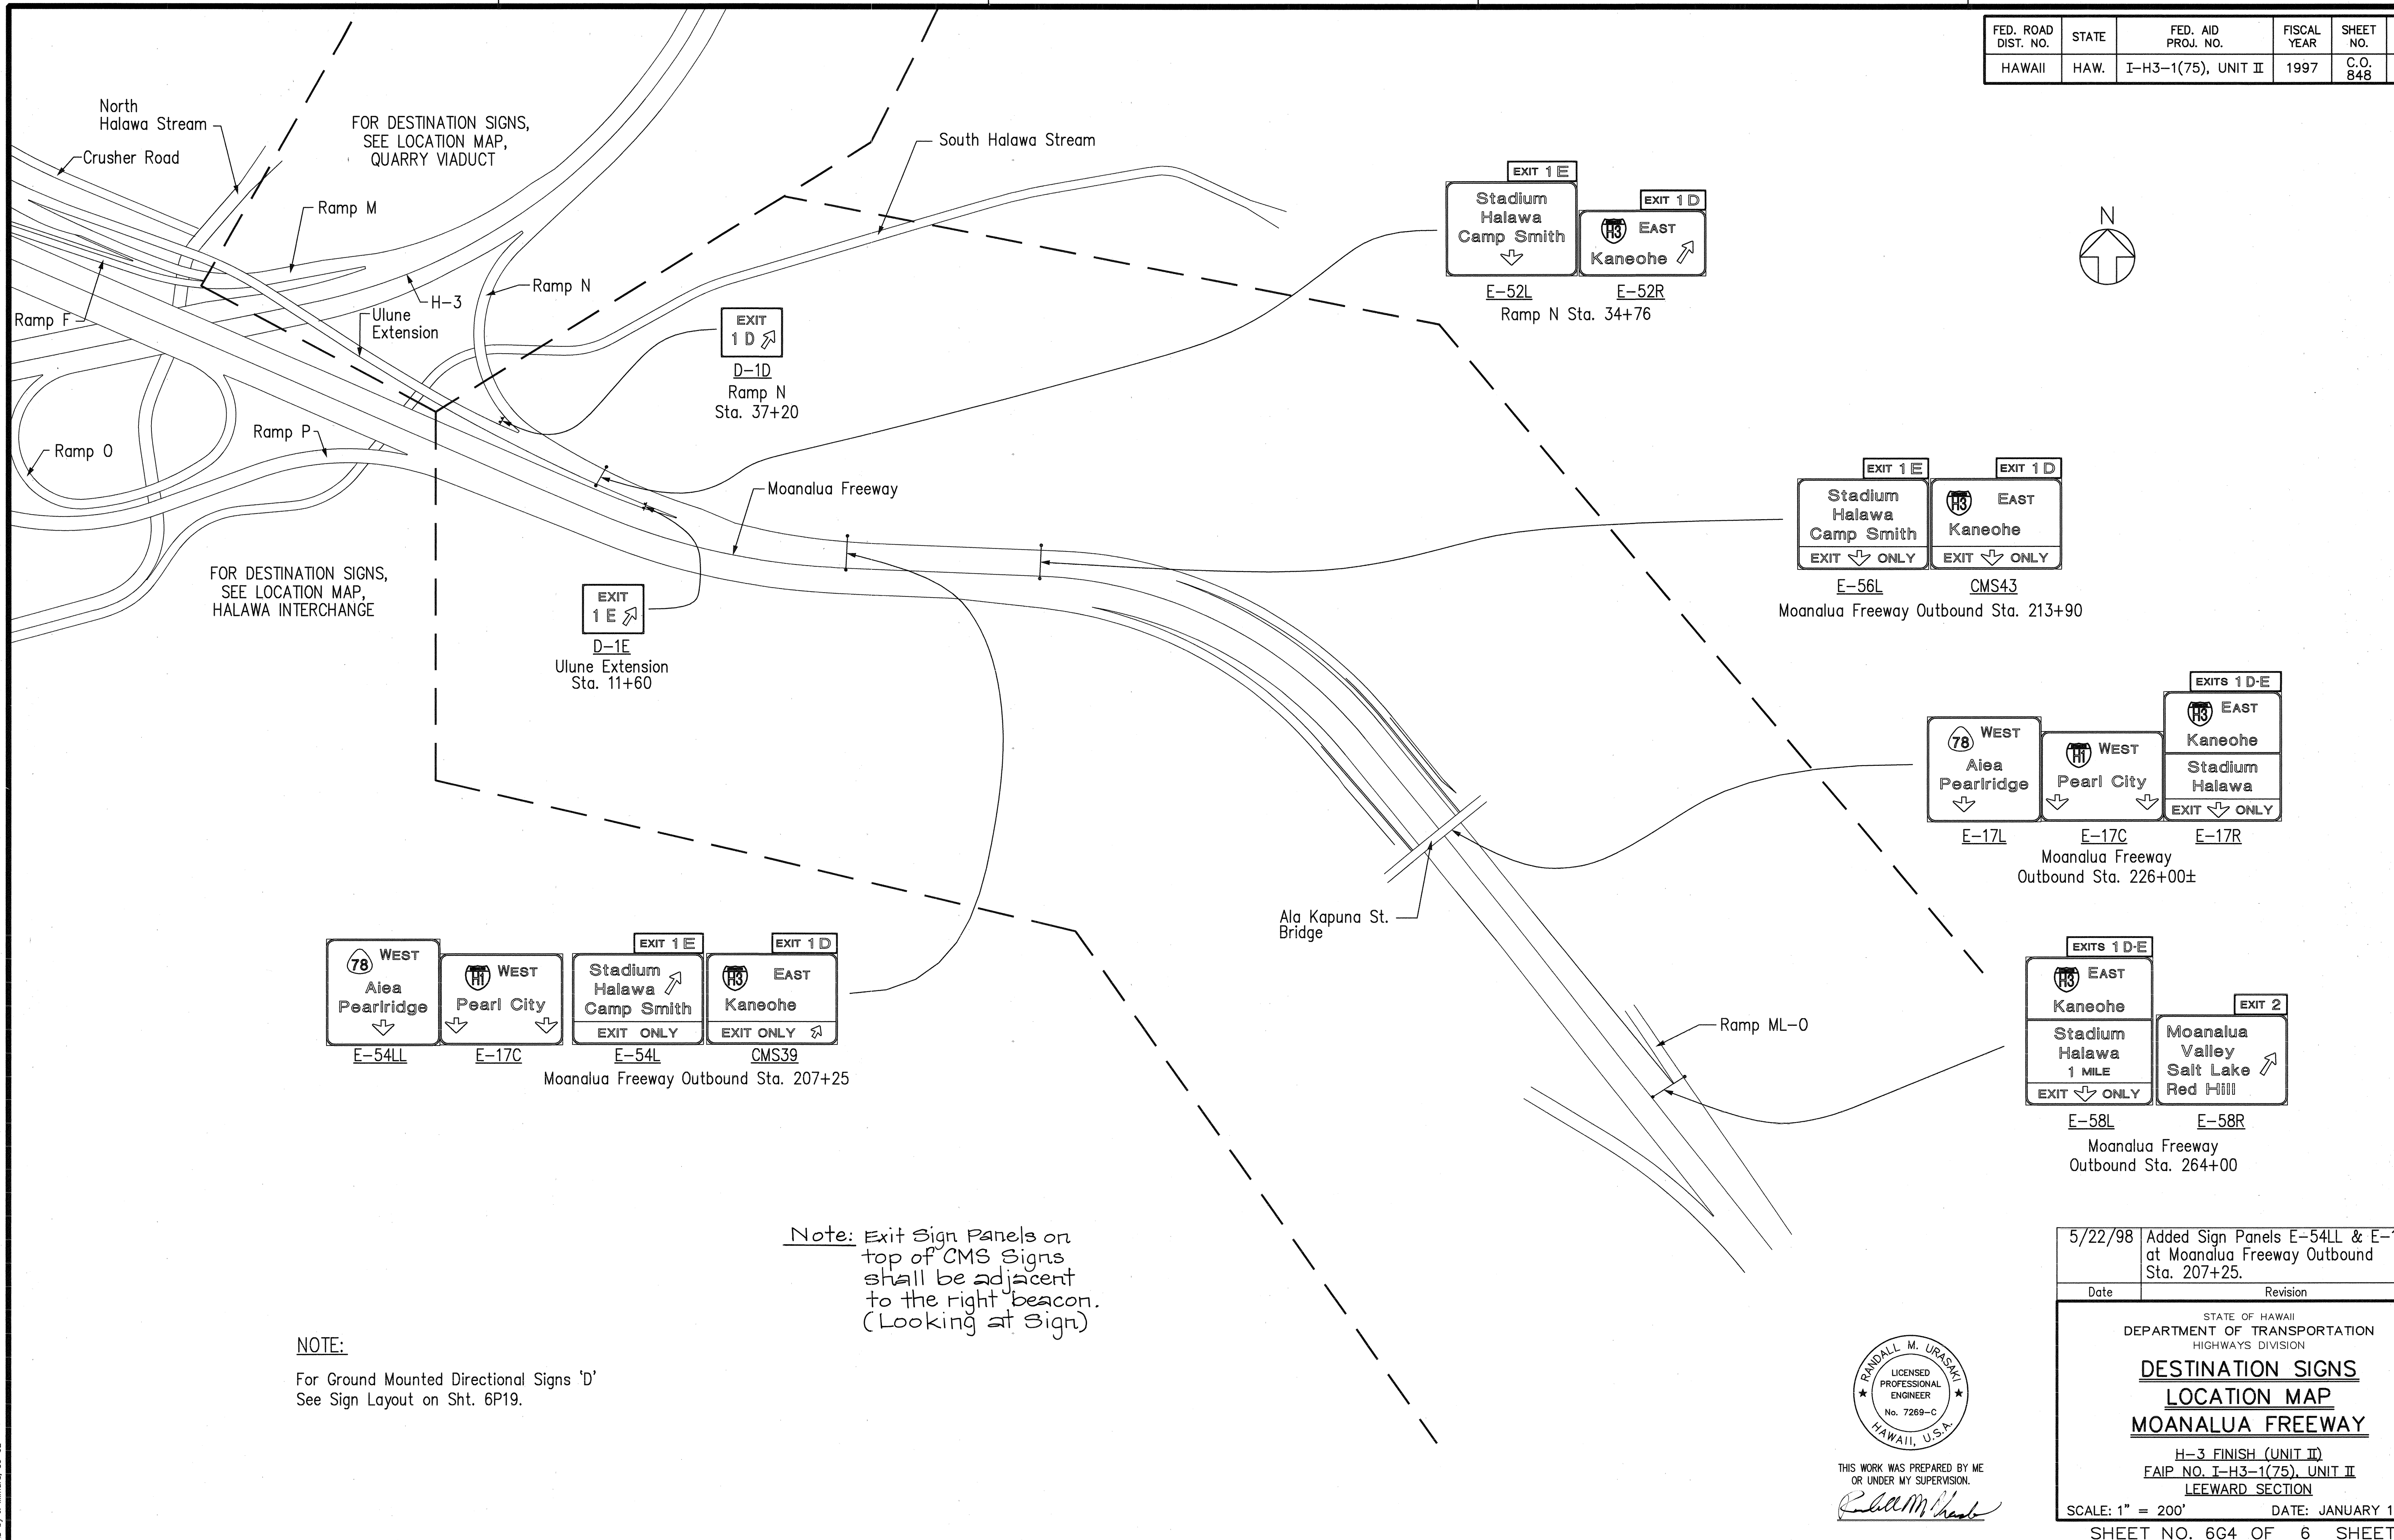

SURVEY PLOTTED BY	DATE
DRAWN BY	
TRACED BY	
DESIGNED BY	
CHECKED BY	
ORIGINAL PLAN	No.
NOTE BOOK	

CAD by J. Mura, 55-52

Last Saved: J:\H3RF\RFU2\CO\SIGN\Co-h3mf.dwg 05/29/98 at 13:48

THIS WORK WAS PREPARED BY ME
OR UNDER MY SUPERVISION.

Randall M. Urasaki

5/22/98

Added Sign Panels E-54LL & E-17C at Moanalua Freeway Outbound Sta. 207+25.

Date	Revision

STATE OF HAWAII

DEPARTMENT OF TRANSPORTATION

HIGHWAYS DIVISION

DESTINATION SIGNS

LOCATION MAP

MOANALUA FREEWAY

H-3 FINISH (UNIT II)

FAIP NO. I-H3-1(75), UNIT II


LEEWARD SECTION

SCALE: 1" = 200'

DATE: JANUARY 1997

SHEET NO. 664 OF 6 SHEETS


FED. ROAD DIST. NO.	STATE	FED. AID PROJ. NO.	FISCAL YEAR	SHEET NO.	TOTAL SHEETS
HAWAII	HAW.	I-H3-1(75), UNIT II	1997	850	1102

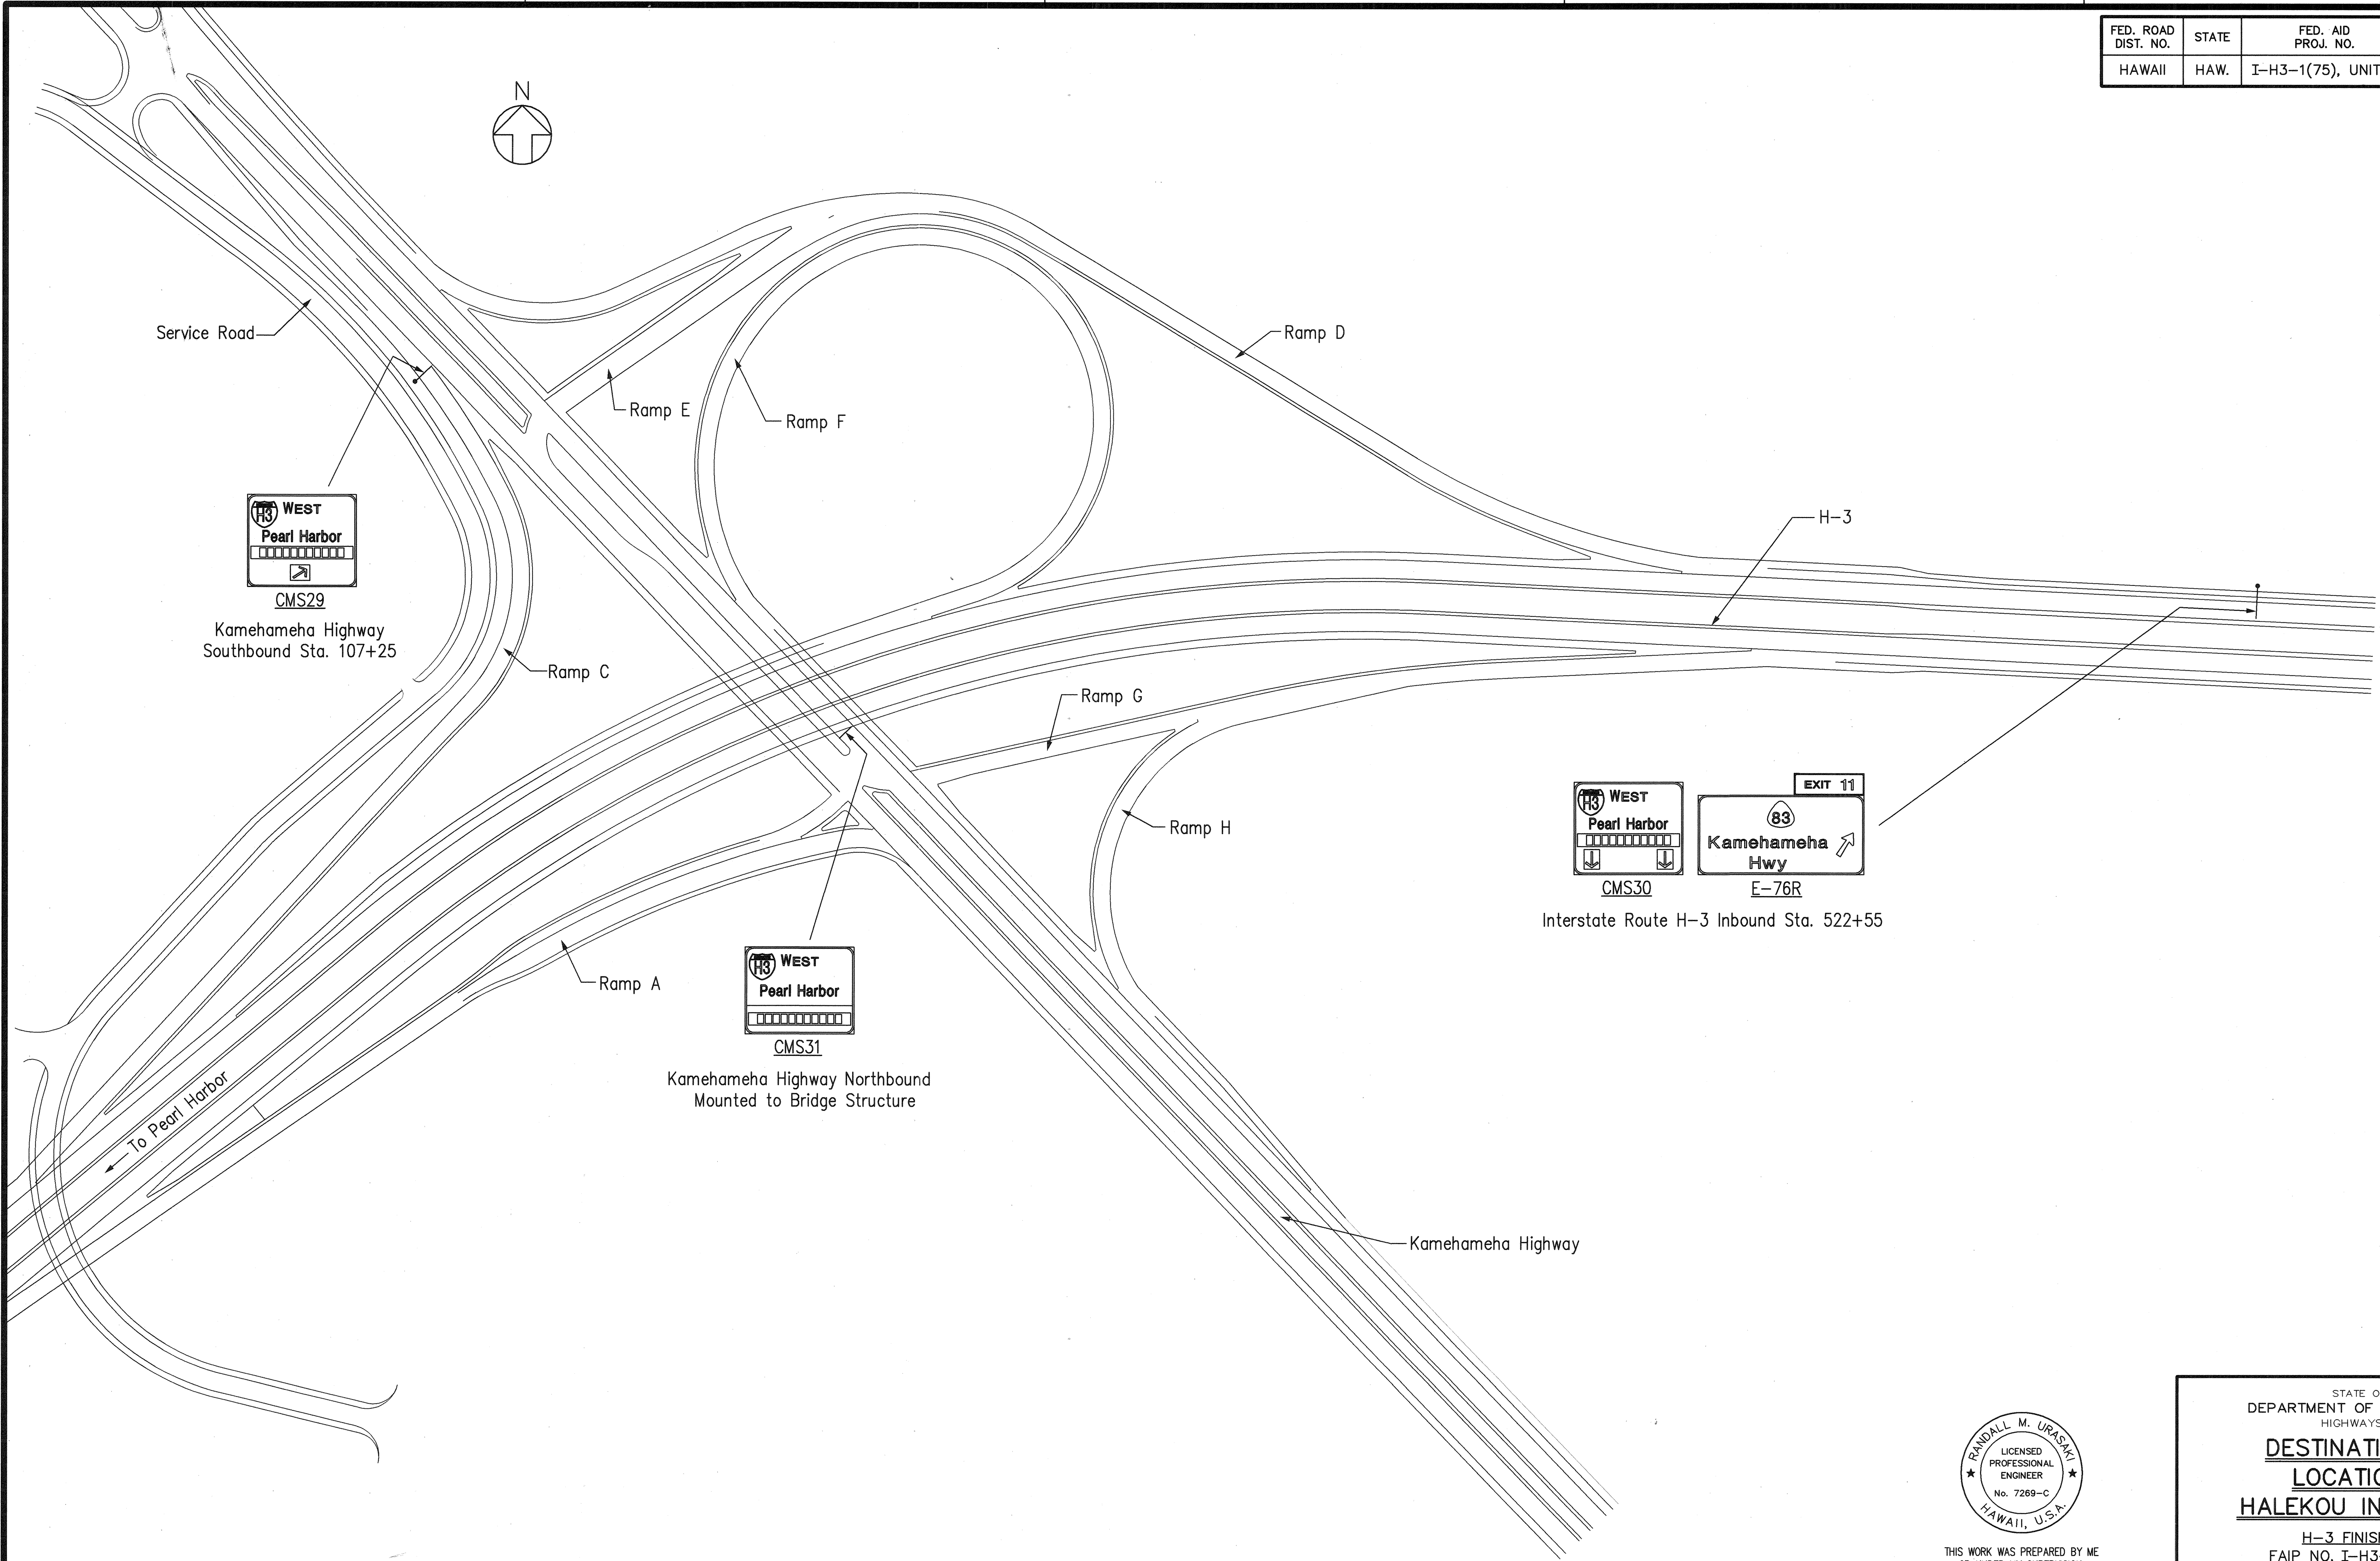

ORIGINAL SURVEY PLOTTED BY	DATE
PLAN	
NOTE BOOK	
DESIGNED BY	
CHECKED BY	
No.	

CAD by J. MMURA 55-52

Last Saved: J:\H3RF\RFU2\SIGN\HALEKOU.dwg 02/24/97 at 07:12

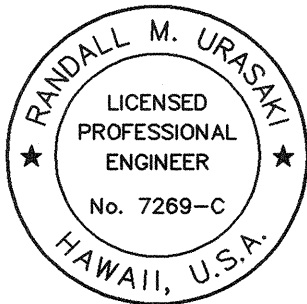

THIS WORK WAS PREPARED BY ME
OR UNDER MY SUPERVISION.
R. M. Urasaki

STATE OF HAWAII
DEPARTMENT OF TRANSPORTATION
HIGHWAYS DIVISION


DESTINATION SIGNS
LOCATION MAP
HALEKOU INTERCHANGE

H-3 FINISH (UNIT II)
FAIP NO. I-H3-1(75), UNIT II
LEEWARD SECTION


SCALE: 1" = 100'
DATE: JANUARY 1997

SHEET NO. 606 OF 6 SHEETS


FED. ROAD DIST. NO.	STATE	FED. AID PROJ. NO.	FISCAL YEAR	SHEET NO.	TOTAL SHEETS
HAWAII	HAW.	I-H3-1(75), UNIT II	1997	851	1102

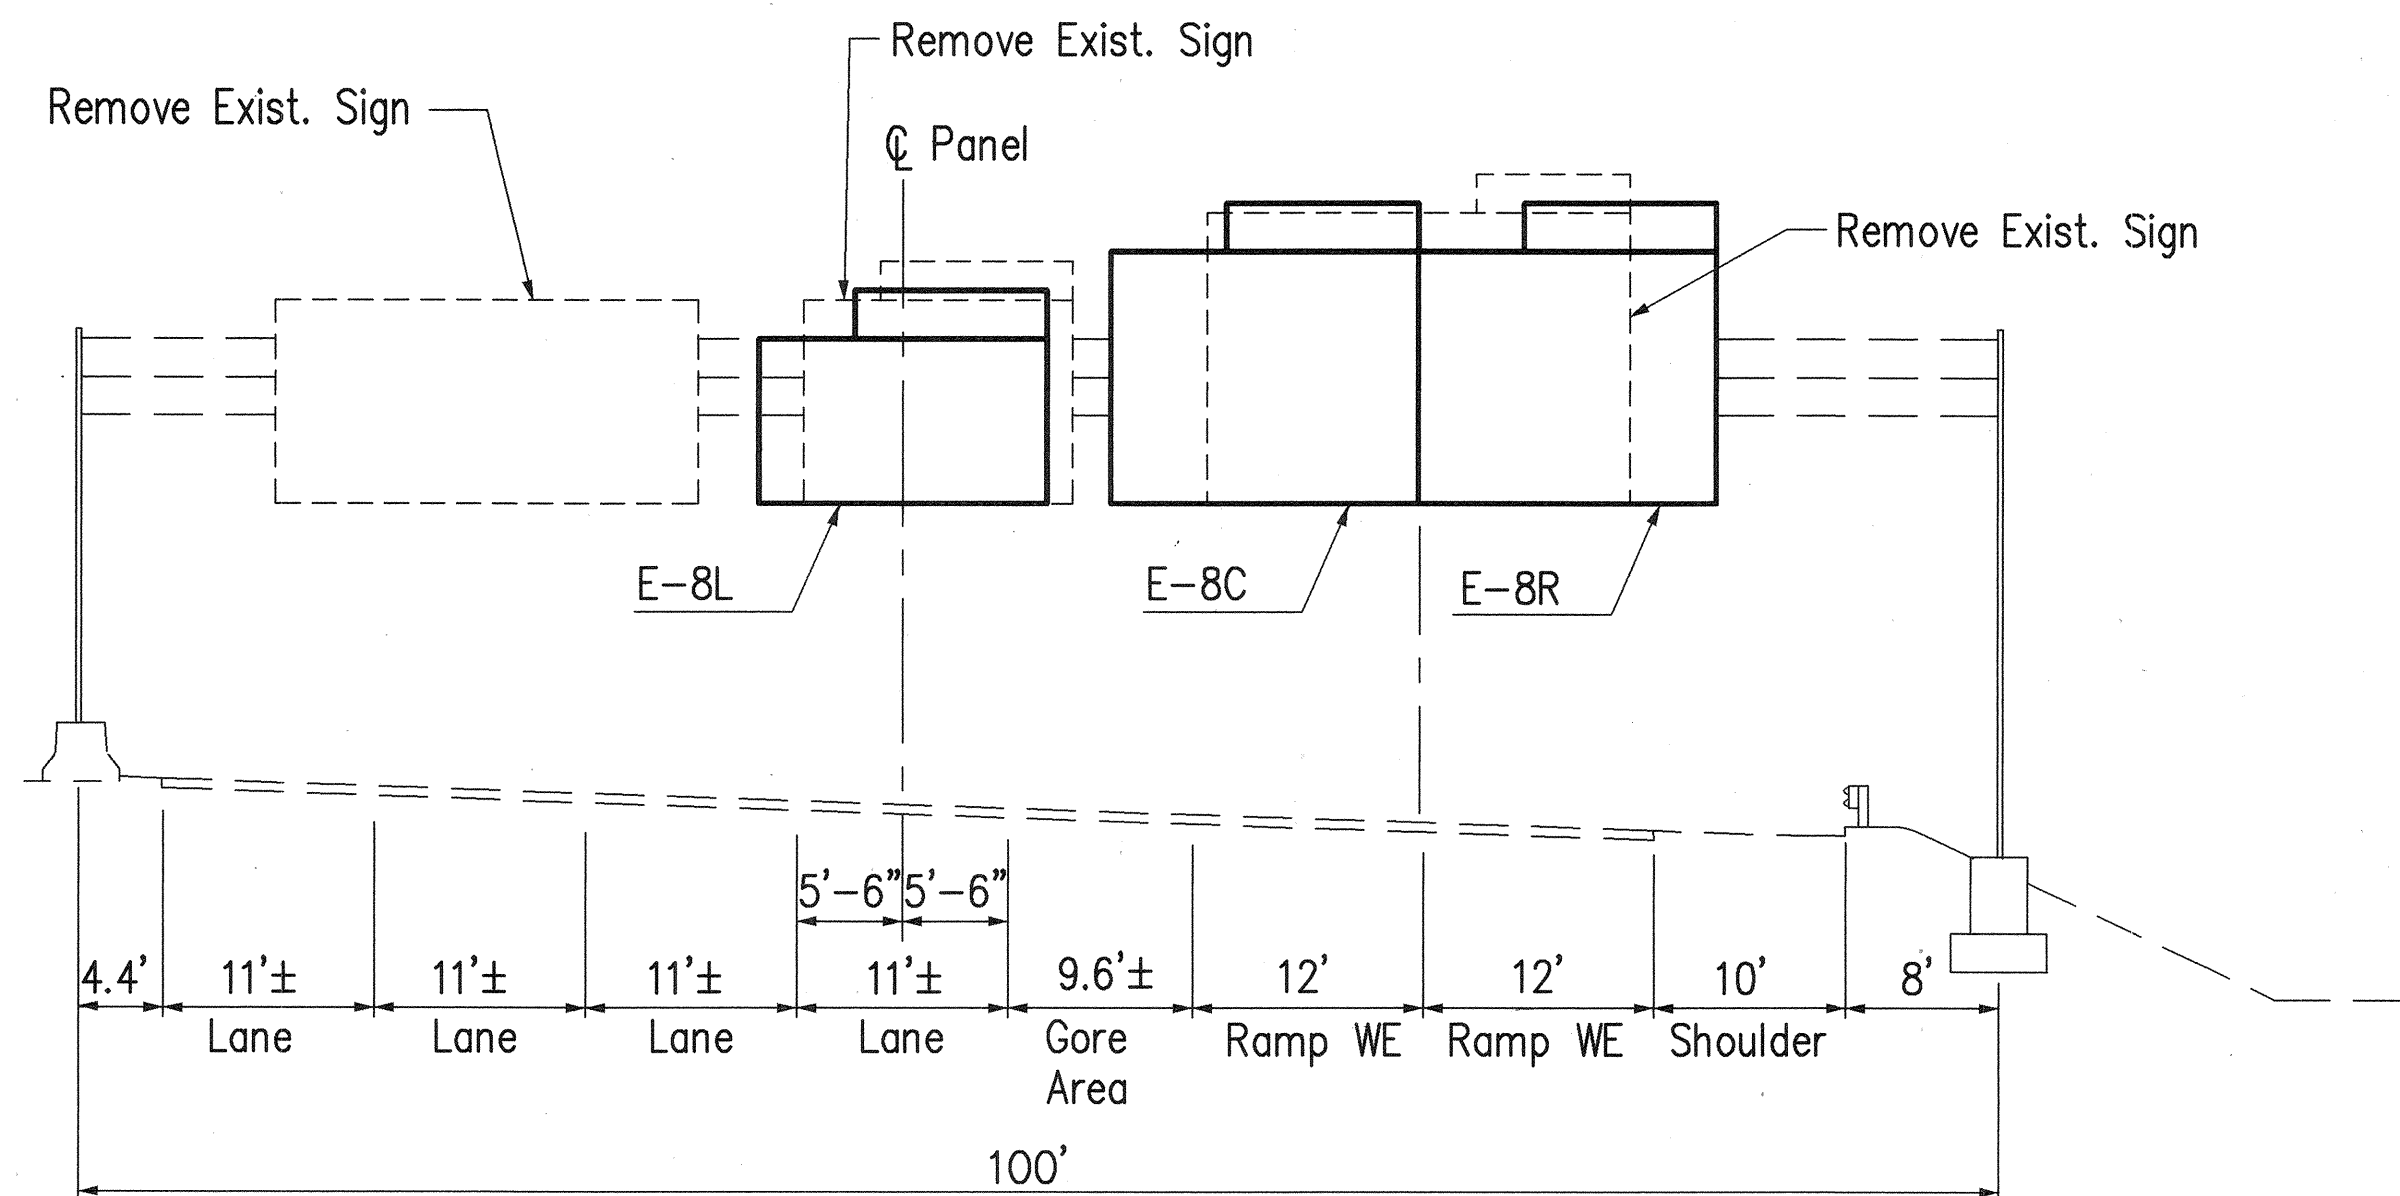


SIGN LAYOUT E-8L, E-8C & E-8R
Interstate Route H-1 Inbound Sta. 200+65

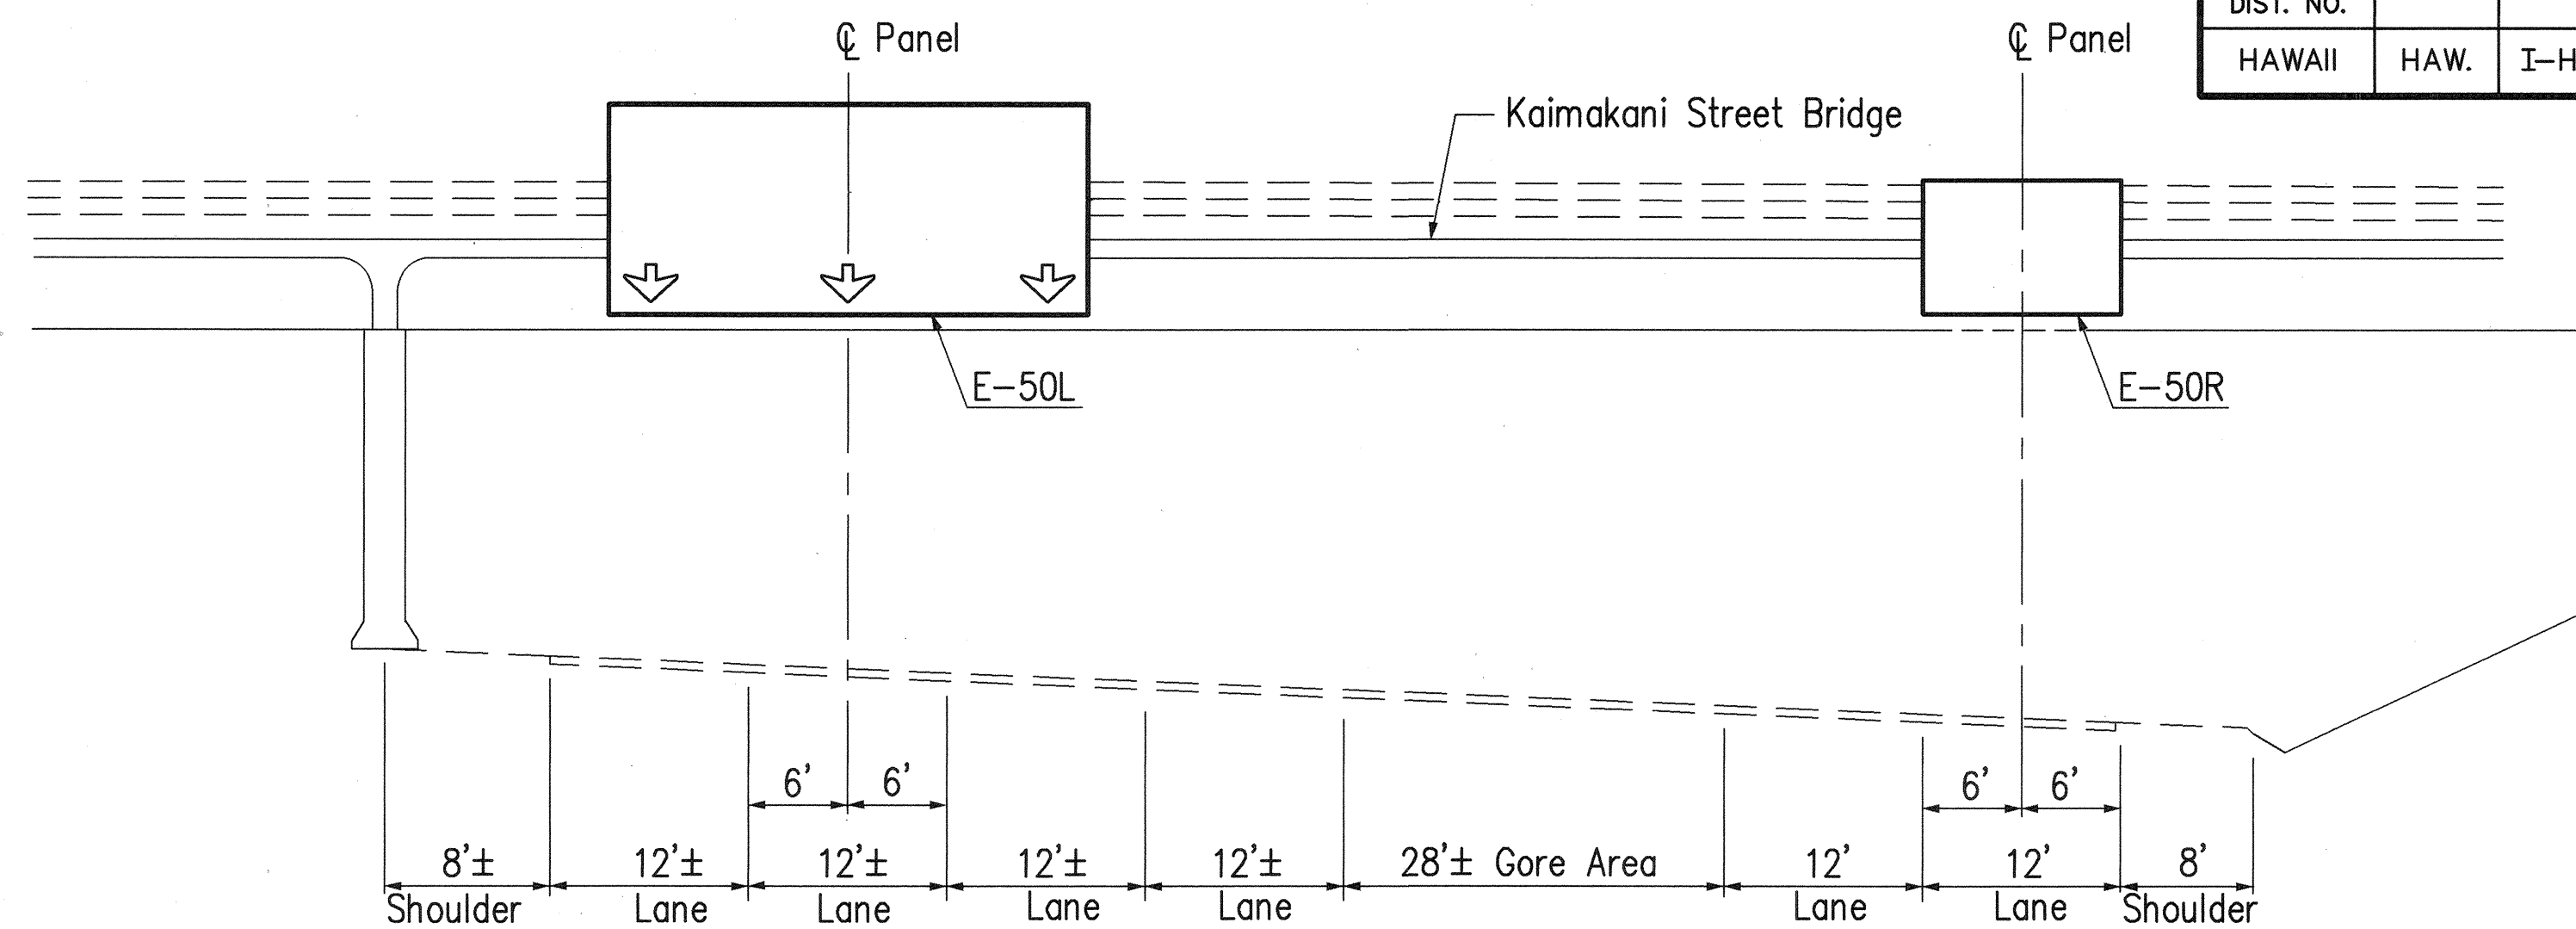


SIGN LAYOUT E-50L & E-50R
Interstate Route H-1 Inbound Sta. 204+10±

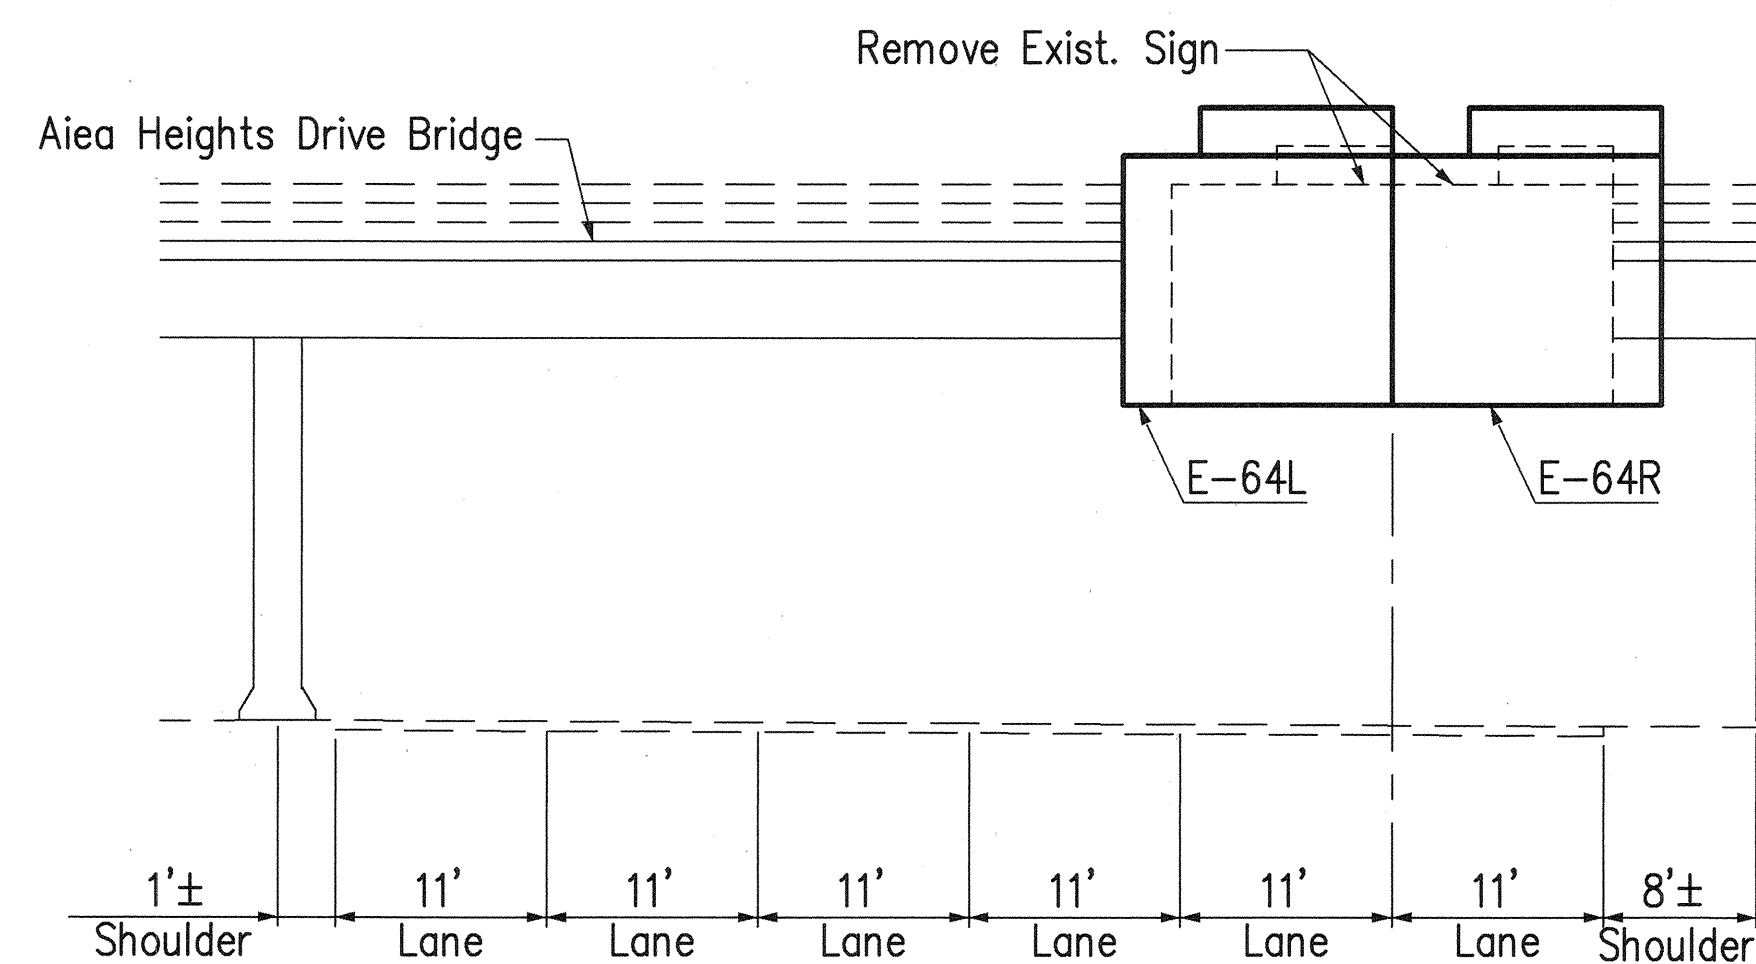


SIGN LAYOUT E-64L & E-64R
Interstate Route H-1 Inbound Sta. 191+88±

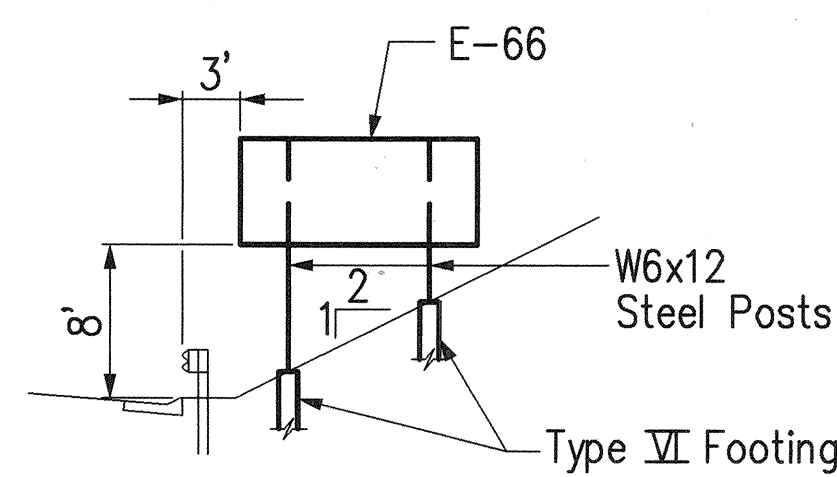


SIGN LAYOUT E-66
Interstate Route H-1 Inbound Sta. 174+00

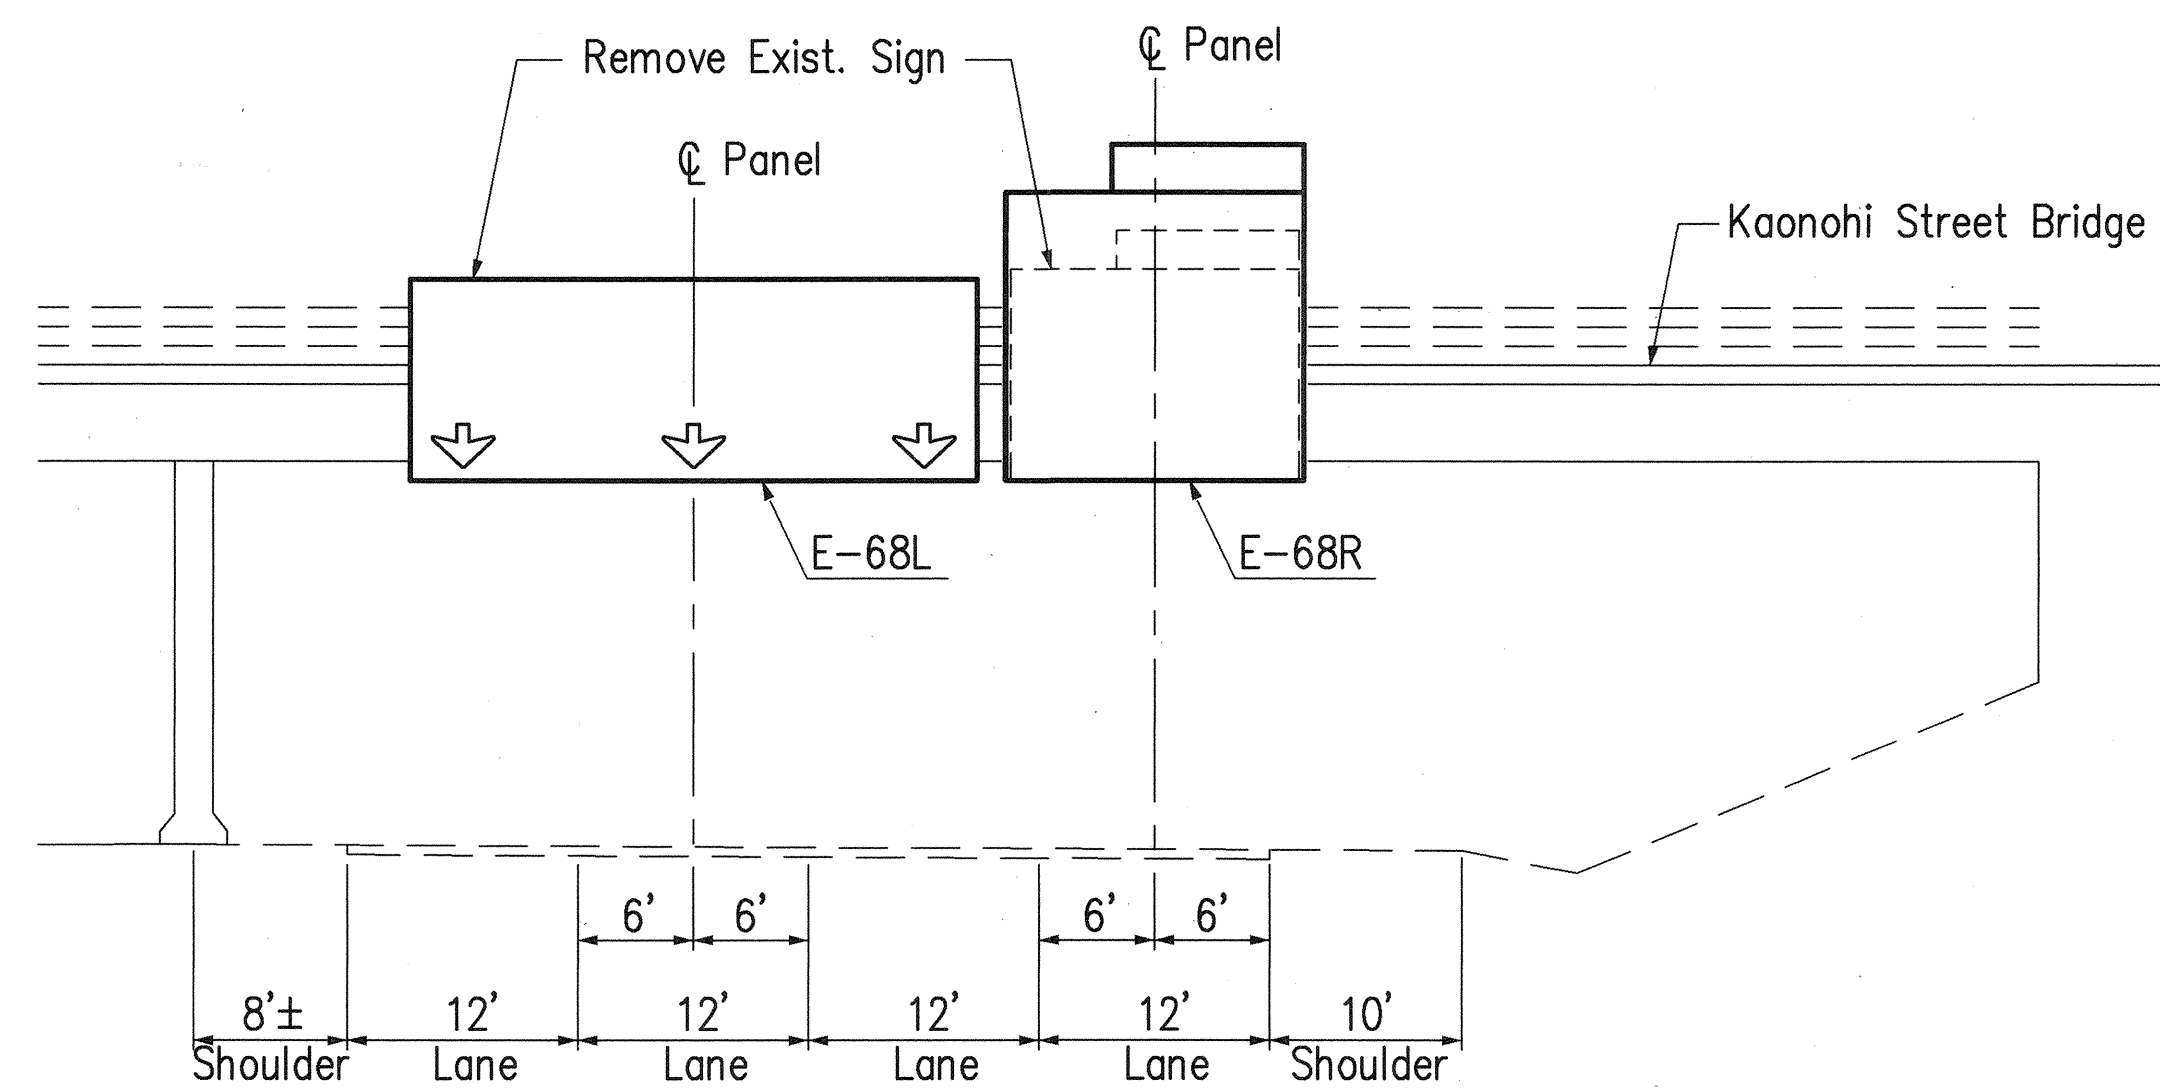


SIGN LAYOUT E-68L & E-68R
Interstate Route H-1 Inbound Sta. 138+75±

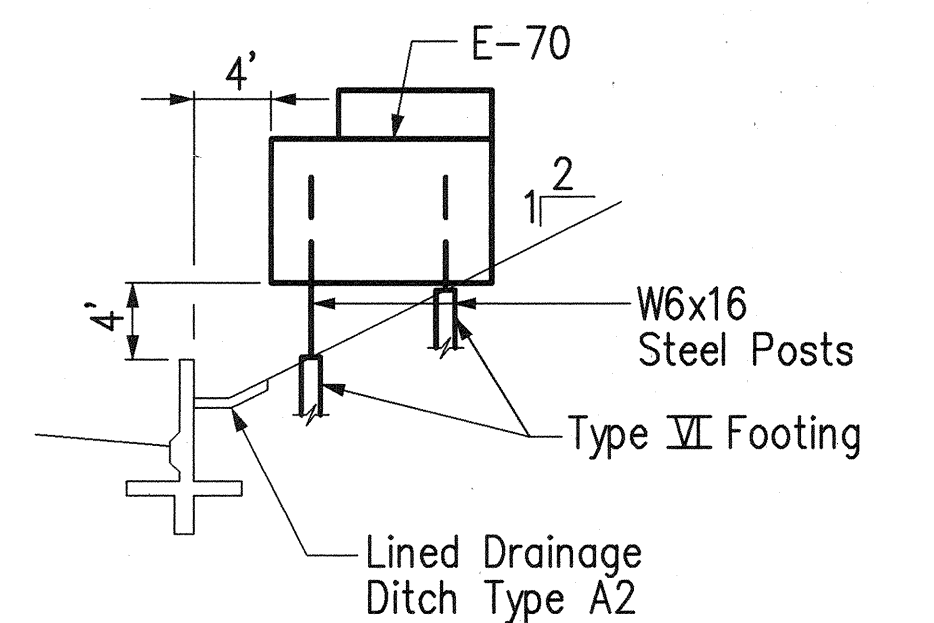

SIGN LAYOUT E-70
Interstate Route H-1 Outbound Sta. 152+80

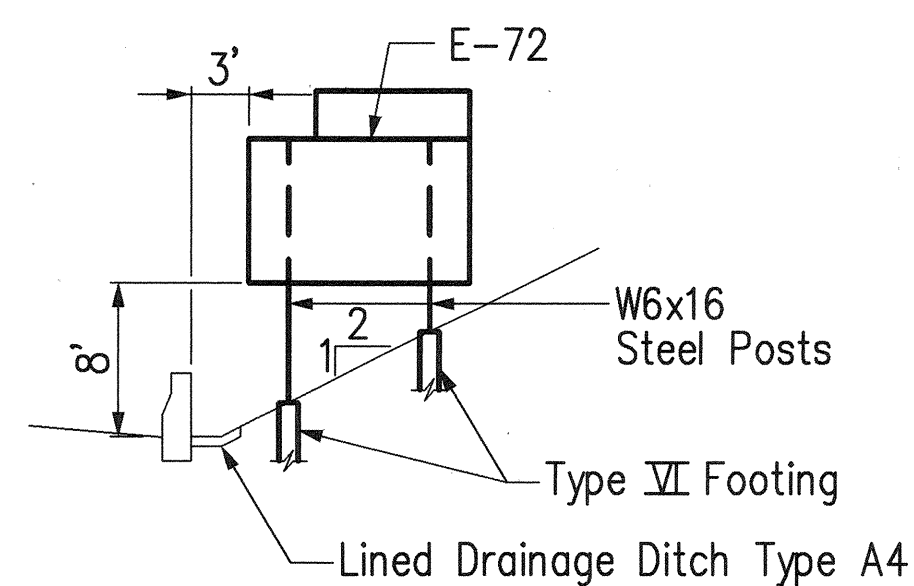


SIGN LAYOUT E-72
Interstate Route H-1 Outbound Sta. 129+63±

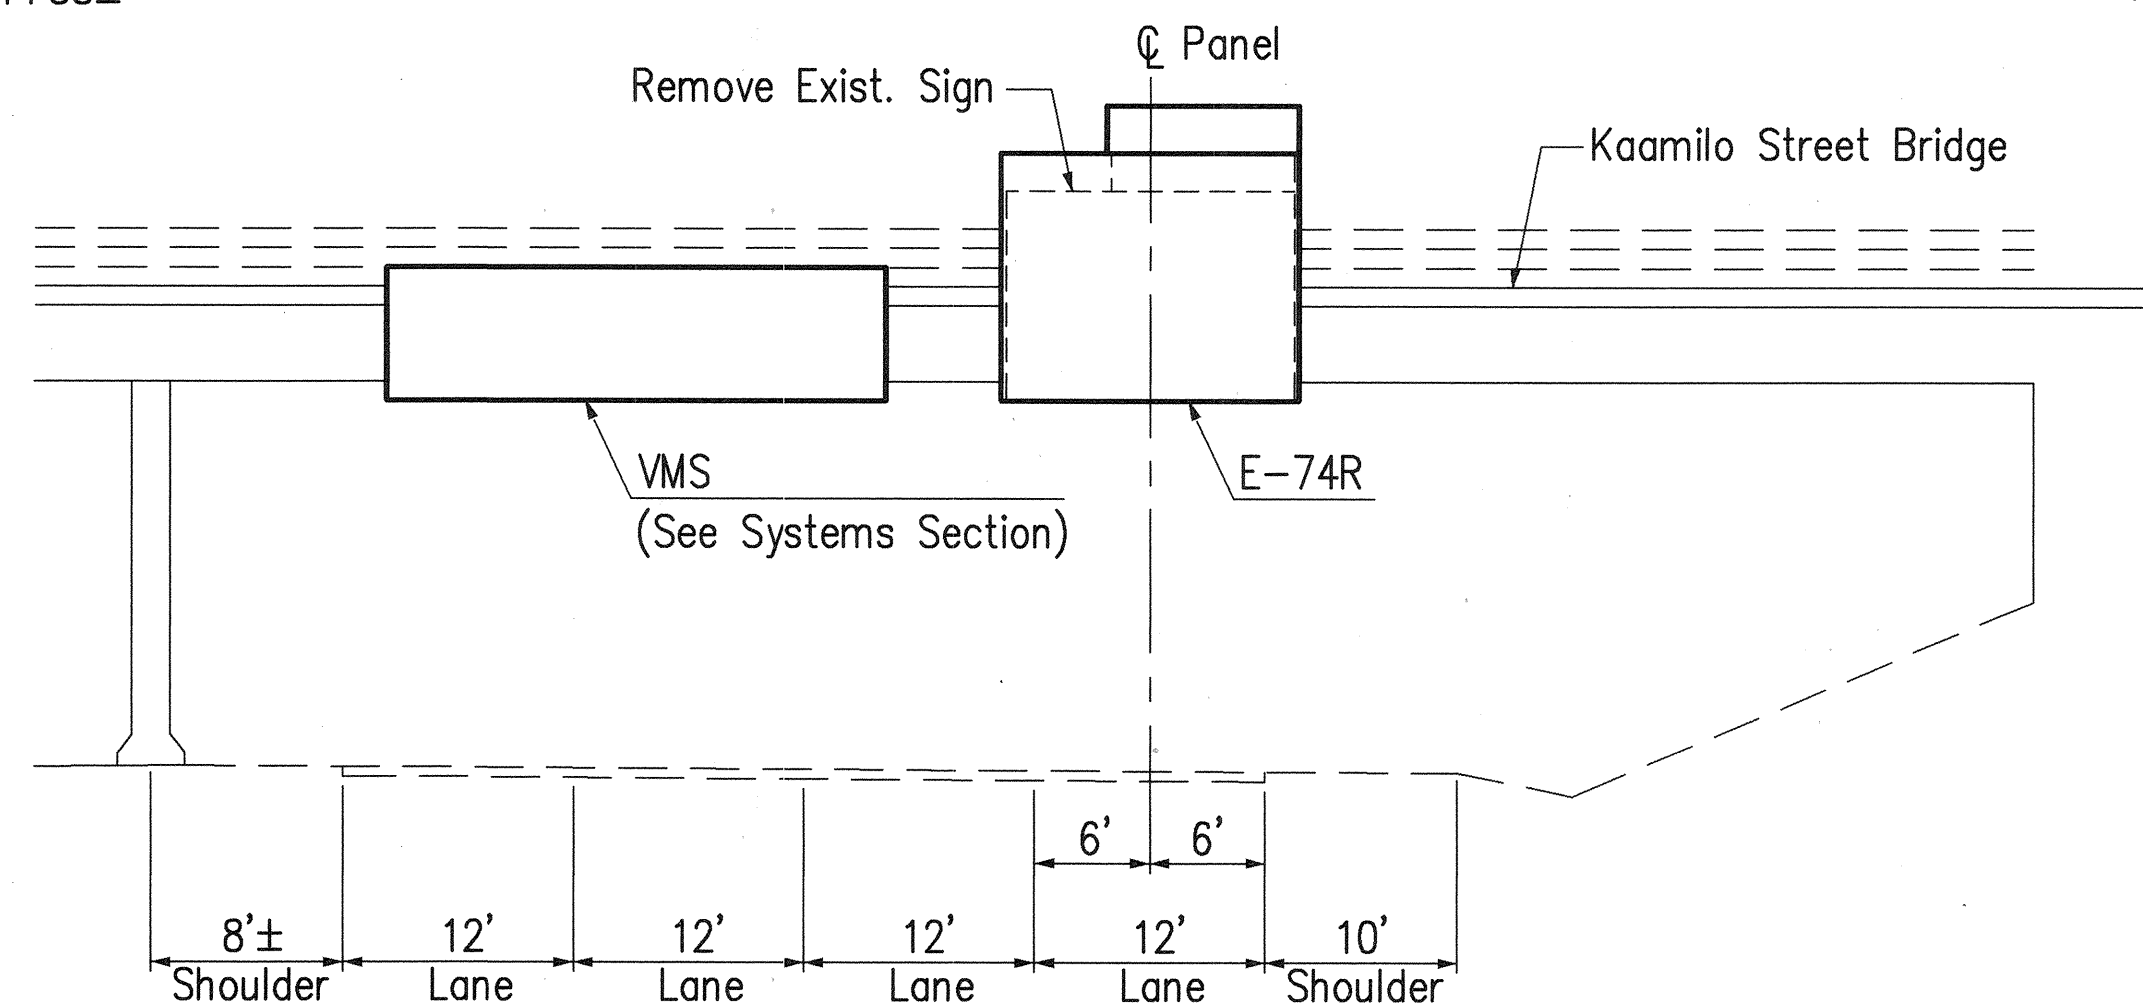

SIGN LAYOUT E-74R
Interstate Route H-1 Inbound Sta. 172+38±

Notes For Ground Mounted 'E' signs:

- For Dimensions Not Shown, See Standard Plans TE-23, TE-26, & TE-27.
- For Type VI Footing, See Standard Plan TE-23.

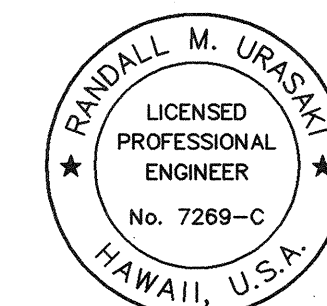

THIS WORK WAS PREPARED BY ME
OR UNDER MY SUPERVISION






[Signature]

STATE OF HAWAII
DEPARTMENT OF TRANSPORTATION
HIGHWAYS DIVISION

DESTINATION SIGNS
SIGN LAYOUTS
H-1 WEST
H-3 FINISH (UNIT II)
FAIP NO. I-H3-1(75), UNIT II
LEEWARD SECTION

SCALE: 1" = 10' DATE: JANUARY 1997
SHEET NO. 6P1 OF 20 SHEETS

FED. ROAD DIST. NO.	STATE	FED. AID PROJ. NO.	FISCAL YEAR	SHEET NO.	TOTAL SHEETS
HAWAII	HAW.	I-H3-1(75), UNIT II	1997	852	1102

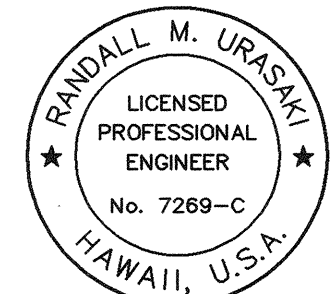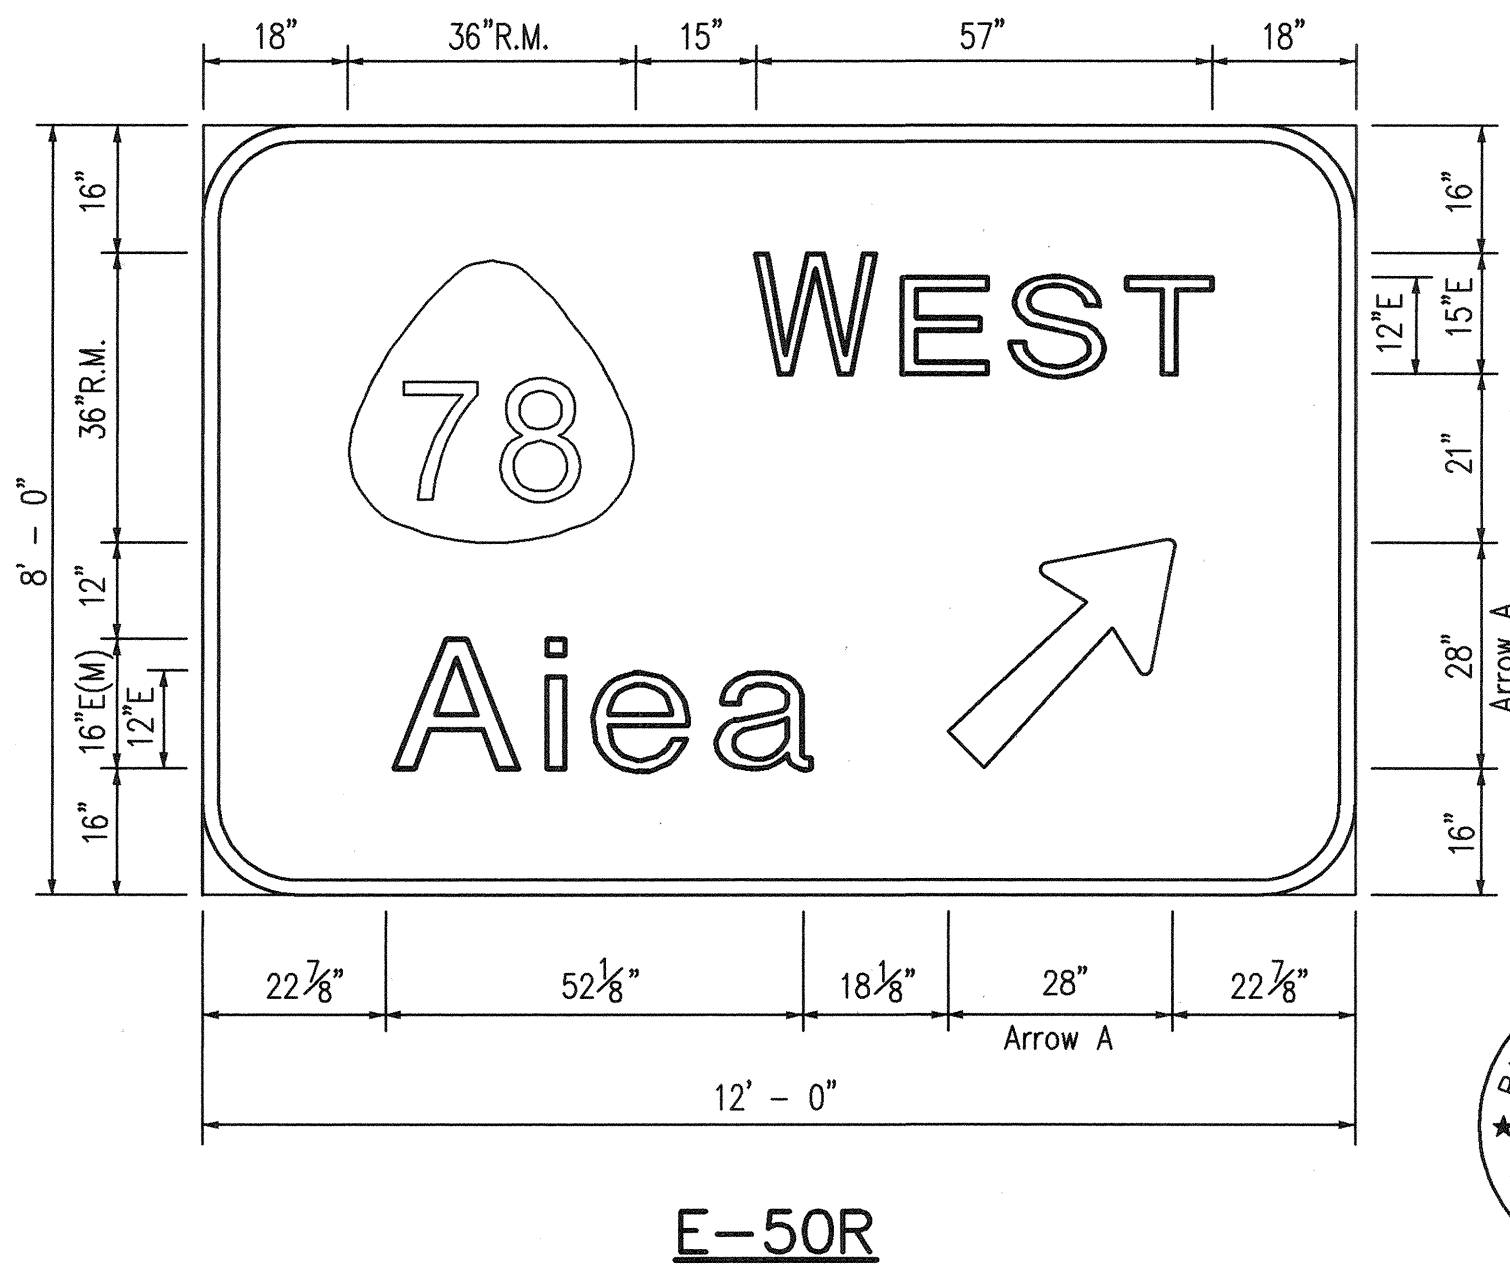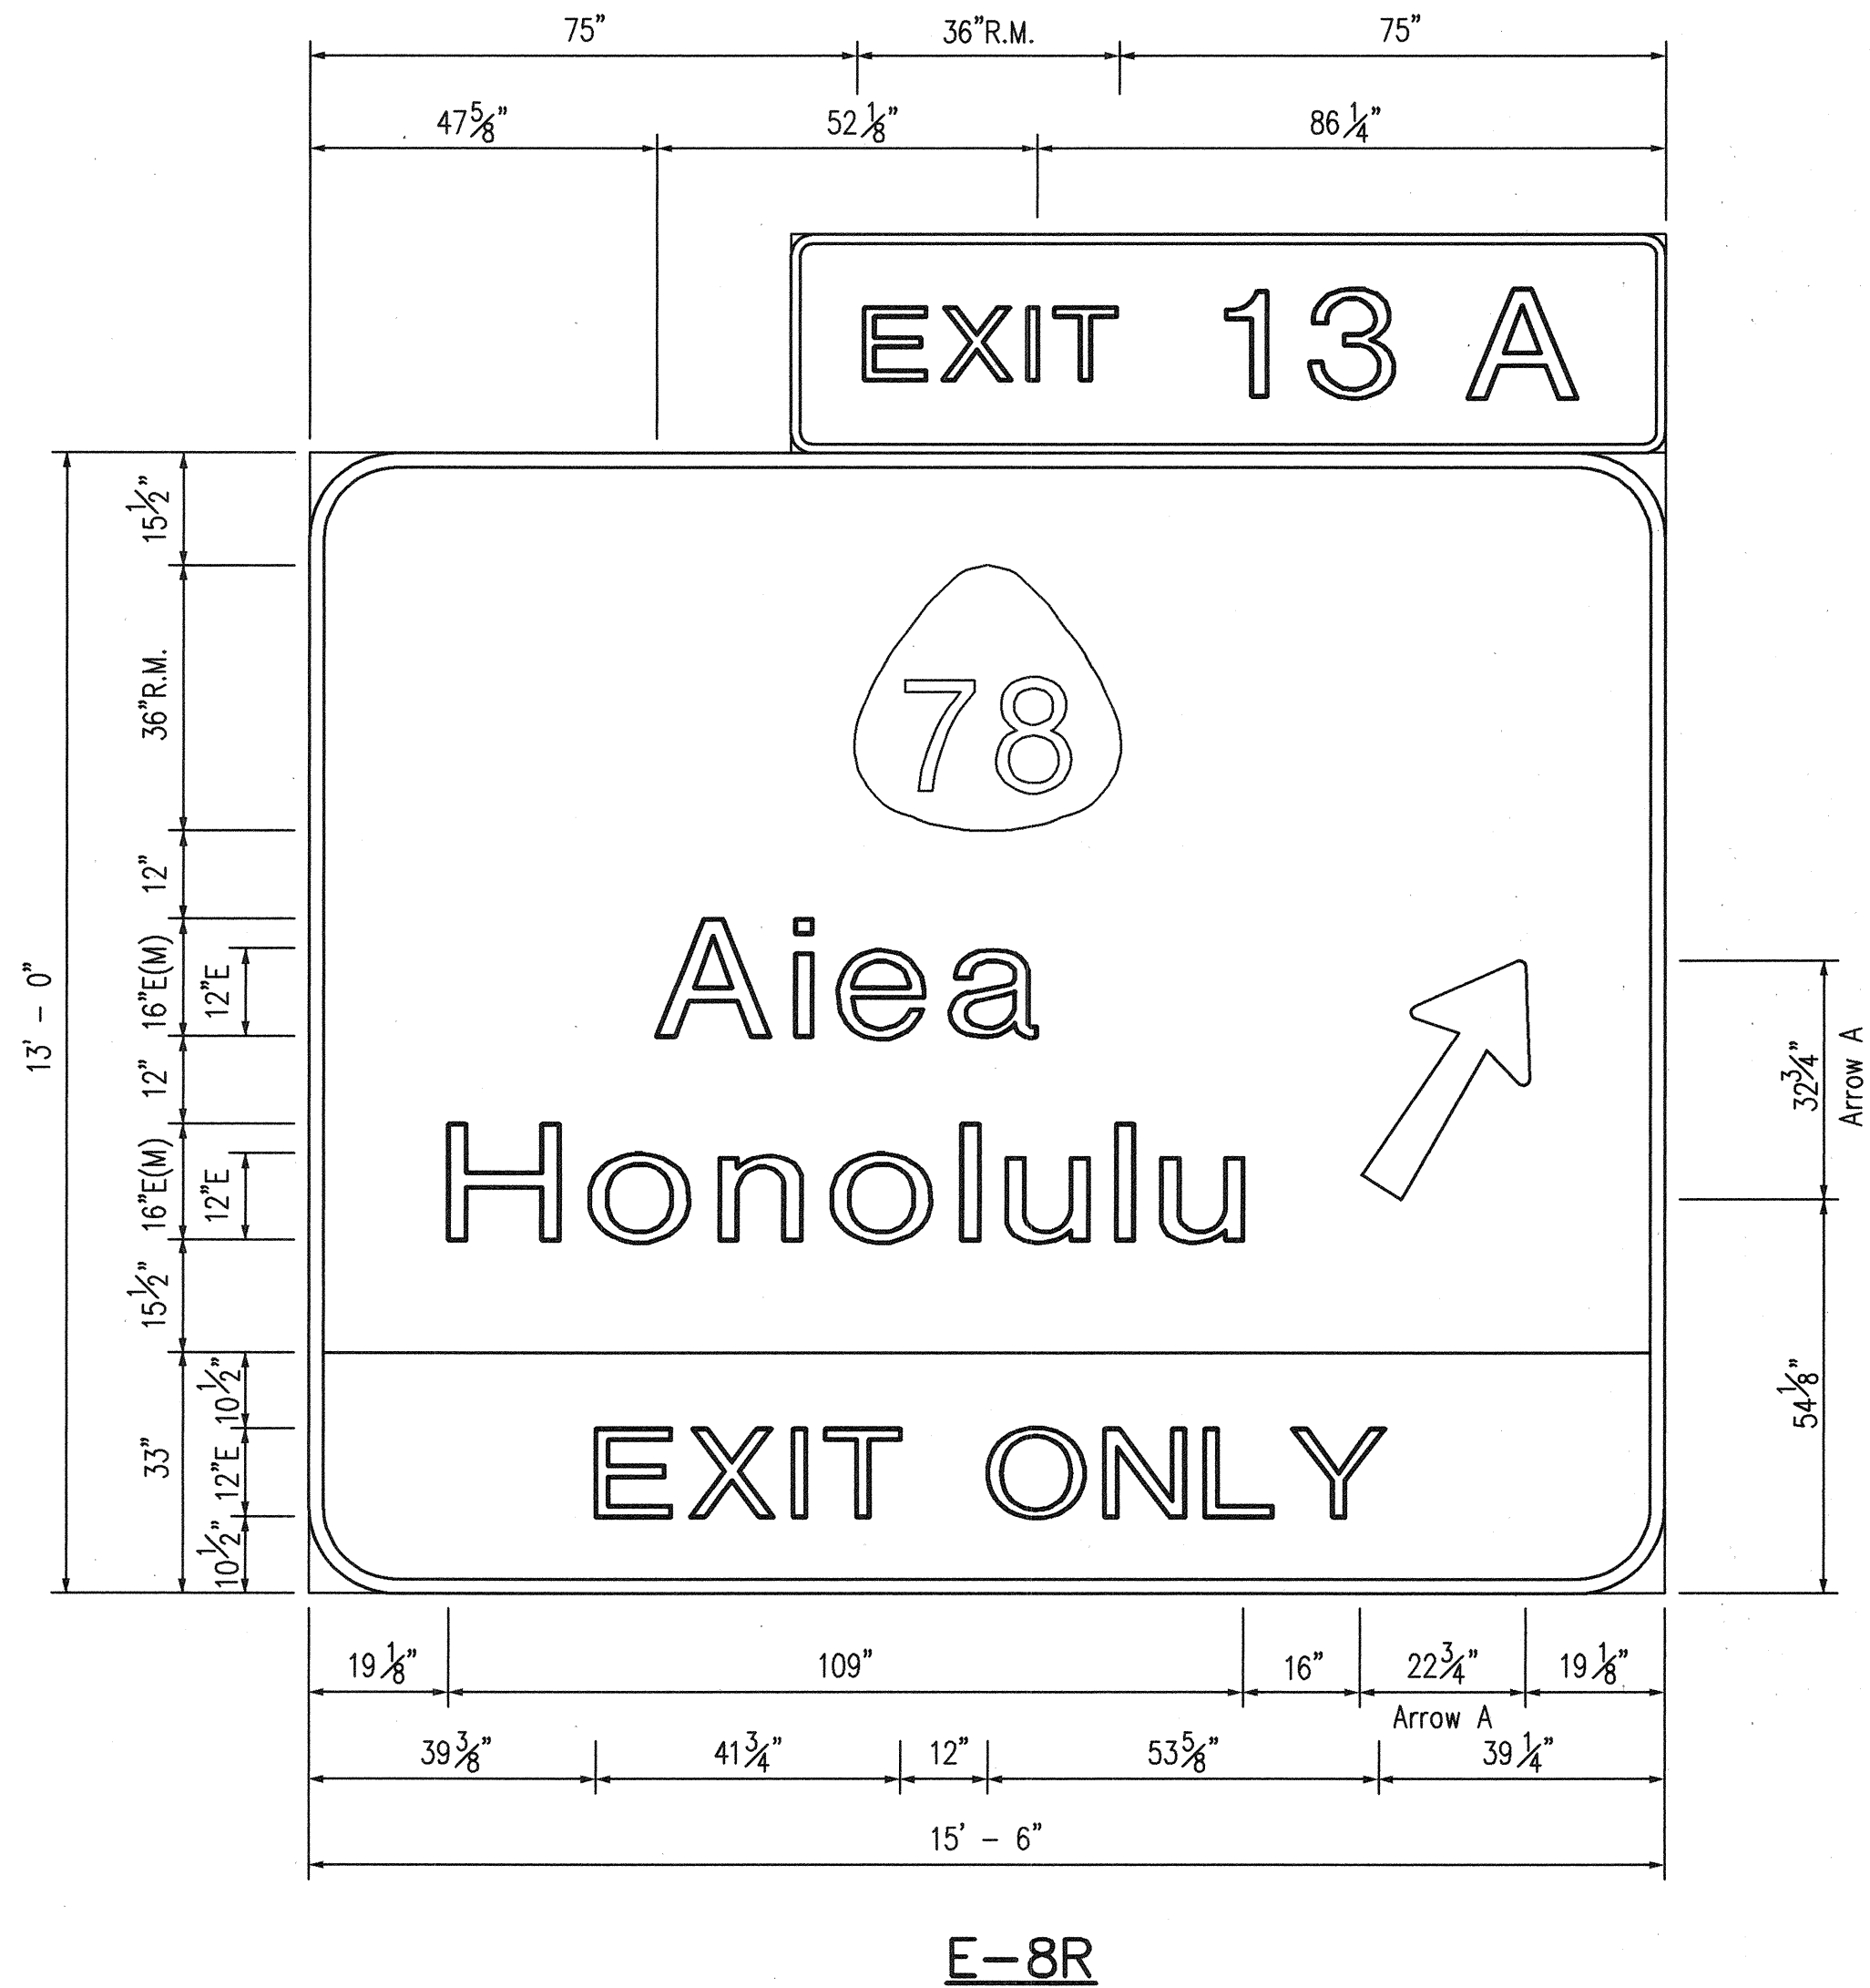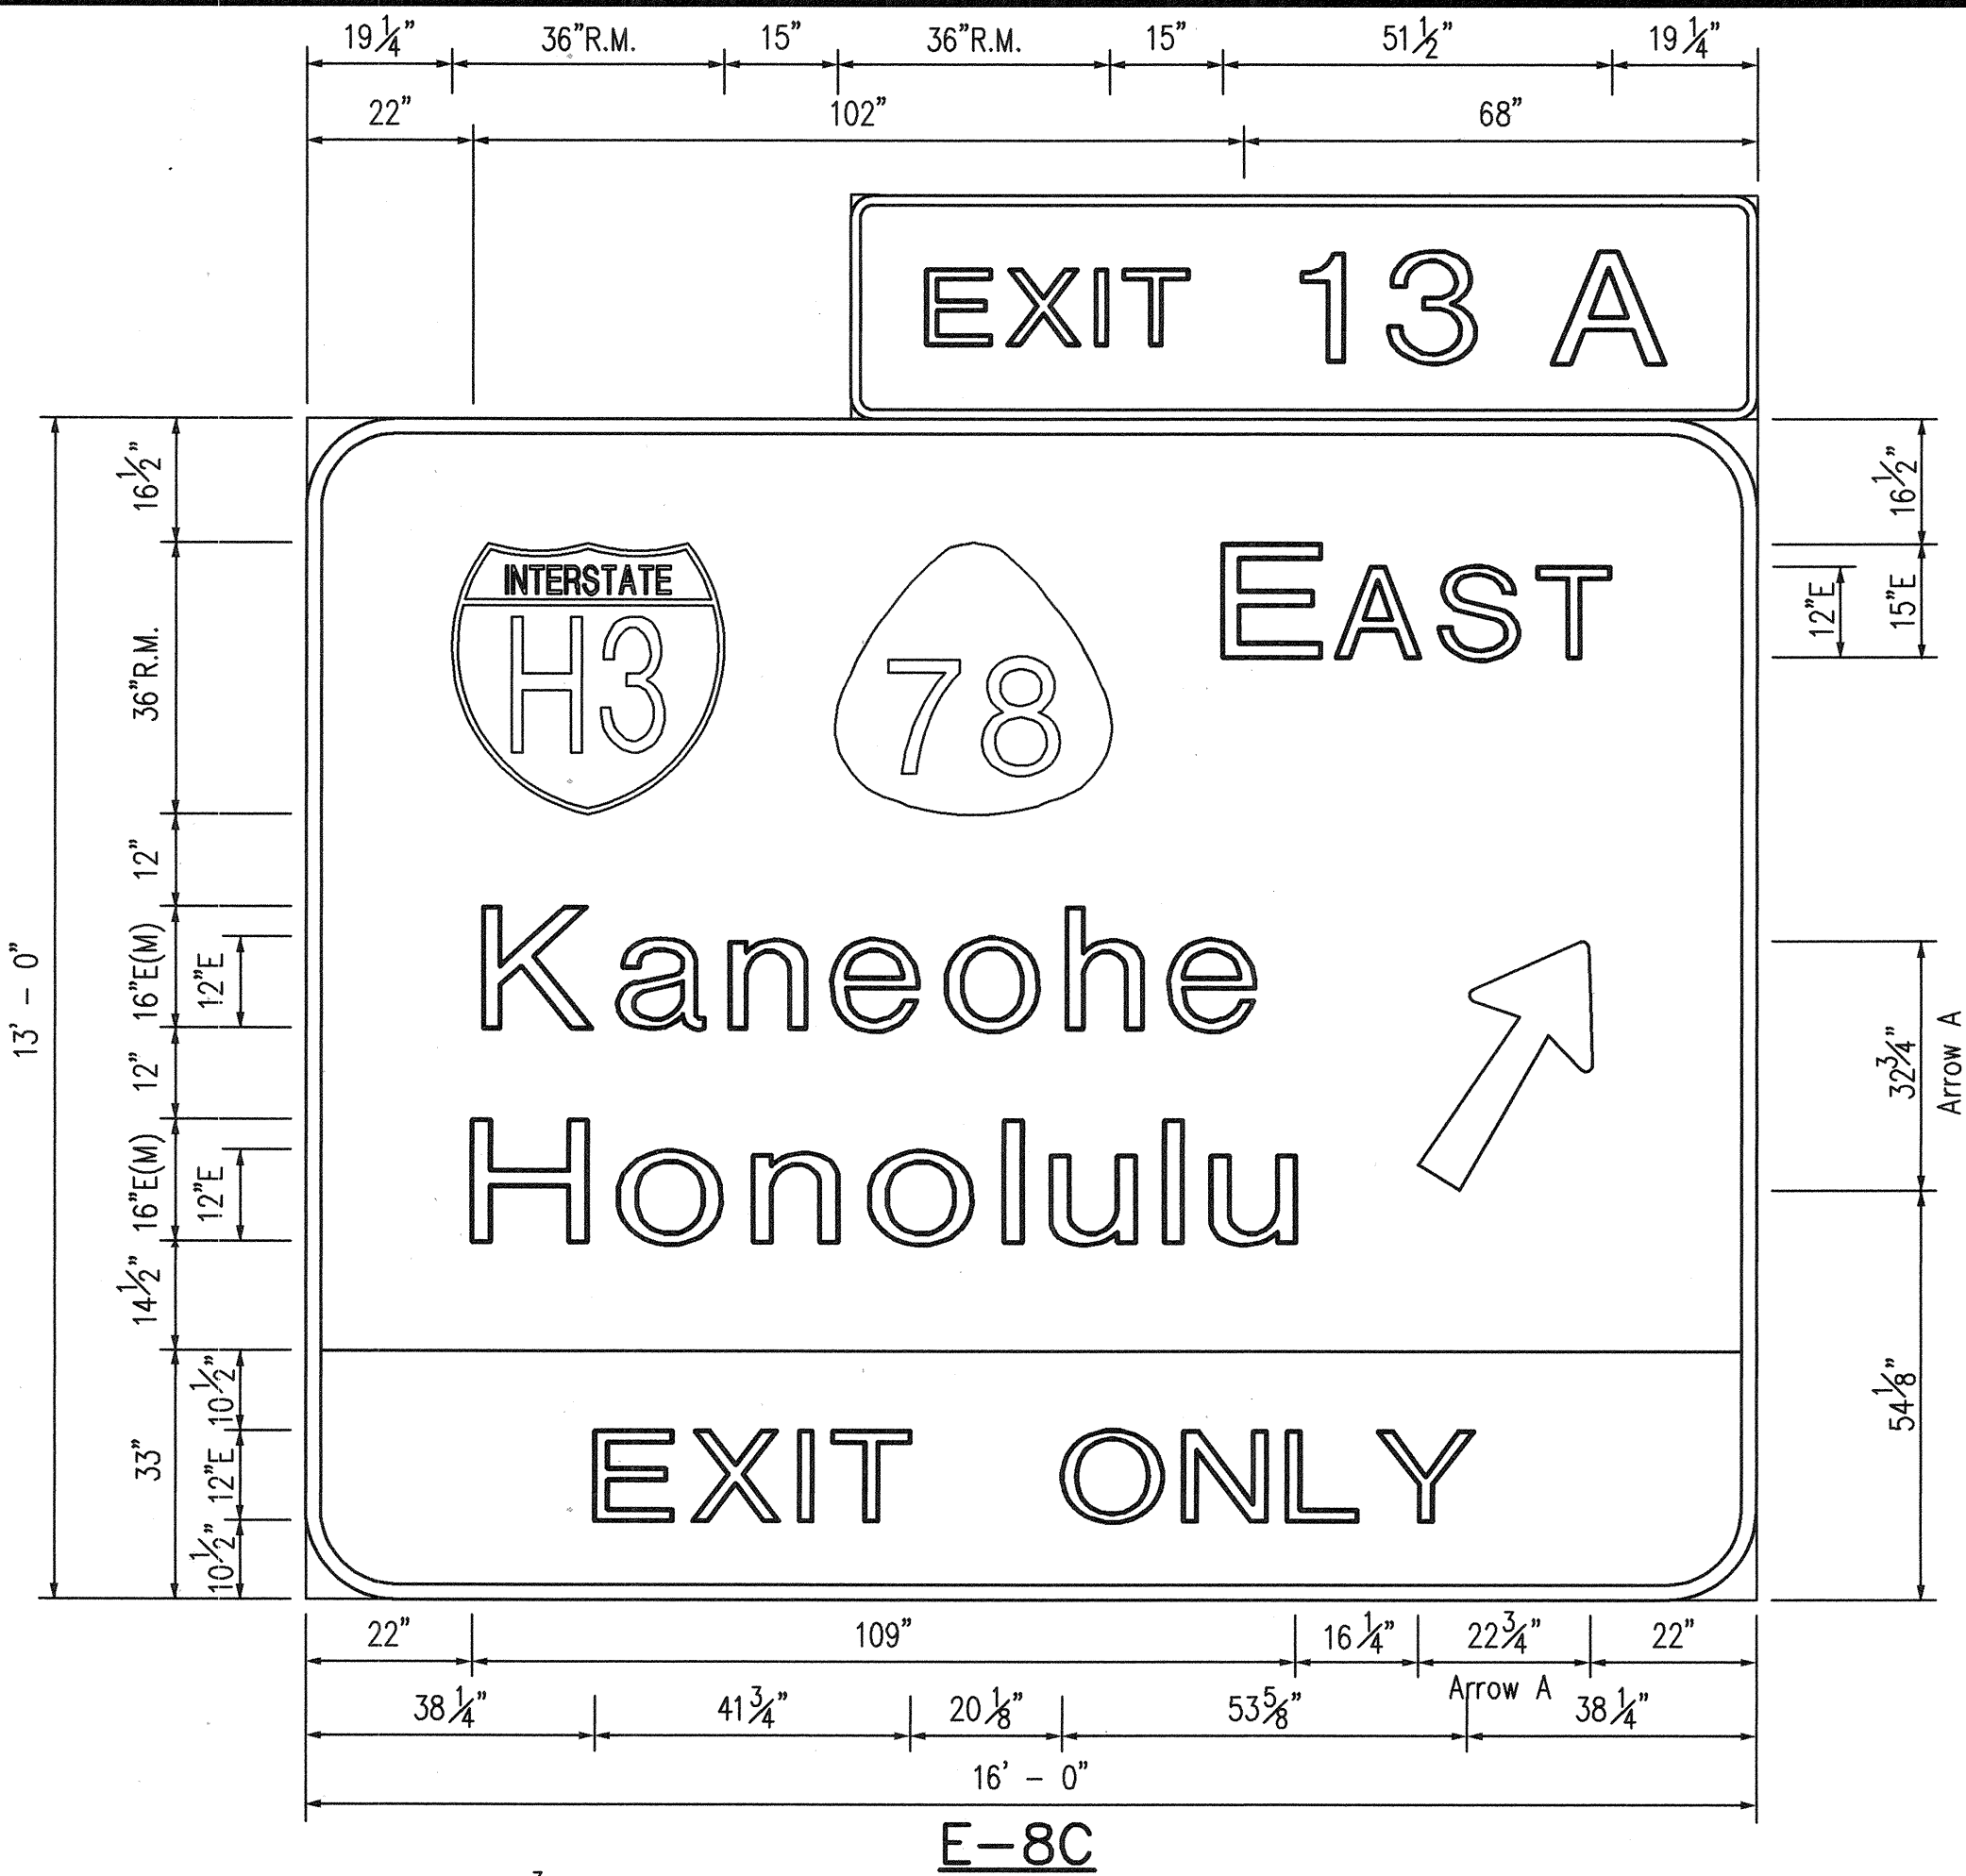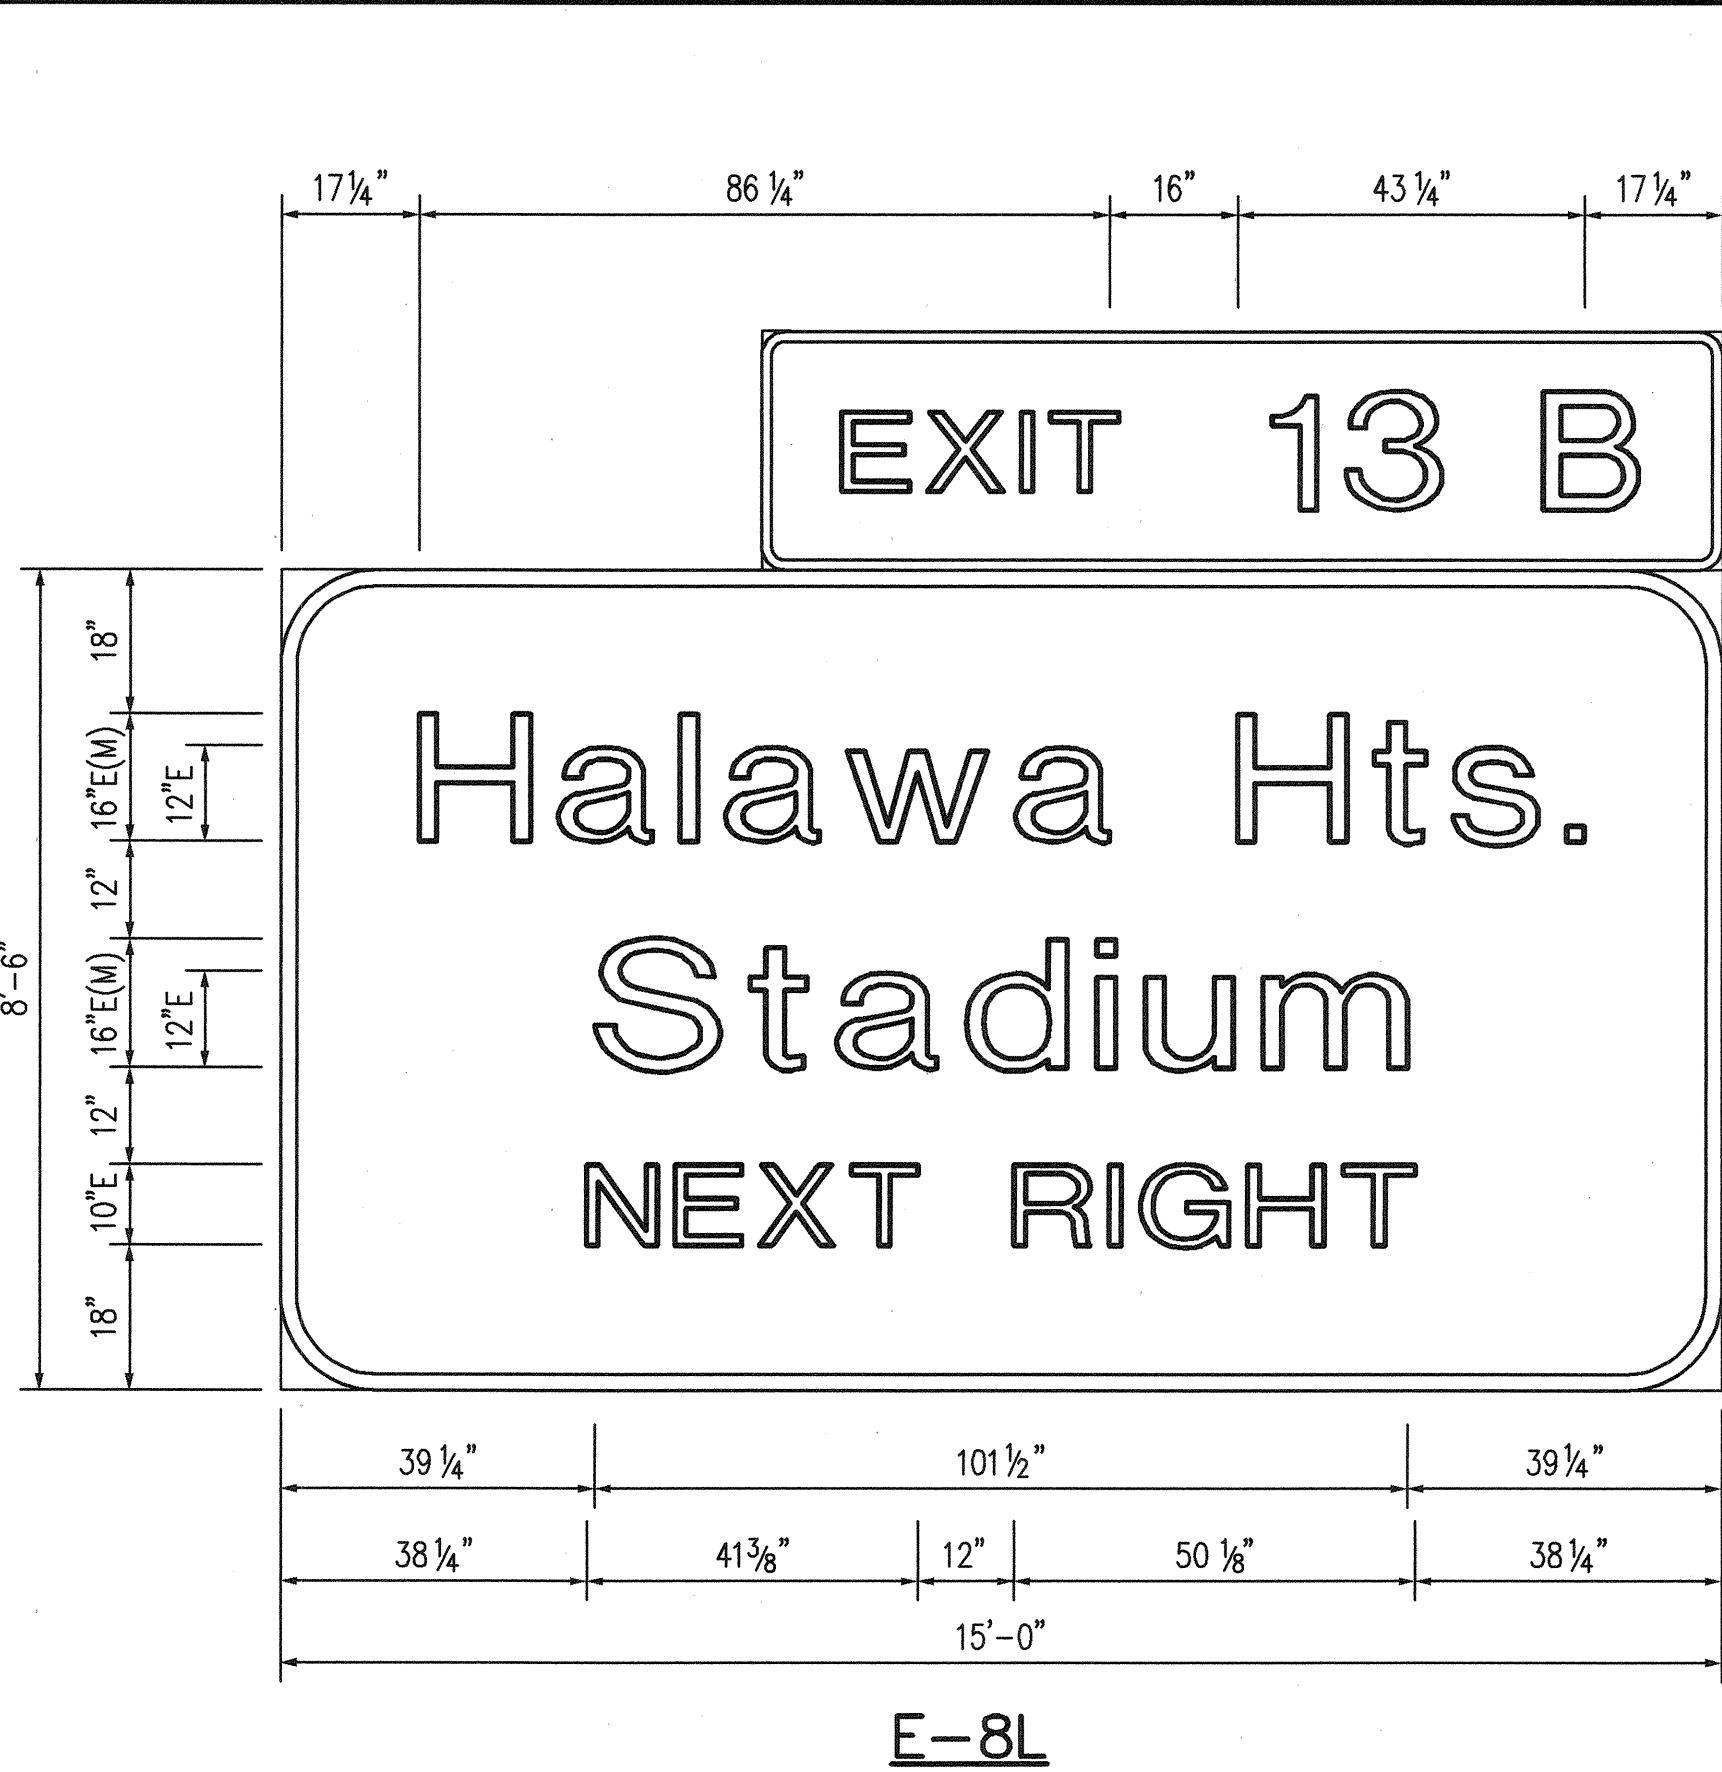


THIS WORK WAS PREPARED BY ME
OR UNDER MY SUPERVISION.
Randall M. Urasak

STATE OF HAWAII
DEPARTMENT OF TRANSPORTATION
HIGHWAYS DIVISION
DESTINATION SIGNS
SIGN DETAILS
H-1 WEST
H-3 FINISH (UNIT II)
FAIP NO. I-H3-1(75), UNIT II
LEEWARD SECTION
SCALE: 1/2" = 1'-0" DATE: JANUARY 1997
SHEET NO. 6P2 OF 20 SHEETS


ORIGINAL SURVEY PLOTTED BY _____	DATE _____
DRAWN BY _____	DATE _____
TRACED BY _____	DATE _____
DESIGNED BY _____	DATE _____
QUANTITY BY _____	DATE _____
CHECKED BY _____	DATE _____
No. _____	

CAD by J. Minura, 55-52


FED. ROAD DIST. NO.	STATE	FED. AID PROJ. NO.	FISCAL YEAR	SHEET NO.	TOTAL SHEETS
HAWAII	HAW.	I-H3-1(75), UNIT II	1997	853	1102

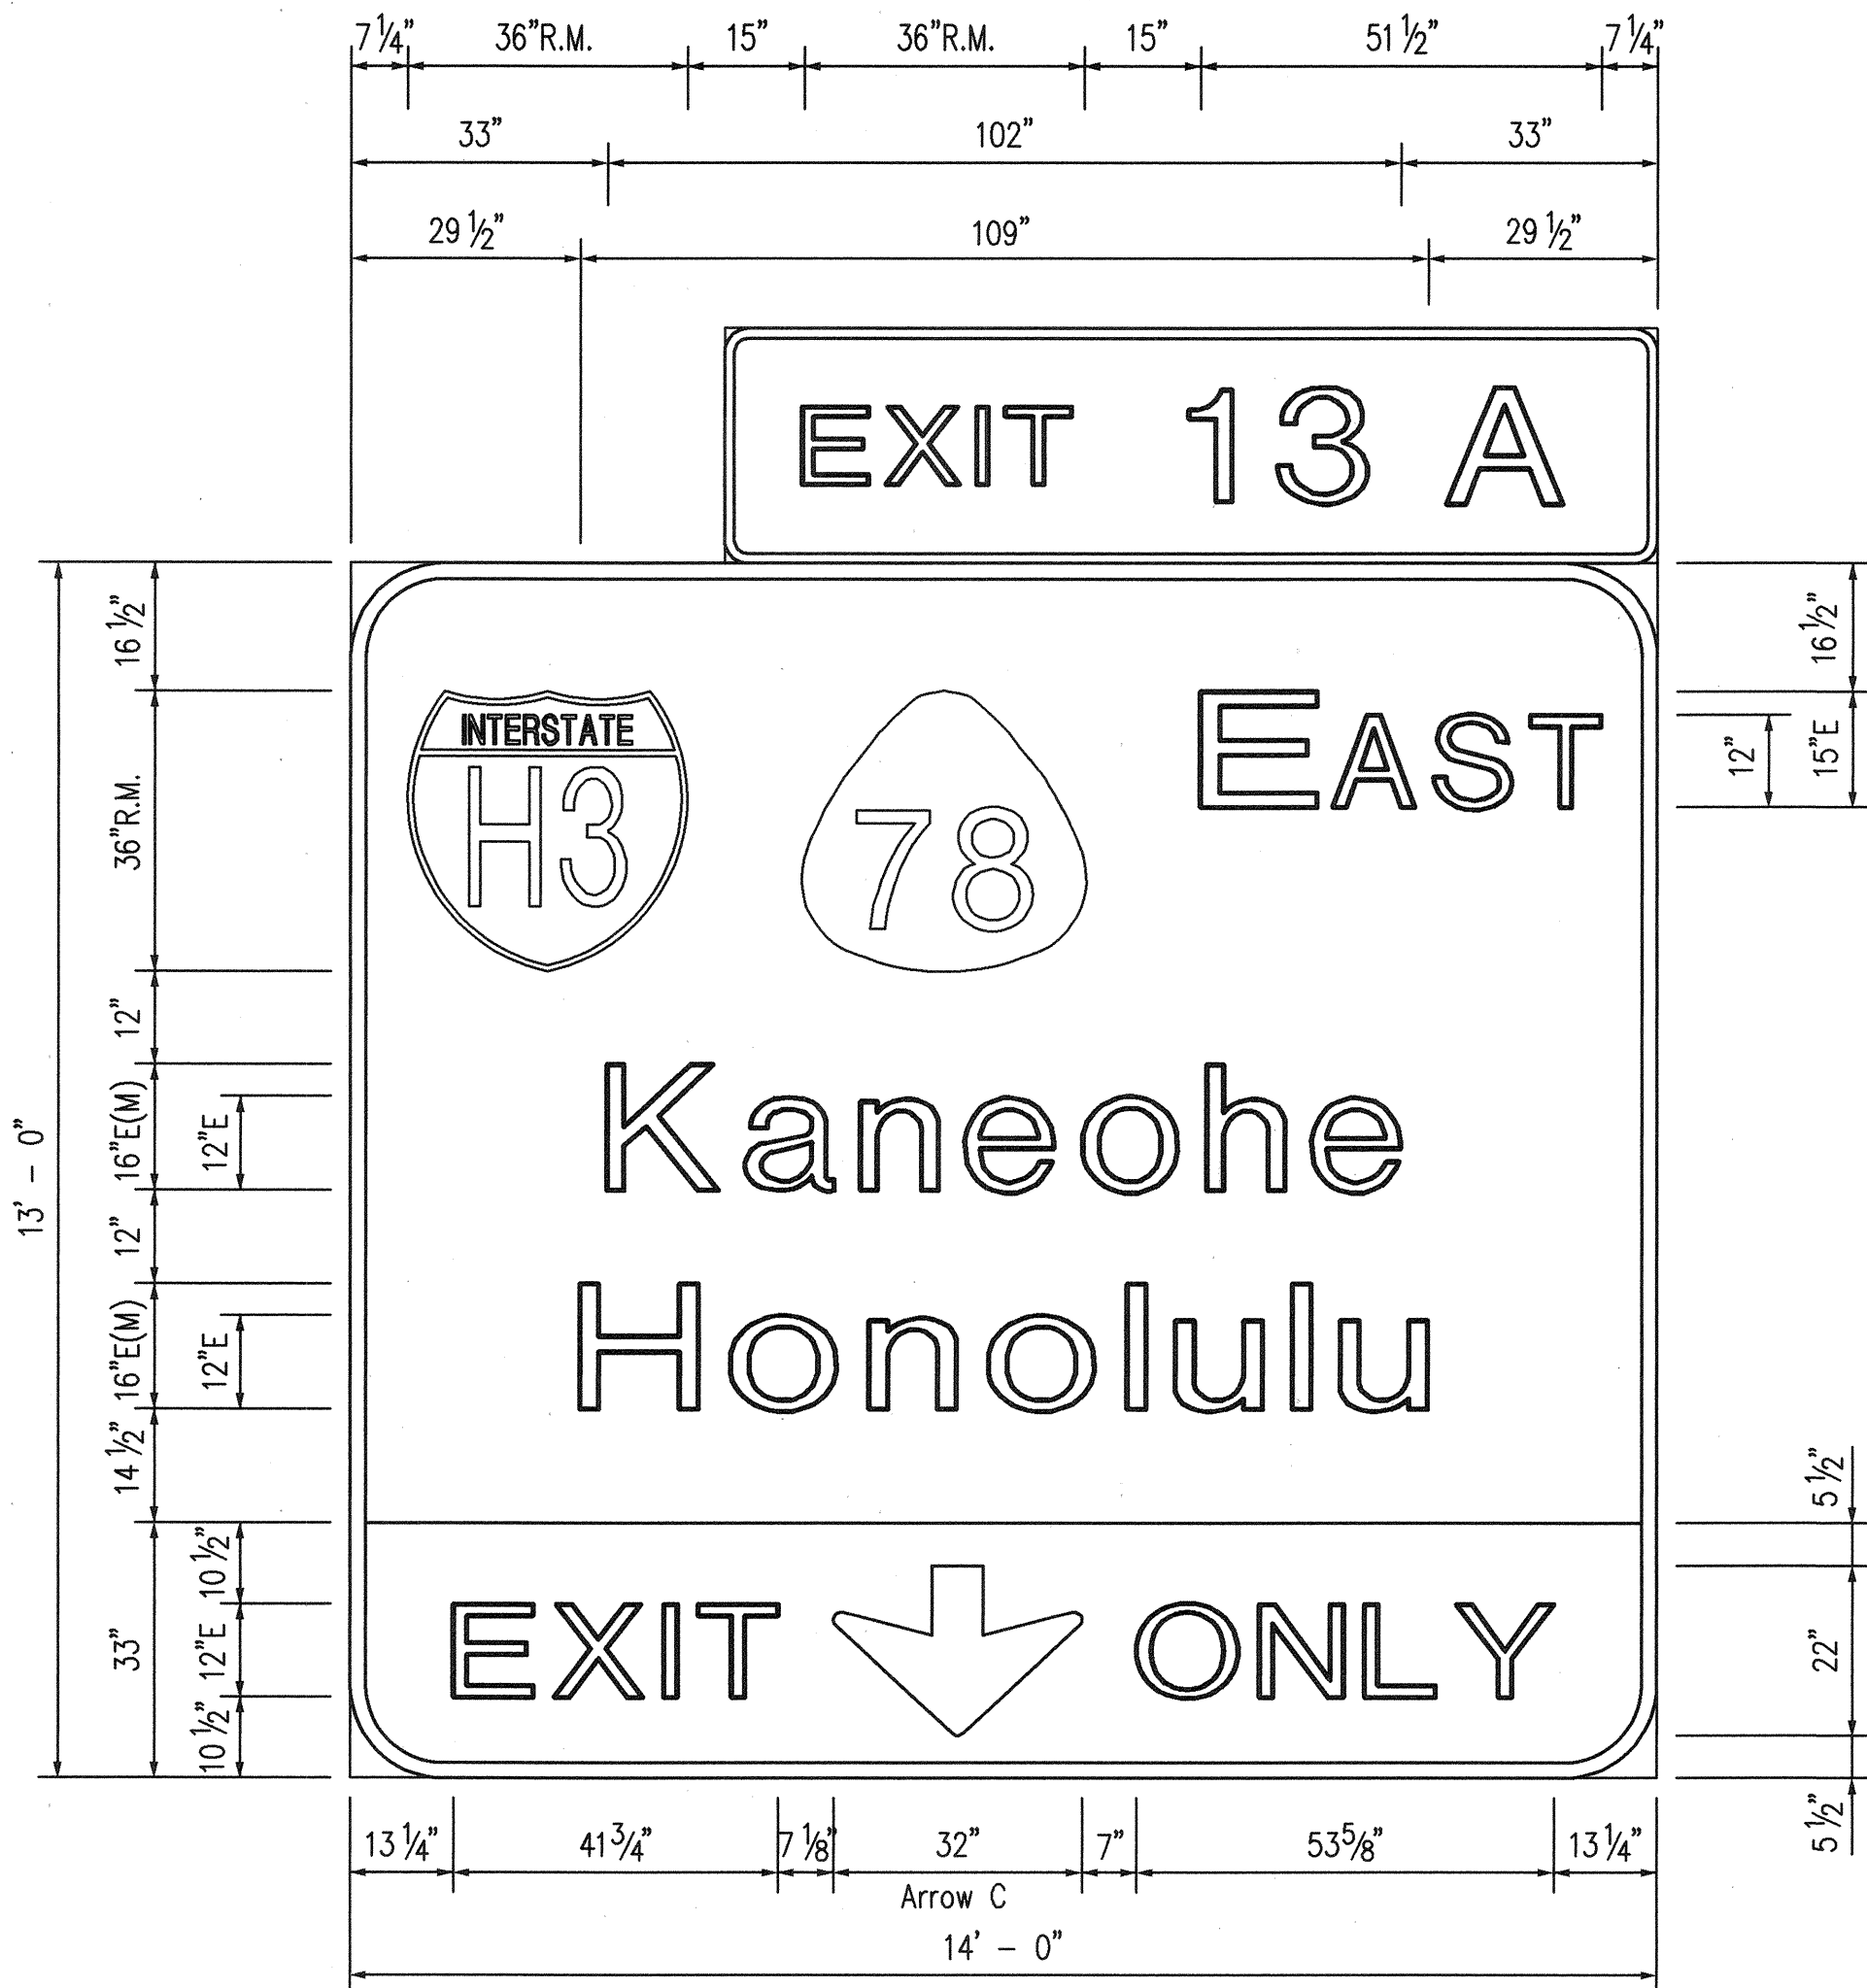


E-64L

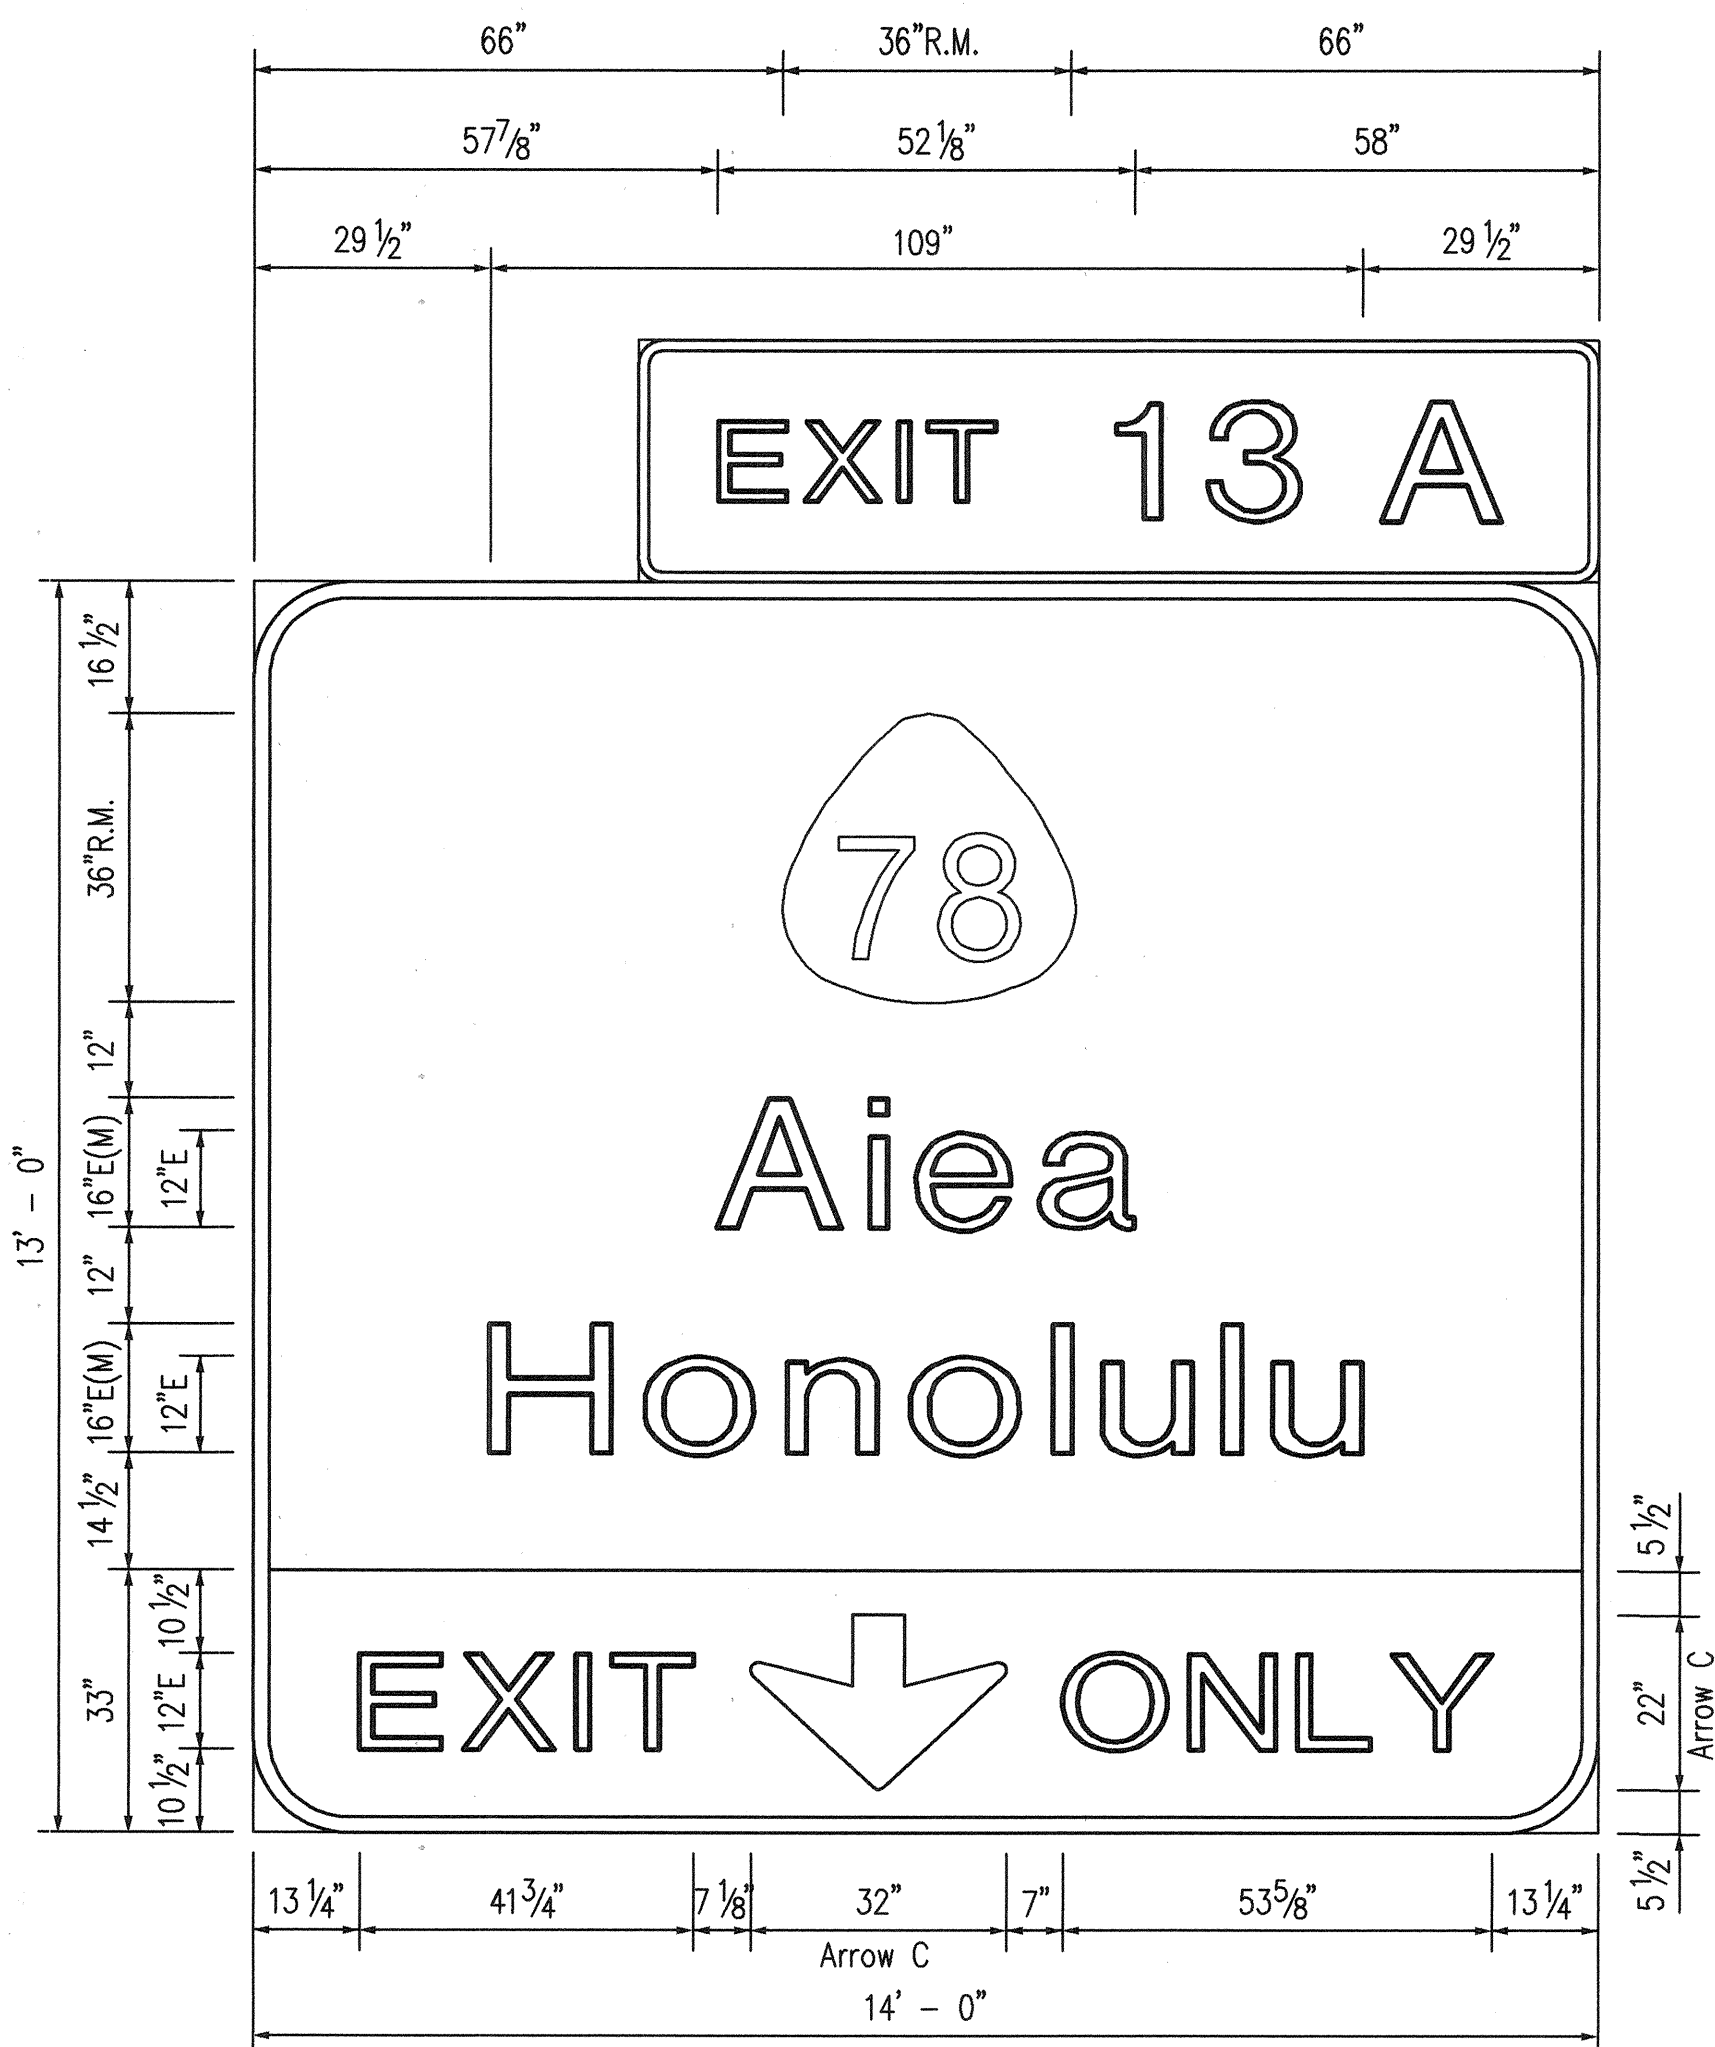

E-64R

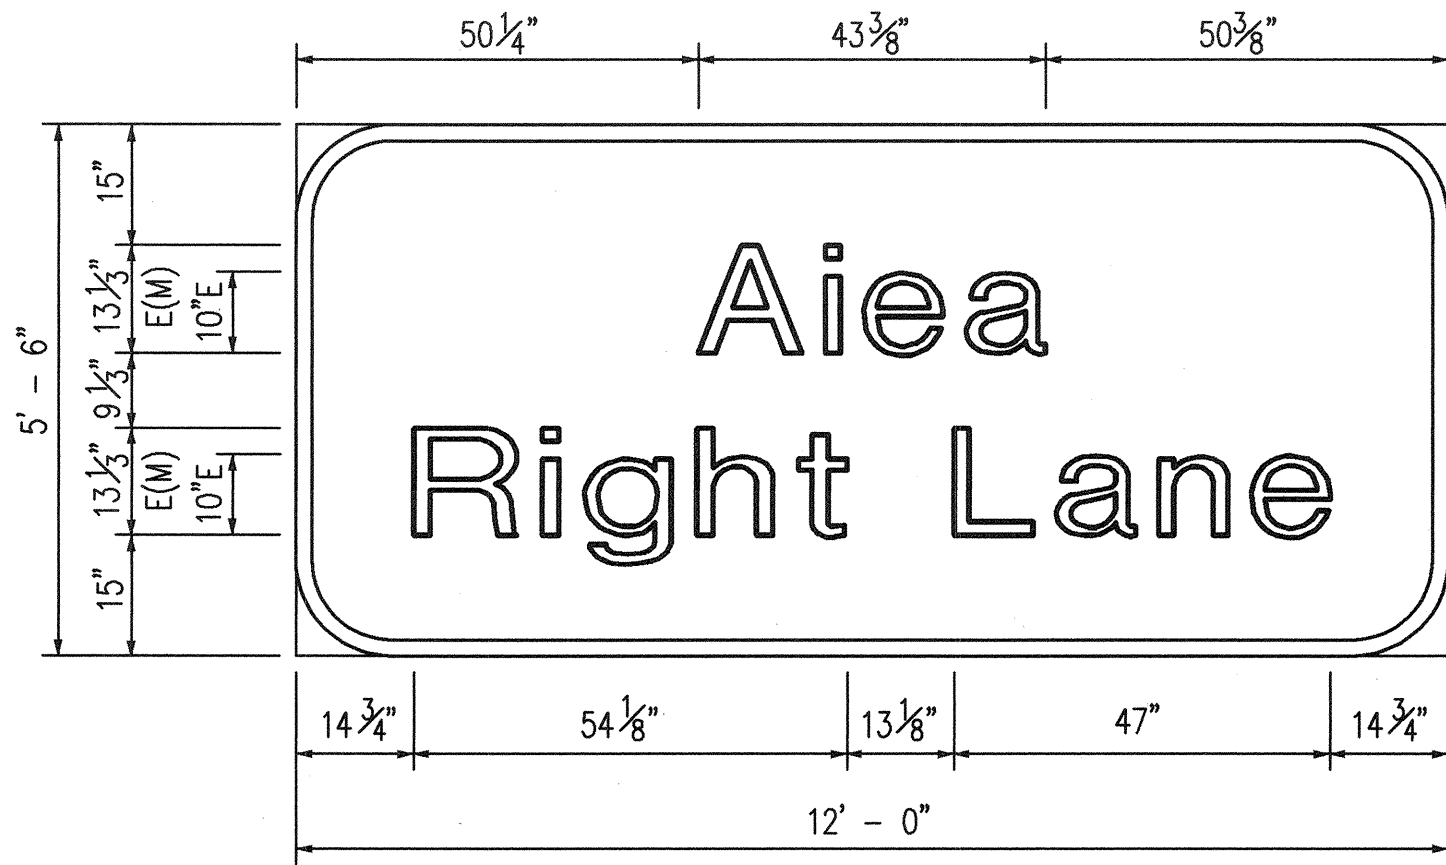

E-66

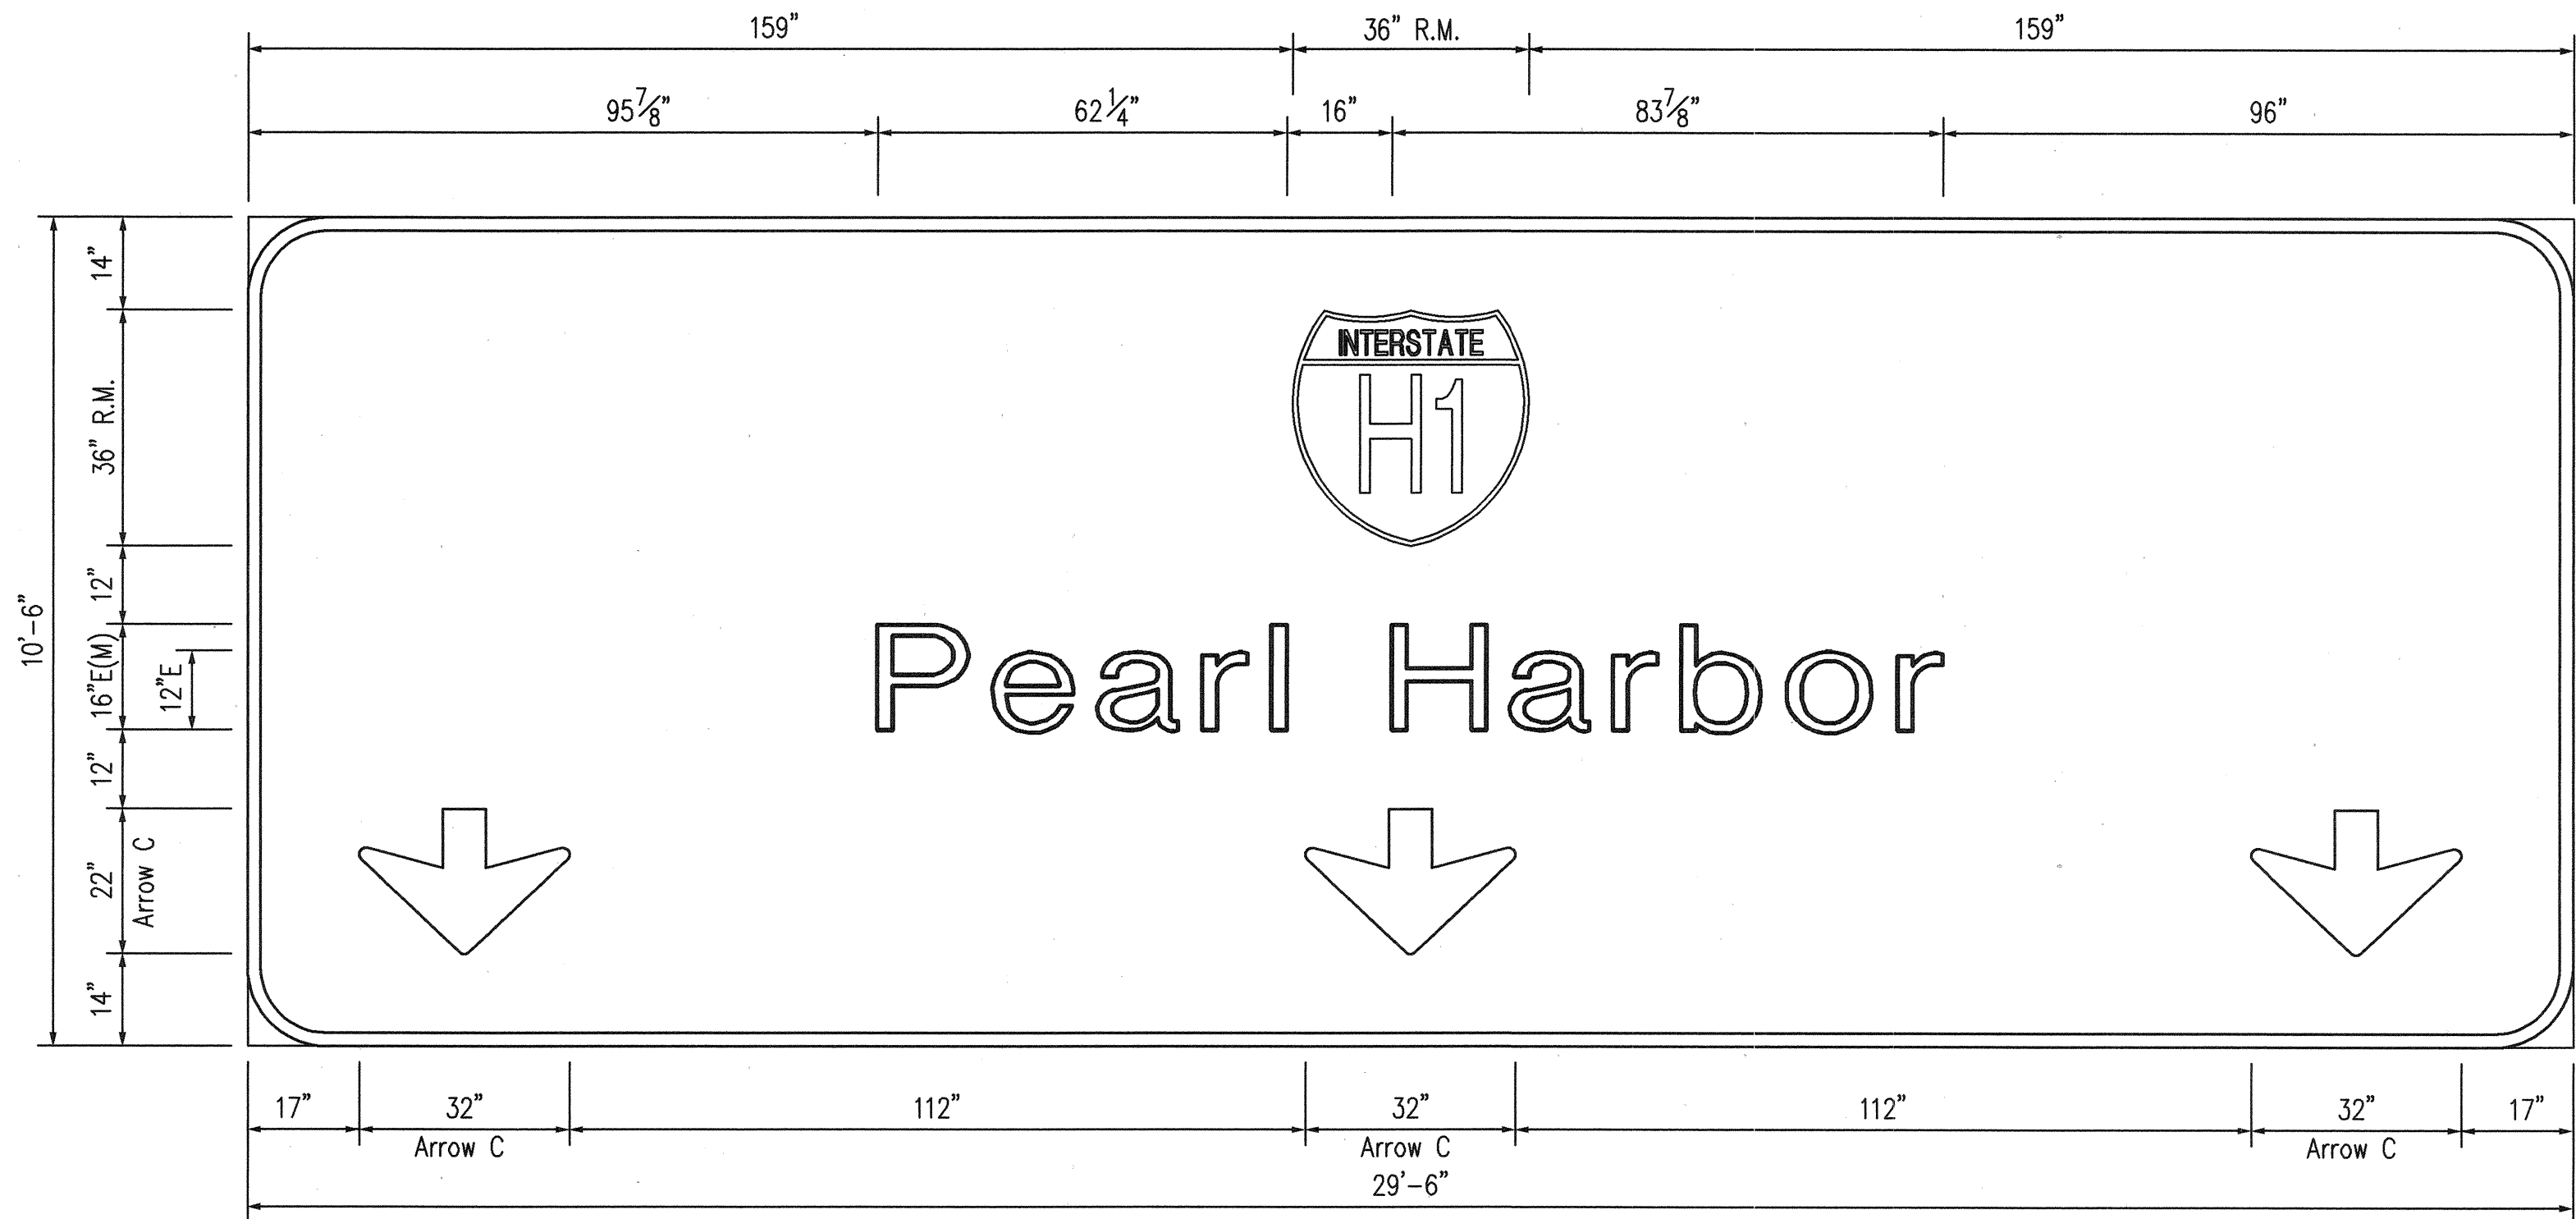


E-68L

ORIGINAL	SURVEY PLOTTED BY	DATE
PLAN	DRAWN BY	
NOTE BOOK	TRACED BY	
	DESIGNED BY	
	CHECKED BY	
No.		

CAD by D. Burgess, 55-52





Last Saved: J:\H3RF\RFU2\SIGN\SD-H1W-1.dwg 01/03/97 at 09:31

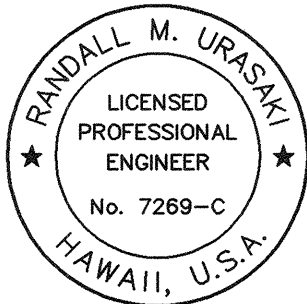

THIS WORK WAS PREPARED BY ME
OR UNDER MY SUPERVISION.
Randall M. Urasaki

STATE OF HAWAII DEPARTMENT OF TRANSPORTATION HIGHWAYS DIVISION	
DESTINATION SIGNS	
SIGN DETAILS	
H-1 WEST	
H-3 FINISH (UNIT II) FAIP NO. I-H3-1(75), UNIT II LEEWARD SECTION	
SCALE: 1/2" = 1'-0"	DATE: JANUARY 1997
SHEET NO. 6P3 OF 20 SHEETS	

FED. ROAD DIST. NO.	STATE	FED. AID PROJ. NO.	FISCAL YEAR	SHEET NO.	TOTAL SHEETS
HAWAII	HAW.	I-H3-1(75), UNIT II	1997	854	1102

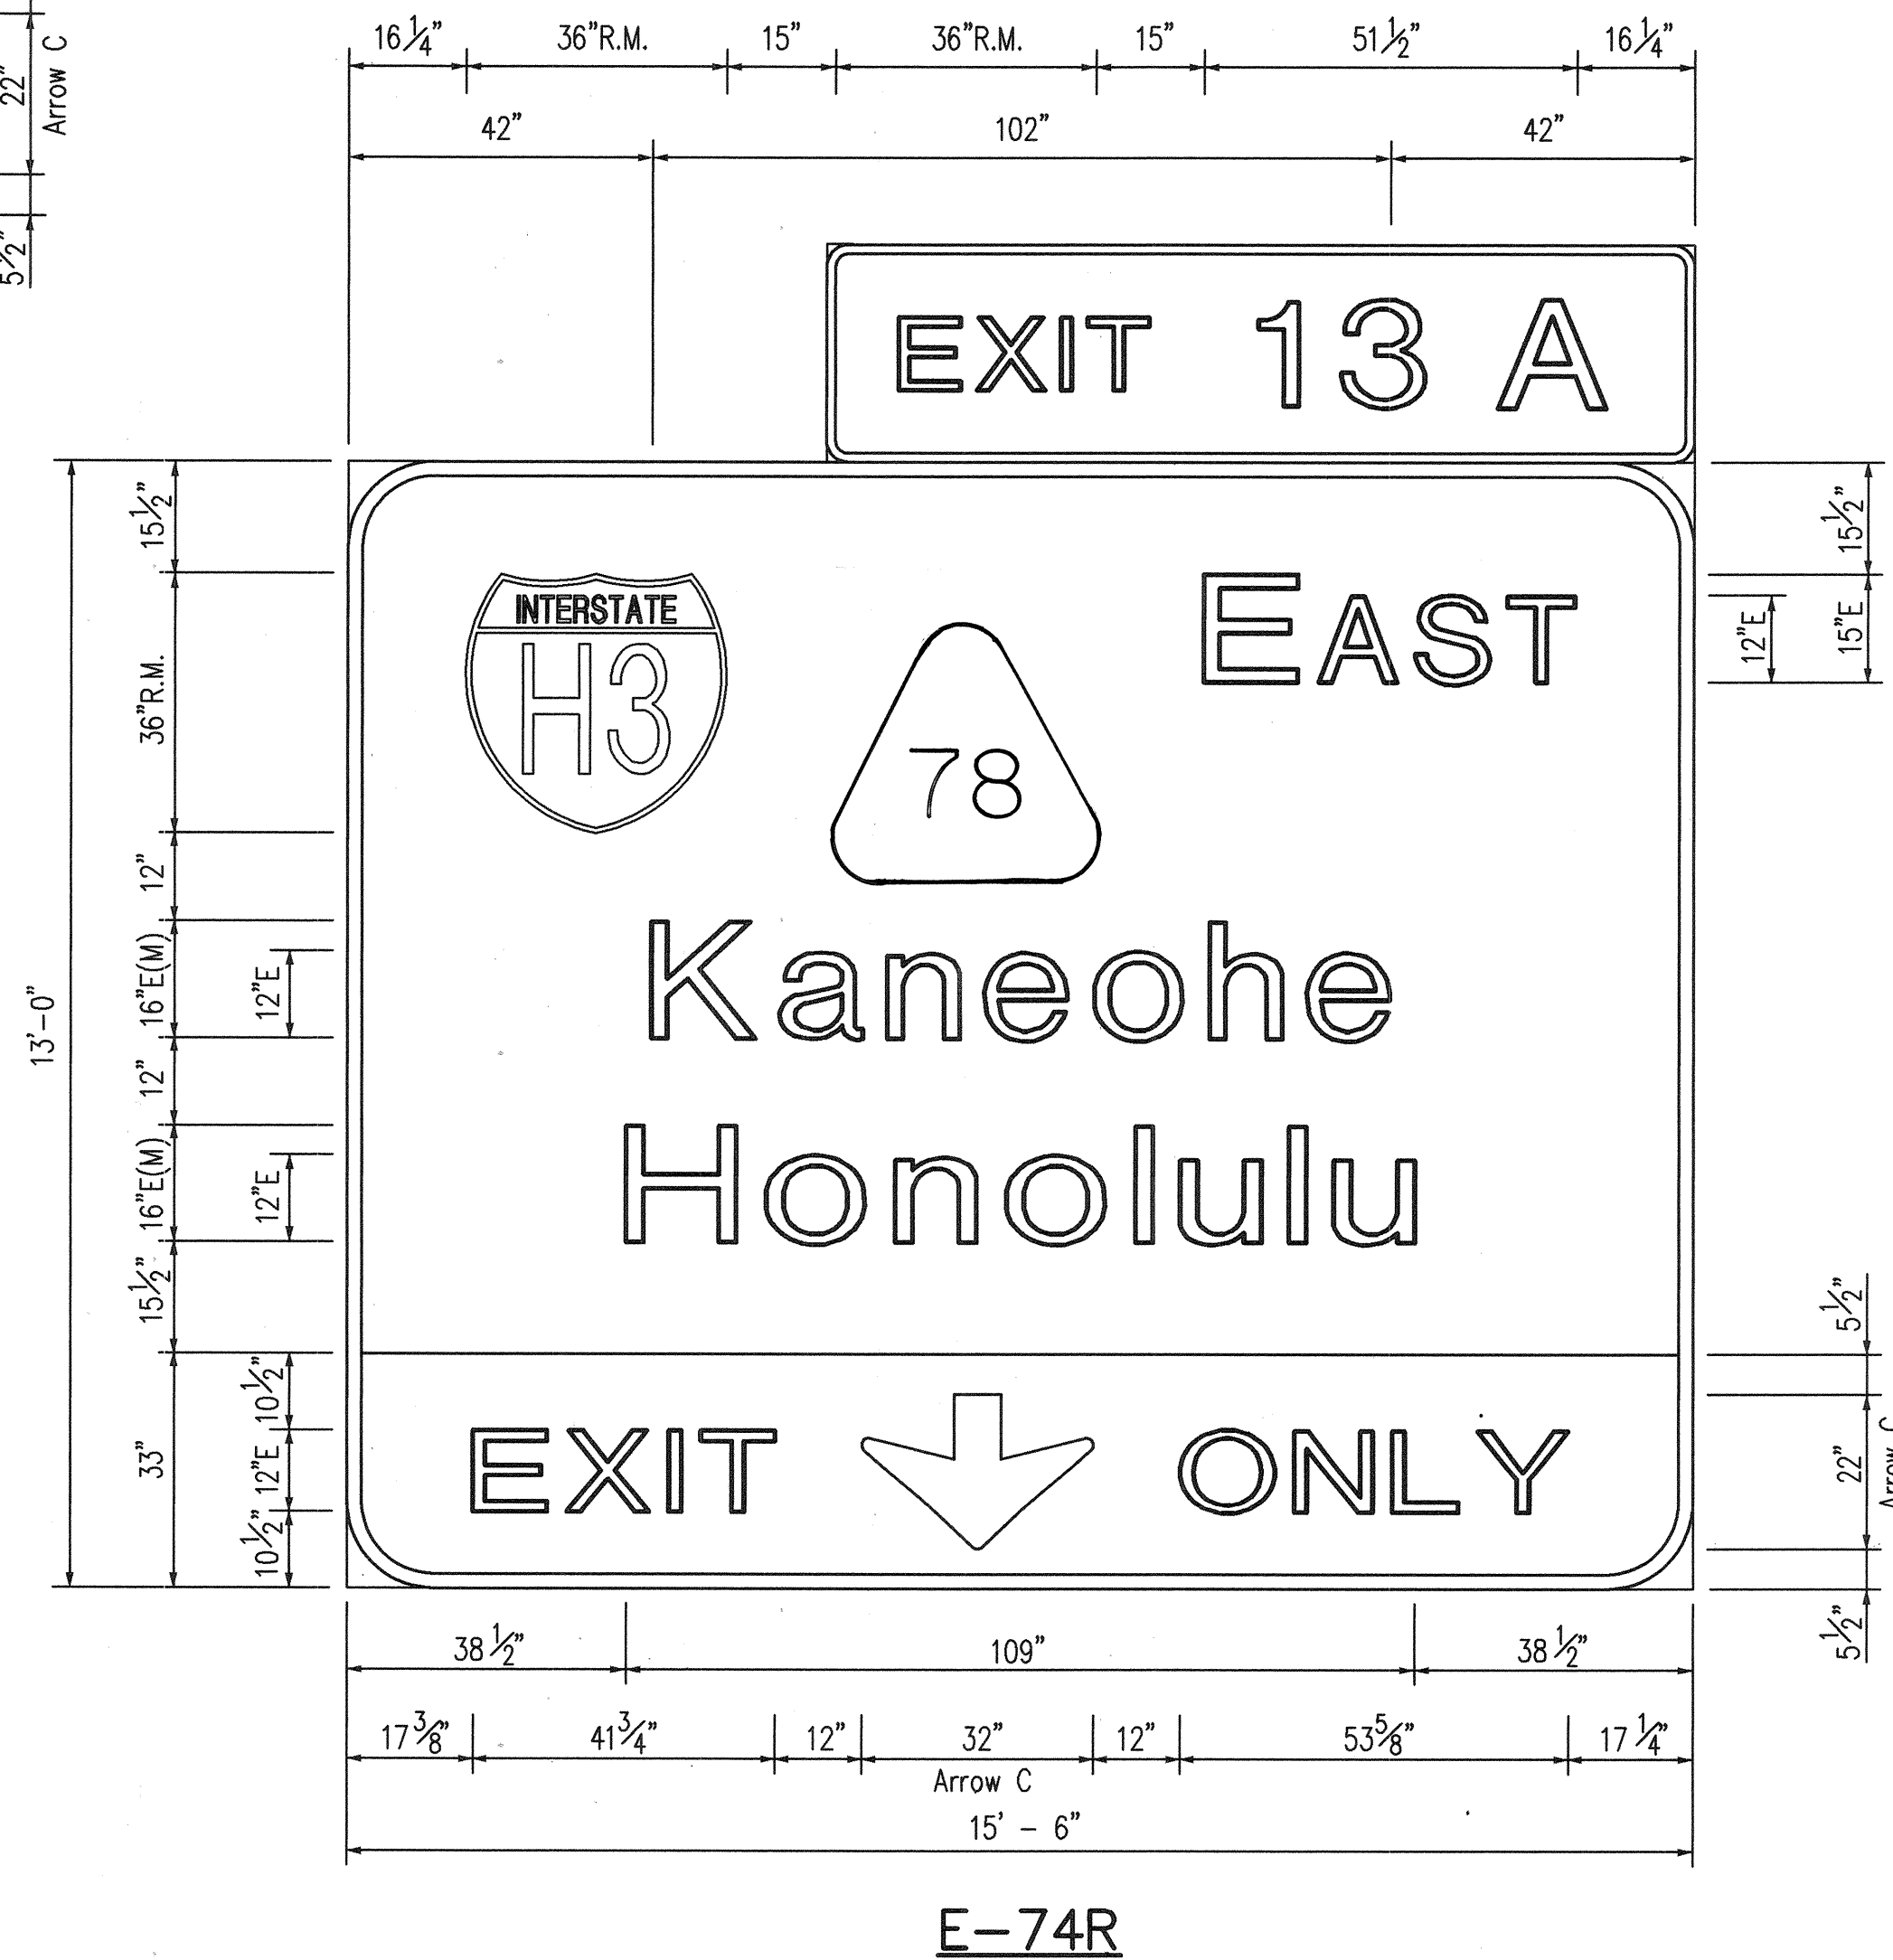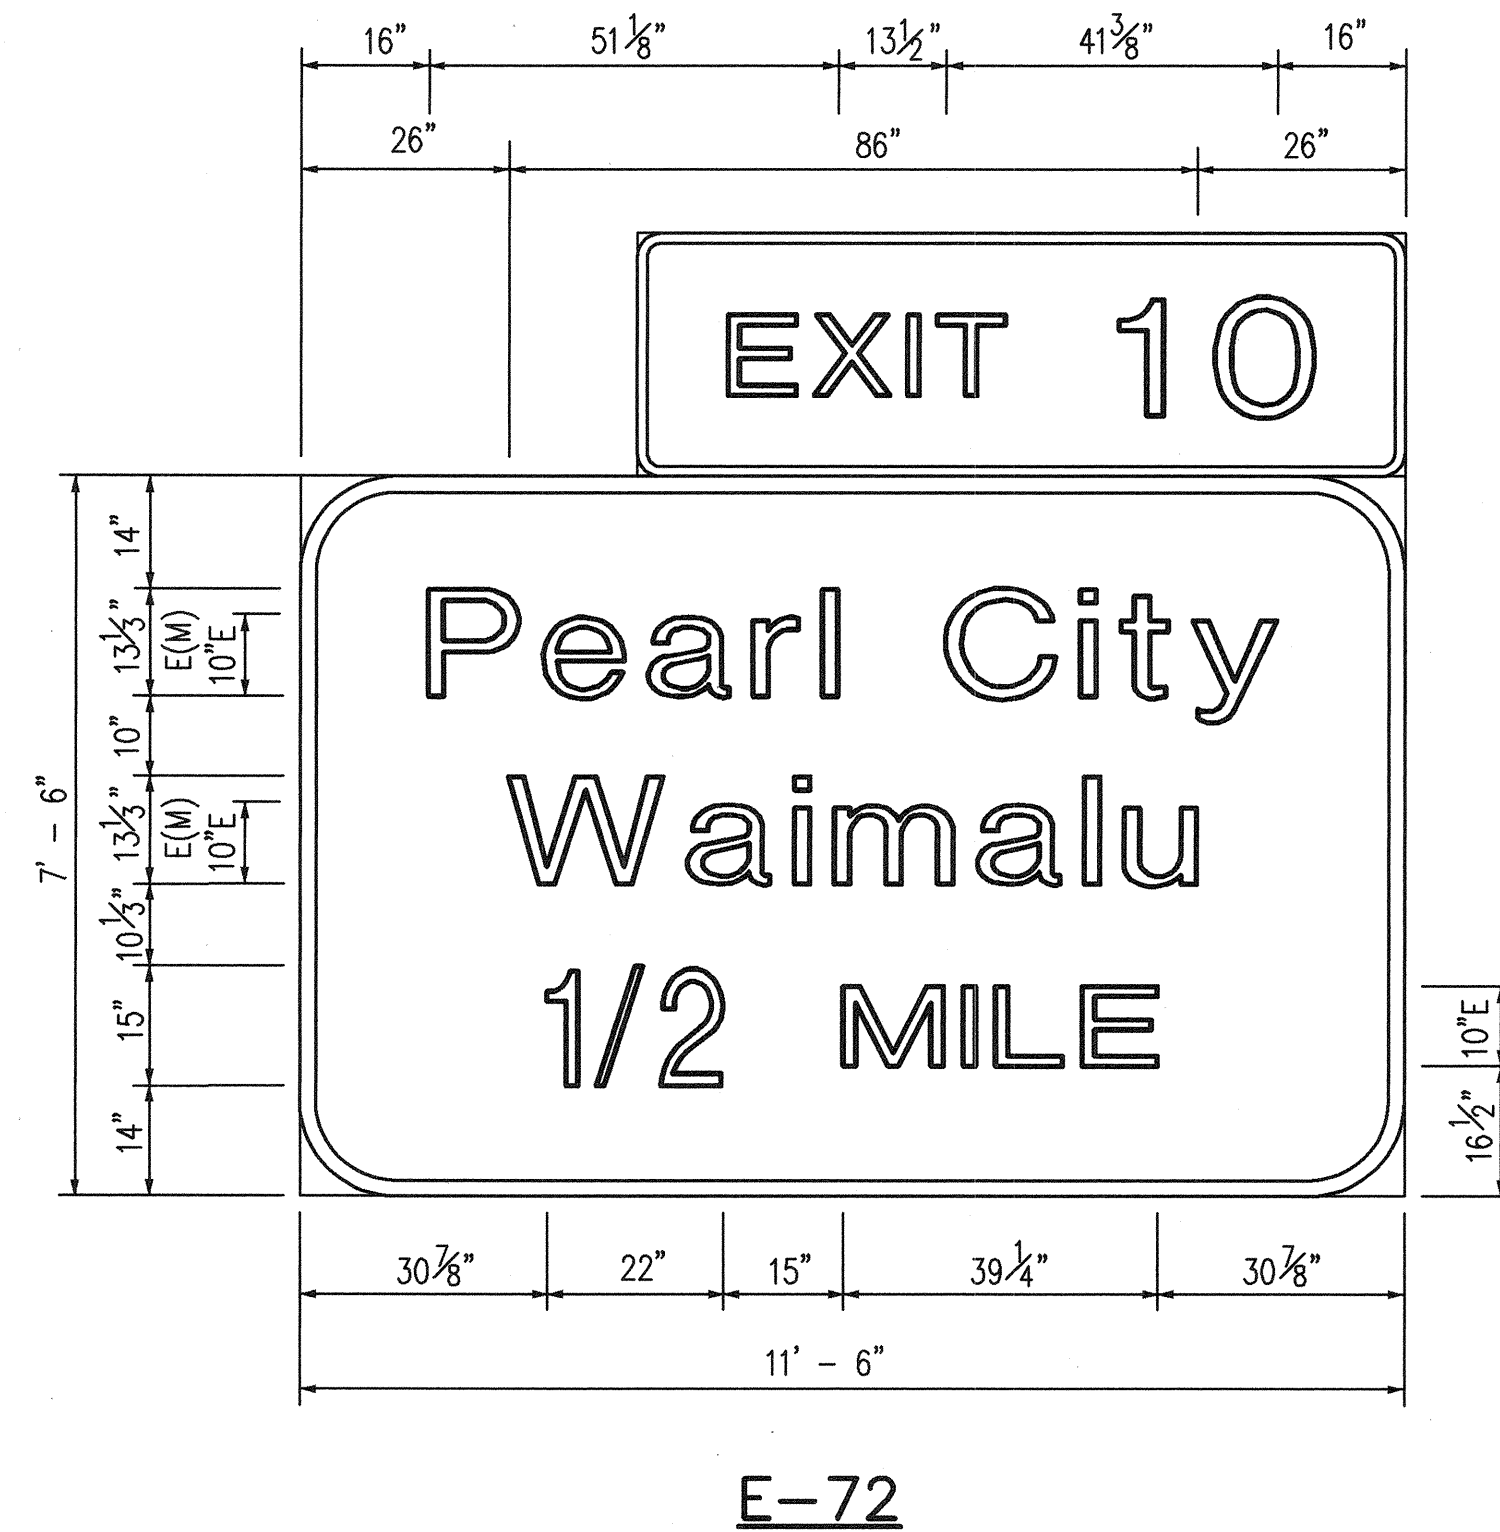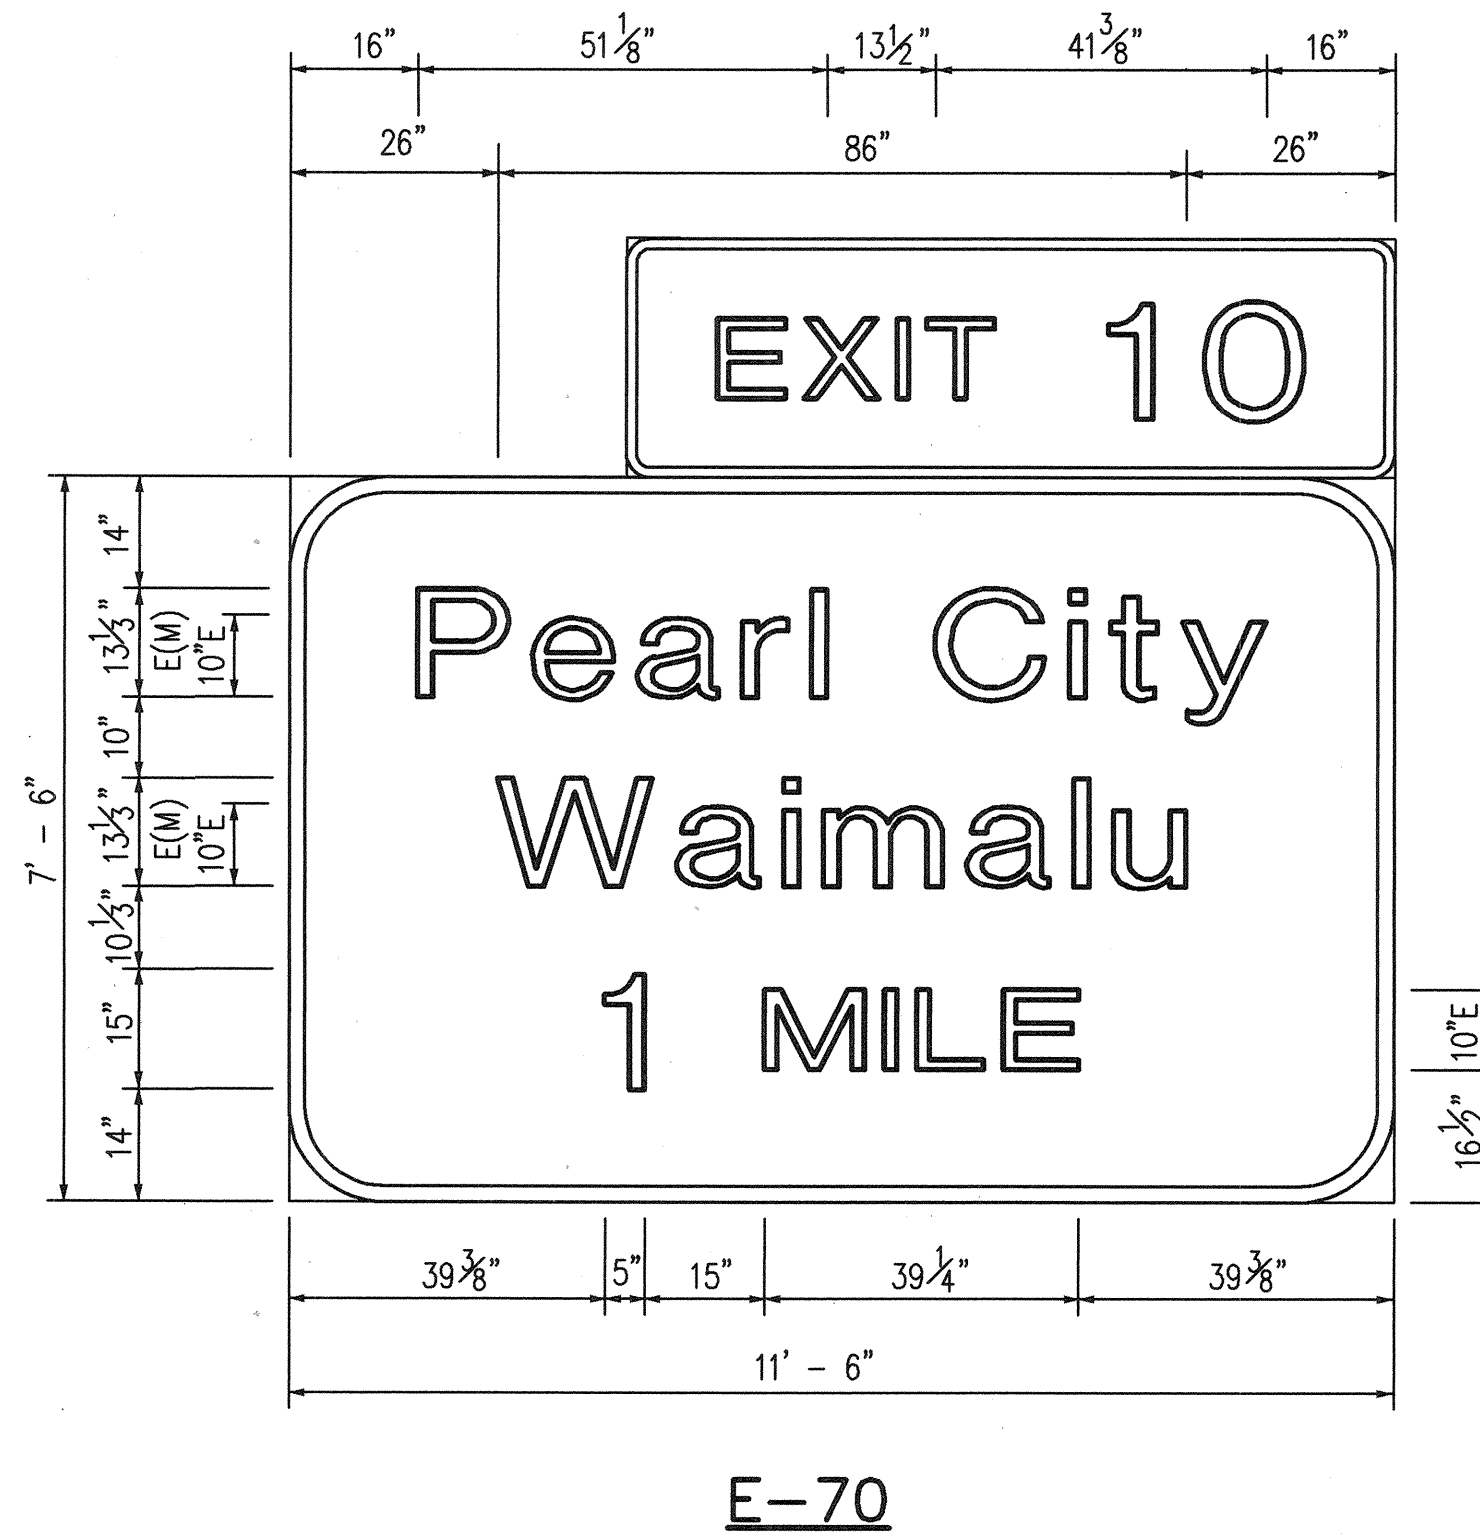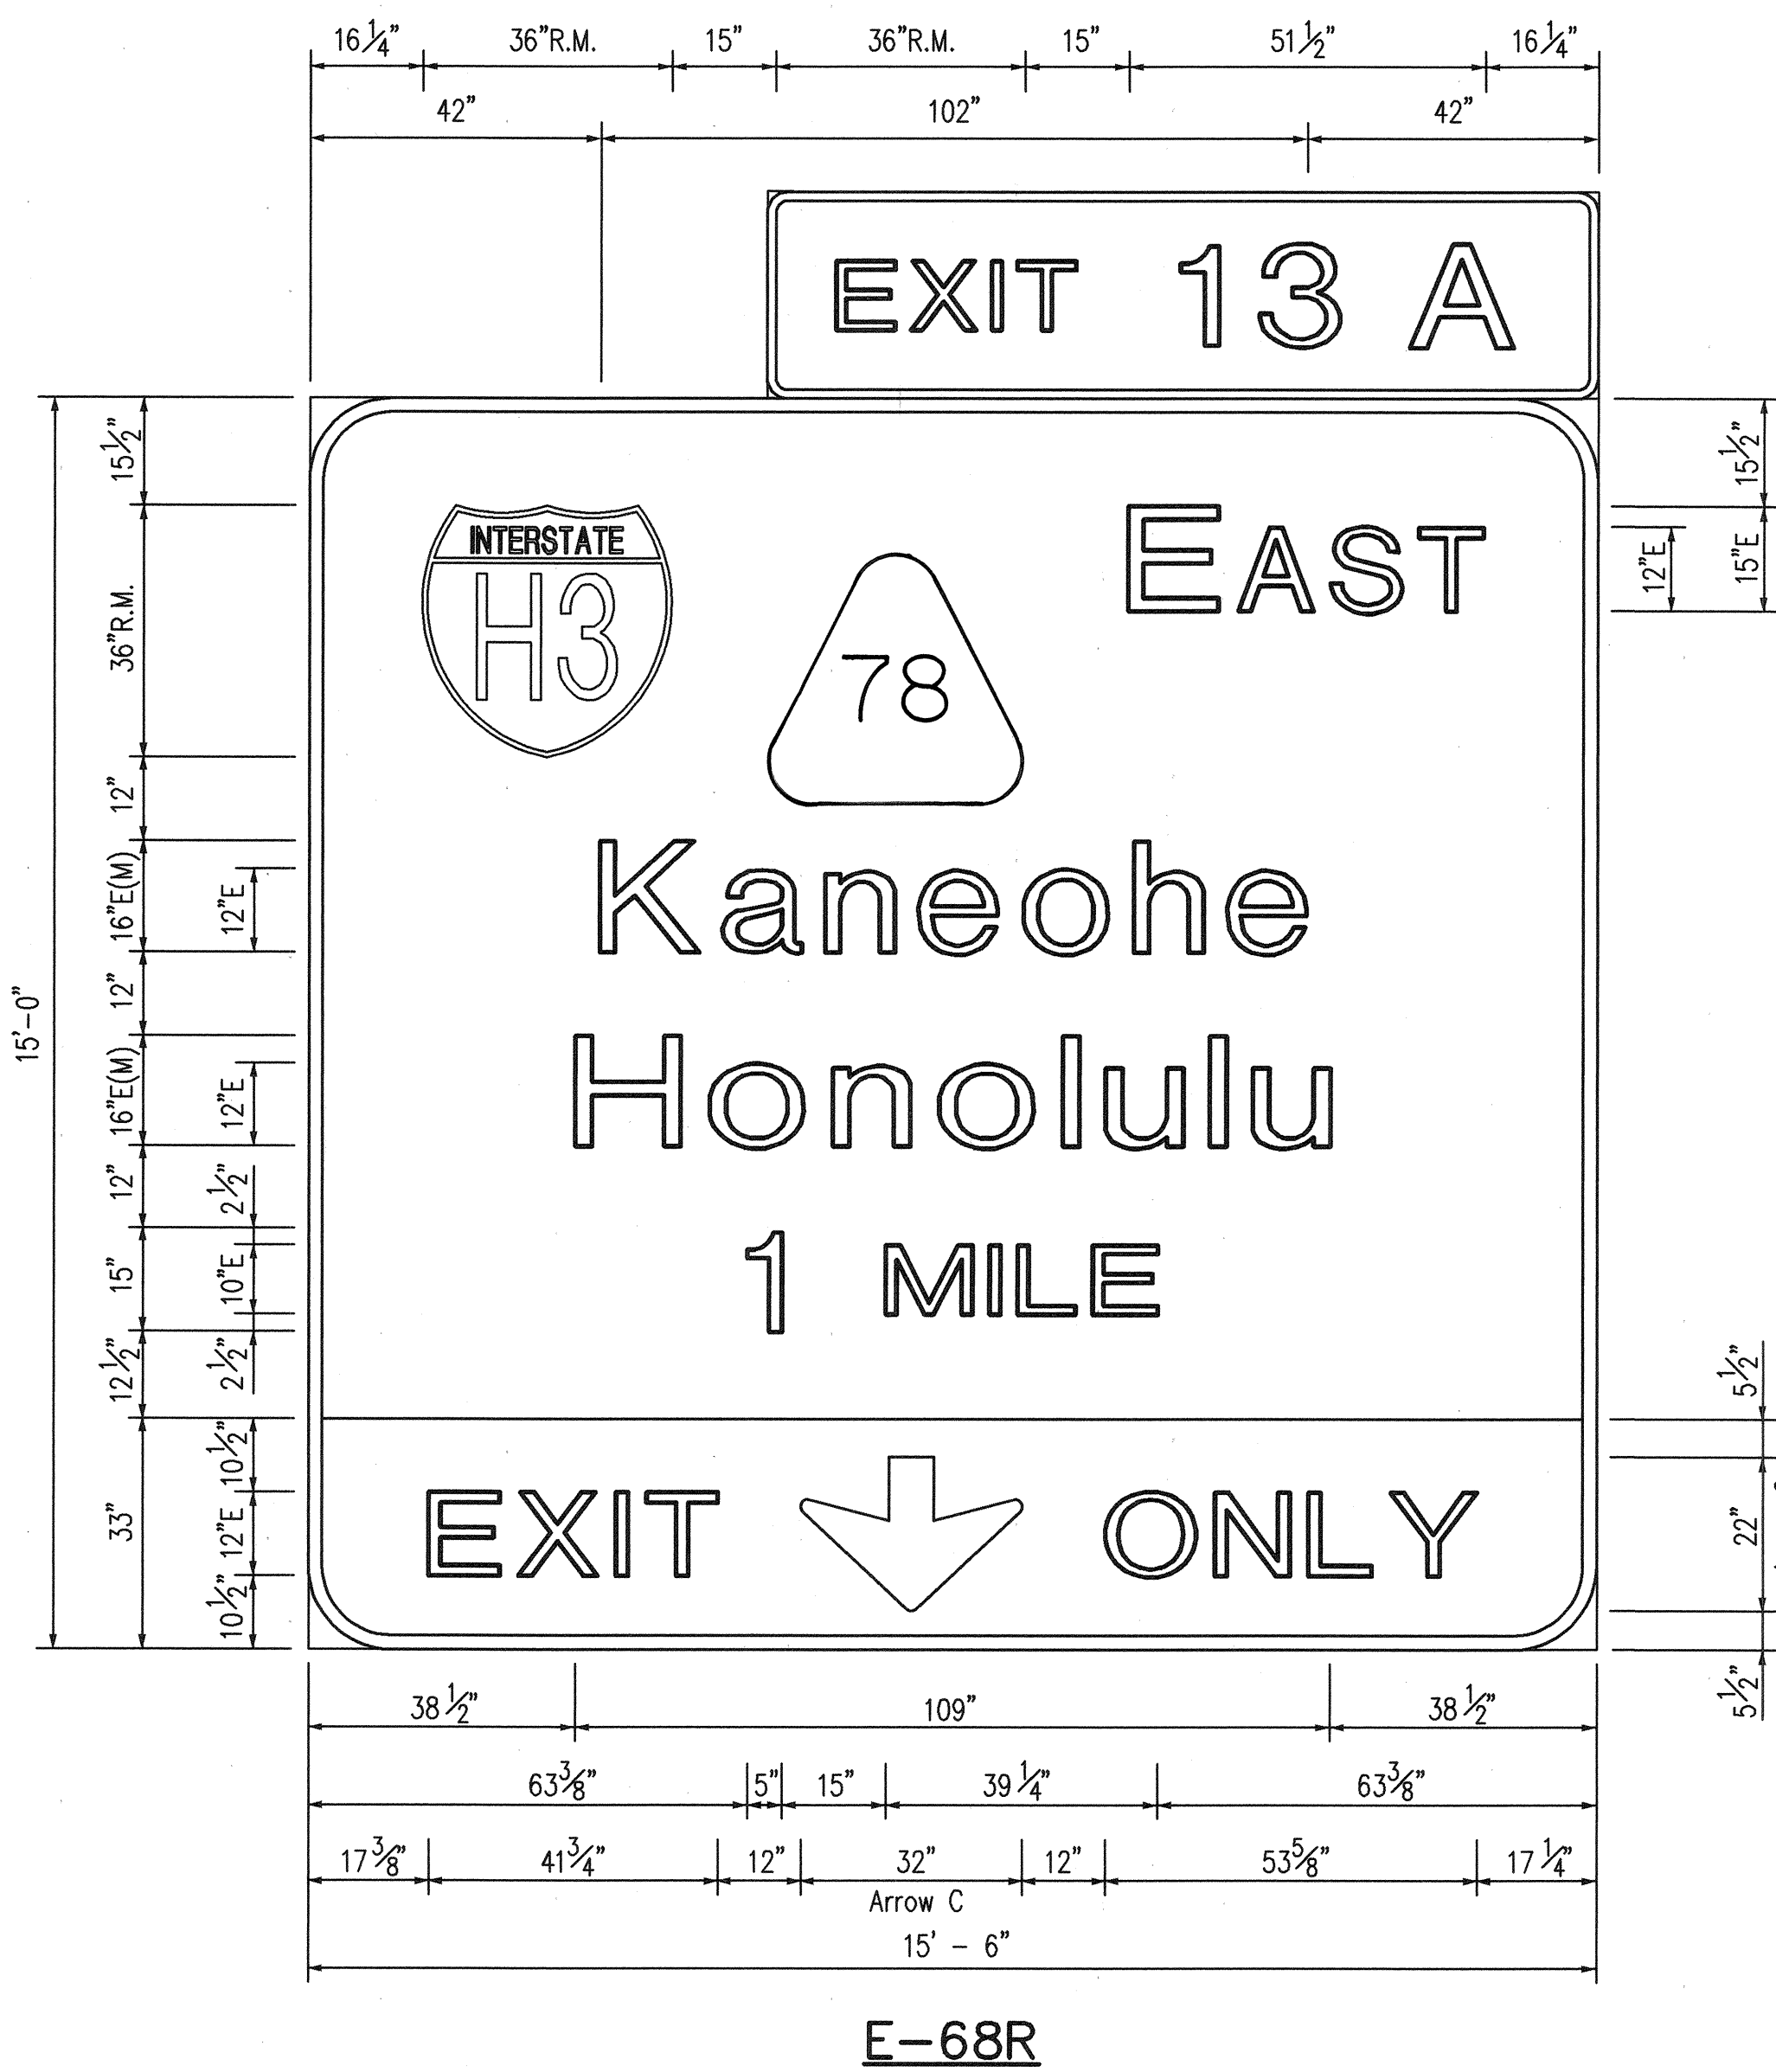

THIS WORK WAS PREPARED BY ME
OR UNDER MY SUPERVISION.
Randall M. Urasak

STATE OF HAWAII
DEPARTMENT OF TRANSPORTATION
HIGHWAYS DIVISION


DESTINATION SIGNS
SIGN DETAILS
H-1 WEST
H-3 FINISH (UNIT II)
FAIP NO. I-H3-1(75), UNIT II
LEEWARD SECTION

SCALE: 1/2" = 1'-0"
DATE: JANUARY 1997
SHEET NO. 6P4 OF 20 SHEETS


ORIGINAL SURVEY PLOTTED BY	DATE
PLAN	
TRACED BY	
NOTE BOOK	
DESIGNED BY	
DRAWN BY	
CHECKED BY	
No.	

CAD by J. MIMURA, 55-52


FED. ROAD DIST. NO.	STATE	FED. AID PROJ. NO.	FISCAL YEAR	SHEET NO.	TOTAL SHEETS
HAWAII	HAW.	I-H3-1(75), UNIT II	1997	855	1102

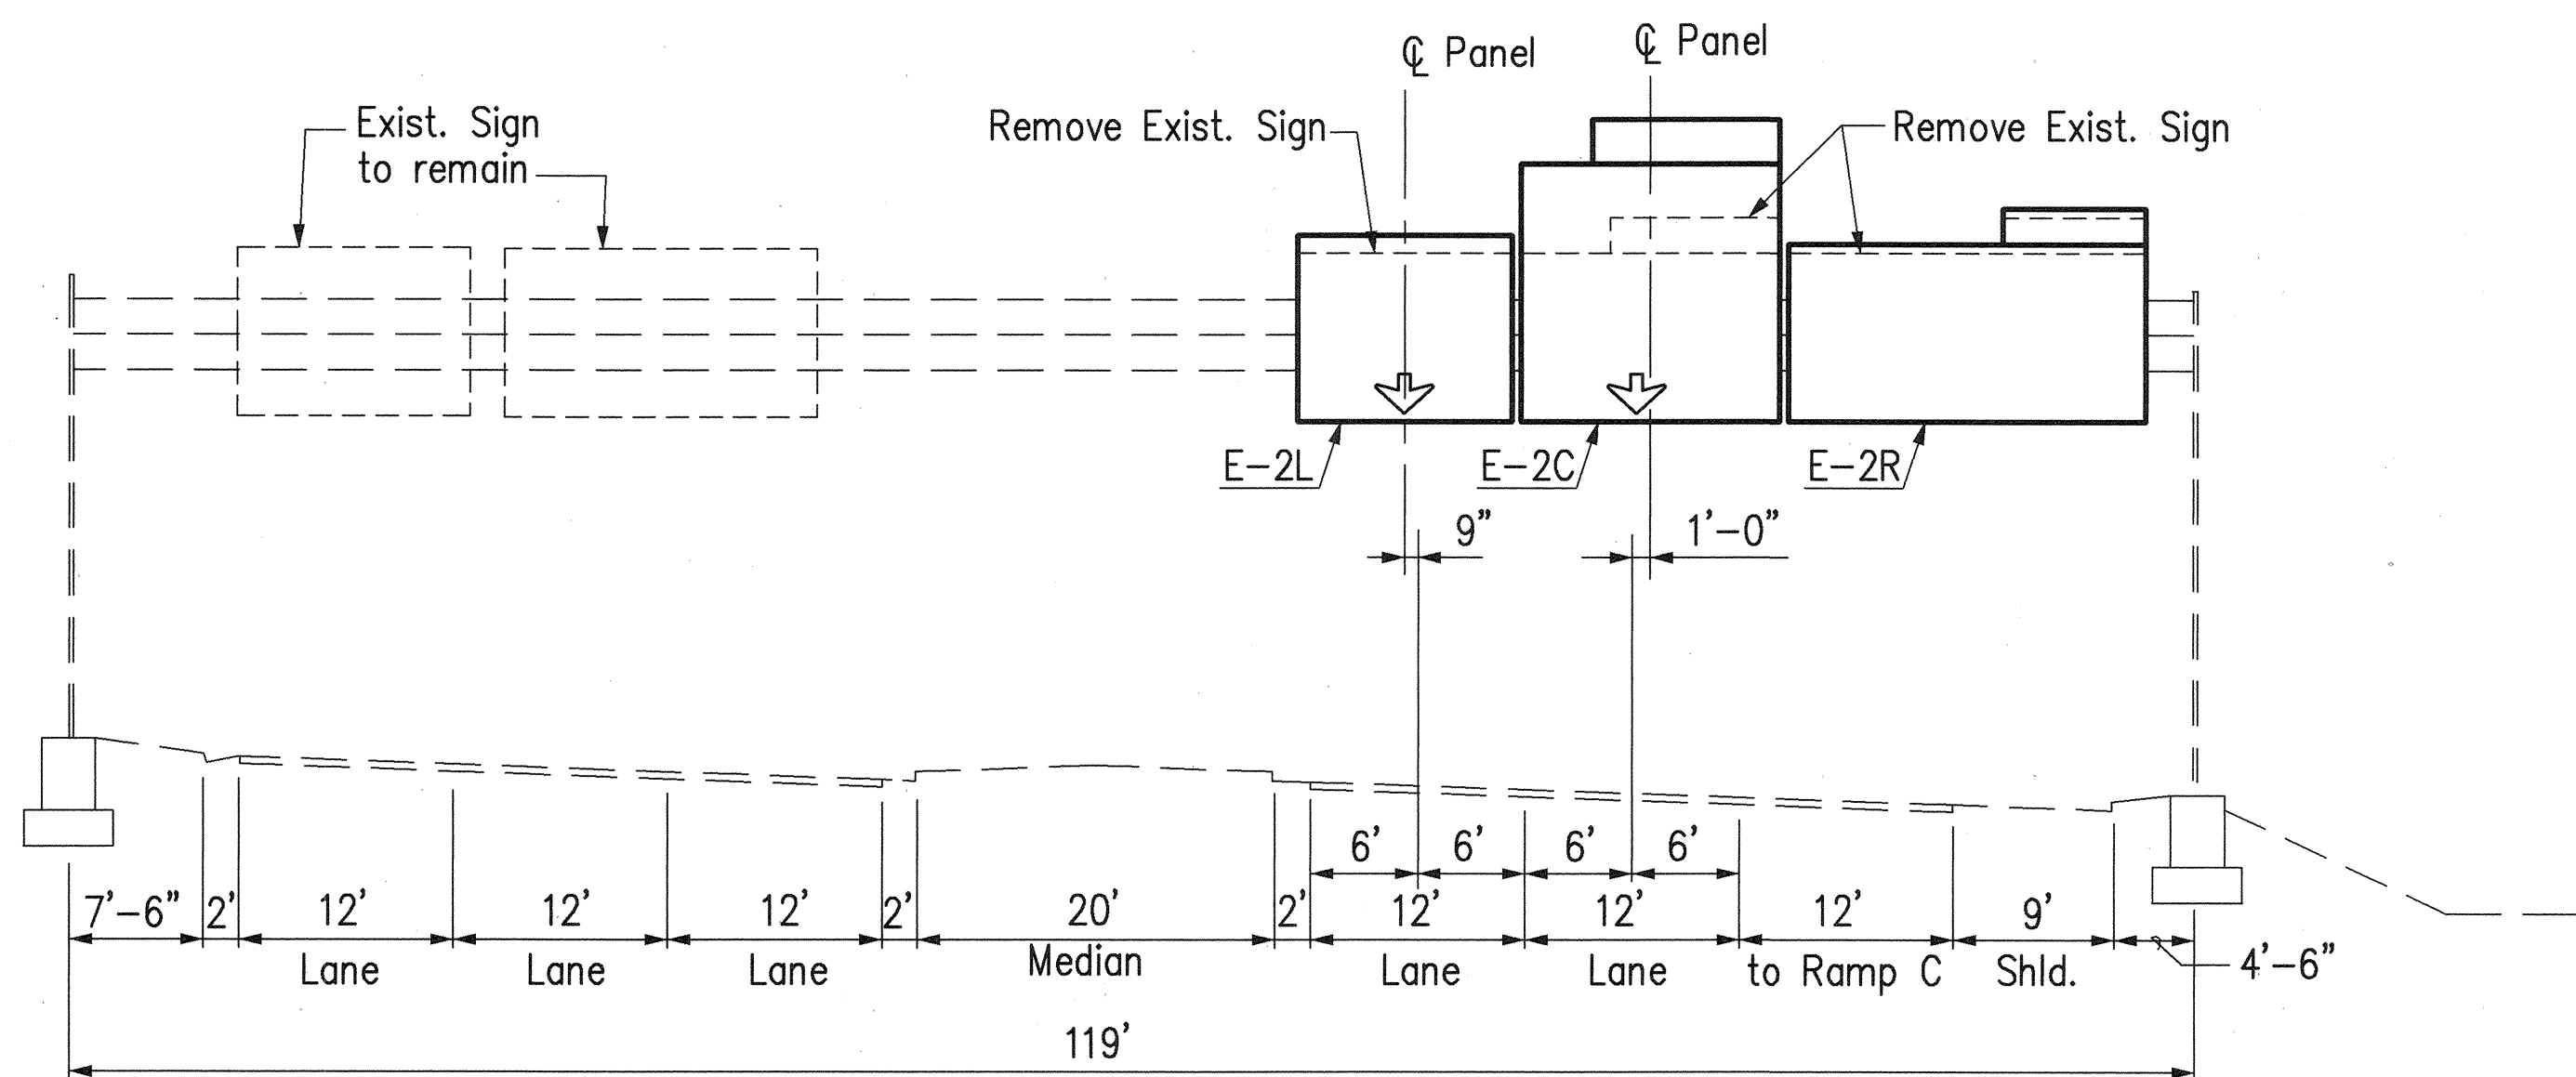

SIGN LAYOUT E-2L, E-2C & E-2R
Moanalua Freeway Inbound Sta. 136+80

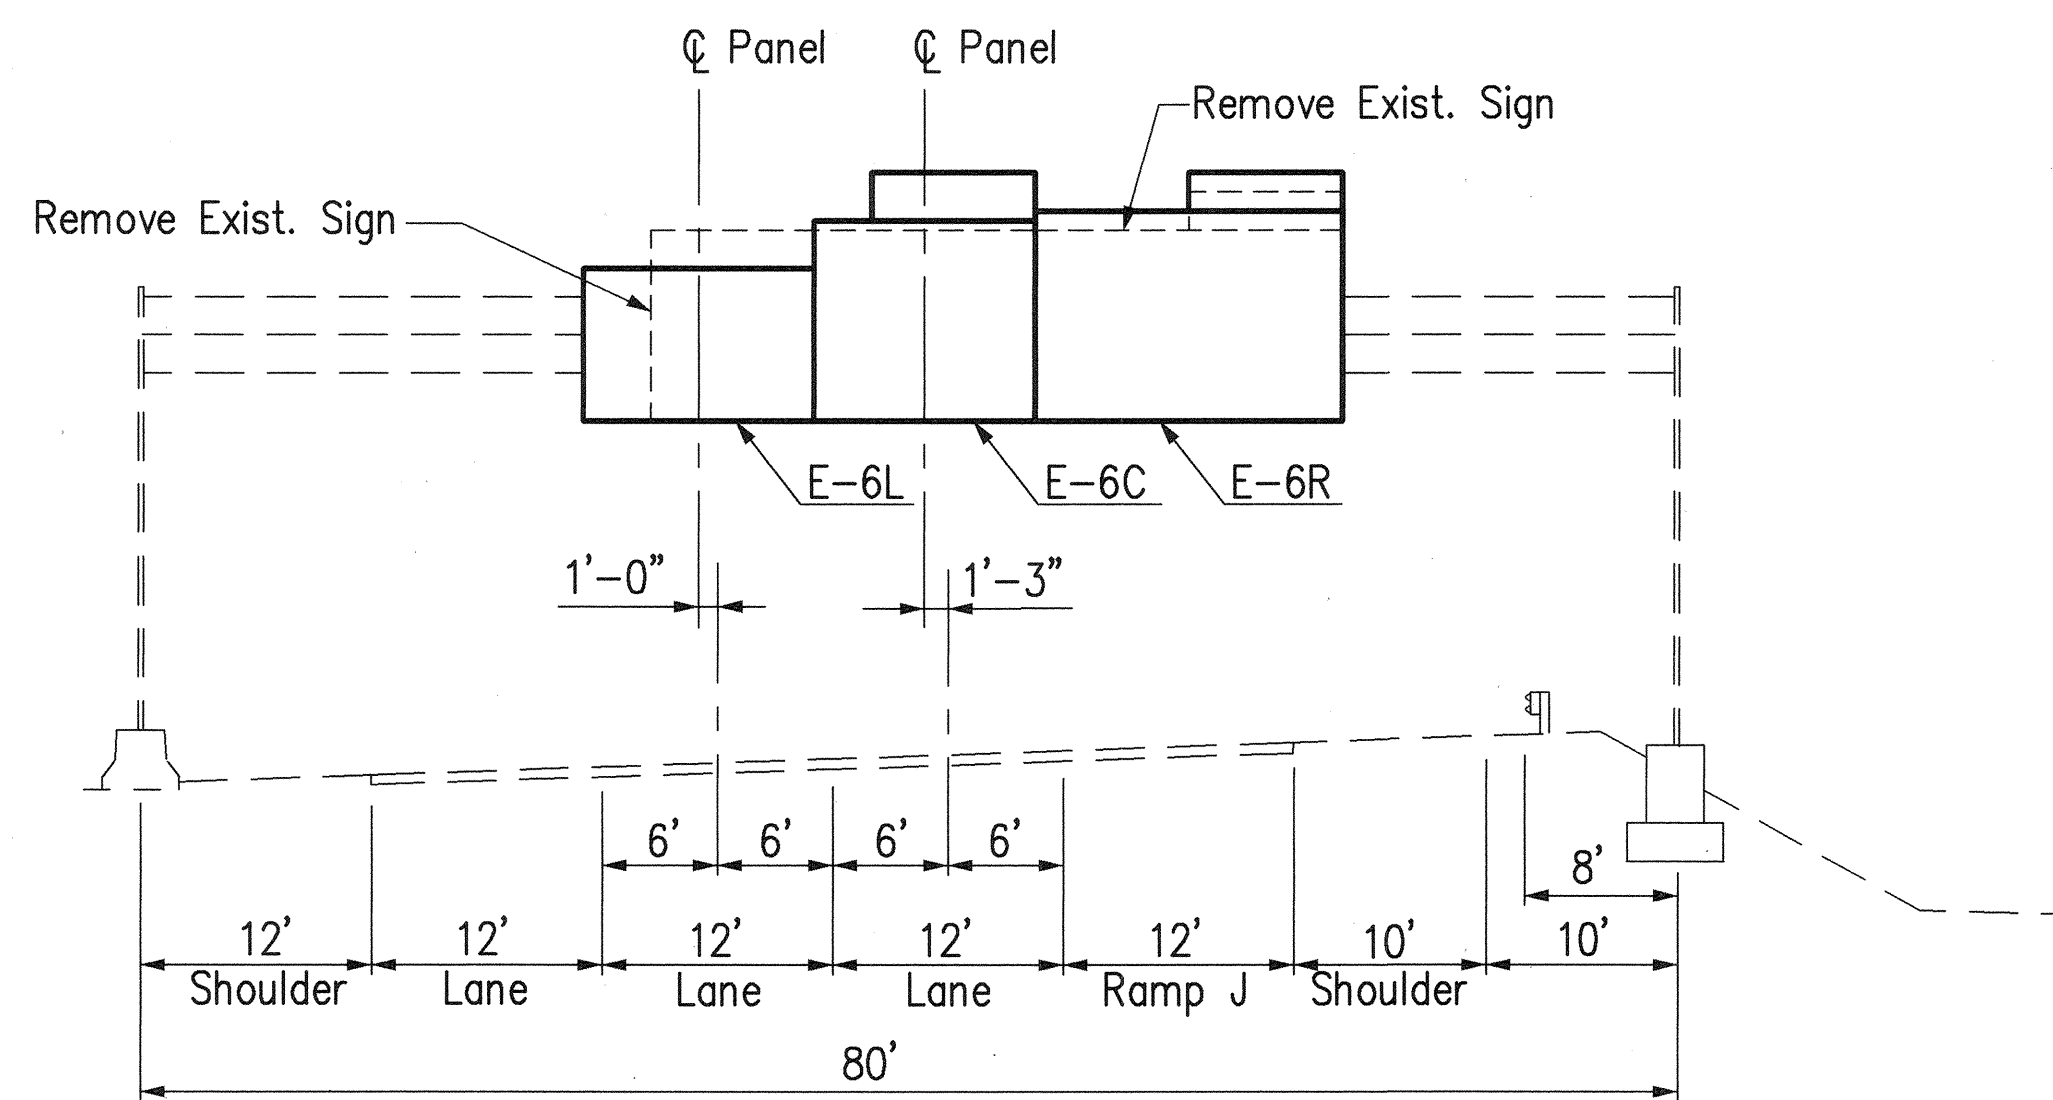


SIGN LAYOUT E-6L, E-6C & E-6R
Moanalua Freeway Inbound Sta. 158+90

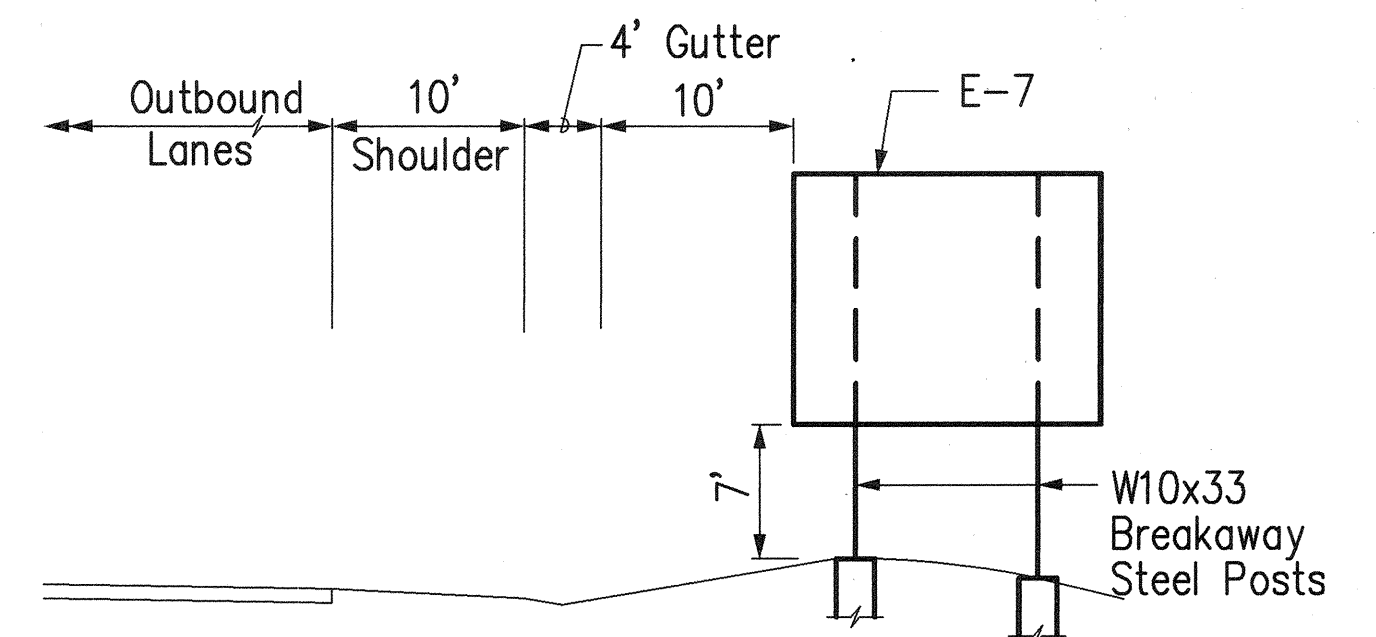


NOTE FOR SIGN E-7:
1. Remove and dispose existing sign, posts, and footings.


SIGN LAYOUT E-7
Interstate Route H-1 Outbound Sta. 59+00

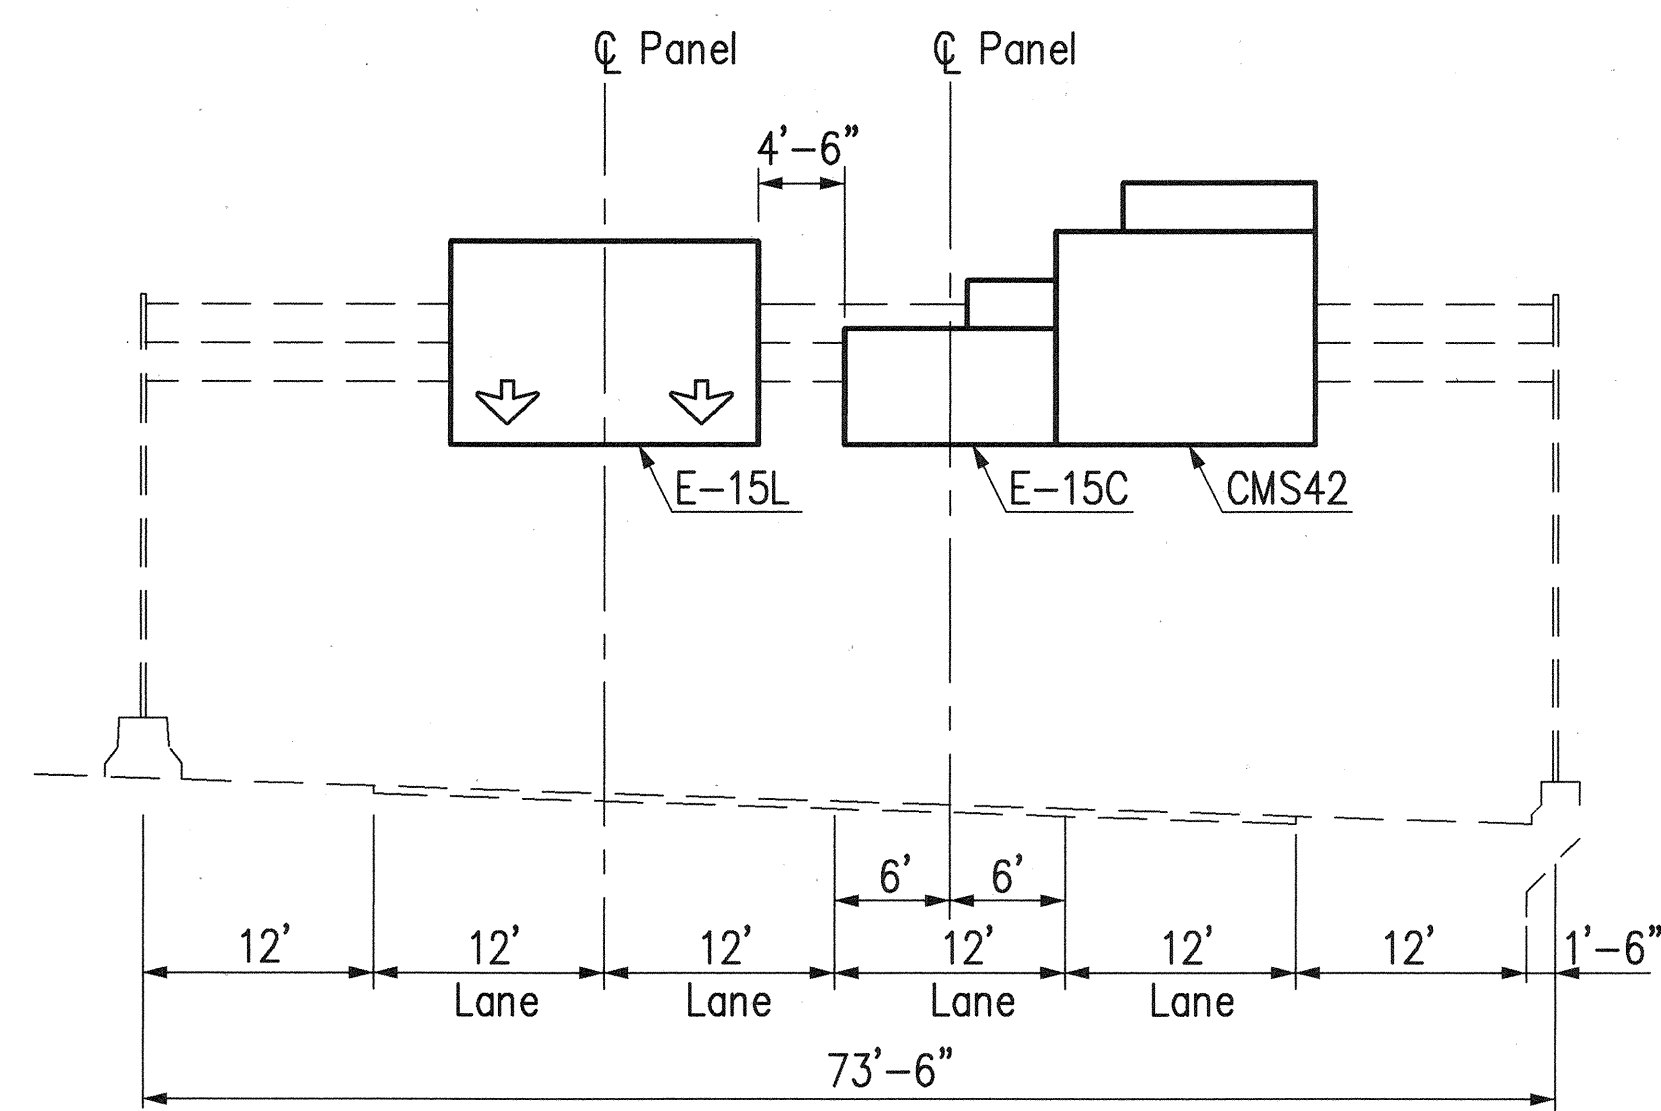

SIGN LAYOUT E-15L, E-15C & CMS42
Moanalua Freeway Inbound Sta. 188+10

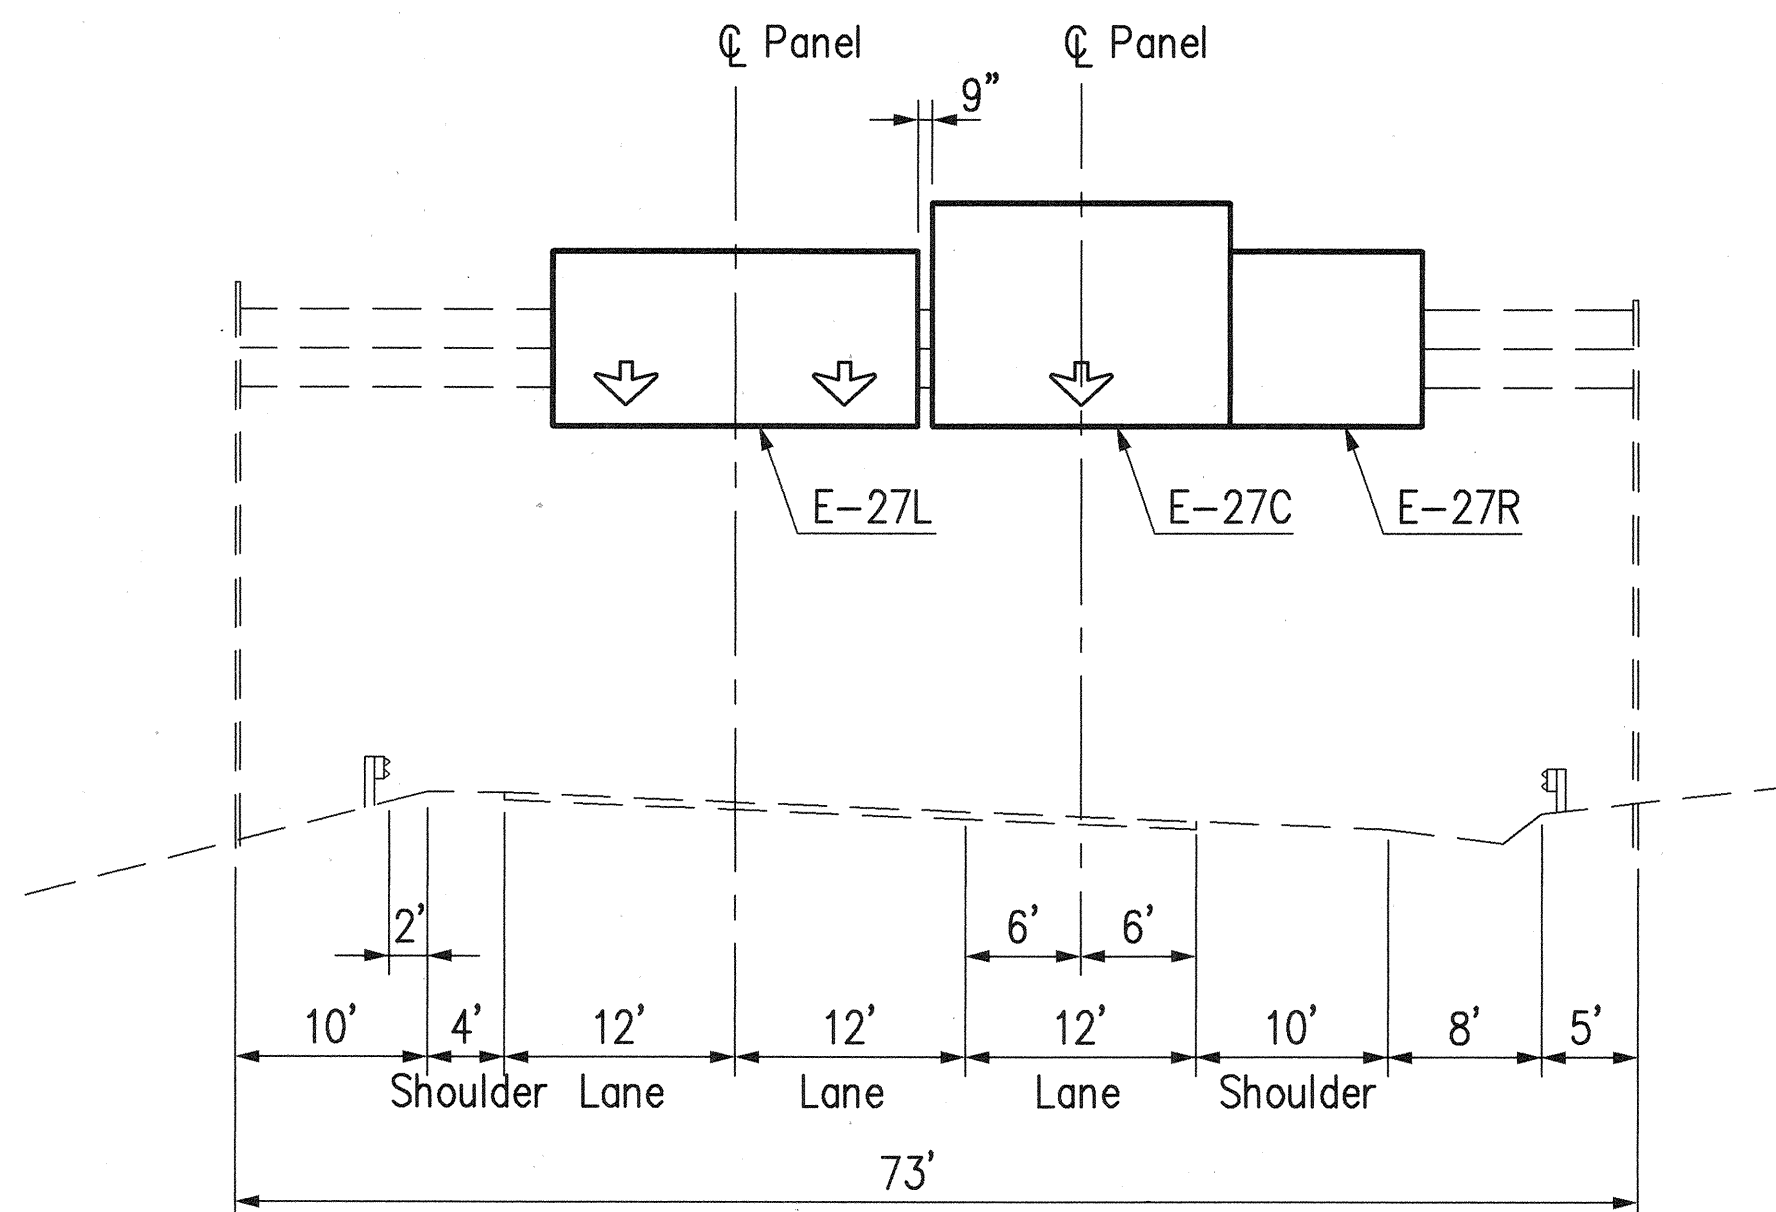


SIGN LAYOUT E-27L, E-27C & E-27R
Ulune Extension Sta. 34+35

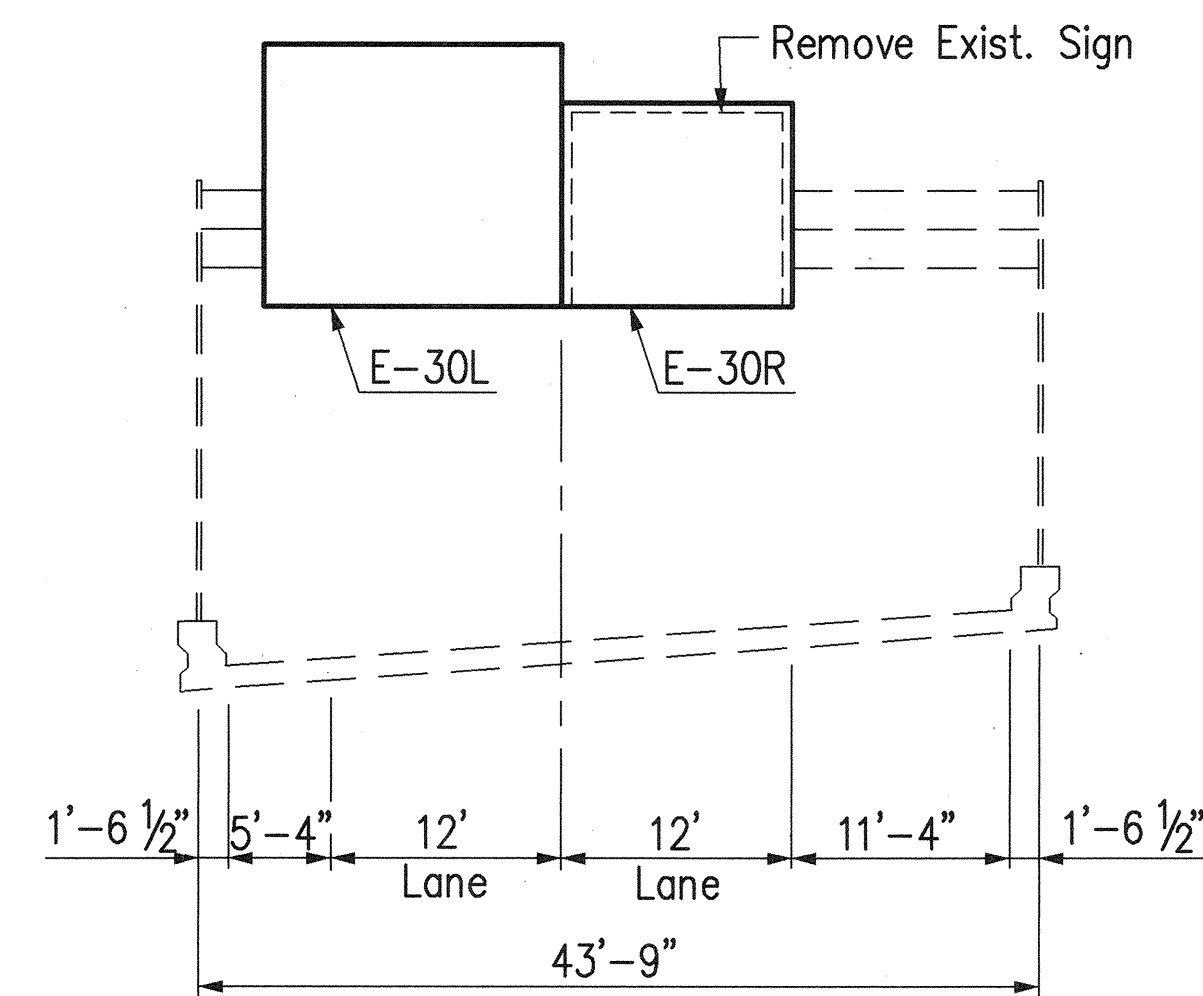

SIGN LAYOUT E-30L & E-30R
Ramp WE Sta. 225+25

Note: Exit Sign Panels on top of CMS Signs, shall be adjacent to the right beacon. (Looking at Sign)

ORIGINAL SURVEY PLOTTED BY: _____
DATE: _____
DRAWN BY: _____
TRACED BY: _____
NOTE BOOK: _____
DESIGNED BY: _____
CHECKED BY: _____
No. _____

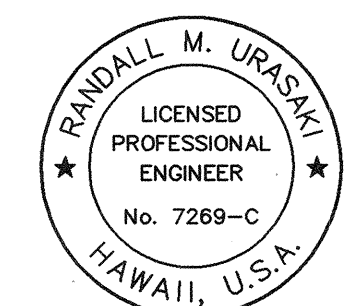

THIS WORK WAS PREPARED BY ME
OR UNDER MY SUPERVISION.
Randall M. Urasak


STATE OF HAWAII
DEPARTMENT OF TRANSPORTATION
HIGHWAYS DIVISION

**DESTINATION SIGNS
SIGN LAYOUTS
HALAWA INTERCHANGE**


H-3 FINISH (UNIT II)
FAIP NO. I-H3-1(75), UNIT II
LEEWARD SECTION

SCALE: 1" = 10' DATE: JANUARY 1997
SHEET NO. 6P5 OF 20 SHEETS


FED. ROAD DIST. NO.	STATE	FED. AID PROJ. NO.	FISCAL YEAR	SHEET NO.	TOTAL SHEETS
HAWAII	HAW.	I-H3-1(75), UNIT II	1997	856	1102

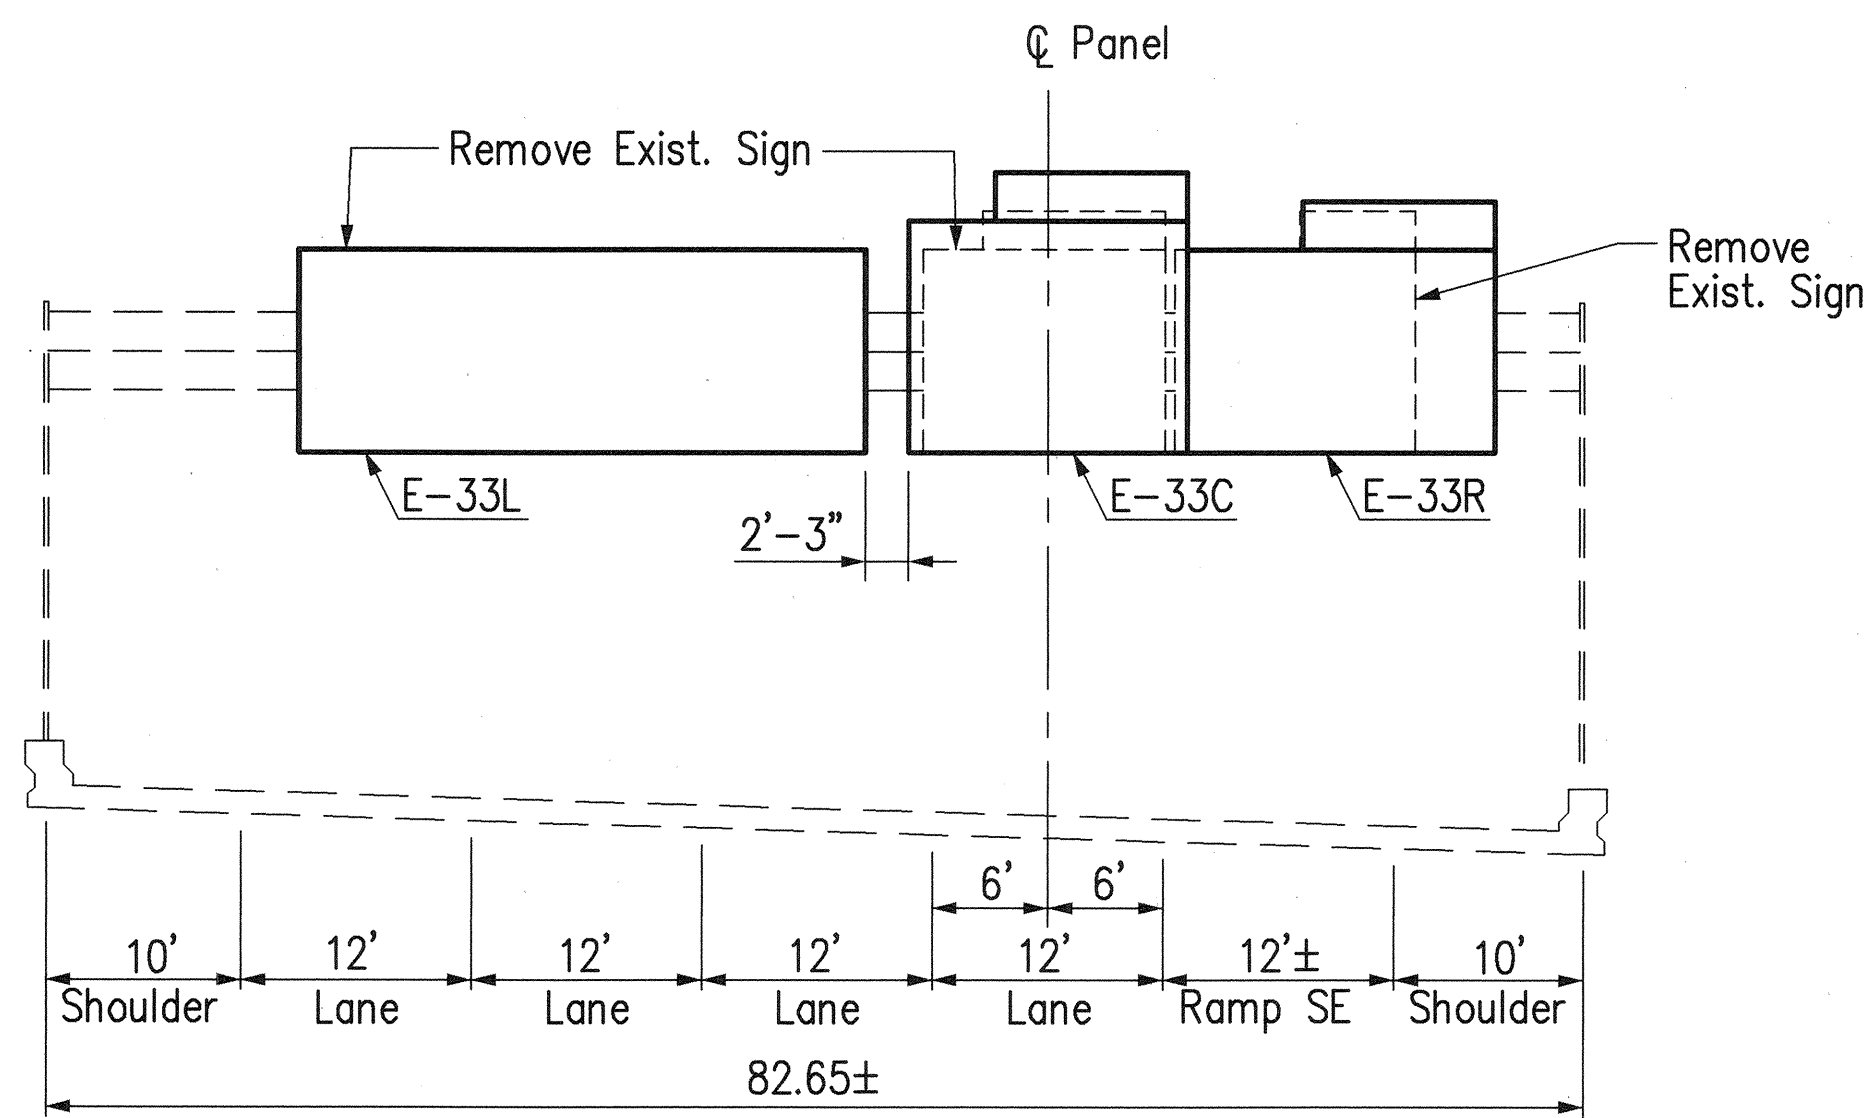

SIGN LAYOUT E-33L, E-33C & E-33R
Interstate Route H-1 Outbound Sta. 6+05

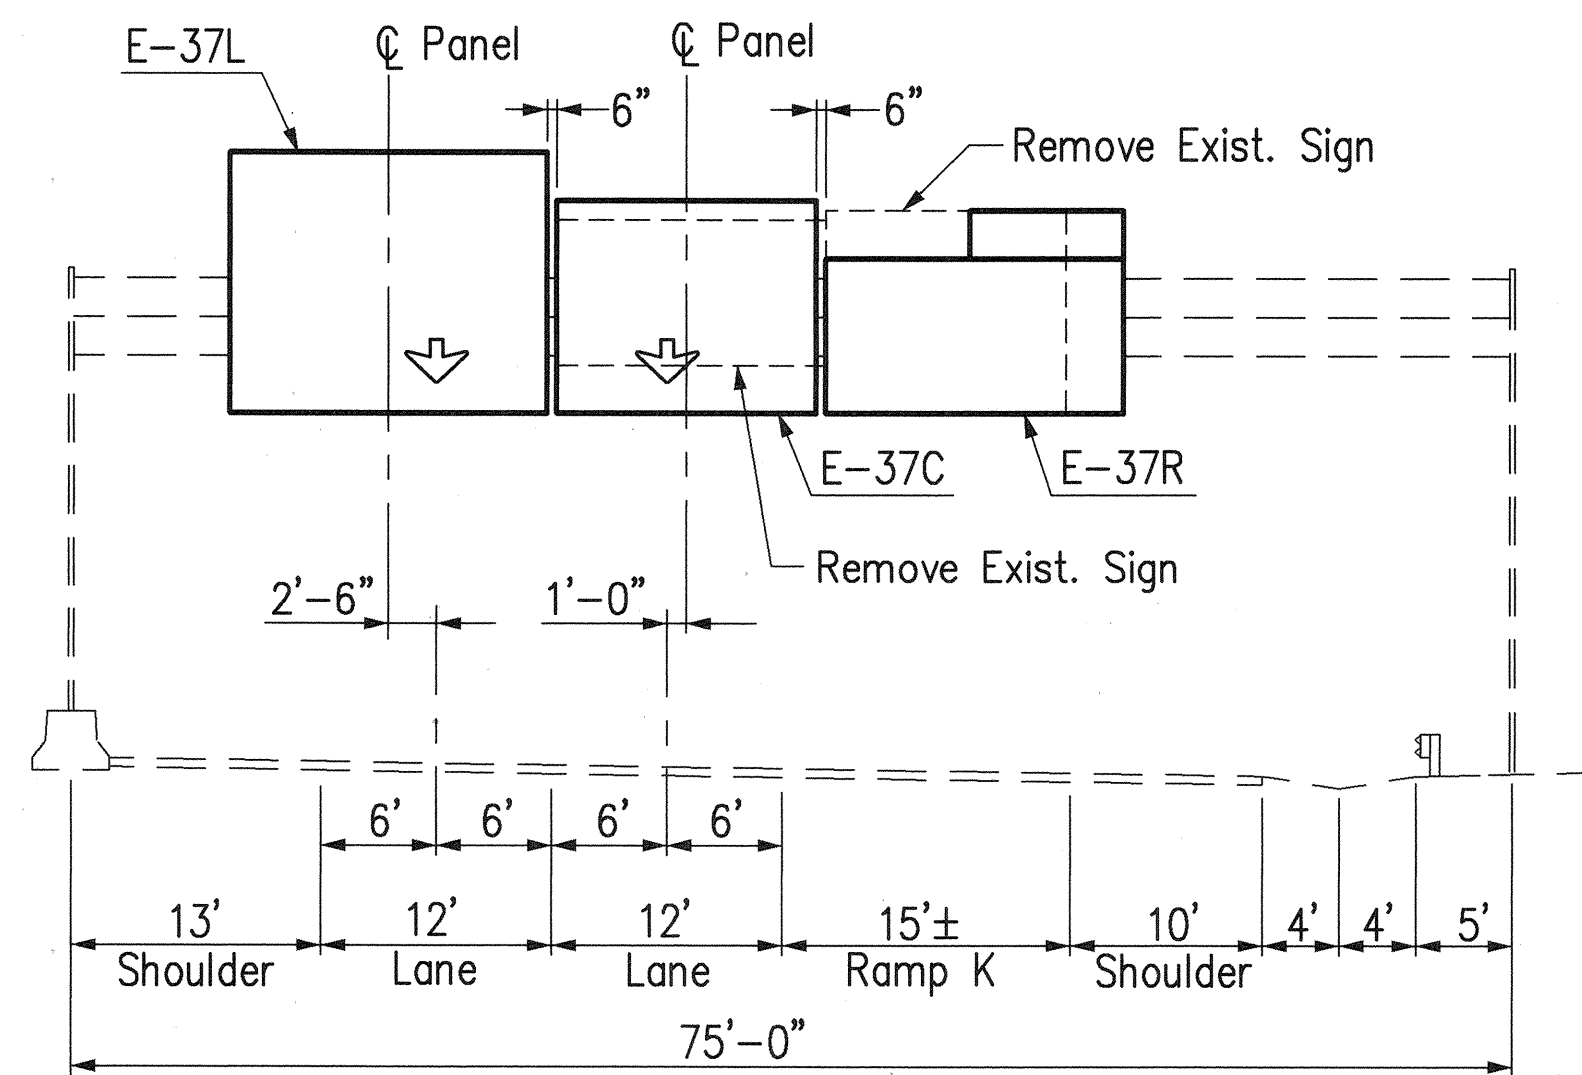


SIGN LAYOUT E-37L, E-37C & E-37R
Interstate Route H-3 Inbound Sta. 261+25

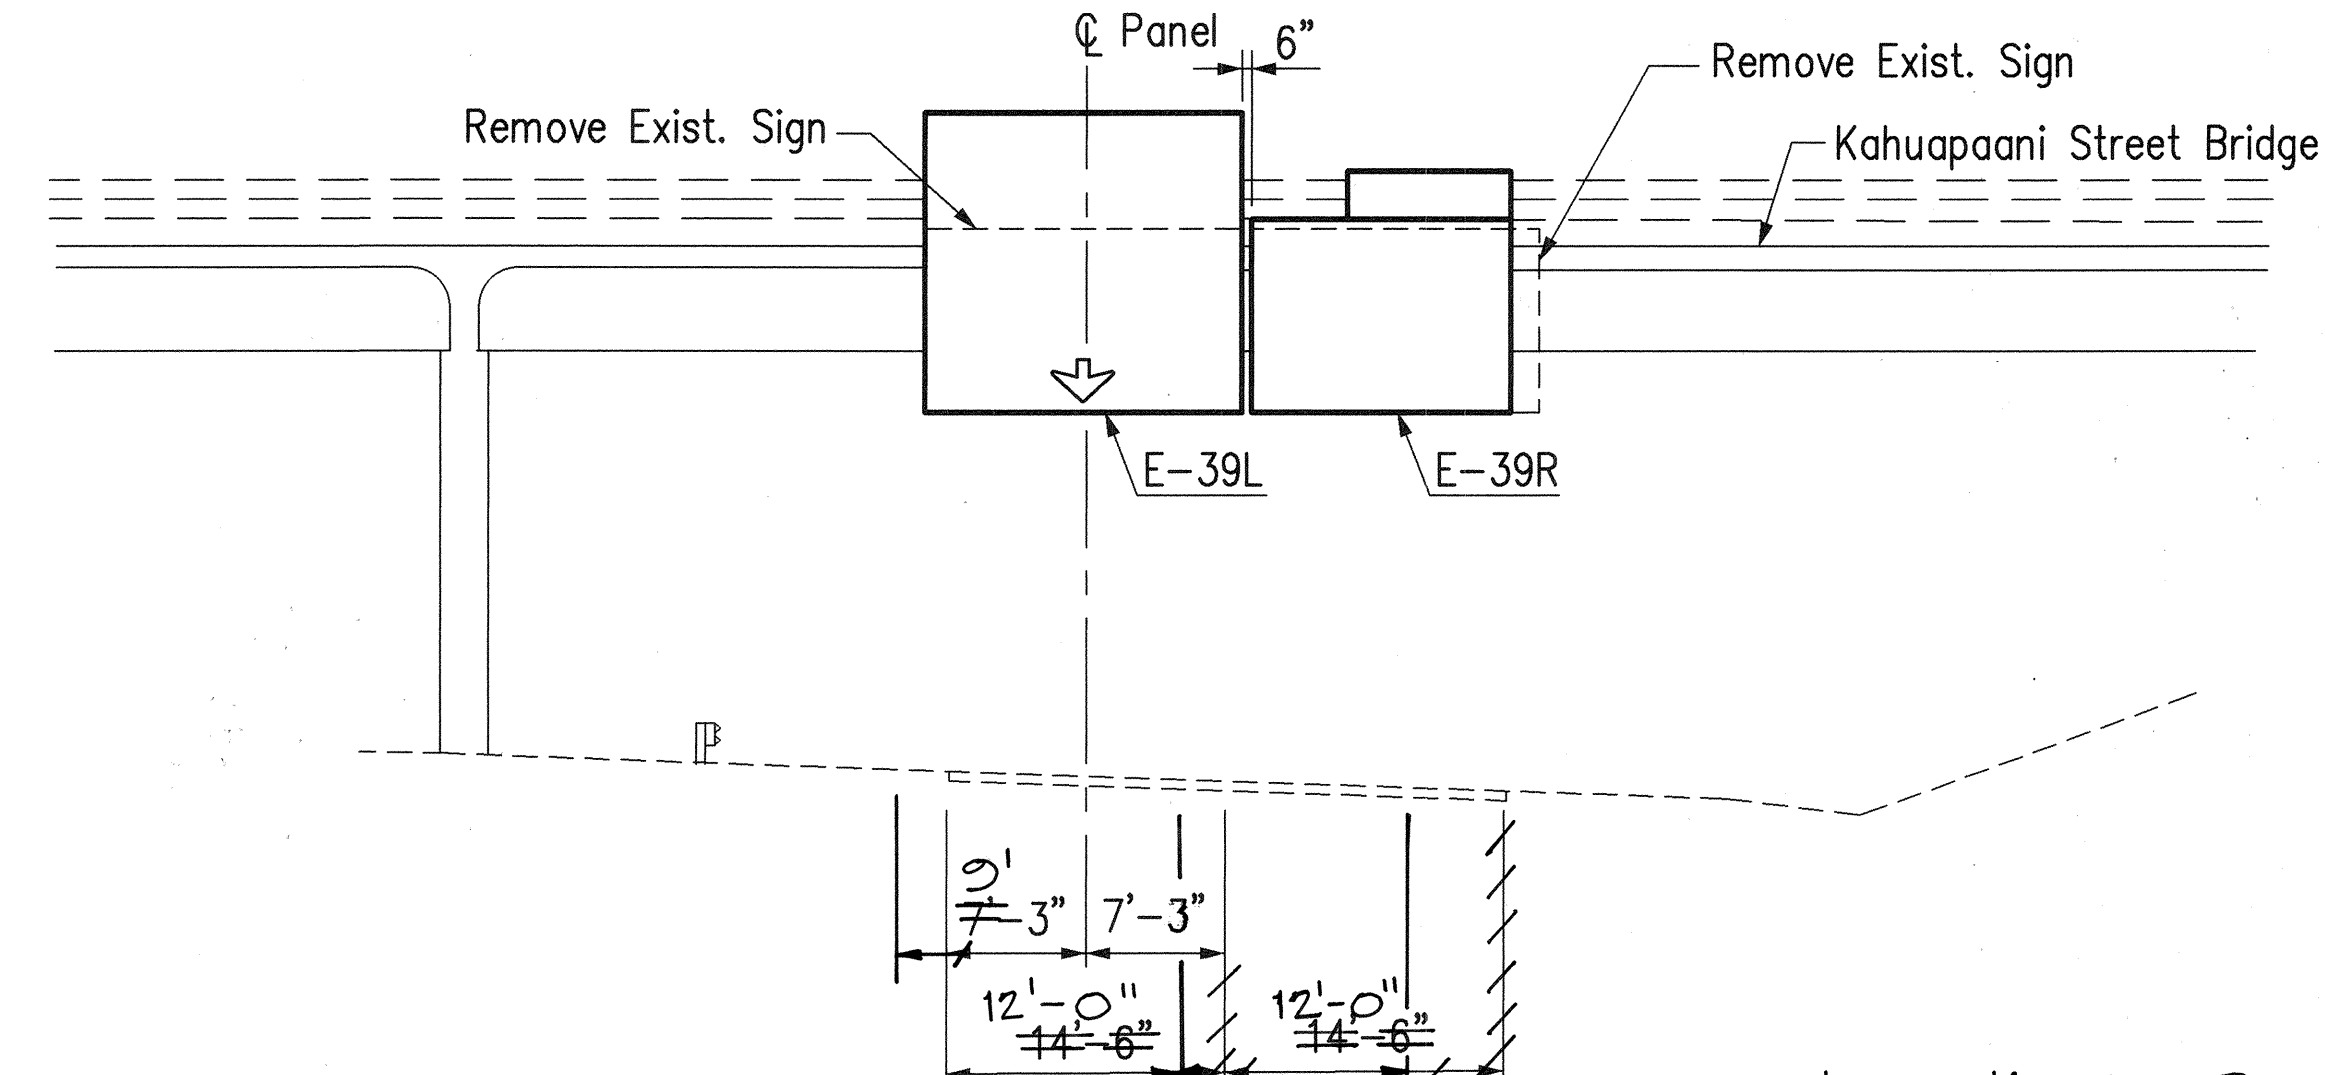


SIGN LAYOUT E-39L & E-39R
Ramp ES Sta. 50+13


Note: Exit Sign Panels on top of CMS Signs, shall be adjacent to the right beacon. (Looking at Sign)

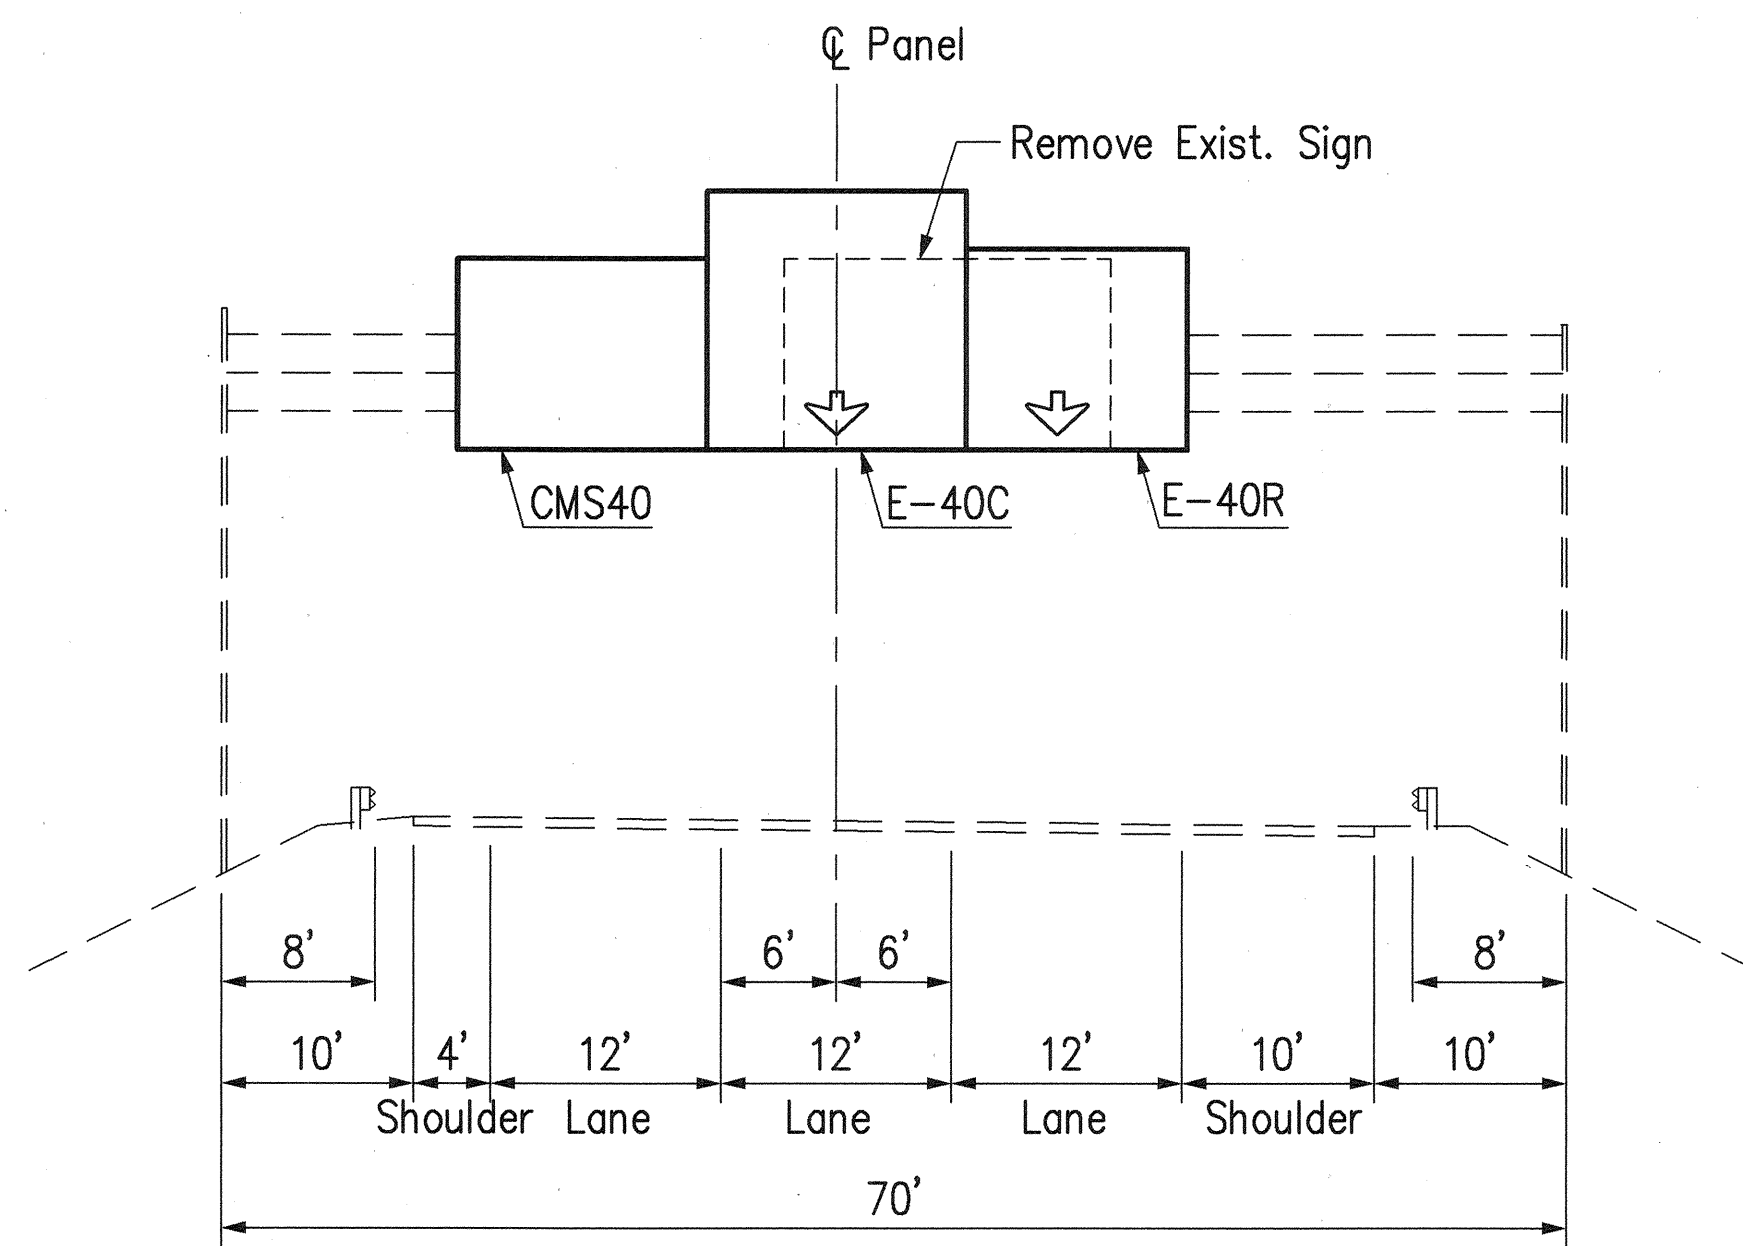

SIGN LAYOUT CMS40, E-40C & E-40R
Ramp WE Sta. 244+25

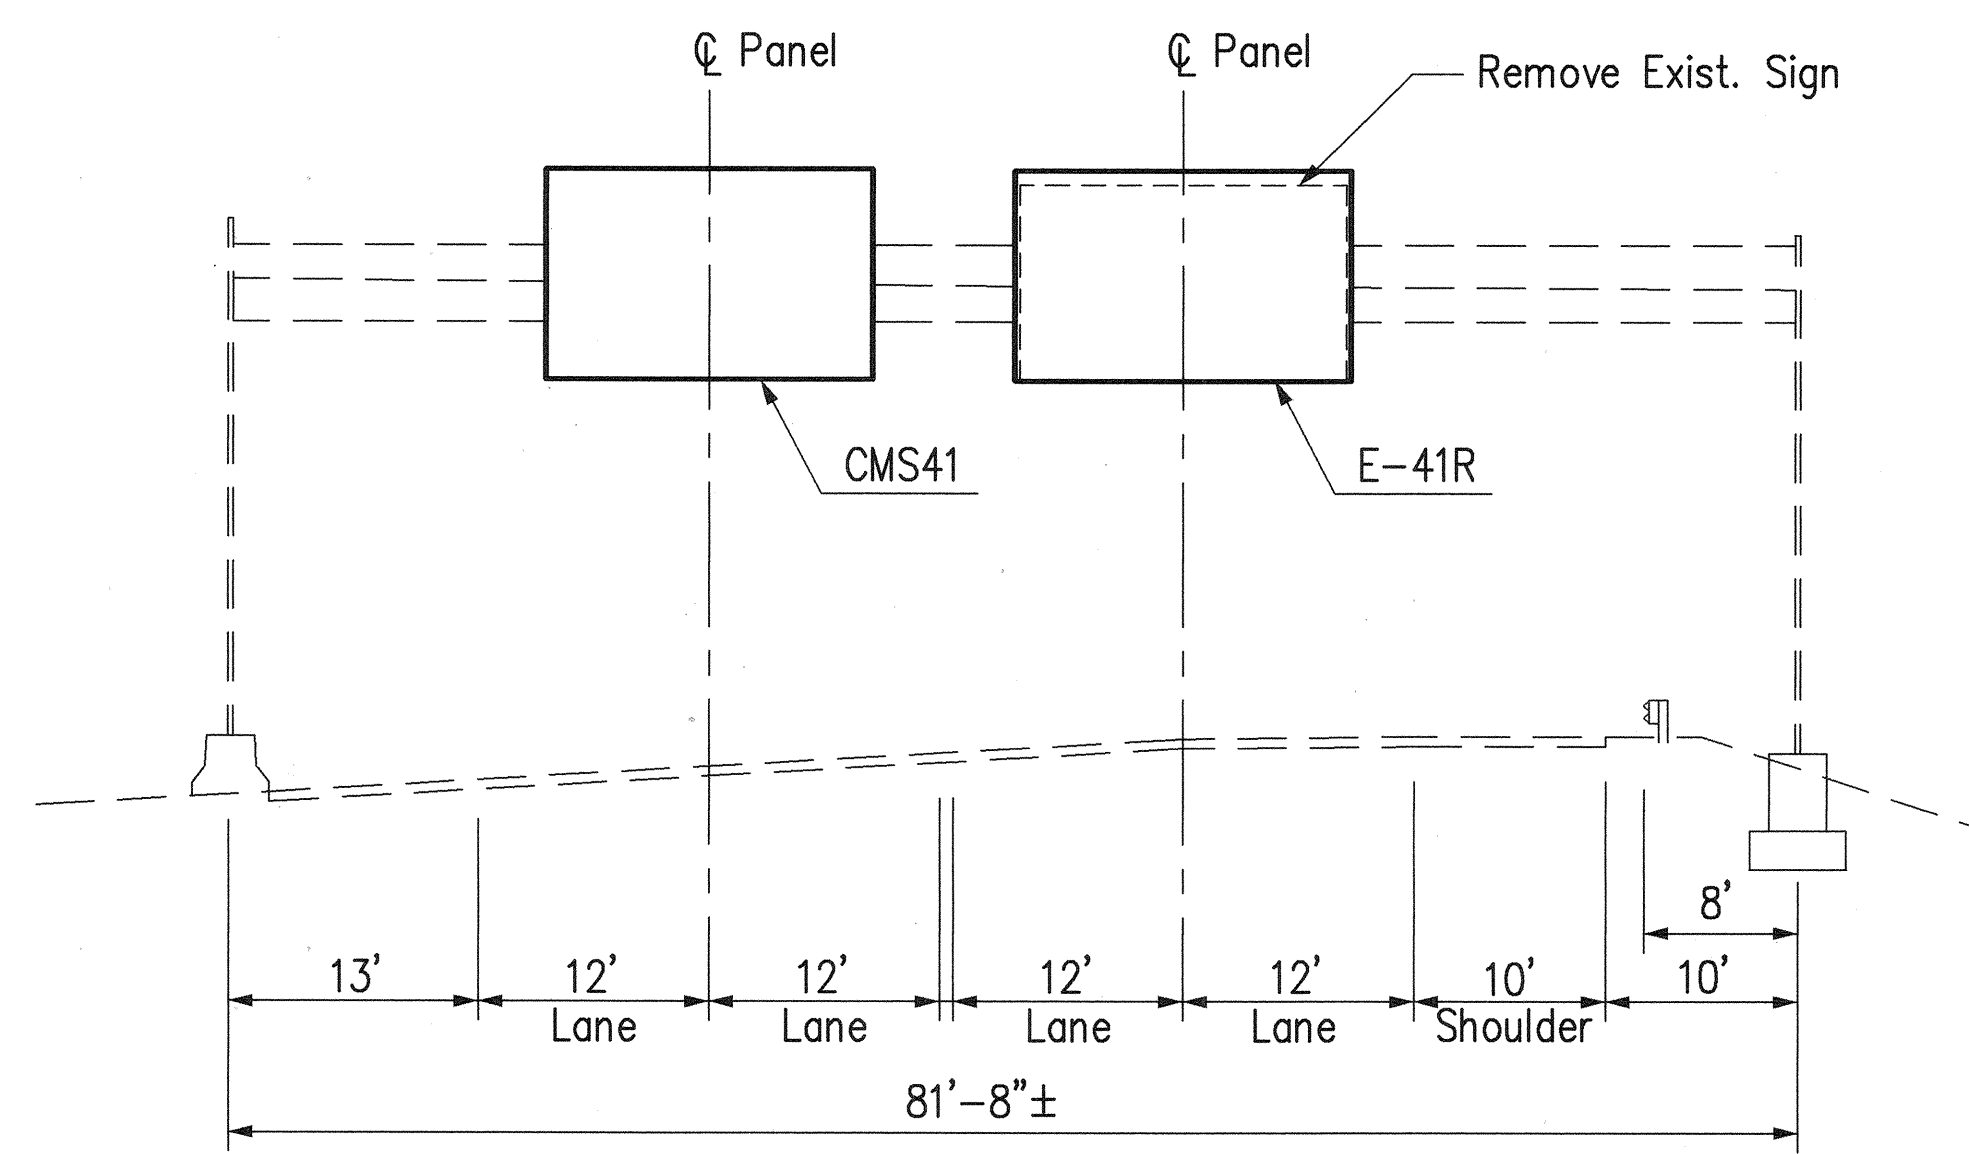


SIGN LAYOUT CMS41 & E-41R
Ramp P Sta. 12+00

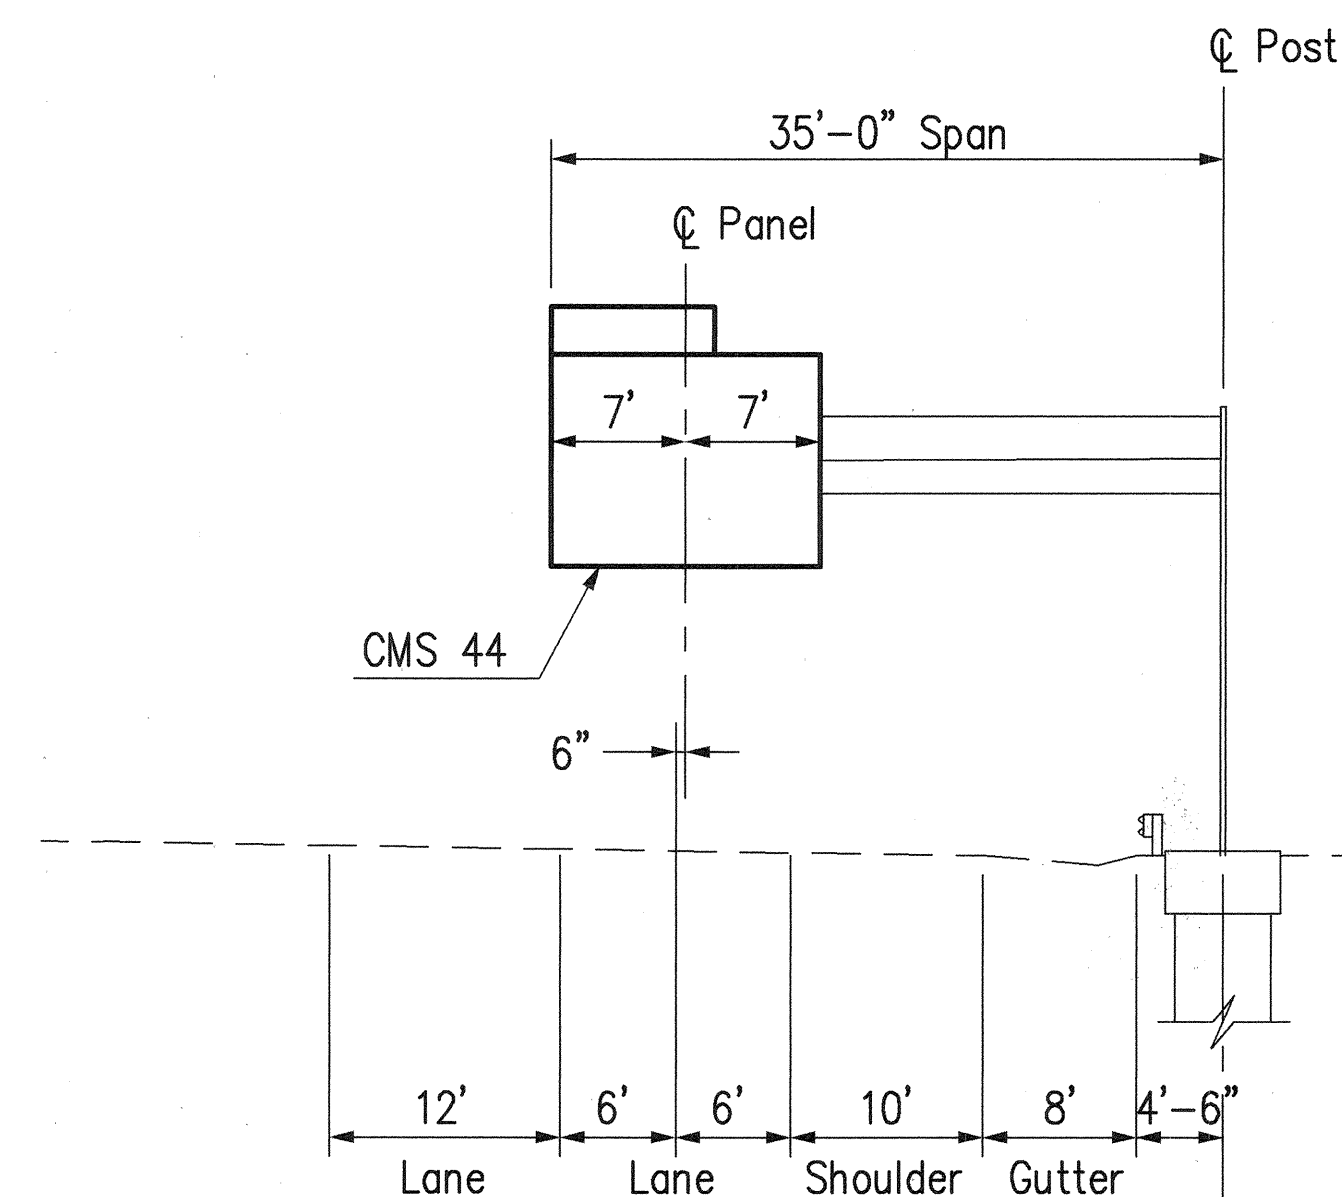

SIGN LAYOUT CMS 44
Moanalua Freeway Inbound Sta. 181+00

DATE: _____
SURVEY PLOTTED BY: _____
DRAWN BY: _____
TRACED BY: _____
DESIGNED BY: _____
CHECKED BY: _____
No. _____

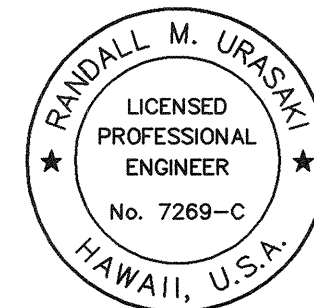

THIS WORK WAS PREPARED BY ME
OR UNDER MY SUPERVISION.

Randall M. Urasaki


STATE OF HAWAII
DEPARTMENT OF TRANSPORTATION
HIGHWAYS DIVISION

DESTINATION SIGNS
SIGN LAYOUTS
HALAWA INTERCHANGE


H-3 FINISH (UNIT II)
FAIP NO. I-H3-1(75), UNIT II
LEEWARD SECTION

SCALE: 1" = 10' DATE: JANUARY 1997
SHEET NO. 6P6 OF 20 SHEETS

FED. ROAD DIST. NO.	STATE	FED. AID PROJ. NO.	FISCAL YEAR	SHEET NO.	TOTAL SHEETS
HAWAII	HAW.	I-H3-1(75), UNIT II	1997	ADD. 856S-1	1102

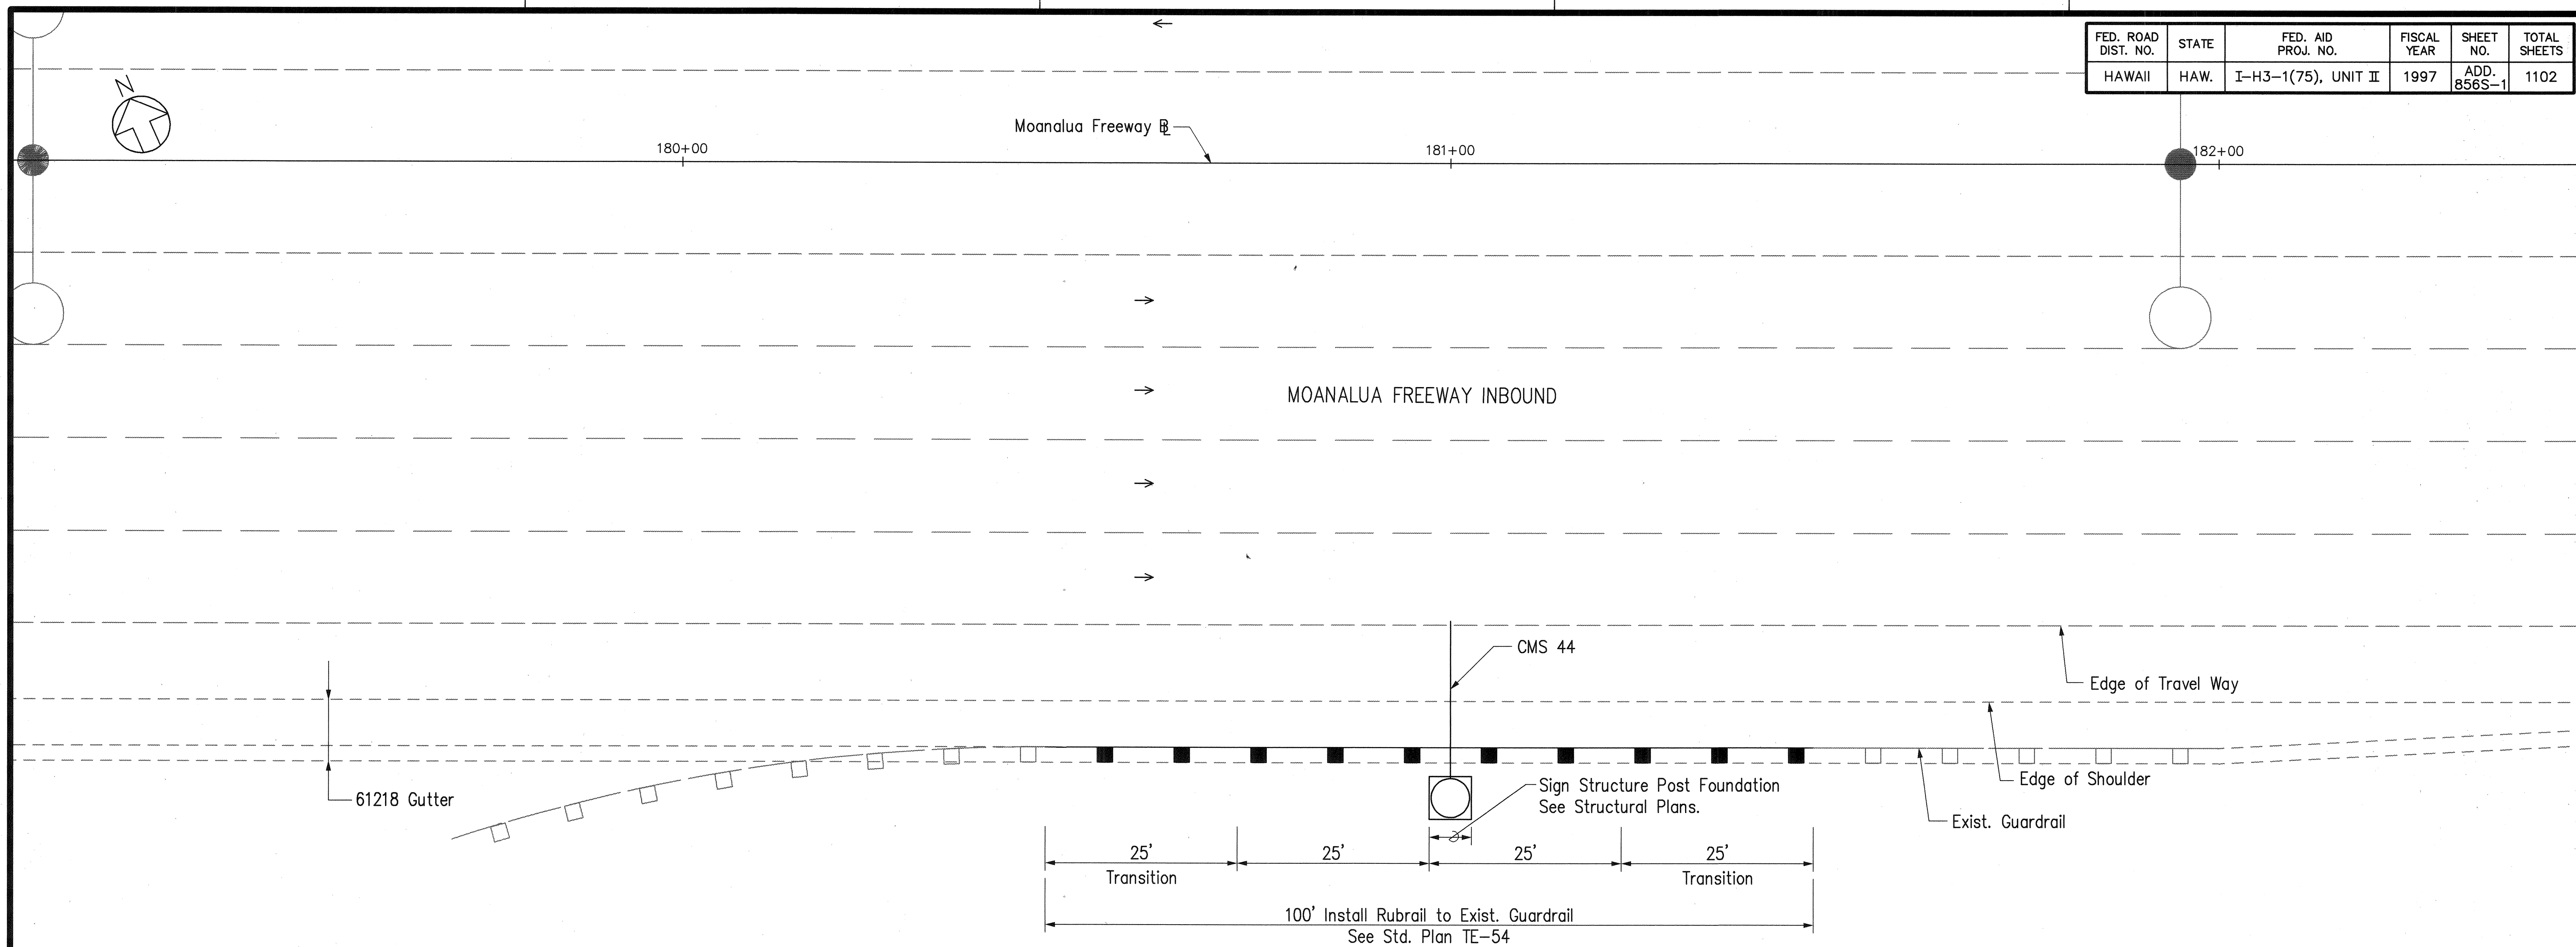


CMS 44 LOCATION PLAN

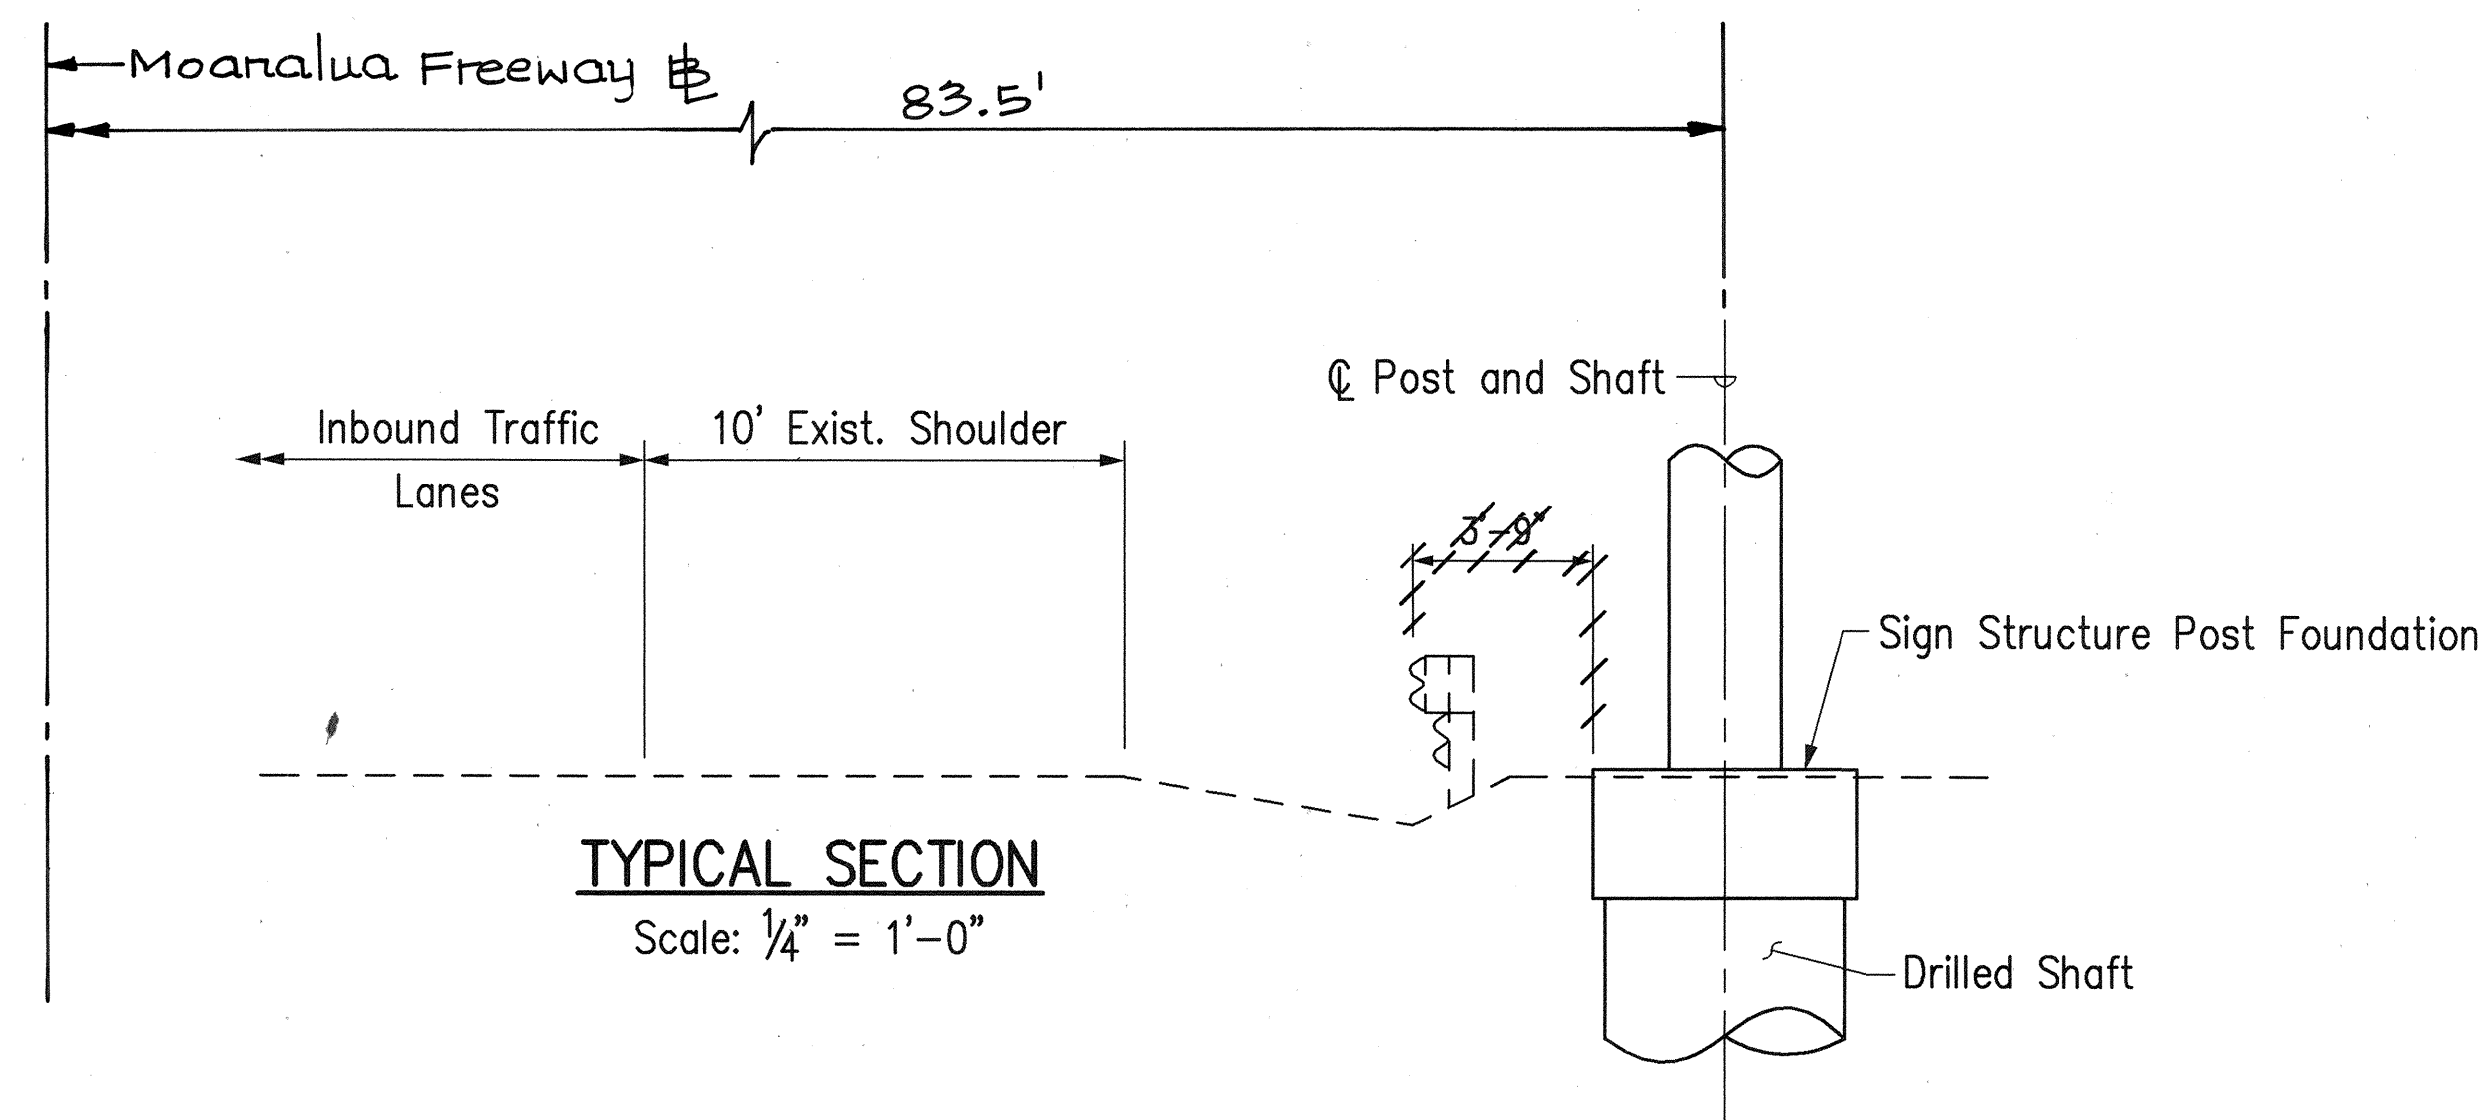

TYPICAL SECTION
Scale: 1/4" = 1'-0"

ORIGINAL SURVEY PLOTTED BY: _____ DATE: _____
 PLAN DRAWN BY: _____
 NOTE BOOK TRACED BY: _____
 DESIGNED BY: _____
 CHECKED BY: _____
 No. _____

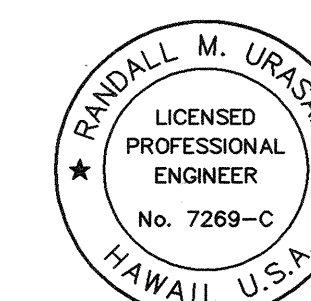

THIS WORK WAS PREPARED BY ME
OR UNDER MY SUPERVISION.






Randall M. Urasak

5/2/97	Added Sheet
Date	Revision
STATE OF HAWAII DEPARTMENT OF TRANSPORTATION HIGHWAYS DIVISION	
DESTINATION SIGNS	
ROADWAY CONSTRUCTION	
CMS44	
H-3 FINISH (UNIT II)	
FAIP NO. I-H3-1(75), UNIT II	
LEEWARD SECTION	
SCALE: 1" = 10'	DATE: MAY 1997

SHEET NO. 6P6A OF 20 SHEETS

ADD. 856S-1

FED. ROAD DIST. NO.	STATE	FED. AID PROJ. NO.	FISCAL YEAR	SHEET NO.	TOTAL SHEETS
HAWAII	HAW.	I-H3-1(75), UNIT II	1997	857	1102

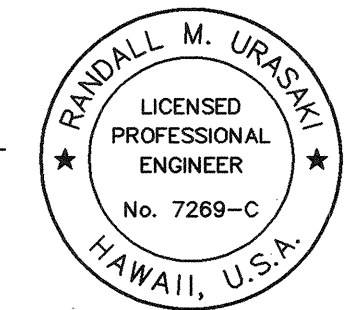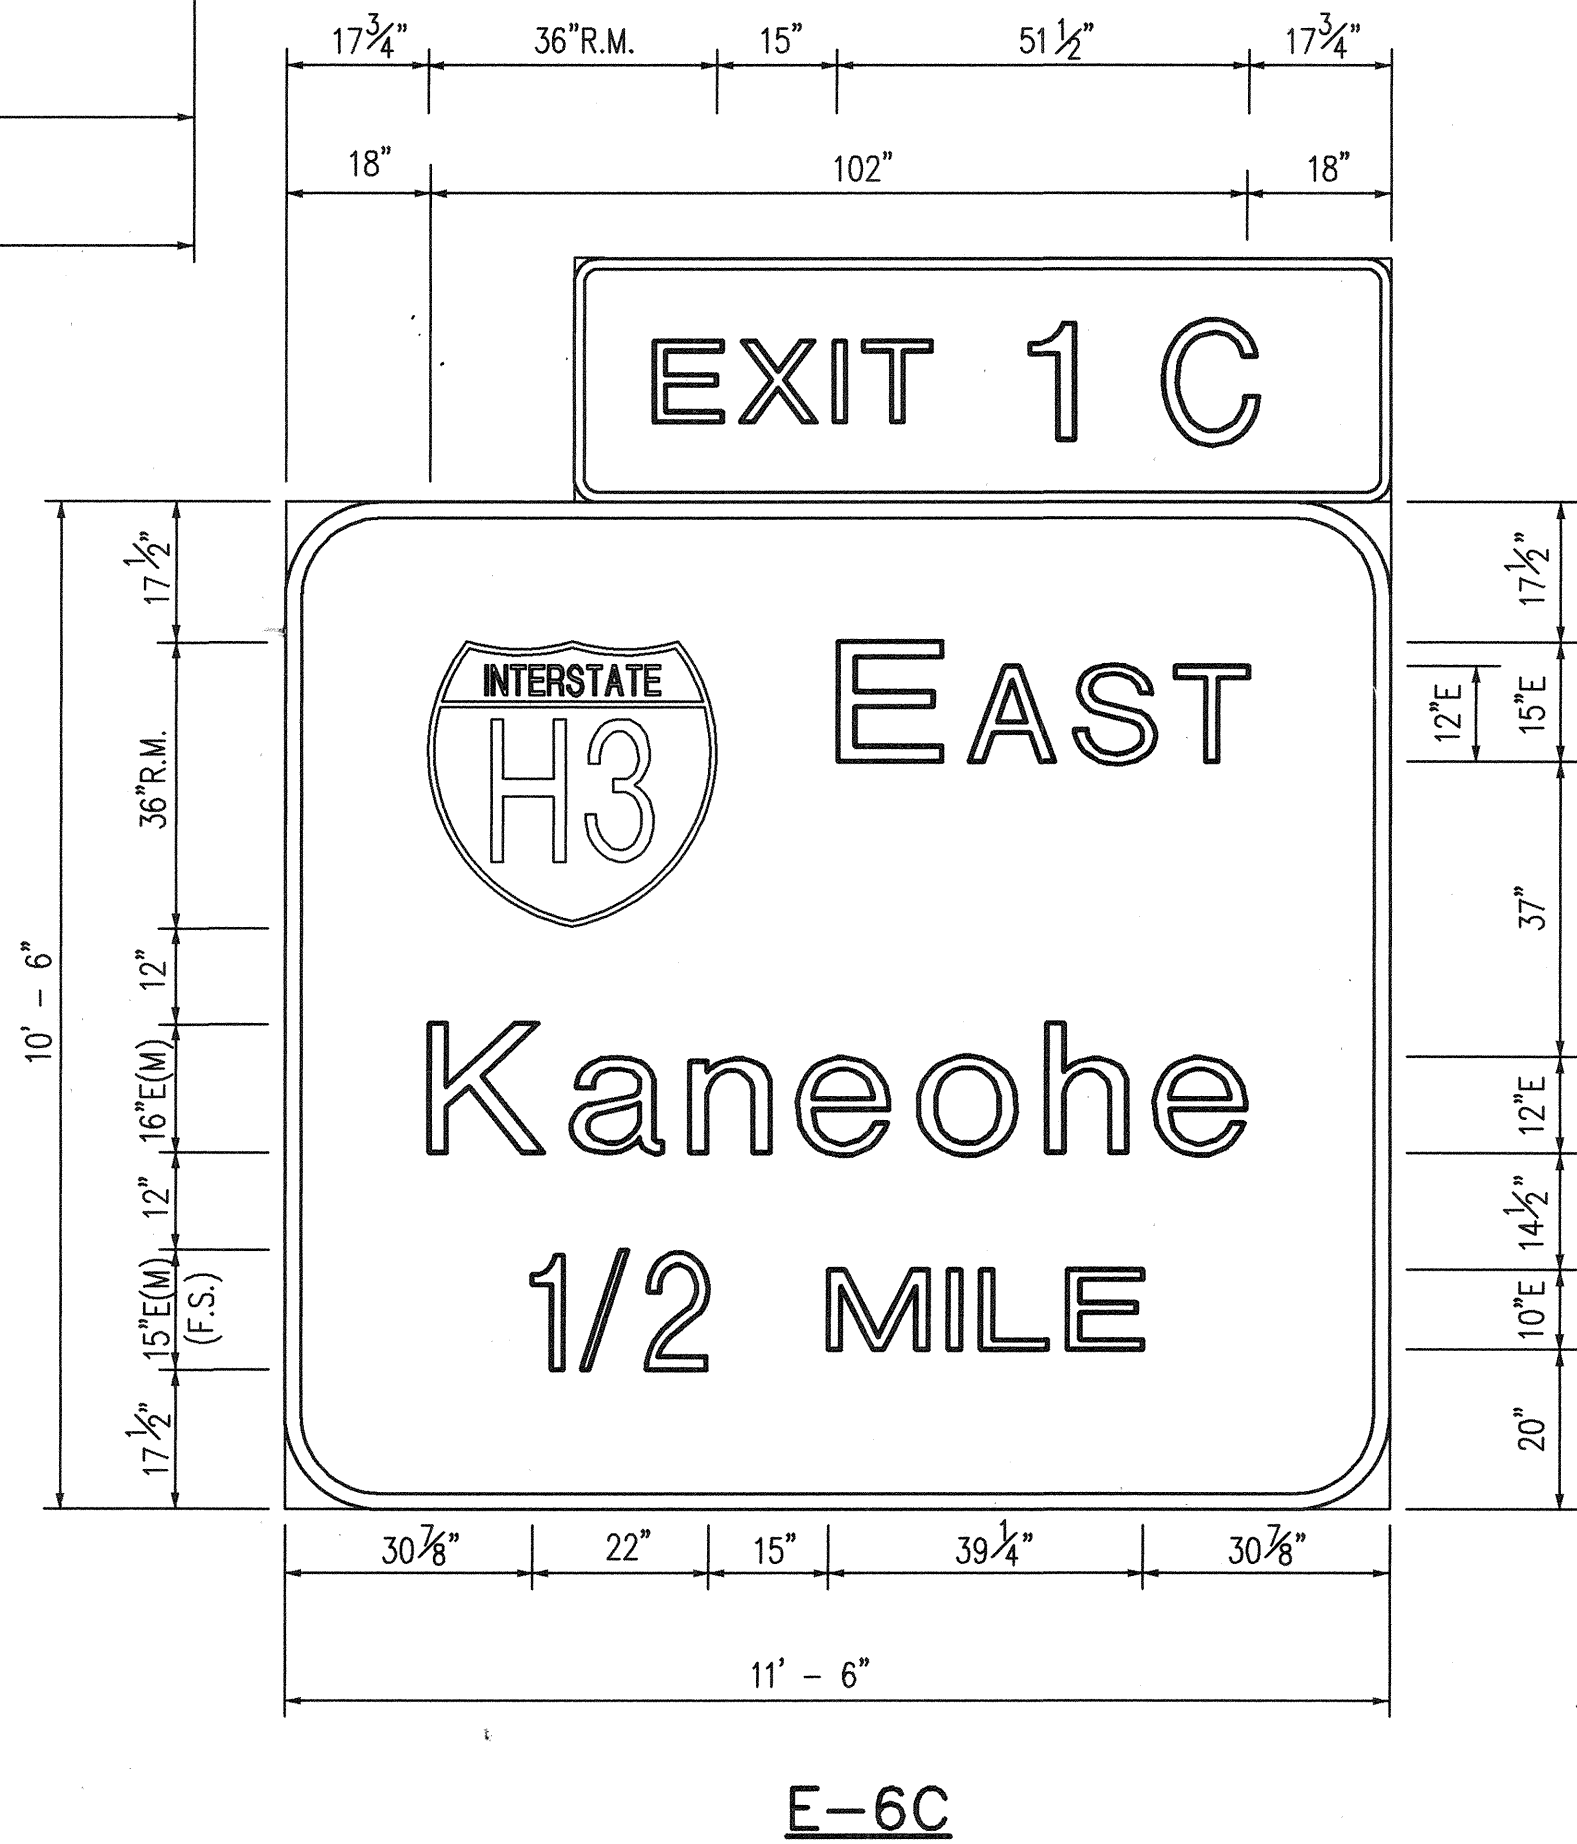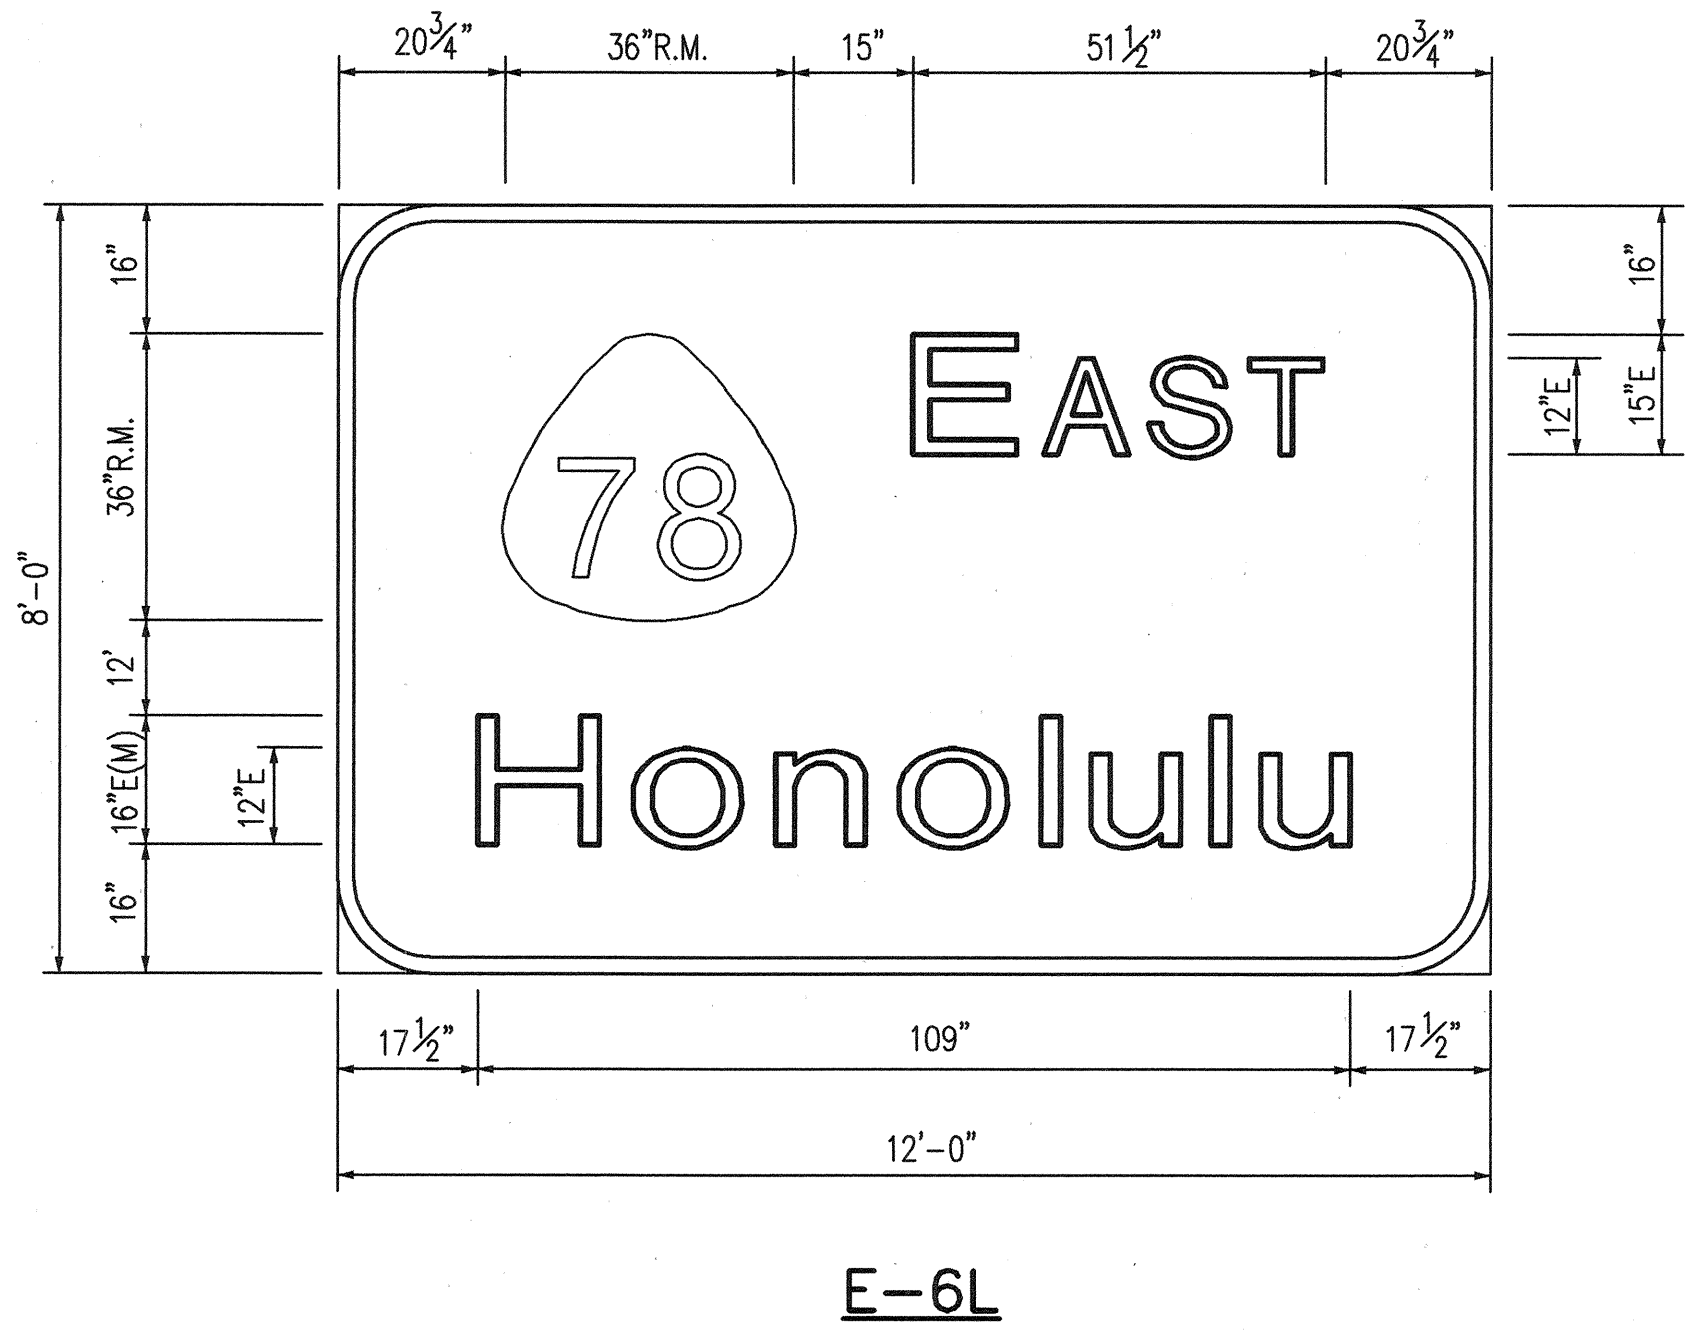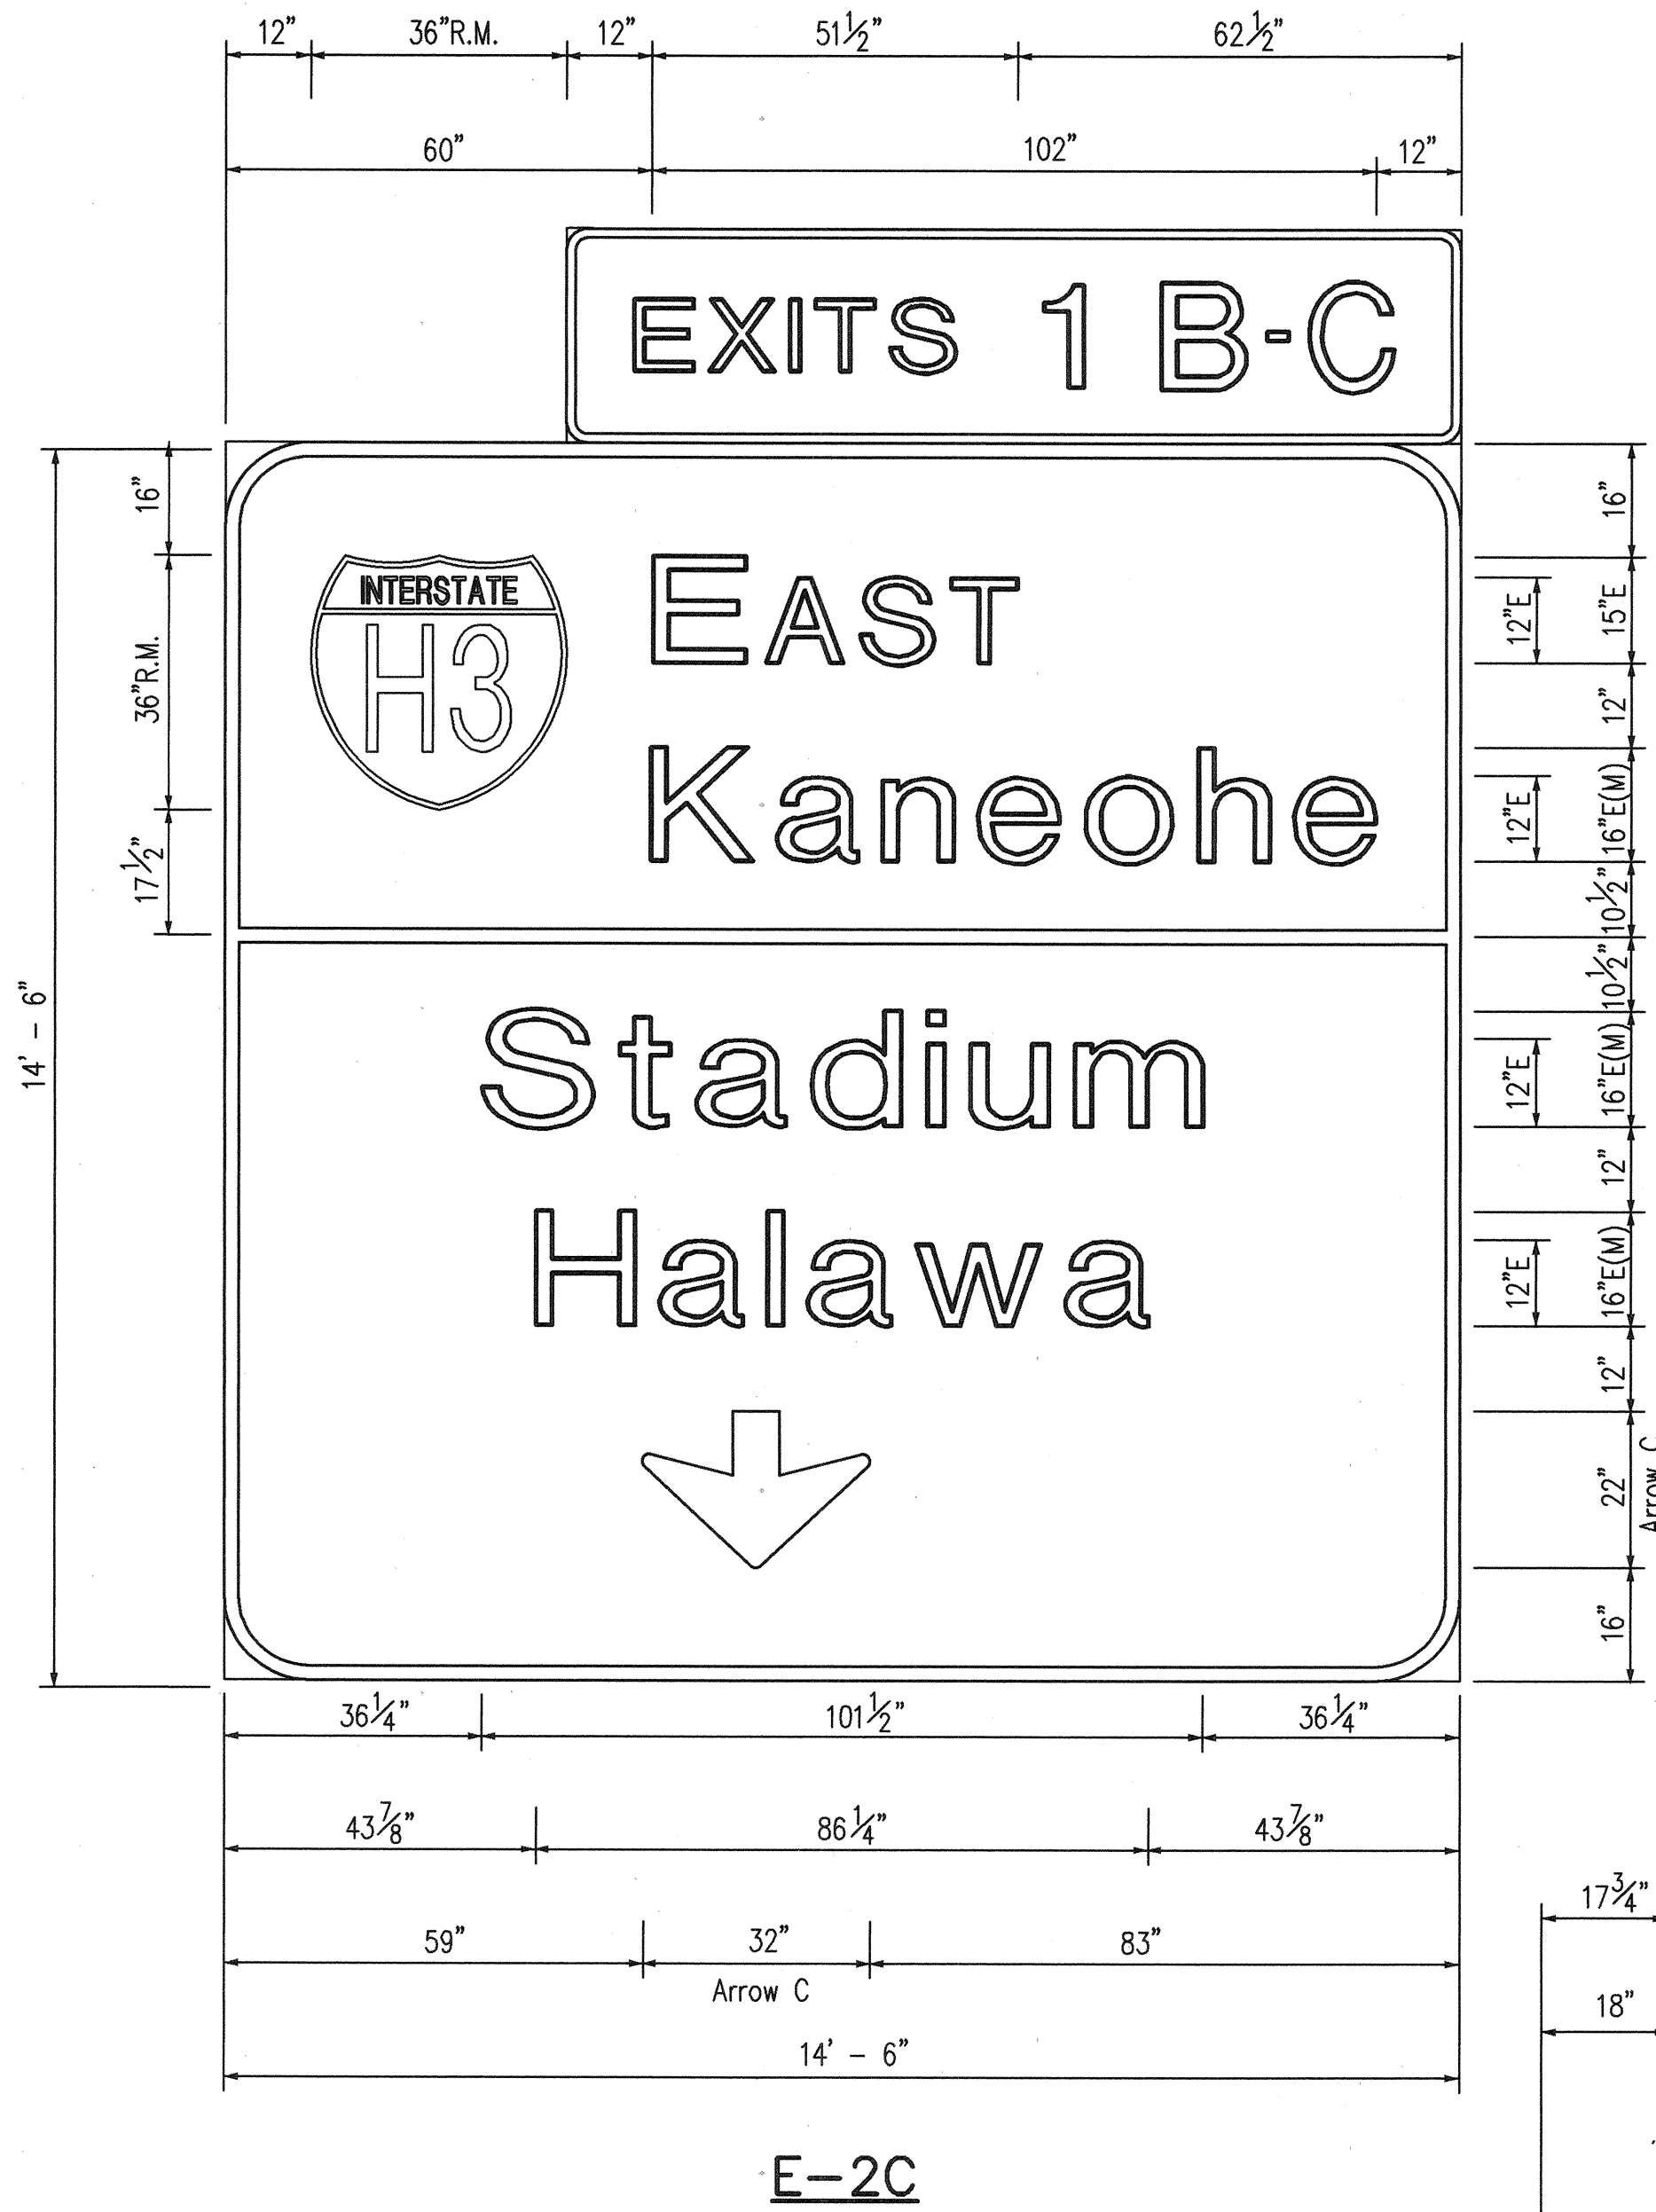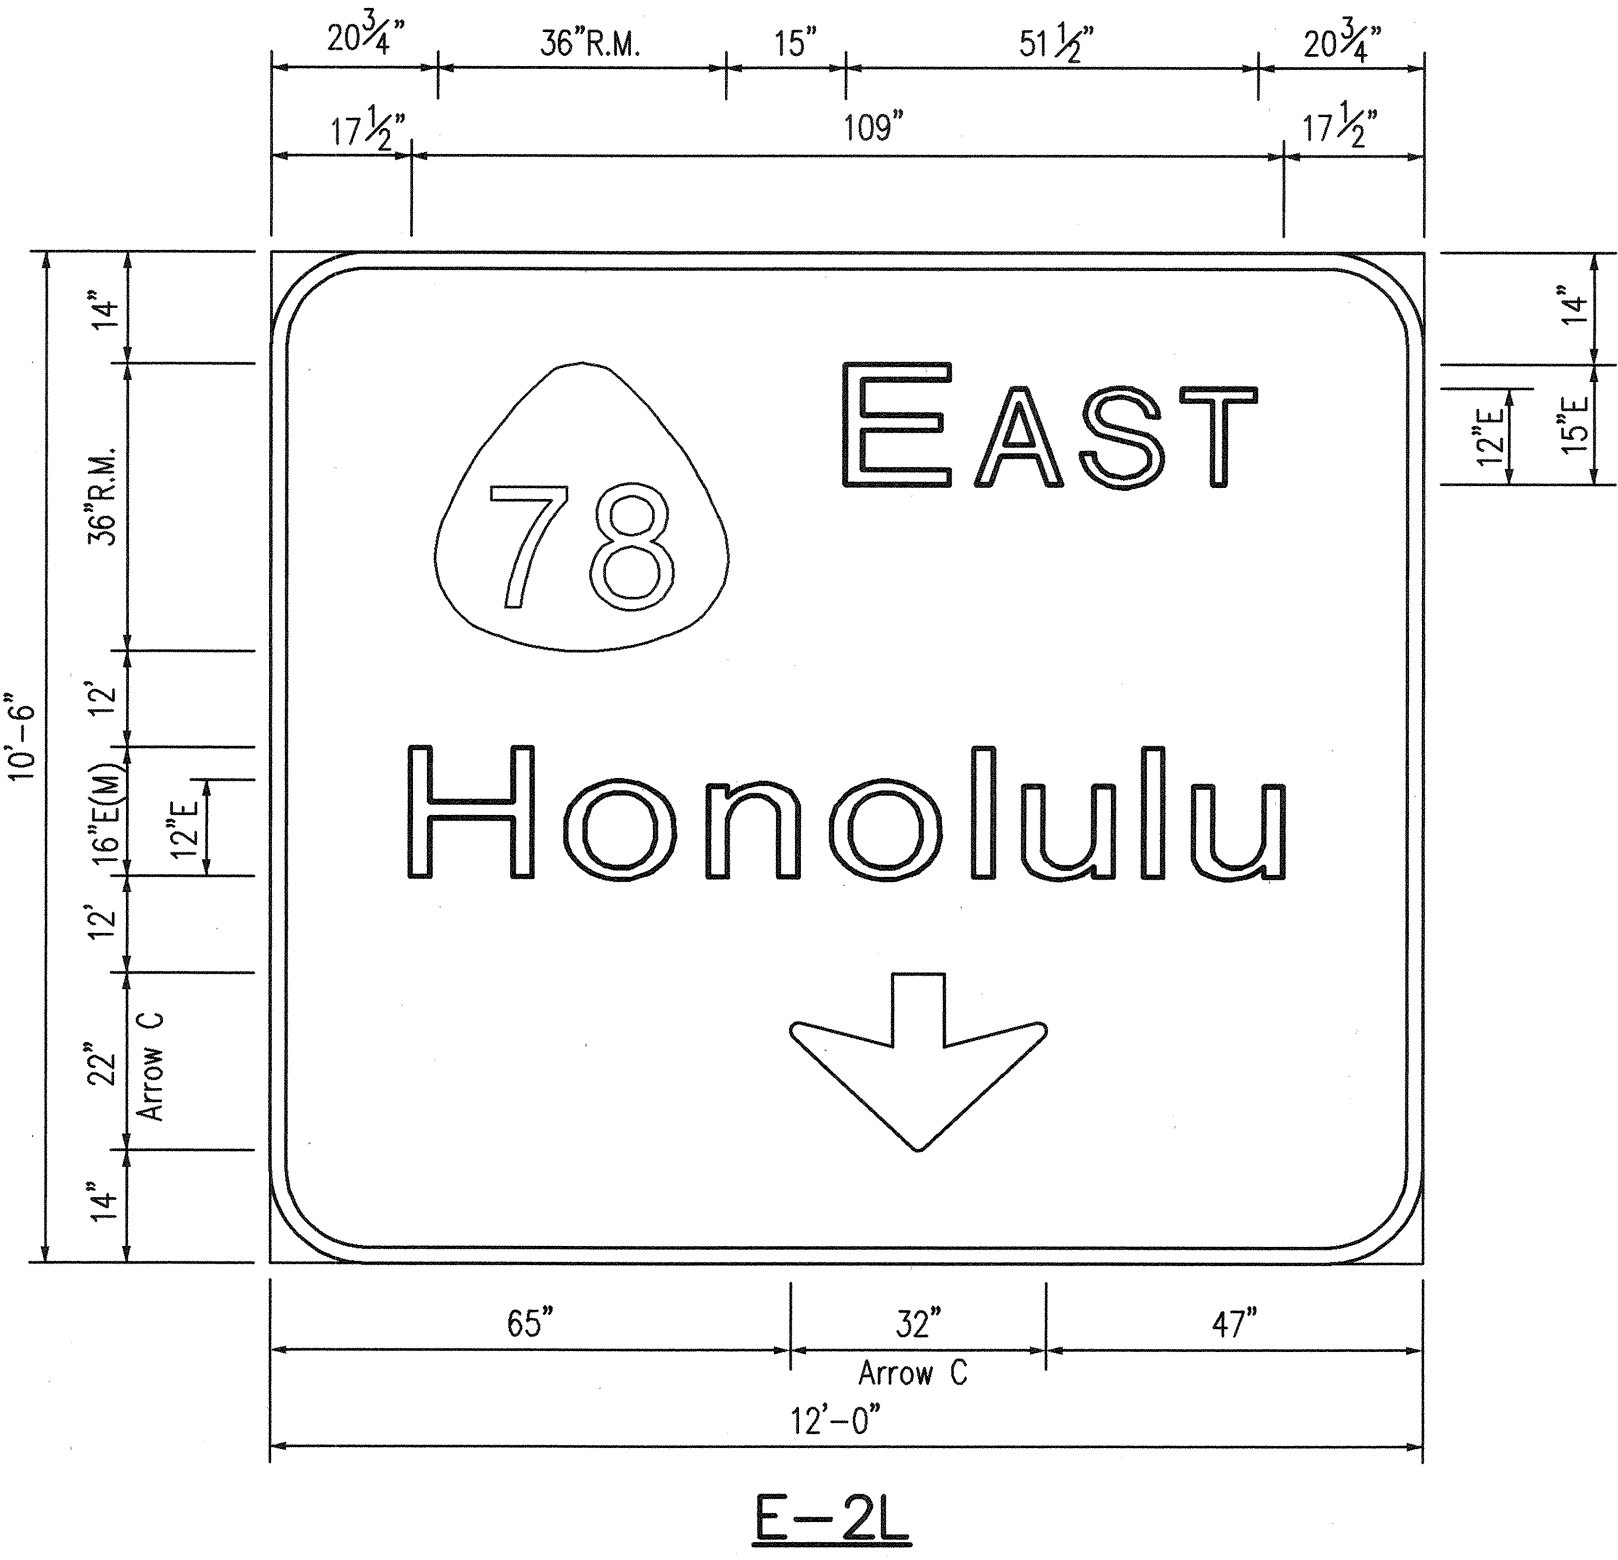

THIS WORK WAS PREPARED BY ME
OR UNDER MY SUPERVISION.
Randall M. Urasaki







STATE OF HAWAII
DEPARTMENT OF TRANSPORTATION
HIGHWAYS DIVISION

DESTINATION SIGNS
SIGN DETAILS
HALAWA INTERCHANGE
H-3 FINISH (UNIT II)
FAIP NO. I-H3-1(75), UNIT II
LEEWARD SECTION
SCALE: 1/2" = 1'-0" DATE: JANUARY 1997
SHEET NO. 6P7 OF 20 SHEETS

ORIGINAL SURVEY PLOTTED BY	DATE
DRAWN BY	
TRACED BY	
DESIGNED BY	
CHECKED BY	
No.	

CAD by J. Minura, 95-52

FED. ROAD DIST. NO.	STATE	FED. AID PROJ. NO.	FISCAL YEAR	SHEET NO.	TOTAL SHEETS
HAWAII	HAW.	I-H3-1(75), UNIT II	1997	858	1102

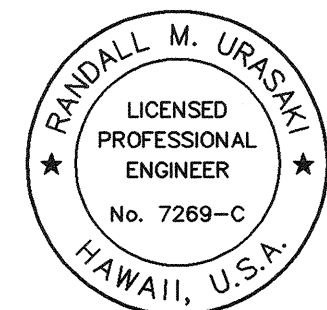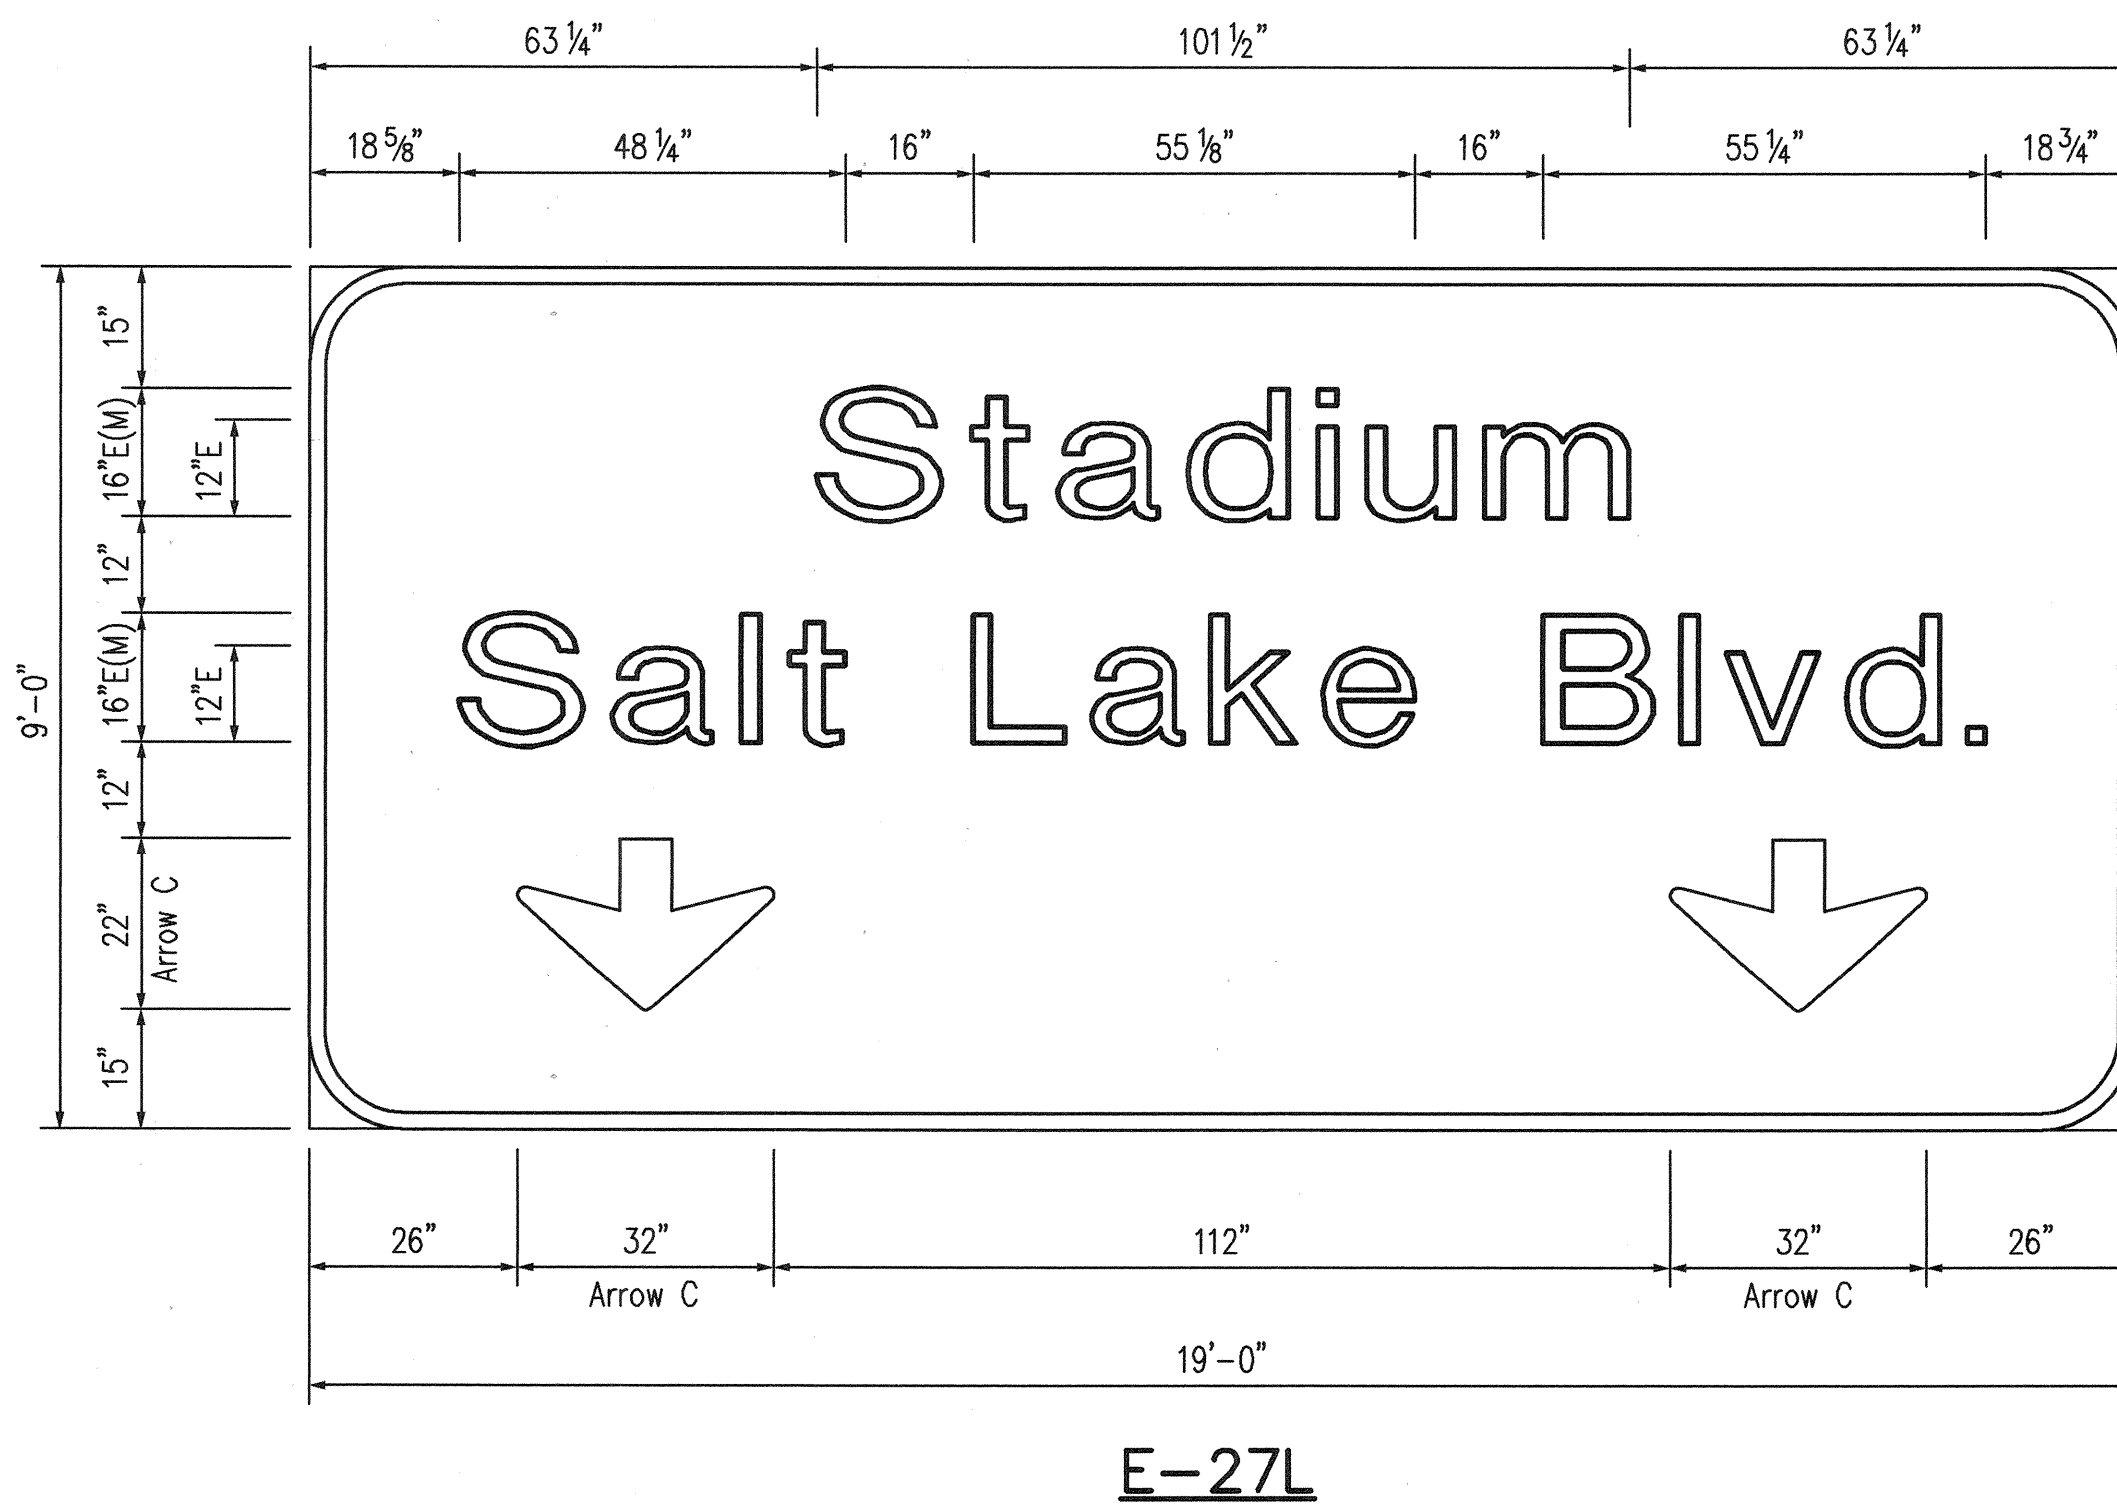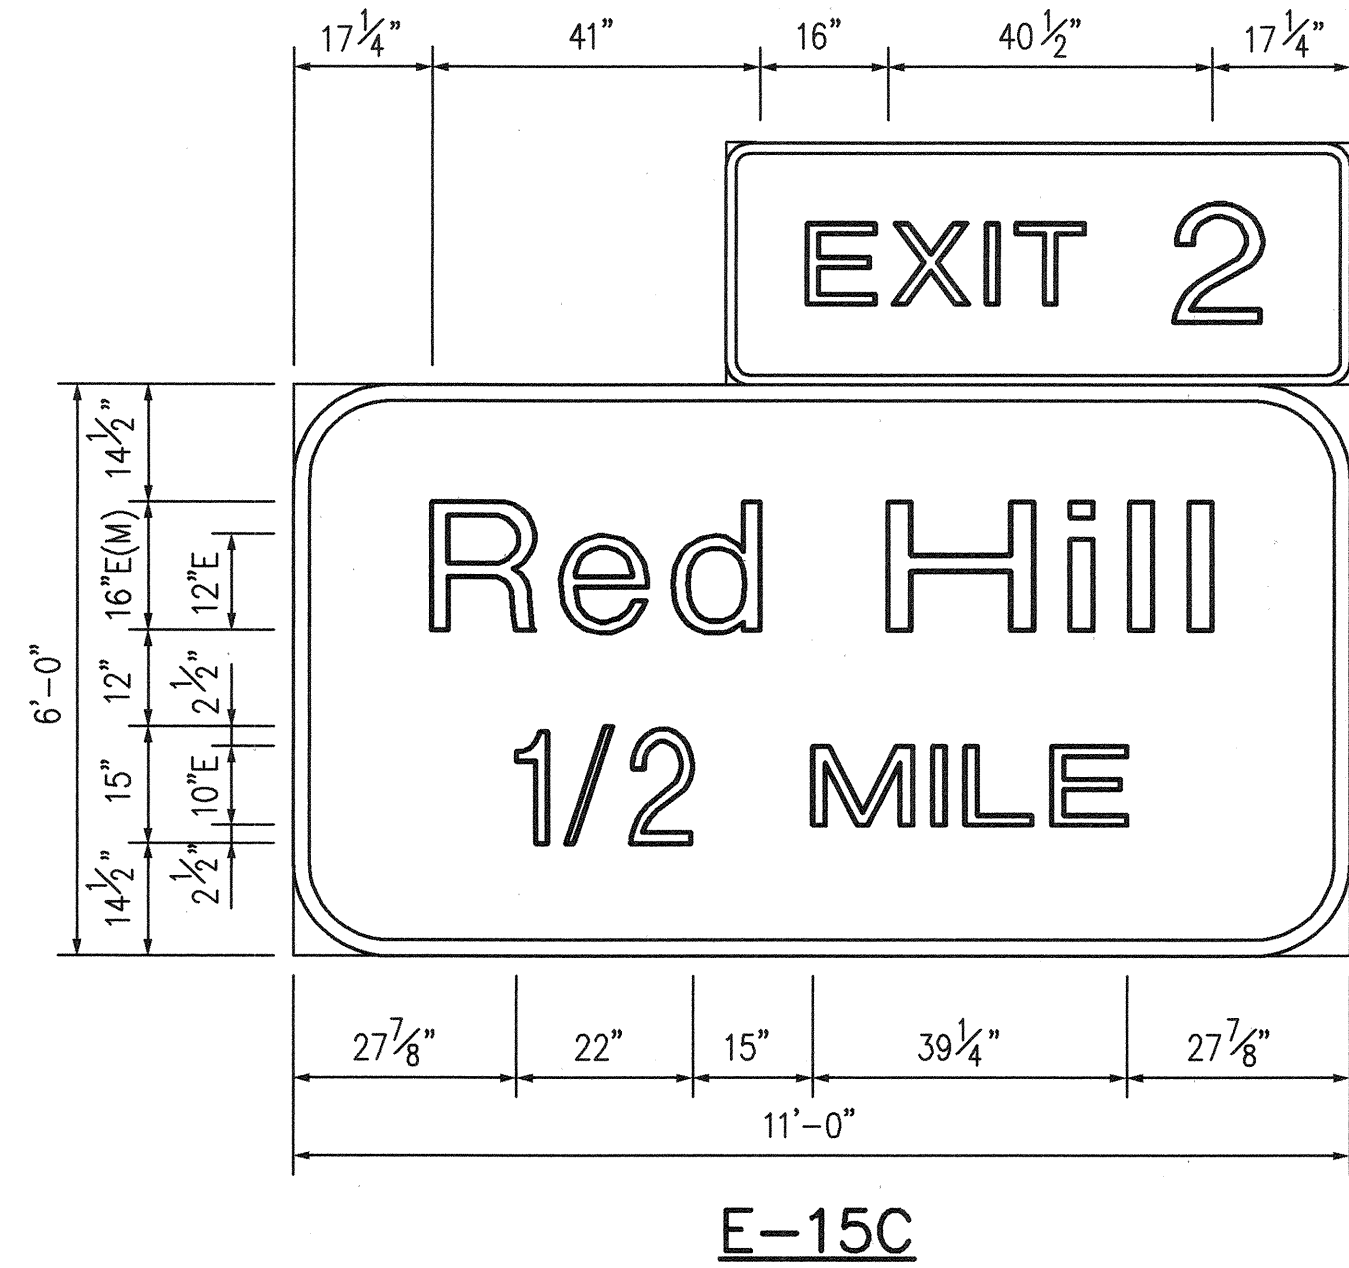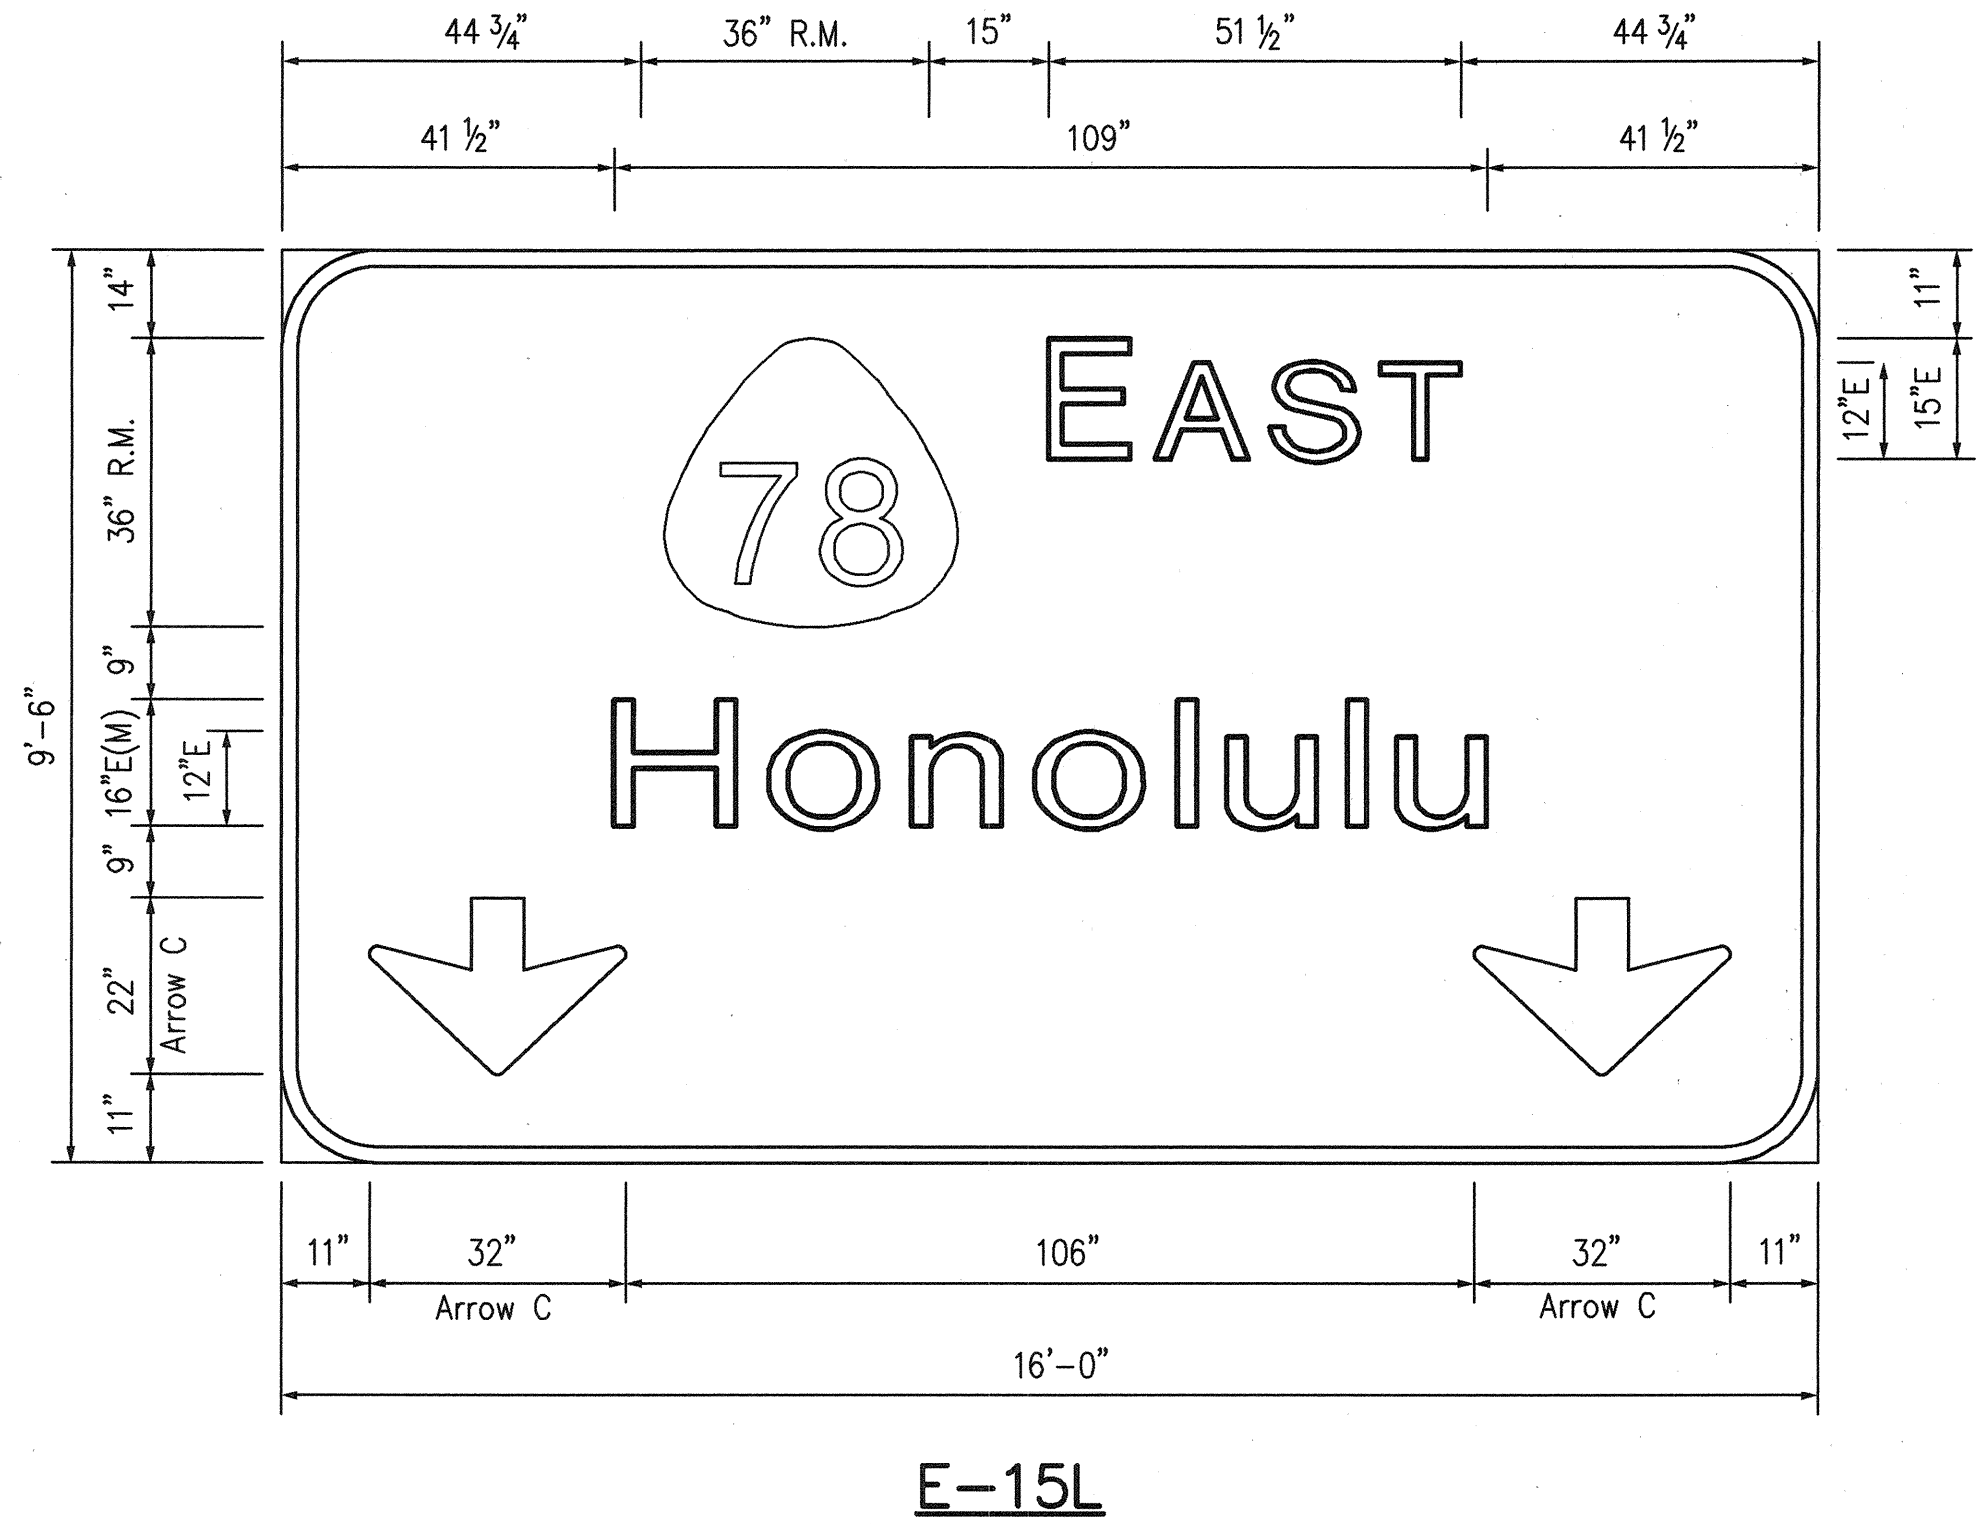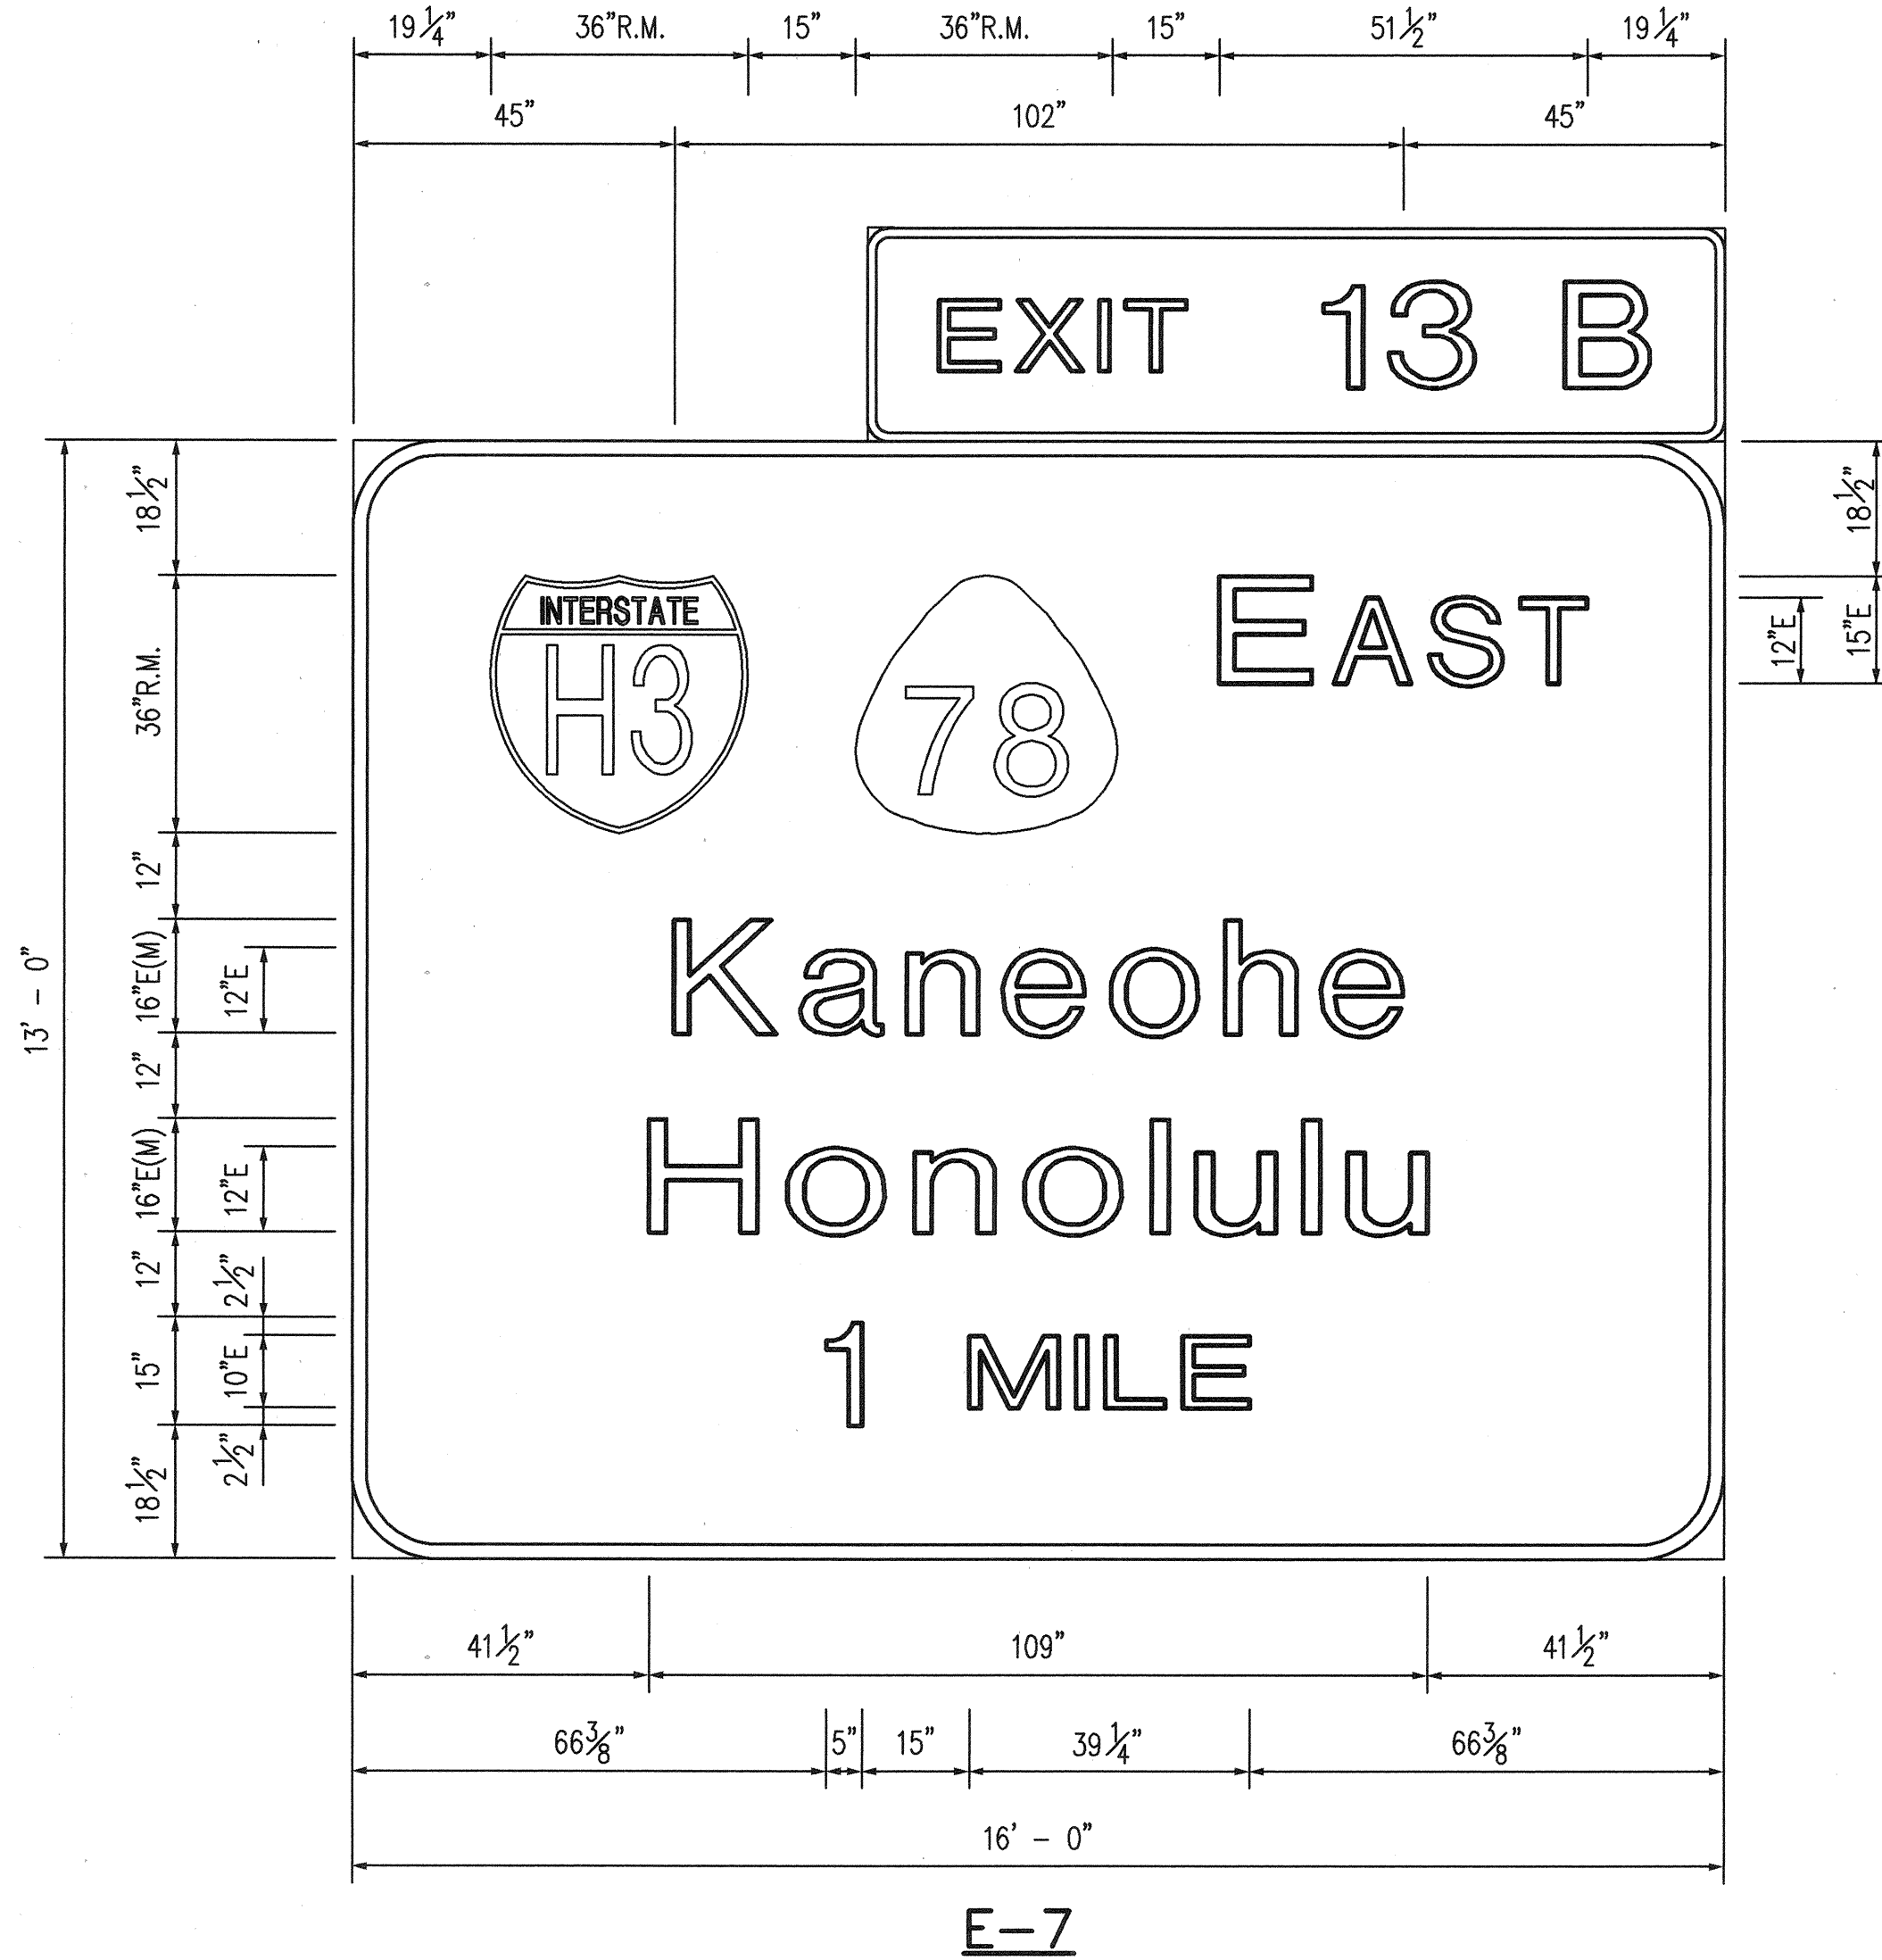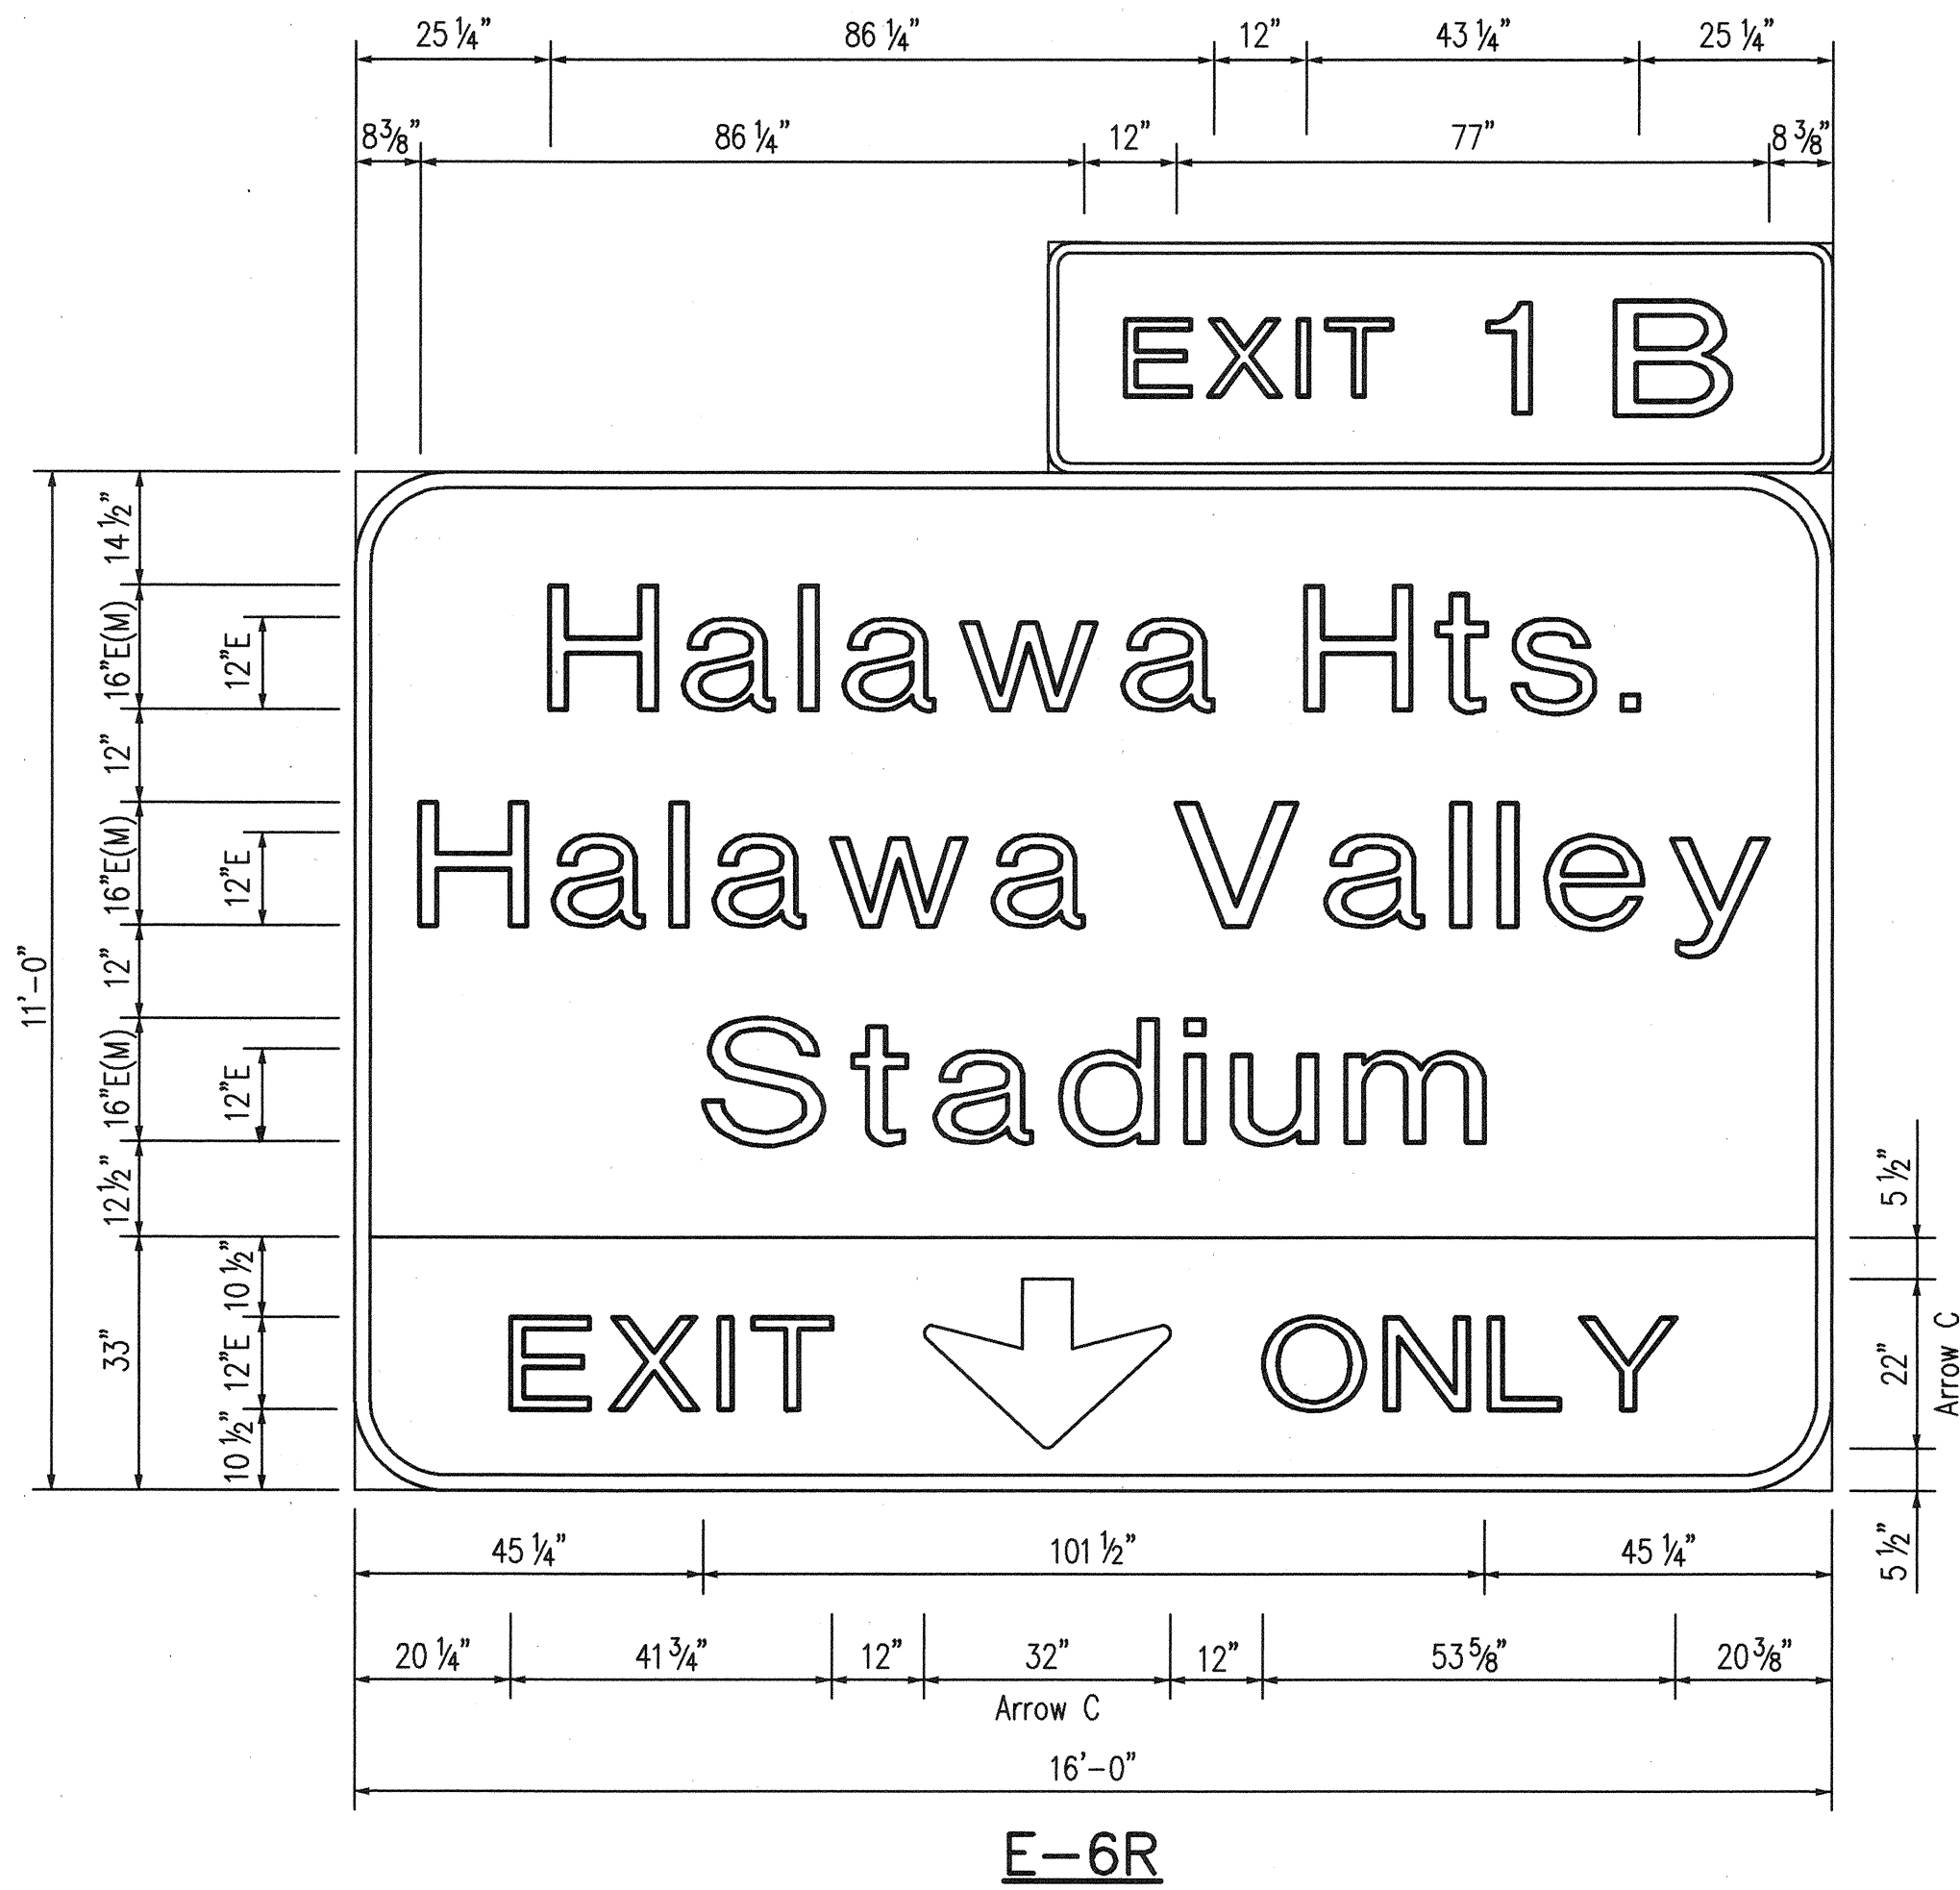

THIS WORK WAS PREPARED BY ME
OR UNDER MY SUPERVISION.
Randall M. Urasky


STATE OF HAWAII
DEPARTMENT OF TRANSPORTATION
HIGHWAYS DIVISION

DESTINATION SIGNS
SIGN DETAILS
HALAWA INTERCHANGE
H-3 FINISH (UNIT II)
FAIP NO. I-H3-1(75), UNIT II
LEEWARD SECTION
SCALE: 1/2" = 1'-0" DATE: JANUARY 1997
SHEET NO. 6P8 OF 20 SHEETS


ORIGINAL SURVEY PLOTTED BY	DATE
DRAWN BY	
TRACED BY	
DESIGNED BY	
CHECKED BY	
NO.	

CAD by J. Mmura, 55-52


FED. ROAD DIST. NO.	STATE	FED. AID PROJ. NO.	FISCAL YEAR	SHEET NO.	TOTAL SHEETS
HAWAII	HAW.	I-H3-1(75), UNIT II	1997	859	1102

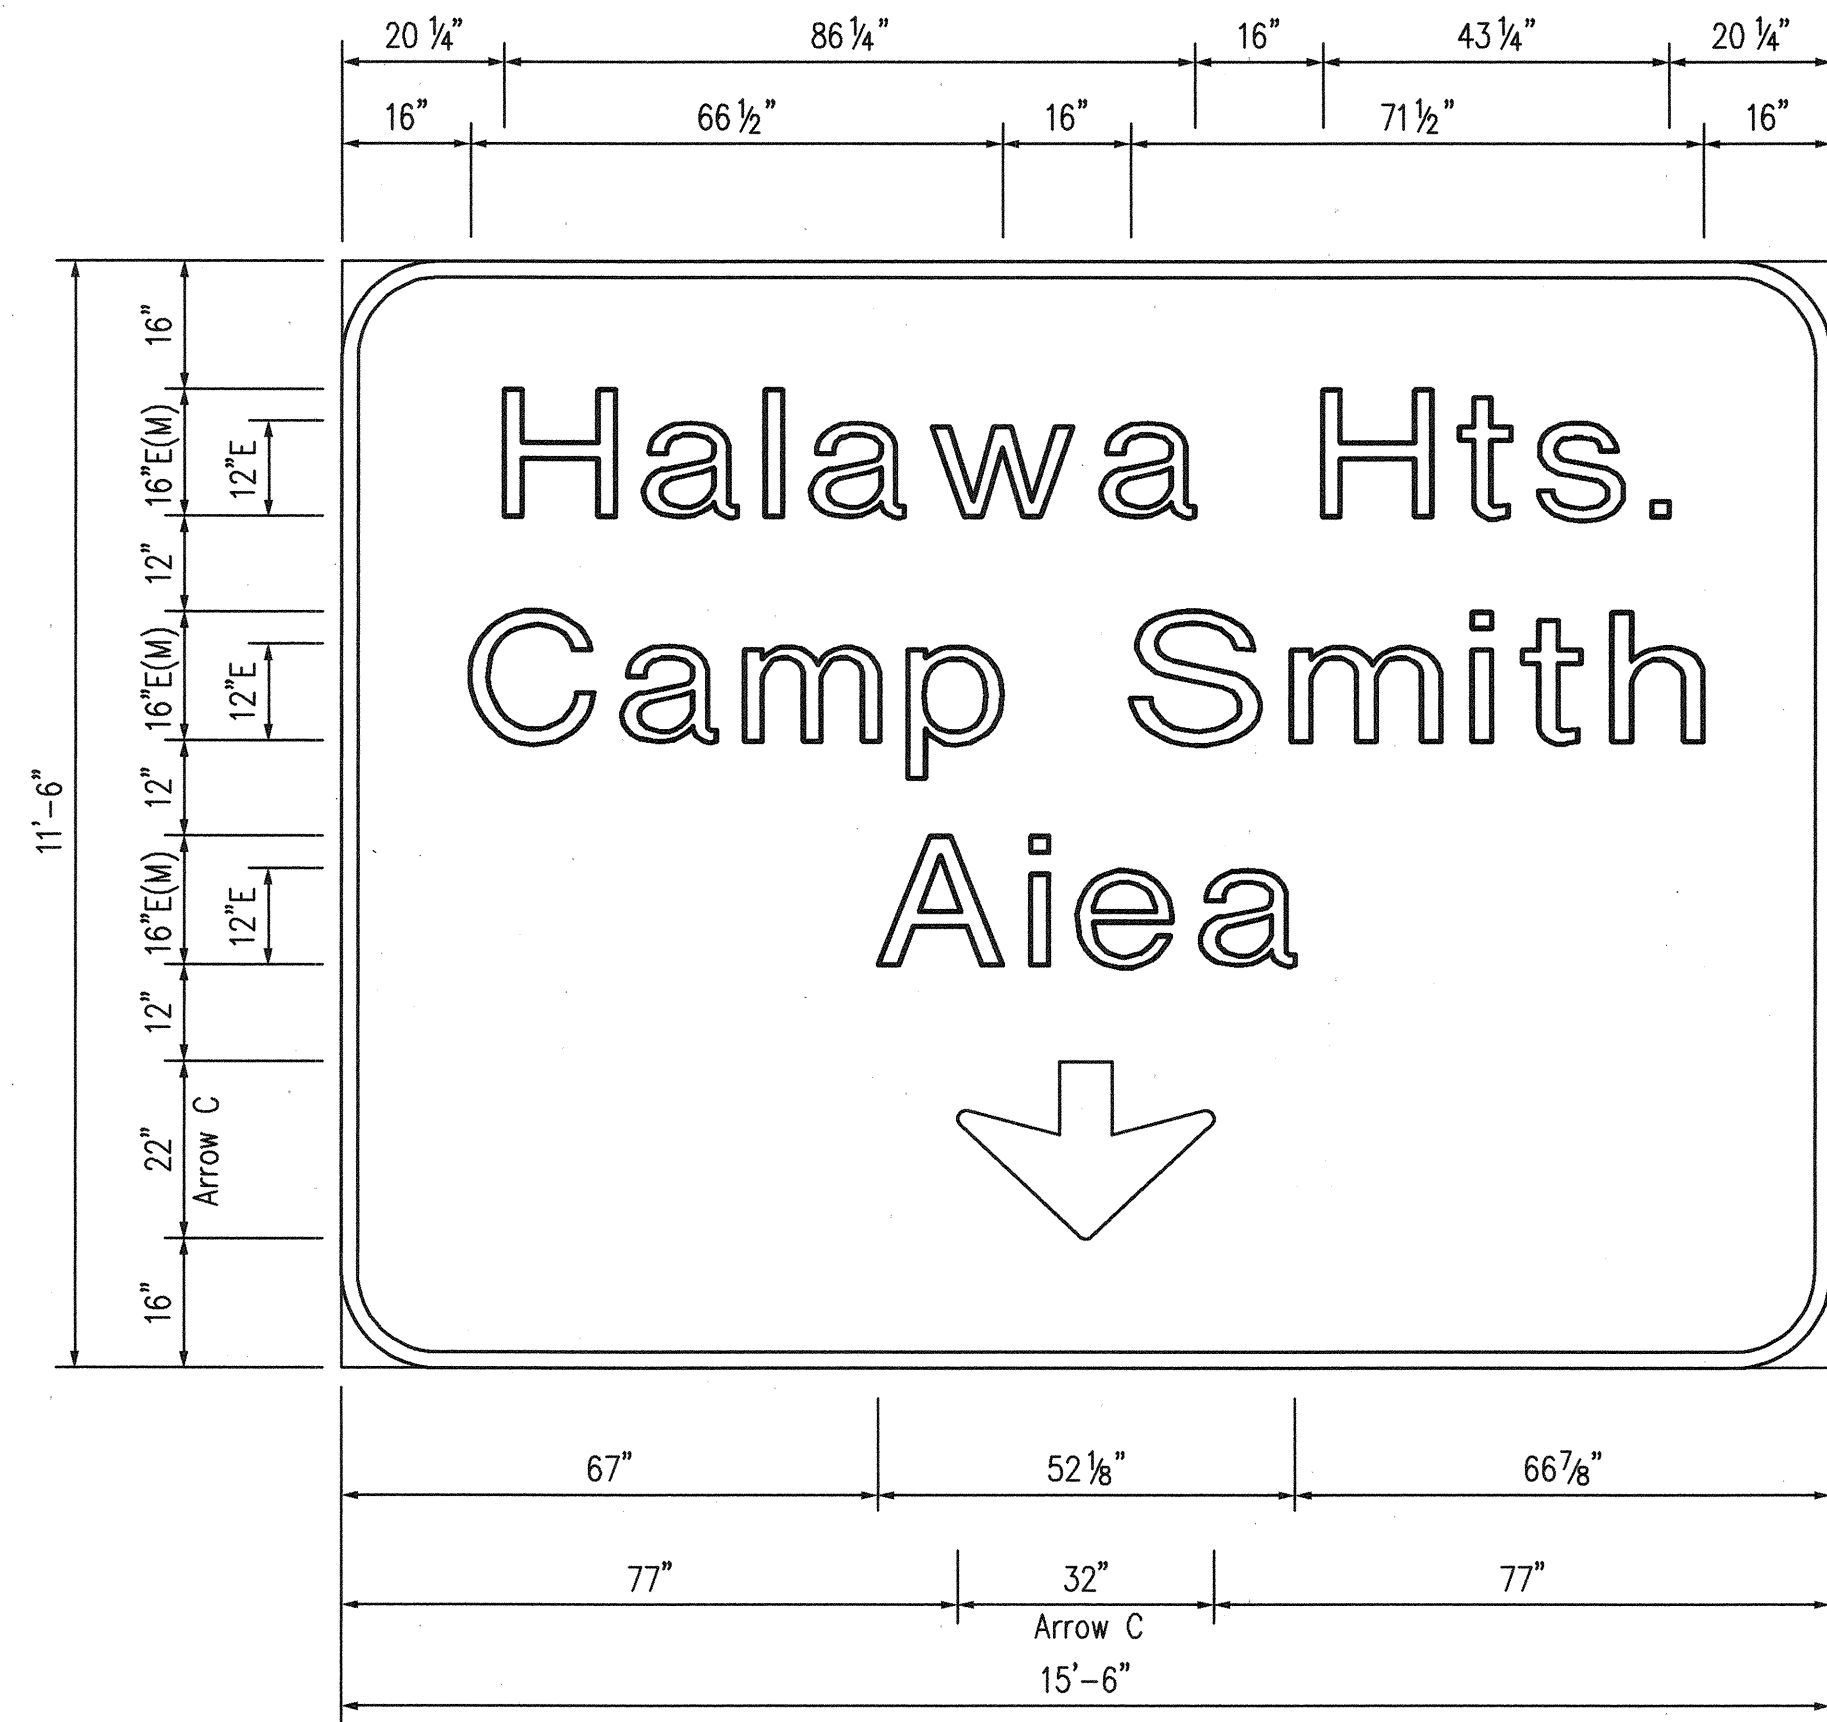


E-27C

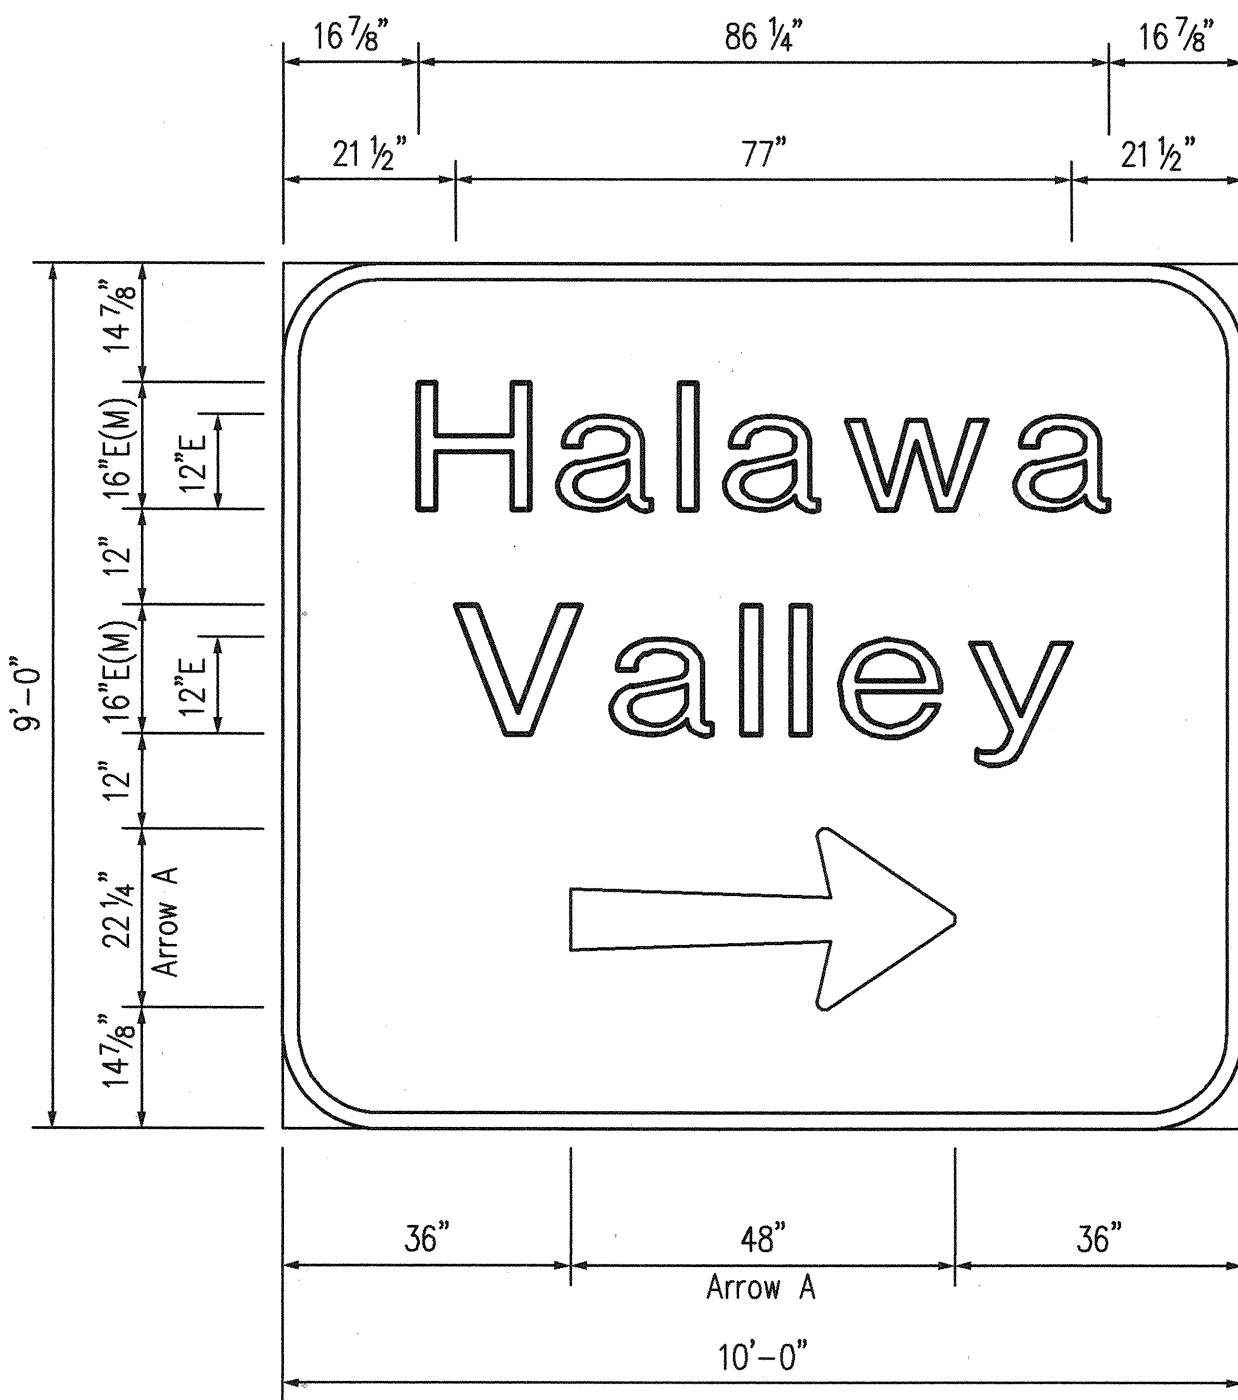


E-27R

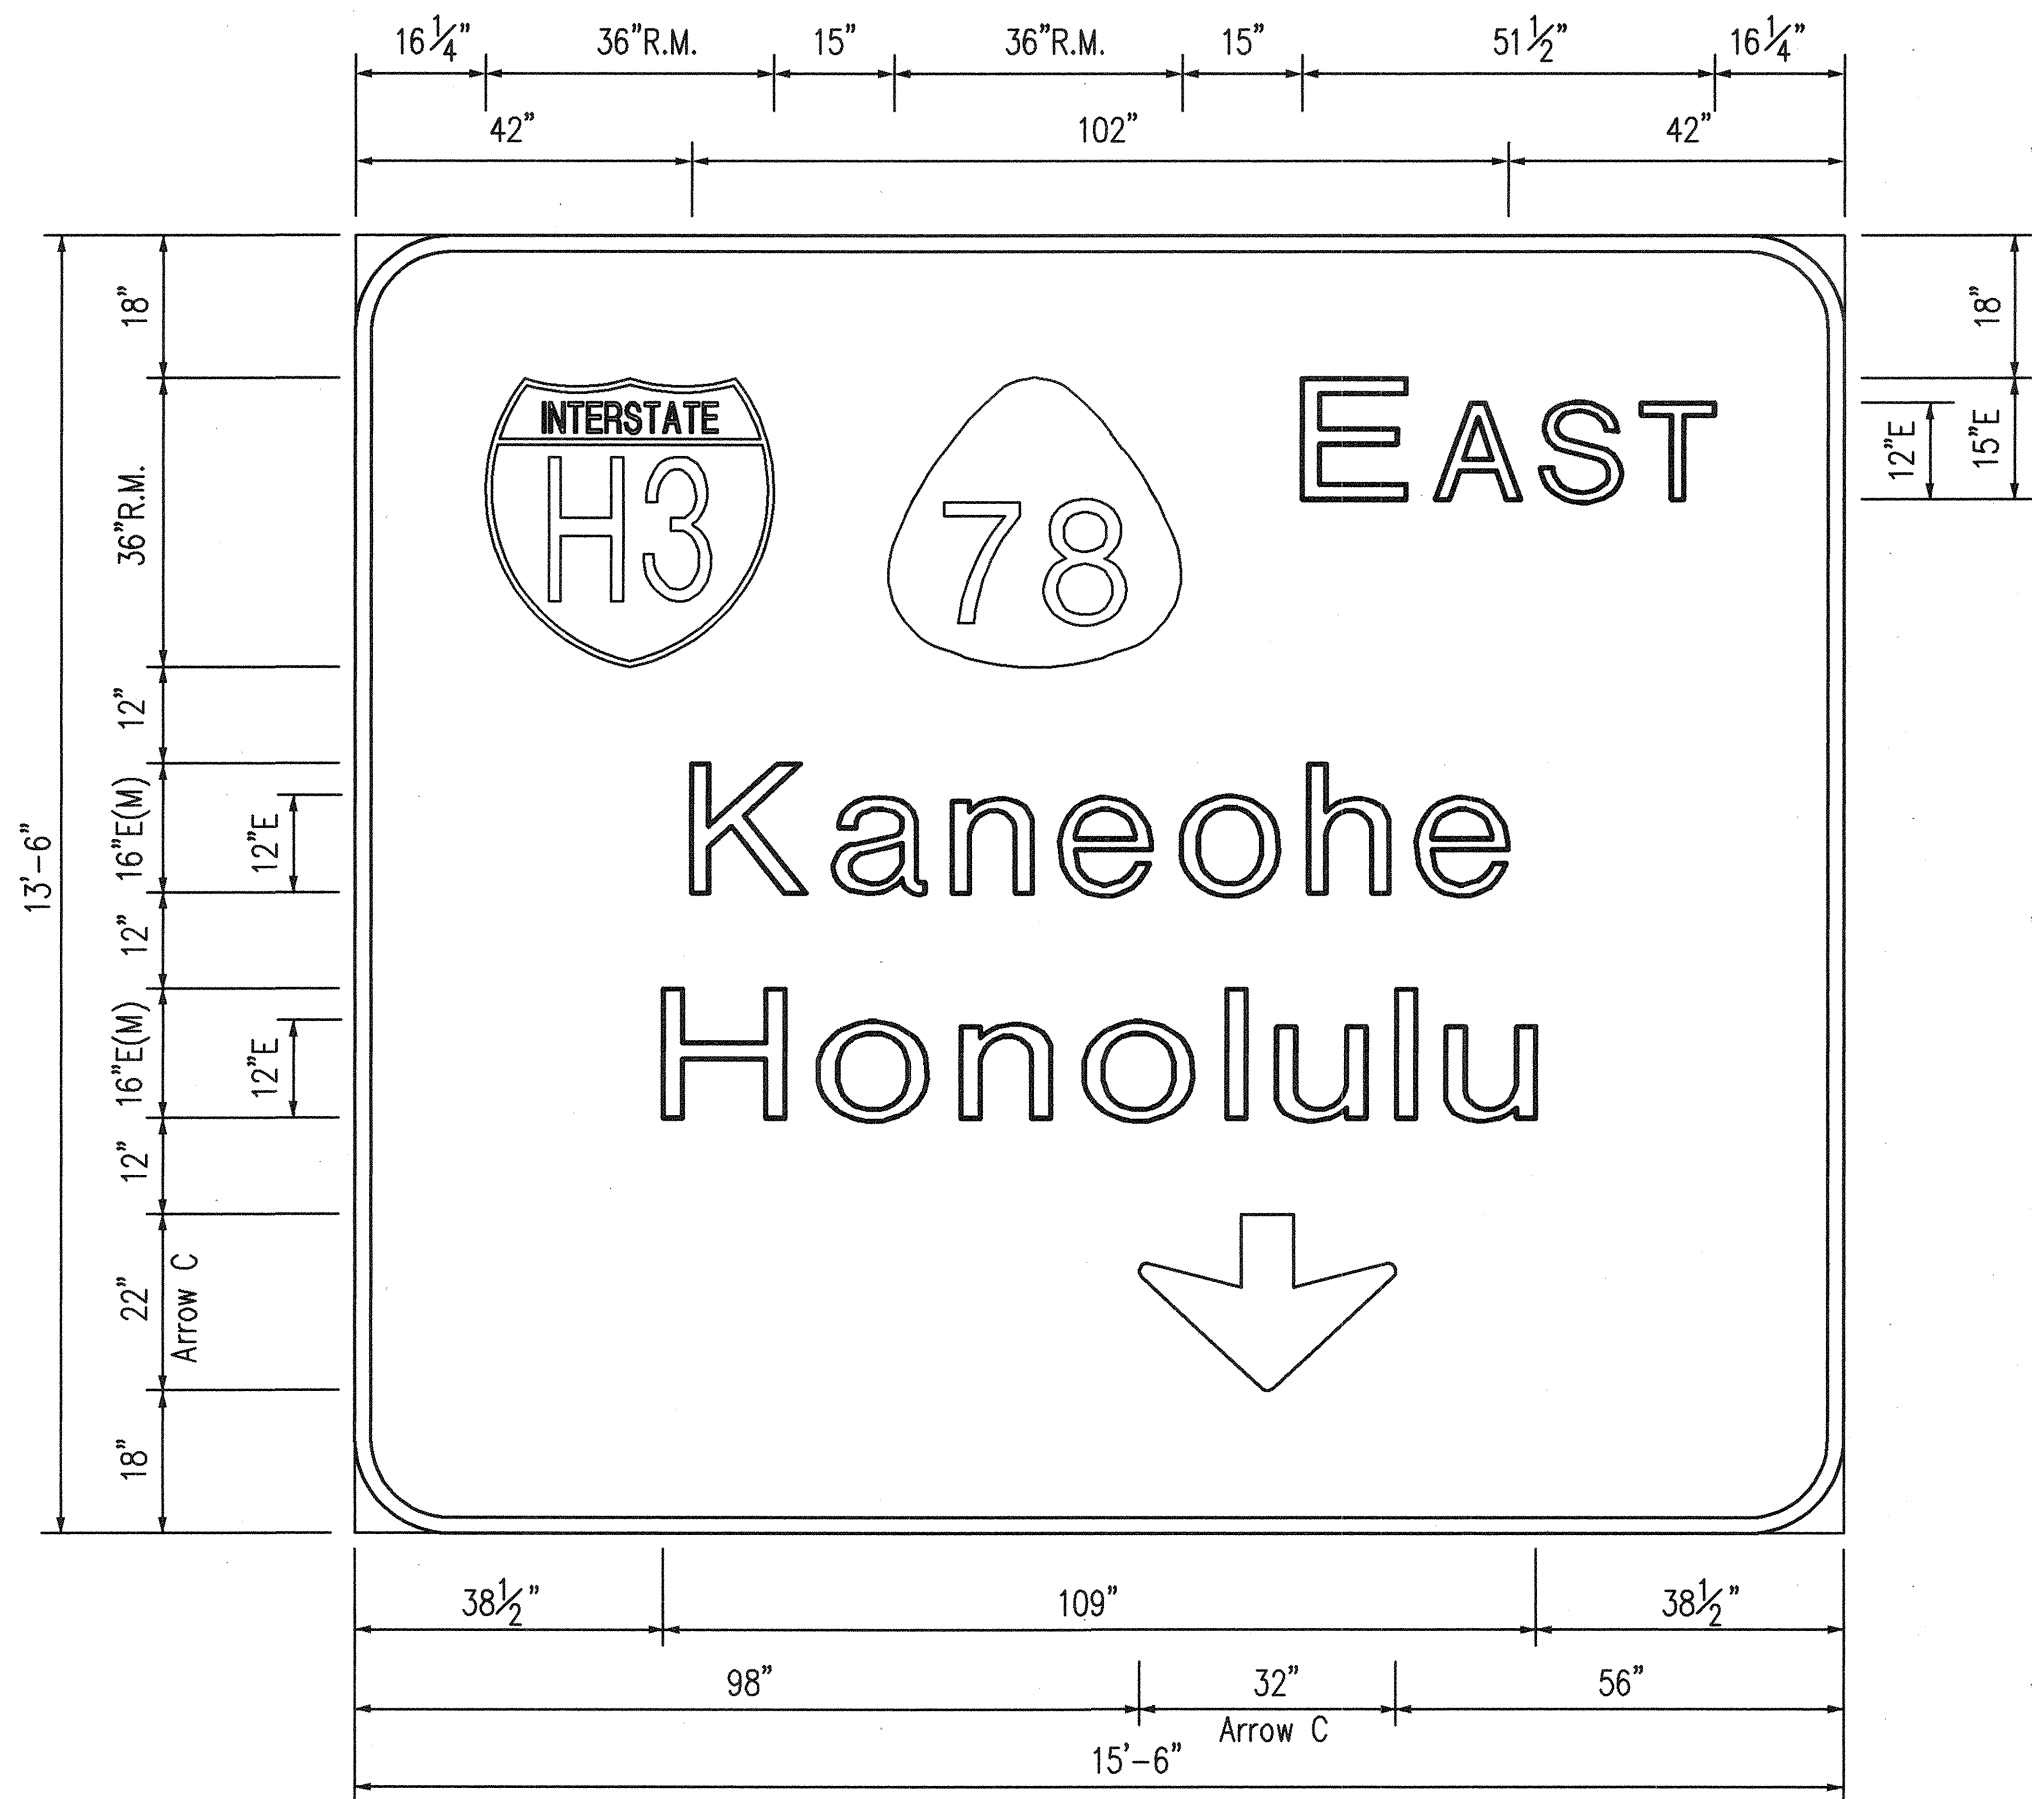


E-30L

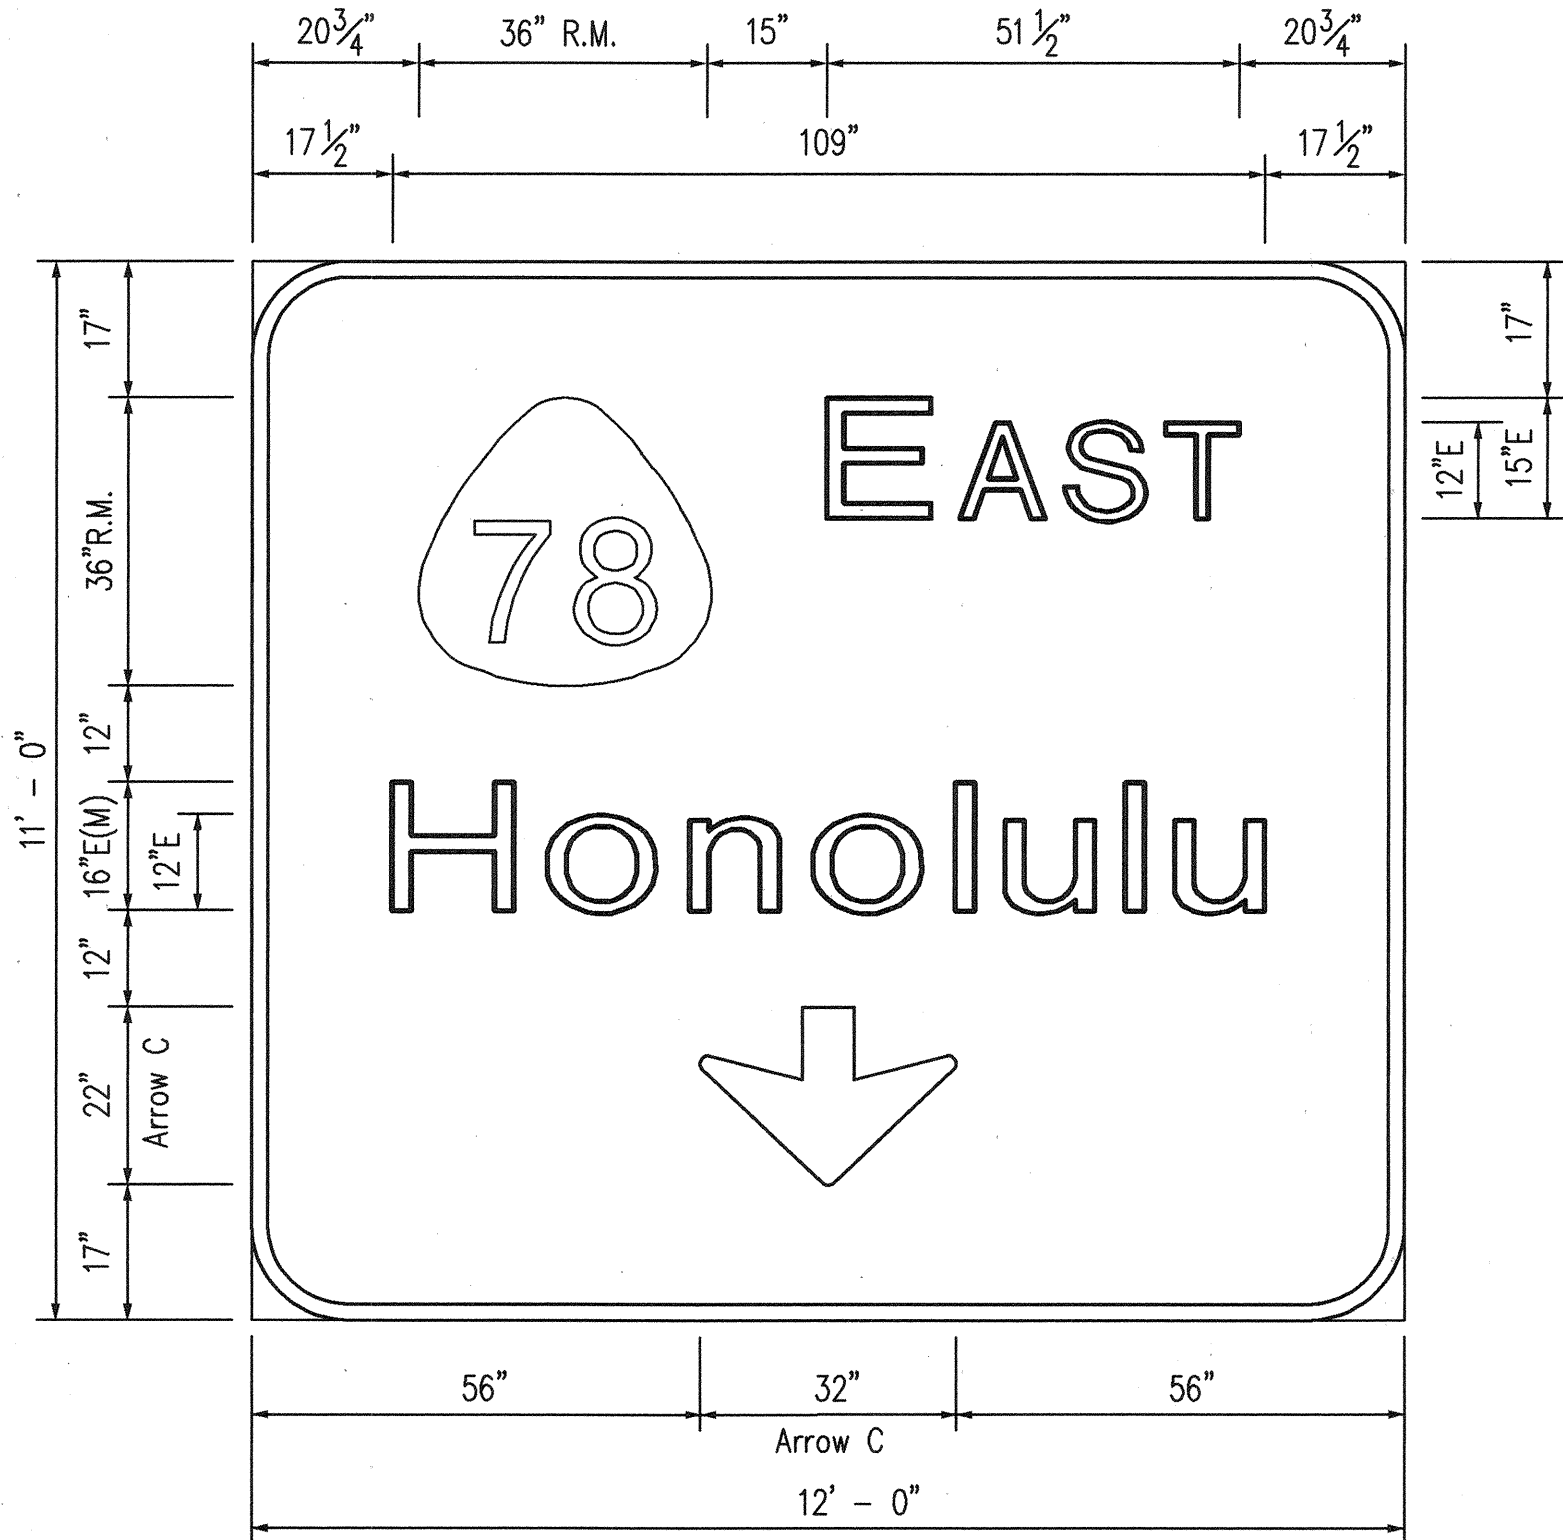

E-30R

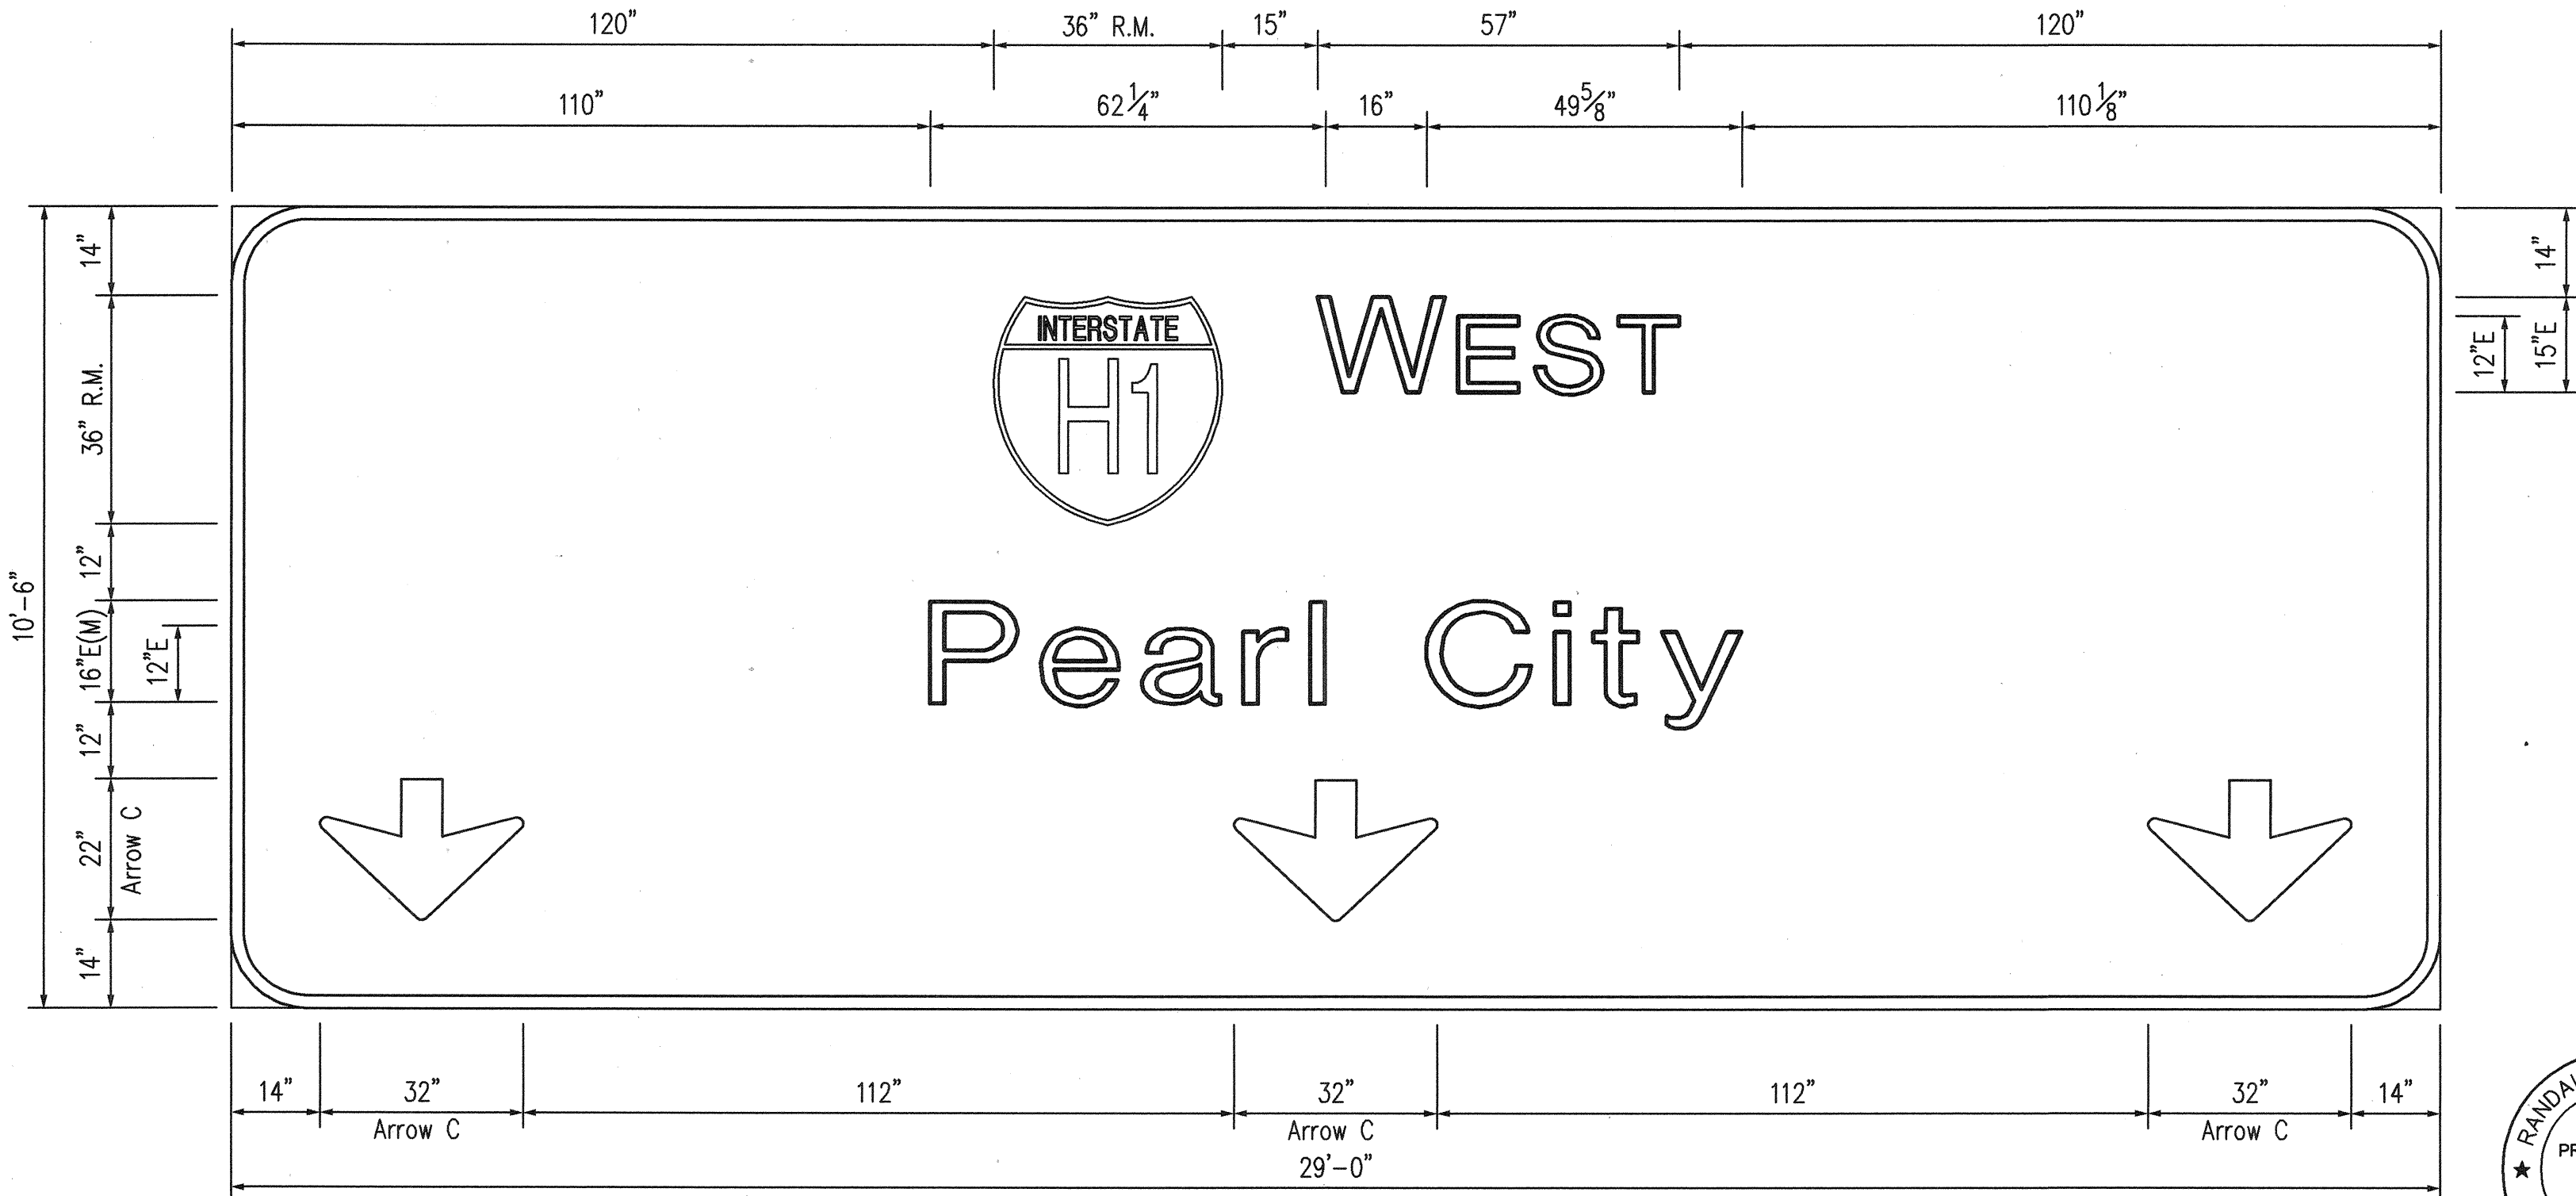

E-33L

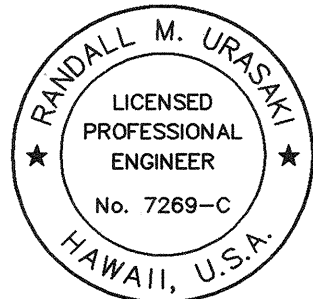

THIS WORK WAS PREPARED BY ME
OR UNDER MY SUPERVISION.
Randall M. Urasaki







STATE OF HAWAII
DEPARTMENT OF TRANSPORTATION
HIGHWAYS DIVISION

DESTINATION SIGNS
SIGN DETAILS
HALAWA INTERCHANGE
H-3 FINISH (UNIT II)
FAIP NO. I-H3-1(75), UNIT II
LEEWARD SECTION
SCALE: 1/2" = 1'-0" DATE: JANUARY 1997
SHEET NO. 6P9 OF 20 SHEETS

ORIGINAL SURVEY PLOTTED BY _____	DATE _____
DRAWN BY _____	DATE _____
TRACED BY _____	DATE _____
DESIGNED BY _____	DATE _____
CHECKED BY _____	DATE _____
No. _____	

CAD by J. IMURA, 55-52

FED. ROAD DIST. NO.	STATE	FED. AID PROJ. NO.	FISCAL YEAR	SHEET NO.	TOTAL SHEETS
HAWAII	HAW.	I-H3-1(75), UNIT II	1997	860	1102

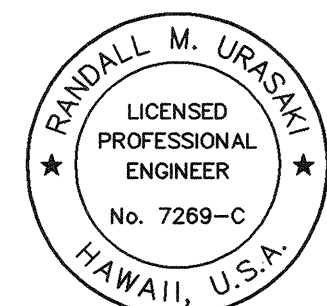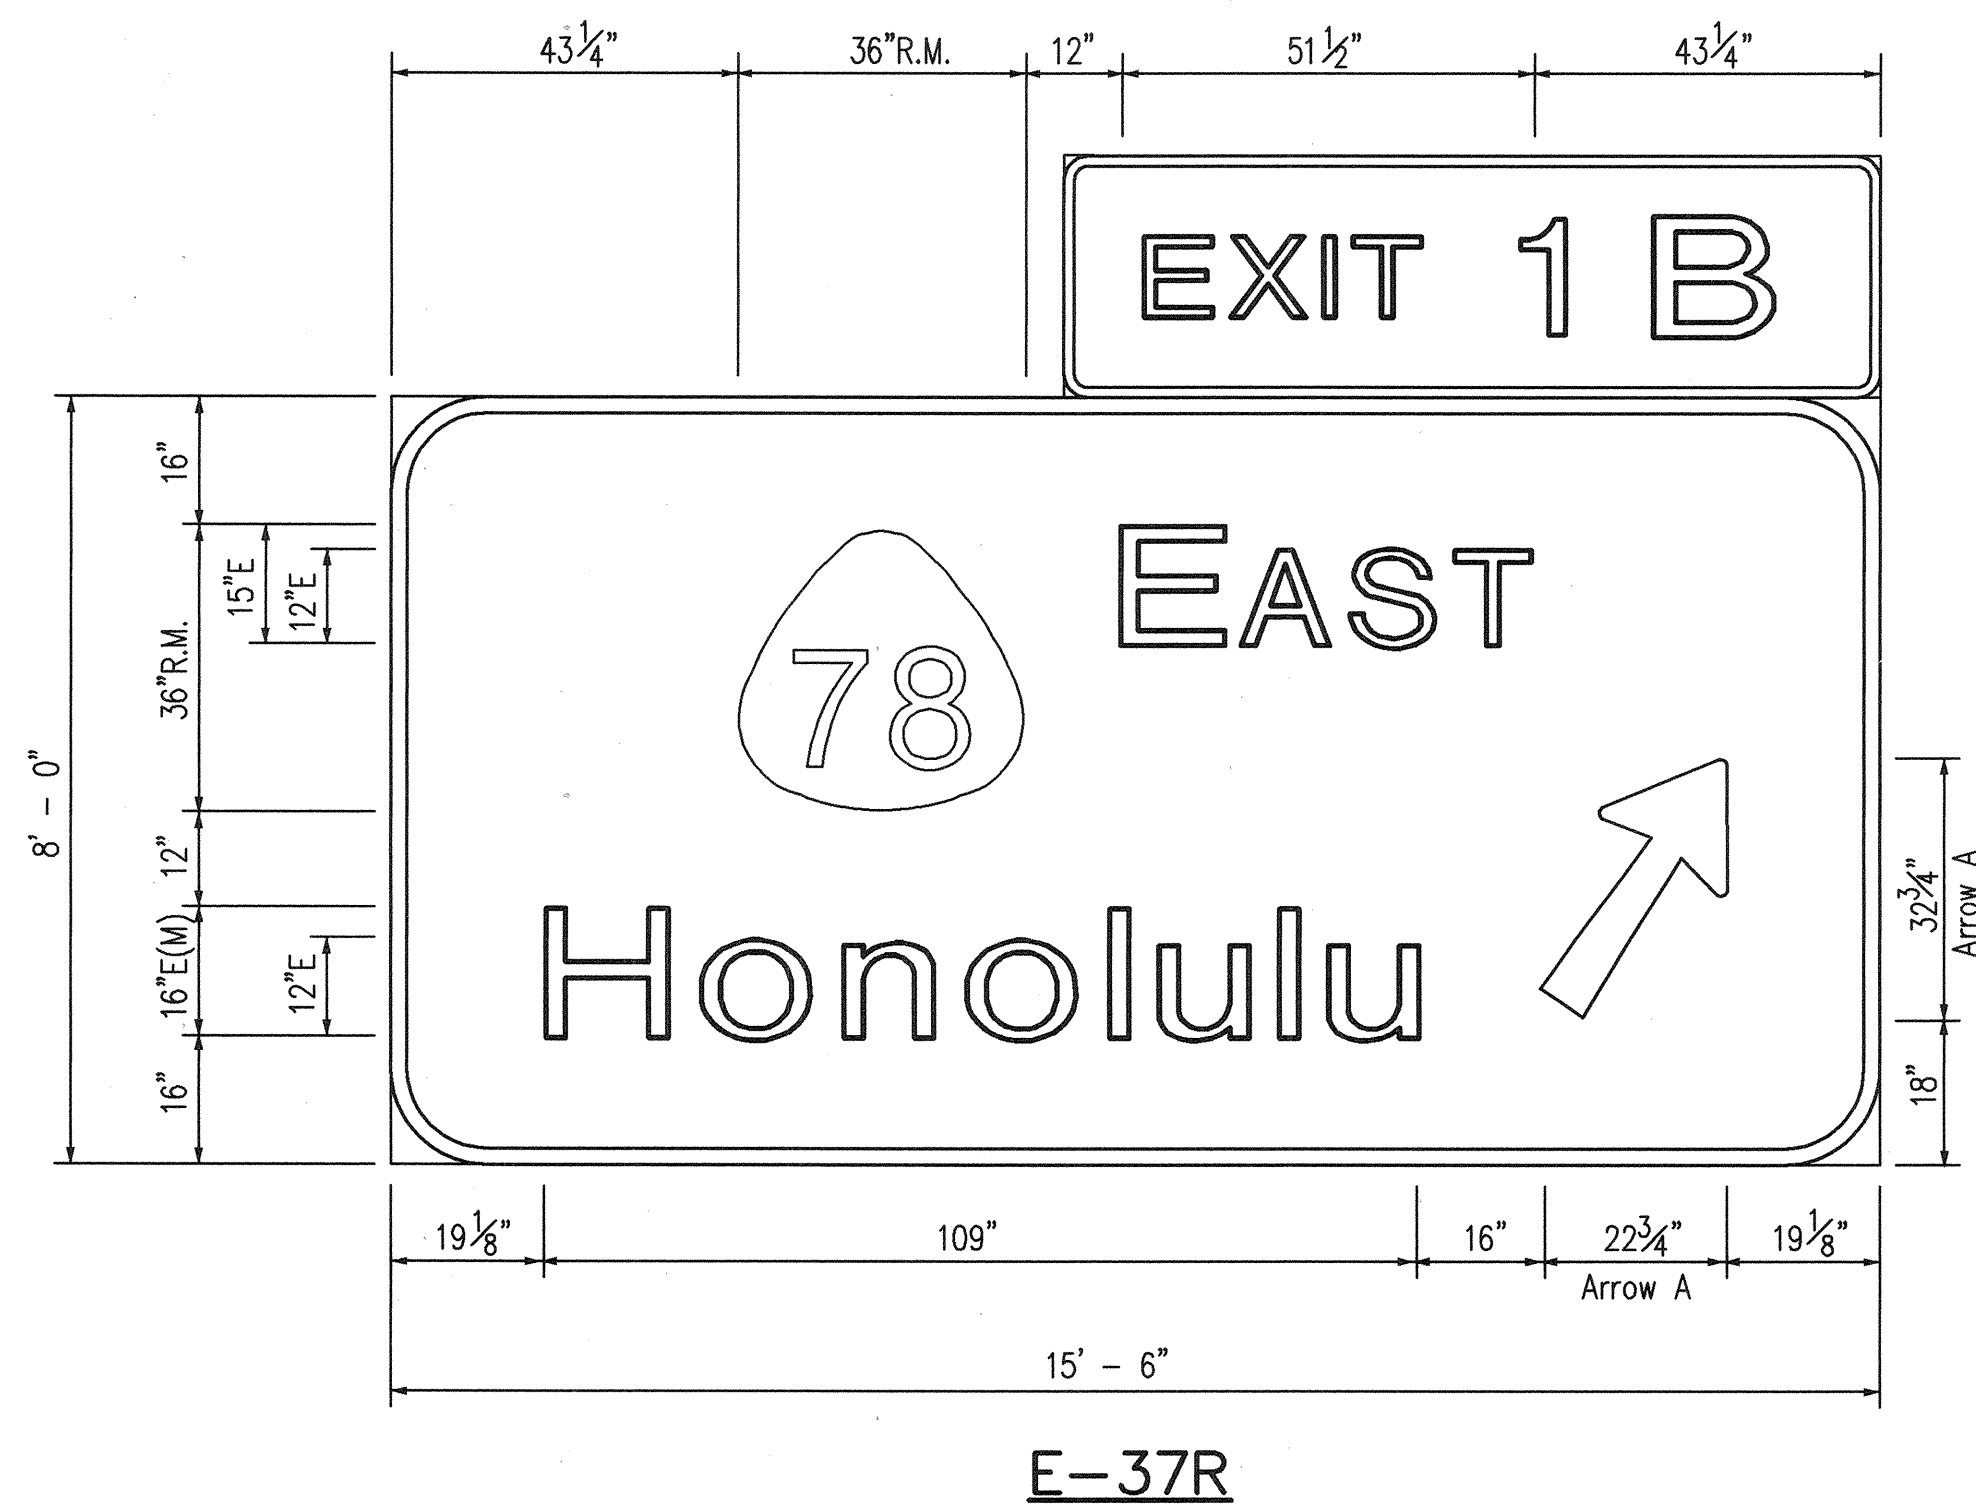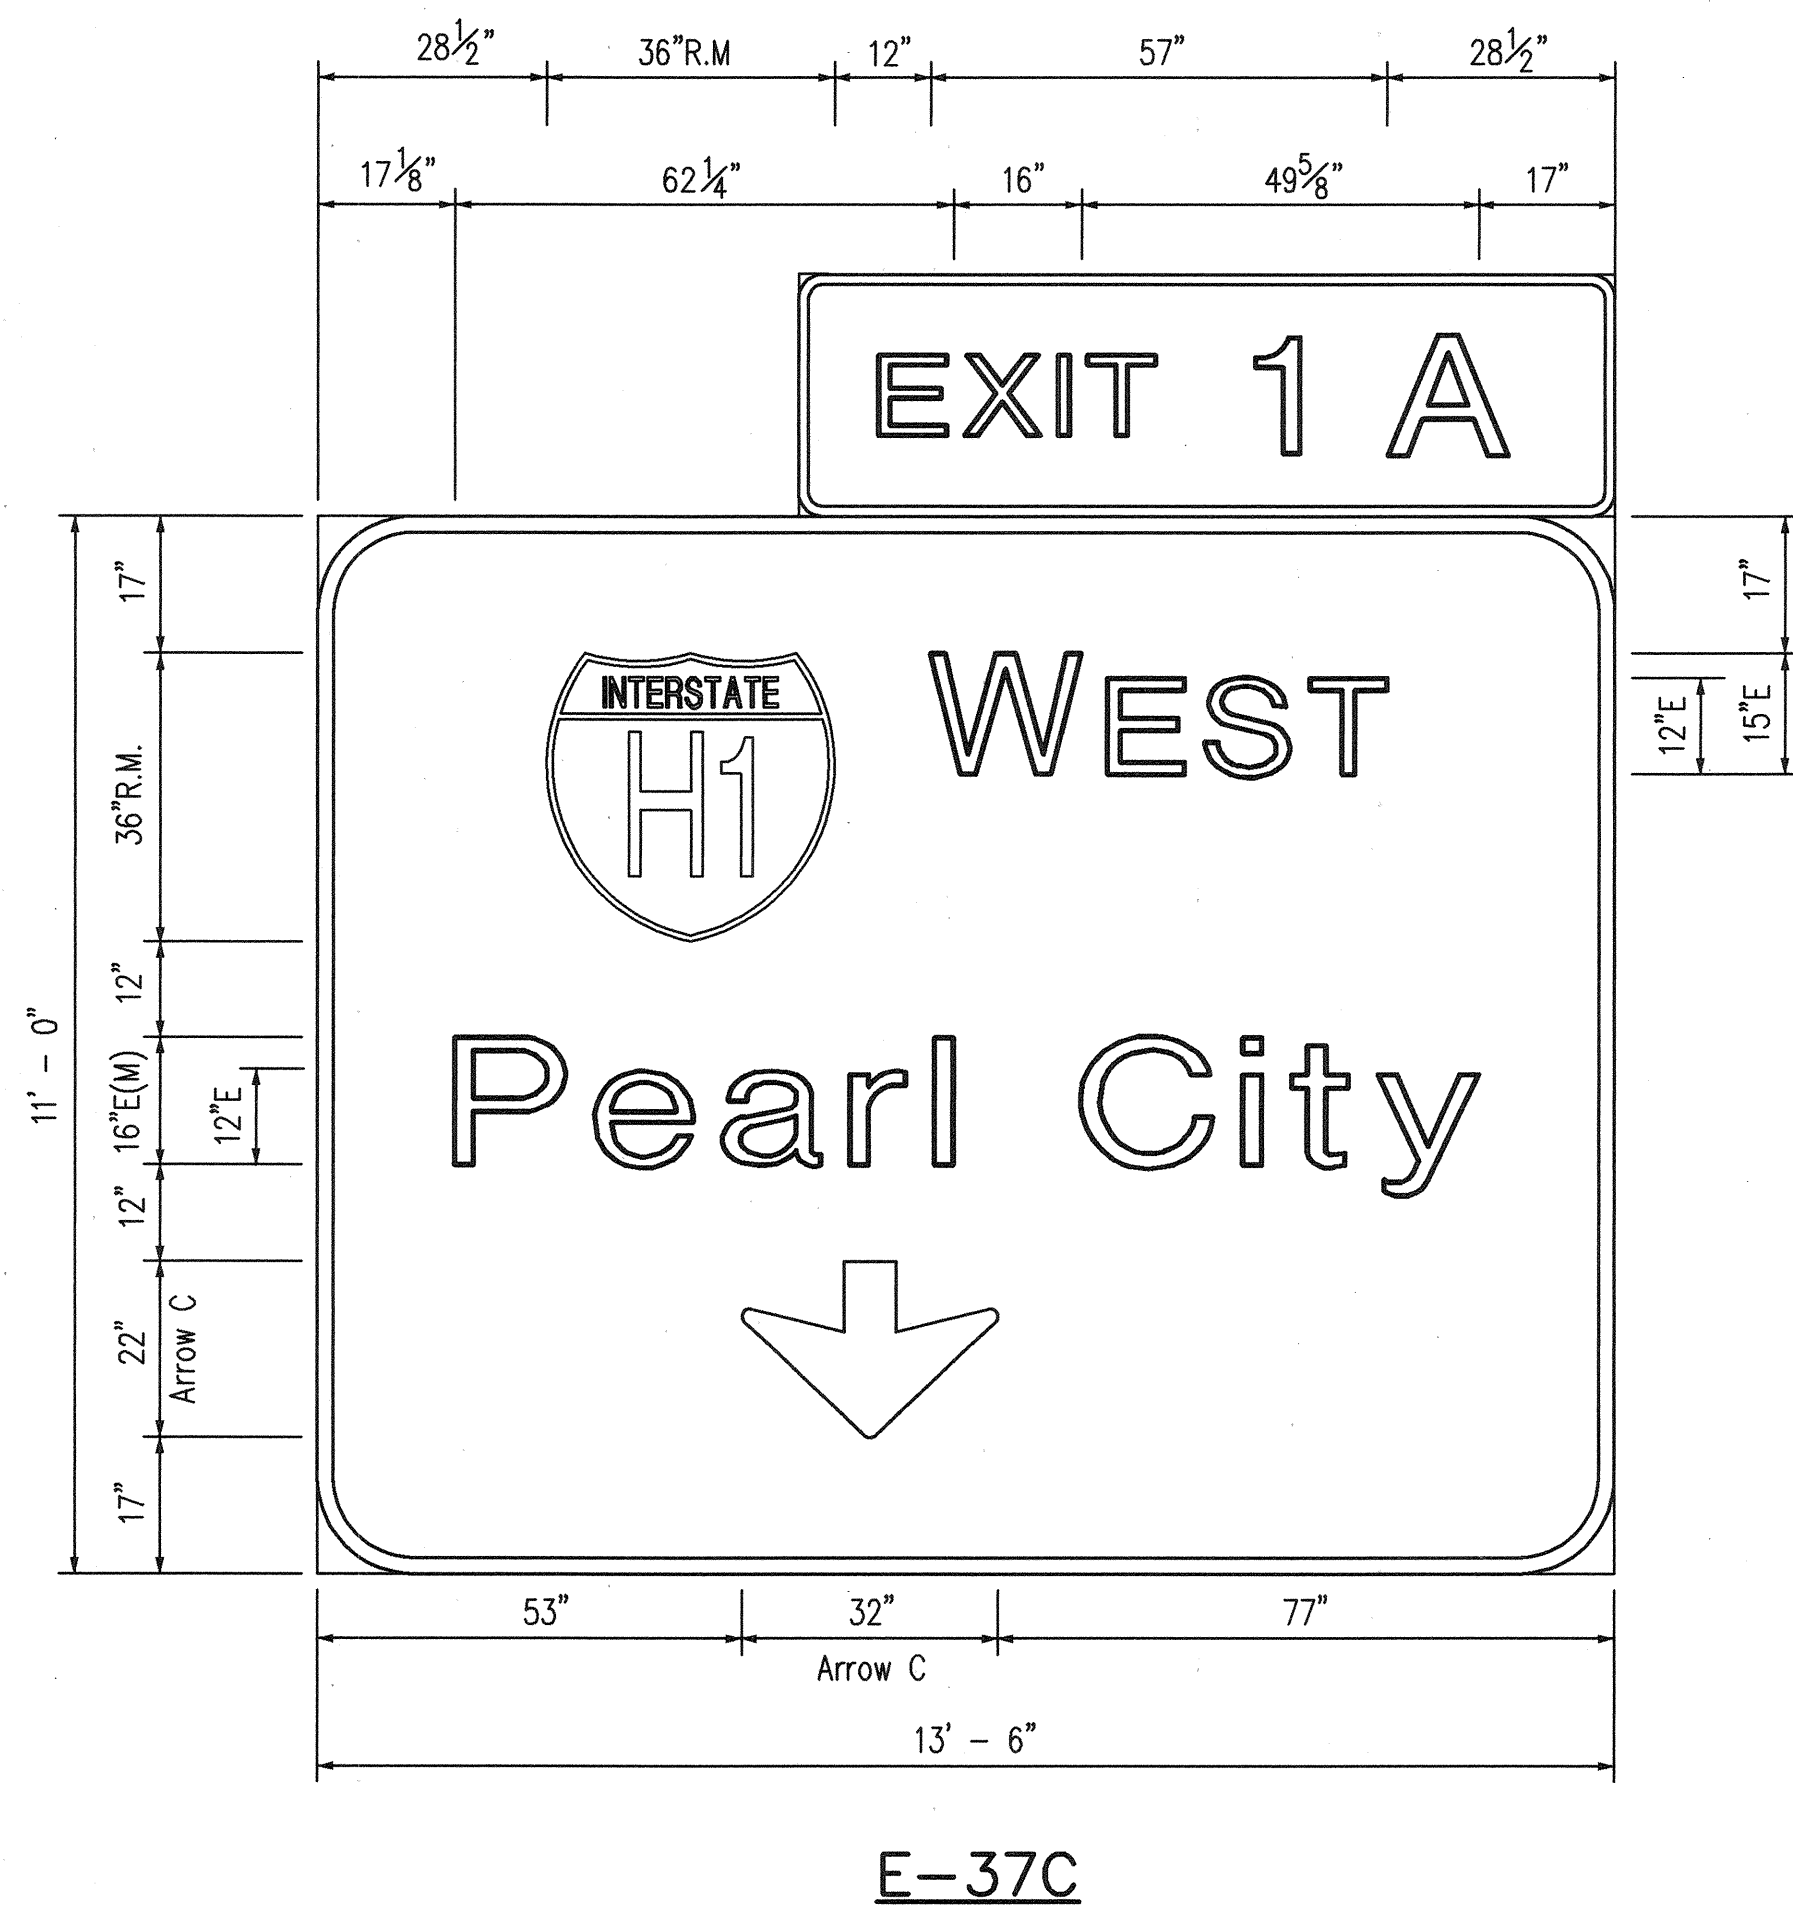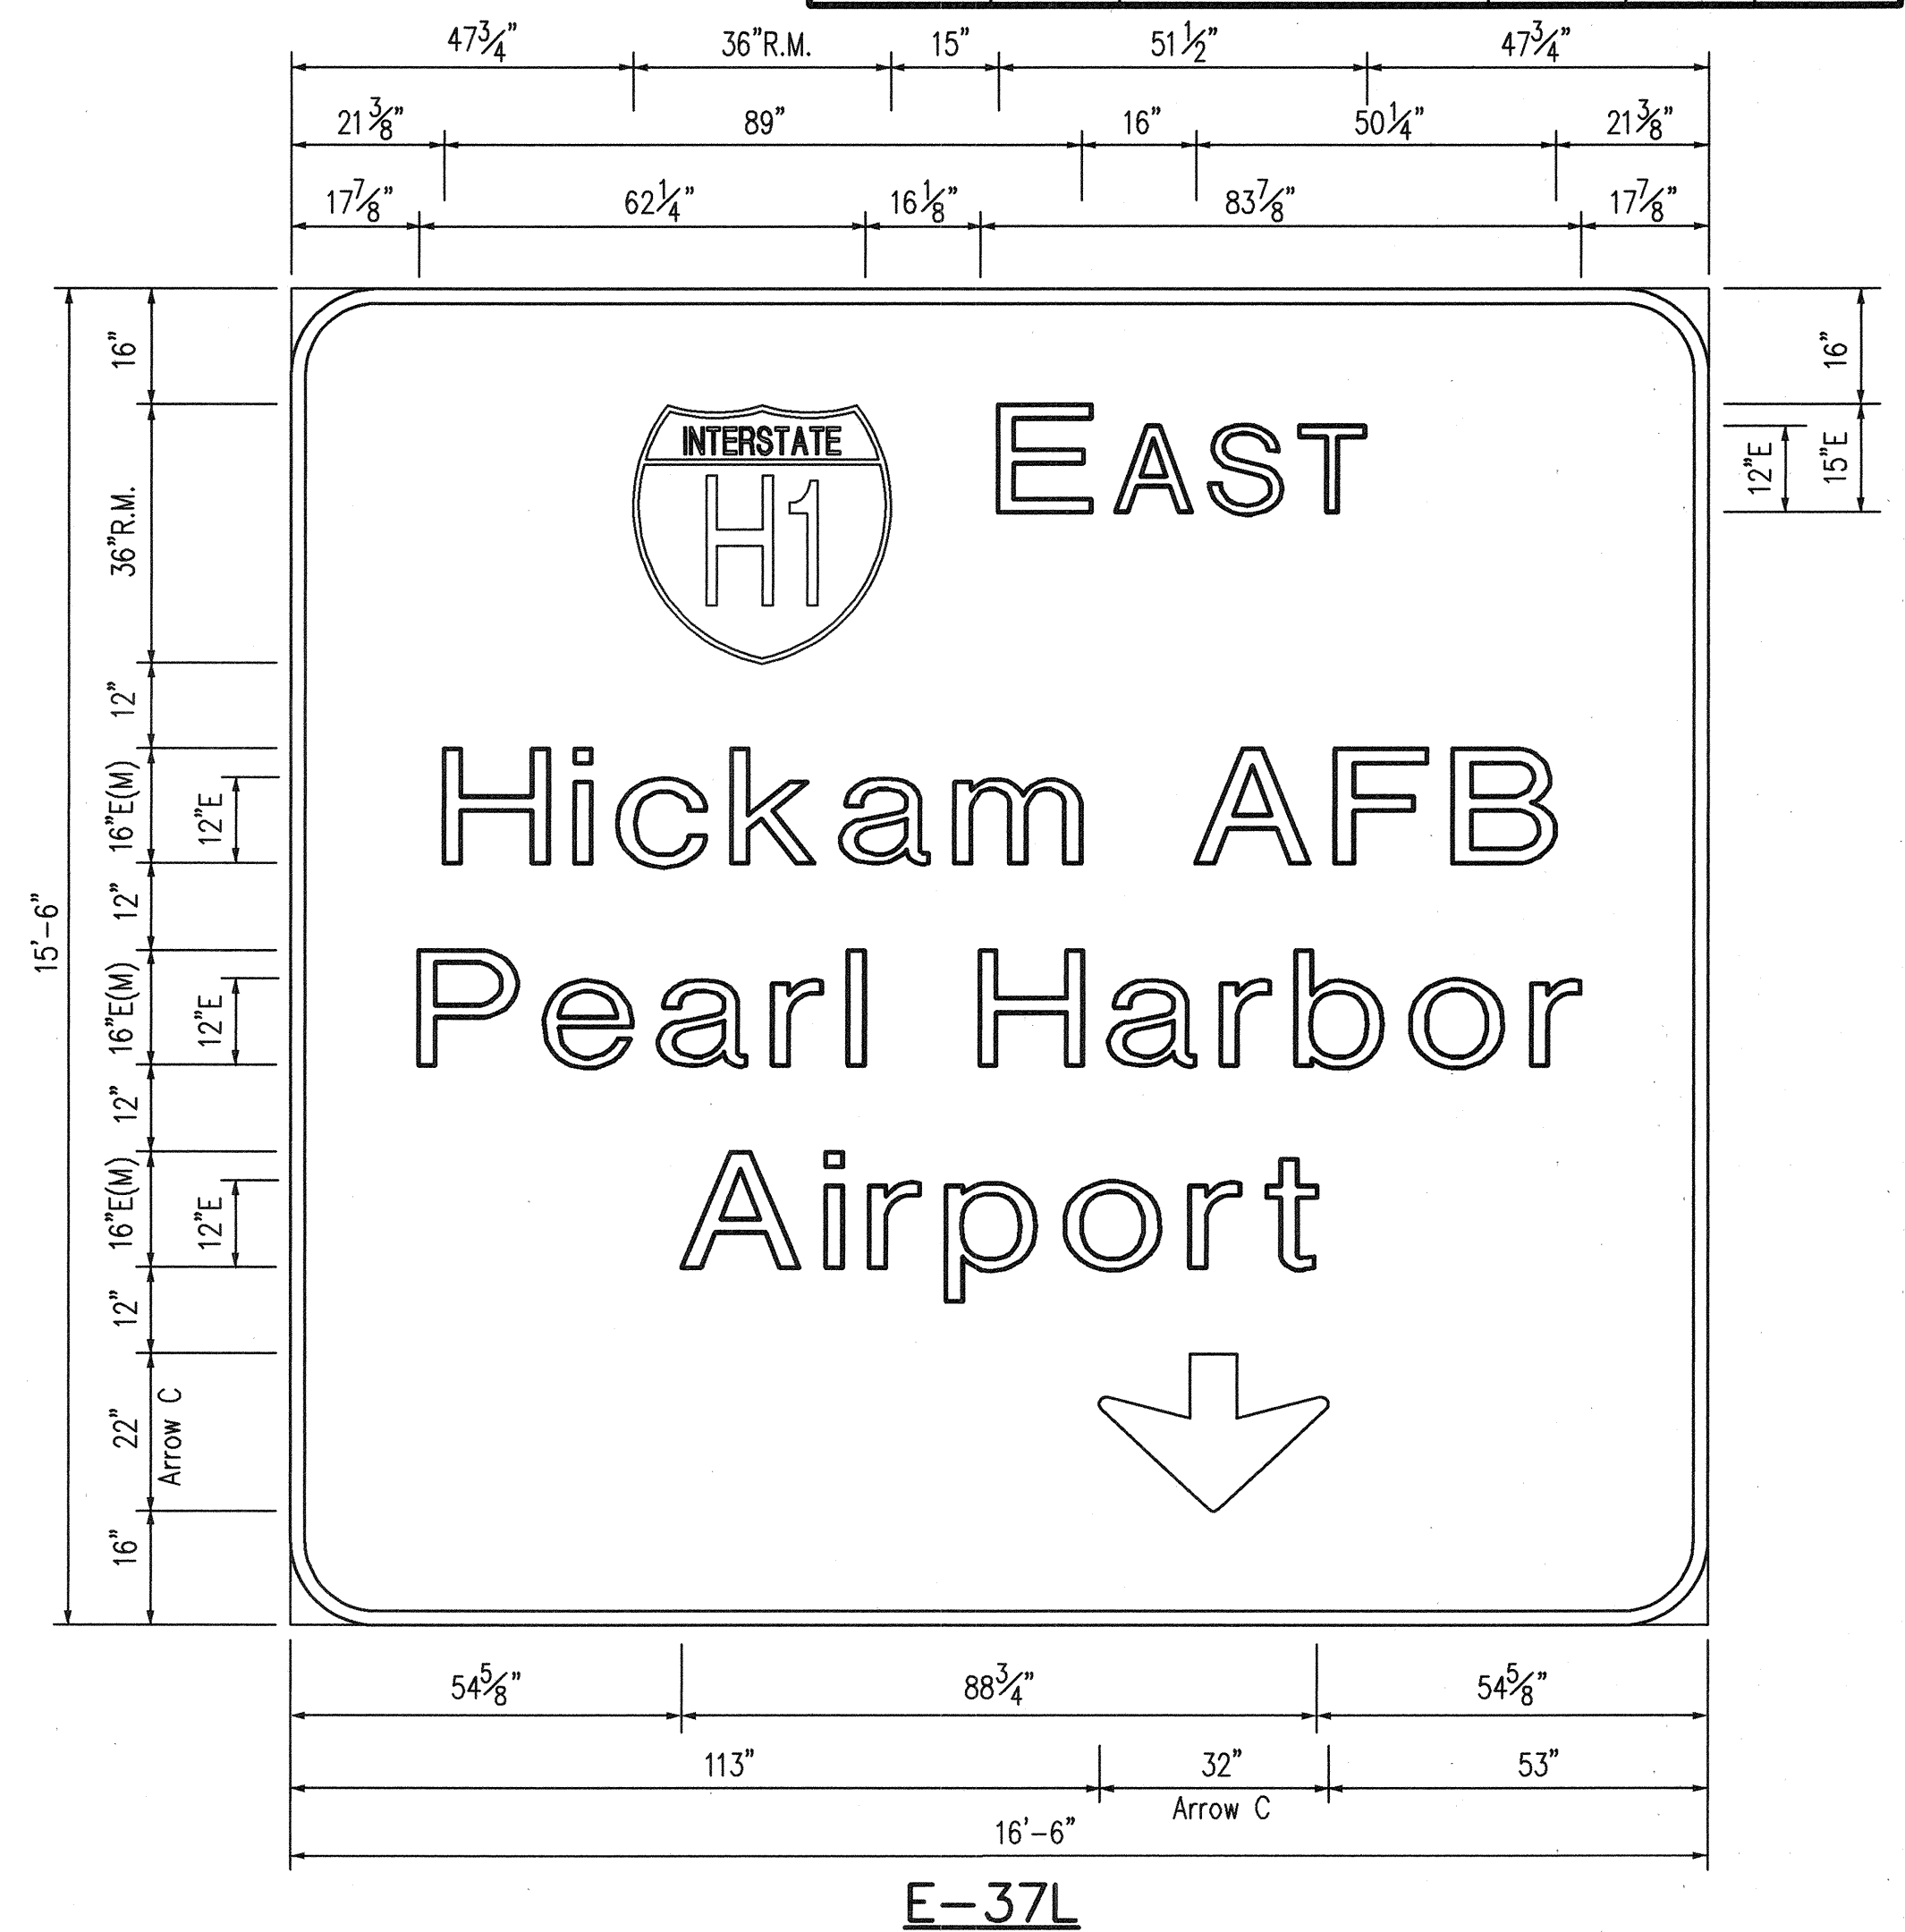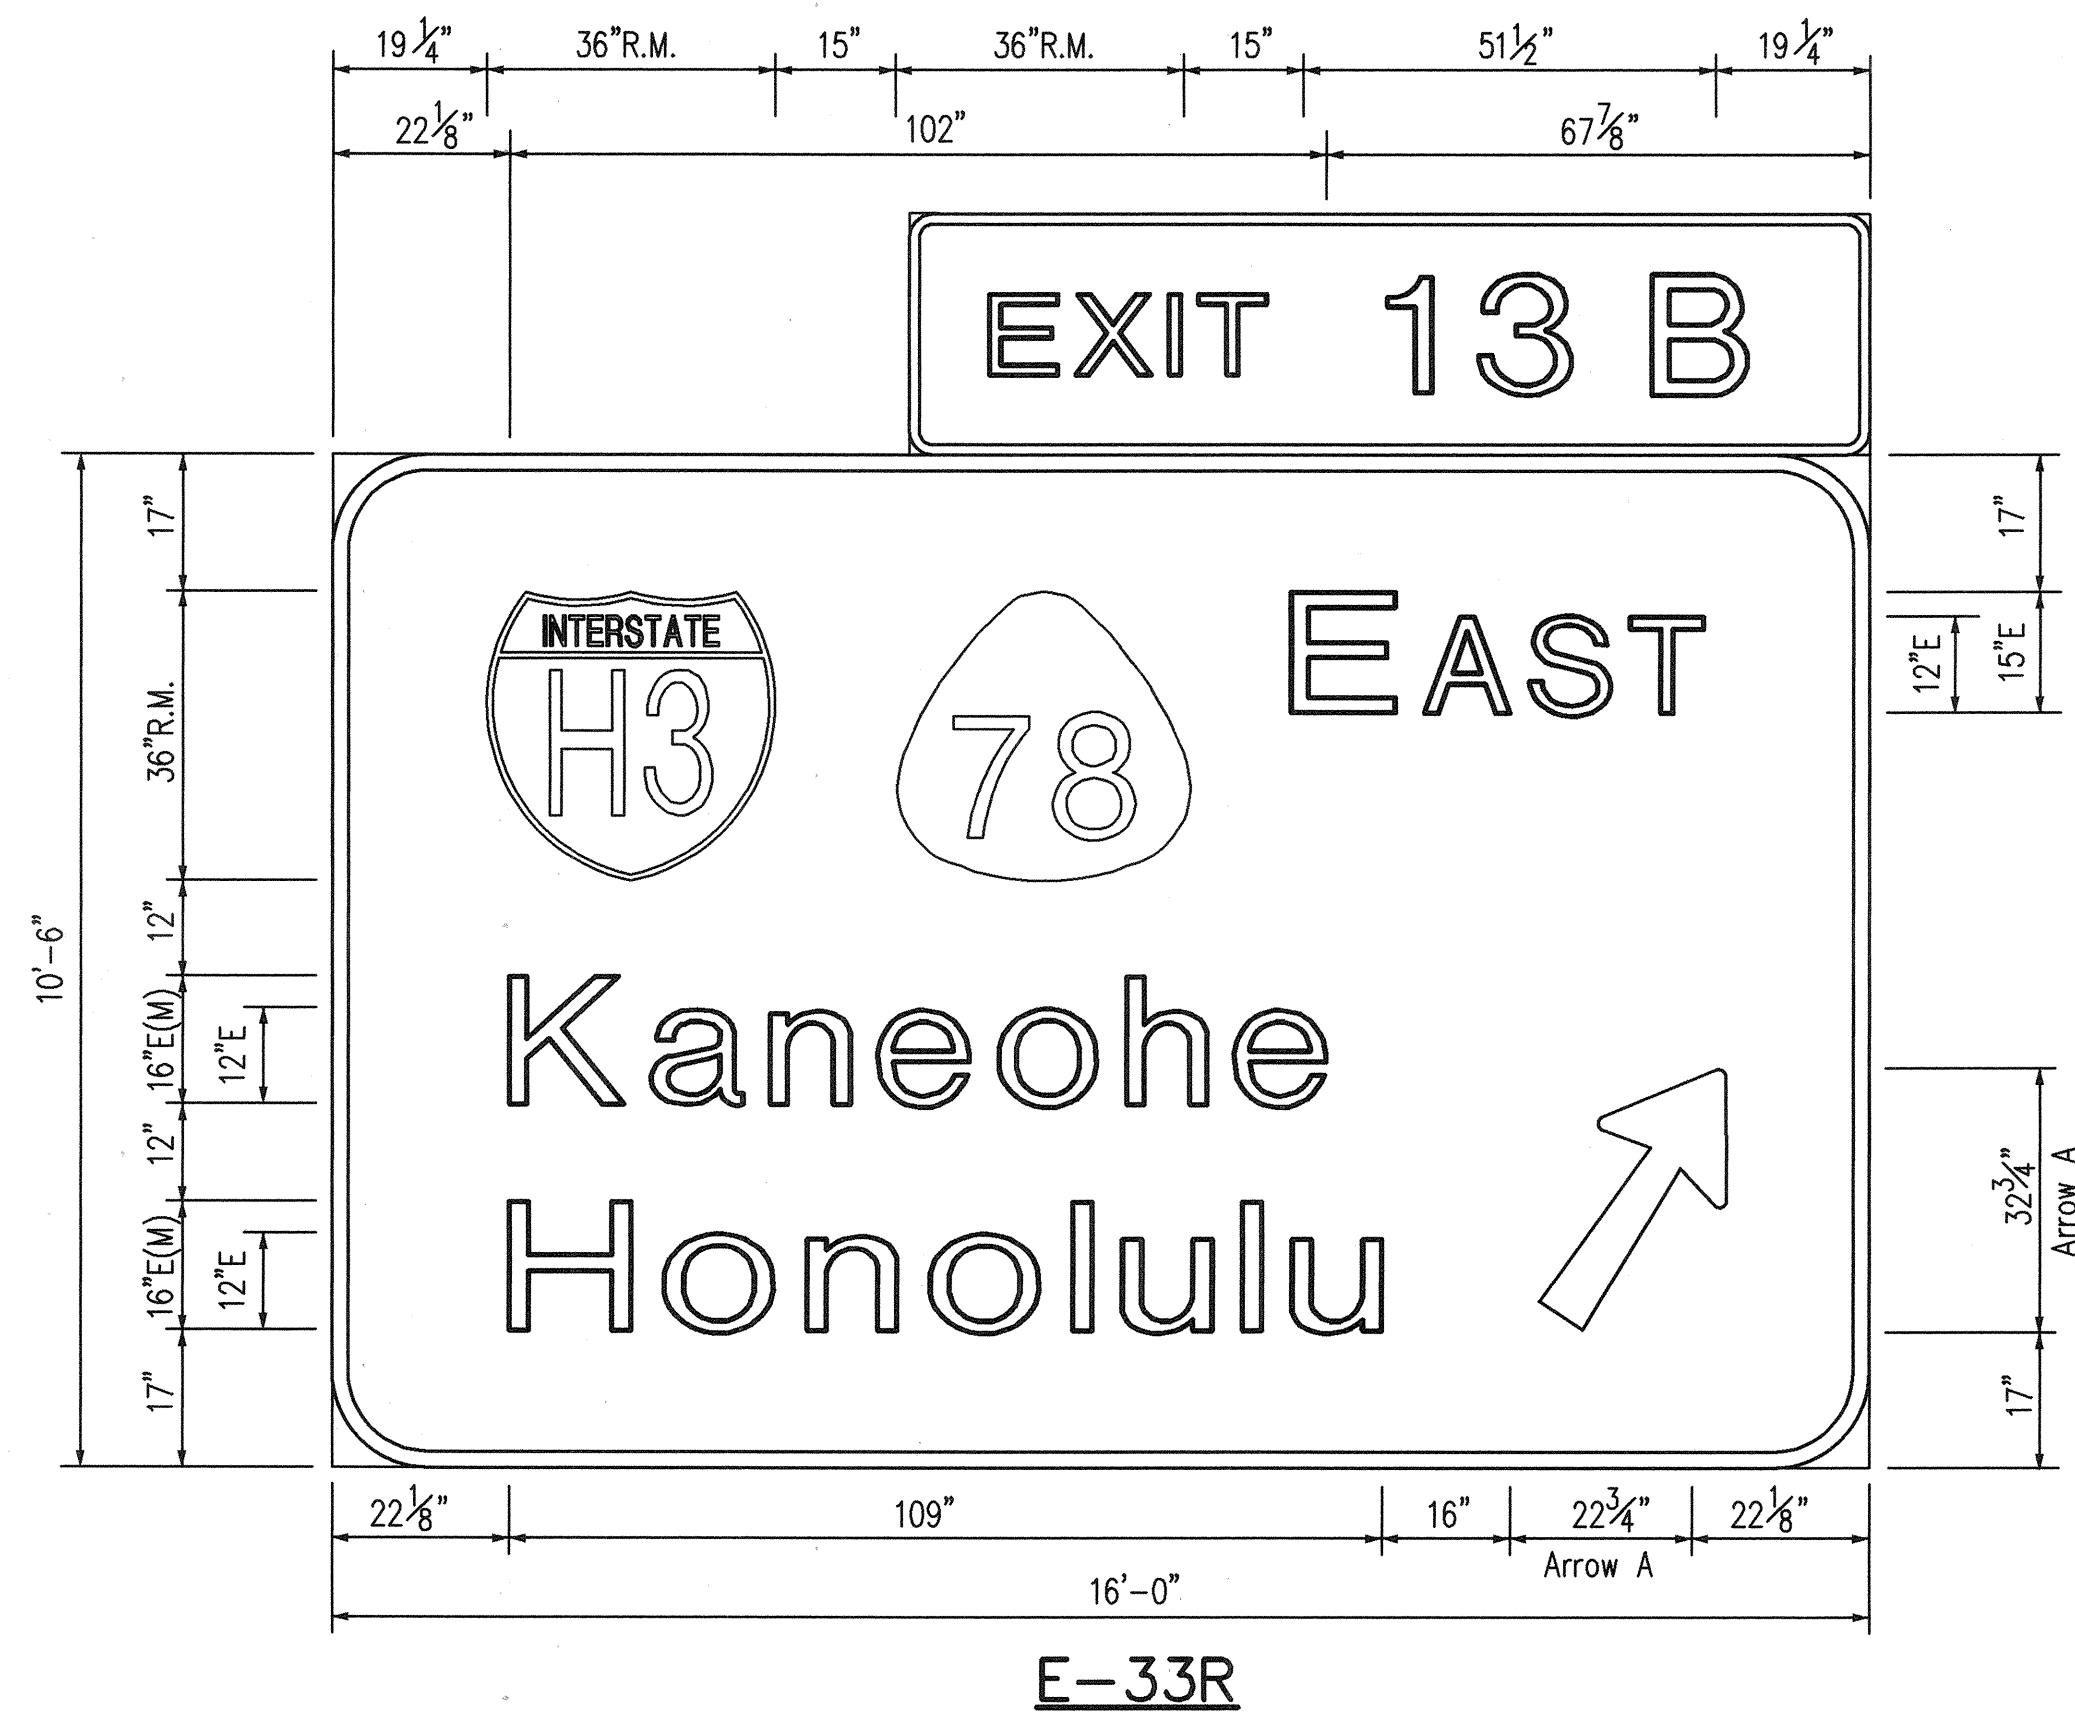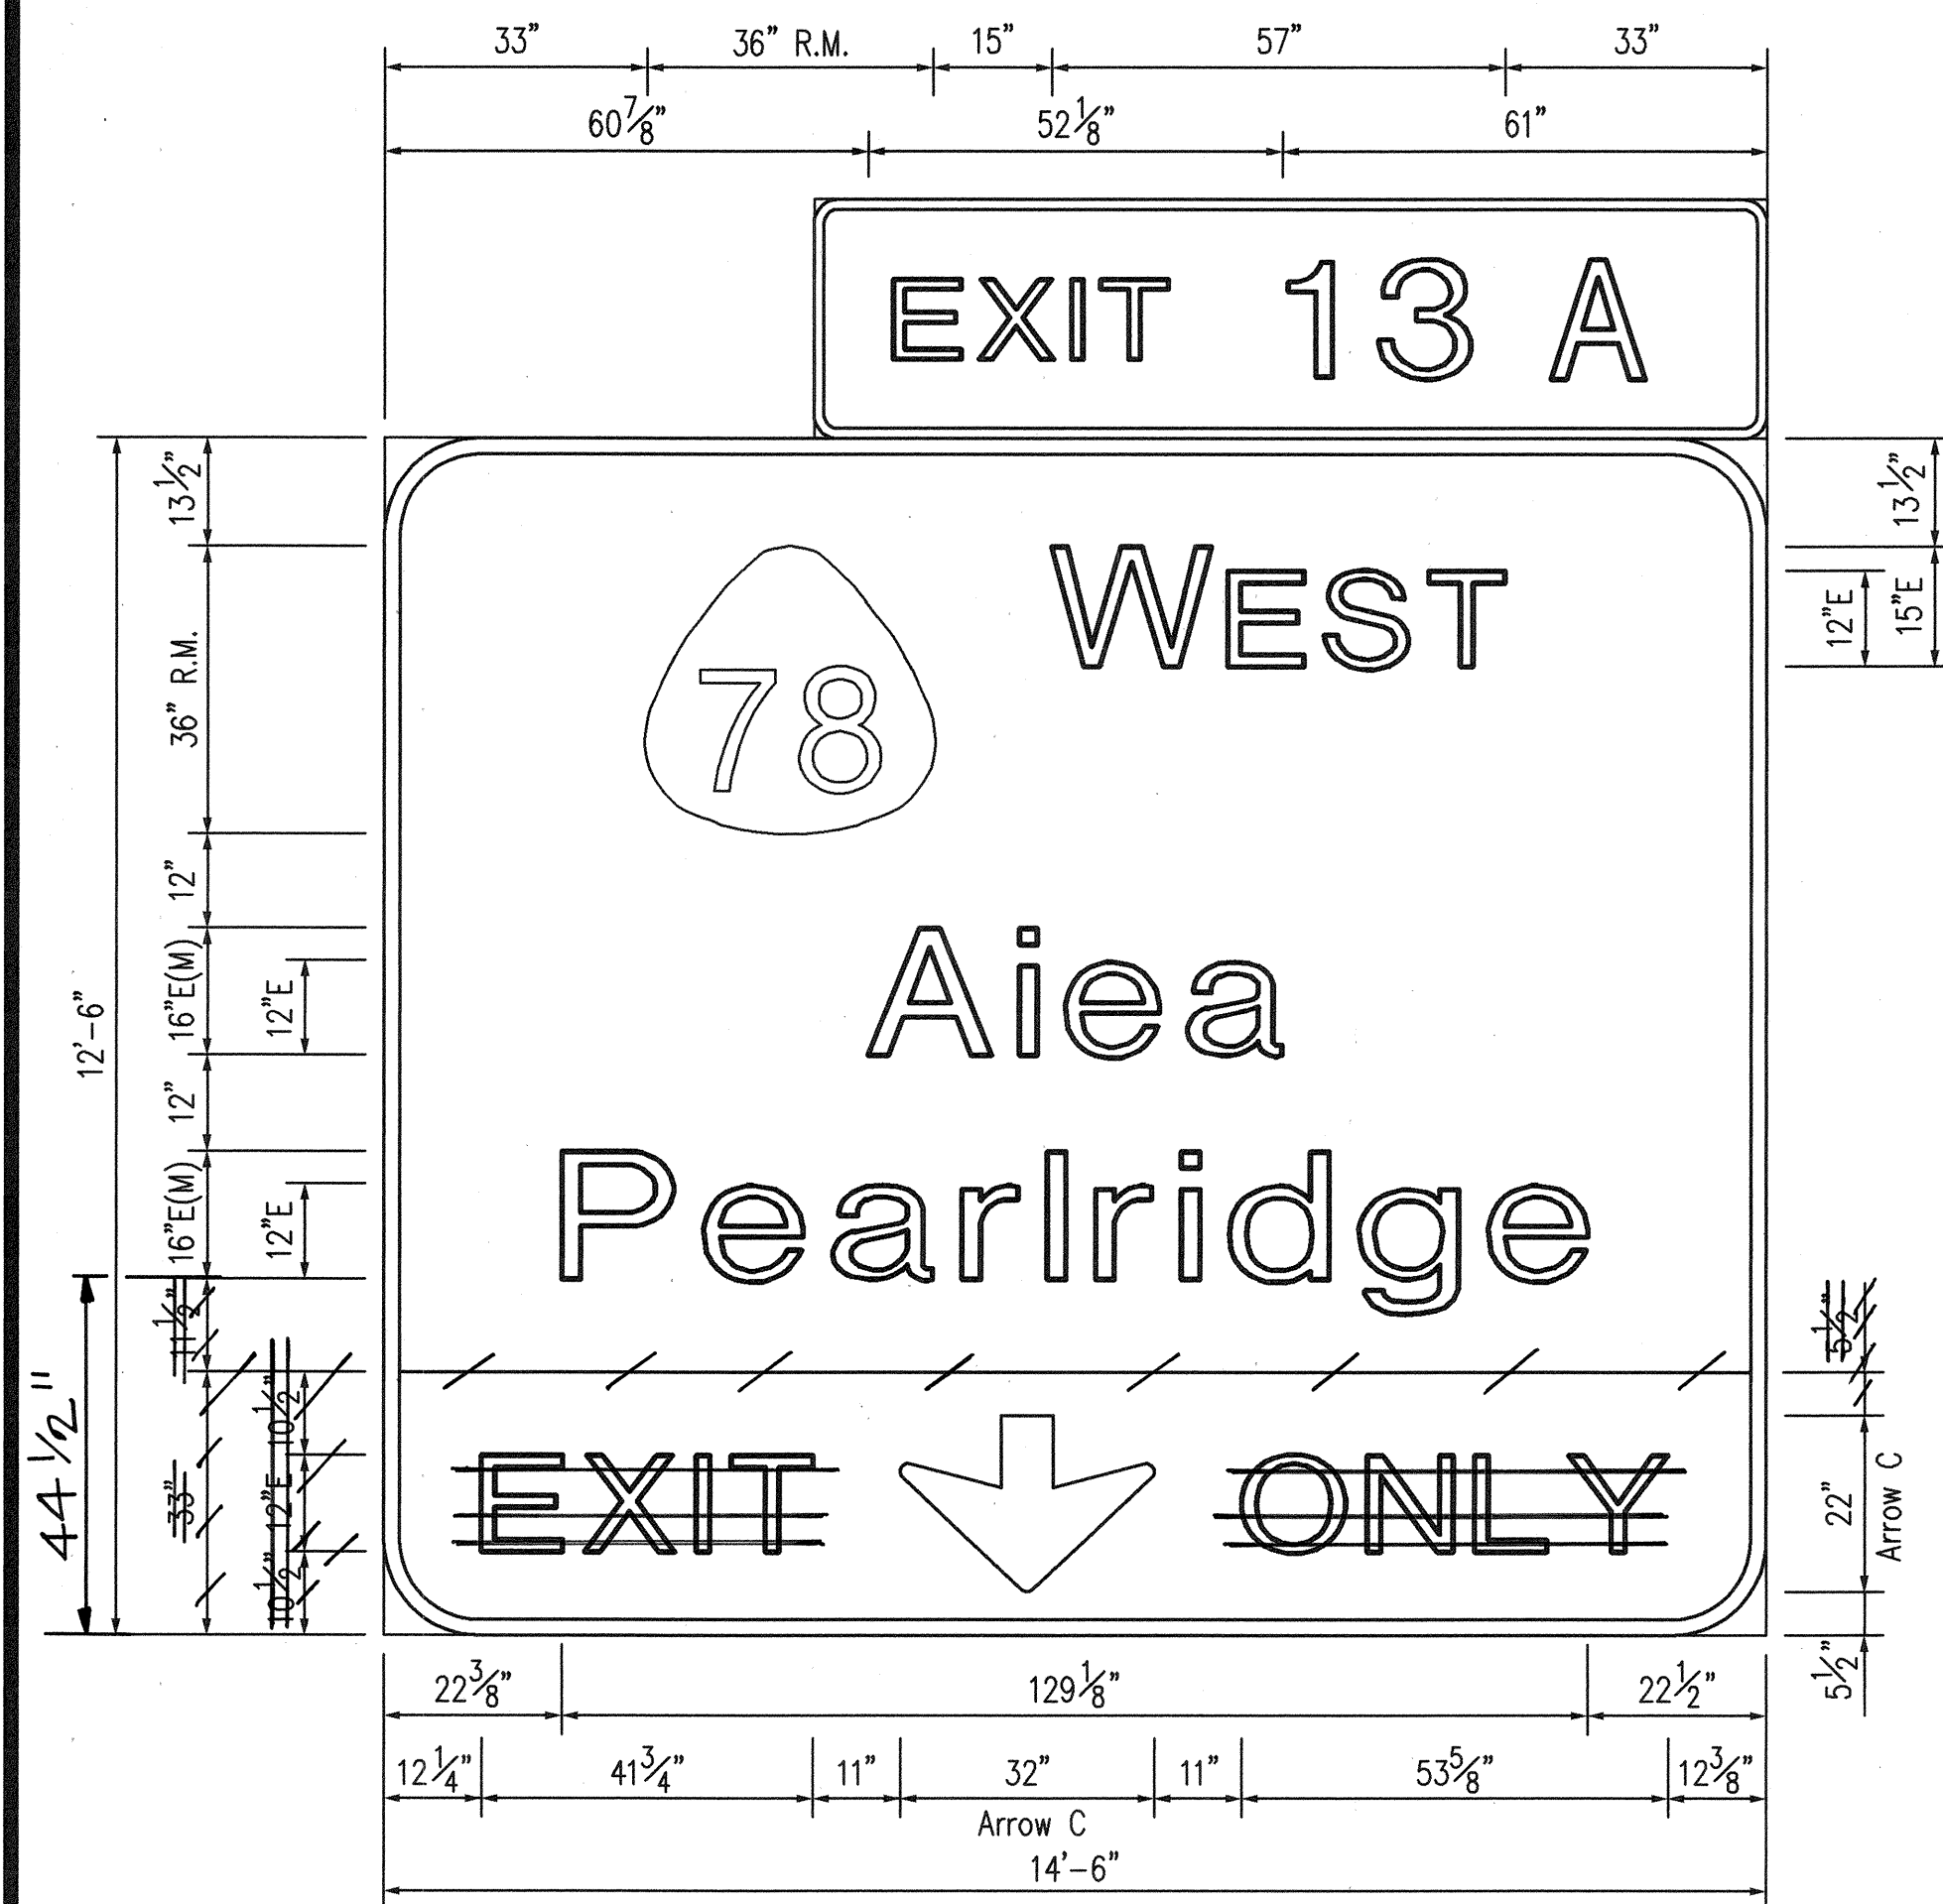

THIS WORK WAS PREPARED BY ME
OR UNDER MY SUPERVISION.
Randall M. Urasak







STATE OF HAWAII
DEPARTMENT OF TRANSPORTATION
HIGHWAYS DIVISION

**DESTINATION SIGNS
SIGN DETAILS
HALAWA INTERCHANGE**

H-3 FINISH (UNIT II)
FAIP NO. I-H3-1(75), UNIT II
LEEWARD SECTION

SCALE: 1/2" = 1'-0" DATE: JANUARY 1997
SHEET NO. 6P10 OF 20 SHEETS

FED. ROAD DIST. NO.	STATE	FED. AID PROJ. NO.	FISCAL YEAR	SHEET NO.	TOTAL SHEETS
HAWAII	HAW.	I-H3-1(75), UNIT II	1997	861	1102

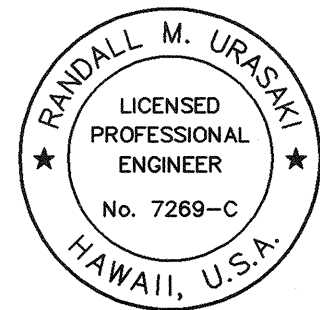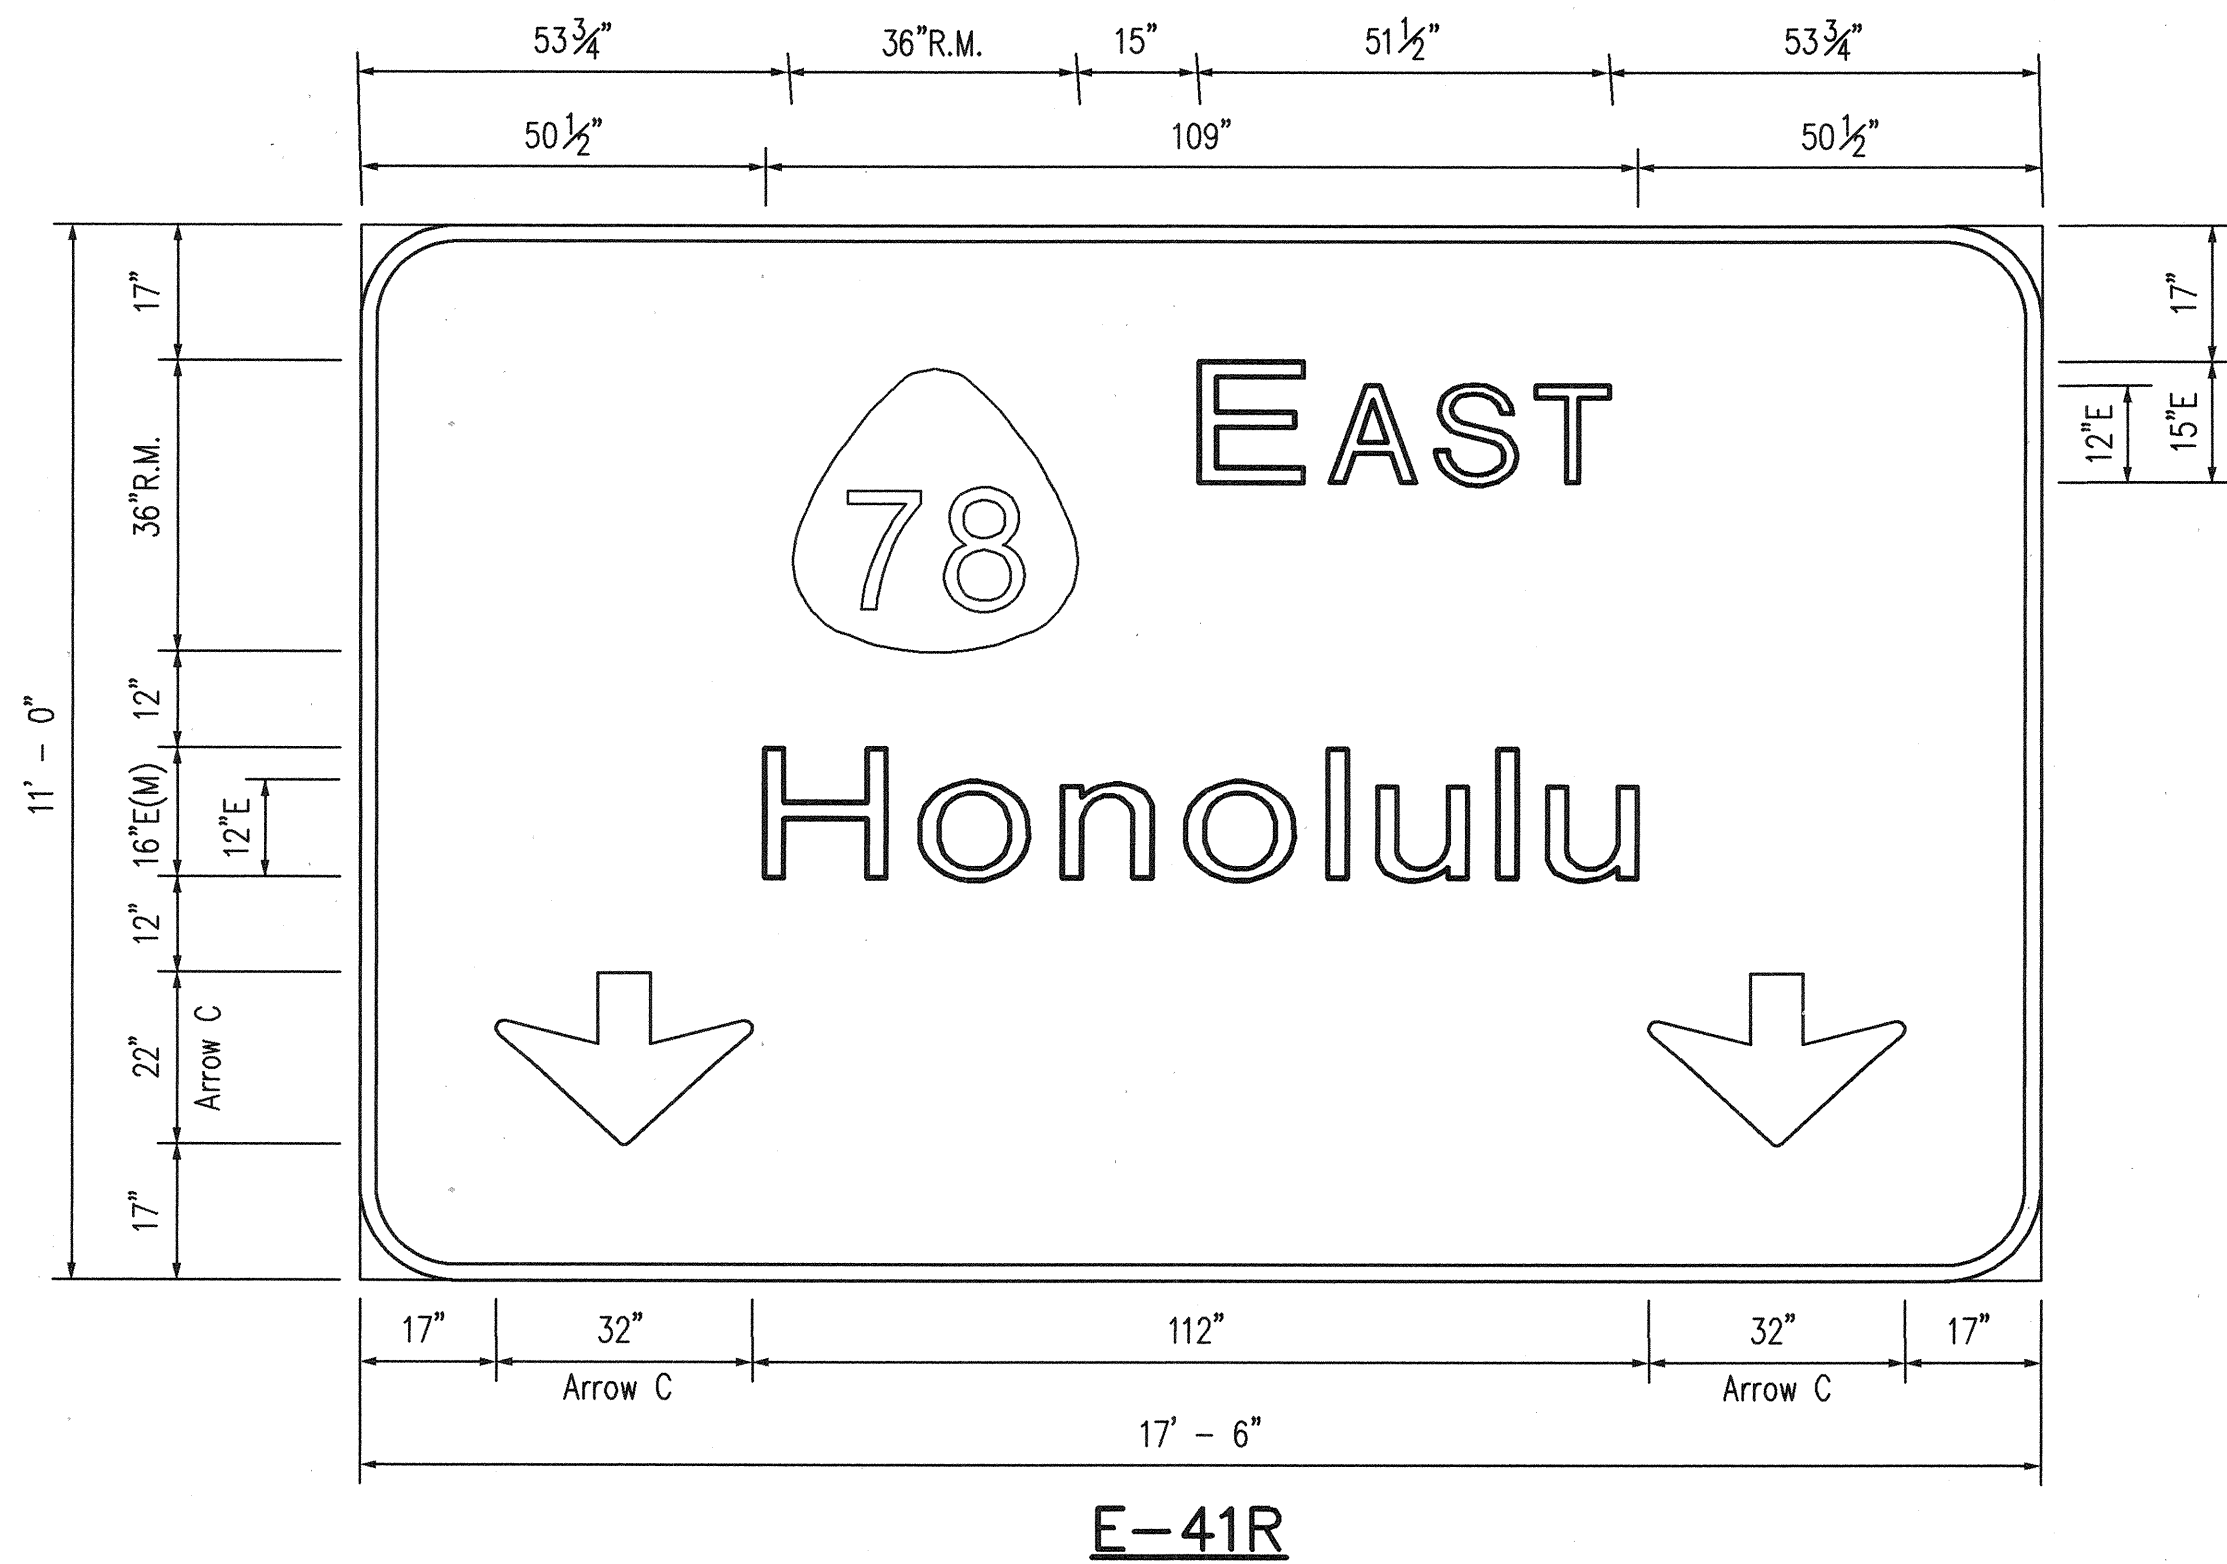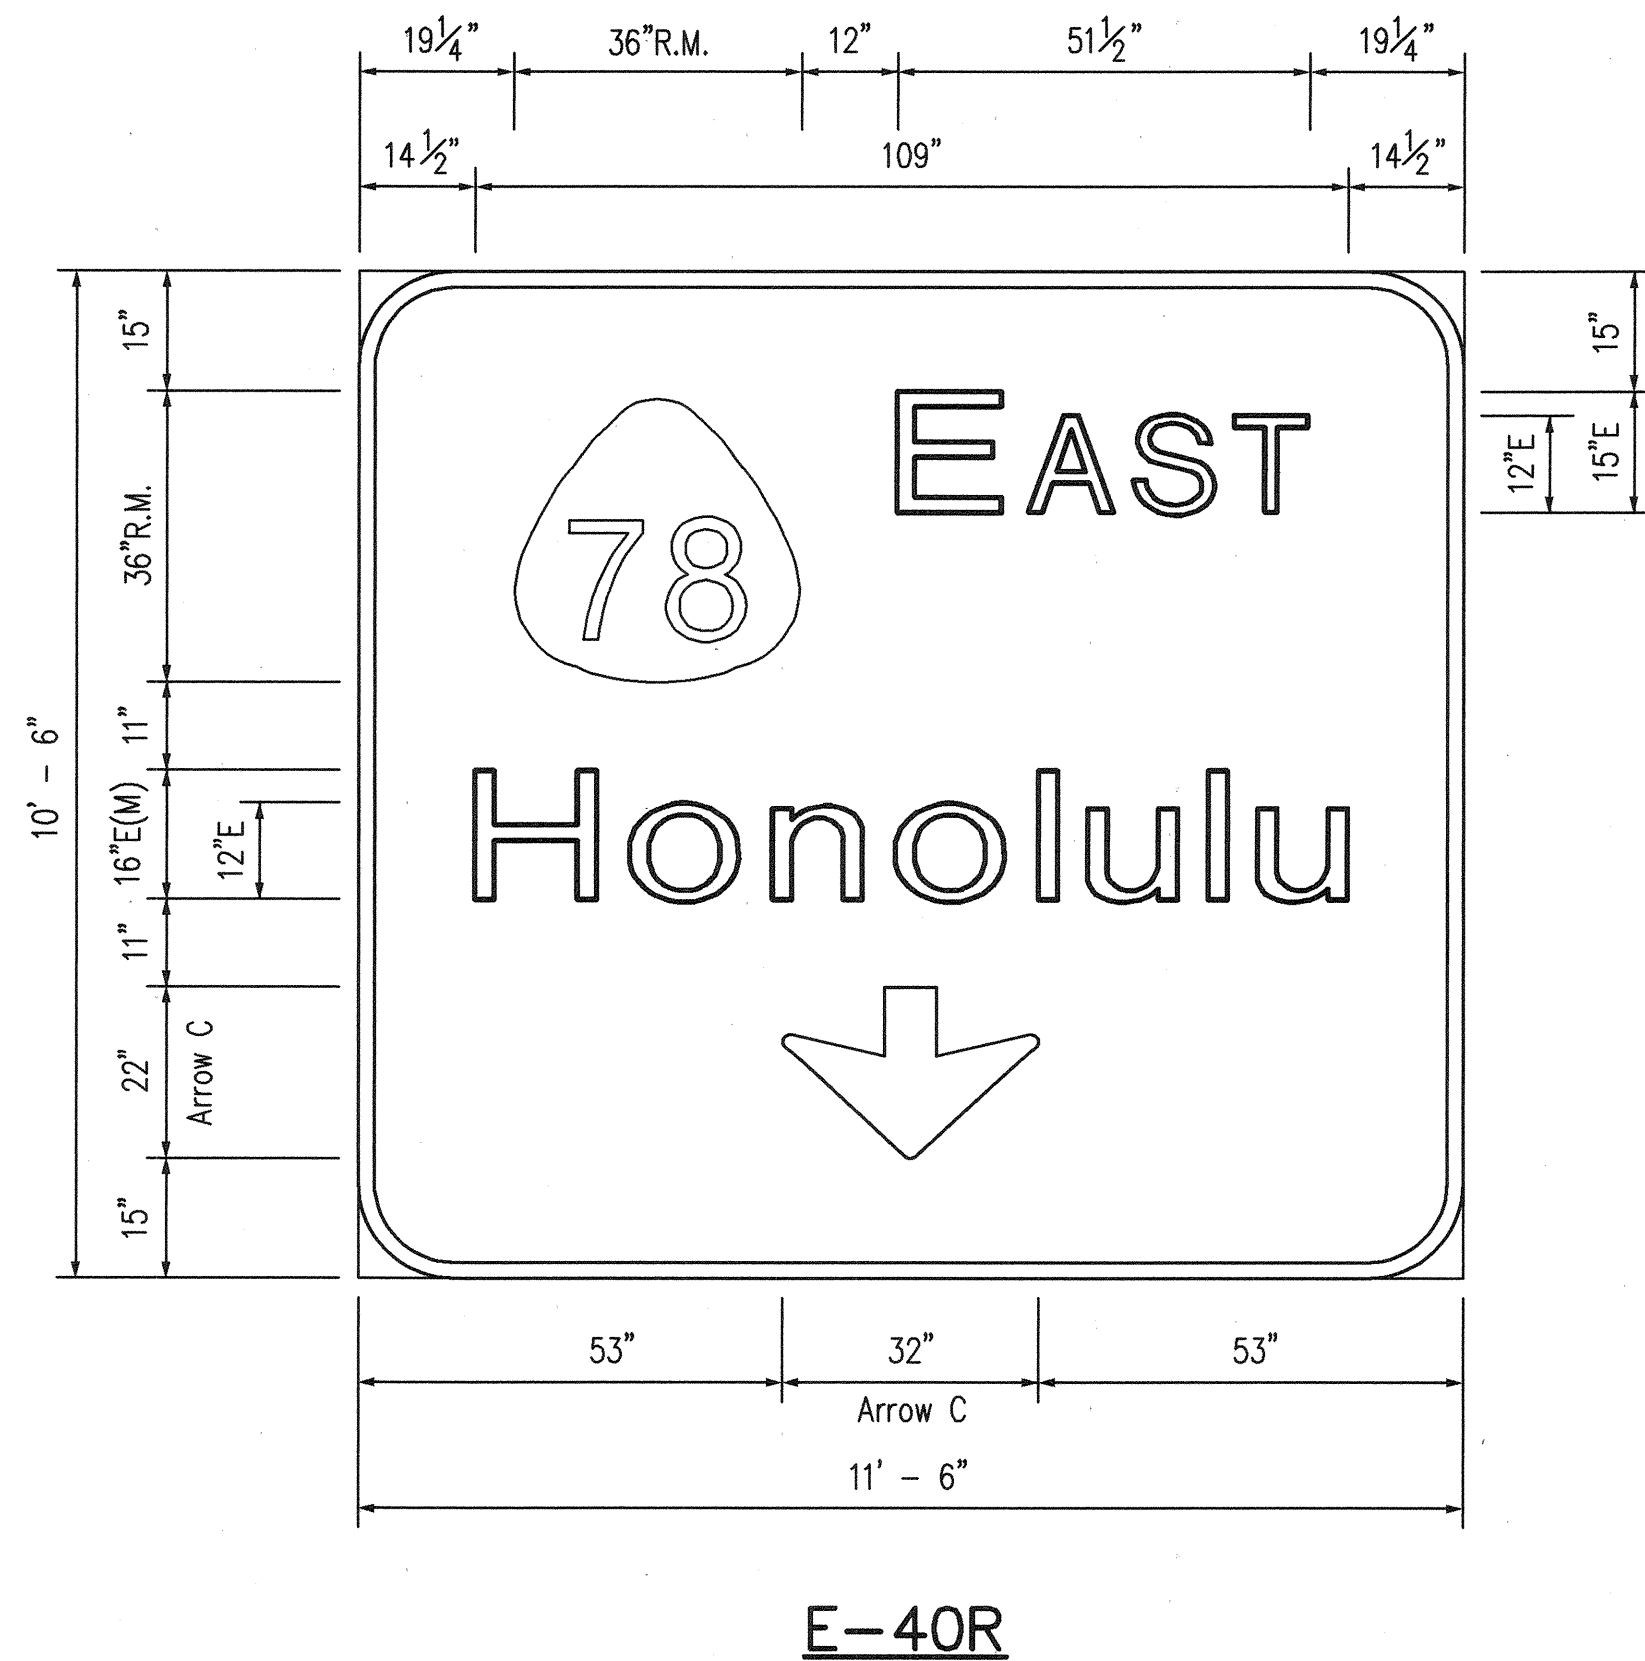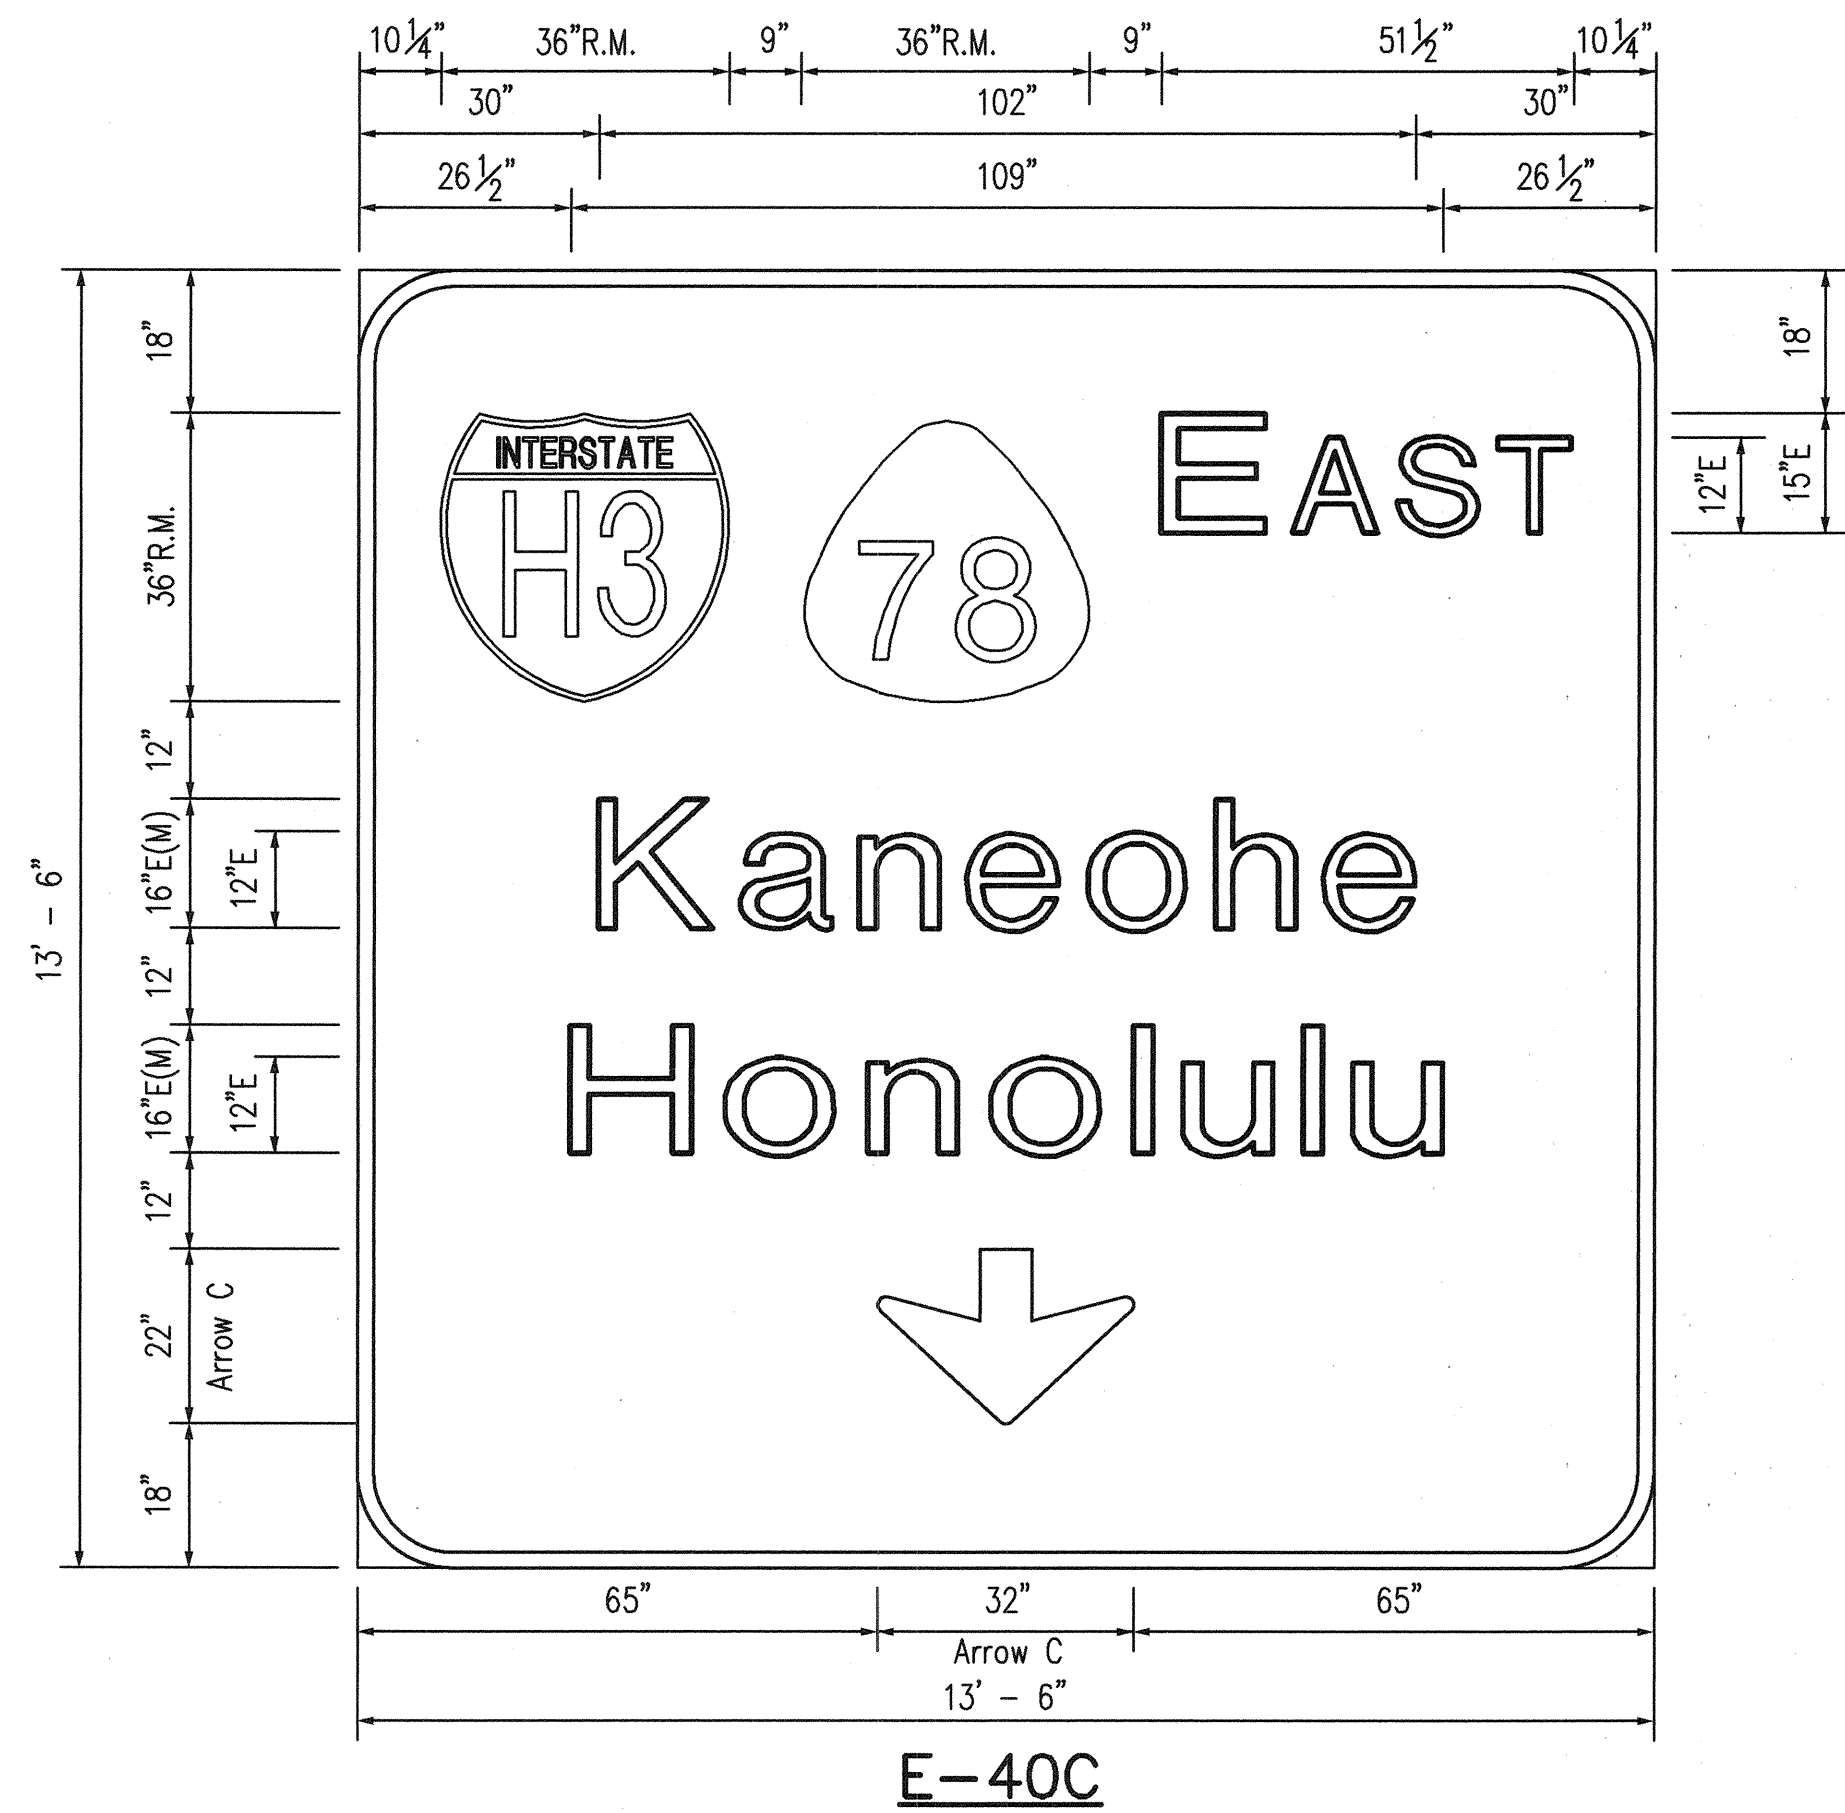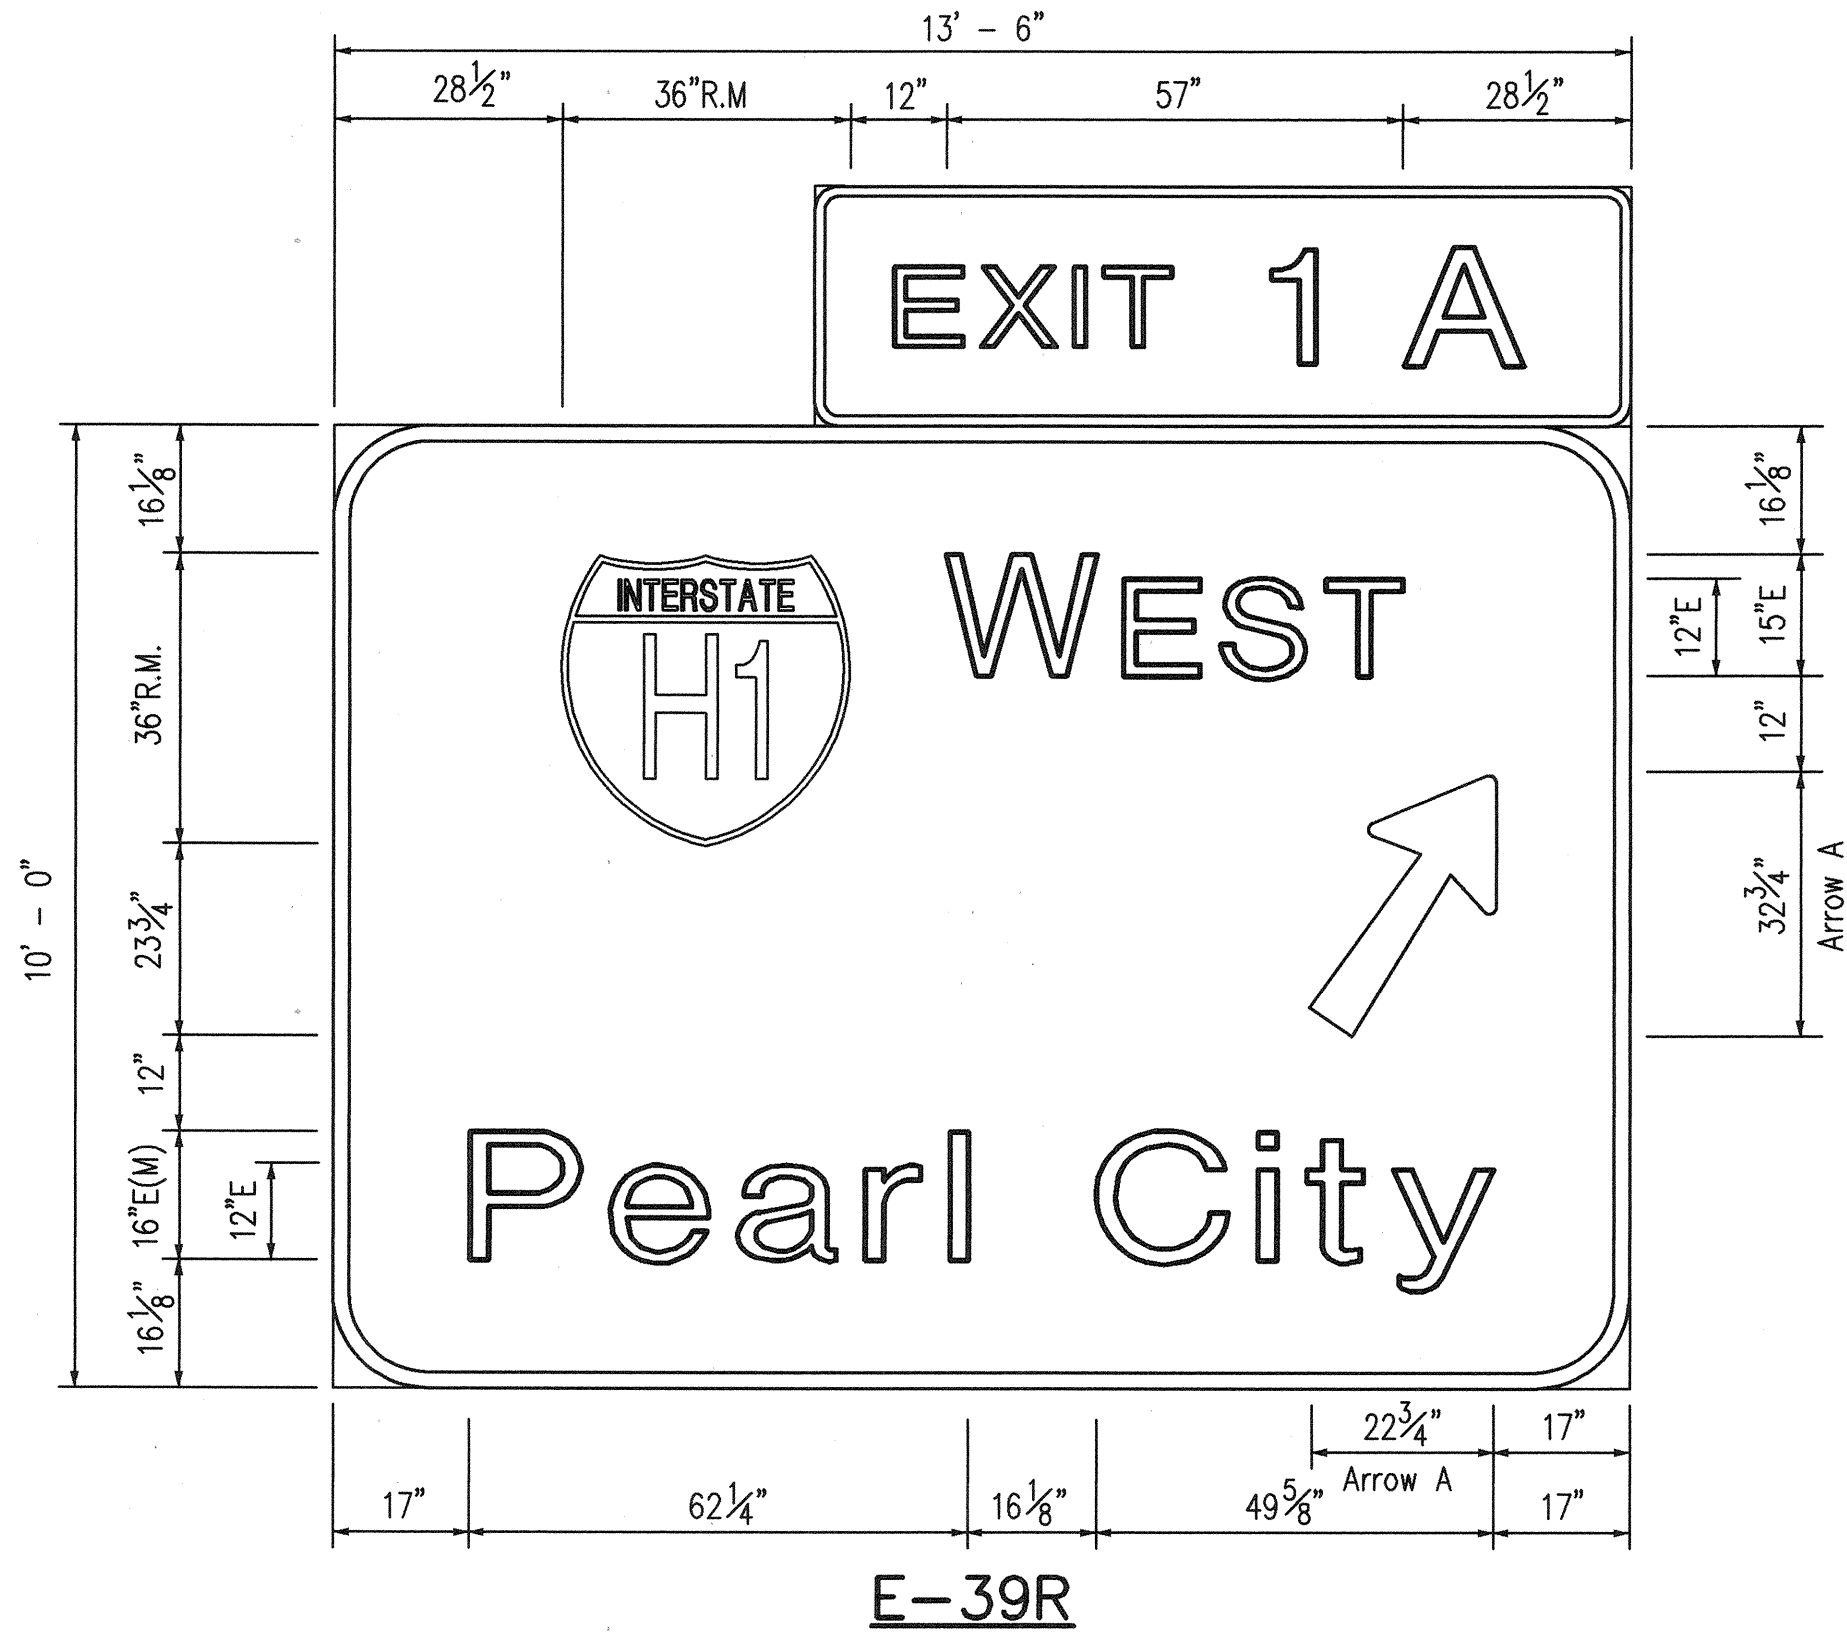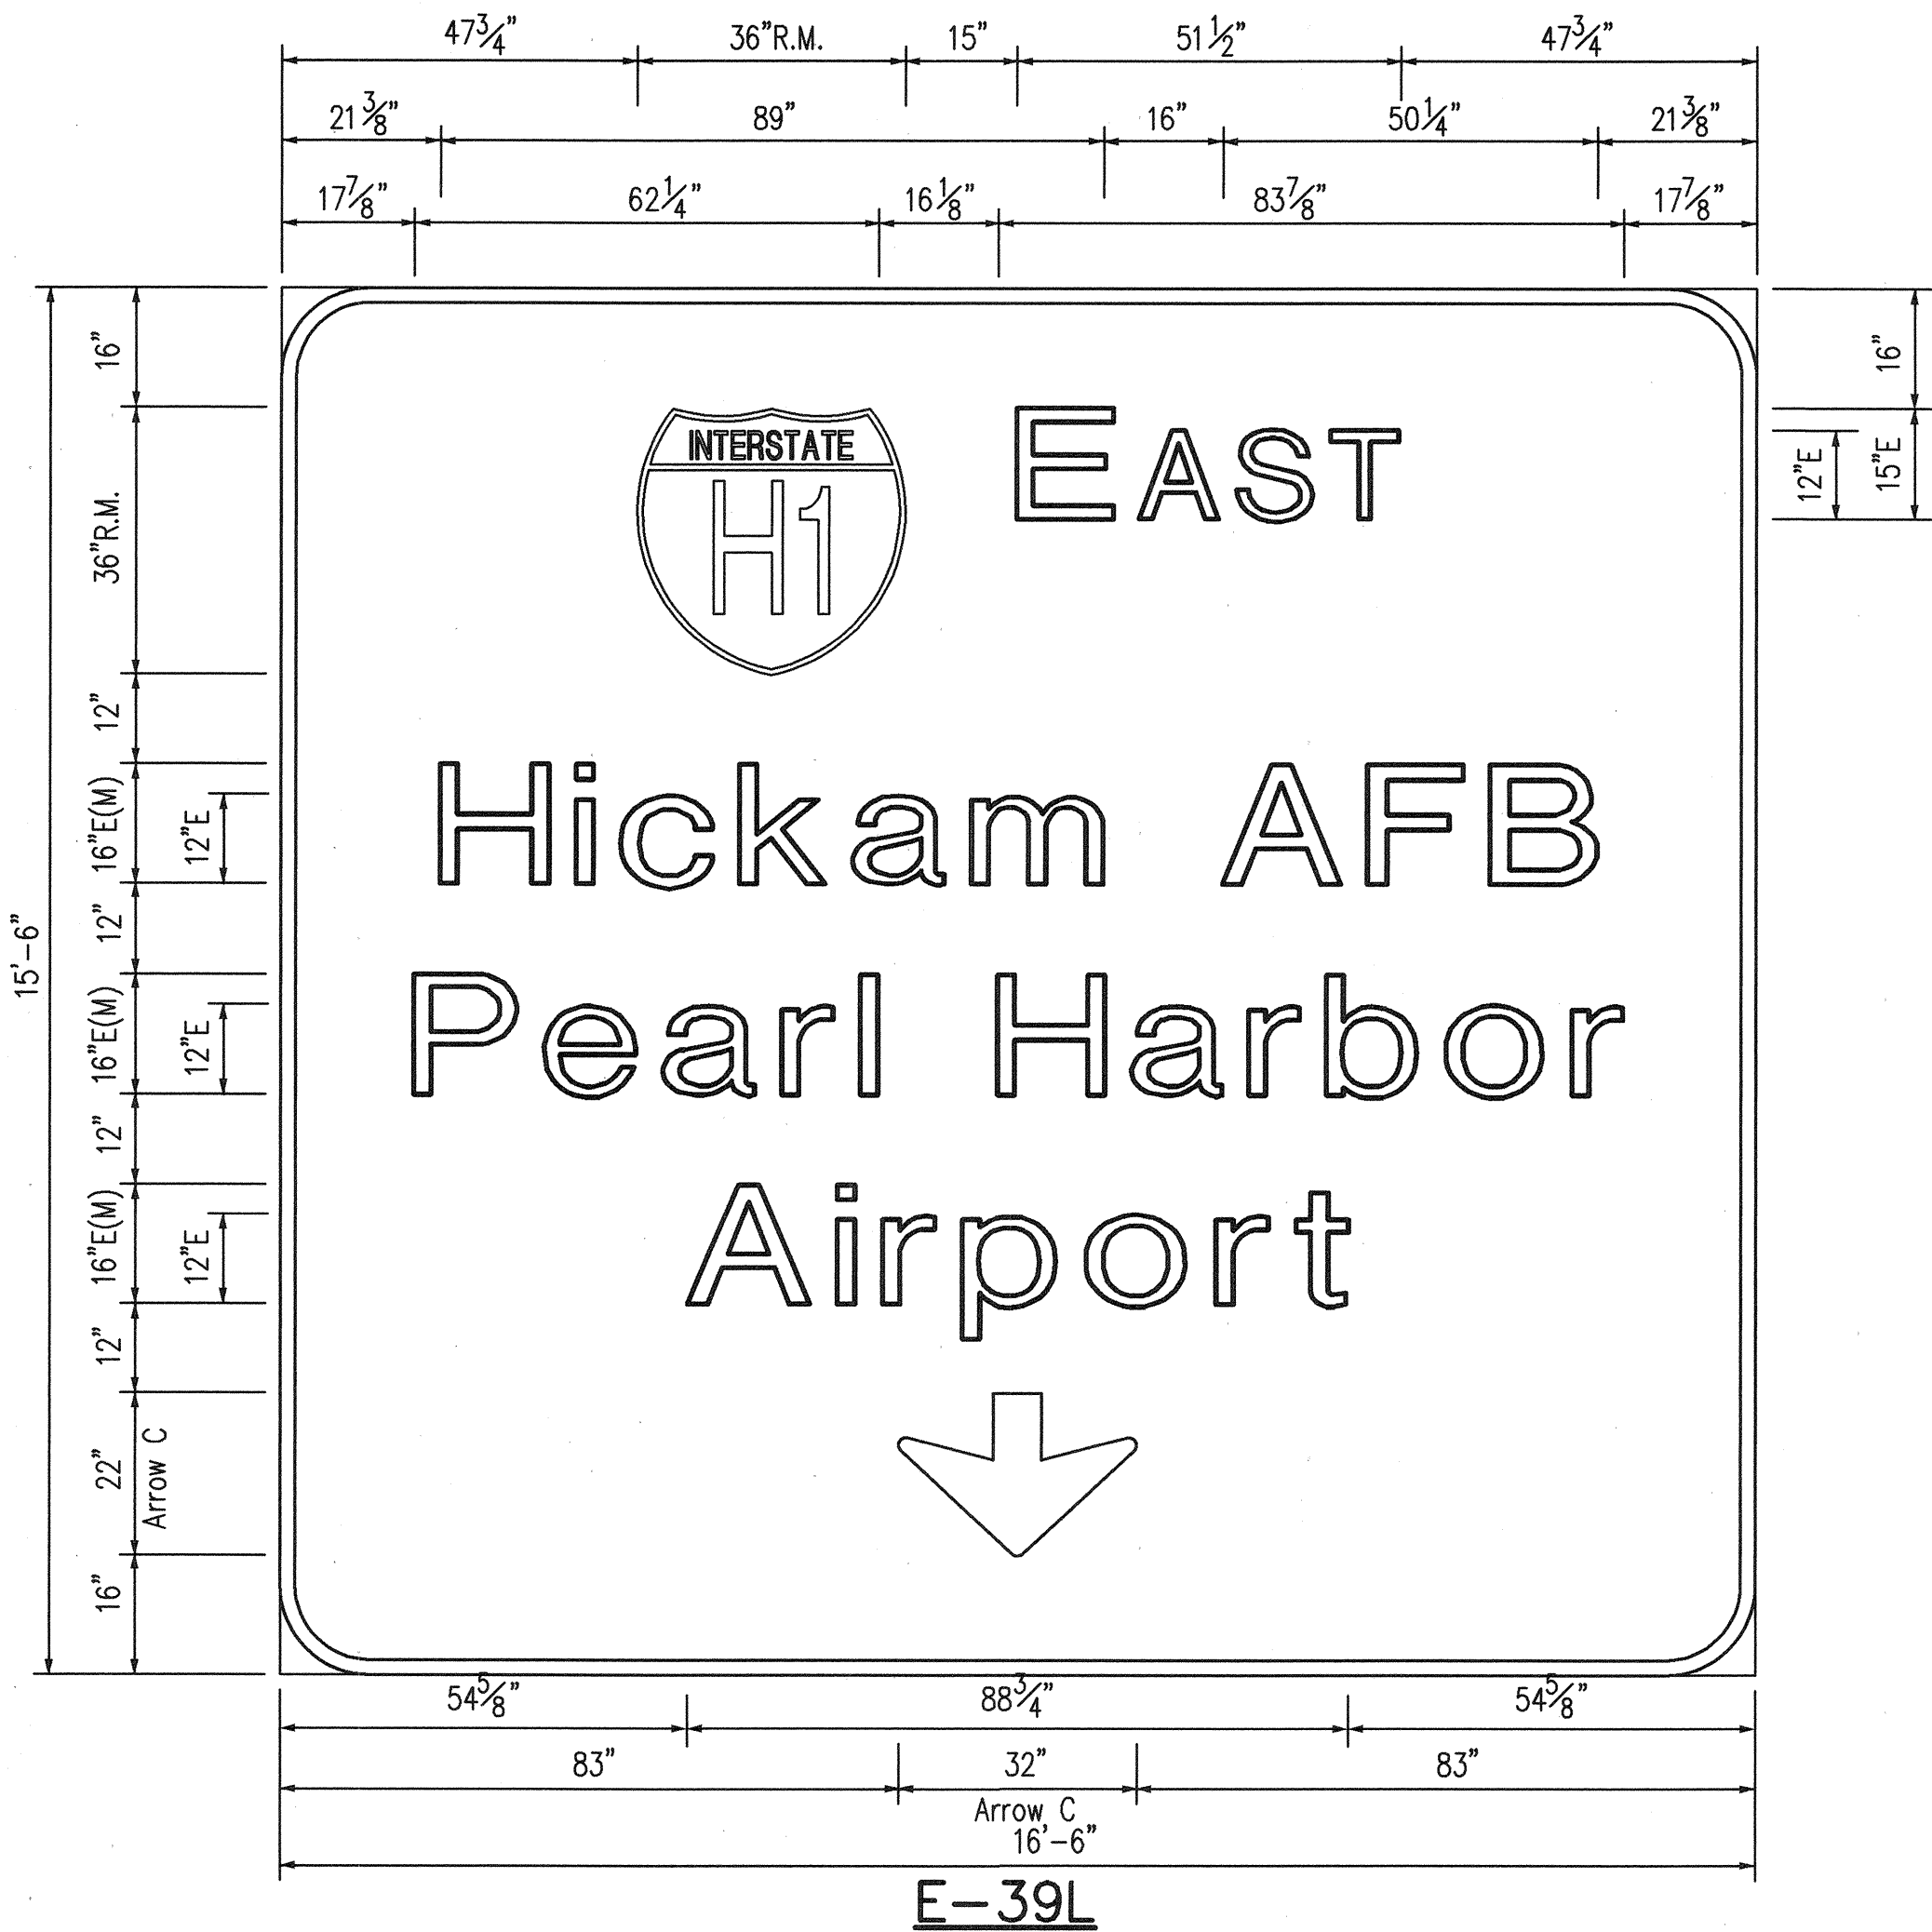

THIS WORK WAS PREPARED BY ME
OR UNDER MY SUPERVISION.
Randall M. Urasaki

STATE OF HAWAII
DEPARTMENT OF TRANSPORTATION
HIGHWAYS DIVISION

DESTINATION SIGNS
SIGN DETAILS
HALAWA INTERCHANGE

H-3 FINISH (UNIT II)
FAIP NO. I-H3-1(75), UNIT II
LEEWARD SECTION


SCALE: 1/2" = 1'-0" DATE: JANUARY 1997

SHEET NO. 6P11 OF 20 SHEETS

ORIGINAL PLAN	SURVEY PLOTTED BY	DATE
NOTE BOOK	DRAWN BY	
	TRACED BY	
	DESIGNED BY	
	CHECKED BY	
No. _____		


CAD by J. MUMURA, 55-52

FED. ROAD DIST. NO.	STATE	FED. AID PROJ. NO.	FISCAL YEAR	SHEET NO.	TOTAL SHEETS
HAWAII	HAW.	I-H3-1(75), UNIT II	1997	C.O. 862	1102

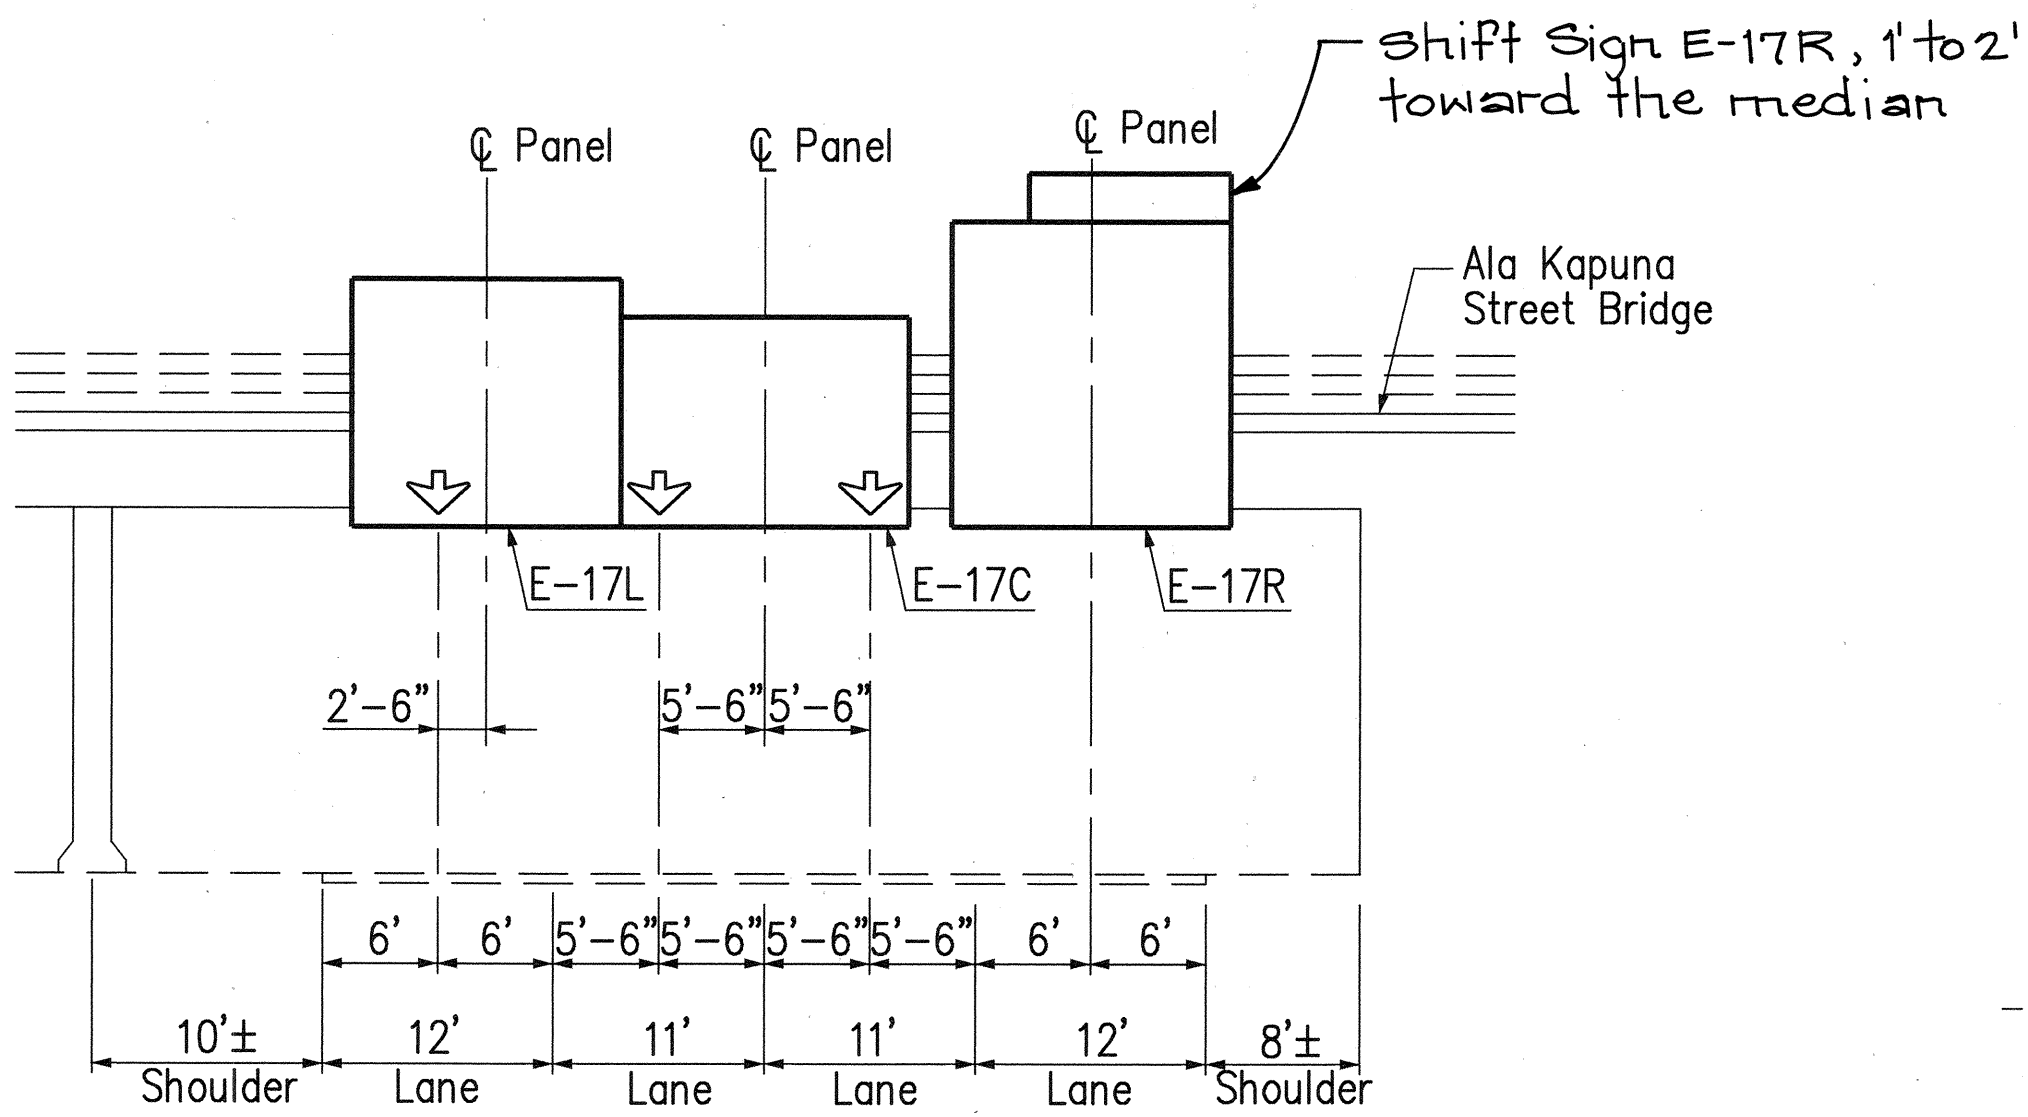


NOTE:
Remove exist. sign panels

SIGN LAYOUT E-17L, E-17C & E-17R
Moanalua Freeway Outbound Sta. 226+00±

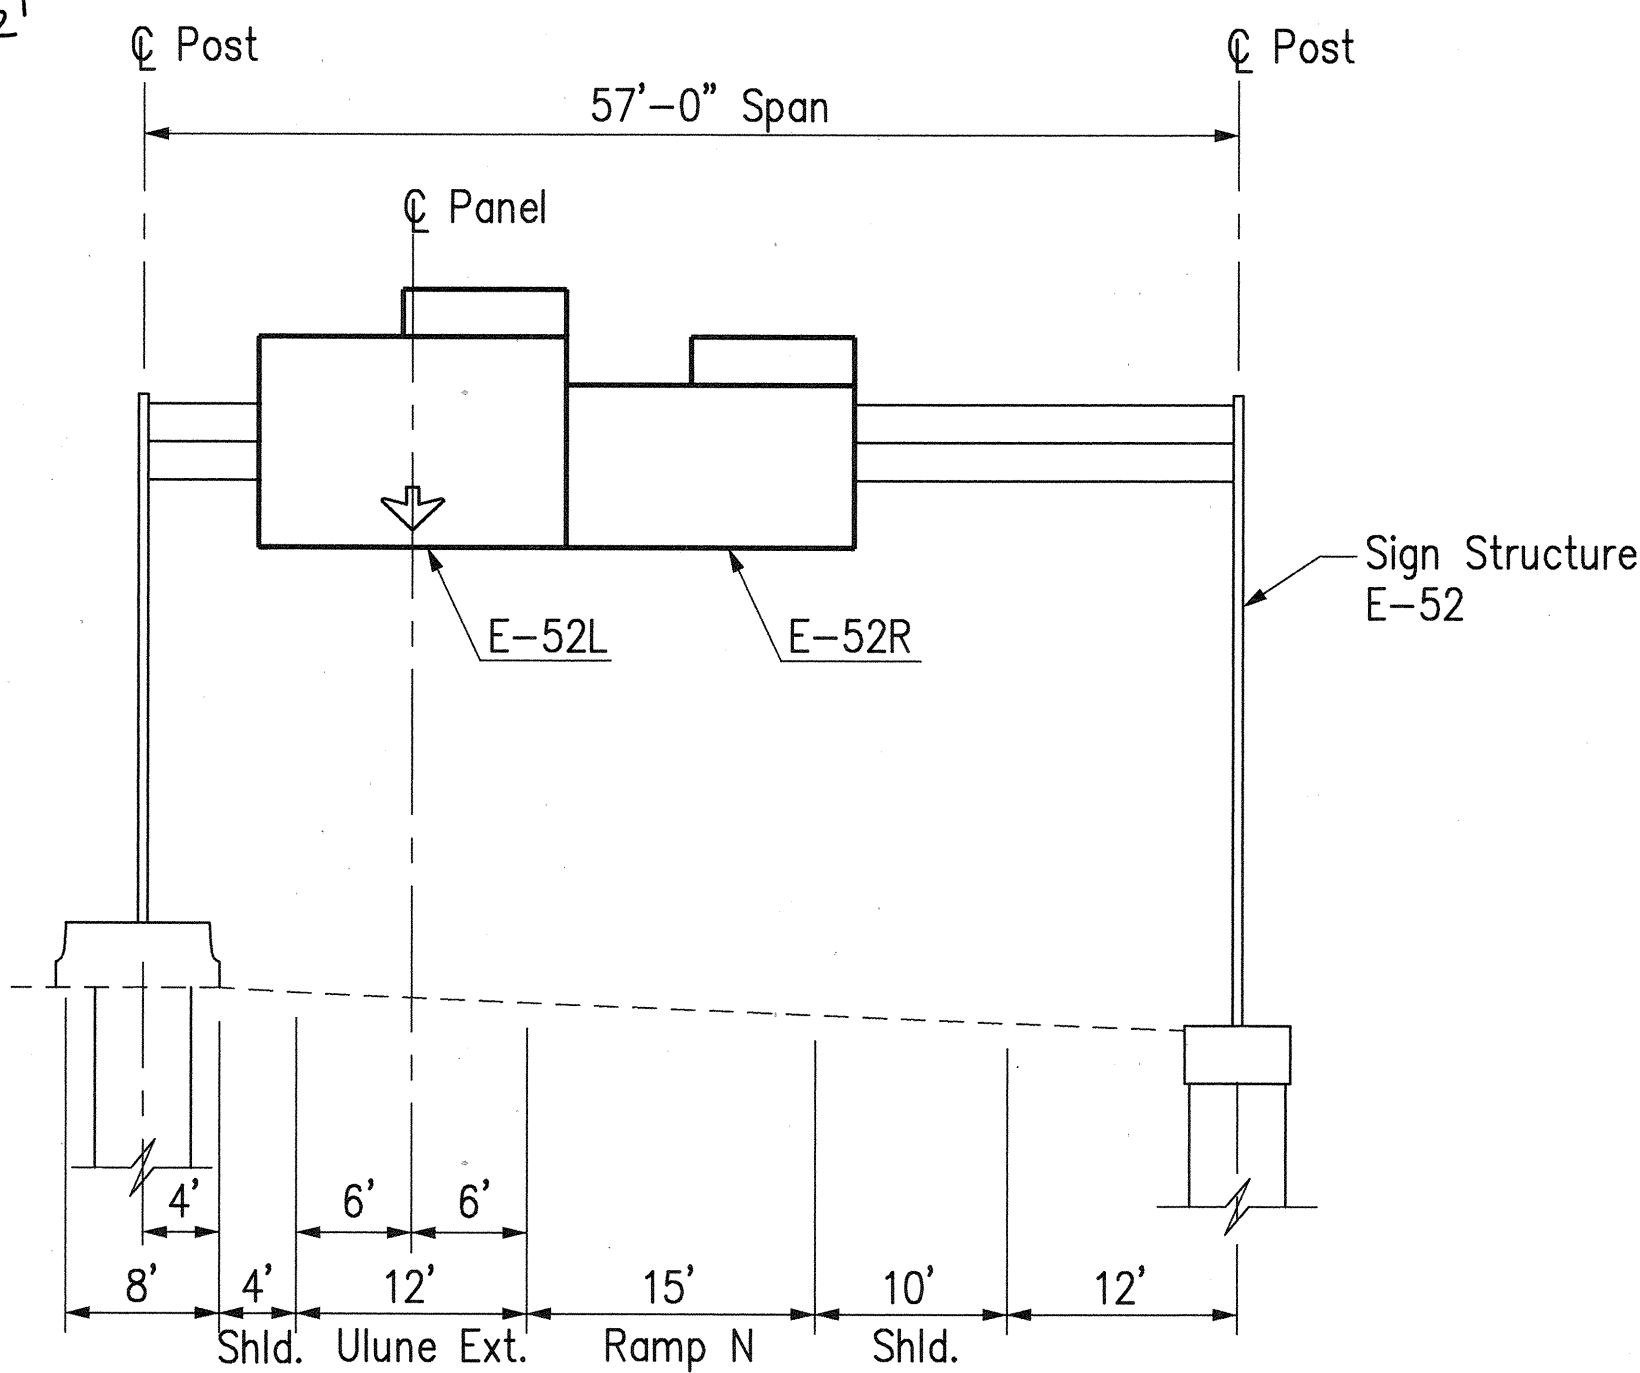


SIGN LAYOUT E-52L & E-52R
Ramp N Sta. 34+76±

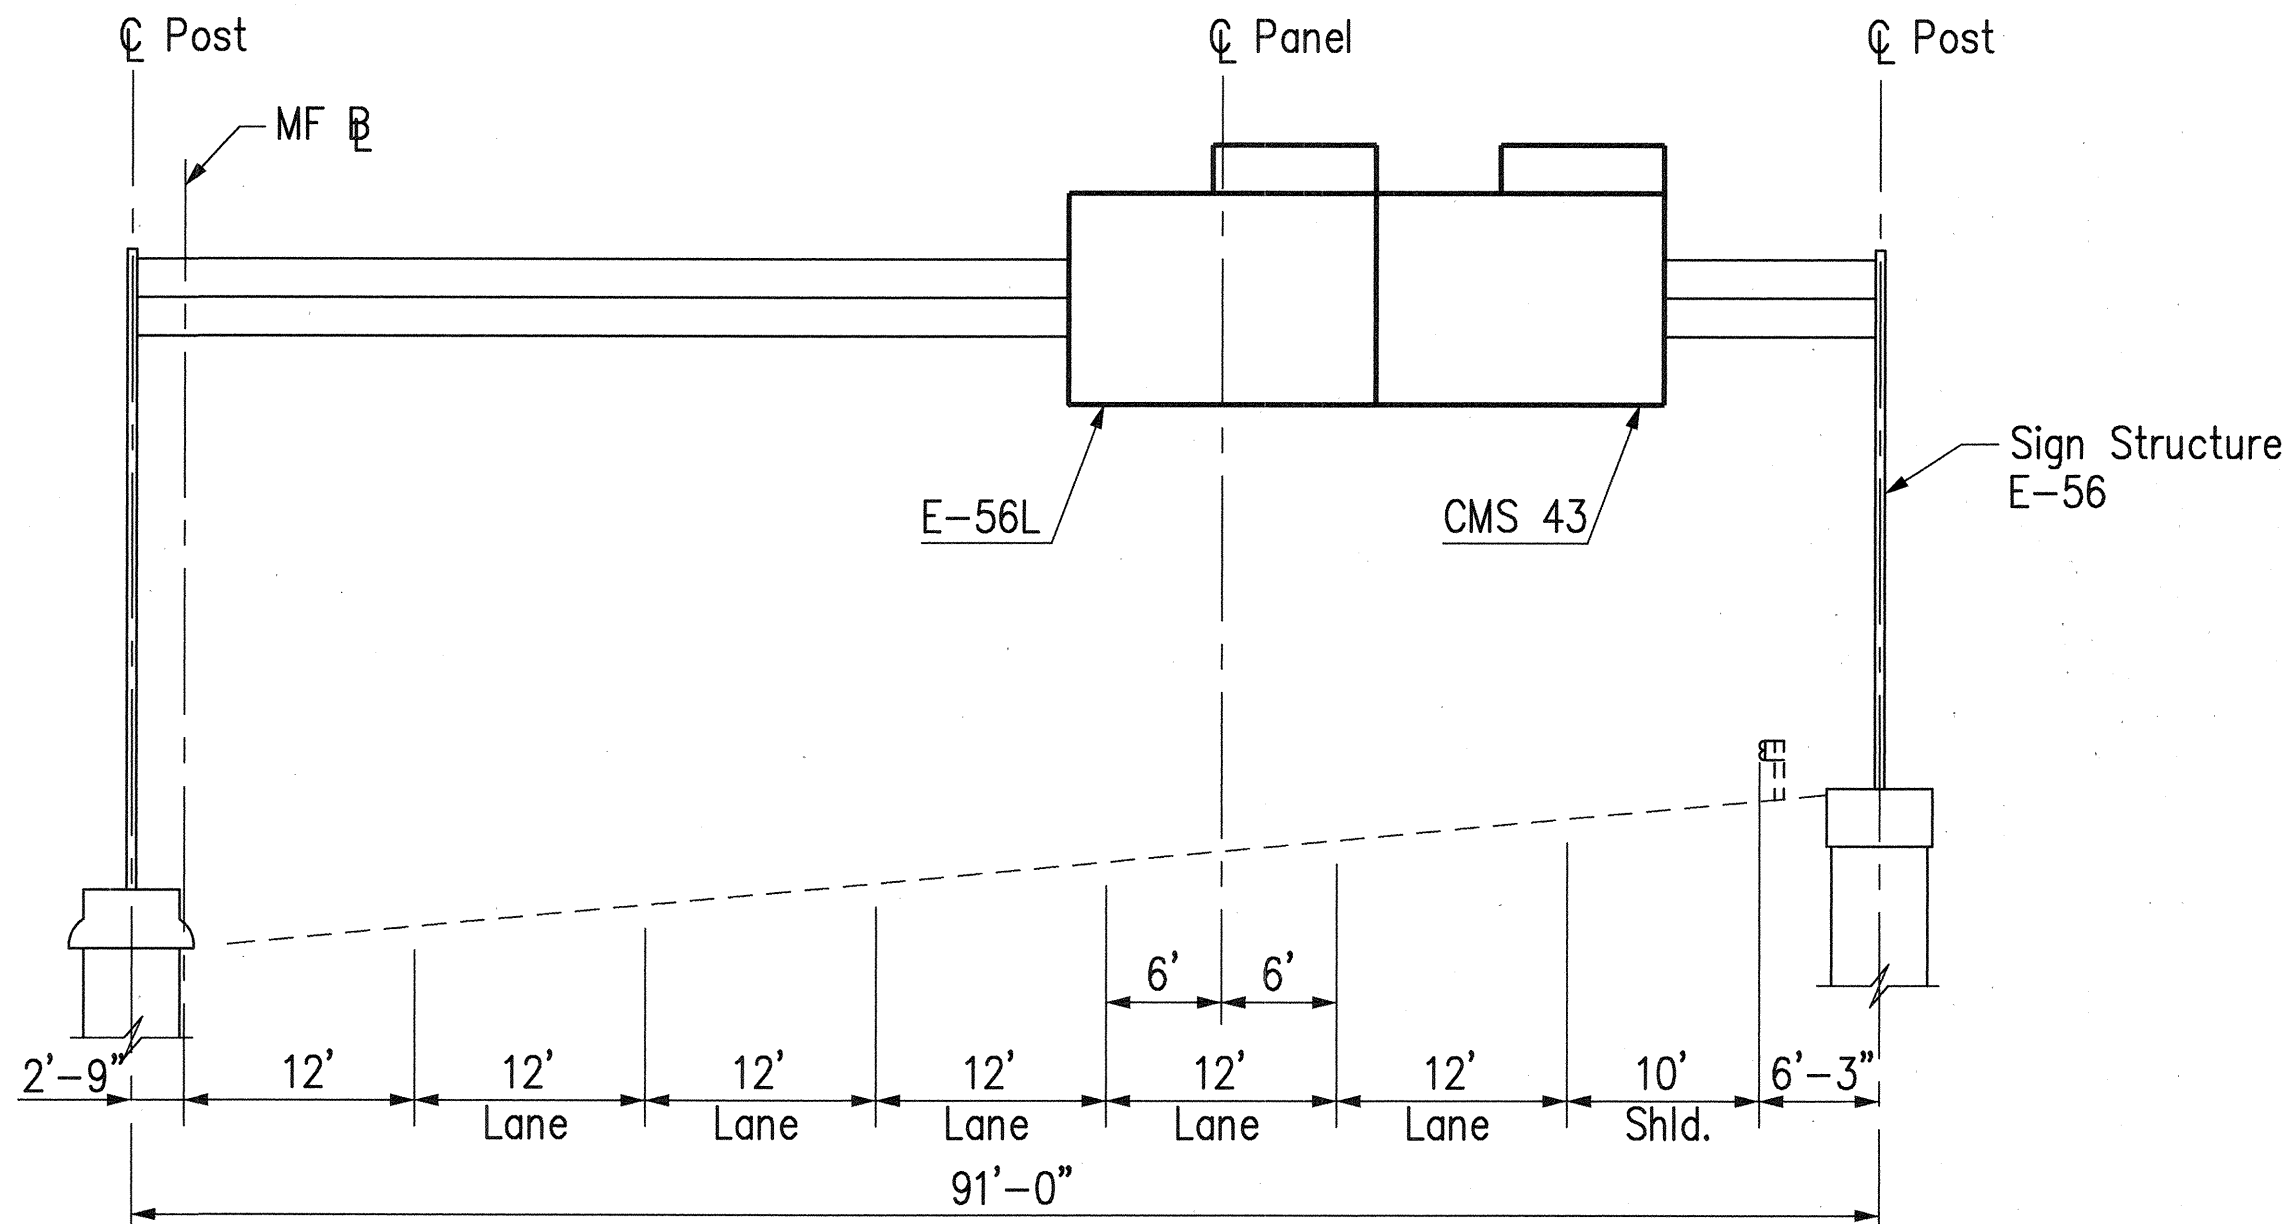


SIGN LAYOUT E-56L & CMS 43
Moanalua Freeway Outbound Sta. 213+90

NOTE:
Exit Sign Panels on top of CMS signs shall be adjacent to the right beacon (Looking at sign).

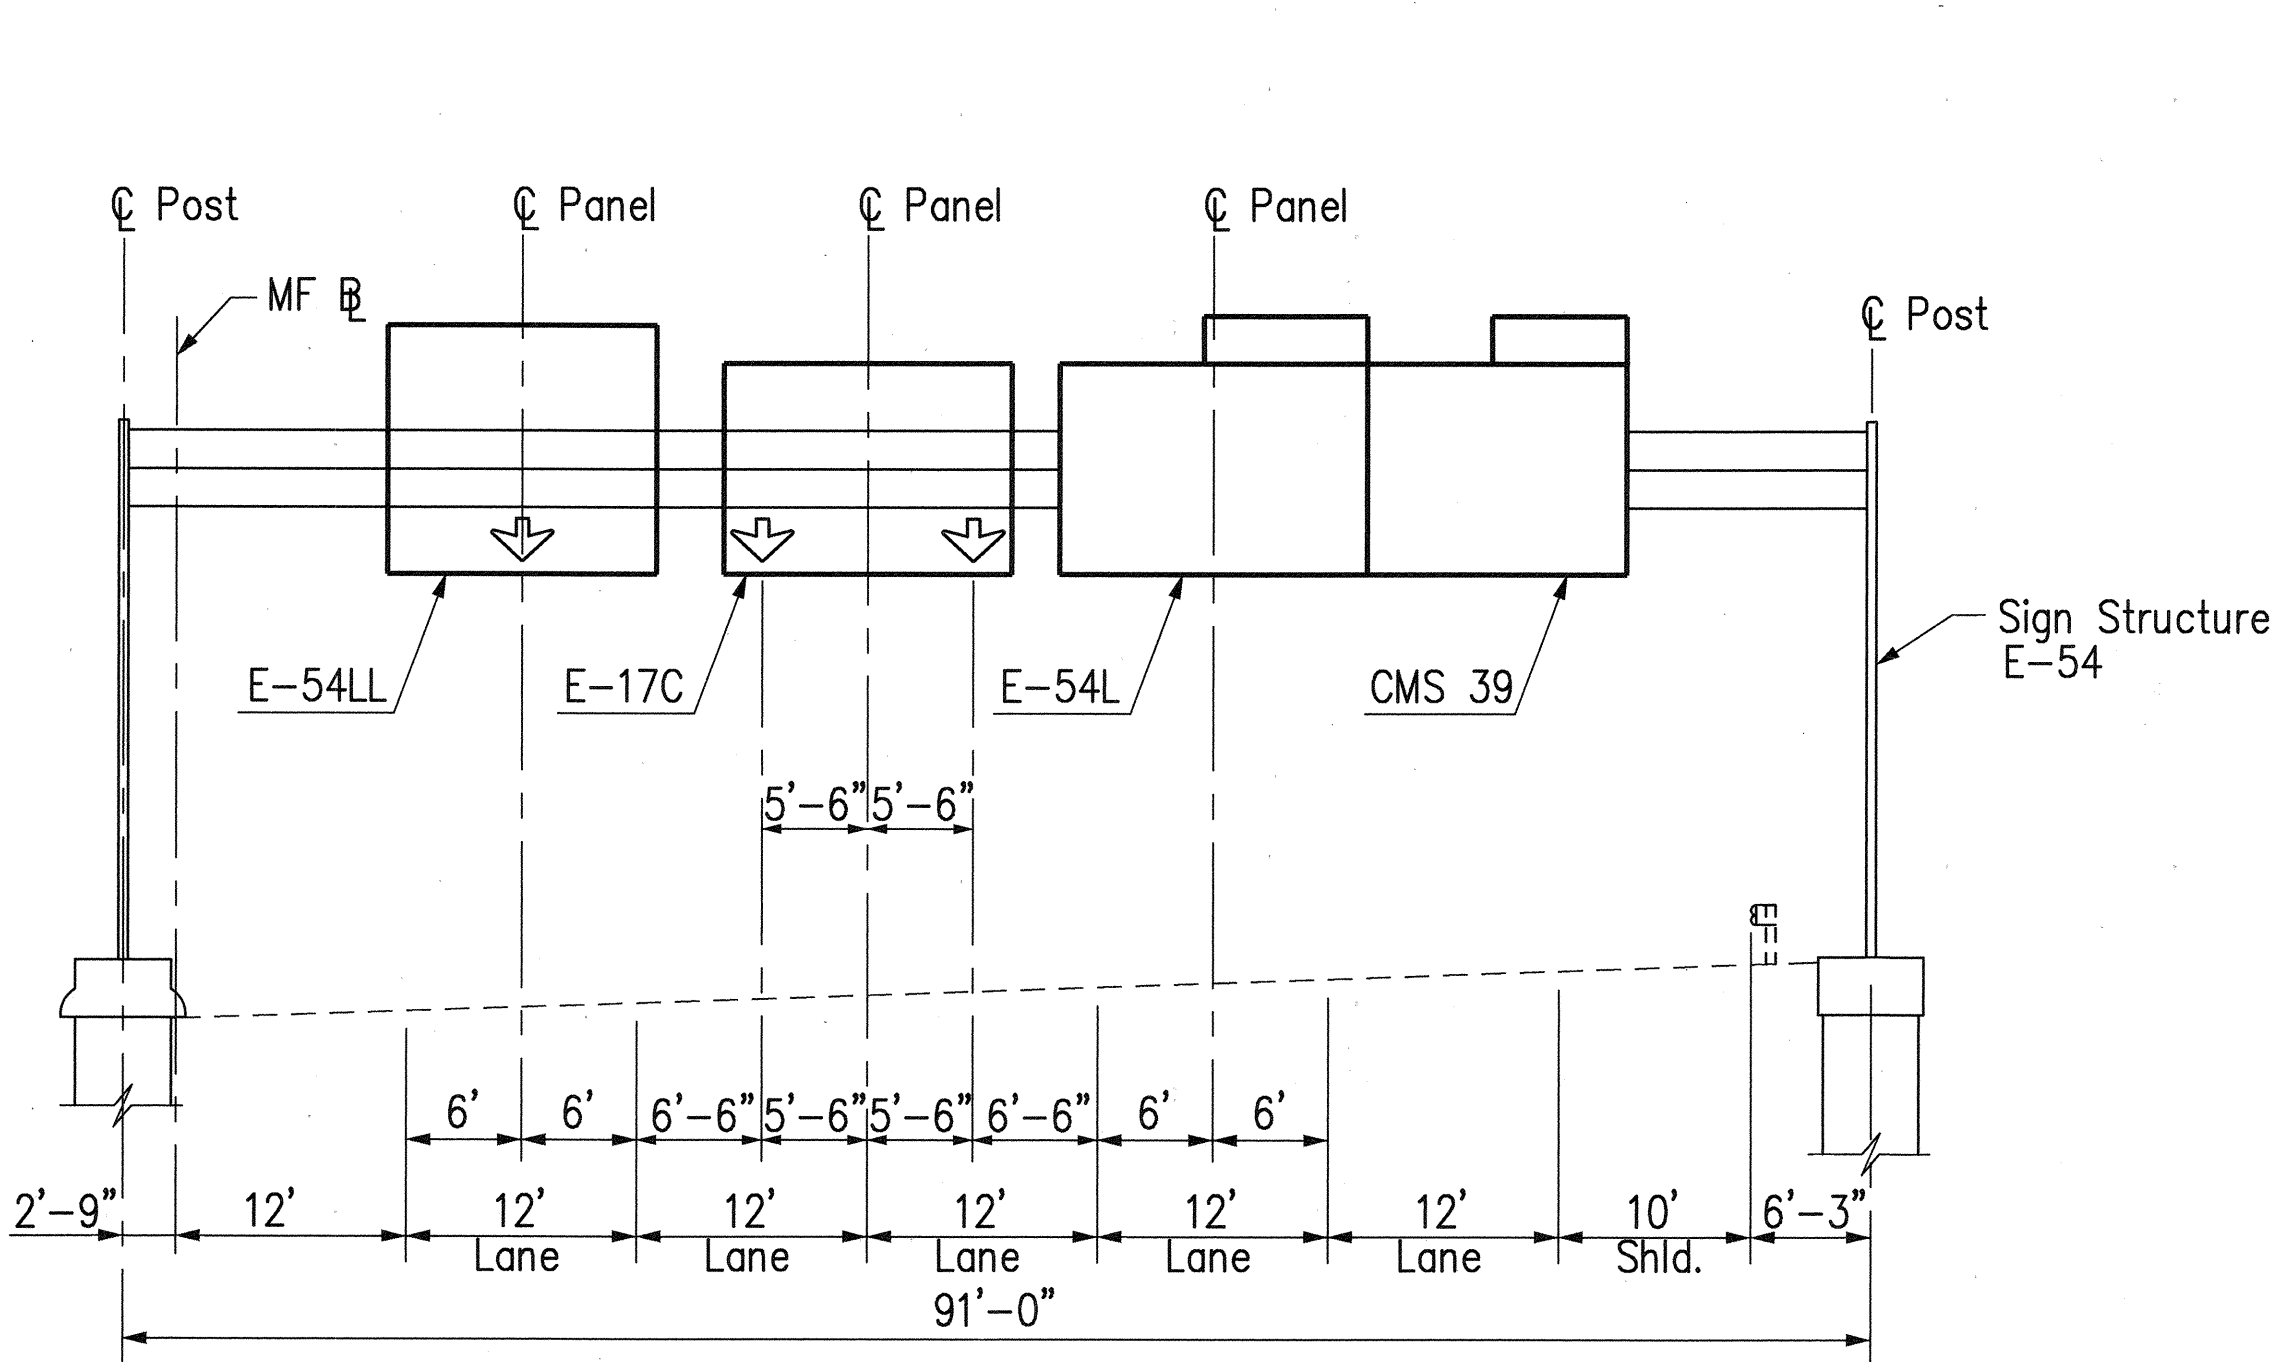


SIGN LAYOUT E-54LL, E-17C, E-54L & CMS 39
Moanalua Freeway Outbound Sta. 207+25±

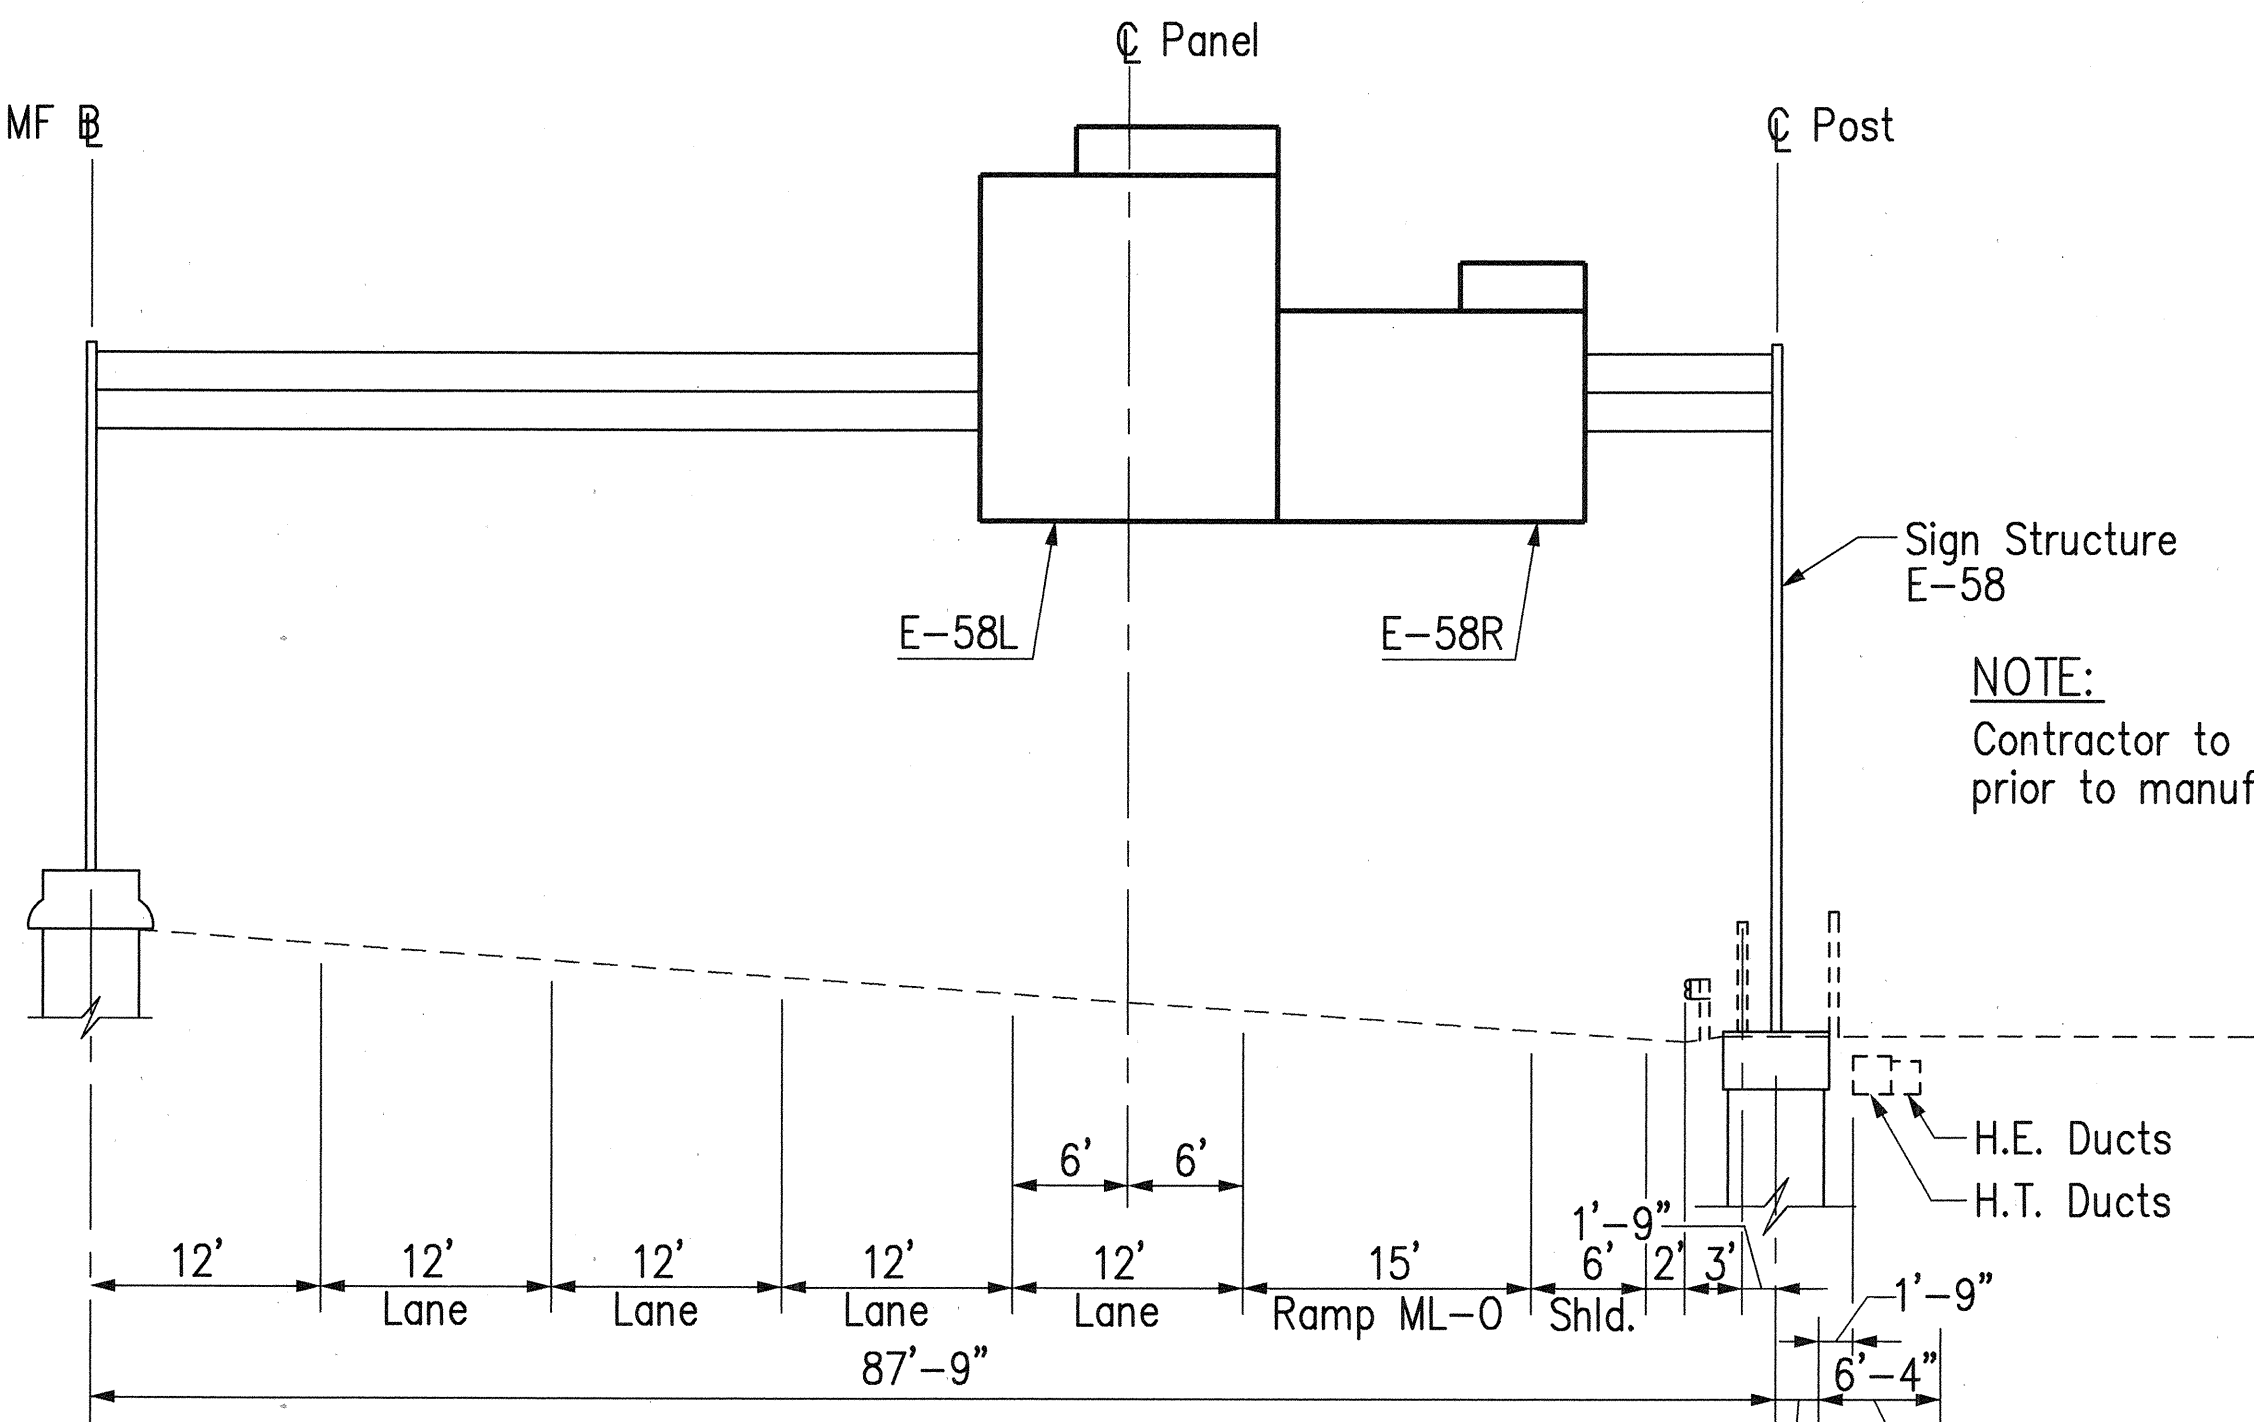

SIGN LAYOUT E-58L & E-58R
Moanalua Freeway Outbound Sta. 264+00

NOTE:
Contractor to verify span length prior to manufacturing sign bridge.

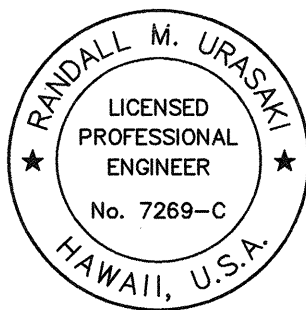

THIS WORK WAS PREPARED BY ME
OR UNDER MY SUPERVISION
R. M. Urasak

5/22/98	Added Signs E-54LL & E-17C to Sign Structure E-54
Date	Revision
STATE OF HAWAII DEPARTMENT OF TRANSPORTATION HIGHWAYS DIVISION DESTINATION SIGNS SIGN LAYOUTS MOANALUA FREEWAY H-3 FINISH (UNIT II) FAIP NO. I-H3-1(75), UNIT II LEeward SECTION SCALE: 1" = 10' DATE: JANUARY 1997 SHEET NO. 6P12 OF 20 SHEETS	

C.O. 862

SURVEY PLOTTED BY	DATE
DRAWN BY	
TRACED BY	
DESIGNED BY	
QUANTITIES BY	
CHECKED BY	
ORIGINAL PLAN	NO.

CAD by J. MINURA, 55-52

at Barrier


12'-0"

4'-0"

New Fence


58' Rt. Pedestal

1.5' x 2.35' Handhole

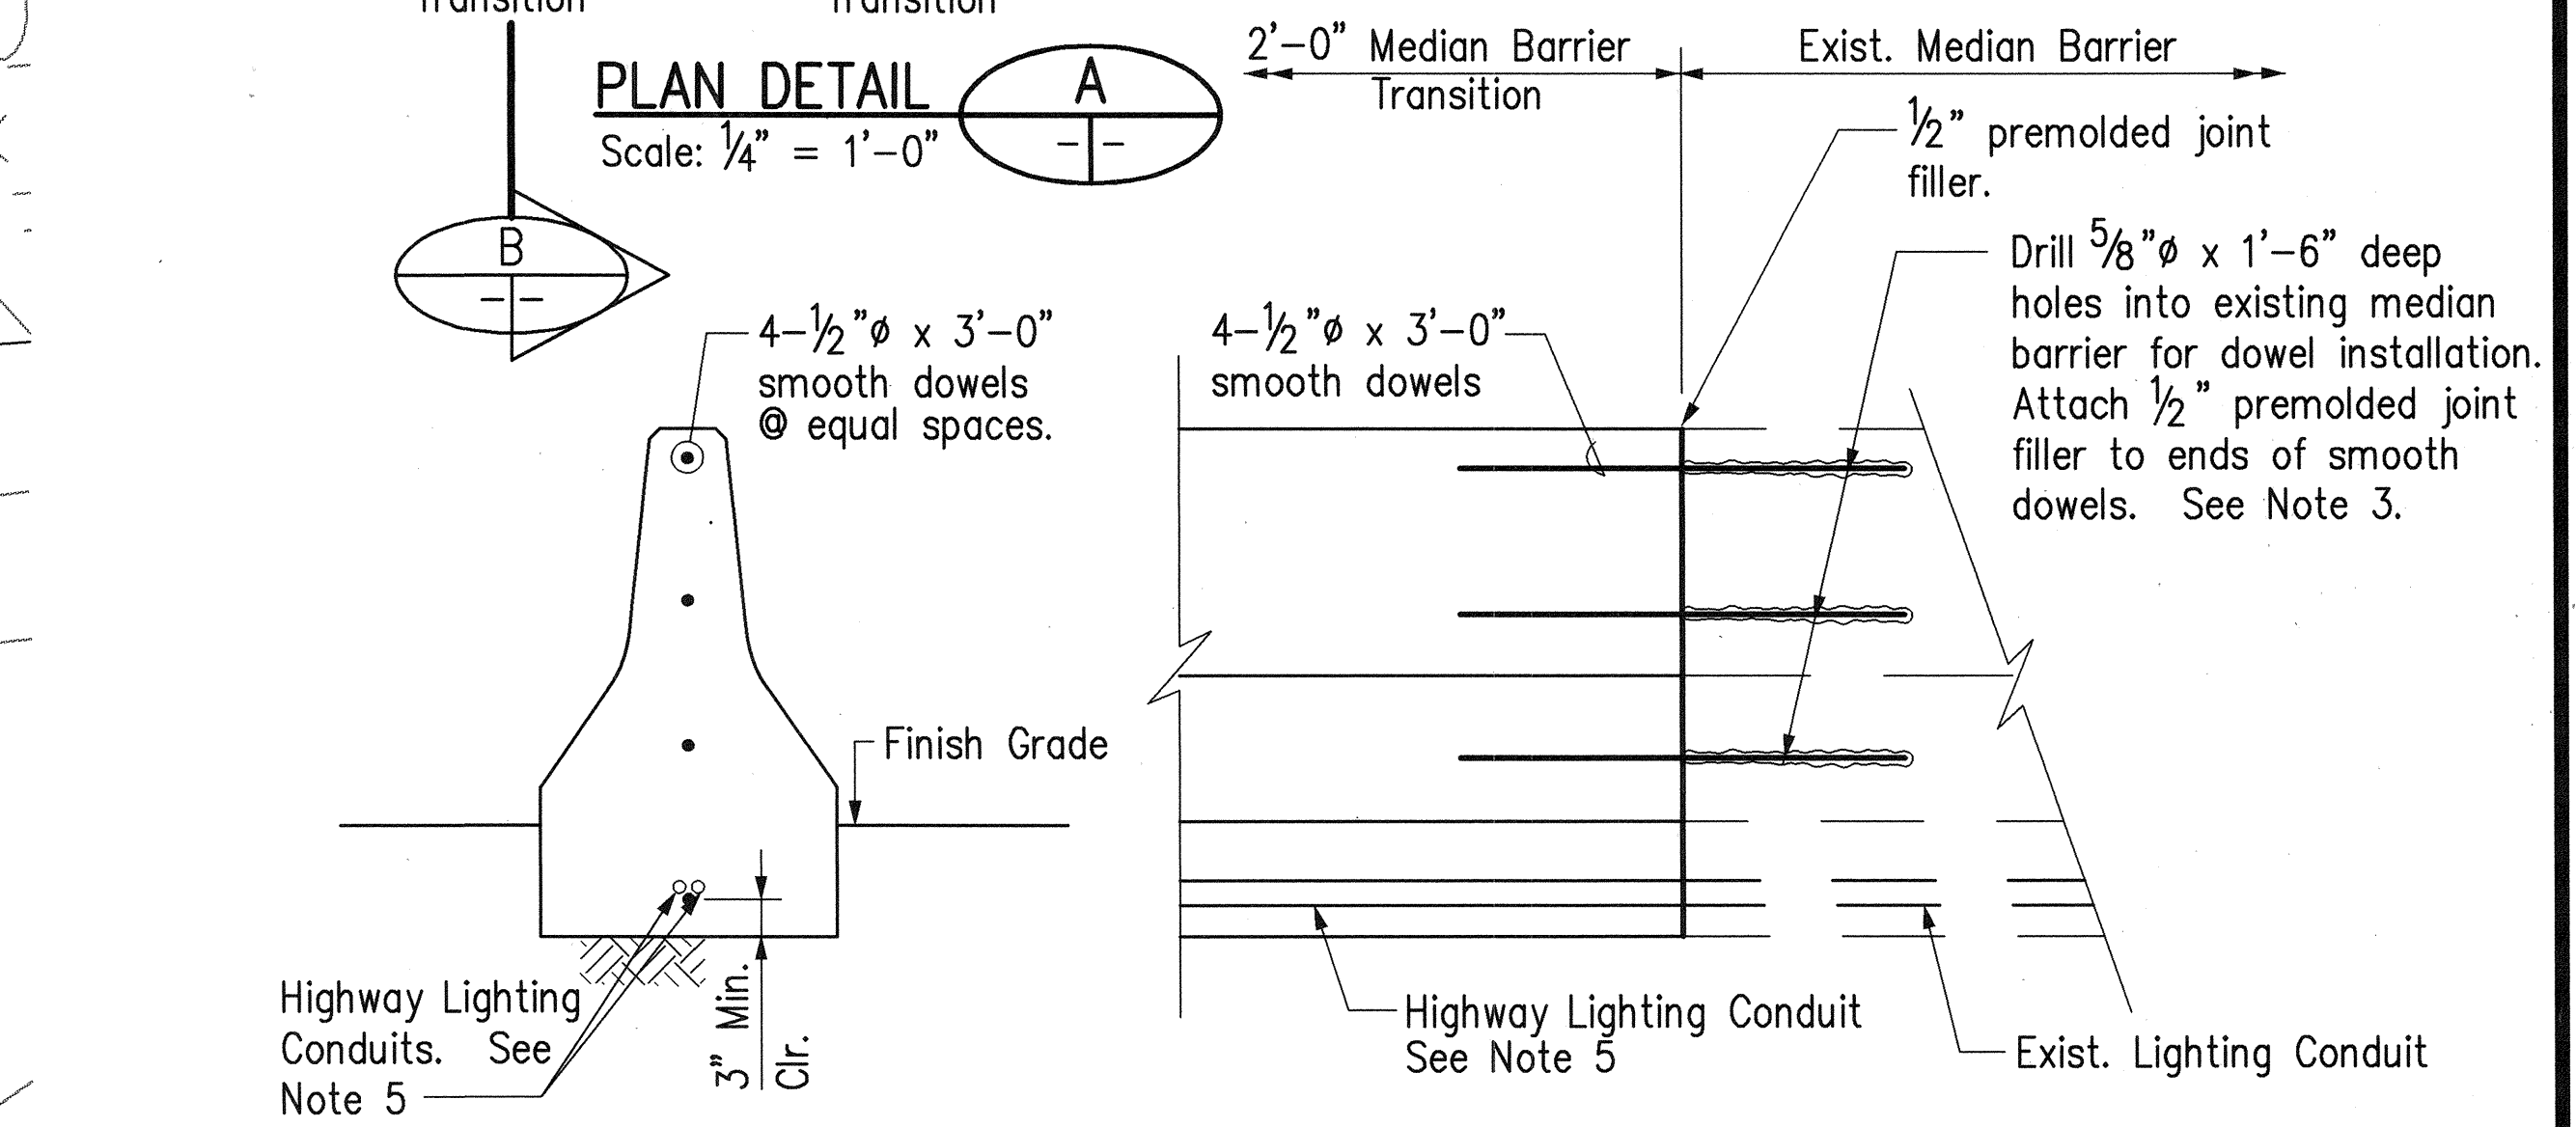


ELEVATION

Scale: $\frac{1}{2}" = 1'-0"$

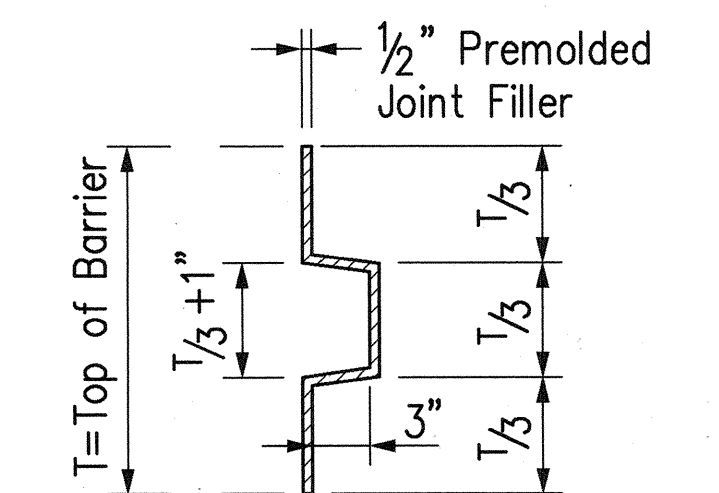


EXPANSION JOINT KEY

Not to Scale

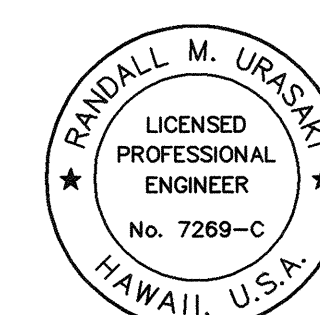

Paul M. Charles

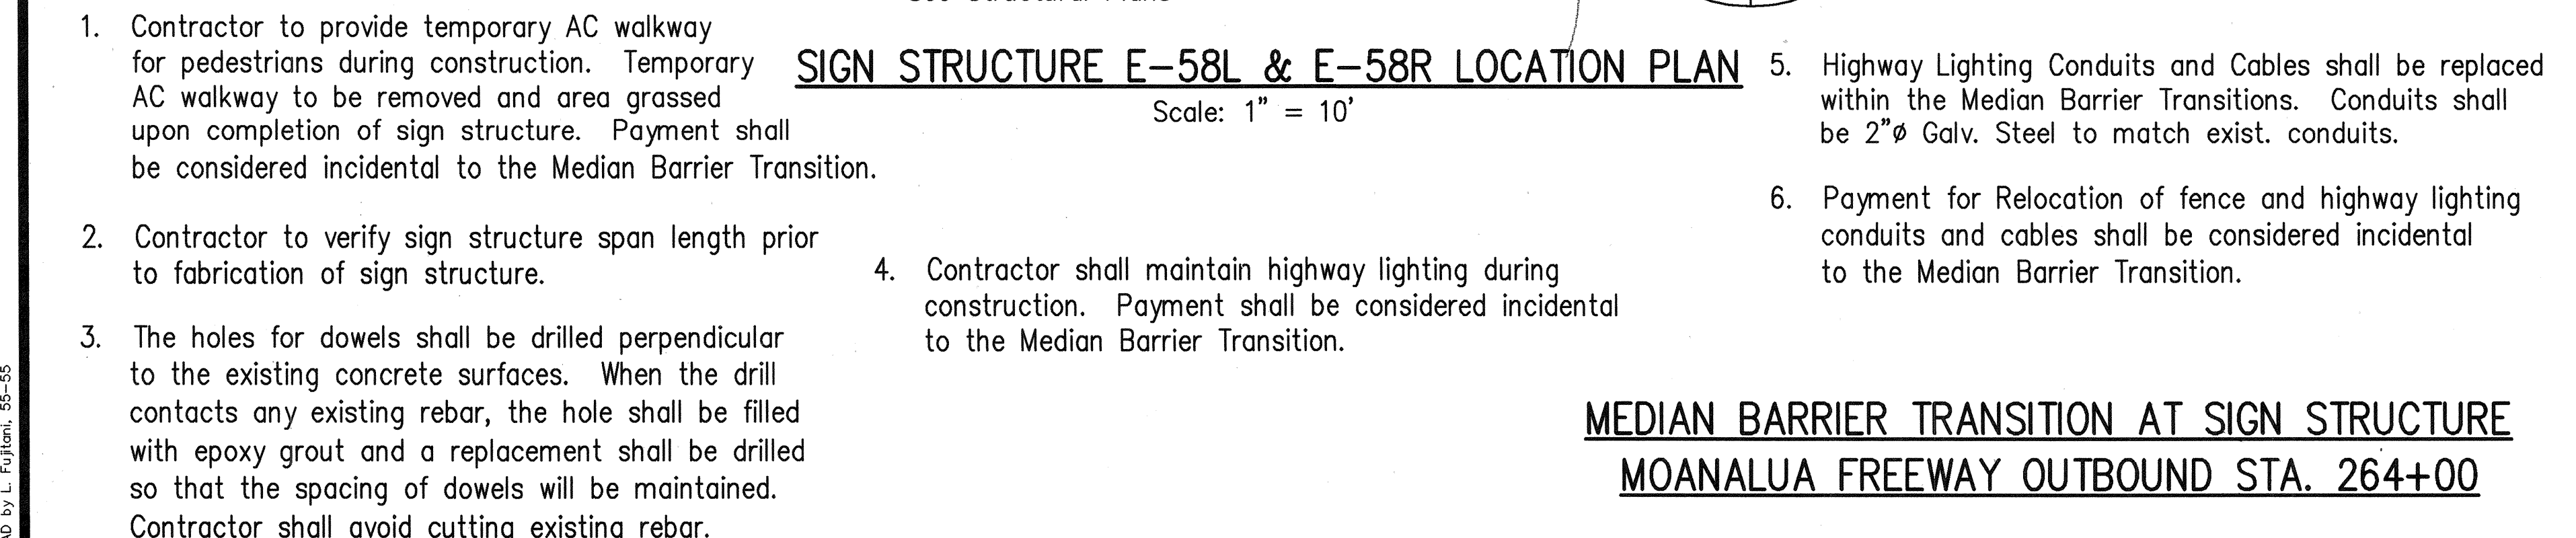

- NOTES:

1. Contractor to provide temporary AC walkway for pedestrians during construction. Temporary AC walkway to be removed and area grassed upon completion of sign structure. Payment shall be considered incidental to the Median Barrier Transition.

2. Contractor to verify sign structure span length prior to fabrication of sign structure.

3. The holes for dowels shall be drilled perpendicular to the existing concrete surfaces. When the drill contacts any existing rebar, the hole shall be filled with epoxy grout and a replacement shall be drilled so that the spacing of dowels will be maintained. Contractor shall avoid cutting existing rebar.

See Structural Plans

SIGN STRUCTURE E-58L & E-58R LOCATION PLAN

Scale: 1" = 10'


4. Contractor shall maintain highway lighting during construction. Payment shall be considered incidental to the Median Barrier Transition.

5. Highway Lighting Conduits and Cables shall be replaced within the Median Barrier Transitions. Conduits shall be 2"Ø Galv. Steel to match exist. conduits.


6. Payment for Relocation of fence and highway lighting conduits and cables shall be considered incidental to the Median Barrier Transition.

MEDIAN BARRIER TRANSITION AT SIGN STRUCTURE
MOANALUA FREEWAY OUTBOUND STA. 264+00

FED. ROAD DIST. NO.	STATE	FED. AID PROJ. NO.	FISCAL YEAR	SHEET NO.	TOTAL SHEETS
HAWAII	HAW.	I-H3-K(75), UNIT II	1997	ADD. 862S-2	1102

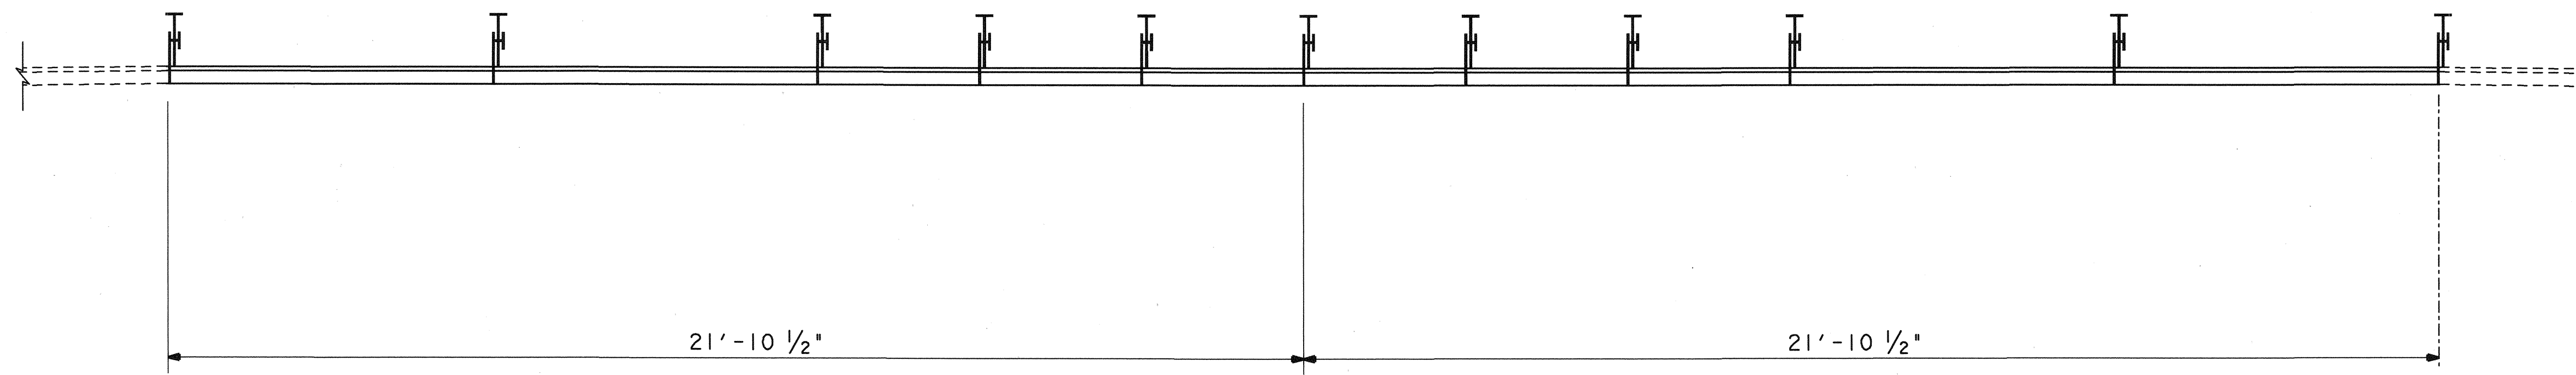


PLAN
Scale: 1/2" = 1'-0"

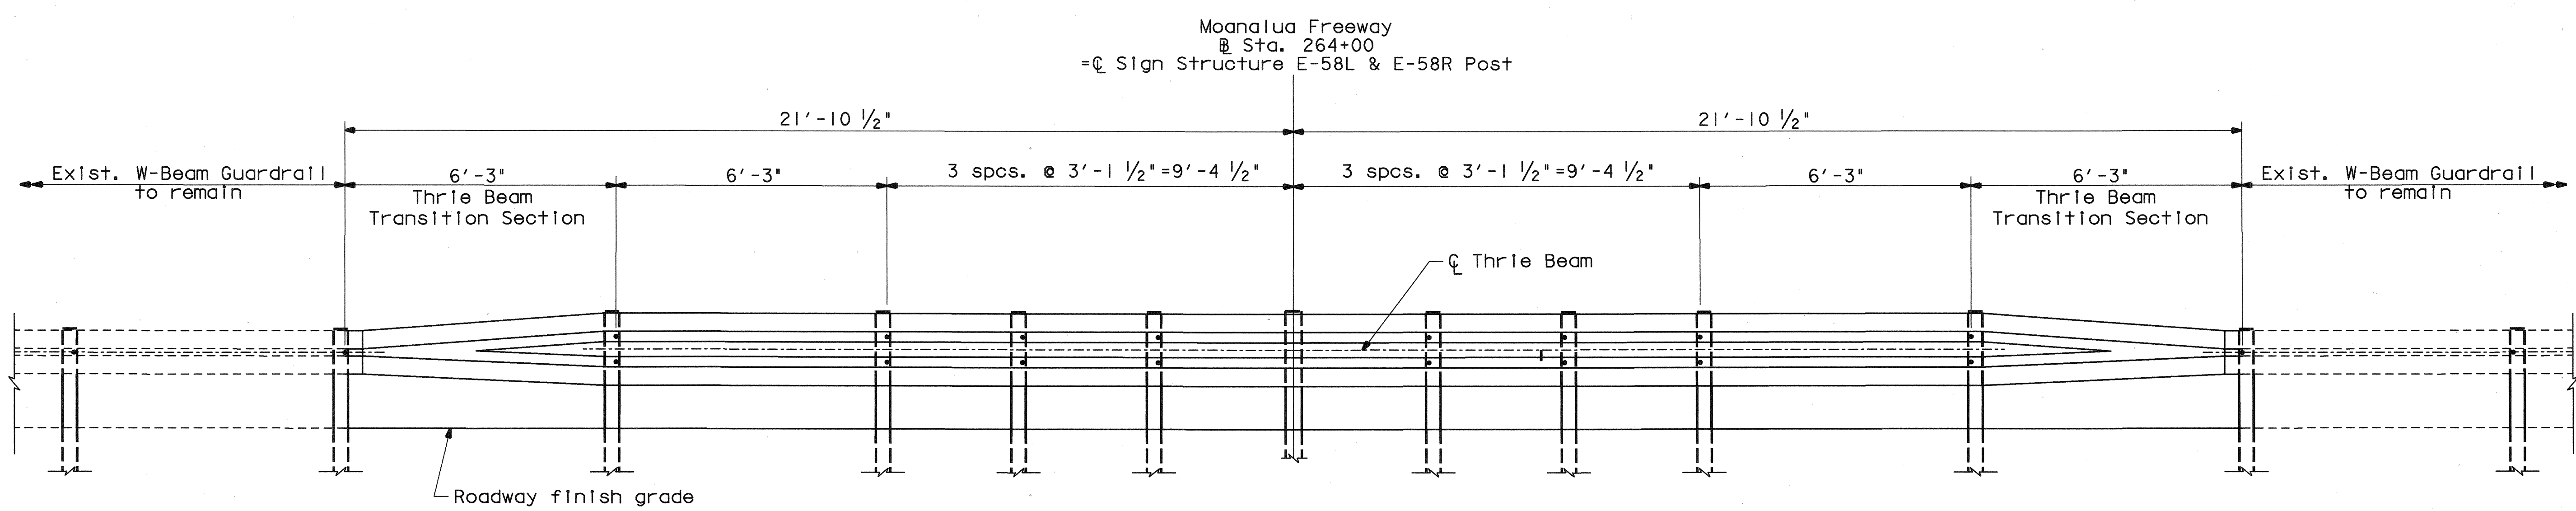

ELEVATION
Scale: 1/2" = 1'-0"

NOTE:
Payment for Thrile Beam Transition Section shall be paid for under Guardrail Type 3 - Thrile Beam.

GUARDRAIL TYPE 3 - THRIE BEAM
AT SIGN STRUCTURE E-58L & E-58R

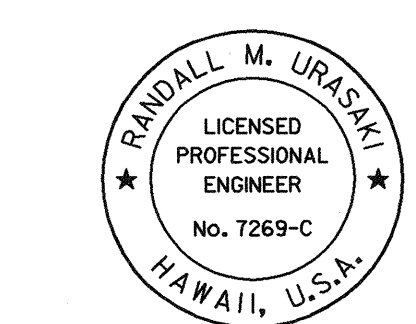


THIS WORK WAS PREPARED BY ME OR UNDER MY SUPERVISION.
Randall M. Uraski

5/2/97	Added sheet
Date	Revision
STATE OF HAWAII DEPARTMENT OF TRANSPORTATION HIGHWAYS DIVISION DESTINATION SIGNS ROADWAY CONSTRUCTION DETAILS SIGN STRUCTURE E-58L & E-58R H-3 FINISH (UNIT II) FAIP NO. I-H3-K(75), UNIT II LEEWARD SECTION SCALE: AS SHOWN DATE: MAY 1997	


ORIGINAL PLAN	SURVEY PLOTTED BY	DATE
NOTE BOOK	DRAWN BY	
	DESIGNED BY	
	QUANTITIES BY	
	CHECKED BY	
No. _____		

\$\$\$\$\$SYTIME\$\$\$\$\$
\$\$\$\$\$DGN SPEC\$\$\$\$\$


FED. ROAD DIST. NO.	STATE	FED. AID PROJ. NO.	FISCAL YEAR	SHEET NO.	TOTAL SHEETS
HAWAII	HAW.	I-H3-1(75), UNIT II	1997	863	1102

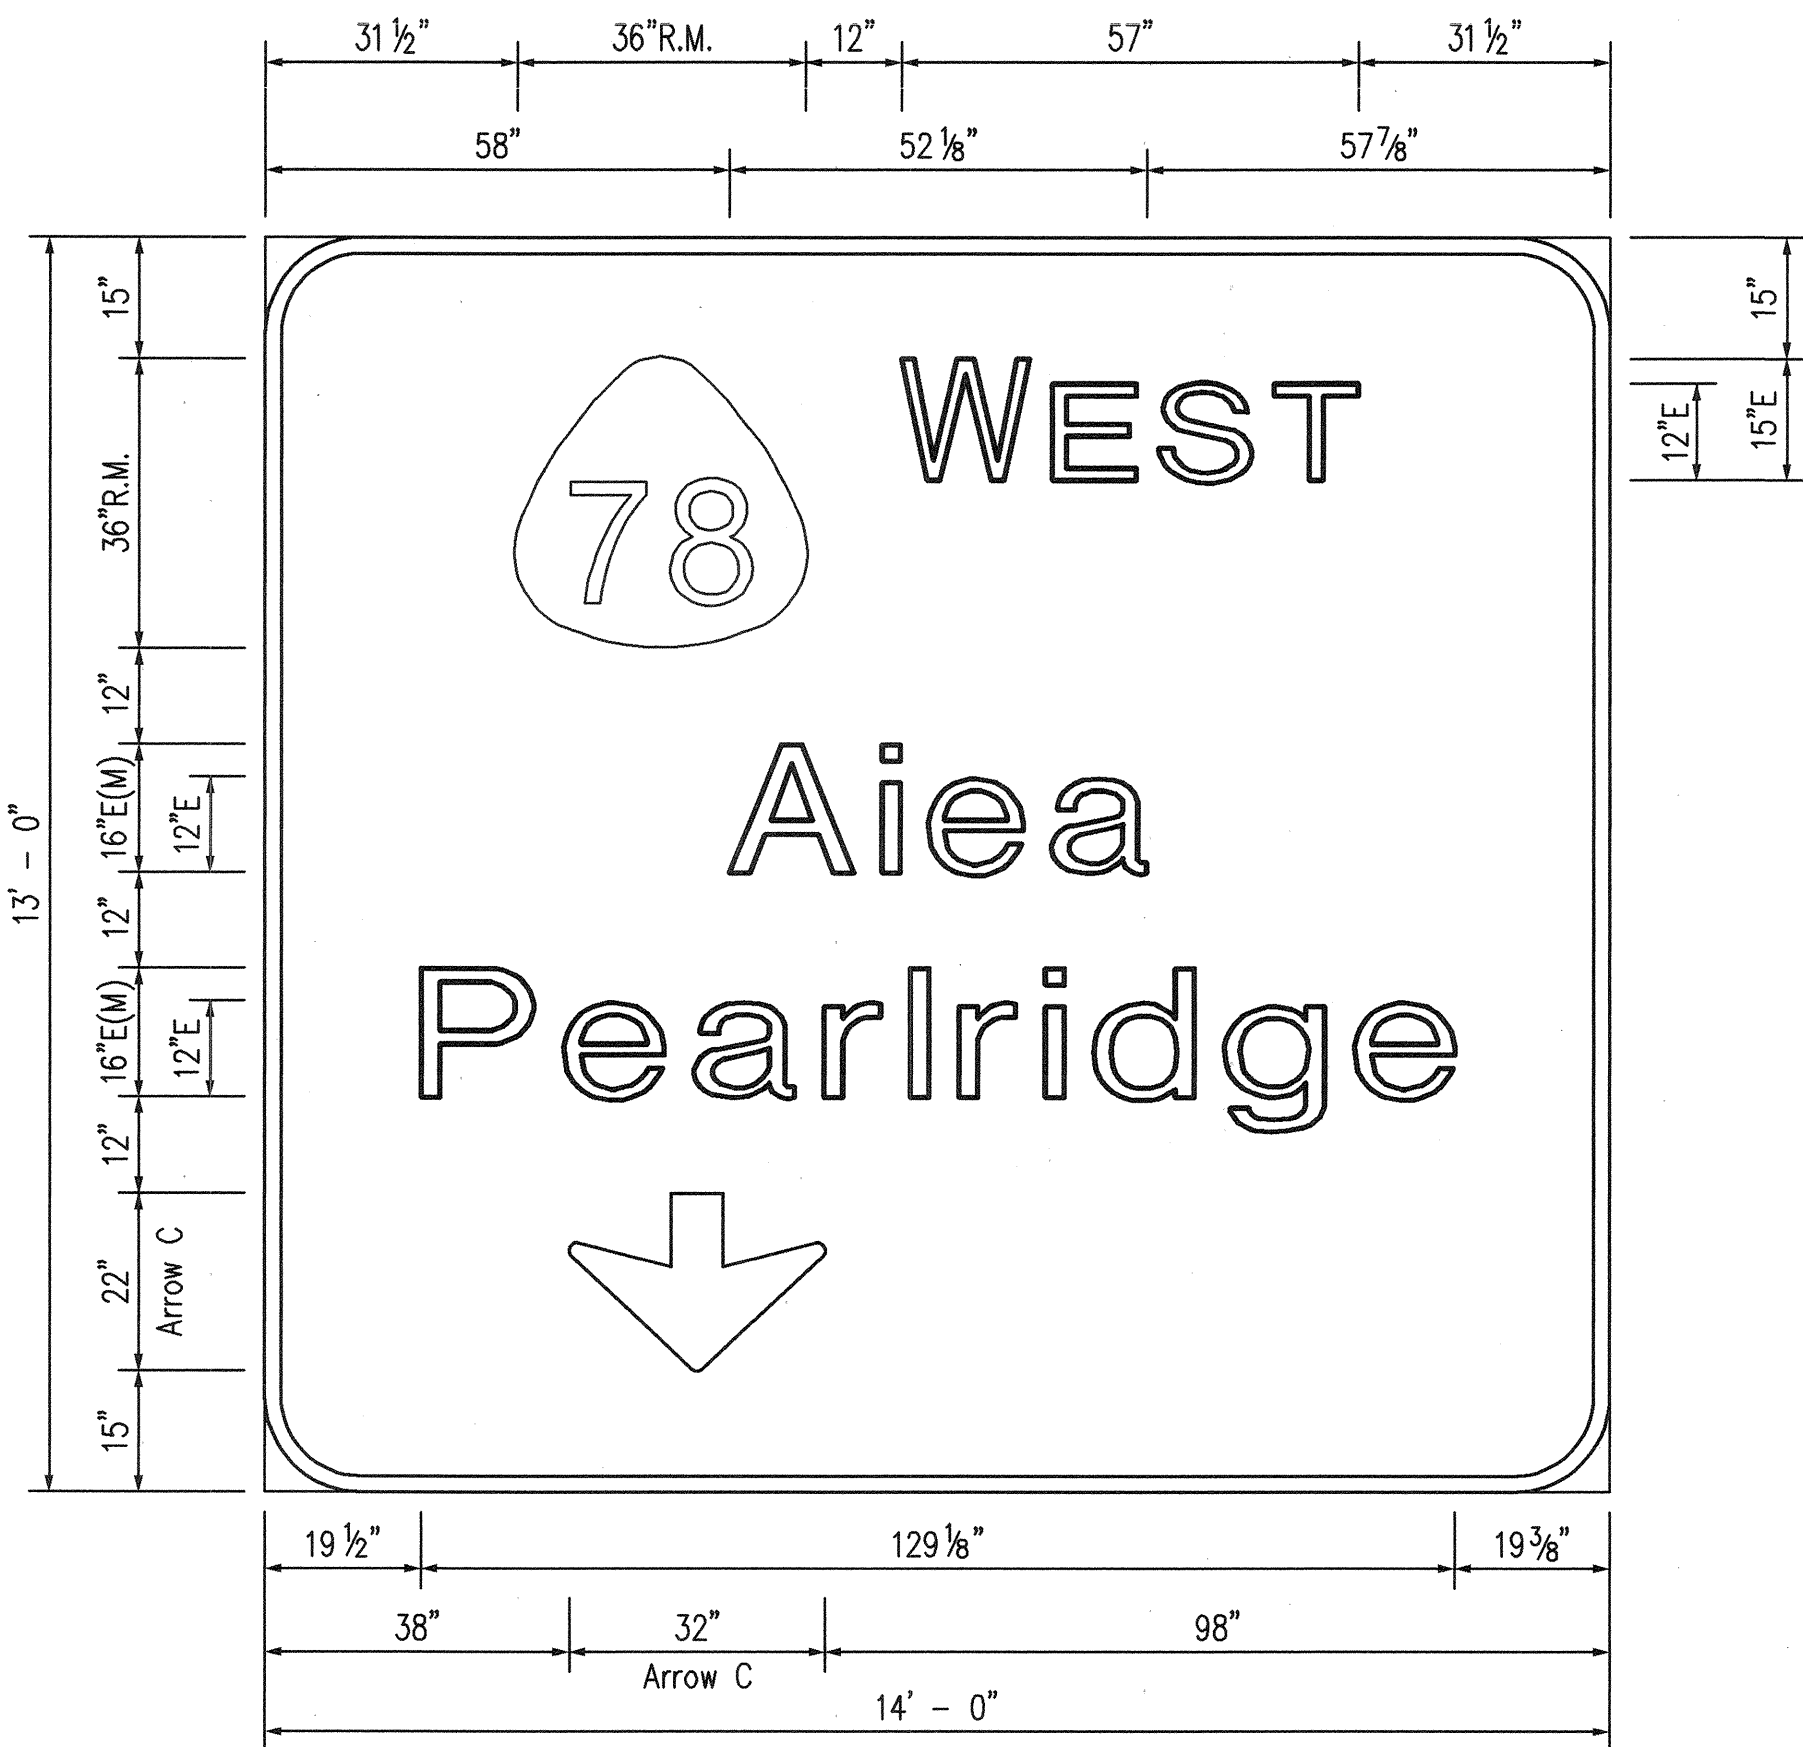


E-17L

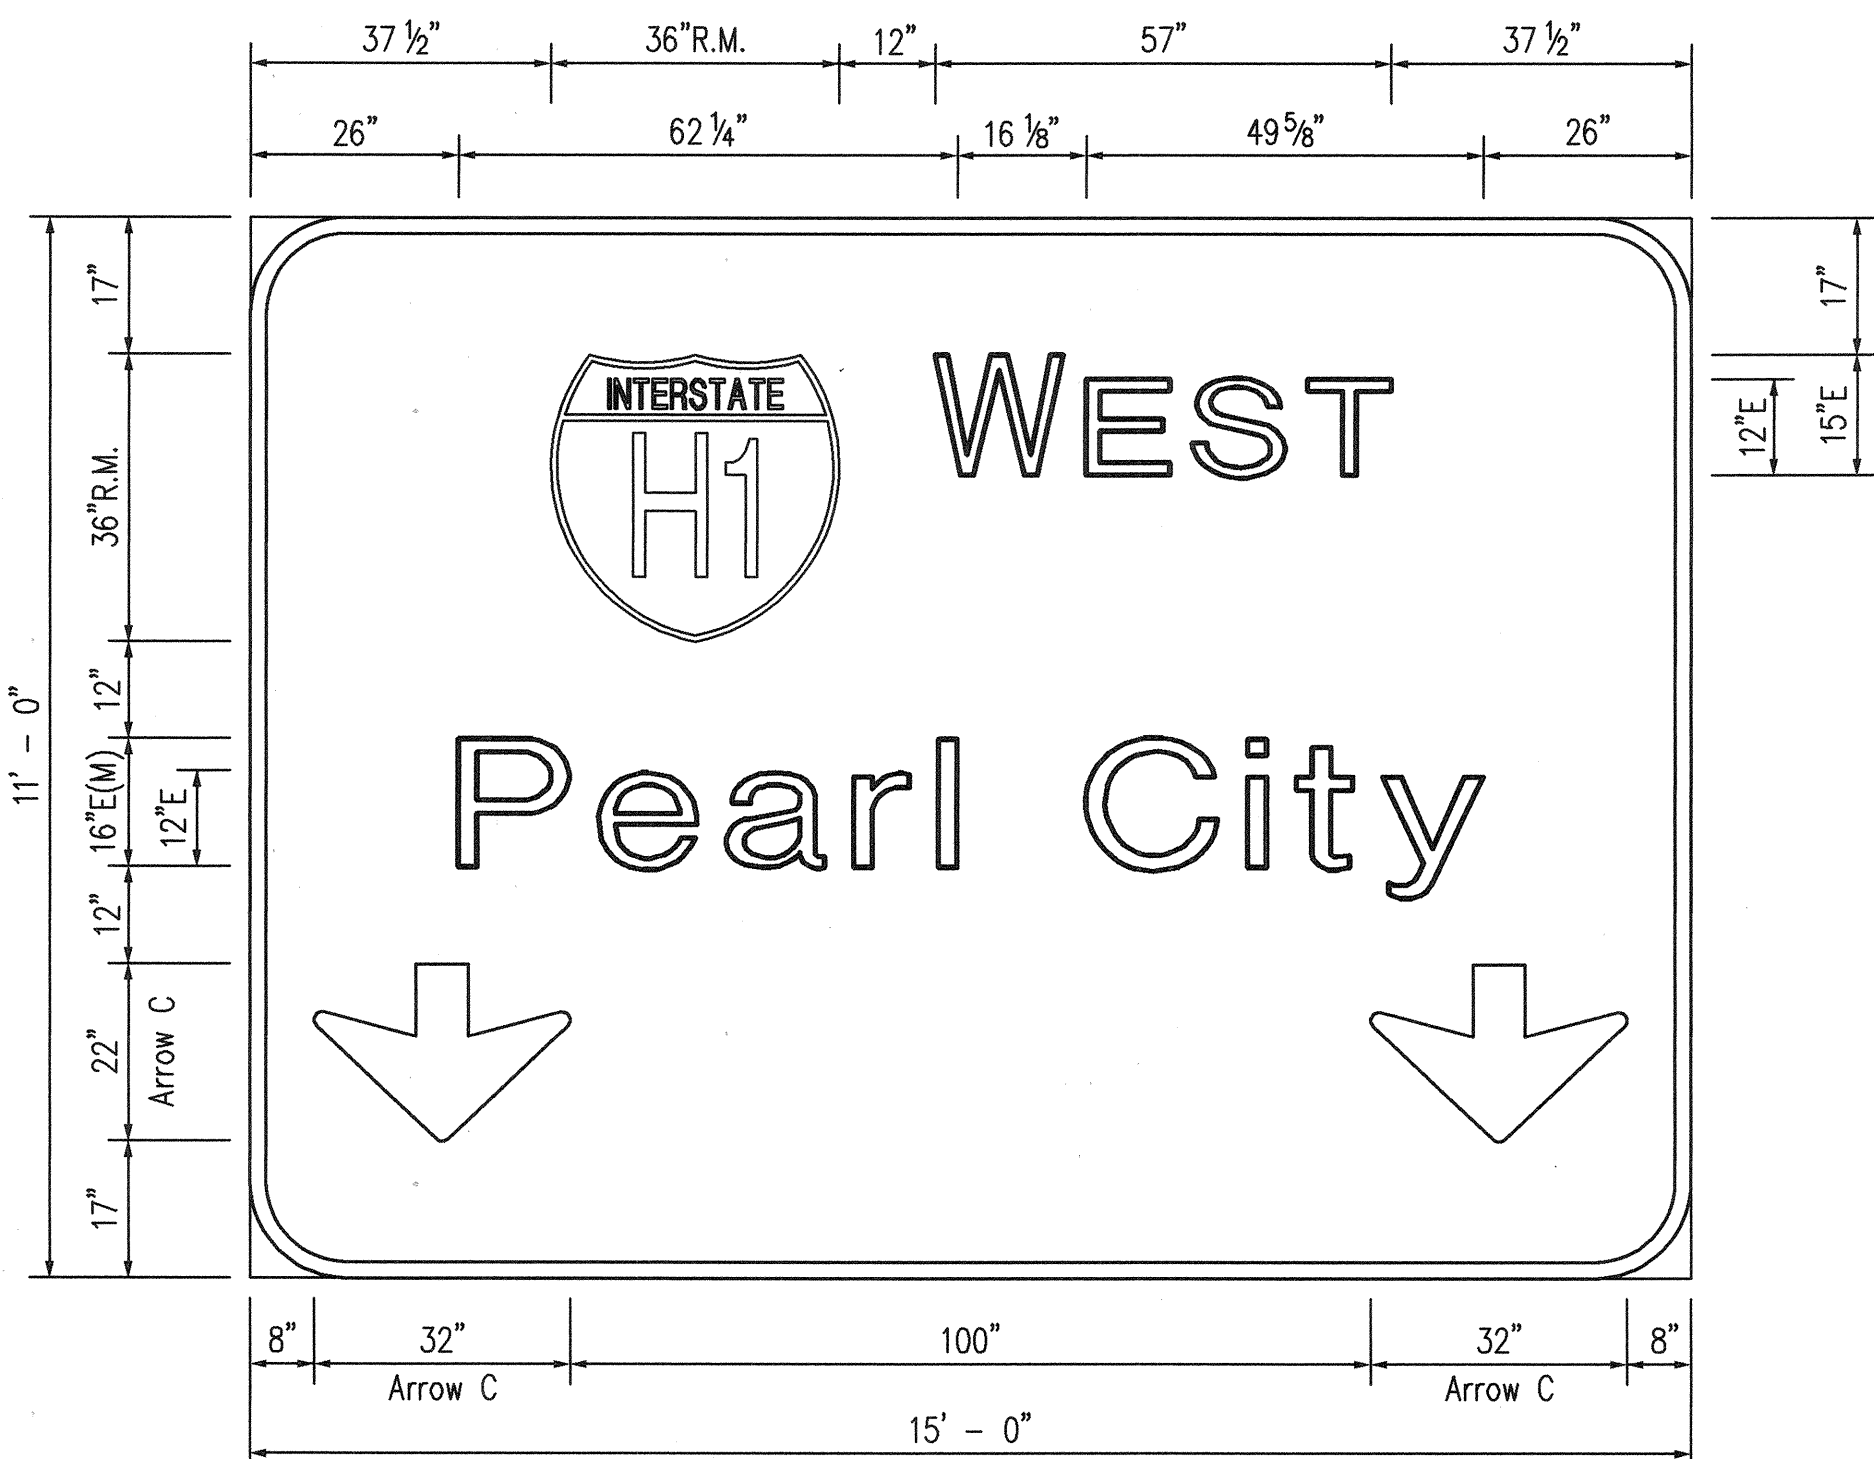


E-17C

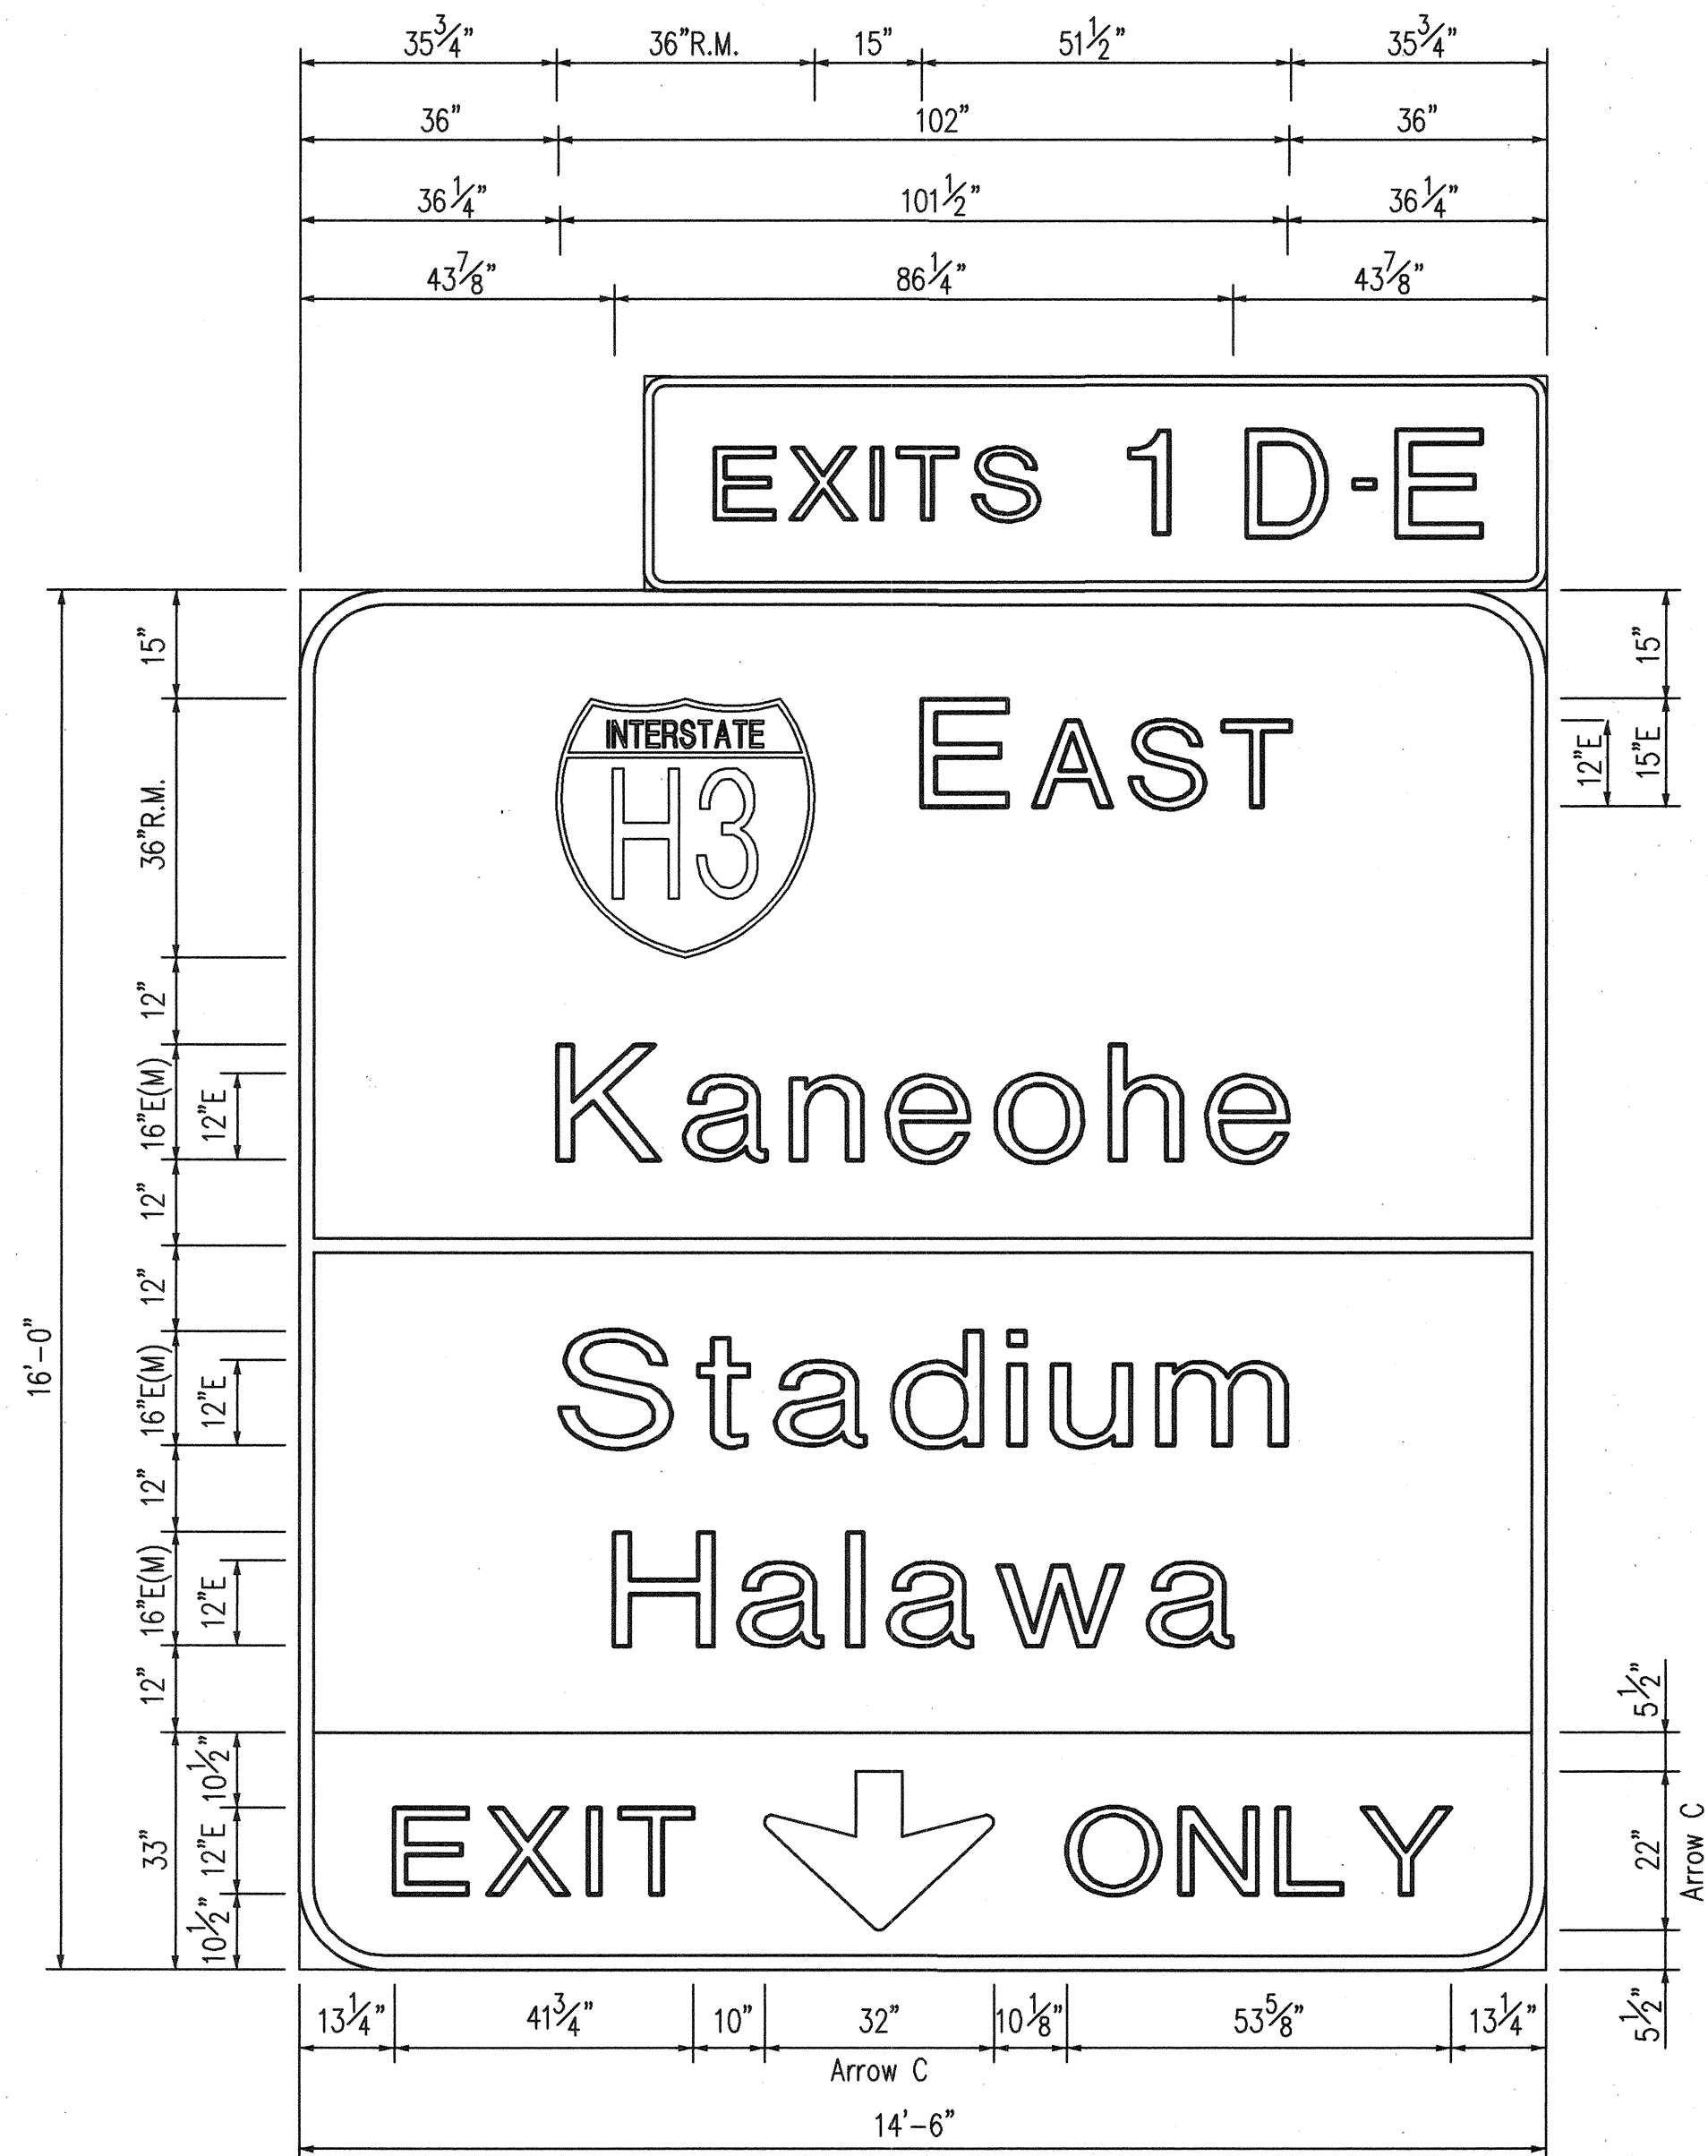


E-17R

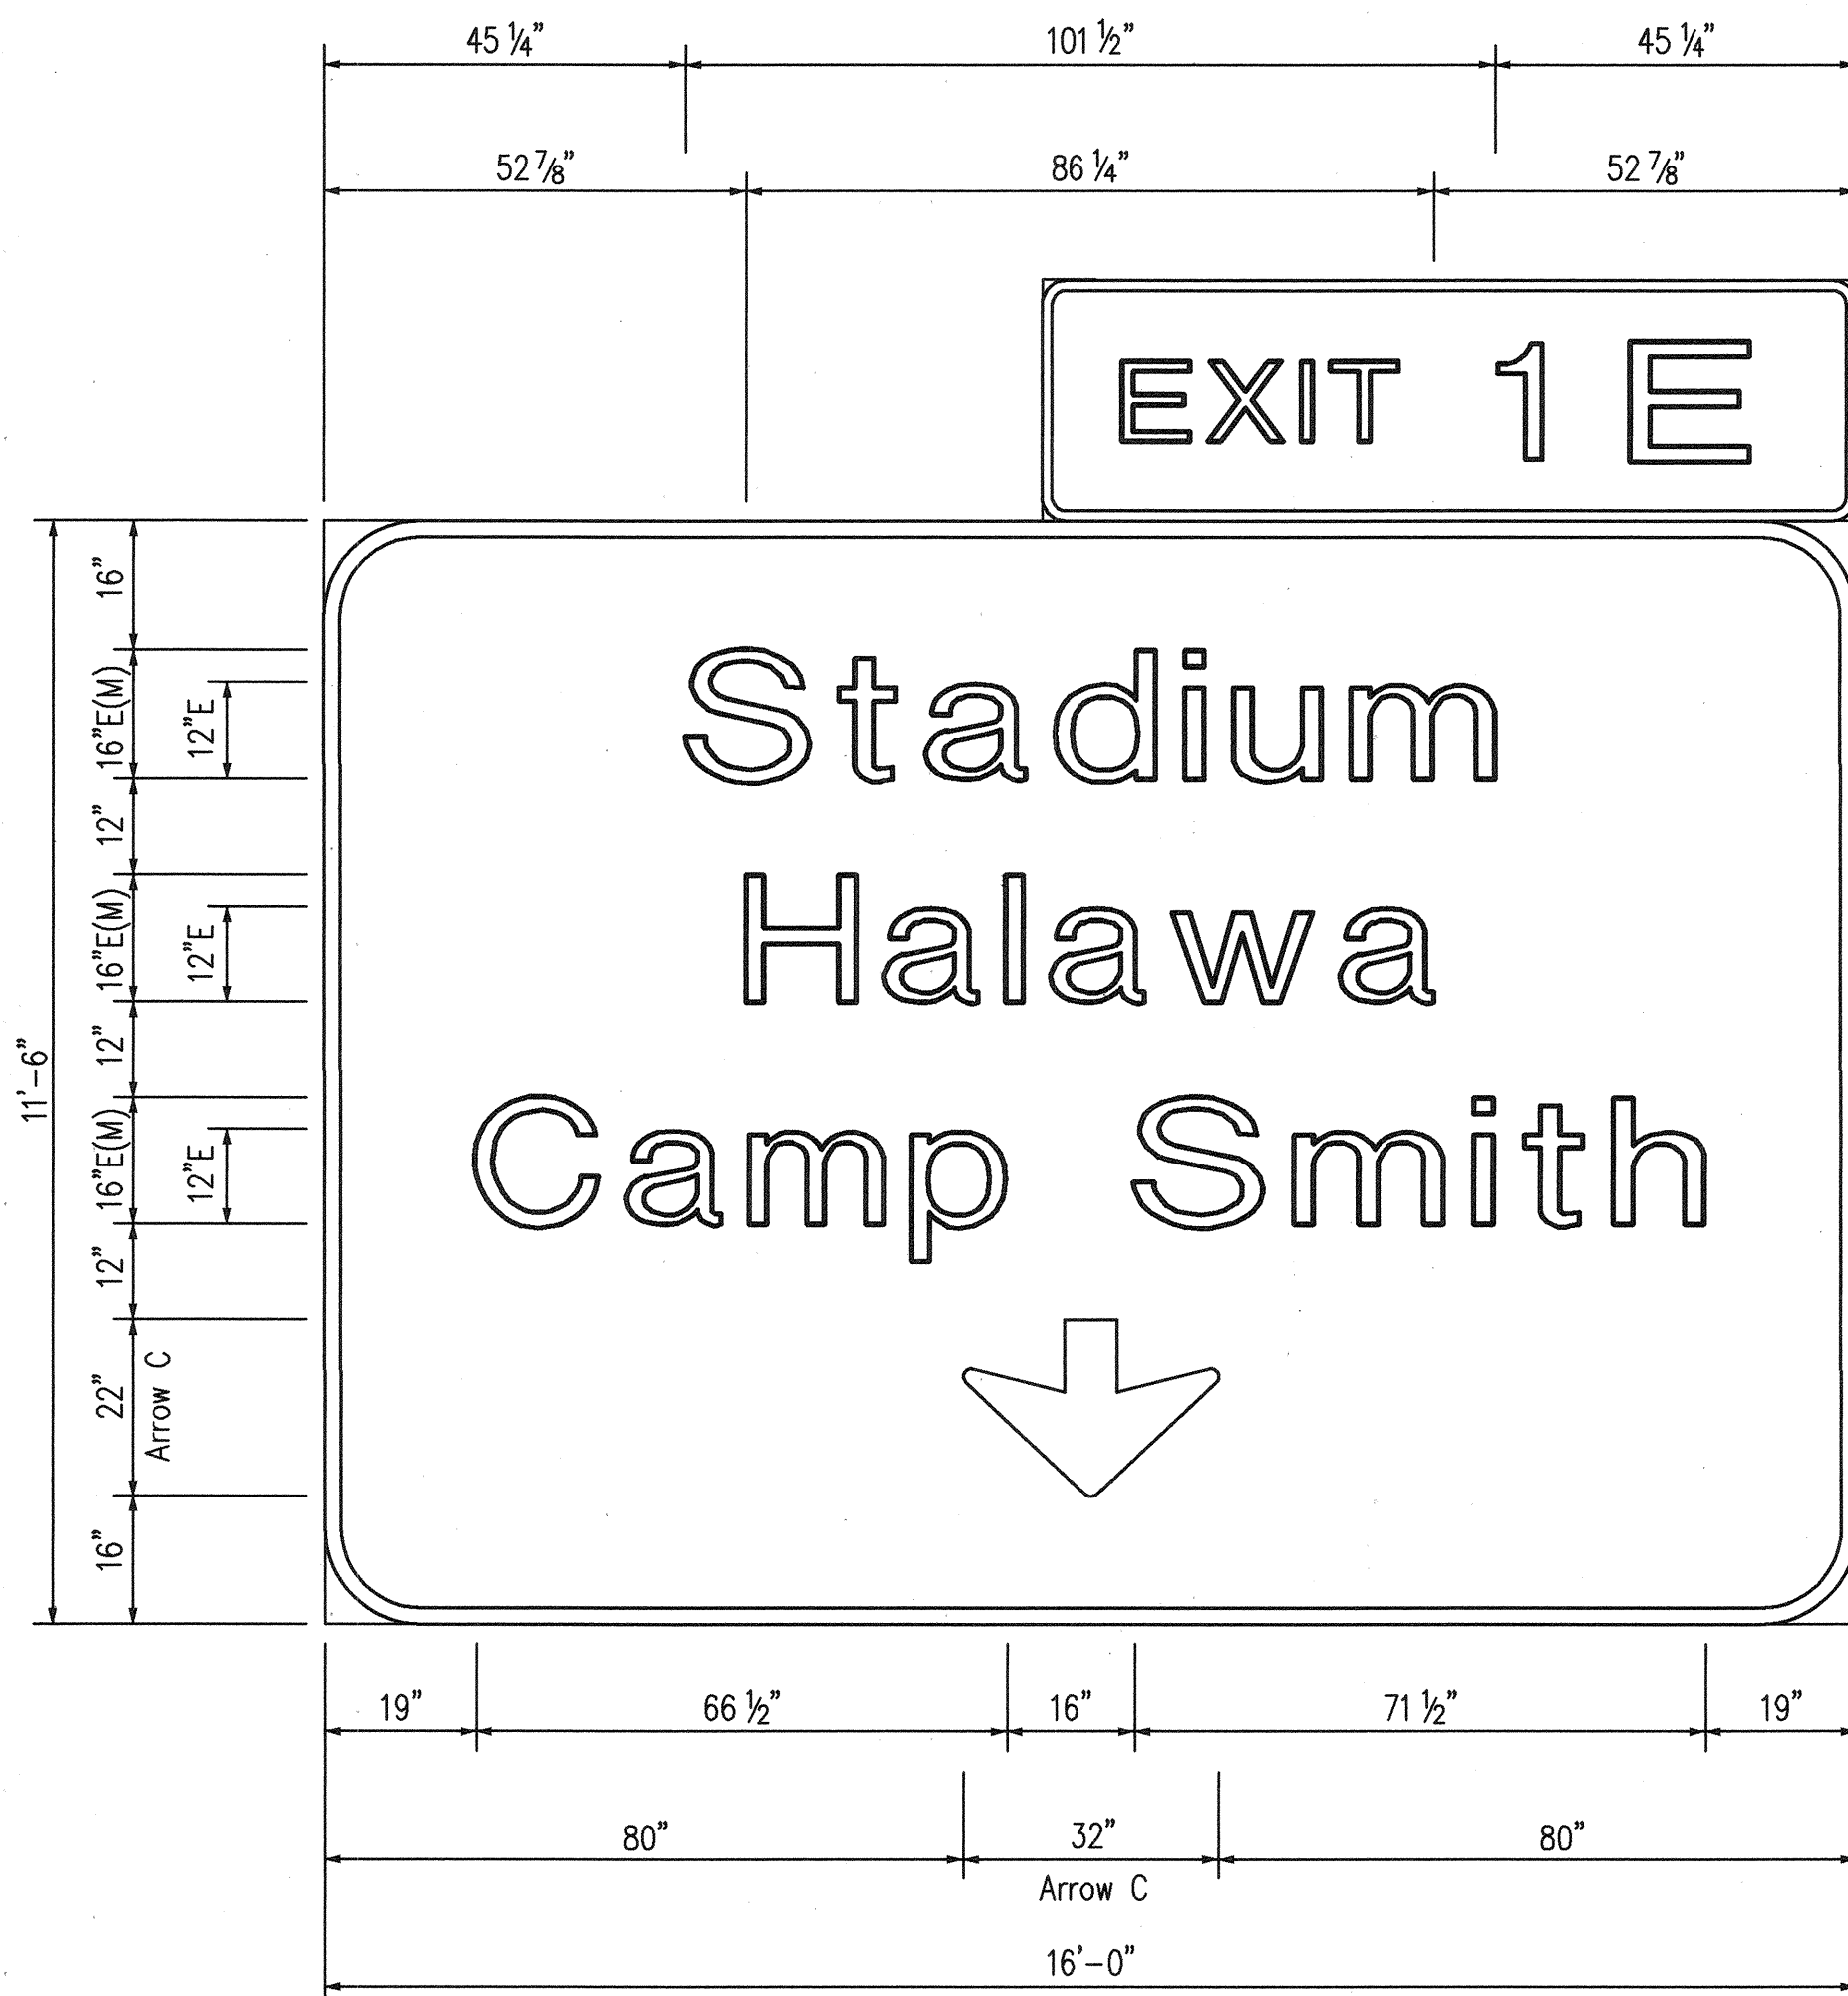

E-52L

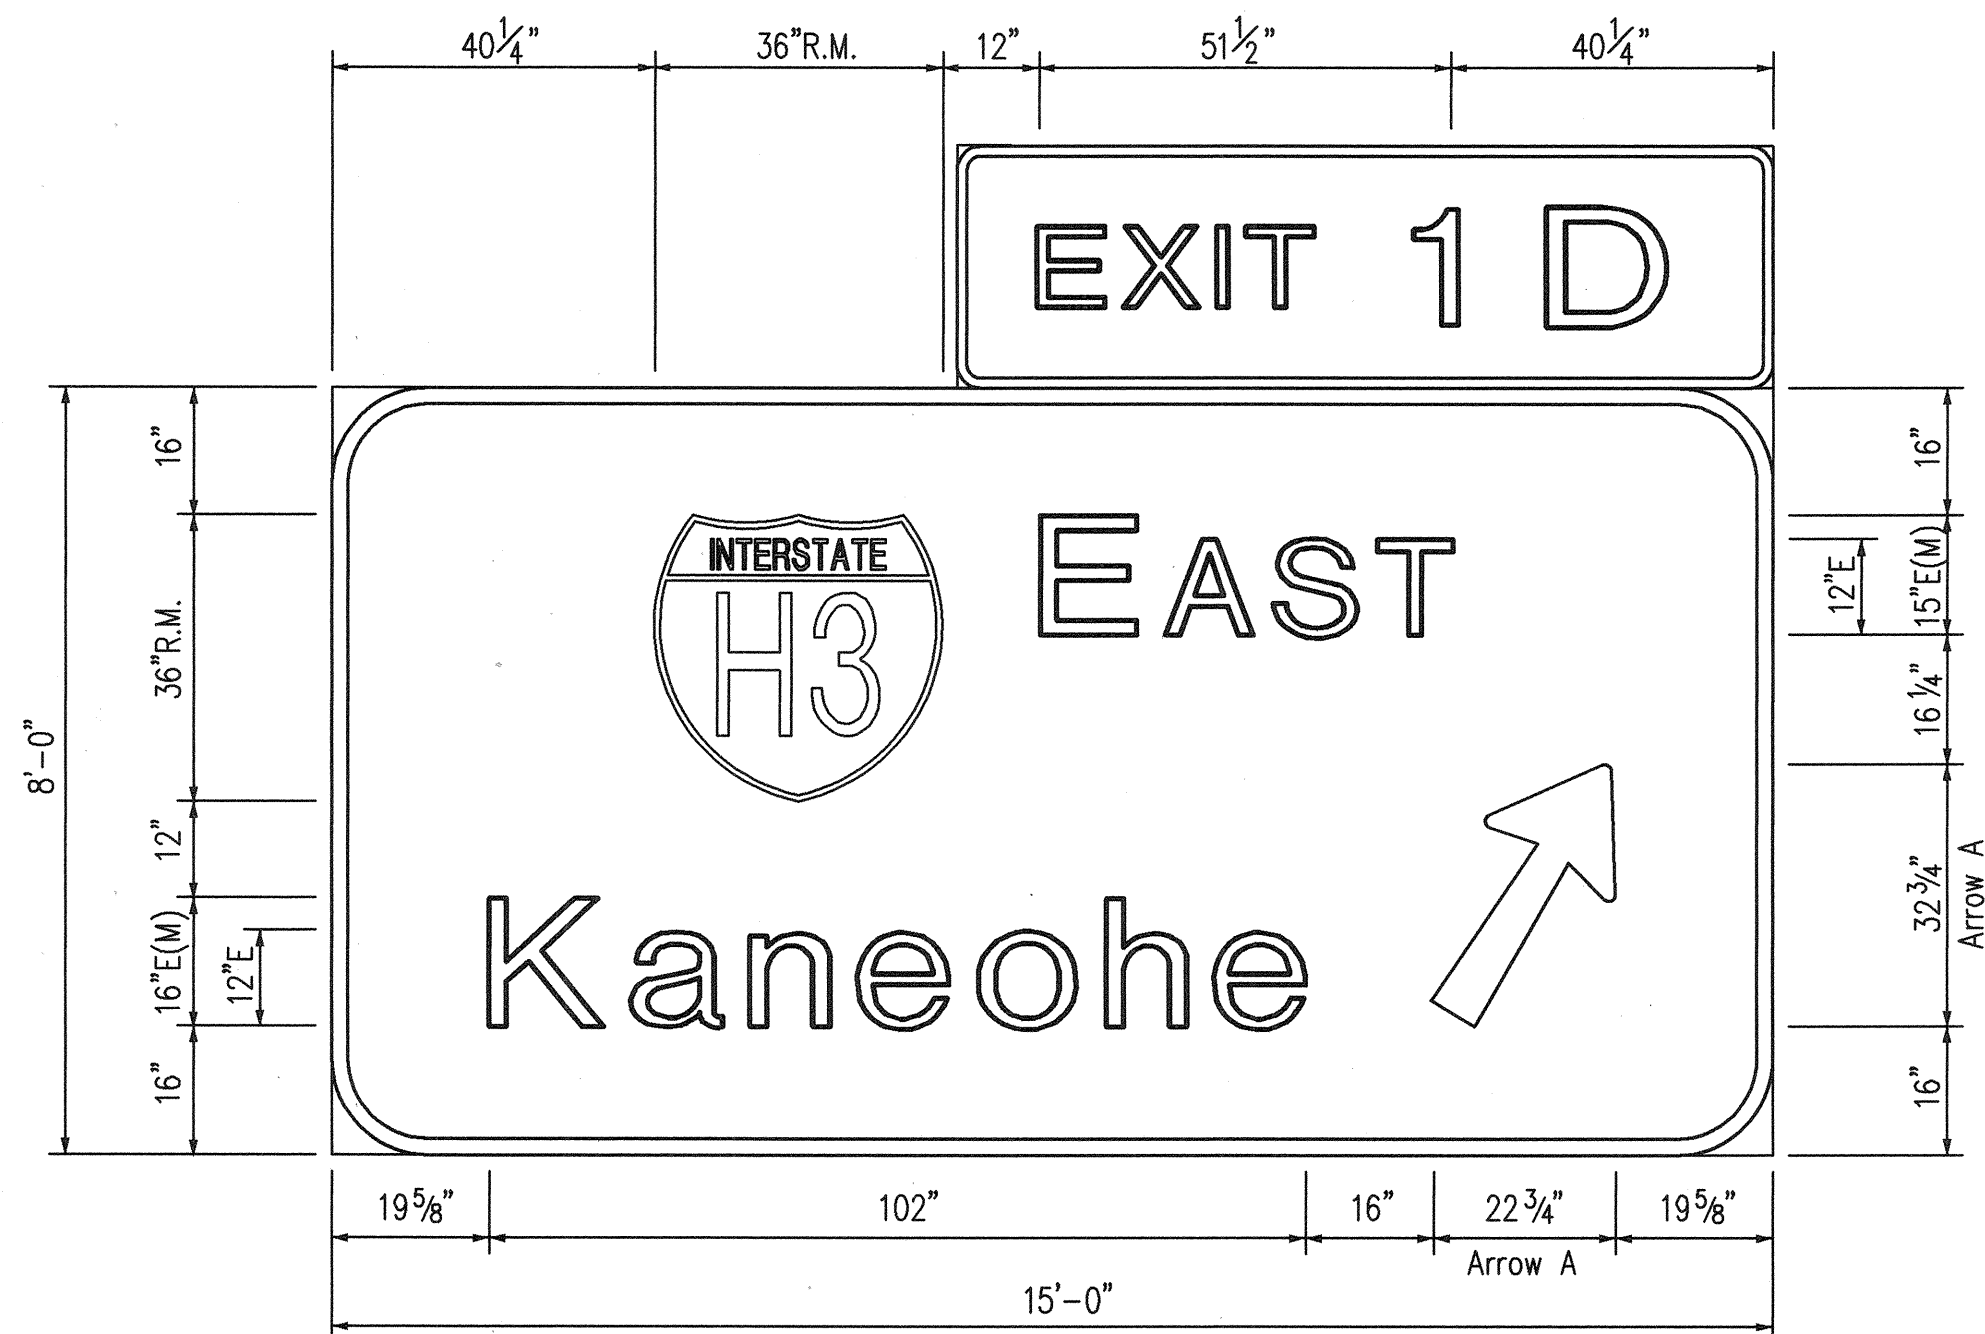

E-52R

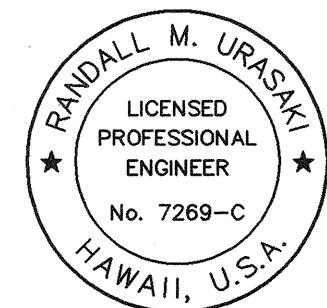

THIS WORK WAS PREPARED BY ME
OR UNDER MY SUPERVISION.

Randall M. Urasaki


STATE OF HAWAII
DEPARTMENT OF TRANSPORTATION
HIGHWAYS DIVISION

**DESTINATION SIGNS
SIGN DETAILS
MOANALUA FREEWAY**


H-3 FINISH (UNIT II)
FAIP NO. I-H3-1(75), UNIT II
LEEWARD SECTION

SCALE: 1/2" = 1'-0" DATE: JANUARY 1997
SHEET NO. 6P13 OF 20 SHEETS


FED. ROAD DIST. NO.	STATE	FED. AID PROJ. NO.	FISCAL YEAR	SHEET NO.	TOTAL SHEETS
HAWAII	HAW.	I-H3-1(75), UNIT II	1997	C.O. 864	1102

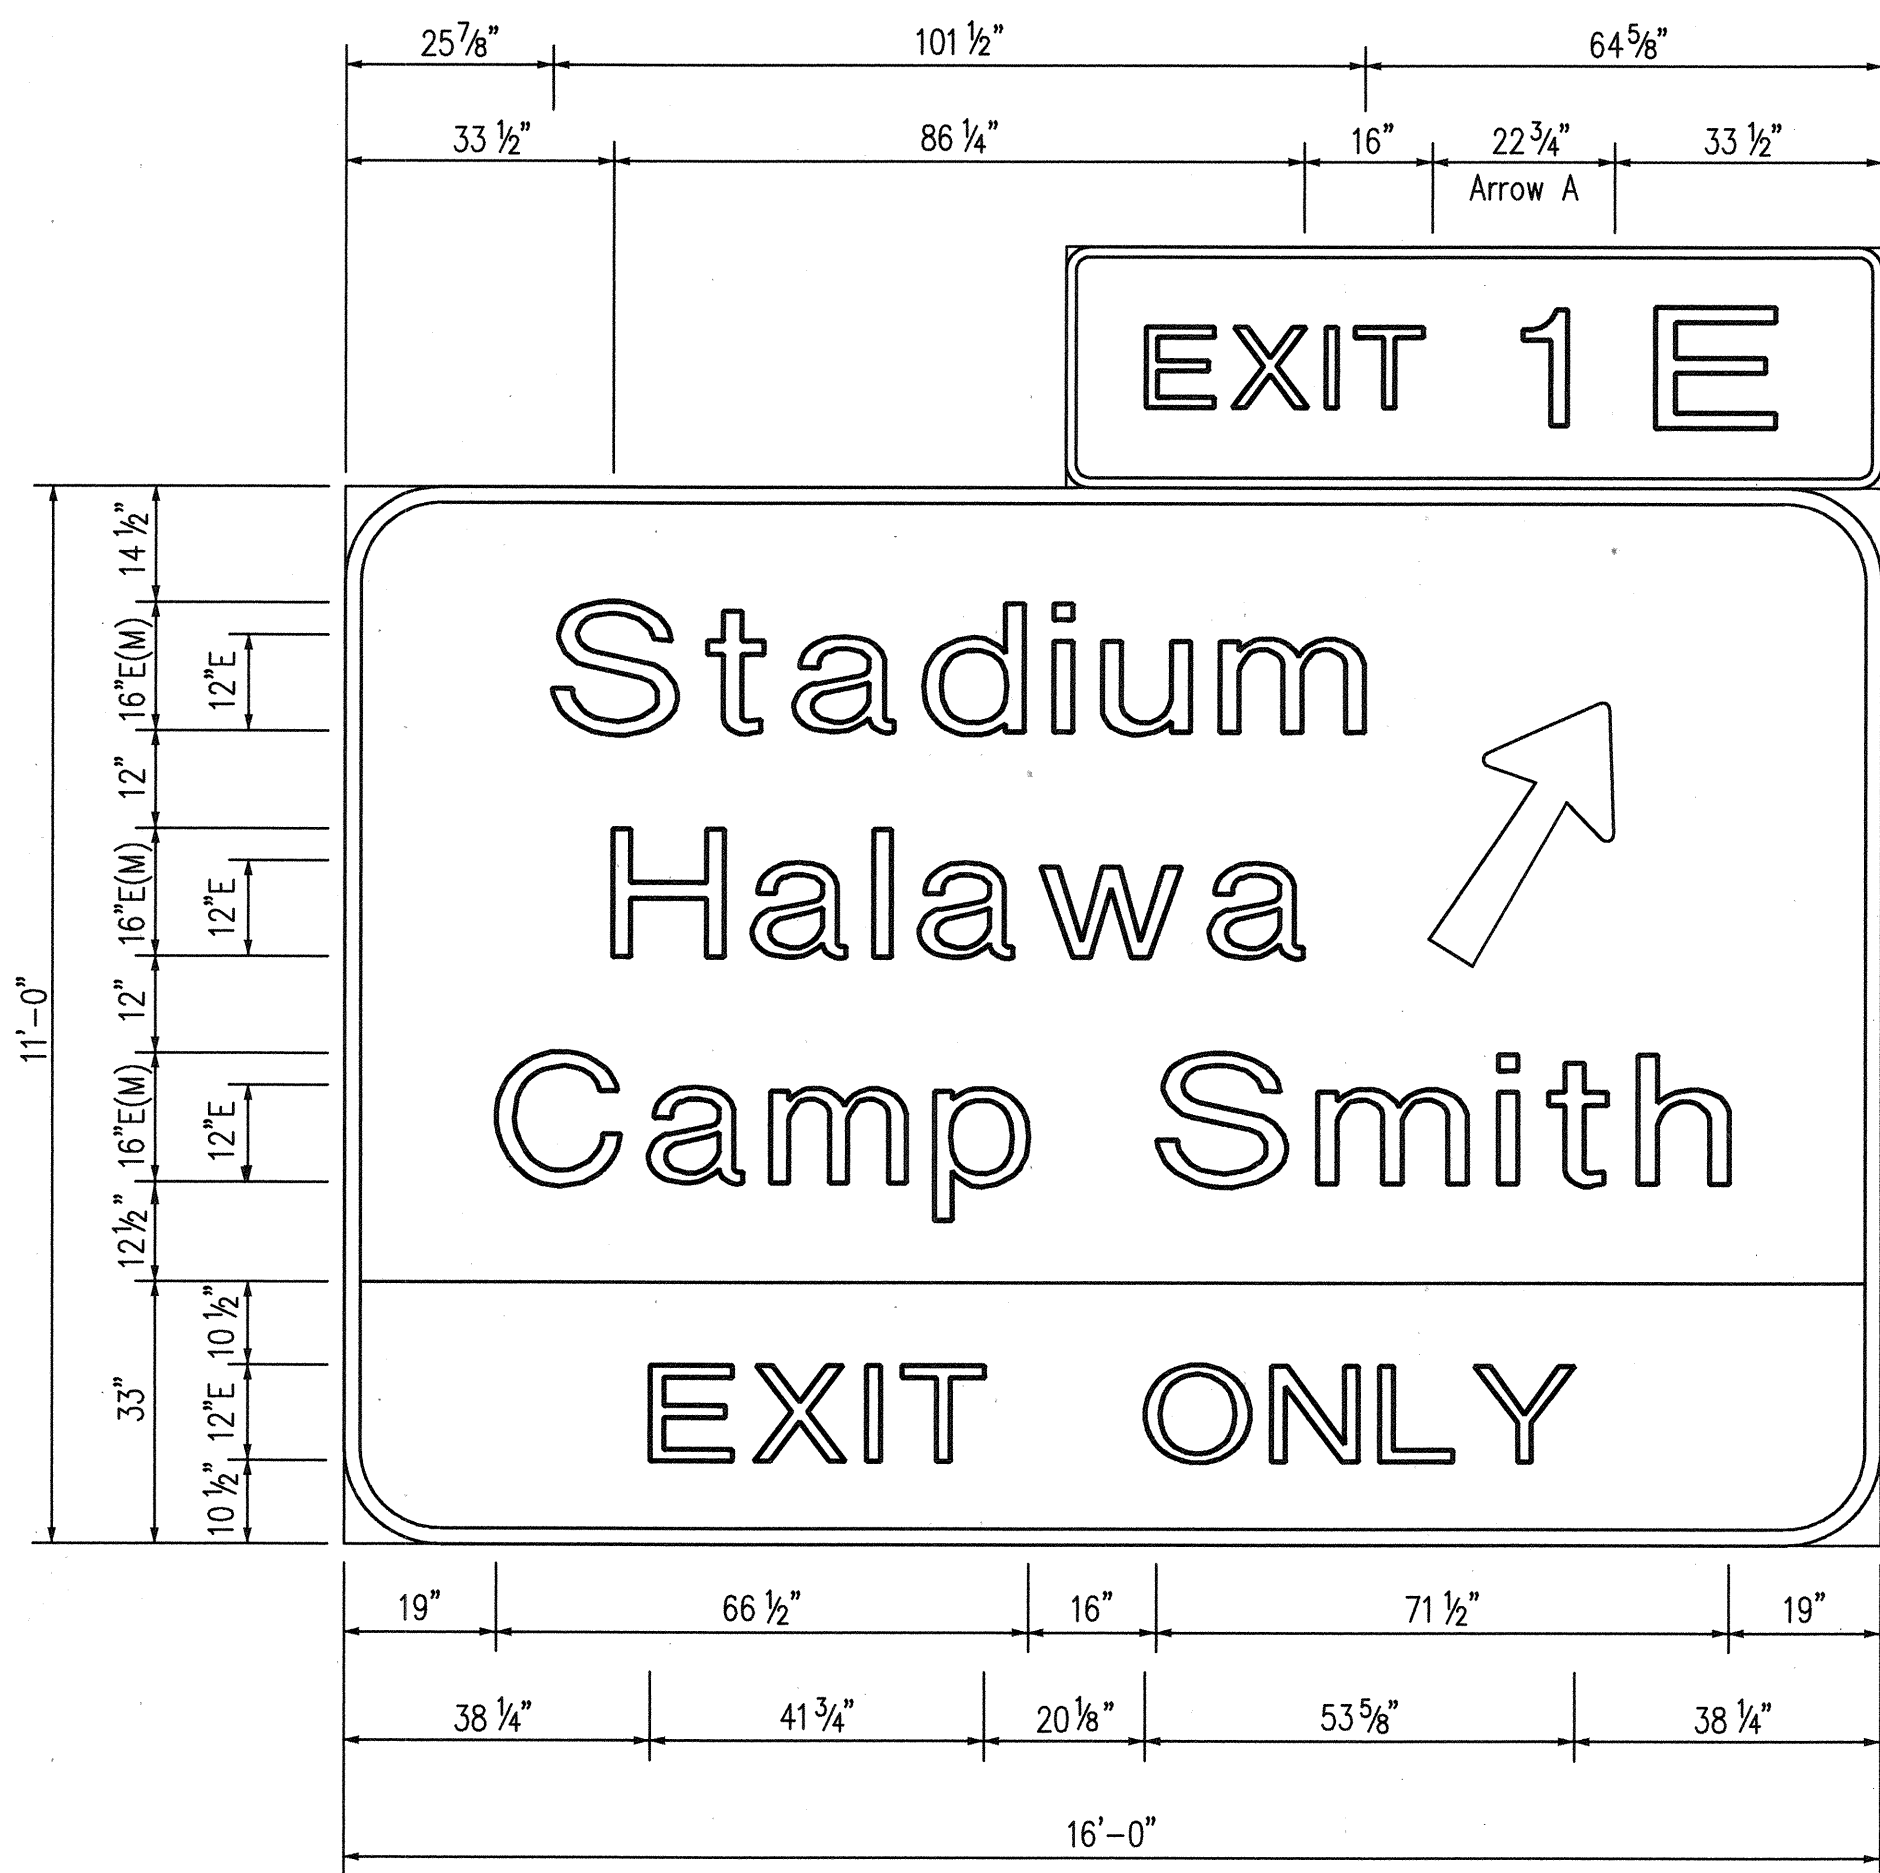


E-54L

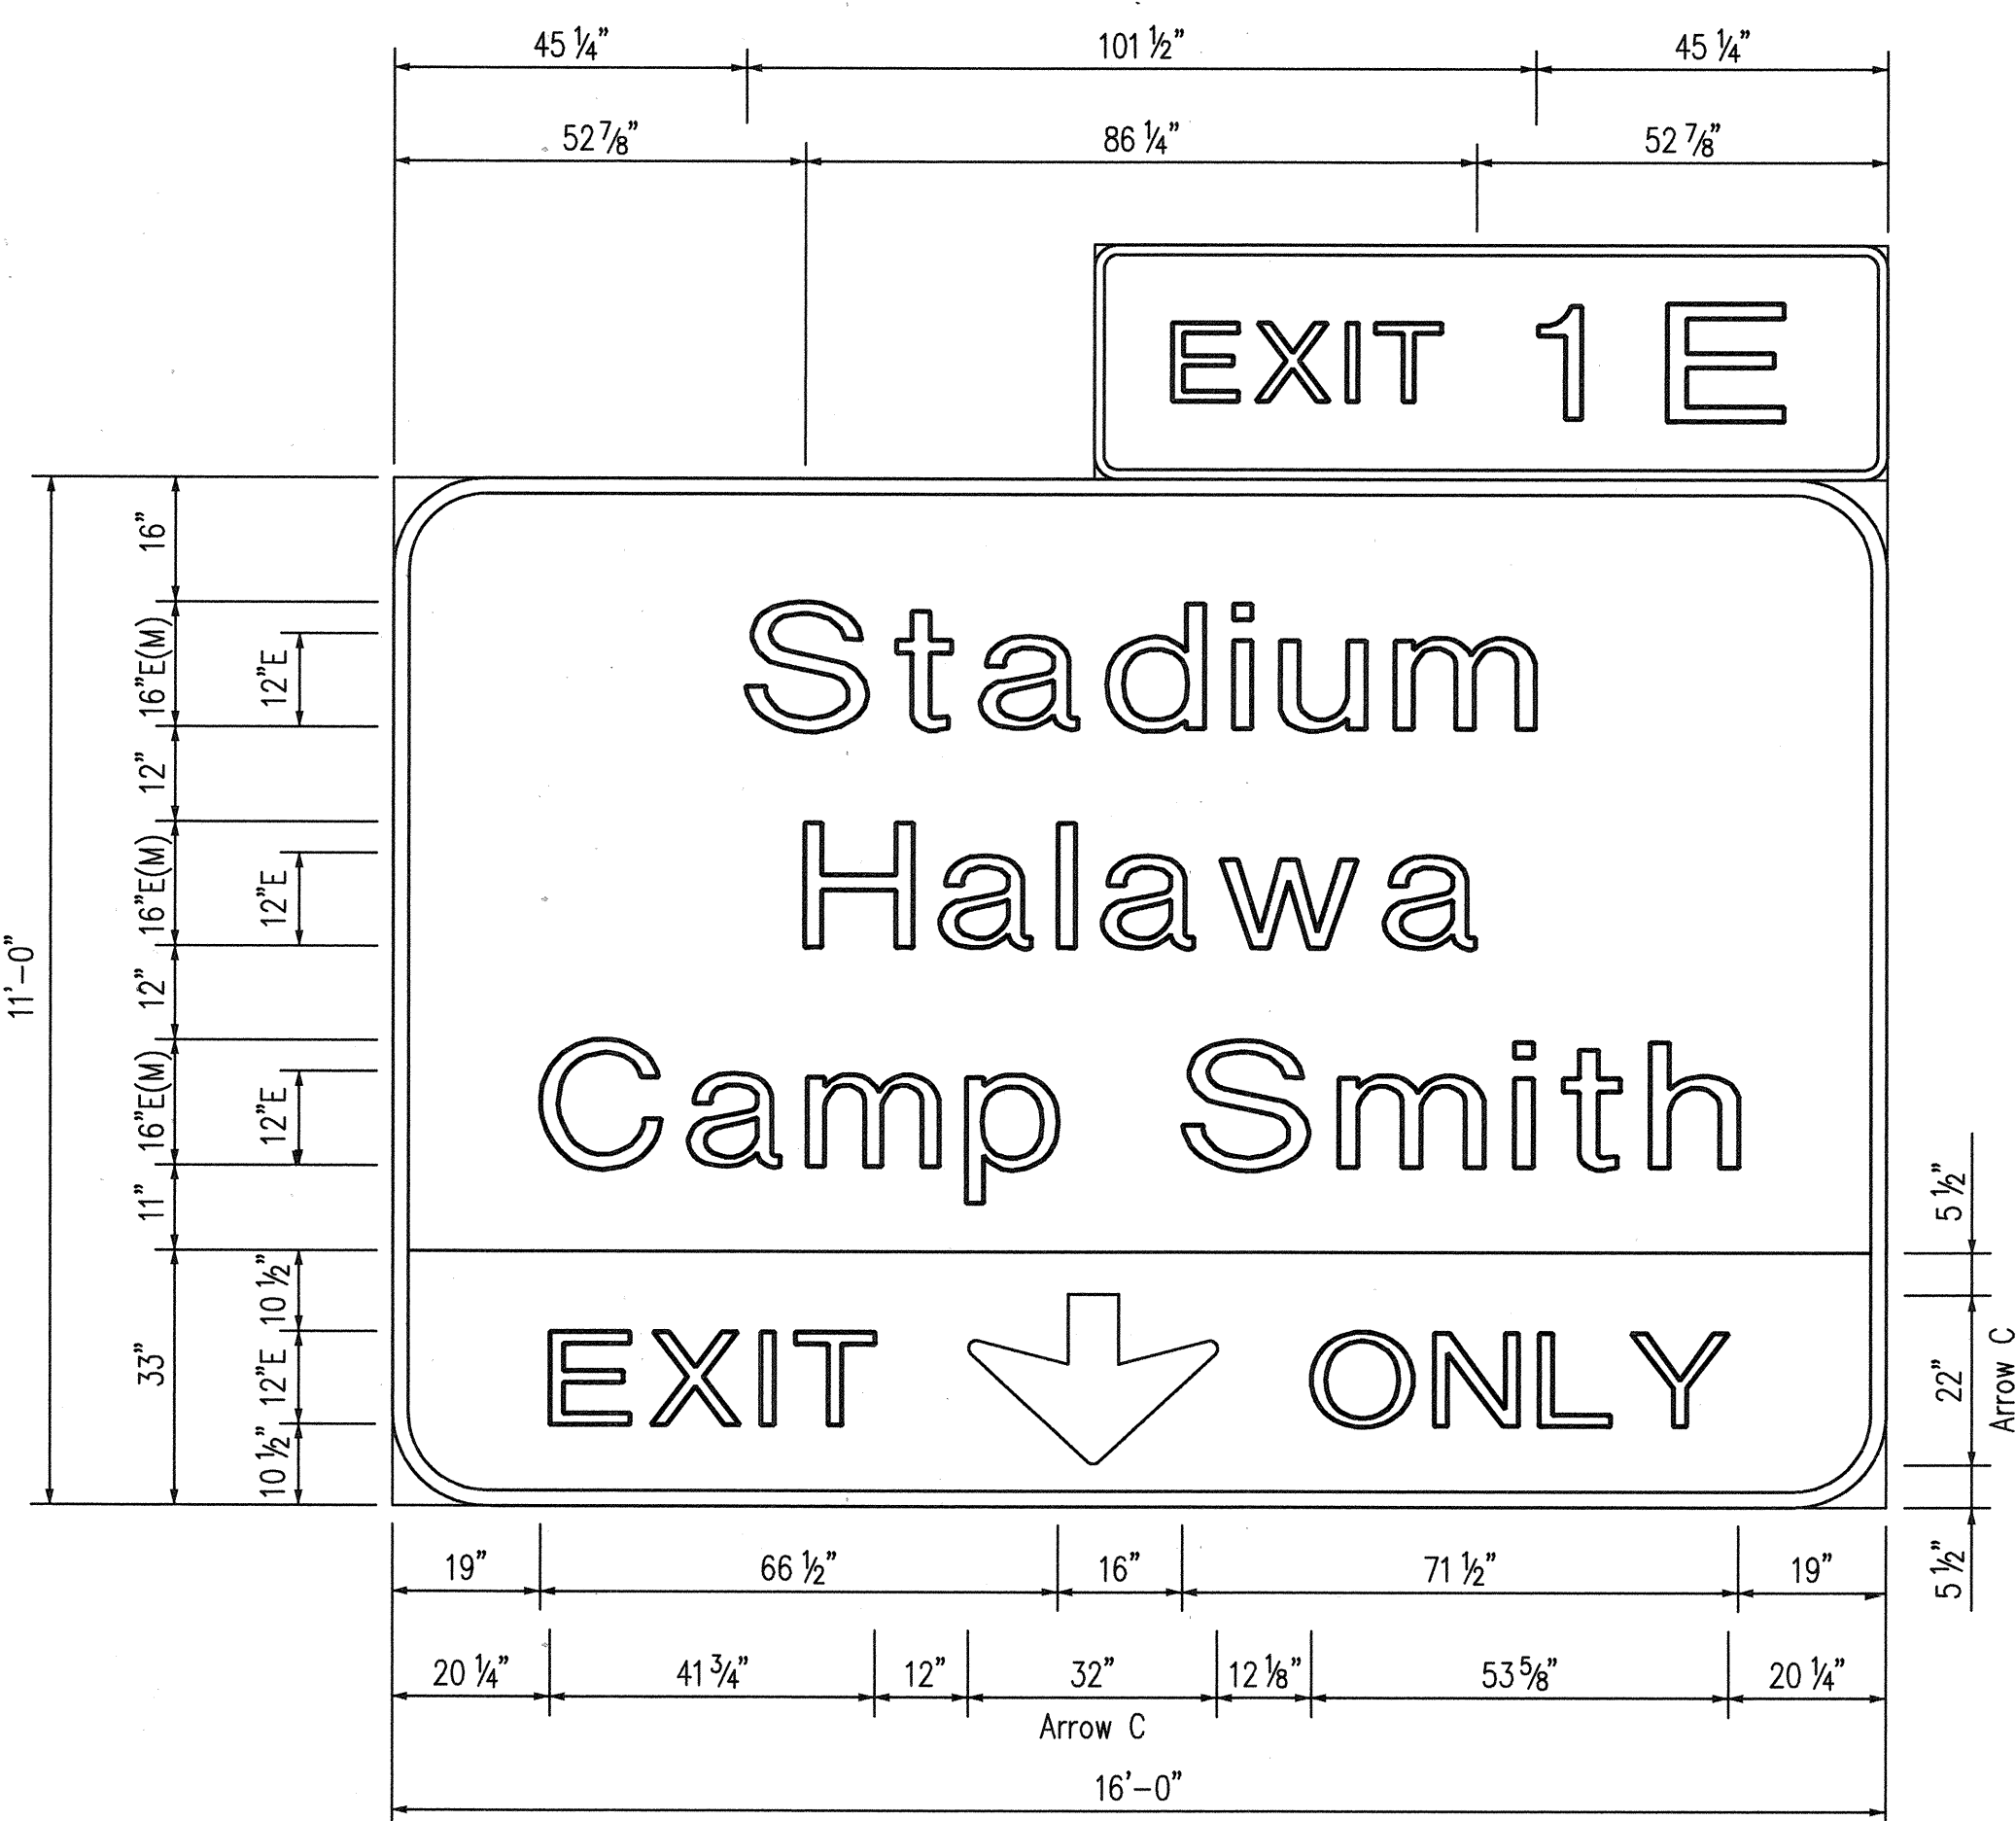


E-56L

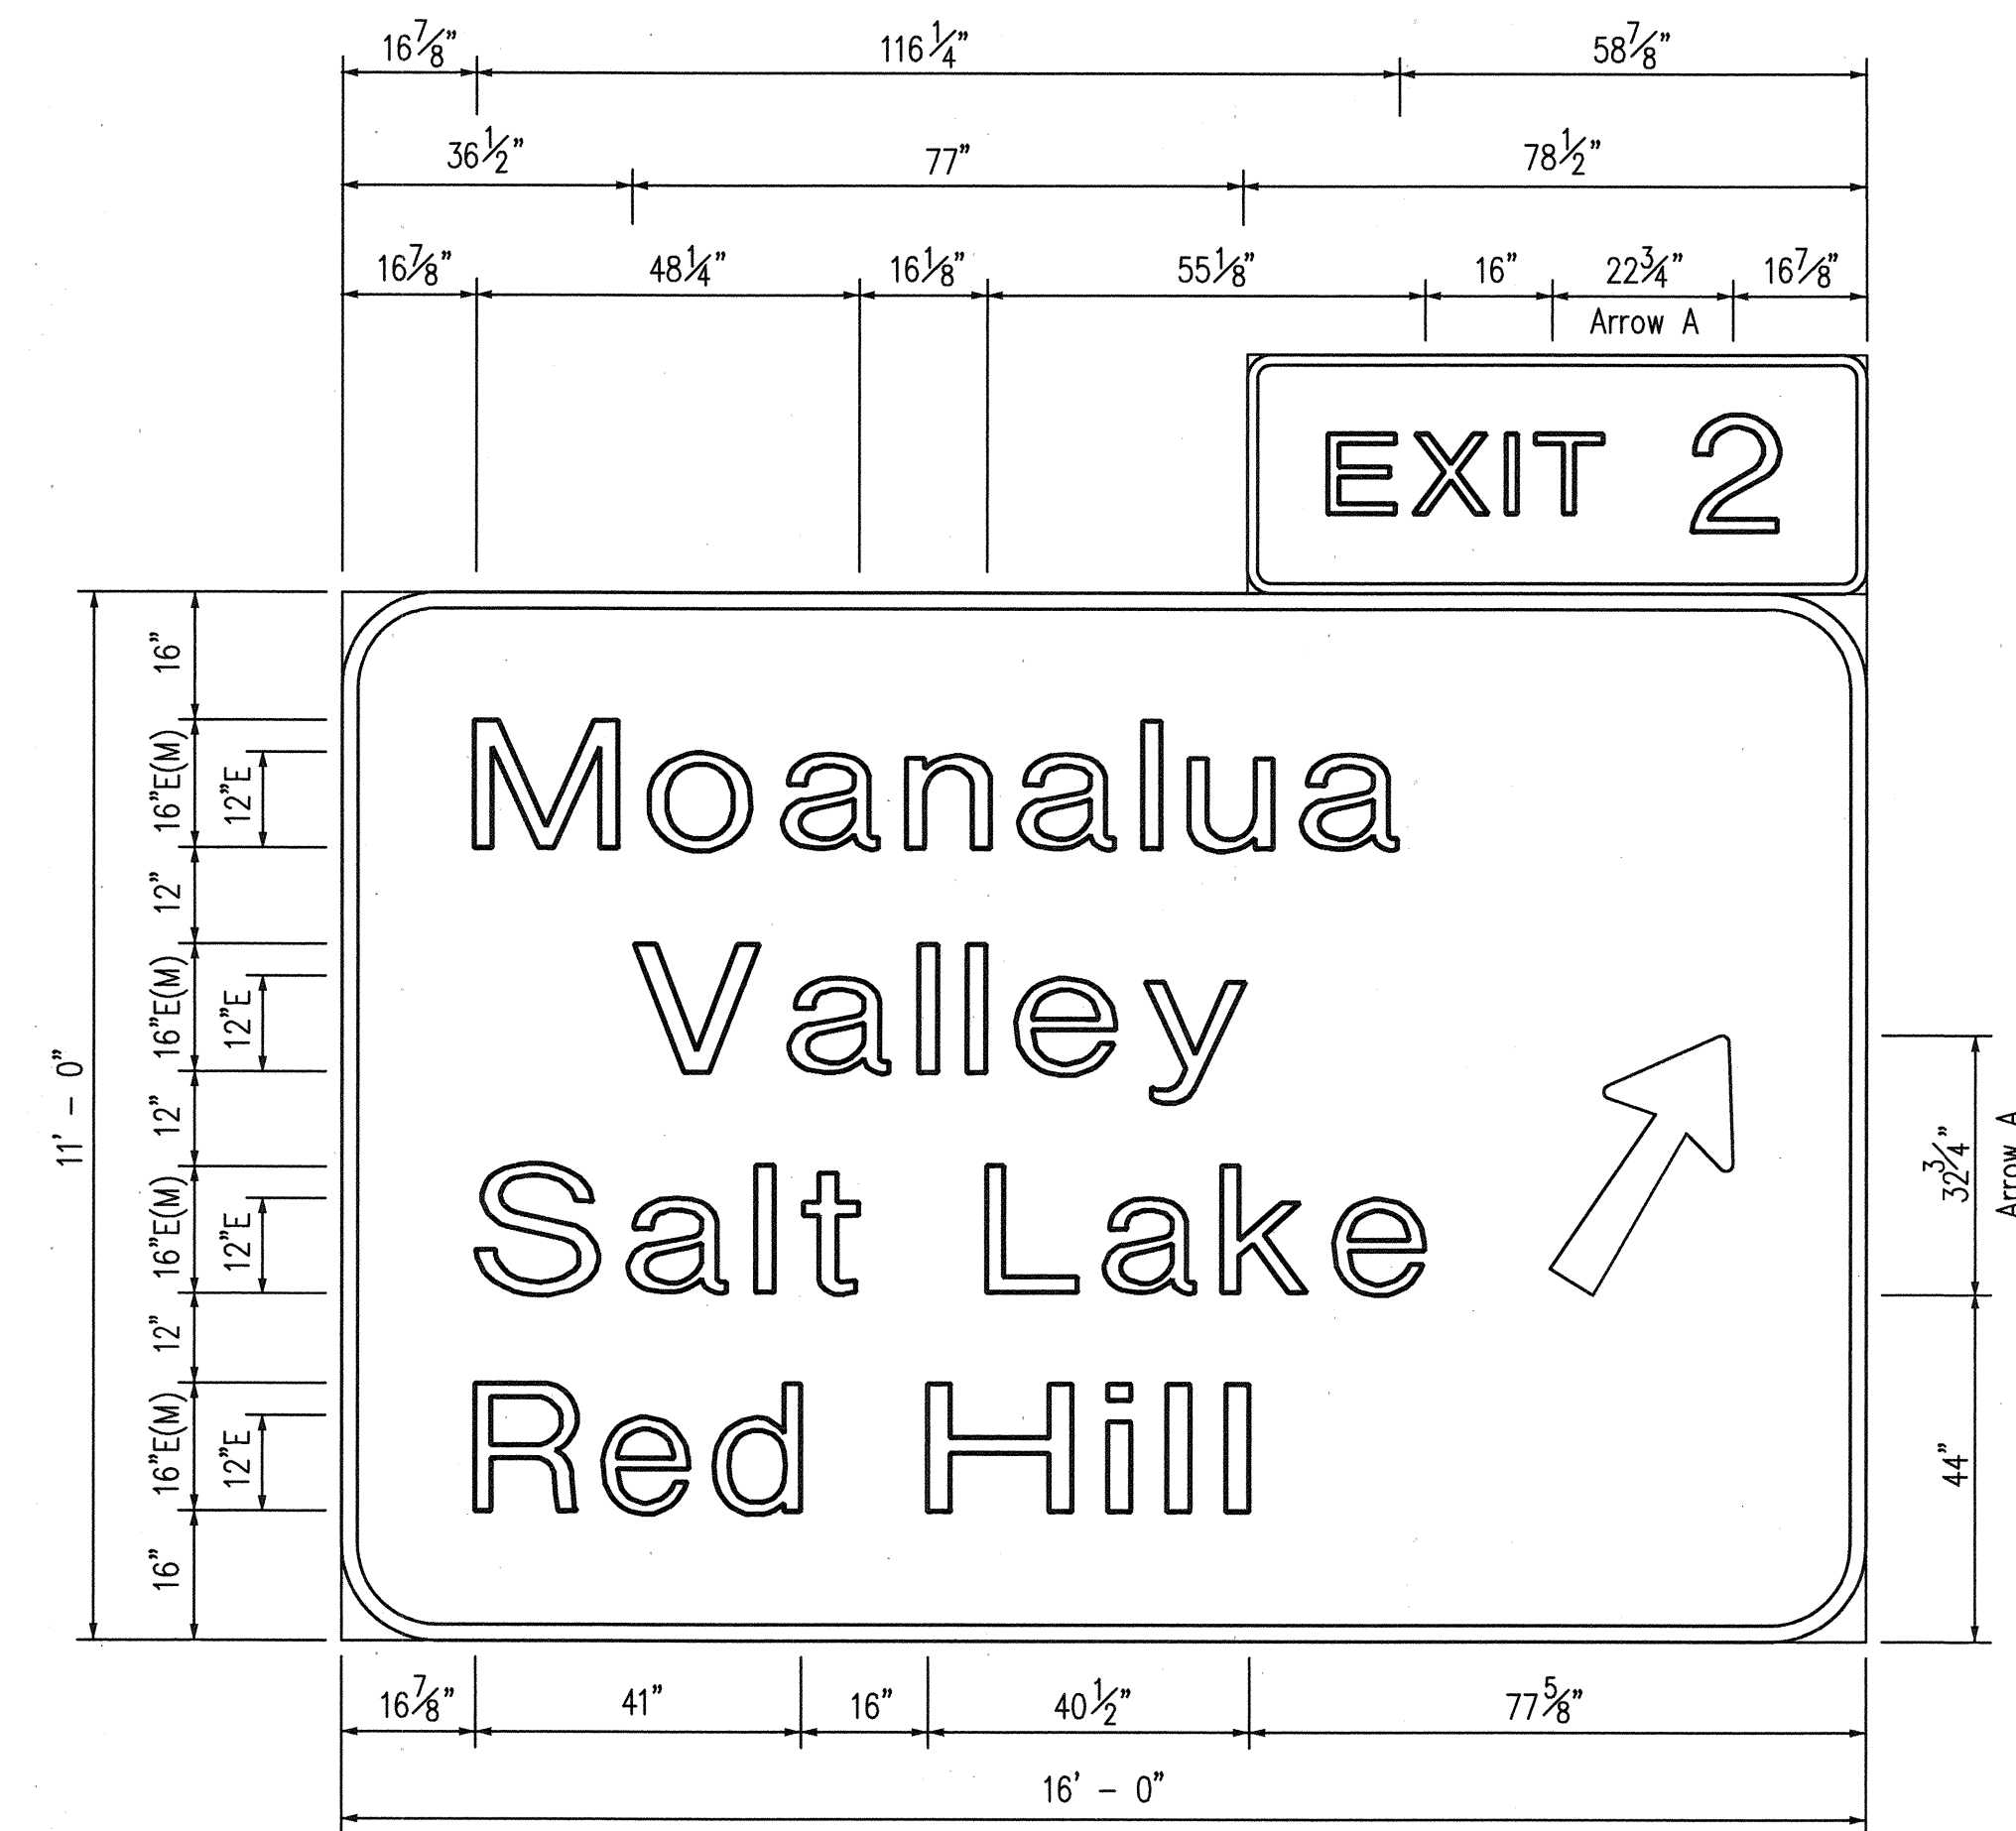


E-58R

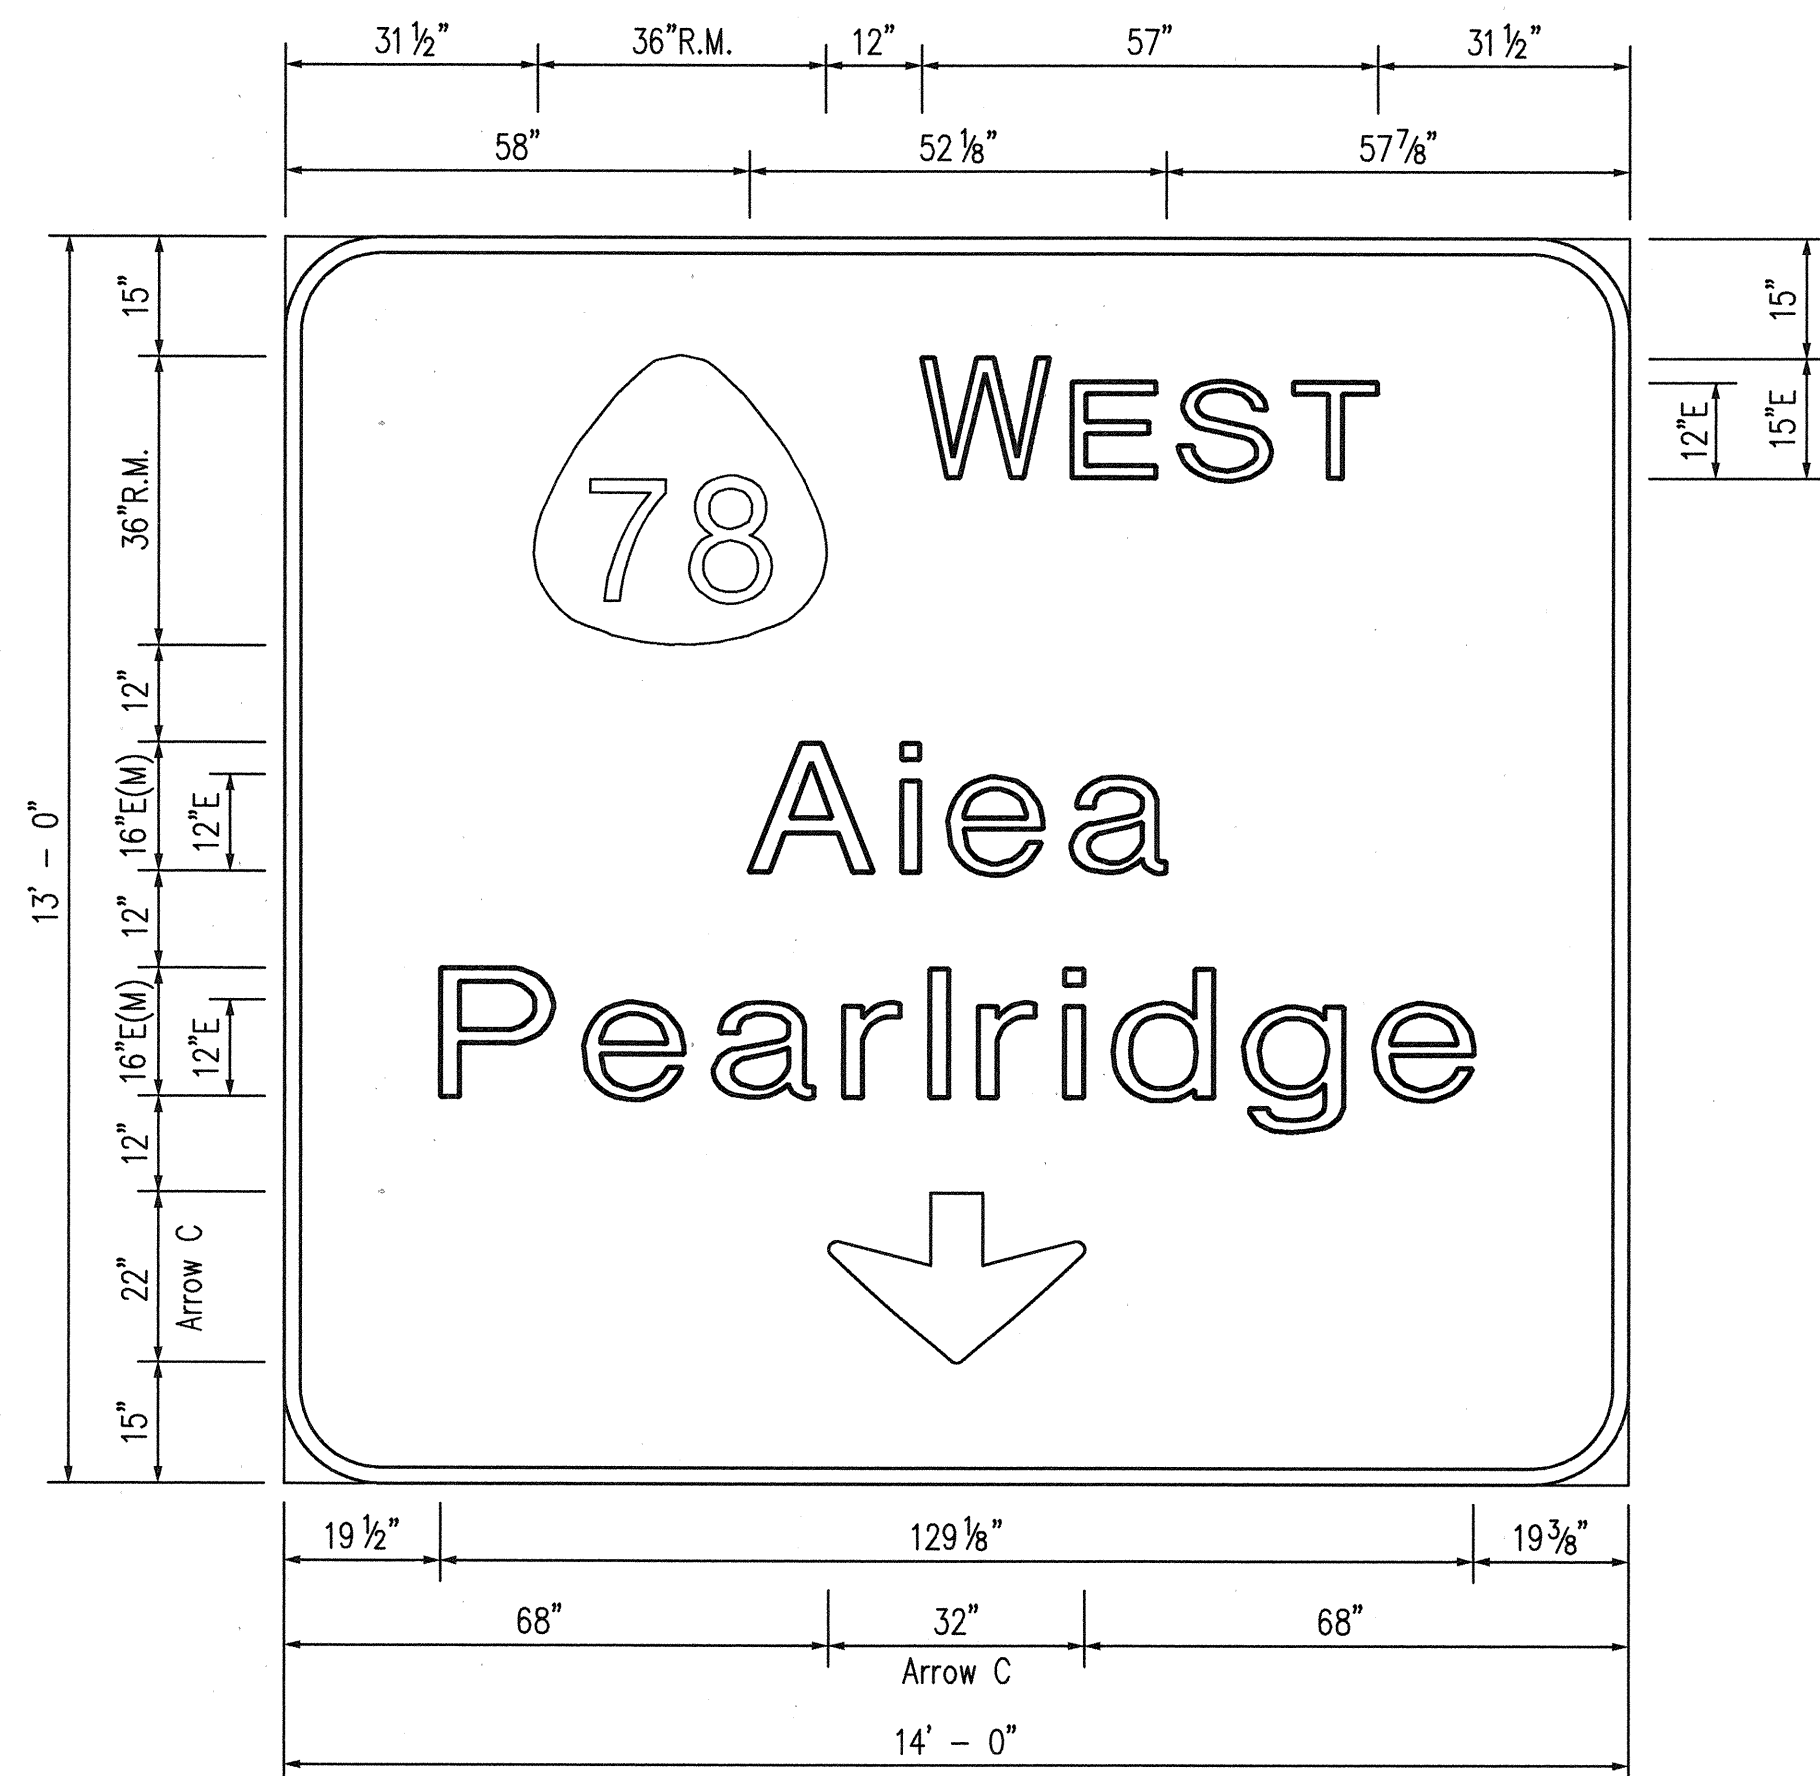

E-54LL

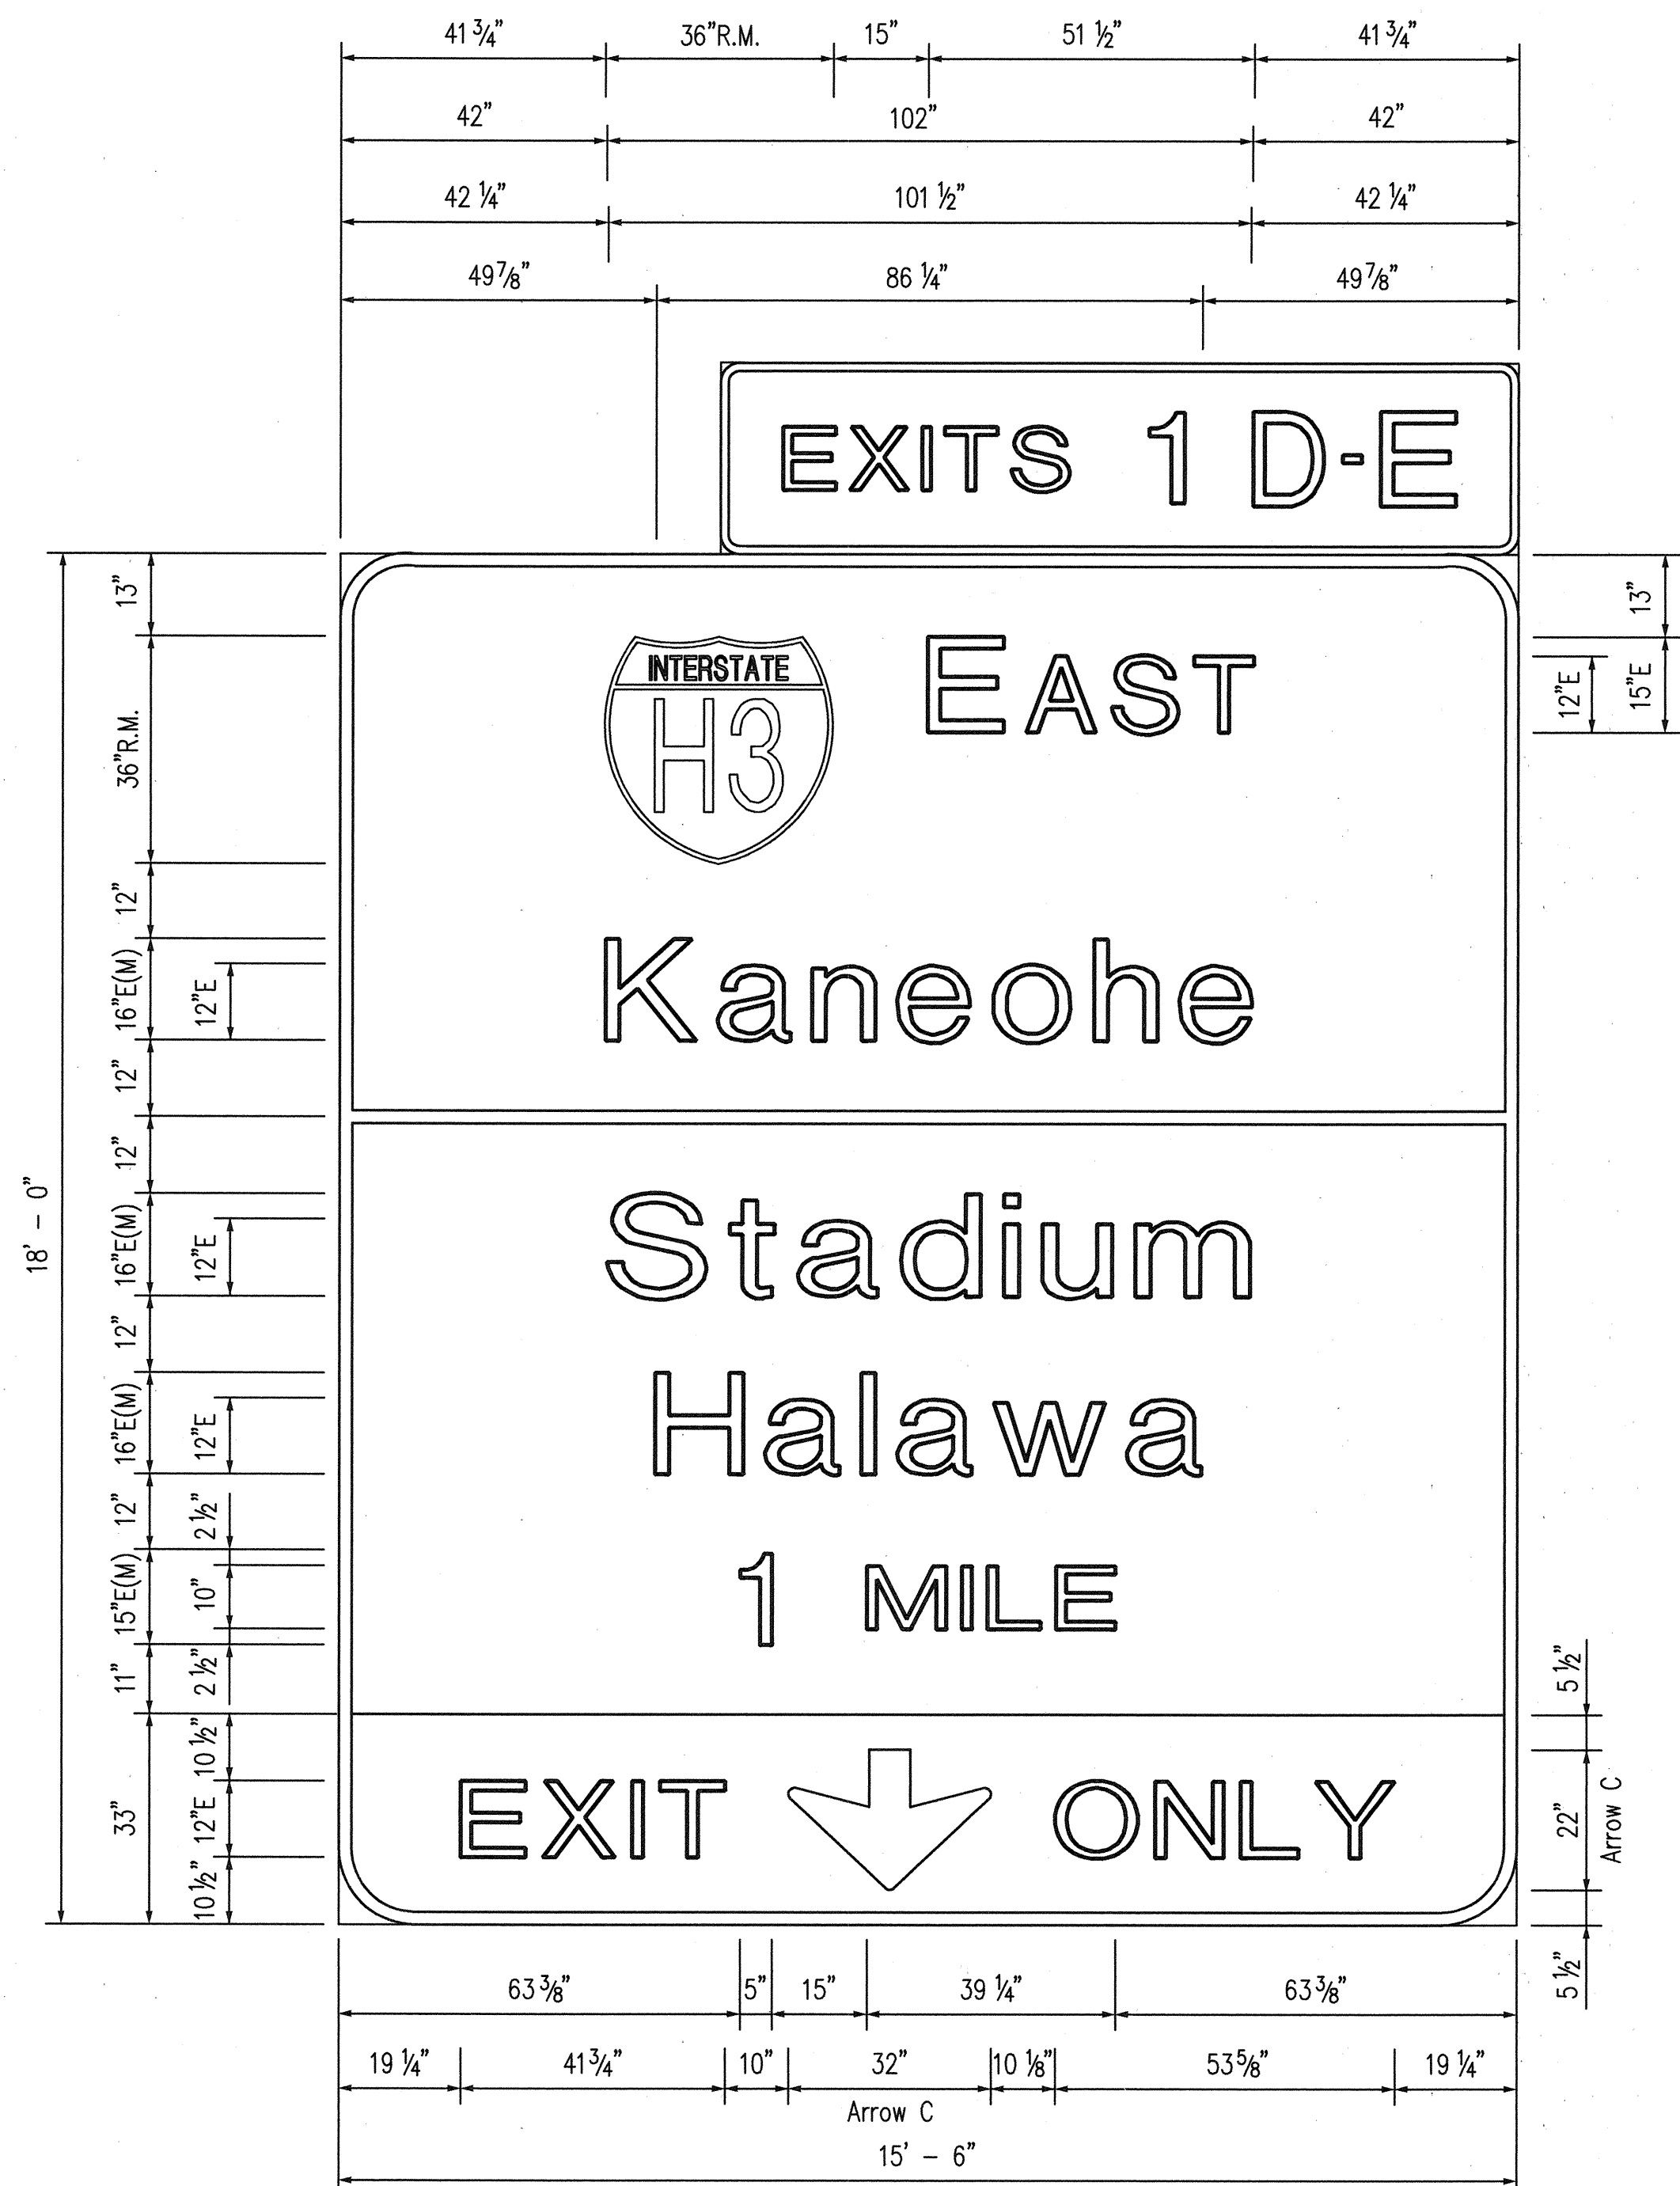

E-58L

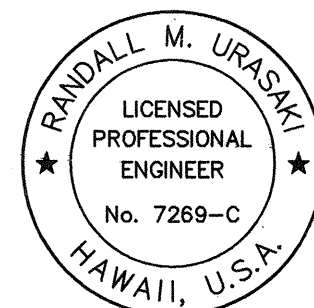

THIS WORK WAS PREPARED BY ME OR UNDER MY SUPERVISION.

Randall M. Urasaki

5/22/98	Added Sign E-54LL
Date	Revision
STATE OF HAWAII DEPARTMENT OF TRANSPORTATION HIGHWAYS DIVISION	
DESTINATION SIGNS	
SIGN DETAILS	
MOANALUA FREEWAY	
H-3 FINISH (UNIT II) FAIP NO. I-H3-1(75), UNIT II LEEWARD SECTION	
SCALE: 1/2" = 1'-0"	DATE: JANUARY 1997
SHEET NO. 6P14 OF 20 SHEETS	

C.O. 864




ORIGINAL SURVEY PLOTTED BY	DATE
DRAWN BY	
TRACED BY	
DESIGNED BY	
QUANTITIES BY	
CHECKED BY	
No.	

GAD by J. Minura, 55-52

Last Saved: J:\H3RF\RFU2\CO\SIGN\Co-mfl.dwg 06/02/98 at 08:20


GENERAL SIGN NOTES

- FOR DETAILS. MOUNTED ON THE RIGHT POST OF SIGN STRUCTURE
5. SIGN D-1 SHALL BE ~~GROUND MOUNTED. SEE STANDARD PLAN IF 02~~
~~FOR DETAILS.~~ E-63 AT A HEIGHT OF 7'-0" ABOVE PAVEMENT
ELEVATION.
6. SIGNS E-61 AND D-1 SHALL NOT BE ILLUMINATED.

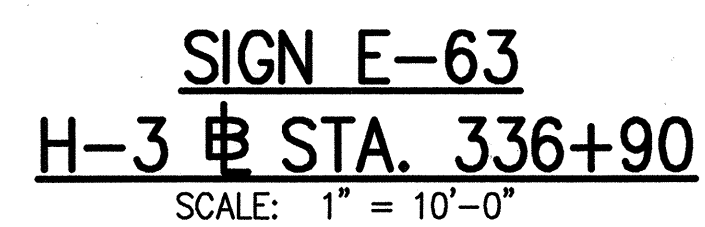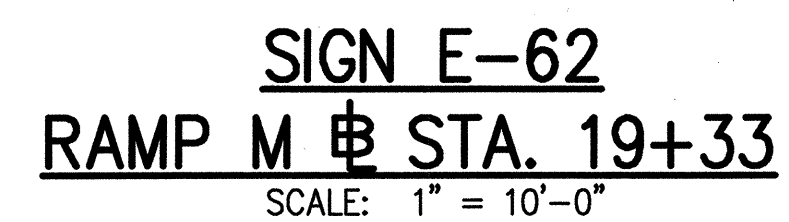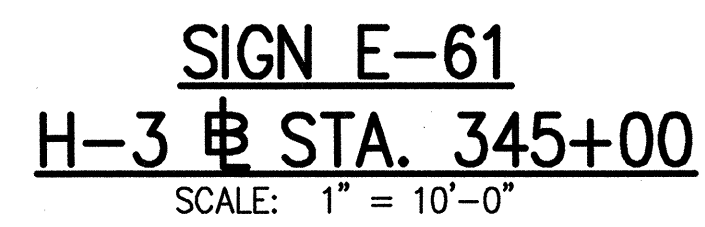


	STATE OF HAWAII DEPARTMENT OF TRANSPORTATION HIGHWAYS DIVISION <u>SIGNING & PAVEMENT MARKINGS</u> <u>SIGN LAYOUTS</u> <u>MAKAI QUARRY VIADUCT</u> H-3 FINISH (UNIT II) FAIP NO. 1-H-3-1(75), UNIT II <u>LEEWARD SECTION</u>
<i>1/1/77</i> <i>Ronald M. Uemura</i> This work was prepared by me or under my supervision.	SCALE: AS NOTED DATE: JAN. 1997 SHEET NO. 6P15 OF 20 SHEETS


FED. ROAD DIST. NO.	STATE	FED. AID PROJ. NO.	FISCAL YEAR	SHEET NO.	TOTAL SHEETS
HAWAII	HAW.	I-H3-1(75), UNIT II	1997	866	1102

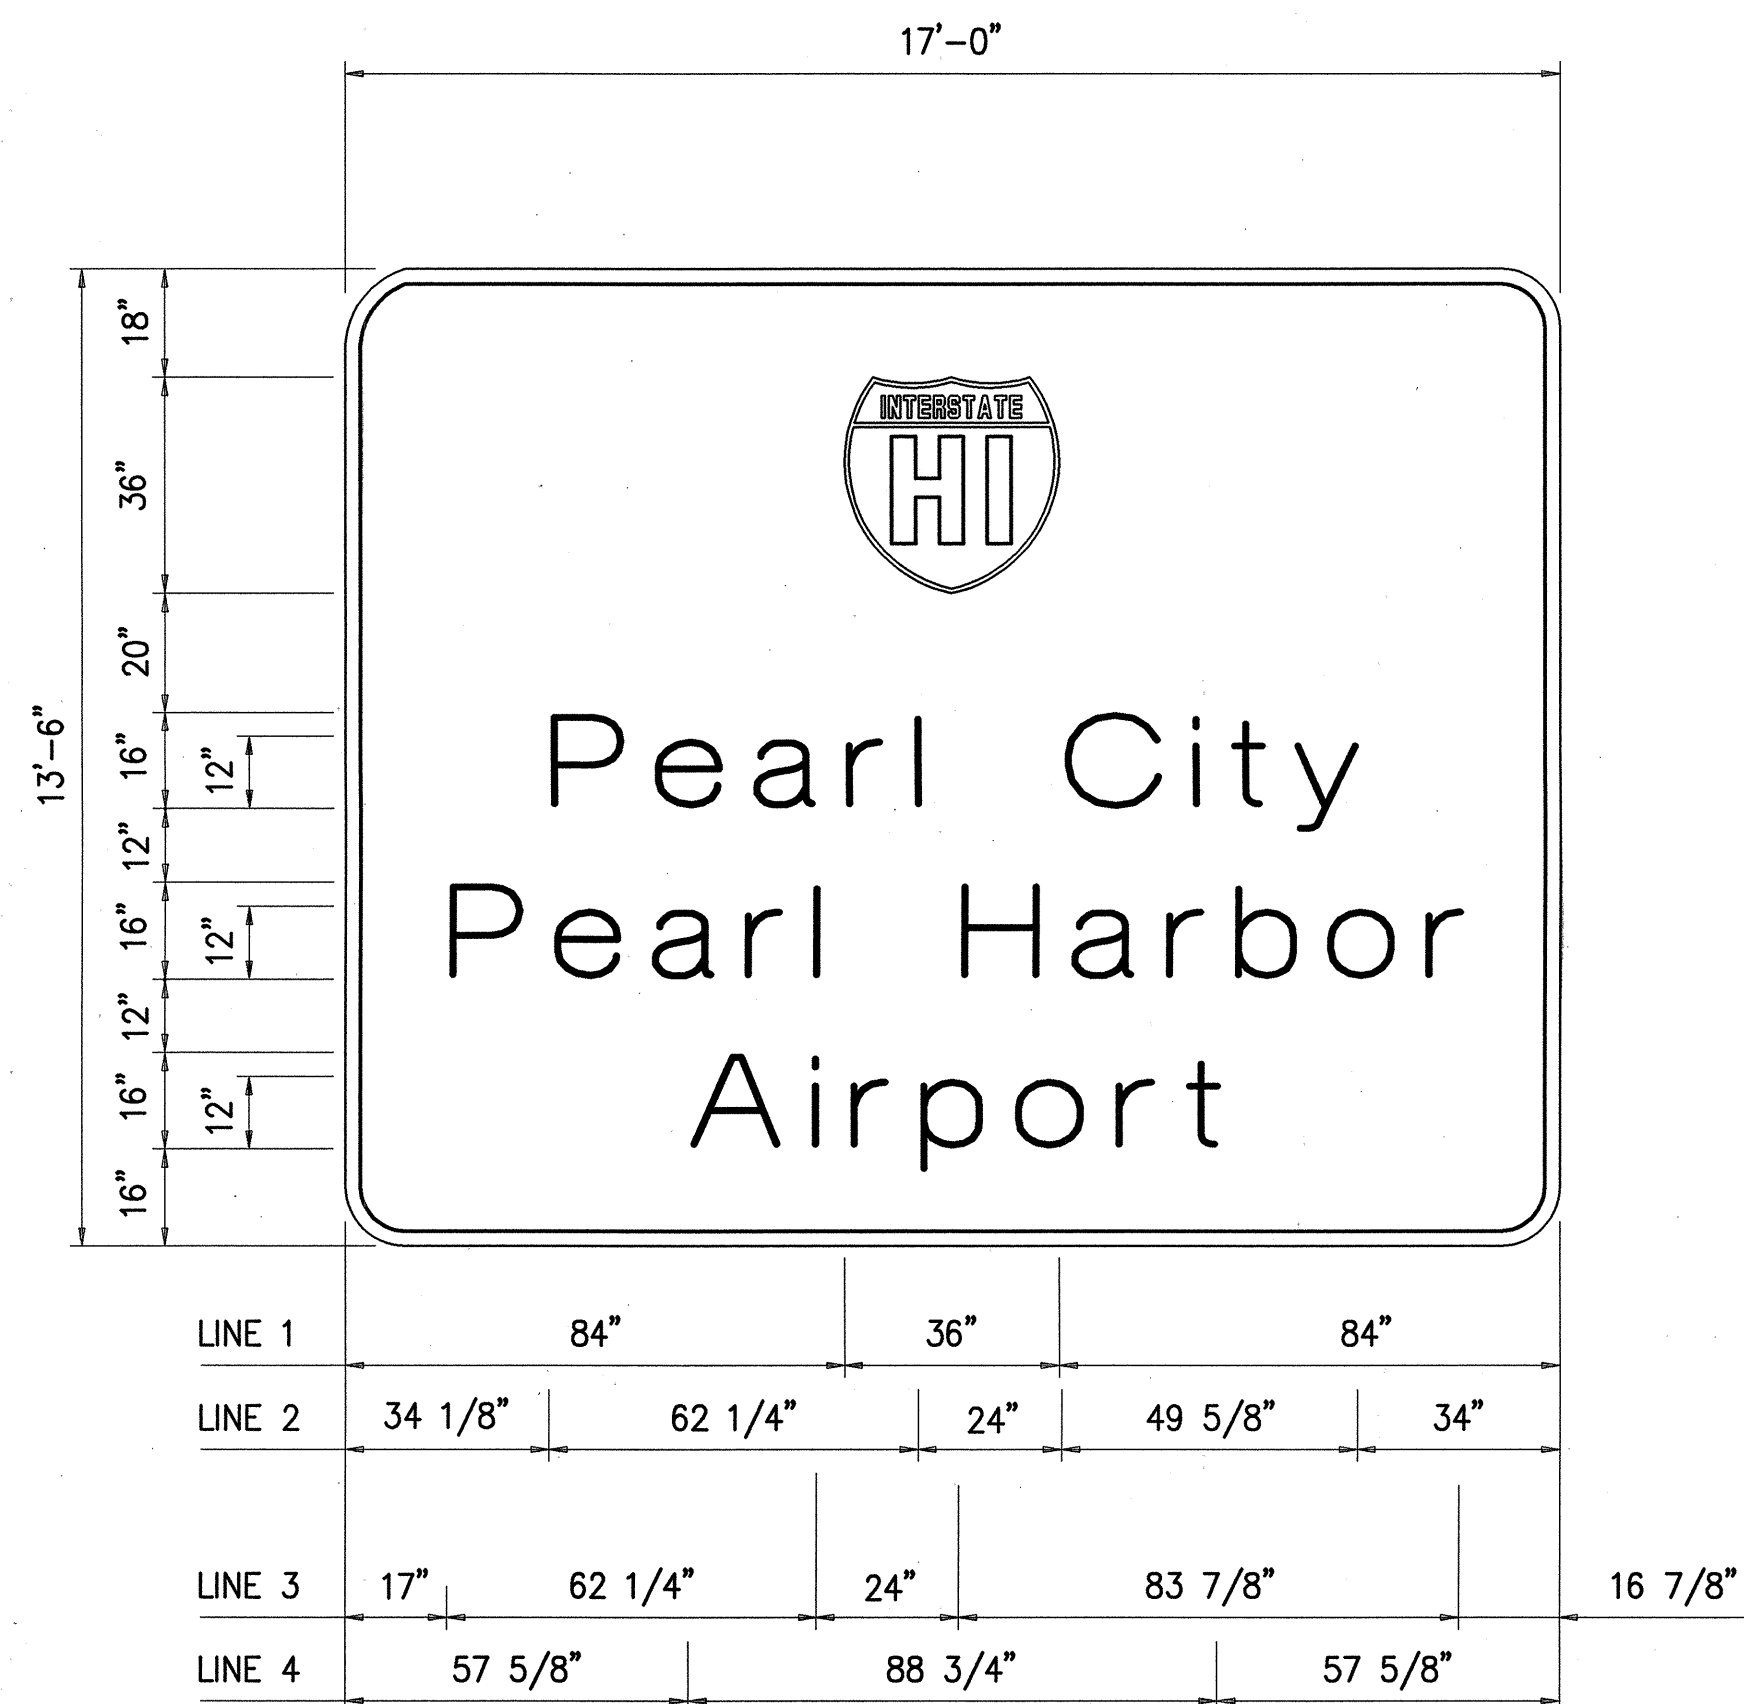


SIGN E-60L
SCALE: 3/8" = 1'-0"

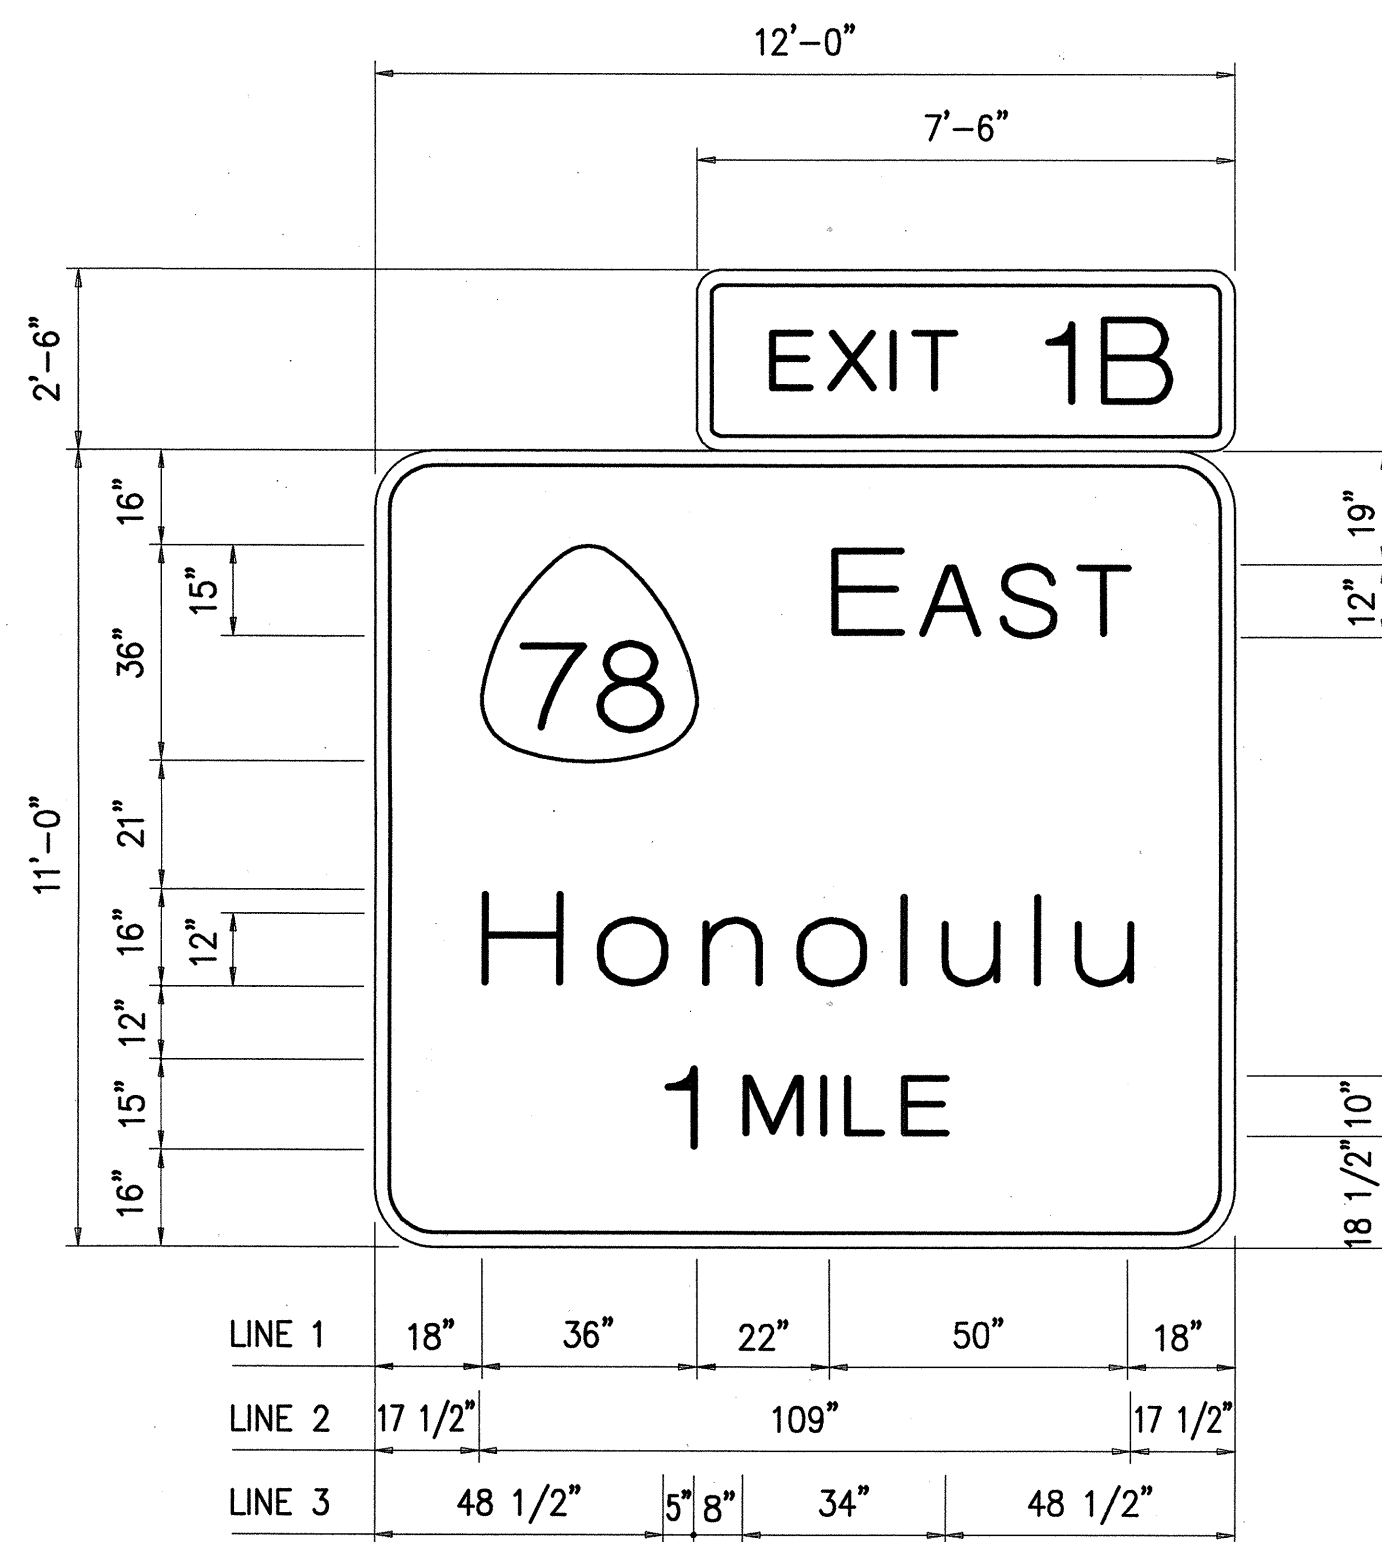


SIGN E-60C
SCALE: 3/8" = 1'-0"

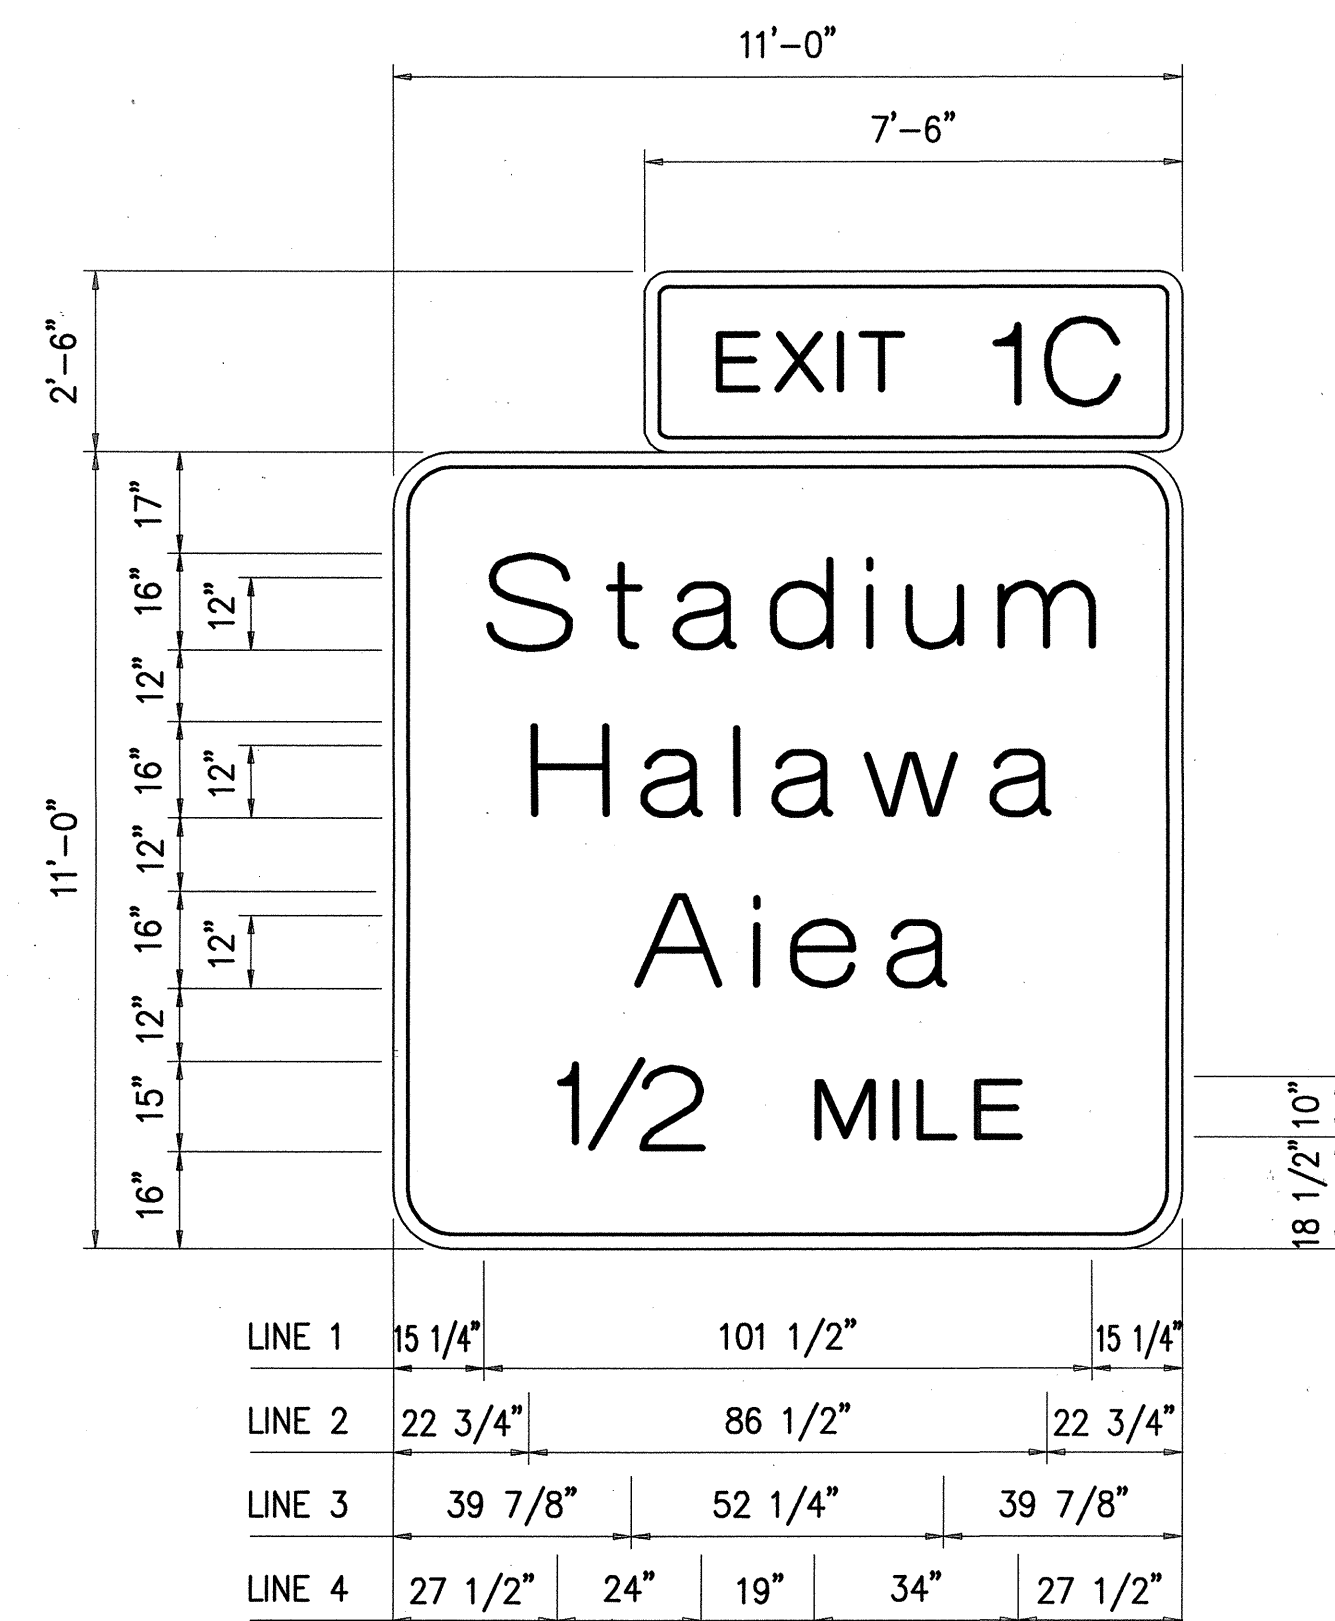


SIGN E-60R
SCALE: 3/8" = 1'-0"

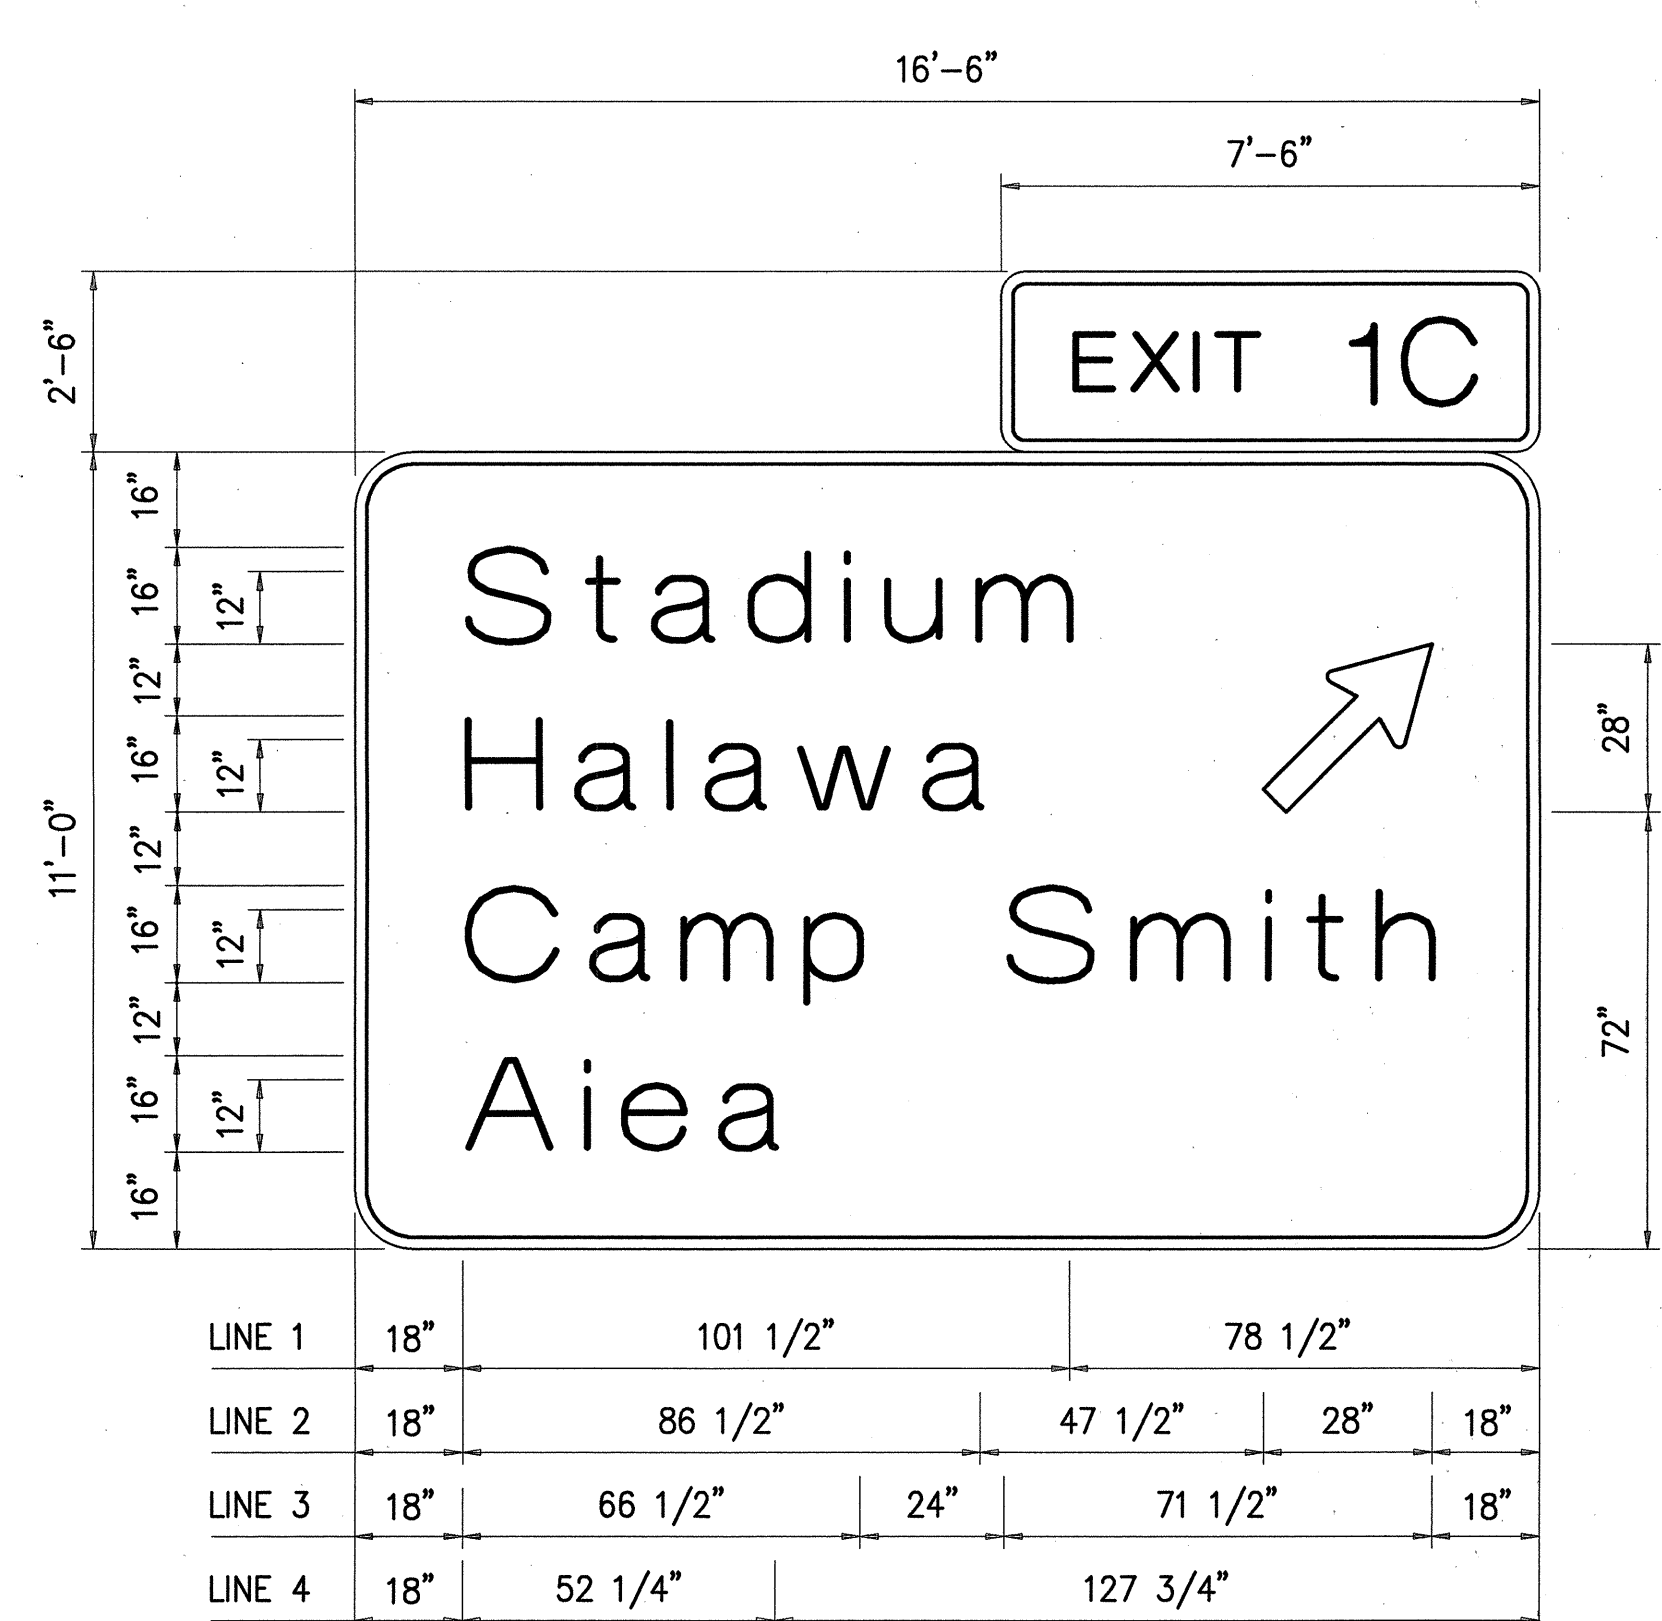

SIGN E-61
SCALE: 3/8" = 1'-0"

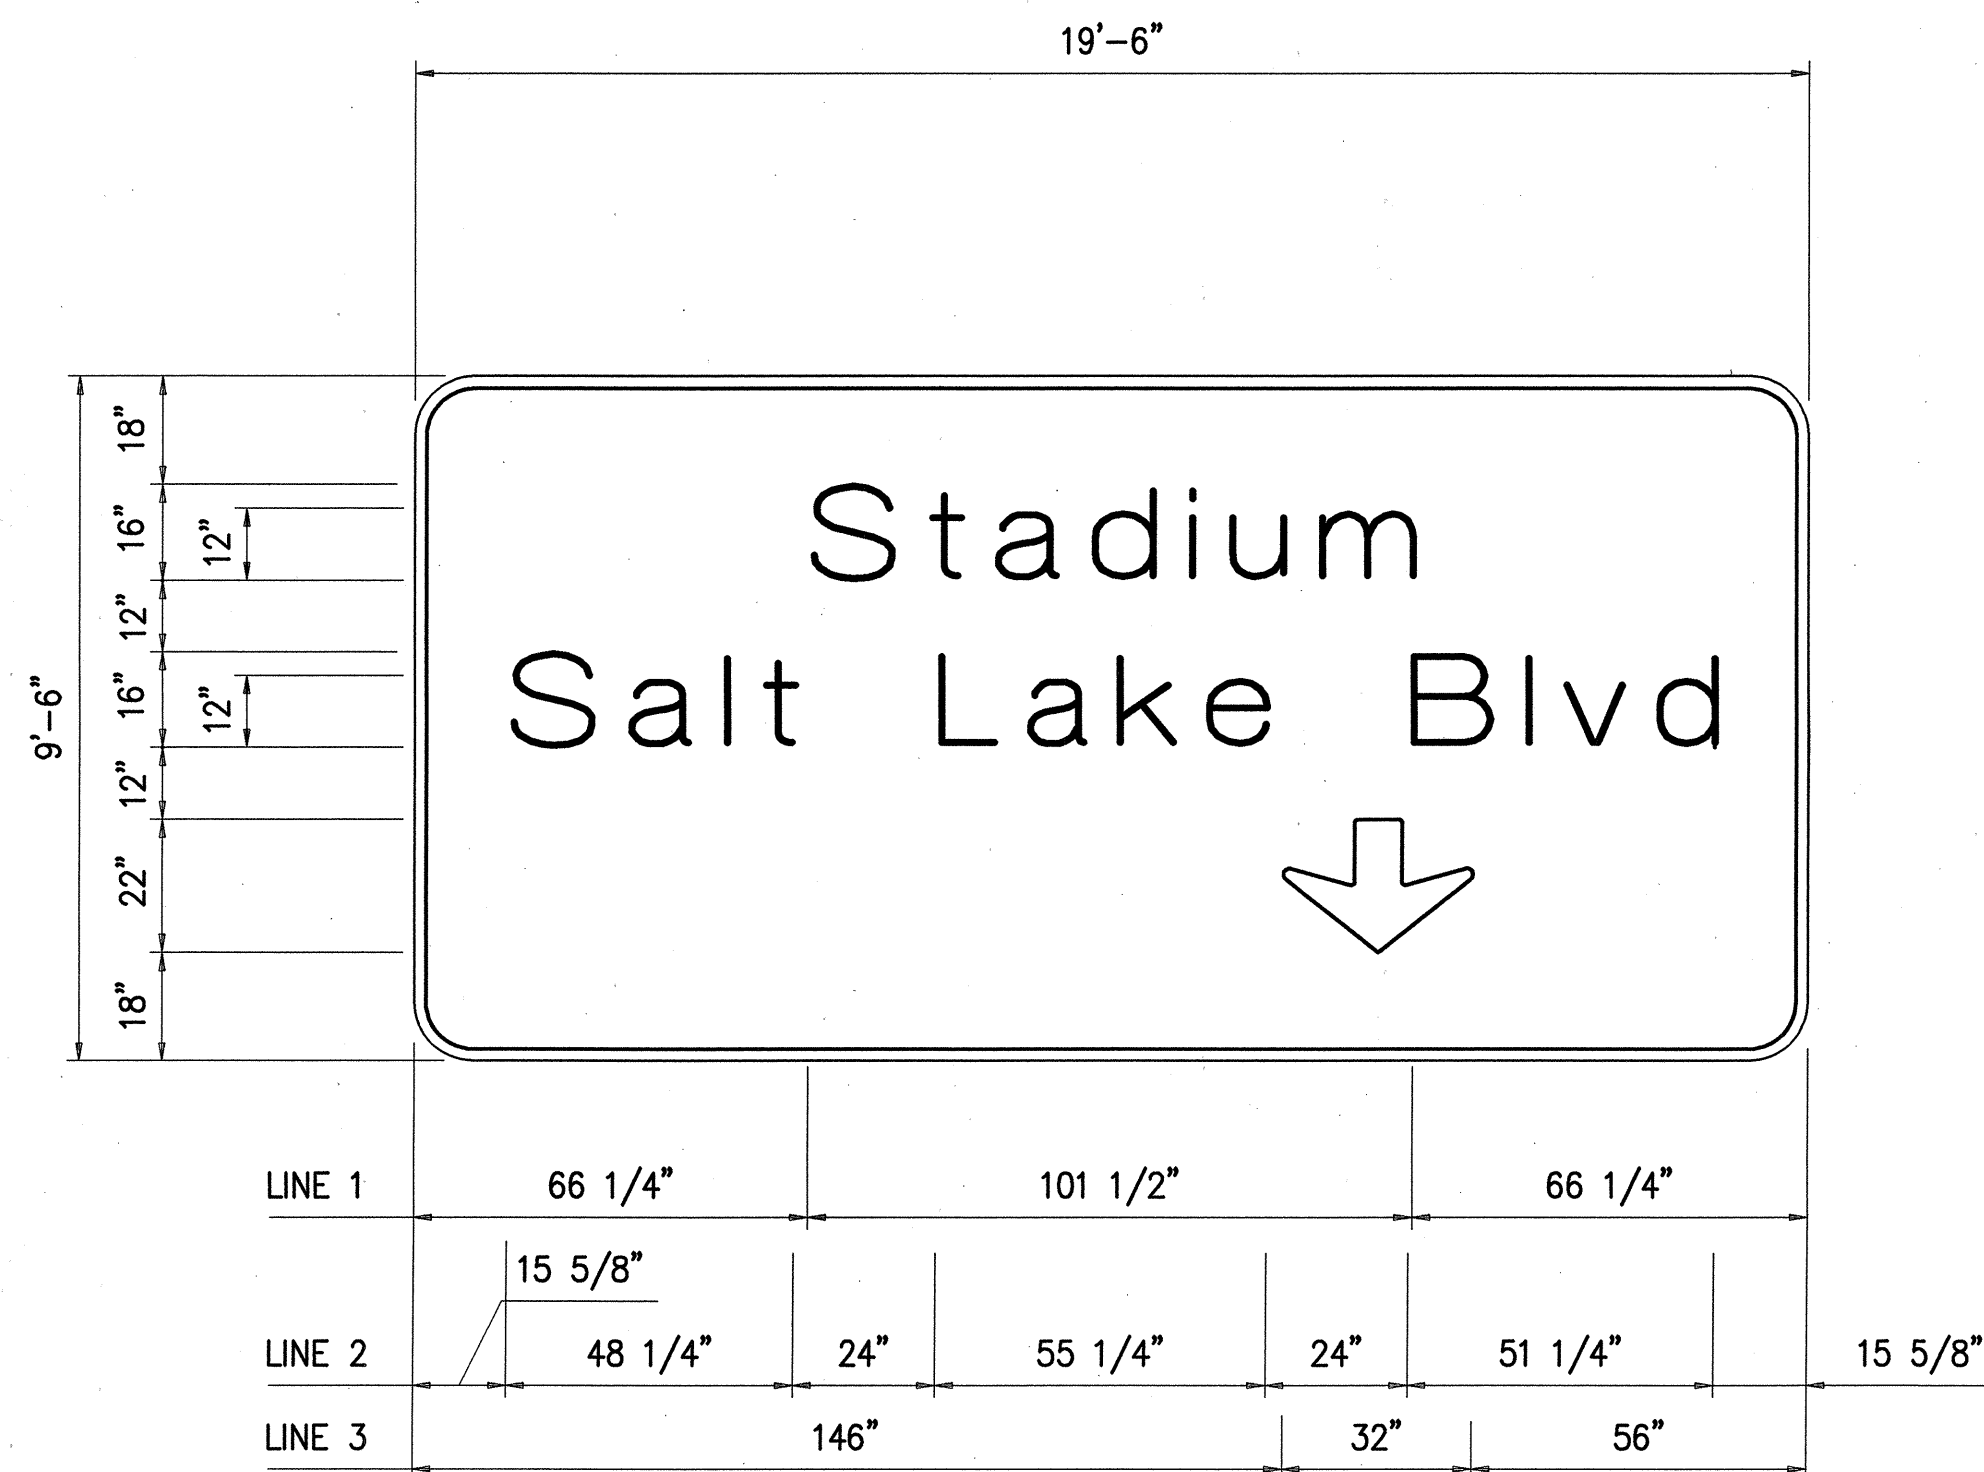


SIGN E-62L
SCALE: 3/8" = 1'-0"

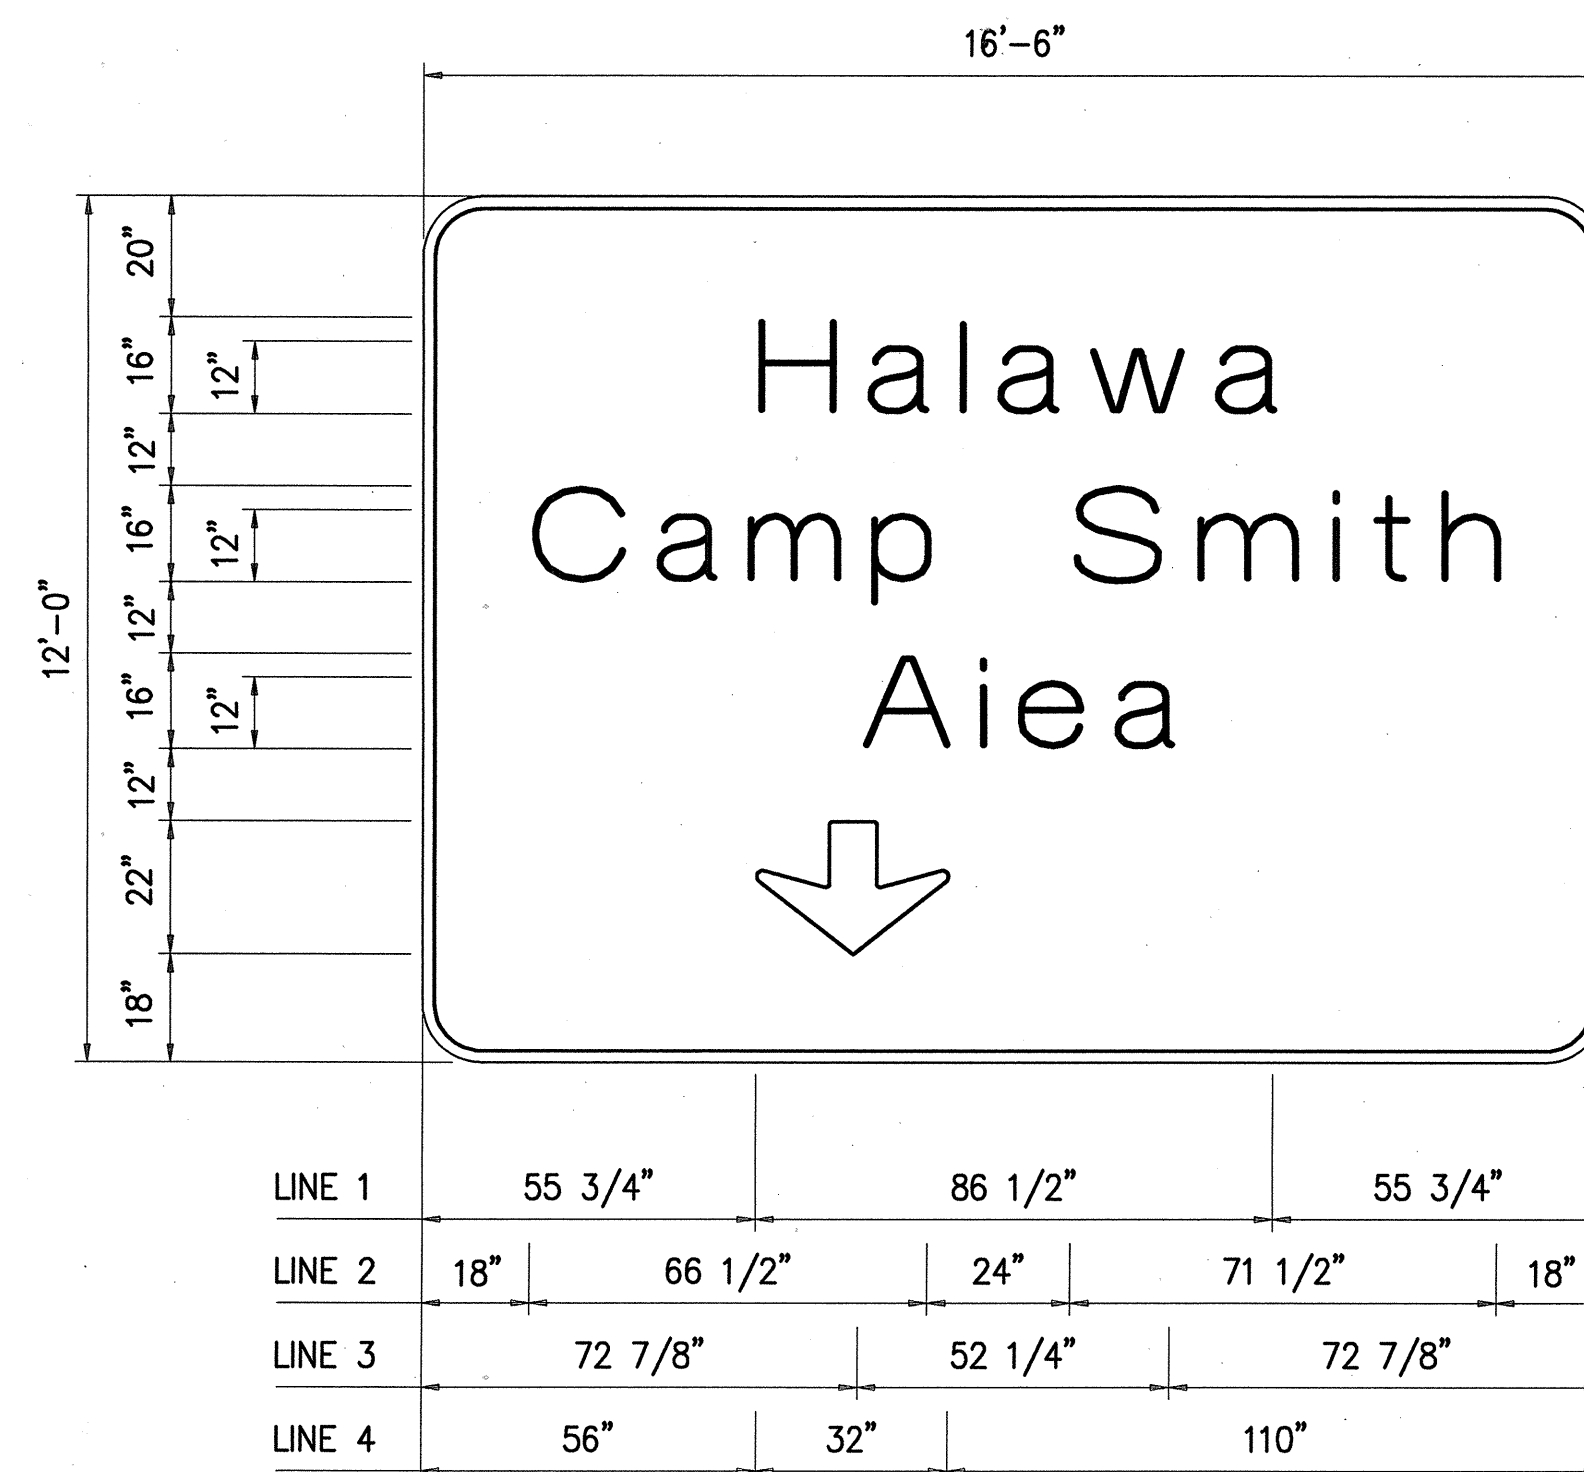

SIGN E-62R
SCALE: 3/8" = 1'-0"


ORIGINAL PLAN	SURVEY PLOTTED BY	DATE
NOTE BOOK	DRAWN BY	
QUANTITIES BY	DESIGNED BY	
CHECKED BY		

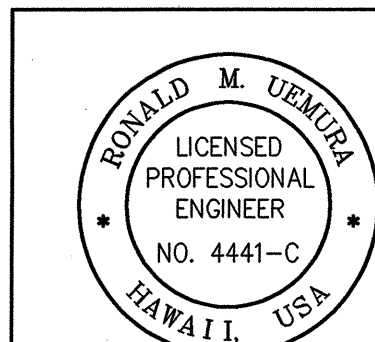


This work was prepared by me or under my supervision.

STATE OF HAWAII DEPARTMENT OF TRANSPORTATION HIGHWAYS DIVISION SIGNING & PAVEMENT MARKINGS SIGN DETAILS MAKAI QUARRY VIADUCT H-3 FINISH (UNIT II) FAIP NO. I-H3-1(75), UNIT II LEEWARD SECTION SCALE: AS NOTED DATE: JAN. 1997 SHEET No. 6PI6 OF 20 SHEETS
--



FED. ROAD DIST. NO.	STATE	FED. AID PROJ. NO.	FISCAL YEAR	SHEET NO.	TOTAL SHEETS
HAWAII	HAW.	I-H3-1(75), UNIT II	1997	867	1102

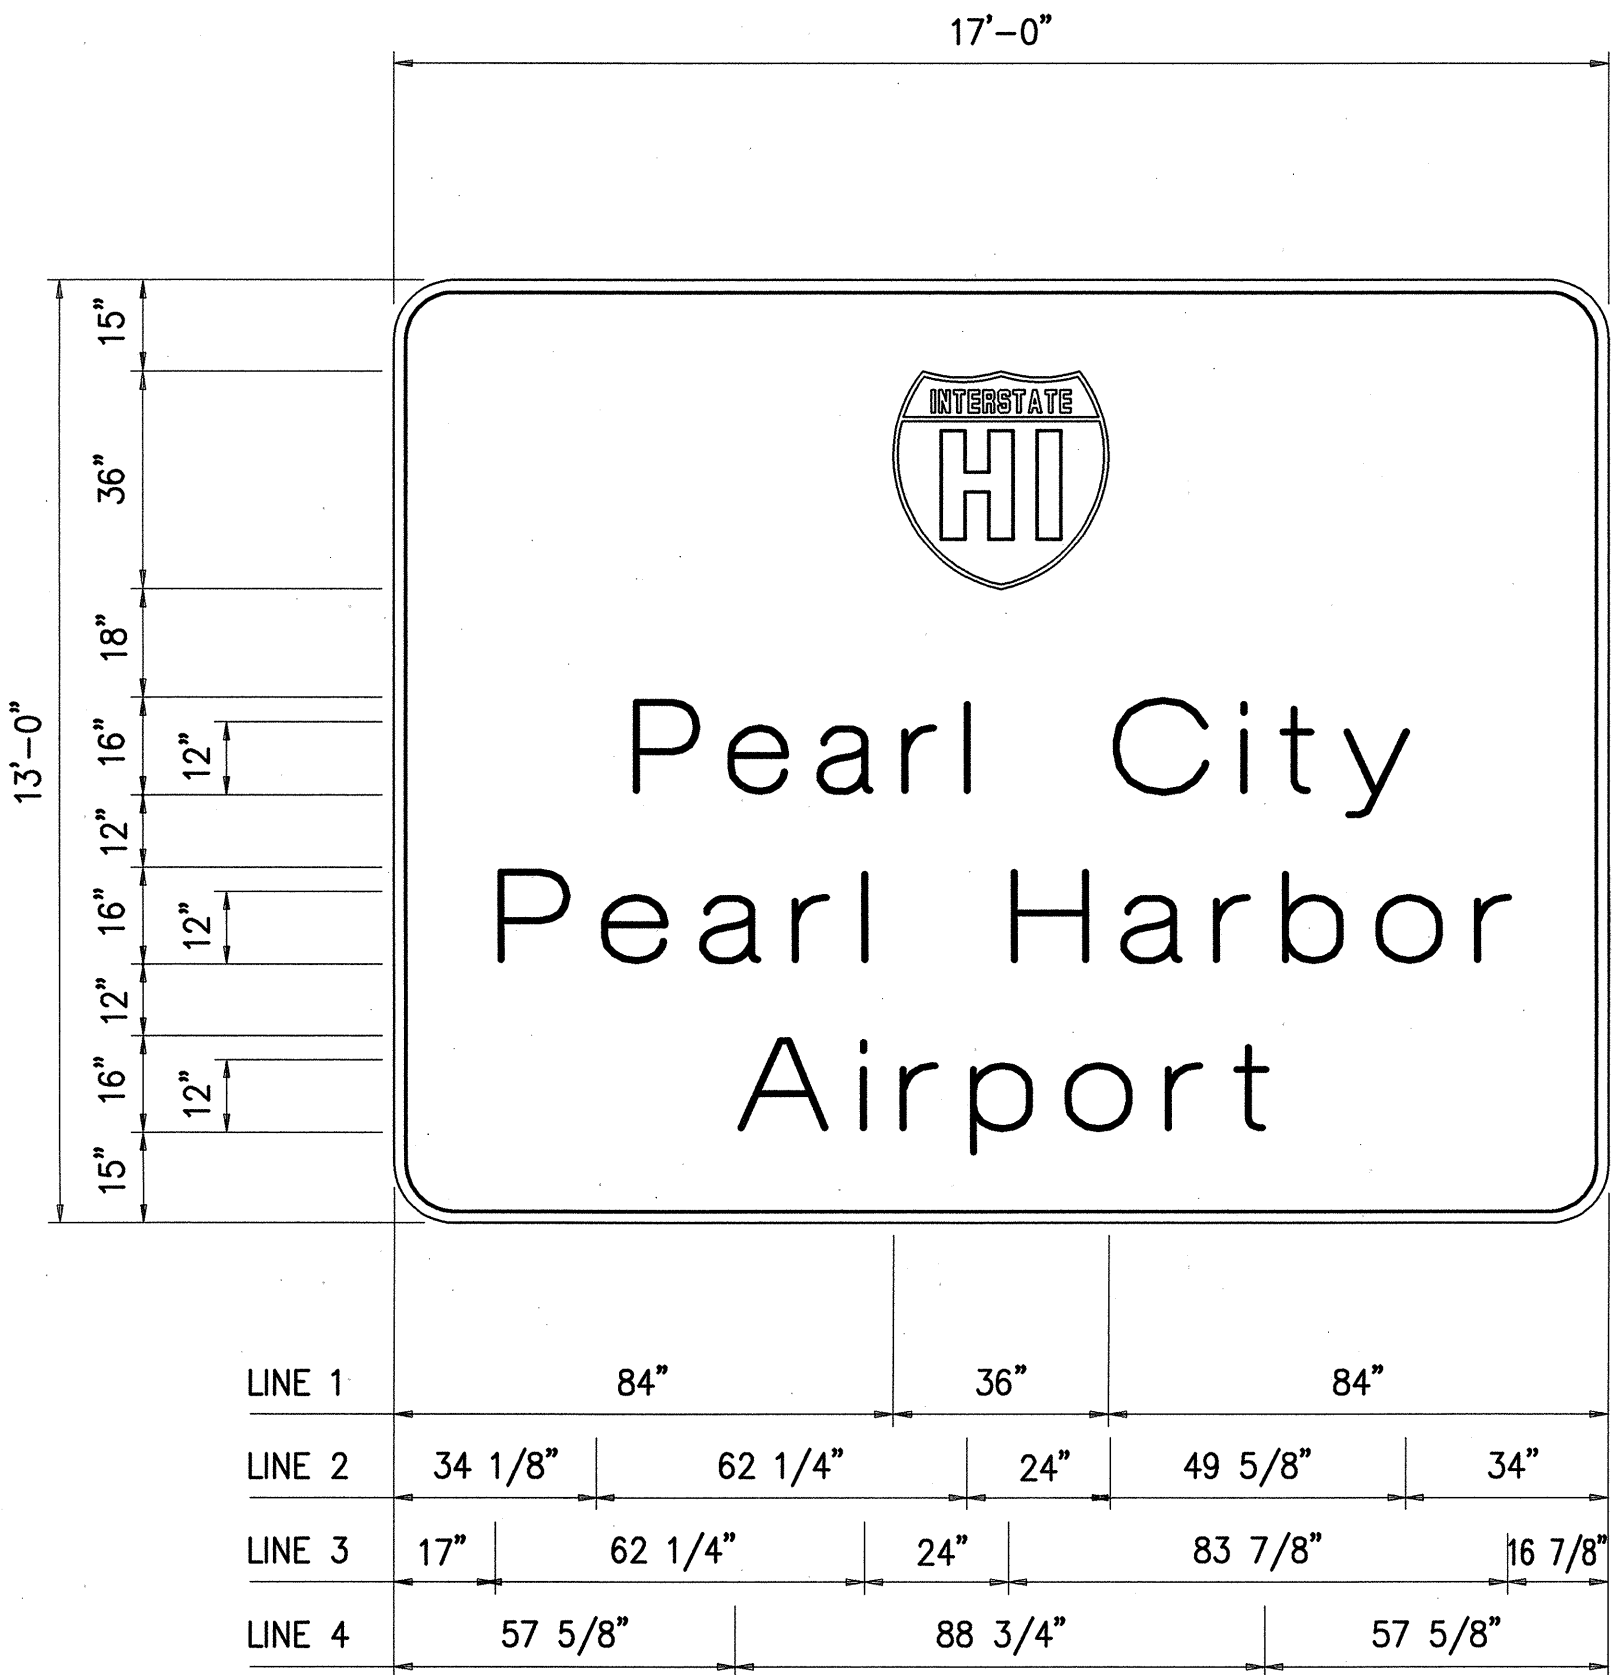


SIGN E-63L
SCALE: 3/8" = 1'-0"

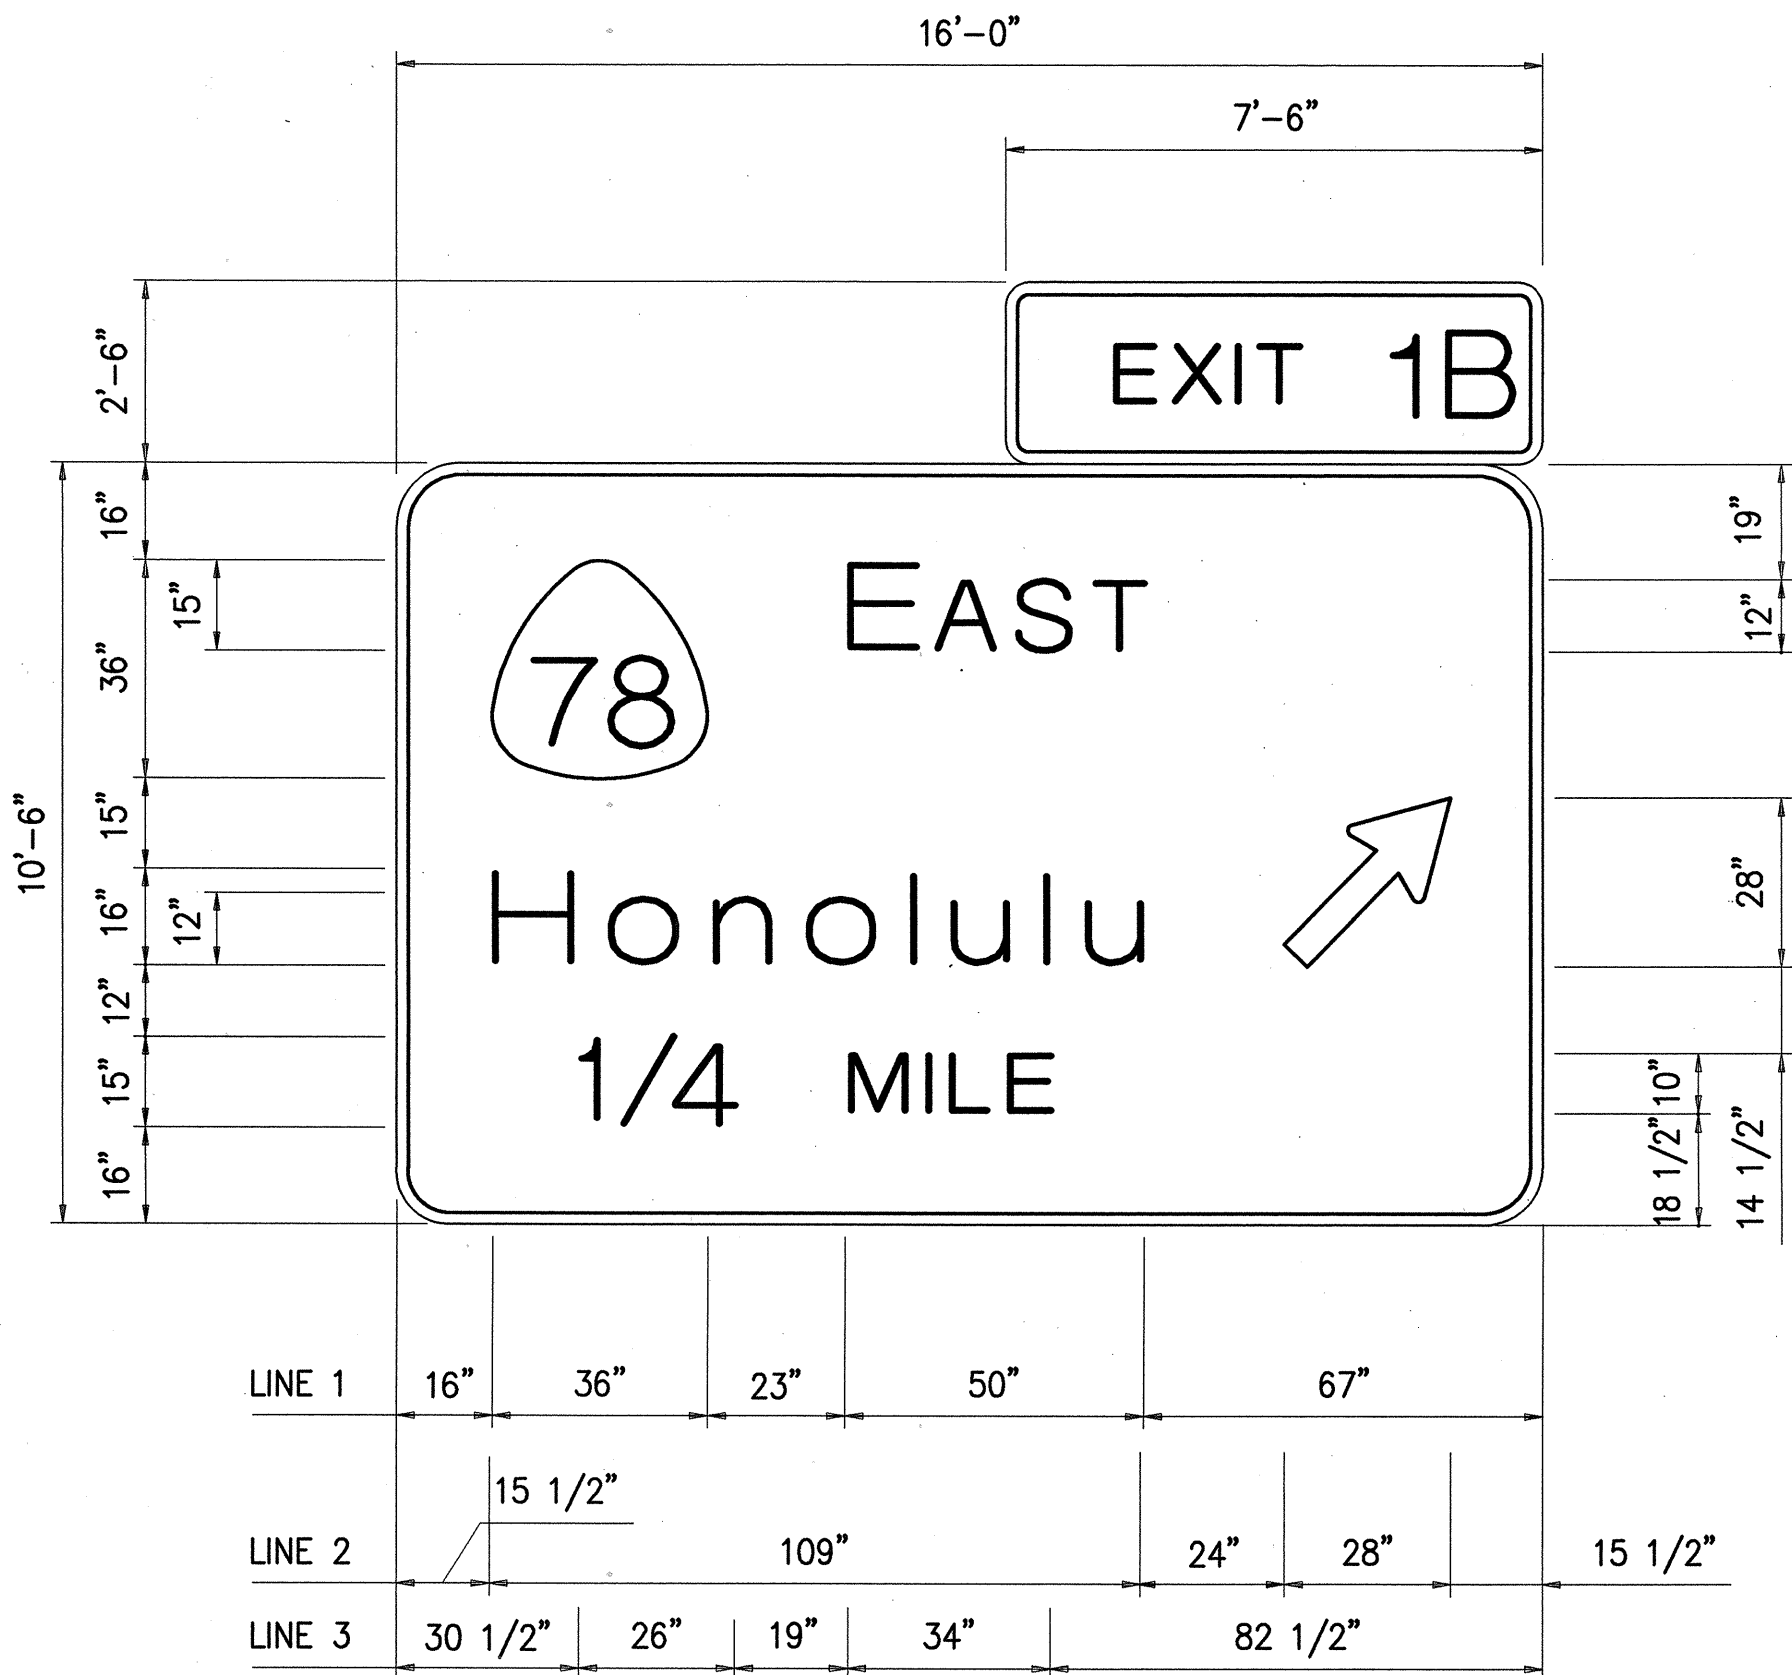

SIGN E-63R
SCALE: 3/8" = 1'-0"

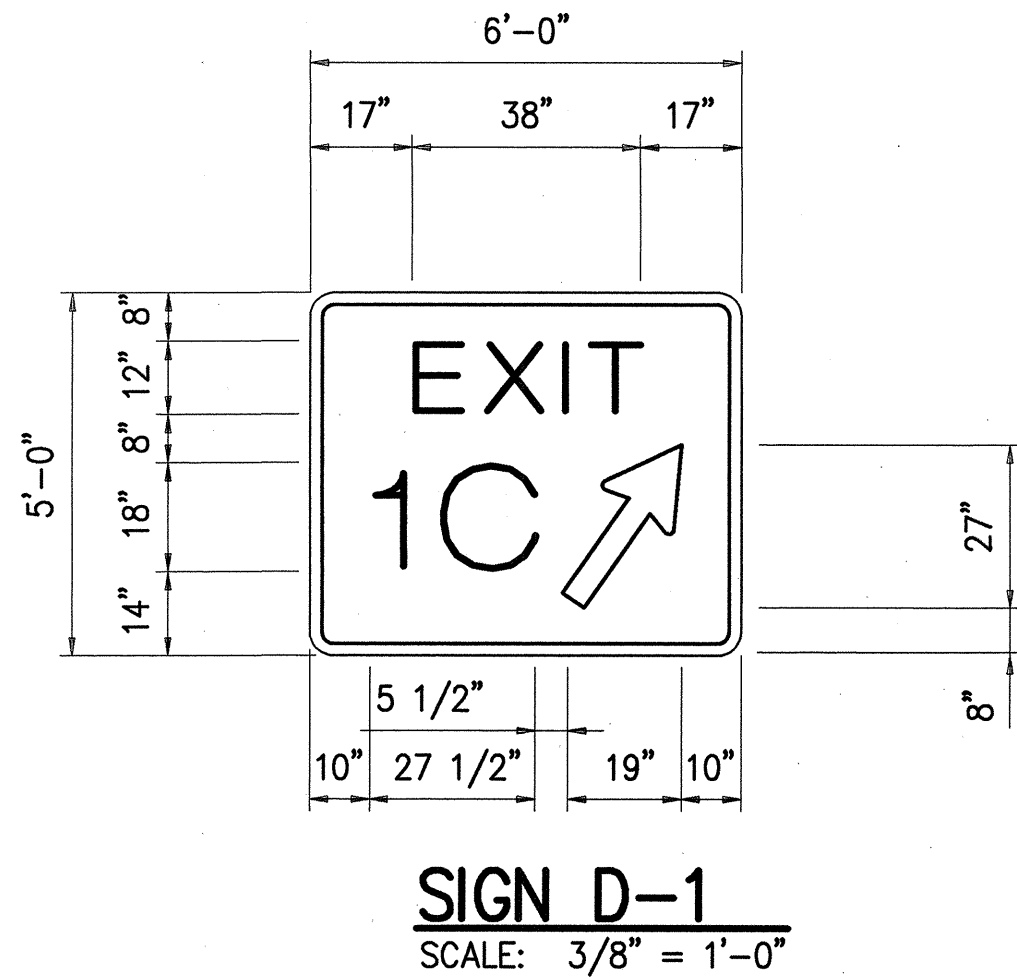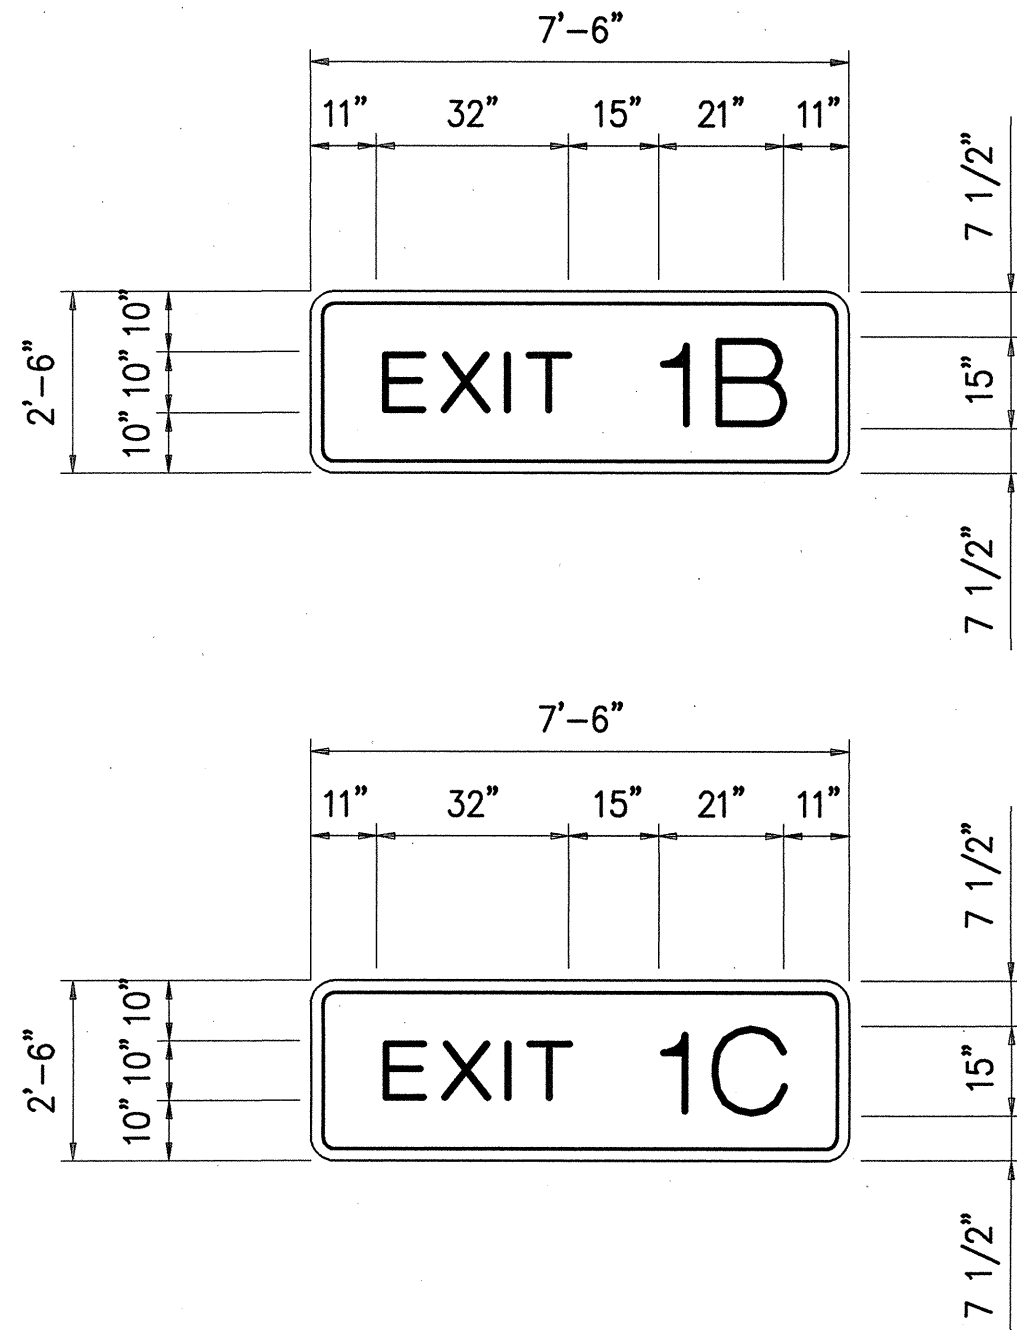

SIGN D-1
SCALE: 3/8" = 1'-0"

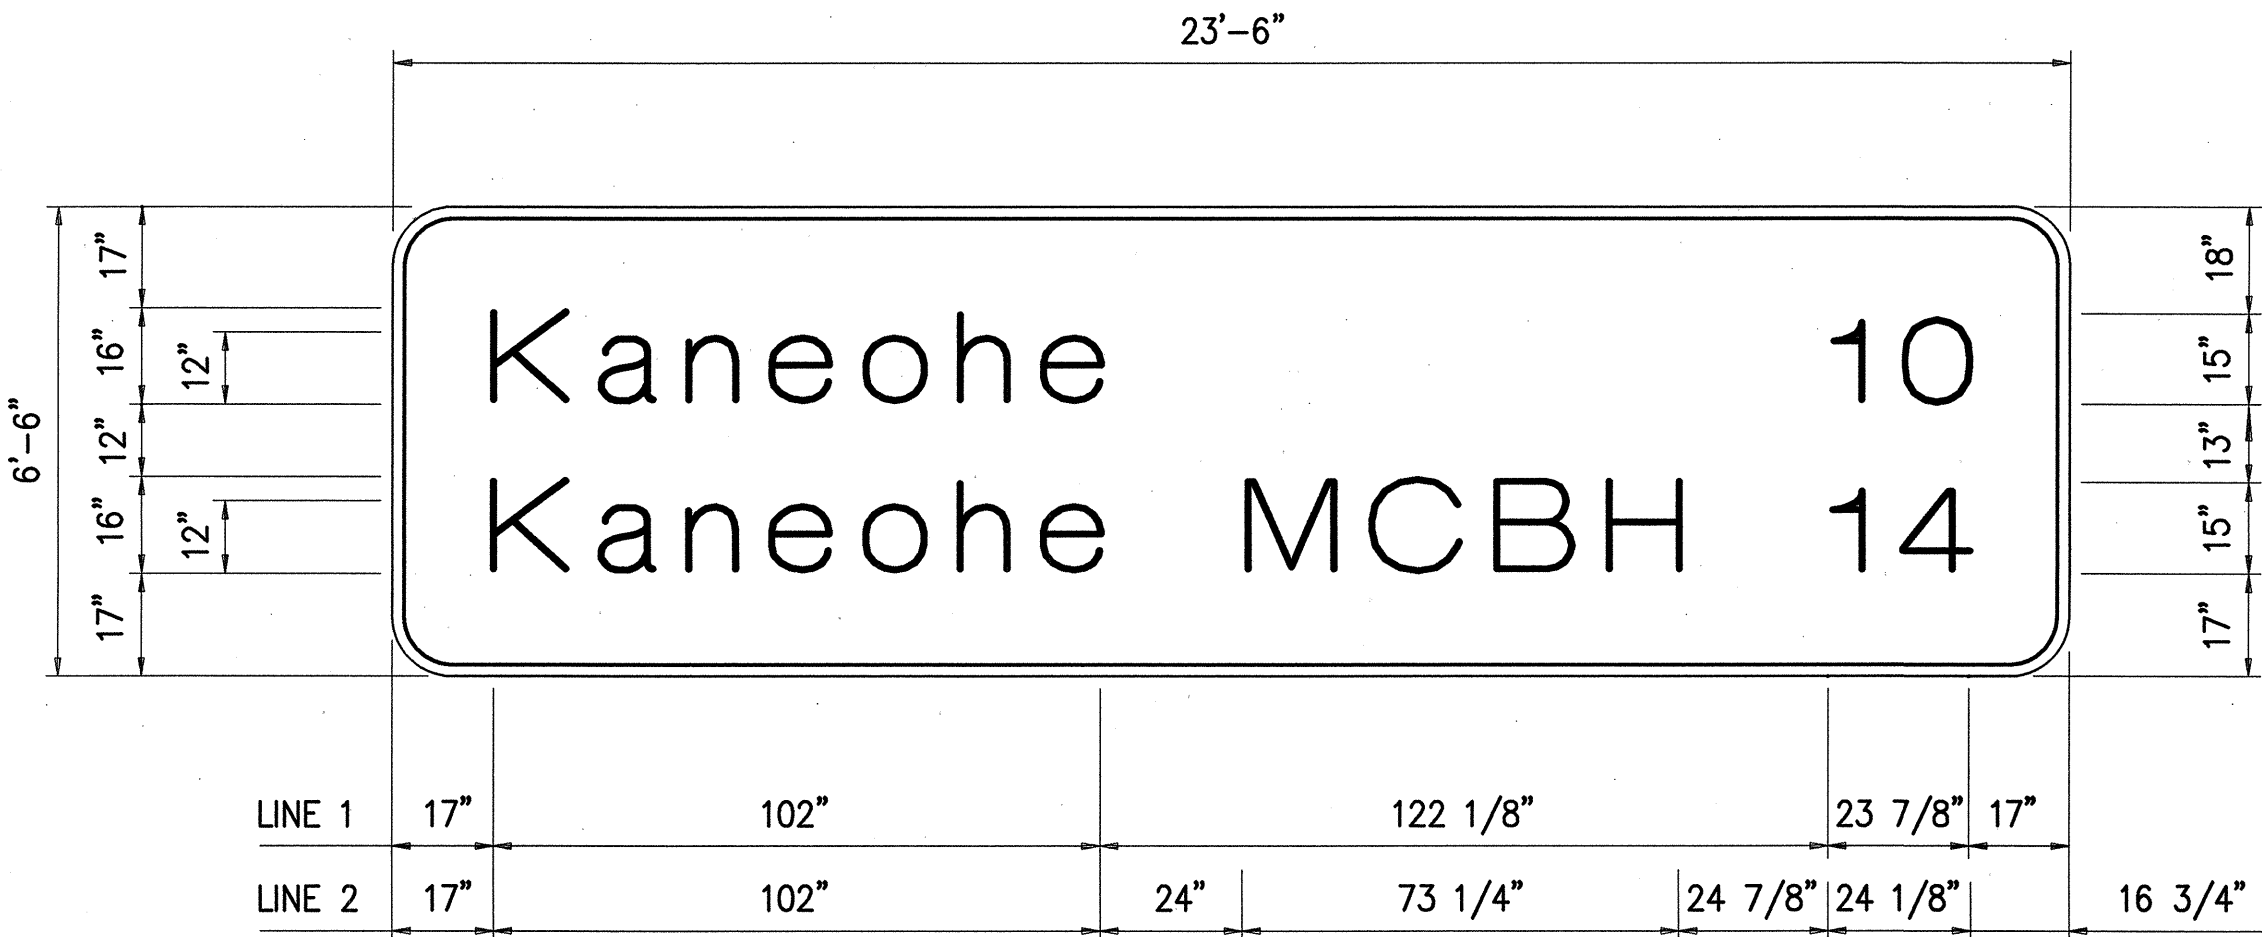


SIGN E-64
SCALE: 3/8" = 1'-0"

SURVEY PLOTTED BY	DATE
DESIGNED BY	
TRACED BY	
NOTE BOOK	
QUANTITIES BY	
CHECKED BY	
No.	


STATE OF HAWAII
DEPARTMENT OF TRANSPORTATION
HIGHWAYS DIVISION
SIGNING & PAVEMENT MARKINGS
SIGN DETAILS
MAKAI QUARRY VIADUCT
H-3 FINISH (UNIT II)
FAIP NO. I-H3-1(75), UNIT II
LEEWARD SECTION
SCALE: AS NOTED DATE: JAN. 1997
SHEET No. 6PI7 OF 20 SHEETS

FED. ROAD DIST. NO.	STATE	FED. AID PROJ. NO.	FISCAL YEAR	SHEET NO.	TOTAL SHEETS
HAWAII	HAW.	I-H3-1(75), UNIT II	1997	868	1102

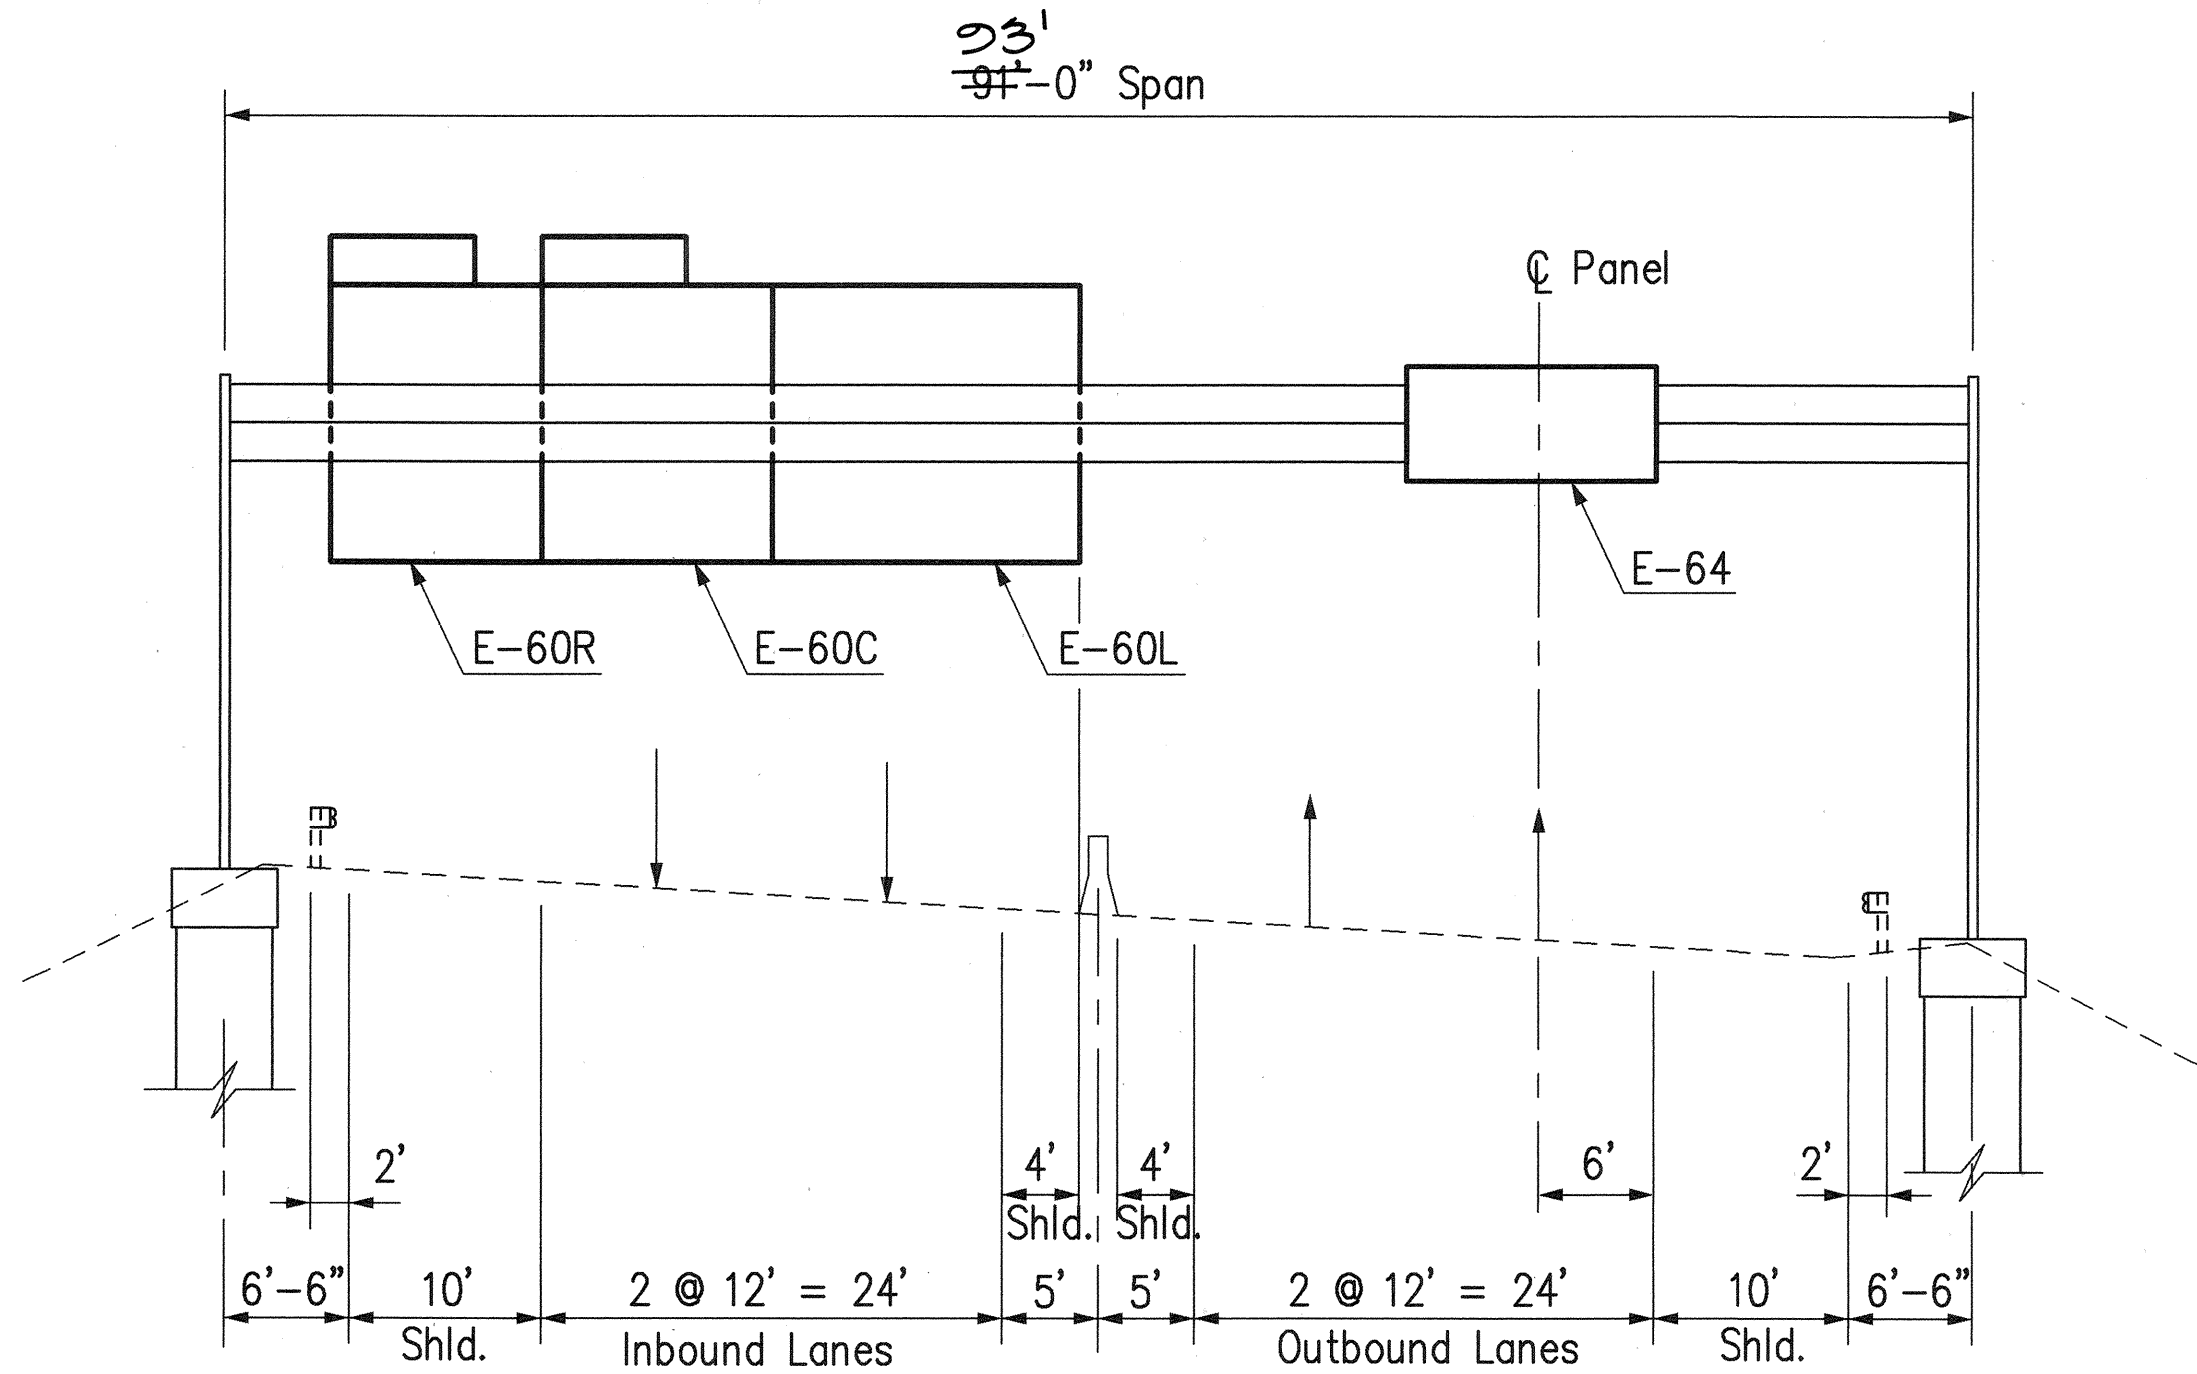


NOTE:
Signs E-60R, E-60C, & E-60L
install in direction of traffic.
See Structural Plans.


SIGN LAYOUT E-60L, E-60C, E-60R & E-64
Interstate Route H-3 @ Sta. 374+75

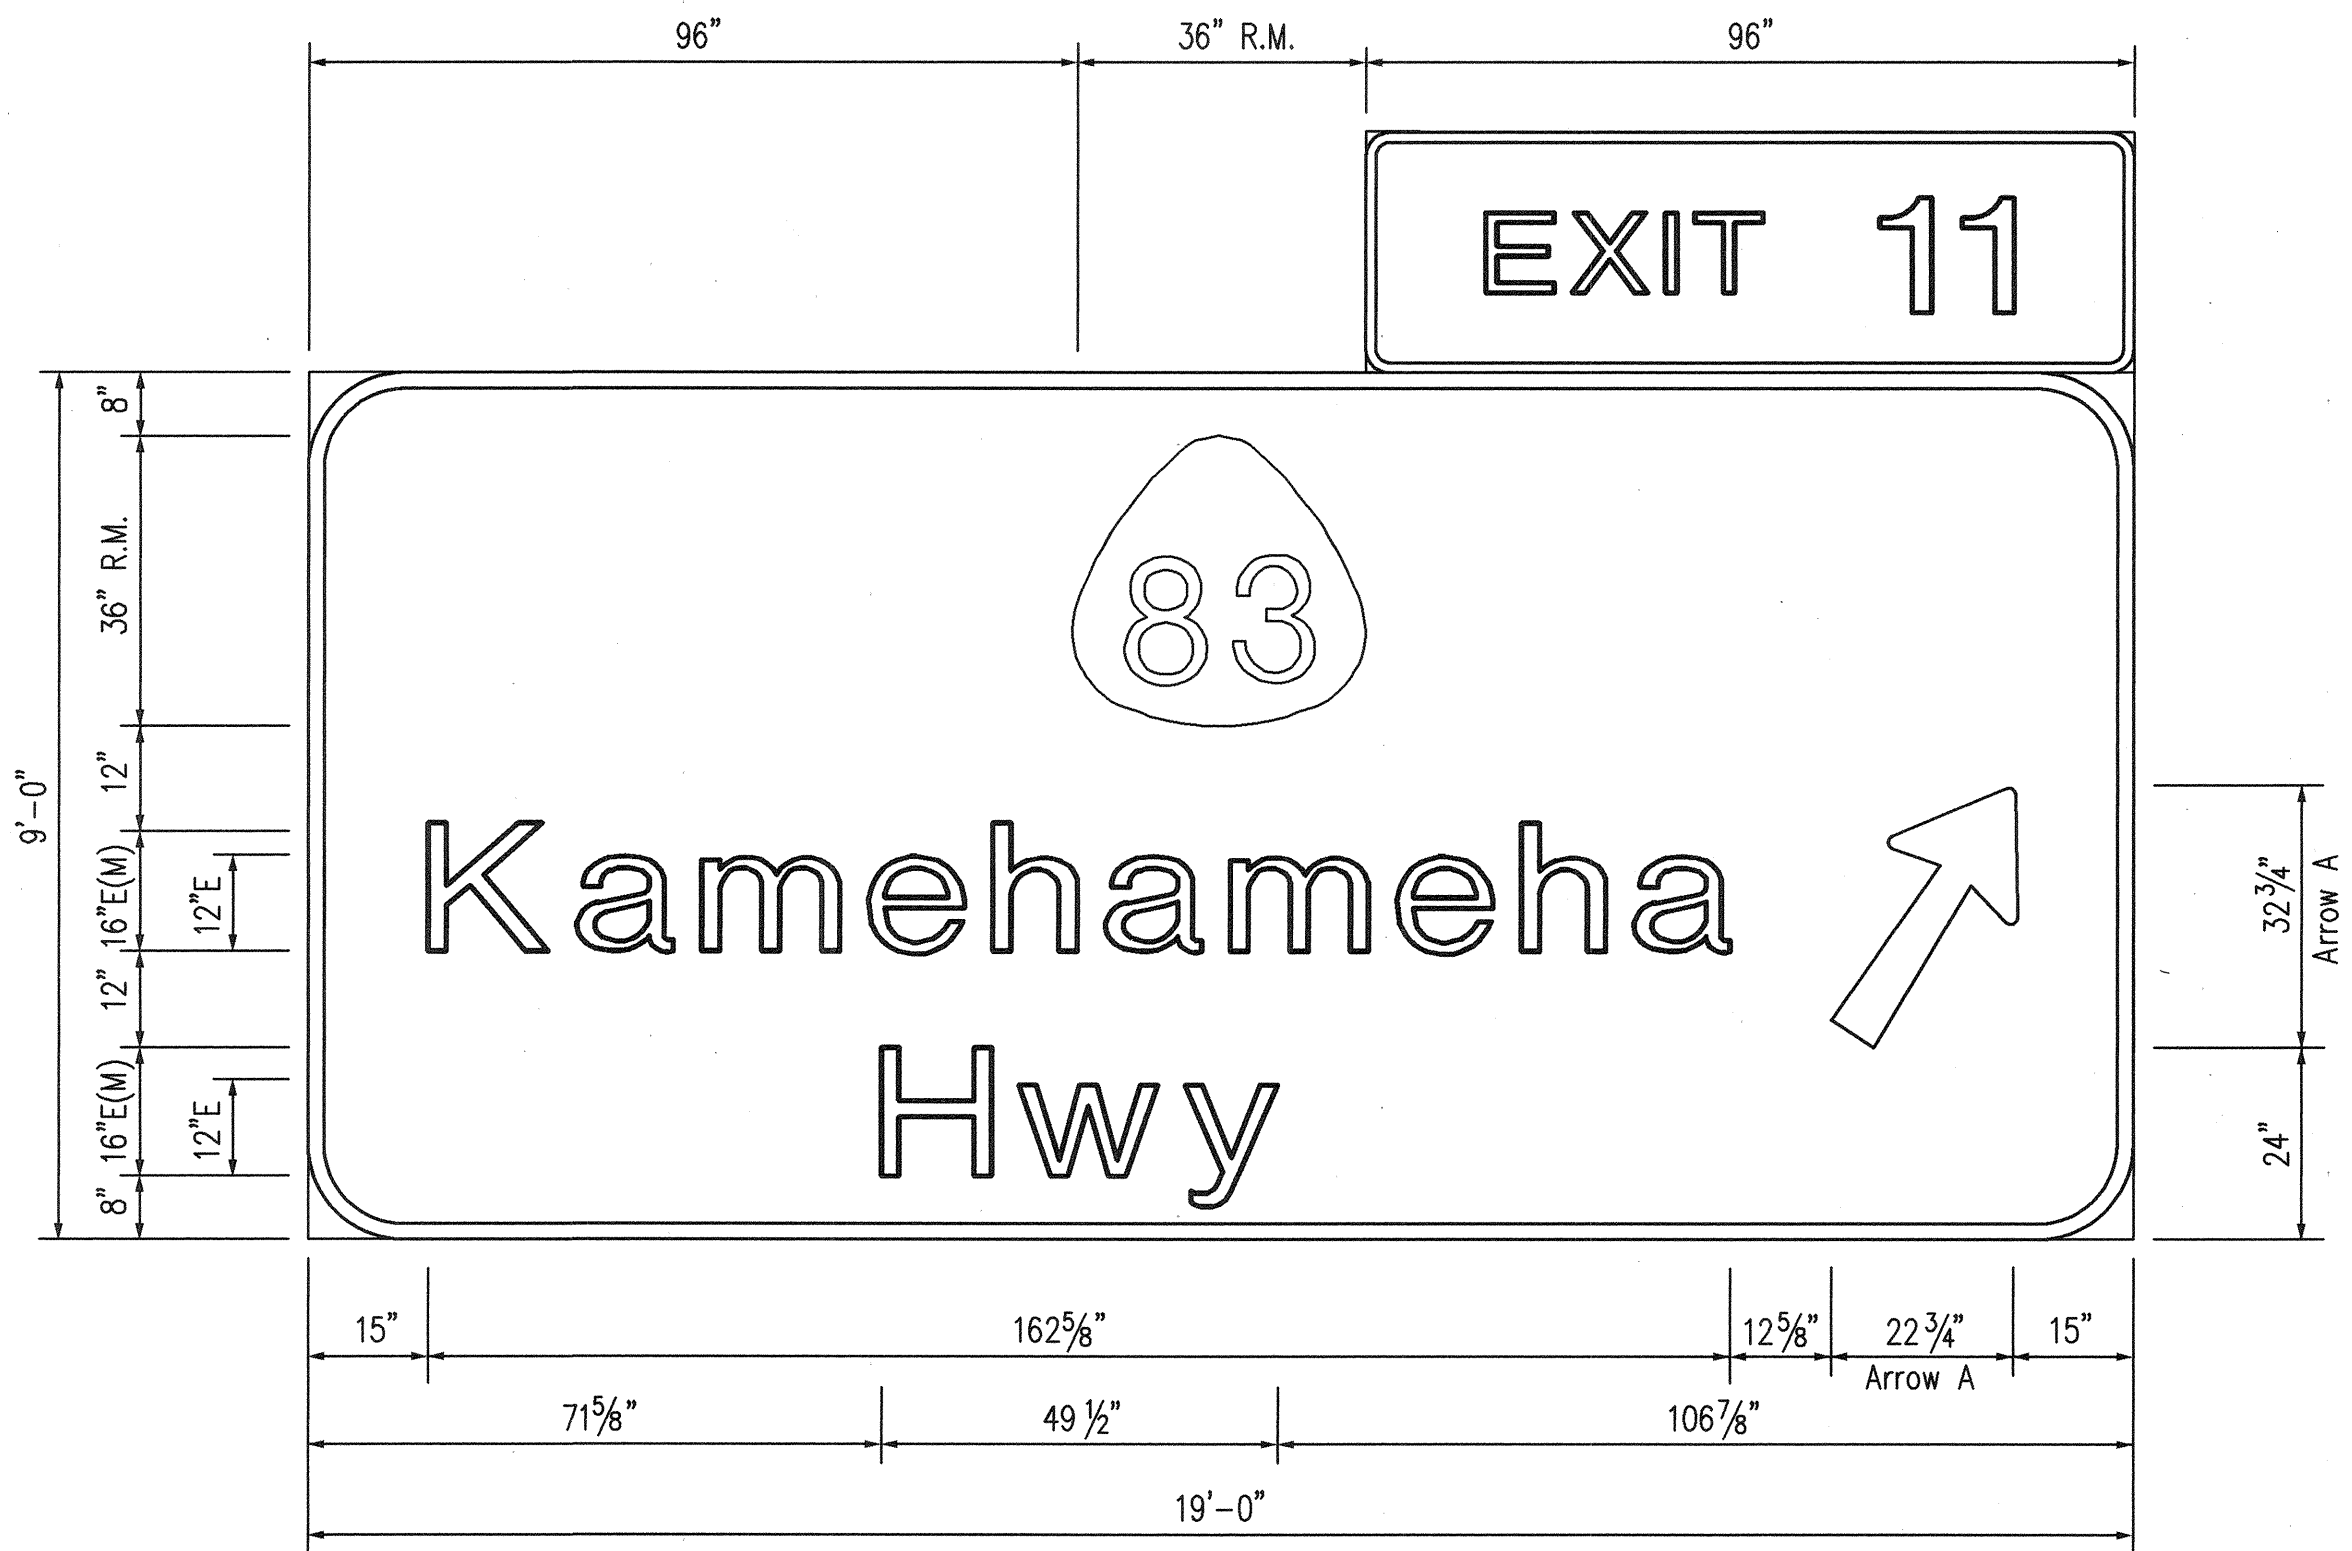

E-76R

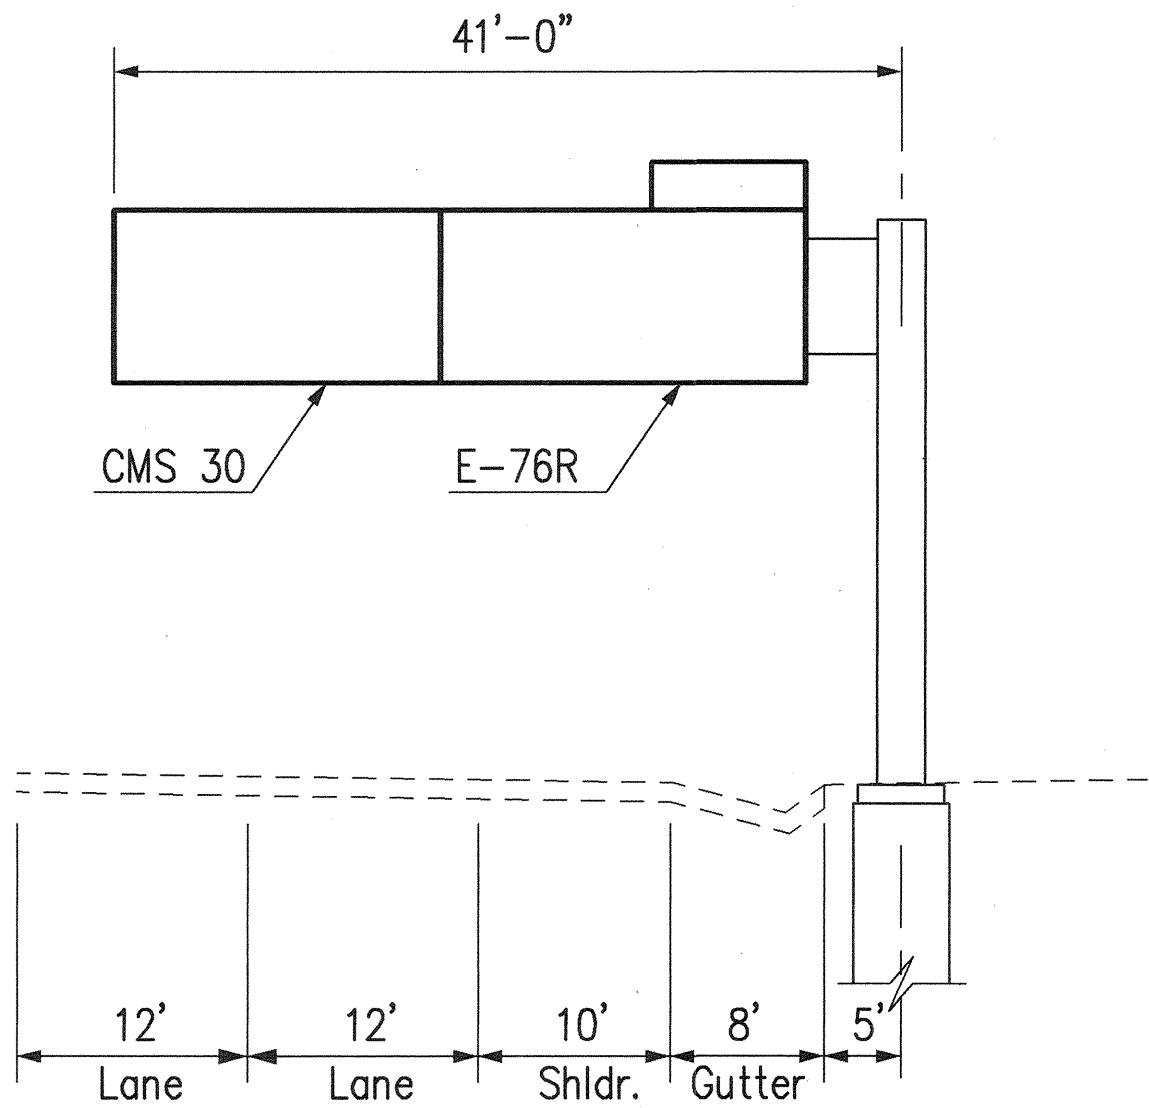

SIGN LAYOUT CMS30 & E-76R
Interstate Route H-3 Inbound Sta. 522+55

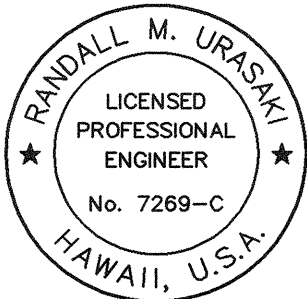

THIS WORK WAS PREPARED BY ME
OR UNDER MY SUPERVISION.
Randall M. Urasaki

STATE OF HAWAII
DEPARTMENT OF TRANSPORTATION
HIGHWAYS DIVISION













DESTINATION SIGNS
SIGN LAYOUTS & DETAILS
QUARRY VIA. & HALEKOU I/C
H-3 FINISH (UNIT II)
FAIP NO. I-H3-1(75), UNIT II
LEEWARD SECTION

SCALE: 1" = 10'
DATE: JANUARY 1997
SHEET NO. 6P18 OF 20 SHEETS

ORIGINAL SURVEY PLOTTED BY	DATE
PLAN	
TRACED BY	
NOTE BOOK	
QUANTITIES BY	
CHECKED BY	
No.	


CAD by J. MIMURA 55-52

FED. ROAD DIST. NO.	STATE	FED. AID PROJ. NO.	FISCAL YEAR	SHEET NO.	TOTAL SHEETS
HAWAII	HAW.	I-H3-1(75), UNIT II	1997	869	1102

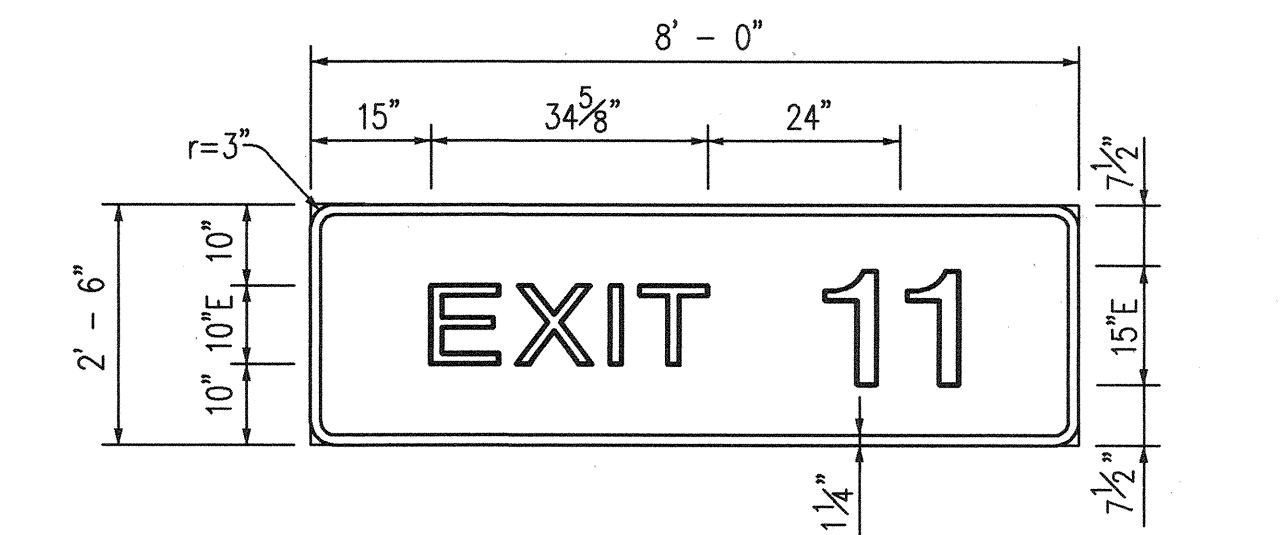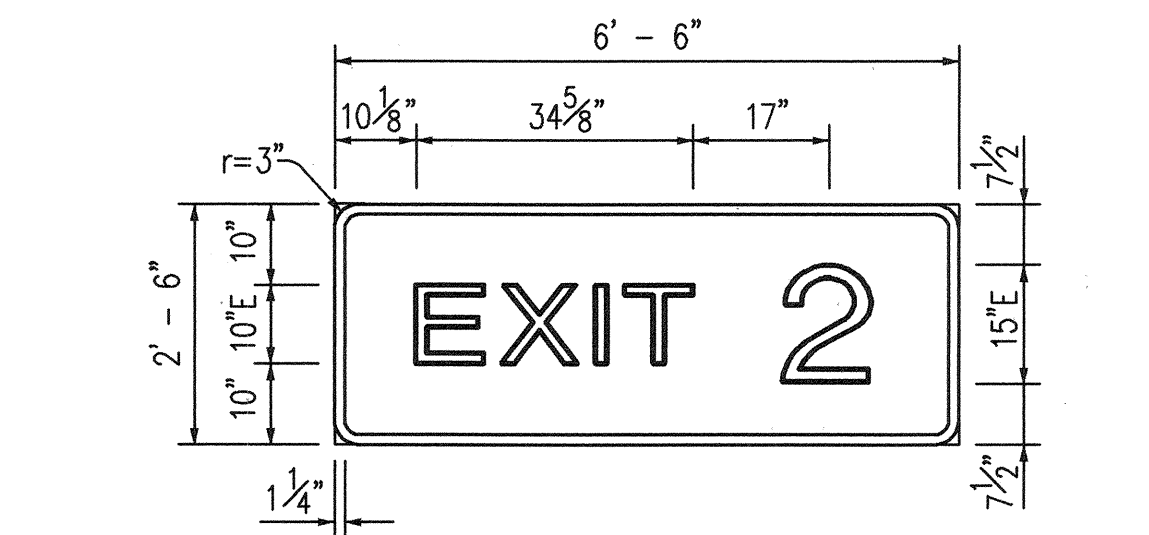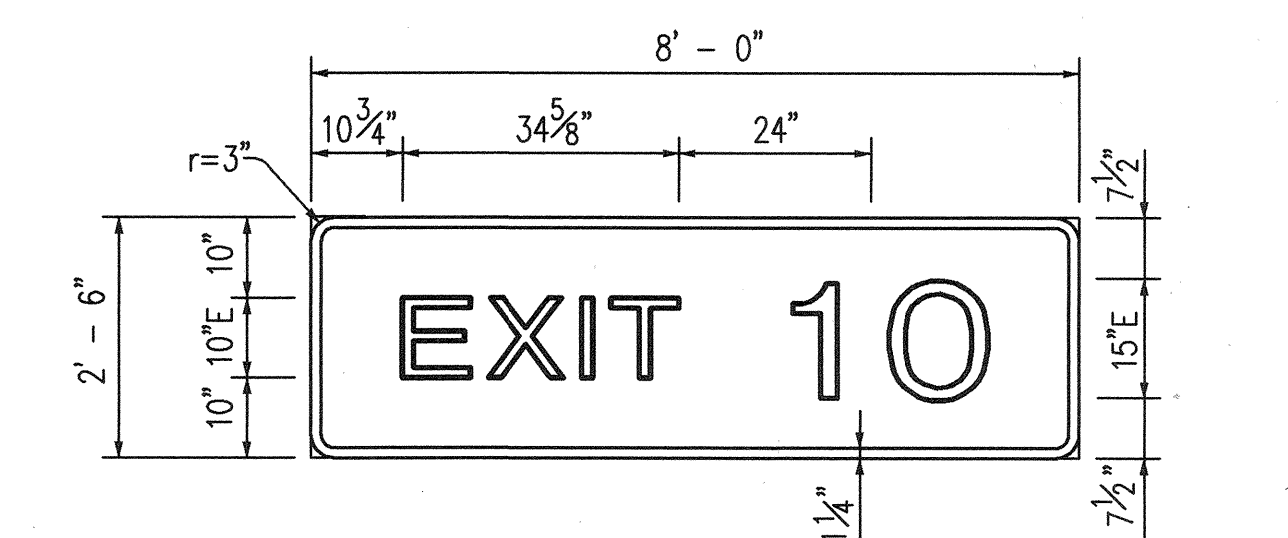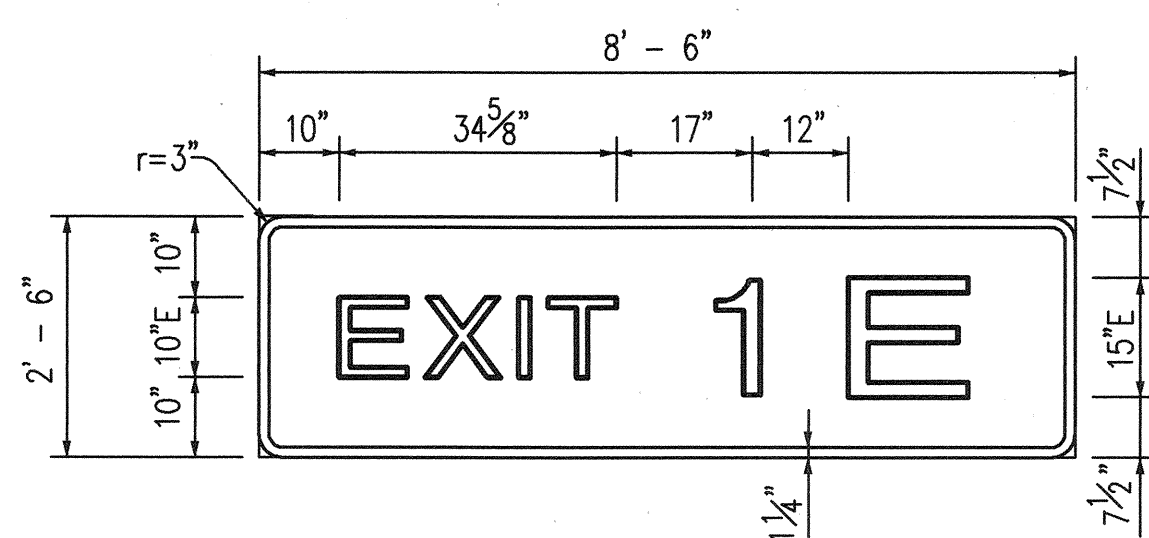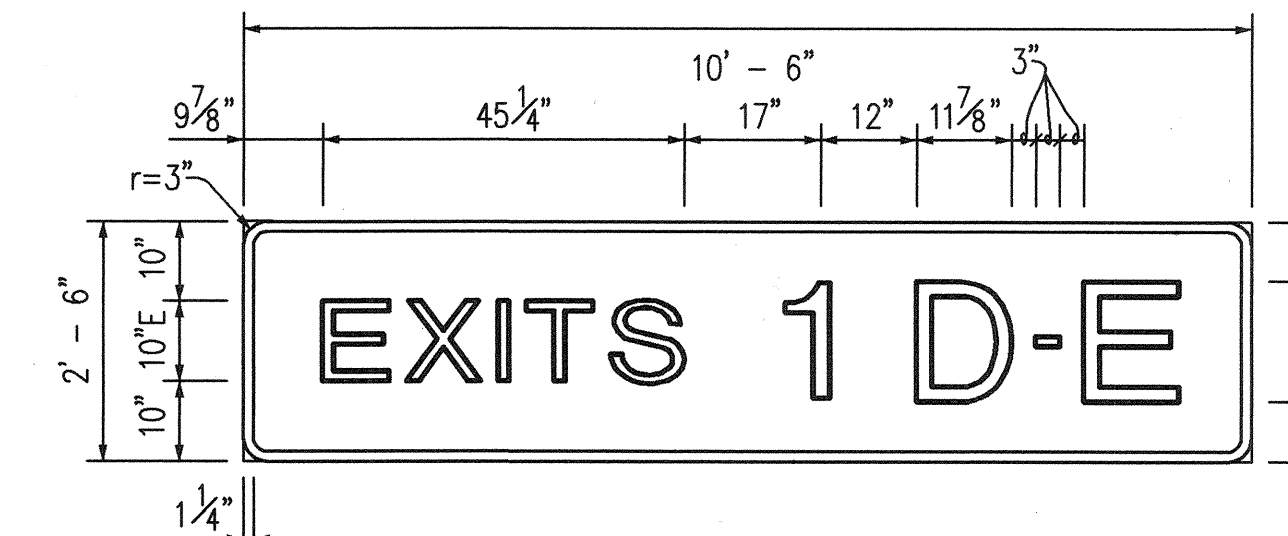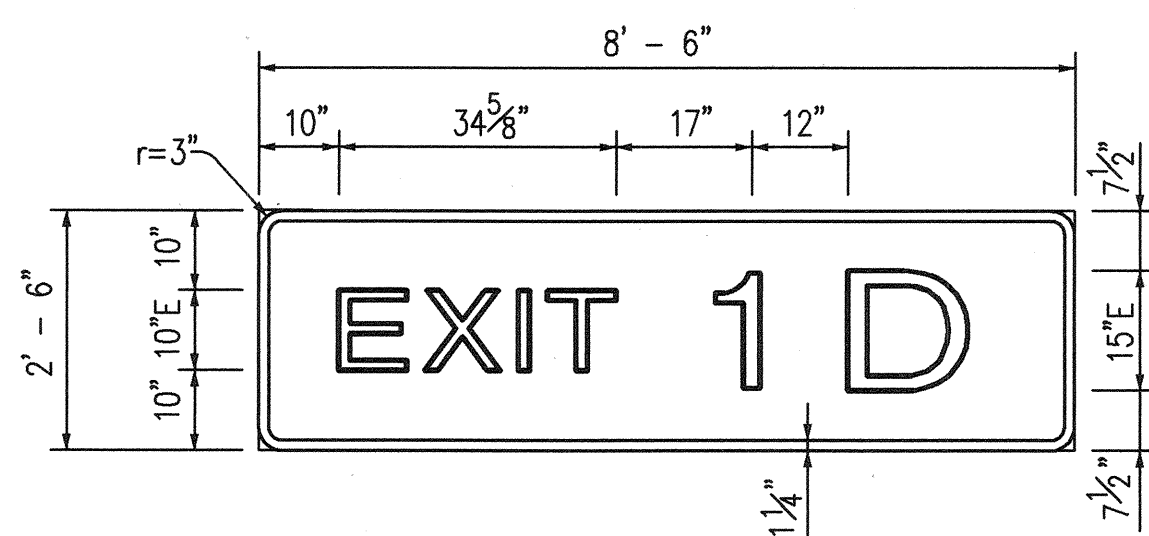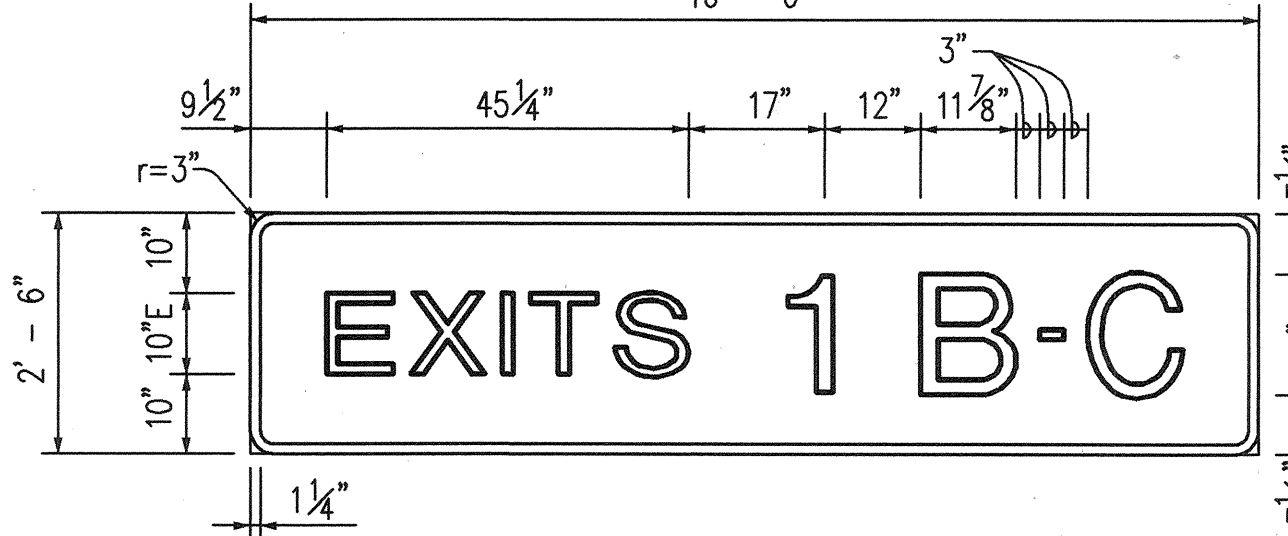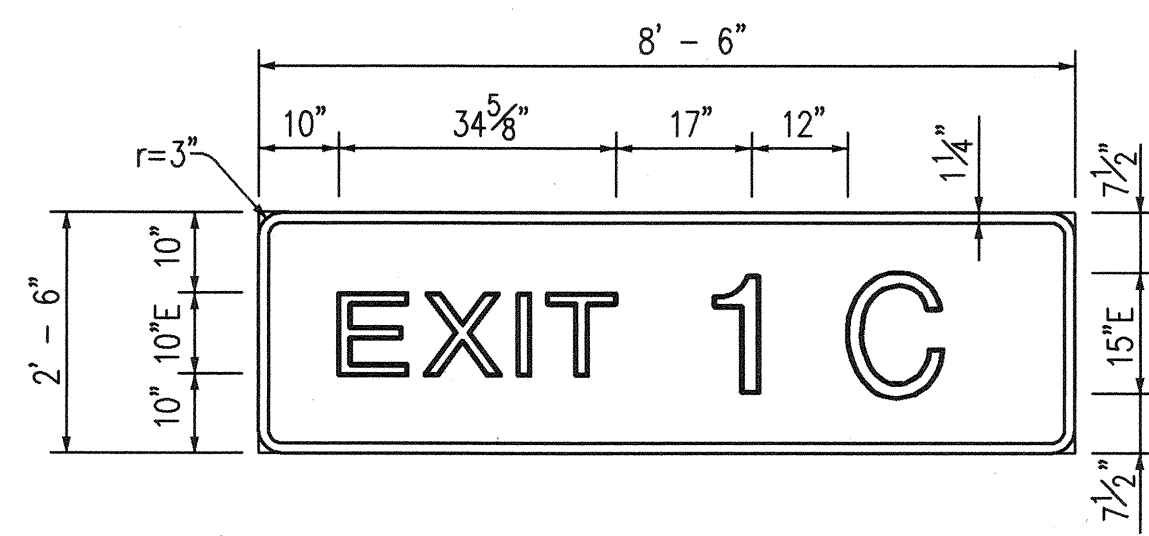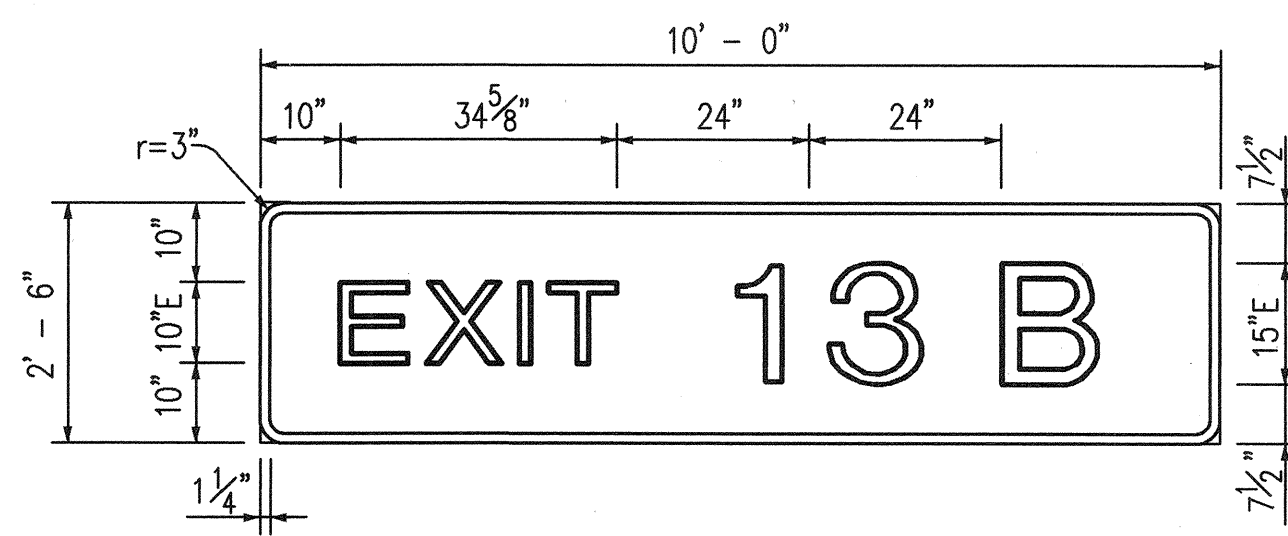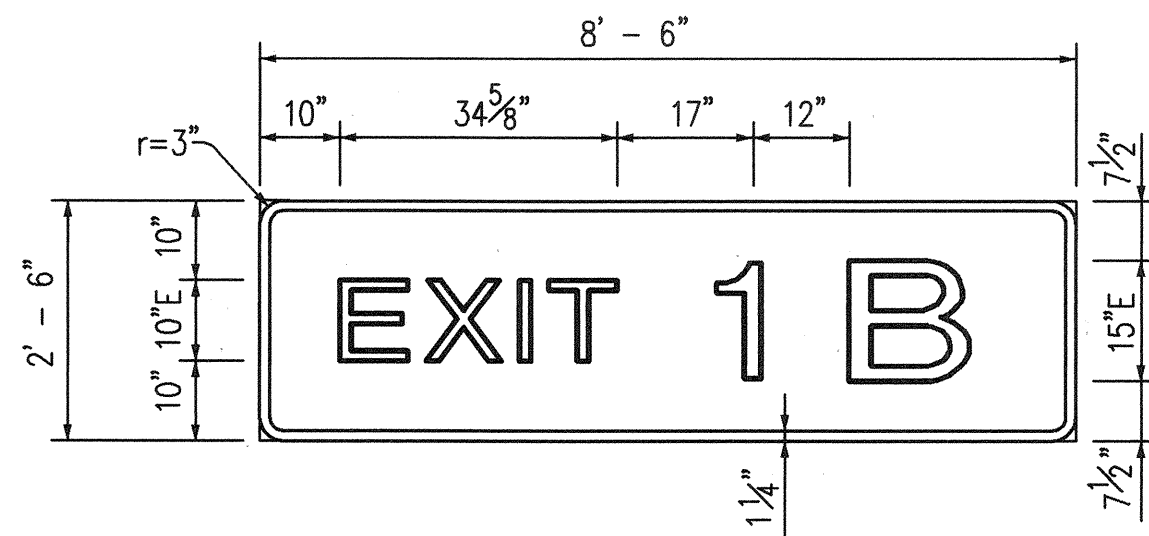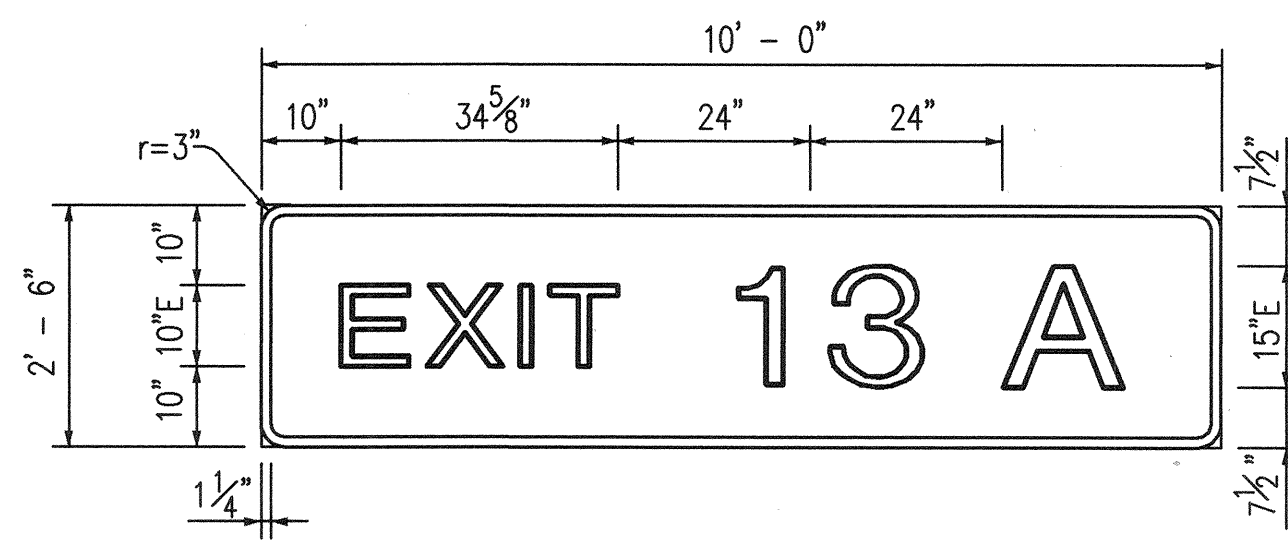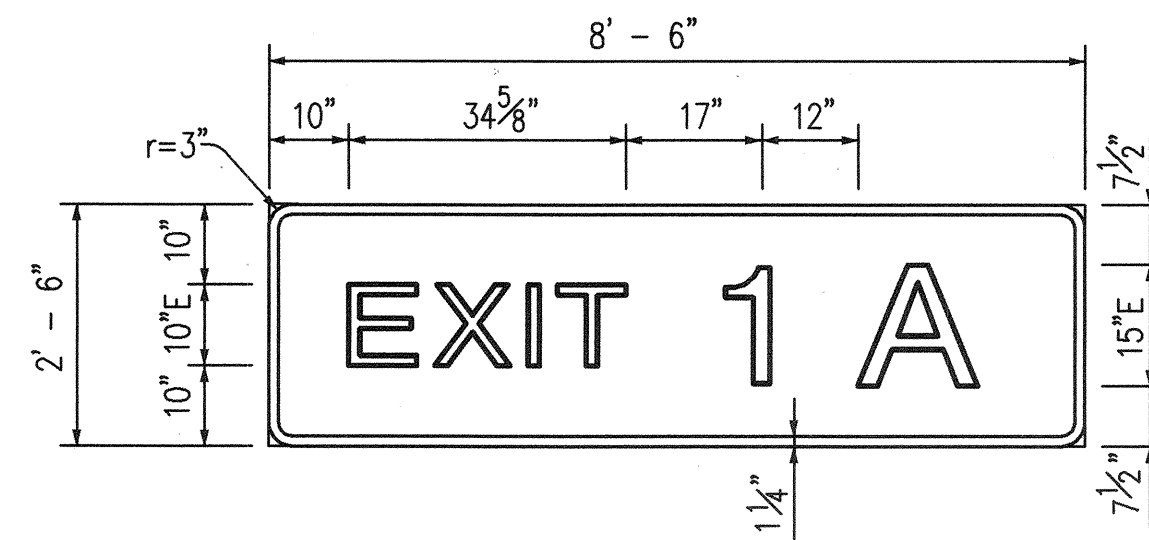


EXIT PANEL DETAILS

Scale: 1/2" = 1'-0"

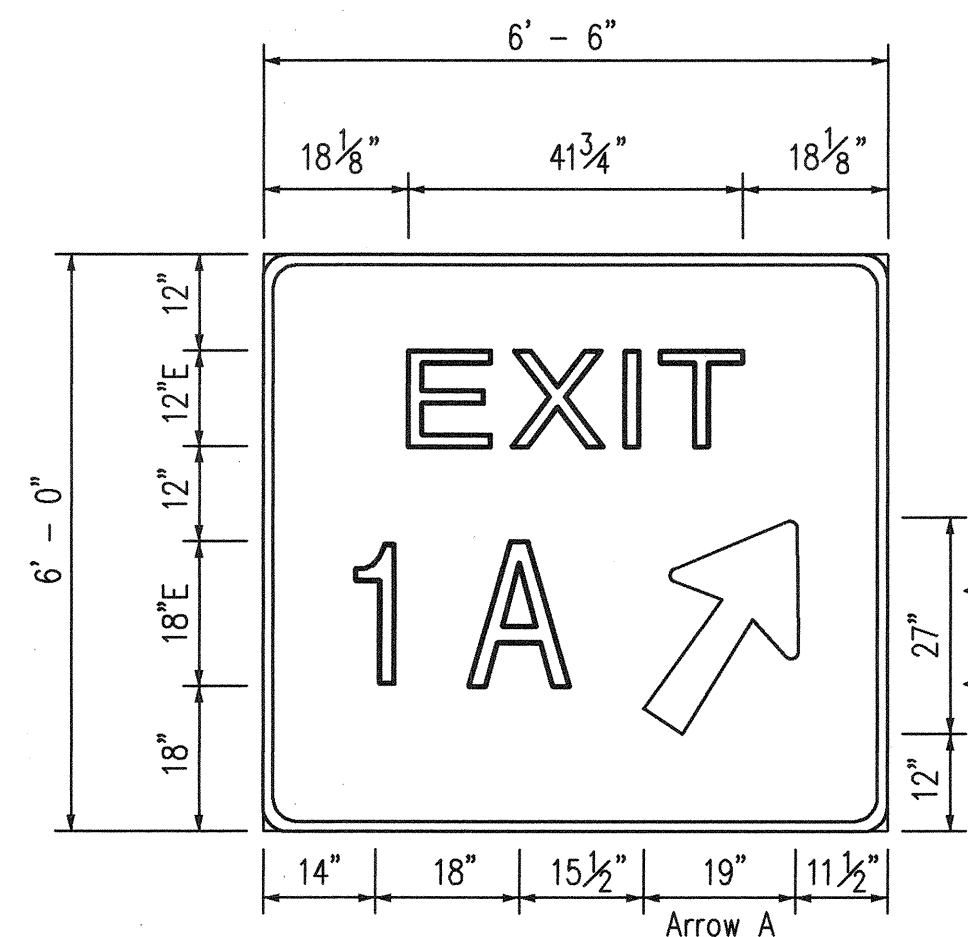


D-1A

Scale: 1/2" = 1'-0"

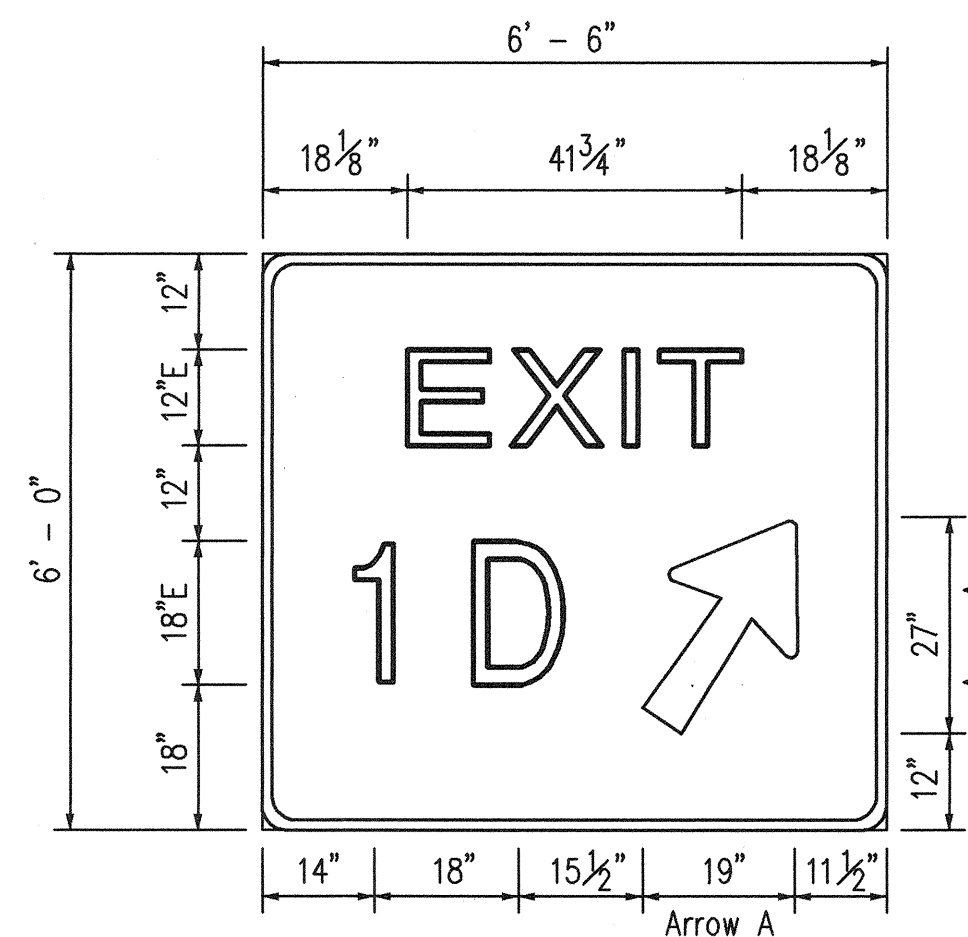


D-1D

Scale: 1/2" = 1'-0"

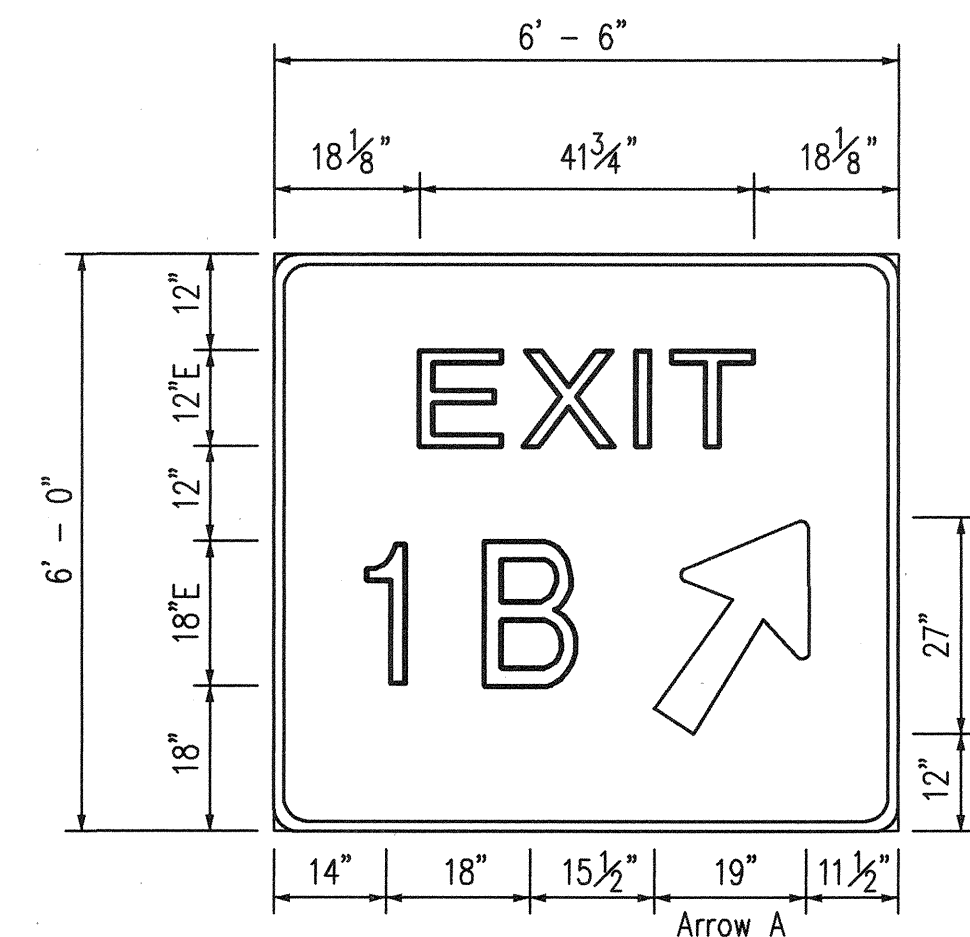


D-1B

Scale: 1/2" = 1'-0"

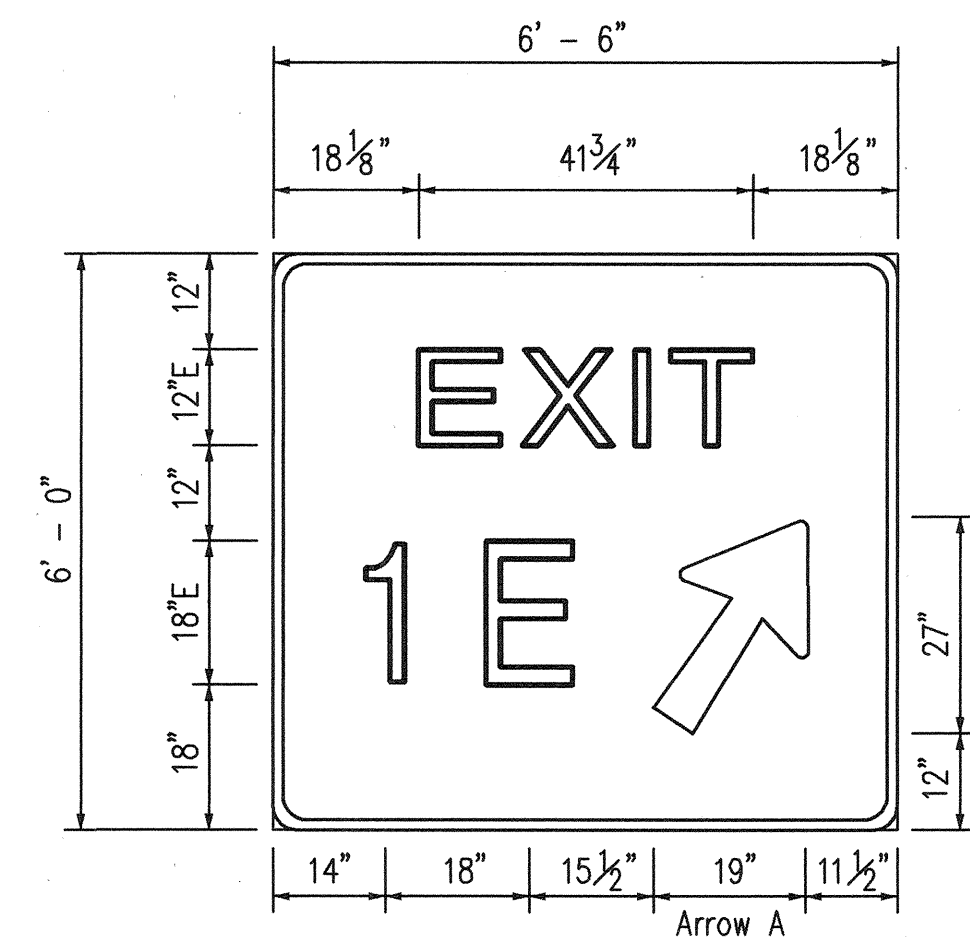


D-1E

Scale: 1/2" = 1'-0"

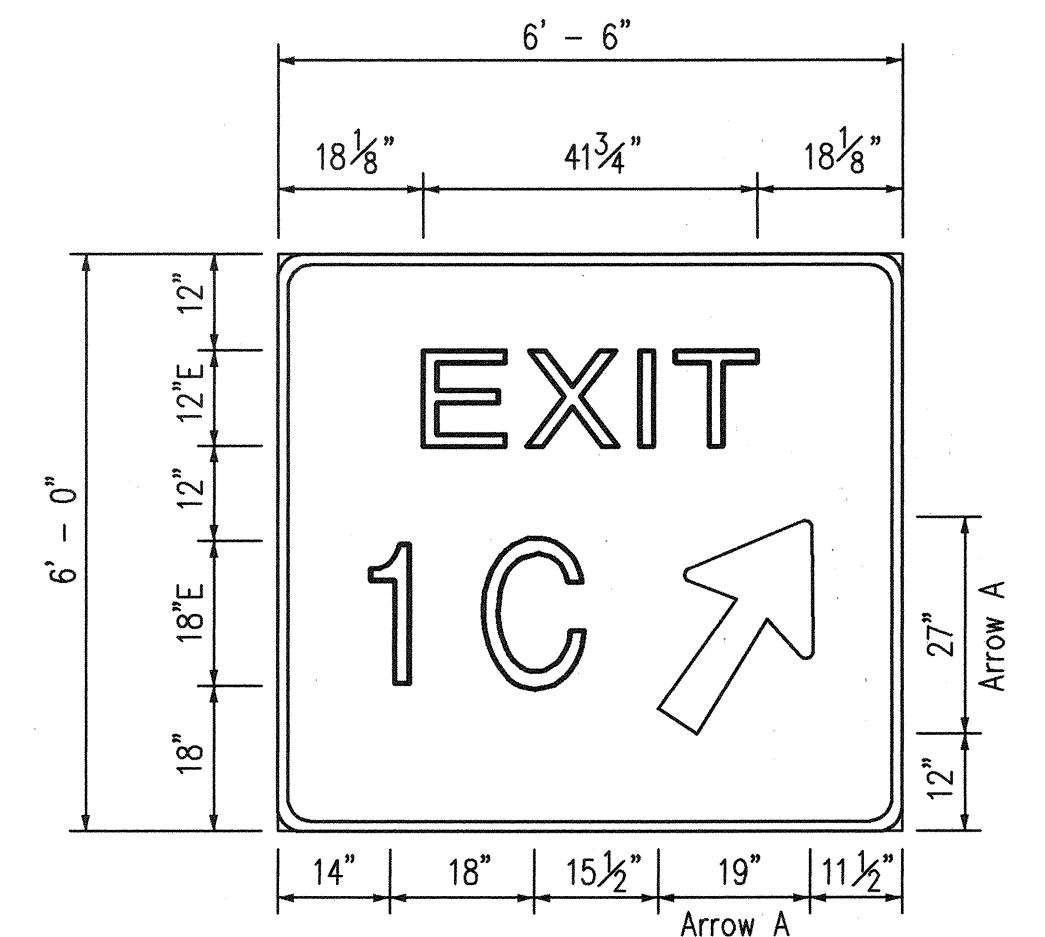

D-1C

Scale: 1/2" = 1'-0"

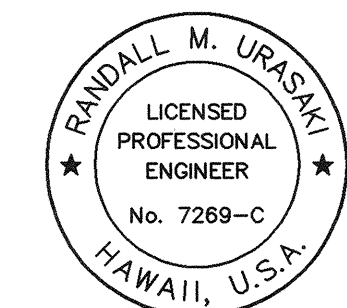

THIS WORK WAS PREPARED BY ME
OR UNDER MY SUPERVISION.
Randall M. Urasaki

STATE OF HAWAII
DEPARTMENT OF TRANSPORTATION
HIGHWAYS DIVISION

DESTINATION SIGNS
SIGN DETAILS
MISCELLANEOUS


H-3 FINISH (UNIT II)
FAIP NO. I-H3-1(75), UNIT II
LEEWARD SECTION

SCALE: AS SHOWN DATE: JANUARY 1997

SHEET NO. 6P19 OF 20 SHEETS


ORIGINAL PLAN	SURVEY PLOTTED BY	DATE
NOTE BOOK	DRAWN BY	
DESIGNED BY		
CHECKED BY		
No.		

FED. ROAD DIST. NO.	STATE	FED. AID PROJ. NO.	FISCAL YEAR	SHEET NO.	TOTAL SHEETS
HAWAII	HAW.	I-H3-1(75), UNIT II	1997	870	1102

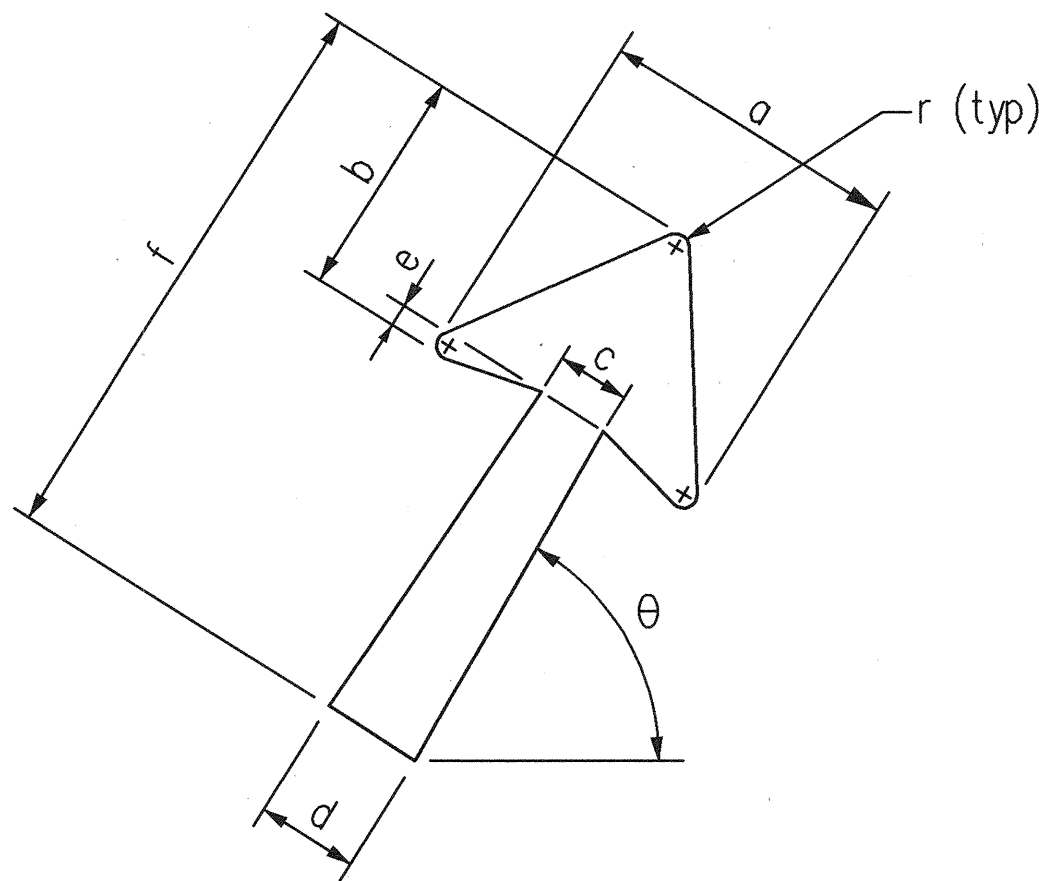


SIGN	ARROW A - DIMENSIONS							
	Inches							Degrees
	a	b	c	d	e	f	r	θ
D-1A D-1B D-1C D-1D D-1E	18 ¼	14	4 ½	6	1 ½	29 ¼	¾	60
E-8C E-8R E-33R E-37R E-39R E-52R E-54L E-58R	22 ¼	17	5 ⅜	7 ⅞	1 ¾	35 ⅝	1	60
E-2 E-50R	22 ¼	17	5 ⅜	7 ⅞	1 ¾	35 ⅝	1	45
E-27R	22 ¼	17	5 ⅜	7 ⅞	1 ¾	48	1	0

ARROW A
N.T.S.

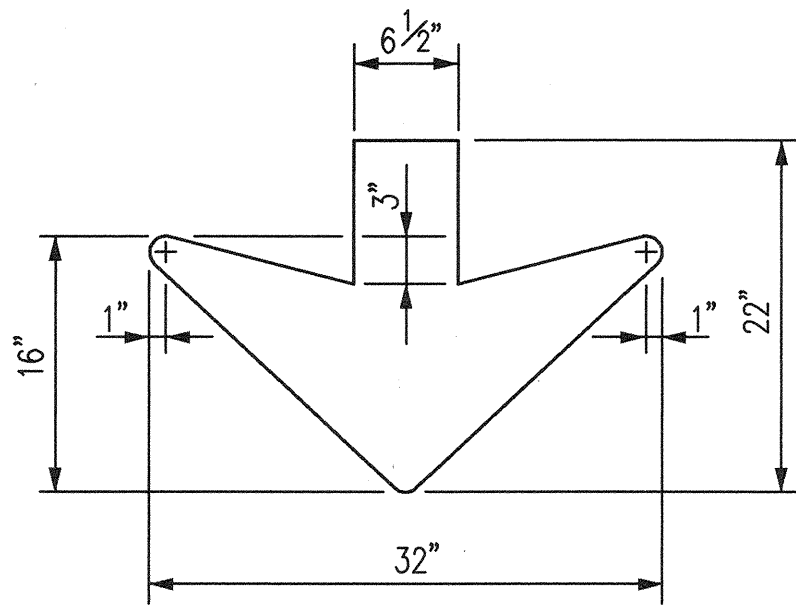

ARROW C
N.T.S.

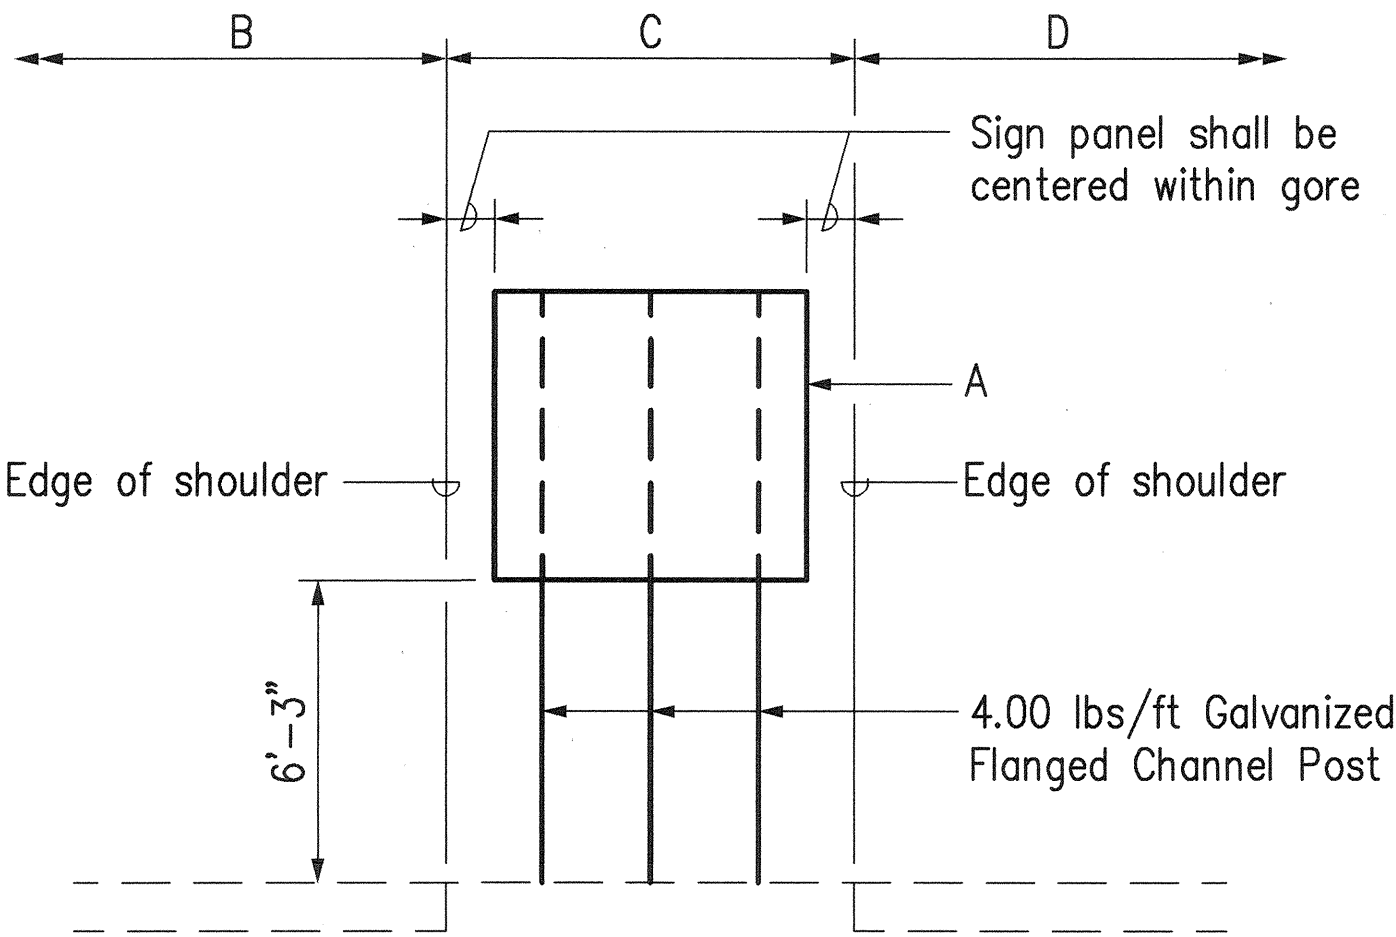

**SIGN LAYOUT D-1A, D-1B,
D-1C, D-1D & D-1E**


NOTES FOR 'D' SIGNS:

- For dimensions not shown, see Standard Plan TE-02.
- Sign Layout shown in direction of traffic.

ORIGINAL PLAN	SURVEY PLOTTED BY	DATE
NOTE BOOK	DRAWN BY	
	TRACED BY	
	QUANTITIES BY	
	CHECKED BY	
No.		

CAD by J. MMURA, 55-52

Last Saved: J:\H3RF\RFU2\SIGN\SLO-H1W2.dwg 02/24/97 at 08:29

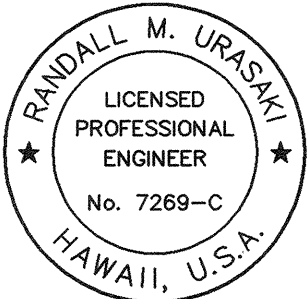

THIS WORK WAS PREPARED BY ME
OR UNDER MY SUPERVISION.
Randall M. Urasaki

STATE OF HAWAII
DEPARTMENT OF TRANSPORTATION
HIGHWAYS DIVISION

DESTINATION SIGNS
SIGN DETAILS & SIGN LAYOUT
MISCELLANEOUS
H-3 FINISH (UNIT II)
FAIP NO. I-H3-1(75), UNIT II
LEEWARD SECTION
SCALE: 1/4" = 1'-0" DATE: JANUARY 1997
SHEET NO. 6P20 OF 20 SHEETS

FED. ROAD DIST. NO.	STATE	FED. AID PROJ. NO.	FISCAL YEAR	SHEET NO.	TOTAL SHEETS
HAWAII	HAW.	I-H3-1(75), UNIT II	1997	871	1102

1. DESIGN SPECIFICATIONS:

AASHTO Standard Specifications for Structural Supports for Highway Signs, Luminaires and Traffic Signals, 1994 Edition.

2. DESIGN DATA:

WIND LOADING: Design wind speed = 80 mph. For wind load normal to face of sign and transverse to face of sign, see Design Specifications.

ICE LOAD: None.

STRUCTURAL STEEL: ASTM A36.

HIGH STRENGTH BOLTS: ASTM A325 (Friction – Type Connection).

ALUMINUM MEMBERS: Aluminum Alloy 6061-T6.

STEEL PIPE: ASTM A53 Type E Grade B

3. WELDING:

All welding to be continuous welds and as noted on the plans. All welding shall conform to the requirements of ANSI/AASHTO/AWS D1.5-88, "Bridge Welding Code".

4. MATERIALS:

- A. Galvanized surfaces of overhead sign support structures shall be painted to dark green color. See Specifications.
- B. Contact surfaces in high strength (H.S.) bolt connections shall not be painted. The galvanizing on these surfaces shall be lightly scored by wire brushing prior to assembly.
- C. High strength bolts shall be galvanized, furnished and installed in conformance with current ASTM A325 with lubricated nuts.
- D. Leveling grout shall be non-shrink and non-metallic.
- E. Anchor bolts to be ASTM A449 galvanized.
- F. Aluminum members and surfaces in contact with structural steel shall be $\frac{1}{16}$ " thick neoprene sheet.

5. CONSTRUCTION METHOD:


See Hawaii Standard Specifications for road and bridge construction, 1994 Edition, AASHTO Standard Specifications for structural supports for Highway Signs, Luminaires and Traffic Signals, current Edition and Special Provisions for this project.

6. GENERAL:

- A. Prior to fabrication of the sign support structures, the Contractor shall verify in the field the exact location of each of the anchor bolts installed and the post elevation at the top of the supporting concrete.
- B. Payment for the overhead sign support structures, sign panel mounting brackets and modifications of the existing sign support structures shall be made as described in the Special Provisions.
- C. All sign support structures are viewed in the direction of traffic, unless noted otherwise.
- D. The Contractor shall probe to locate the existing utilities and shall notify the respective owners prior to commencing with foundation work.

7. LEGEND AND ABBREVIATIONS:


&	And	Lt.	Left
@	At	Max.	Maximum
Alum.	Aluminum	Min.	Minimum
Ⓟ	Baseline	O.C.	On center
Bot.	Bottom	O.D.	Outside diameter
Brg.	Bearing	Opng.	Opening
Ⓒ	Centerline	o/s	Offset
Cl, Clr.	Clear	Ⓟ	Plate
CM	Changeable message	Pt	Point of tangent
CMS	Changeable message sign	Pvmt.	Pavement
Conc.	Concrete	Rect.	Rectangular
Conn.	Connection	Reloc.	Relocated
Cont.	Continuous	Req'd.	Required
Dia.	Diameter	Rt.	Right
Diag.	Diagonal	Sect.	Section
E.F.	Each face	Sht.	Sheet
Eq.	Equal	S.S.	Stainless Steel
Eq. Spc.	Equal spaces	Std.	Standard
Exist.	Existing	Stiff.	Stiffener
Flex.	Flexible	Symm.	Symmetrical
FM	Fixed message	t, Thk.	Thick
FMS	Fixed message sign	Typ.	Typical
Galv.	Galvanized	Ult.	Ultimate
Gr.	Ground	Vert.	Vertical
H.S.	High strength	VMS	Variable message sign
I.B.	Inbound	WP	Weatherproof
Jt.	Joint	w/	With

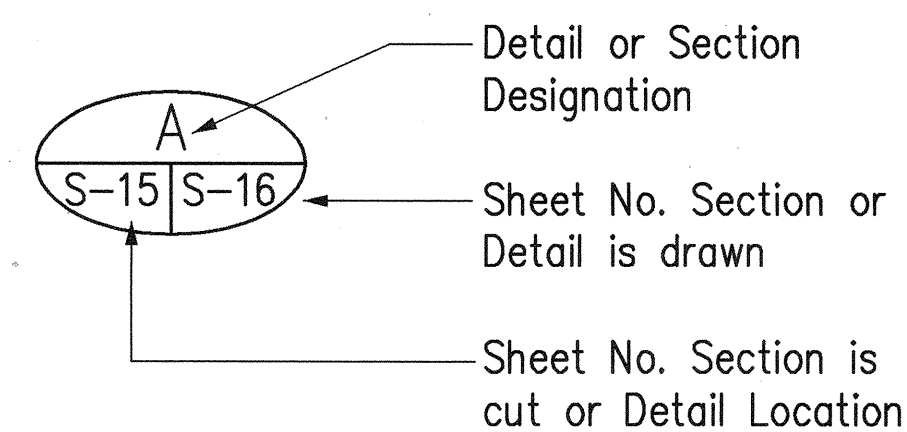

8. FOUNDATION:

Use 5'-0" diameter Drilled Shafts. For Details see Sht. Nos. 6V6 and 6V7.

ORIGINAL PLAN	SURVEY PLOTTED BY _____	DATE _____
NOTE BOOK	DRAWN BY _____	_____
	TRACED BY _____	_____
	DESIGNED BY _____	_____
	QUANTITIES BY _____	_____
No. _____	CHECKED BY _____	_____

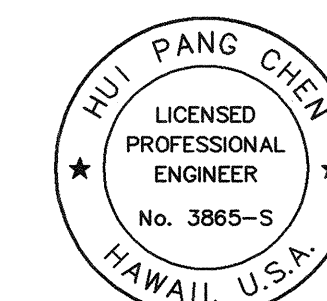

THIS WORK WAS PREPARED BY ME
OR UNDER MY SUPERVISION.

Shirong Chen

STATE OF HAWAII
DEPARTMENT OF TRANSPORTATION
HIGHWAYS DIVISION


DESTINATION SIGNS
SIGN STRUCTURES
GENERAL NOTES

H-3 FINISH (UNIT II)
FAIP NO. I-H3-1(75), UNIT II
LEEWARD SECTION



SCALE: NONE DATE: JANUARY 1997

SHEET NO. 6V1 OF 14 SHEETS


FED. ROAD DIST. NO.	STATE	FED. AID PROJ. NO.	FISCAL YEAR	SHEET NO.	TOTAL SHEETS
HAWAII	HAW.	I-H3-1(75), UNIT II	1997	872	1102

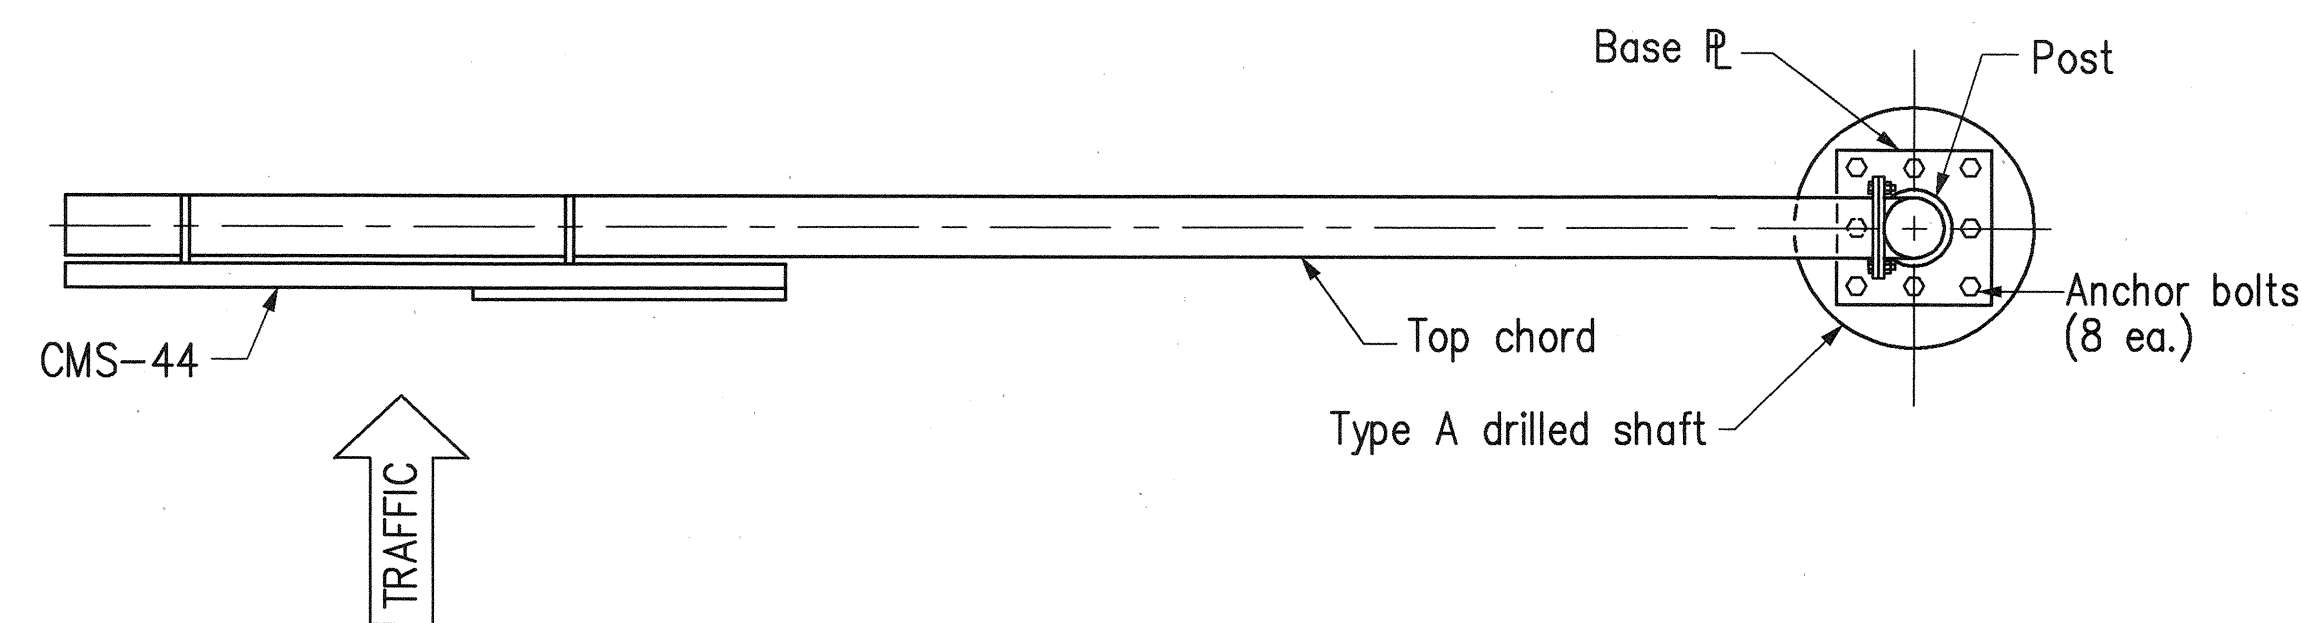

PLAN - CANTILEVER SIGN STRUCTURE CMS-44
Not to Scale

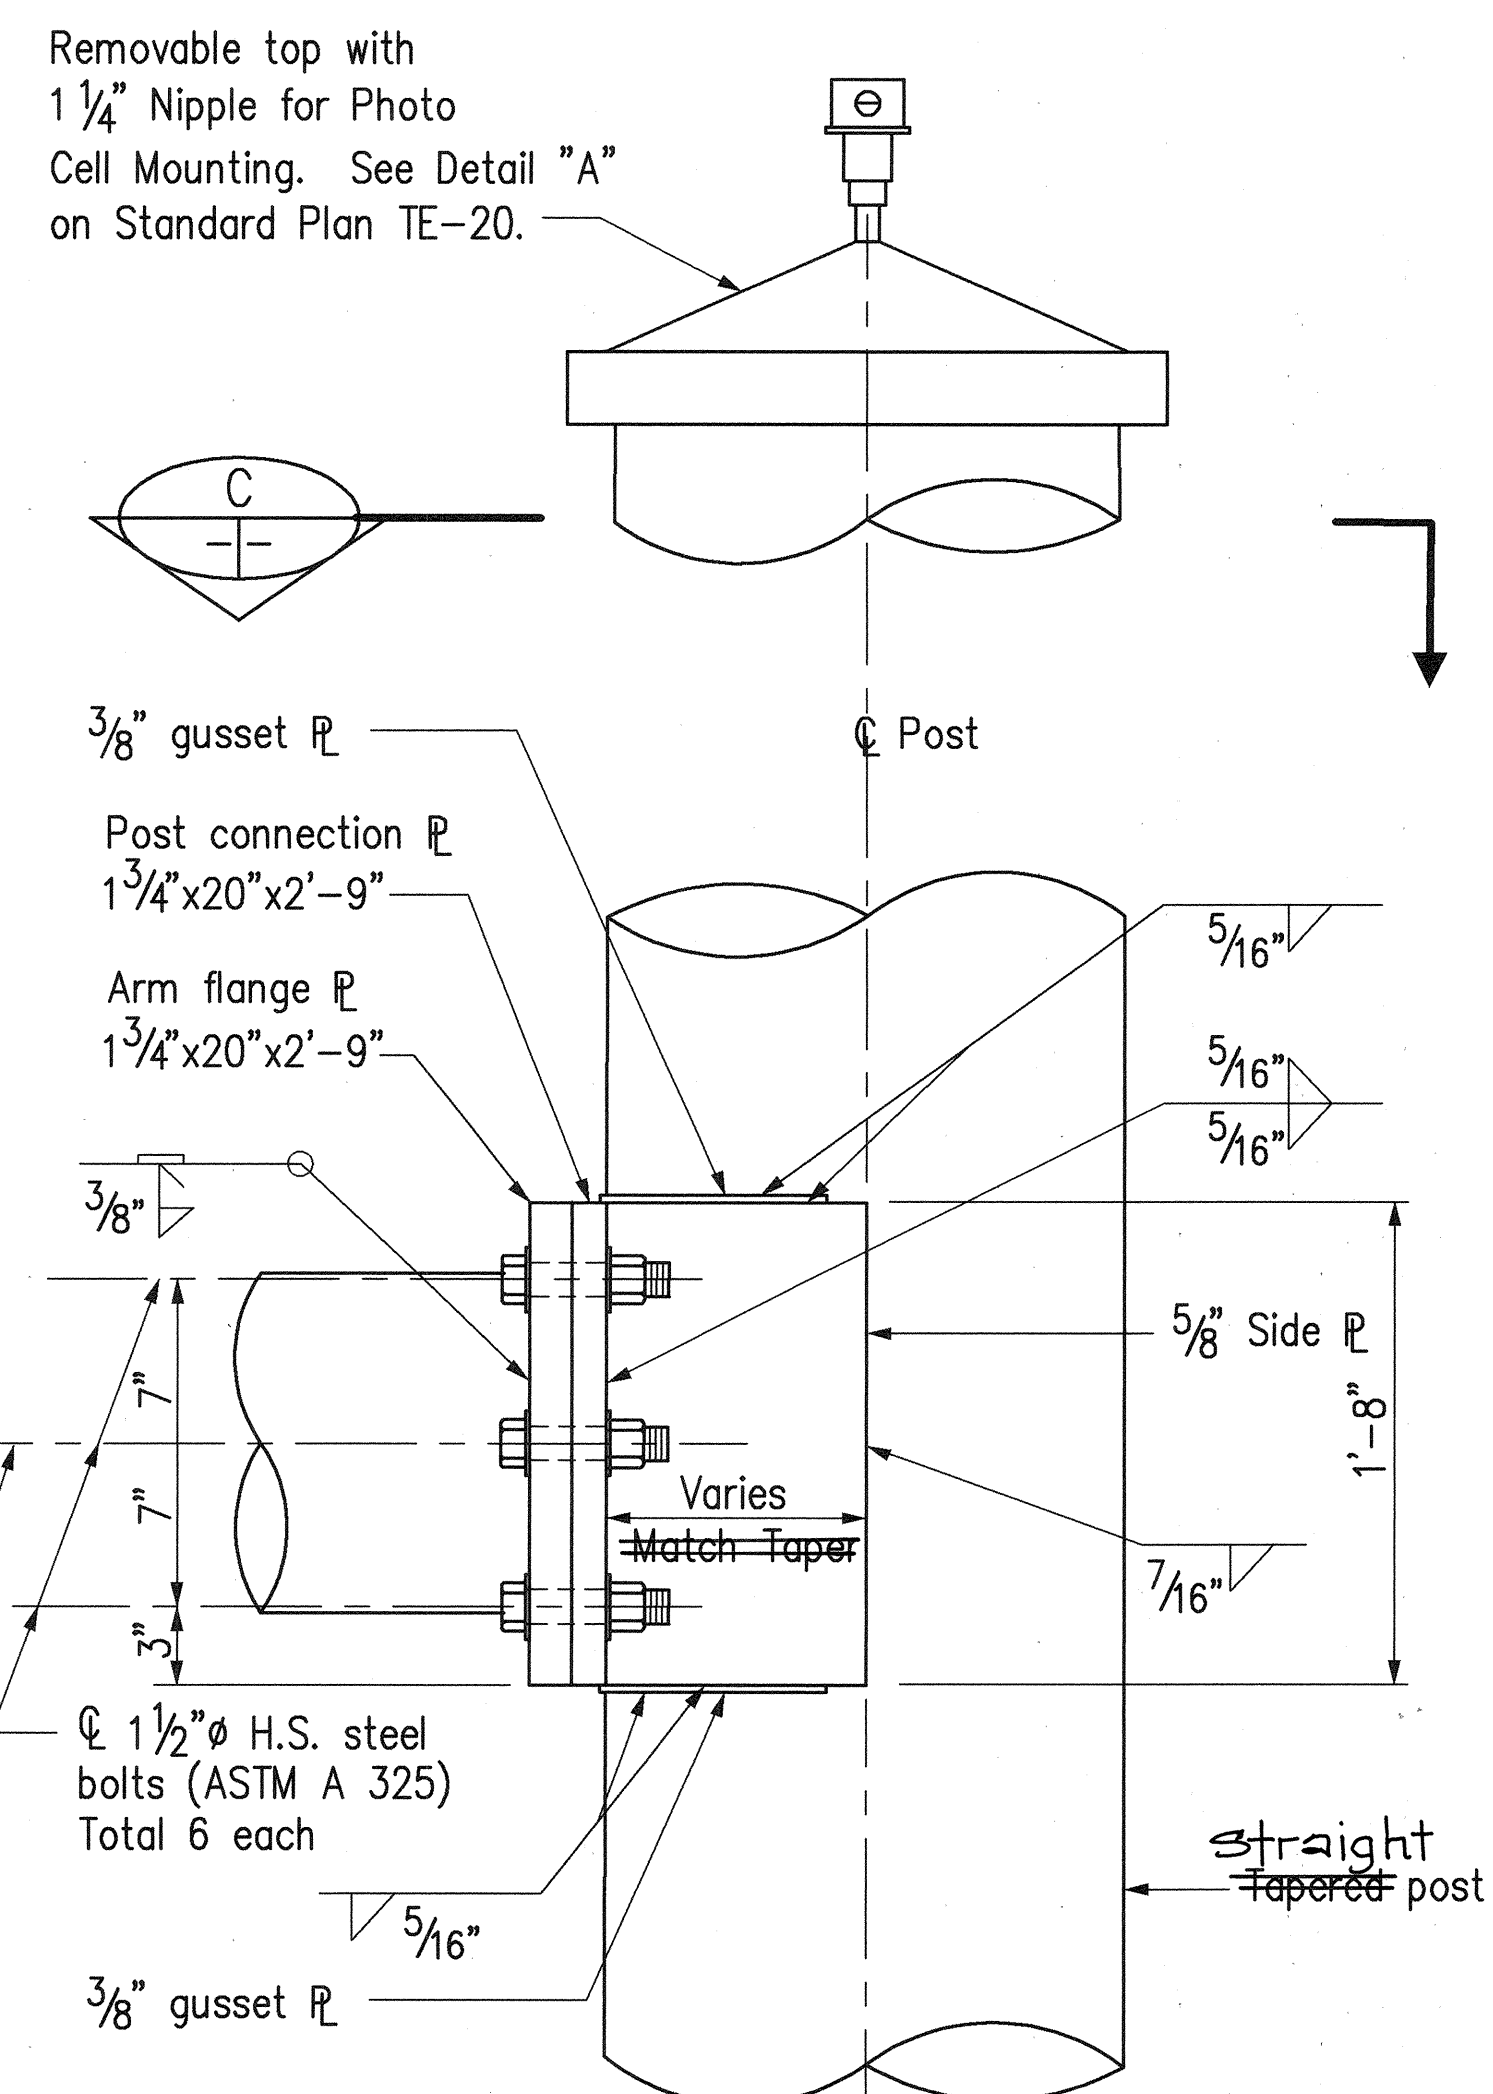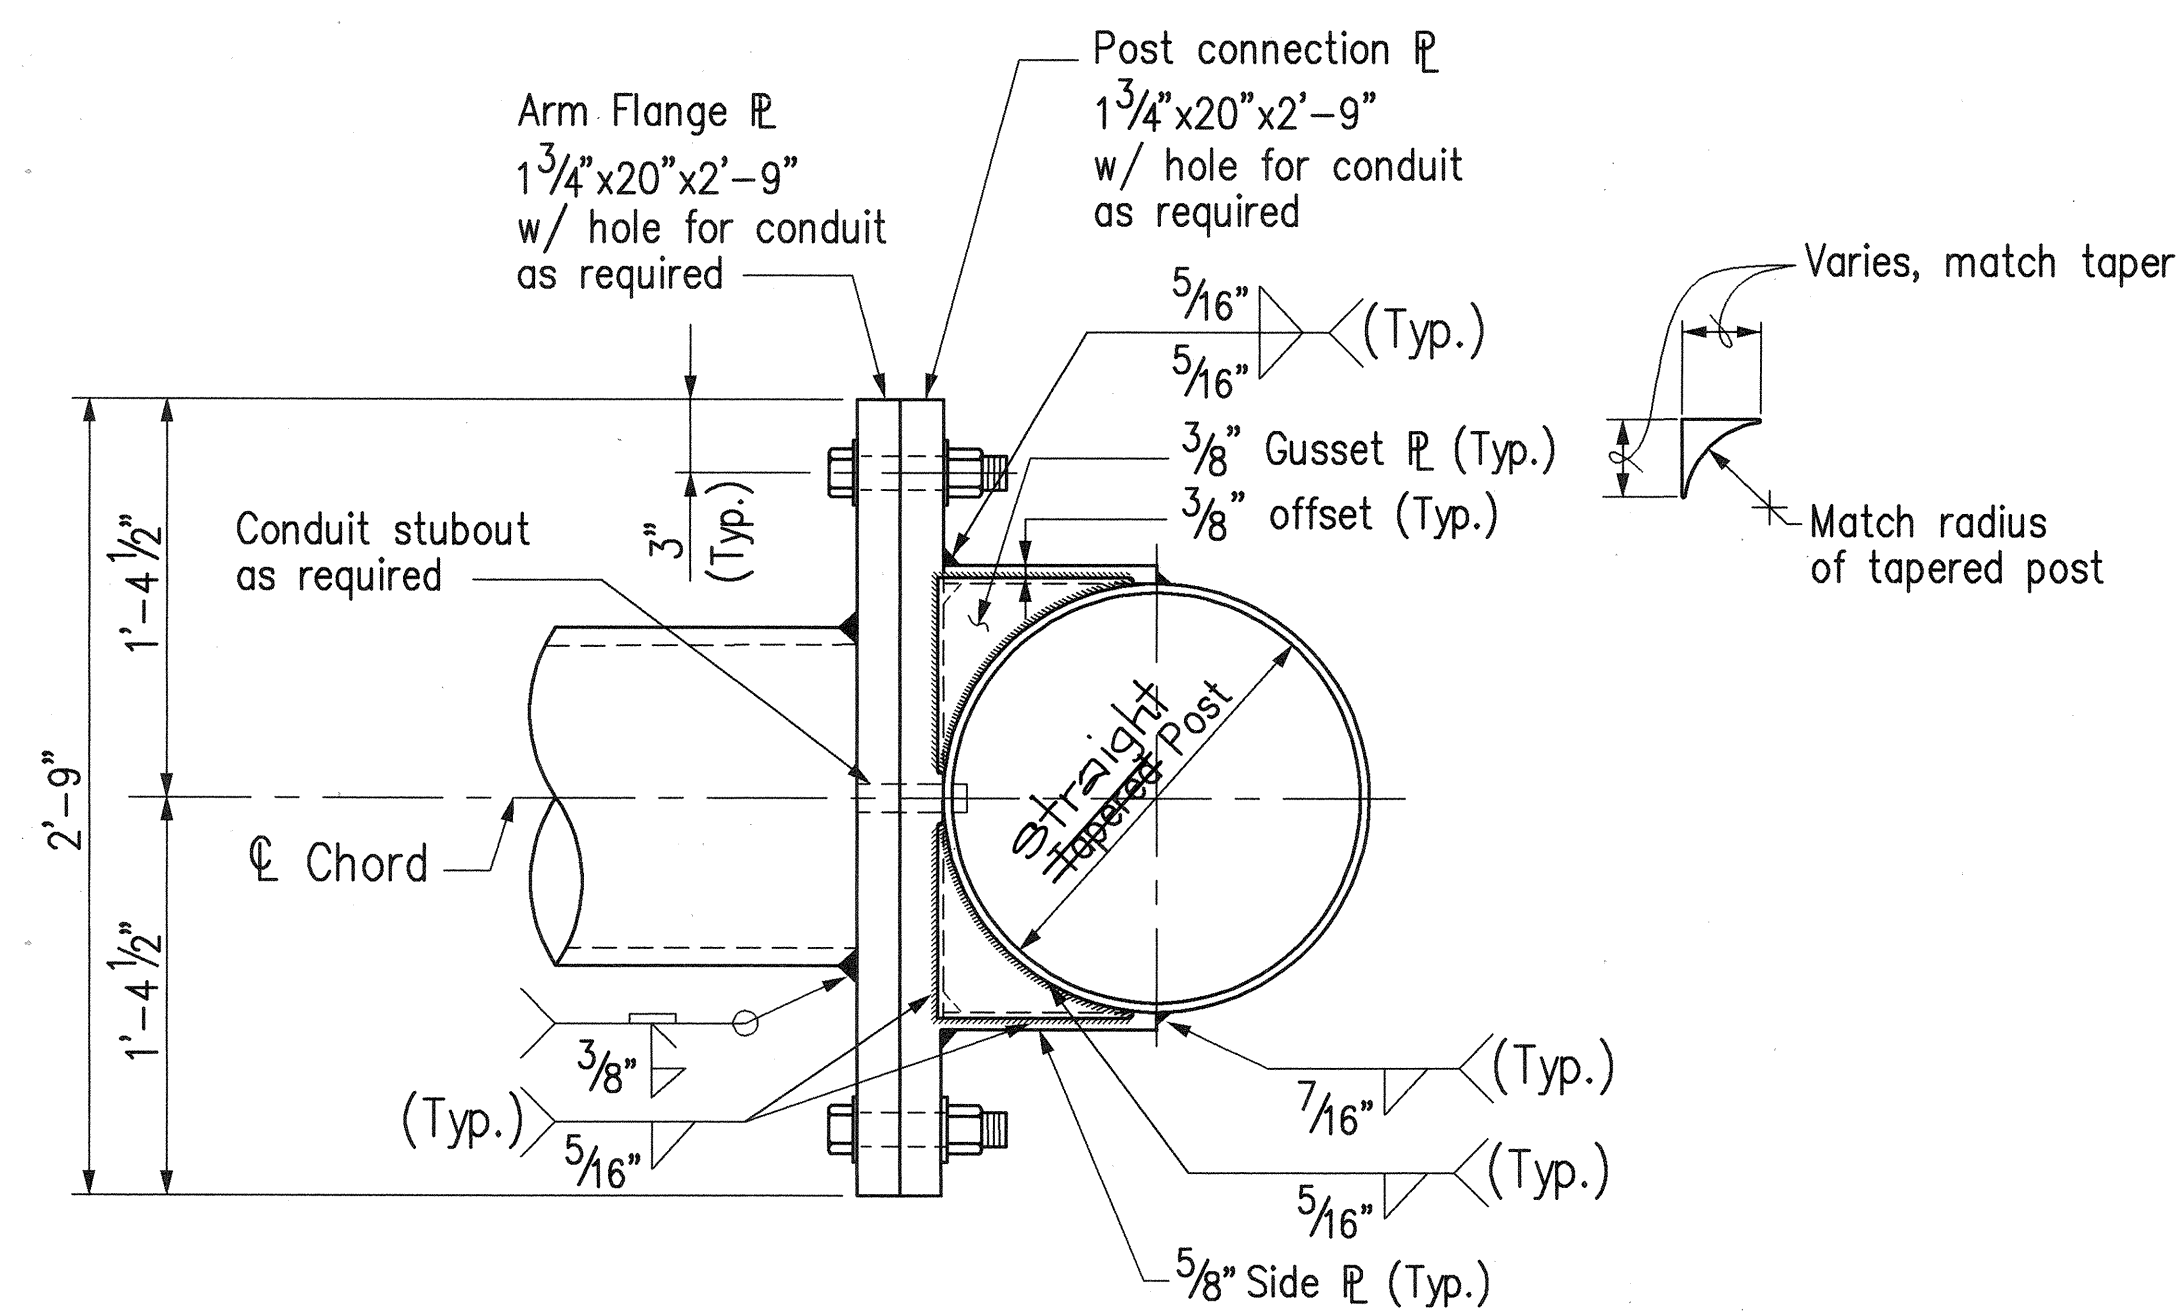

POST ELEVATION - SIGN STRUCTURE CMS-44
Scale : 1 1/2" = 1'-0"

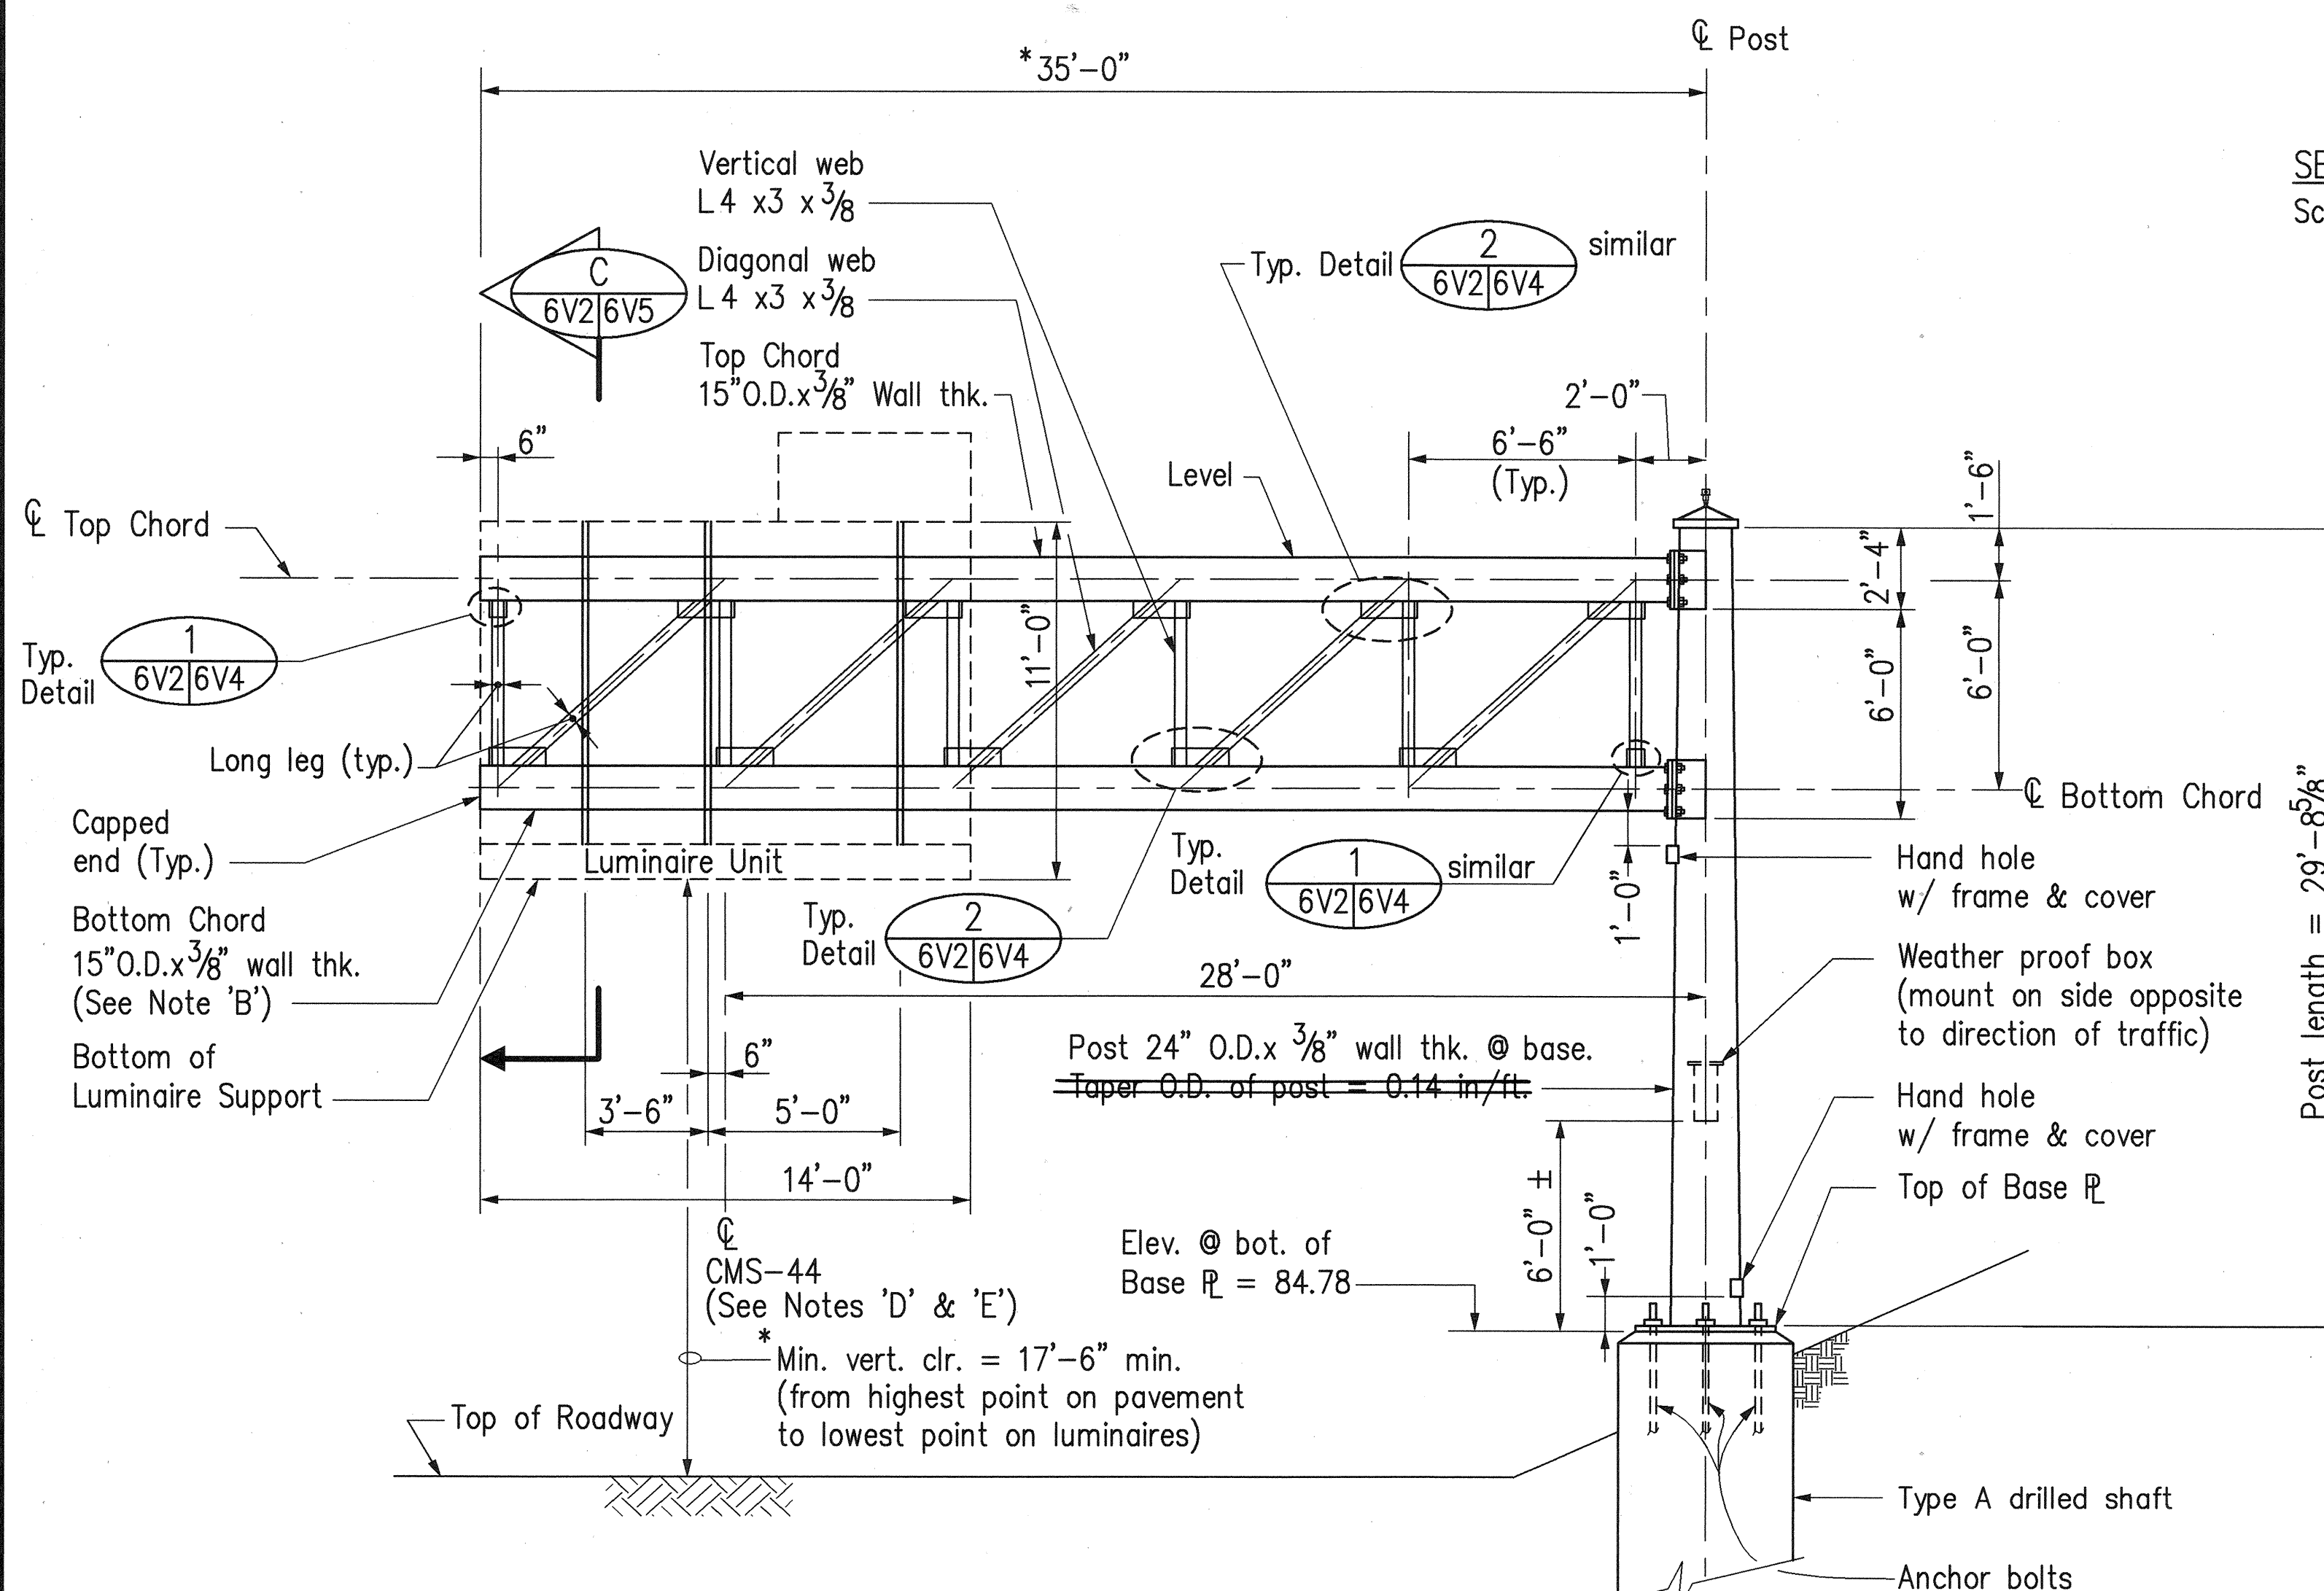


ELEVATION – CANTILEVER SIGN STRUCTURE CMS-44
MOANALUA FREEWAY INBOUND STA. 181+00
Not To Scale

* The Contractor shall verify the dimensions in field prior to fabrication of structure.

DEAD LOAD DEFLECTIONS
FOR SIGN STRUCTURE CMS-44
Not To Scale

NOTES:

- A. The dead load deflection includes the effect of the weight of the truss. A camber shall be provided to accommodate this deflection.
- B. Provide conduit stubouts in bottom chord for luminaire wiring as required. At these locations, place handholes on bottom side of chord 1'-0" from hole.
- C. For sign structure notes, see Sht. No. 6V1.
- D. CMS 44 panel is State-Furnished. For assembly and mounting details, see Sht. No. SY-98.
- E. The Contractor shall furnish and install mounting bracket as shown on this sheet and Sht. No. 6V5 for CMS 44.

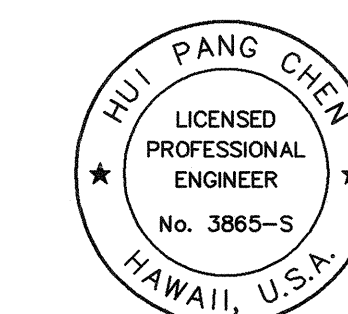

THIS WORK WAS PREPARED BY ME
OR UNDER MY SUPERVISION.

Shipingchen

STATE OF HAWAII
DEPARTMENT OF TRANSPORTATION
HIGHWAYS DIVISION

DESTINATION SIGNS

SIGN STRUCTURES

CANTILEVER TYPE

H-3 FINISH (UNIT II)
FAIP NO. I-H3-1(75). UNIT II
LEEWARD SECTION



SCALE: AS SHOWN DATE: JANUARY 1997

SHEET NO. 6V2 OF 14 SHEETS

FED. ROAD DIST. NO.	STATE	FED. AID PROJ. NO.	FISCAL YEAR	SHEET NO.	TOTAL SHEETS
HAWAII	HAW.	I-H3-1(75), UNIT II	1997	873	1102


SIGN STRUCTURE	LOCATION	A	B	C	D	E	TRUSS PANEL SPACING	TOP & BOT CHORD SIZE	VERT. WEB SIZE	DIAG. WEB SIZE	LEFT & RIGHT POST SIZE @ BASE	DEAD LOAD DEFLECTION	ELEV. BOT. OF BASE $\bar{P}$	
													LEFT POST	RIGHT POST
E-52L & E-52R	Ramp N Sta. 34+76±	57'-0"	27'-6"	43'-0"	26'-11 3/16"	31'-5 3/16"	8 Equal Panels @ 6'-9"	14" O.D.x 3/8" thk. Wall	L5x3x5/16	L5x3x5/16	20"O.D.x 3/8" thk. Wall	1/16"	137.54	133.04
E-54L & CMS-39	Moanalua Freeway O.B. Sta. 207+25±	91'-0"	19'-6"	34'-3"	25'-2 9/16"	30'-5 1/2"	14 Equal Panels @ 6'-3 7/16"	20" O.D.x 3/8" thk. Wall	L5x3x3/8	L5x3x3/8	26"O.D.x 3/8" thk. Wall	1/4"	184.99	179.74
E-56L & CMS-43	Moanalua Freeway O.B. Sta. 213+90	91'-0"	18'-9"	34'-3"	32'-0 15/16"	28'-10 13/16"	14 Equal Panels @ 6'-3 7/16"	20" O.D.x 3/8" thk. Wall	L5x3x3/8	L5x3x3/8	26"O.D.x 3/8" thk. Wall	1/4"	228.89	232.07
E-58L & E-58R	Moanalua Freeway B.L. Sta. 264+00	87'-9"	18'-0"	33'-9"	26'-10 15/16"	35'-3 1/4"	14 Equal Panels @ 6'-0 5/8"	20" O.D.x 3/8" thk. Wall	L5x3x3/8	L5x3x3/8	26"O.D.x 3/8" thk. Wall	1/4"	93.67	85.31
E-60 (L,C,R) & E-64	H-3 B.L. Sta. 374+75.72 See Notes G & H	93'-0"	32'-0"	73'-0"	30'-9 15/16"	34'-10 15/16"	13 Equal Panels @ 6'-3 7/16" 2 Equal Panels @ 4'-1 3/4" Adjacent to Right Post	20" O.D.x 3/8" thk. Wall	L5x3x3/8	L5x3x3/8	26"O.D.x 3/8" thk. Wall	1/4"	163.64	159.56
E-37L, E-37C & E-37R	H-3 B.L. Sta. 261+25	75'-0"	28'-0"±	58'-6"±	28'-7 1/2"	28'-7 1/2"	12 Equal Panels @ 6'-0"	14" O.D.x 3/8" thk. Wall	L5x3x3/8	L5x3x3/8	20"O.D.x 3/8" thk. Wall	1/8"	61.06	61.05

NOTES: (Cont.)
H. The Outbound Drilled Shaft location is to be moved 4.5' from Plan Location away from PCC.

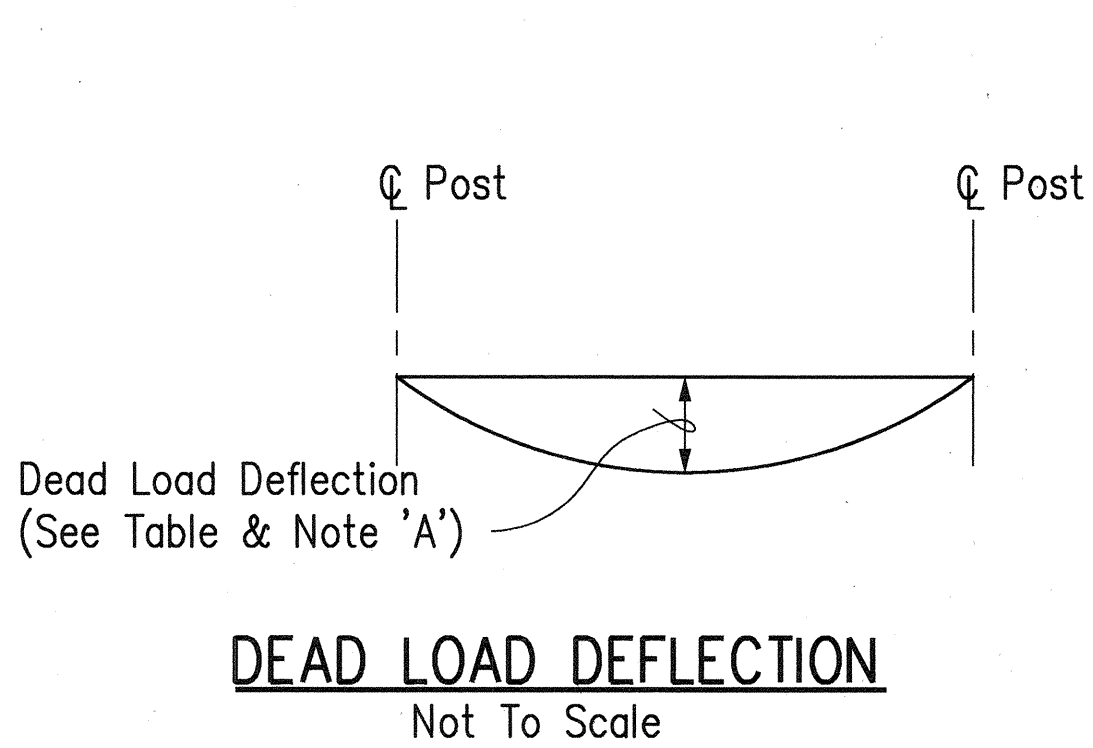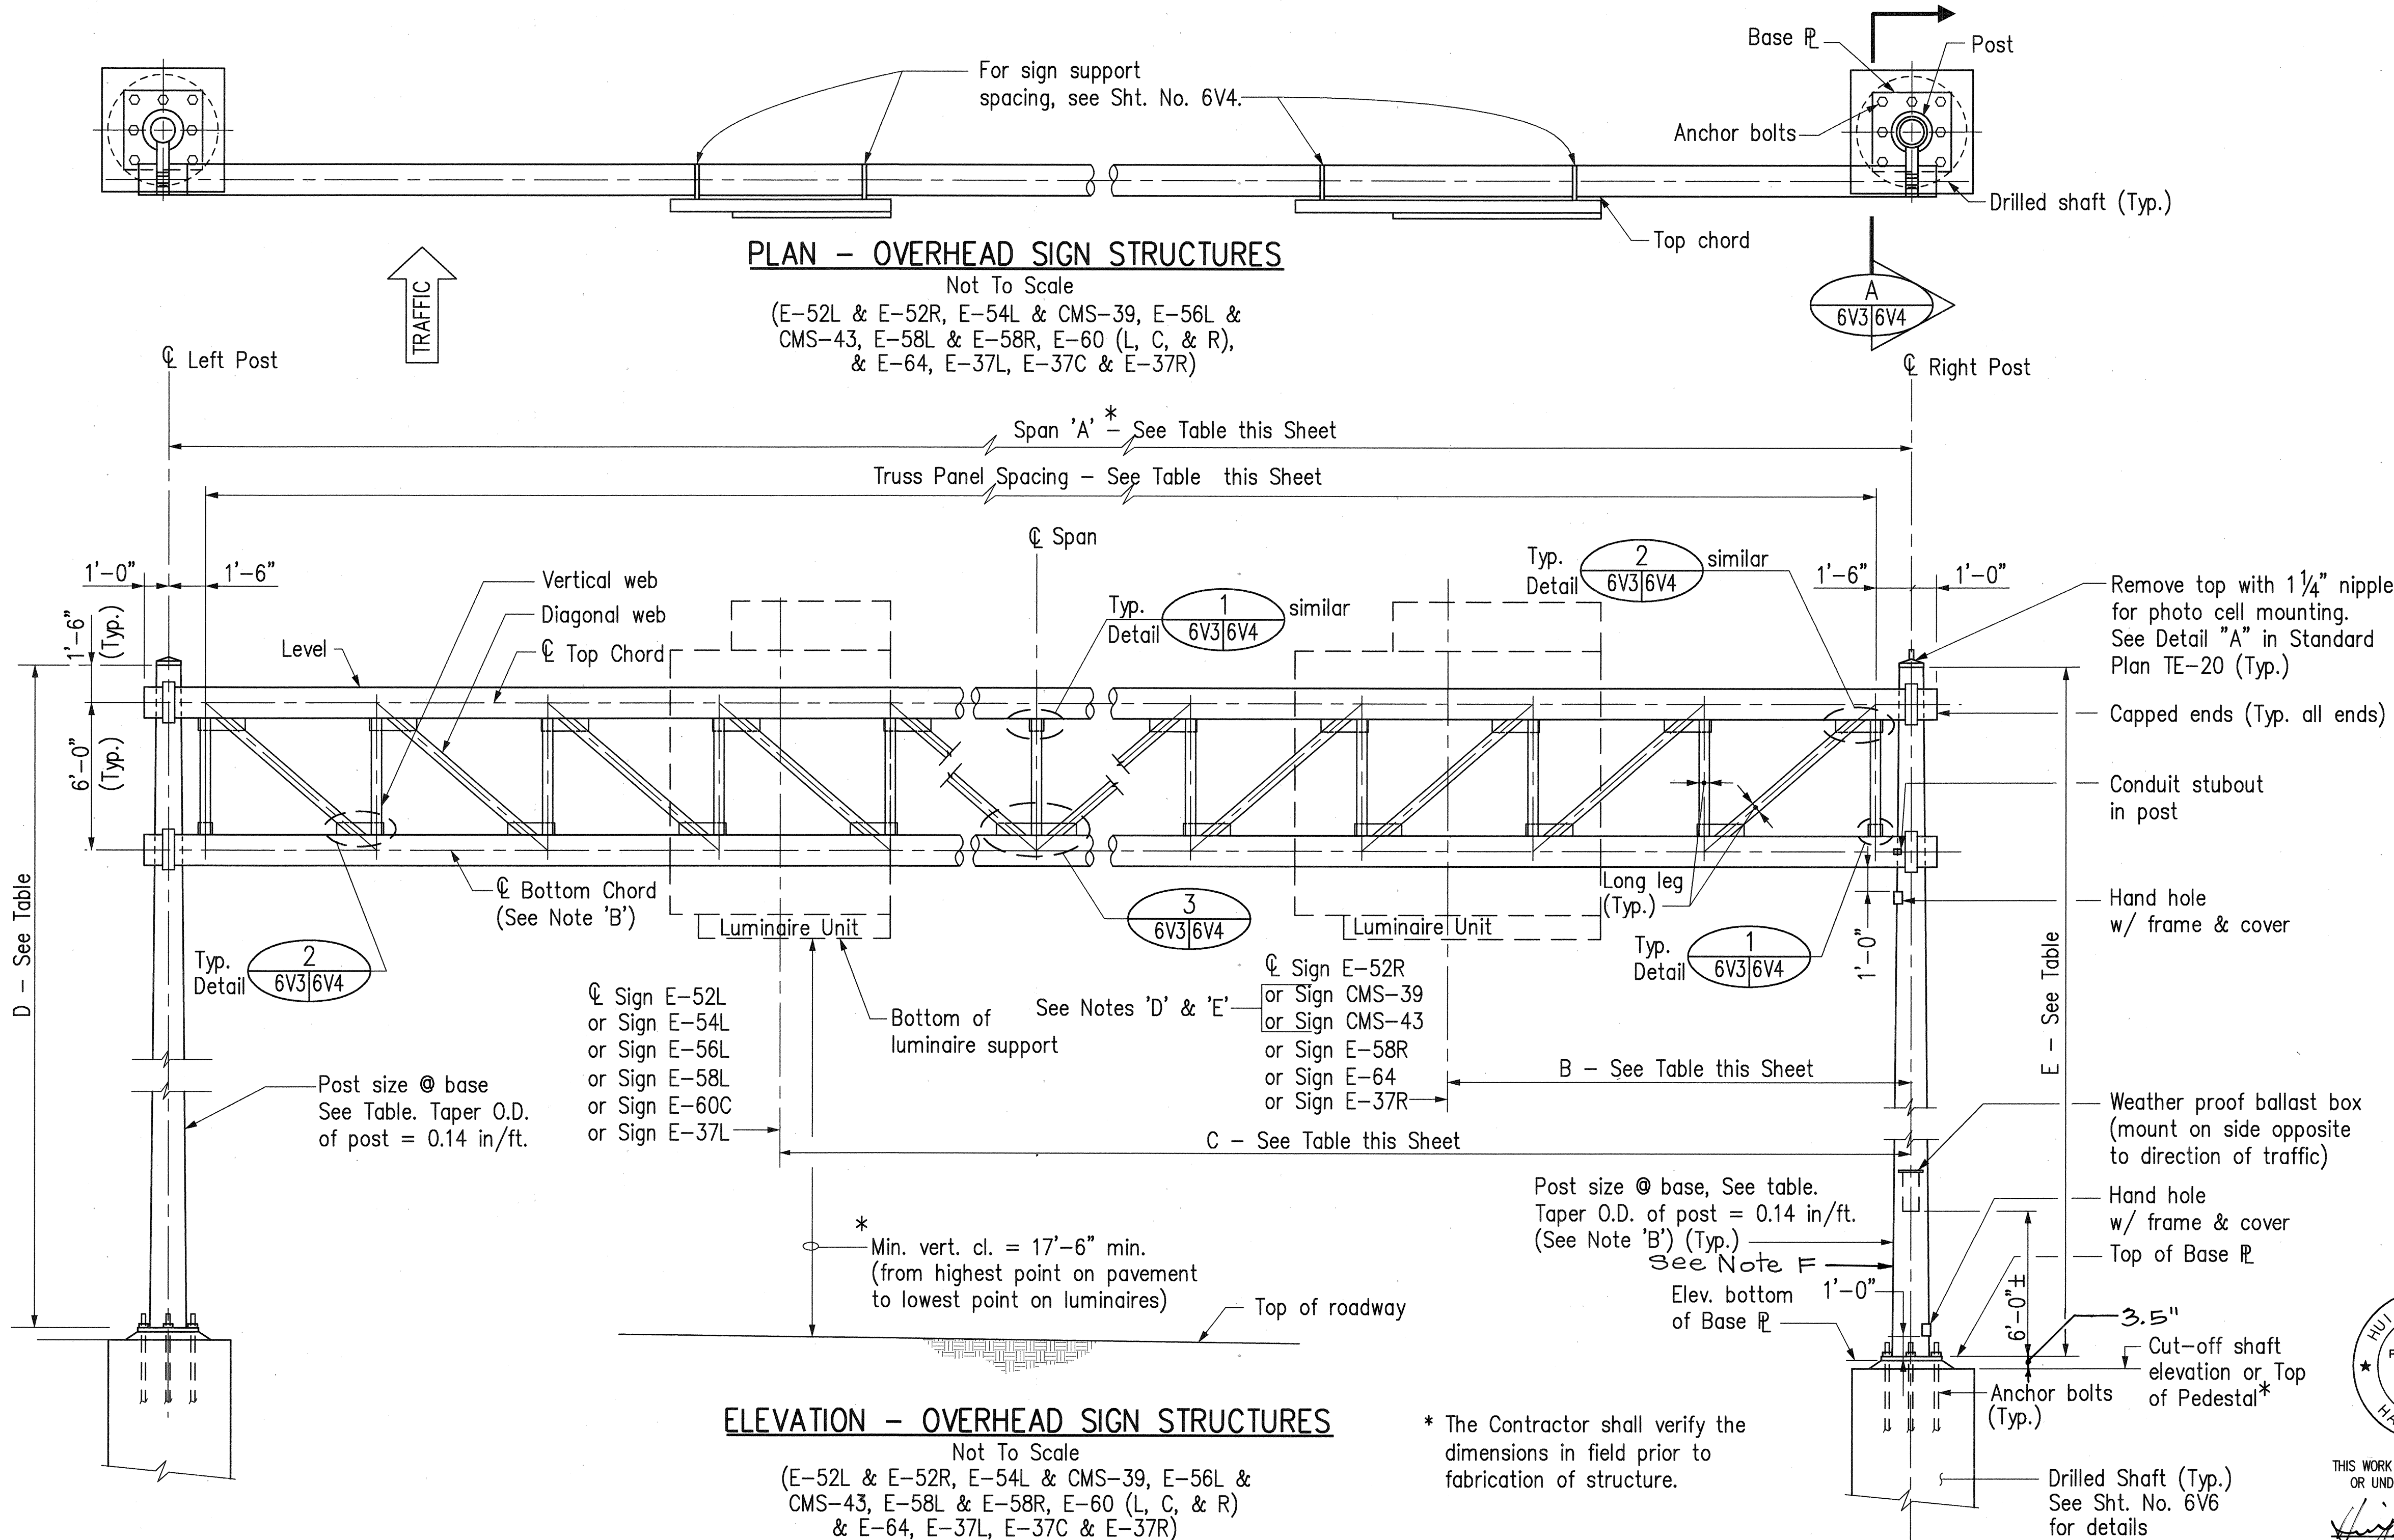

- NOTES:
- A. The dead load deflection includes the effect of the weight of the truss. A camber shall be provided to accommodate this deflection.
 - B. Provide conduit stubouts in bottom chord for luminaire wiring as required. At these locations, place handholes on bottom side of chord 1'-0" from hole.
 - C. For sign structure notes, see Sht. No. 6V1.
 - D. CMS 39 and CMS 43 sign panels are State-Furnished. For assembly and mounting details, see Sht. No. SY-98.
 - E. The Contractor shall furnish and install mounting brackets as shown on Sht. No. 6V5 for CMS 39 and CMS43.
 - F. Sign Structures E-37, E-52, E-54, E-56, E-58, E-60 are supported by straight Poles.
 - G. The Inbound Drilled Shaft location is to be moved 2.5' from Plan Location towards the PCC.


10/10/97	Revised Table for Sign Structure E-60 (L,C,R) & E-64, E-37(L,C,R). Revised Shaft Cut-off on Elevation
4/21/97	Revised Table, Added Sign E-37L, E-37C & E-37R
Date	Revision
STATE OF HAWAII DEPARTMENT OF TRANSPORTATION HIGHWAYS DIVISION DESTINATION SIGNS SIGN STRUCTURES OVERHEAD TYPE H-3 FINISH (UNIT II) FAIP NO. I-H3-1(75), UNIT II LEEWARD SECTION SCALE: AS SHOWN DATE: JANUARY 1997 SHEET NO. 6V3 OF 14 SHEETS	

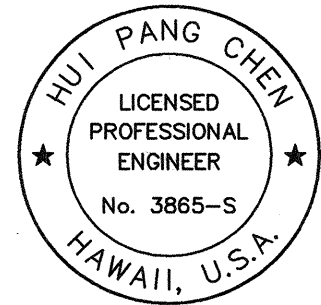


THIS WORK WAS PREPARED BY ME
OR UNDER MY SUPERVISION.
Hui Pang Chen

C.O. ADD. 873


FED. ROAD DIST. NO.	STATE	FED. AID PROJ. NO.	FISCAL YEAR	SHEET NO.	TOTAL SHEETS
HAWAII	HAW.	I-H3-1(75), UNIT II	1997	874	1102

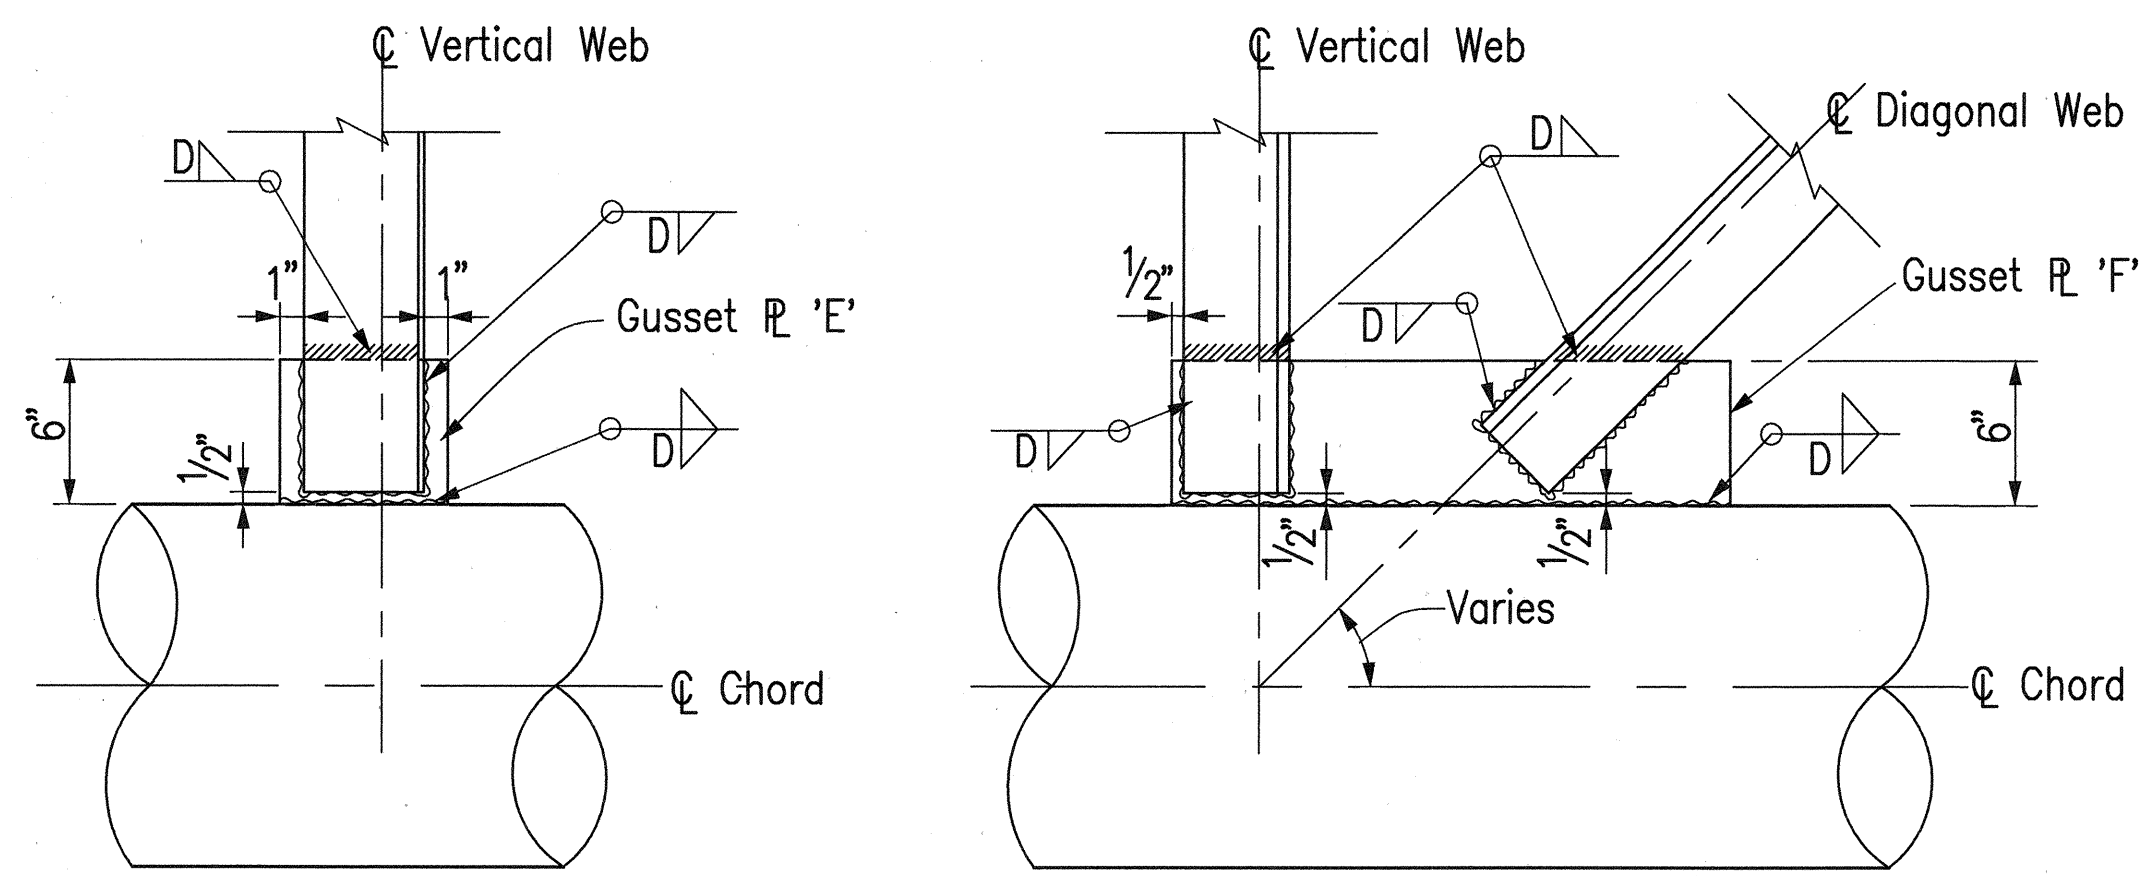


DETAIL 1
Not To Scale 6V2, 6V3, 6V4

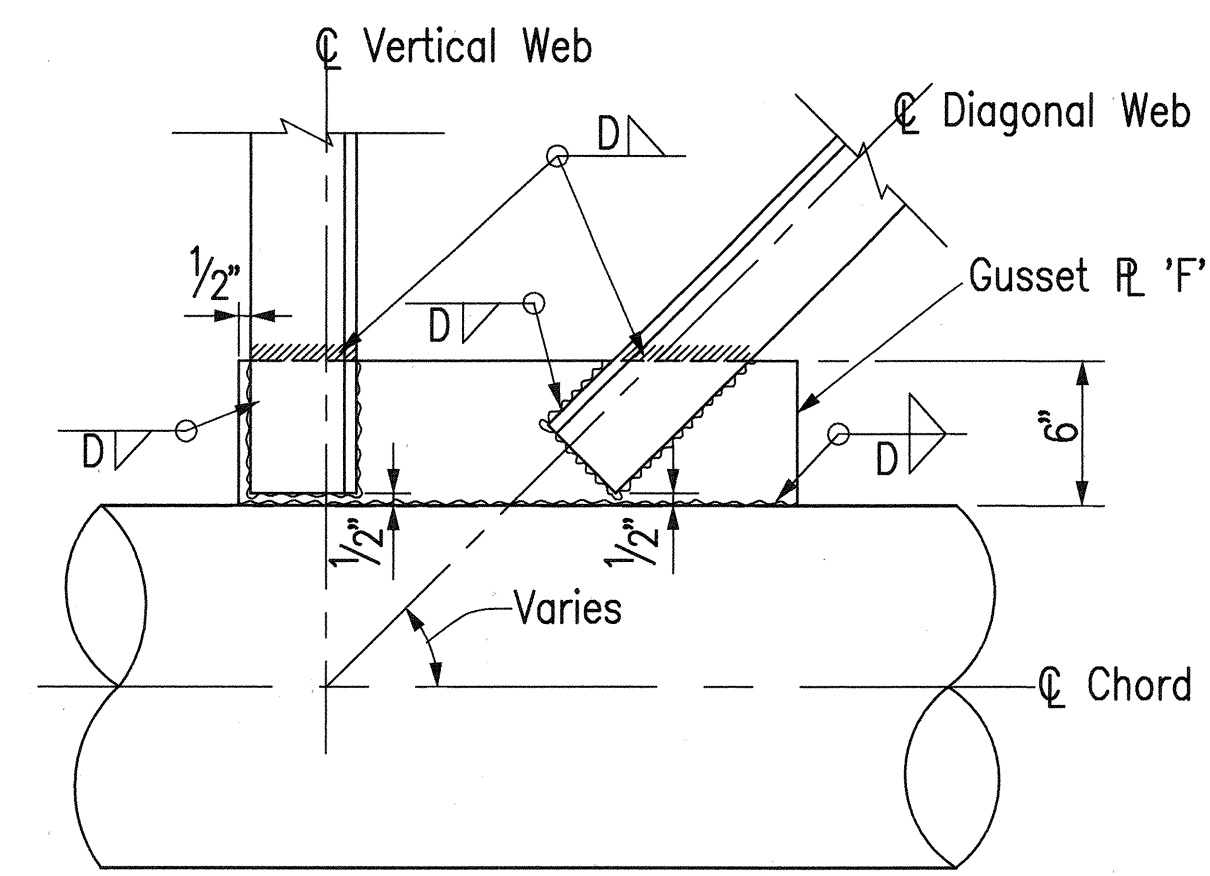


DETAIL 2
Not To Scale 6V2, 6V3, 6V4

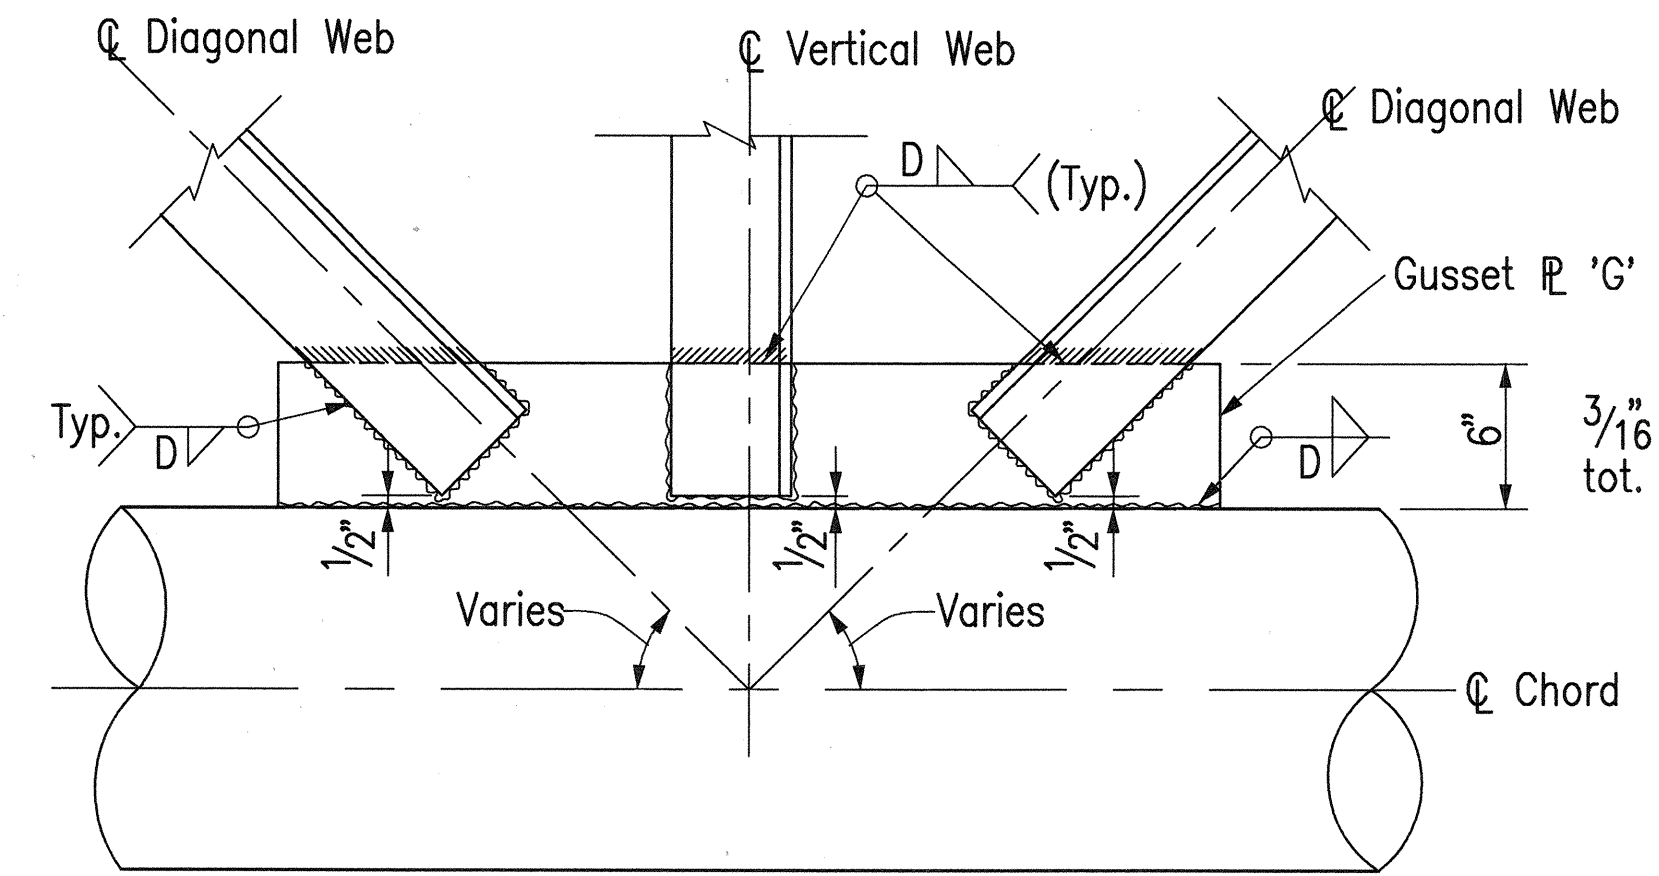

DETAIL 3
Not To Scale 6V2, 6V3, 6V4

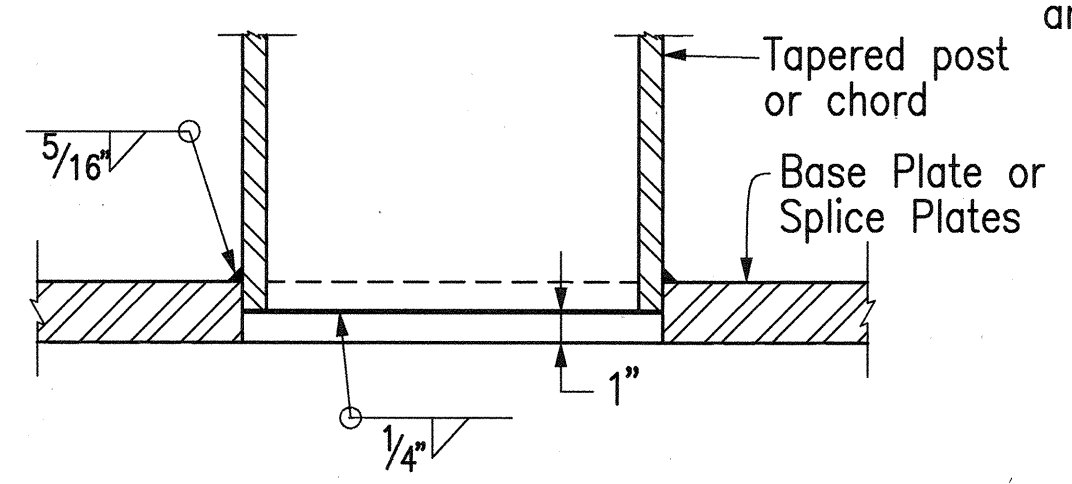


POST TO BASE PLATE & SPLICE WELDING DETAIL
Not To Scale

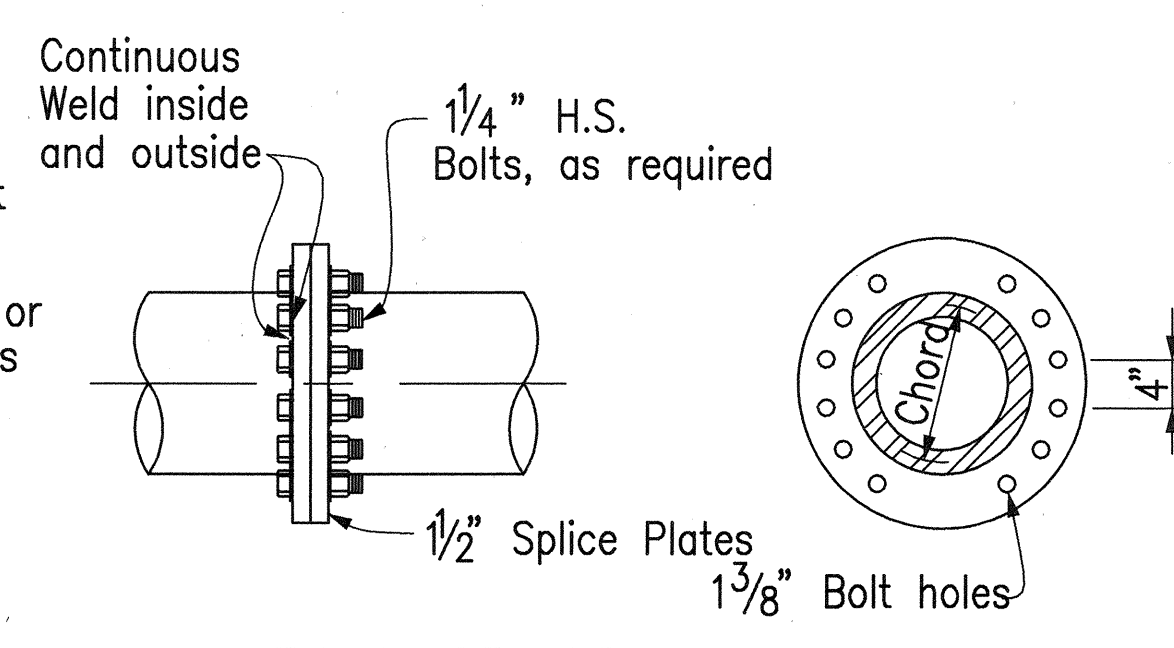


FIELD SPLICE DETAIL
Not To Scale

NOTE:
Field splice or Shop splice located at top & bottom chords of each truss shall be staggered and at alternating locations. Indicate splice locations on shop fabrication drawings for approval. In no case shall splices be located at midspan of the truss.

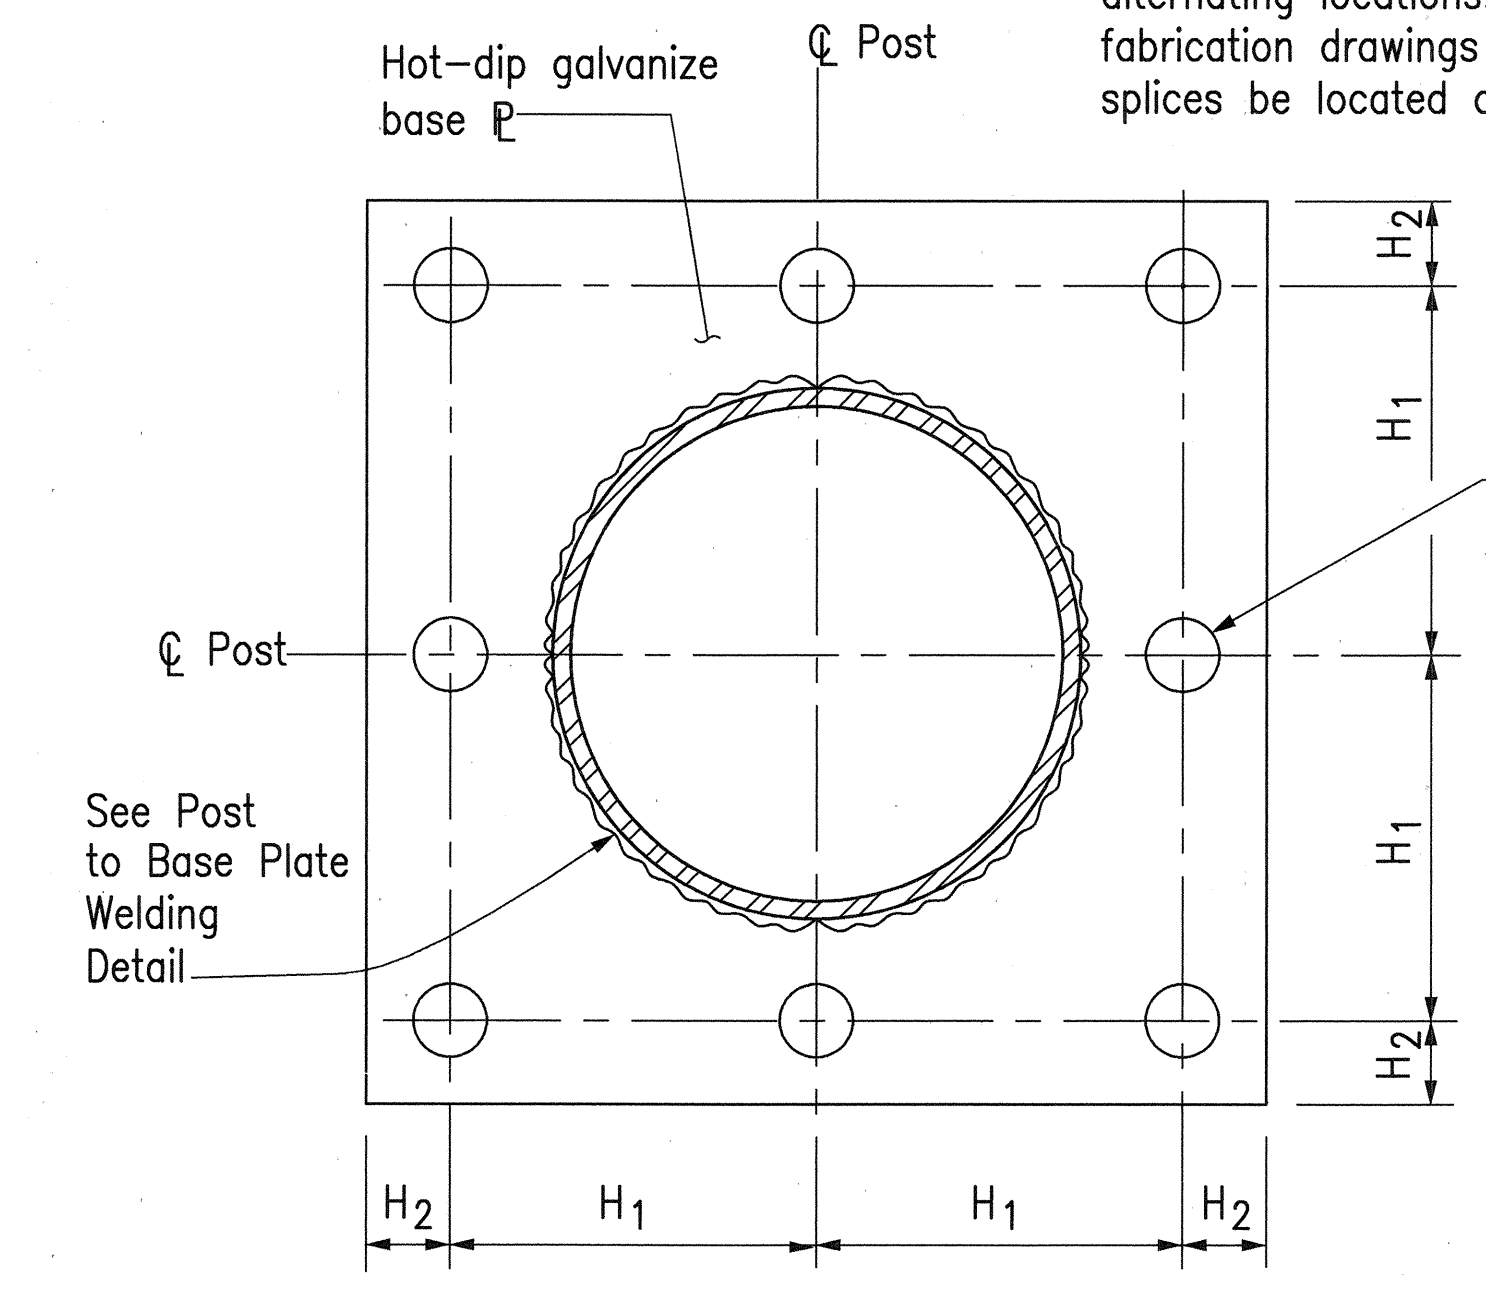


BASE PLATE DETAILS
Not To Scale

NOTE:
The Contractor shall verify the locations of the anchor bolts prior to fabrication of base plate.

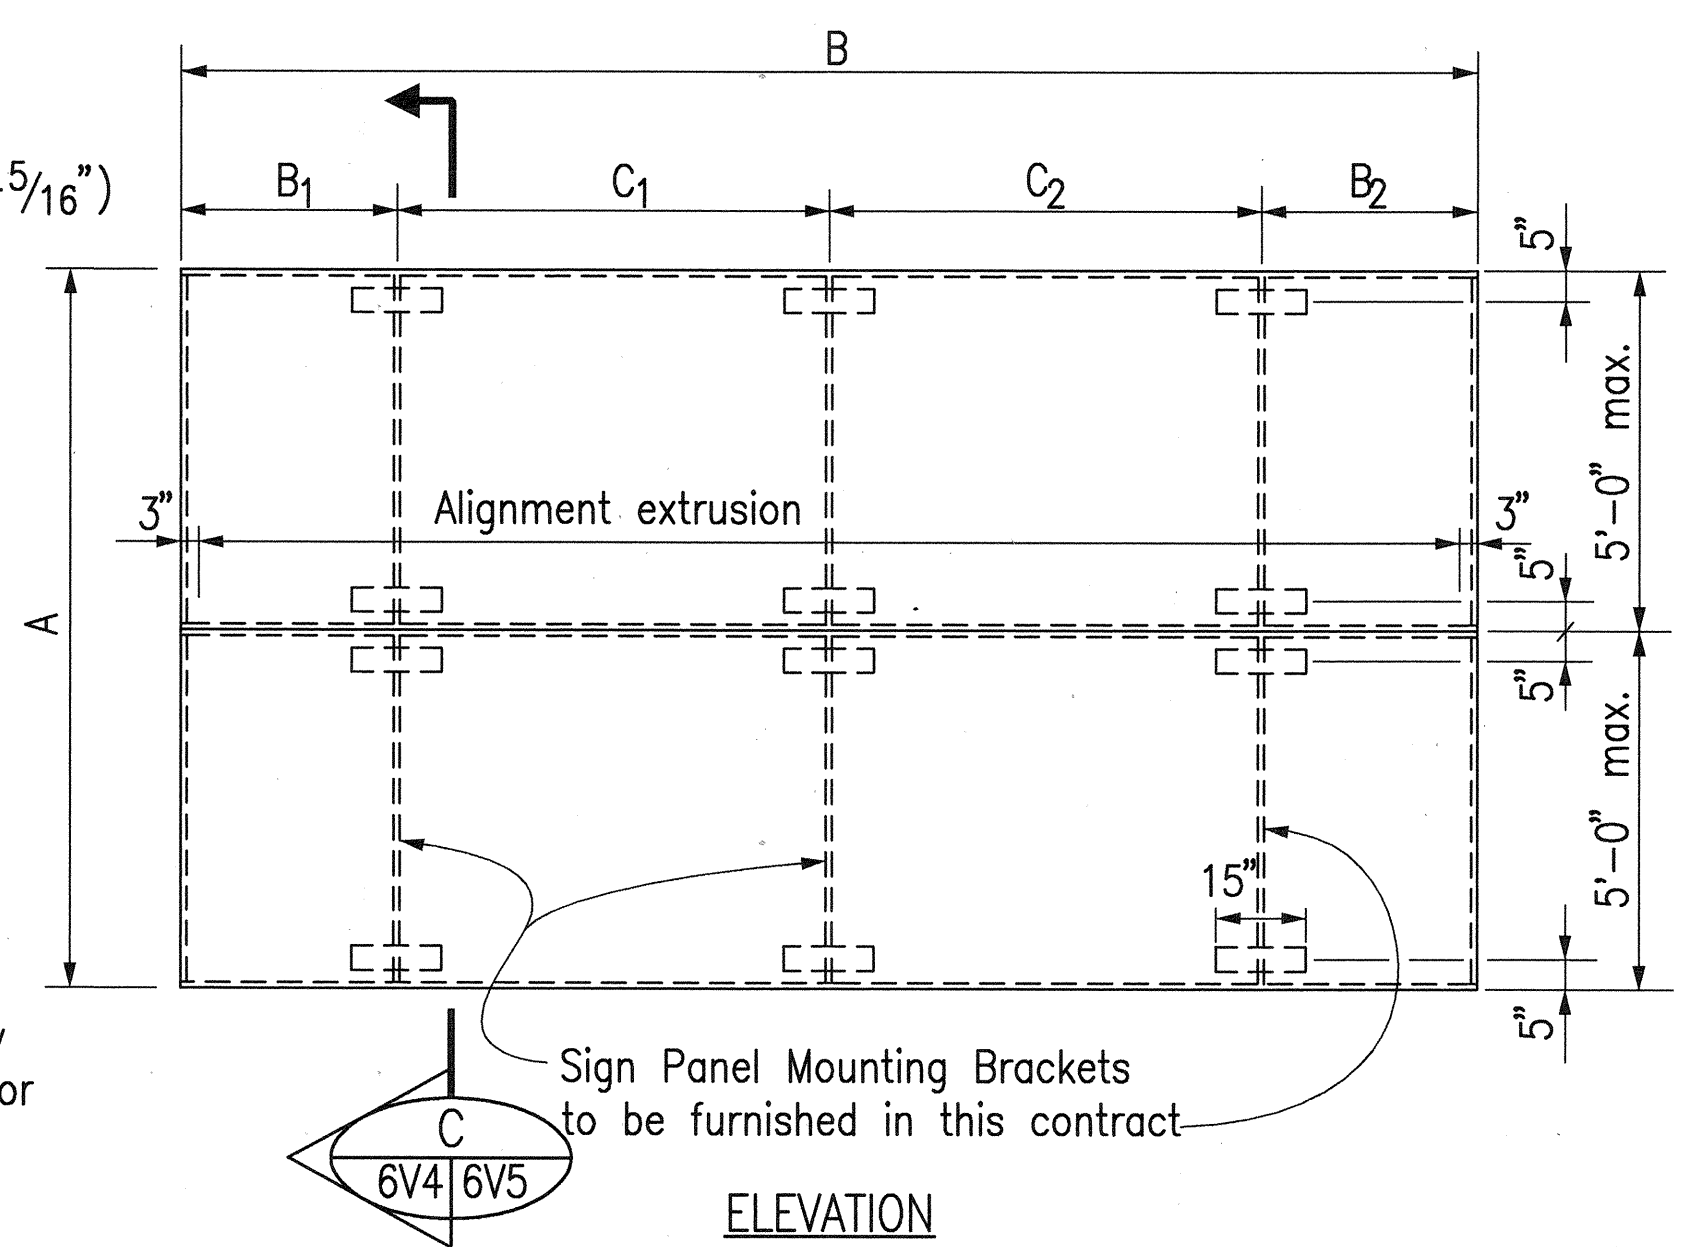

TYPICAL FIXED MESSAGE SIGN (FMS) ASSEMBLY
Not To Scale
(For Sign Panel Assembly Detail, see Standard Plan TE-25)

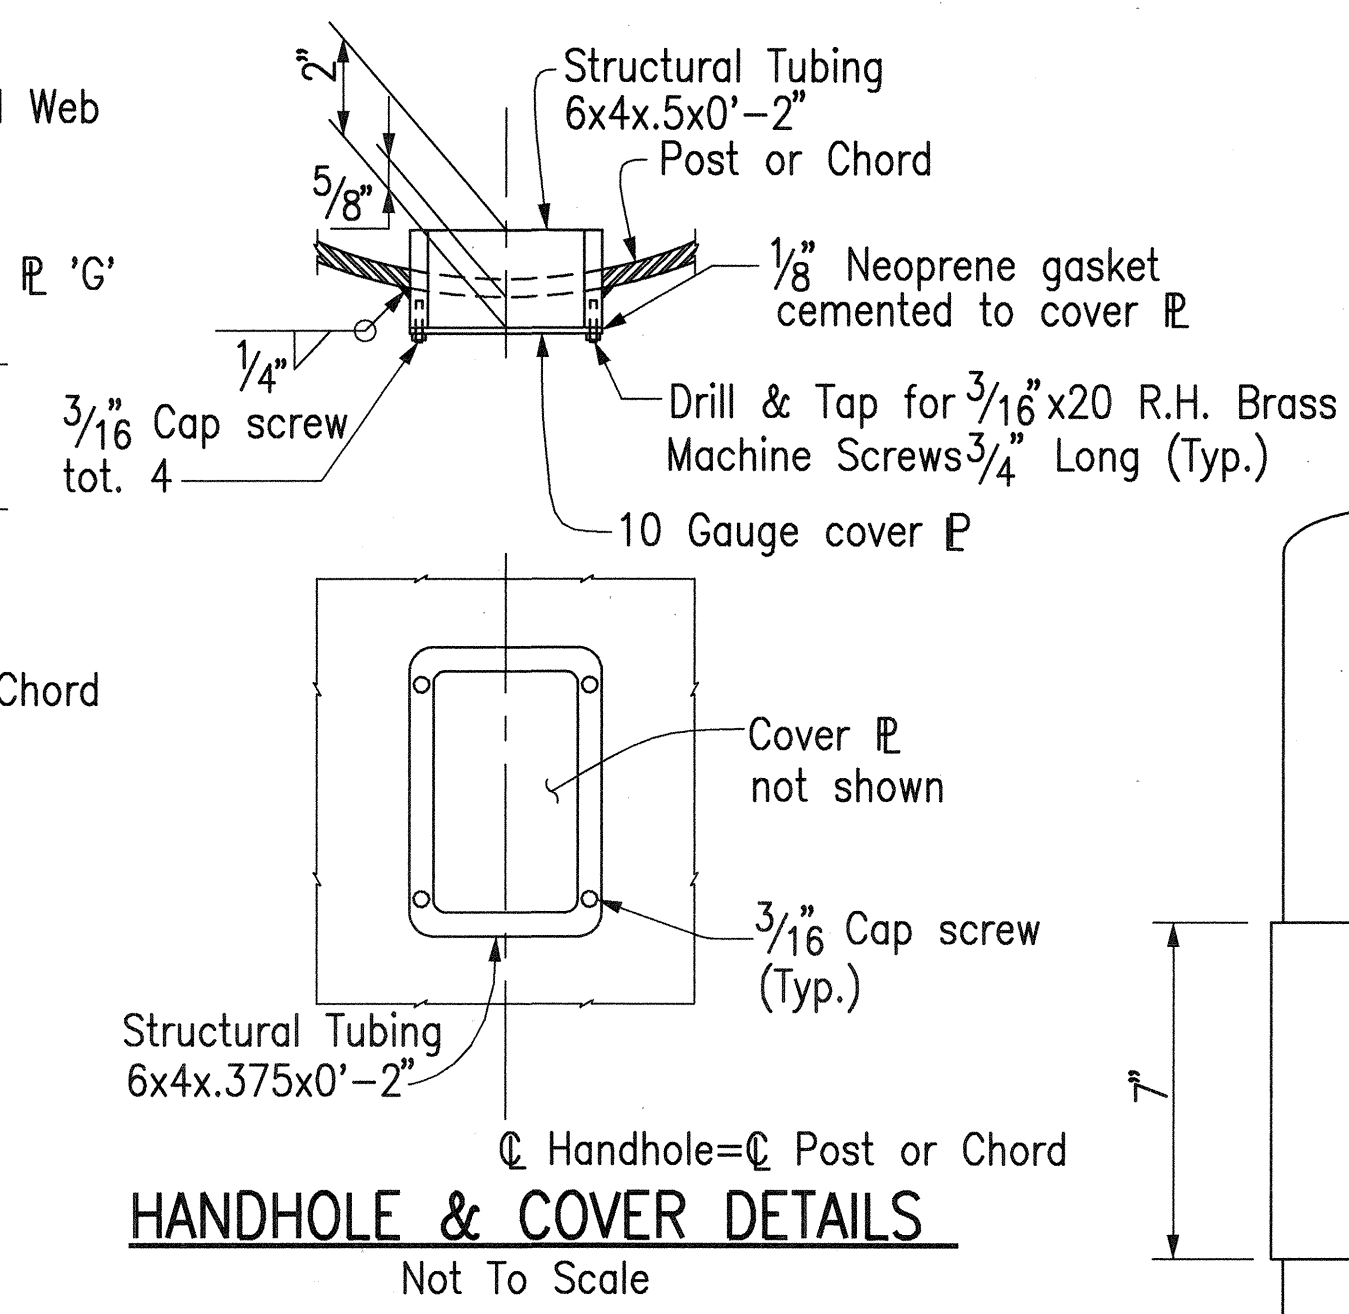


HANDHOLE & COVER DETAILS
Not To Scale

SIGN STRUCTURE	GUSSET PLATE				BASE PLATE			
	Weld 'D'	'E'	'F'	'G'	ANCHOR BOLT Ø	PLATE	H ₁	H ₂
CMS-44	1/4"	1/2" x 6" x 0'-6"	1/2" x 6" x 2'-3"	-	2"	2" x 35" x 2'-11"	1'-2 1/2"	3"
E-52L & E-52R	1/4"	1/2" x 6" x 0'-7"	1/2" x 6" x 2'-3"	1/2" x 6" x 3'-10"	1 3/4"	1 3/4" x 31" x 2'-7"	1'-0 1/2"	3"
E-54L & CMS-39	1/4"	1/2" x 6" x 0'-7"	1/2" x 6" x 2'-0"	1/2" x 6" x 3'-3"	2"	2 1/4" x 41" x 3'-5"	1'-5 1/2"	3"
E-56L & CMS-43	1/4"	1/2" x 6" x 0'-7"	1/2" x 6" x 2'-0"	1/2" x 6" x 3'-3"	2"	2 1/4" x 41" x 3'-5"	1'-5 1/2"	3"
E-58L & E-58R	1/4"	1/2" x 6" x 0'-7"	1/2" x 6" x 2'-0"	1/2" x 6" x 2'-9"	2"	2 1/4" x 41" x 3'-5"	1'-5 1/2"	3"
E-60 (L, C, R) & E-64	1/4"	1/2" x 6" x 0'-7"	1/2" x 6" x 2'-0"	1/2" x 6" x 3'-3"	2"	2 1/4" x 41" x 3'-5"	1'-5 1/2"	3"
E-37L, E-37C & E-37R	1/4"	1/2" x 6" x 0'-7"	1/2" x 6" x 1'-9"	1/2" x 6" x 2'-9"	2"	2 1/4" x 31" x 2'-7"	1'-0 1/2"	3"

FMS SIGN SUPPORT SPACING

SIGN	A	B	B ₁	B ₂	C ₁	C ₂	Alum. Mounting Beam
E-52L	11'-6"	16'-0"	1'-9"	2'-3"	6'-9"	5'-3"	L 5x3x1/2
E-52R	8'-0"	15'-0"	2'-0"	1'-3"	5'-0"	6'-9"	L 6x3 1/2 x 1/2
E-54L	11'-0"	16'-0"	2'-6"	9"	6'-3"	6'-6"	L 6x3 1/2 x 1/2
E-56L	11'-0"	16'-0"	2'-6"	9"	6'-3"	6'-6"	L 6x3 1/2 x 1/2
E-58L	18'-0"	15'-6"	1'-9"	2'-0"	6'-0"	5'-9"	C 6x3x5.77
E-58R	11'-0"	16'-0"	2'-0"	1'-6"	6'-0"	6'-6"	L 6x3 1/2 x 1/2
E-60L	13'-6"	17'-0"	1'-3"	2'-0"	7'-3"	6'-6"	L 6x3 1/2 x 1/2
E-60C	11'-0"	12'-0"	3'-0"	2'-3"	---	---	L 6x3 1/2 x 1/2
E-60R	11'-0"	11'-0"	1'-9"	2'-6"	---	---	L 6x3 1/2 x 1/2
E-64	6'-6"	23'-6"	3'-0"	3'-0"	8'-9"	8'-9"	C 6x3x5.77
E-37L	15'-6"	16'-6"	2'-0"	2'-0"	6'-3"	6'-3"	C 6x3x5.77
E-37C	11'-0"	13'-6"	3'-0"	1'-9"	---	---	L 6x3 1/2 x 1/2
E-37R	8'-0"	15'-6"	2'-0"	2'-0"	5'-9"	5'-9"	L 6x3 1/2 x 1/2

10/10/97	Revised Base plate for Sign Structures E-52(L&R), E-37(L,C,R). Revised Table for FMS Sign Support Spacing.
4/21/97	Revised Table, Added Sign E-37L, E-37C & E-37R
Date	Revision

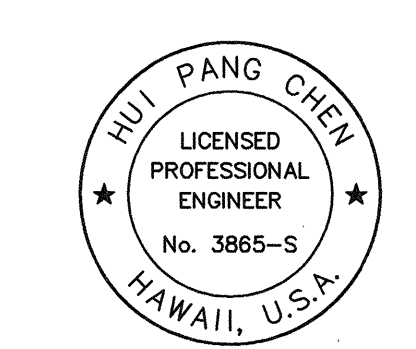

THIS WORK WAS PREPARED BY ME OR UNDER MY SUPERVISION.
Hui Pang Chen


STATE OF HAWAII
DEPARTMENT OF TRANSPORTATION
HIGHWAYS DIVISION

**DESTINATION SIGNS
SIGN STRUCTURES
CONNECTION DETAILS - 1**


H-3 FINISH (UNIT II)
FAIP NO. I-H3-1(75), UNIT II
LEEWARD SECTION

SCALE: AS SHOWN DATE: JANUARY 1997
SHEET NO. 6V4 OF 14 SHEETS


FED. ROAD DIST. NO.	STATE	FED. AID PROJ. NO.	FISCAL YEAR	SHEET NO.	TOTAL SHEETS
HAWAII	HAW.	I-H3-1(75), UNIT II	1997	875	1102

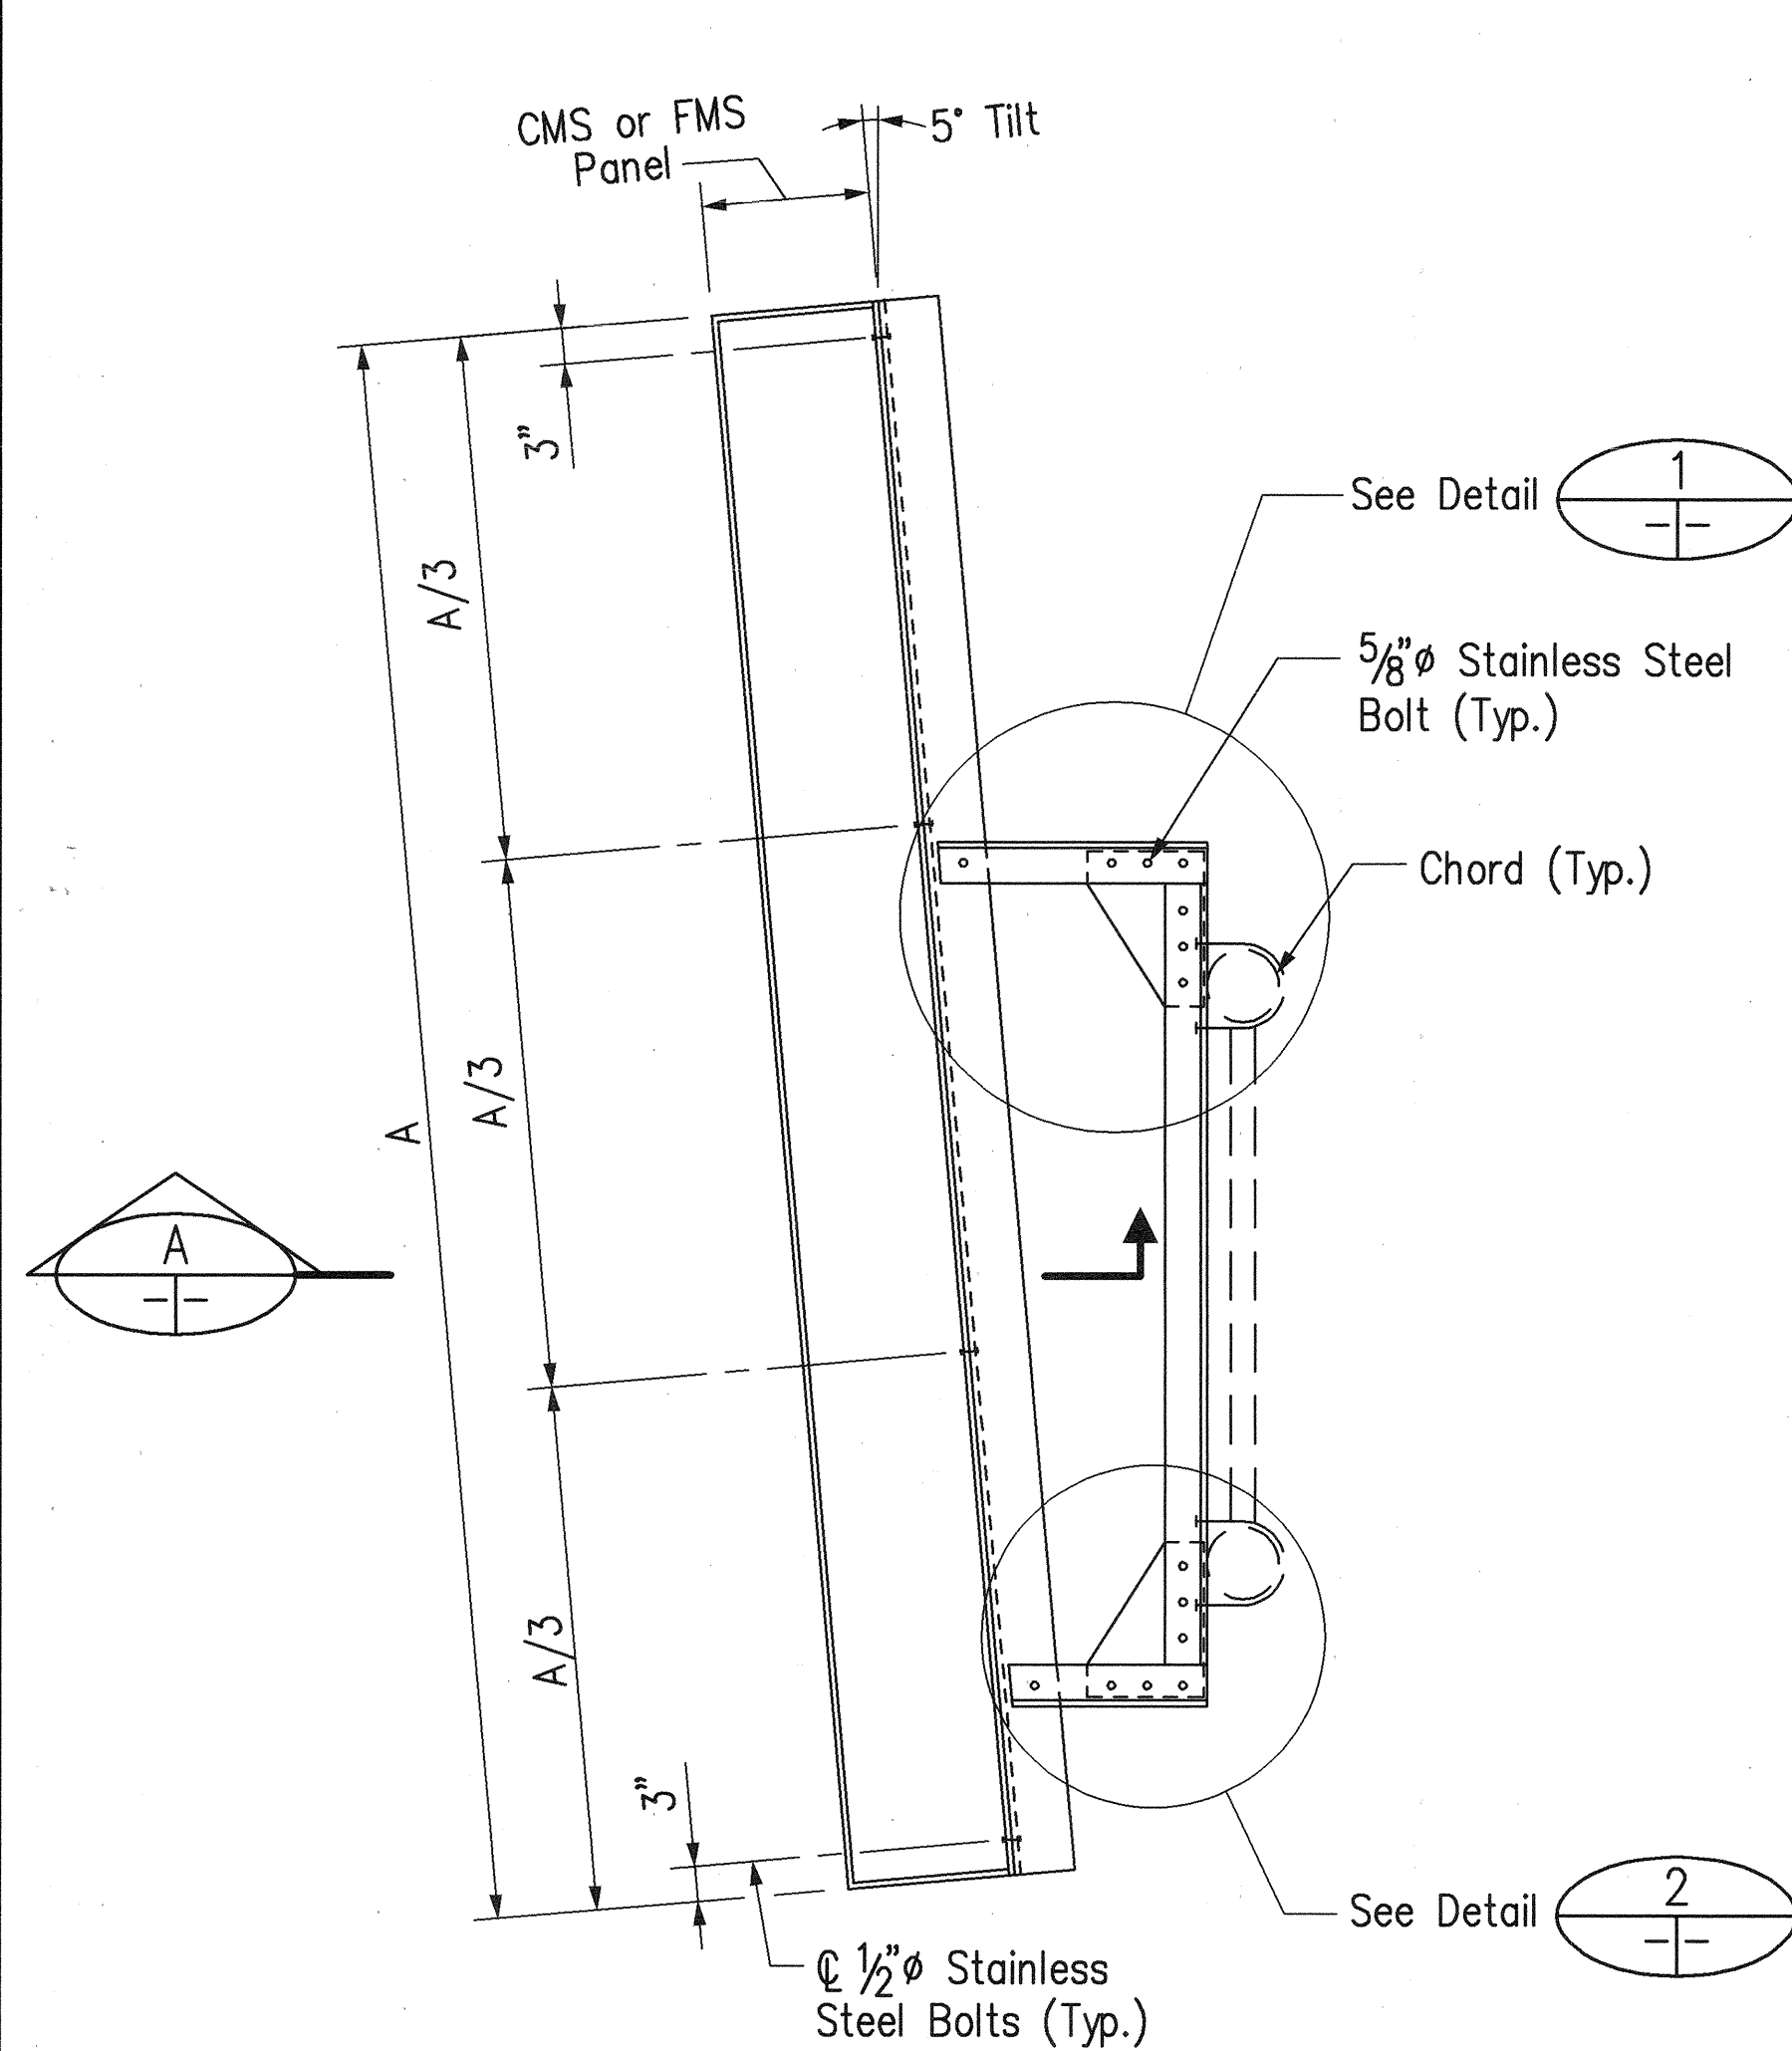


MOUNTING BRACKET DETAIL C
Not To Scale 6V2,6V4,6V5 | 6V5

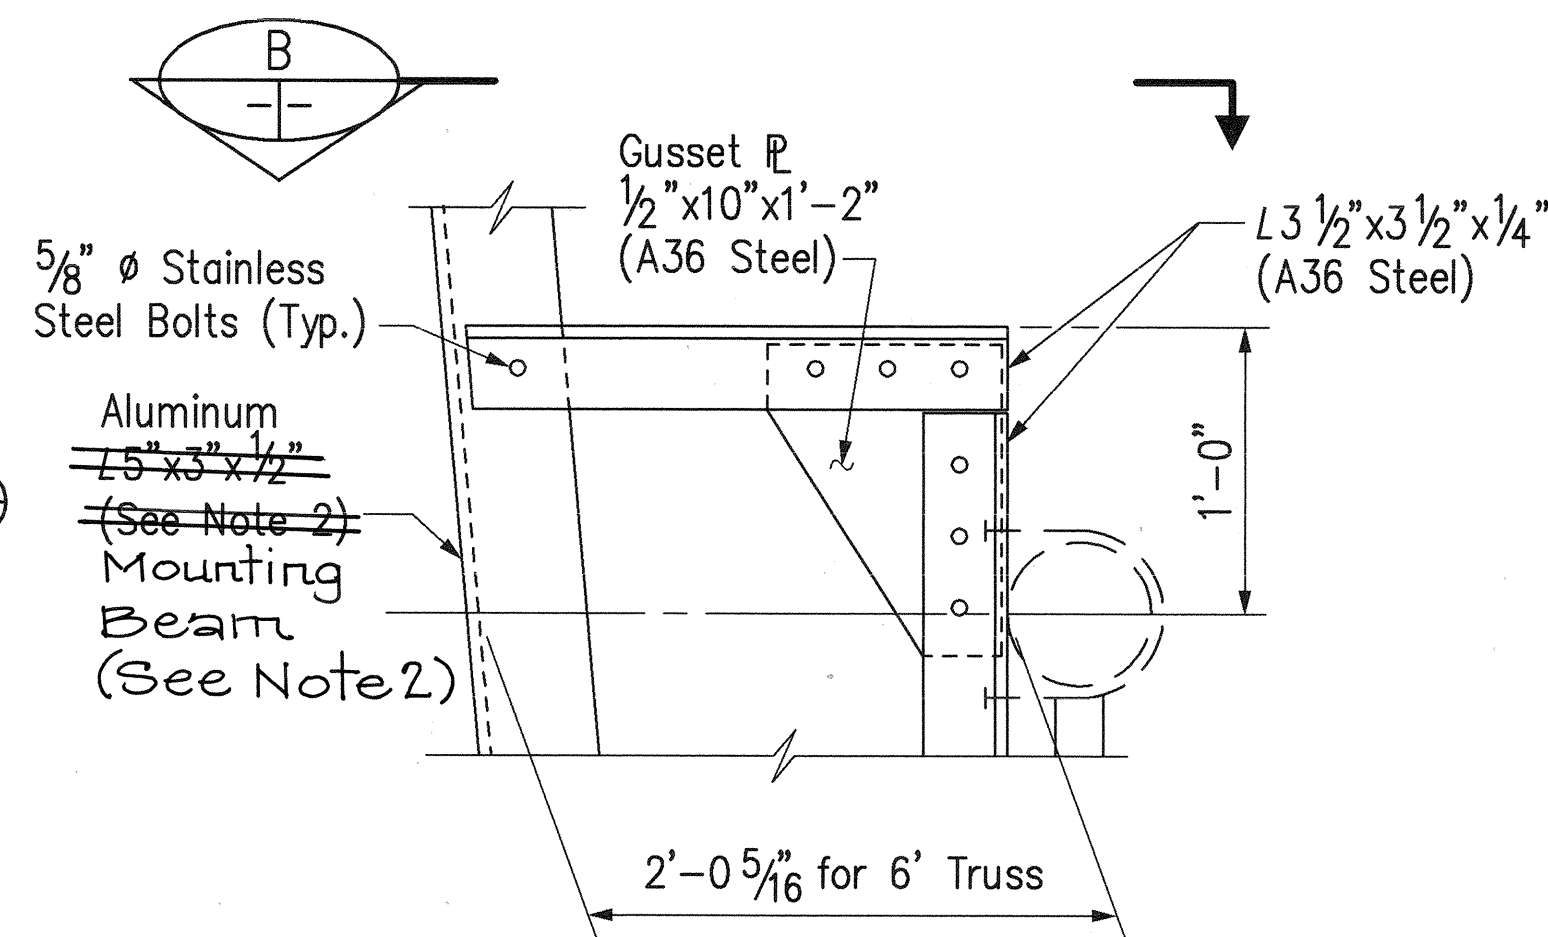


DETAIL 1
Not To Scale

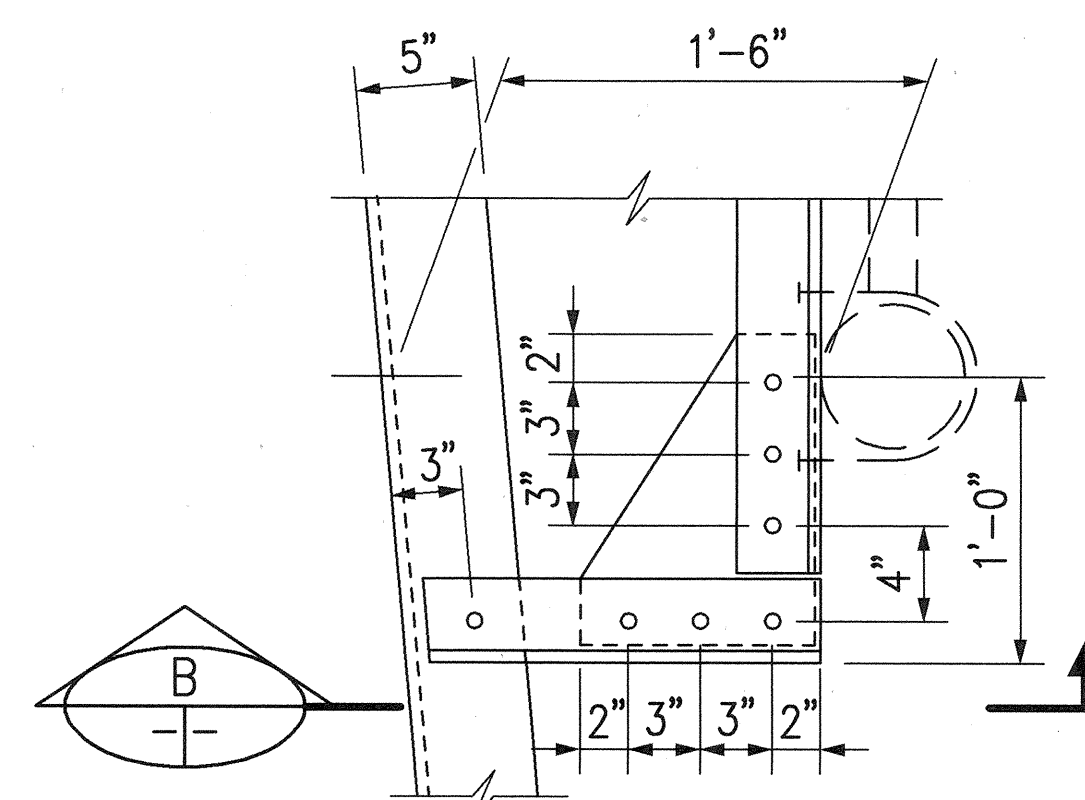

DETAIL 2
Not To Scale

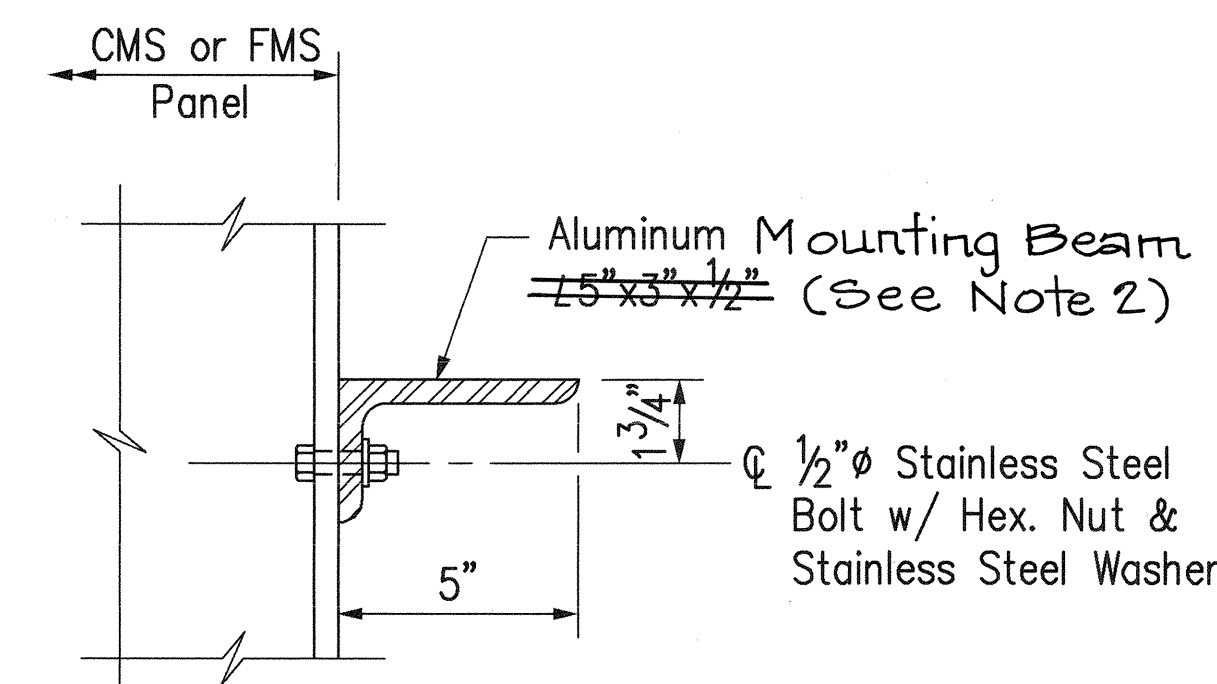


SECTION A
Scale: 3" = 1'-0" 6V5,6V8 | 6V5

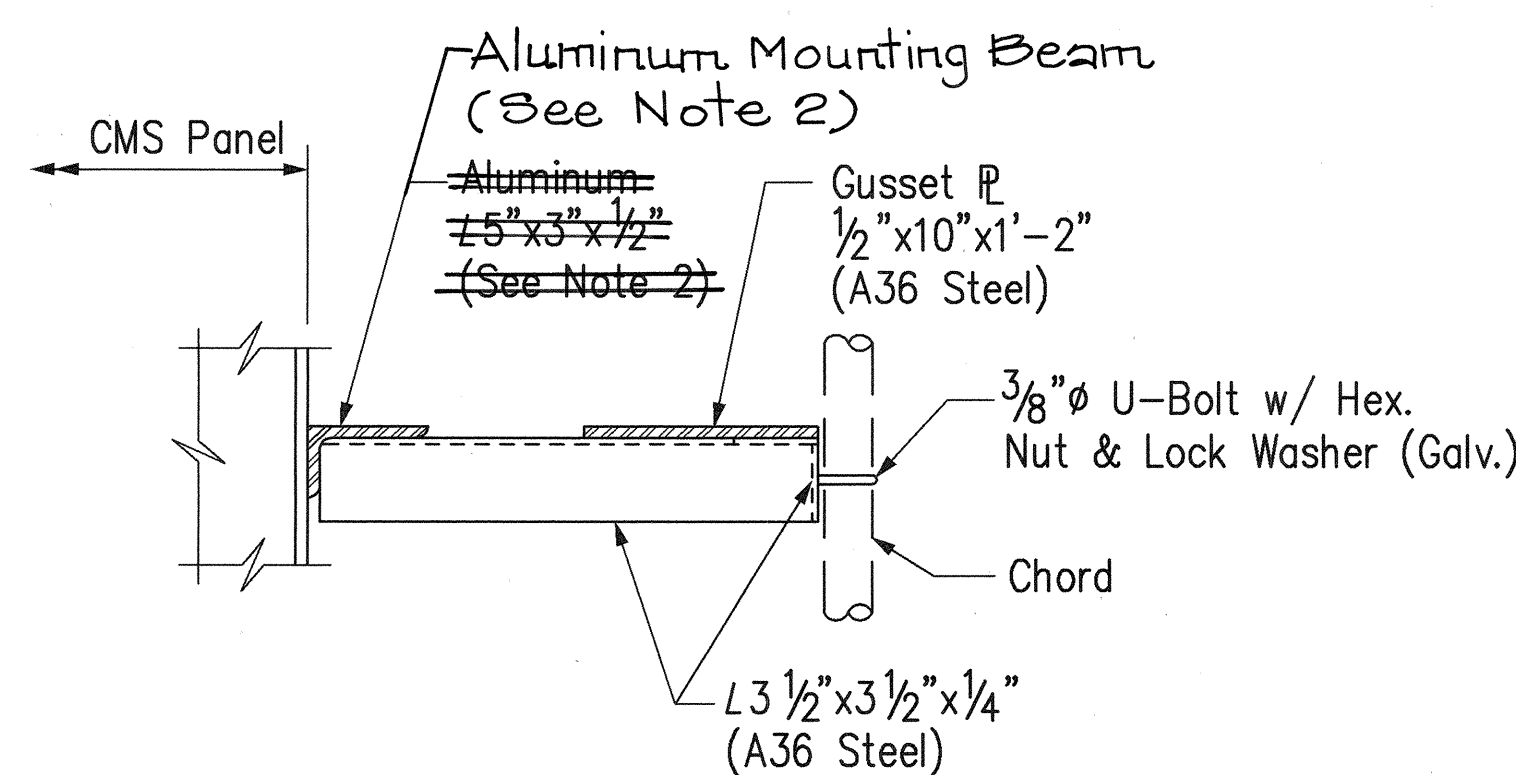


SECTION B
Not To Scale

NOTES:


- The dimensions for height of existing truss and locations of CMS panel mounting brackets shall be verified in field prior to fabrication of CMS panel and mounting bracket.
- Contact surface between structural steel and aluminum shall be separated with min. 1/16" thick neoprene gasket.
- The 1/8" x 4" x 1/2" light blocking member shall prevent sign luminaires from illuminating the changeable message matrix modules while allowing the illumination of the fixed message portion of the sign. Location 'X' shall be determined after the changeable message sign and sign luminaires have been installed and are in operating condition. The 1/8" x 4" x 1/2" light blocking member shall be adjusted in the field to determine location 'X' in the presence of the Engineer. Field adjustments shall occur at night while both luminaires and changeable message signs are illuminated. Scheduling of field adjustments of light blocking member shall be coordinated with the Electrical Contractor to simultaneously adjust the luminaires. Location 'X' is subject to approval by the Engineer.
- Drill 7/8" ϕ hole on the gusset plate while conflicting with U-Bolt.

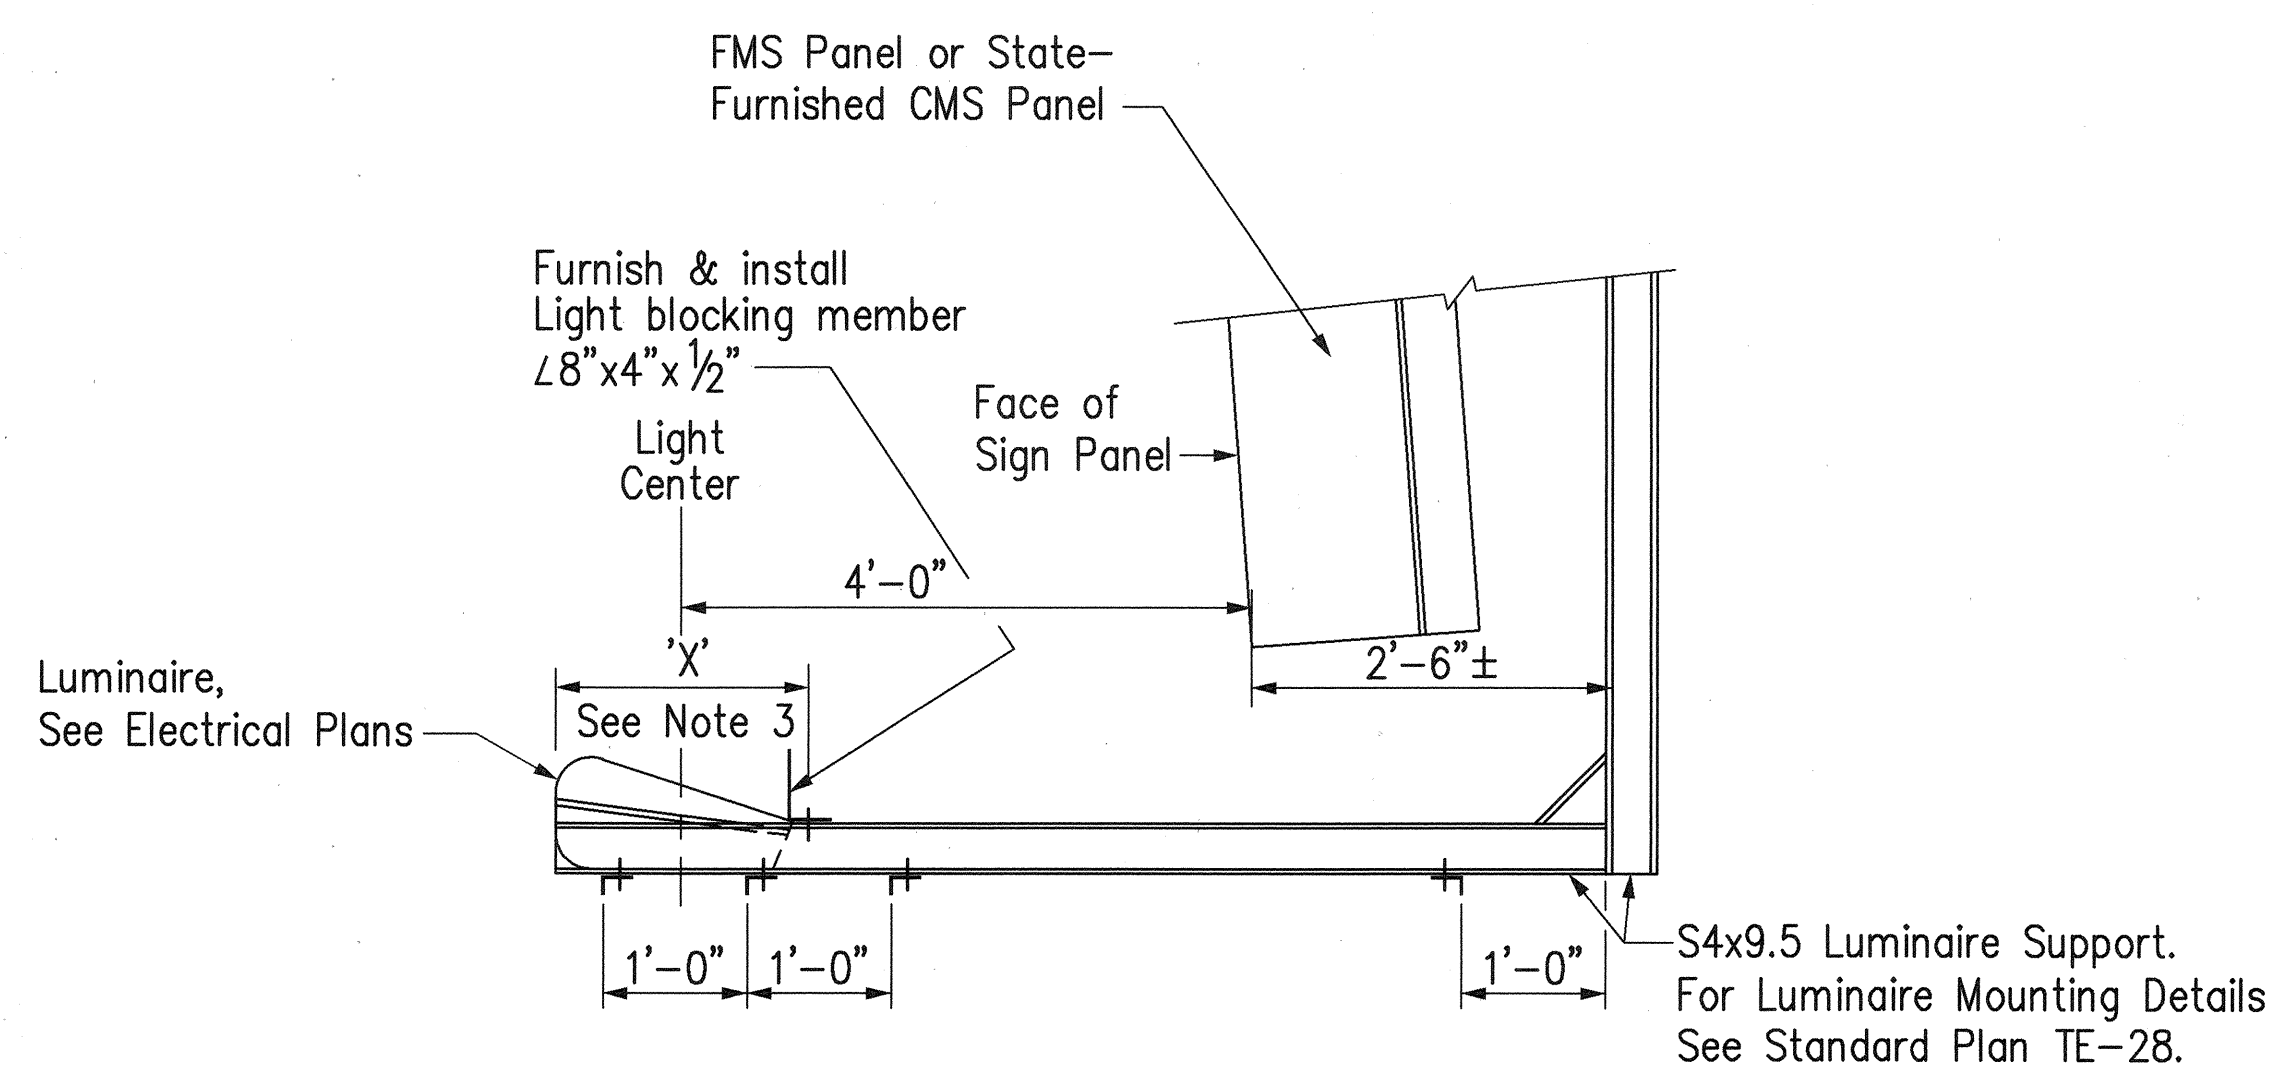

LUMINAIRE MOUNTING
Scale: 3/4" = 1'-0"

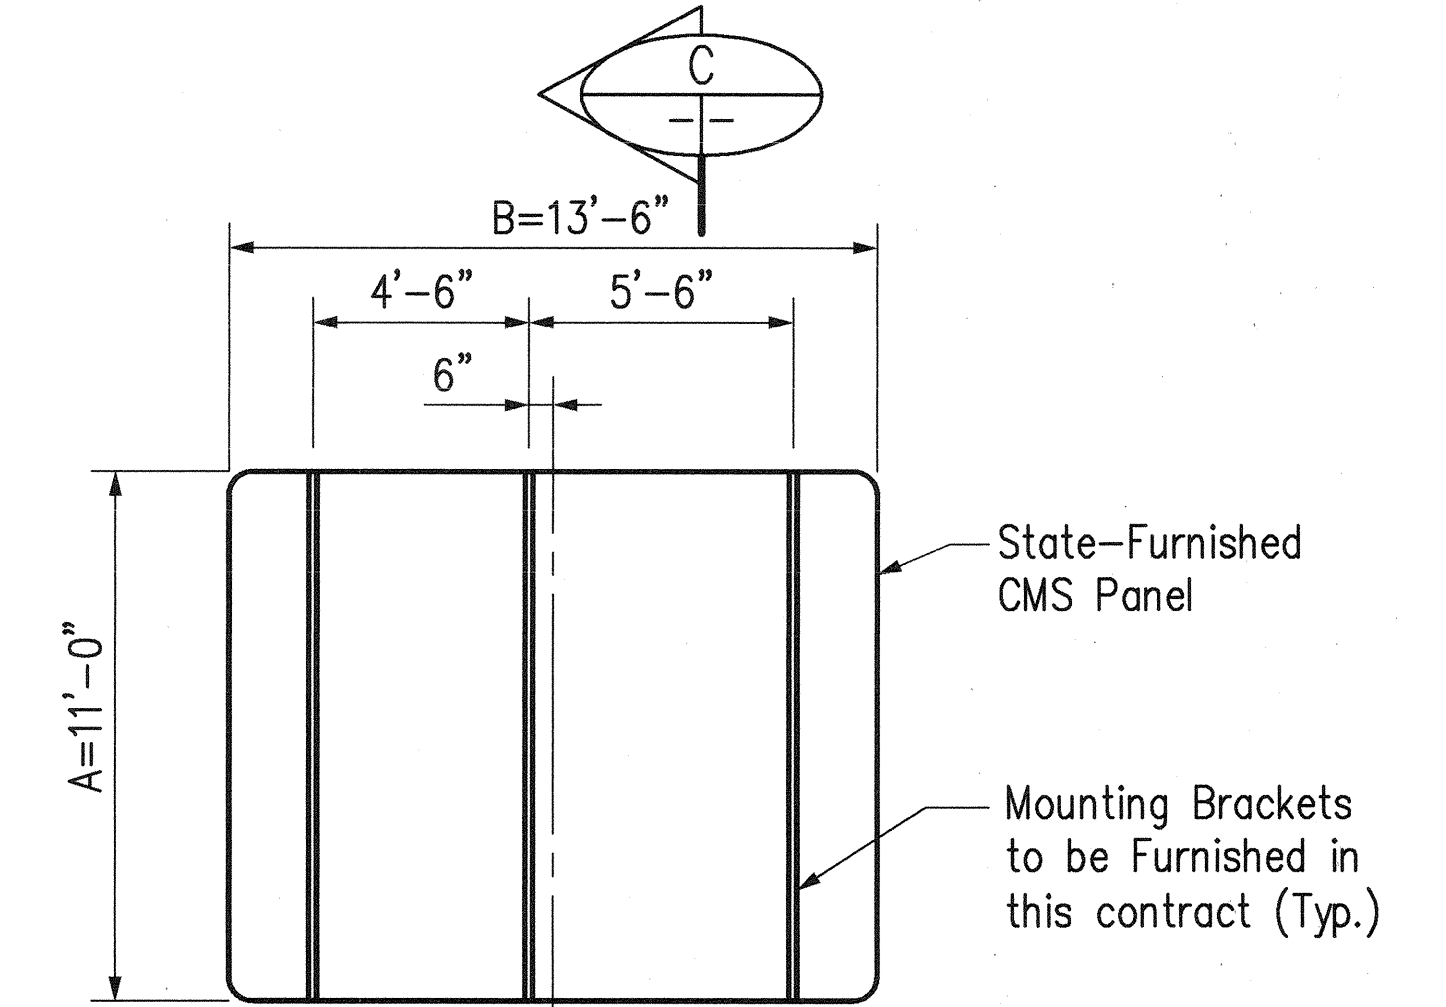


Q CMS-39

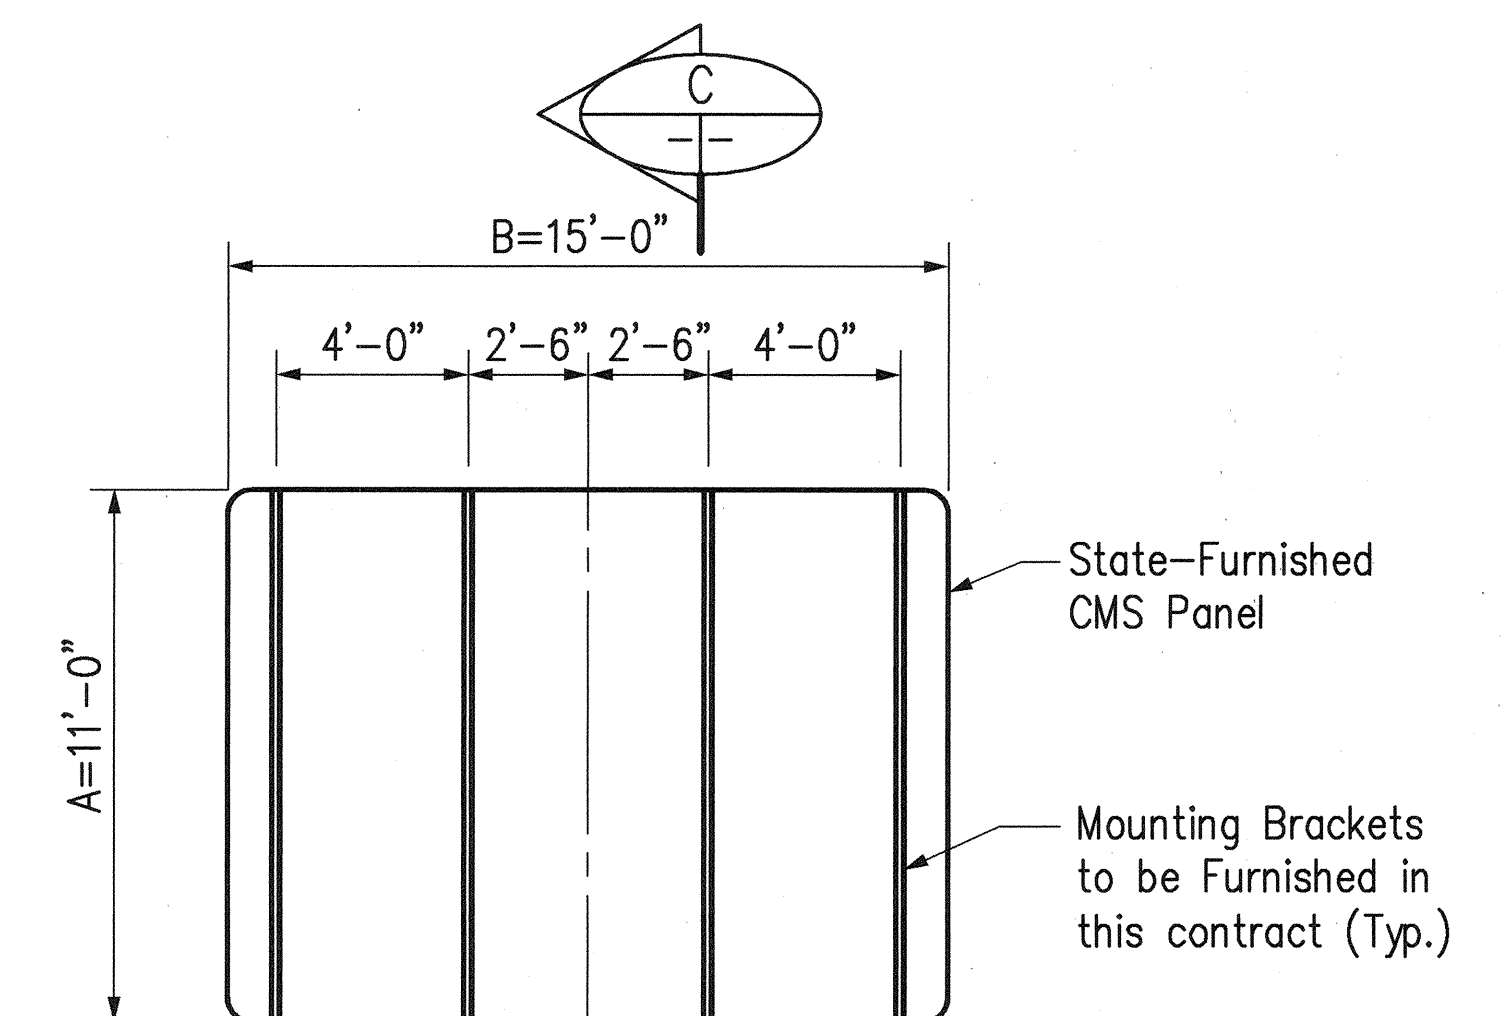

Q CMS-43

CMS SIGN SUPPORT SPACING
Not to Scale

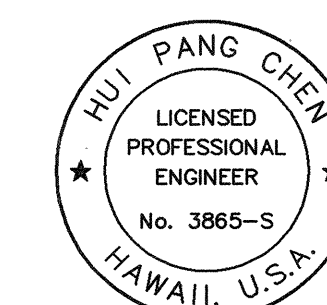

THIS WORK WAS PREPARED BY ME
OR UNDER MY SUPERVISION.

Hui Pang Chen

STATE OF HAWAII
DEPARTMENT OF TRANSPORTATION
HIGHWAYS DIVISION

**DESTINATION SIGNS
SIGN STRUCTURES
CONNECTION DETAILS - 2**

H-3 FINISH (UNIT II)
FAIP NO. I-H3-1(75), UNIT II
LEEWARD SECTION

SCALE: AS SHOWN DATE: JANUARY 1997
SHEET NO. 6V5 OF 14 SHEETS

FED. ROAD DIST. NO.	STATE	FED. AID PROJ. NO.	FISCAL YEAR	SHEET NO.	TOTAL SHEETS
HAWAII	HAW.	I-H3-1(75), UNIT II	1997	876	1102


NOTES:

- Centering devices shall be used to maintain the reinforcement cage in position within the shaft hole.
- Provide sizing hoops as a guide for the fabrication of the rebar cage.
- Provide temporary stiffeners to strengthen the rebar cage during lifting. Stiffeners are to be removed prior to pouring of concrete.
- Splices in the longitudinal steel, if required, should be staggered so as not to occur at the same horizontal plane along the rebar cage. The stagger shall be 1'-0" minimum.
- Use #6 circular spiral for rebar cage. Circular ties shall not be used in drilled shafts except otherwise noted.
- The rebar cage shall be fabricated and stored so as to avoid distortion during transportation to the job site and to avoid contamination with mud or other deleterious material.
- The spiral pitch may be opened wider at the location where the Conduit Stub-out is required in the Shaft. During the construction of the Shaft, the Contractor shall seal the end of the Conduit Stub-out and provide a device to identify its location in the Shaft for later Conduit connection. The conduit and conduit stub-out will be considered incidental to drilled shaft and will not be paid for separately.
- For installation of anchor bolts, the Contractor shall provide rigid templates at top and ties at bottom to maintain the anchor bolts in proper locations.
- The anchor bolts and Conduit shall be installed prior to pouring shaft concrete and shall be protected at all times during construction.
- Concrete for drilled shafts shall have a minimum 28 days compressive strength of 4500 PSI.
- All reinforcing steel shall be ASTM A615 Grade 60.
- For all drilled shafts, the Contractor shall provide a minimum 5'-0" long temporary casing to control the upper drilled hole size.
- For borings and locations, see Sht. Nos. 6H1 through 6H8.

SIGN STRUCTURE	@ LEFT POST			@ RIGHT POST		
	SHAFT TYPE	SHAFT LENGTH	SHAFT CUT-OFF ELEV.	SHAFT TYPE	SHAFT LENGTH	SHAFT CUT-OFF ELEV.
CMS-44	-	-	-	A	20'	-84.78-80.8
E-52L & E-52R	E*	20'	-134.87-133.73	A	20'	-130.79-128.5
E-54L & CMS-39	C	25'	-182.32-180.31	B	25'	-177.49-175.5
E-56L & CMS-43	C	20'	-226.22-226.5	B	20'	-229.82-227.26
E-58L & E-58R	C	30'	-91.00-87.0	B	30'	-83.06-80.3
E-60 (L, C, R) & E-64	B	25'	-161.39-160.89	B	25'	-157.34-153.67
E-37L, E-37C & E-37R	G*	25'	-60.81-56.55	F*	25'	-60.80-56.08

* See Sht. No. 6V7A









SIGN STRUCTURE	@ LEFT POST	@ RIGHT POST
	AS-BUILT TIP ELEV.	AS-BUILT TIP ELEV.
CMS-44	-	64.8
E-52L & E-52R	114.73	111.0
E-54L & CMS-39	155.81	152.5
E-56L & CMS-43	206.2	210.26
E-58L & E-58R	61.0	54.3
E-60L & E-60R	137.89	131.67
E-37L & E-37R	35.75	34.08

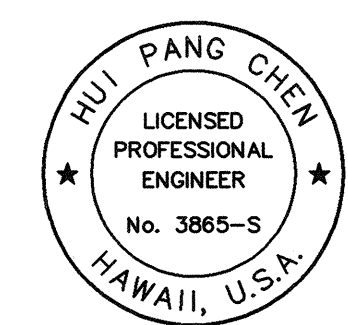

THIS WORK WAS PREPARED BY ME OR UNDER MY SUPERVISION.


Hui Pang Chen

4/21/97	Revised Table, Added Sign E-37L, E-37C & E-37R
Date	Revision
STATE OF HAWAII DEPARTMENT OF TRANSPORTATION HIGHWAYS DIVISION DESTINATION SIGNS SIGN STRUCTURES FOUNDATION DETAILS H-3 FINISH (UNIT II) FAIP NO. I-H3-1(75), UNIT II LEFTWARD SECTION SCALE: AS SHOWN DATE: JANUARY 1997 SHEET NO. 6V6 OF 14 SHEETS	

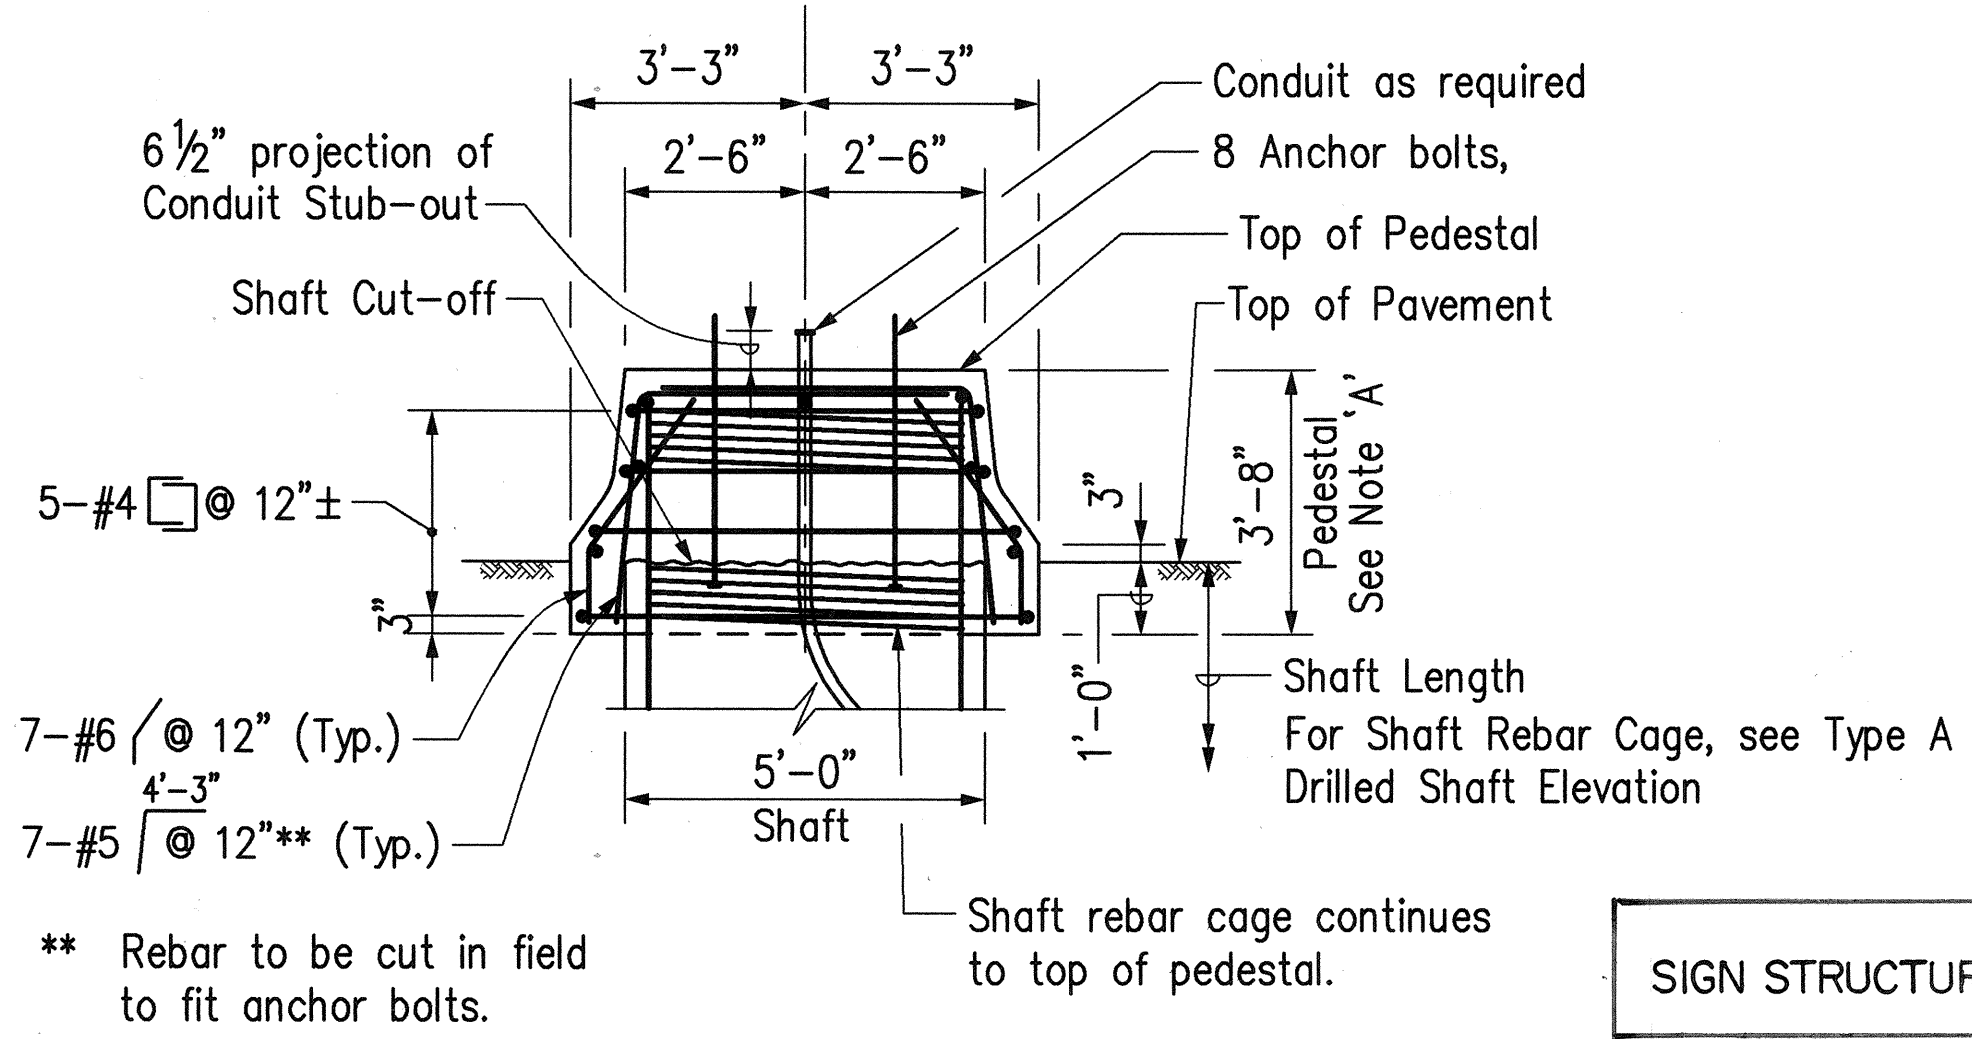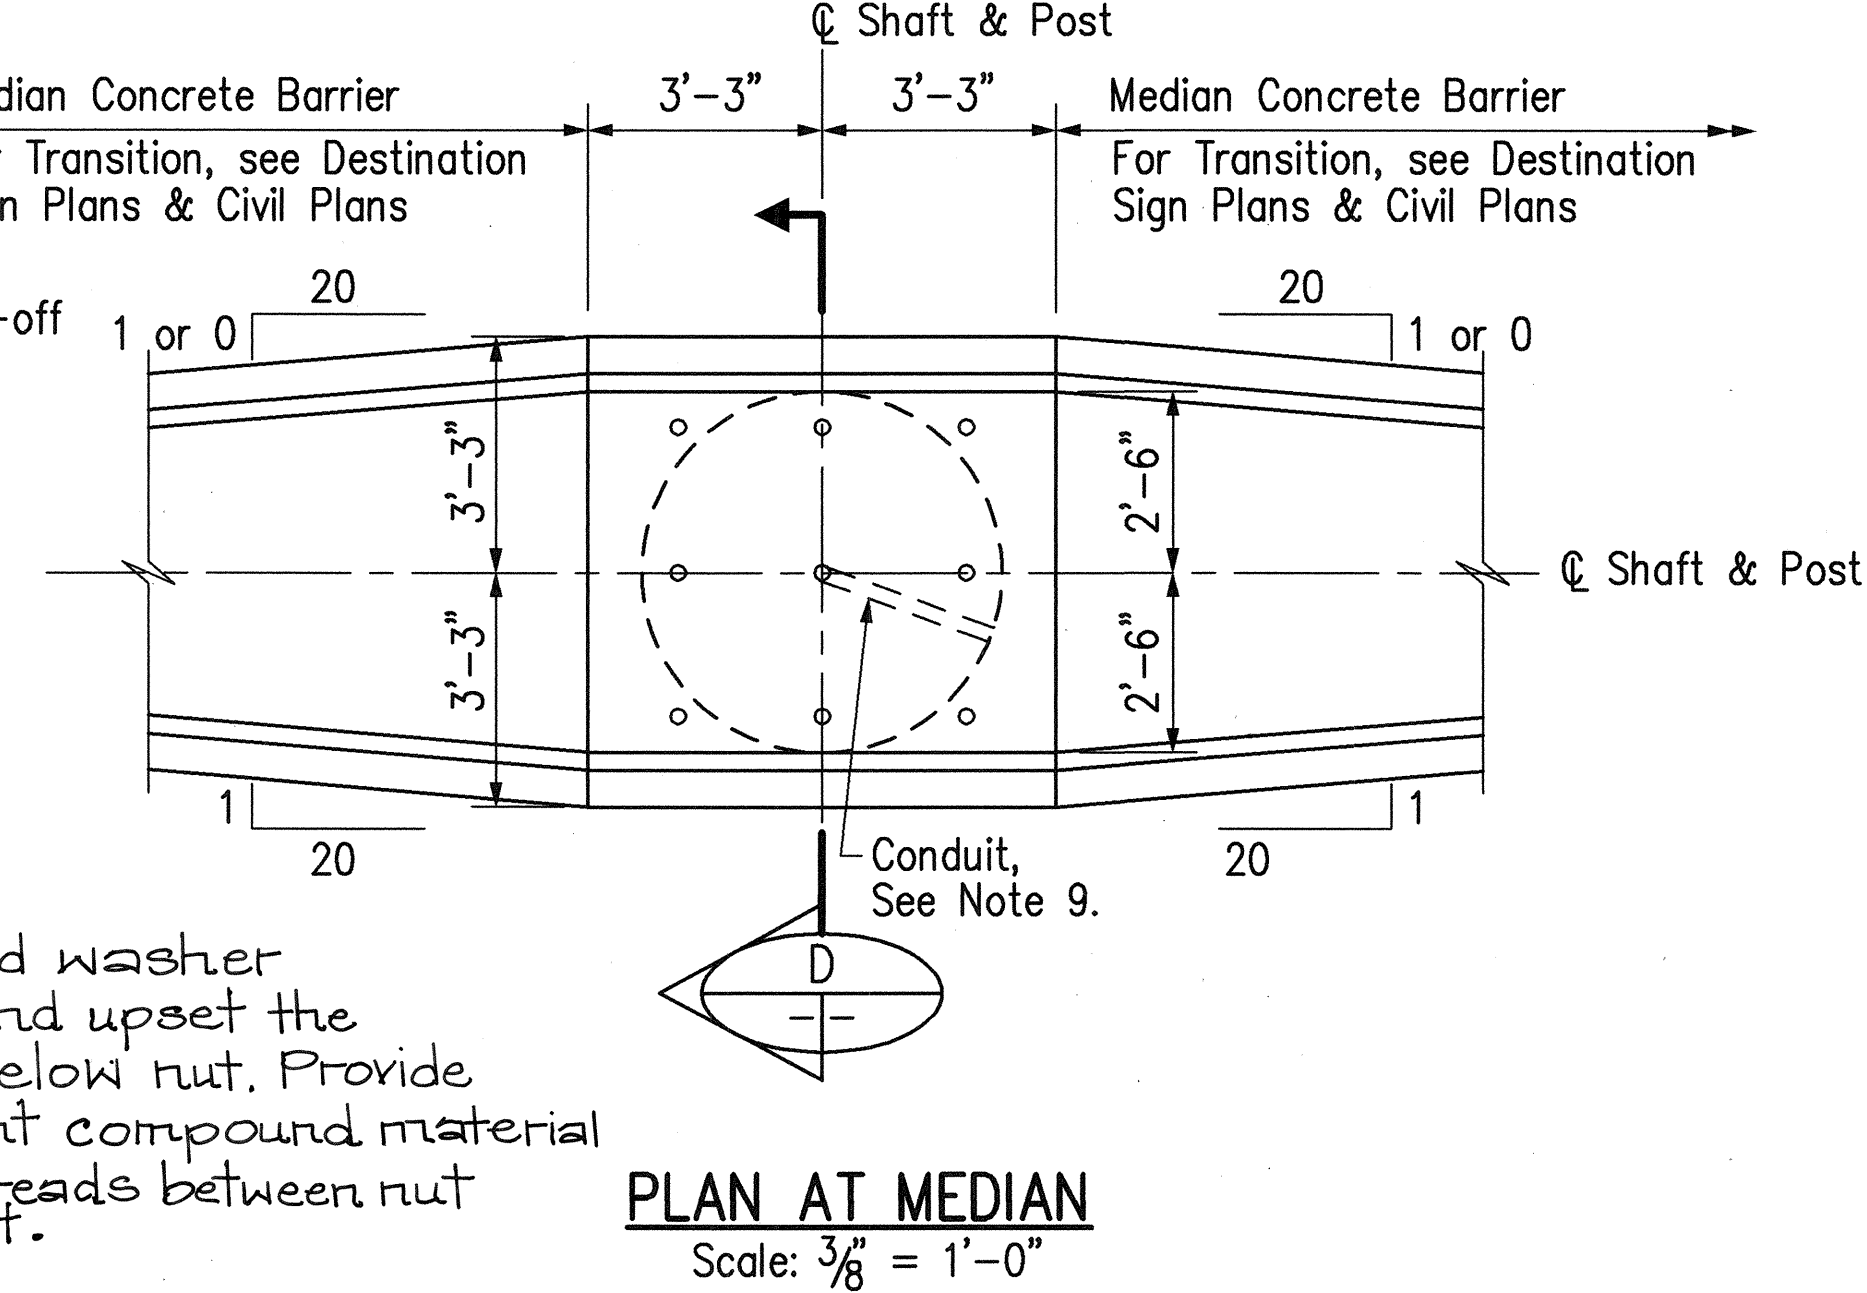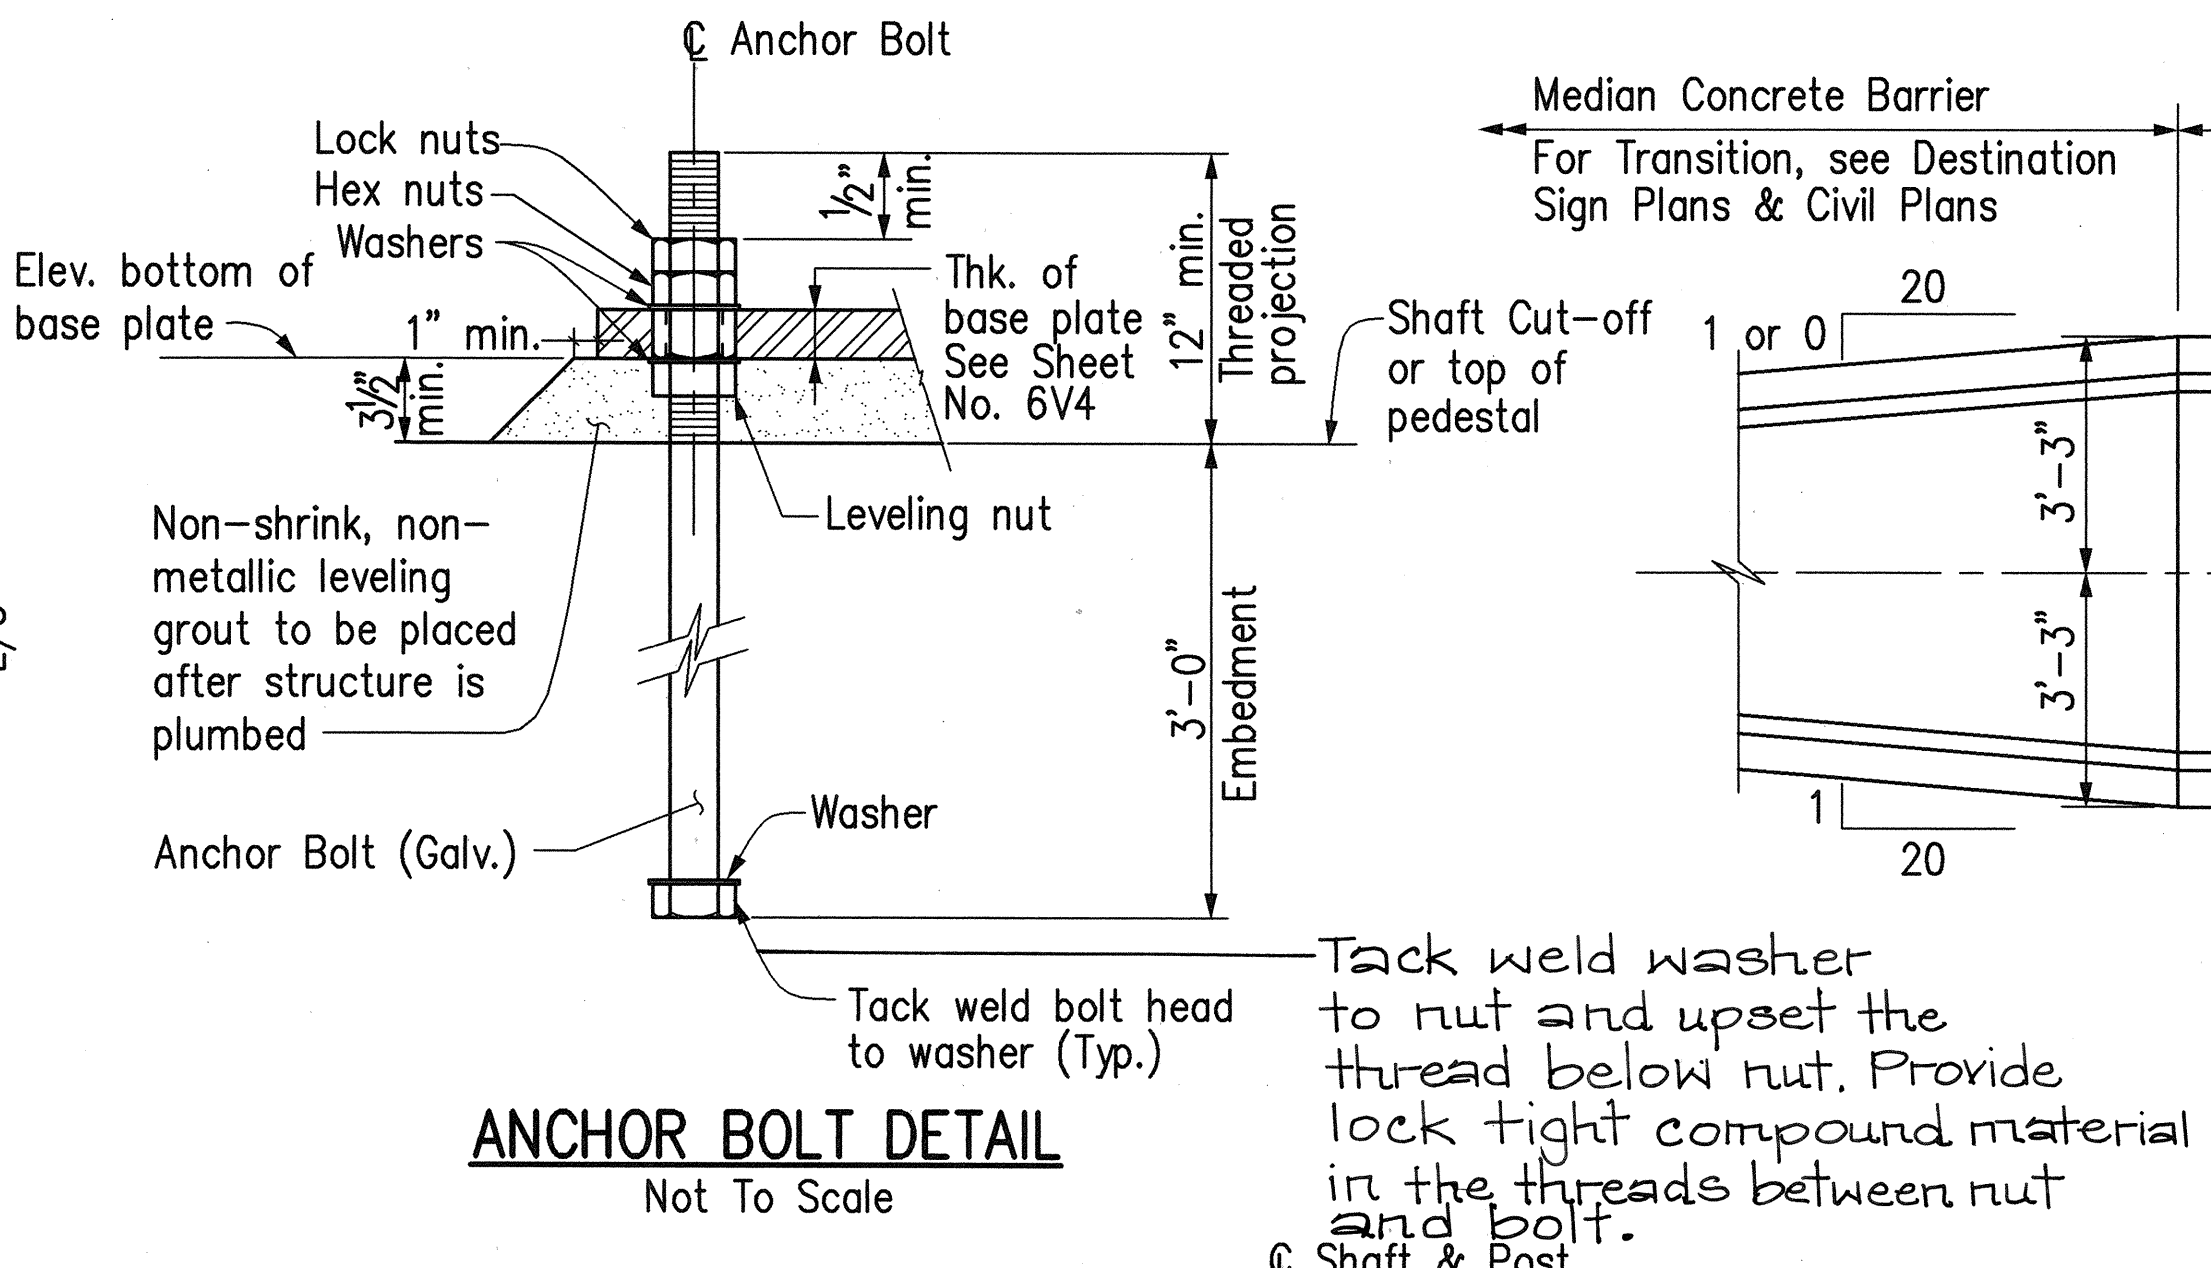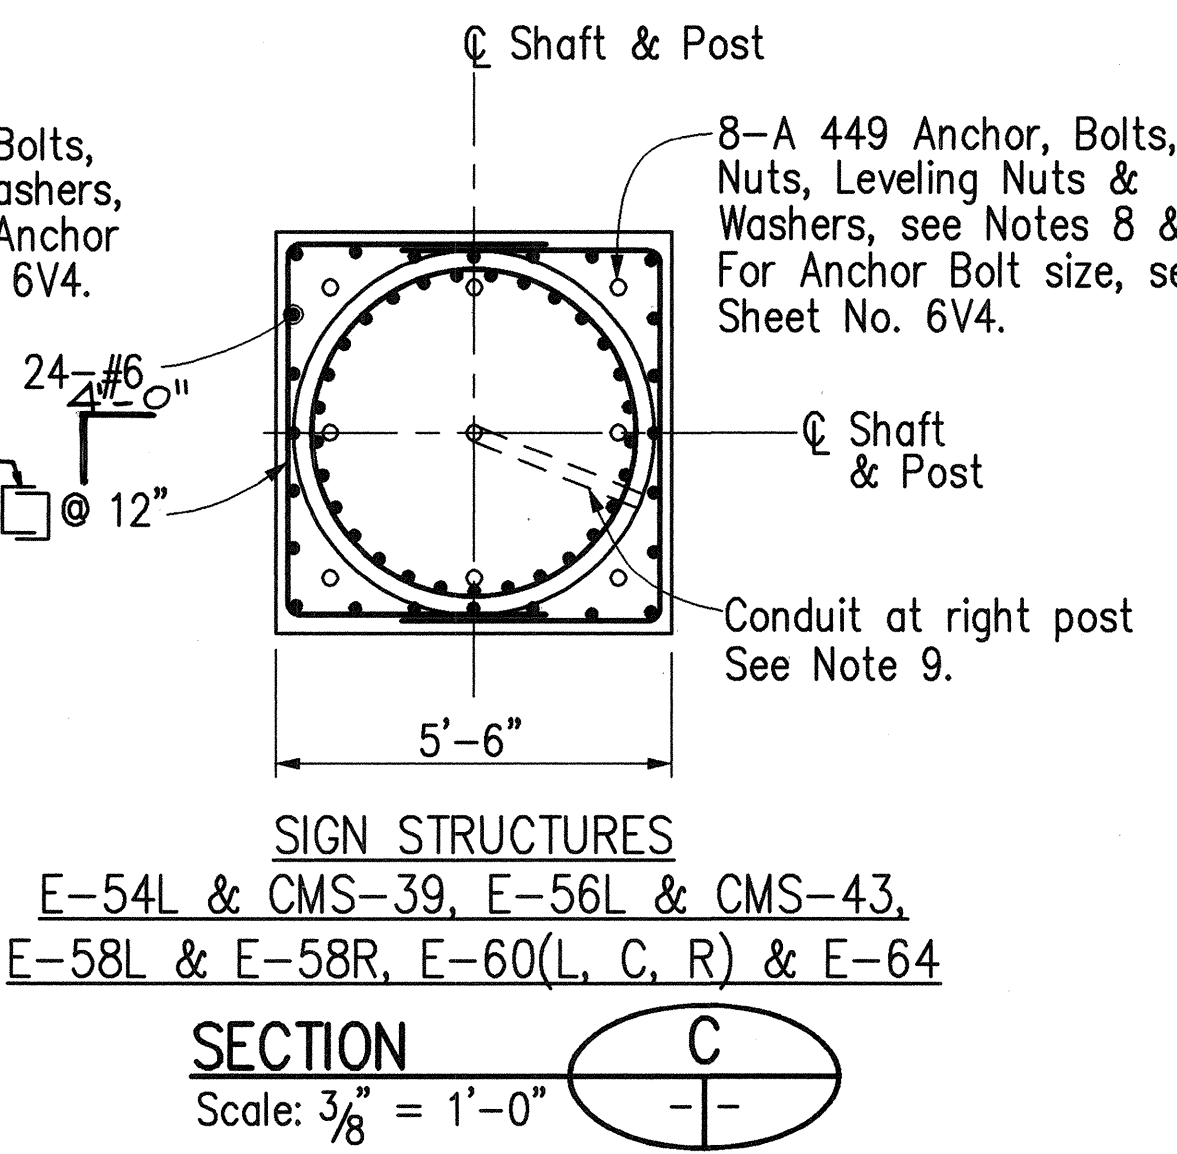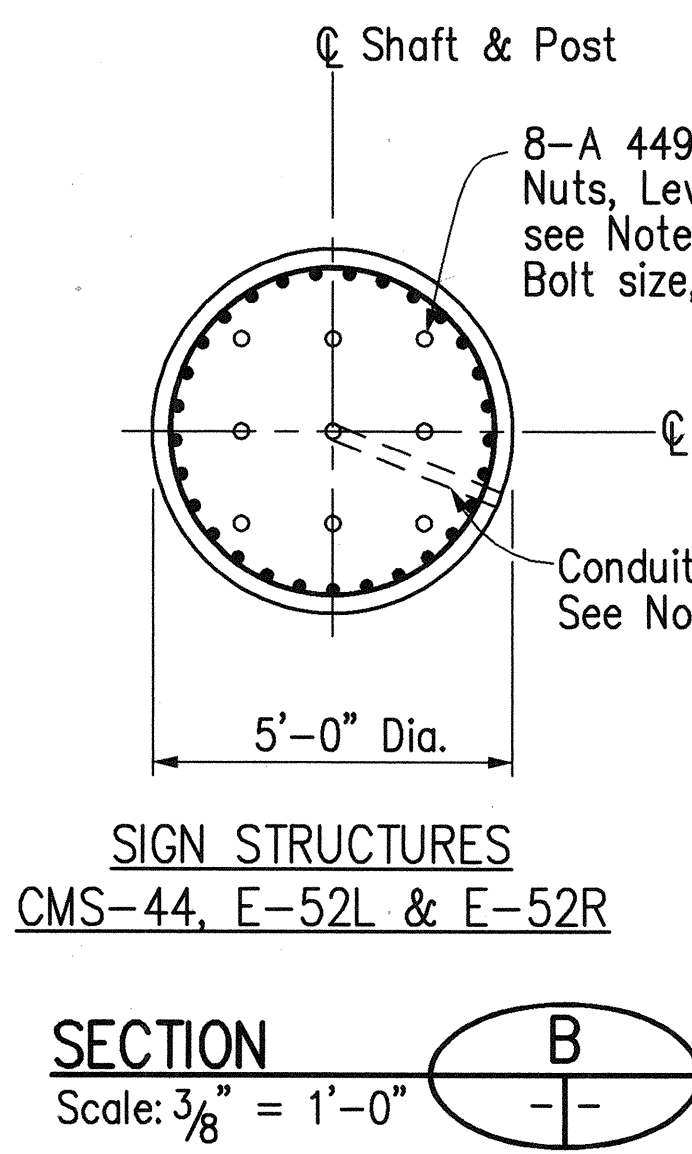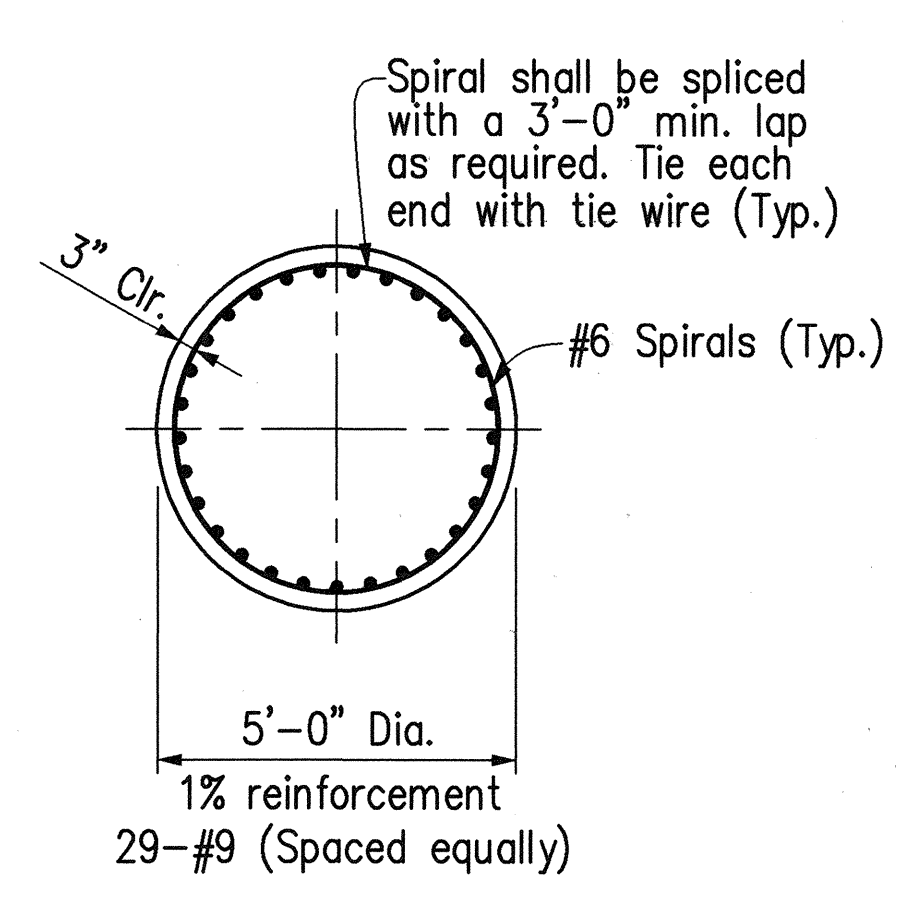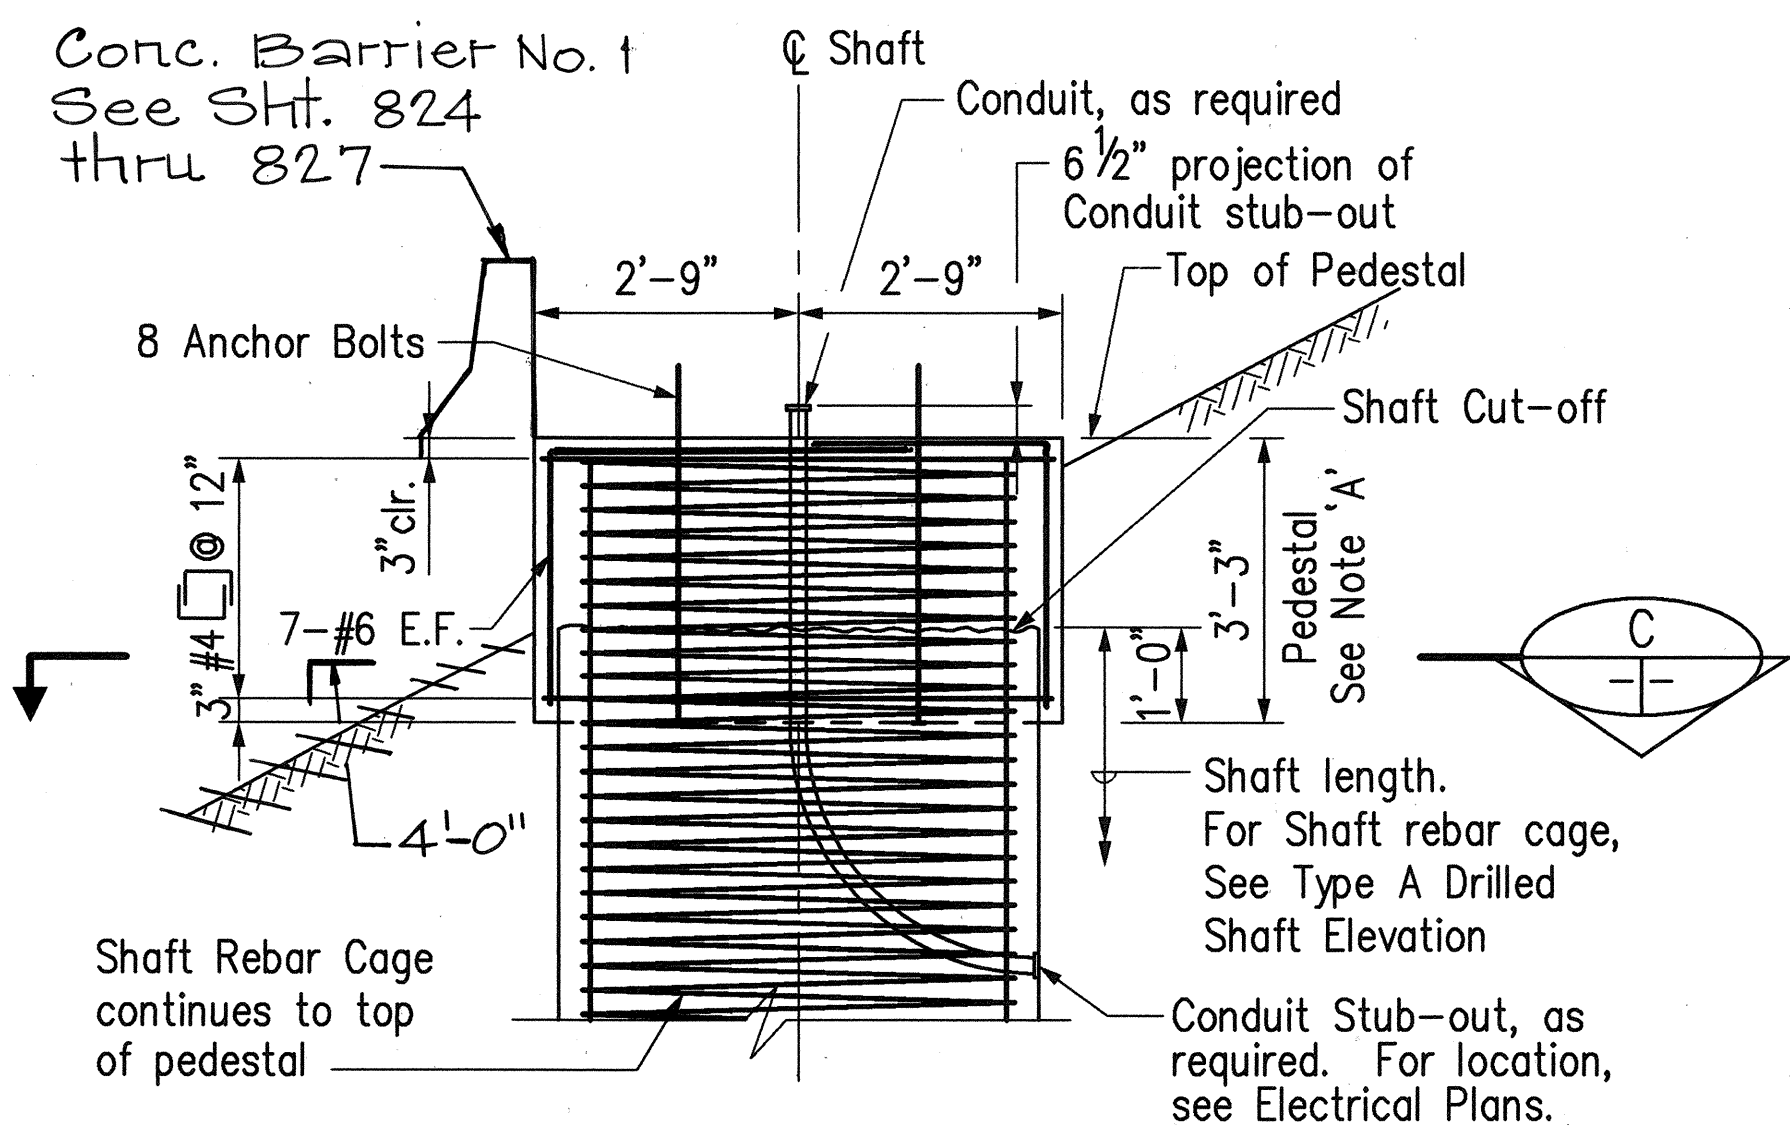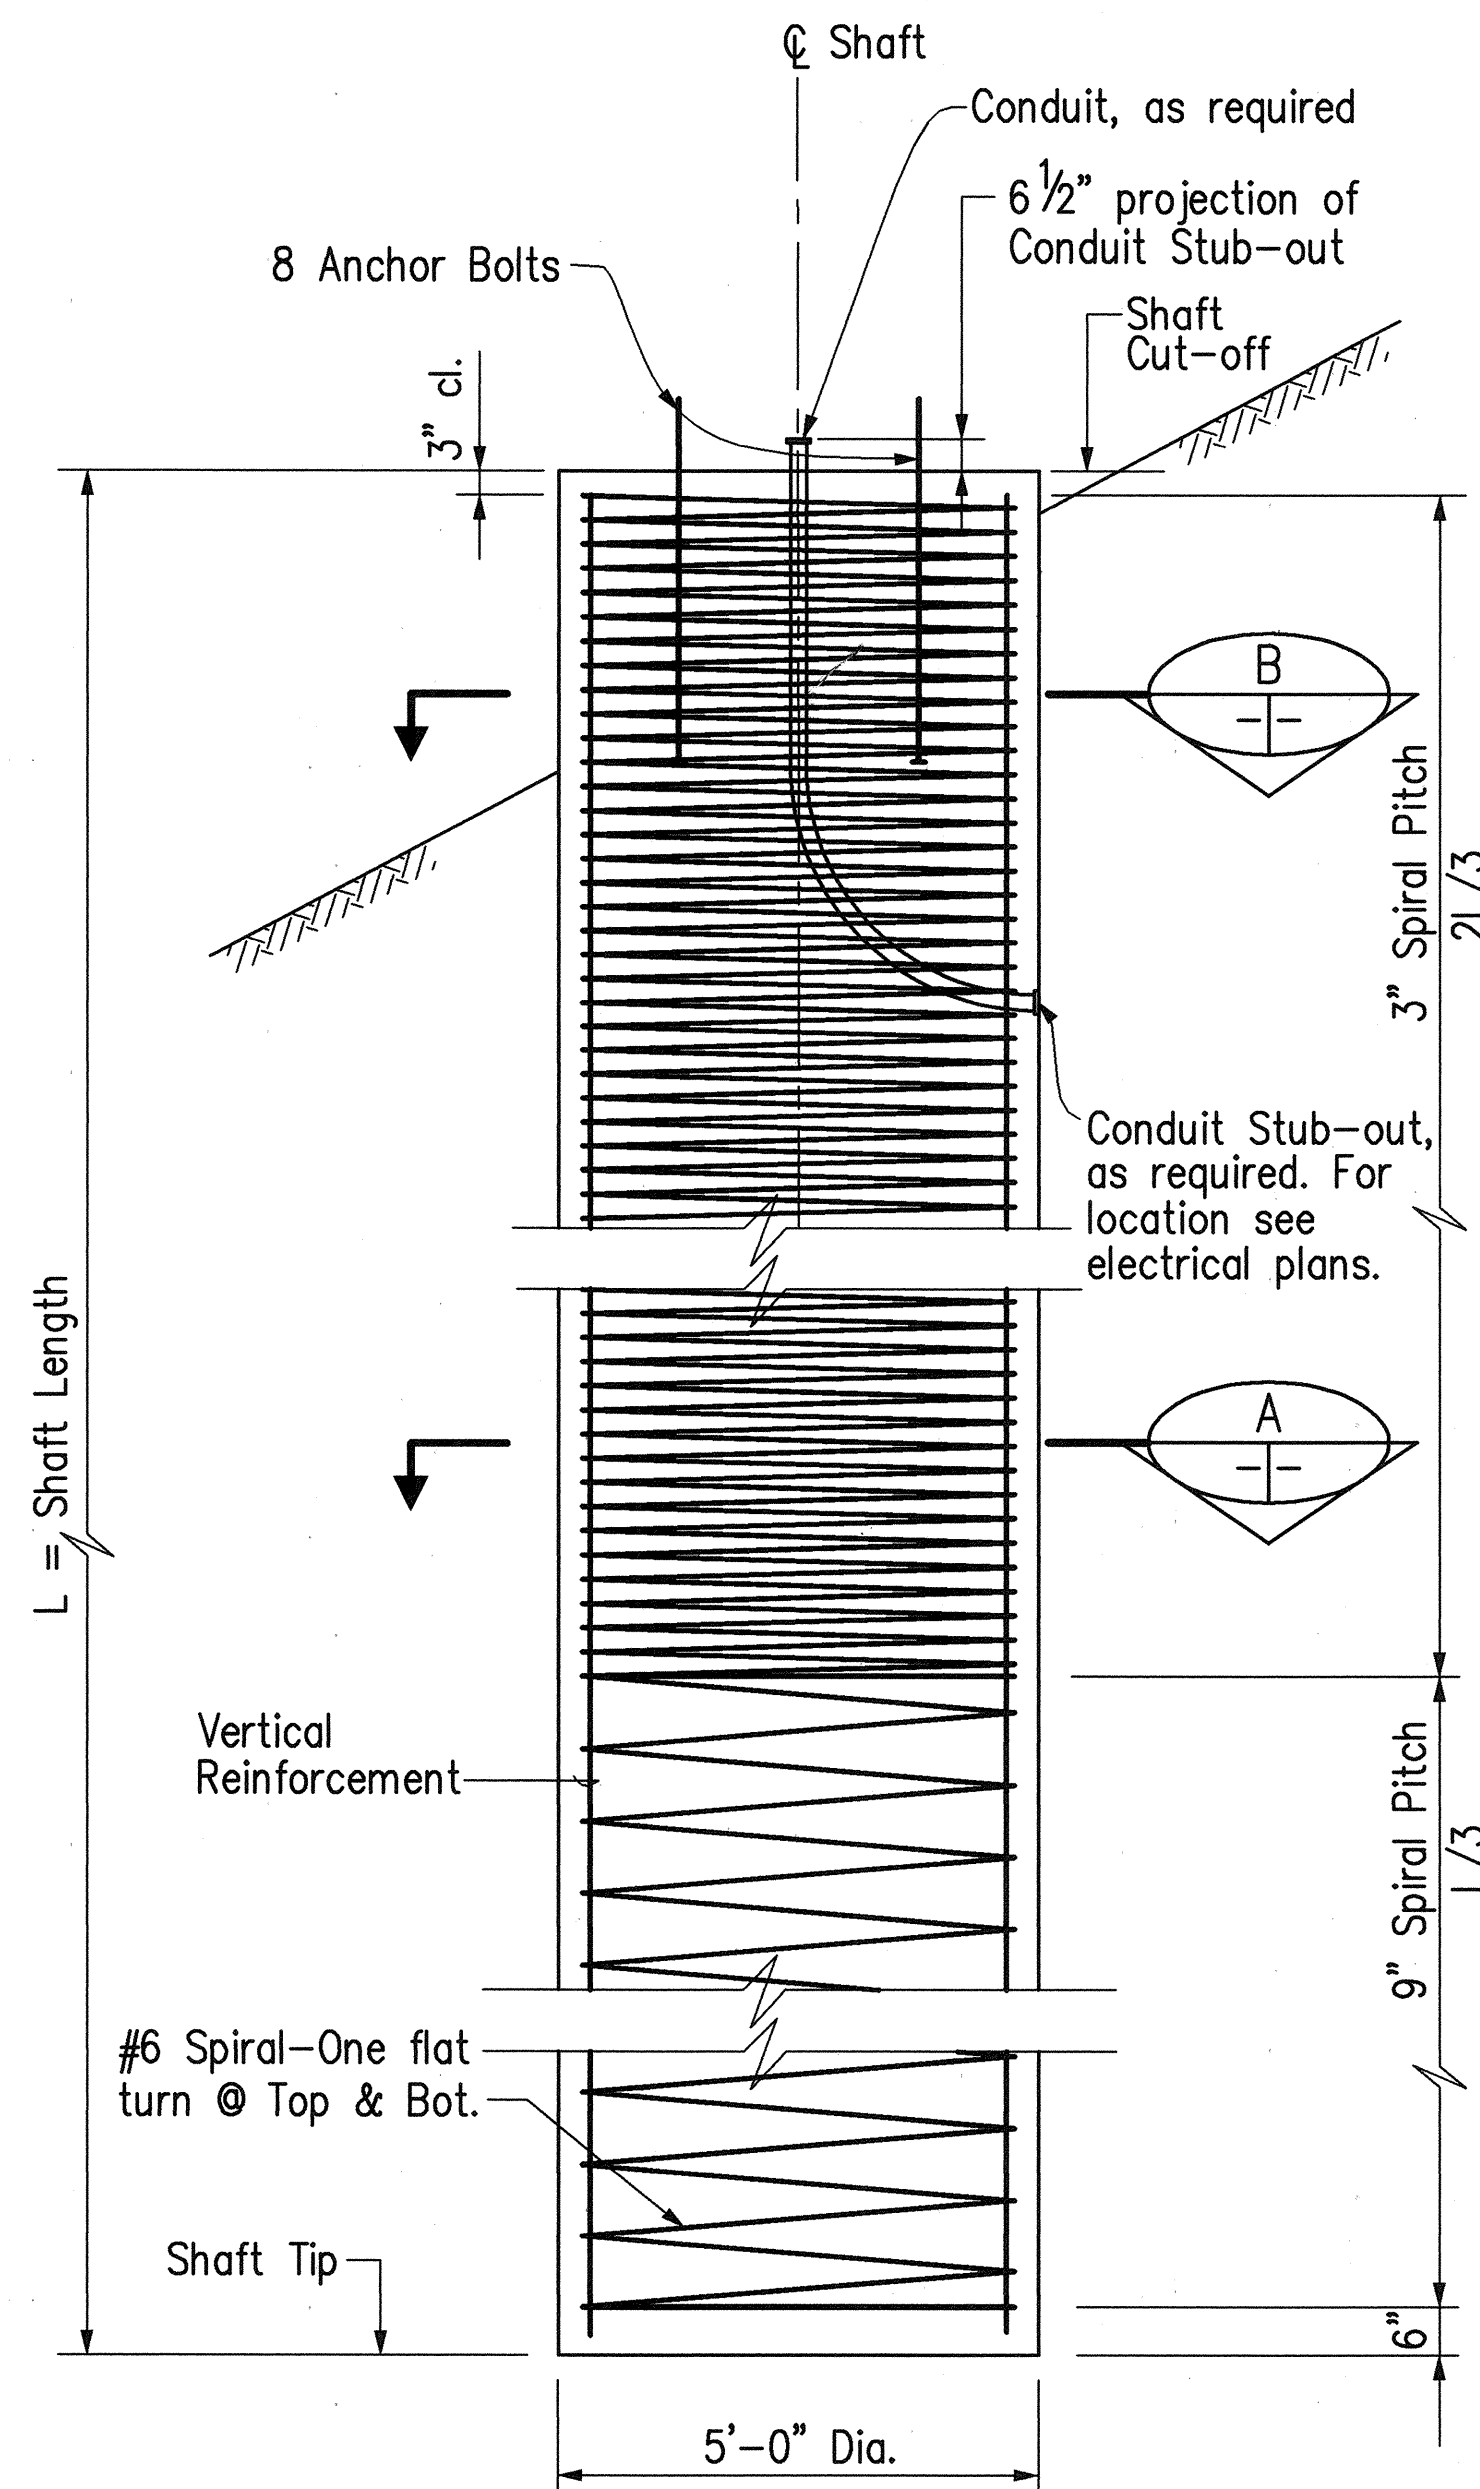


NOTE 'A':

Pedestal on top of drilled shaft shall be considered incidental to Drilled Shaft and will not be paid for separately.

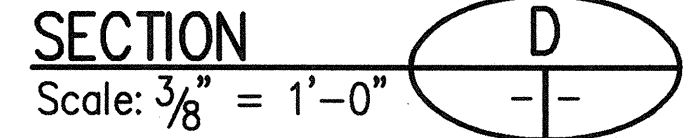


FED. ROAD DIST. NO.	STATE	FED. AID PROJ. NO.	FISCAL YEAR	SHEET NO.	TOTAL SHEETS
HAWAII	HAW.	I-H3-1(75), UNIT II	1997	877	1102

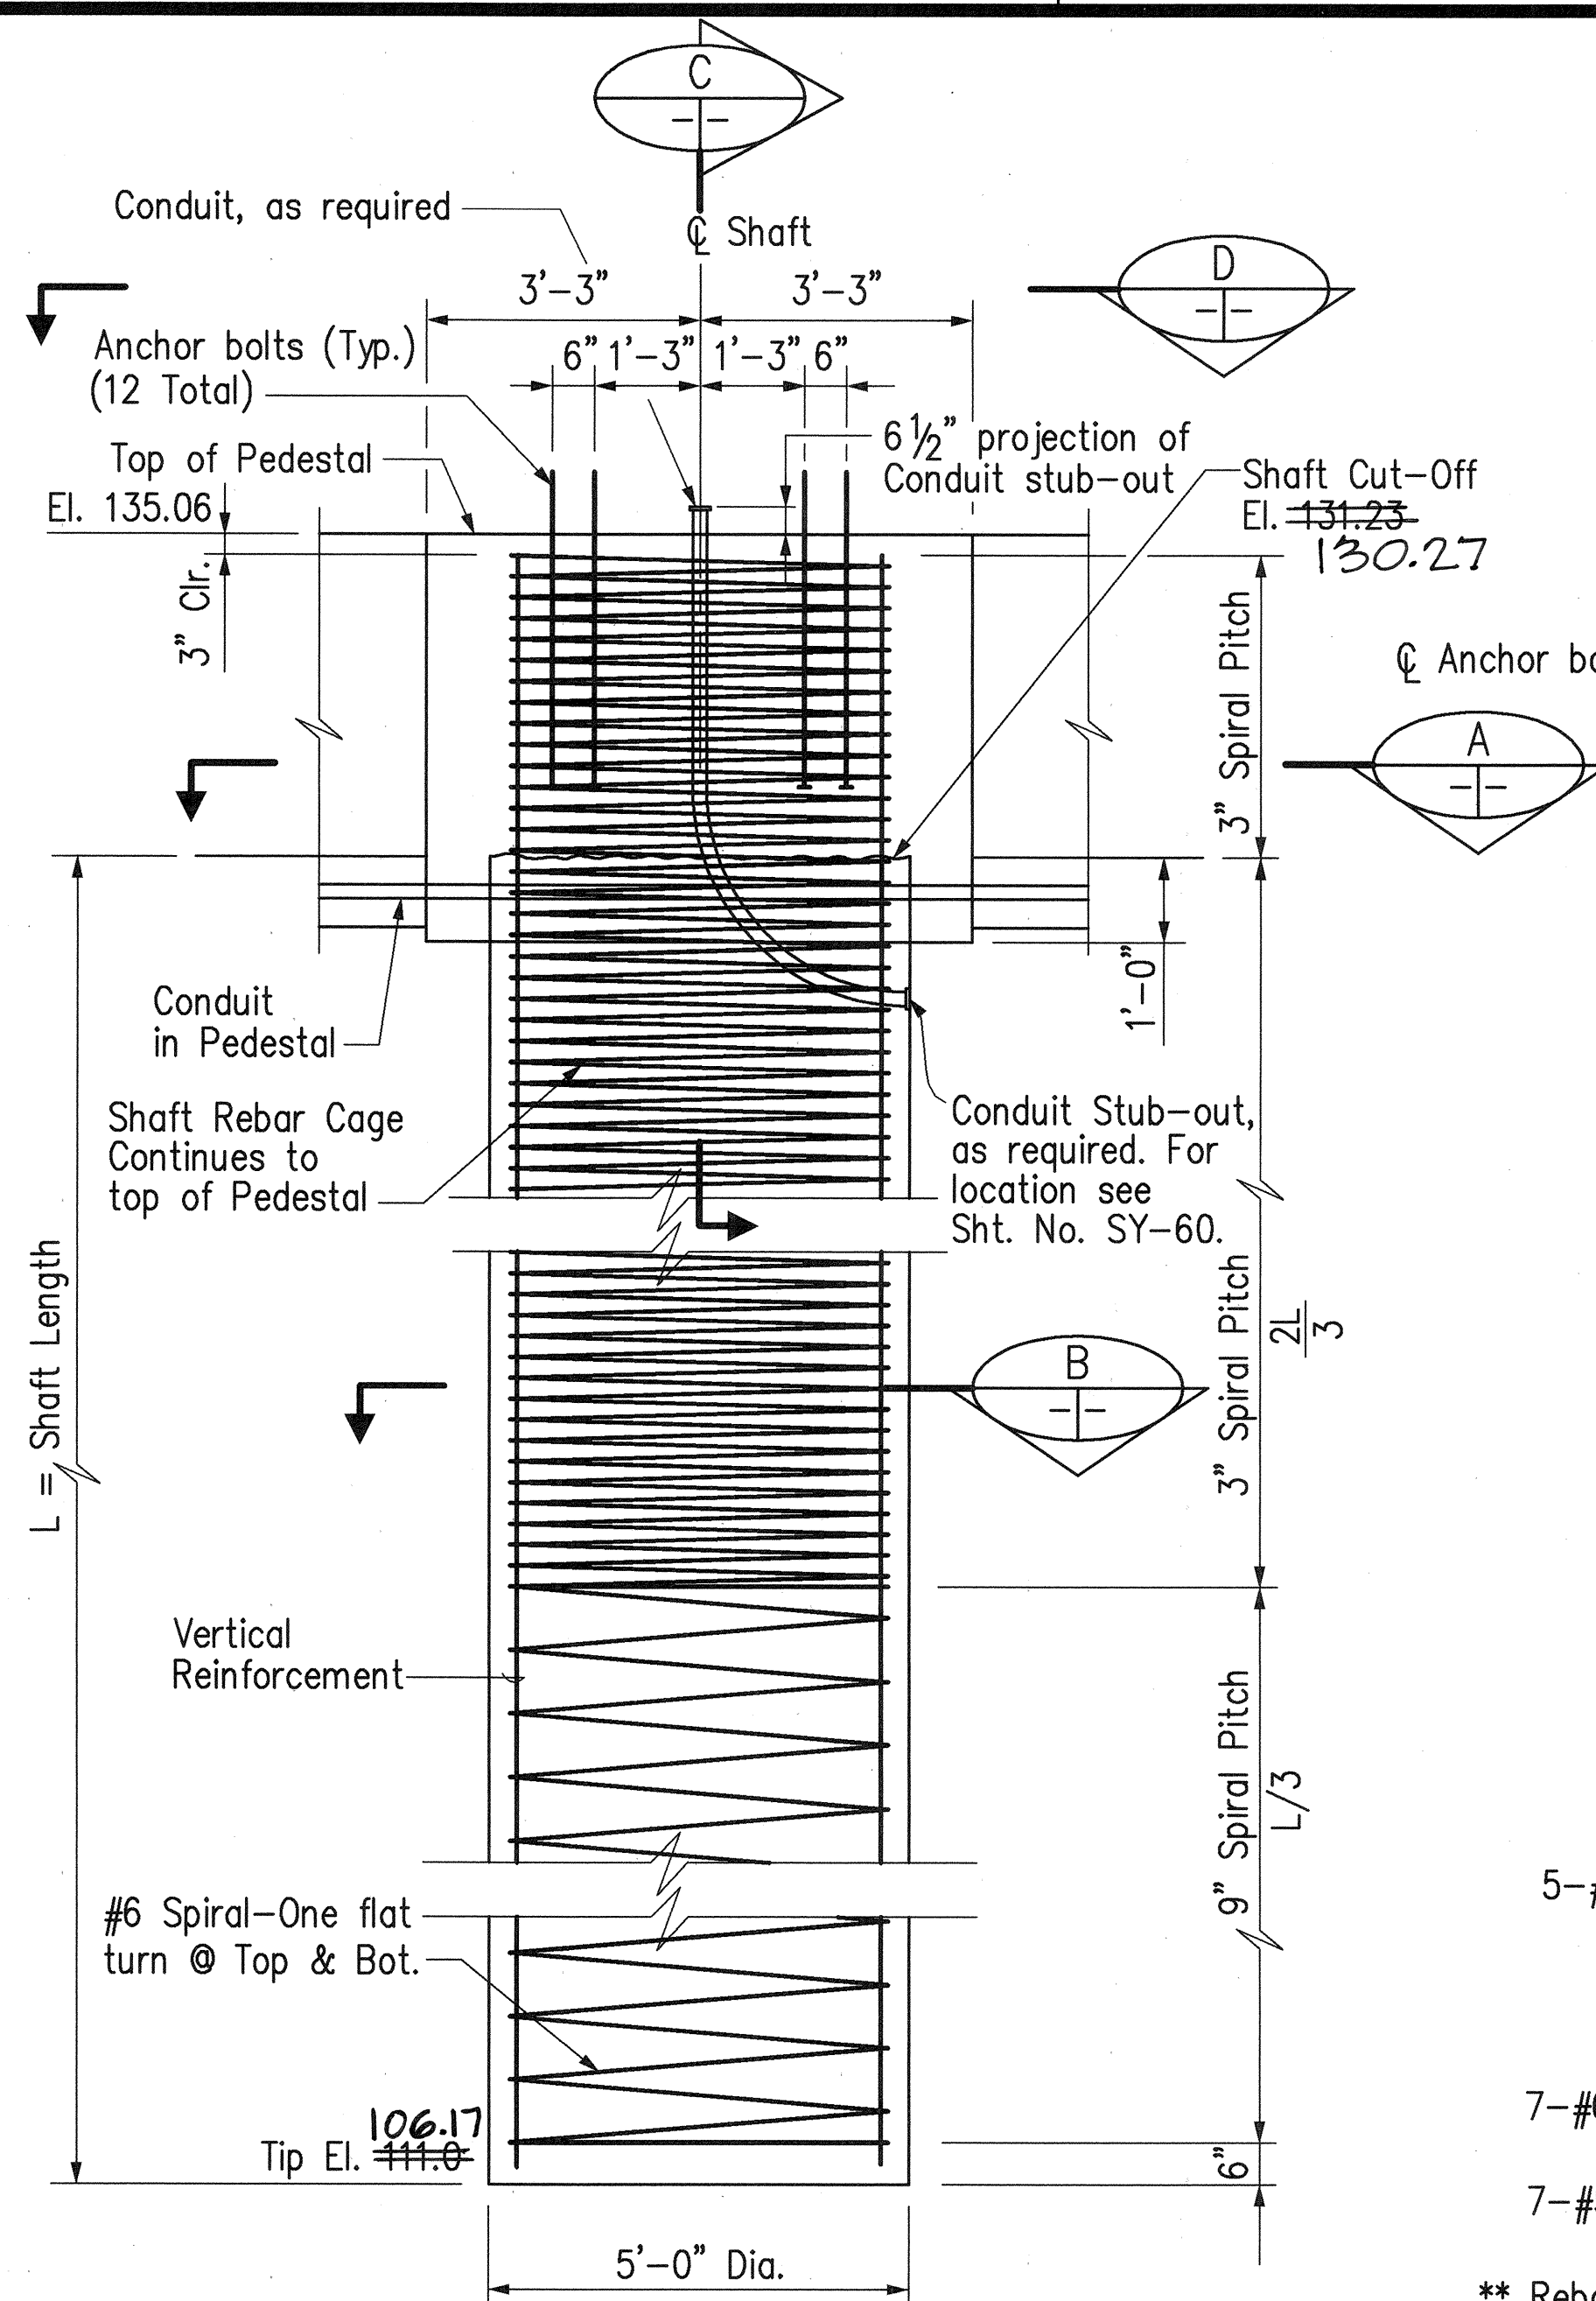


TYPE D DRILLED SHAFT ELEVATION FOR VMS 37

Not To Scale

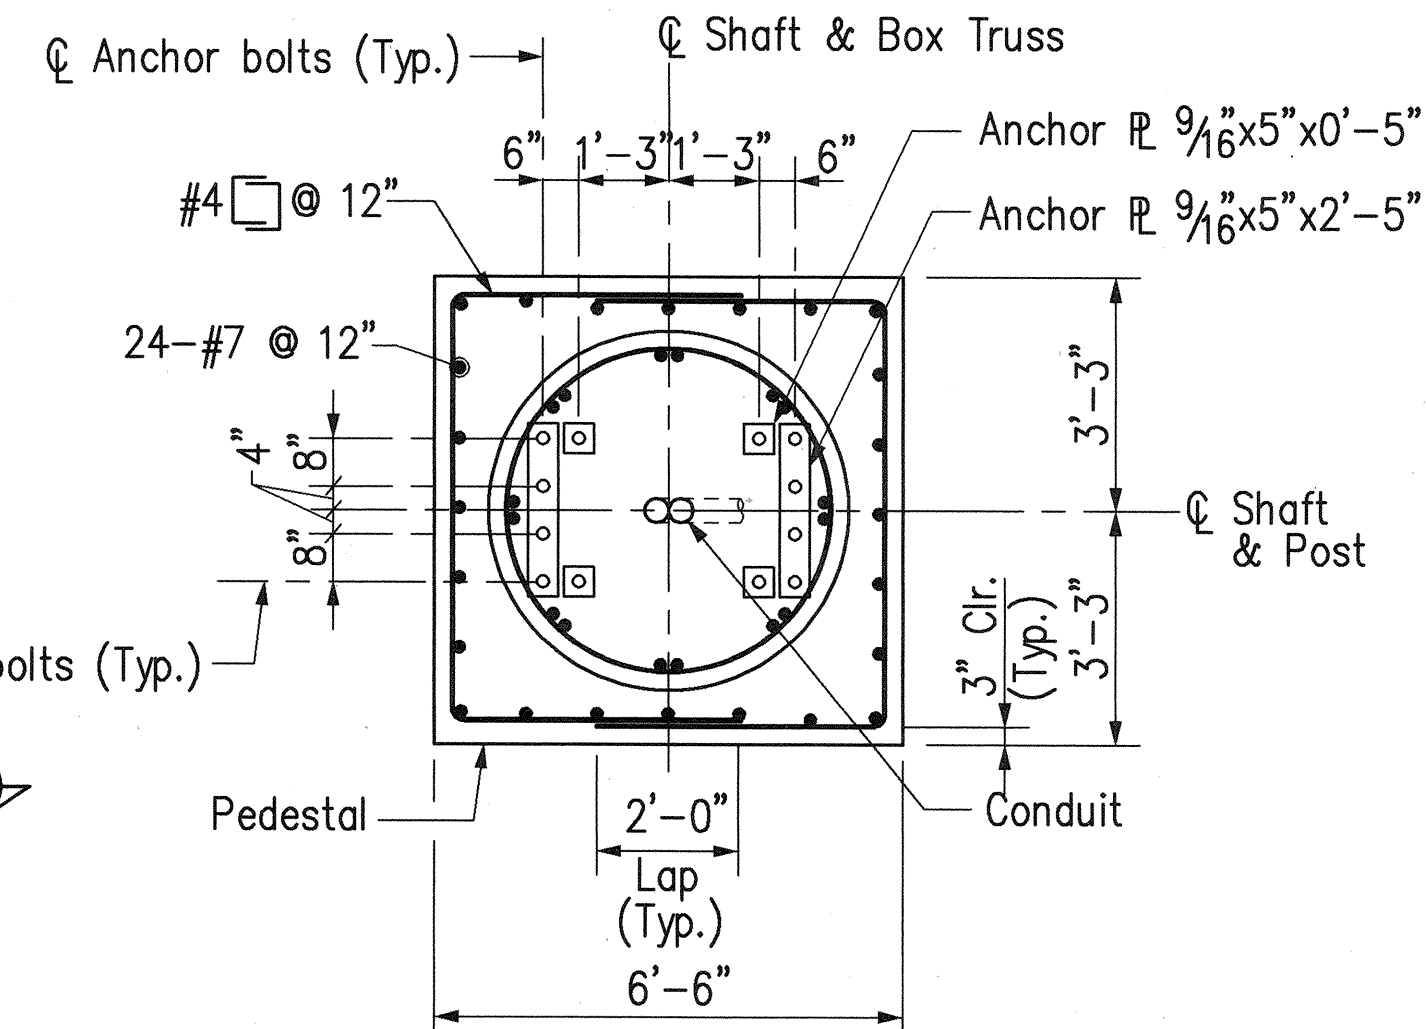


SECTION A

Scale: $\frac{3}{8}'' = 1'-0''$

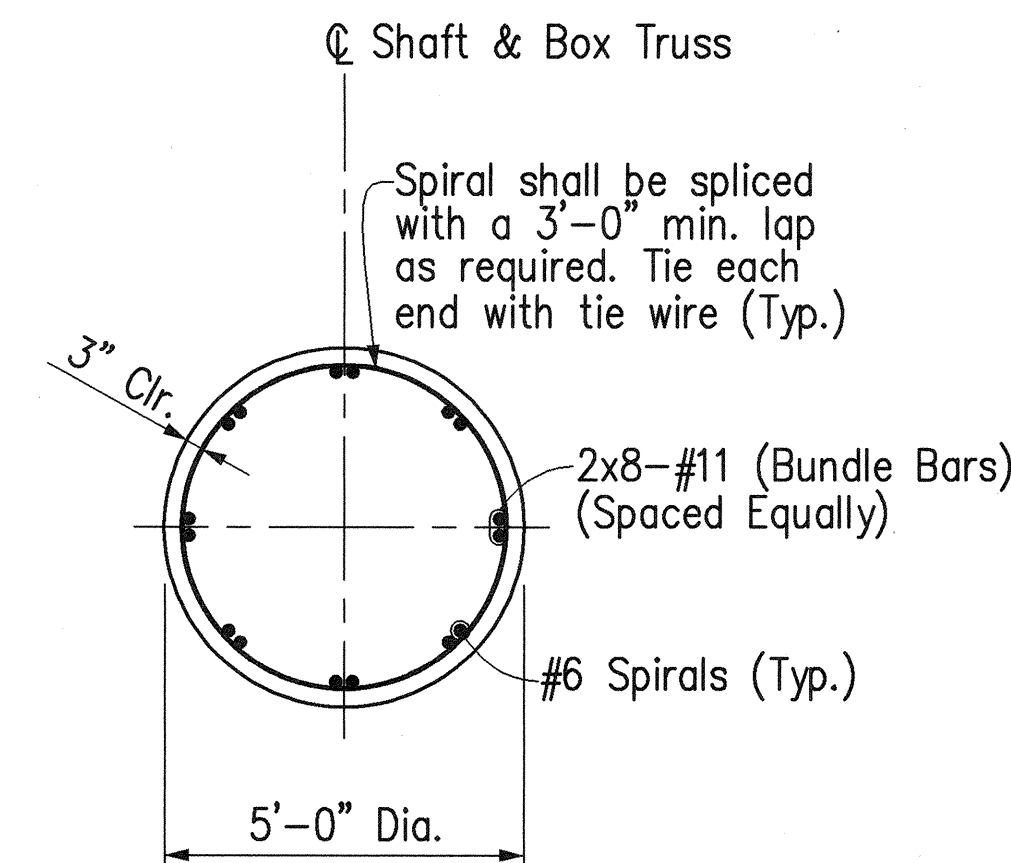

SECTION B


Scale: $\frac{3}{8}'' = 1'-0''$

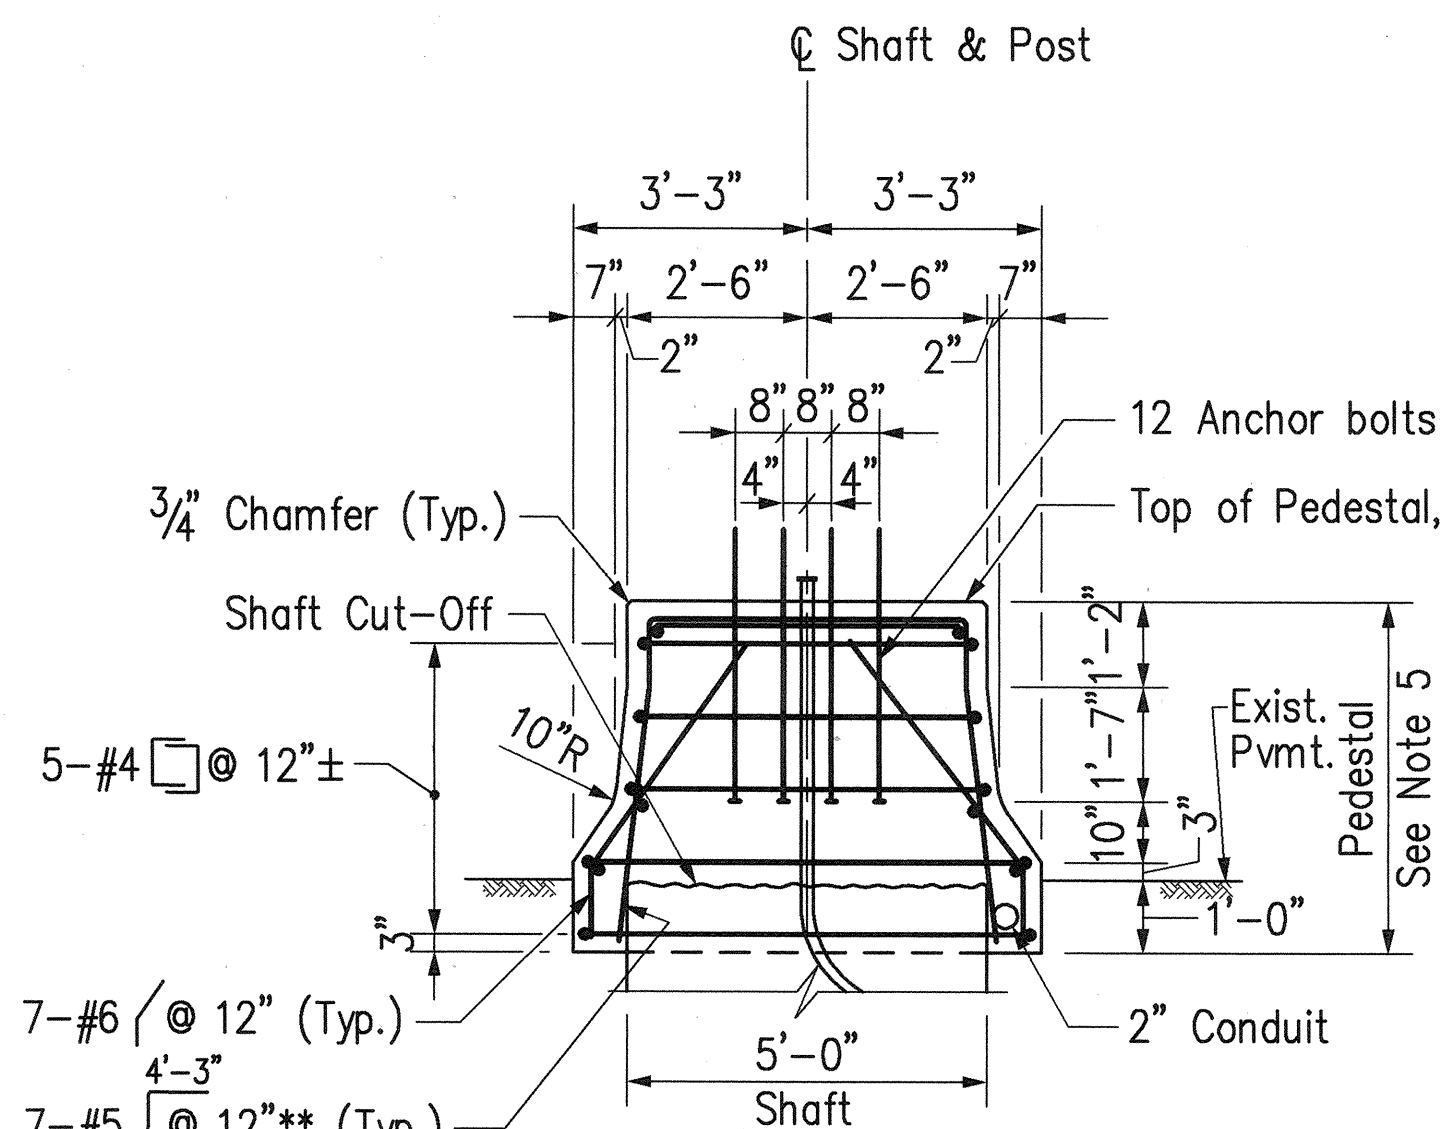

SECTION C


NOTE: Shaft Rebar Cage not shown for clarity

** Rebar to be cut in field to fit anchor bolts.

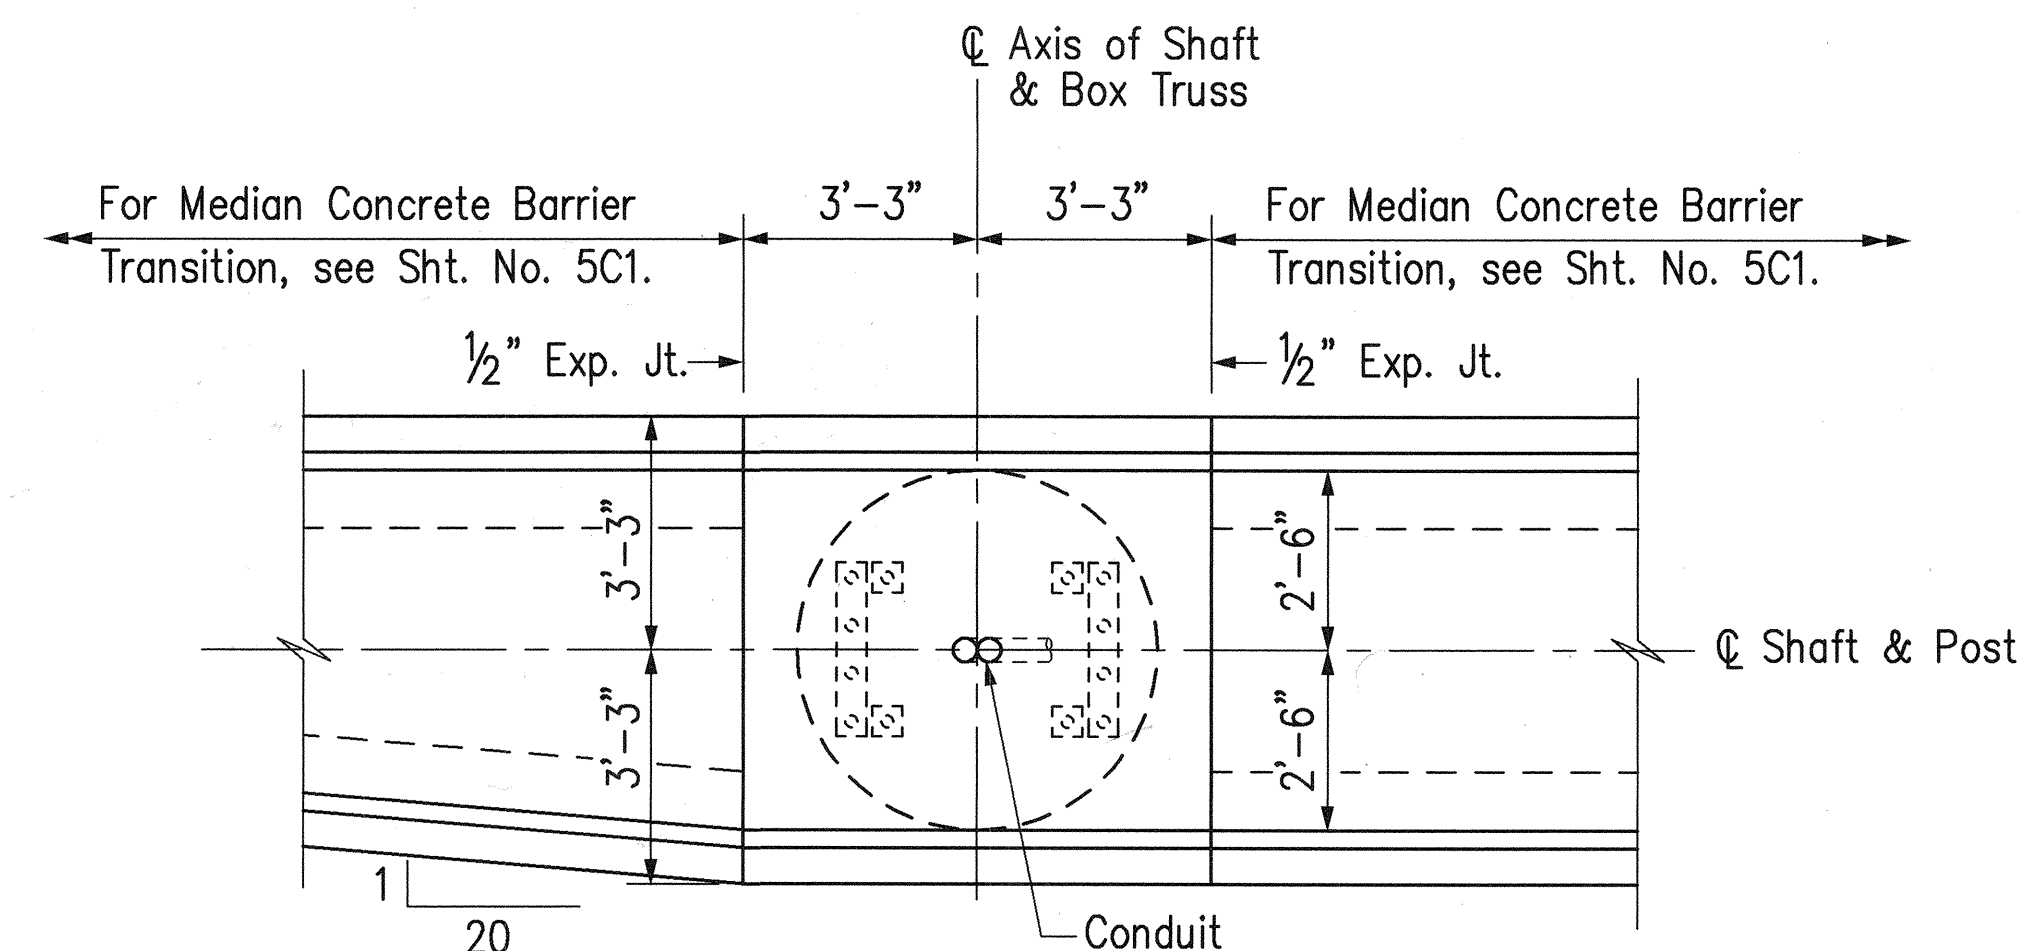


VIEW D

Scale: $\frac{3}{8}'' = 1'-0''$

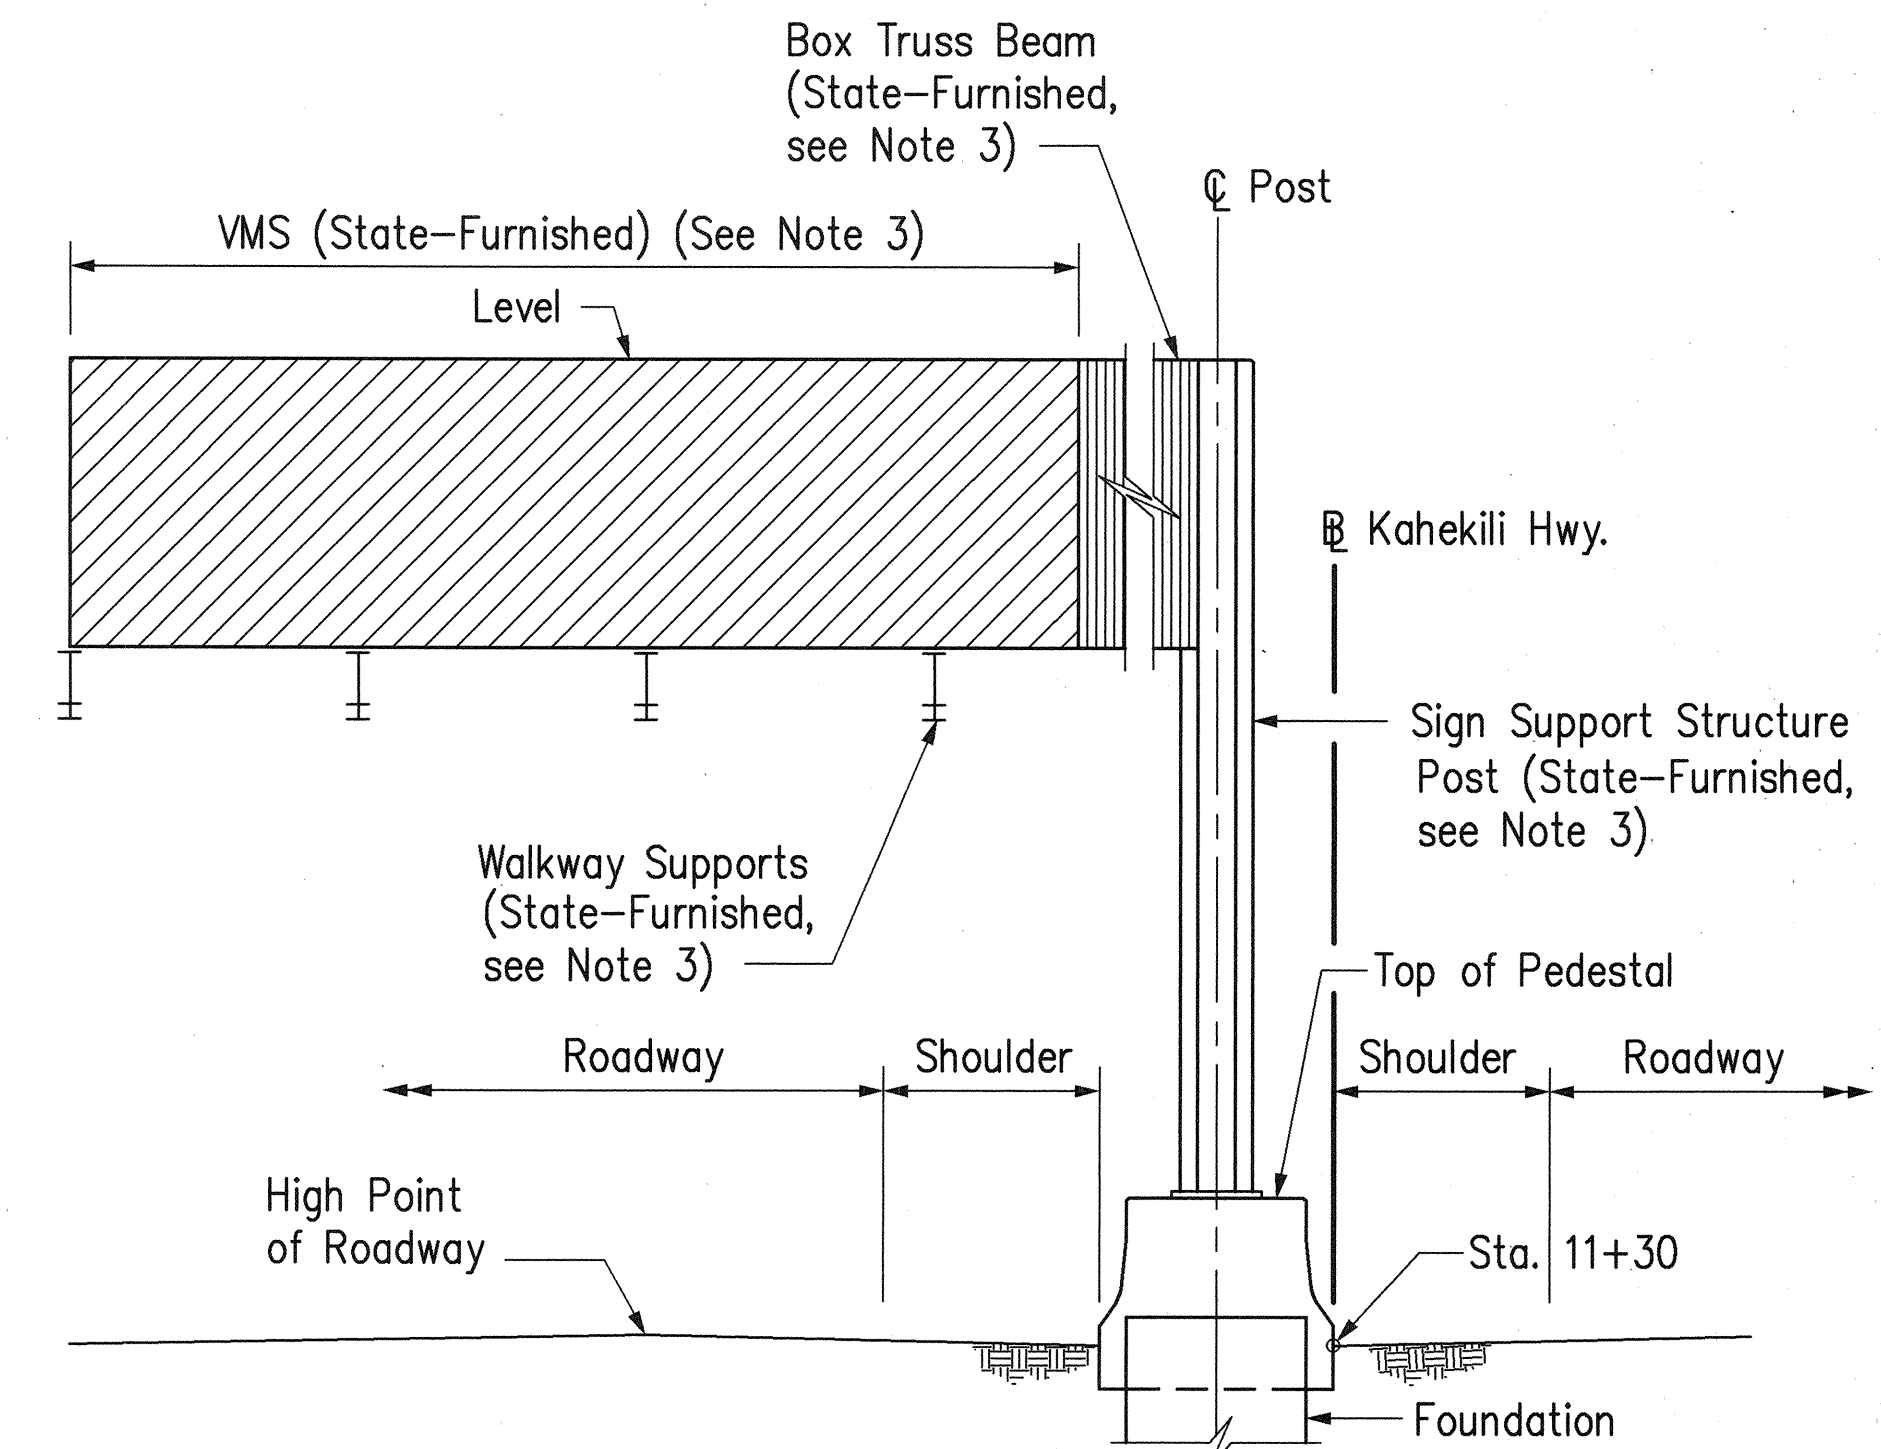

SIGN STRUCTURE FOR VMS 37

Not to Scale

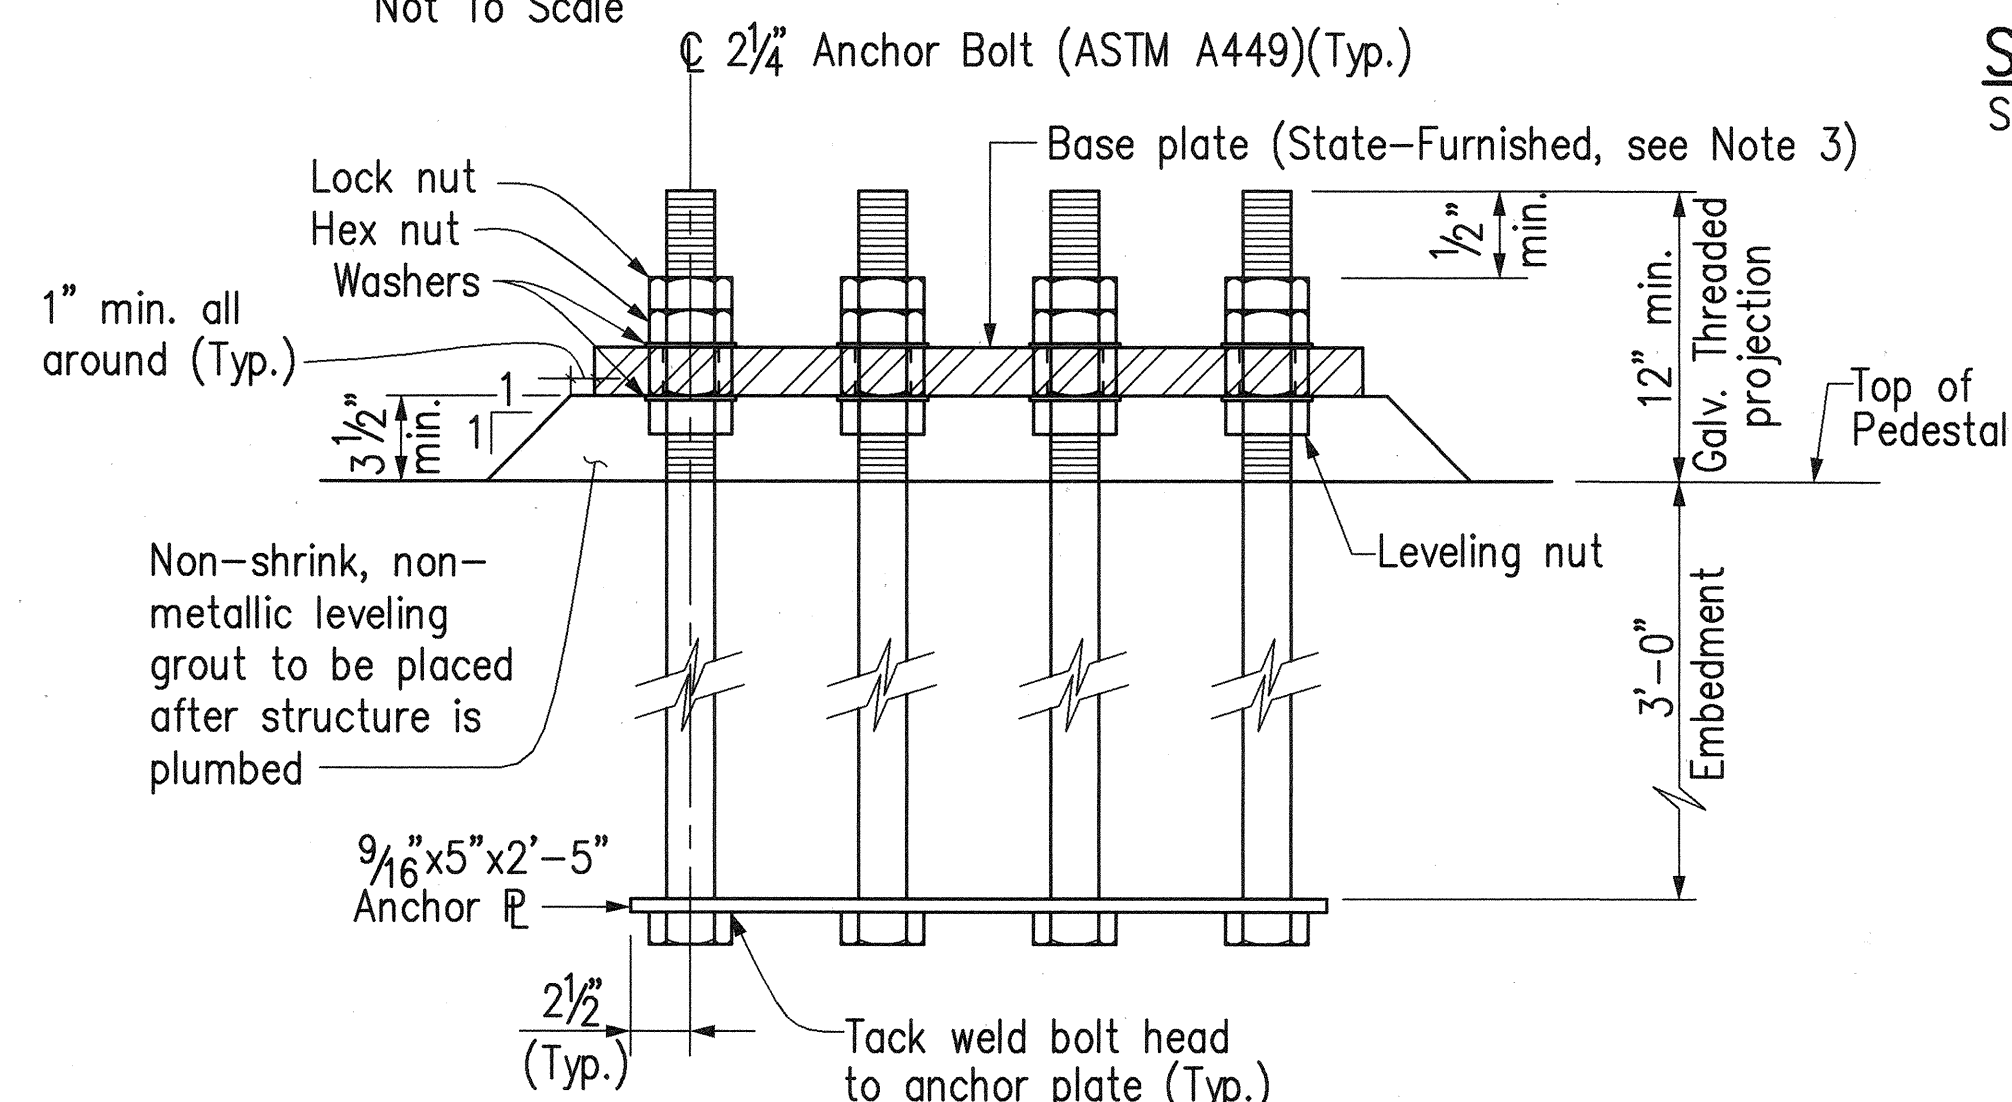


ANCHOR BOLT DETAIL

Not To Scale

NOTES:

1. The Contractor shall furnish and install drilled shaft, anchor plates, anchor bolts, hex nuts, lock nuts, leveling nuts, washers, and leveling grout for VMS 37 as shown.
2. For drilled shaft notes, see Sht. No. 6V6.
3. For State-Furnished Sign Support Structure (Box Truss Beam, Support Post, Walkway Supports) and VMS, see Sht. No. SY-103.
4. For Location of conduit stub-out, see Sht. No. SY-60.
5. Pedestal on top of drilled shaft shall be considered incidental to "5'-0" Diameter Drilled Shaft Type D for Sign Structure" and will not be paid for separately.

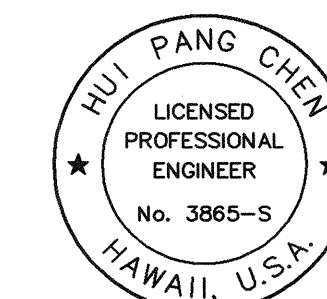

THIS WORK WAS PREPARED BY ME OR UNDER MY SUPERVISION.

Hui Pang Chen


STATE OF HAWAII
DEPARTMENT OF TRANSPORTATION
HIGHWAYS DIVISION

**DESTINATION SIGNS
SIGN STRUCTURES
VMS 37 FOUNDATION**


H-3 FINISH (UNIT II)
FAIP NO. I-H3-1(75), UNIT II
LEEWARD SECTION

SCALE: AS SHOWN DATE: JANUARY 1997
SHEET NO. 6V7 OF 14 SHEETS


FED. ROAD DIST. NO.	STATE	FED. AID PROJ. NO.	FISCAL YEAR	SHEET NO.	TOTAL SHEETS
HAWAII	HAW.	I-H3-1(75), UNIT II	1997	ADD. 877S-1	1102

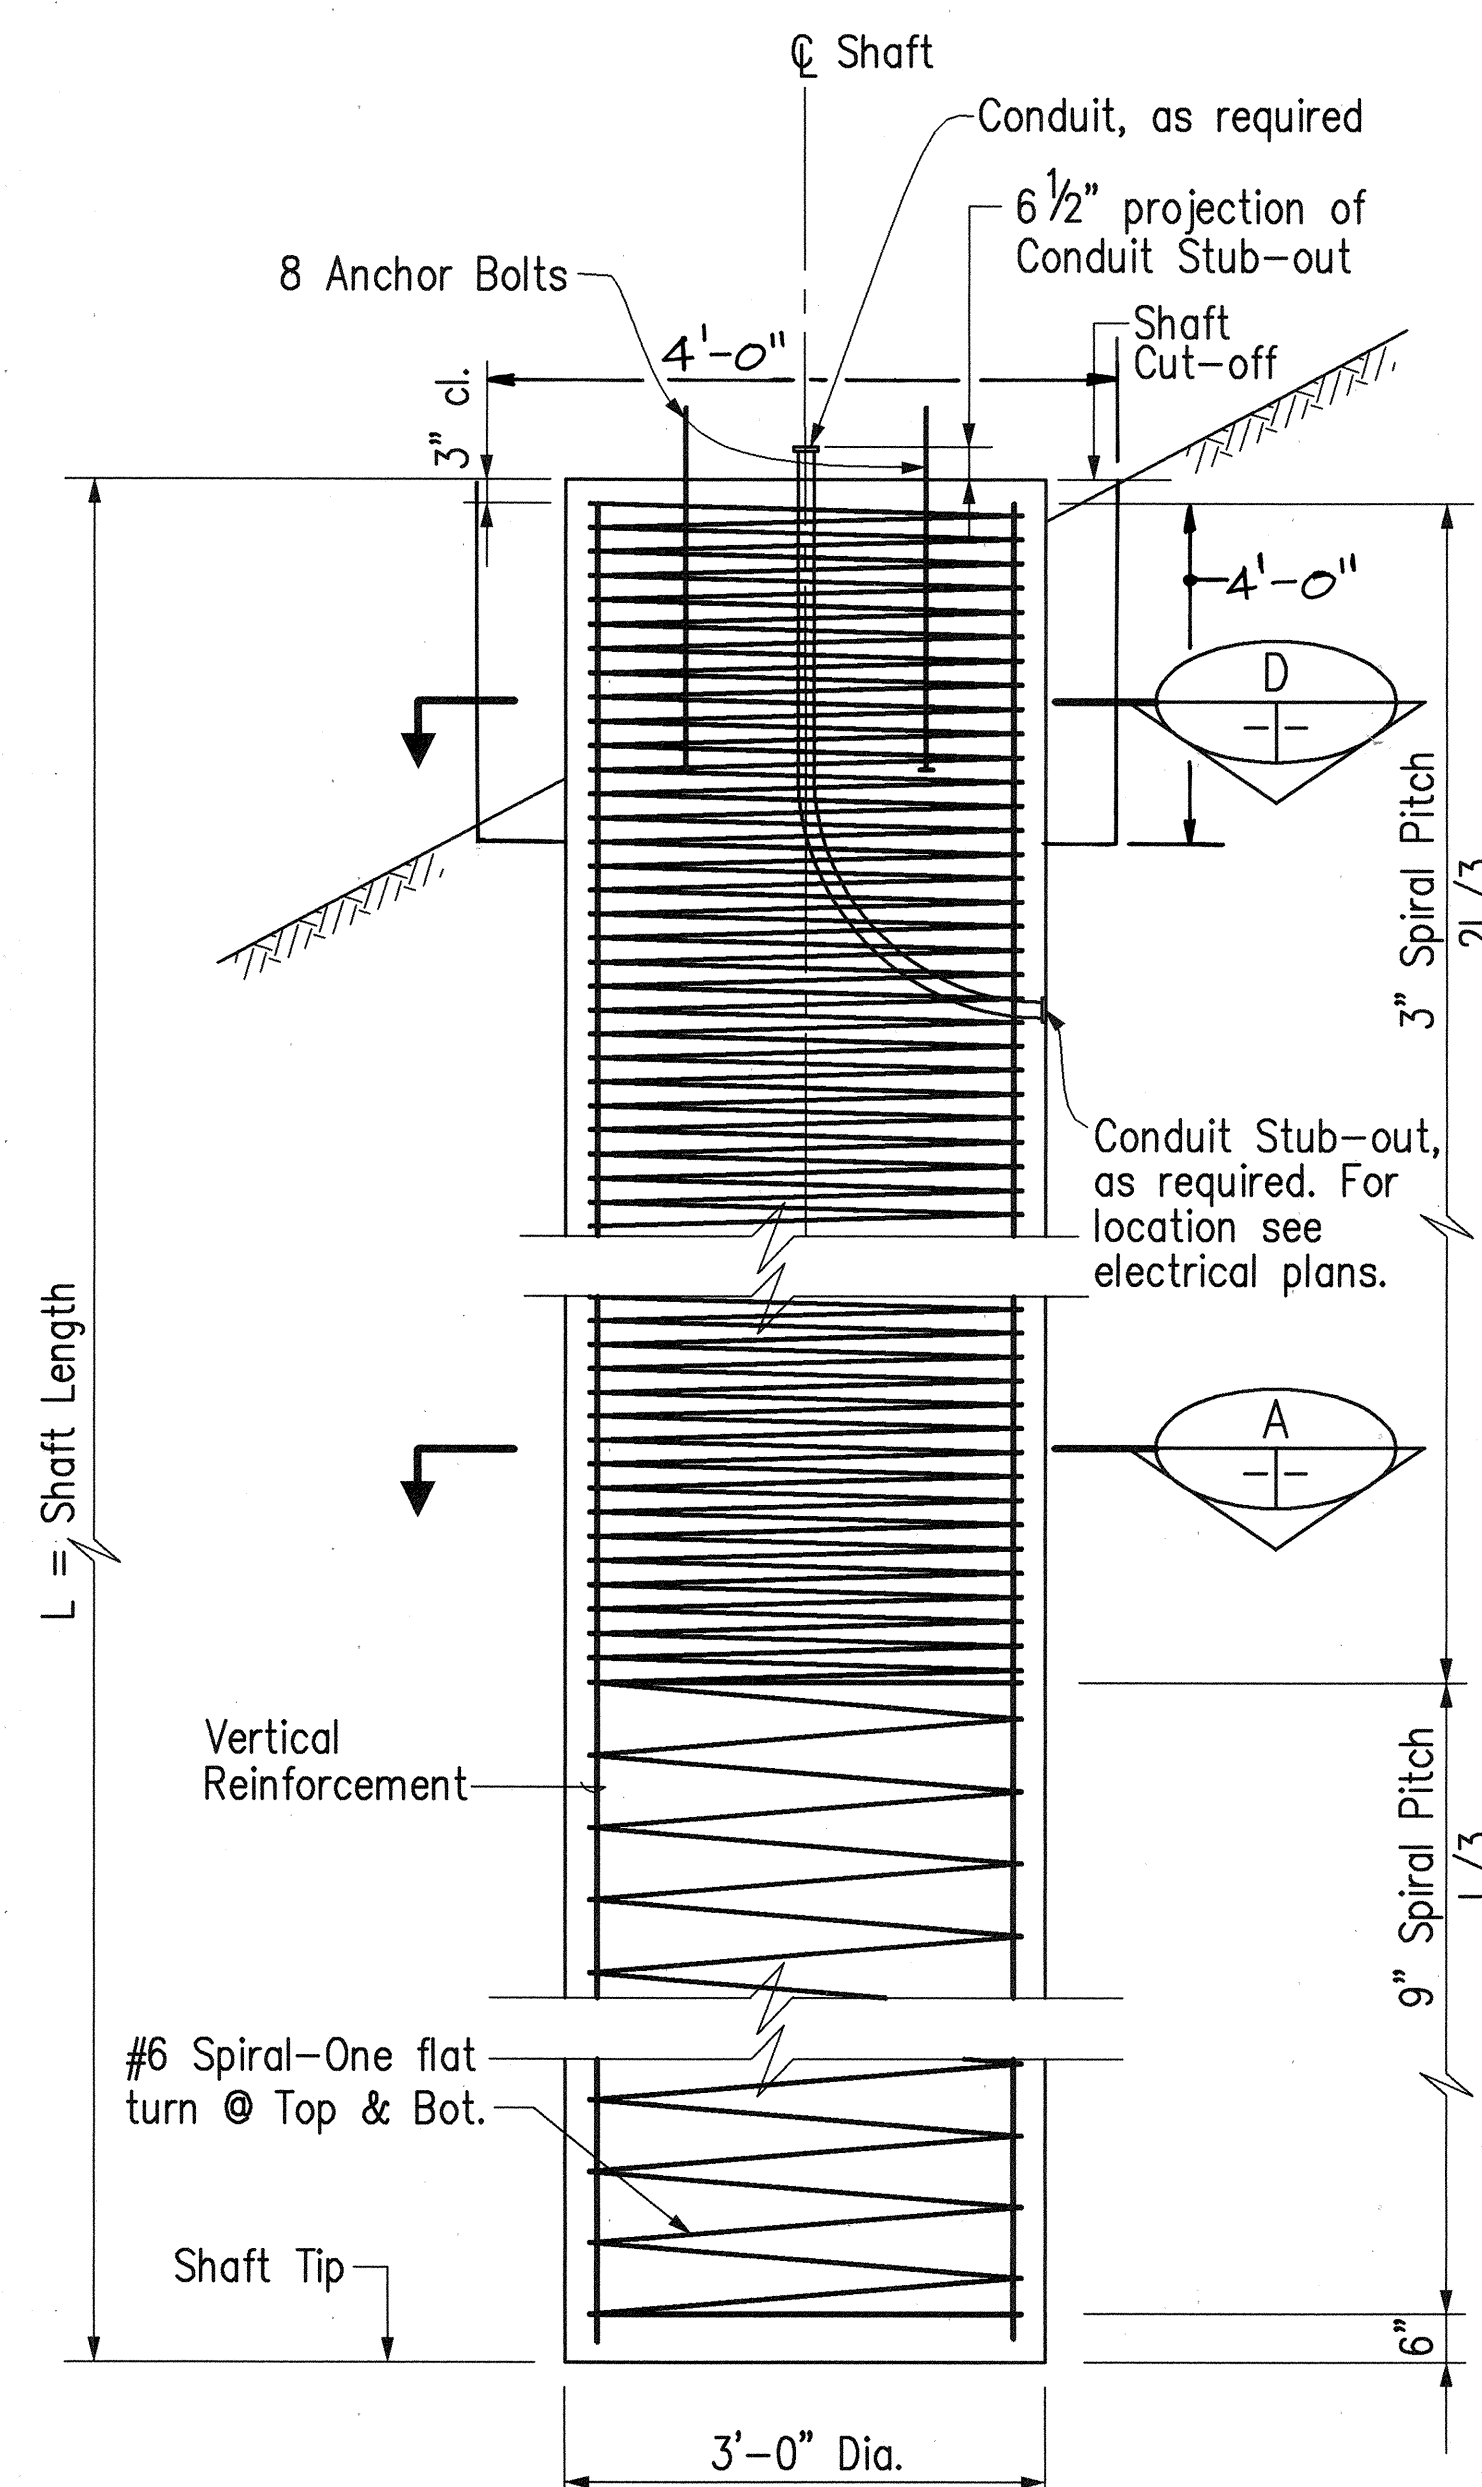


TYPE F DRILLED SHAFT ELEVATION
Not To Scale

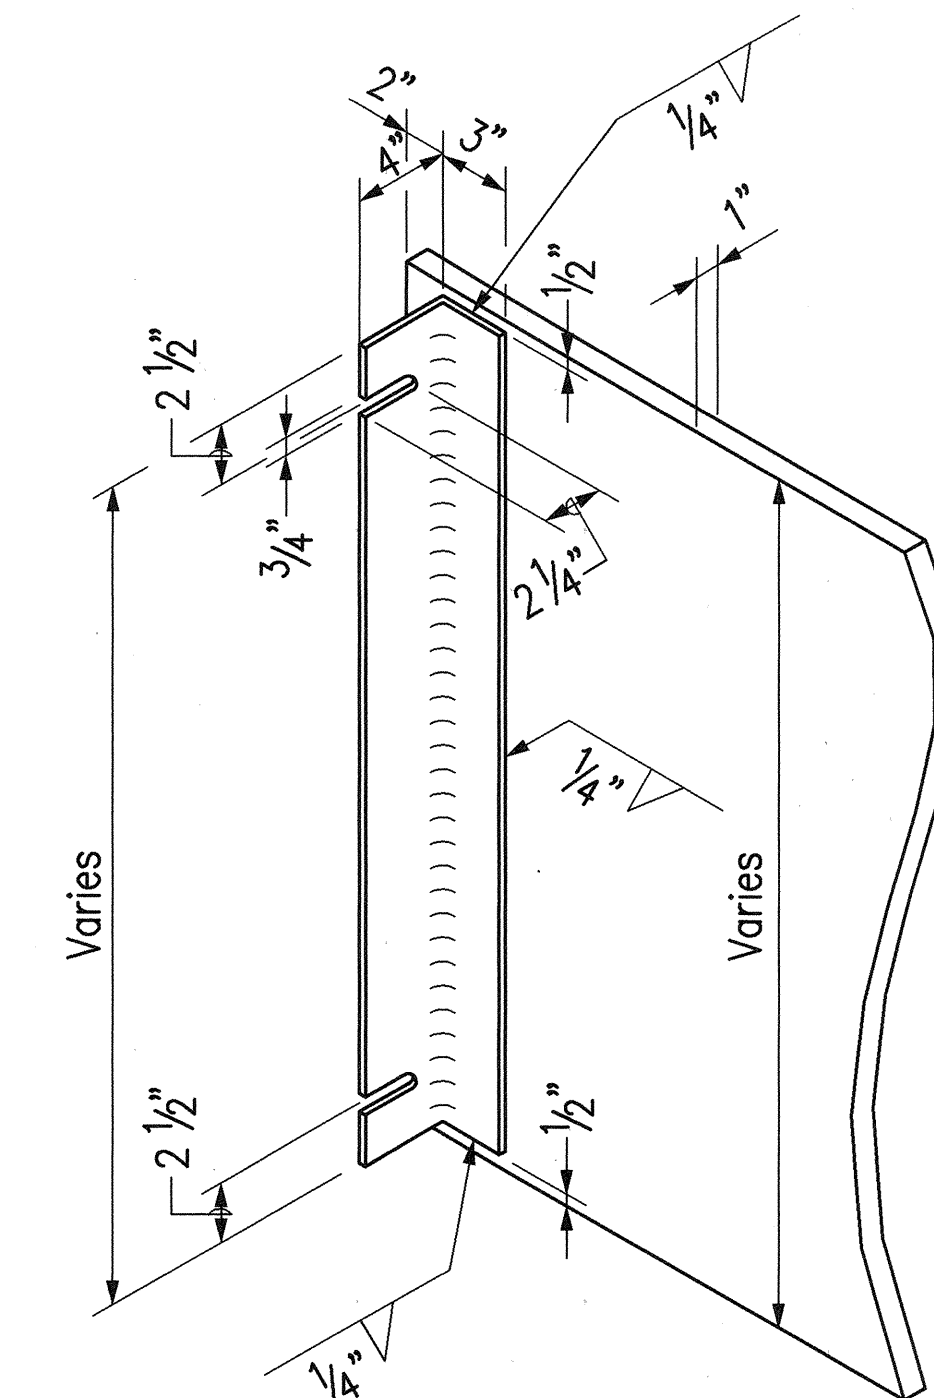


COVER PLATE DETAIL
Scale: 1 1/2" = 1'-0"

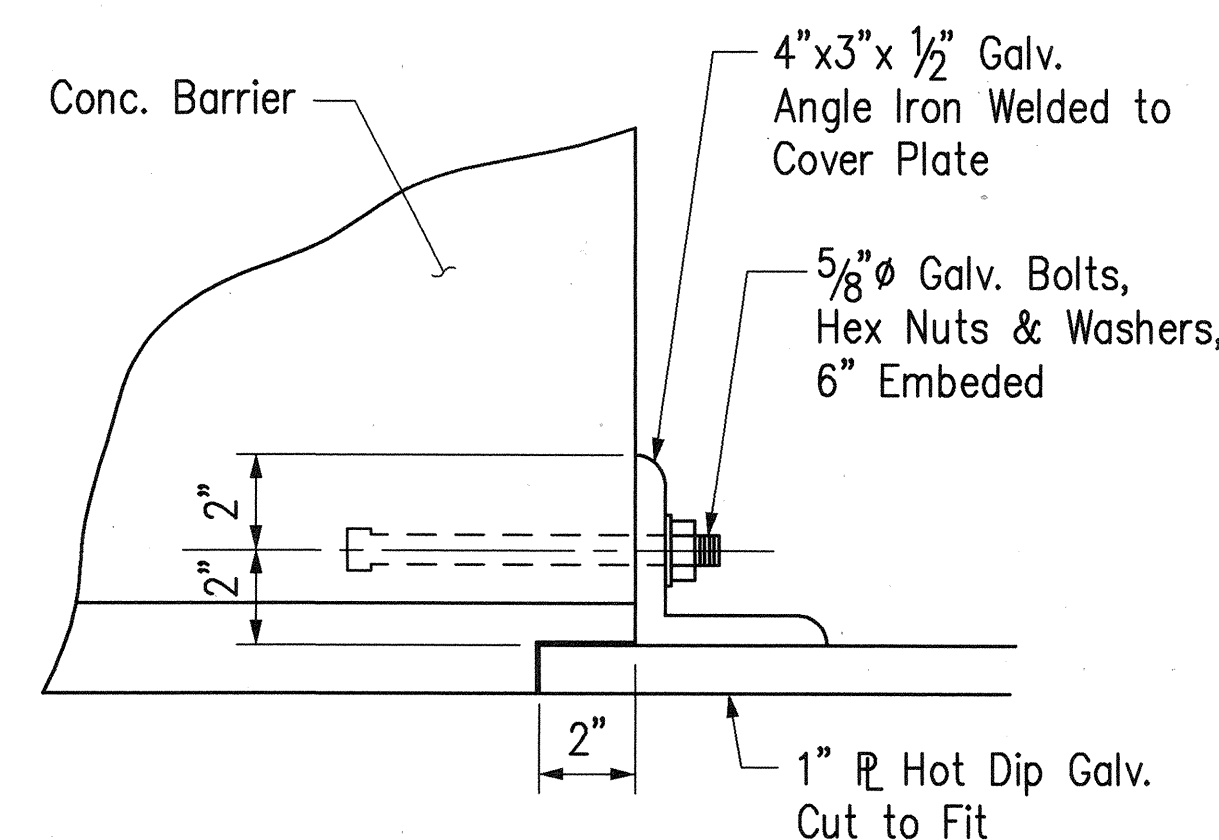


COVER PLATE ANCHOR DETAIL
Scale: 3" = 1'-0"

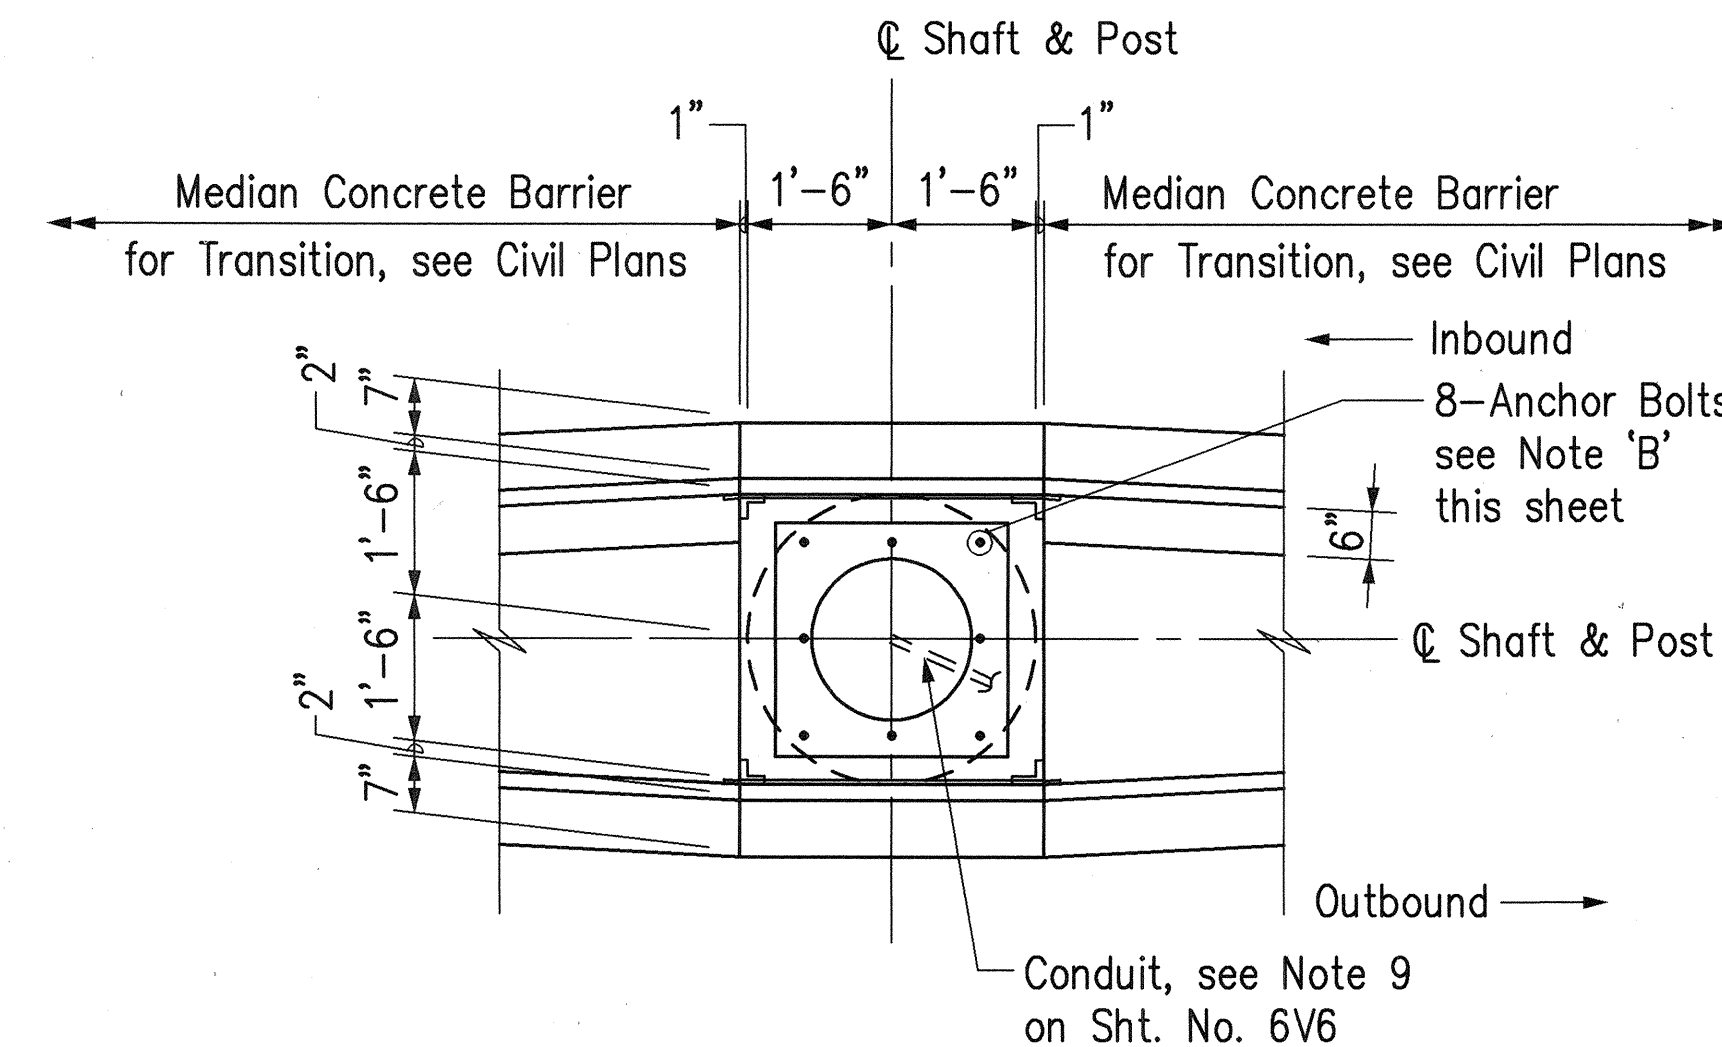


PLAN AT MEDIAN
SIGN STRUCTURE E-37L, E-37C & E-37R
Scale: 1/2" = 1'-0"

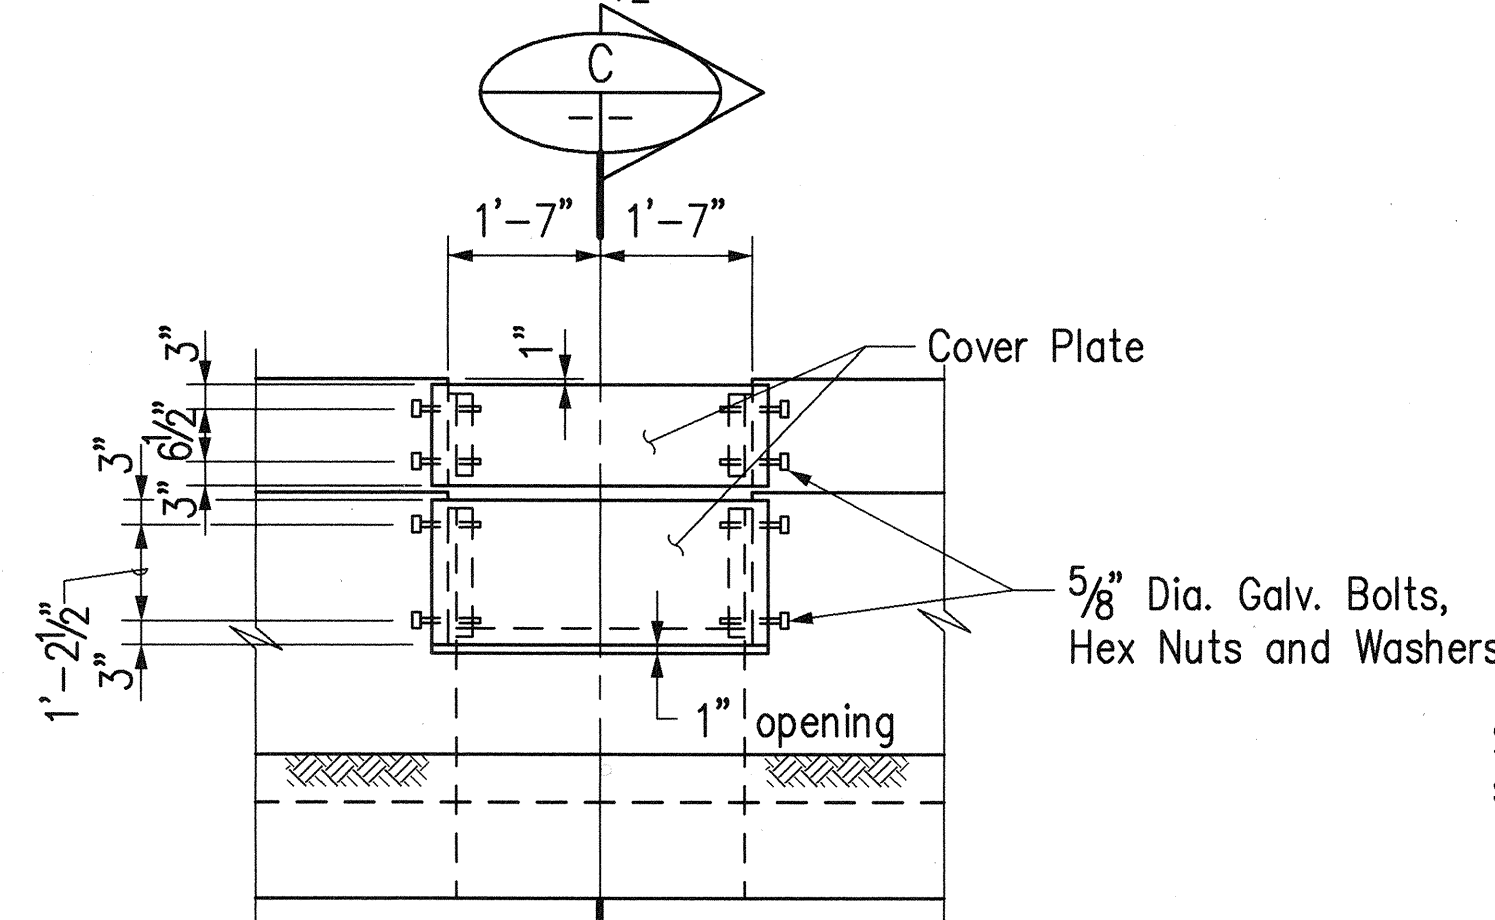

SIDE ELEVATION AT MEDIAN
SIGN STRUCTURE E-37L, E-37C & E-37R
Scale: 1/2" = 1'-0"

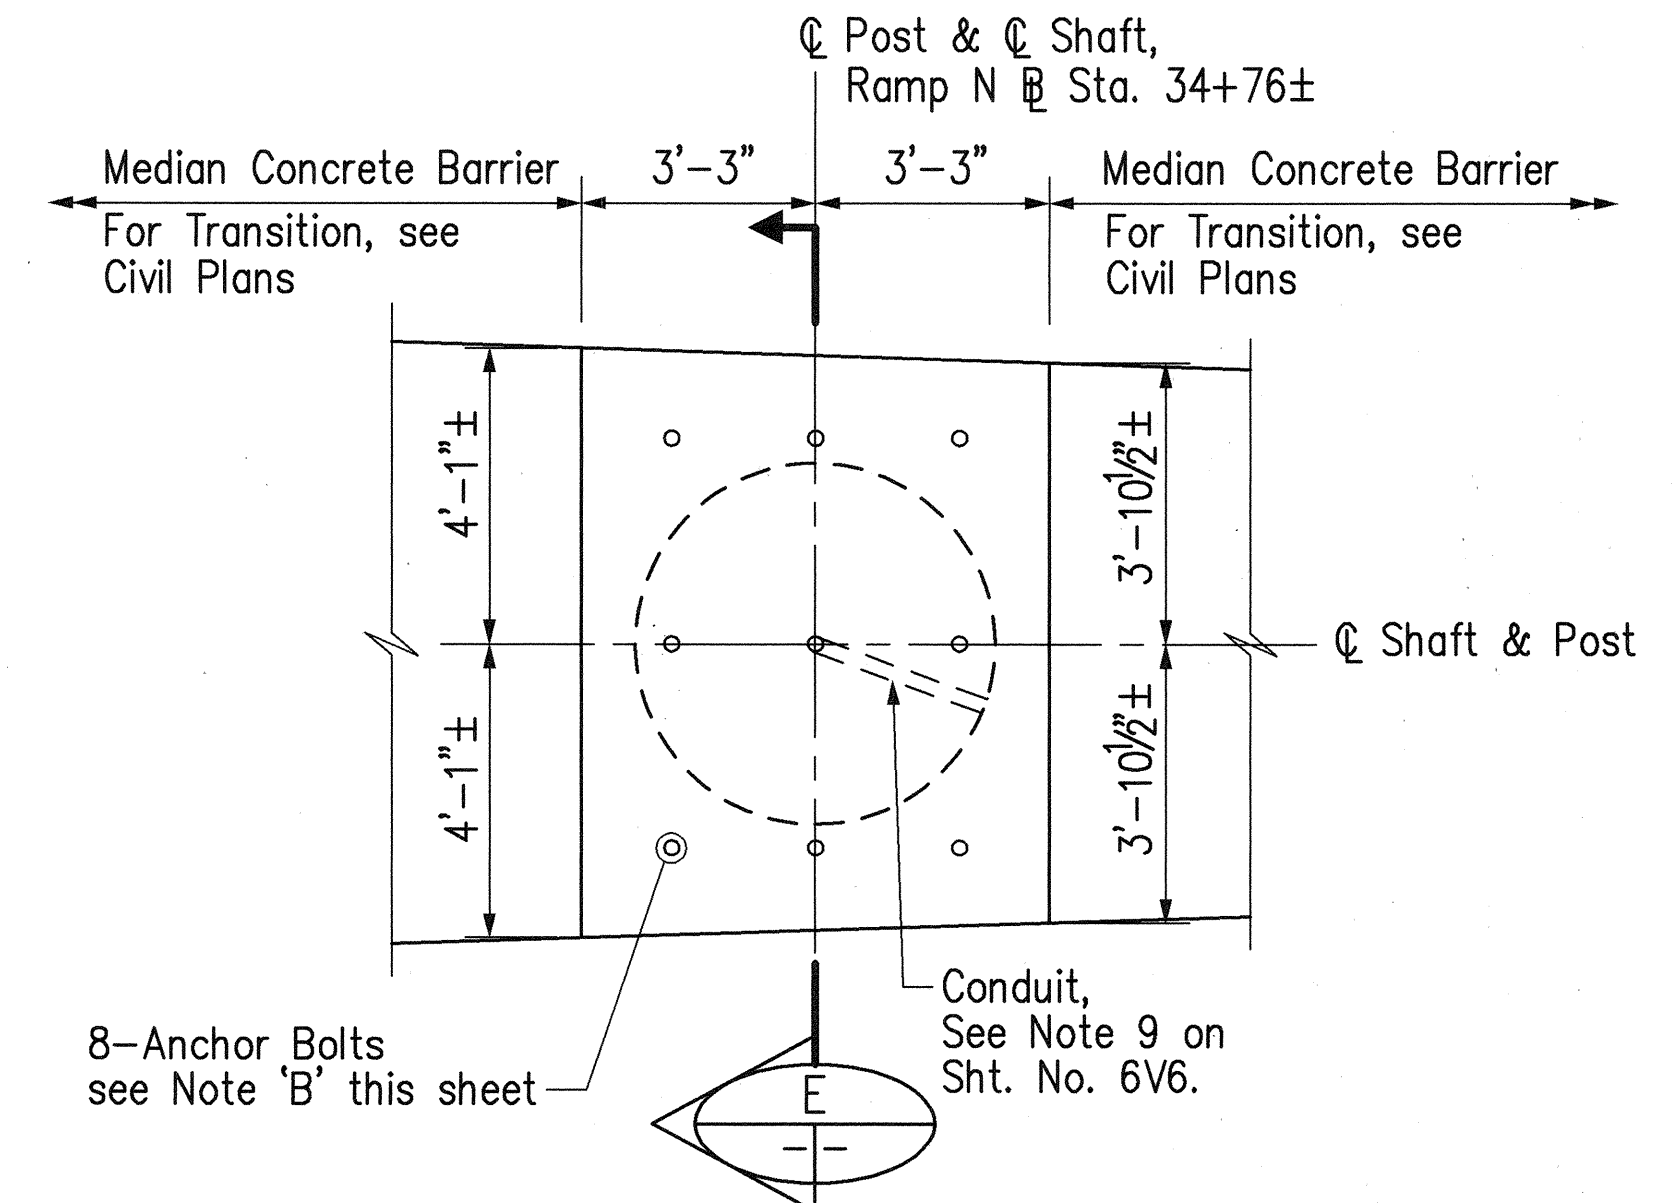

PLAN AT MEDIAN
SIGN STRUCTURE E-52L & E-52R
Scale: 3/8" = 1'-0"

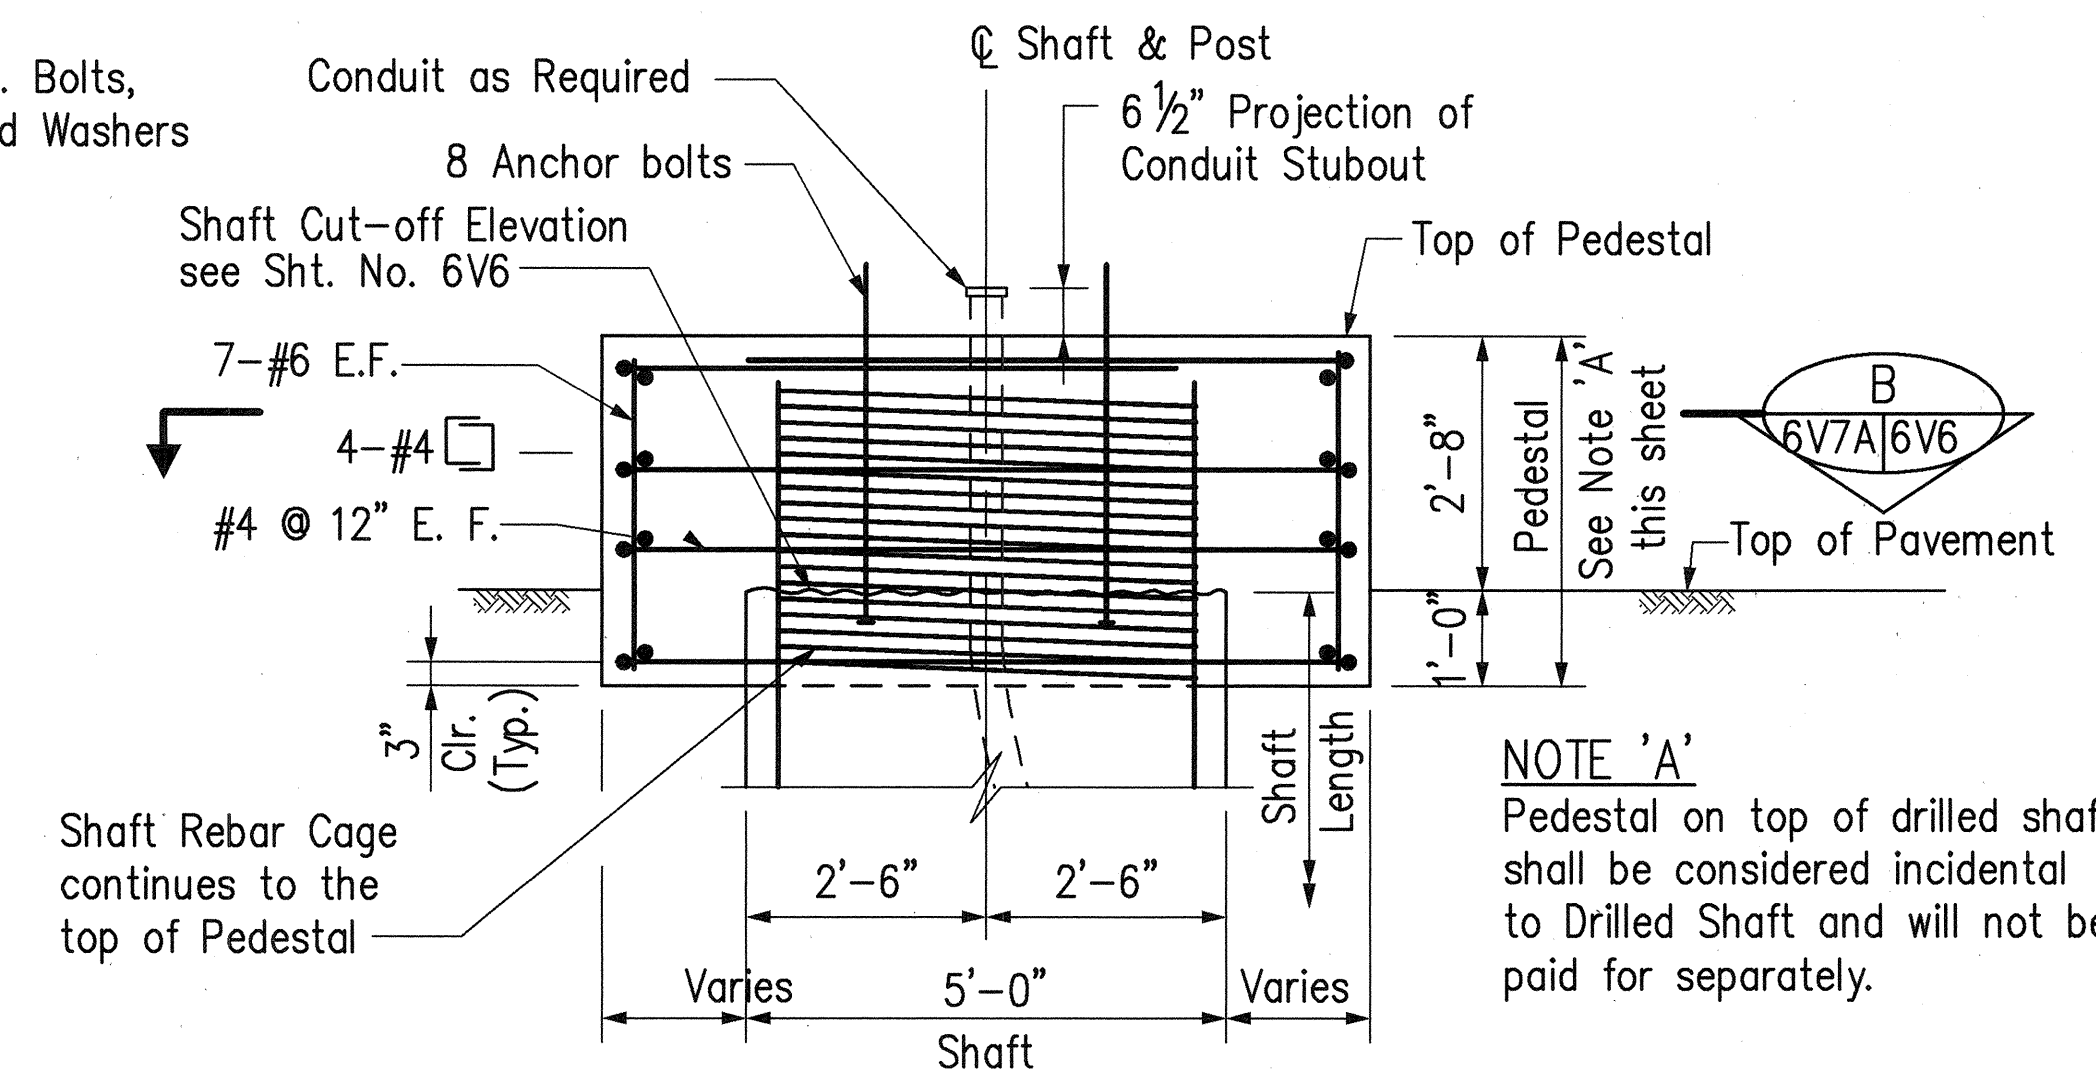


TYPE E DRILLED SHAFT ELEVATION

SECTION E
Scale: 1/2" = 1'-0"

NOTE:
For shaft rebar cage, see Type A Drilled Shaft Elevation on Sht. No. 6V6.


NOTE:
See Notes on Sht. No. 6V6.

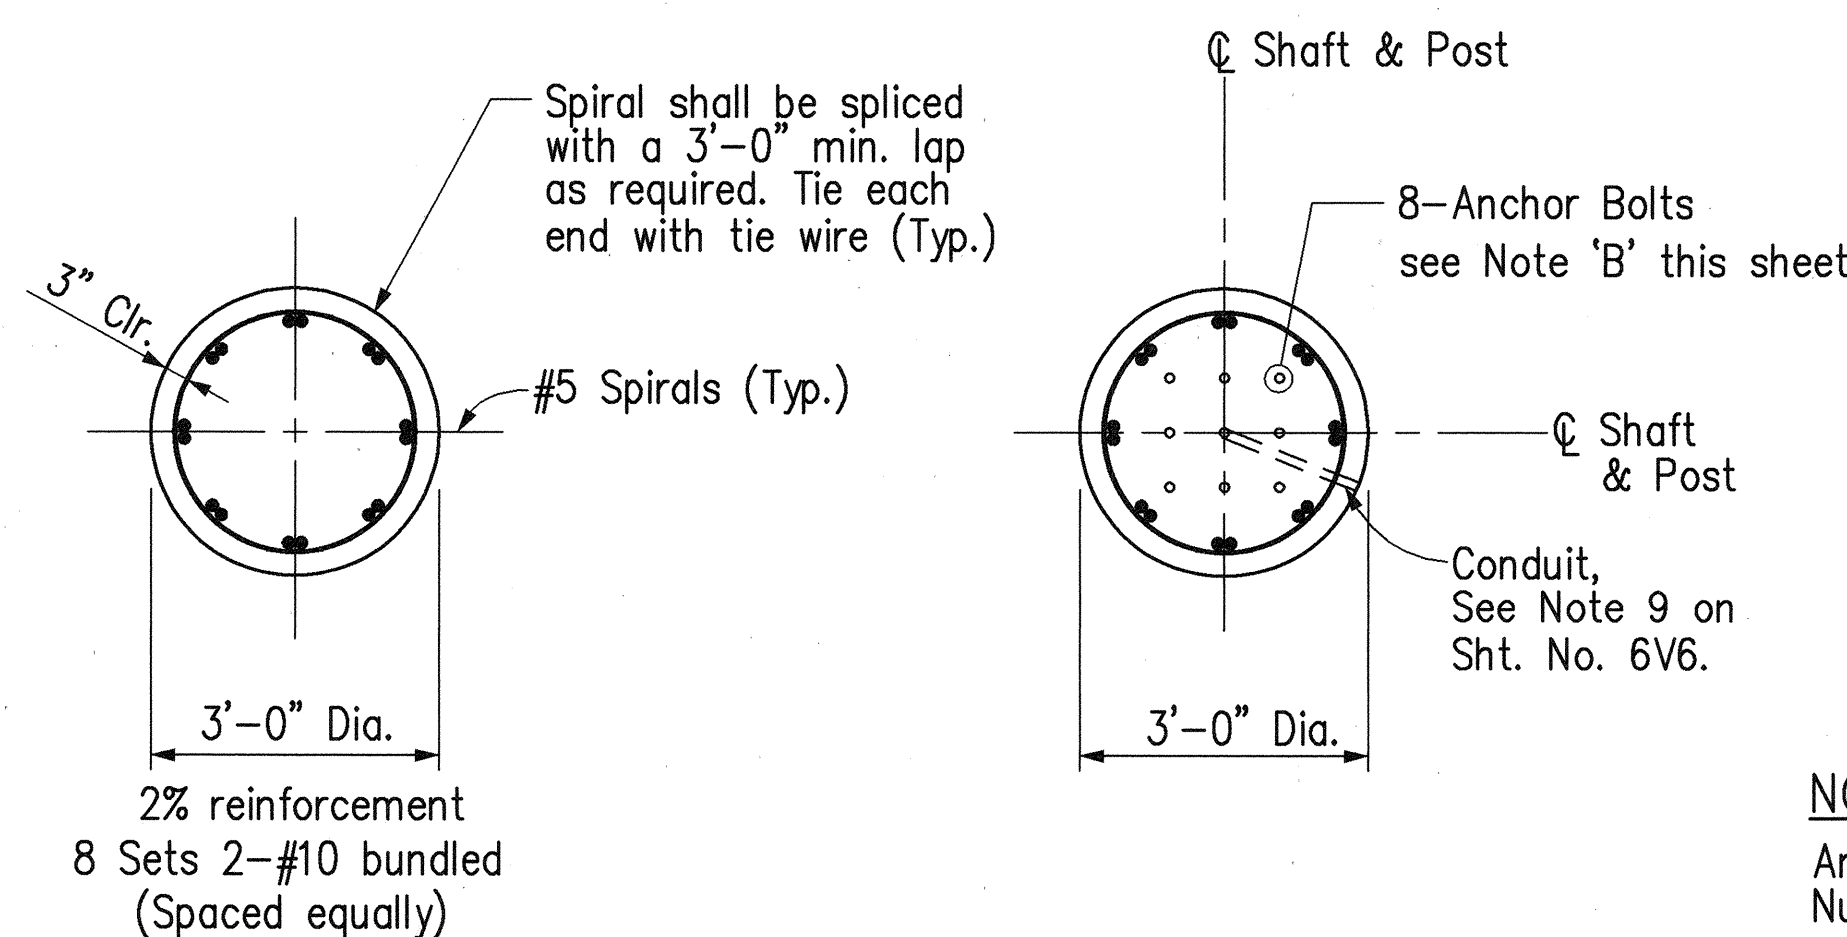

SECTION A
Scale: 1/2" = 1'-0"


SECTION D
Scale: 1/2" = 1'-0"

NOTE: 'B'
Anchor Bolts, Bolts, Nuts, Leveling Nuts & Washers, see Notes 8 & 9 on Sht. No. 6V6. For Anchor Bolt size & Details, see Sht. No. 6V4 & Sht. No. 6V6.

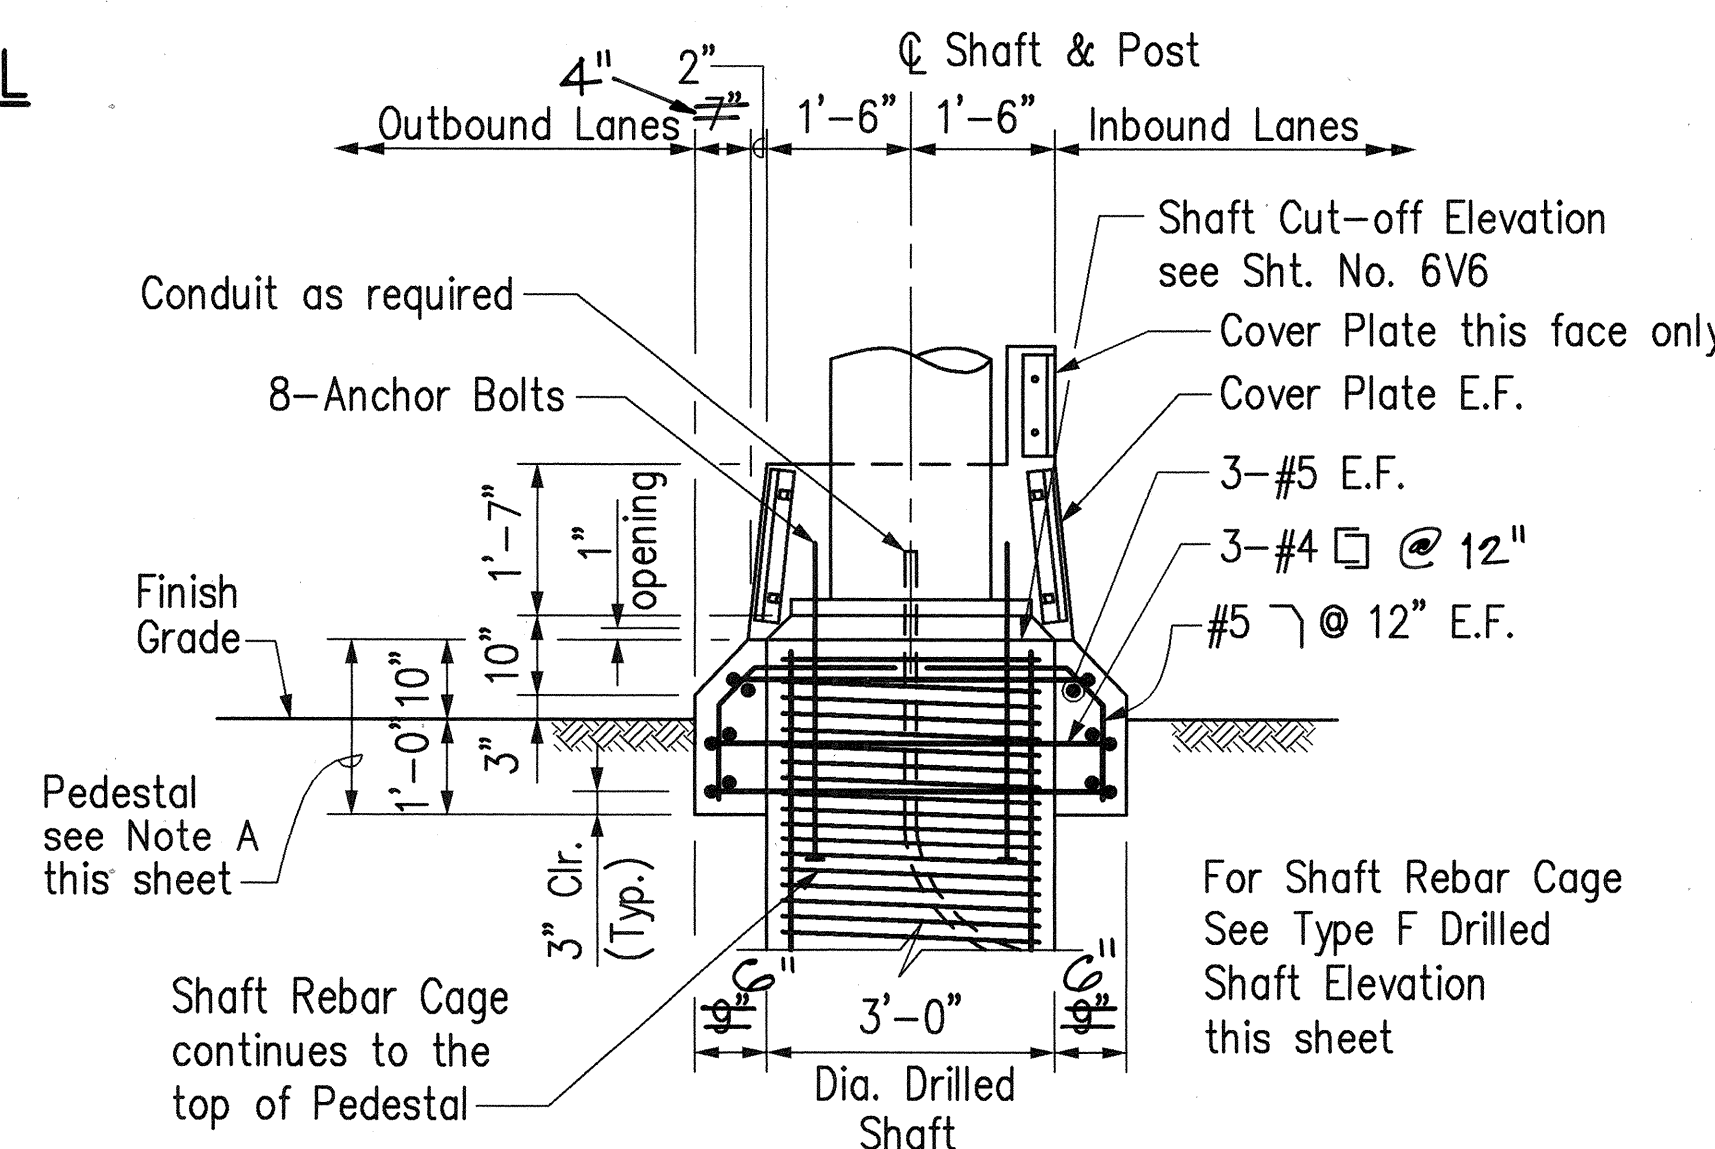

TYPE G DRILLED SHAFT ELEVATION

SECTION C
Scale: 1/2" = 1'-0"

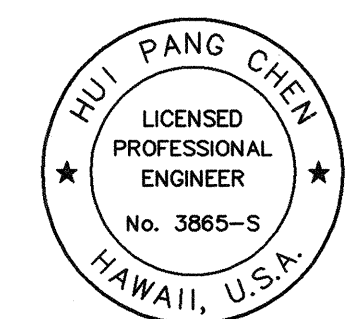

THIS WORK WAS PREPARED BY ME OR UNDER MY SUPERVISION.
Hui Pang Chen

5/2/97	Added Cover Plate
4/21/97	Added this Sheet
Date	Revision
STATE OF HAWAII DEPARTMENT OF TRANSPORTATION HIGHWAYS DIVISION	
DESTINATION SIGNS SIGN STRUCTURES FOUNDATION DETAILS	
H-3 FINISH (UNIT II) FAIP NO. I-H3-1(75), UNIT II LEEWARD SECTION	
SCALE: AS SHOWN	DATE:
SHEET NO. 6V7A OF 14 SHEETS	


ADD. 877S-1

ORIGINAL SURVEY PLOTTED BY: DATE: _____
DRAWN BY: _____
CHECKED BY: _____
DESIGNED BY: _____
NOTED BY: _____
No. _____

CAD by D. Burgess, 5/2/97

Last Saved: J:\H3RF\RFU2\SIGN\5-SHAFT2.dwg 04/29/97 at 14:39

FED. ROAD DIST. NO.	STATE	FED. AID PROJ. NO.	FISCAL YEAR	SHEET NO.	TOTAL SHEETS
HAWAII	HAW.	I-H3-1(75), UNIT II	1997	C.O. 877S-2	1102

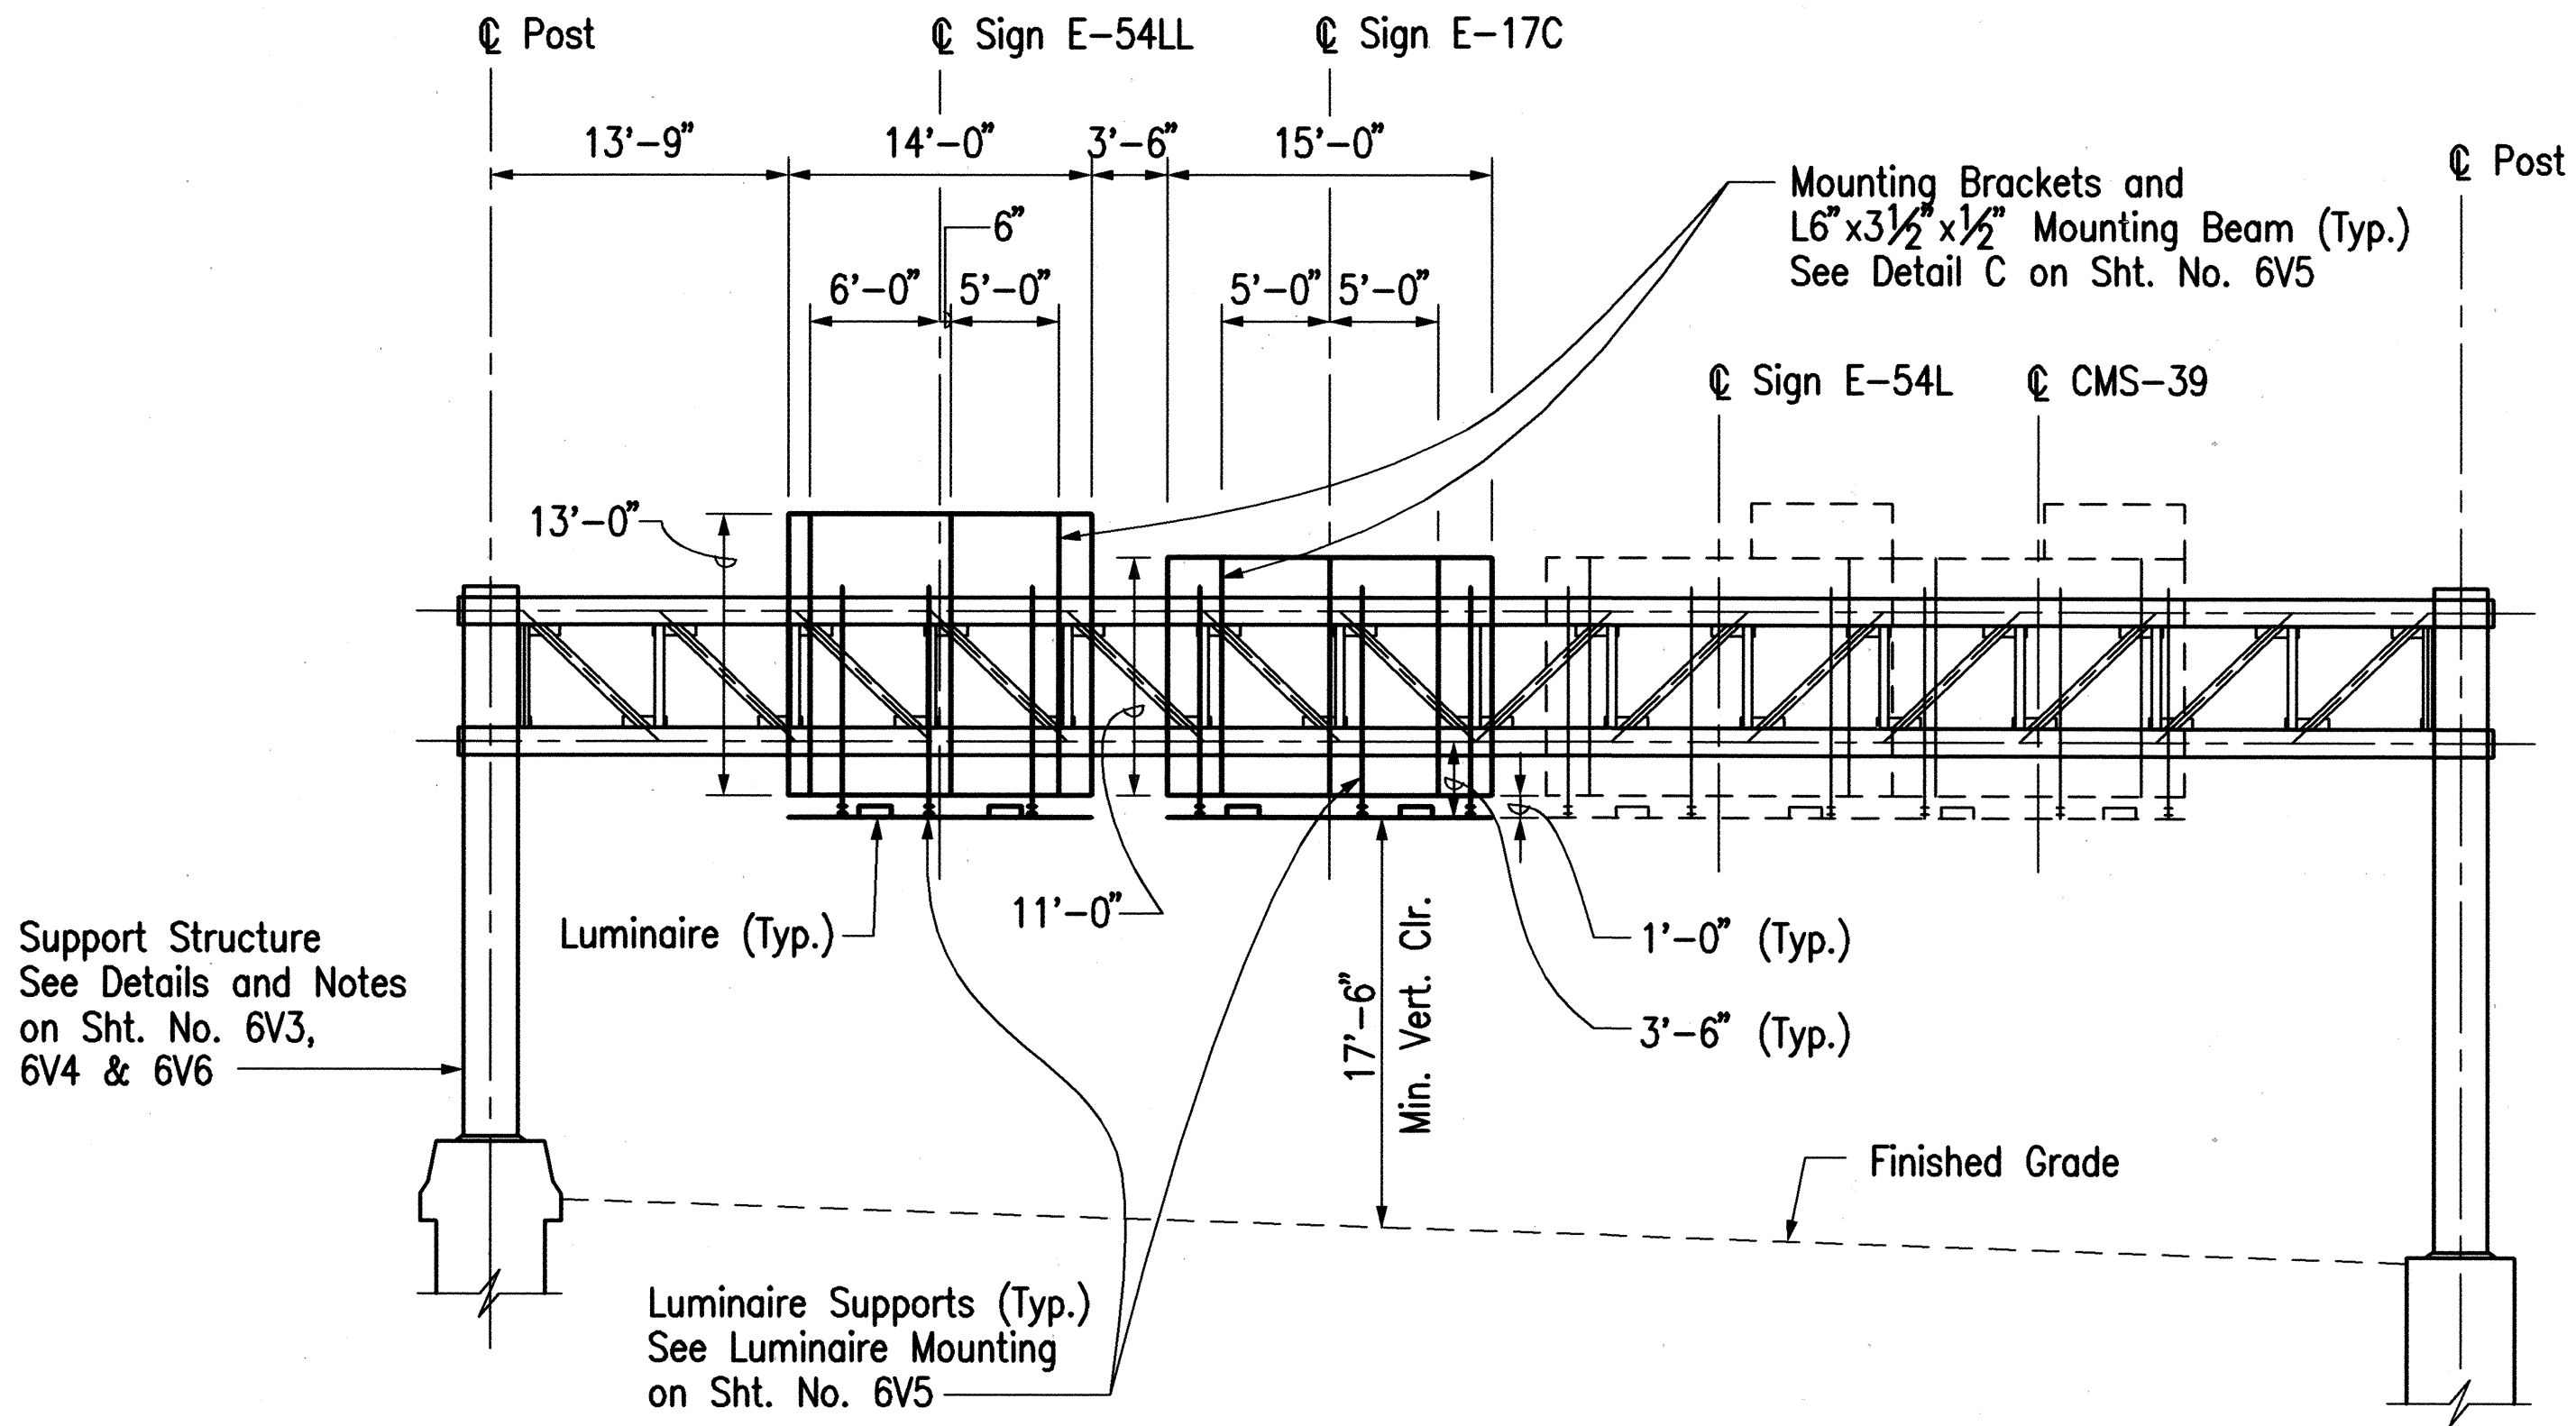


ELEVATION - SIGN E-54LL & CMS-39
MOANALUA FREEWAY OUTBOUND STA. 207+25±
Scale: 1/8" = 1'-0"

ORIGINAL PLAN	SURVEY PLOTTED BY	DATE
NOTE BOOK	DRAWN BY	
	TRACED BY	
	QUANTITIES BY	
	CHECKED BY	
No.		

55-52

Last Saved: J:\H3RF\RFU2\CO\SIGN\Co-e54.dwg 07/15/98 at 18:05

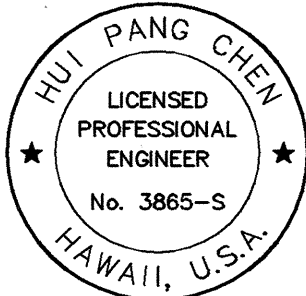

THIS WORK WAS PREPARED BY ME
OR UNDER MY SUPERVISION.

Hui Pang Chen

Date	Revision
7/10/98	Added Signs E-54LL & E-17C

STATE OF HAWAII DEPARTMENT OF TRANSPORTATION HIGHWAYS DIVISION
DESTINATION SIGNS SIGN STRUCTURES
H-3 FINISH (UNIT II) FAIP NO. I-H3-1(75), UNIT II LEEWARD SECTION
SCALE: AS SHOWN DATE:

SHEET NO. 6V7B OF 14 SHEETS

C.O. 877S-2

SIGN	CHORD O.D. *		"C"	ALUMINUM BEAM
	MAX.	MIN.		
E-2L	8.25"	6.15"	1' - 9 3/4"	L 5"X3"X1/2"
E-2C	8.25"	6.15"	1' - 9 3/4"	L 6"X3 1/2"X1/2"
E-2R	6.17"	4.06"	1' - 9 5/8"	L 5"X3"X1/2"
E-6L	7.06"	6.15"	1' - 9 3/4"	L 5"X3"X1/2"
E-6C	7.06"	6.15"	1' - 9 3/4"	L 5"X3"X1/2"
E-6R	7.06"	4.18"	1' - 9 5/8"	L 5"X3"X1/2"
E-8L	6.63"	6.63"	2' - 0 5/16"	L 5"X3"X1/2"
E-8C	6.63"	6.63"	2' - 0 5/16"	L 6"X3 1/2"X1/2"
E-8R	6.63"	6.63"	2' - 0 5/16"	L 6"X3 1/2"X1/2"
E-15L	4.5"	4.5"	1' - 10 3/16"	L 5"X3"X1/2"
E-15C	4.5"	4.5"	1' - 10 3/16"	L 5"X3"X1/2"
CMS 42	4.5"	4.5"	1' - 10 3/16"	**
E-27L	4.5"	4.5"	1' - 10 3/16"	L 5"X3"X1/2"
E-27C	4.5"	4.5"	1' - 10 3/16"	L 5"X3"X1/2"
E-27R	4.5"	4.5"	1' - 10 3/16"	L 5"X3"X1/2"
E-30L	4.5"	4.5"	1' - 10 3/16"	L 6"X3 1/2"X1/2"
E-30R	4.5"	4.5"	1' - 10 3/16"	L 5"X3"X1/2"
E-33L	7.06"	4.06"	1' - 9 5/8"	L 6"X3 1/2"X1/2"
E-33C	7.06"	4.18"	1' - 9 5/8"	L 5"X3"X1/2"
E-33R	6.15"	4.18"	1' - 9 5/8"	L 5"X3"X1/2"
CMS 40	4.5"	4.5"	1' - 10 3/16"	**
E-40C	4.5"	4.5"	1' - 10 3/16"	L 6"X3 1/2"X1/2"
E-40R	4.5"	4.5"	1' - 10 3/16"	L 5"X3"X1/2"
CMS 41	4.5"	4.5"	1' - 10 3/16"	**
E-41R	4.5"	4.5"	1' - 10 3/16"	L 6"X3 1/2"X1/2"

Sign Panel

Alum. Beam
See Table 1

Gusset Pl.
 $\frac{1}{2}$ " x 10" x 1'-2"
(A36 Steel)

$\frac{3}{8}$ " $\varnothing$ U-Bolt w/
Hex Nut & Lock
Washer (Galv.)

Chord

See Note 3

L $3\frac{1}{2}$ " x $3\frac{1}{2}$ " x $\frac{1}{4}$ "
(A36 Steel)

STATE OF HAWAII
DEPARTMENT OF TRANSPORTATION
HIGHWAYS DIVISION

DESTINATION SIGNS
EXISTING SIGN STRUCTURES
SIGN MOUNTING DETAILS - 1


H-3 FINISH (UNIT II)
FAIP NO. I-H3-1(75), UNIT II
LEEWARD SECTION

SCALE: AS SHOWN DATE: JANUARY 1997

SHEET NO. 6V8 OF 14 SHEETS

A circular professional engineer seal. The outer ring contains the text "HUI PANG CHEN" at the top and "HAWAII, U.S.A." at the bottom, separated by two five-pointed stars on the left and right. The inner circle contains the text "LICENSED PROFESSIONAL ENGINEER" and "No. 3865-S" below it.


Shirong Chen

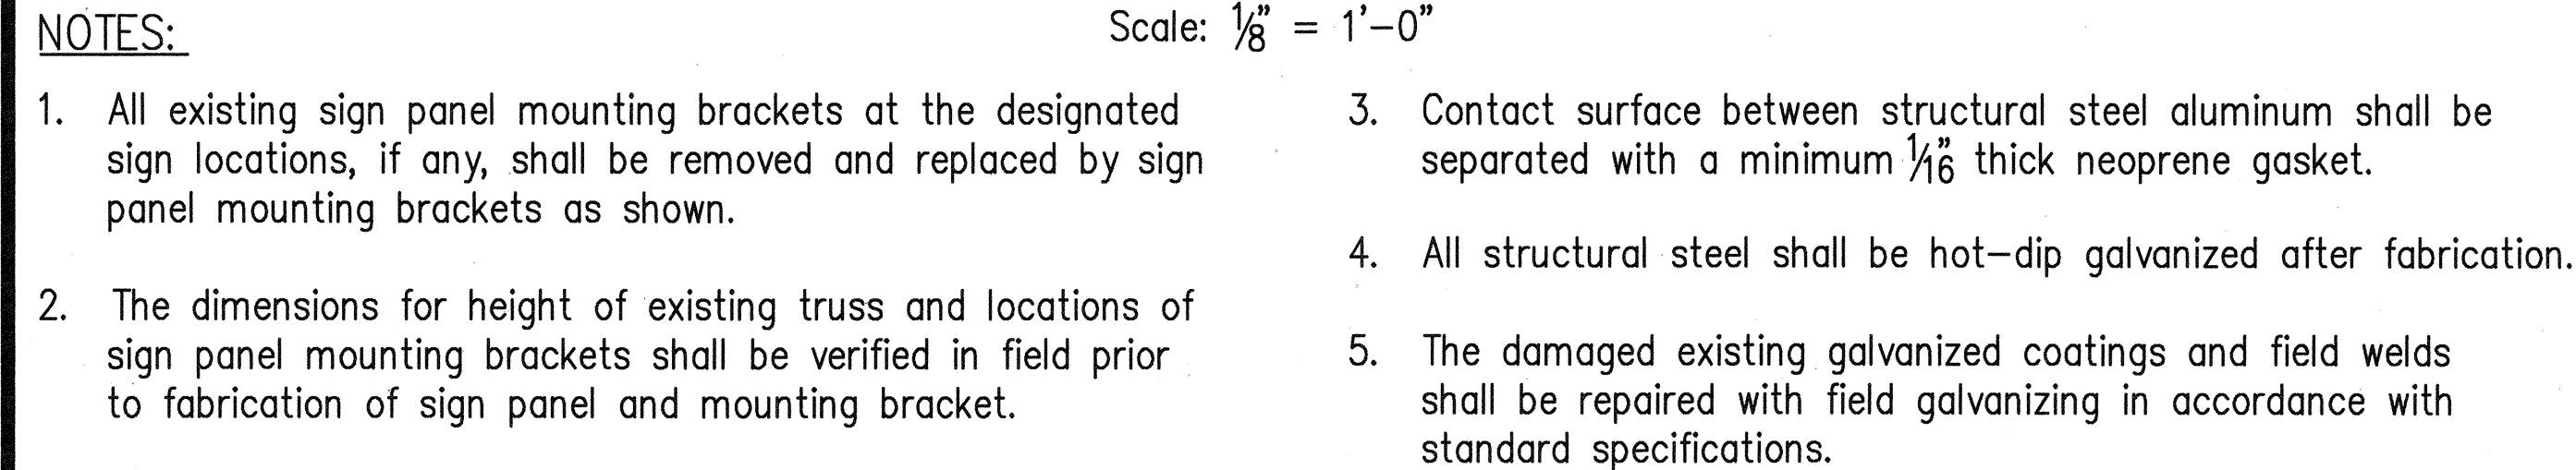

Last Saved: J:\H3RF\RFU2\CO\SIGN\CO-SMD-1.dwg 10/09/97 at 12:08

LEGEND


Exist. Sign to be removed

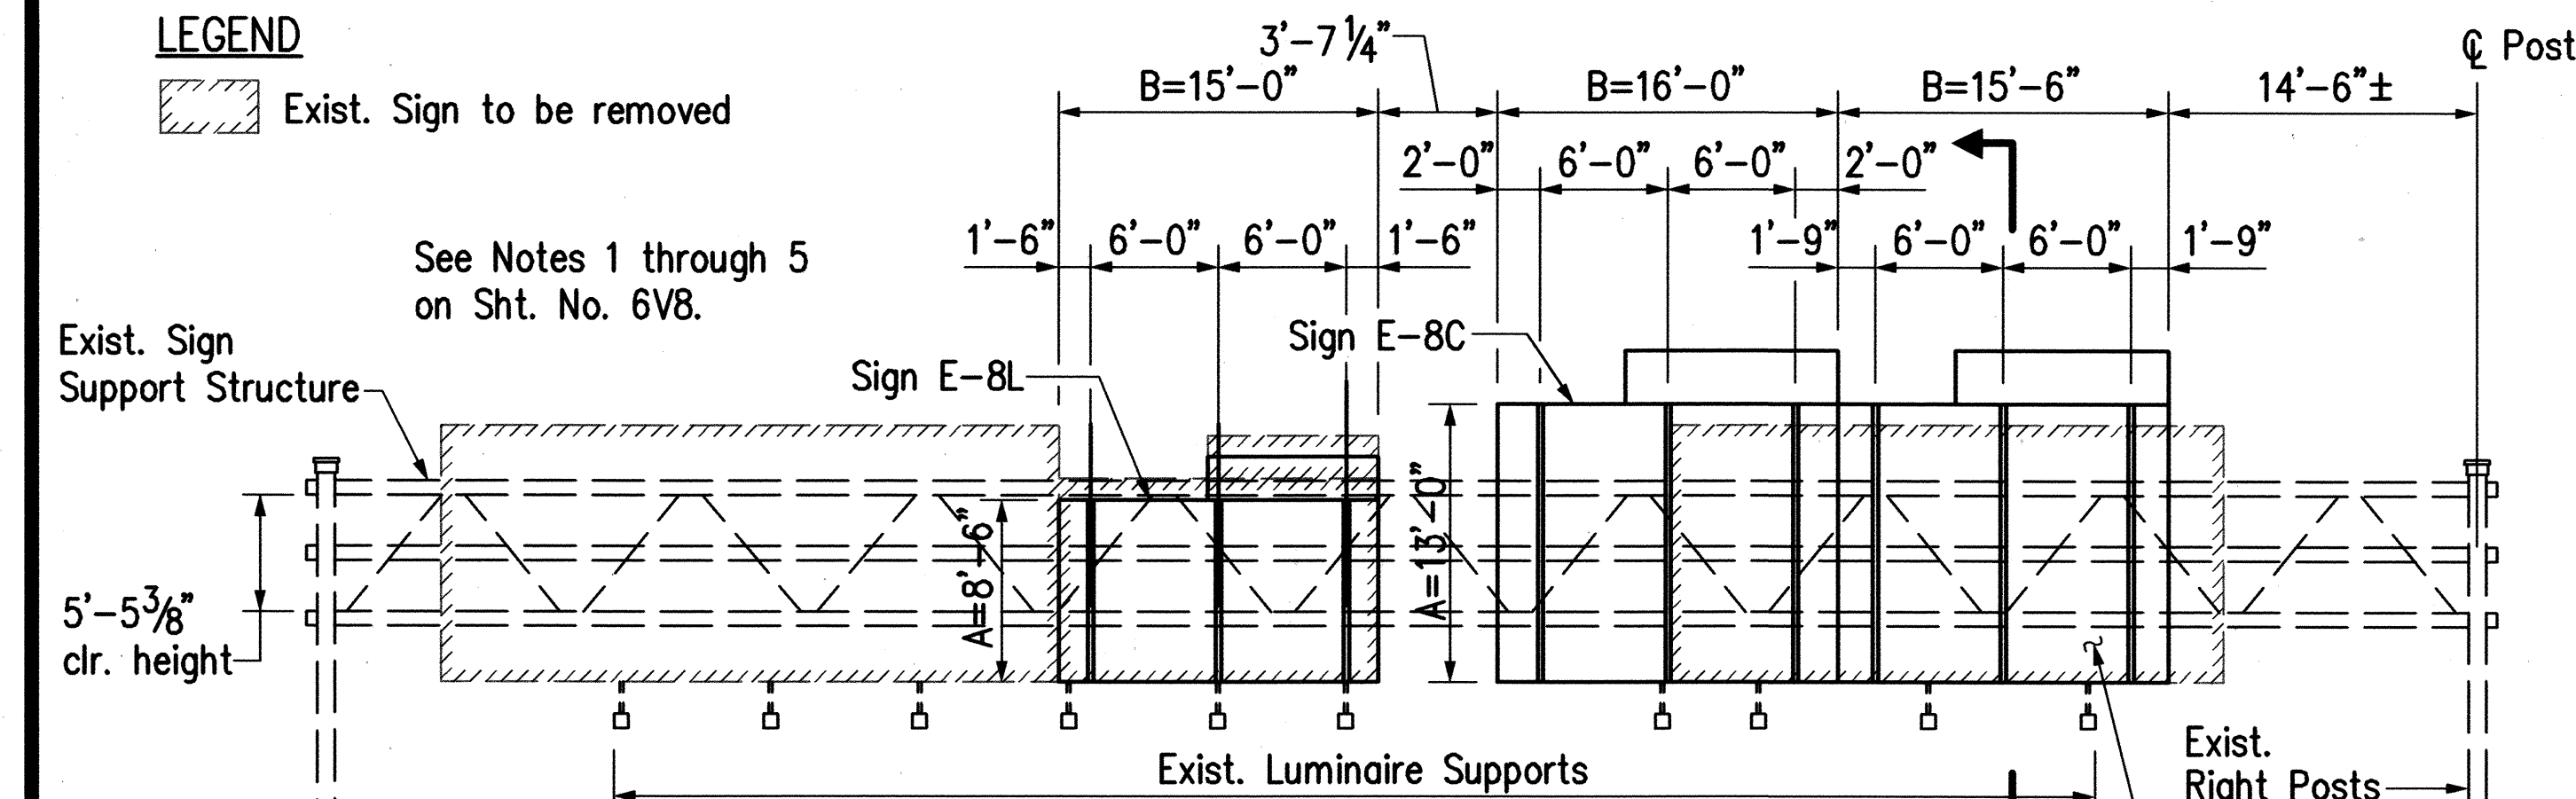

ELEVATION - SIGN E-8L, E-8C, & E-8R

INTERSTATE ROUTE H-1 INBOUND STA. 200+65


Scale: 1/8" = 1'-0"

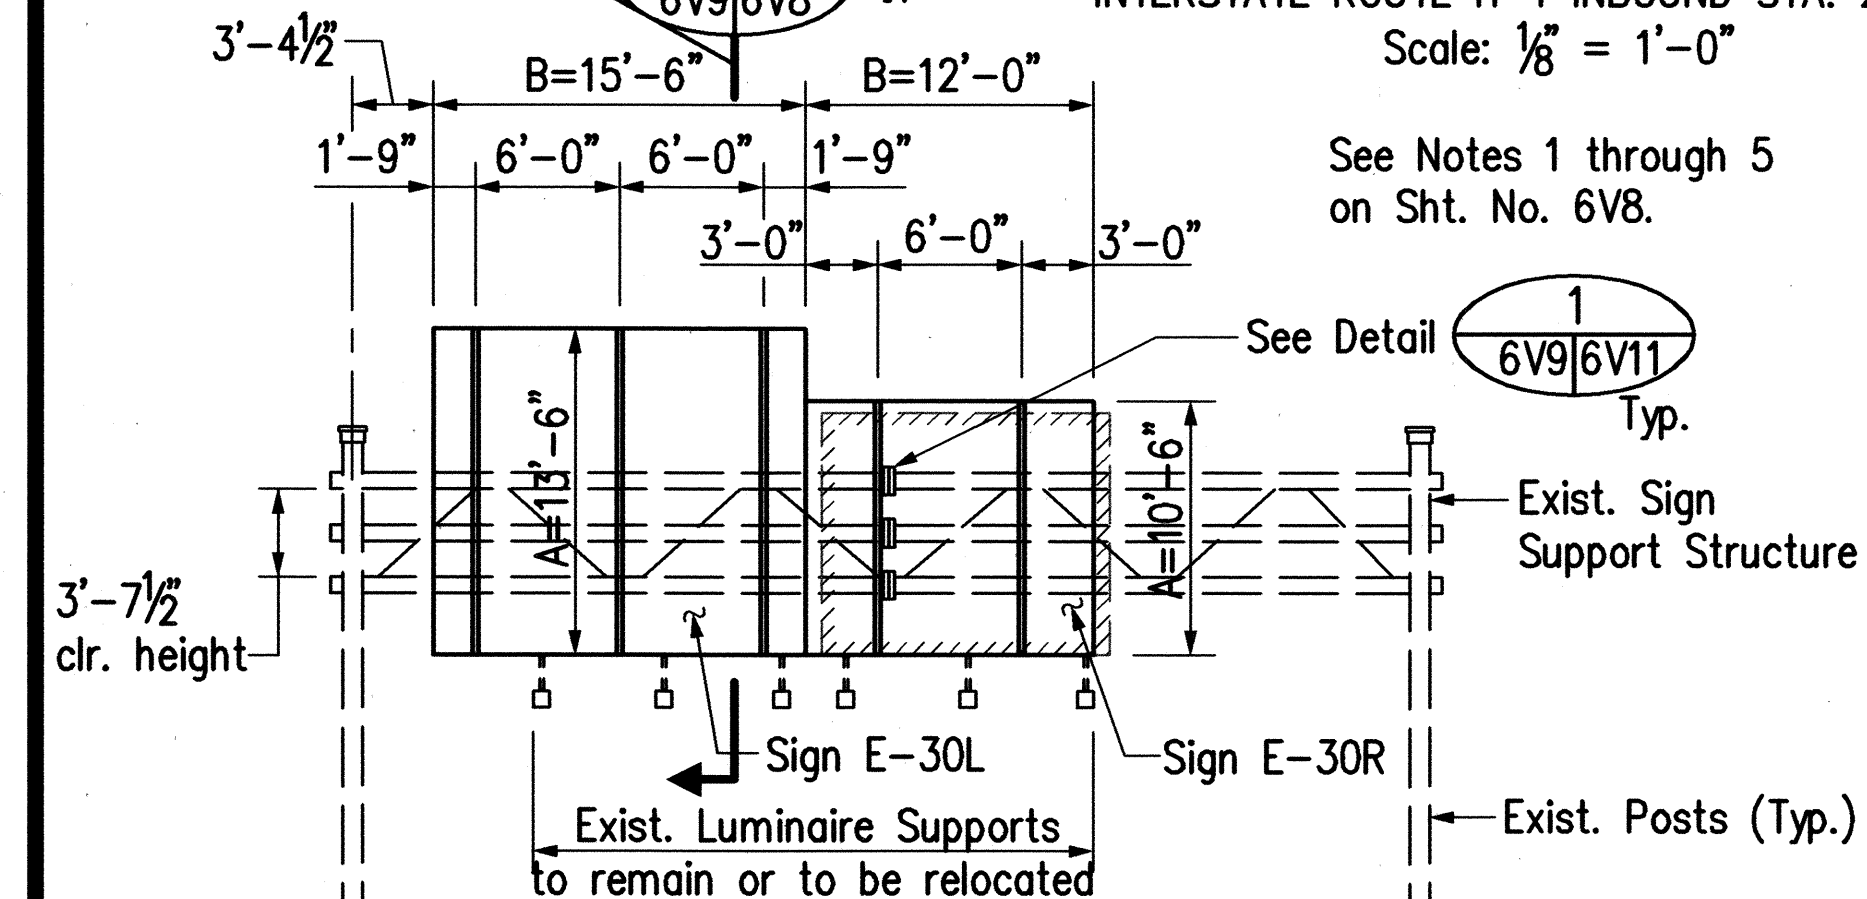

ELEVATION - SIGN E-30L & E-30R

RAMP WE STA. 225+25

Scale: 1/8" = 1'-0"

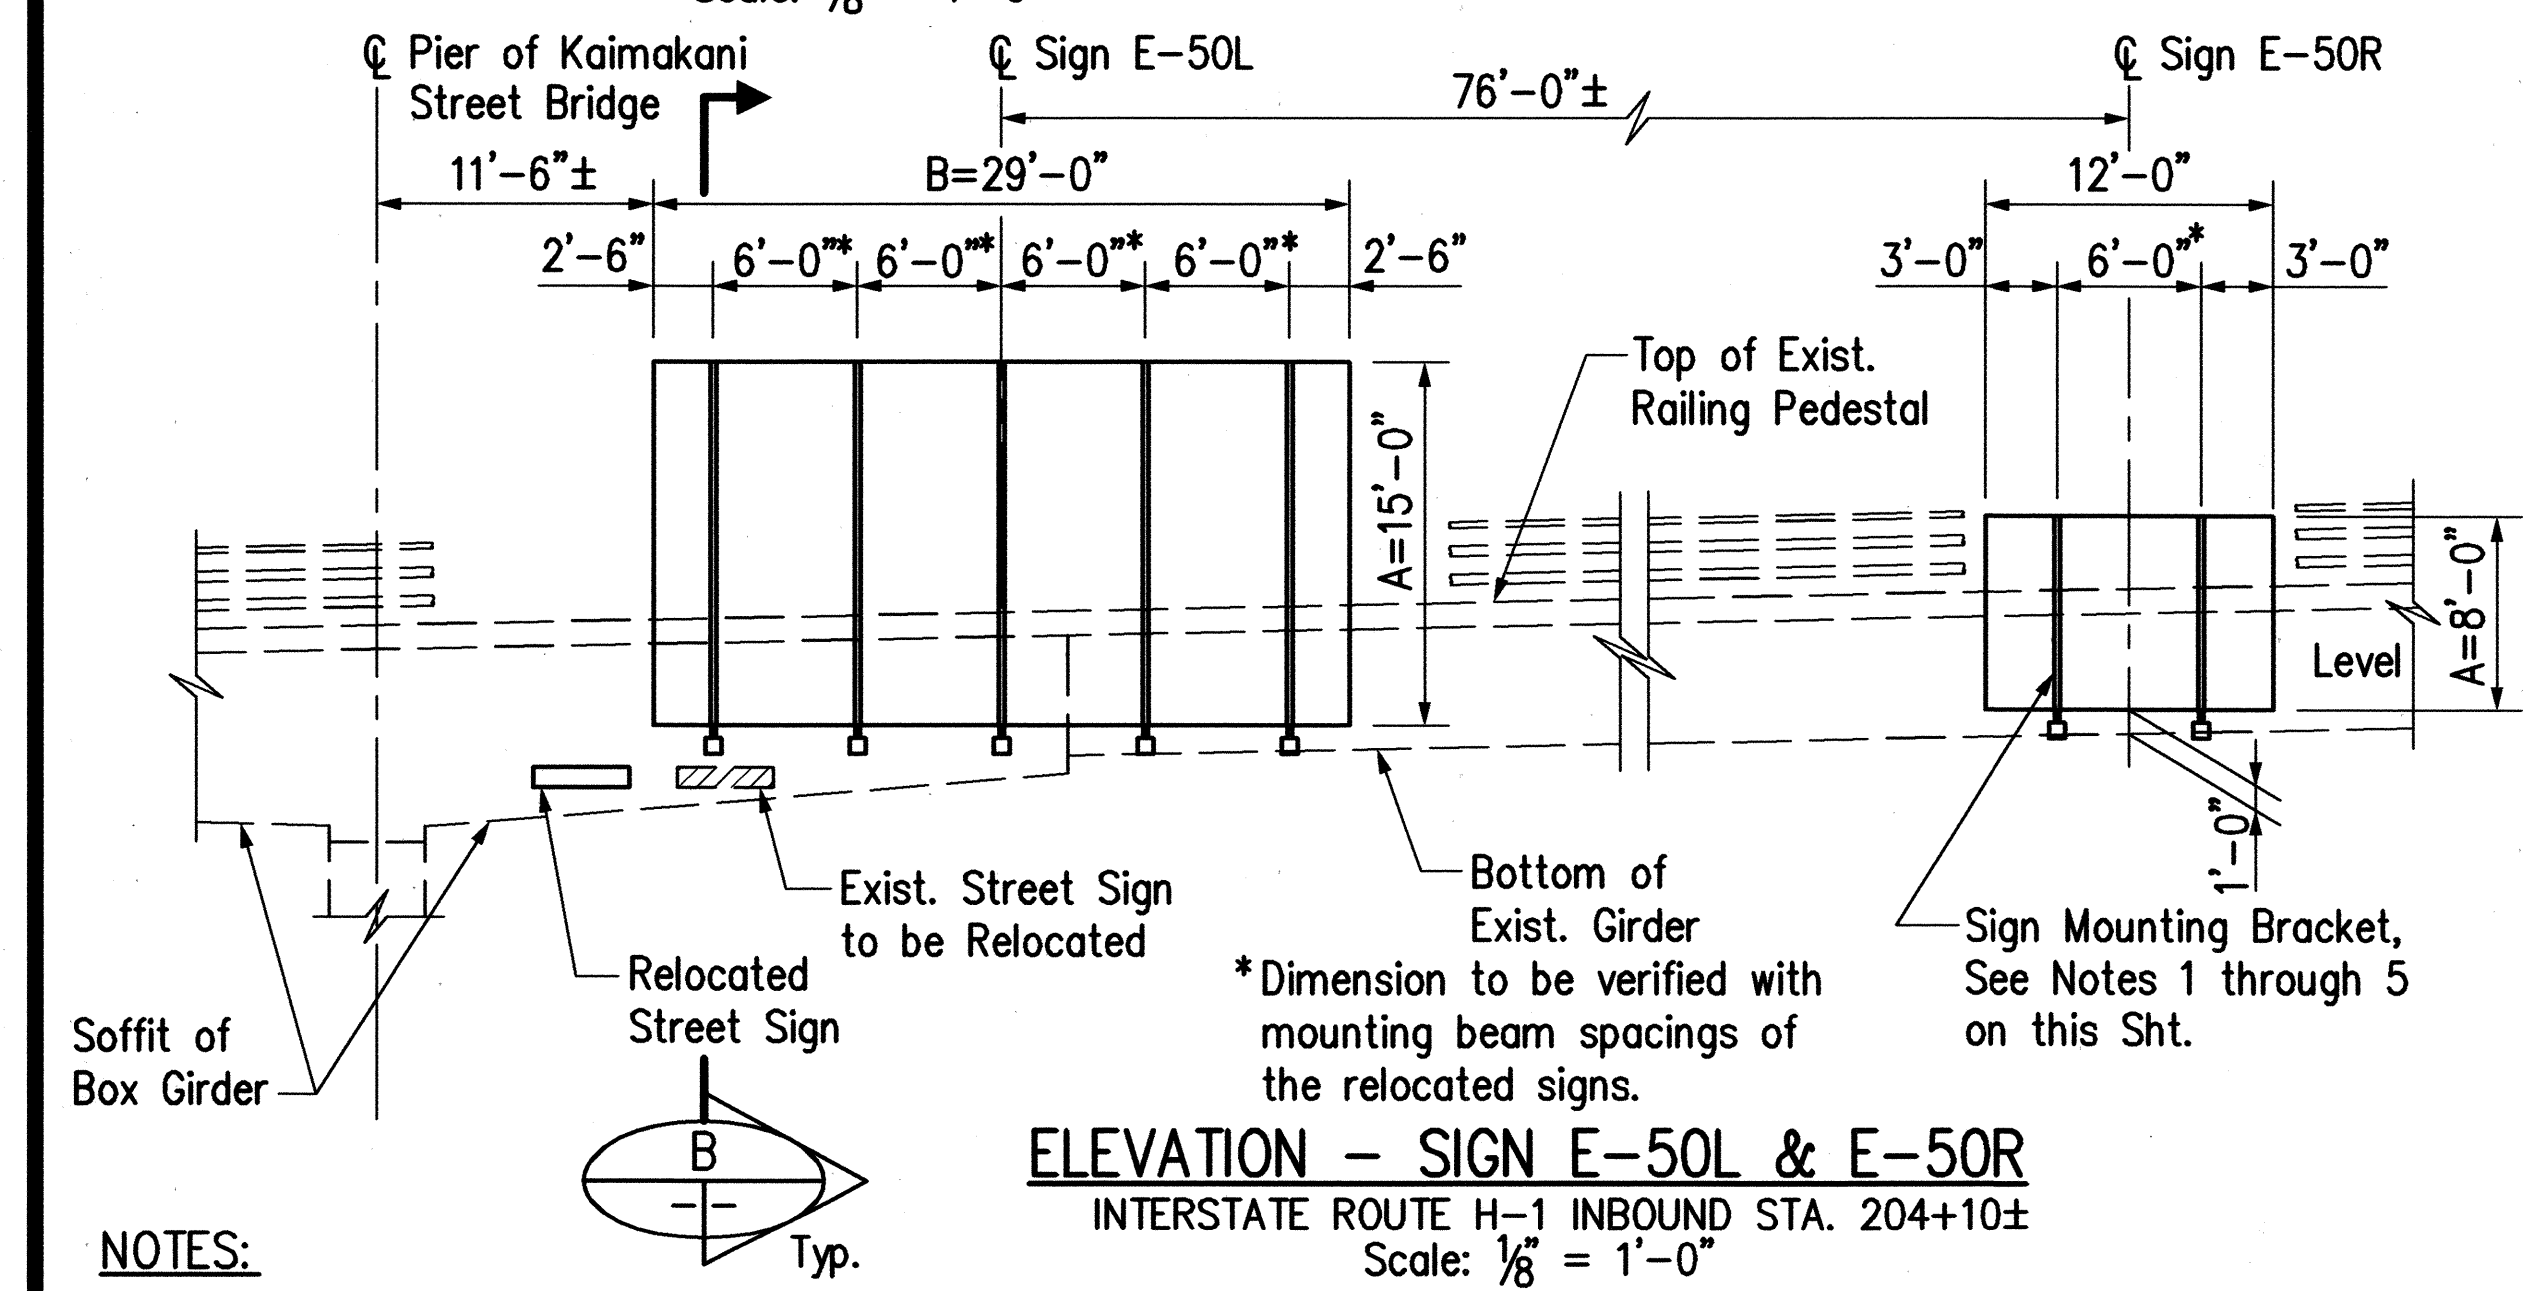


ELEVATION - SIGN E-50L & E-50R

INTERSTATE ROUTE H-1 INBOUND STA. 204+10±

Scale: 1/8" = 1'-0"


NOTES:

- Prior to fabrication of sign supports, the Contractor shall install the adhesive type anchor bolts in accordance with Note 2 and the bolts pattern as shown. The spacings of sign supports as shown shall be verified with the anchor bolt installed and adjusted accordingly.
- The Contractor shall avoid cutting existing rebars during drill. When the drill contacts any existing rebars, the hole shall be filled with epoxy grout and a replacement hole shall be drilled so that the anchor bolt pattern is maintained. The adhesive type anchor shall be installed per recommendation of manufacturer.
- The 3/4" adhesive type anchor bolt with hex nut and washers shall be stainless steel and develop a minimum ultimate pulling force of 28,000 lbs. and a minimum ultimate shear force of 27,000 lbs.
- The 5/8" connection bolts for mounting brackets shall be ASTM A325 High Strength bolts with hex nuts and washers and shall all be hot-dipped galvanized.
- The required bolt holes in aluminum mounting beams may be field drilled.

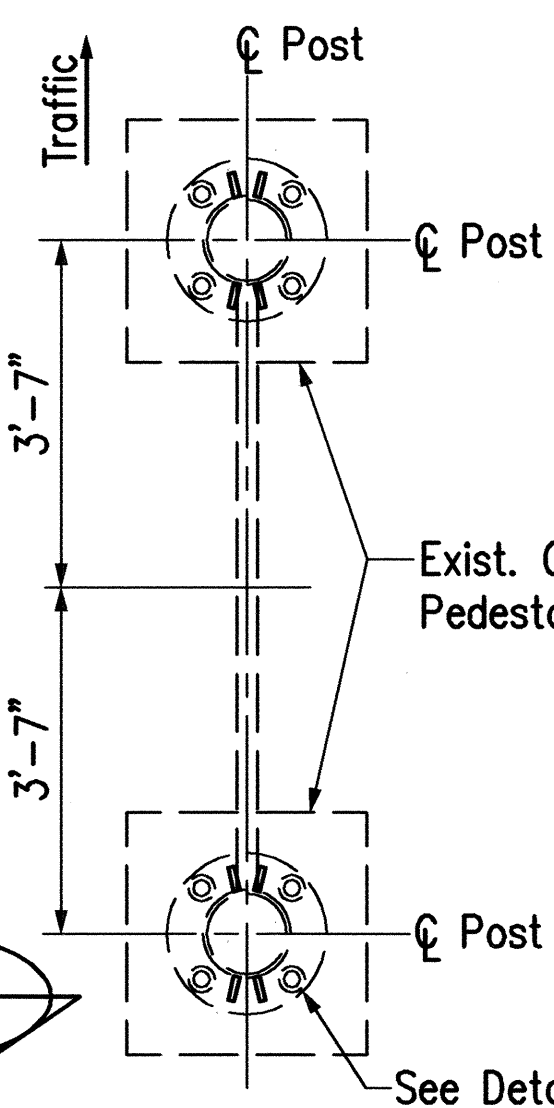


SECTION A-A

Scale: 1/2" = 1'-0"

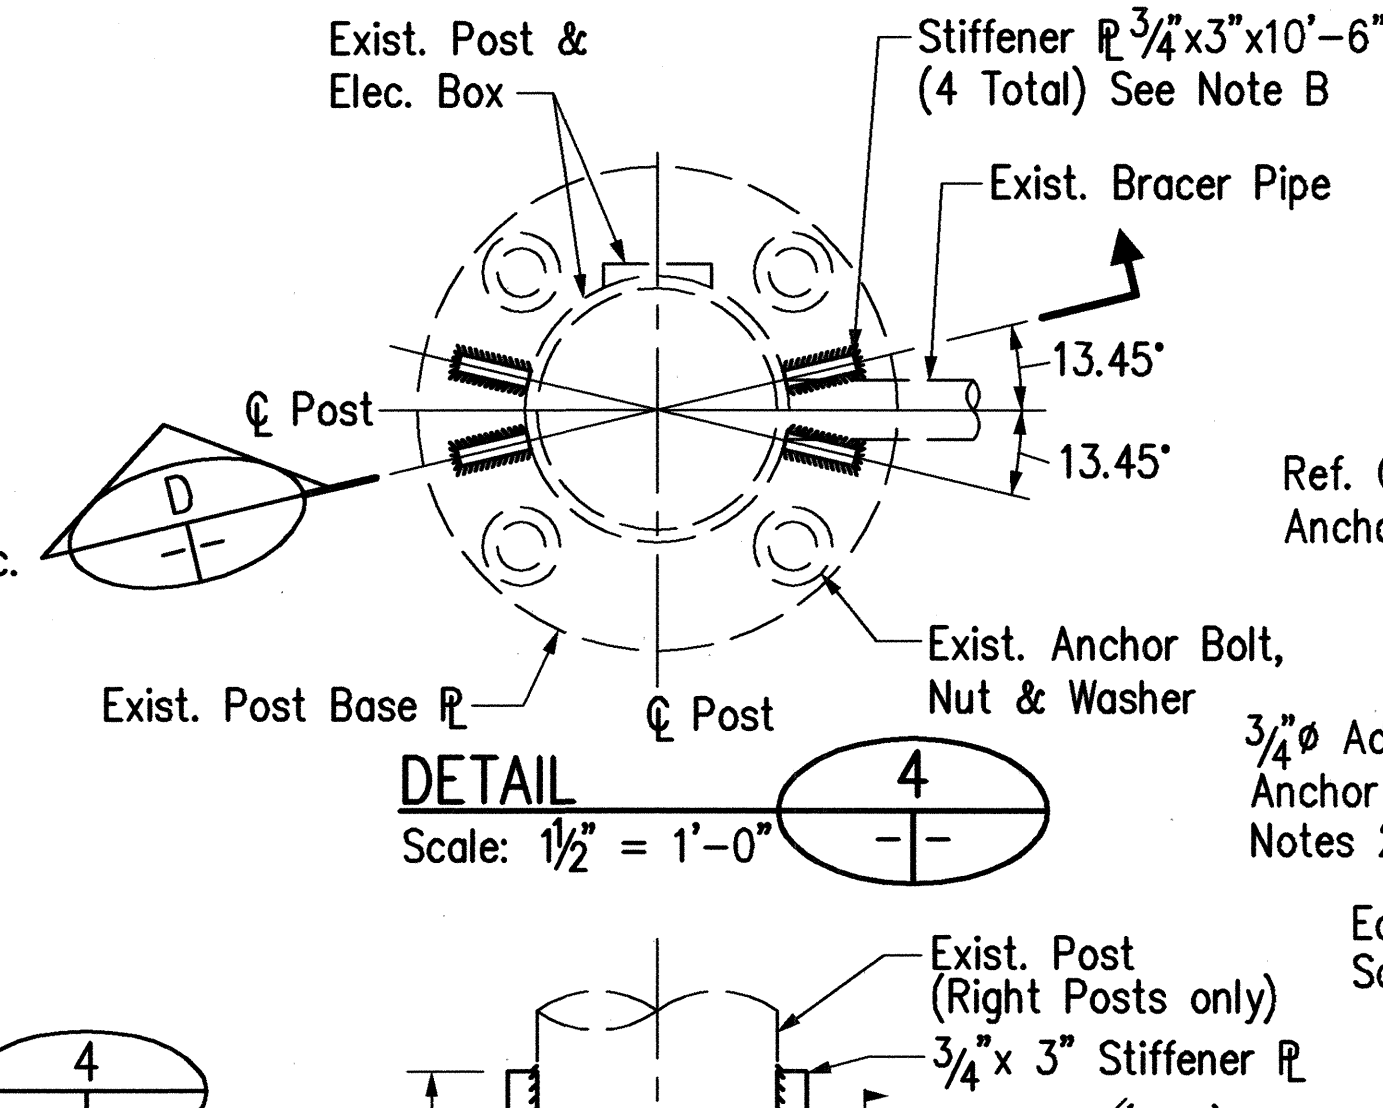


SECTION D-D

Scale: 1/2" = 1'-0"

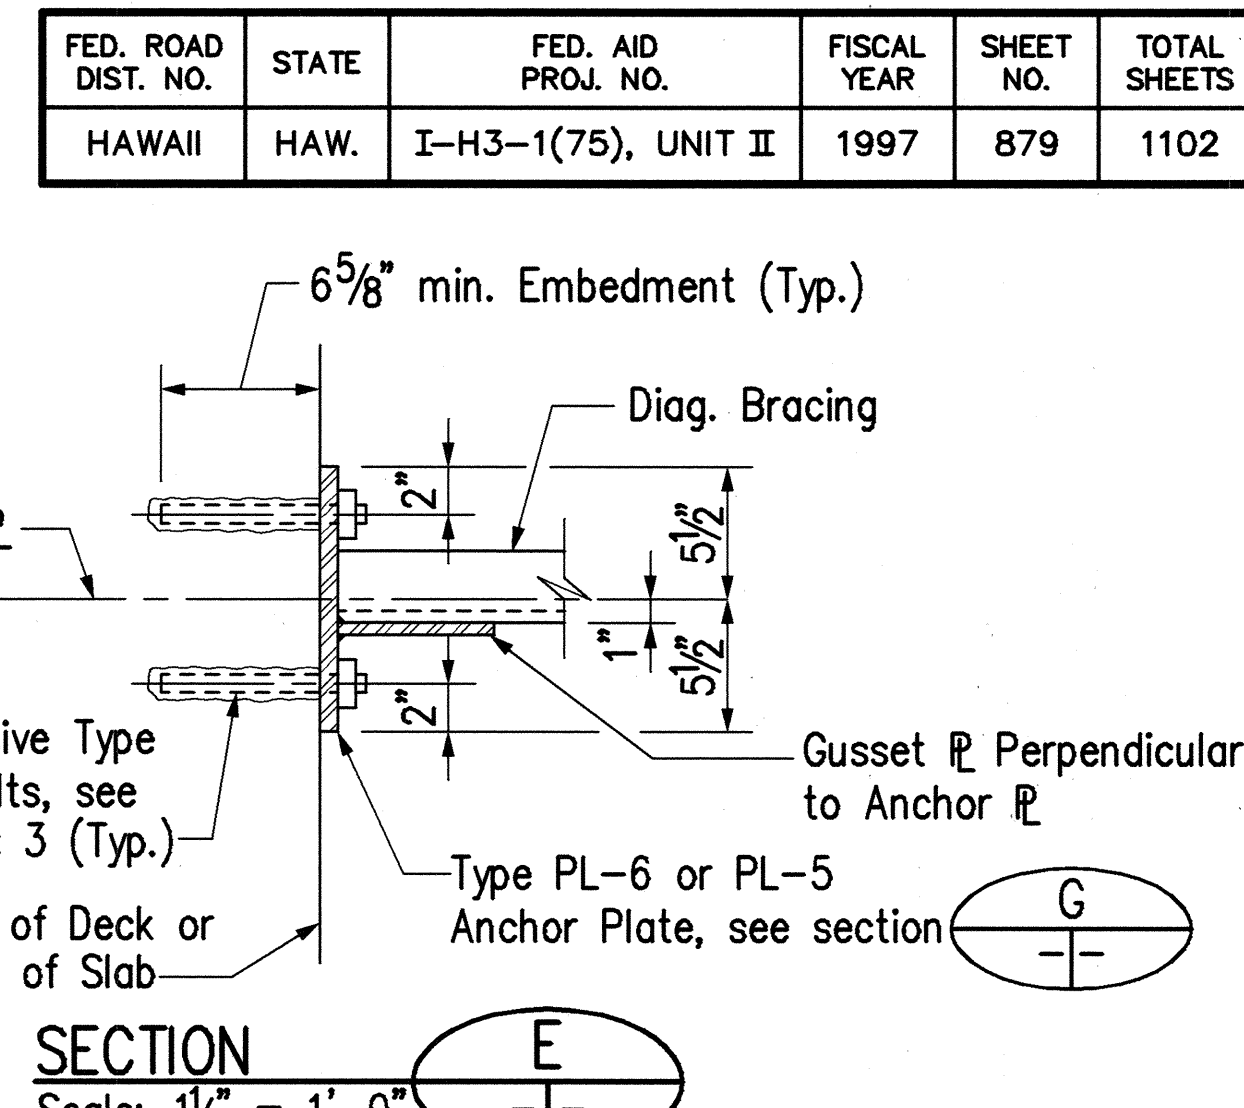

SECTION E-E

Scale: 1/2" = 1'-0"

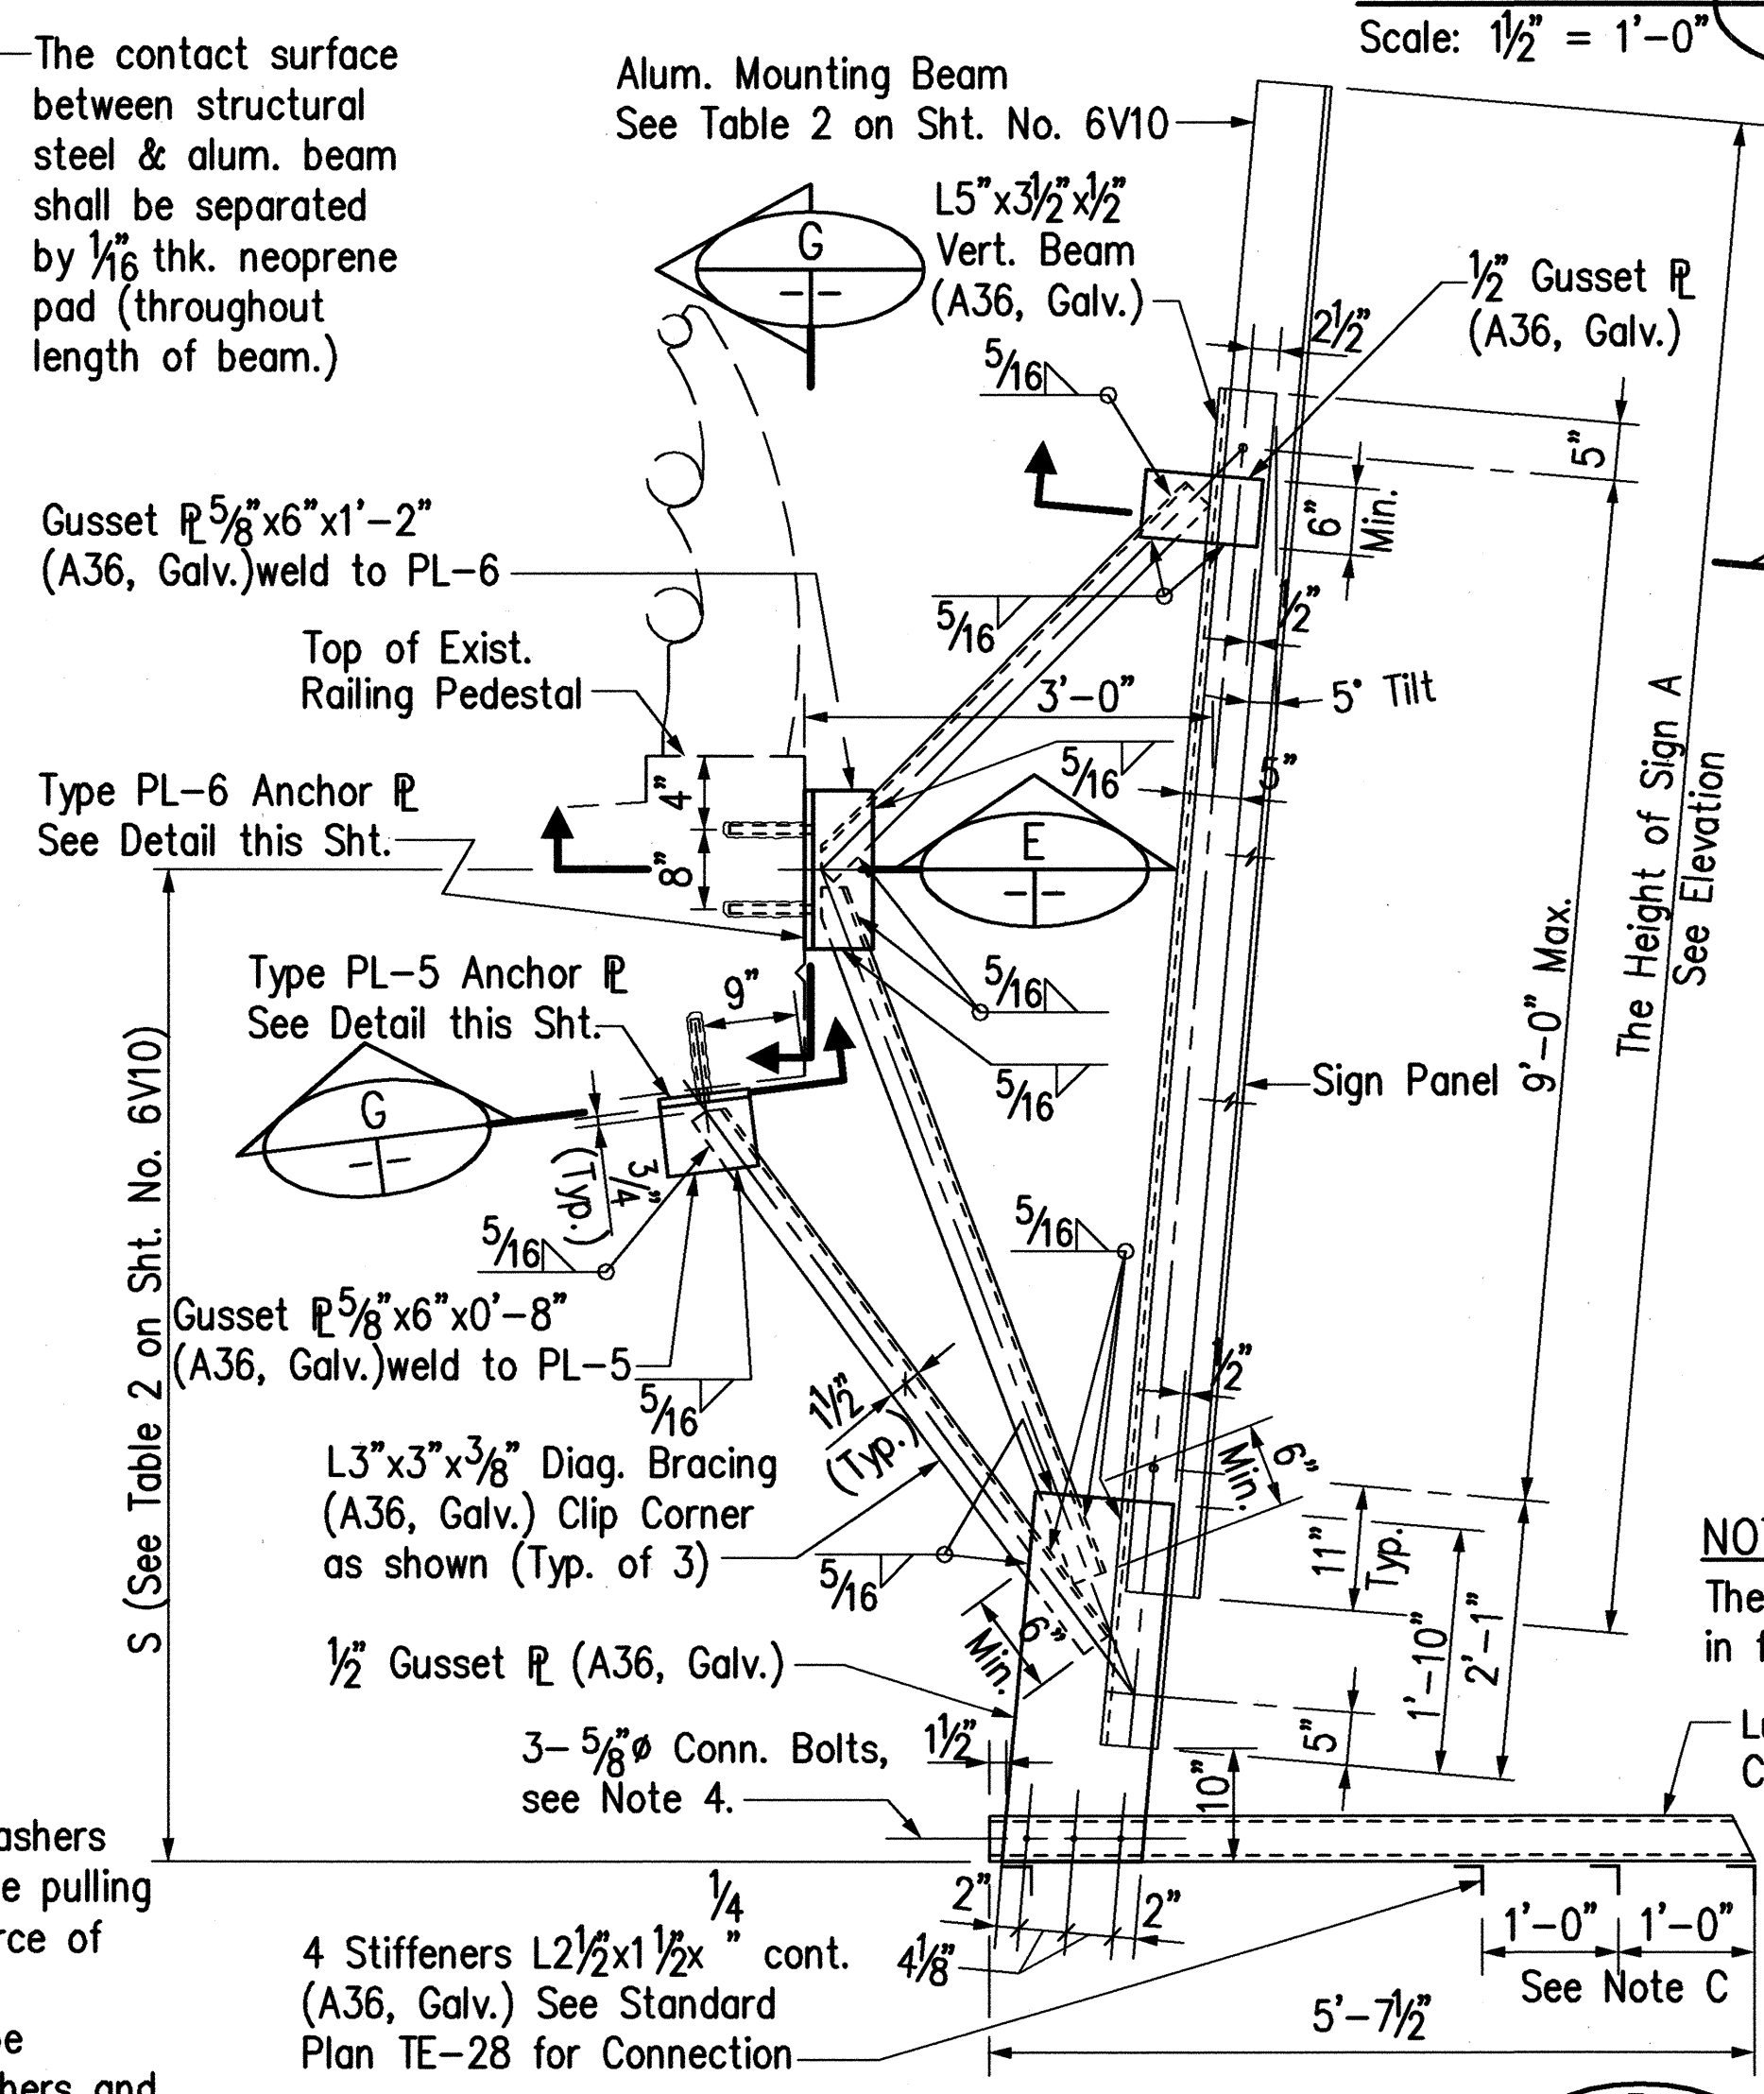

SECTION B-B

Not to Scale


6V9, 6V13, 6V14, 6V9 Typ.

NOTE B

The locations of Stiffener R's shall be located to avoid interfering with existing anchor bolts, nuts, washers and bracer pipes.

NOTE C

The location of angle may be adjusted in field for luminaire mounting.

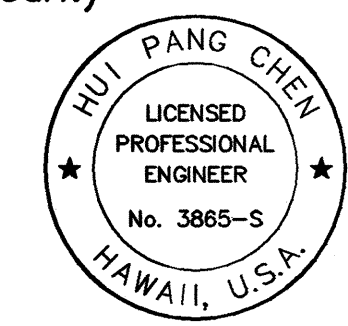

THIS WORK WAS PREPARED BY ME OR UNDER MY SUPERVISION.

Hui Pang Chen

FED. ROAD DIST. NO.	STATE	FED. AID PROJ. NO.	FISCAL YEAR	SHEET NO.	TOTAL SHEETS
HAWAII	HAW.	I-H3-1(75), UNIT II	1997	879	1102

12/3/97	Revised Luminaire Support Stiffeners on Section B. Added Note C.
10/10/97	Modified Mounting Beam Note in Section F. Modified Dimensions in Section B.
Date	Revision

STATE OF HAWAII
DEPARTMENT OF TRANSPORTATION
HIGHWAYS DIVISION

DESTINATION SIGNS
EXISTING SIGN STRUCTURES
SIGN MOUNTING DETAILS - 2

H-3 FINISH (UNIT II)
FAIP NO. I-H3-1(75), UNIT II
LEEWARD SECTION

SCALE: AS SHOWN DATE: _____


SHEET NO. 6V9 OF 14 SHEETS

C.O. 879

FED. ROAD DIST. NO.	STATE	FED. AID PROJ. NO.	FISCAL YEAR	SHEET NO.	TOTAL SHEETS
HAWAII	HAW.	I-H3-1(75), UNIT II	1997	C.O. 880	1102

LEGEND


 Exist. Sign to be removed

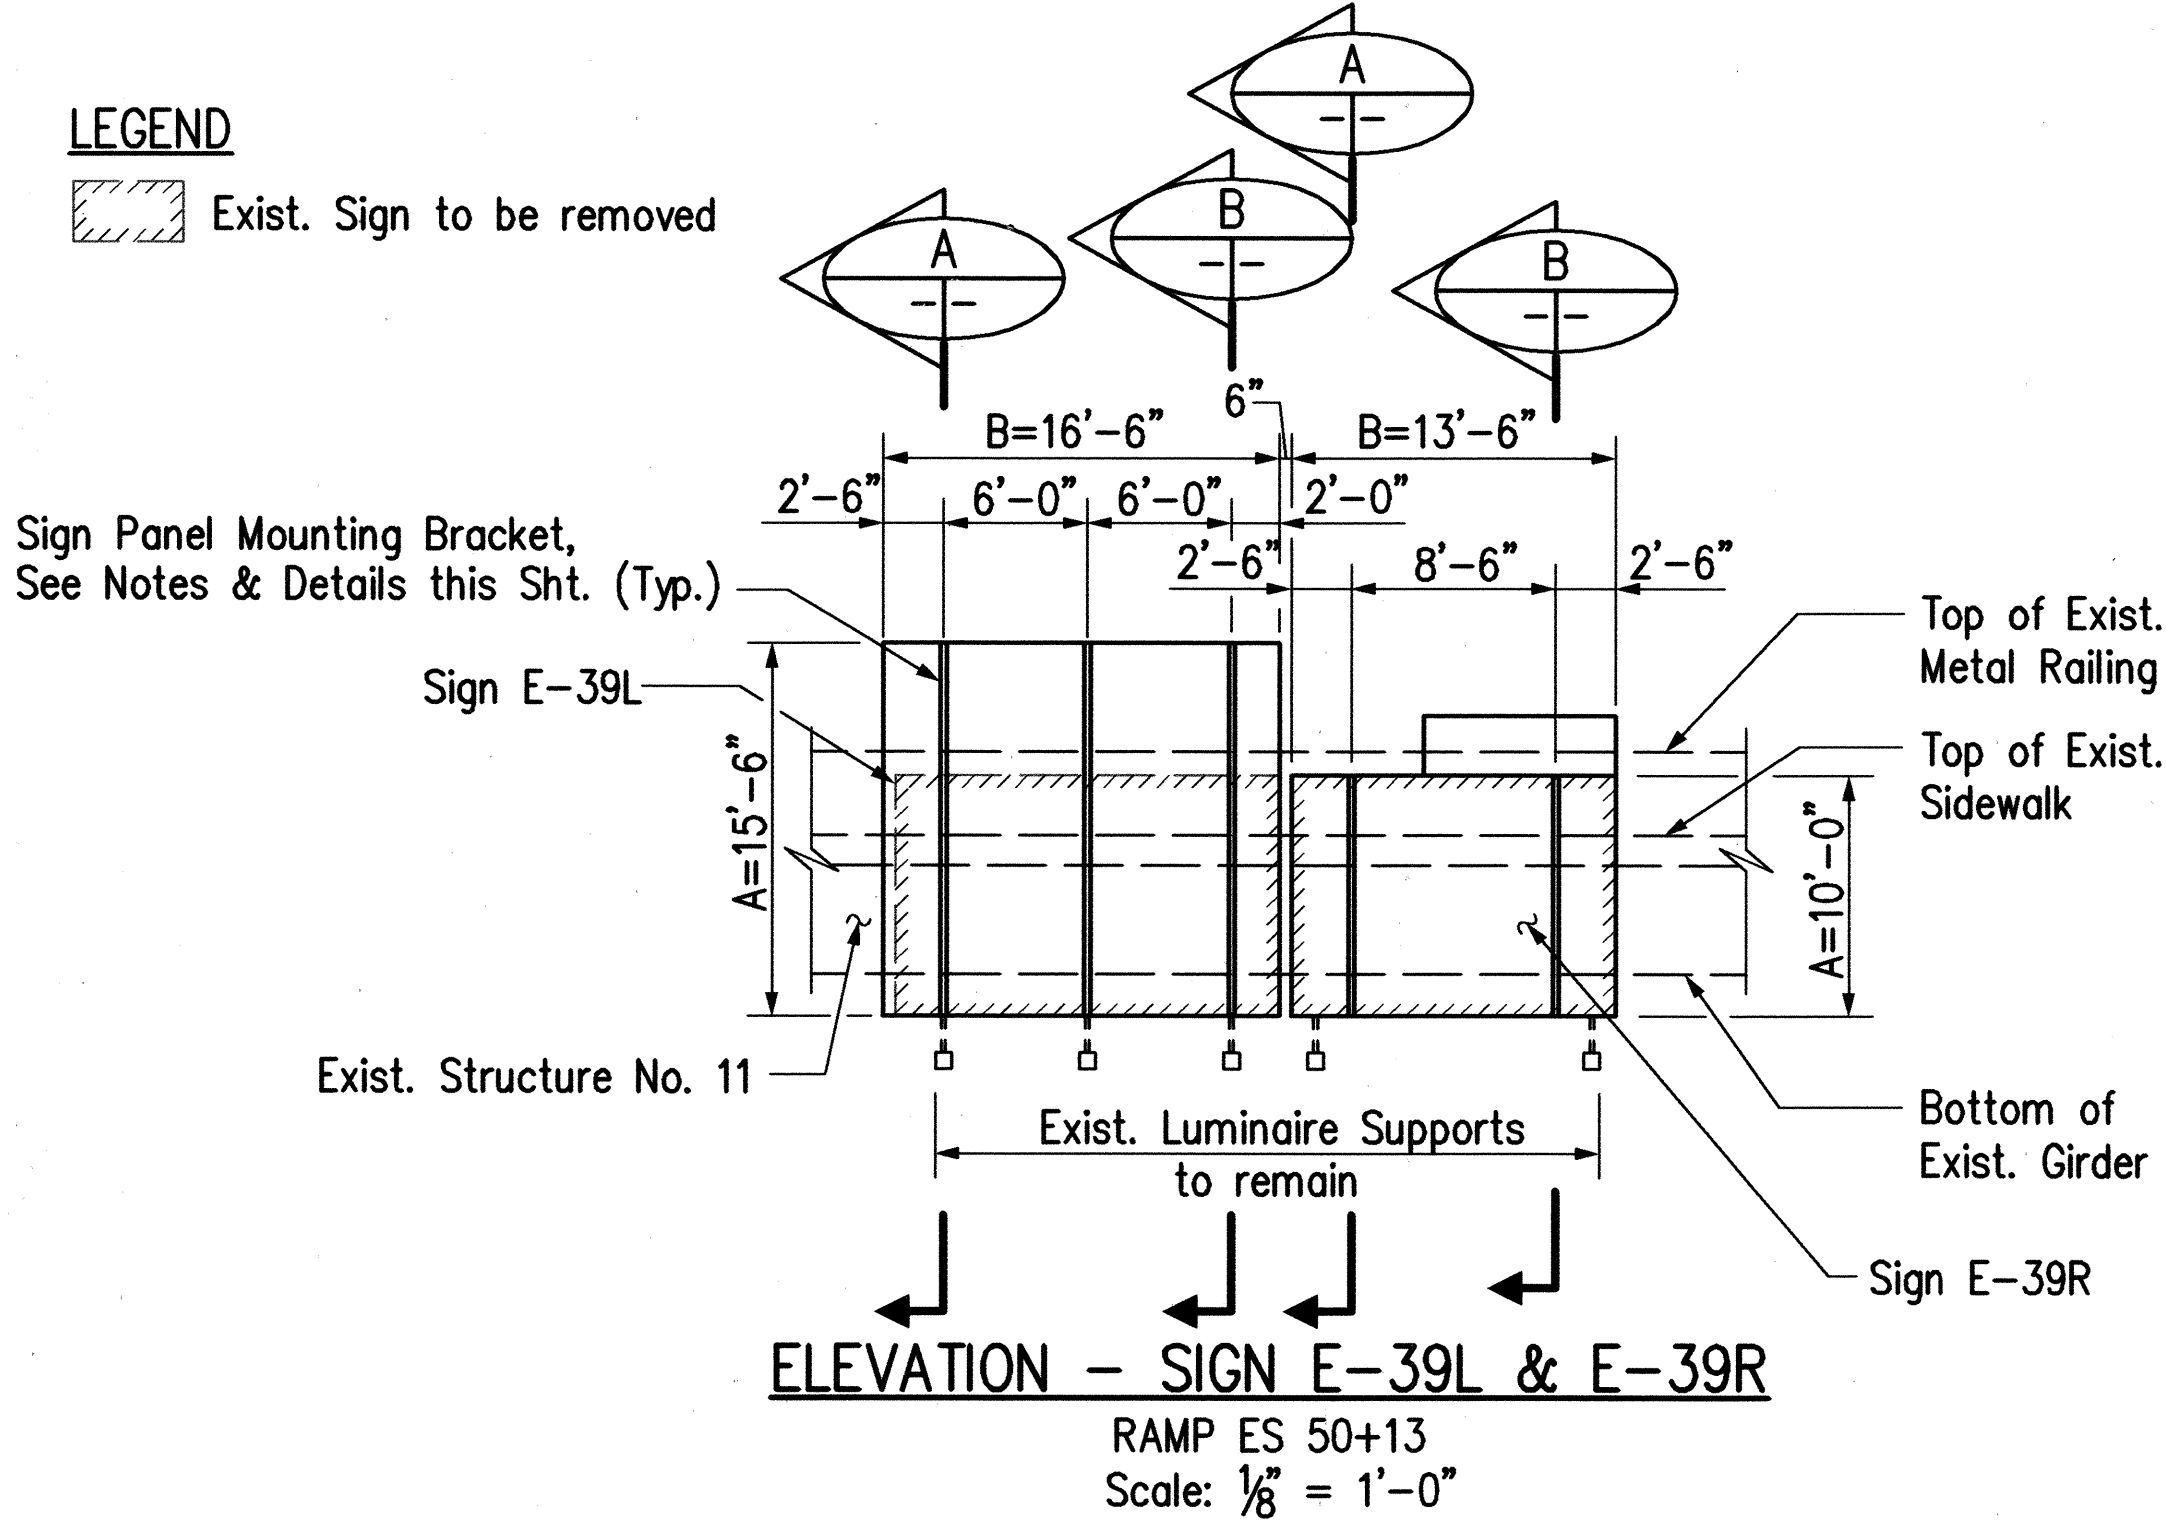

Sign	Alum. Mounting Beam	S (ft)-(in)
E-17L	L 6x3 1/2 x 1/2	5'-3"
E-17C	L 6x3 1/2 x 1/2	5'-3"
E-17R	L 6x3 1/2 x 1/2	5'-3"
E-50L	L 5x3 x 1/2	5'-3"
E-50R	L 5x3 x 1/2	5'-3"
E-64L	L 6x3 1/2 x 1/2	3'-8"
E-64R	L 6x3 1/2 x 1/2	3'-8"
E-68L	L 6x3 1/2 x 1/2	6'-6"
E-68R	L 5x3 x 1/2	6'-6"
E-74R	L 6x3 1/2 x 1/2	6'-6"
E-39L	C 6x3x5.77	Exist.
E-39R	L 6x3 1/2 x 1/2	Exist.


NOTES:

- All existing sign panel and aluminum mounting beams at the designated sign locations shall be removed and replaced by the aluminum beams and sign panels as shown. The locations of the sign panel mounting bracket bolt holes in the aluminum mounting beams shall be verified in field prior to fabrication of members.
- Provide 5/8"x2"± long High Strength Bolts with hex nuts and hard plate washers (A325, Galv.), and 1/16" thick of neoprene pads at the contact surface between structural steel and aluminum at the locations as shown. The removed connection bolts and neoprene pads shall not be reused. The lengths and locations of connection bolts shall be verified in field.
- The bolt holes in aluminum mounting beam may be field drilled.
- The location of angle may be adjusted in field for luminaire mounting.

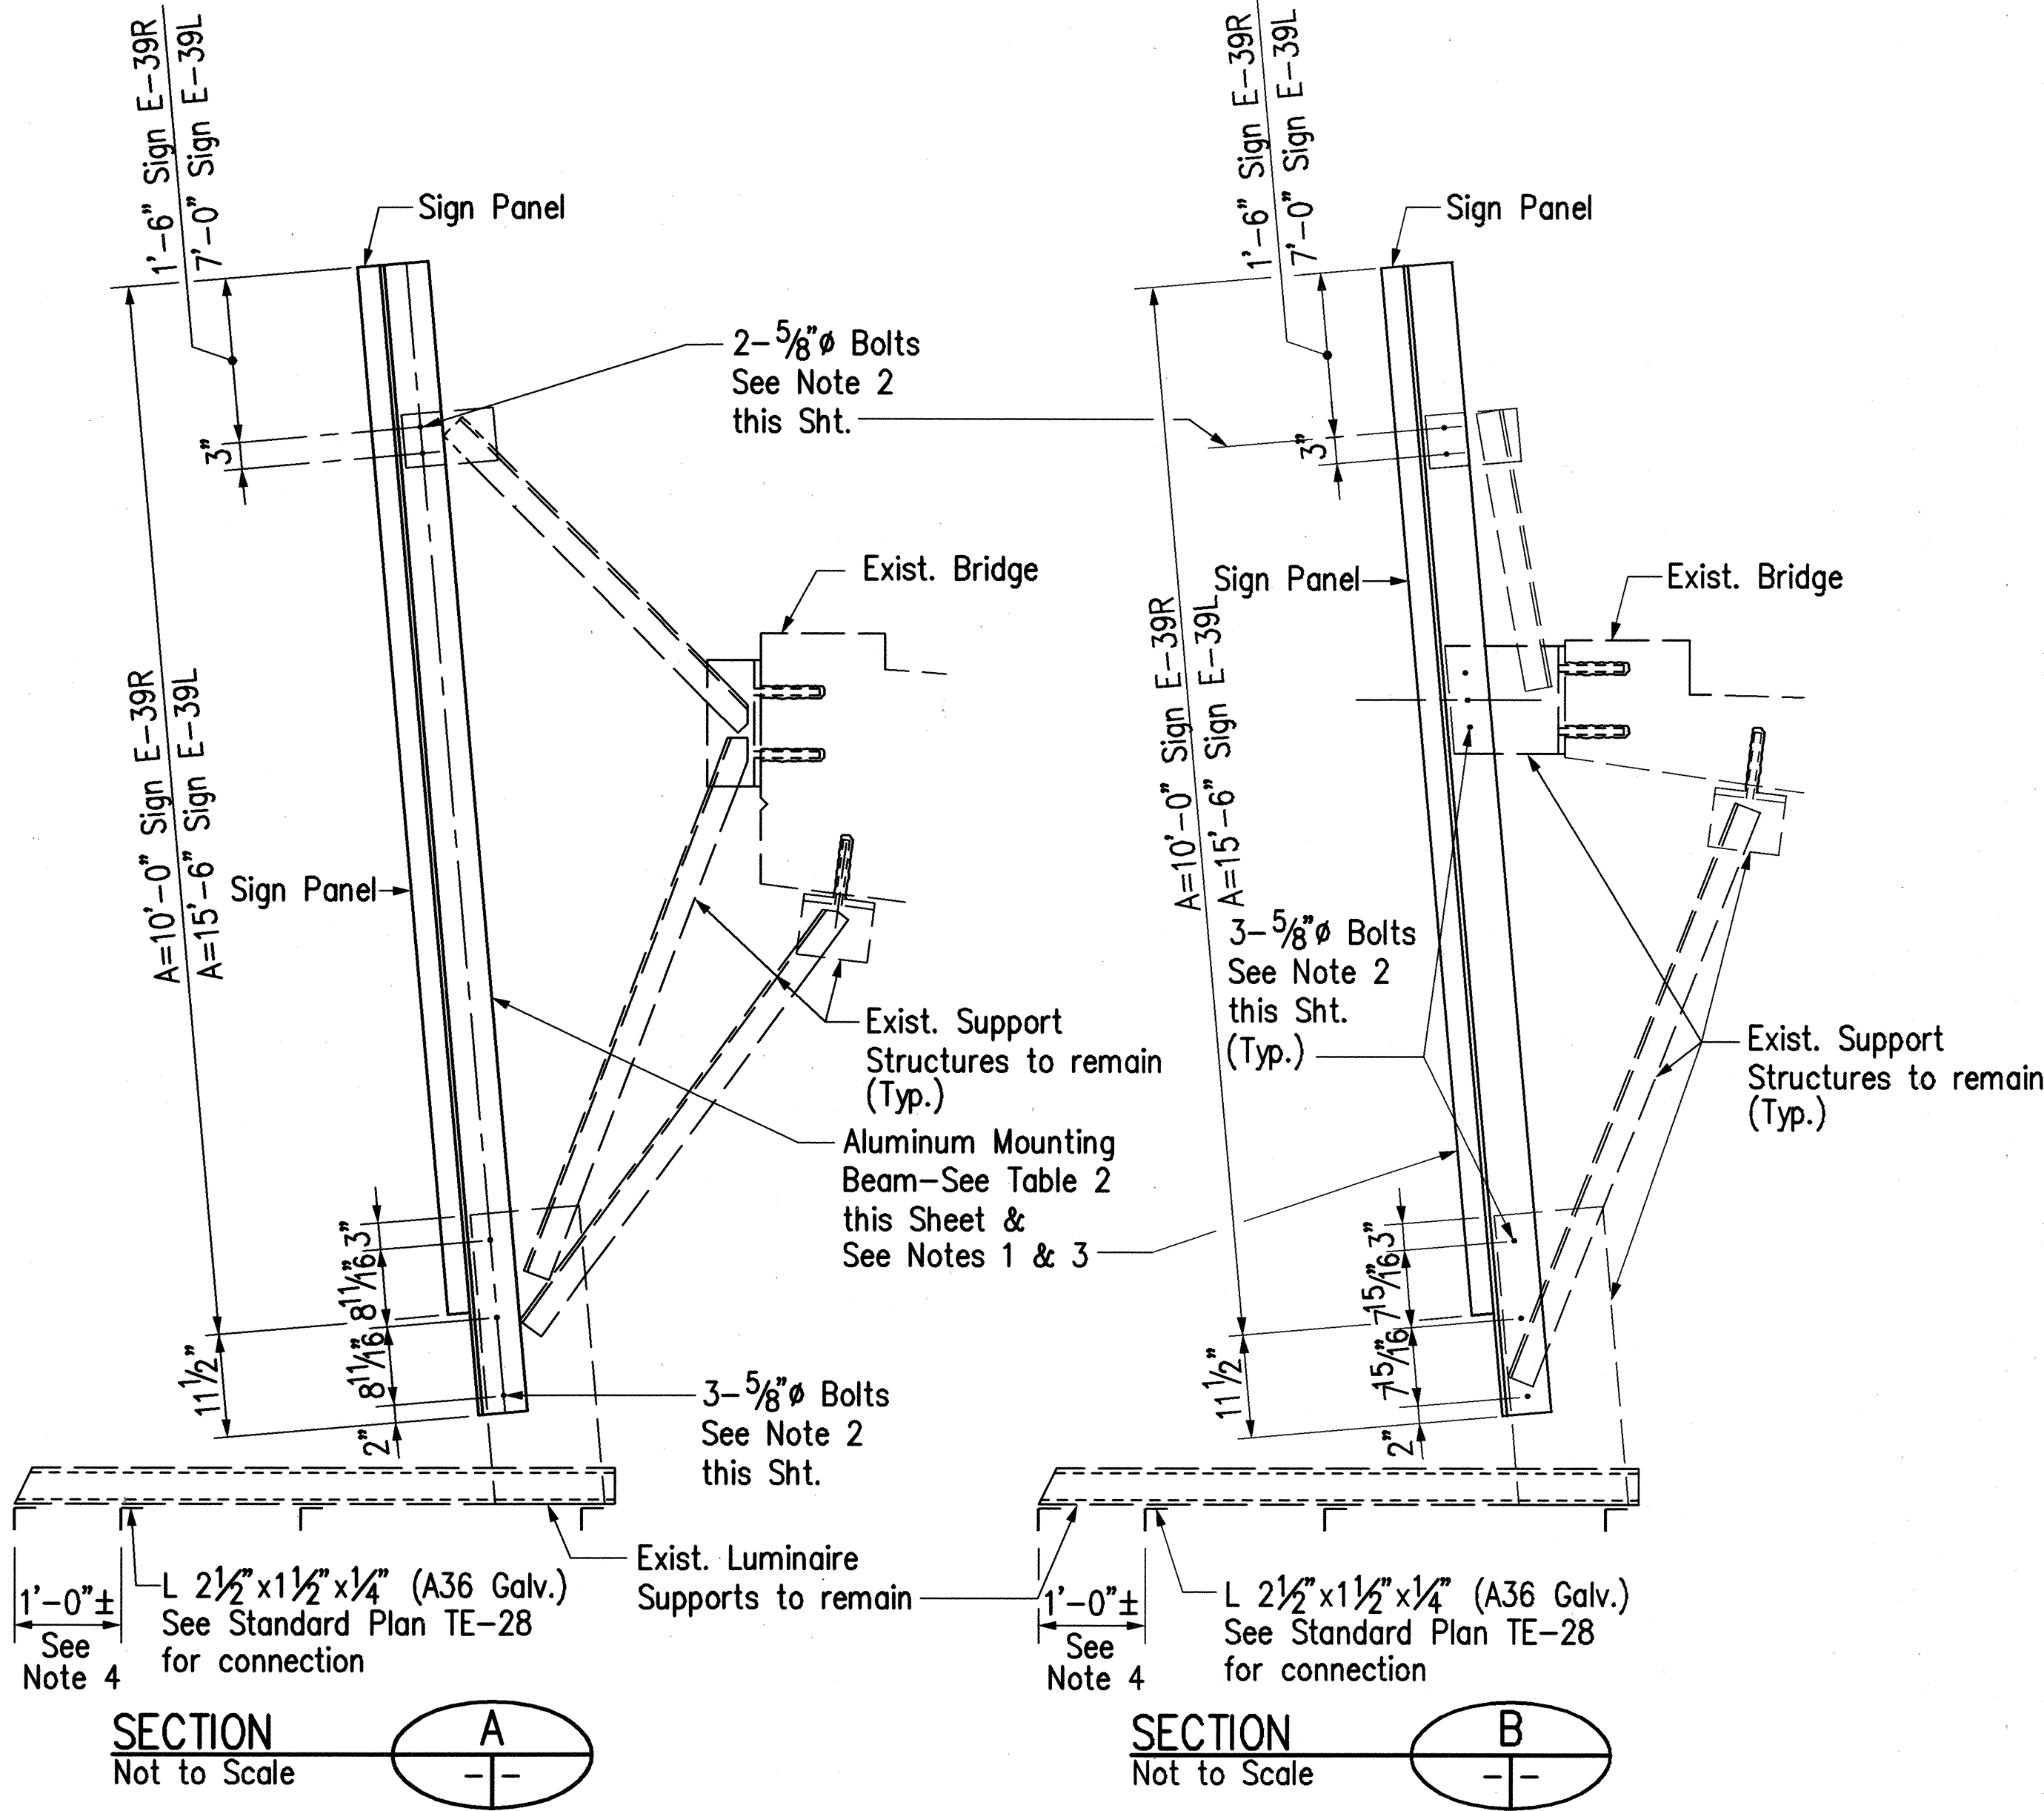

12/3/97	Added one Luminaire Support Stiffener on Sections A & B. Added Note 4.
10/10/97	Revised Support Spacing for Sign E-39R. Added Table 2, modified dimensions in Sections A & B.

Date	Revision
STATE OF HAWAII DEPARTMENT OF TRANSPORTATION HIGHWAYS DIVISION DESTINATION SIGNS EXISTING SIGN STRUCTURES SIGN MOUNTING DETAILS - 3 H-3 FINISH (UNIT II) FAIP NO. I-H3-1(75), UNIT II LEEWARD SECTION SCALE: AS SHOWN DATE:	

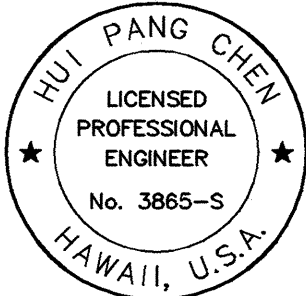

THIS WORK WAS PREPARED BY ME OR UNDER MY SUPERVISION.

Hui Pang Chen

SHEET NO. 6V10 OF 14 SHEETS



C.O. 880

SURVEY PLOTTED BY	DATE
DRAWN BY	
TRACED BY	
NOTED BY	
CHECKED BY	
No.	

CAD by D. Burgess, 05-02

LEGEND


Exist. Sign to be removed

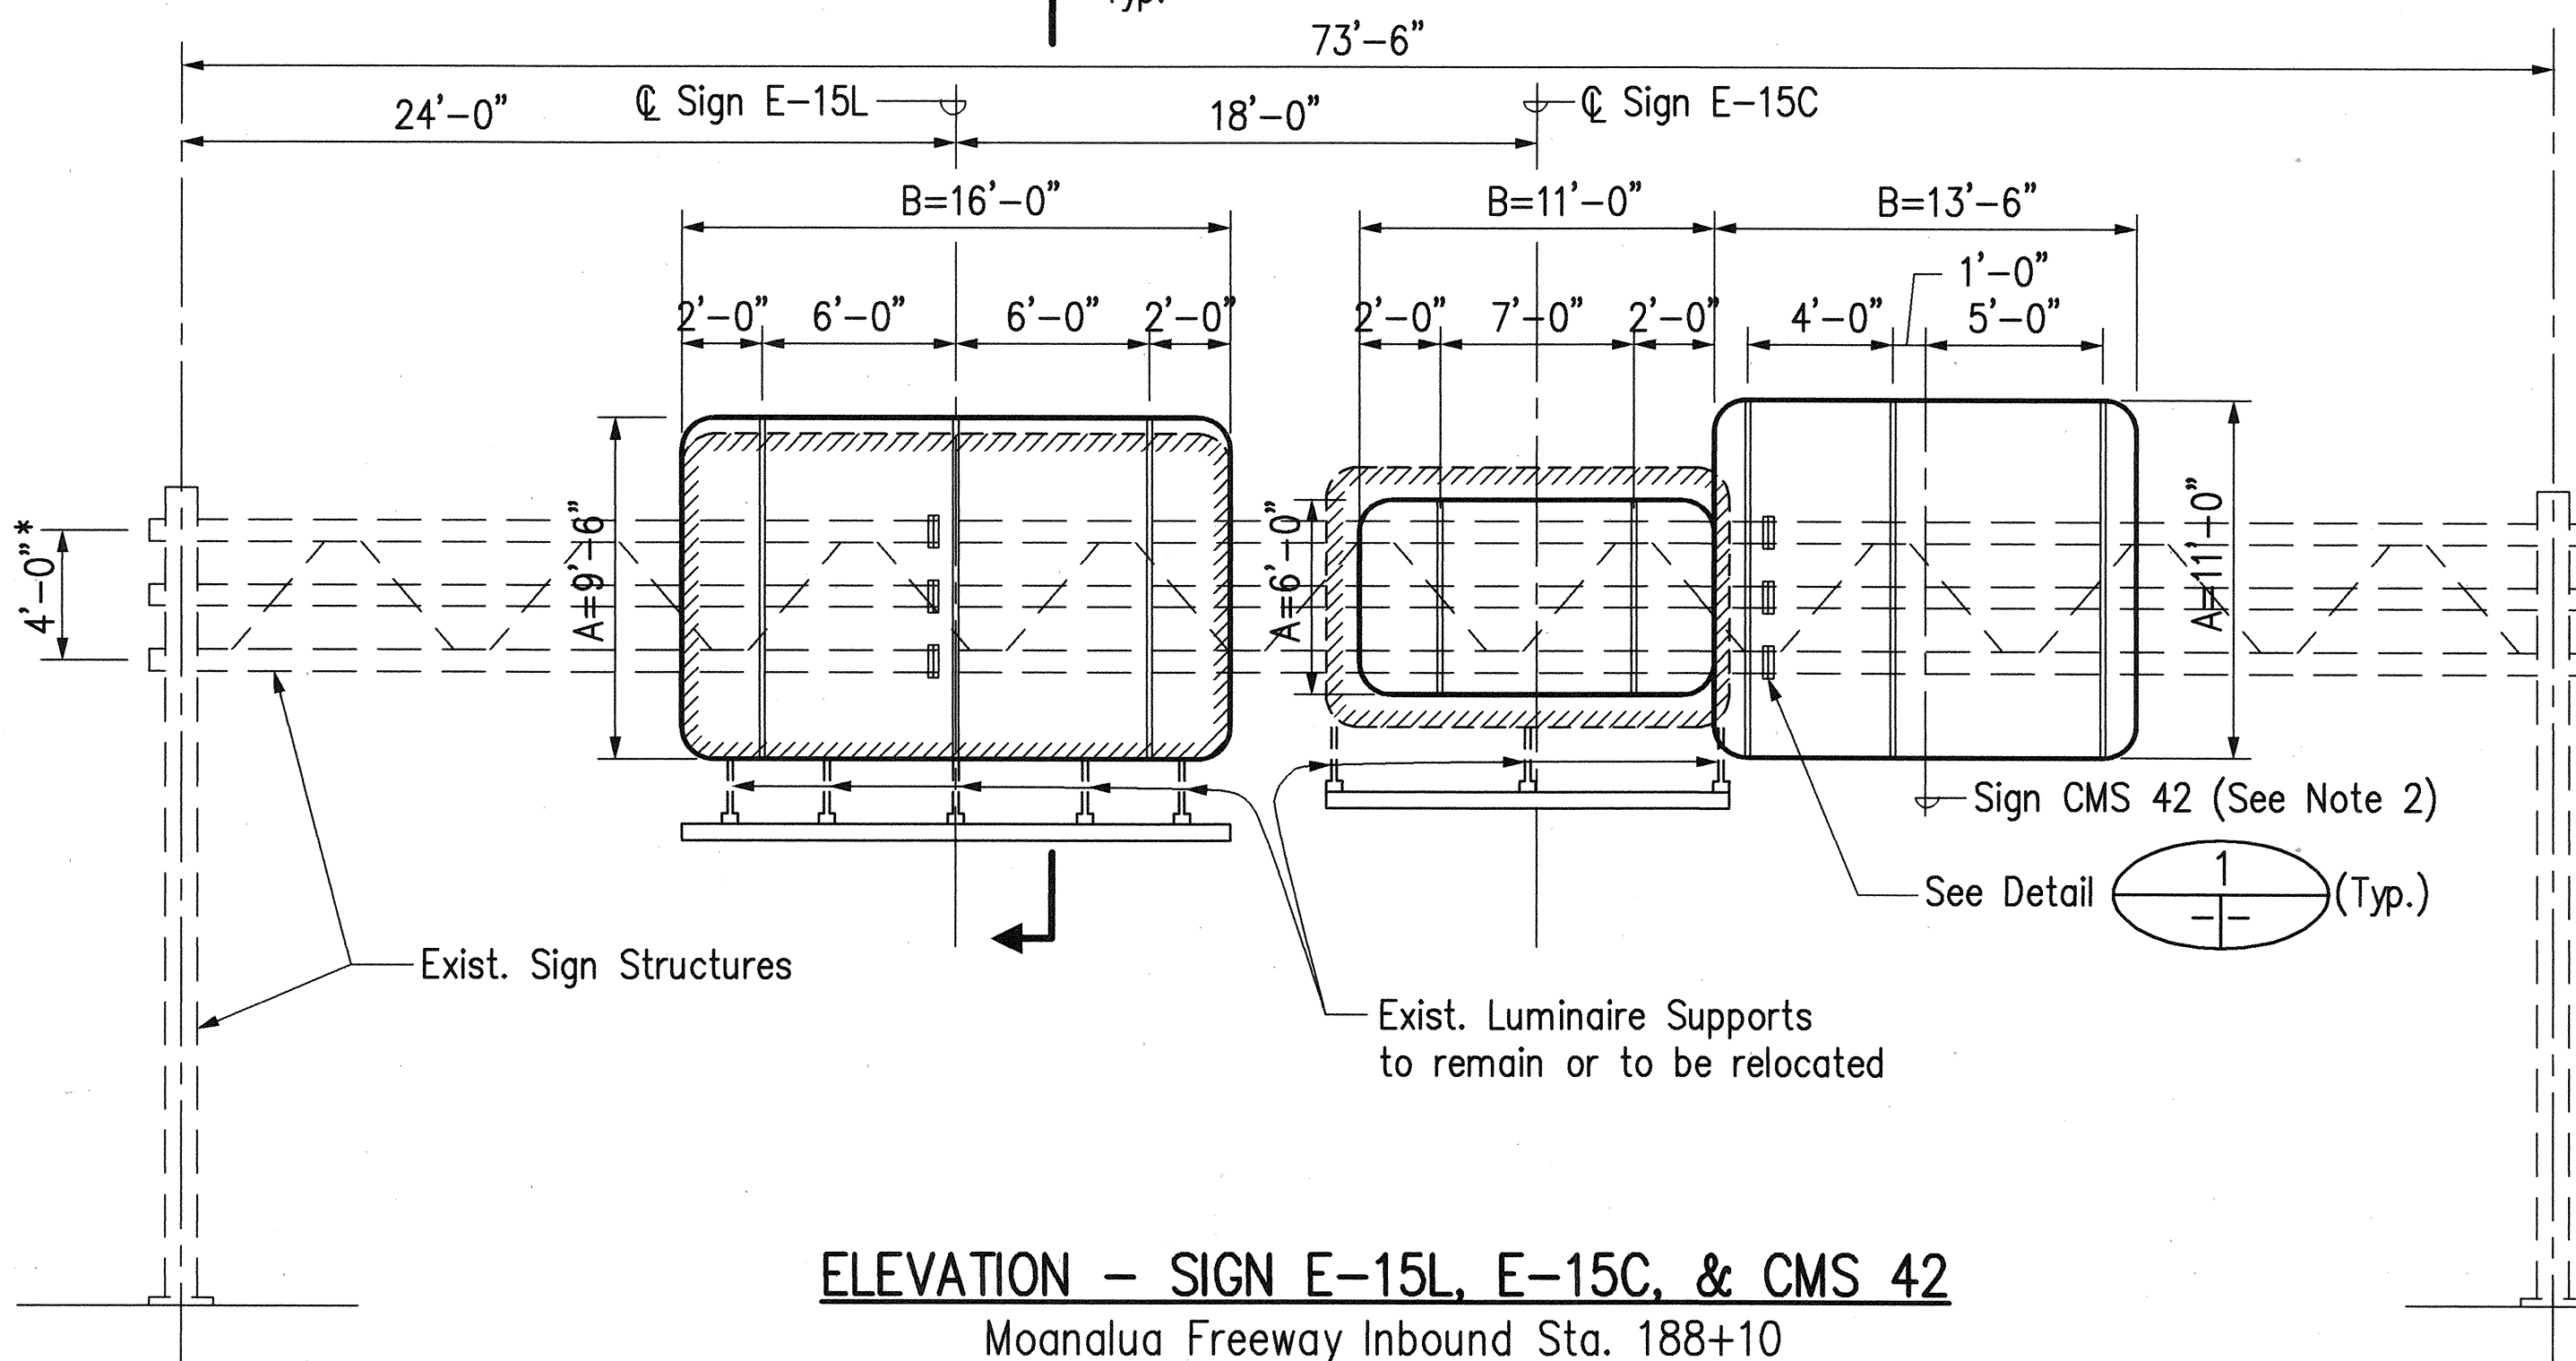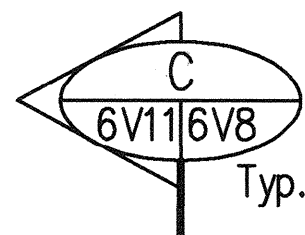

ELEVATION - SIGN E-15L, E-15C, & CMS 42

Moanalua Freeway Inbound Sta. 188+10

Scale: $\frac{3}{16}'' = 1'-0''$

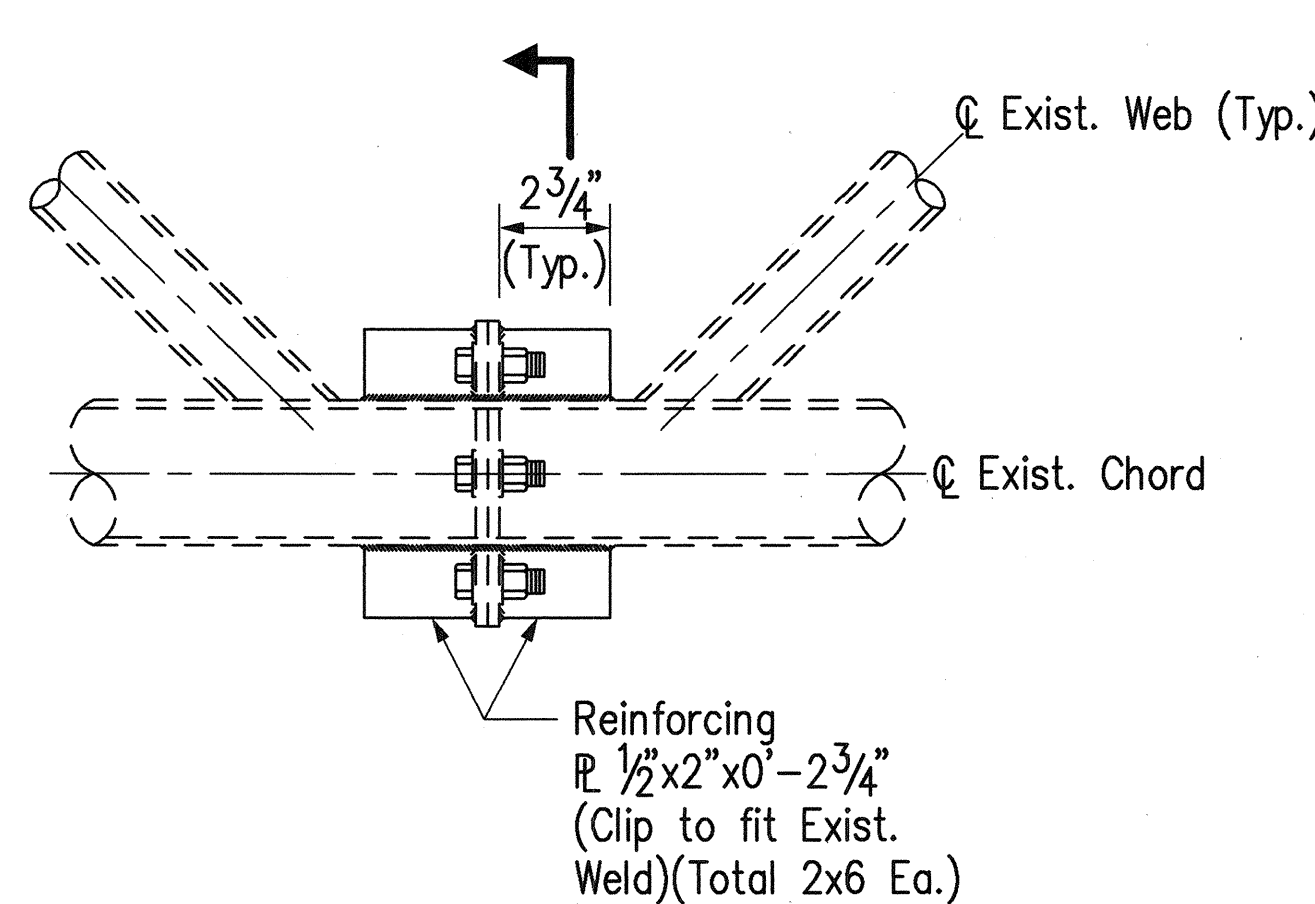

DETAIL

Not to Scale 6V9,6V11,6V12/6V11

SECTION

Not to Scale




LEGEND

Exist. Sign to be removed

NOTE:


- See Notes 1 through 5 on Sht. No. 6V8.
- CMS Panel and Mounting Brackets for CMS 42 are State-Furnished. For assembly and mounting details see Sht. No. SY-98.
- The interface between new and old concrete shall be clean, free of laitance and roughened to a full amplitude of approximately $\frac{1}{4}''$.
- The contractor shall avoid cutting the existing rebars during drill. When the drill contacts any existing rebar, the holes shall be filled with epoxy grout and replacement hole shall be drilled so that the spacing of dowels to be maintained. Minimum edge distance to ϕ of drill hole shall be 4".
- Spread footings shall be excavated and poured to neat line. In case of over excavation, space between footing and ground shall be filled with concrete at the Contractor's expense and as directed by the Engineer. The minimum quality of the fill concrete shall be class D.
- Payment for added footing including excavation, concrete and rebars for "Sign Structure E-2L, E-2C & E-2R", "Sign Structure E-27L, E-27C & E-27R" and "Sign Structure E-40C, E-40R & CMS-40" shall be incidental to the corresponding pay item "Sign Structure E-___, E-___ & E-___."

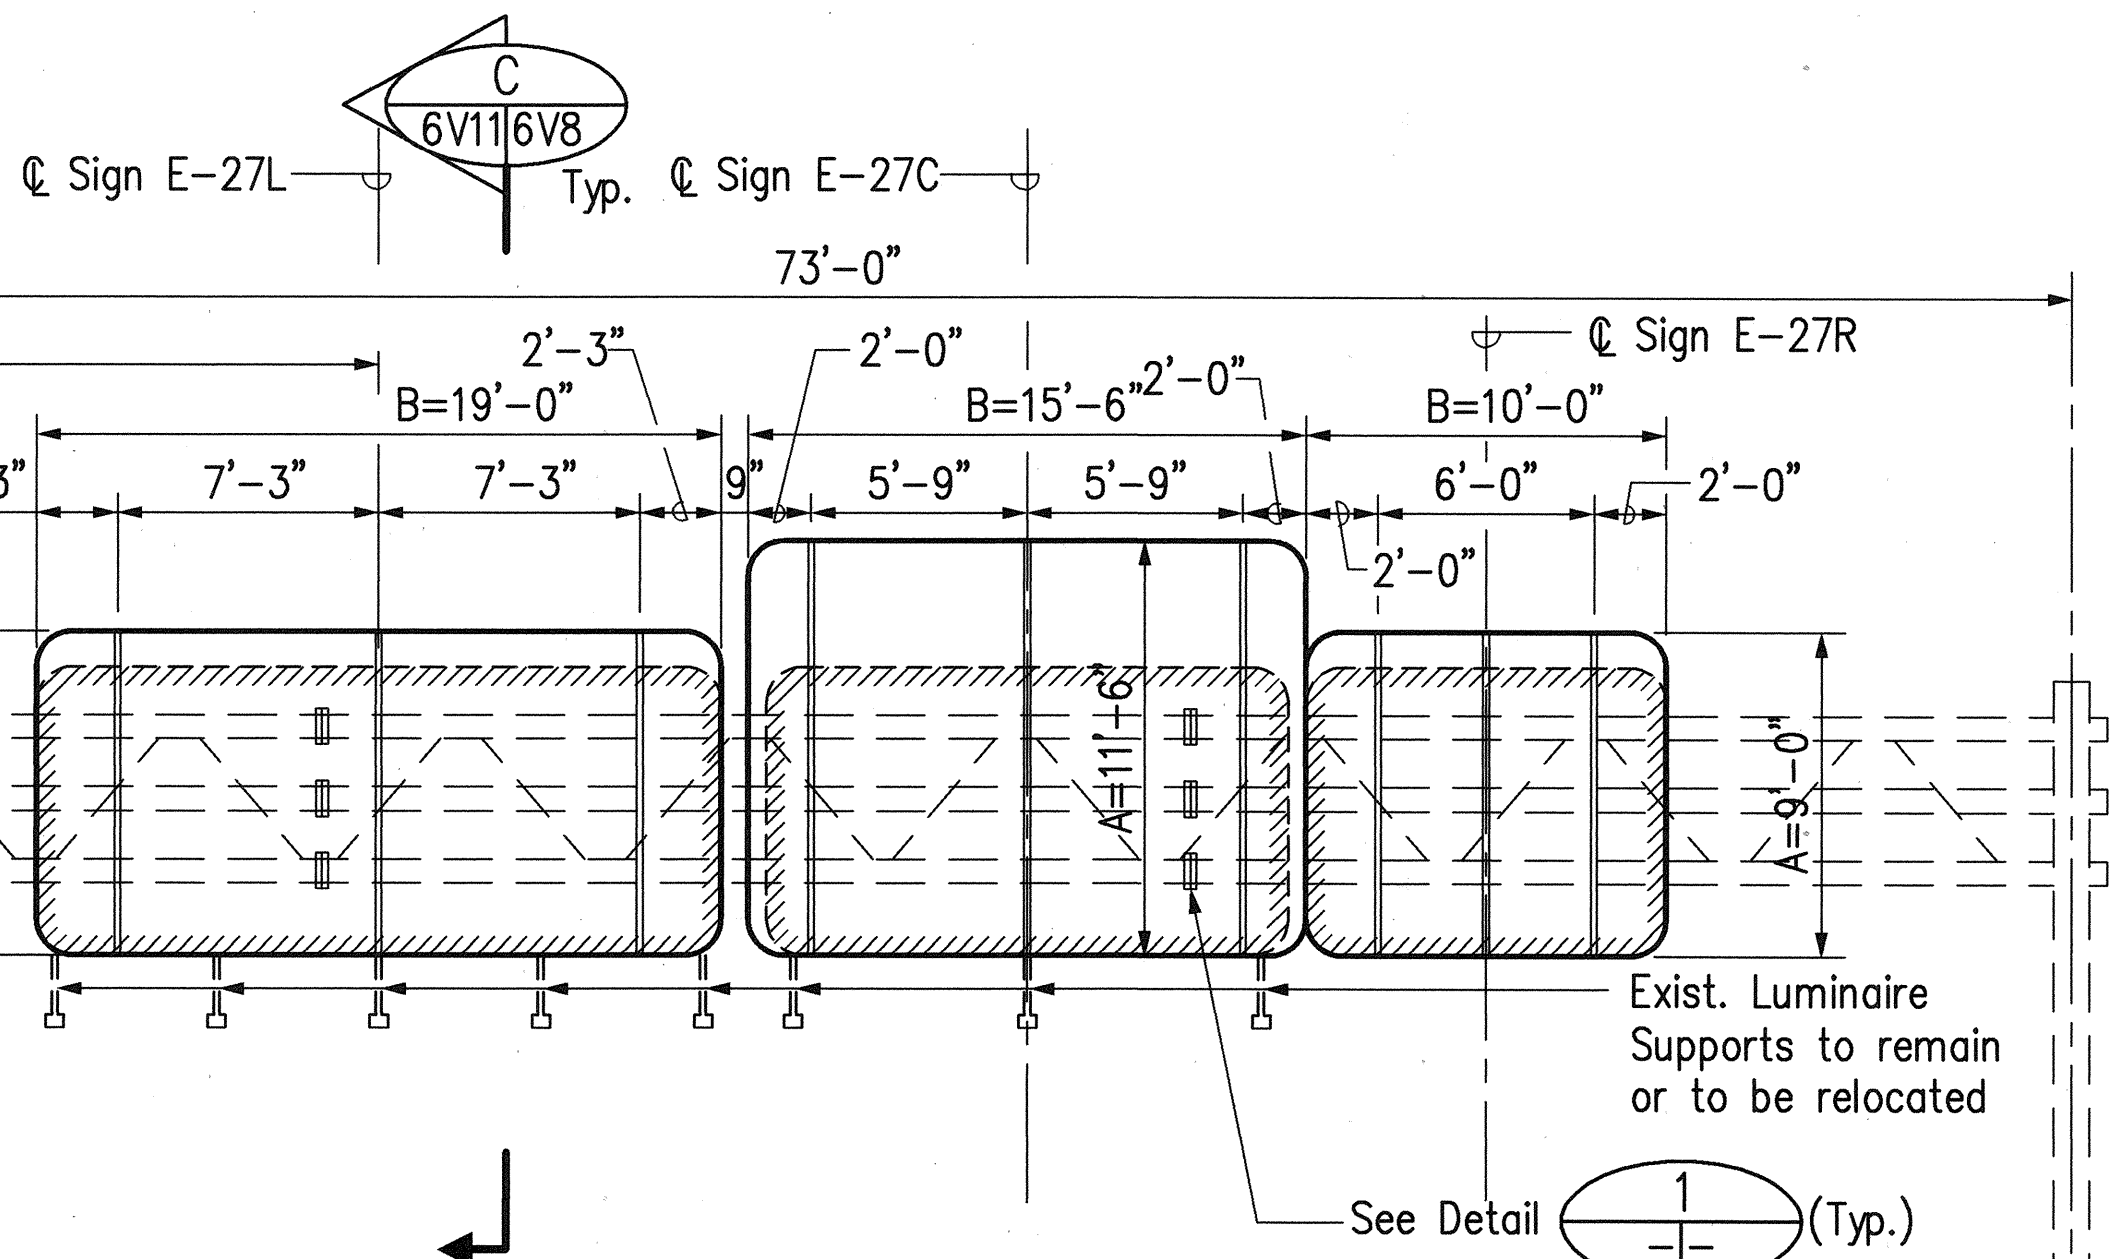

ELEVATION - SIGN E-27L, E-27C, & E-27R

Ulu Extension Sta. 34+35

Scale: $\frac{3}{16}'' = 1'-0''$

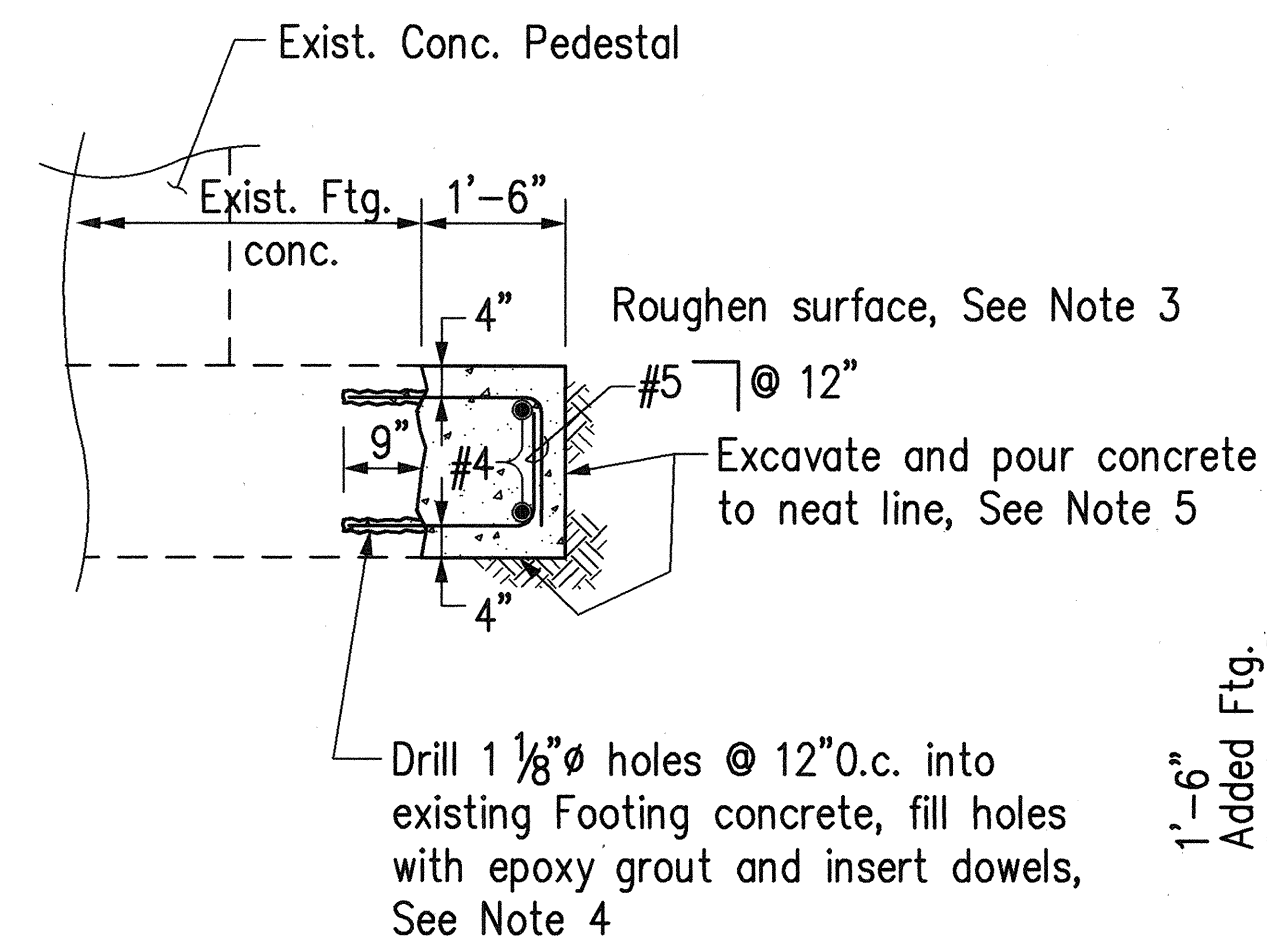

SECTION

Scale: $\frac{1}{2}'' = 1'-0''$



SECTION

Scale: $\frac{3}{8}'' = 1'-0''$ 6V8,6V11,6V12/6V11



THIS WORK WAS PREPARED BY ME OR UNDER MY SUPERVISION.

Hui Pang Chen

4/21/97	Added Foundation Details & Section E
Date	Revision
STATE OF HAWAII DEPARTMENT OF TRANSPORTATION HIGHWAYS DIVISION	
DESTINATION SIGNS	
EXISTING SIGN STRUCTURES	
SIGN MOUNTING DETAILS - 4	
H-3 FINISH (UNIT II) FAIP NO. I-H3-1(75), UNIT II LEEWARD SECTION	
SCALE: AS SHOWN	DATE: JANUARY 1997
SHEET NO. 6V11 OF 14 SHEETS	

ADD. 881

ORIGINAL SURVEY PLOTTED BY	DATE
DRAWN BY	
TRACED BY	
DESIGNED BY	
CHECKED BY	
No.	






CAD by D. Burgess, 55-52

Last Saved: J:\H3RF\RFU2\SIGN\SLO-MISC.dwg 04/18/97 at 07:48

LEGEND

Exist. Sign to be removed

FED. ROAD DIST. NO.	STATE	FED. AID PROJ. NO.	FISCAL YEAR	SHEET NO.	TOTAL SHEETS
HAWAII	HAW.	I-H3-1(75), UNIT II	1997	882	1102

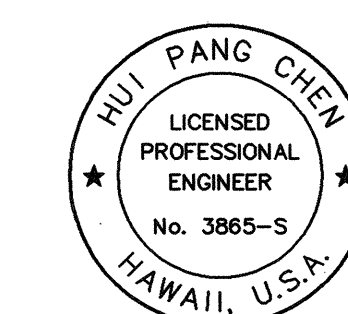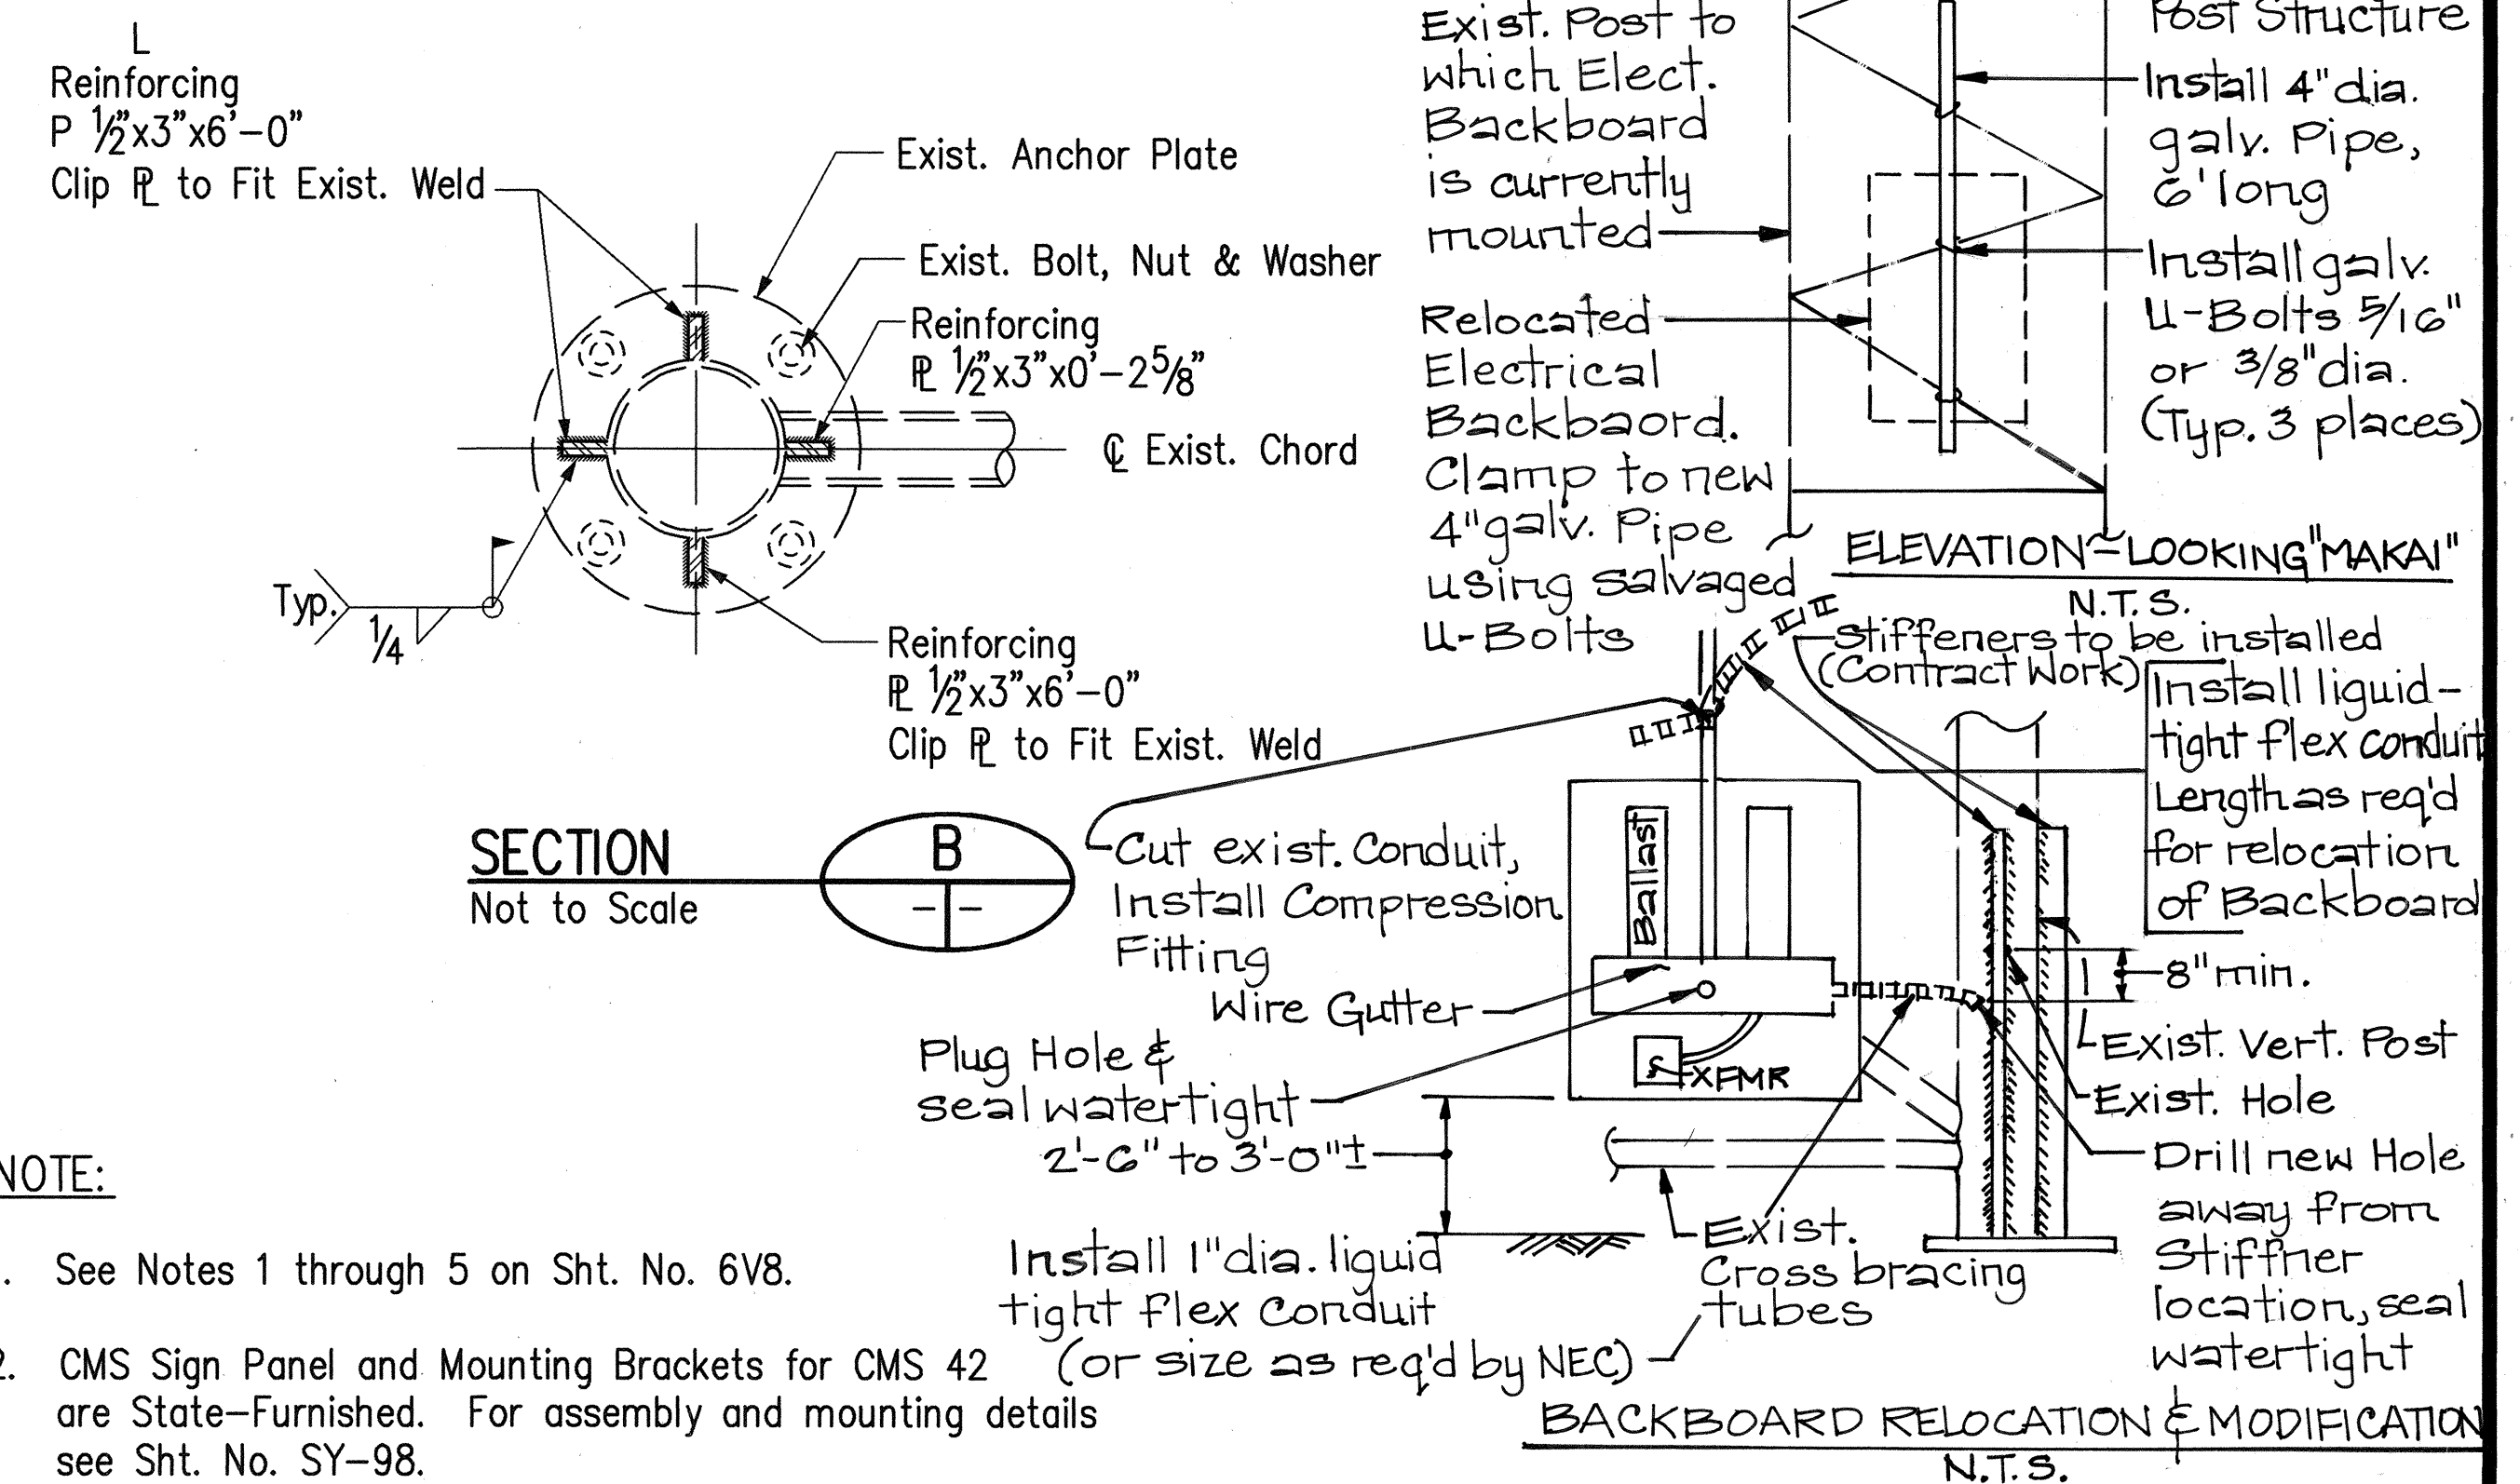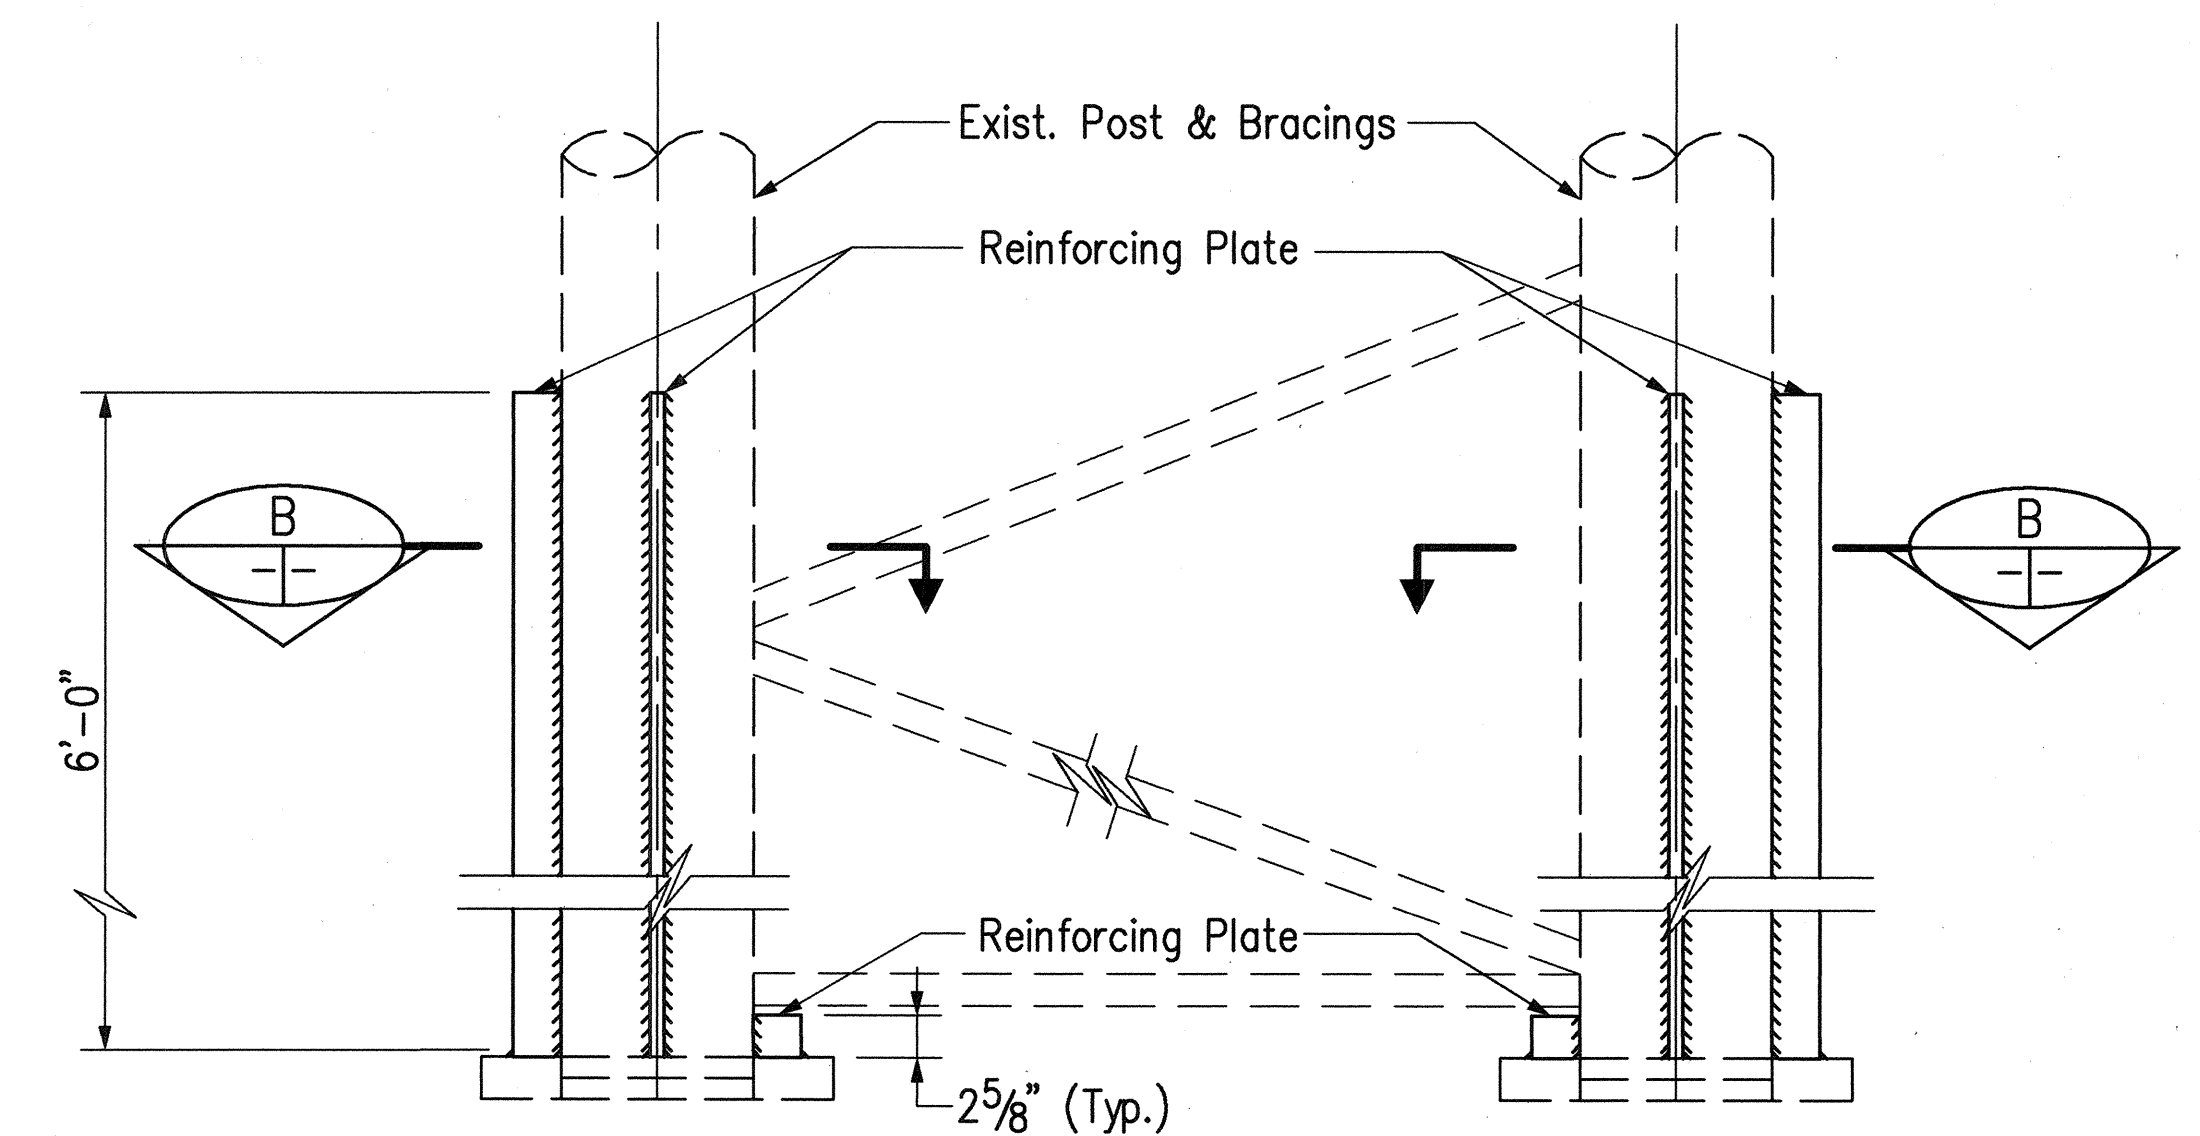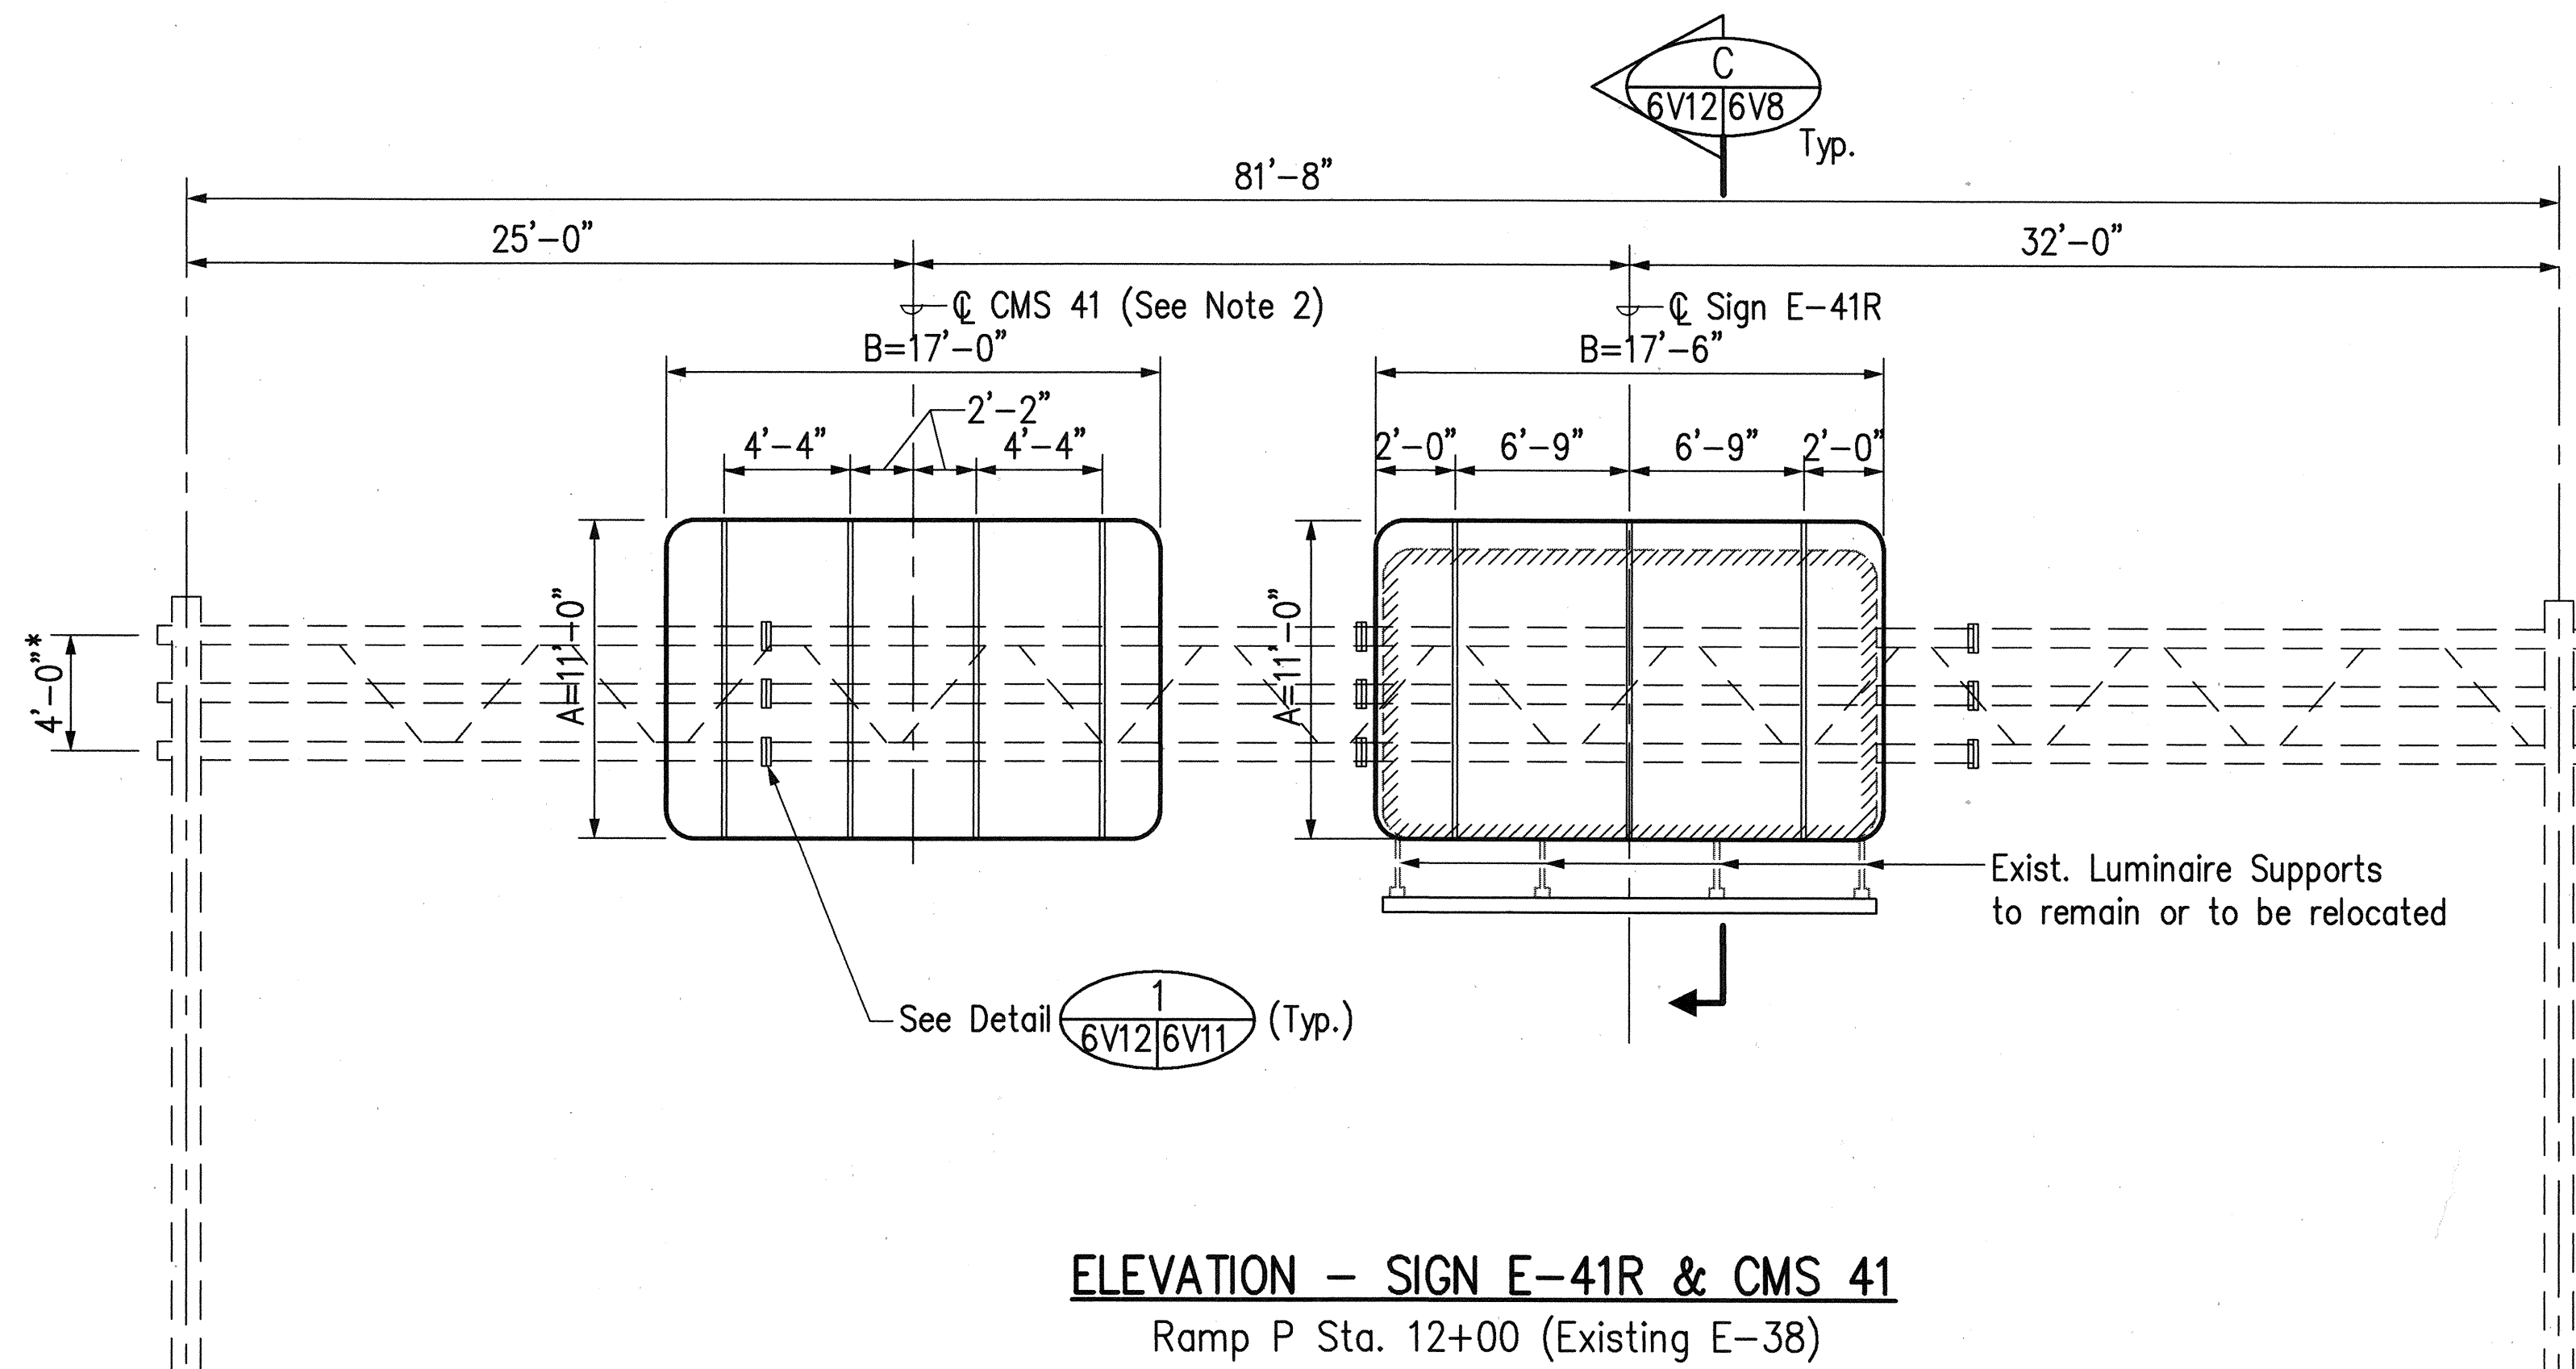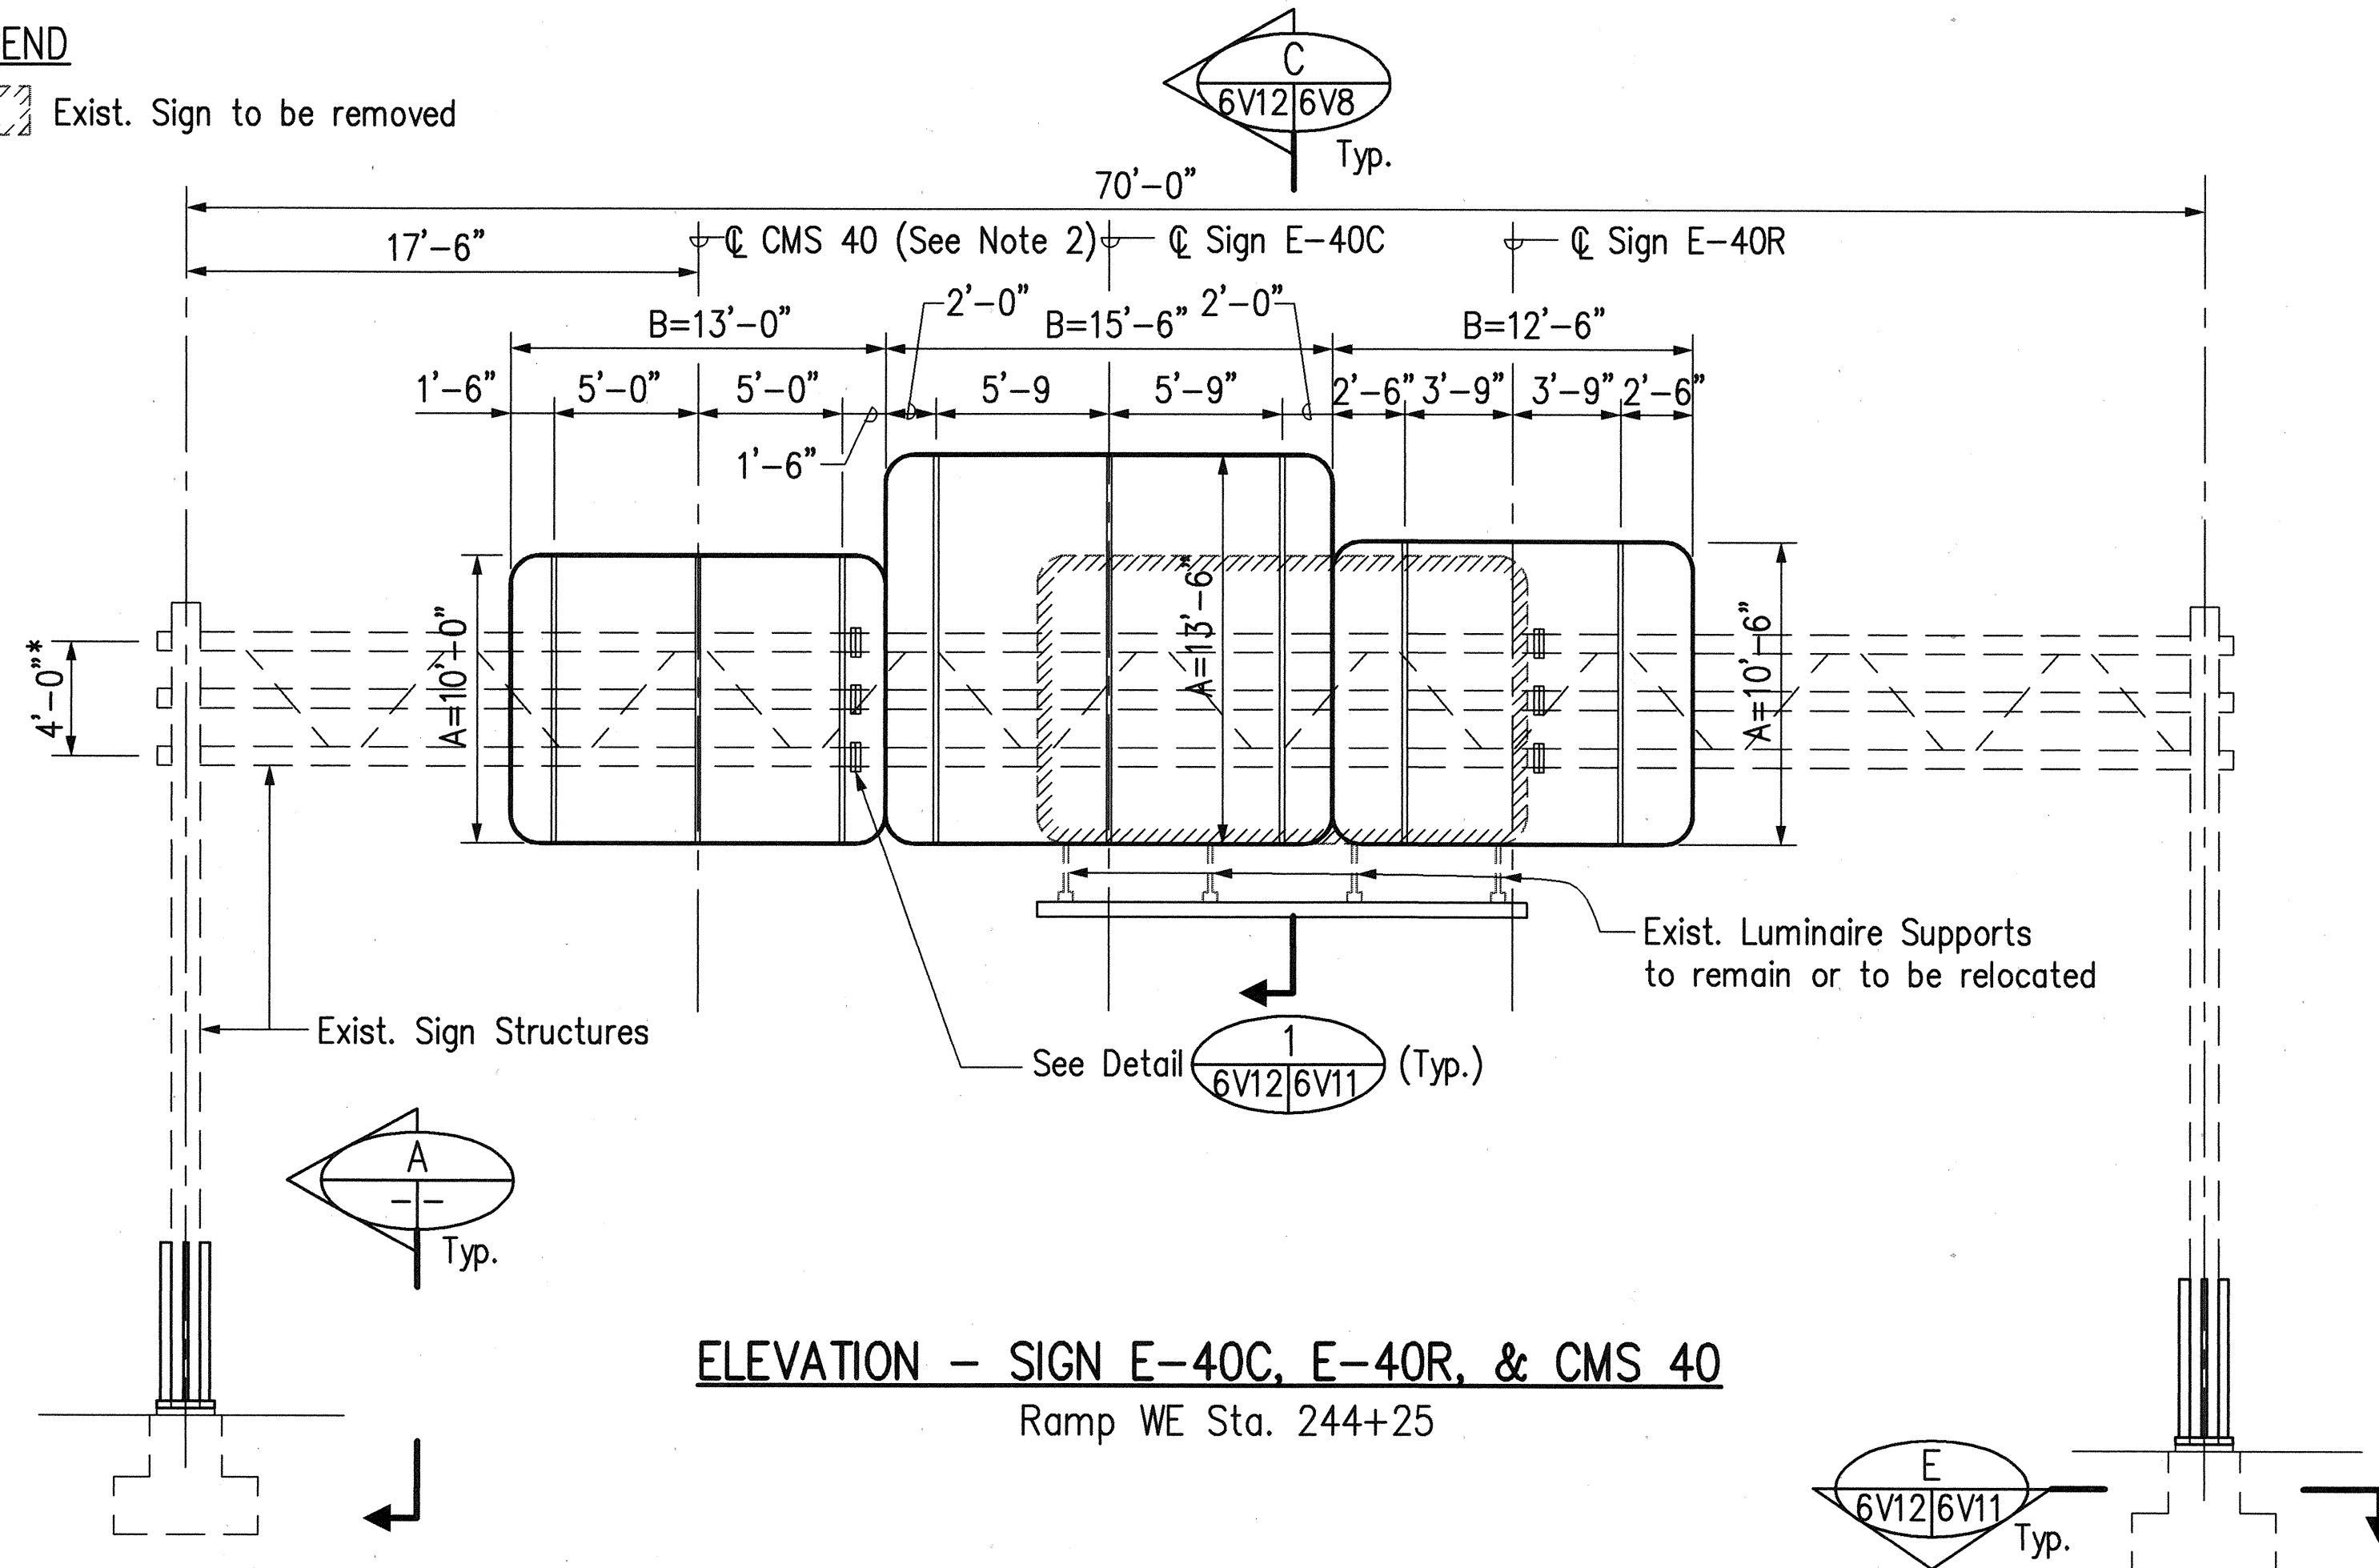

THIS WORK WAS PREPARED BY ME OR UNDER MY SUPERVISION.

Hui Pang Chen

Date	Added Section E	Revision
4/21/97		
STATE OF HAWAII DEPARTMENT OF TRANSPORTATION HIGHWAYS DIVISION		
DESTINATION SIGNS EXISTING SIGN STRUCTURES SIGN MOUNTING DETAILS - 5		
H-3 FINISH (UNIT II) FAIP NO. I-H3-1(75), UNIT II LEEWARD SECTION		
SCALE: 3/16" = 1'-0" DATE: JANUARY 1997		
SHEET NO. 6V12 OF 14 SHEETS		


ADD. 882


FED. ROAD DIST. NO.	STATE	FED. AID PROJ. NO.	FISCAL YEAR	SHEET NO.	TOTAL SHEETS
HAWAII	HAW.	I-H3-1(75), UNIT II	1997	883	1102

NOTE:

See Notes 1 through 5 on Sht. No. 6V9.

LEGEND

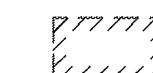
 Exist. Sign to be removed

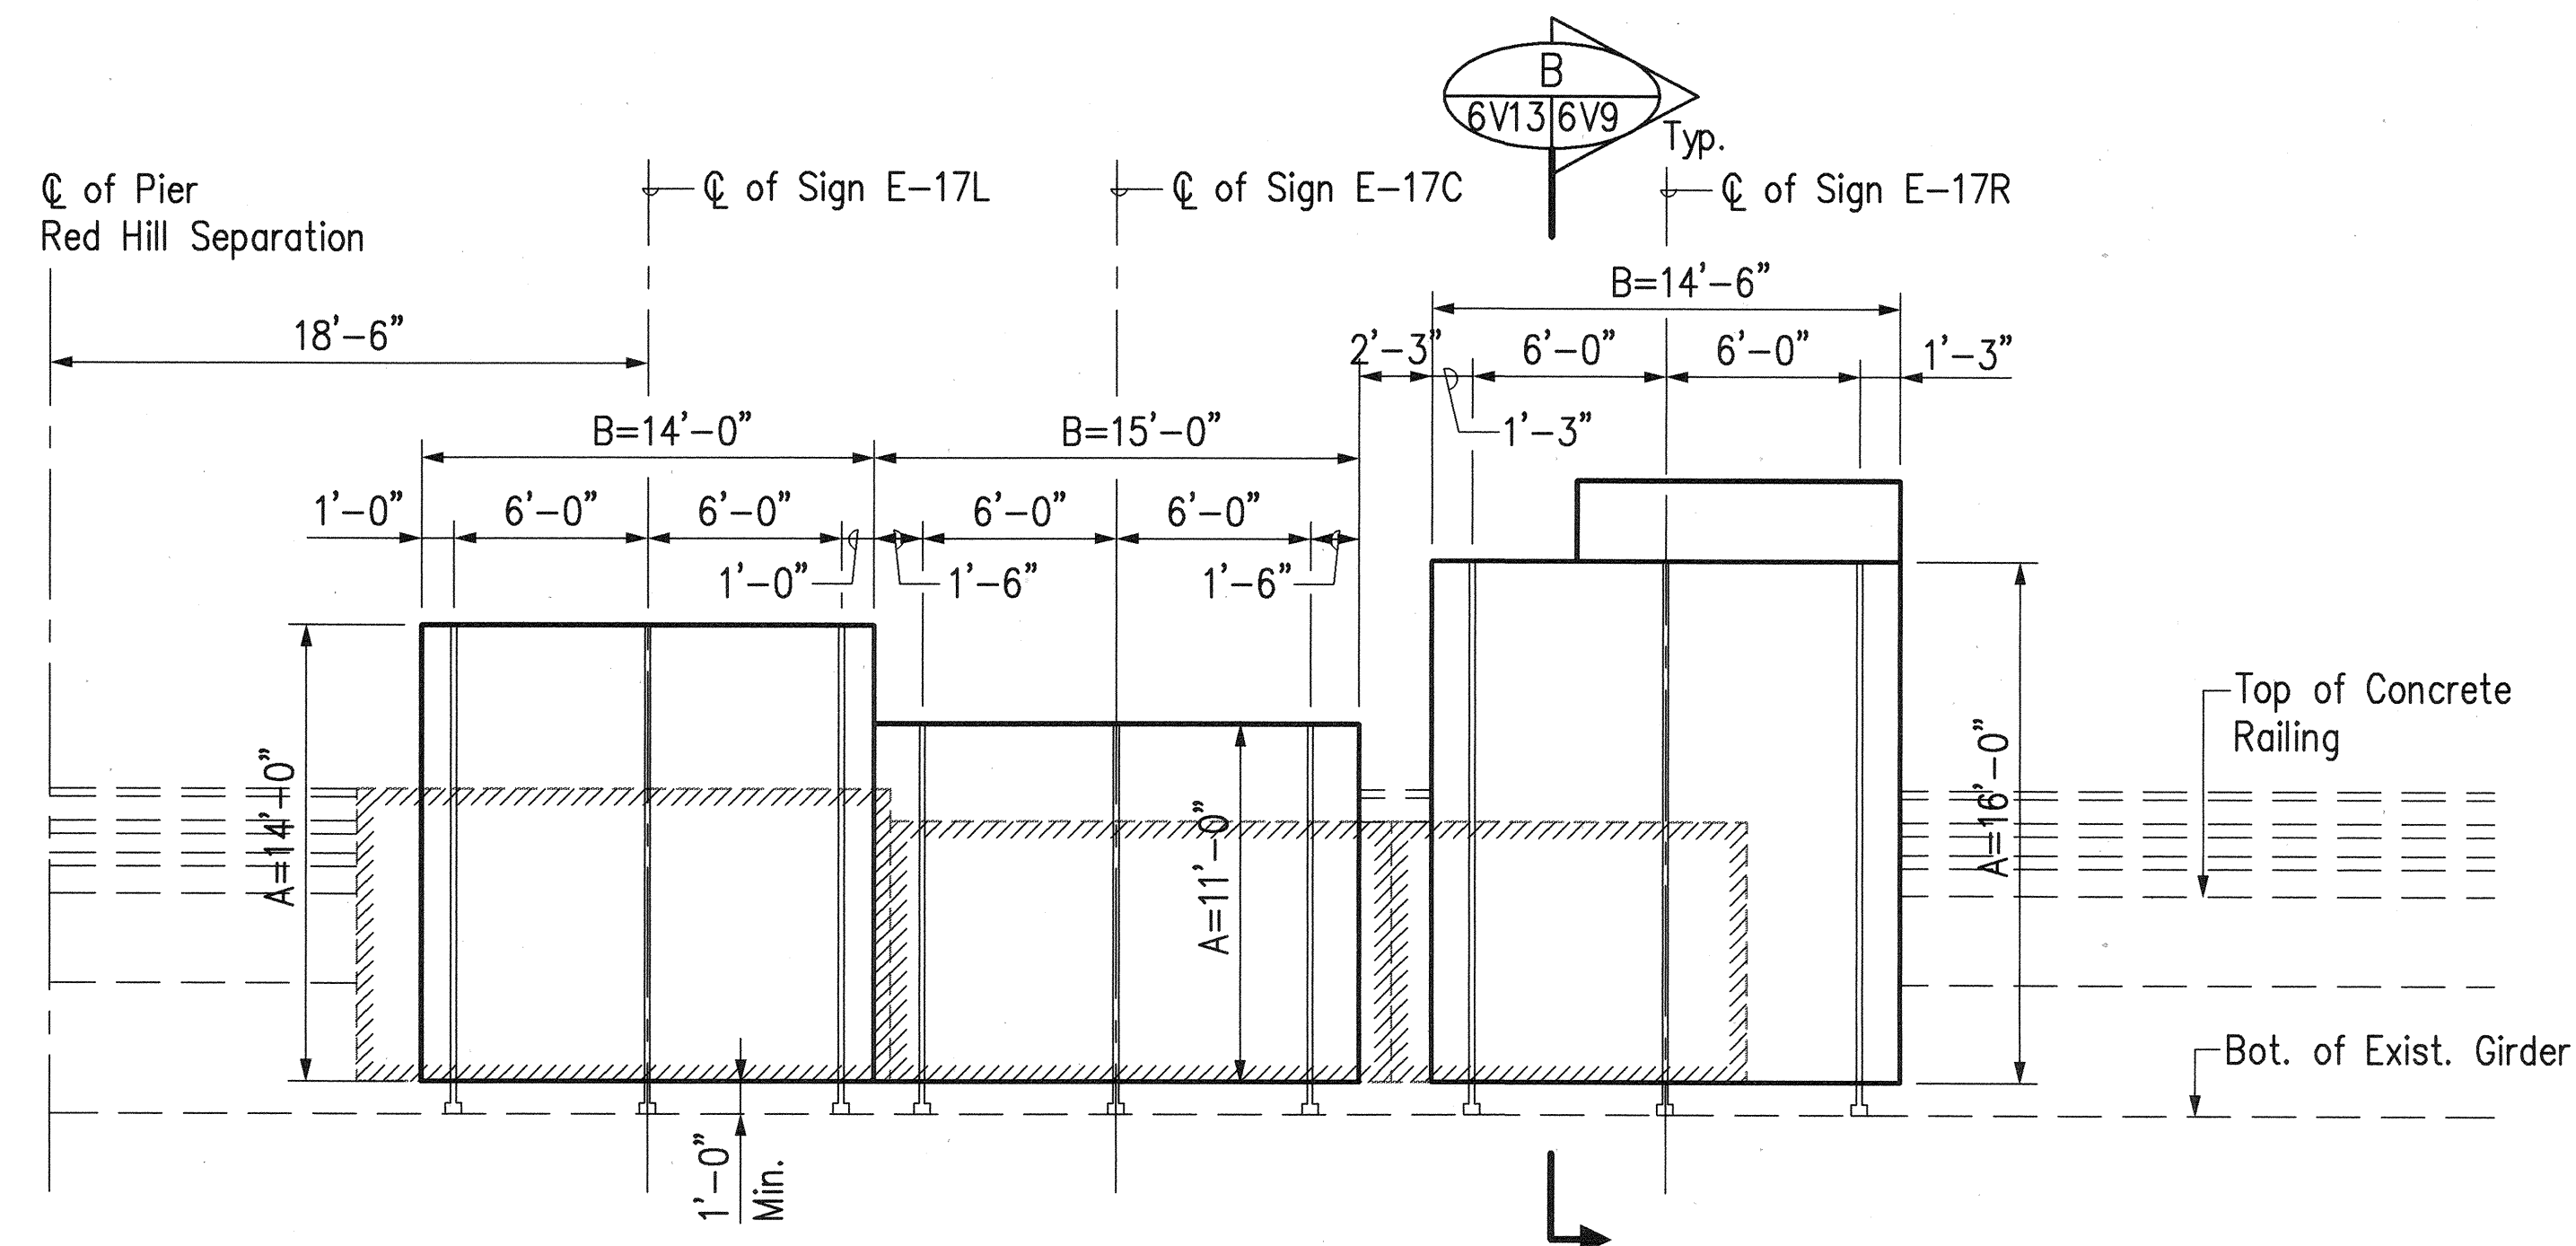

ELEVATION - SIGN E-17L, E-17C, & E-17R

Moanalua Freeway Sta. 226+00±


Scale: $\frac{3}{16}$ " = 1'-0"

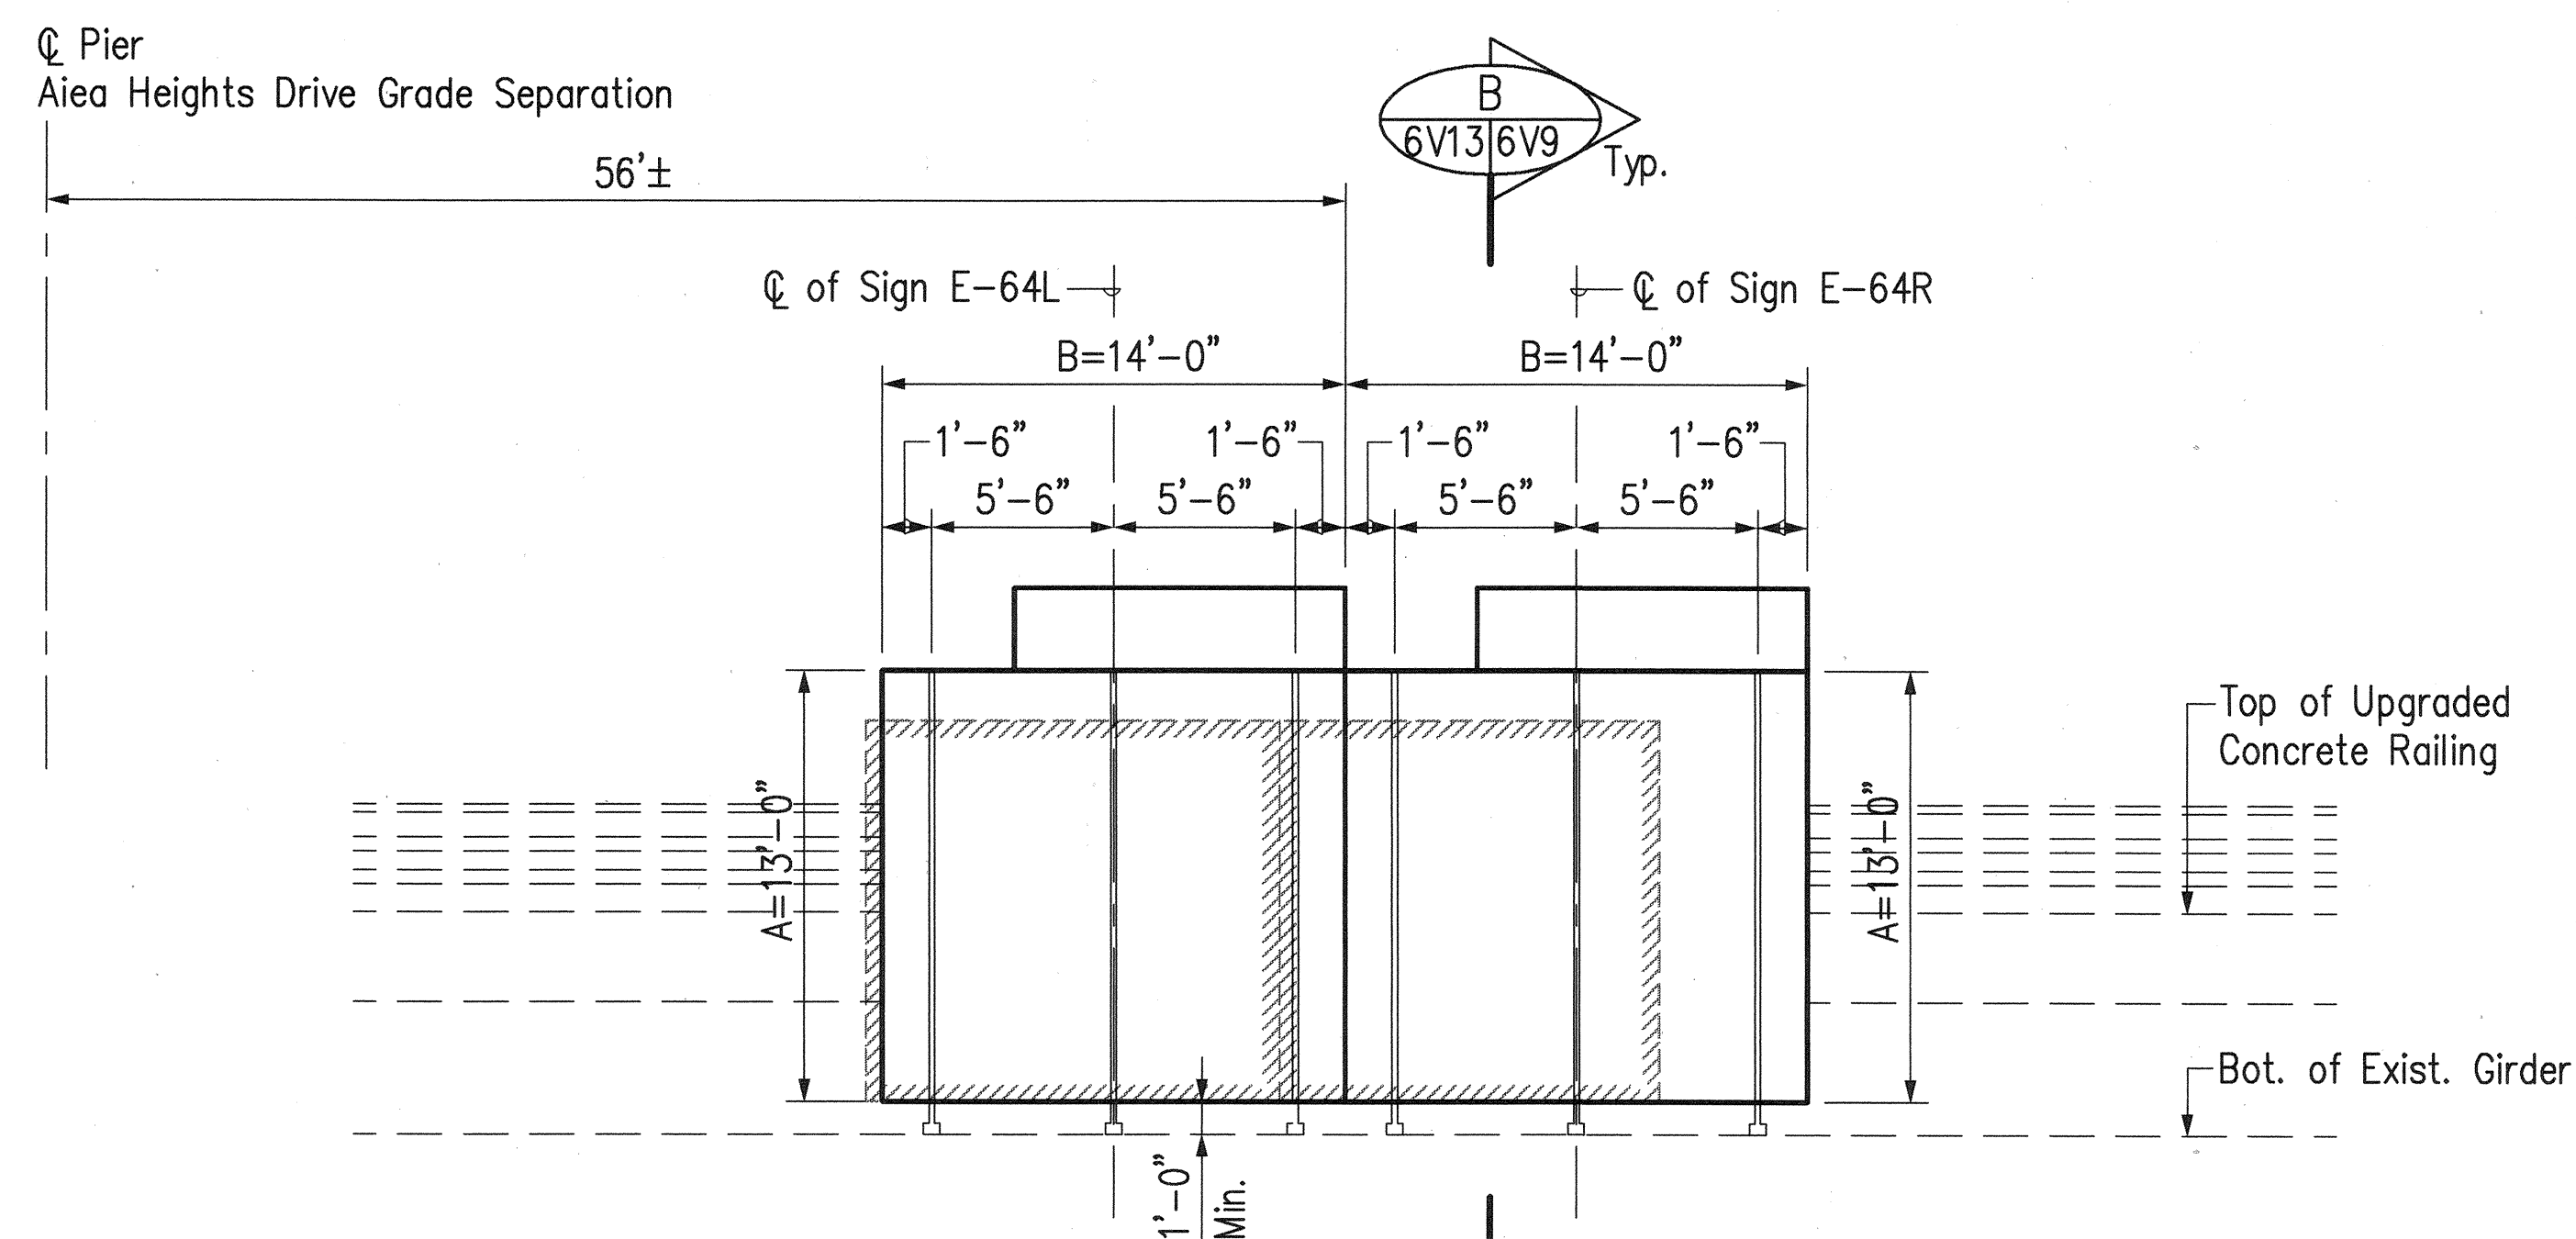

ELEVATION - SIGN E-64L & E-64R

Interstate Route H-1 Inbound Sta. 191+88±

Scale: $\frac{3}{16}$ " = 1'-0"

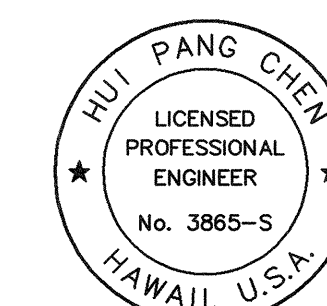

THIS WORK WAS PREPARED BY ME
OR UNDER MY SUPERVISION.

Hui Pang Chen

STATE OF HAWAII
DEPARTMENT OF TRANSPORTATION
HIGHWAYS DIVISION

DESTINATION SIGNS EXISTING SIGN STRUCTURES SIGN MOUNTING DETAILS - 6

H-3 FINISH (UNIT II)
FAIP NO. I-H3-1(75), UNIT II
LEEWARD SECTION

SCALE: $\frac{3}{16}$ " = 1'-0" DATE: JANUARY 1997

SHEET NO. 6V13 OF 14 SHEETS

883

ORIGINAL PLAN	SURVEY PLOTTED BY	DATE
NOTE BOOK	DRAWN BY	
	TRACED BY	
	DESIGNED BY	
	CHECKED BY	
No.		

CAD by D. Burgess, 55-52


Last Saved: J:\H3RF\RFU2\SIGN\SLOMISC4.dwg 03/02/97 at 15:36


FED. ROAD DIST. NO.	STATE	FED. AID PROJ. NO.	FISCAL YEAR	SHEET NO.	TOTAL SHEETS
HAWAII	HAW.	I-H3-1(75), UNIT II	1997	884	1102

NOTES:


- See Notes 1 through 5 on Sht No. 6V9.
- The existing sign panels, sign panel mounting brackets, and luminaire supports while interfere with the new sign mounting brackets shall be removed.

LEGEND:

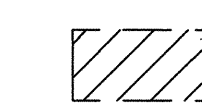
 Exist. Structure to be removed

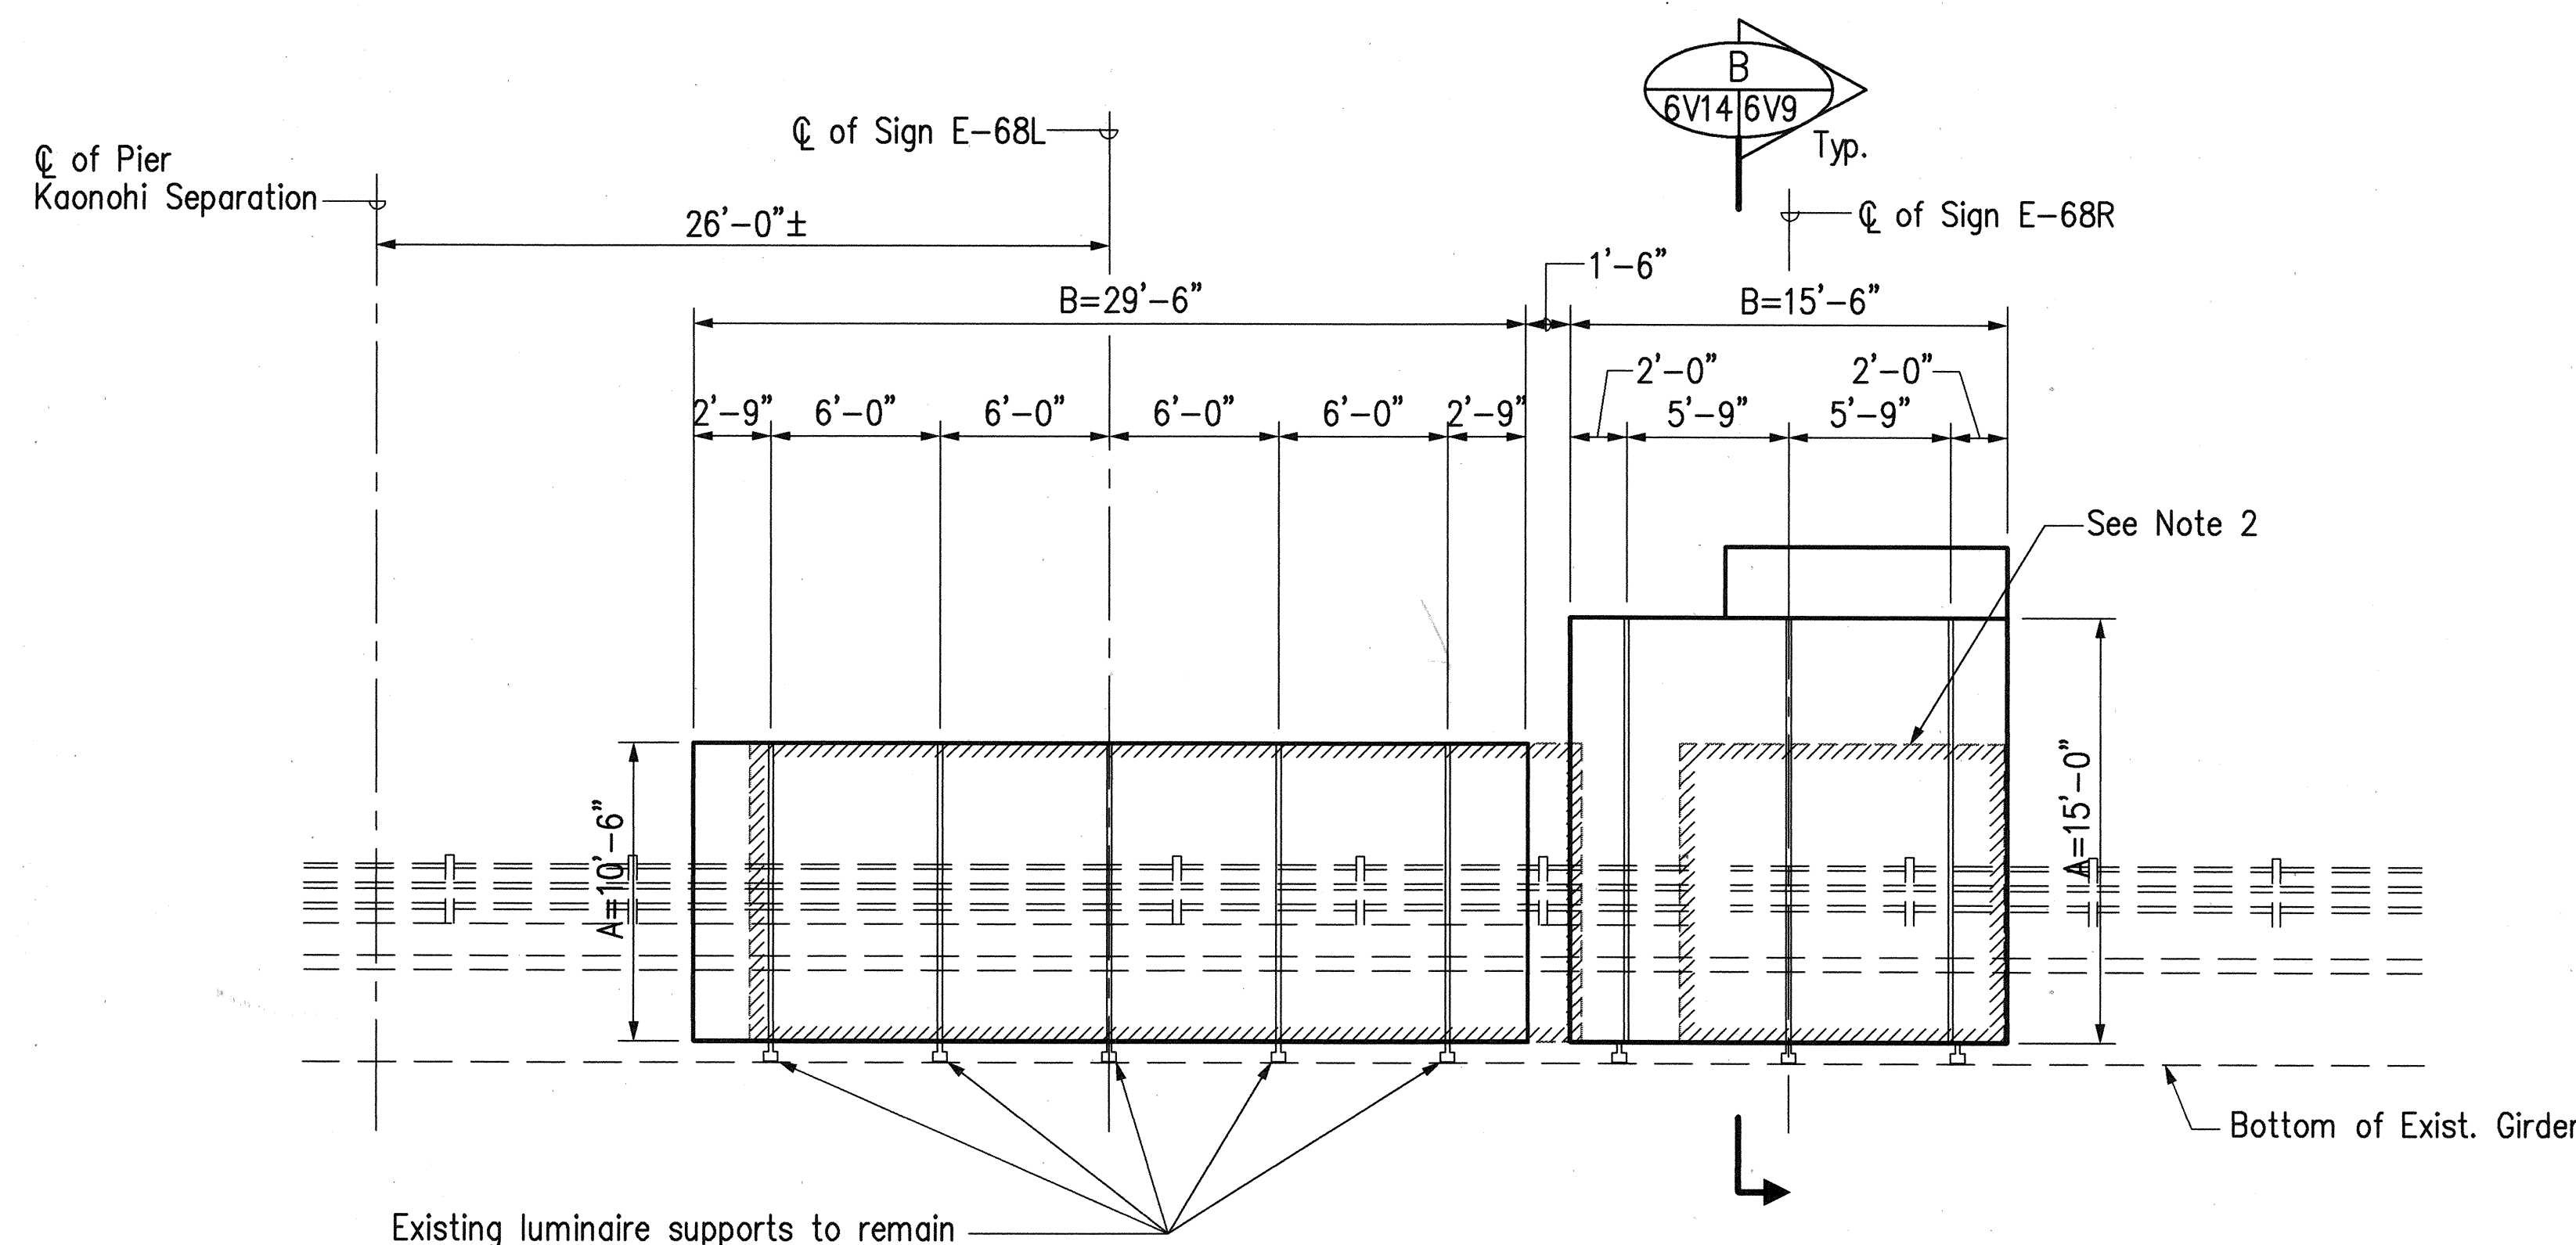


ELEVATION - SIGN E-68L & E-68R
Interstate Route H-1 Inbound Sta. 138+75±
Scale: $\frac{3}{16}$ " = 1'-0"

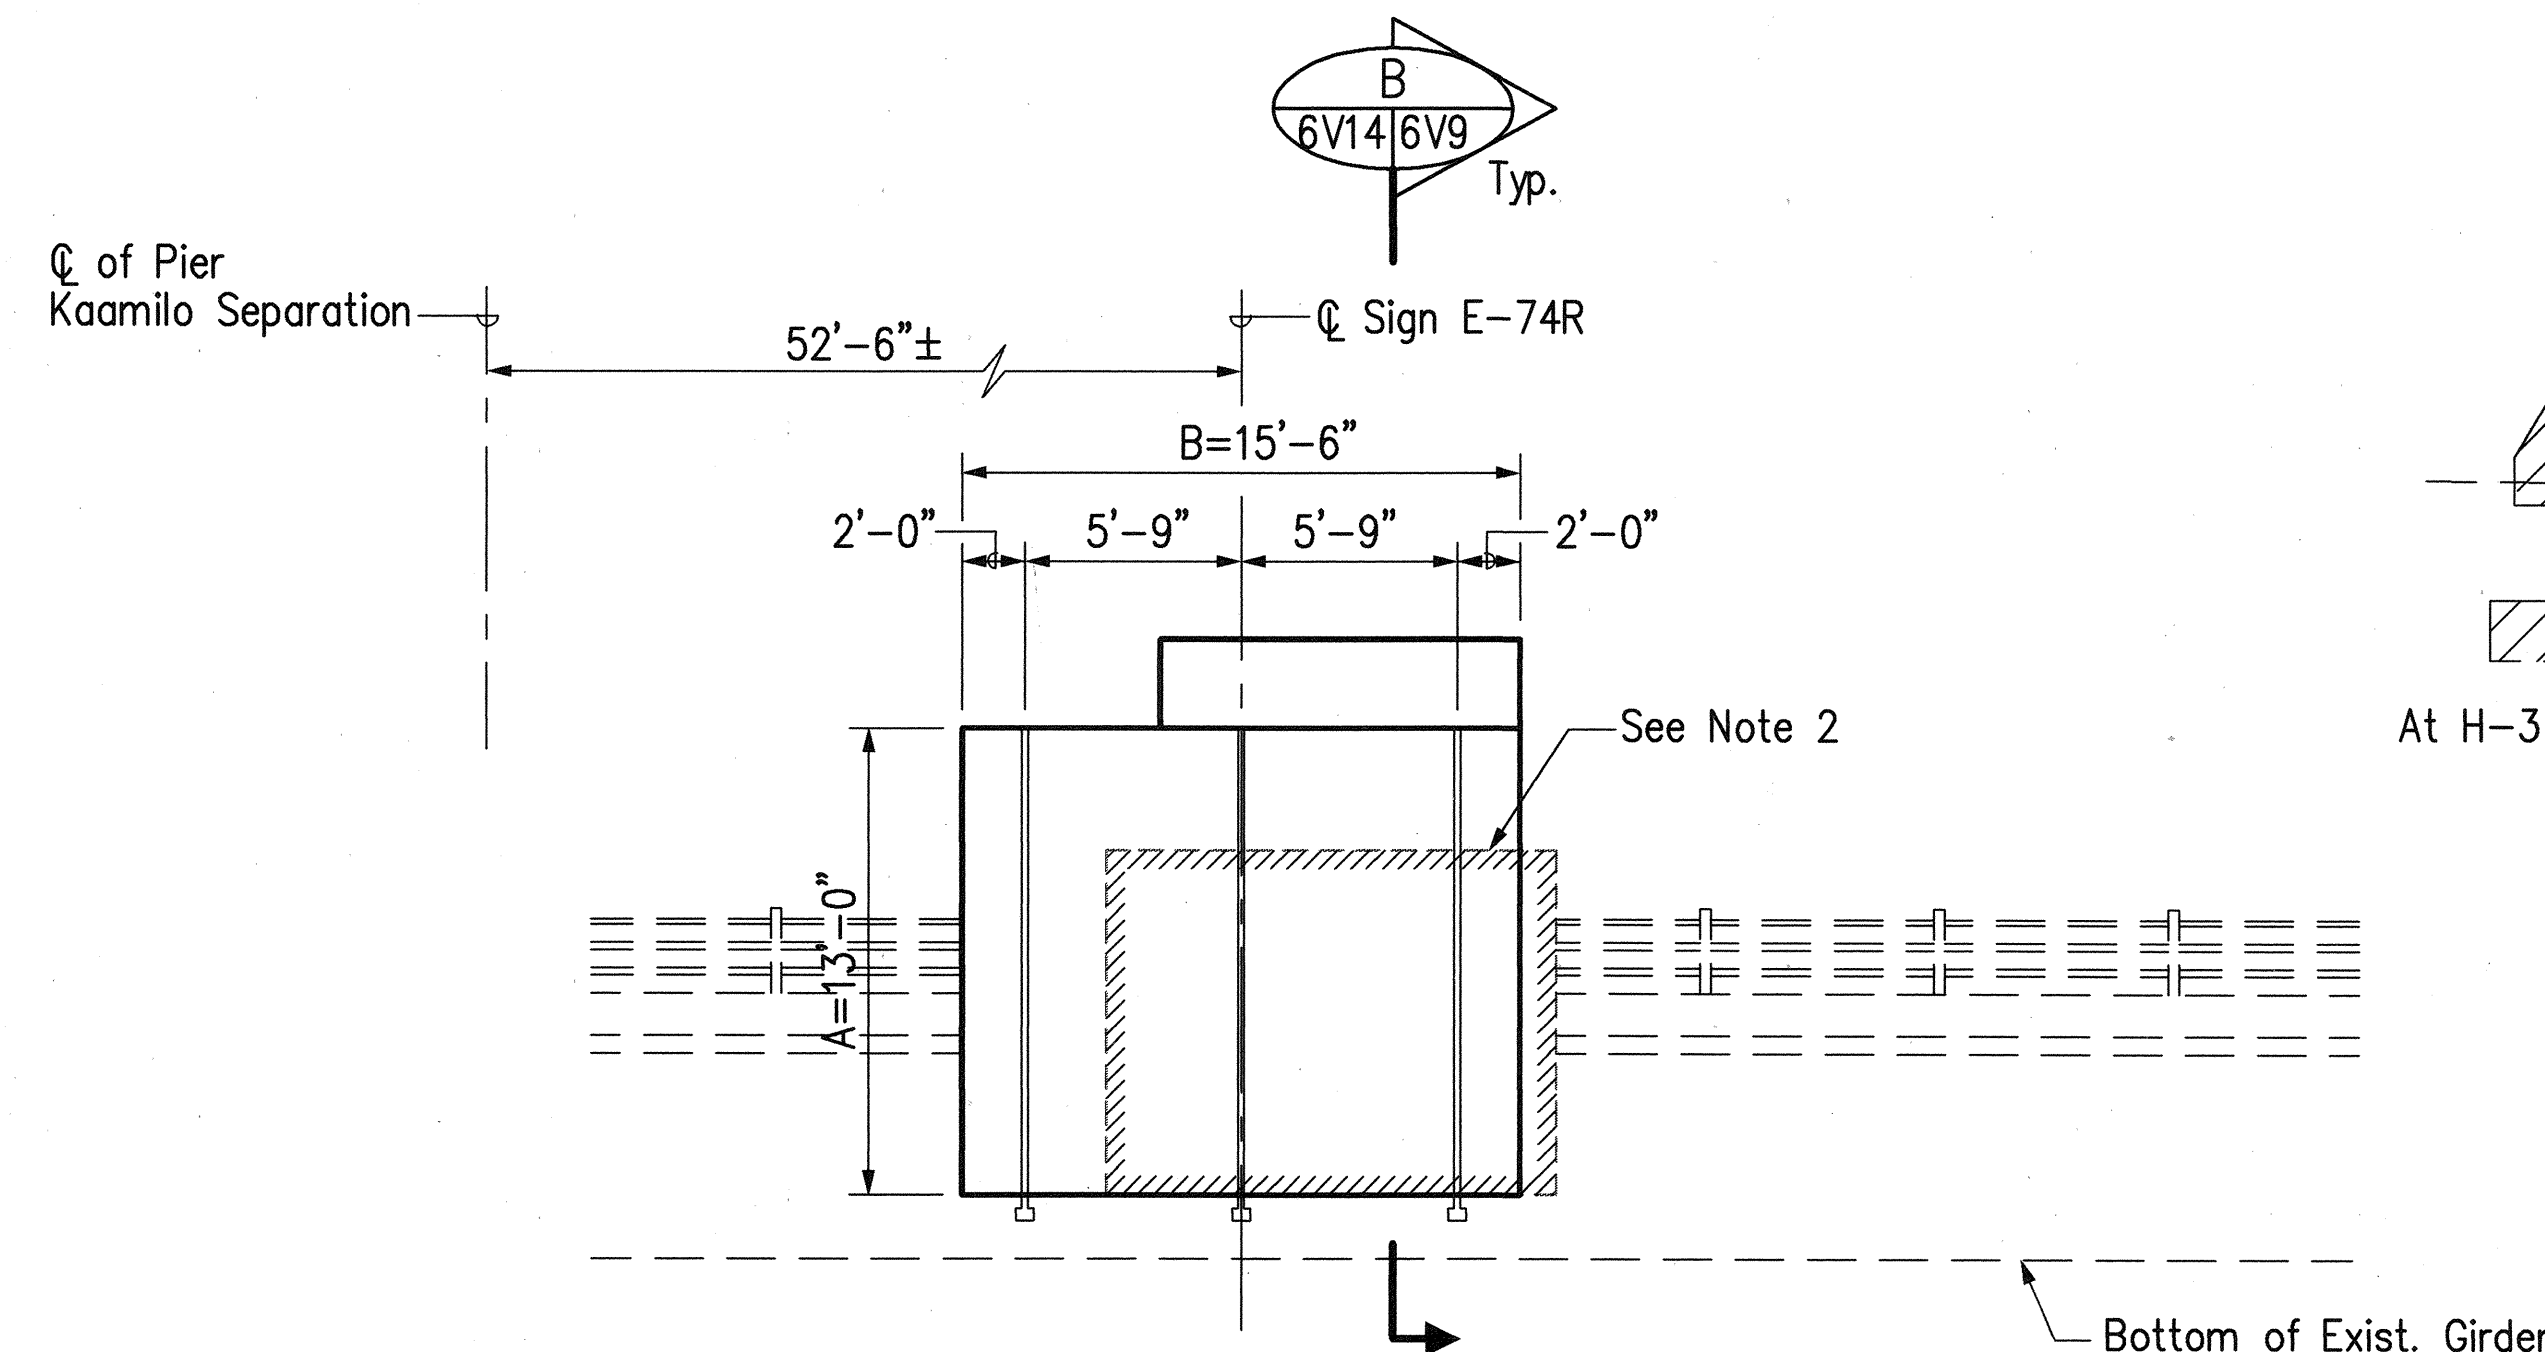

ELEVATION - SIGN E-74R
Interstate Route H-1 Inbound Sta. 172+38±
Scale: $\frac{3}{16}$ " = 1'-0"

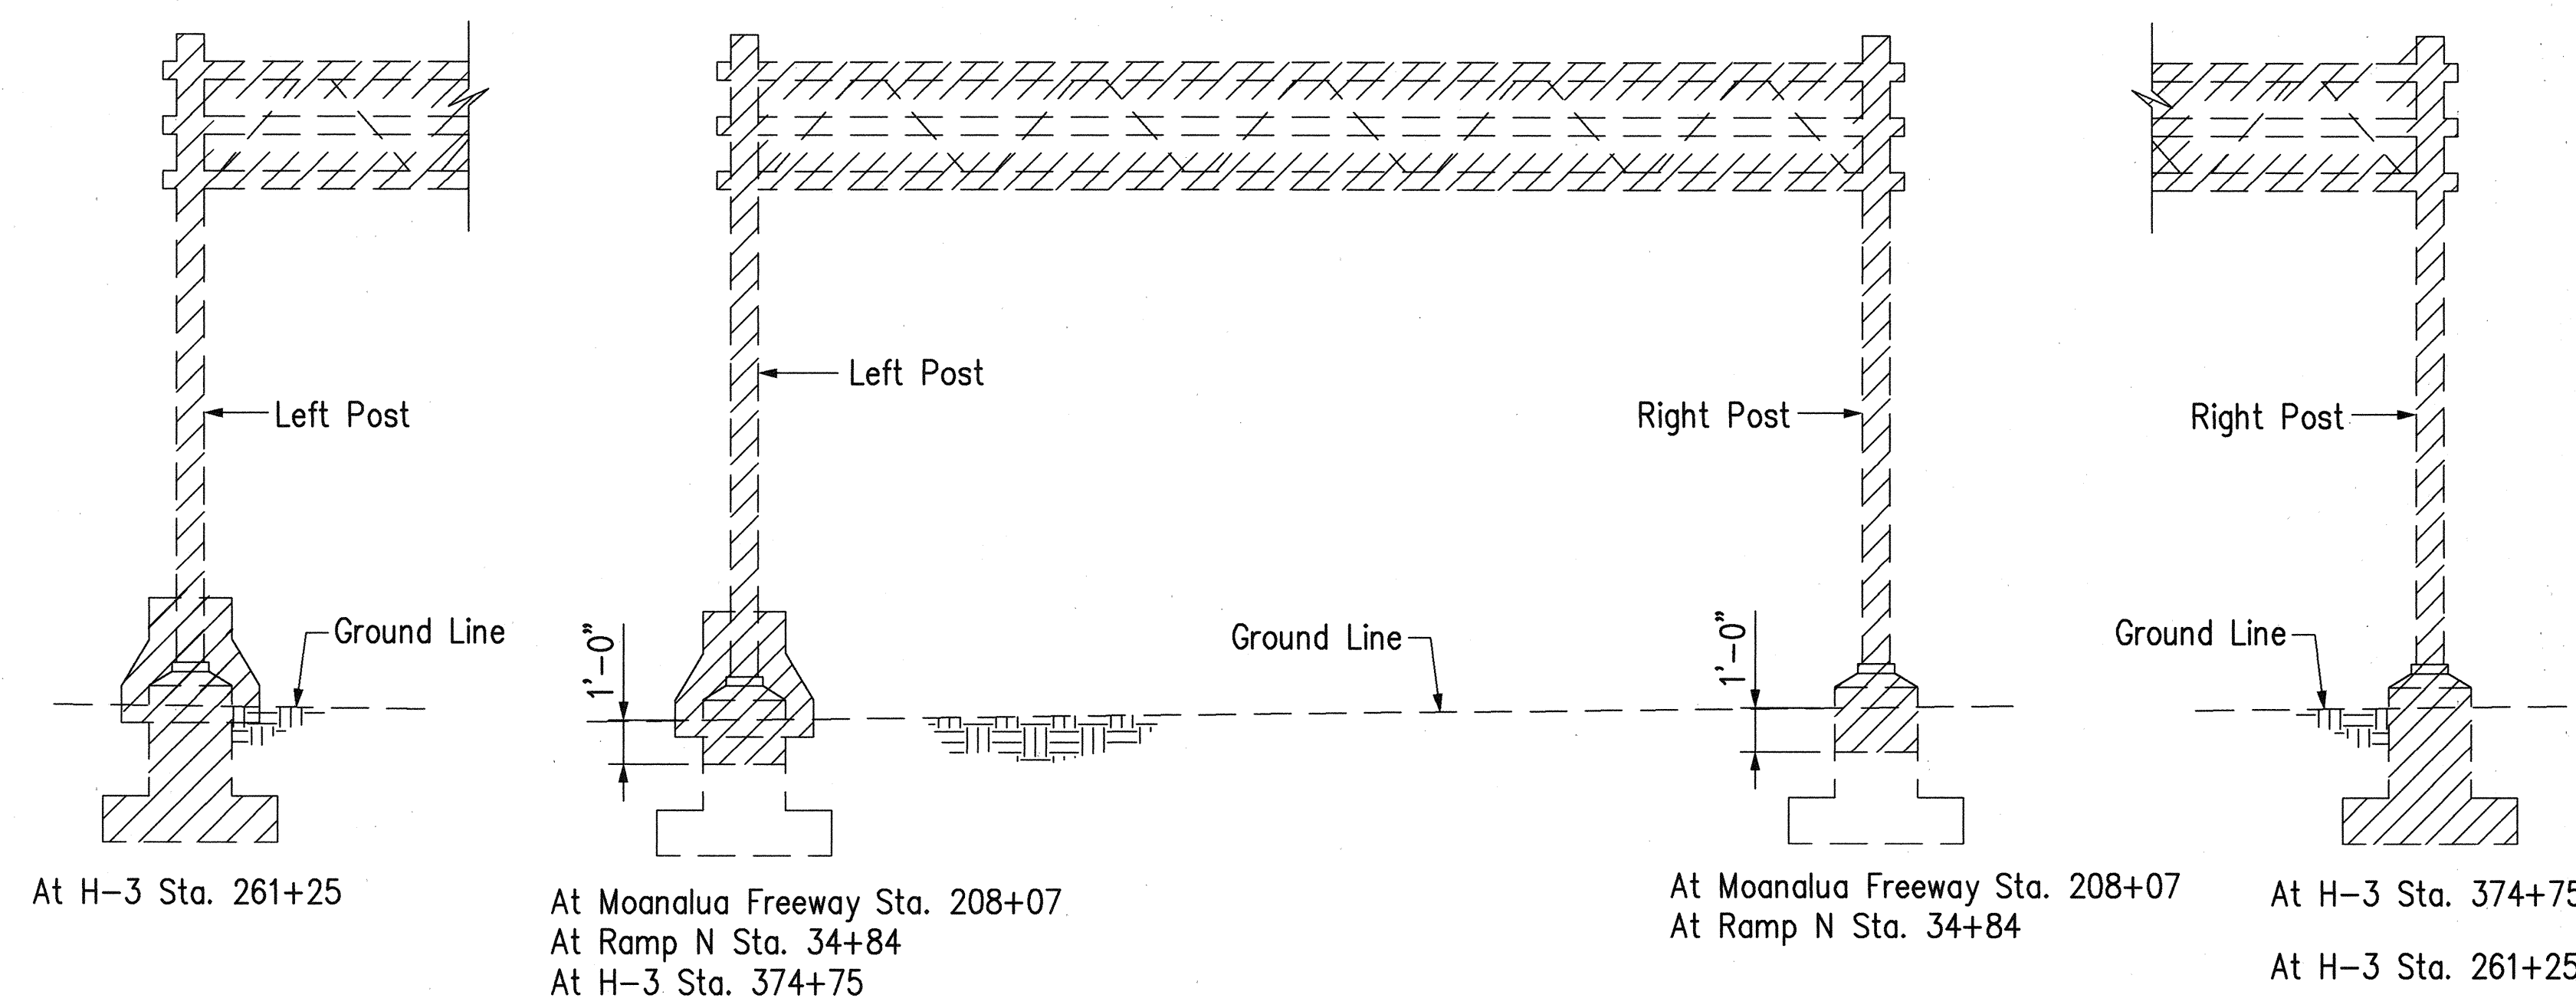

REMOVAL OF EXISTING SIGN STRUCTURE
N.T.S.

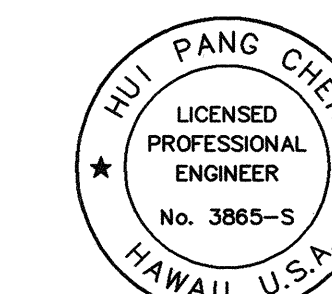

THIS WORK WAS PREPARED BY ME
OR UNDER MY SUPERVISION.

Hui Pang Chen

Date	Revision
4/21/97	Revised Removal of Exist. Structures
STATE OF HAWAII DEPARTMENT OF TRANSPORTATION HIGHWAYS DIVISION DESTINATION SIGNS EXISTING SIGN STRUCTURES SIGN MOUNTING DETAILS - 7 H-3 FINISH (UNIT II) FAIP NO. I-H3-1(75), UNIT II LEeward SECTION SCALE: AS SHOWN DATE: JANUARY 1997 SHEET NO. 6V14 OF 14 SHEETS	

ADD. 884

SURVEY PLOTTED BY	DATE
DRAWN BY	
TRACED BY	
DESIGNED BY	
CHECKED BY	
NO.	

CAD by D. Burgess, SS-52

Last Saved: J:\H3RF\RFU2\SIGN\SLOWISC3.dwg 04/16/97 at 17:52

FED. ROAD DIST. NO.	STATE	FED. AID PROJ. NO.	FISCAL YEAR	SHEET NO.	TOTAL SHEETS
HAWAII	HAW.	I-H3-1(75), UNIT II	1997	C.O. 884S-1	1102

LUMINAIRE MOUNTING BRACKET MODIFICATION


SIGN	TYPE I	TYPE II
E-2L	X	-
E-2C	X	-
E-2R	X	-
E-6L	X	-
E-6C	X	-
E-6R	X	-
E-8L	X	-
E-8C	X	-
E-8R	X	-
E-15L	X	-
E-15C	X	-
CMS 42	-	-
E-27L	-	3*
E-27C	X	-
E-27R	X	-
E-30L	X	-
E-30R	X	-
E-33L	X	-
E-33C	X	-
E-33R	X	-
CMS 40	-	-
E-40C	X	-
E-40R	-	3*
CMS 41	-	-
E-41R	X	-
E-62L	-	**
E-62R	-	**
E-63L	-	3*
E-63R	-	3*

LEGEND	
-	Modification not required
X	Modification required
*	Number of brackets required
**	Existing luminaire mounting brackets to be relocated per locations specified in Electrical Drawings.
***	Dimensions to be verified in field.

SIGN PANEL MOUNTING BRACKETS

Sign	Chord O.D.		"C"	Aluminum Beam
	Max.	Min.		
E-62L	4.5"***	4.5"***	1'-10 3/16"	L 5"X3"X1/2"
E-62R	4.5"***	4.5"***	1'-10 3/16"	L 5"X3"X1/2"
E-63L	4.5"	4.5"	1'-10 3/16"	L 6"X3 1/2"X1/2"
E-63R	4.5"	4.5"	1'-10 3/16"	L 5"X3"X1/2"

1/2" U-Bolt (A36)
w/ 1/2" Hex Nut
Bevel & Lock Washer
(A307 Galv.) (Typ.)

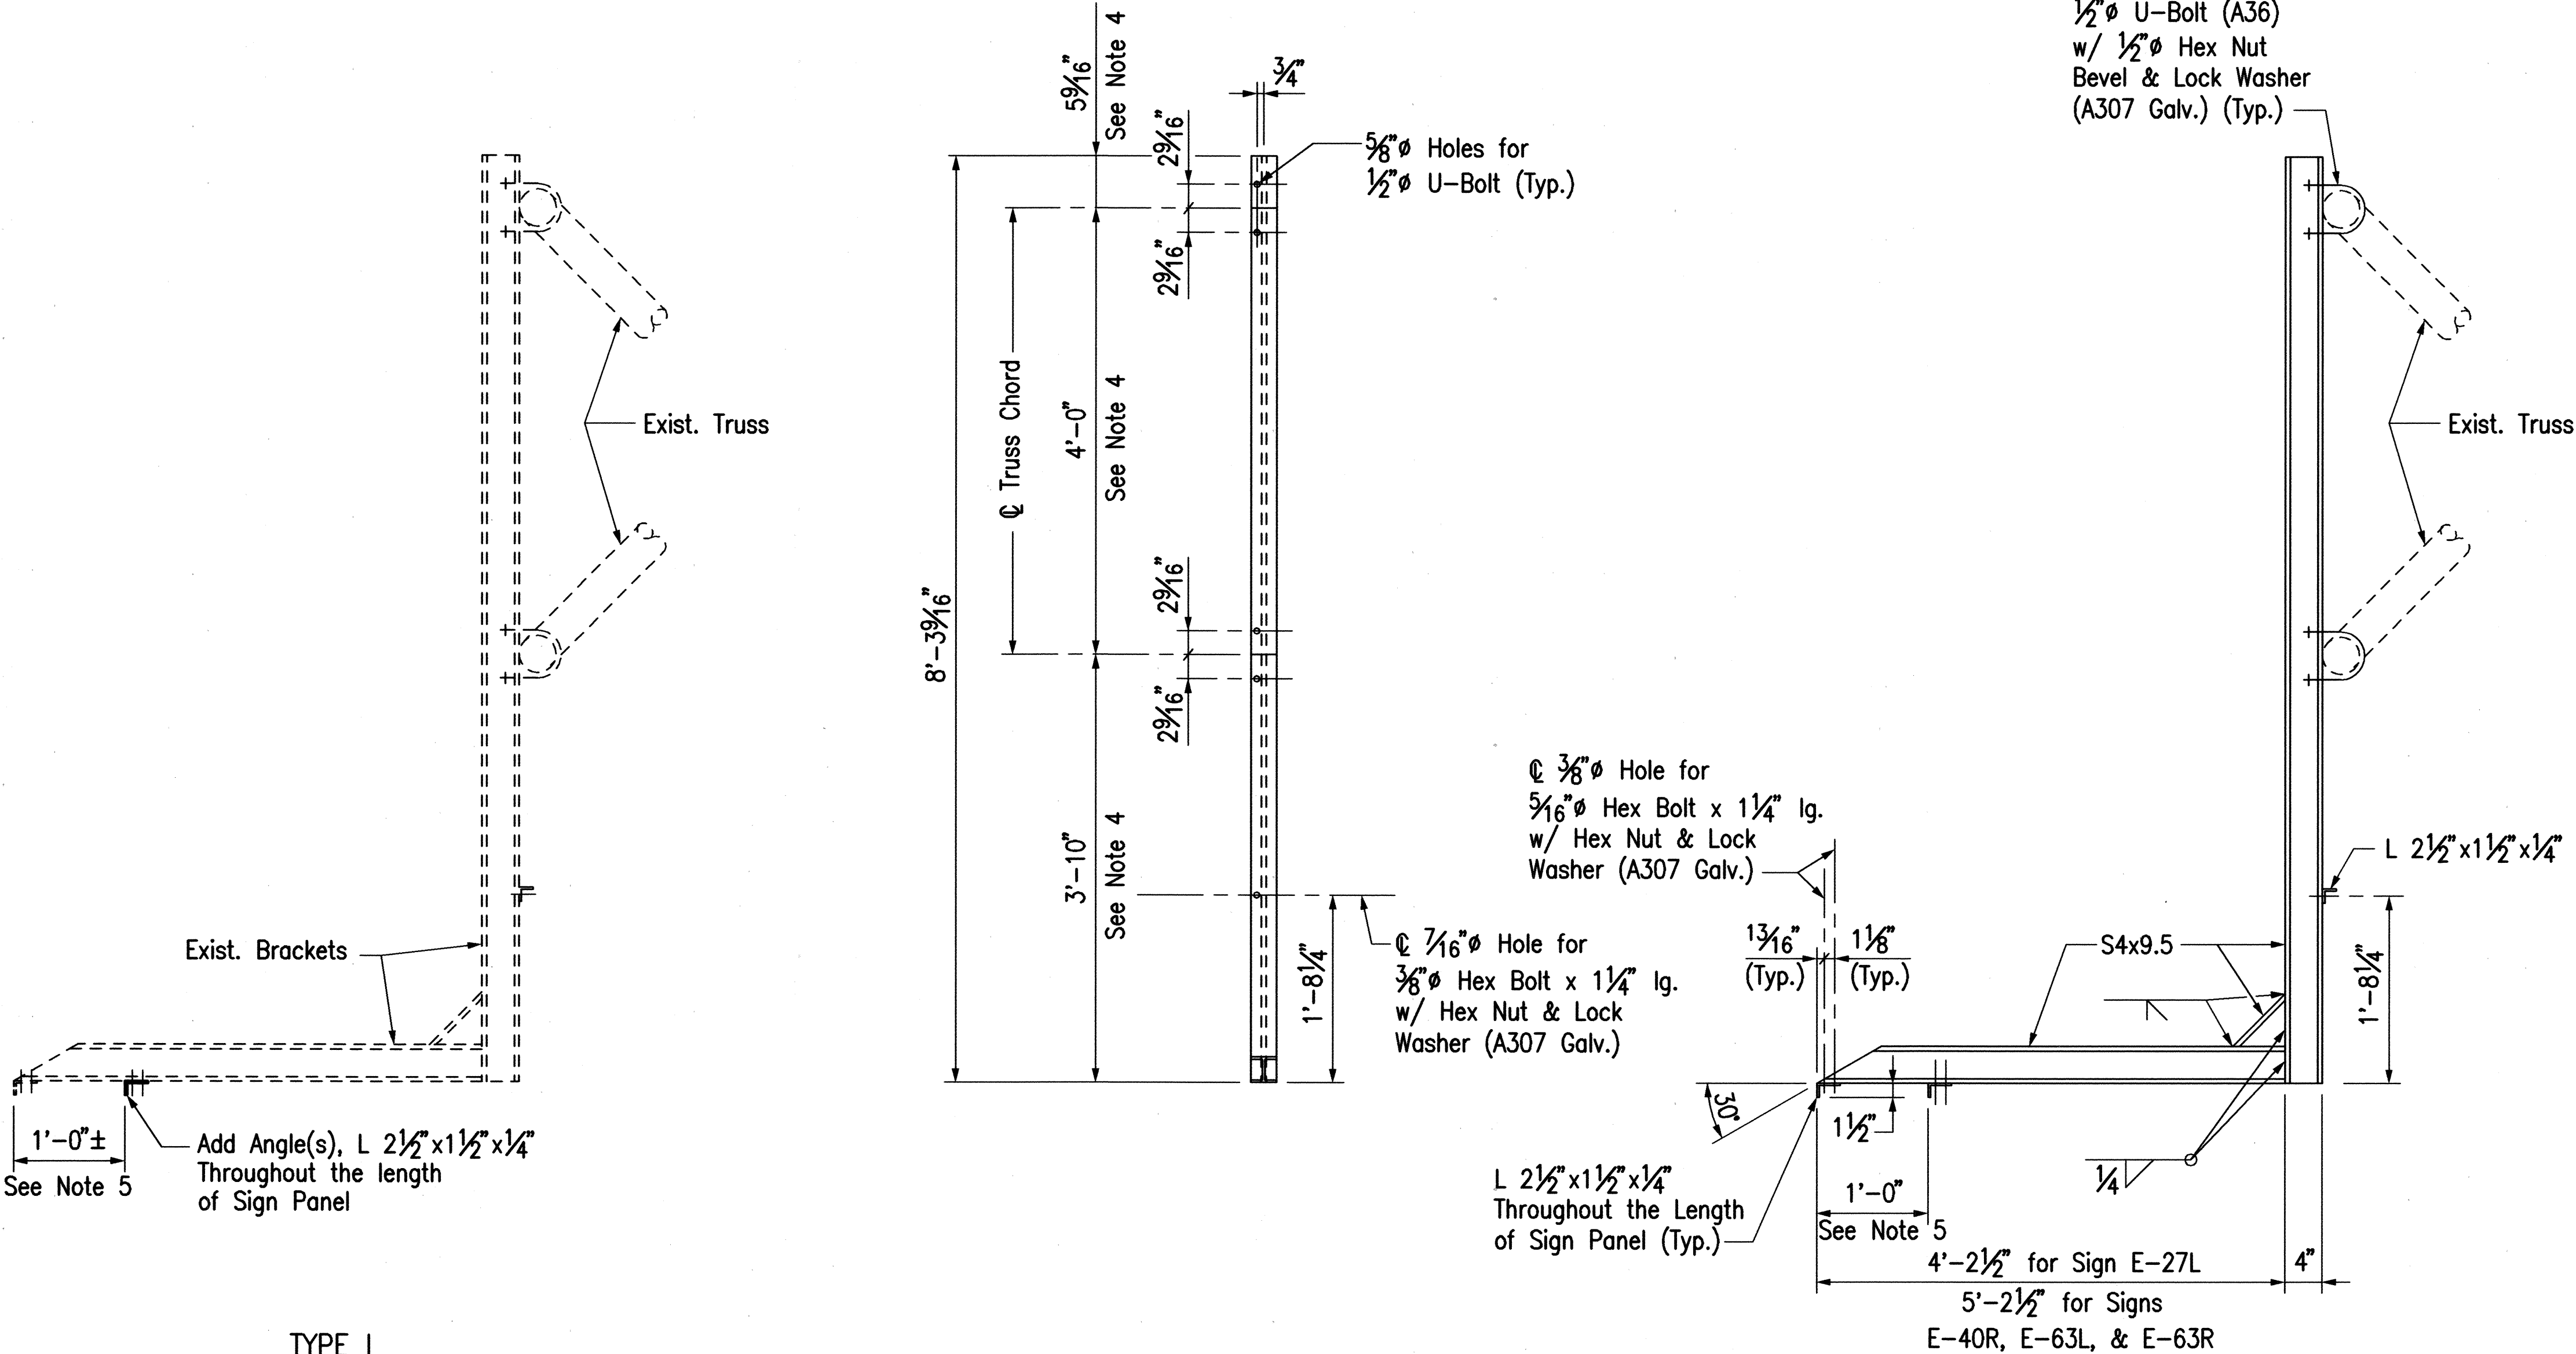


TYPE II

LUMINAIRE MOUNTING BRACKET MODIFICATION

1" = 1'-0"

NOTES:

- For Sign Panel Mounting Bracket Details, see Section C and Notes on Sht. No. C.O. ADD. 878.
- For location of signs E-62L, E-62R, E-63L, & E-63R, see Sht. No. 865.
- For sign assembly and bracket spacing, see Standard Plan TE-25.
- Dimensions to be verified and adjusted in field to match the existing brackets.
- Location of angle may be adjusted in field for luminaire mounting.
- All structural steel shall be ASTM A36, hot-dipped galvanized after fabrication.

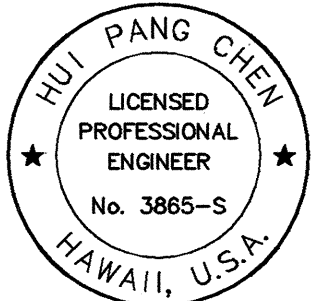

THIS WORK WAS PREPARED BY ME
OR UNDER MY SUPERVISION.

Hui Pang Chen


Date	Added Sheet	Revision
12/3/97		
STATE OF HAWAII DEPARTMENT OF TRANSPORTATION HIGHWAYS DIVISION DESTINATION SIGNS EXISTING SIGN STRUCTURES SIGN MOUNTING DETAILS-8 H-3 FINISH (UNIT II) FAIP NO. I-H3-1(75), UNIT II LEEWARD SECTION SCALE: AS SHOWN DATE: DECEMBER 1997 SHEET NO. 6V14A OF 14 SHEETS		

C.O. 884S-1


SURVEY PLOTTED BY	DATE
DRAWN BY	
NOTE BOOK	
QUANTITIES BY	
CHECKED BY	
No.	

CAD by D. Burgess, 55-52

FED. ROAD DIST. NO.	STATE	FED. AID PROJ. NO.	FISCAL YEAR	SHEET NO.	TOTAL SHEETS
HAWAII	HAW.	I-H3-1(75), UNIT II	1997	885	1102

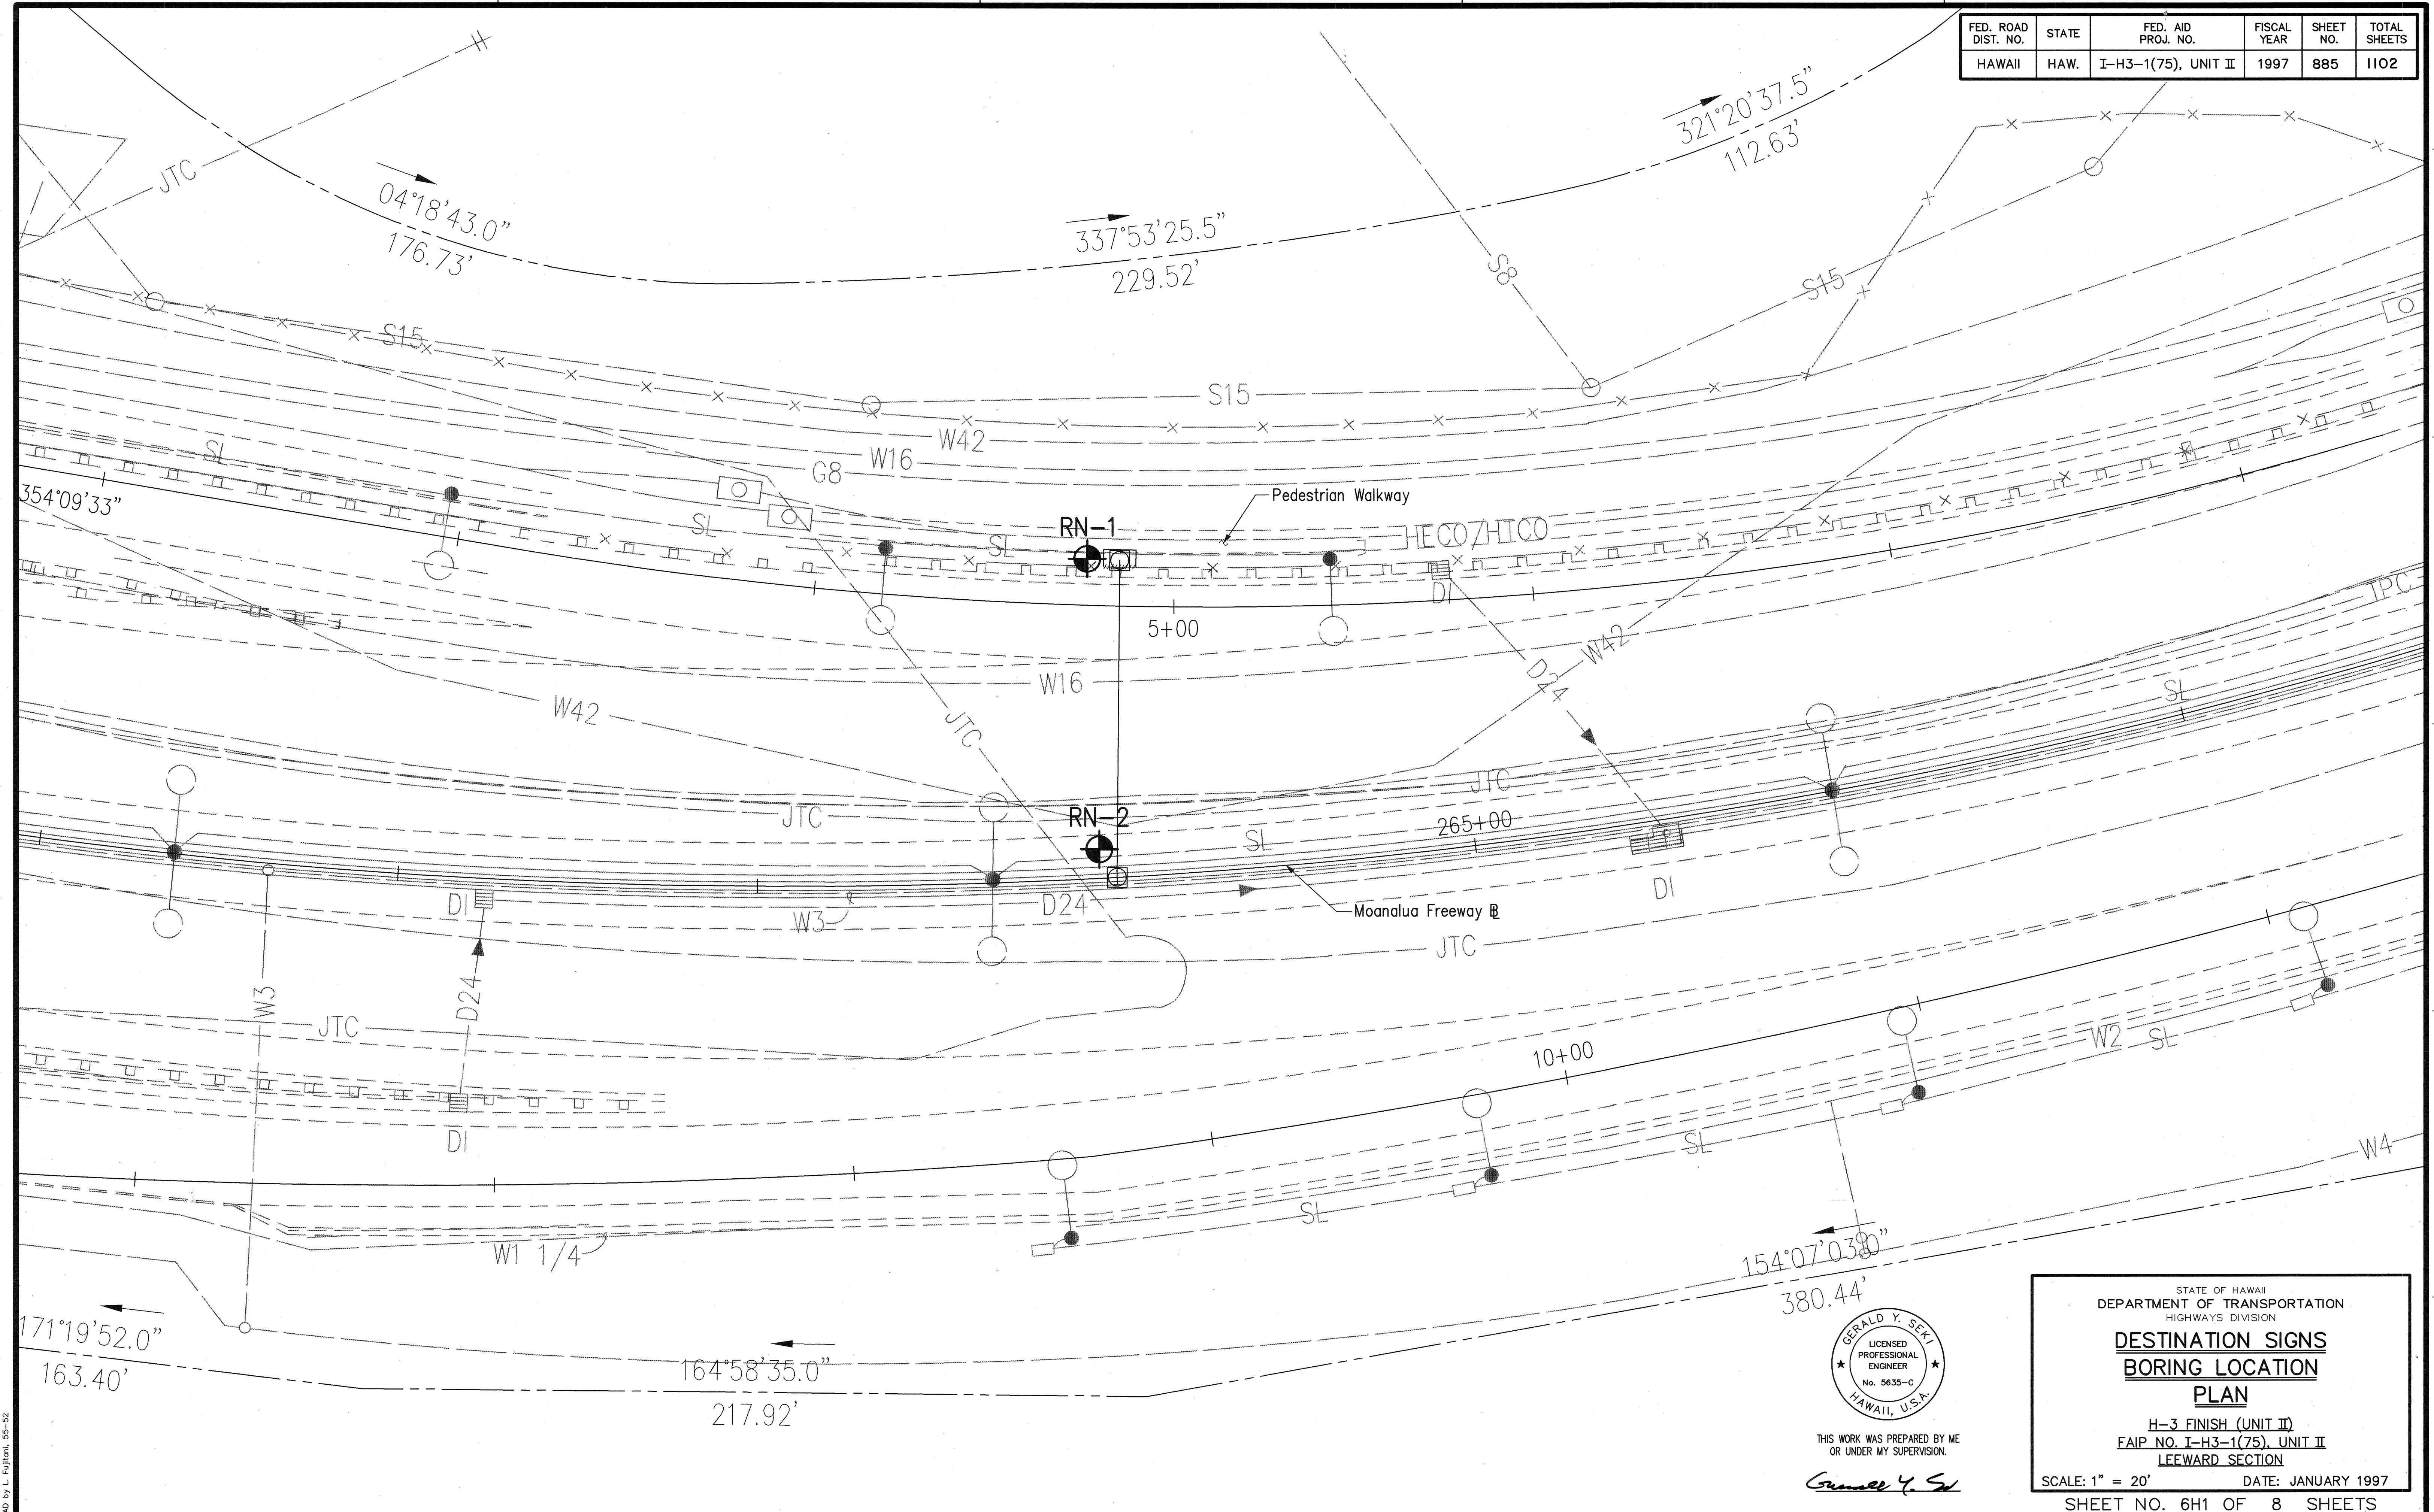

ORIGINAL PLAN	DATE
DESIGNED BY	DATE
CHECKED BY	DATE
NO.	

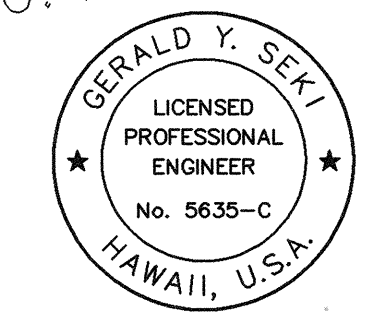


THIS WORK WAS PREPARED BY ME OR UNDER MY SUPERVISION.

Gerald Y. Seki

STATE OF HAWAII
DEPARTMENT OF TRANSPORTATION
HIGHWAYS DIVISION
**DESTINATION SIGNS
BORING LOCATION
PLAN**
H-3 FINISH (UNIT II)
FAIP NO. I-H3-1(75), UNIT II
LEEWARD SECTION
SCALE: 1" = 20'
DATE: JANUARY 1997
SHEET NO. 6H1 OF 8 SHEETS

885


FED. ROAD DIST. NO.	STATE	FED. AID PROJ. NO.	FISCAL YEAR	SHEET NO.	TOTAL SHEETS
HAWAII	HAW.	I-H3-1(75), UNIT II	1997	886	1102

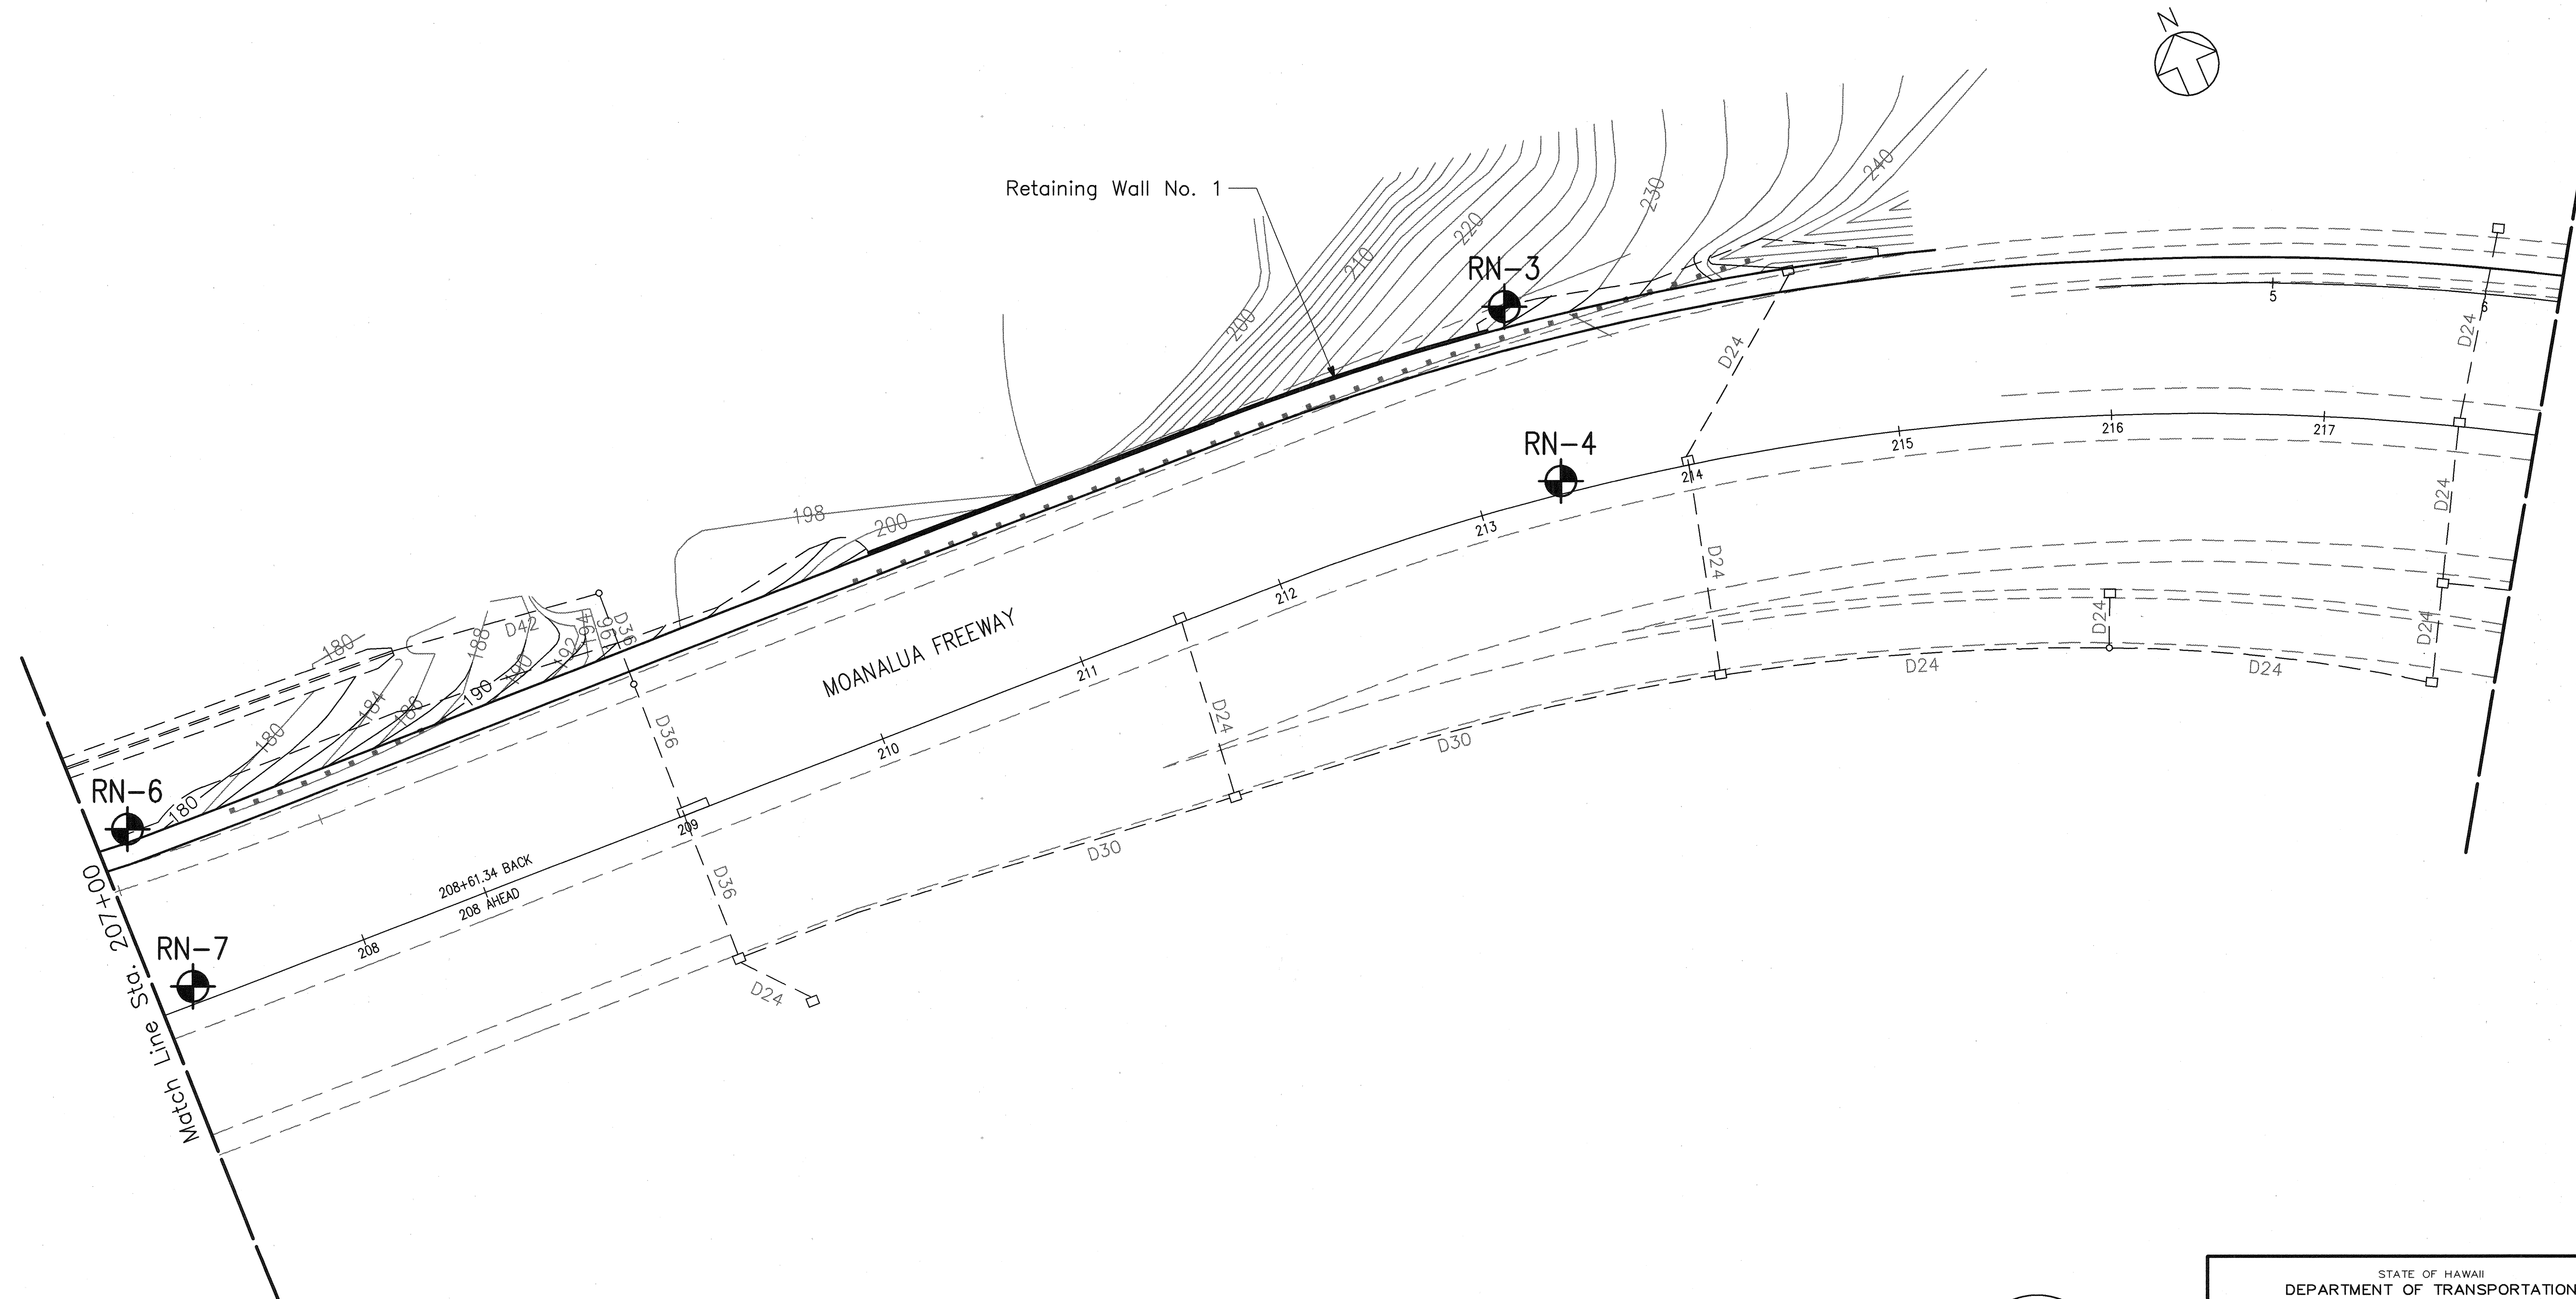

ORIGINAL PLAN	SURVEY PLOTTED BY	DATE
NOTE BOOK	DESIGNED BY	
	QUANTITIES BY	
	CHECKED BY	
No.		

CAD by L. Fujimori, 55-52

Last Saved: J:\H3RF\RFU2\DEOTECH\DRN04.dwg 01/28/97 at 13:52

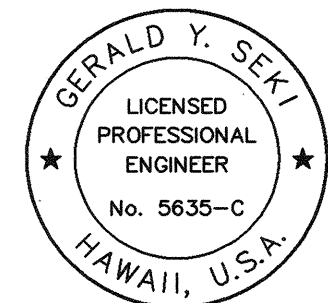


THIS WORK WAS PREPARED BY ME
OR UNDER MY SUPERVISION.


Gerald Y. Seki

STATE OF HAWAII
DEPARTMENT OF TRANSPORTATION
HIGHWAYS DIVISION
DESTINATION SIGNS
BORING LOCATION
PLAN
H-3 FINISH (UNIT II)
FAIP NO. I-H3-1(75), UNIT II
LEEWARD SECTION
SCALE: 1" = 40'
DATE: JANUARY 1997
SHEET NO. 6H2 OF 8 SHEETS

FED. ROAD DIST. NO.	STATE	FED. AID PROJ. NO.	FISCAL YEAR	SHEET NO.	TOTAL SHEETS
HAWAII	HAW.	I-H3-1(75), UNIT II	1997	887	1102

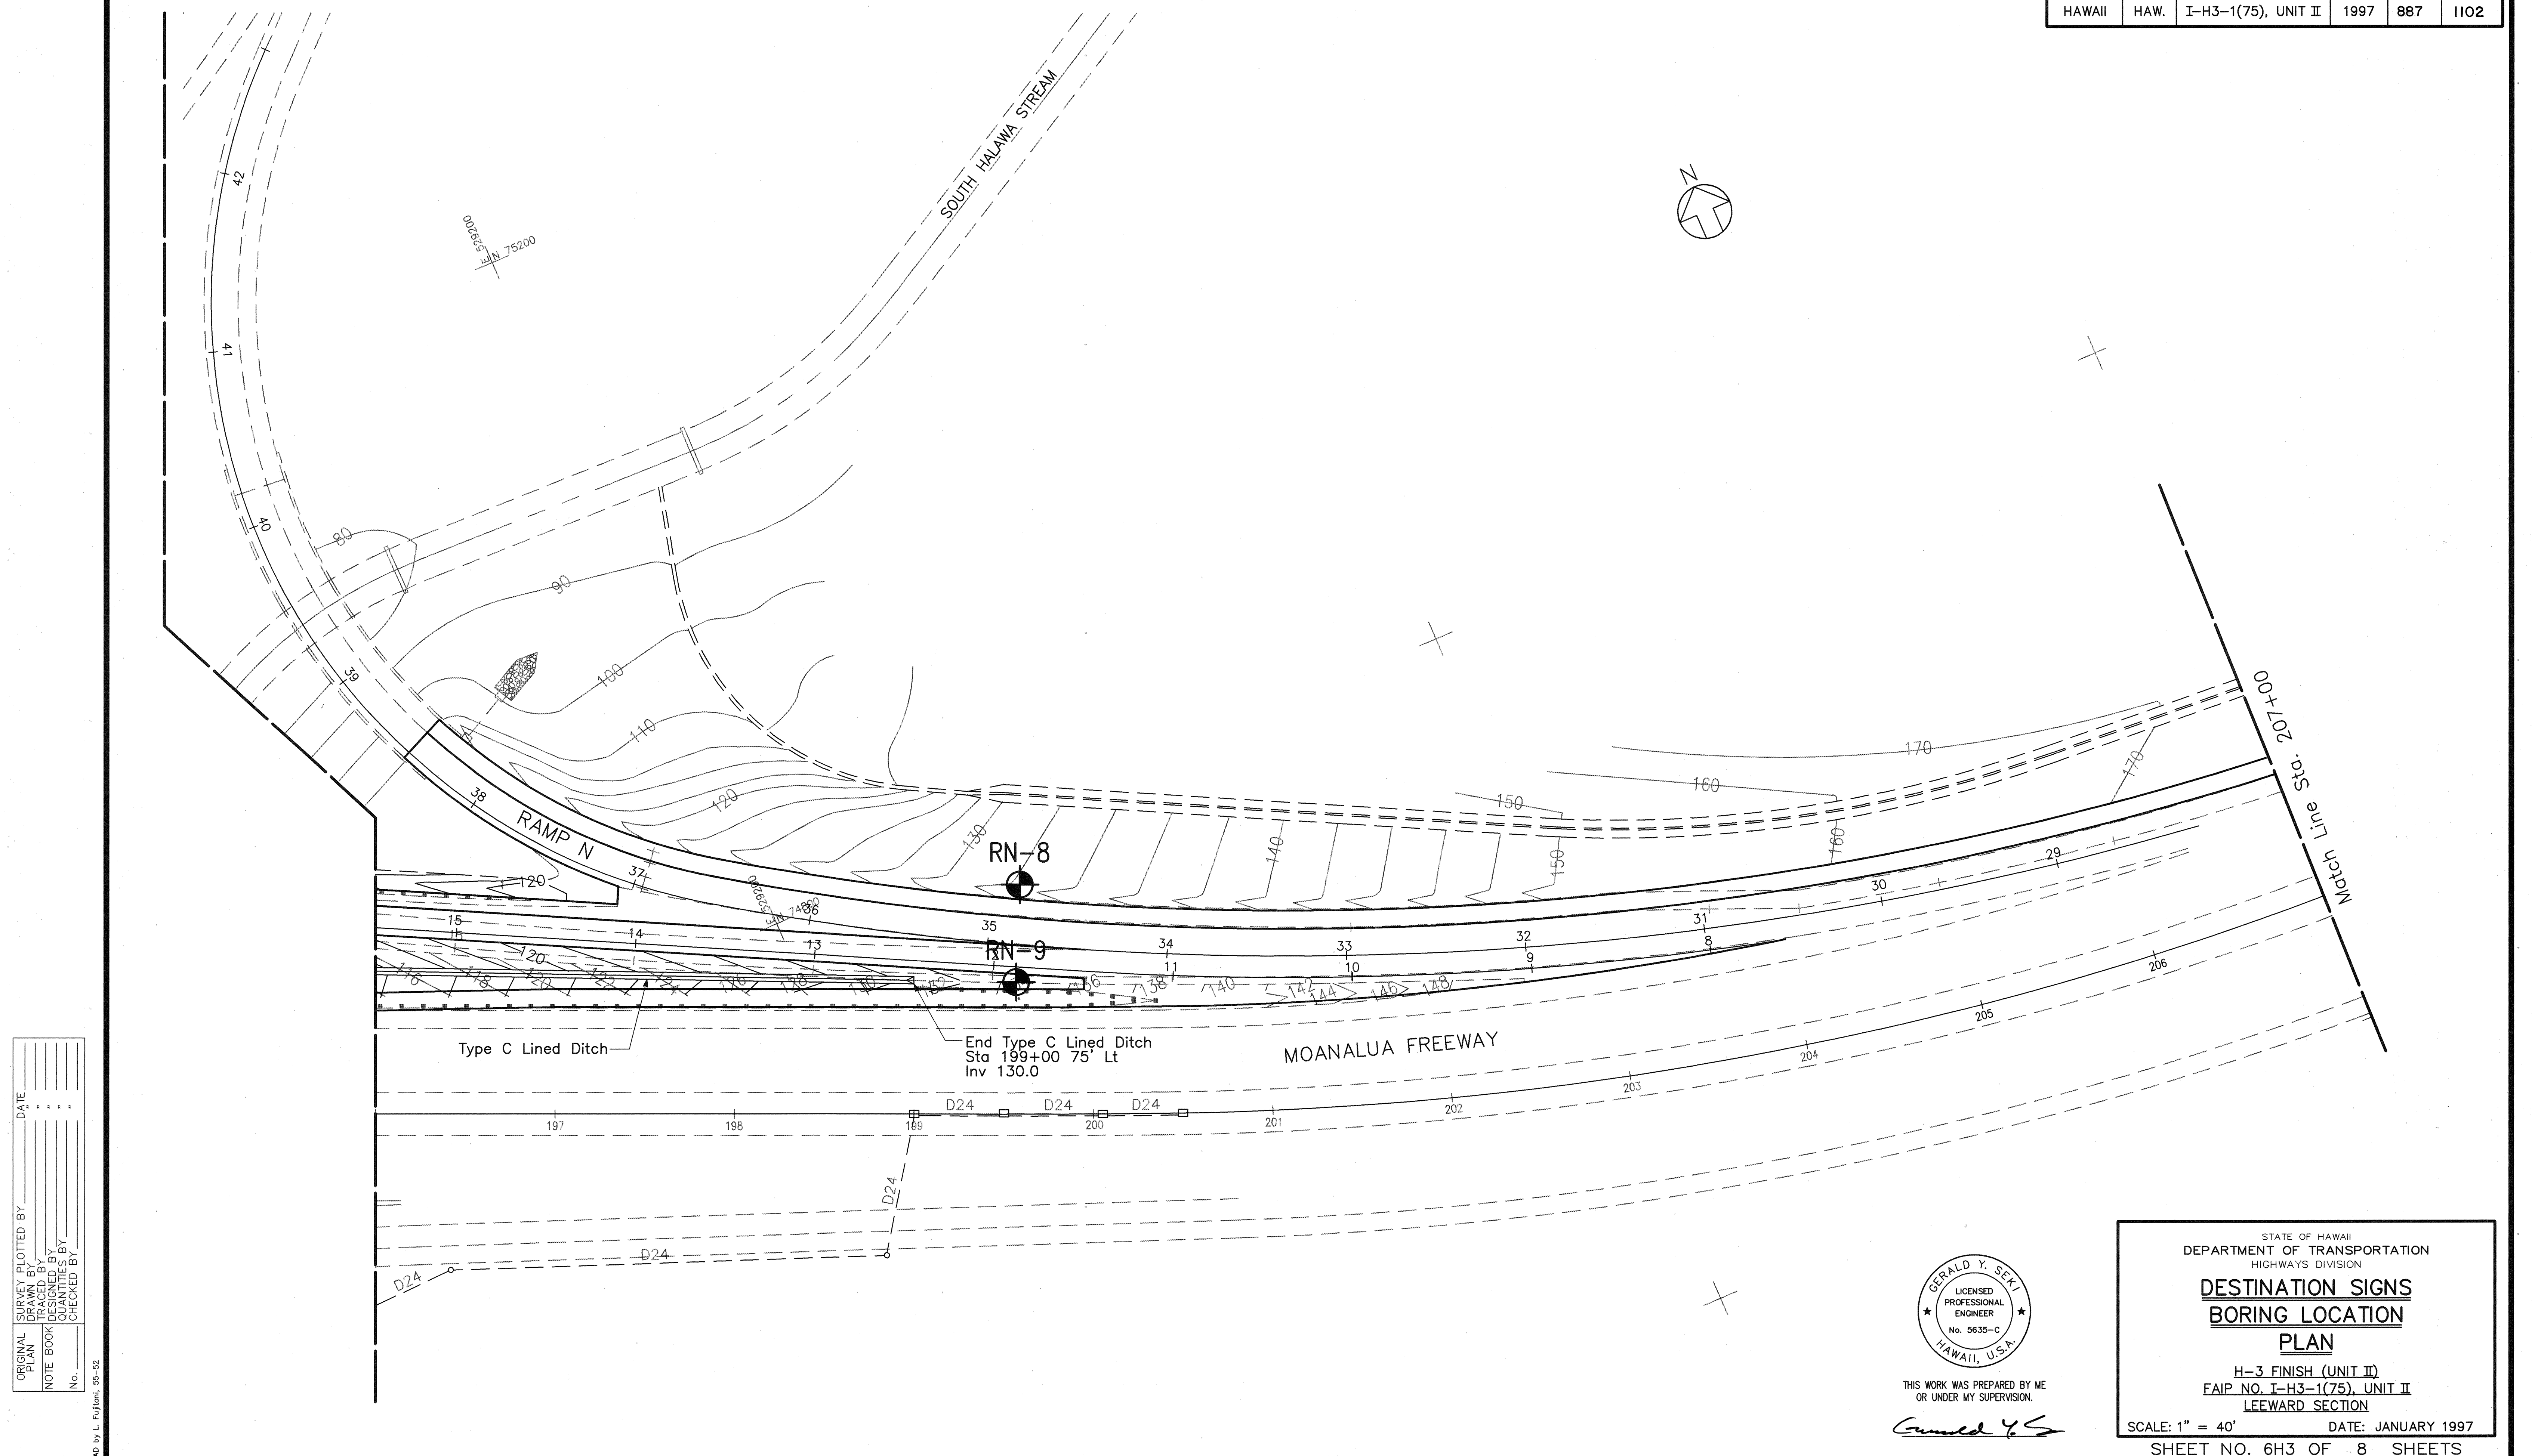

ORIGINAL PLAN	DATE
DESIGNED BY	DATE
CHECKED BY	DATE
NO.	

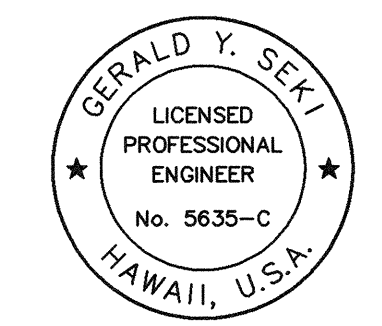


THIS WORK WAS PREPARED BY ME
OR UNDER MY SUPERVISION.

Gerald Y. Seki

STATE OF HAWAII
DEPARTMENT OF TRANSPORTATION
HIGHWAYS DIVISION
**DESTINATION SIGNS
BORING LOCATION
PLAN**
H-3 FINISH (UNIT II)
FAIP NO. I-H3-1(75), UNIT II
LEEWARD SECTION
SCALE: 1" = 40'
DATE: JANUARY 1997
SHEET NO. 6H3 OF 8 SHEETS

FED. ROAD DIST. NO.	STATE	FED. AID PROJ. NO.	FISCAL YEAR	SHEET NO.	TOTAL SHEETS
HAWAII	HAW.	I-H3-1(75), UNIT II	1997	888	1102

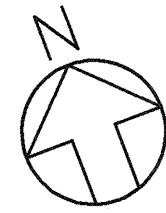

000825 LN 75600



000825 LN 75600

000825 LN 75600

000825 LN 75200

000825 LN 75200

ORIGINAL PLAN	SURVEY PLOTTED BY	DATE
NOTE BOOK	DRAWN BY	
	DESIGNED BY	
	QUANTITIES BY	
	CHECKED BY	
No.		

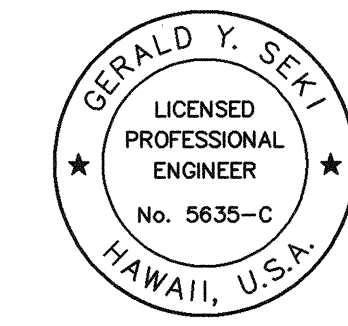
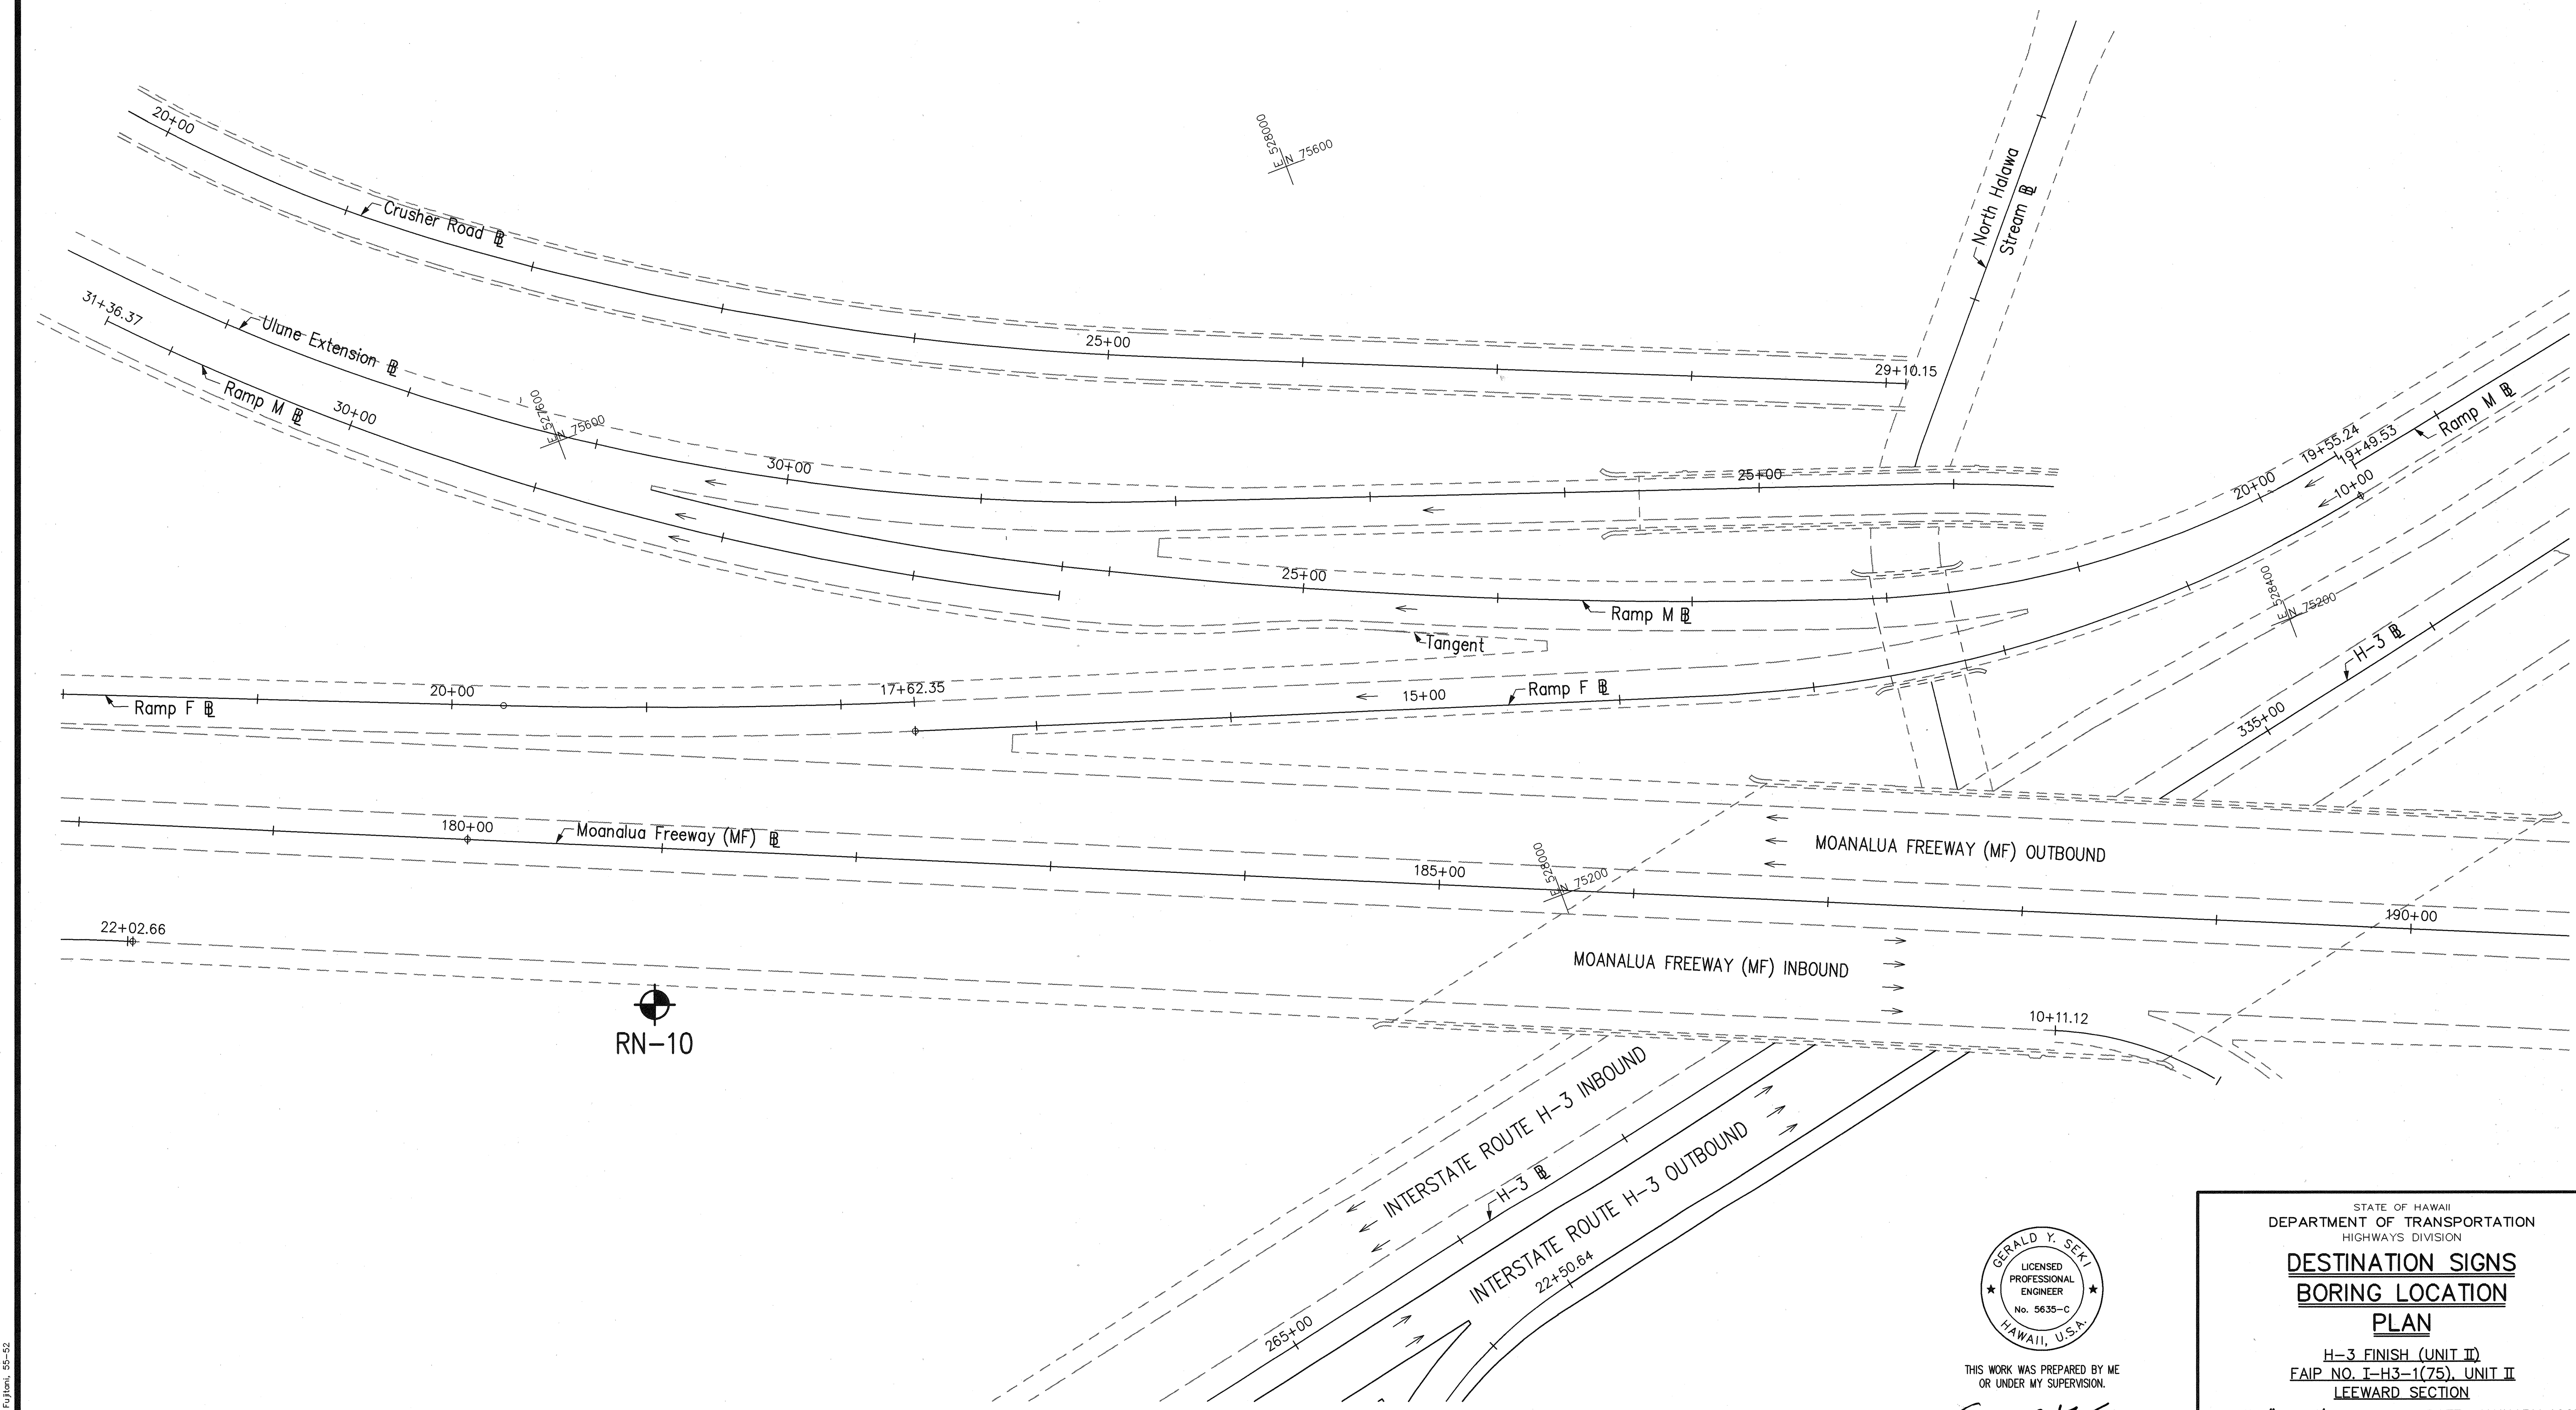


THIS WORK WAS PREPARED BY ME OR UNDER MY SUPERVISION.

Gerald Y. Seki

STATE OF HAWAII
DEPARTMENT OF TRANSPORTATION
HIGHWAYS DIVISION
DESTINATION SIGNS
BORING LOCATION
PLAN
H-3 FINISH (UNIT II)
FAIP NO. I-H3-1(75), UNIT II
LEEWARD SECTION
SCALE: 1" = 40'
DATE: JANUARY 1997
SHEET NO. 6H4 OF 8 SHEETS


FED. ROAD DIST. NO.	STATE	FED. AID PROJ. NO.	FISCAL YEAR	SHEET NO.	TOTAL SHEETS
HAWAII	HAW.	I-H3-1(75), UNIT II	1997	889	1102

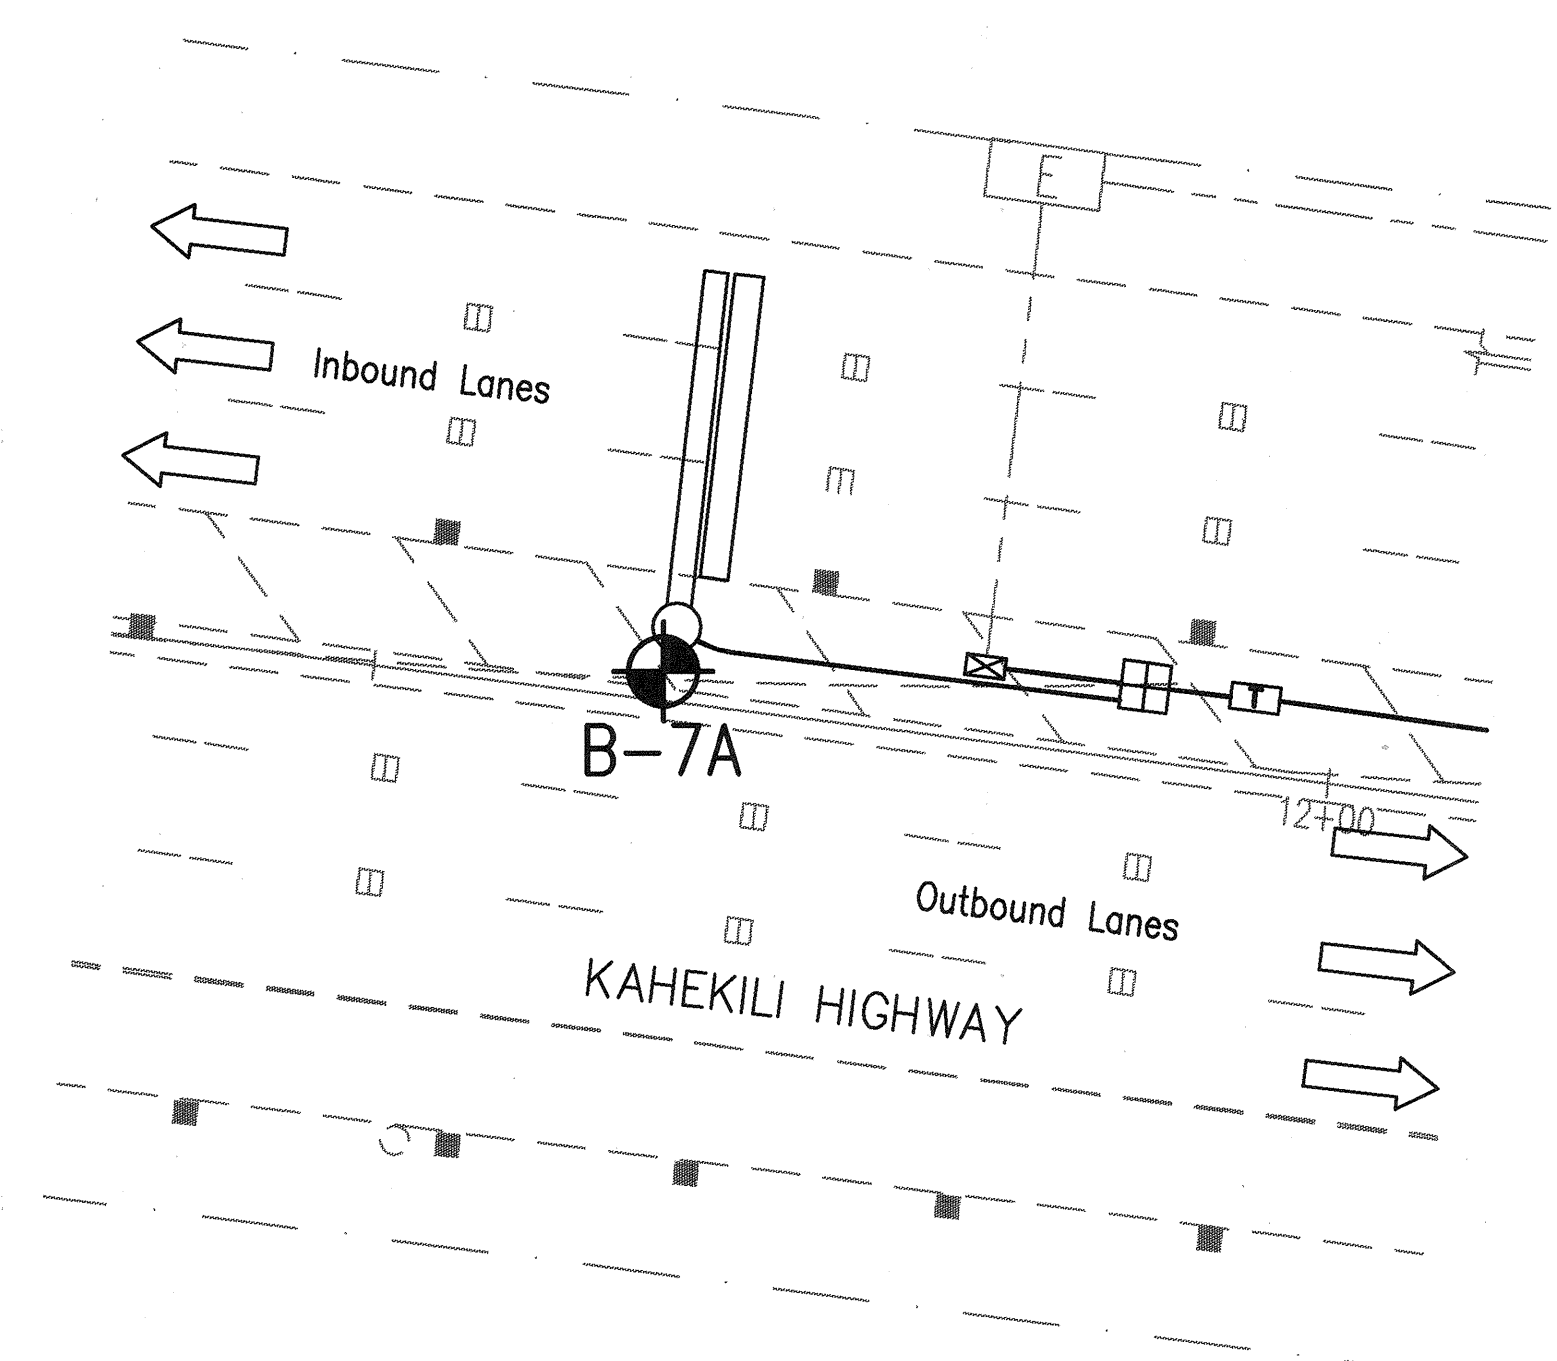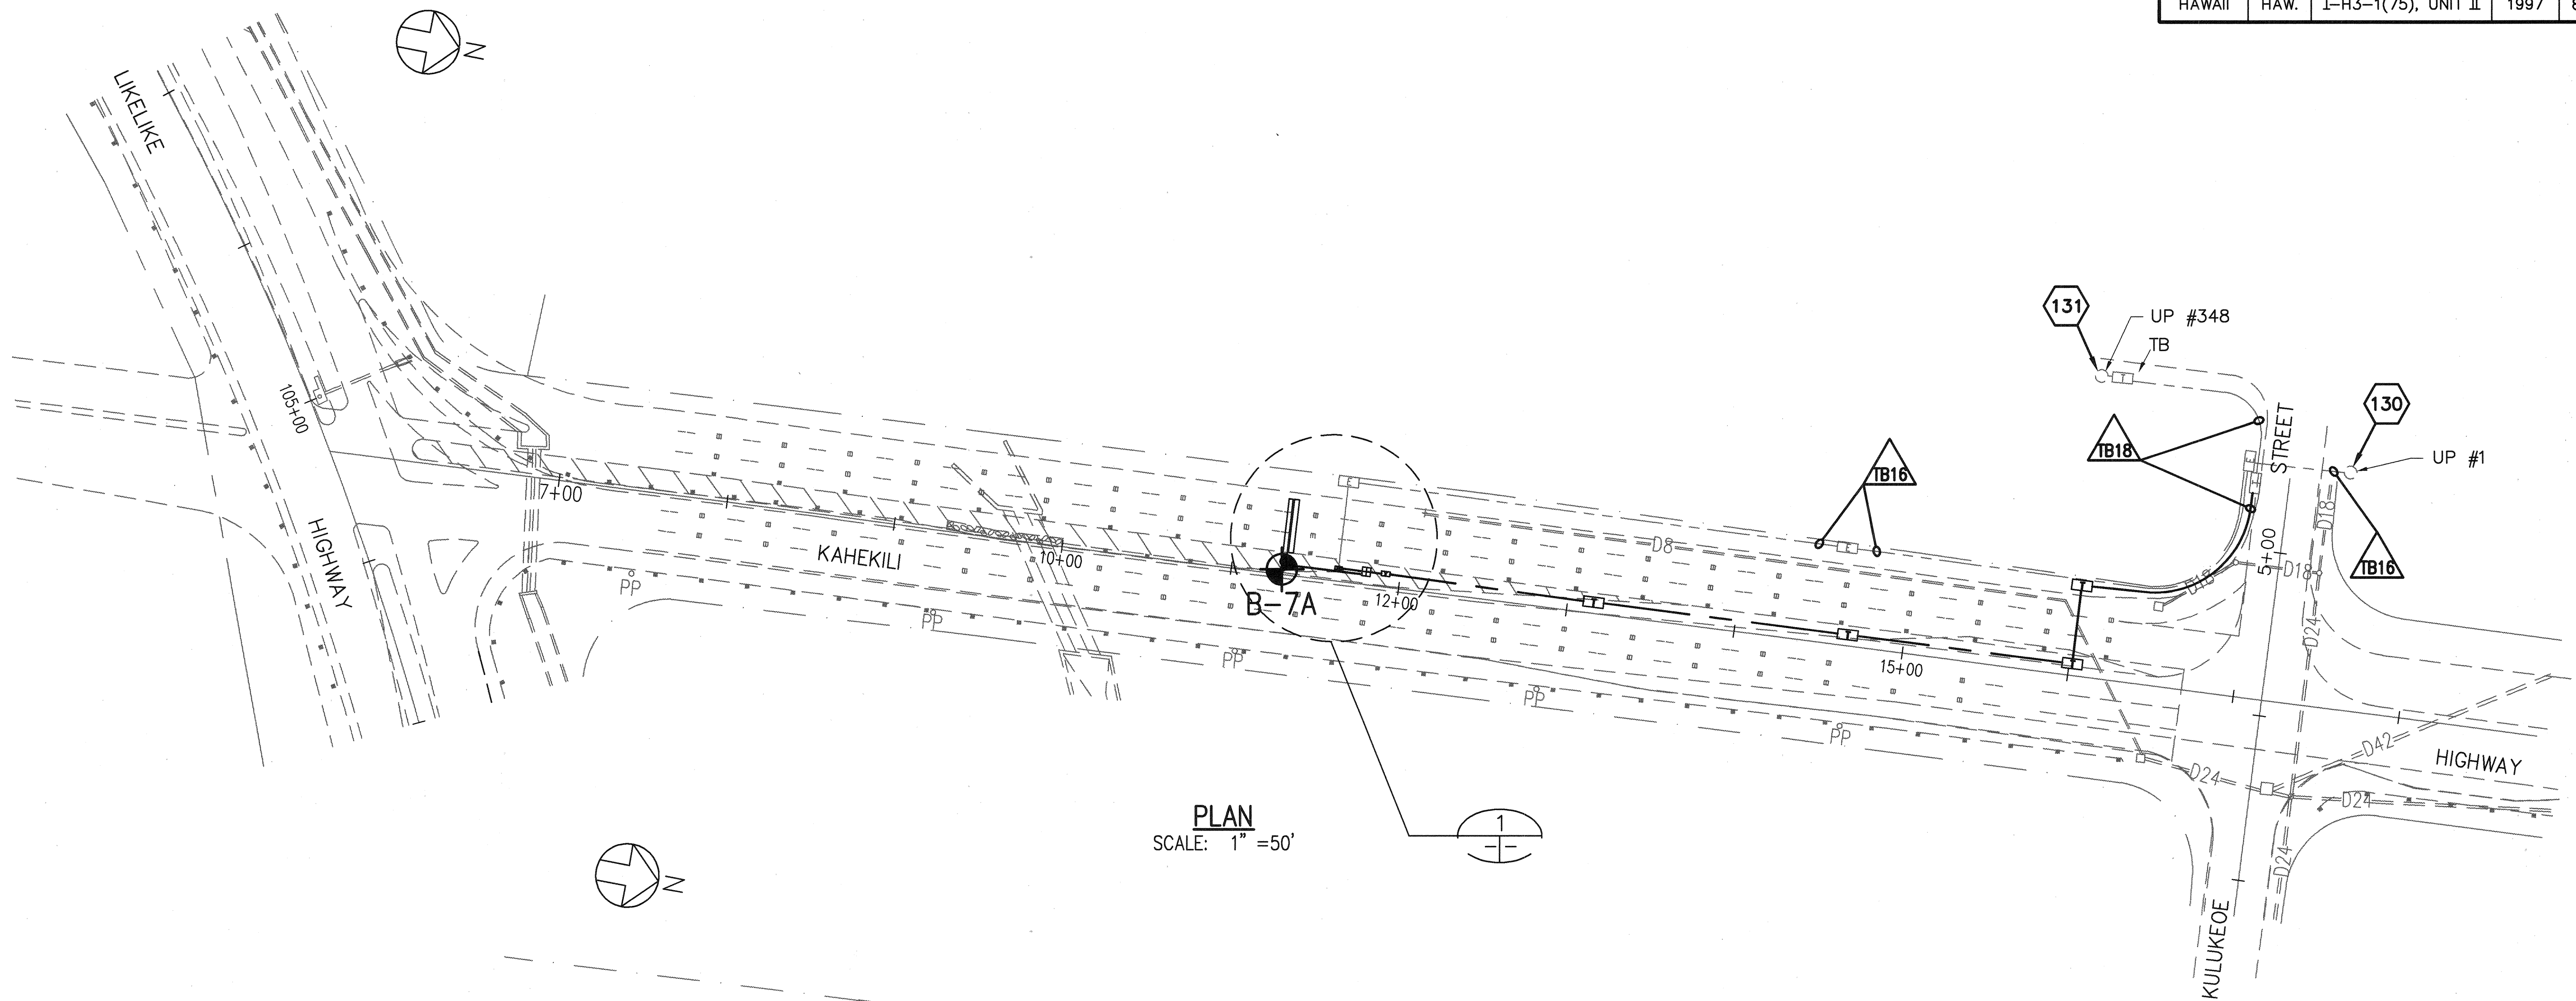

ORIGINAL PLAN	SURVEY PLOTTED BY	DATE
NOTE BOOK	DESIGNED BY	
	QUANTITIES BY	
	CHECKED BY	
No.		

CAD by L. Fujimori, 55-52

Last Saved: J:\H3RF\RFU2\SIGN\BORLOC.dwg 01/28/97 at 14:09

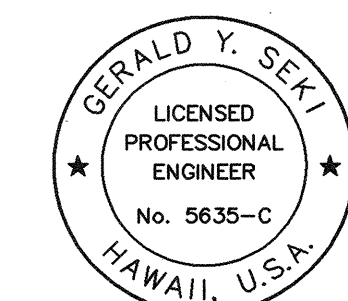

THIS WORK WAS PREPARED BY ME OR UNDER MY SUPERVISION.

Gerald Y. Seki

STATE OF HAWAII
DEPARTMENT OF TRANSPORTATION
HIGHWAYS DIVISION
DESTINATION SIGNS
BORING LOCATION
PLAN
H-3 FINISH (UNIT II)
FAIP NO. I-H3-1(75), UNIT II
LEEWARD SECTION
SCALE: AS SHOWN
DATE: JANUARY 1997
SHEET NO. 6H5 OF 8 SHEETS

FED. ROAD DIST. NO.	STATE	FED. AID PROJ. NO.	FISCAL YEAR	SHEET NO.	TOTAL SHEETS
HAWAII	HAW.	I-H3-1(75), UNIT II	1997	890	1102


LEGEND

UNIFIED SOIL CLASSIFICATION SYSTEM (USCS)

MAJOR DIVISIONS			TYPICAL NAMES	
COARSE-GRAINED SOILS	GRAVELS	CLEAN GRAVELS	GW	WELL GRADED GRAVELS, GRAVEL-SAND MIXTURES, LITTLE OR NO FINES
		LESS THAN 5% FINES	GP	POORLY GRADED GRAVELS, GRAVEL SAND MIXTURES, LITTLE OR NO FINES
		GRAVELS WITH FINES	GM	SILTY GRAVELS, POORLY GRADED GRAVEL-SAND-SILT MIXTURES
		MORE THAN 12% FINES	GC	CLAYEY GRAVELS, POORLY GRADED GRAVEL-SAND-CLAY MIXTURES
	SANDS	CLEAN SANDS	SW	WELL GRADED SANDS, GRAVELLY SANDS, LITTLE OR NO FINES
		LESS THAN 5% FINES	SP	POORLY GRADED SANDS, GRAVELLY SANDS, LITTLE OR NO FINES
		SANDS WITH FINES	SM	SILTY SANDS, POORLY GRADED SAND-SILT MIXTURES
		MORE THAN 12% FINES	SC	CLAYEY SANDS, POORLY GRADED SAND-CLAY MIXTURES
FINE-GRAINED SOILS	SILTS AND CLAYS	LIQUID LIMIT LESS THAN 50	ML	INORGANIC SILTS AND VERY FINE SANDS, ROCK FLOUR, SILTY OR CLAYEY FINE SANDS, WITH SLIGHT PLASTICITY
			CL	INORGANIC CLAYS OF LOW TO MEDIUM PLASTICITY, GRAVELLY CLAYS, SANDY CLAYS, SILTY CLAYS, LEAN CLAYS
			OL	ORGANIC SILTS AND ORGANIC SILT-CLAYS OF LOW PLASTICITY
	SILTS AND CLAYS	LIQUID LIMIT 50 OR MORE	MH	INORGANIC SILTS, MICACEOUS OR DIATOMACEOUS FINE SANDY OR SILTY SOILS, ELASTIC SILTS
			CH	INORGANIC CLAYS OF HIGH PLASTICITY, FAT CLAYS
			OH	ORGANIC CLAYS OF MEDIUM TO HIGH PLASTICITY
HIGHLY ORGANIC SOILS			Pt	PEAT AND OTHER HIGHLY ORGANIC SOILS

NOTE: DUAL SYMBOLS ARE USED TO INDICATE BORDERLINE SOIL CLASSIFICATIONS

2-INCH O.D. SPLIT-SPOON SAMPLE	WATER LEVEL	3-INCH O.D. THIN-WALL TUBE SAMPLE	2.5-INCH O.D. S-H SAMPLE
2.5-INCH OR 1.9-INCH O.D. CORE-BARREL SAMPLE			

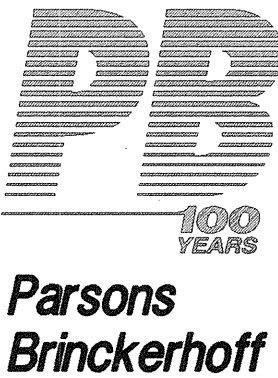

BORING LOG LEGEND

H-3 Finish Unit II
FAIP No. I-H3-1(75)

DATE: JAN. 1997

PROJECT NO. 3506V080

PLATE NO. A

DEFINITION OF TERMS

SOIL DESCRIPTION

Density of Consistency			
Granular Soil		Cohesive Soil	
Relative Density	Blow Count, N	Consistency	Blow Count, N
Very Loose	0-4	Very soft	0-2
Loose	4-10	Soft	2-4
Medium Density	10-30	Medium	4-8
Dense	30-50	Stiff	8-15
Very Dense	50 or more	Very Stiff	15-30
		Hard	30 or more

ROCK DESCRIPTION

WEATHERING


Unweathered	No visible sign of rock material weathering, perhaps slight discoloration on major discontinuity surfaces
Slightly weathered	Discoloration indicates weathering of rock material and discontinuity surfaces. All the rock material may be discolored by weathering and may be somewhat weaker externally than in its fresh condition.
Moderately weathered	Less than half of the rock material is decomposed and/or disintegrated to a soil. Fresh or discolored rock is present either as a continuous framework or as corestones.
Highly weathered	More than half of the rock material is decomposed and/or disintegrated to a soil. Fresh or discolored rock is present either as a discontinuous framework or as corestones.

CONTINUITY

Term	Length of Drill Core Stem Pieces
Sound	>8"
Slightly Fractured	4"-8"
Moderately Fractured	1"-4"
Closely Fractured	<1"

HARDNESS

Weak	Can be peeled by a pocket knife, shallow indentations made or crumbles by firm blow with point of geological hammer
Medium Strong	Cannot be scraped or peeled with a pocket knife, specimen can be fractured with single firm blow or geological hammer
Strong	Specimen requires more than one blow of geological hammer to fracture it

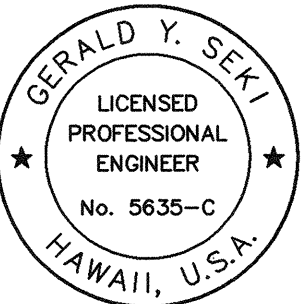

THIS WORK WAS PREPARED BY ME
OR UNDER MY SUPERVISION.

Gerald Y. Seki

STATE OF HAWAII
DEPARTMENT OF TRANSPORTATION
HIGHWAYS DIVISION

DESTINATION SIGNS
BORING LOG LEGEND

H-3 FINISH (UNIT II)
FAIP NO. I-H3-1(75), UNIT II
LEEWARD SECTION

SCALE: NONE DATE: JANUARY 1997
SHEET NO. 6H6 OF 8 SHEETS

FED. ROAD DIST. NO.	STATE	FED. AID PROJ. NO.	FISCAL YEAR	SHEET NO.	TOTAL SHEETS
HAWAII	HAW.	I-H3-1(75), UNIT II	1997	891	1102

 Parsons Brinckerhoff	H-3 Finish Unit II FAIP No. I-H3-1(75) Oahu, Hawaii	BORING NO. RN- 1
OTHER LAB TESTS DRY UNIT WEIGHT (pcf) MOISTURE CONTENT (%) CORE RECOVERY (%) R.O.D. (%) NUMBER OF BLOWS/FT SAMPLE TYPE AND NUMBER DEPTH IN FEET GRAPHIC SYMBOL U.S.C.S.	GEOTECHNICAL DESCRIPTION Mottled brown clayey GRAVEL with sand, dense, dry (Fill) Mottled brown and gray clayey SAND with gravel, dense, moist (Fill) Reddish brown silty CLAY with some gravel and cobbles, hard, moist (Fill) Reddish brown clayey SILT with sand and gravel, hard, moist (Residual) Reddish brown clayey SILT with sand and gravel, hard, moist (Residual) Dark brown silty CLAY with fine sand, hard, moist (Residual) End boring at 31.0 ft. on 9/8/95 Groundwater not encountered.	
SAMPLE TYPE CB - Core Barrel DN - Denison Barrel SB - Split Barrel (2.5") SP - Standard Penetration ST - Thin-Wall Tube SH - S & H Barrel (2.5") CN - Consolidation DS - Direct Shear PI - Atterberg Limits SA - Sieve Analysis TX - Triaxial Compression UC - Unconfined Compression		
BORING LOCATION: Sta.264+48, o/s 89'L GROUND SURFACE ELEVATION: + 85 ft. DATE(S) DRILLED: 9/7/95 to 9/8/95 DRILLER: HGG LOGGED BY: BC,FB TYPE RIG: CME 55 PROJECT NO. 3506V080 PLATE NO. A- 1		

 Parsons Brinckerhoff	H-3 Finish Unit II FAIP No. I-H3-1(75) Oahu, Hawaii	BORING NO. RN- 2
OTHER LAB TESTS DRY UNIT WEIGHT (pcf) MOISTURE CONTENT (%) CORE RECOVERY (%) R.O.D. (%) NUMBER OF BLOWS/FT SAMPLE TYPE AND NUMBER DEPTH IN FEET GRAPHIC SYMBOL U.S.C.S.	GEOTECHNICAL DESCRIPTION 2.5" AC Gray brown silty GRAVEL with sand, very dense, damp (Base Course) Grayish brown clayey SAND with gravel, dense, dry (Fill) Grades to very dense Grayish brown clayey SAND with gravel, loose, wet (Fill) Dark brown silty CLAY with cobble and traces of mudrock fragments, medium, moist Grades to very stiff Dark brown clayey SAND with mudrock fragments, very dense, moist End boring at 31.5 ft. on 9/11/95 Groundwater not encountered.	
SAMPLE TYPE CB - Core Barrel DN - Denison Barrel SB - Split Barrel (2.5") SP - Standard Penetration ST - Thin-Wall Tube SH - S & H Barrel (2.5") CN - Consolidation DS - Direct Shear PI - Atterberg Limits SA - Sieve Analysis TX - Triaxial Compression UC - Unconfined Compression		
BORING LOCATION: Sta.264+48, o/s 8'L GROUND SURFACE ELEVATION: + 91 ft. DATE(S) DRILLED: 9/11/95 to 9/11/95 DRILLER: HGG LOGGED BY: BC,EH,FB TYPE RIG: CME 55 PROJECT NO. 3506V080 PLATE NO. A- 2		


 Parsons Brinckerhoff	H-3 Finish Unit II FAIP No. I-H3-1(75) Oahu, Hawaii	BORING NO. RN- 3
OTHER LAB TESTS DRY UNIT WEIGHT (pcf) MOISTURE CONTENT (%) CORE RECOVERY (%) R.O.D. (%) NUMBER OF BLOWS/FT SAMPLE TYPE AND NUMBER DEPTH IN FEET GRAPHIC SYMBOL U.S.C.S.	GEOTECHNICAL DESCRIPTION Grayish brown clayey SAND with gravel, dense, damp (Fill) Reddish brown clayey SILT with sand and gravel, very stiff to hard, damp (Fill) Reddish brown silty CLAY, hard, moist (Residual) Gray BASALT, slightly weathered, moderately fractured, strong End boring at 30.0 ft. on 9/19/95 Groundwater not encountered.	
SAMPLE TYPE CB - Core Barrel DN - Denison Barrel SB - Split Barrel (2.5") SP - Standard Penetration ST - Thin-Wall Tube SH - S & H Barrel (2.5") CN - Consolidation DS - Direct Shear PI - Atterberg Limits SA - Sieve Analysis TX - Triaxial Compression UC - Unconfined Compression		
BORING LOCATION: Sta.213+40, o/s 85'L GROUND SURFACE ELEVATION: + 230 ft. DATE(S) DRILLED: 9/18/95 to 9/19/95 DRILLER: HGG LOGGED BY: BC,EH,FB TYPE RIG: Deltrich D-25 PROJECT NO. 3506V080 PLATE NO. A- 3		

 Parsons Brinckerhoff	H-3 Finish Unit II FAIP No. I-H3-1(75) Oahu, Hawaii	BORING NO. RN- 4
OTHER LAB TESTS DRY UNIT WEIGHT (pcf) MOISTURE CONTENT (%) CORE RECOVERY (%) R.O.D. (%) NUMBER OF BLOWS/FT SAMPLE TYPE AND NUMBER DEPTH IN FEET GRAPHIC SYMBOL U.S.C.S.	GEOTECHNICAL DESCRIPTION 2.5" AC Gray and brown silty GRAVEL with sand, dense, damp (Base Course) Mottled gray brown clayey SILT, hard, moist (Residual) Grades to mottled brown Gray clayey SILT, hard, moist (Saprolite) Gray BASALT, slightly weathered, closely to moderately fractured, strong Reddish brown CLINKER End boring at 30.2 ft. on 9/12/95	
SAMPLE TYPE CB - Core Barrel DN - Denison Barrel SB - Split Barrel (2.5") SP - Standard Penetration ST - Thin-Wall Tube SH - S & H Barrel (2.5") CN - Consolidation DS - Direct Shear PI - Atterberg Limits SA - Sieve Analysis TX - Triaxial Compression UC - Unconfined Compression		
BORING LOCATION: Sta.213+40, o/s 6'L GROUND SURFACE ELEVATION: + 227 ft. DATE(S) DRILLED: 9/12/95 to 9/12/95 DRILLER: HGG LOGGED BY: BC,EH,FB TYPE RIG: CME 55 PROJECT NO. 3506V080 PLATE NO. A- 4		

 Parsons Brinckerhoff	H-3 Finish Unit II FAIP No. I-H3-1(75) Oahu, Hawaii	BORING NO. RN- 6
OTHER LAB TESTS DRY UNIT WEIGHT (pcf) MOISTURE CONTENT (%) CORE RECOVERY (%) R.O.D. (%) NUMBER OF BLOWS/FT SAMPLE TYPE AND NUMBER DEPTH IN FEET GRAPHIC SYMBOL U.S.C.S.	GEOTECHNICAL DESCRIPTION Brown clayey SILT with traces of sand and gravel, hard, damp (Fill) Mottled brown clayey SILT with sand, hard, moist (Residual) Mottled gray clayey SILT, hard, moist (Residual) Gray clayey SILT, stiff, moist (Saprolite) Gray BASALT, slightly weathered, moderately fractured, strong End boring at 30.0 ft. on 9/5/95 Groundwater not encountered.	
SAMPLE TYPE CB - Core Barrel DN - Denison Barrel SB - Split Barrel (2.5") SP - Standard Penetration ST - Thin-Wall Tube SH - S & H Barrel (2.5") CN - Consolidation DS - Direct Shear PI - Atterberg Limits SA - Sieve Analysis TX - Triaxial Compression UC - Unconfined Compression		
BORING LOCATION: Sta.206+55, o/s 88'L GROUND SURFACE ELEVATION: + 180 ft. DATE(S) DRILLED: 9/5/95 to 9/5/95 DRILLER: HGG LOGGED BY: BC,EH,FB TYPE RIG: CME 55 PROJECT NO. 3506V080 PLATE NO. A- 6		

 Parsons Brinckerhoff	H-3 Finish Unit II FAIP No. I-H3-1(75) Oahu, Hawaii	BORING NO. RN- 7
OTHER LAB TESTS DRY UNIT WEIGHT (pcf) MOISTURE CONTENT (%) CORE RECOVERY (%) R.O.D. (%) NUMBER OF BLOWS/FT SAMPLE TYPE AND NUMBER DEPTH IN FEET GRAPHIC SYMBOL U.S.C.S.	GEOTECHNICAL DESCRIPTION 2" AC Gray silty GRAVEL with sand, dense, damp (Base Course) Reddish brown clayey SILT, very stiff, moist (Fill) Reddish brown clayey SILT with sand and gravel, stiff, moist (Fill) Brown and gray clayey SILT, very stiff, moist (Residual) Brown gray clayey SILT and GRAVEL, hard, moist (Saprolite) Gray BASALT fragments, dense End boring at 30.4 ft. on 9/13/95 Groundwater not encountered.	
SAMPLE TYPE CB - Core Barrel DN - Denison Barrel SB - Split Barrel (2.5") SP - Standard Penetration ST - Thin-Wall Tube SH - S & H Barrel (2.5") CN - Consolidation DS - Direct Shear PI - Atterberg Limits SA - Sieve Analysis TX - Triaxial Compression UC - Unconfined Compression		
BORING LOCATION: Sta.206+55, o/s 6'L GROUND SURFACE ELEVATION: + 180 ft. DATE(S) DRILLED: 9/13/95 to 9/13/95 DRILLER: HGG LOGGED BY: BC,EH,FB TYPE RIG: CME 55 PROJECT NO. 3506V080 PLATE NO. A- 7		

 Parsons Brinckerhoff	H-3 Finish Unit II FAIP No. I-H3-1(75) Oahu, Hawaii	BORING NO. RN- 8
OTHER LAB TESTS DRY UNIT WEIGHT (pcf) MOISTURE CONTENT (%) CORE RECOVERY (%) R.O.D. (%) NUMBER OF BLOWS/FT SAMPLE TYPE AND NUMBER DEPTH IN FEET GRAPHIC SYMBOL U.S.C.S.	GEOTECHNICAL DESCRIPTION Brown clayey SILT with sand and gravel, stiff to very stiff, damp (Fill) Brown clayey SILT with gravel, stiff, moist (Residual) Mottled brown clayey SILT, hard, moist (Residual) Brown clayey SILT, stiff, moist (Residual) Grades to hard Gray brown silty SAND with gravel, dense, moist (Saprolite) End boring at 31.5 ft. on 9/6/95 Groundwater not encountered.	
SAMPLE TYPE CB - Core Barrel DN - Denison Barrel SB - Split Barrel (2.5") SP - Standard Penetration ST - Thin-Wall Tube SH - S & H Barrel (2.5") CN - Consolidation DS - Direct Shear PI - Atterberg Limits SA - Sieve Analysis TX - Triaxial Compression UC - Unconfined Compression		
BORING LOCATION: Sta.34+85, o/s 32'R GROUND SURFACE ELEVATION: + 132 ft. DATE(S) DRILLED: 9/6/95 to 9/6/95 DRILLER: HGG LOGGED BY: BC,EH,FB TYPE RIG: CME 55 PROJECT NO. 3506V080 PLATE NO. A- 8		

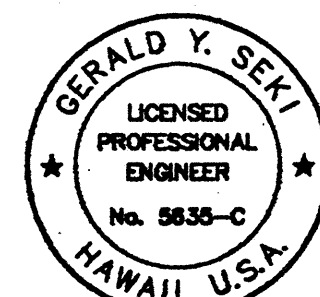

THIS WORK WAS PREPARED BY ME OR UNDER MY SUPERVISION.

Gerald Y. Seki

STATE OF HAWAII DEPARTMENT OF TRANSPORTATION HIGHWAYS DIVISION	
DESTINATION SIGNS BORING LOGS	
H-3 FINISH (UNIT II) FAIP NO. I-H3-1(75), UNIT II LEEWARD SECTION	
SCALE: NONE	DATE: JANUARY 1997
SHEET NO. 6H7 OF 8 SHEETS	

FED. ROAD DIST. NO.	STATE	FED. AID PROJ. NO.	FISCAL YEAR	SHEET NO.	TOTAL SHEETS
HAWAII	HAW.	I-H3-1(75), UNIT II	1997	892	1102


										H-3 Finish Unit II FAIP No. I-H3-1(75) Oahu, Hawaii										BORING NO. RN- 9									
Parsons Brinckerhoff										GEOTECHNICAL DESCRIPTION																			
OTHER LAB TESTS	DRY UNIT WEIGHT (pcf)	MOISTURE CONTENT (%)	CORE RECOVERY (%)	R.O.D. (%)	NUMBER OF BLOWSP	SAMPLE TYPE AND NUMBER	DEPTH IN FEET	GRAPHIC SYMBOL	U.S.C.S	DESCRIPTION																			
	84	16 35 34			17 800 /1.3	SP-1 ST-2	5	GM MH		2.5" AC Gray silty GRAVEL with sand, medium density, damp (Base Course)																			
		47			51	SP-3	10	ML		Reddish brown clayey SILT with sand and traces of gravel, stiff to hard, moist (Fill)																			
		27	27	0	50.5	CB-4	15			Gray brown clayey SILT with sand, hard, moist (Residual)																			
		50	50	0		CB-6				Brown volcanic TUFF, medium strong (Mudrock)																			
		25	25	0		CB-7																							
		30			35	SP-8	20	MH		Reddish brown clayey SILT, hard, moist (Residual)																			
UC	97	25 28			600ps 120	ST-9 SH-10	25																						
	82	34			650ps 75	ST-11 SP-12	30																						
		36			75	SP-12																							
		29			700ps 73	ST-13 SP-14	35	MH		Mottled reddish brown clayey SILT with fine sand, hard, moist (Residual)																			
		34					40			End boring at 31.6 ft. on 9/8/95 Groundwater not encountered.																			
SAMPLE TYPE CB - Core Barrel SP - Standard Penetration DN - Denison Barrel ST - Thin-Wall Tube SB - Split Barrel (2.5") SH - S & H Barrel (2.5")										OTHER LAB TESTS CN - Consolidation SA - Sieve Analysis DS - Direct Shear TX - Triaxial Compression PI - Atterberg Limits UC - Unconfined Compression																			
BORING LOCATION: Sta. 34 + 85, o/s 20'L										DRILLER: HGG										PROJECT NO. 3506V080									
GROUND SURFACE ELEVATION: +132 ft.										LOGGED BY: BC,EH,FB										PLATE NO. A- 9									
DATE(S) DRILLED: 9/8/95 to 9/8/95										TYPE RIG: CME 55																			

 Parsons Brinckerhoff				H-3 Finish Unit II FAIP No. I-H3-1(75) Oahu, Hawaii				BORING NO. RN-10																					
OTHER LAB TESTS								GEOTECHNICAL DESCRIPTION																					
DRY UNIT WEIGHT (pcf)	MOISTURE CONTENT (%)	CORE RECOVERY (%)	R.Q.D (%)	NUMBER OF BLOWS/FT	SAMPLE TYPE AND NUMBER	DEPTH IN FEET	GRAPHIC SYMBOL	U.S.C.S.																					
	39 19 27			22	SP-1			CH	Brownish gray CLAY with sand, gravel, cobbles and boulders, very stiff, damp (Fill)																				
PI				26	SP-2																								
TX	93	28		550ps / .5	ST-3	5																							
				50/0'	SP-4	10																							
								MH	Gray and brown silty CLAY with sand and gravel, hard, moist (Alluvium)																				
	44			36	SP-5	15																							
	45			600ps / .2	ST-6	20																							
TX PI	68	64		19	SH-7	25																							
								MH	Mottled brown silty CLAY with sand and gravel, very stiff, moist (Alluvium)																				
	49			25	SP-8	30																							
	57			25	SP-9	35																							
						40																							
									End boring at 36.5 ft. on 9/3/96.																				
									Groundwater not encountered.																				
<table border="0" style="width:100%"> <tr> <th colspan="4">SAMPLE TYPE</th> <th colspan="4">OTHER LAB TESTS</th> </tr> <tr> <td>CB - Core Barrel</td> <td>SP - Standard Penetration</td> <td>CN - Consolidation</td> <td>SA - Sieve Analysis</td> </tr> <tr> <td>DN - Denison Barrel</td> <td>ST - Thin-Wall Tube</td> <td>DS - Direct Shear</td> <td>TX - Triaxial Compression</td> </tr> <tr> <td>SB - Split Barrel (2.5")</td> <td>SH - S & H Barrel (2.5")</td> <td>PI - Atterberg Limits</td> <td>UC - Unconfined Compression</td> </tr> </table>										SAMPLE TYPE				OTHER LAB TESTS				CB - Core Barrel	SP - Standard Penetration	CN - Consolidation	SA - Sieve Analysis	DN - Denison Barrel	ST - Thin-Wall Tube	DS - Direct Shear	TX - Triaxial Compression	SB - Split Barrel (2.5")	SH - S & H Barrel (2.5")	PI - Atterberg Limits	UC - Unconfined Compression
SAMPLE TYPE				OTHER LAB TESTS																									
CB - Core Barrel	SP - Standard Penetration	CN - Consolidation	SA - Sieve Analysis																										
DN - Denison Barrel	ST - Thin-Wall Tube	DS - Direct Shear	TX - Triaxial Compression																										
SB - Split Barrel (2.5")	SH - S & H Barrel (2.5")	PI - Atterberg Limits	UC - Unconfined Compression																										
BORING LOCATION: Sta.181 +00, o/s 80' R'						DRILLER: HGG		PROJECT NO. 3508V080																					
GROUND SURFACE ELEVATION: + 88 ft.						LOGGED BY: BC, PM		PLATE NO. A- 10																					
DATE(S) DRILLED: 9/3/96 to 9/3/96						TYPE RIG: CME 55																							


 H-3 Finish Unit II FAIP No. IH3-1(75) Oahu, Hawaii										BORING NO. B- 7A	
Parsons Brinckerhoff										GEOTECHNICAL DESCRIPTION	
OTHER LAB TESTS	DRY UNIT WEIGHT (pcf)	MOISTURE CONTENT (%)	CORE RECOVERY (%)	R.O.D. (%)	NUMBER OF BLOW/FT	SAMPLE TYPE AND NUMBER	DEPTH IN FEET	GRAPHIC SYMBOL	U.S.C.S.	GEOTECHNICAL DESCRIPTION	
	49				13	SP-1			CH	Mottled reddish brown CLAY with traces of roots and decomposed rock, stiff to medium, moist	
	50				7	SP-2			CH	Mottled brown CLAY, stiff to very stiff, moist	
PI	72	50				ST-3	5				
	63				13	SP-4	10				
PI	62	64				ST-5	15				
PI	38				30	SP-6	20				
	49					ST-7	25				
	63				12	SP-8	30			CH	Mottled brown CLAY with traces of decomposed rock, stiff, moist
	67	52				ST-9	35			CH	Grayish brown CLAY, stiff to hard, moist
			78	10		CB-10	40				Gray BASALT, slightly weathered, closely fractured, strong

SAMPLE TYPE				OTHER LAB TESTS			
CB - Core Barrel	SP - Standard Penetration	CM - Consolidation	SA - Sieve Analysis				
DN - Denison Barrel	ST - Thin-Wall Tube	DS - Direct Shear	TX - Triaxial Compression				
SB - Split Barrel (2.5")	SH - S & H Barrel (2.5")	PI - Atterberg Limits	UC - Unconfined Compression				

BORING LOCATION: Sta. 11 + 30, o/s 5'L	DRILLER: HGG	PROJECT NO. 3506V080
GROUND SURFACE ELEVATION: + 126 ft.	LOGGED BY: BC	PLATE NO. A- 11
DATE(S) DRILLED: 3/15/94 to 3/16/94	TYPE RIG: Mobile B-50	

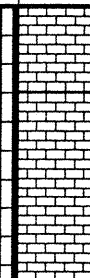		H-3 Finish Unit II FAIP No. I-H3-1(75) Oahu, Hawaii				BORING NO. B- 7A				
Parsons Brinckerhoff										
OTHER LAB TESTS	DRY UNIT WEIGHT (pcf)	MOISTURE CONTENT (%)	CORE RECOVERY (%)	R.O.D. (%)	NUMBER OF BLOW/FT	SAMPLE TYPE AND NUMBER	DEPTH IN FEET	GRAPHIC SYMBOL	U.S.C.S.	GEOTECHNICAL DESCRIPTION
			90	17		CB-11	45			Gray BASALT, slightly weathered, moderately fractured, strong
			95	0		CB-12	50			
							55			End boring at 50 ft. on 3/16/94.
							60			Groundwater Level at: Depth (ft) Time Date 18 1:30 pm 3/15/94 13.5 4:50 pm 3/16/94
							65			Laboratory Vane Shear (psf): ST-3 2050, 1650, 1900 ST-5 1120, 1480, 1100
							70			
							75			
							80			
SAMPLE TYPE CB - Core Barrel SP - Standard Penetration DN - Denison Barrel ST - Thin-Wall Tube SB - Split Barrel (2.5") SH - S & H Barrel (2.5")						OTHER LAB TESTS CN - Consolidation SA - Sieve Analysis DS - Direct Shear TX - Triaxial Compression PI - Atterberg Limits UC - Unconfined Compression				
BORING LOCATION: Sta. 11 + 30, o/s 5'L						DRILLER: HGG		PROJECT NO. 3506V080		
GROUND SURFACE ELEVATION: + 126 ft.						LOGGED BY: BC		PLATE NO. A- 12		
DATE(S) DRILLED: 3/15/94 to 3/16/94						TYPE RIG: Mobile B-50				

ORIGINAL PLAN	SURVEY PLOTTED BY _____ DATE _____
NOTE BOOK	DRAWN BY _____
	TRACED BY _____
	DESIGNED BY _____
	QUANTITIES BY _____
No. _____	CHECKED BY _____

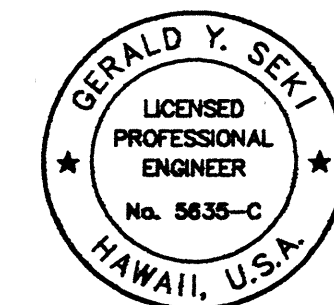

THIS WORK WAS PREPARED BY ME
OR UNDER MY SUPERVISION.

Ground 4.5

STATE OF HAWAII
DEPARTMENT OF TRANSPORTATION
HIGHWAYS DIVISION

DESTINATION SIGNS
BORING LOGS

H-3 FINISH (UNIT II)
FAIP NO. I-H3-1(75) UNIT II
LEEWARD SECTION

SCALE: NONE DATE: JANUARY 1997

SHEET NO. 6H8 OF 8 SHEETS