


FED. ROAD DIST. NO.	STATE	FED. AID PROJ. NO.	FISCAL YEAR	SHEET NO.	TOTAL SHEETS
HAWAII	HAW.	I-H3-1(75), UNIT II	1997	777	1102

CURVE	RADIUS	LENGTH	TANGENT	CHORD	DELTA	COORDINATES OF POINT OF INTERSECTION OF TANGENTS	
H3-1	1537.00'	645.22'	327.43'	640.49'	24°03'08.0"	N 74842.46	E 526860.22

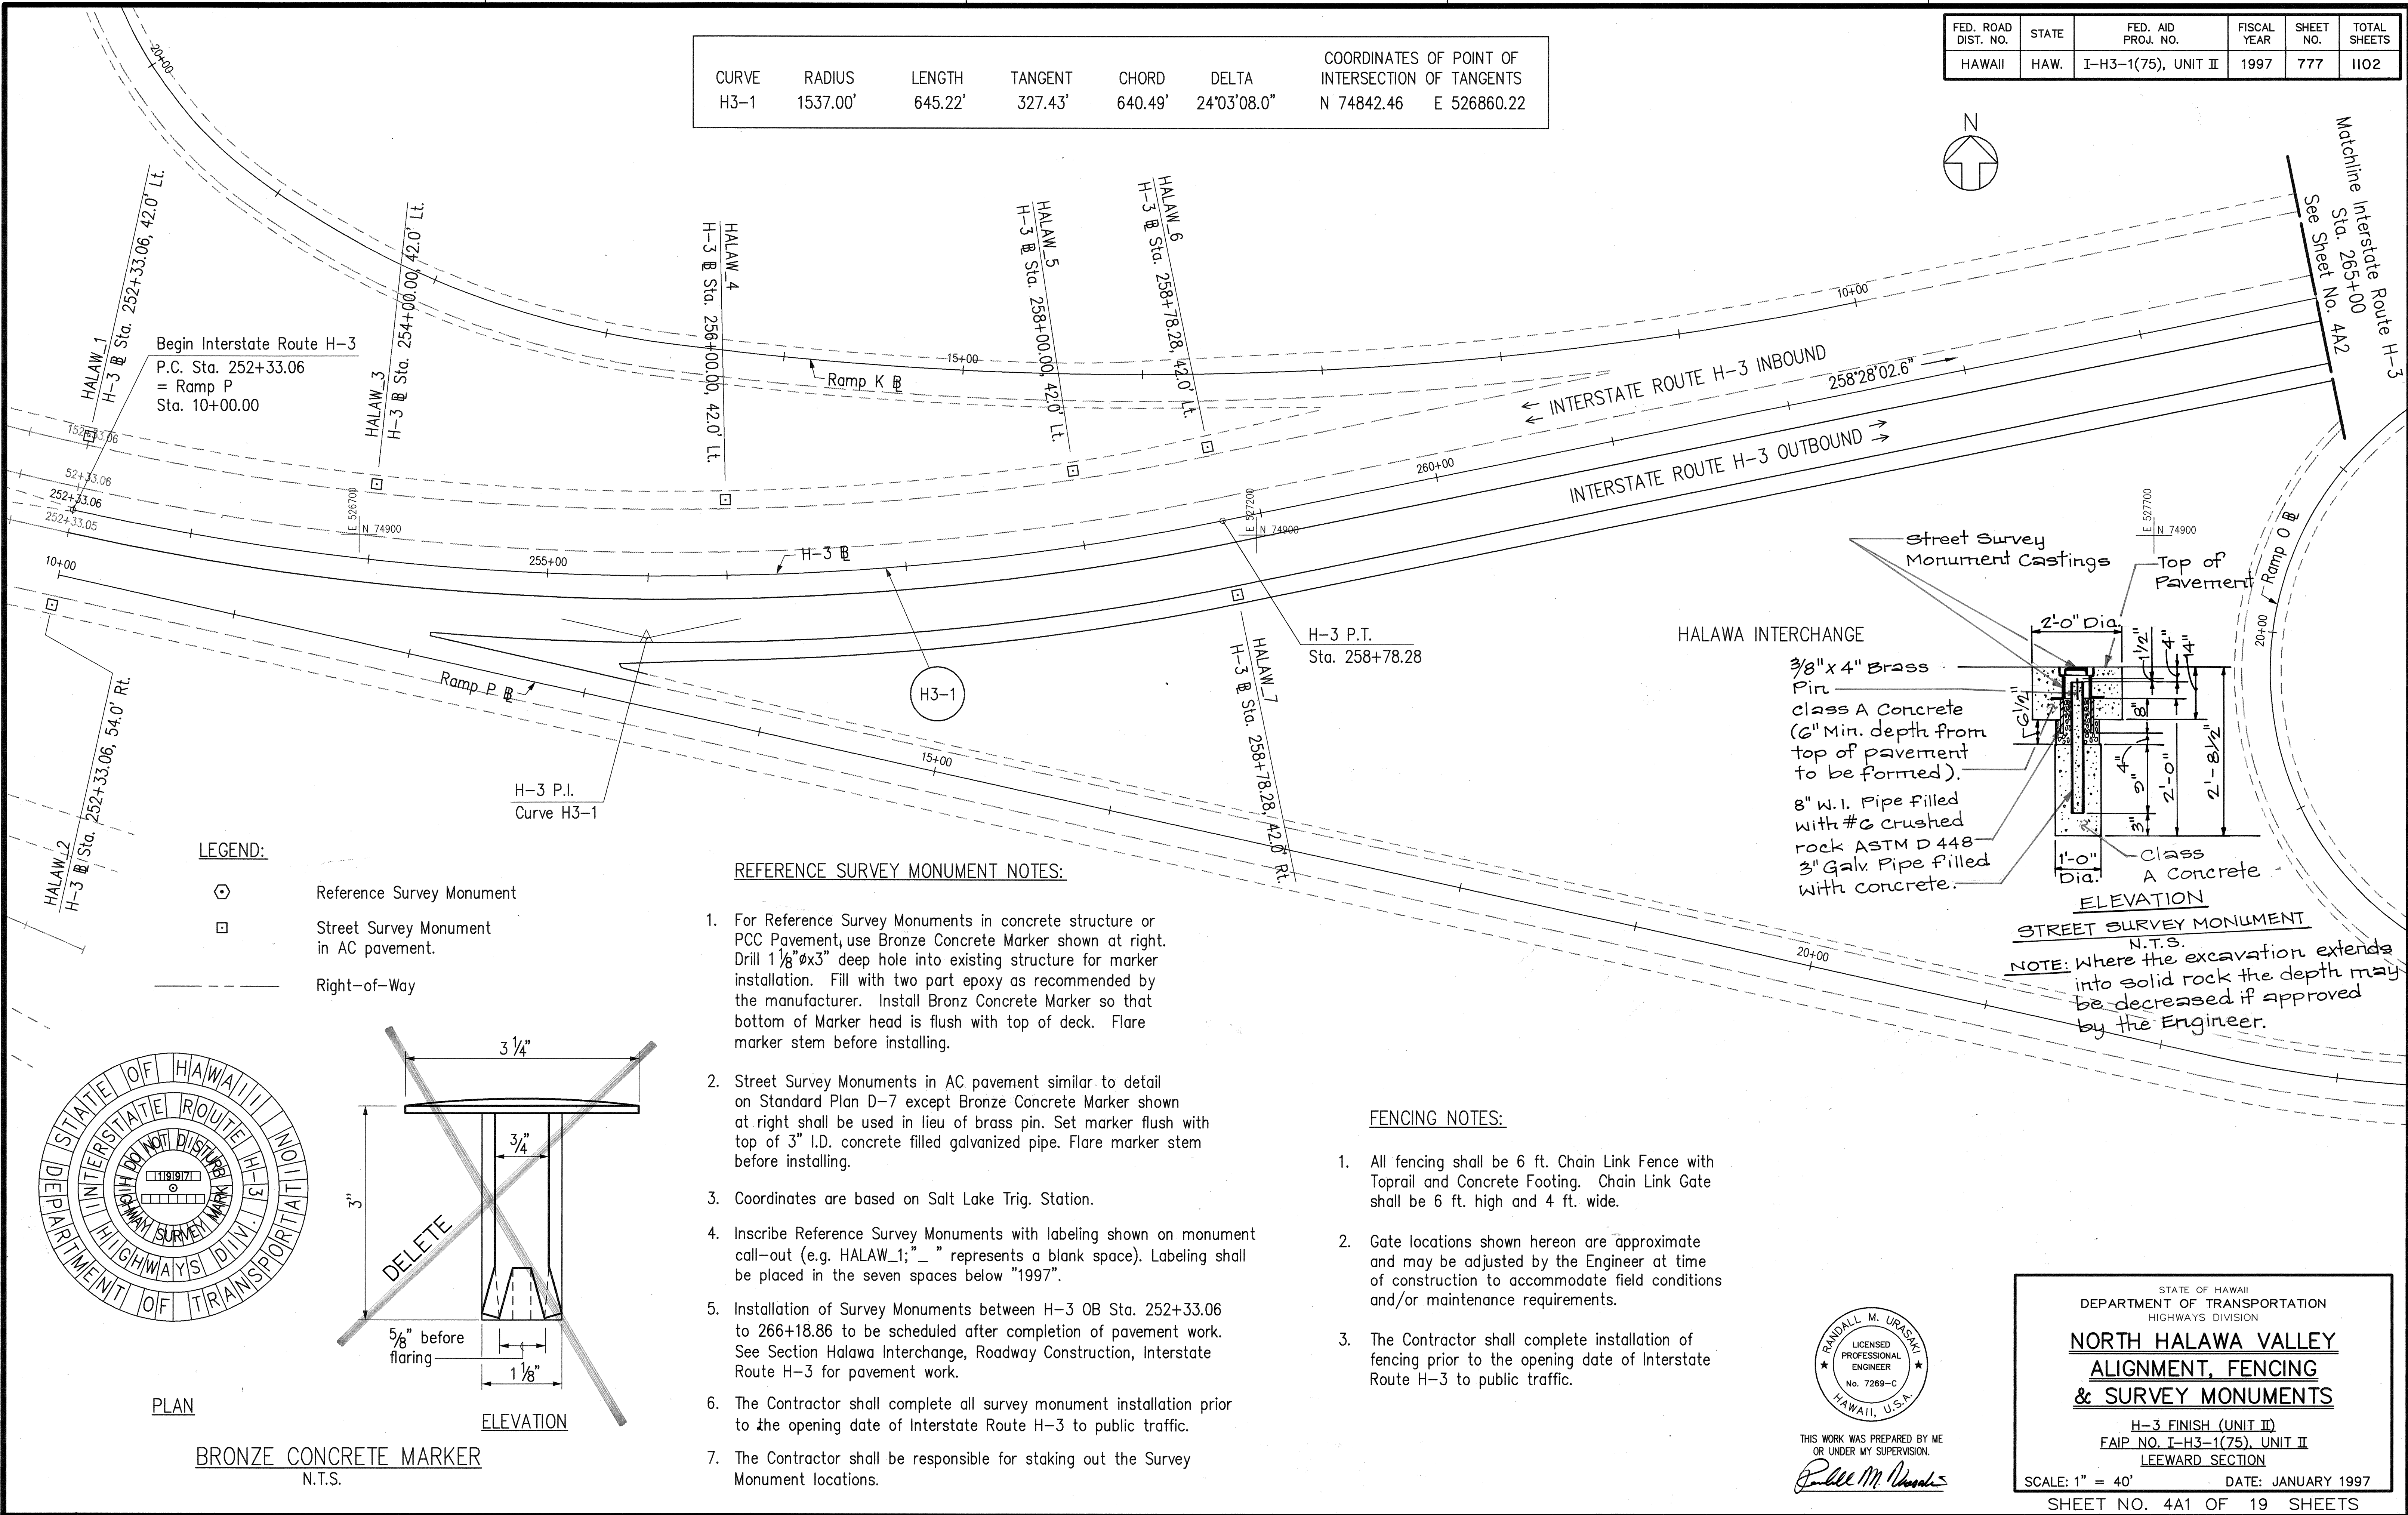

LEGEND:


- Reference Survey Monument
- Street Survey Monument in AC pavement.
- Right-of-Way

REFERENCE SURVEY MONUMENT NOTES:

- For Reference Survey Monuments in concrete structure or PCC Pavement, use Bronze Concrete Marker shown at right. Drill 1 1/8" x 3" deep hole into existing structure for marker installation. Fill with two part epoxy as recommended by the manufacturer. Install Bronze Concrete Marker so that bottom of Marker head is flush with top of deck. Flare marker stem before installing.
- Street Survey Monuments in AC pavement similar to detail on Standard Plan D-7 except Bronze Concrete Marker shown at right shall be used in lieu of brass pin. Set marker flush with top of 3" I.D. concrete filled galvanized pipe. Flare marker stem before installing.
- Coordinates are based on Salt Lake Trig. Station.
- Inscribe Reference Survey Monuments with labeling shown on monument call-out (e.g. HALAW_1; " _ " represents a blank space). Labeling shall be placed in the seven spaces below "1997".
- Installation of Survey Monuments between H-3 OB Sta. 252+33.06 to 266+18.86 to be scheduled after completion of pavement work. See Section Halawa Interchange, Roadway Construction, Interstate Route H-3 for pavement work.
- The Contractor shall complete all survey monument installation prior to the opening date of Interstate Route H-3 to public traffic.
- The Contractor shall be responsible for staking out the Survey Monument locations.

FENCING NOTES:

- All fencing shall be 6 ft. Chain Link Fence with Toprail and Concrete Footing. Chain Link Gate shall be 6 ft. high and 4 ft. wide.
- Gate locations shown hereon are approximate and may be adjusted by the Engineer at time of construction to accommodate field conditions and/or maintenance requirements.
- The Contractor shall complete installation of fencing prior to the opening date of Interstate Route H-3 to public traffic.

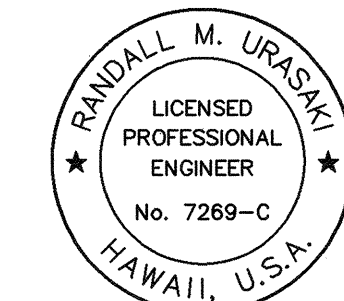

THIS WORK WAS PREPARED BY ME
OR UNDER MY SUPERVISION.

Randall M. Uraski

STATE OF HAWAII
DEPARTMENT OF TRANSPORTATION
HIGHWAYS DIVISION

**NORTH HALAWA VALLEY
ALIGNMENT, FENCING
& SURVEY MONUMENTS**
H-3 FINISH (UNIT II)
FAIP NO. I-H3-1(75), UNIT II
LEEWARD SECTION

SCALE: 1" = 40'
DATE: JANUARY 1997
SHEET NO. 4A1 OF 19 SHEETS

BRONZE CONCRETE MARKER
N.T.S.


PLAN

ELEVATION


SURVEY PLOTTED BY	DATE
ORIGINAL PLAN	
DESIGNED BY	
NOTE BOOK	
QUANTITIES BY	
CHECKED BY	
No.	

FED. ROAD DIST. NO.	STATE	FED. AID PROJ. NO.	FISCAL YEAR	SHEET NO.	TOTAL SHEETS
HAWAII	HAW.	I-H3-1(75), UNIT II	1997	778	1102

SURVEY PLOTTED BY	DATE
DRAWN BY	
NOTE BOOK DESIGNED BY	
QUANTITIES BY	
CHECKED BY	
No.	

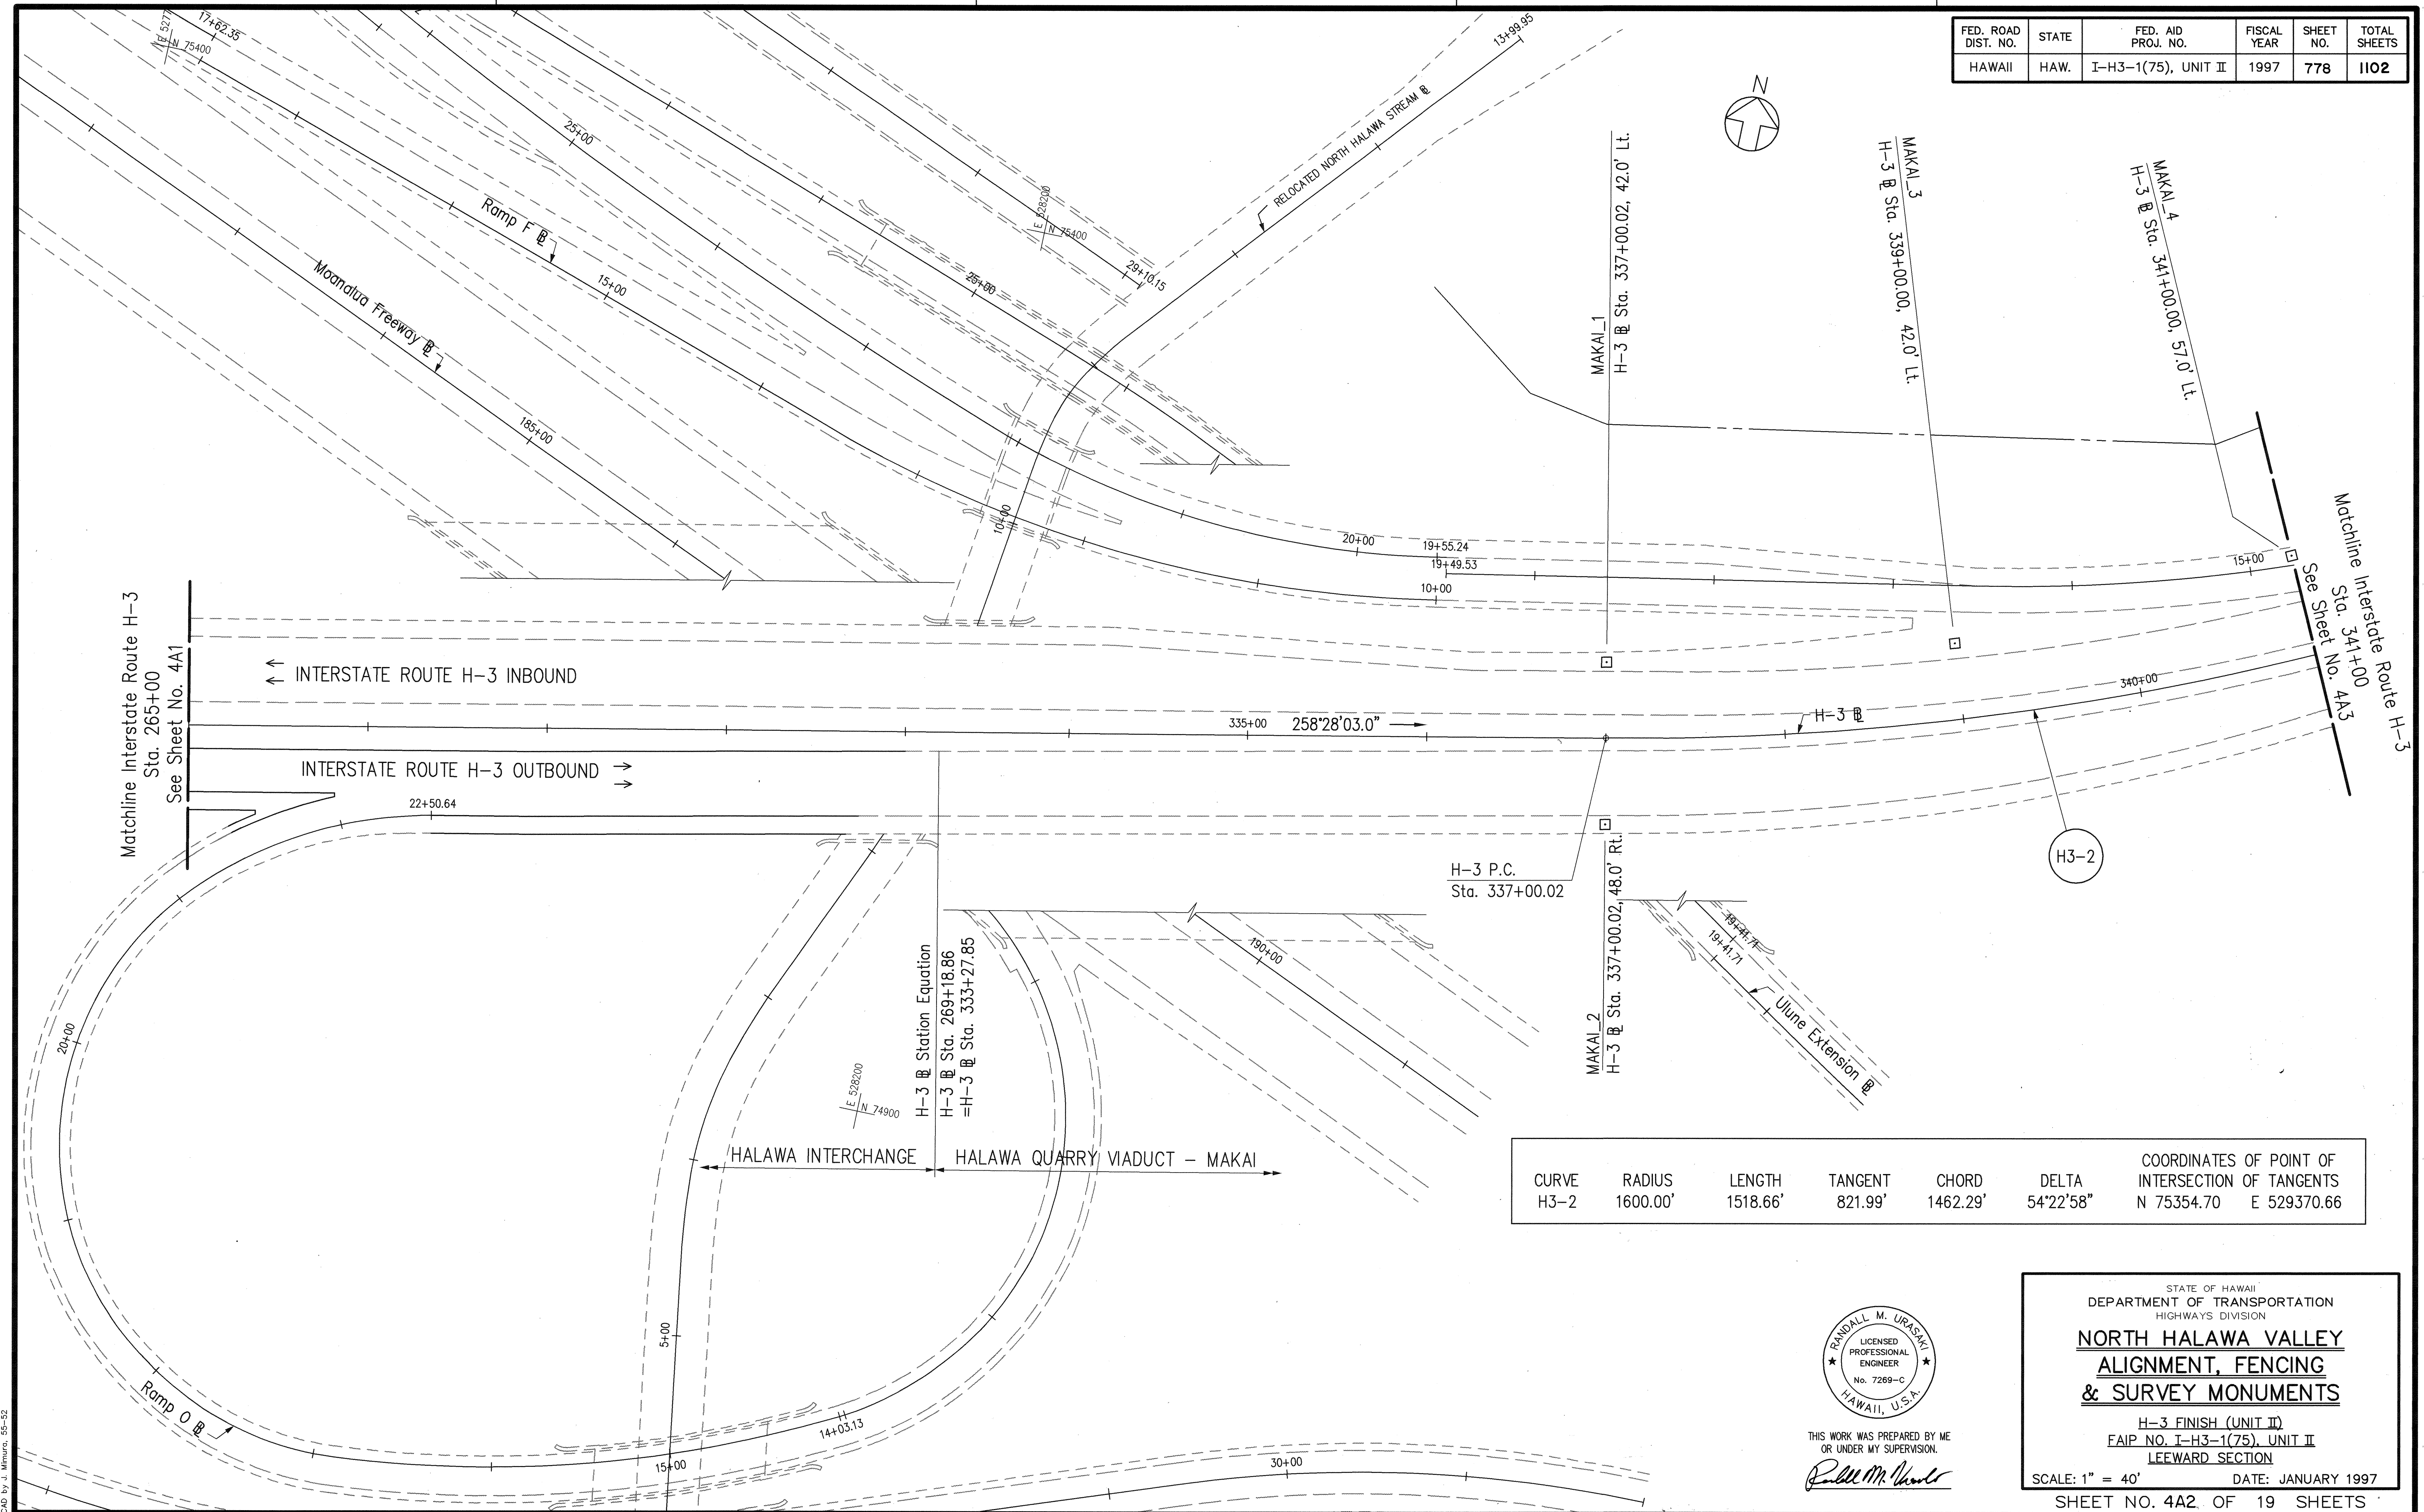

CURVE	RADIUS	LENGTH	TANGENT	CHORD	DELTA	COORDINATES OF POINT OF INTERSECTION OF TANGENTS
H3-2	1600.00'	1518.66'	821.99'	1462.29'	54°22'58"	N 75354.70 E 529370.66

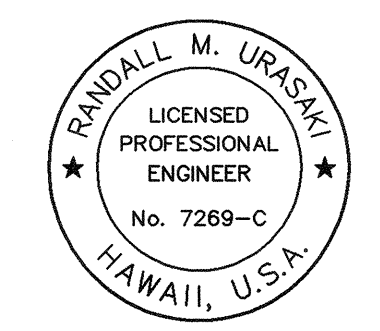

THIS WORK WAS PREPARED BY ME OR UNDER MY SUPERVISION.
Randall M. Urasky

STATE OF HAWAII
DEPARTMENT OF TRANSPORTATION
HIGHWAYS DIVISION


**NORTH HALAWA VALLEY
ALIGNMENT, FENCING
& SURVEY MONUMENTS**

H-3 FINISH (UNIT II)
FAIP NO. I-H3-1(75), UNIT II
LEEWARD SECTION



SCALE: 1" = 40' DATE: JANUARY 1997
SHEET NO. 4A2 OF 19 SHEETS

FED. ROAD DIST. NO.	STATE	FED. AID PROJ. NO.	FISCAL YEAR	SHEET NO.	TOTAL SHEETS
HAWAII	HAW.	I-H3-1(75), UNIT II	1997	779	1102

CURVE	RADIUS	LENGTH	TANGENT	CHORD	DELTA	COORDINATES OF POINT OF INTERSECTION OF TANGENTS
H3-2	1600.00'	1518.66'	821.99'	1462.29'	54°22'58"	N 75354.70 E 529370.66

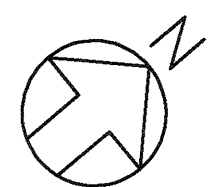

ORIGINAL	SURVEY PLOTTED BY	DATE
PLAN	DESIGNED BY	
NOTE BOOK	QUANTITIES BY	
	CHECKED BY	
No.		

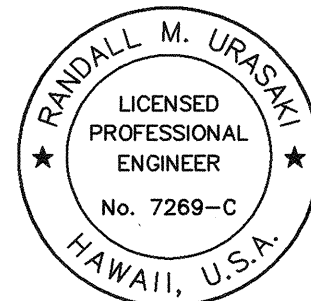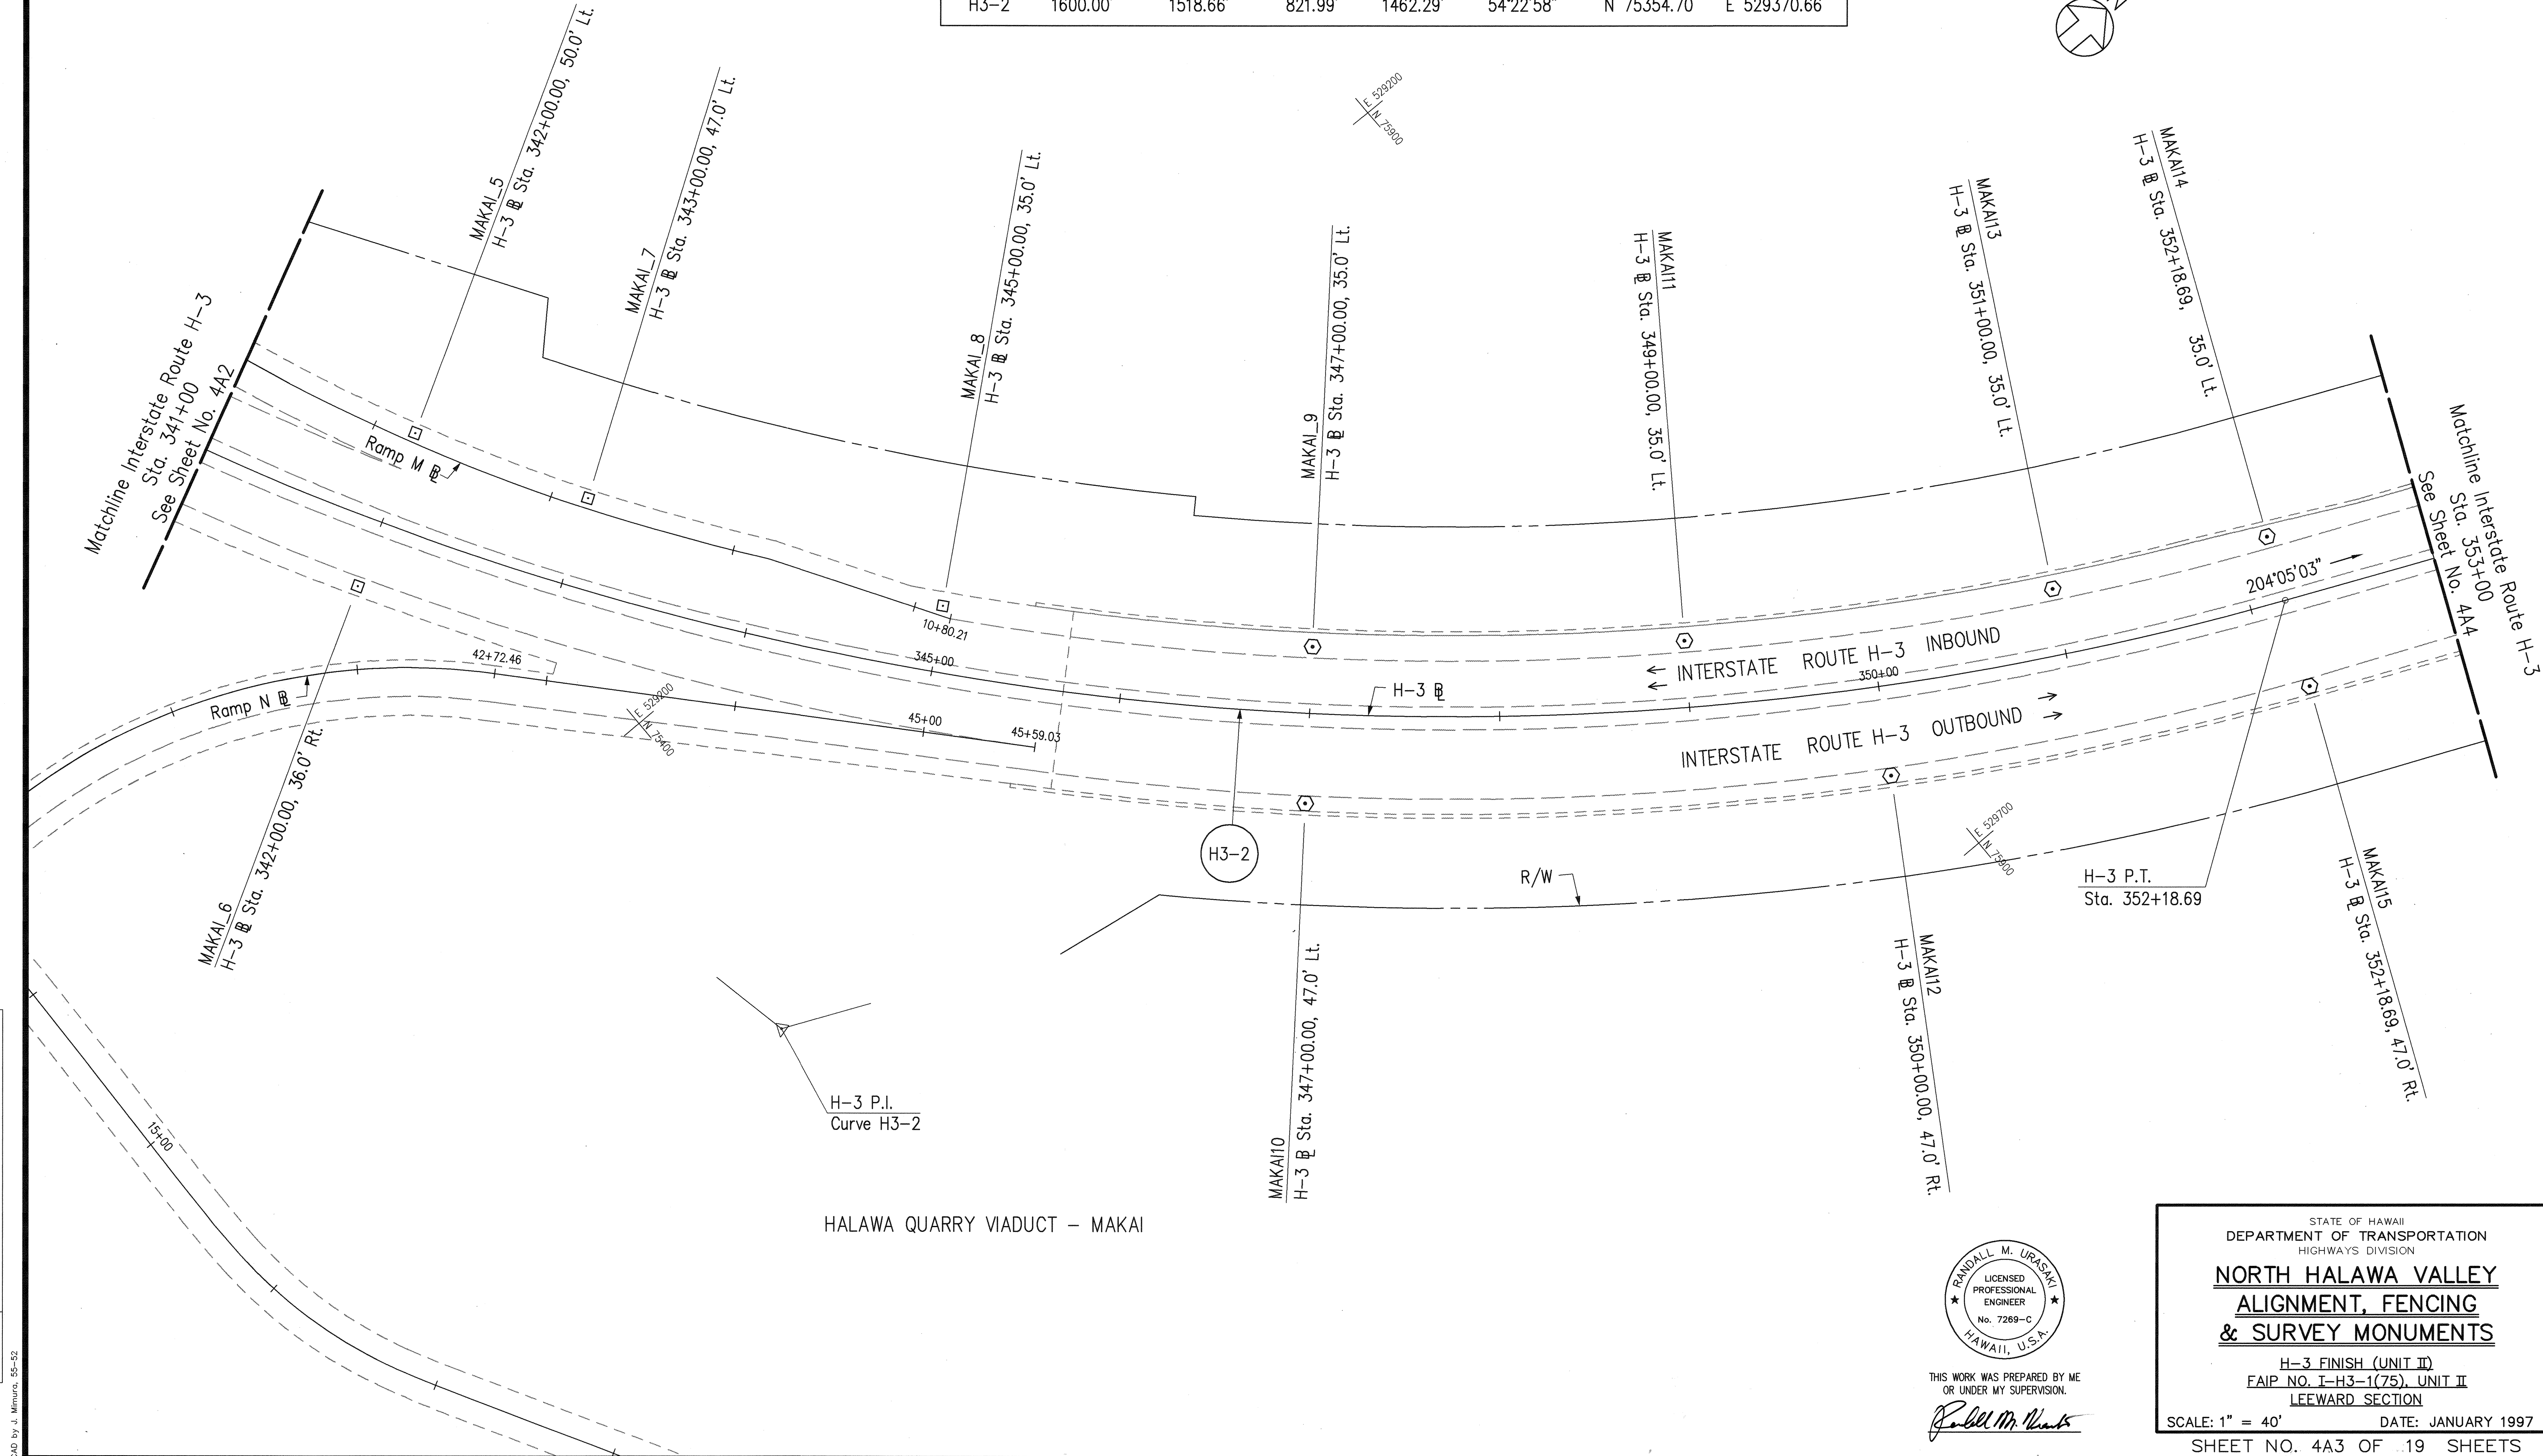

THIS WORK WAS PREPARED BY ME
OR UNDER MY SUPERVISION.


Randall M. Urasky

STATE OF HAWAII
DEPARTMENT OF TRANSPORTATION
HIGHWAYS DIVISION
NORTH HALAWA VALLEY
ALIGNMENT, FENCING
& SURVEY MONUMENTS
H-3 FINISH (UNIT II)
FAIP NO. I-H3-1(75), UNIT II
LEEWARD SECTION
SCALE: 1" = 40' DATE: JANUARY 1997
SHEET NO. 4A3 OF 19 SHEETS

ORIGINAL	SURVEY PLOTTED BY	DATE
PLAN	DRAWN BY	
NOTE BOOK	DESIGNED BY	
No.	QUANTITIES BY	
	CHECKED BY	


CAD by J. Minura 55-52

Last Saved: J:\H3RF\RFU2\ALIGN\H3ALI-04.dwg 02/12/97 at 10:42

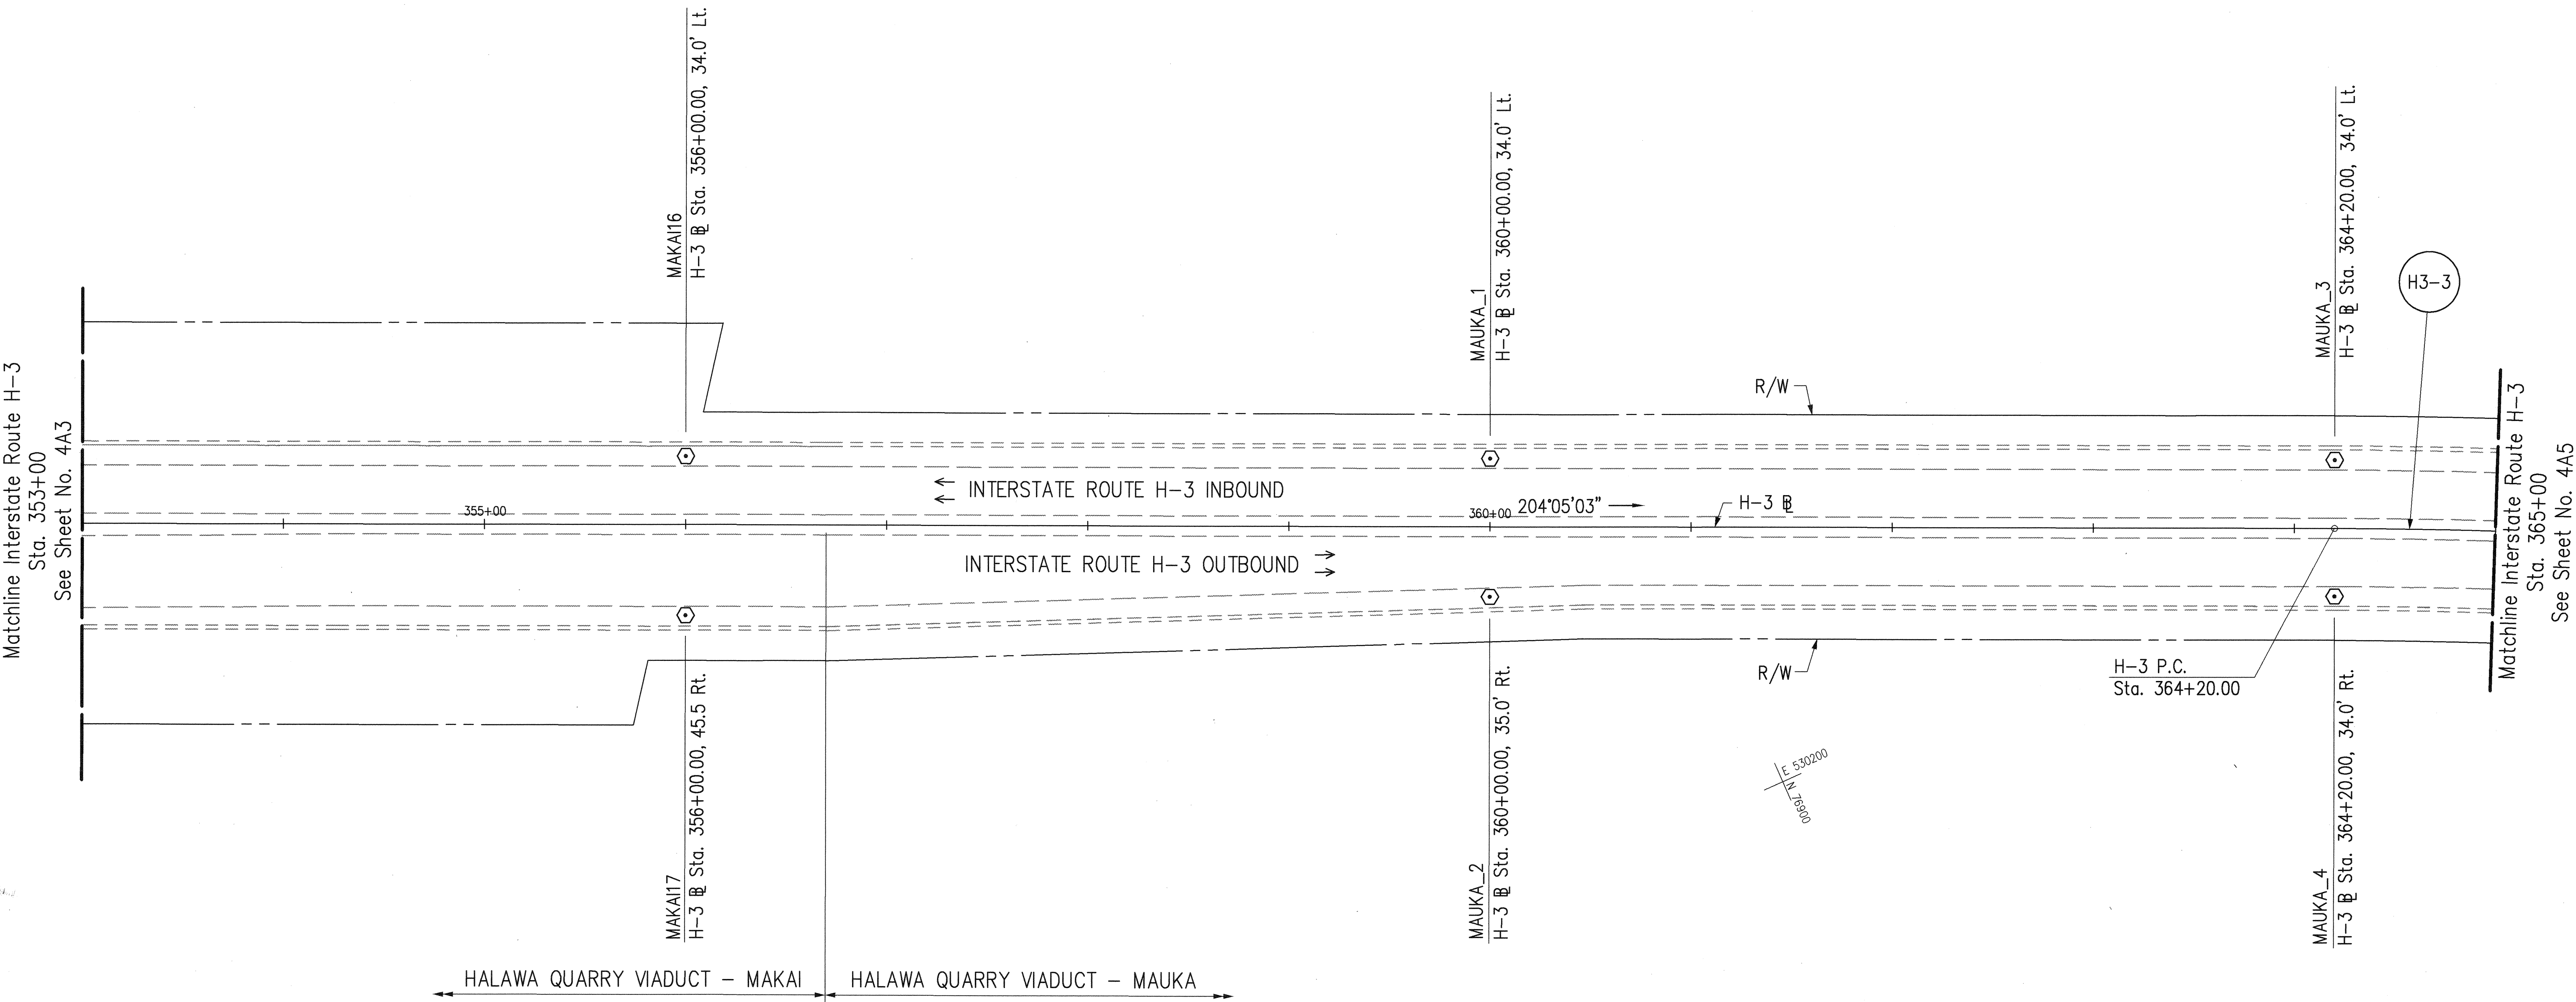

CURVE	RADIUS	LENGTH	TANGENT	CHORD	DELTA	COORDINATES OF POINT OF INTERSECTION OF TANGENTS	
H3-3	2800.00'	1701.46'	877.91'	1675.40'	34°49'00"	N 78003.36	E 530554.59

FED. ROAD DIST. NO.	STATE	FED. AID PROJ. NO.	FISCAL YEAR	SHEET NO.	TOTAL SHEETS
HAWAII	HAW.	I-H3-1(75), UNIT II	1997	780	1102

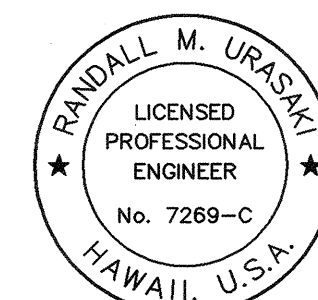

THIS WORK WAS PREPARED BY ME OR UNDER MY SUPERVISION.

Randall M. Uraski

STATE OF HAWAII
DEPARTMENT OF TRANSPORTATION
HIGHWAYS DIVISION

**NORTH HALAWA VALLEY
ALIGNMENT, FENCING
& SURVEY MONUMENTS**



H-3 FINISH (UNIT II)
FAIP NO. I-H3-1(75), UNIT II
LEEWARD SECTION

SCALE: 1" = 40' DATE: JANUARY 1997

SHEET NO. 4A4 OF 19 SHEETS

FED. ROAD DIST. NO.	STATE	FED. AID PROJ. NO.	FISCAL YEAR	SHEET NO.	TOTAL SHEETS
HAWAII	HAW.	I-H3-1(75), UNIT II	1997	781	1102


CURVE	RADIUS	LENGTH	TANGENT	CHORD	DELTA	COORDINATES OF POINT OF INTERSECTION OF TANGENTS
H3-3	2800.00'	1701.46'	877.91'	1675.40'	34°49'00"	N 78003.36 E 530554.59

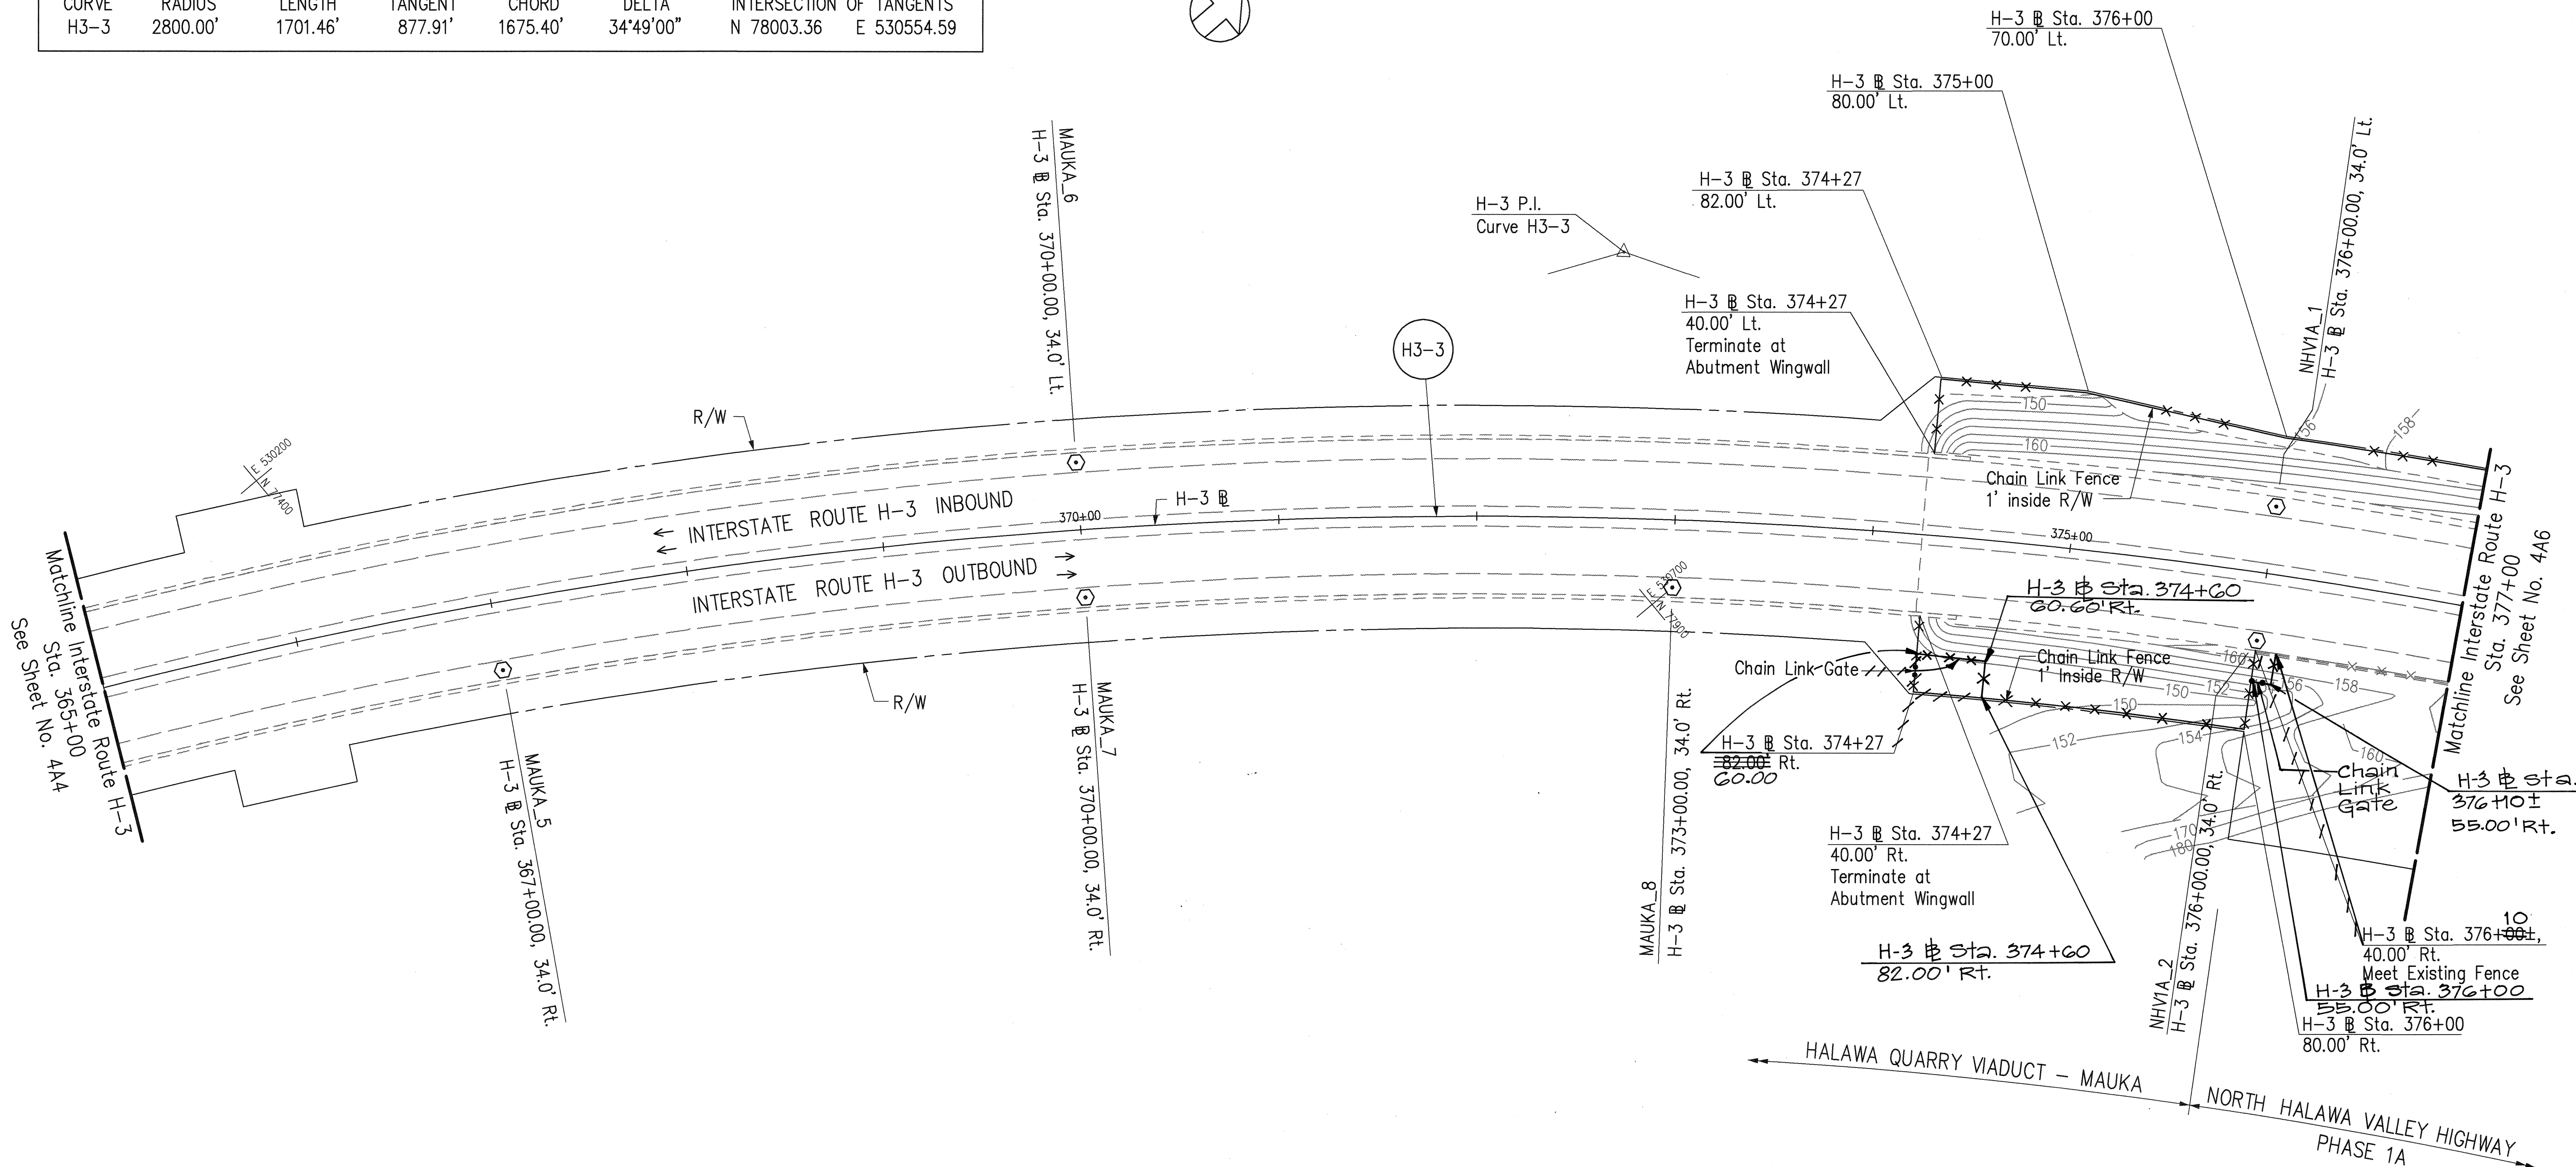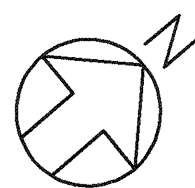

ORIGINAL PLAN	DATE
SURVEY PLOTTED BY	
DESIGNED BY	
TRACED BY	
NOTE BOOK	
DESIGNED BY	
QUANTITIES BY	
CHECKED BY	
No.	

CAD by J. Minura, 55-52

Last Saved: J:\H3RF\RFU2\ALIGN\H3ALI-05.dwg 02/12/97 at 10:50

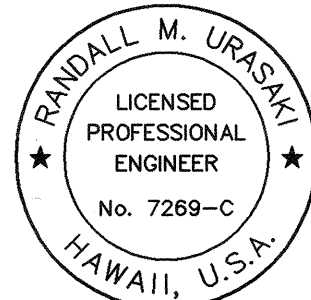


THIS WORK WAS PREPARED BY ME
OR UNDER MY SUPERVISION.

Randall M. Urasaki


STATE OF HAWAII
DEPARTMENT OF TRANSPORTATION
HIGHWAYS DIVISION
**NORTH HALAWA VALLEY
ALIGNMENT, FENCING
& SURVEY MONUMENTS**
H-3 FINISH (UNIT II)
FAIP NO. I-H3-1(75), UNIT II
LEEWARD SECTION
SCALE: 1" = 40' DATE: JANUARY 1997
SHEET NO. 4A5 OF 19 SHEETS

FED. ROAD DIST. NO.	STATE	FED. AID PROJ. NO.	FISCAL YEAR	SHEET NO.	TOTAL SHEETS
HAWAII	HAW.	I-H3-1(75), UNIT II	1997	782	1102

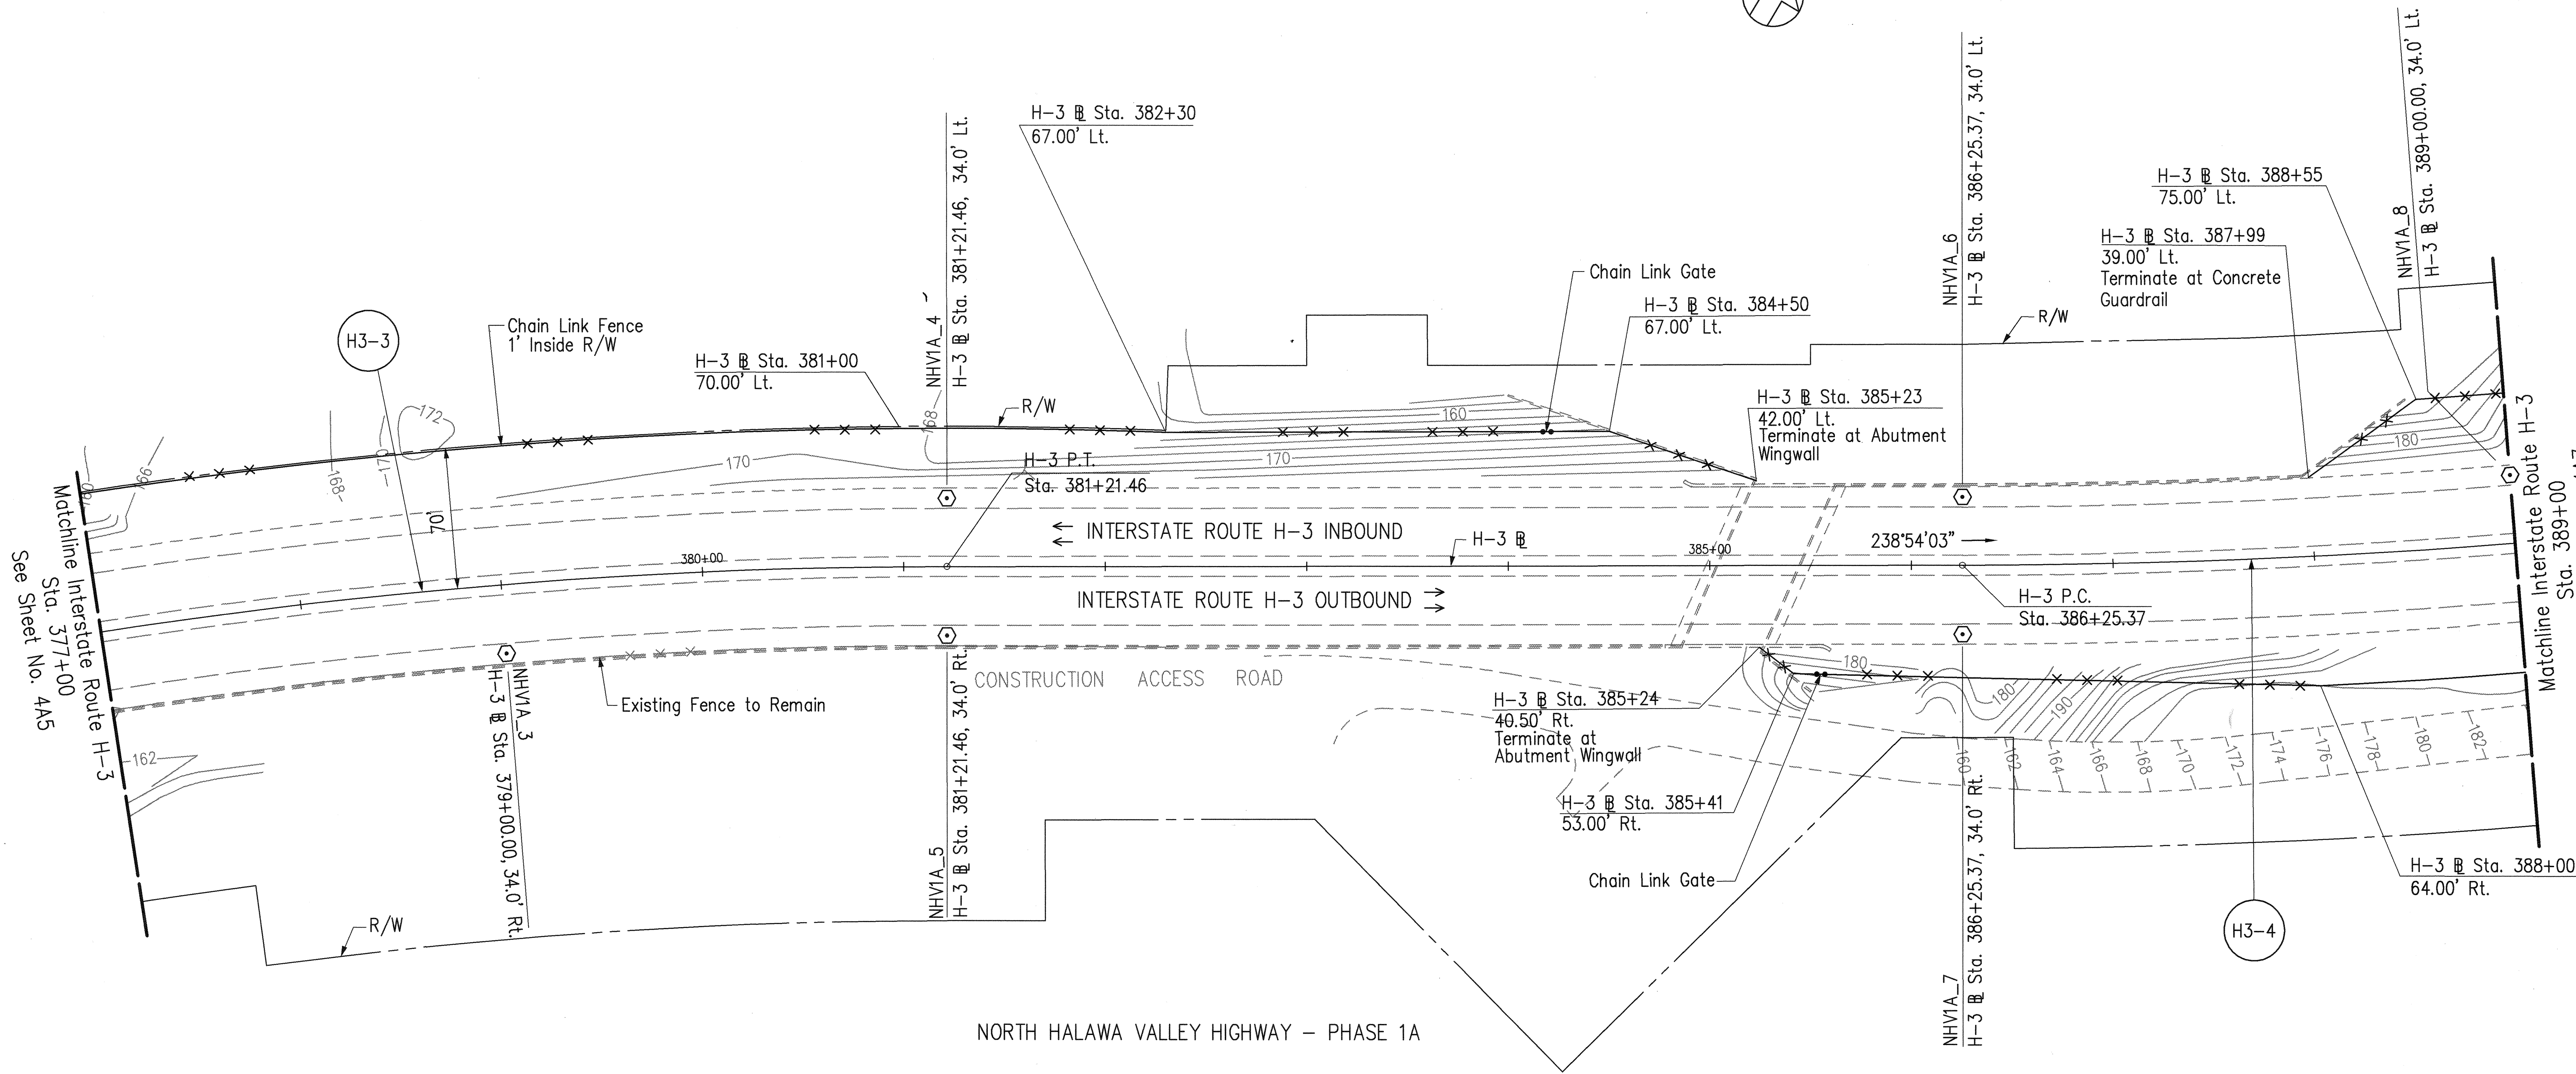

ORIGINAL	SURVEY PLOTTED BY	DATE
PLAN	DESIGNED BY	
NOTE BOOK	TRACED BY	
QUANTITIES BY		
CHECKED BY		
No.		

CURVE	RADIUS	LENGTH	TANGENT	CHORD	DELTA	COORDINATES OF POINT OF INTERSECTION OF TANGENTS	
H3-3	2800.00'	1701.46'	877.91'	1675.40'	34°49'00"	N 78003.36	E 530554.59
H3-4	3600.00'	1010.55'	508.62'	1007.24'	16°05'00"	N 78979.81	E 532173.33

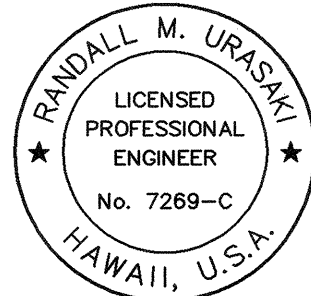


THIS WORK WAS PREPARED BY ME
OR UNDER MY SUPERVISION.

Randall M. Urakami


STATE OF HAWAII
DEPARTMENT OF TRANSPORTATION
HIGHWAYS DIVISION
NORTH HALAWA VALLEY
ALIGNMENT, FENCING
& SURVEY MONUMENTS
H-3 FINISH (UNIT II)
FAIP NO. I-H3-1(75), UNIT II
LEEWARD SECTION
SCALE: 1" = 40'
DATE: JANUARY 1997
SHEET NO. 4A6 OF 19 SHEETS

FED. ROAD DIST. NO.	STATE	FED. AID PROJ. NO.	FISCAL YEAR	SHEET NO.	TOTAL SHEETS
HAWAII	HAW.	I-H3-1(75), UNIT II	1997	783	1102

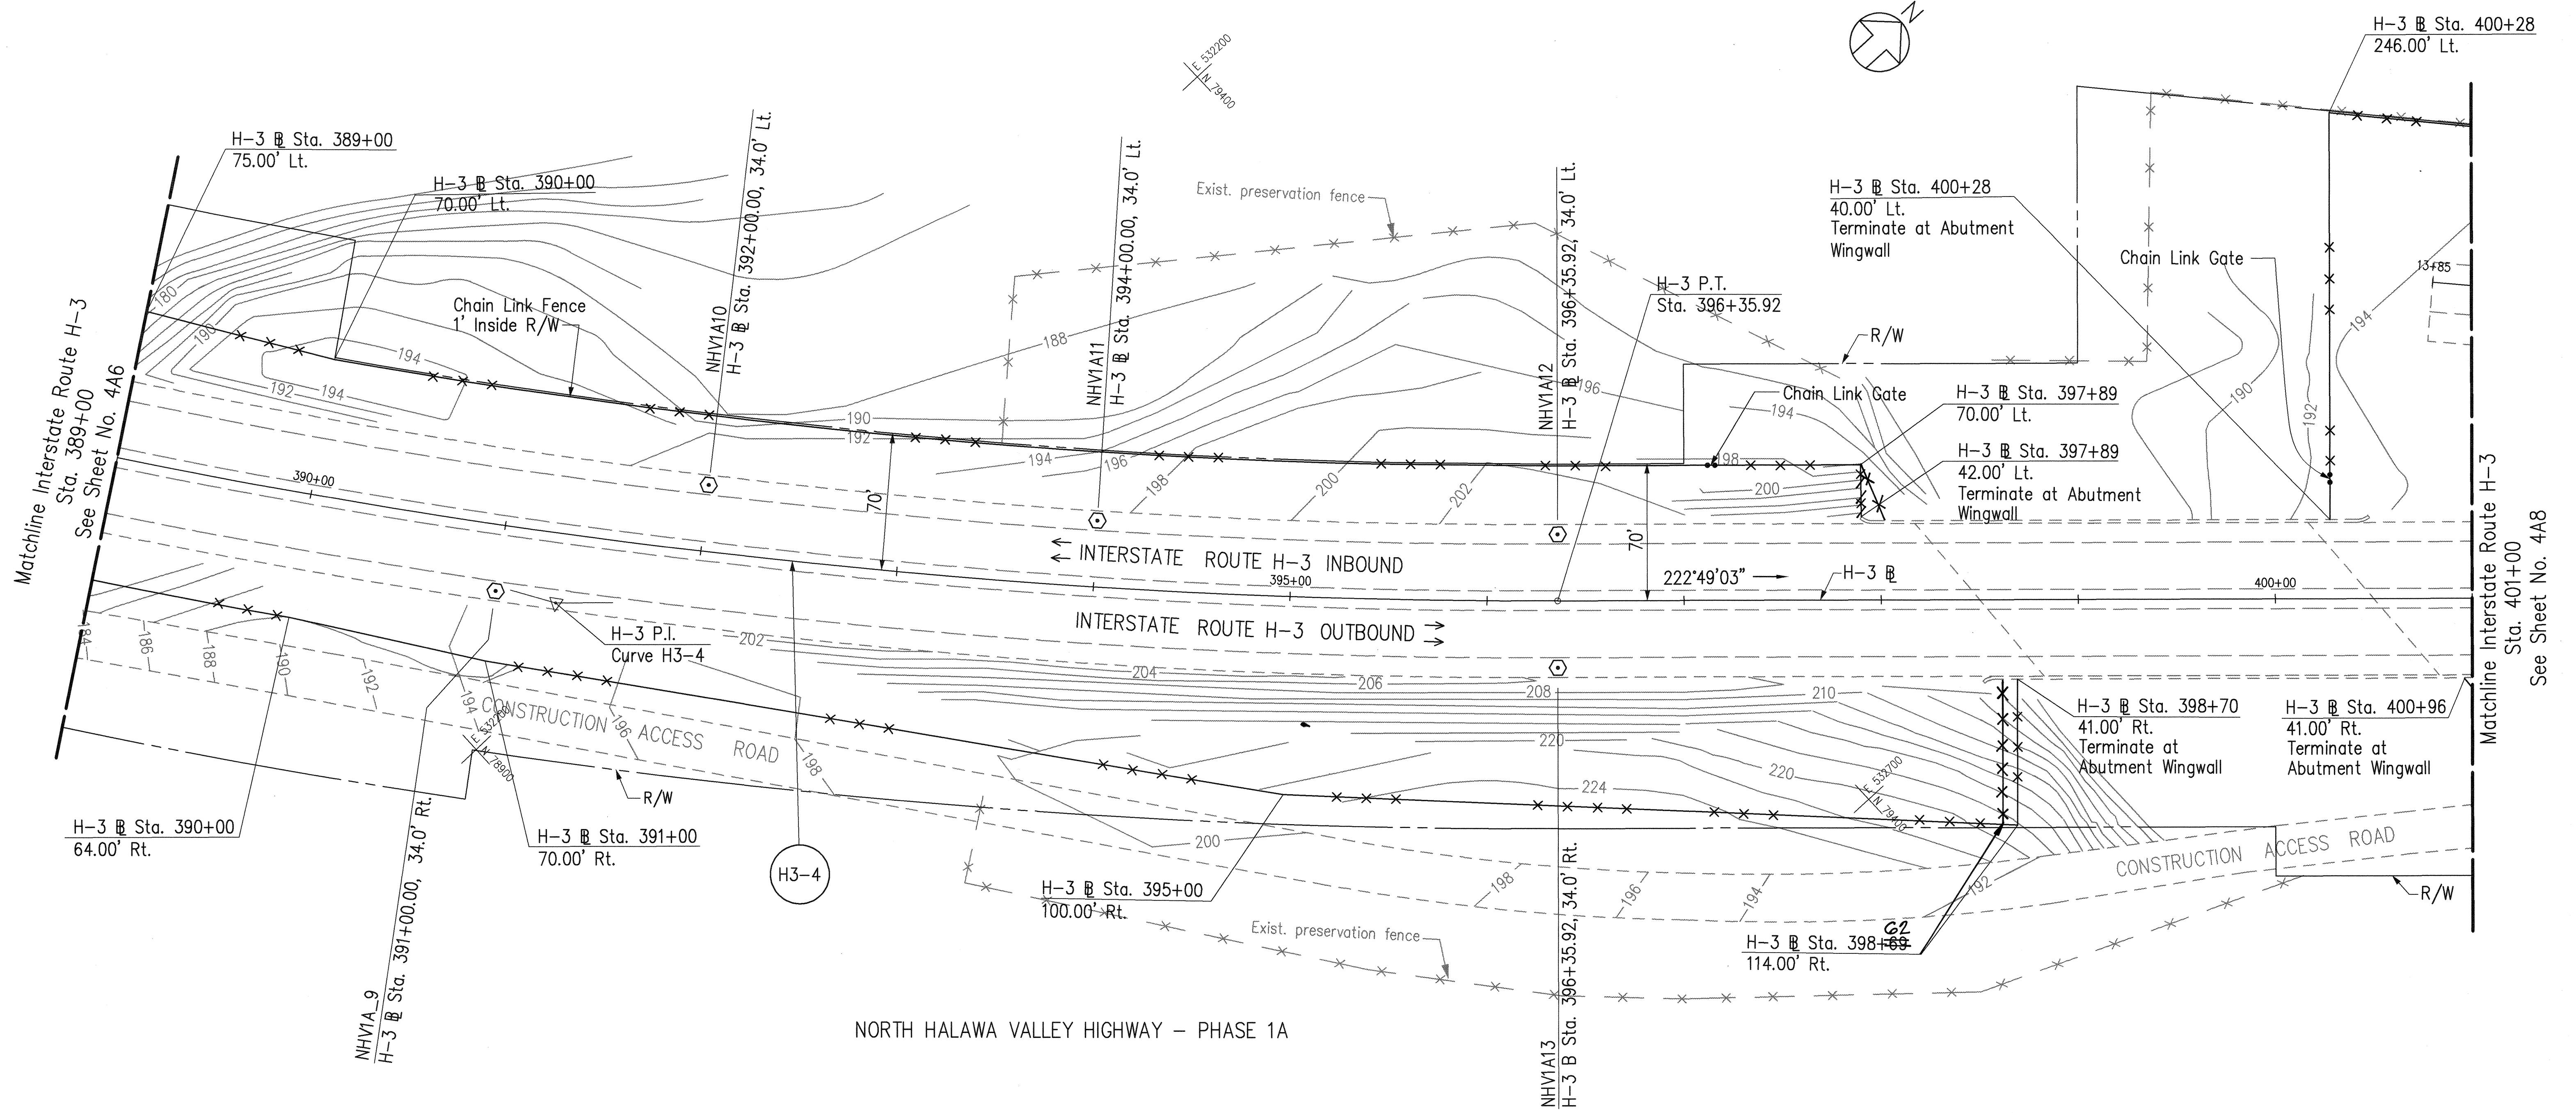

CURVE	RADIUS	LENGTH	TANGENT	CHORD	DELTA	COORDINATES OF POINT OF INTERSECTION OF TANGENTS
H3-4	3600.00'	1010.55'	508.62'	1007.24'	16°05'00"	N 78979.81 E 532173.33

ORIGINAL PLAN	SURVEY PLOTTED BY	DATE
NOTE BOOK	DESIGNED BY	
QUANTITIES BY	CHECKED BY	
No.		

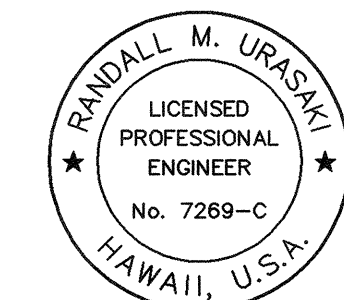

THIS WORK WAS PREPARED BY ME OR UNDER MY SUPERVISION.

Randall M. Uraski

STATE OF HAWAII
DEPARTMENT OF TRANSPORTATION
HIGHWAYS DIVISION

**NORTH HALAWA VALLEY
ALIGNMENT, FENCING
& SURVEY MONUMENTS**



H-3 FINISH (UNIT II)
FAIP NO. I-H3-1(75), UNIT II
LEEWARD SECTION

SCALE: 1" = 40' DATE: JANUARY 1997

SHEET NO. 4A7 OF 19 SHEETS


FED. ROAD DIST. NO.	STATE	FED. AID PROJ. NO.	FISCAL YEAR	SHEET NO.	TOTAL SHEETS
HAWAII	HAW.	I-H3-1(75), UNIT II	1997	784	1102

Note:
 1. In areas where the permanent G' preservation fence conflicts with the existing 4' preservation fence, the wire strands of the existing fence may be cut to allow for the installation of the G' fence.

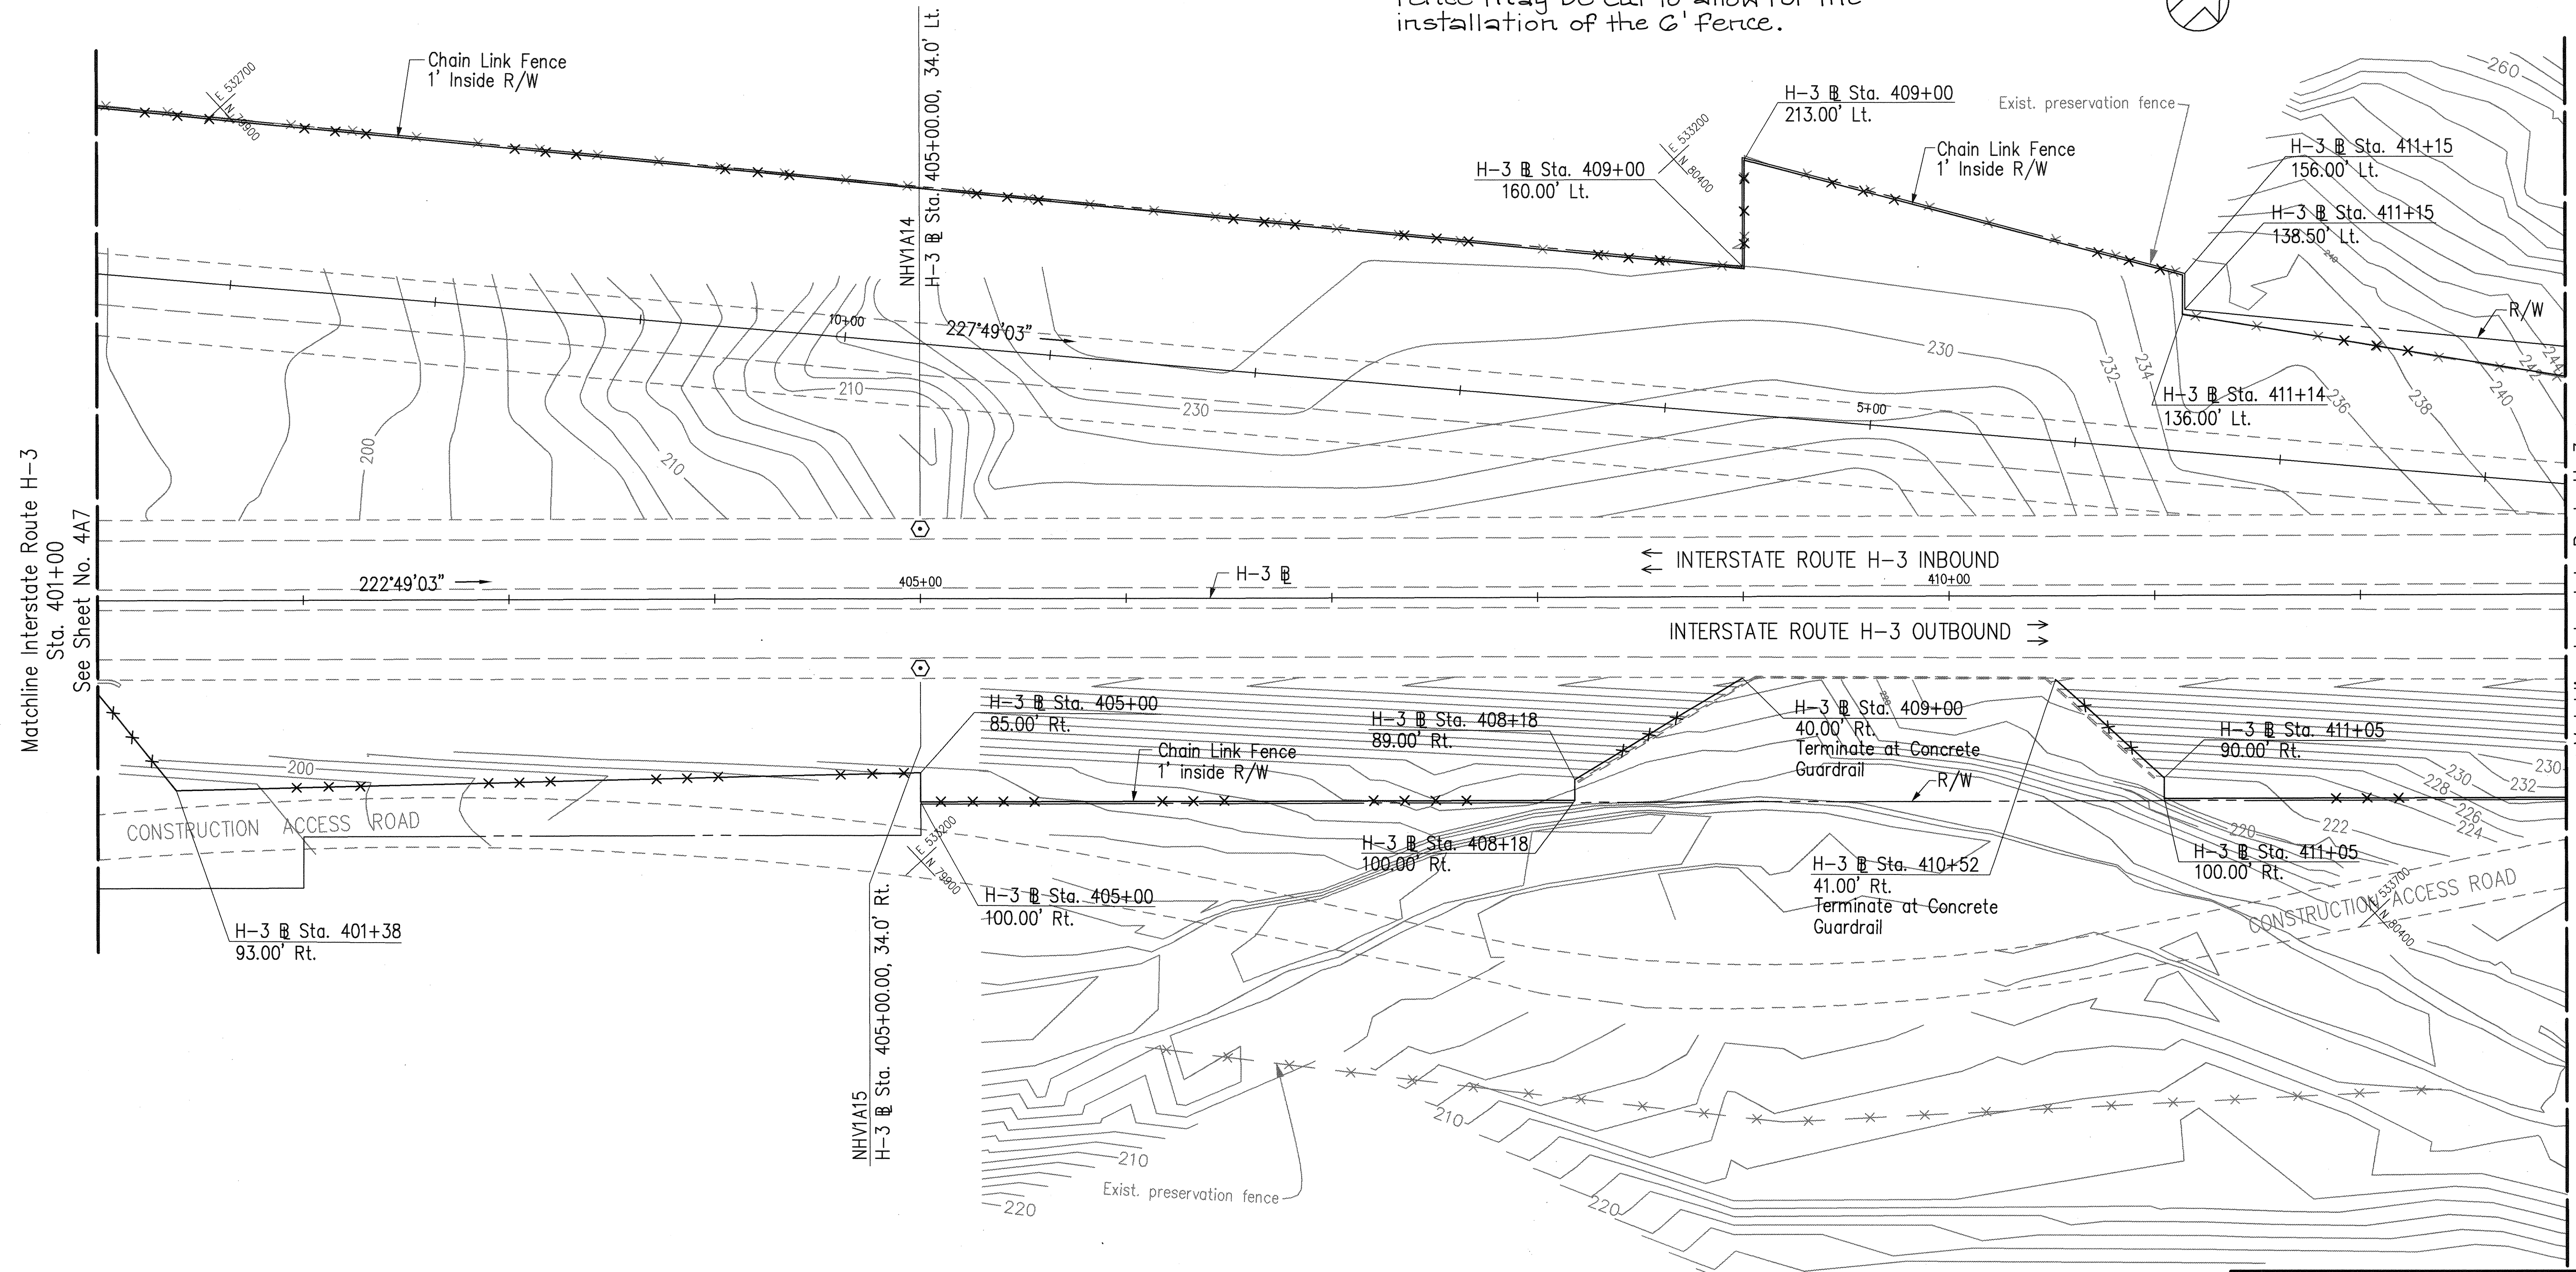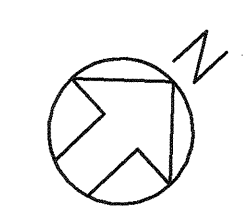

NORTH HALAWA VALLEY HIGHWAY - PHASE 1A

ORIGINAL PLAN	DATE
SURVEY PLOTTED BY	
DESIGNED BY	
NOTED BY	
CHECKED BY	
NO.	

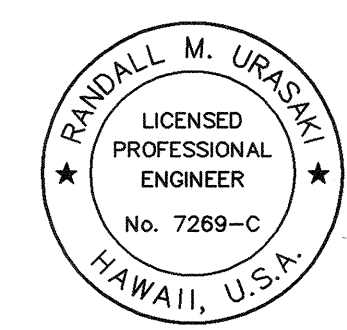

THIS WORK WAS PREPARED BY ME
 OR UNDER MY SUPERVISION.
Randall M. Uraski

STATE OF HAWAII
 DEPARTMENT OF TRANSPORTATION
 HIGHWAYS DIVISION

**NORTH HALAWA VALLEY
 ALIGNMENT, FENCING
 & SURVEY MONUMENTS**


H-3 FINISH (UNIT II)
 FAIP NO. I-H3-1(75), UNIT II
 LEEWARD SECTION

SCALE: 1" = 40' DATE: JANUARY 1997
 SHEET NO. 4A8 OF 19 SHEETS

CAD by J. Minura, 55-52

FED. ROAD DIST. NO.	STATE	FED. AID PROJ. NO.	FISCAL YEAR	SHEET NO.	TOTAL SHEETS
HAWAII	HAW.	I-H3-1(75), UNIT II	1997	785	1102


CURVE	RADIUS	LENGTH	TANGENT	CHORD	DELTA	COORDINATES OF POINT OF INTERSECTION OF TANGENTS
H3-5	4000.00'	570.14'	285.55'	569.66'	08°10'00"	N 80928.70 E 533978.83 80927.42 533977.94

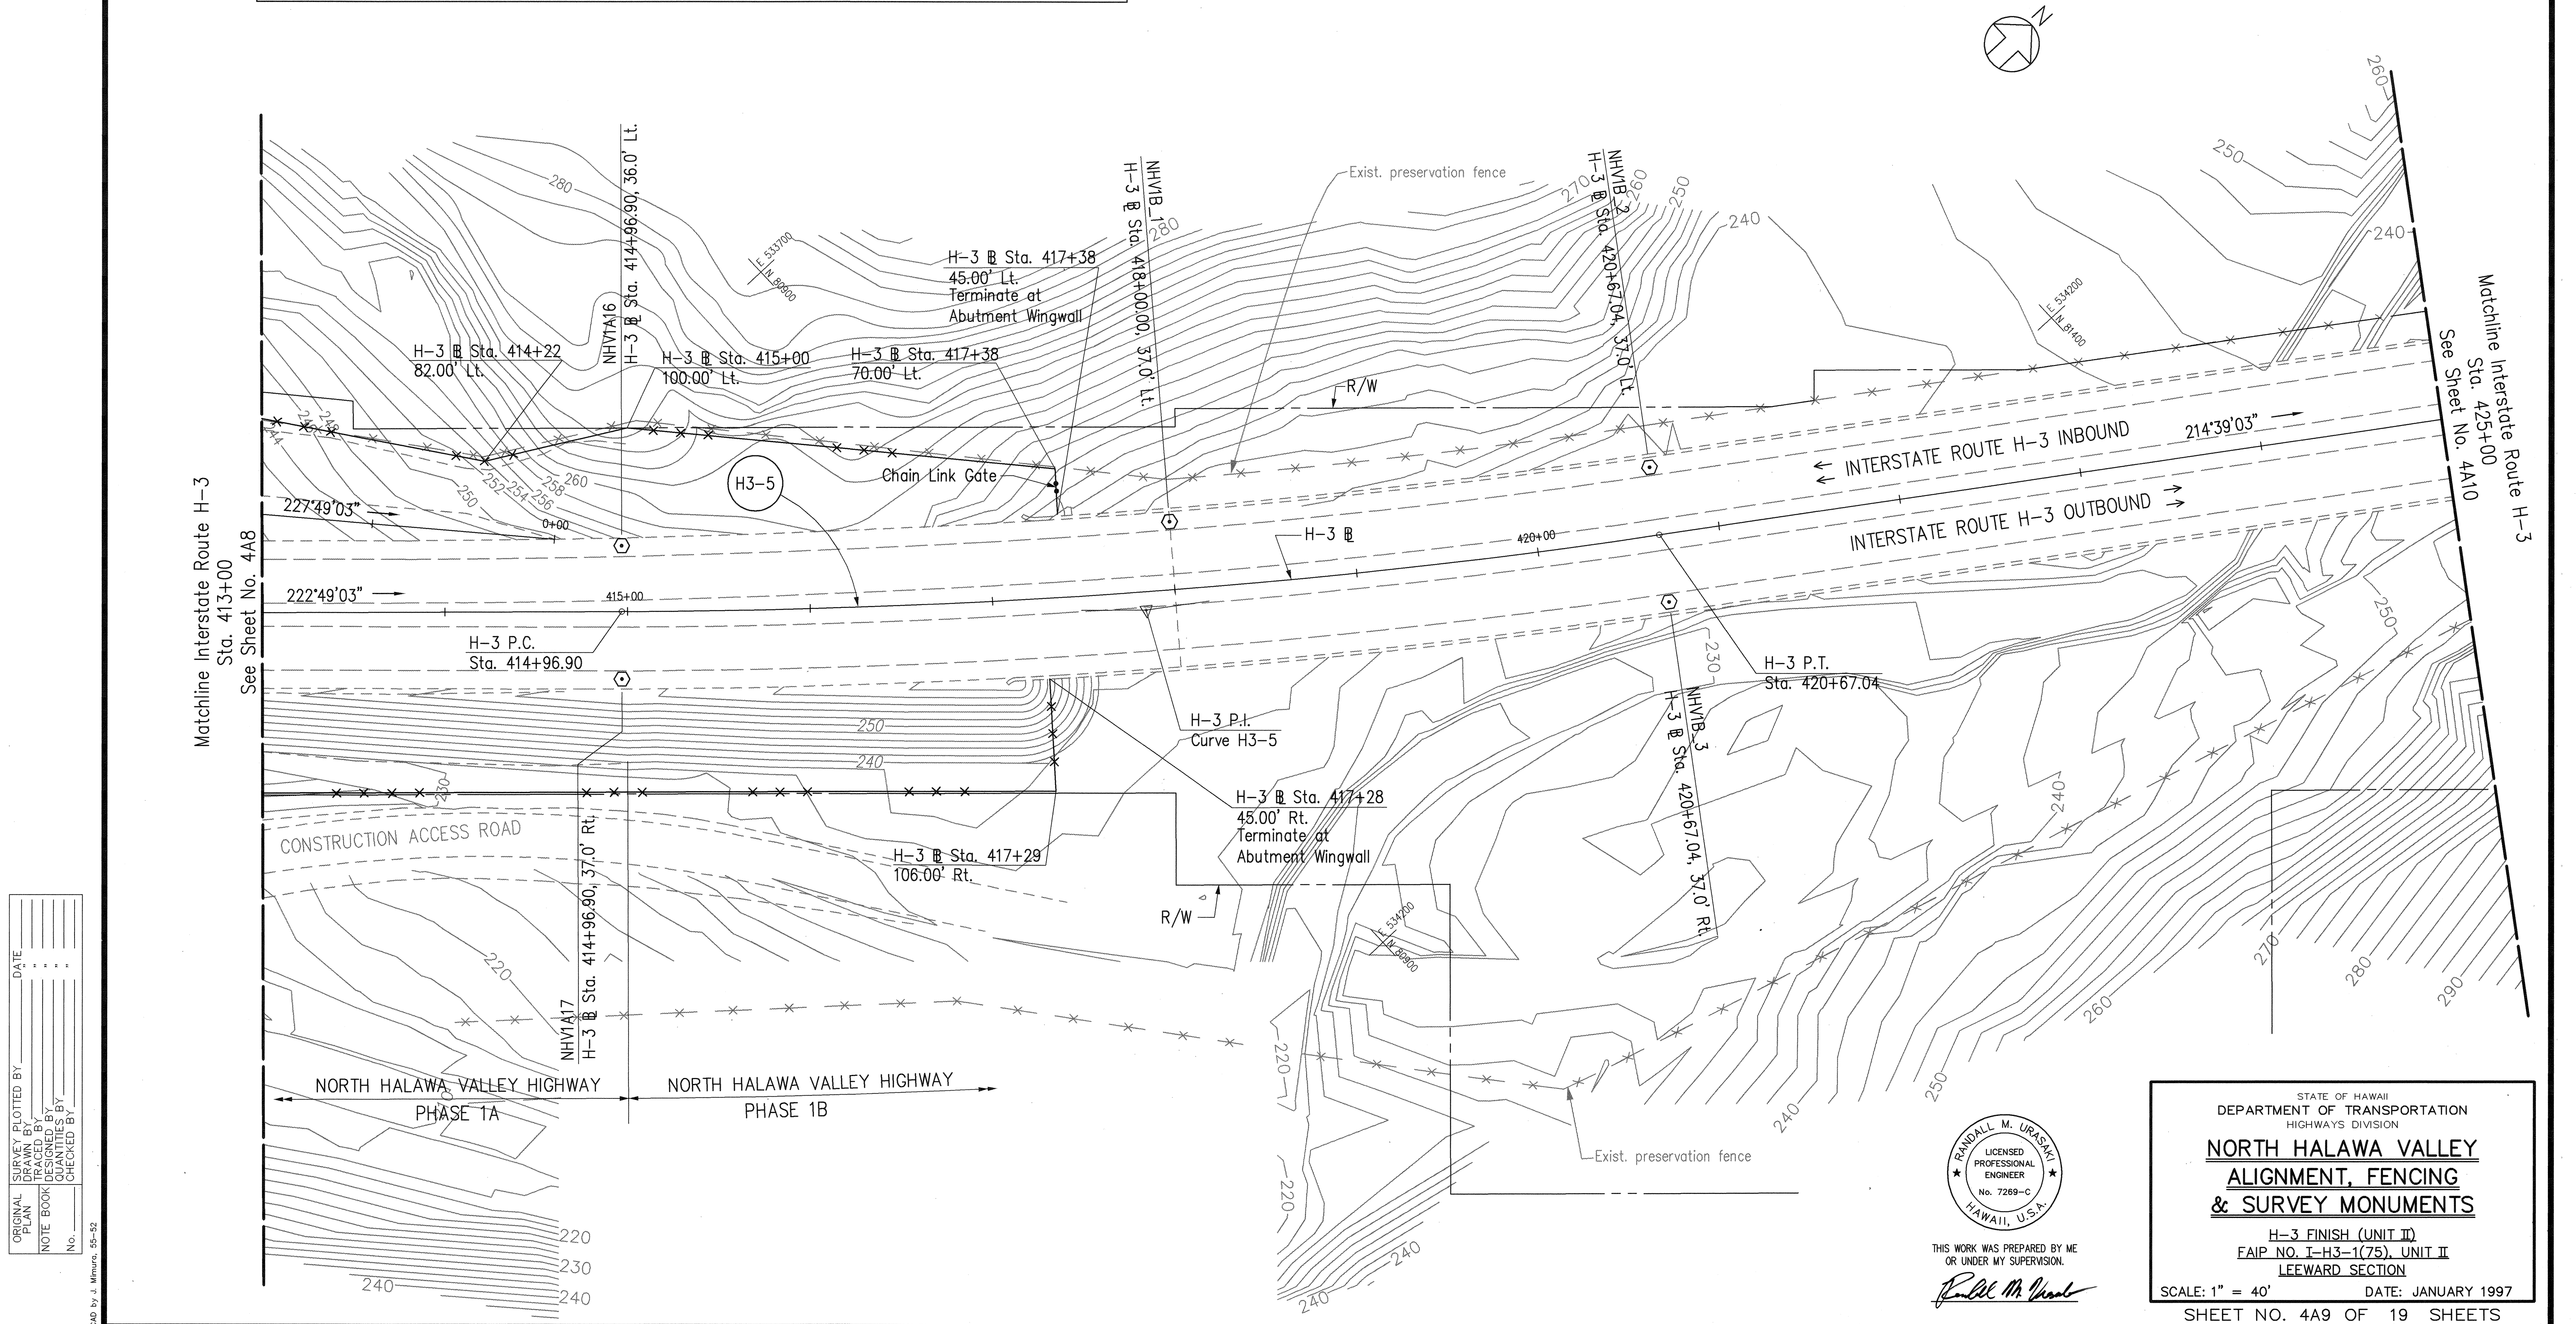

SURVEY PLOTTED BY	DATE
DESIGNED BY	
TRACED BY	
NOTE BOOK	
QUANTITIES BY	
CHECKED BY	
No.	

CAD by J. Minura, 55-52

Last Saved: J:\H3RF\RFU2\ALIGN\H3ALI-09.dwg 02/12/97 at 11:42

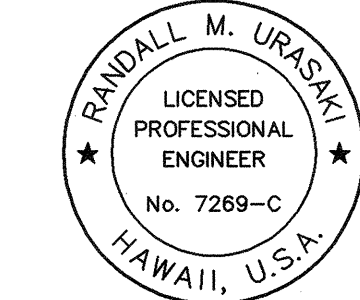


THIS WORK WAS PREPARED BY ME
OR UNDER MY SUPERVISION.

Randall M. Urasaki

STATE OF HAWAII
DEPARTMENT OF TRANSPORTATION
HIGHWAYS DIVISION
NORTH HALAWA VALLEY
ALIGNMENT, FENCING
& SURVEY MONUMENTS
H-3 FINISH (UNIT II)
FAIP NO. I-H3-1(75), UNIT II
LEEWARD SECTION


SCALE: 1" = 40'
DATE: JANUARY 1997
SHEET NO. 4A9 OF 19 SHEETS

FED. ROAD DIST. NO.	STATE	FED. AID PROJ. NO.	FISCAL YEAR	SHEET NO.	TOTAL SHEETS
HAWAII	HAW.	I-H3-1(75), UNIT II	1997	786	1102

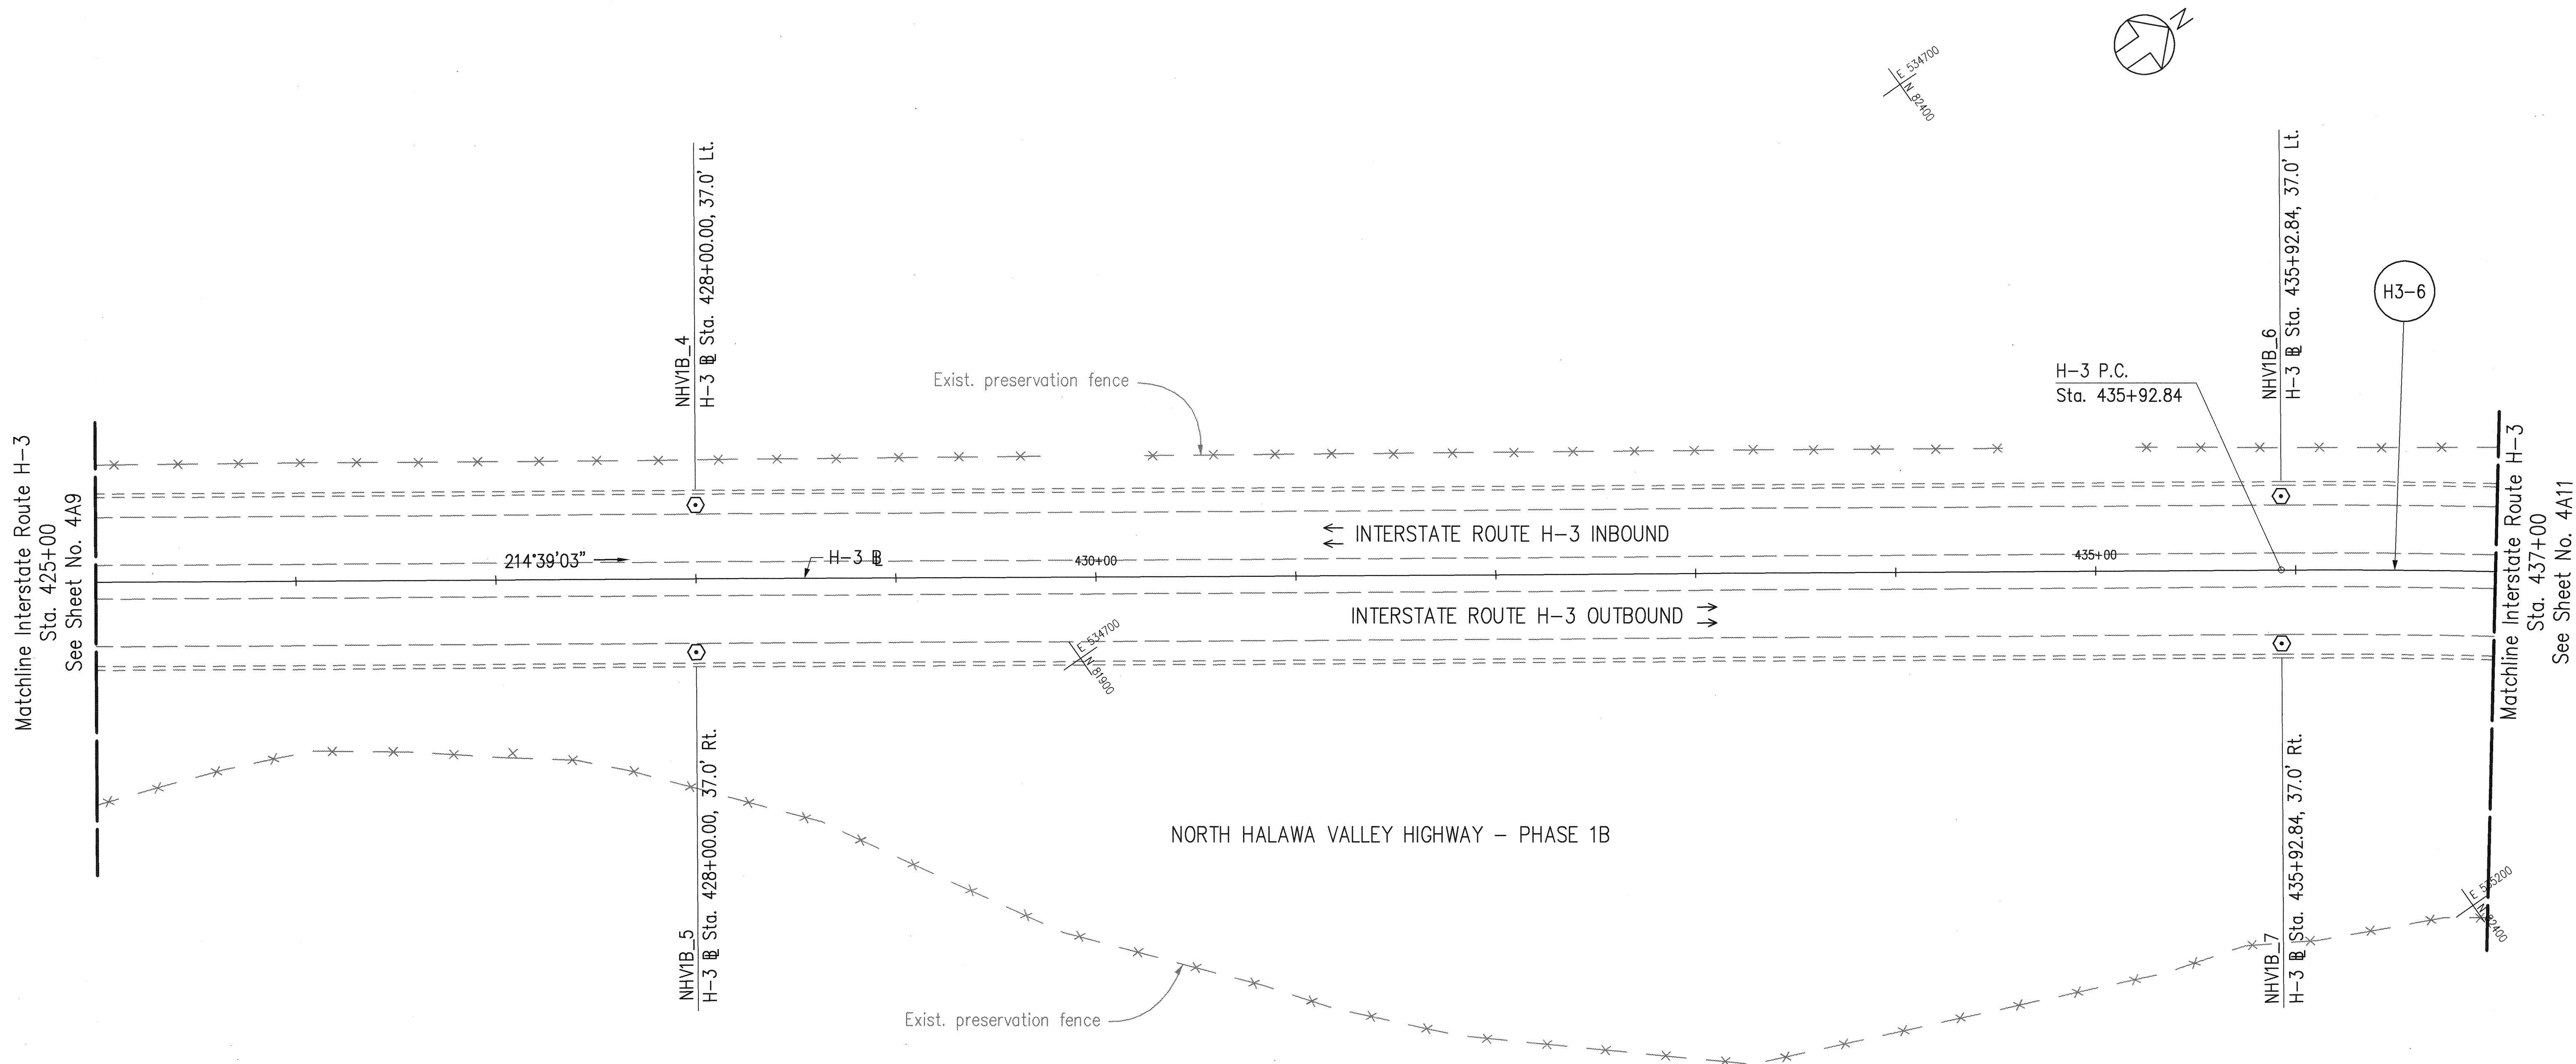

ORIGINAL PLAN	SURVEY PLOTTED BY	DATE
NOTE BOOK	DESIGNED BY	
	QUANTITIES BY	
	CHECKED BY	
No. _____		

CURVE	RADIUS	LENGTH	TANGENT	CHORD	DELTA	COORDINATES OF POINT OF INTERSECTION OF TANGENTS	
H3-6	3800.00'	1793.29'	913.66'	1776.70'	27°02'20"	N 83169.11	E 535527.32

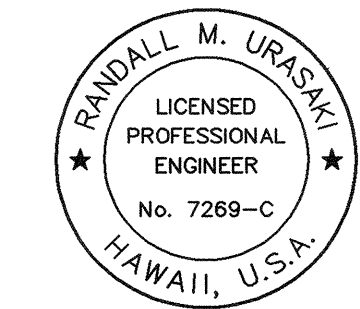

THIS WORK WAS PREPARED BY ME
OR UNDER MY SUPERVISION.

Randall M. Uraski



STATE OF HAWAII
DEPARTMENT OF TRANSPORTATION
HIGHWAYS DIVISION

**NORTH HALAWA VALLEY
ALIGNMENT, FENCING
& SURVEY MONUMENTS**

H-3 FINISH (UNIT II)
FAIP NO. I-H3-1(75), UNIT II
LEEWARD SECTION


SCALE: 1" = 40'
DATE: JANUARY 1997

FED. ROAD DIST. NO.	STATE	FED. AID PROJ. NO.	FISCAL YEAR	SHEET NO.	TOTAL SHEETS
HAWAII	HAW.	I-H3-1(75), UNIT II	1997	787	1102

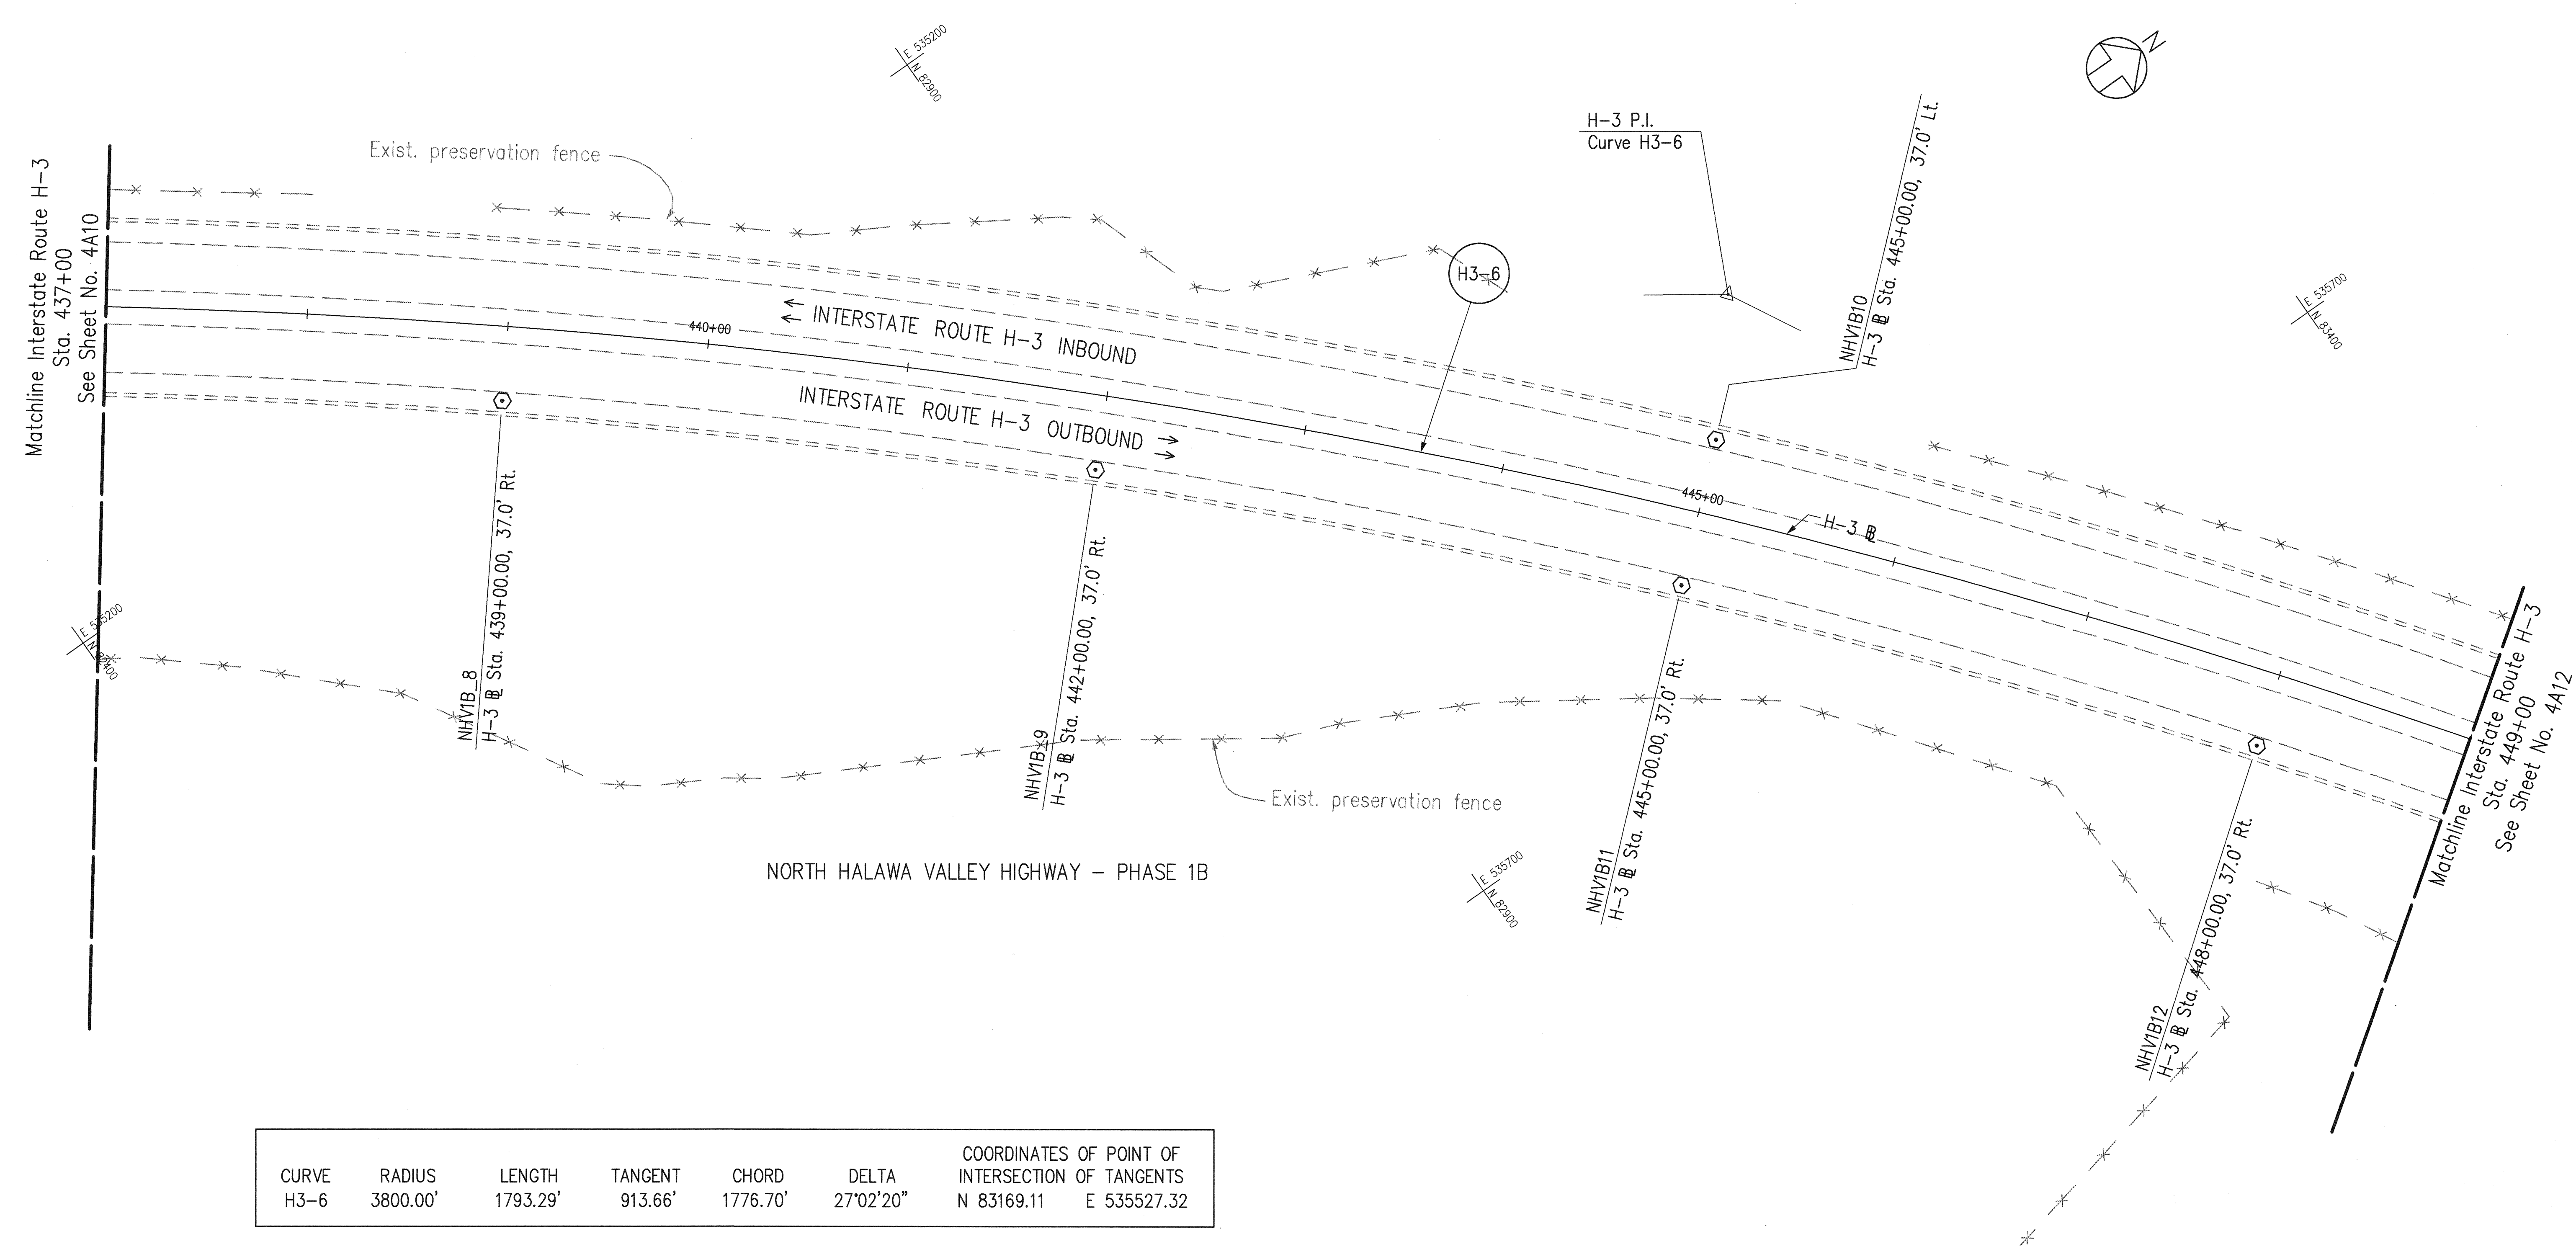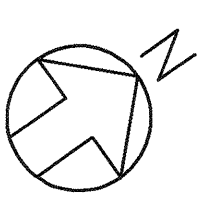

CURVE	RADIUS	LENGTH	TANGENT	CHORD	DELTA	COORDINATES OF POINT OF INTERSECTION OF TANGENTS	
H3-6	3800.00'	1793.29'	913.66'	1776.70'	27°02'20"	N 83169.11	E 535527.32

ORIGINAL PLAN	SURVEY PLOTTED BY	DATE
NOTE BOOK	DESIGNED BY	
QUANTITIES BY	CHECKED BY	
NO.		

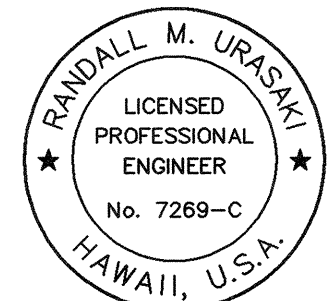

THIS WORK WAS PREPARED BY ME
OR UNDER MY SUPERVISION.
Randall M. Urasaki

STATE OF HAWAII
DEPARTMENT OF TRANSPORTATION
HIGHWAYS DIVISION


**NORTH HALAWA VALLEY
& SURVEY MONUMENTS**

H-3 FINISH (UNIT II)
FAIP NO. I-H3-1(75), UNIT II
LEEWARD SECTION

SCALE: 1" = 40' DATE: JANUARY 1997


SHEET NO. 4A11 OF 19 SHEETS

FED. ROAD DIST. NO.	STATE	FED. AID PROJ. NO.	FISCAL YEAR	SHEET NO.	TOTAL SHEETS
HAWAII	HAW.	I-H3-1(75), UNIT II	1997	788	1102

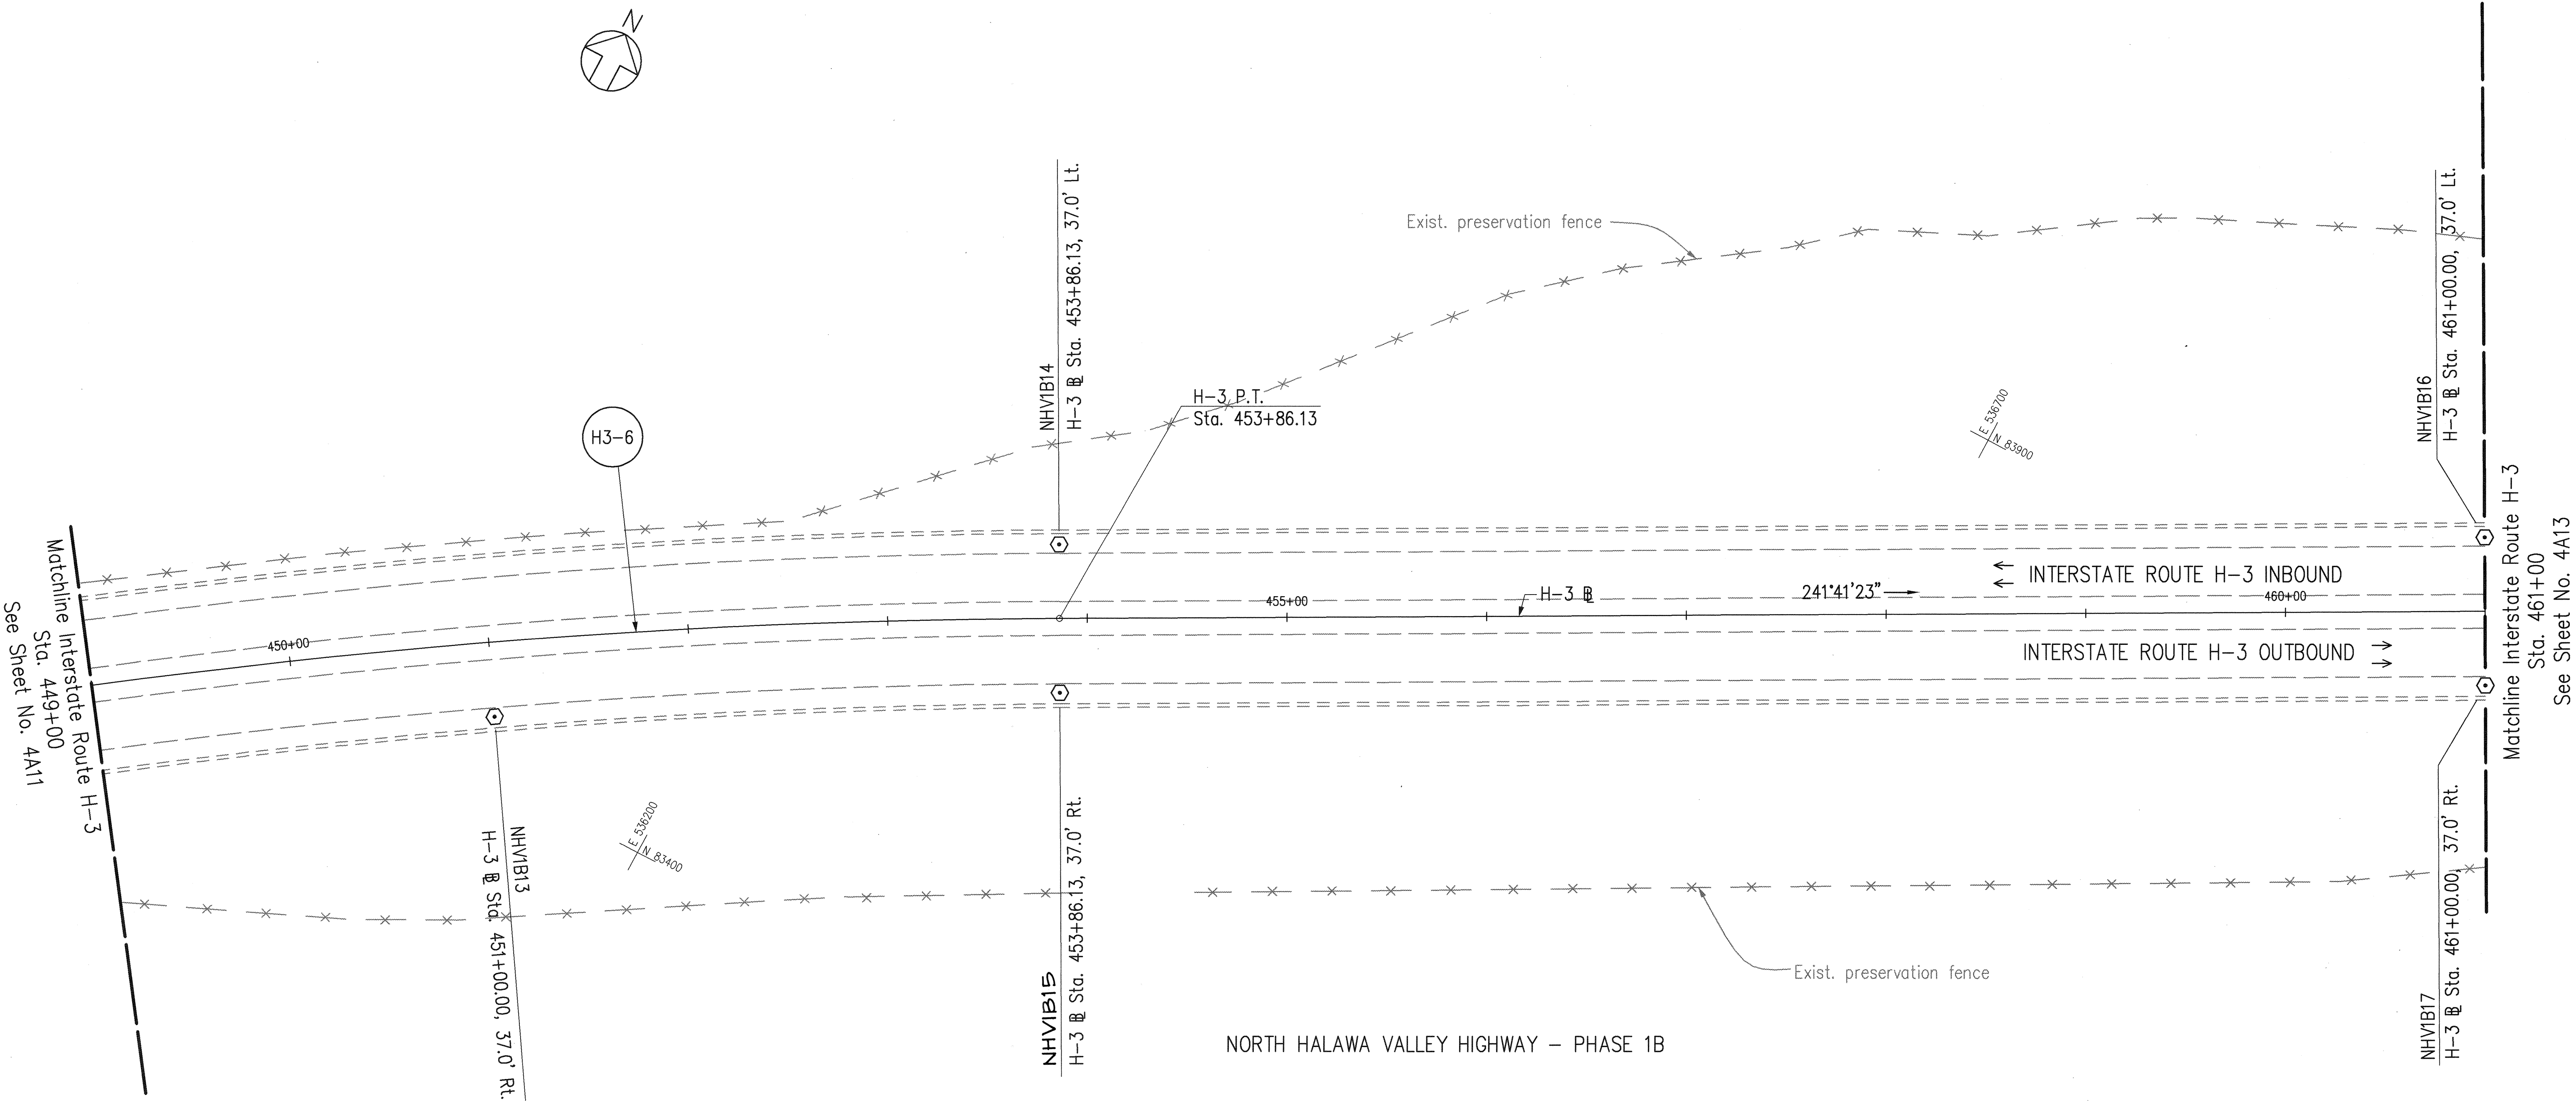

CURVE	RADIUS	LENGTH	TANGENT	CHORD	DELTA	COORDINATES OF POINT OF INTERSECTION OF TANGENTS	
H3-6	3800.00'	1793.29'	913.66'	1776.70'	27°02'20"	N 83169.11	E 535527.32

ORIGINAL PLAN	SURVEY PLOTTED BY	DATE
NOTE BOOK	DESIGNED BY	
QUANTITIES BY	CHECKED BY	
No.		

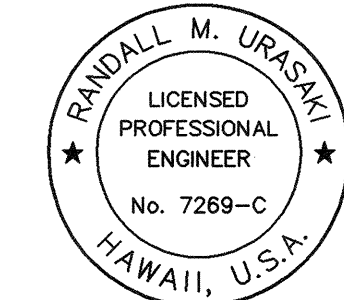

THIS WORK WAS PREPARED BY ME
OR UNDER MY SUPERVISION.

Randall M. Urasaki

STATE OF HAWAII
DEPARTMENT OF TRANSPORTATION
HIGHWAYS DIVISION


**NORTH HALAWA VALLEY
& SURVEY MONUMENTS**

H-3 FINISH (UNIT II)
FAIP NO. I-H3-1(75), UNIT II
LEEWARD SECTION

SCALE: 1" = 40'
DATE: JANUARY 1997

FED. ROAD DIST. NO.	STATE	FED. AID PROJ. NO.	FISCAL YEAR	SHEET NO.	TOTAL SHEETS
HAWAII	HAW.	I-H3-1(75), UNIT II	1997	789	1102


Matchline Interstate Route H-3
Sta. 461+00
See Sheet No. 4A12

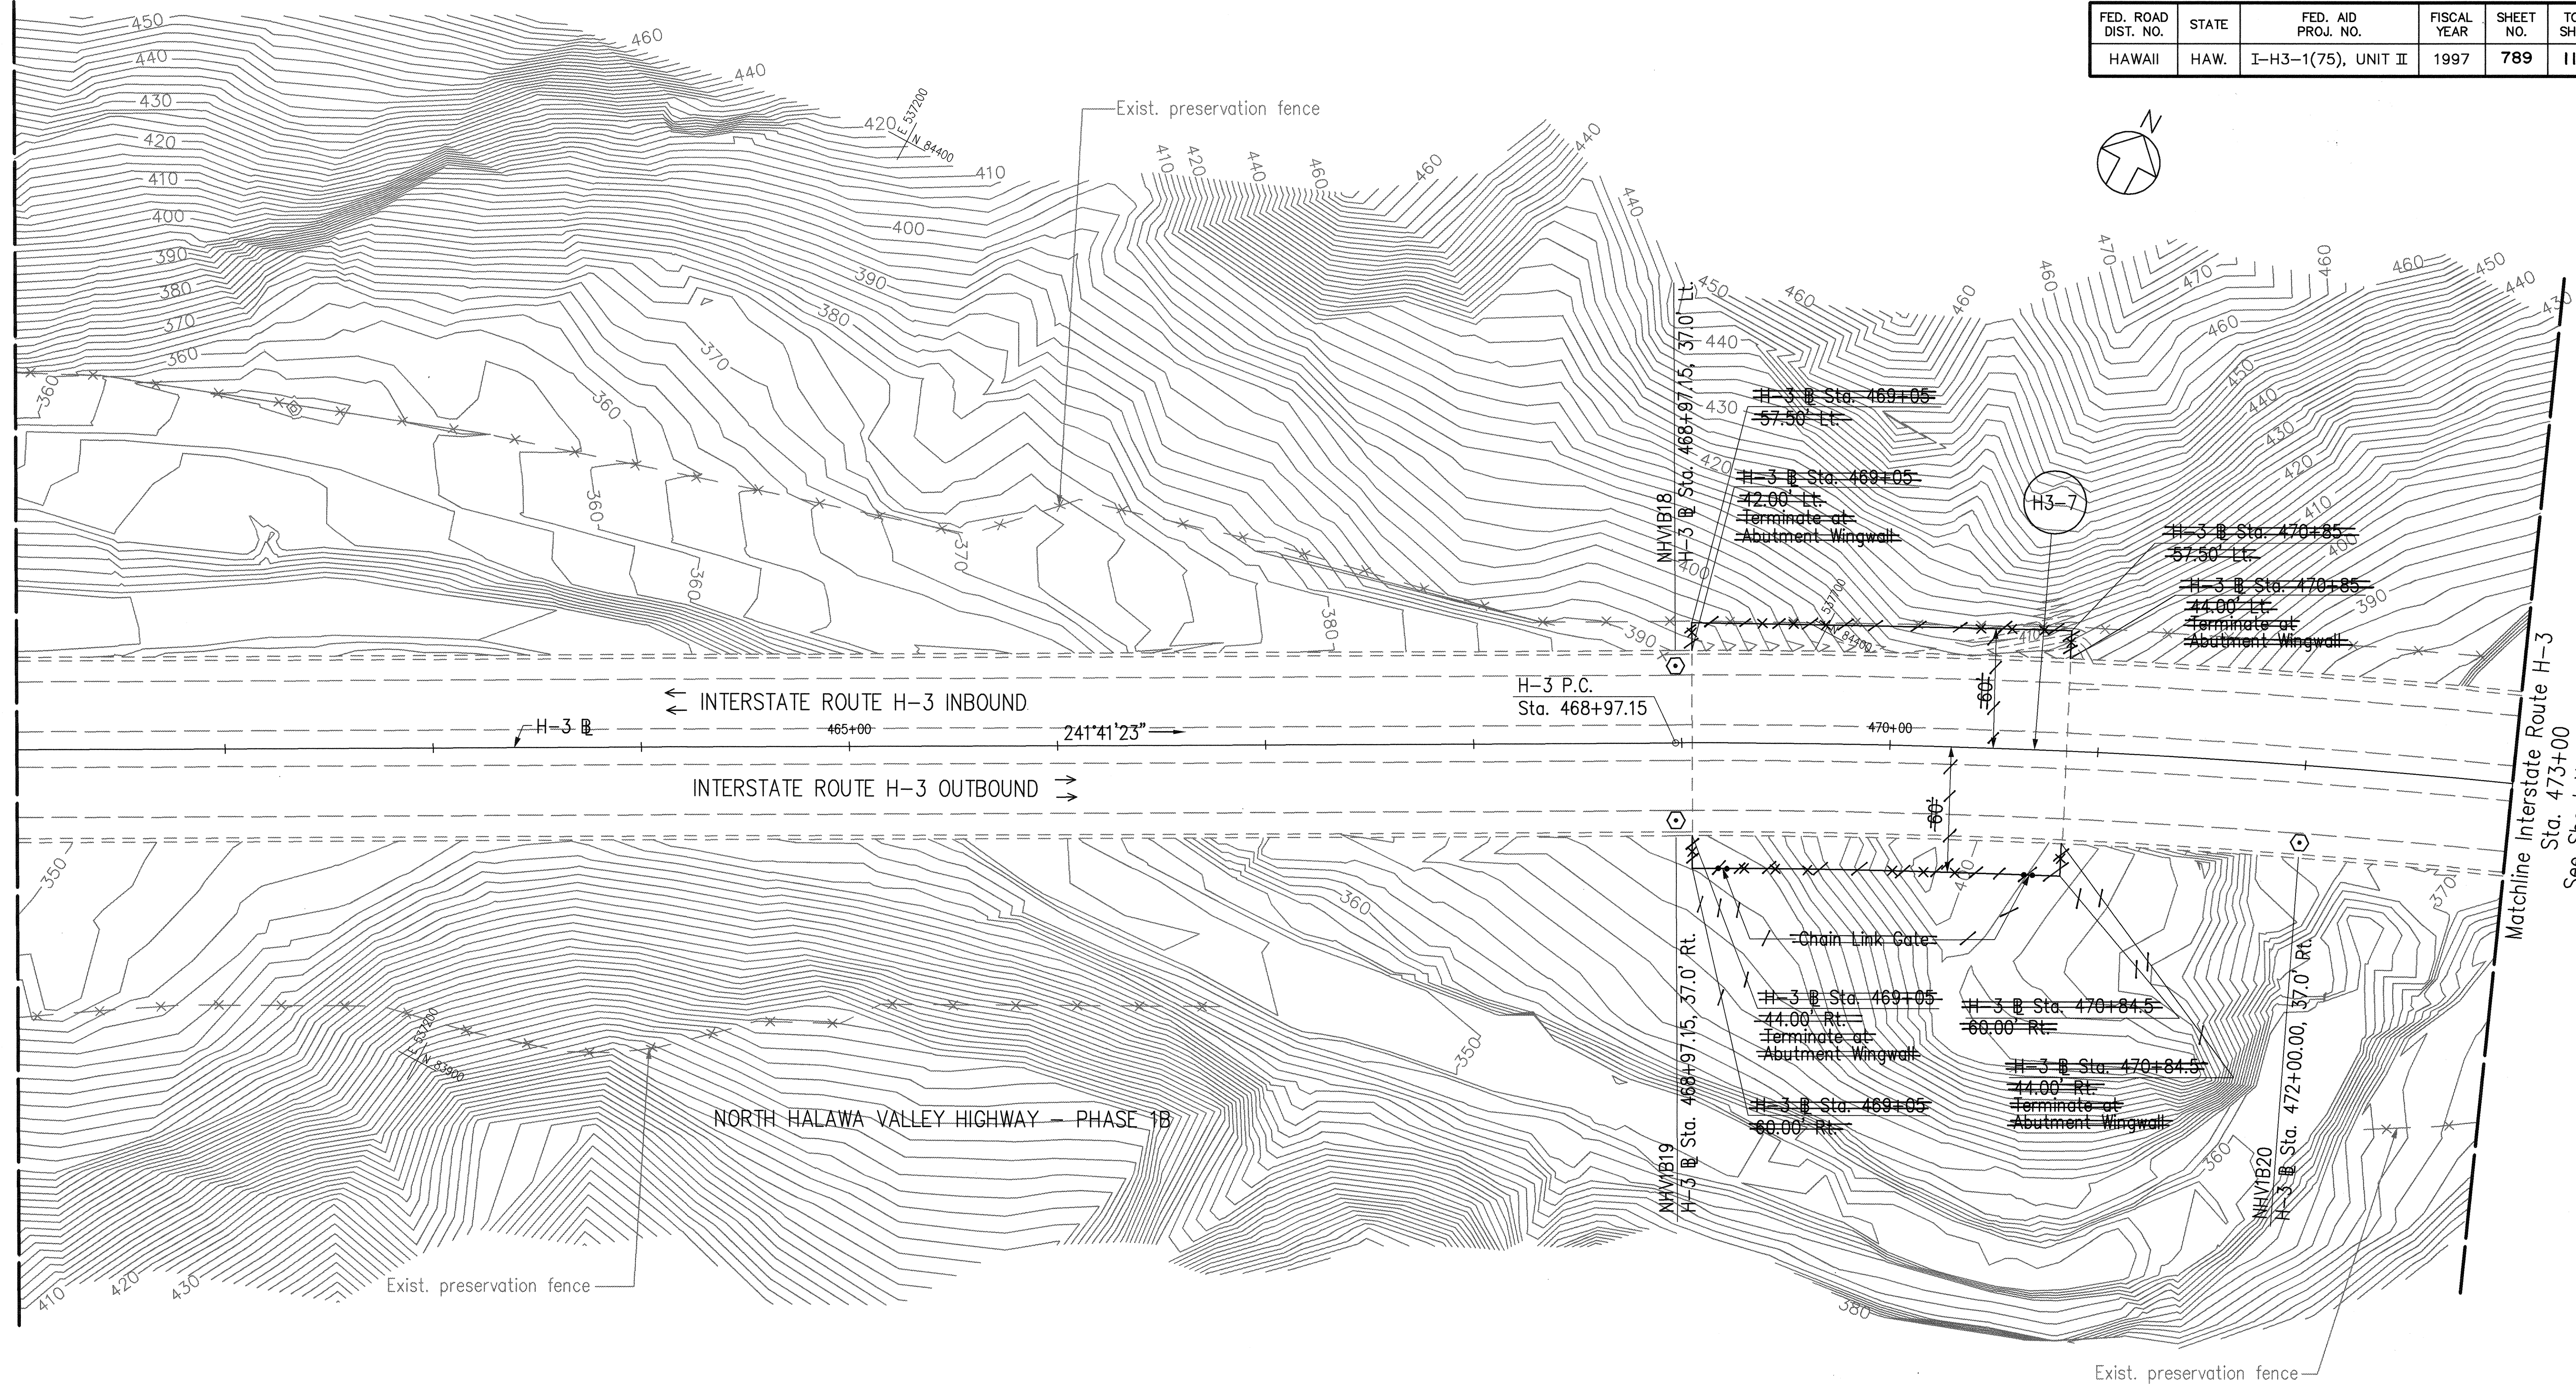

ORIGINAL PLAN	SURVEY PLOTTED BY	DATE
NOTE BOOK	DESIGNED BY	
No.	CHECKED BY	

CAD by J. Minors, 55-52

Last Saved: J:\H3RF\RFU2\ALIGN\H3ALI-13.dwg 02/12/97 at 12:17

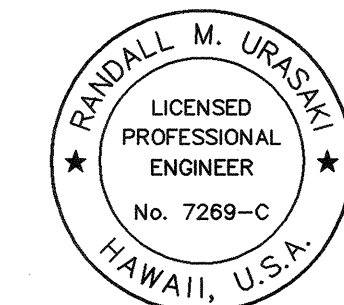

THIS WORK WAS PREPARED BY ME
OR UNDER MY SUPERVISION.

Randall M. Urasky

STATE OF HAWAII
DEPARTMENT OF TRANSPORTATION
HIGHWAYS DIVISION


**NORTH HALAWA VALLEY
ALIGNMENT, FENCING
& SURVEY MONUMENTS**

H-3 FINISH (UNIT II)
FAIP NO. I-H3-1(75), UNIT II
LEEWARD SECTION


SCALE: 1" = 40' DATE: JANUARY 1997

SHEET NO. 4A13 OF 19 SHEETS

FED. ROAD DIST. NO.	STATE	FED. AID PROJ. NO.	FISCAL YEAR	SHEET NO.	TOTAL SHEETS
HAWAII	HAW.	I-H3-1(75), UNIT II	1997	790	1102

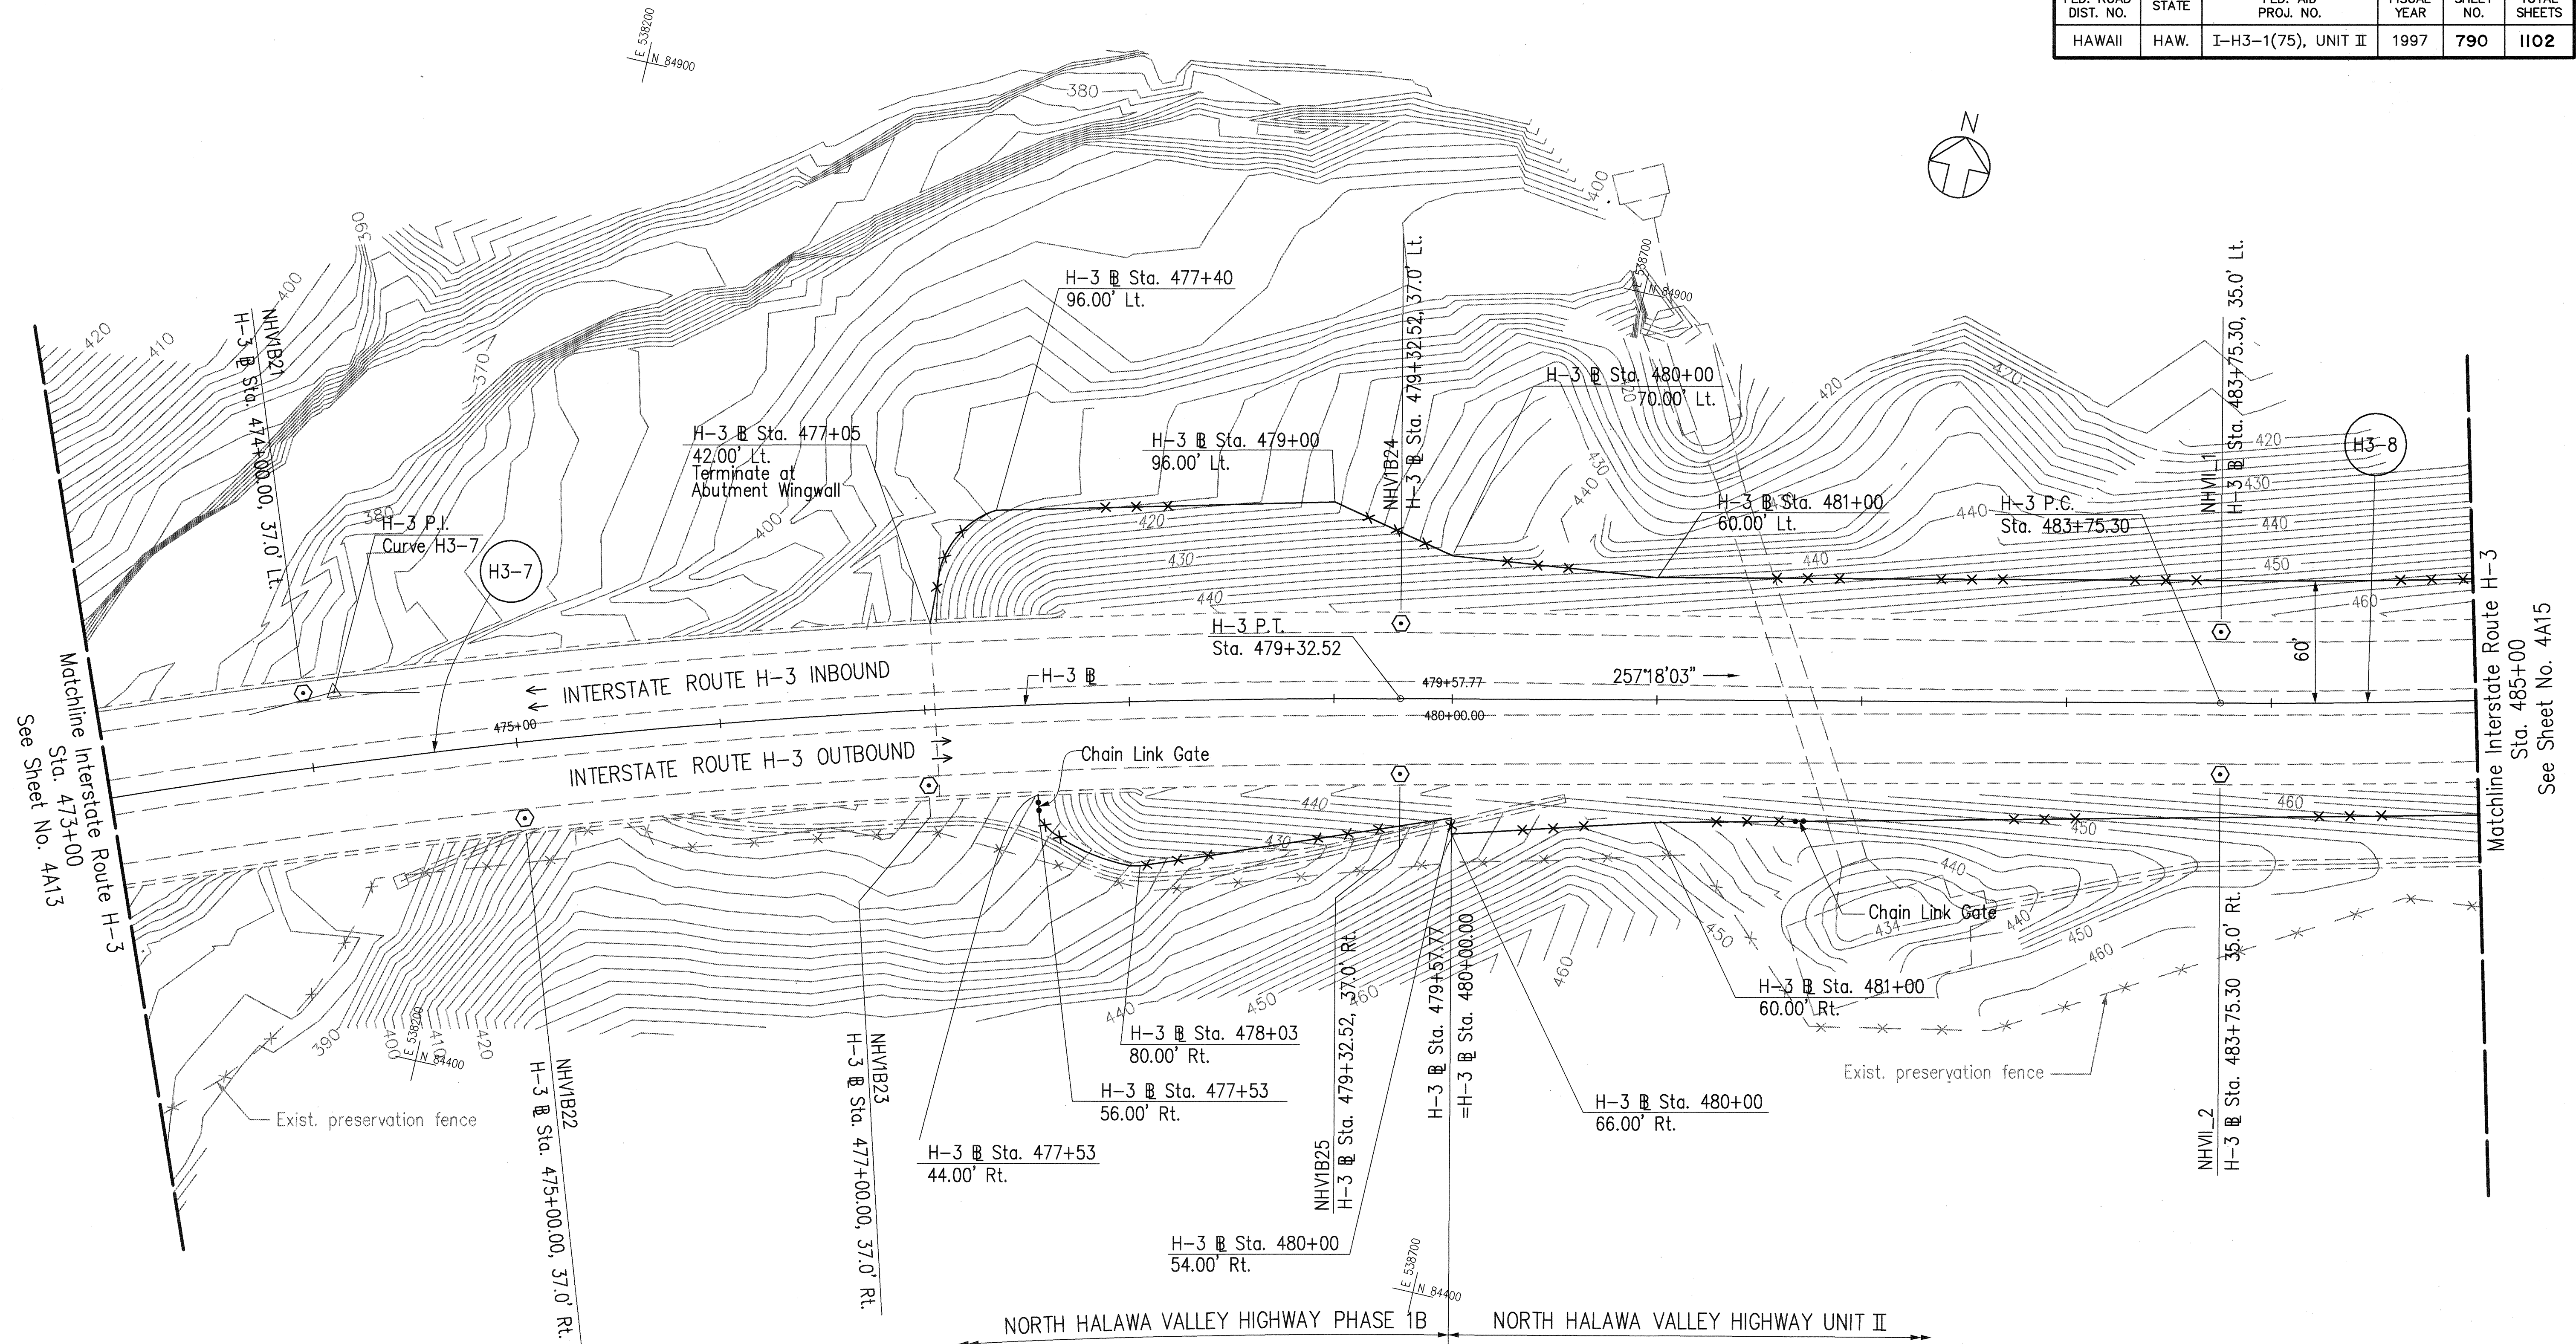

CURVE	RADIUS	LENGTH	TANGENT	CHORD	DELTA	COORDINATES OF POINT OF INTERSECTION OF TANGENTS	
H3-7	3800.00'	1035.37'	520.91'	1032.17'	15°36'40"	N 84566.05	E 538120.60
H3-8	4000.00'	2199.17'	1128.15'	2171.58'	31°30'03"	N 85016.62	E 540120.07

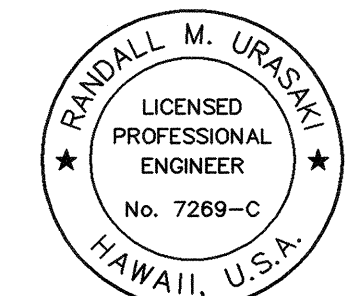

THIS WORK WAS PREPARED BY ME
OR UNDER MY SUPERVISION.

Randall M. Uraski

STATE OF HAWAII
DEPARTMENT OF TRANSPORTATION
HIGHWAYS DIVISION


**NORTH HALAWA VALLEY
ALIGNMENT, FENCING
& SURVEY MONUMENTS**

H-3 FINISH (UNIT II)
FAIP NO. I-H3-1(75), UNIT II
LEEWARD SECTION

SCALE: 1" = 40' DATE: JANUARY 1997

SHEET NO. 4A14 OF 19 SHEETS

FED. ROAD DIST. NO.	STATE	FED. AID PROJ. NO.	FISCAL YEAR	SHEET NO.	TOTAL SHEETS
HAWAII	HAW.	I-H3-1(75), UNIT II	1997	791	1102

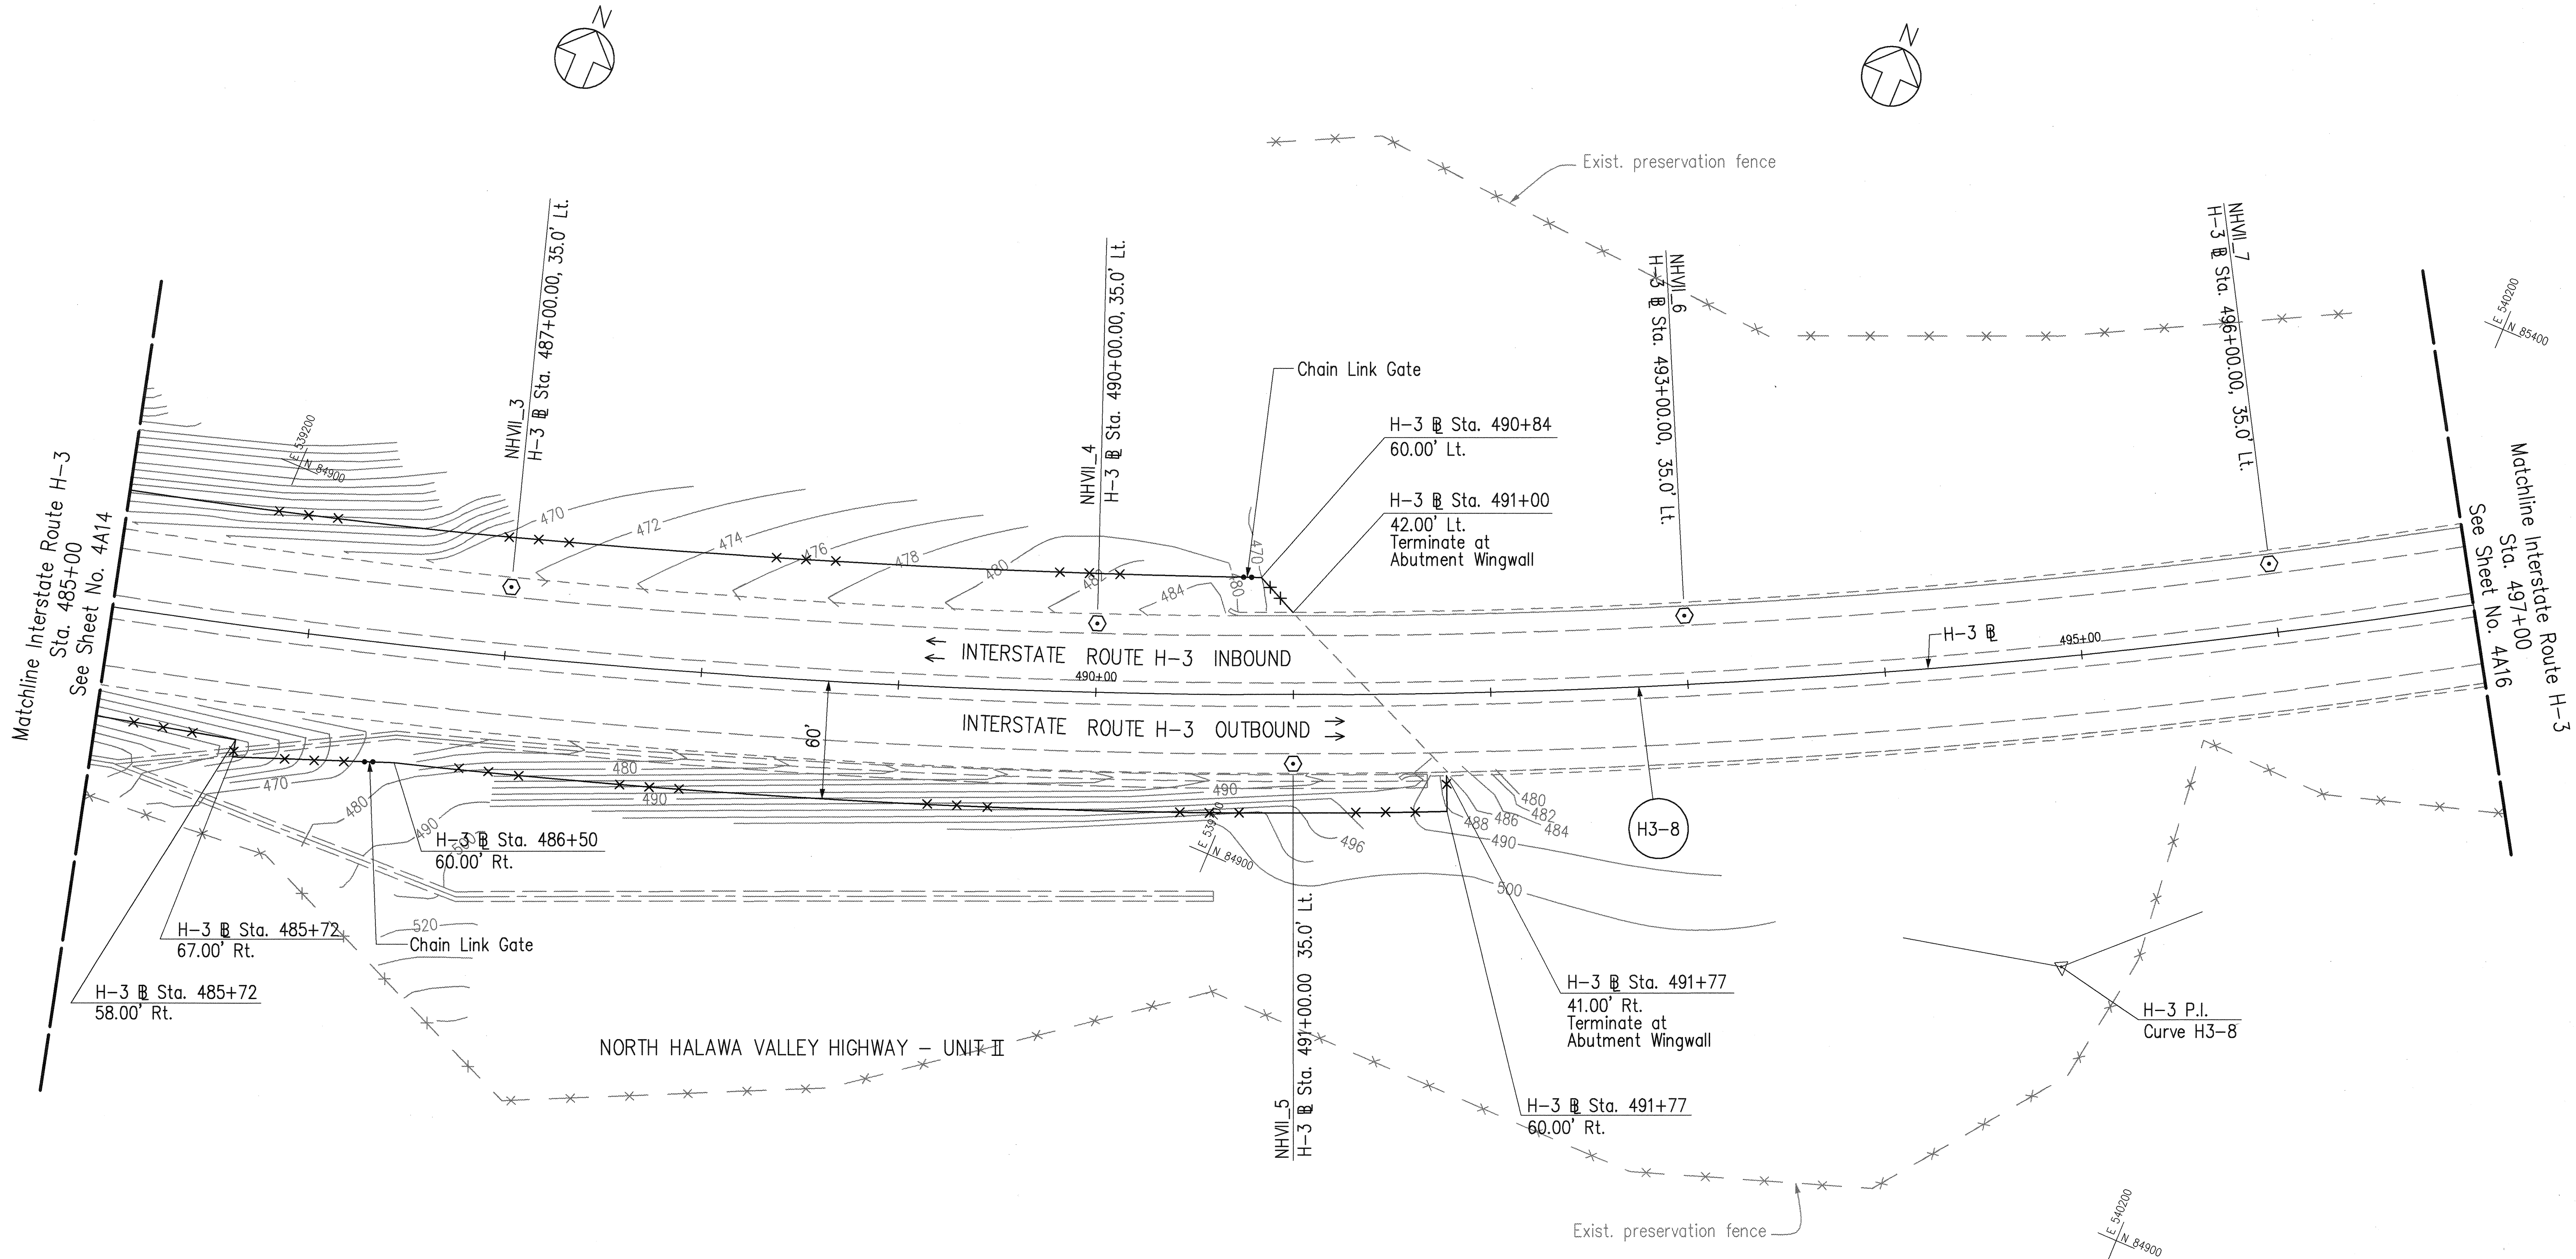


CURVE	RADIUS	LENGTH	TANGENT	CHORD	DELTA	COORDINATES OF POINT OF INTERSECTION OF TANGENTS	
H3-8	4000.00'	2199.17'	1128.15'	2171.58'	31°30'03"	N 85016.62	E 540120.07

ORIGINAL PLAN	SURVEY PLOTTED BY	DATE
NOTE BOOK	DESIGNED BY	
QUANTITIES BY	CHECKED BY	
No.		

CAD by J. Minura, 05-02

Last Saved: J:\H3RF\RFU2\ALIGN\H3ALI-15.dwg 02/12/97 at 12:32

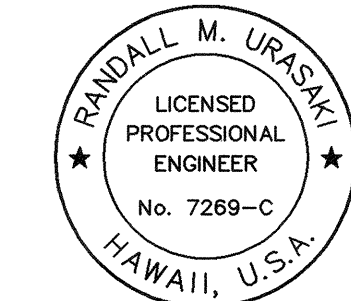



THIS WORK WAS PREPARED BY ME OR UNDER MY SUPERVISION.

Randall M. Uraski

STATE OF HAWAII
DEPARTMENT OF TRANSPORTATION
HIGHWAYS DIVISION
**NORTH HALAWA VALLEY
ALIGNMENT, FENCING
& SURVEY MONUMENTS**
H-3 FINISH (UNIT II)
FAIP NO. I-H3-1(75), UNIT II
LEEWARD SECTION
SCALE: 1" = 40' DATE: JANUARY 1997
SHEET NO. 4A15 OF 19 SHEETS

791


FED. ROAD DIST. NO.	STATE	FED. AID PROJ. NO.	FISCAL YEAR	SHEET NO.	TOTAL SHEETS
HAWAII	HAW.	I-H3-1(75), UNIT II	1997	792	1102

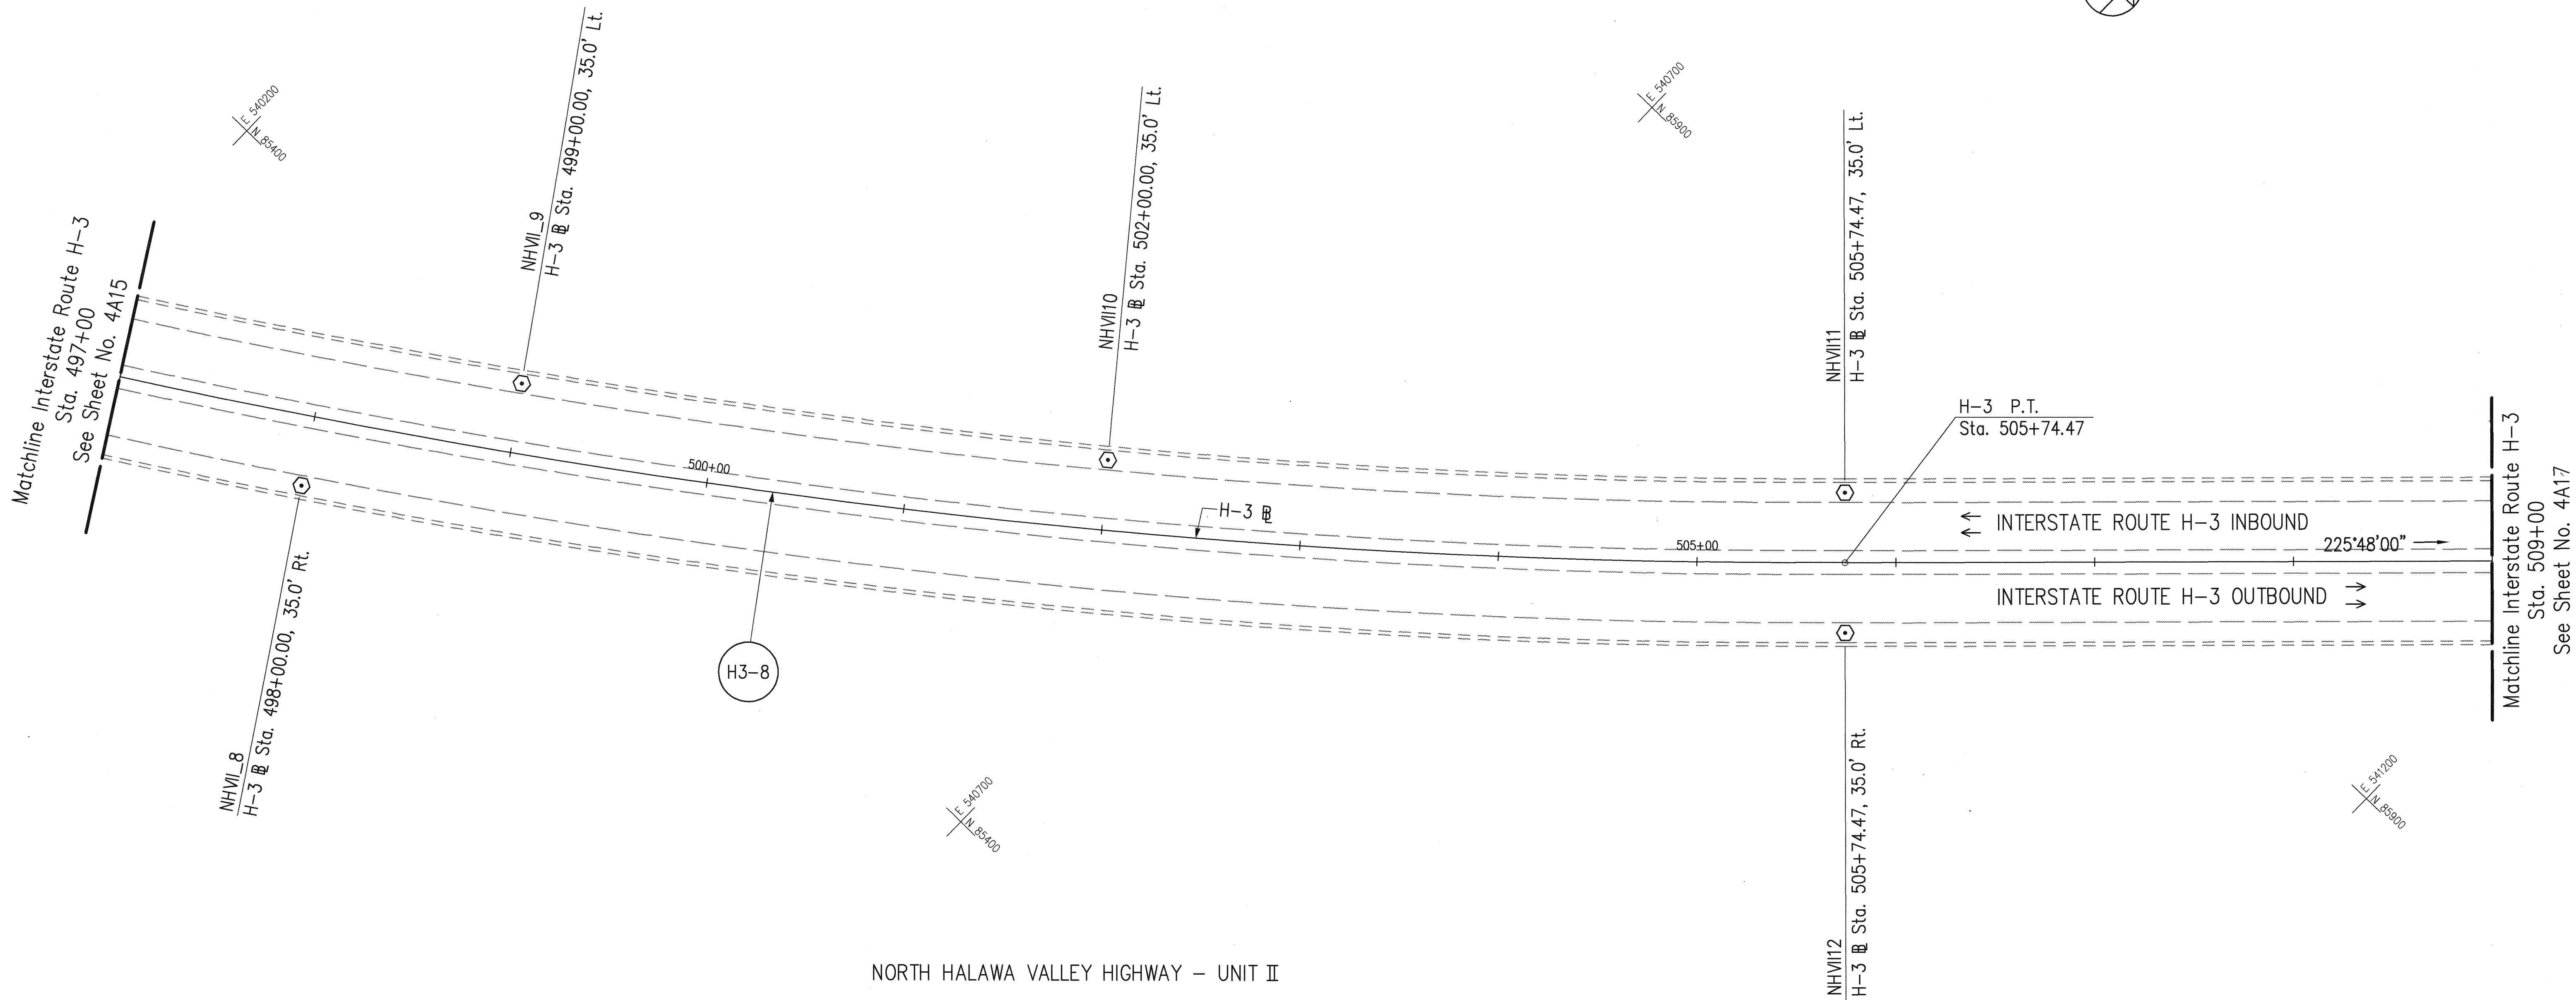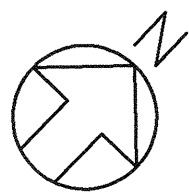

NORTH HALAWA VALLEY HIGHWAY - UNIT II

CURVE	RADIUS	LENGTH	TANGENT	CHORD	DELTA	COORDINATES OF POINT OF INTERSECTION OF TANGENTS
H3-8	4000.00'	2199.17'	1128.15'	2171.58'	31°30'03"	N 85016.62 E 540120.07

ORIGINAL PLAN	SURVEY PLOTTED BY	DATE
NOTE BOOK	DESIGNED BY	
QUANTITIES BY	CHECKED BY	
No.		

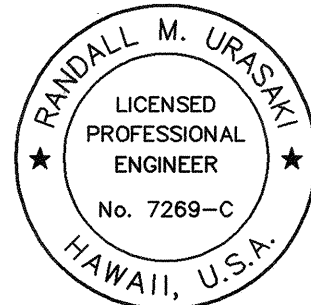

THIS WORK WAS PREPARED BY ME OR UNDER MY SUPERVISION.

Randall M. Urasaki

STATE OF HAWAII
DEPARTMENT OF TRANSPORTATION
HIGHWAYS DIVISION


**NORTH HALAWA VALLEY
ALIGNMENT, FENCING
& SURVEY MONUMENTS**

H-3 FINISH (UNIT II)
FAIP NO. I-H3-1(75), UNIT II
LEEWARD SECTION

SCALE: 1" = 40' DATE: JANUARY 1997

SHEET NO. 4A16 OF 19 SHEETS

FED. ROAD DIST. NO.	STATE	FED. AID PROJ. NO.	FISCAL YEAR	SHEET NO.	TOTAL SHEETS
HAWAII	HAW.	I-H3-1(75), UNIT II	1997	793	1102

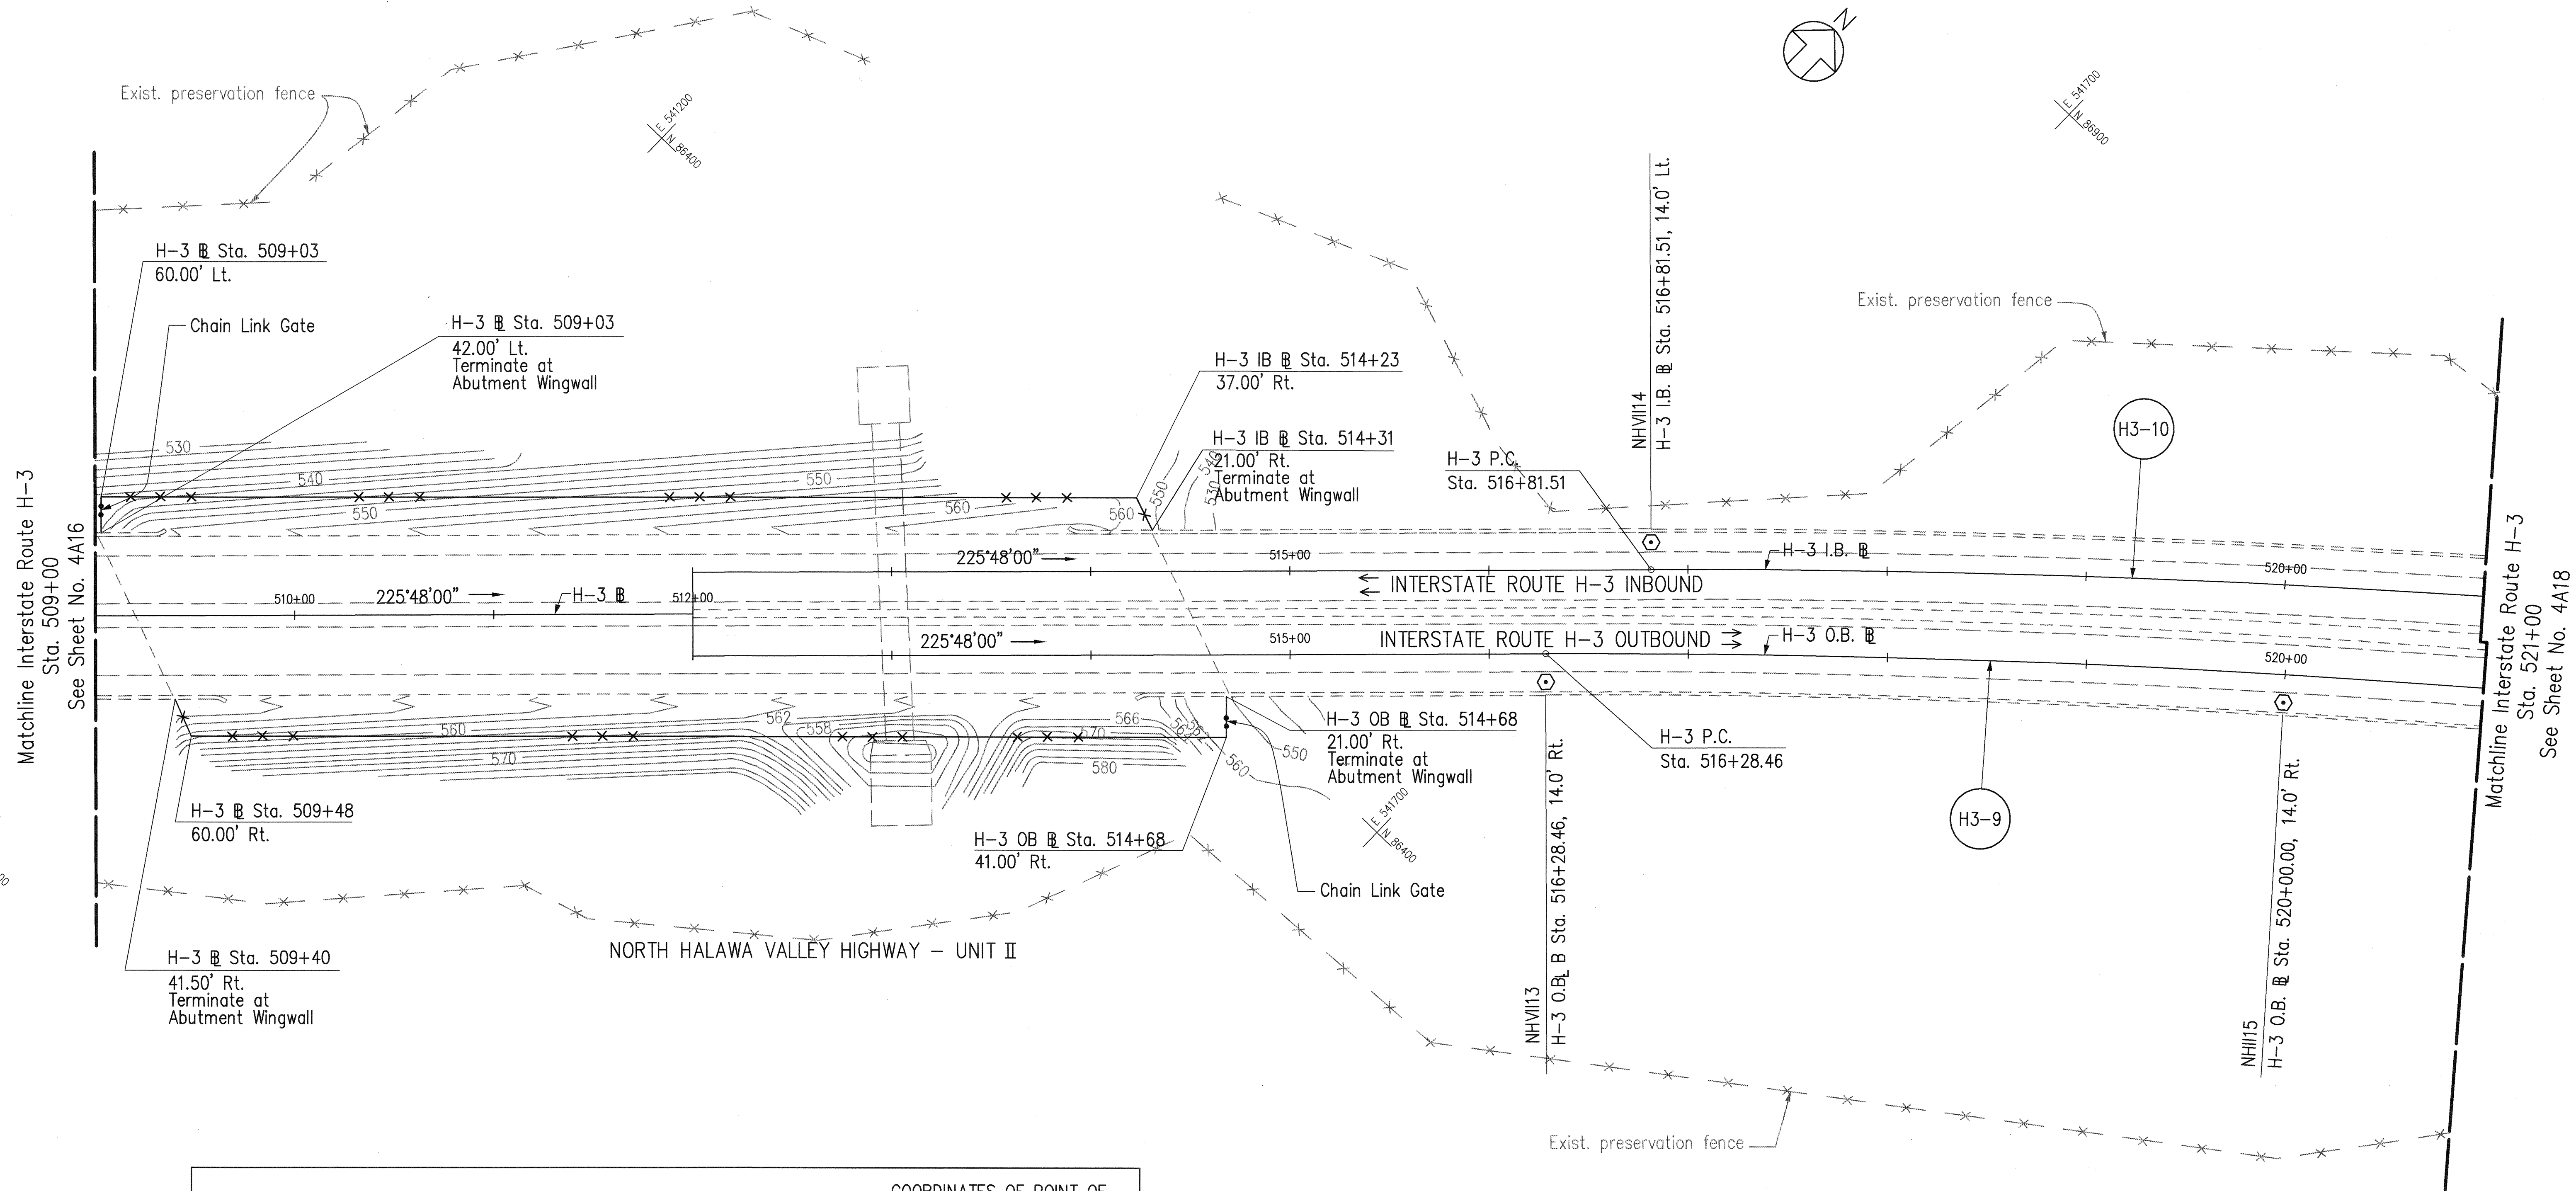


CURVE	RADIUS	LENGTH	TANGENT	CHORD	DELTA	COORDINATES OF POINT OF INTERSECTION OF TANGENTS	
H3-9	5962.28'	1871.44'	943.48'	1863.77'	17°59'02"	N 87180.63	E 542375.50
H3-10	5945.67'	1833.85'	924.26'	1826.59'	17°40'19"	N 87234.33	E 542370.47

ORIGINAL PLAN	DATE
DESIGNED BY	
NOTED BY	
CHECKED BY	
NO.	

CD by J. Minura, 55-52

Last Saved: J:\H3RF\RFU2\ALIGN\H3ALI-17.dwg 02/12/97 at 12:38

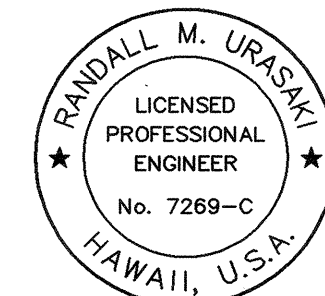

THIS WORK WAS PREPARED BY ME
OR UNDER MY SUPERVISION.

Randall M. Uraski

STATE OF HAWAII
DEPARTMENT OF TRANSPORTATION
HIGHWAYS DIVISION



**NORTH HALAWA VALLEY
ALIGNMENT, FENCING
& SURVEY MONUMENTS**

H-3 FINISH (UNIT II)
FAIP NO. I-H3-1(75), UNIT II
LEEWARD SECTION

SCALE: 1" = 40' DATE: JANUARY 1997

SHEET NO. 4A17 OF 19 SHEETS

FED. ROAD DIST. NO.	STATE	FED. AID PROJ. NO.	FISCAL YEAR	SHEET NO.	TOTAL SHEETS
HAWAII	HAW.	I-H3-1(75), UNIT II	1997	794	1102

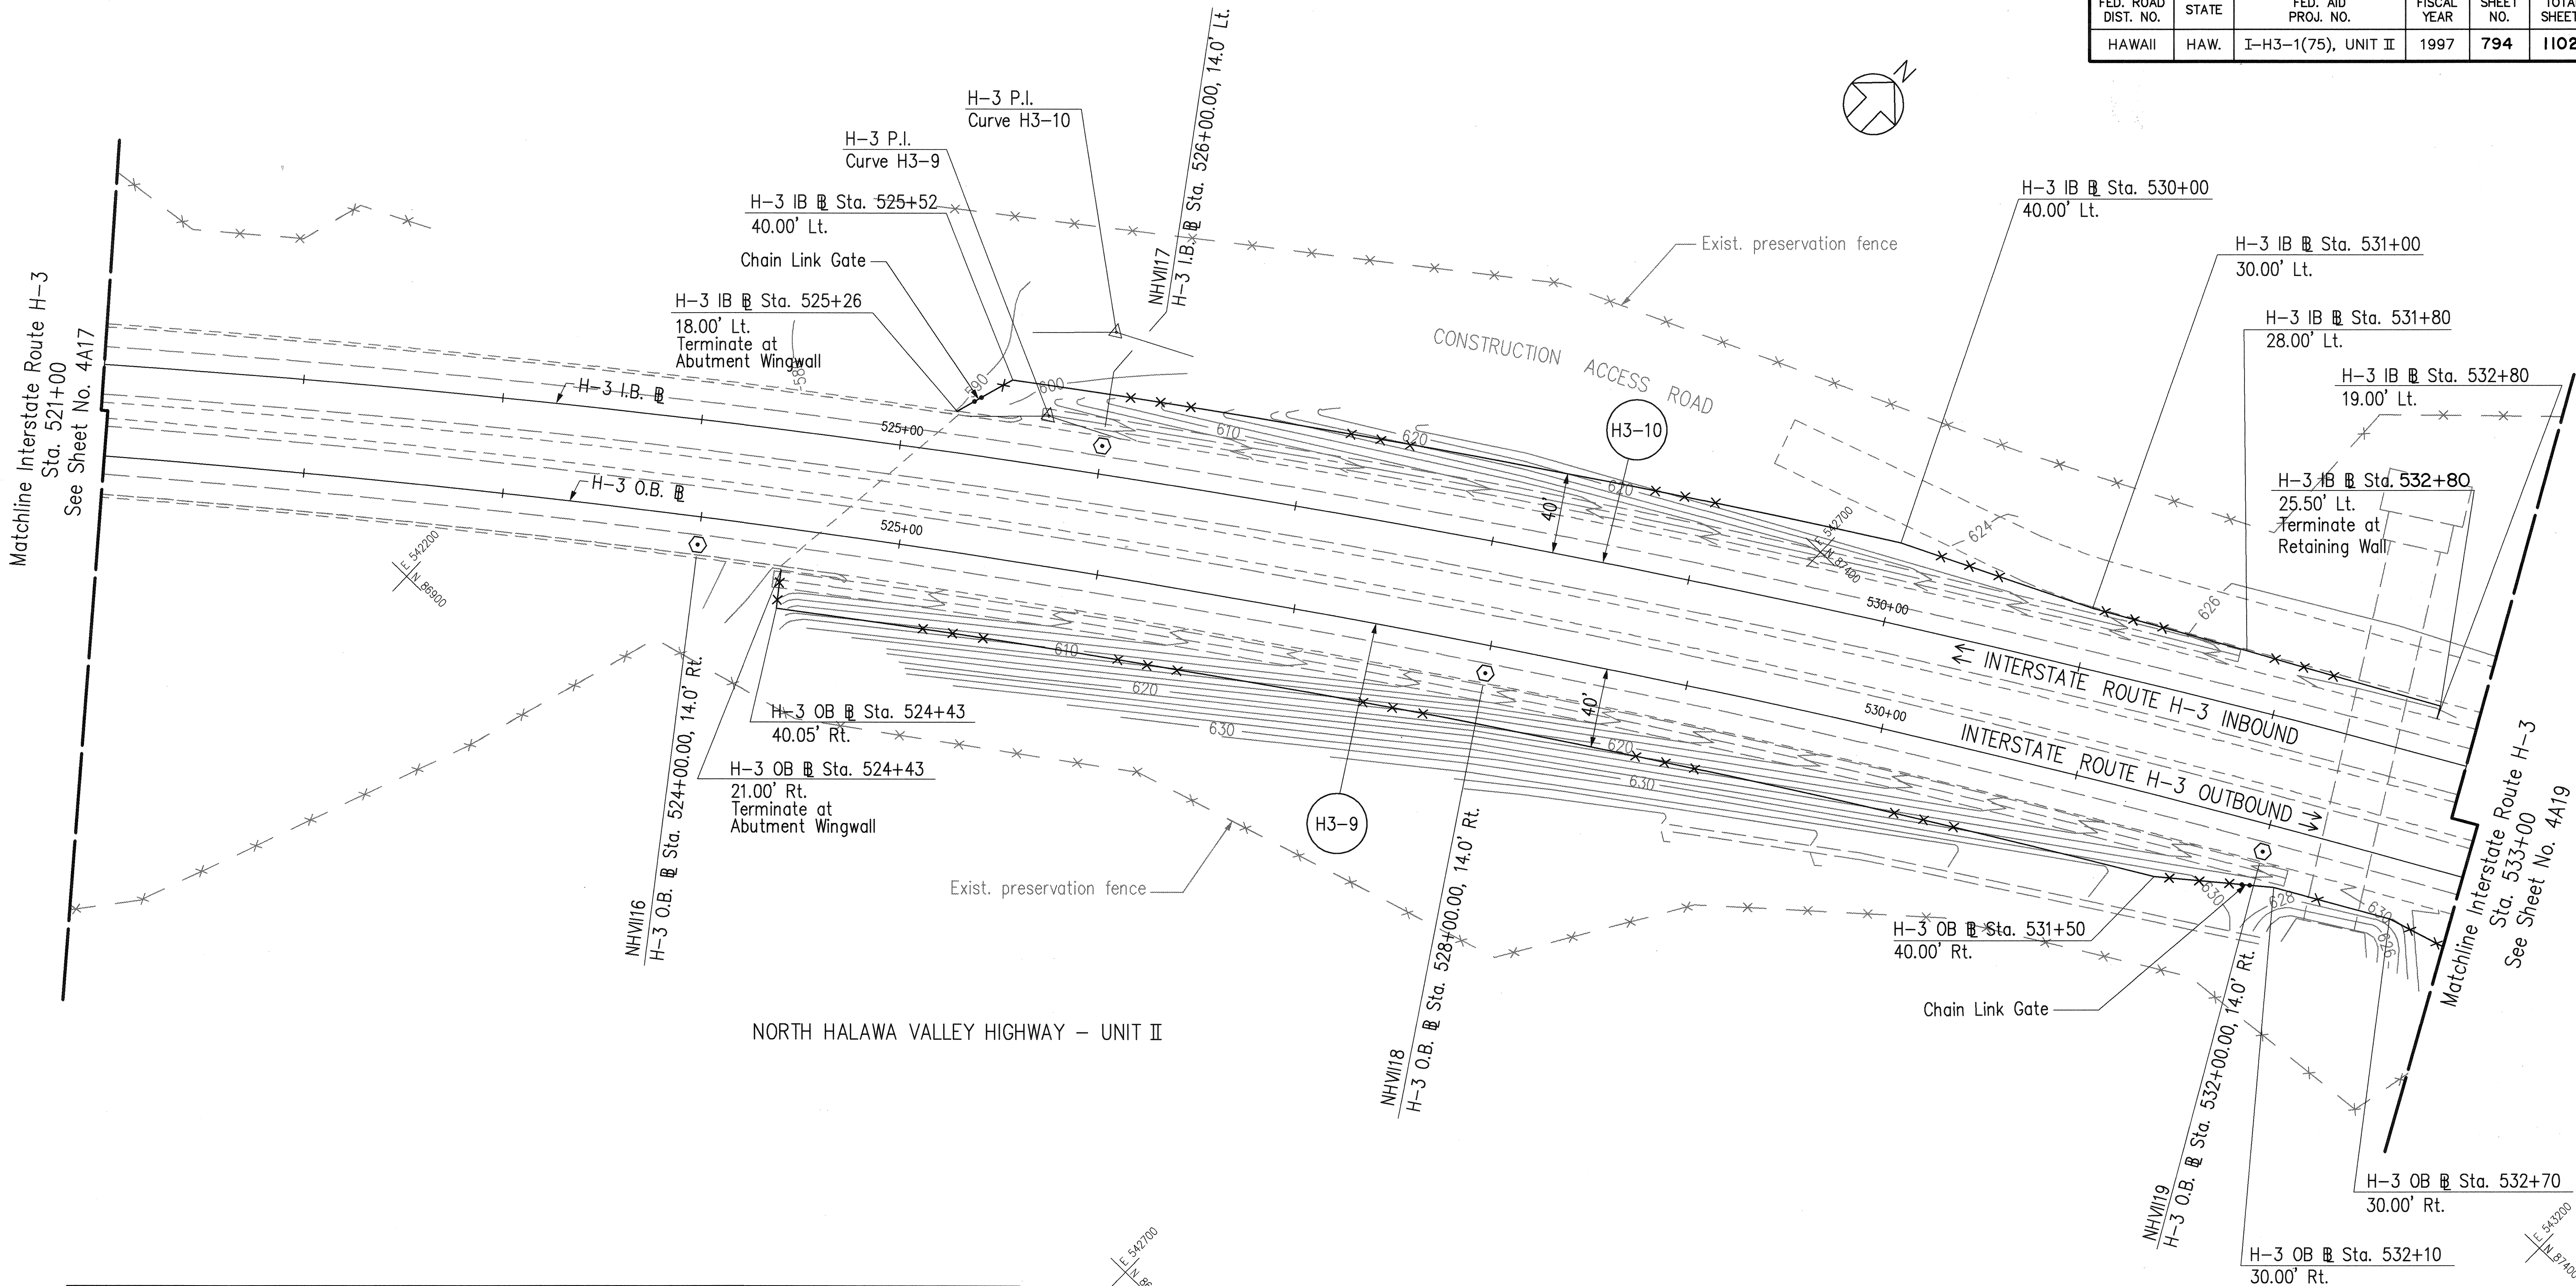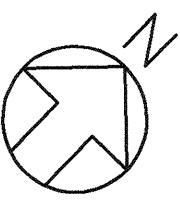


NORTH HALAWA VALLEY HIGHWAY - UNIT II

CURVE	RADIUS	LENGTH	TANGENT	CHORD	DELTA	COORDINATES OF POINT OF INTERSECTION OF TANGENTS	
H3-9	5962.28'	1871.44'	943.48'	1863.77'	17°59'02"	N 87180.63	E 542375.50
H3-10	5945.67'	1833.85'	924.26'	1826.59'	17°40'19"	N 87234.33	E 542370.47

ORIGINAL	SURVEY PLOTTED BY	DATE
PLAN	DESIGNED BY	
NOTE BOOK	TRACED BY	
QUANTITIES BY		
CHECKED BY		
No.		

CAD by J. Minura, 55-52

Last Saved: J:\H3RF\RFU2\ALIGN\H3ALI-18.dwg 02/12/97 at 12:45

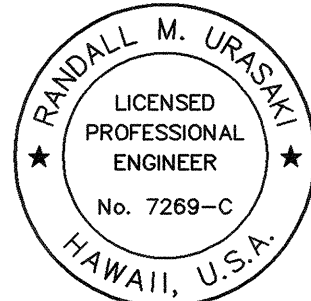


THIS WORK WAS PREPARED BY ME
OR UNDER MY SUPERVISION.

Randall M. Urasaki

STATE OF HAWAII
DEPARTMENT OF TRANSPORTATION
HIGHWAYS DIVISION
NORTH HALAWA VALLEY
ALIGNMENT, FENCING
& SURVEY MONUMENTS
H-3 FINISH (UNIT II)
FAIP NO. I-H3-1(75), UNIT II
LEEWARD SECTION
SCALE: 1" = 40' DATE: JANUARY 1997
SHEET NO. 4A18 OF 19 SHEETS

FED. ROAD DIST. NO.	STATE	FED. AID PROJ. NO.	FISCAL YEAR	SHEET NO.	TOTAL SHEETS
HAWAII	HAW.	I-H3-1(75), UNIT II	1997	795	1102

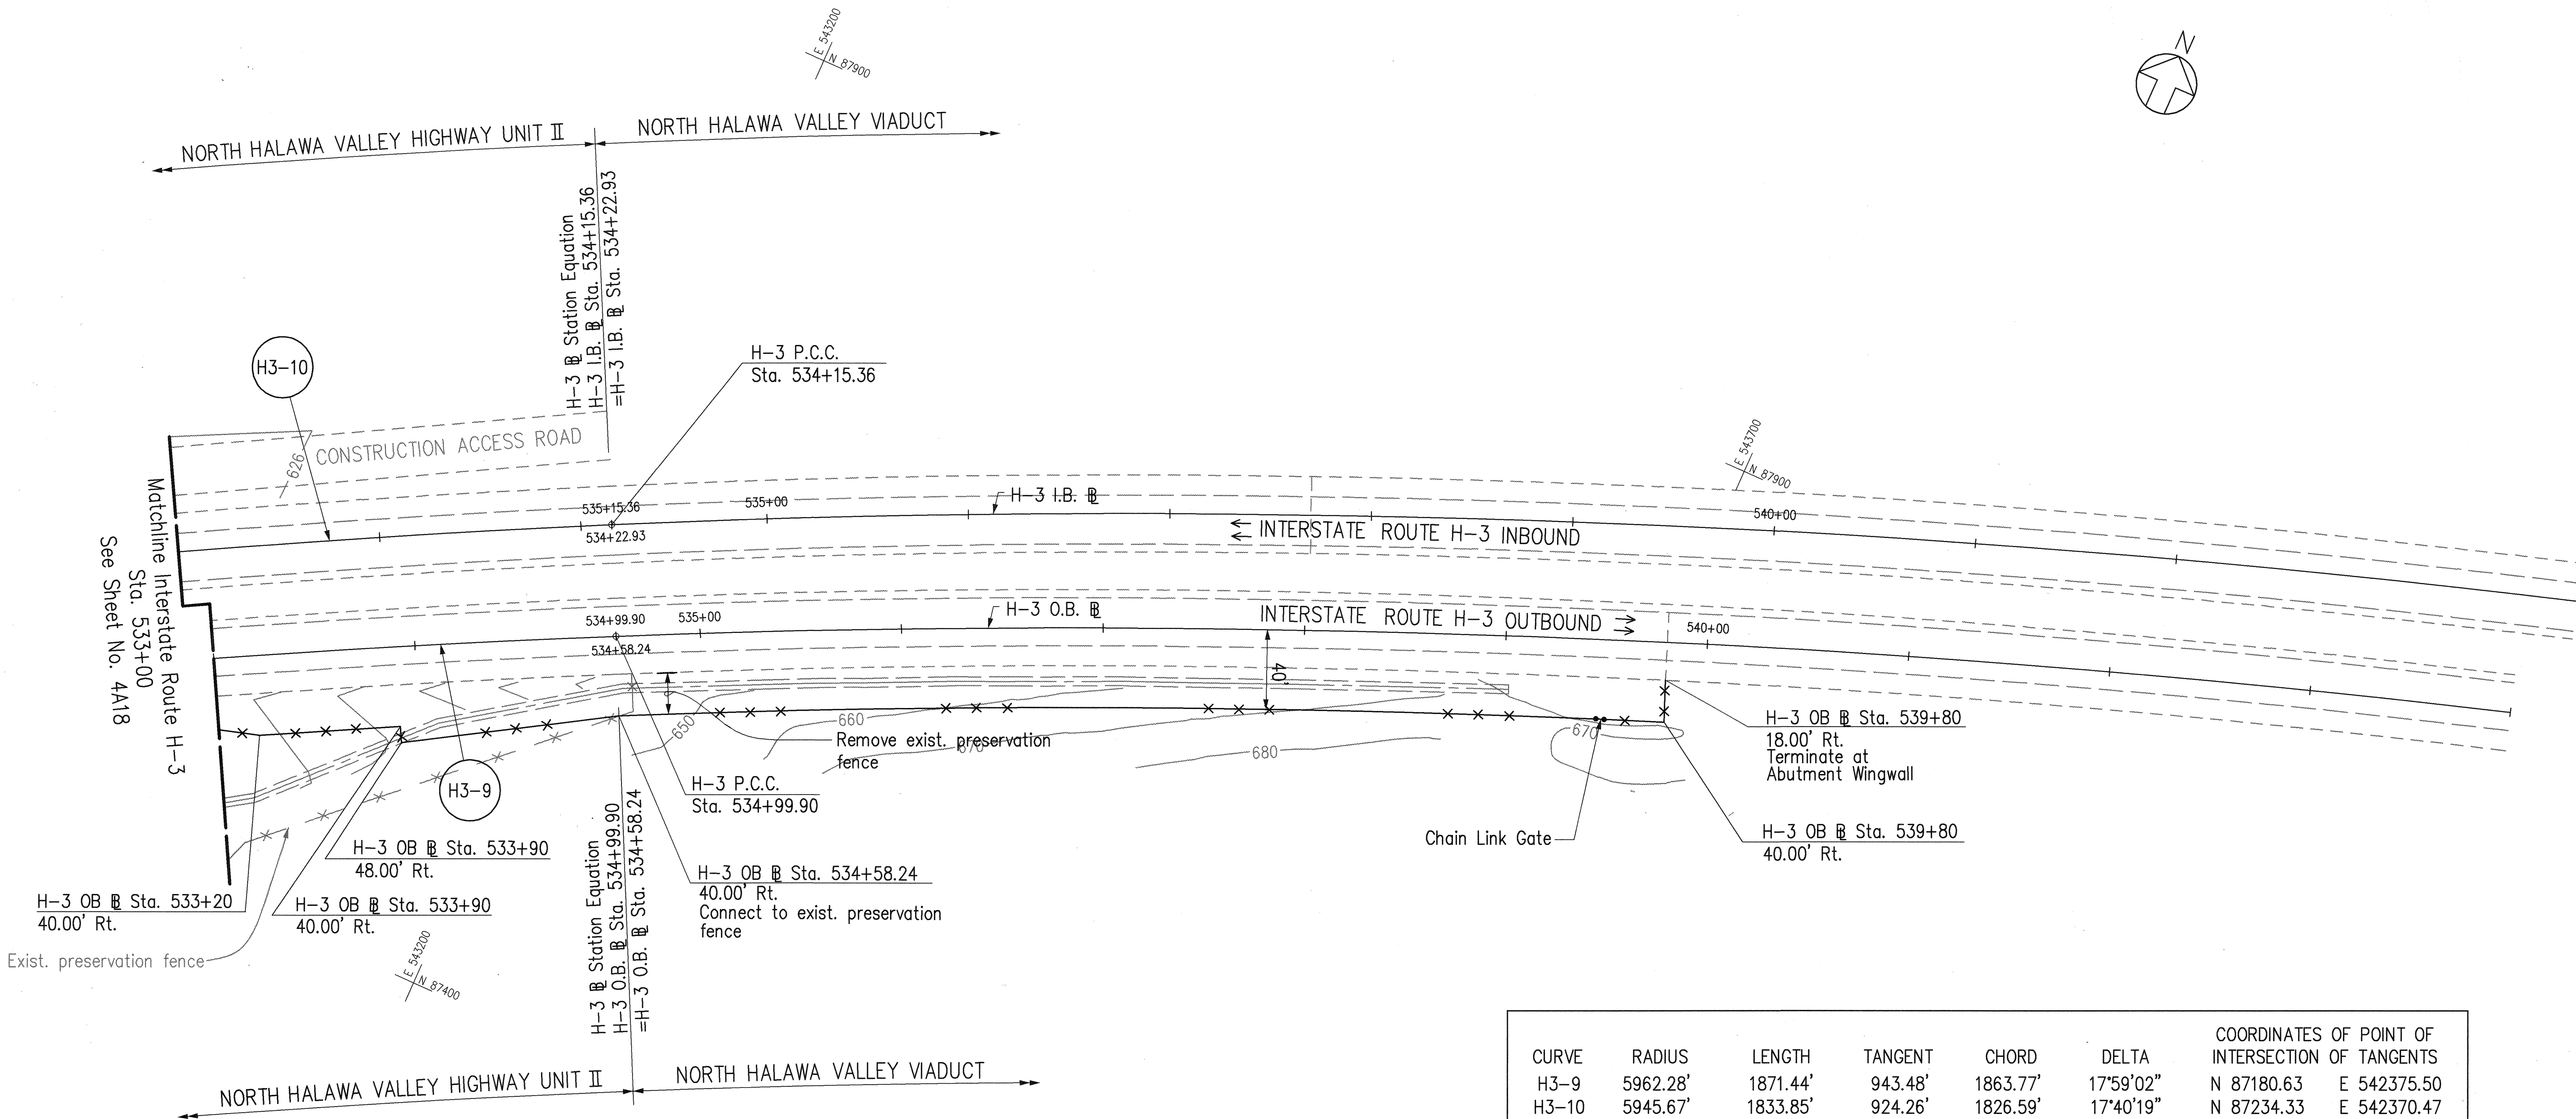


CURVE	RADIUS	LENGTH	TANGENT	CHORD	DELTA	COORDINATES OF POINT OF INTERSECTION OF TANGENTS	
H3-9	5962.28'	1871.44'	943.48'	1863.77'	17°59'02"	N 87180.63	E 542375.50
H3-10	5945.67'	1833.85'	924.26'	1826.59'	17°40'19"	N 87234.33	E 542370.47

ORIGINAL PLAN	SURVEY PLOTTED BY	DATE
NOTE BOOK	DESIGNED BY	
QUANTITIES BY	CHECKED BY	
No.		

CAD by J. Minors, 55-52

Last Saved: J:\H3RF\RFU2\ALIGN\H3ALI-19.dwg 02/12/97 at 12:47

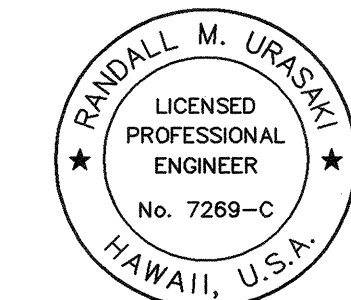

THIS WORK WAS PREPARED BY ME
OR UNDER MY SUPERVISION.
Randall M. Urasky

STATE OF HAWAII
DEPARTMENT OF TRANSPORTATION
HIGHWAYS DIVISION


**NORTH HALAWA VALLEY
ALIGNMENT, FENCING
& SURVEY MONUMENTS**

H-3 FINISH (UNIT II)
FAIP NO. I-H3-1(75), UNIT II
LEEWARD SECTION

SCALE: 1" = 40'
SHEET NO. 4A19 OF 19 SHEETS

DATE: JANUARY 1997

FED. ROAD DIST. NO.	STATE	PROJ. NO.	FISCAL YEAR	SHEET NO.	TOTAL SHEETS
HAWAII	HAW.	I-H3-1(75) UNIT II	1997	796	1102

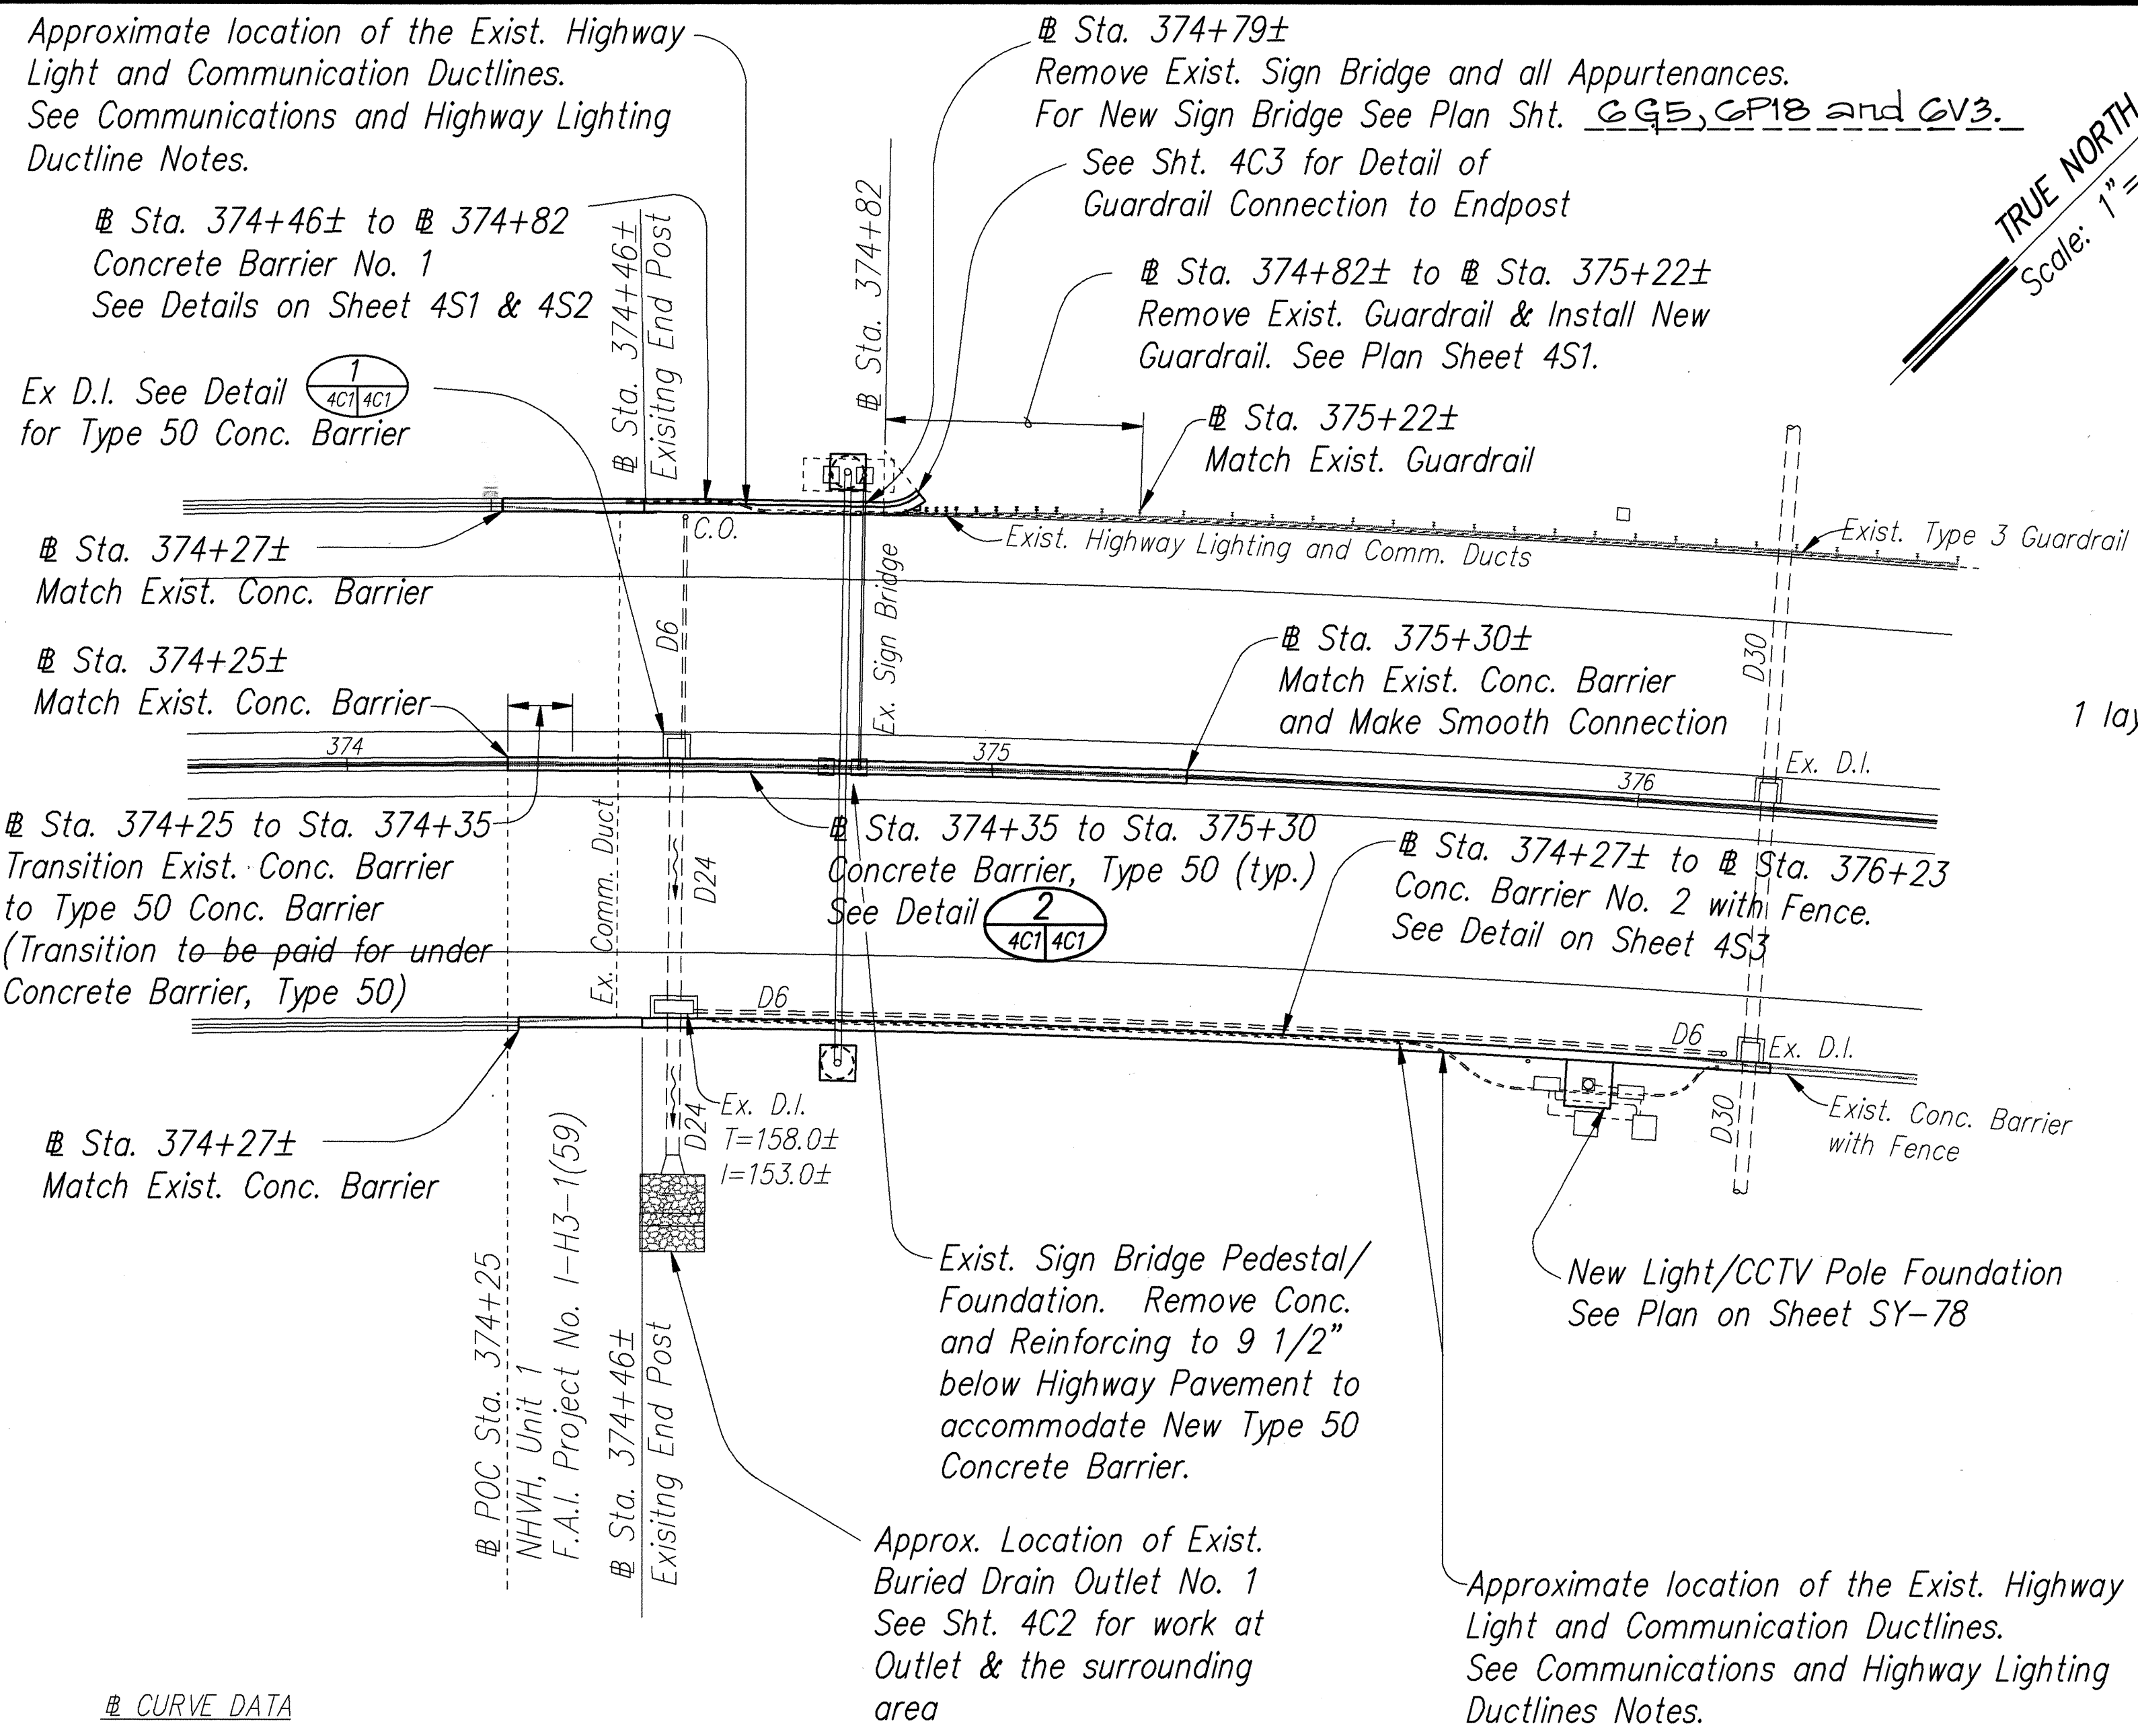


CURVE DATA
 $\Delta = 14^\circ 15' 6''$
 $\Delta/2 = 7^\circ 7' 33''$
 $R = 2800.00$
 $T = 350.04$
 $C = 694.67$
 $L_c = 696.46$


PLAN
 Scale: 1"= 20'-0"

COMMUNICATIONS AND HIGHWAY LIGHTING DUCTLINES NOTES:


- 1- Prior to installation of Concrete Barrier Walls, Contractor shall verify location of existing fiber optic communication and lighting conduits by probing or other methods.
- 2- The Contractor shall exercise extreme caution when excavating for the Concrete Barrier Walls. The existing Ducts contain electrical and fiber optic cables which, if damaged, will be the Contractor's responsibility to repair at no cost to the State.

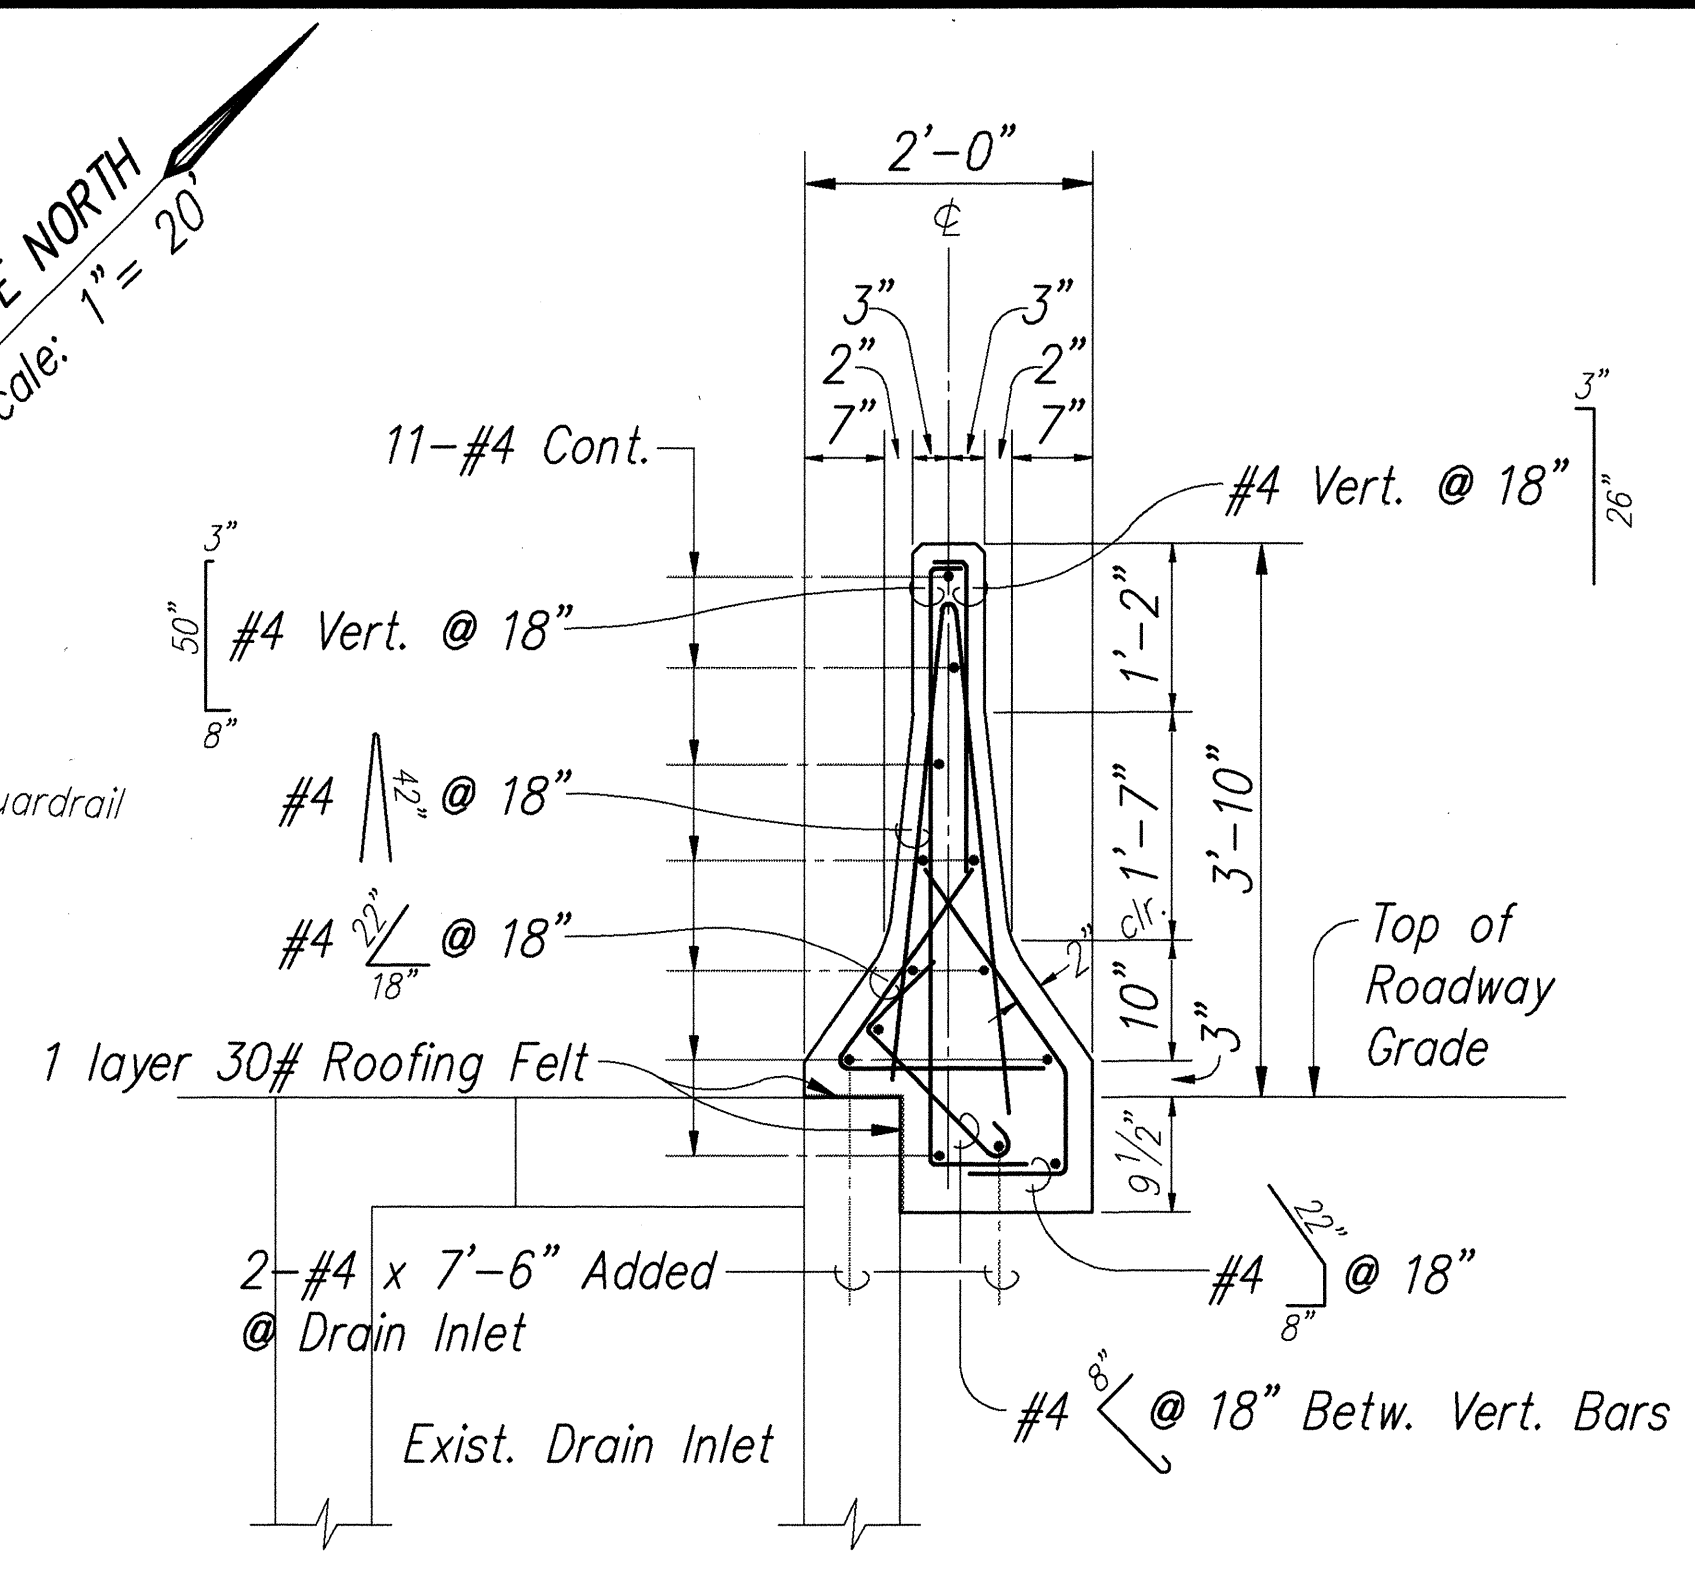

CONCRETE BARRIER, TYPE 50 REINF. @ EXIST. DRAIN INLET
 Scale: 3/4"= 1'-0" 1
 4C1 4C1

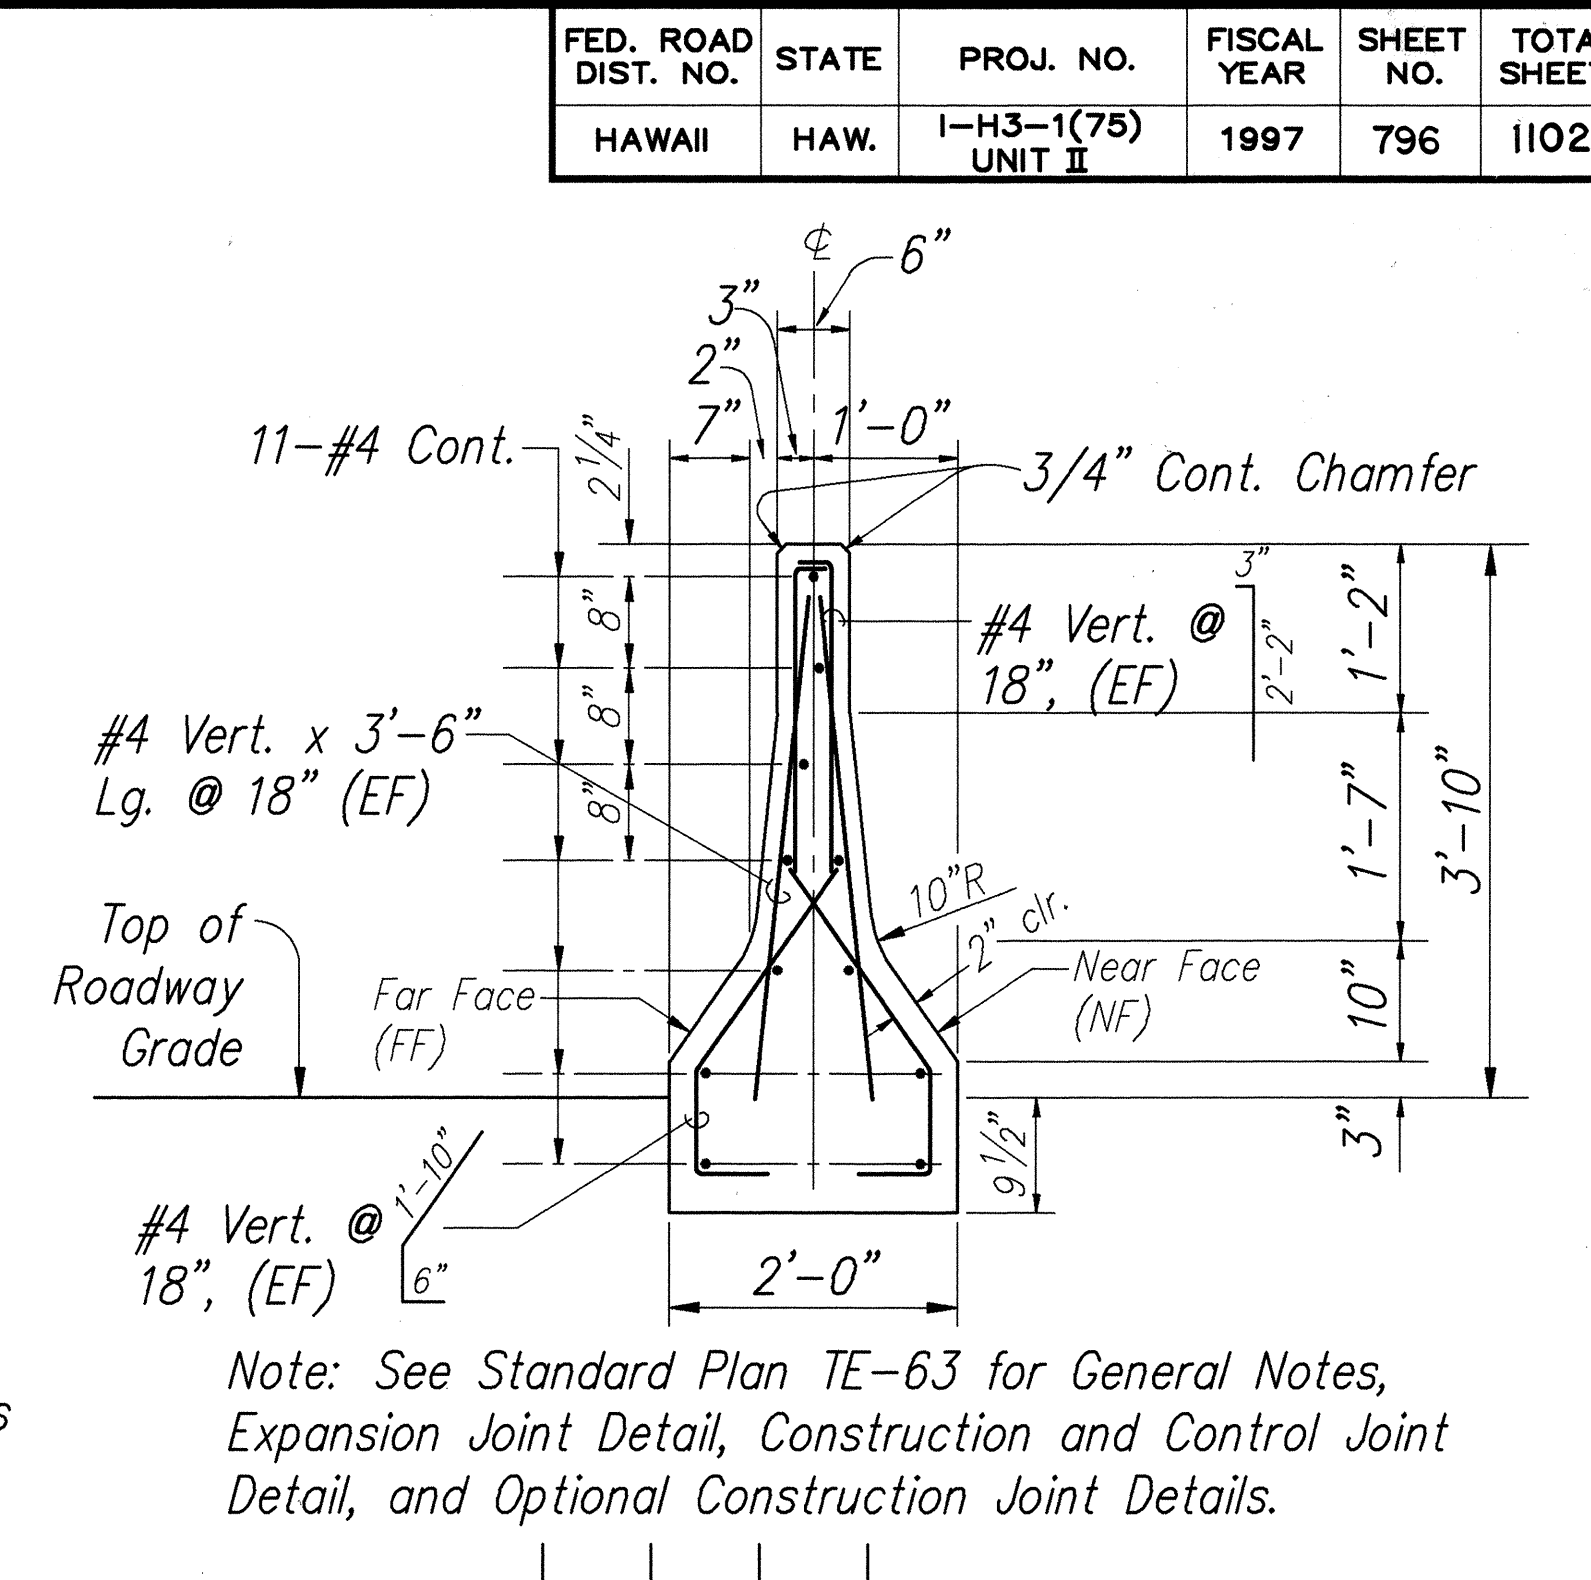

VERTICAL BAR ARRANGEMENT
 N.T.S.
TYP. CONC. BARRIER, TYPE 50
 Scale: 3/4"= 1'-0" 2
 4C1 4C1

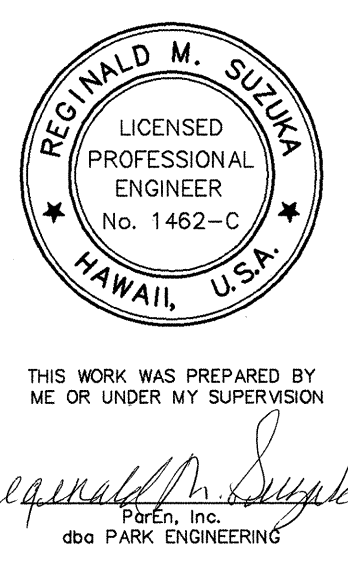

STATE OF HAWAII
 DEPARTMENT OF TRANSPORTATION
 HIGHWAYS DIVISION
NORTH HALAWA VALLEY
ROADWAY CONSTRUCTION
BARRIER AND GUARDRAIL CONN. DETAILS
H-3 FINISH (UNIT II)
FAIP NO. I-H3-1(75), UNIT II
LEEWARD SECTION
 SCALE: AS NOTED DATE: FEB. 1997
 SHEET No. 4C1 OF 22 SHEETS

ORIGINAL PLAN	SURVEY PLOTTED BY	DATE
DESIGNED BY	DRAWN BY	
CHECKED BY	DESIGNED BY	
NO.	CHECKED BY	



FED. ROAD DIST. NO.	STATE	PROJ. NO.	FISCAL YEAR	SHEET NO.	TOTAL SHEETS
HAWAII	HAW.	I-H3-1(75) UNIT II	1997	797	1102

End Drainage Swale Construction. Adjust as necessary to match existing swale and provide positive drainage.




Construct Drainage Swale (min. slope= 1.0%) to match existing swale. b=2', side slope=2:1

Approximate location of buried Existing Drain Outlet No. 1 See Detail 1

PLAN
Scale: 1"= 20'-0"

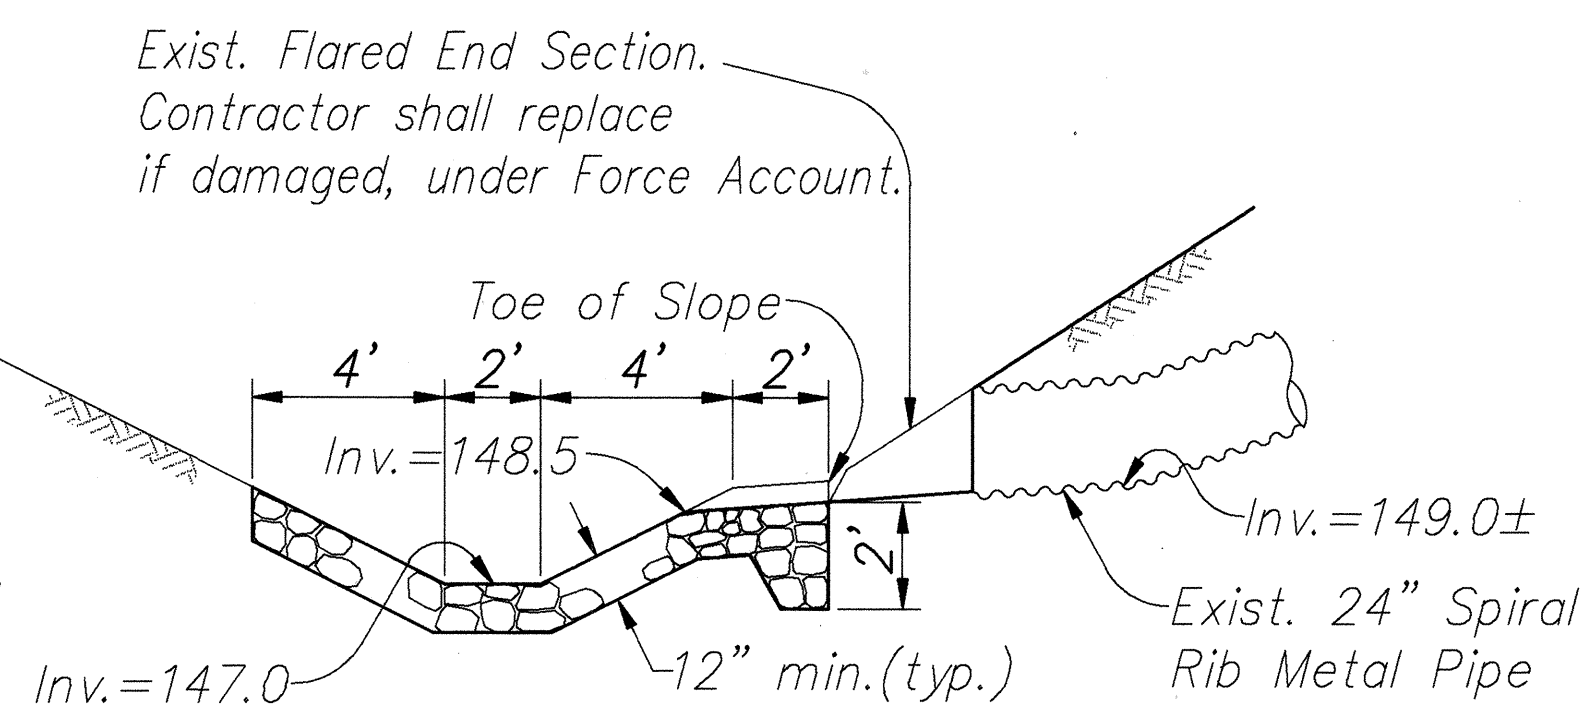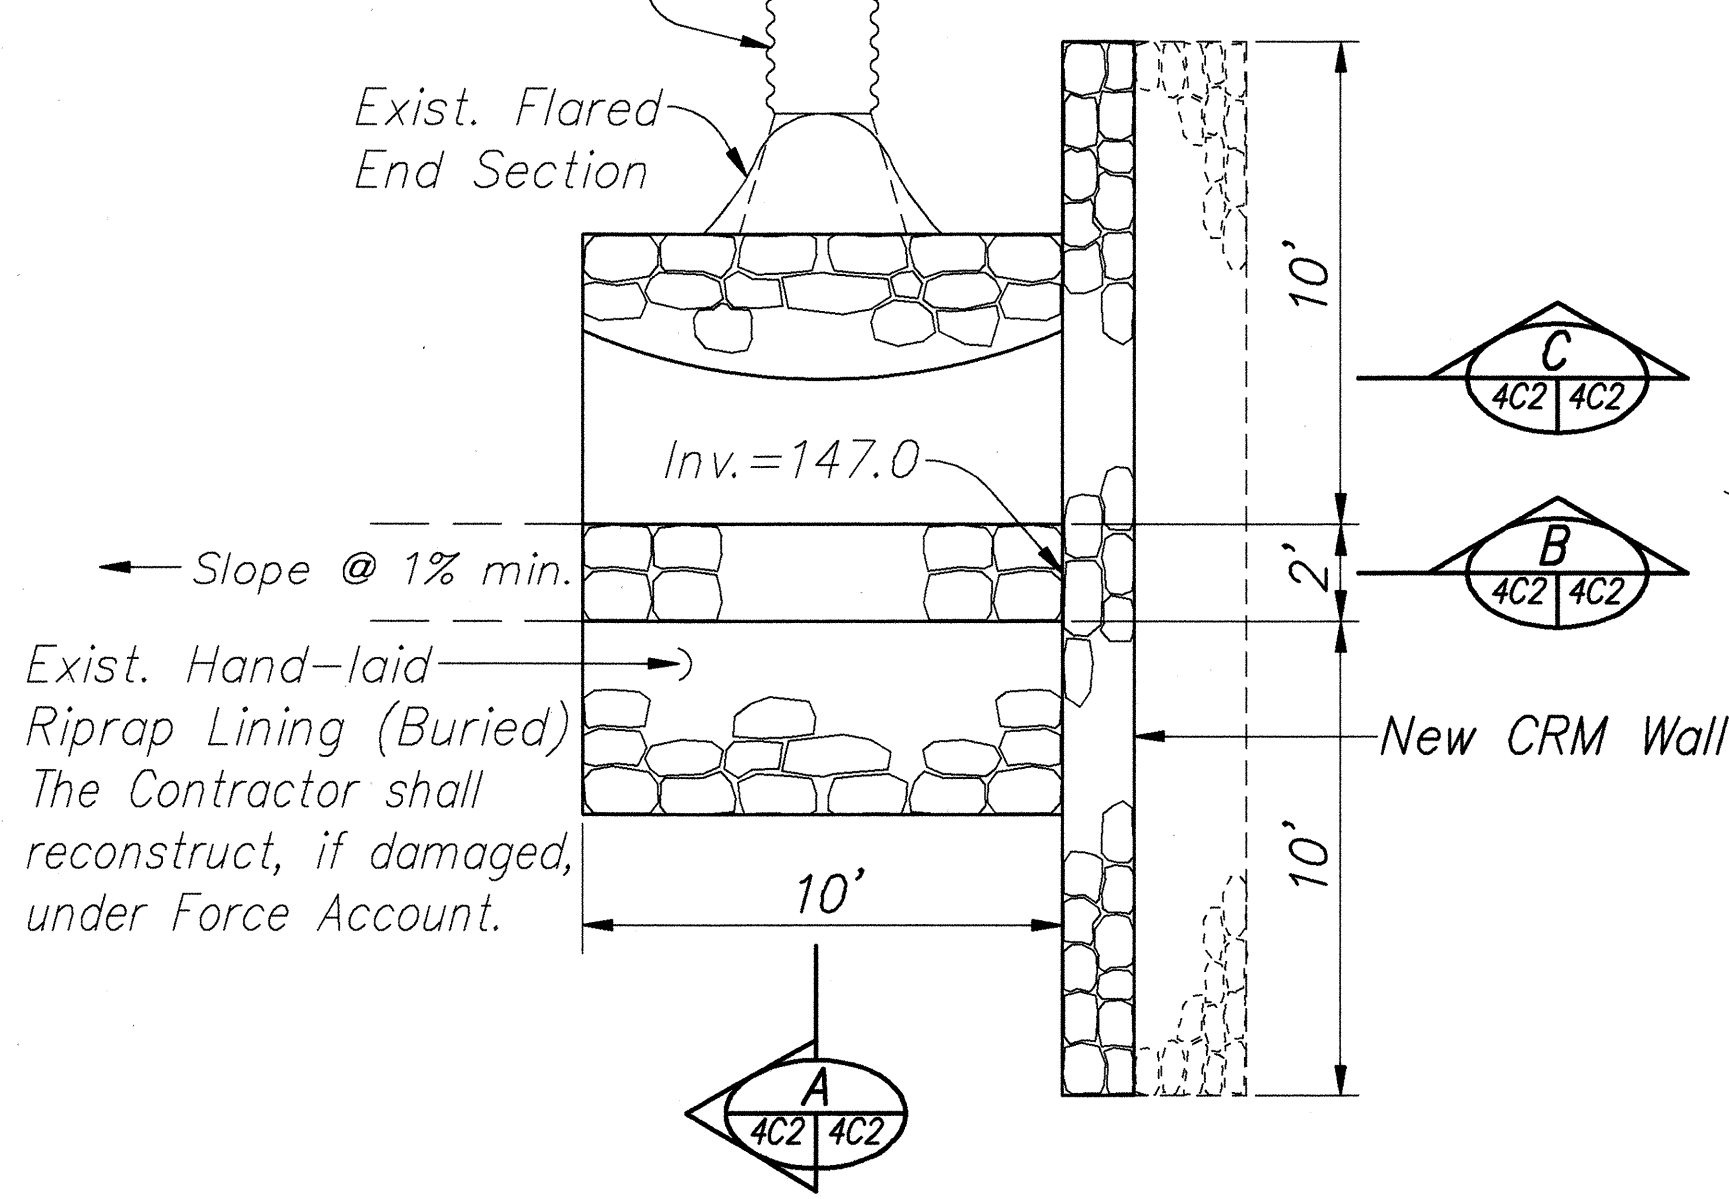

DETAIL - OUTLET NO. 1
Scale: 1/4"= 1'-0"

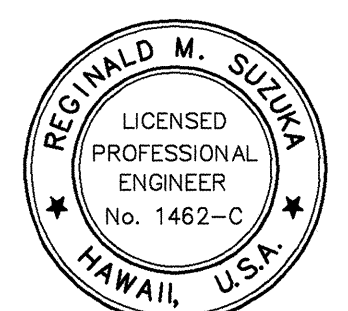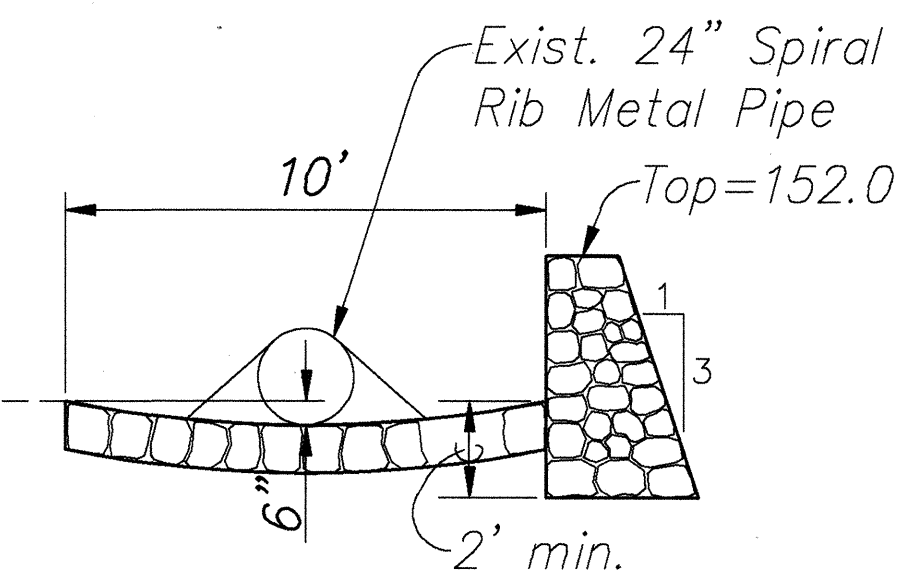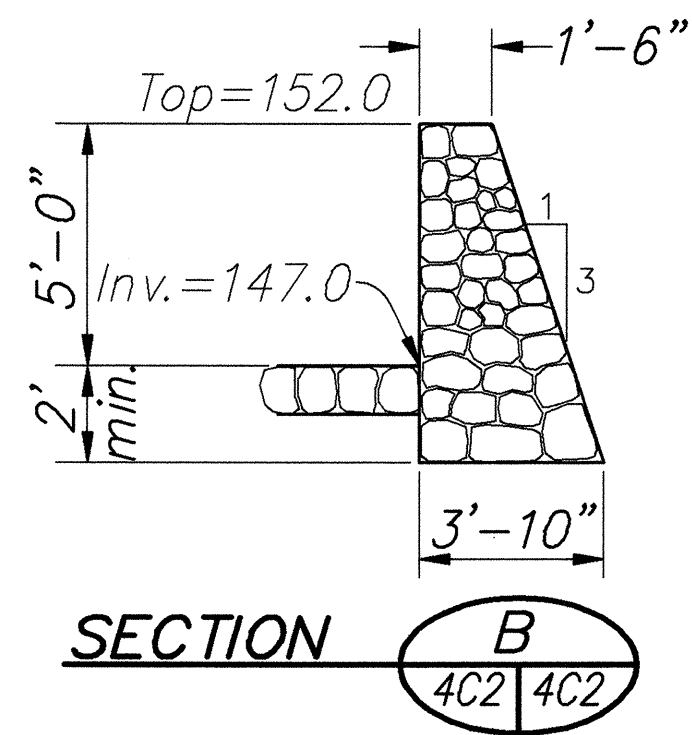

THIS WORK WAS PREPARED BY ME OR UNDER MY SUPERVISION
Reginald M. Suzuki
P.E., Inc.
dba PARK ENGINEERING

STATE OF HAWAII
DEPARTMENT OF TRANSPORTATION
HIGHWAYS DIVISION

**NORTH HALAWA VALLEY
ROADWAY CONSTRUCTION**









DRAINAGE SWALE CONSTRUCTION

H-3 FINISH (UNIT II)
FAIP NO. I-H3-1(75), UNIT II
LEEWARD SECTION


SCALE: AS NOTED DATE: FEB. 1997

SHEET No. 4C2 OF 22 SHEETS

FED. ROAD DIST. NO.	STATE	PROJ. NO.	FISCAL YEAR	SHEET NO.	TOTAL SHEETS
HAWAII	HAW.	I-H3-1(75) UNIT II	1997	798	1102

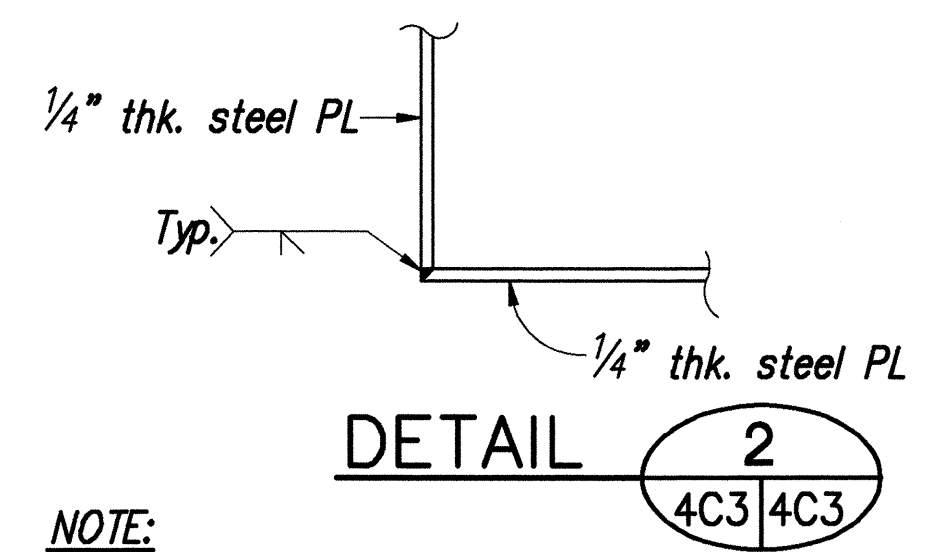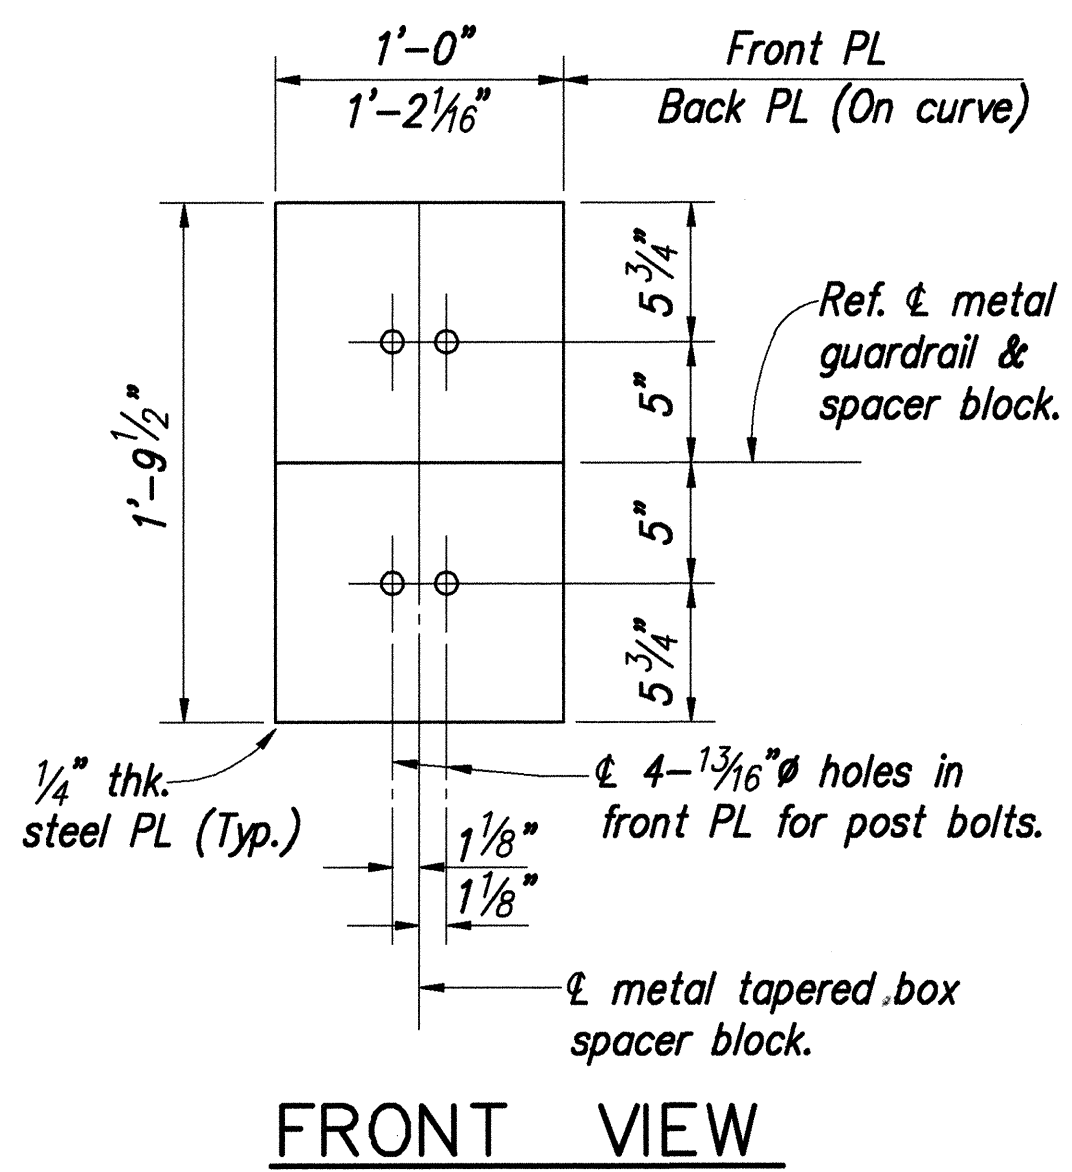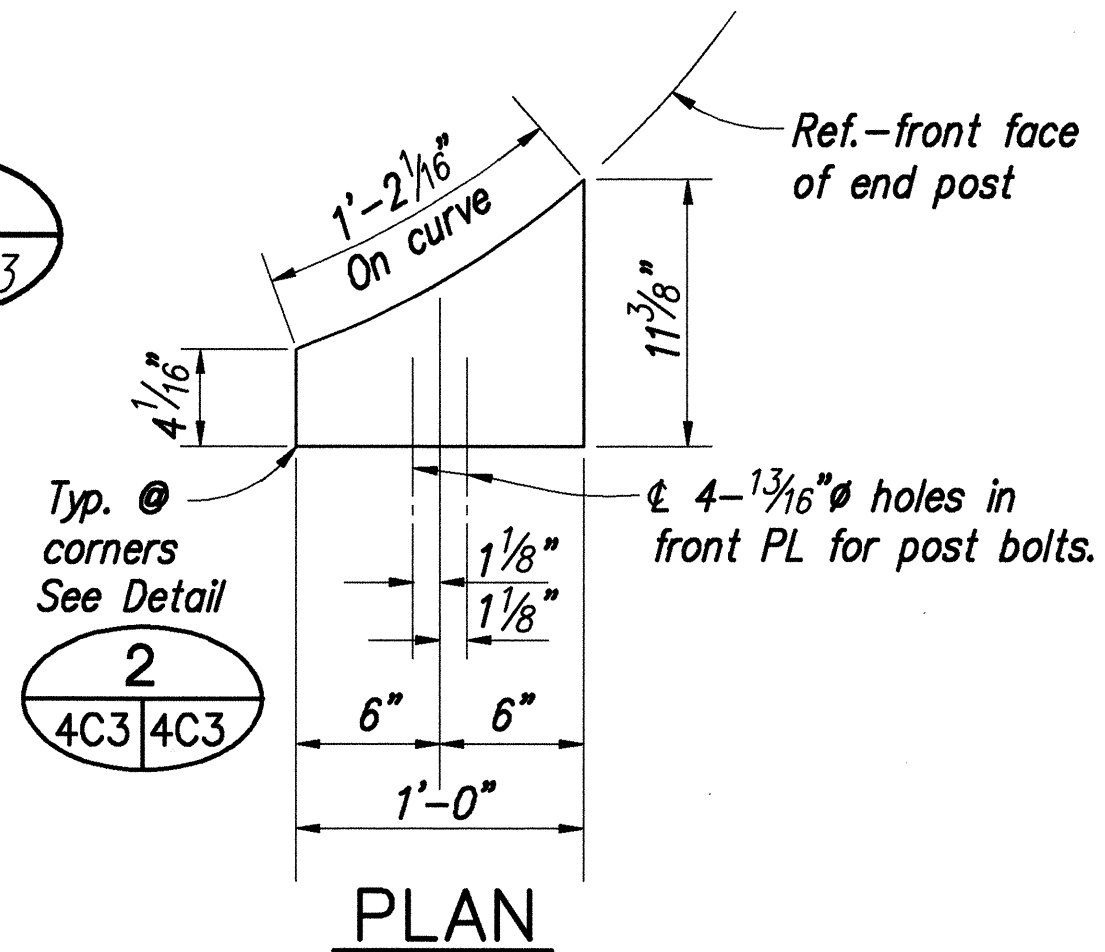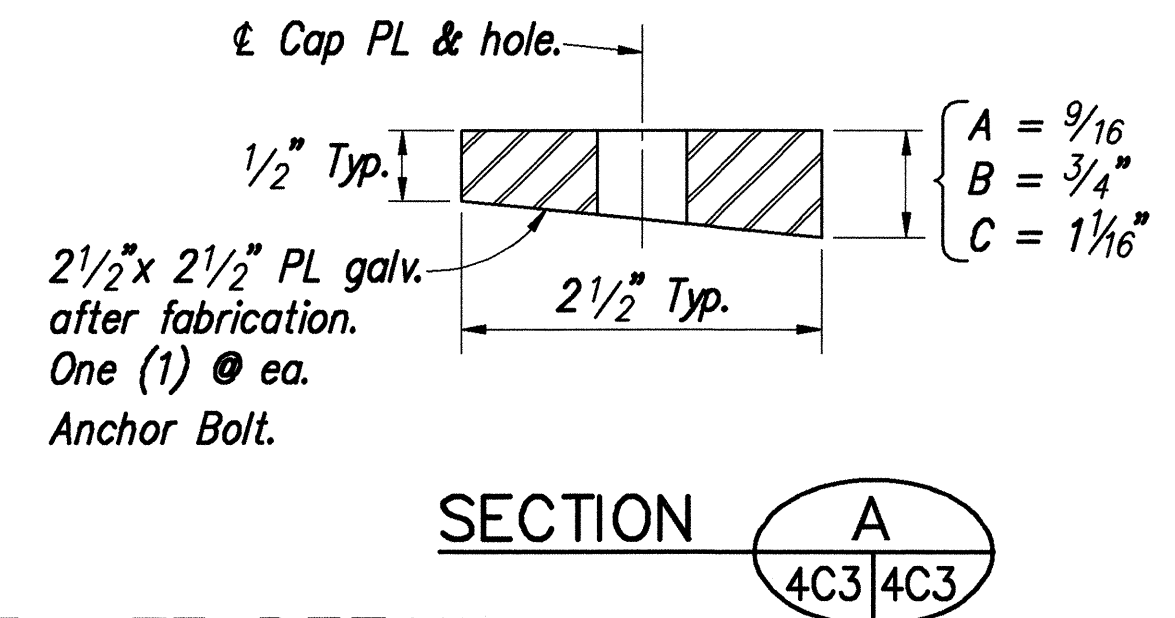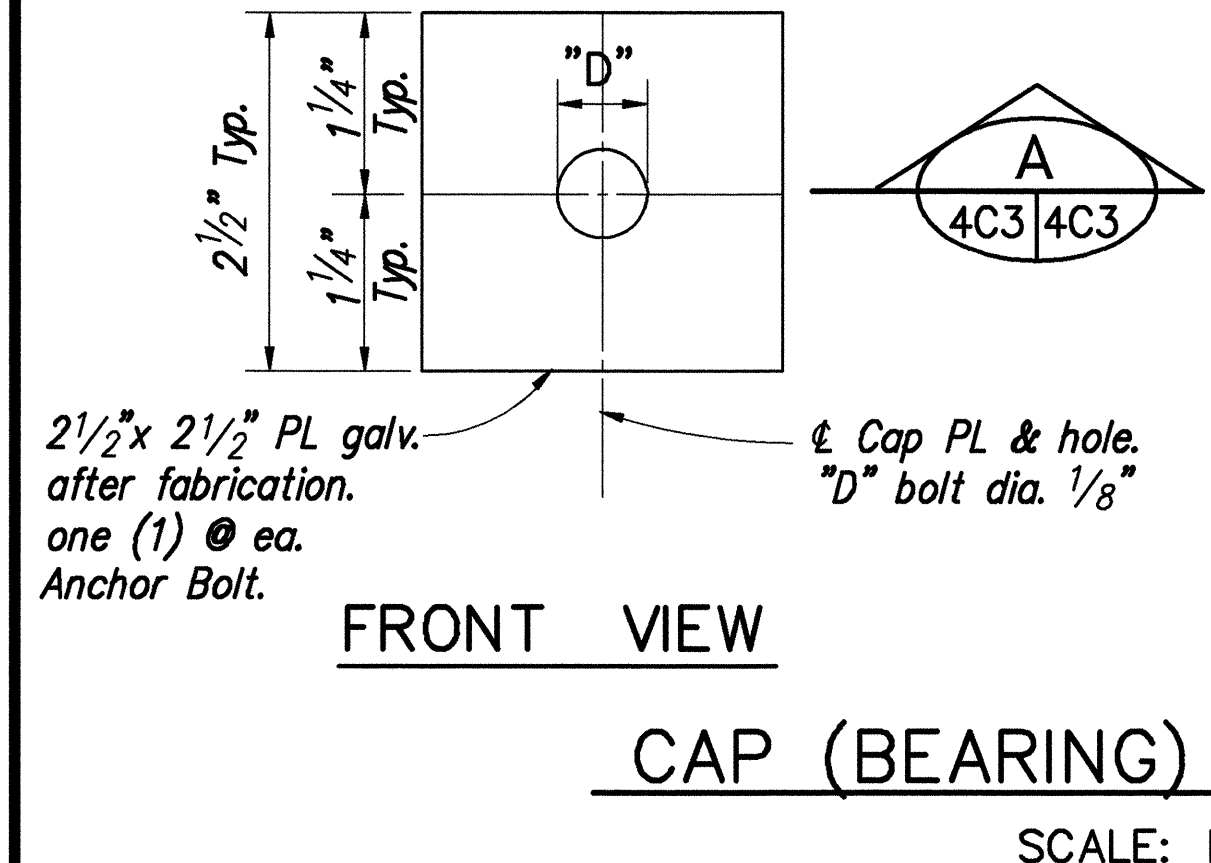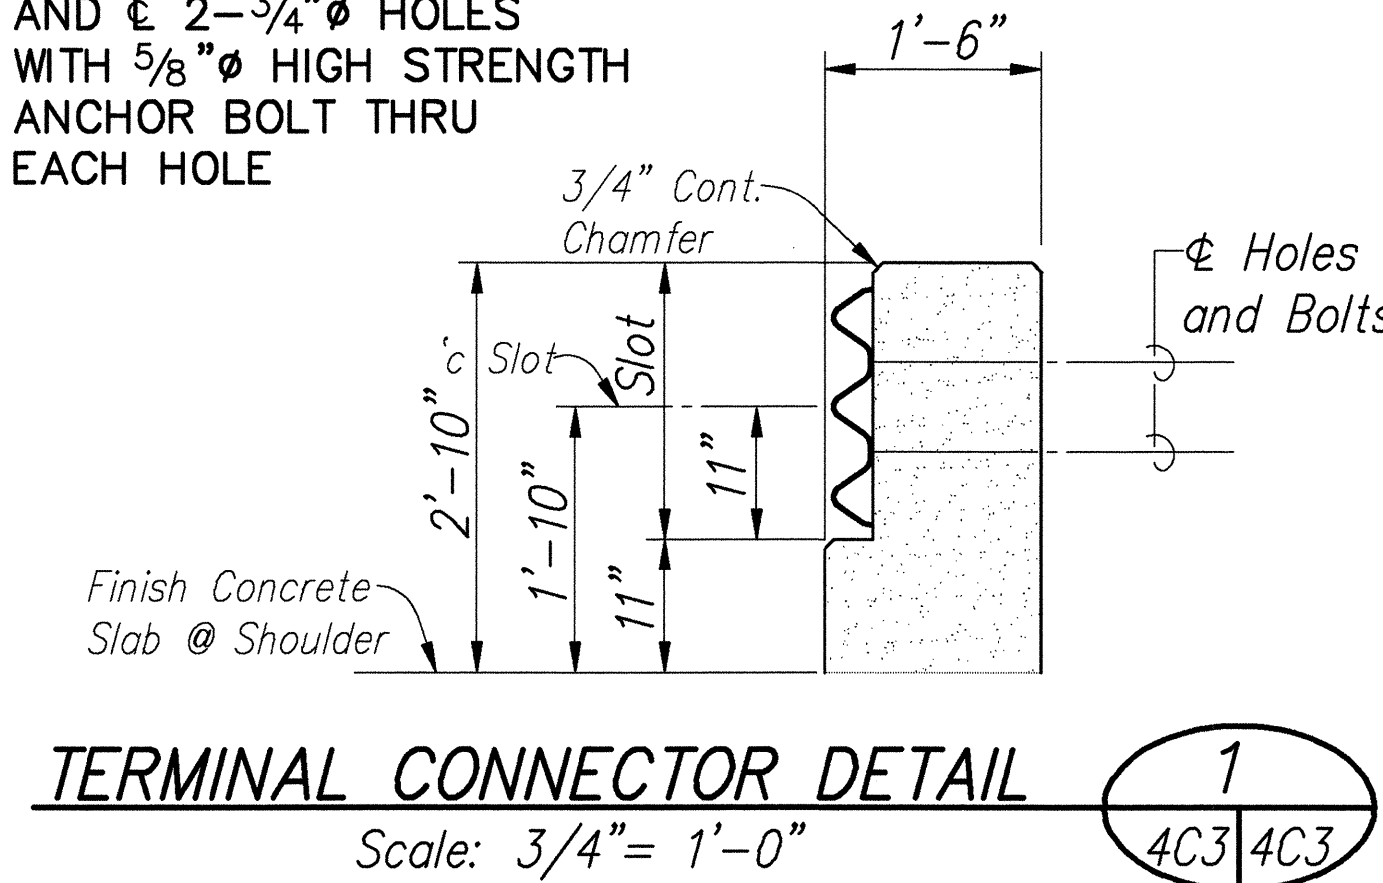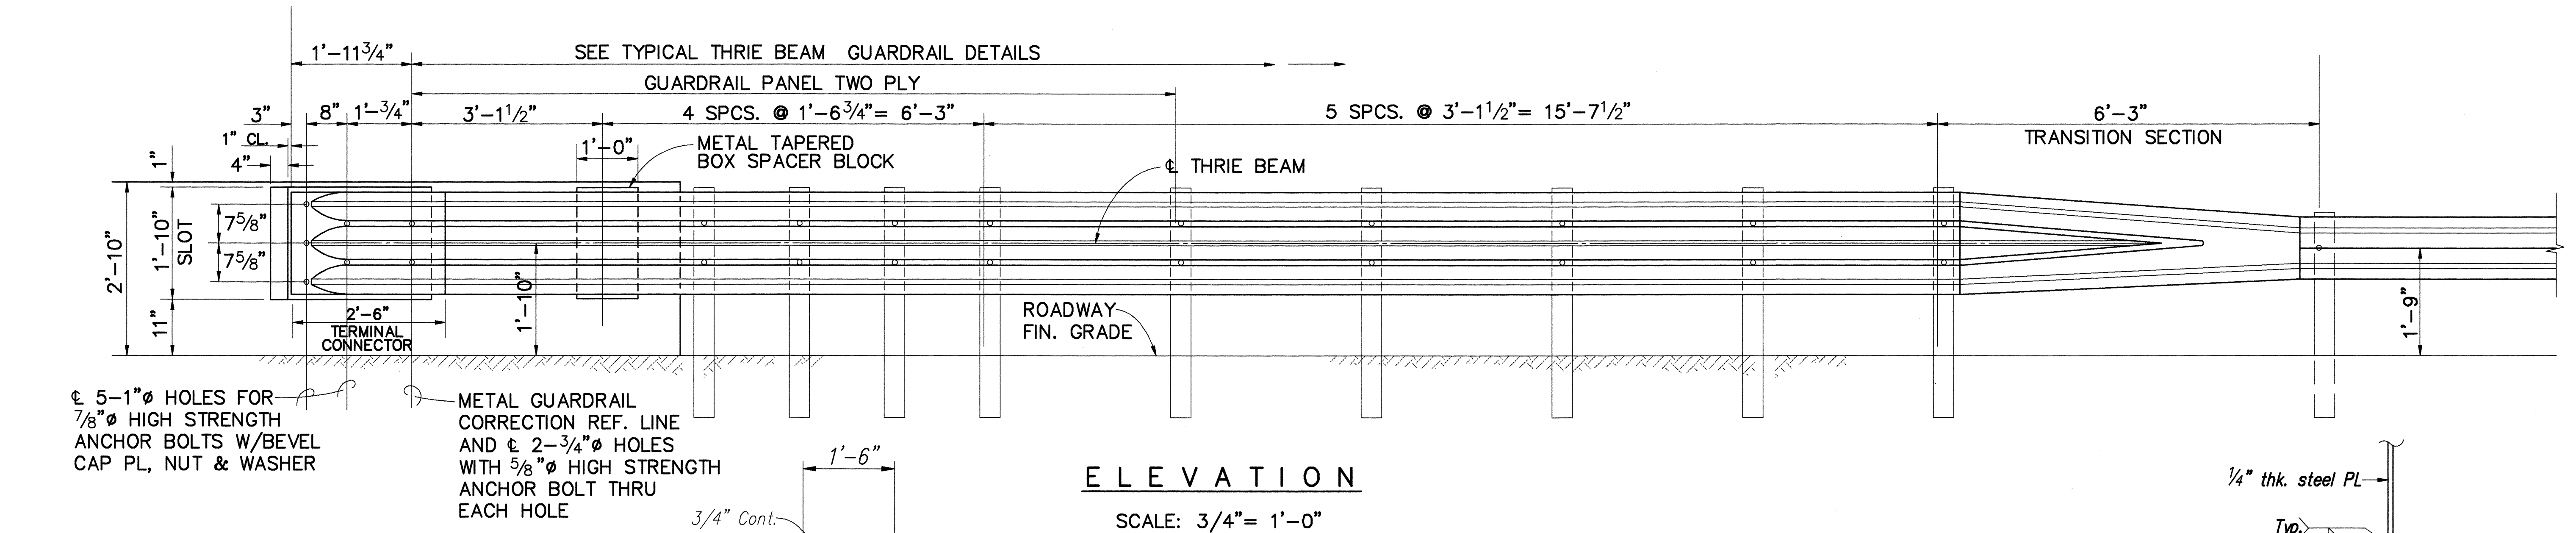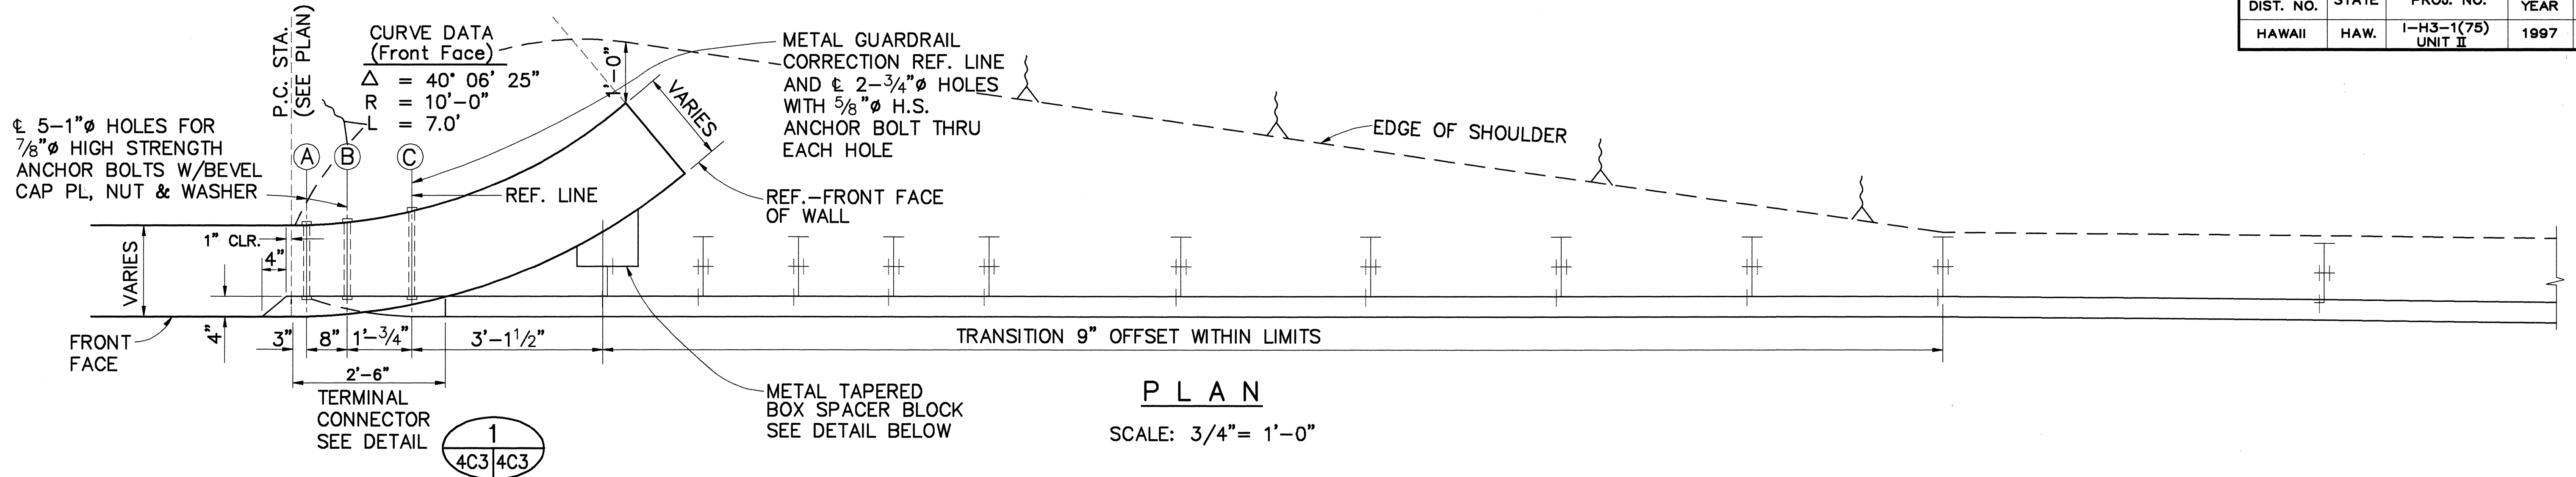

- NOTE:**
- Cap PL and tapered box spacer shall be fabricated from ASTM A 36 steel and hot-dip galvanized after fabrication.
 - Cap PL's tapered box spacer, anchor bolts including nuts and washers and other appurtenances shall be incidental to Guardrail Type 3 (Thrie Beam) endpost connection and will not be paid for separately.
 - See Standard Plan TE-57 for guard rail, type 3, thrie beam detail.

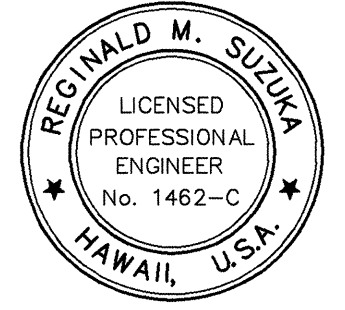

STATE OF HAWAII

DEPARTMENT OF TRANSPORTATION

HIGHWAYS DIVISION

NORTH HALAWA VALLEY

ROADWAY CONSTRUCTION

ENDPOST CONNECTION DETAILS

H-3 FINISH (UNIT II)

FAIP NO. I-H3-1(75), UNIT II


LEEWARD SECTION

SCALE: AS NOTED


DATE: FEB. 1997

SHEET No. 4C3 OF 22 SHEETS

FED. ROAD DIST. NO.	STATE	PROJ. NO.	FISCAL YEAR	SHEET NO.	TOTAL SHEETS
HAWAII	HAW.	I-H3-1(75) UNIT II	1997	799	1102

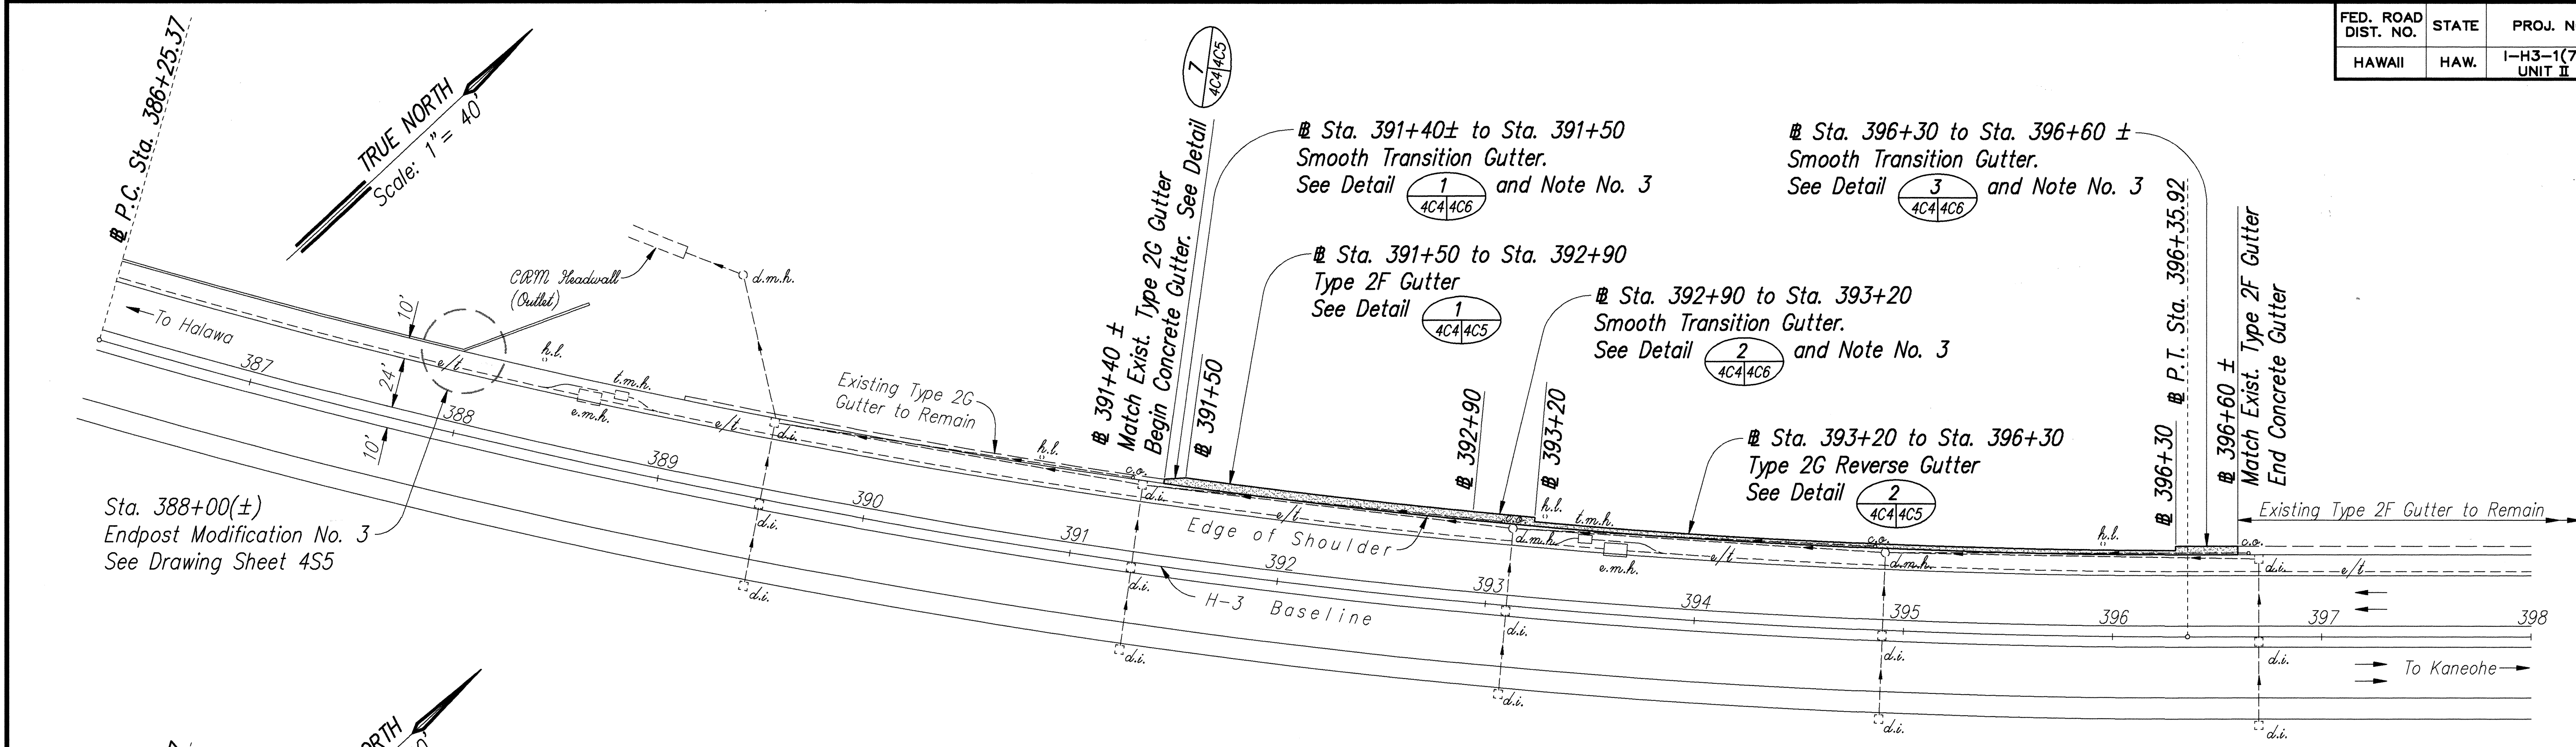


GUTTER PLAN
Scale: 1"= 40'-0"

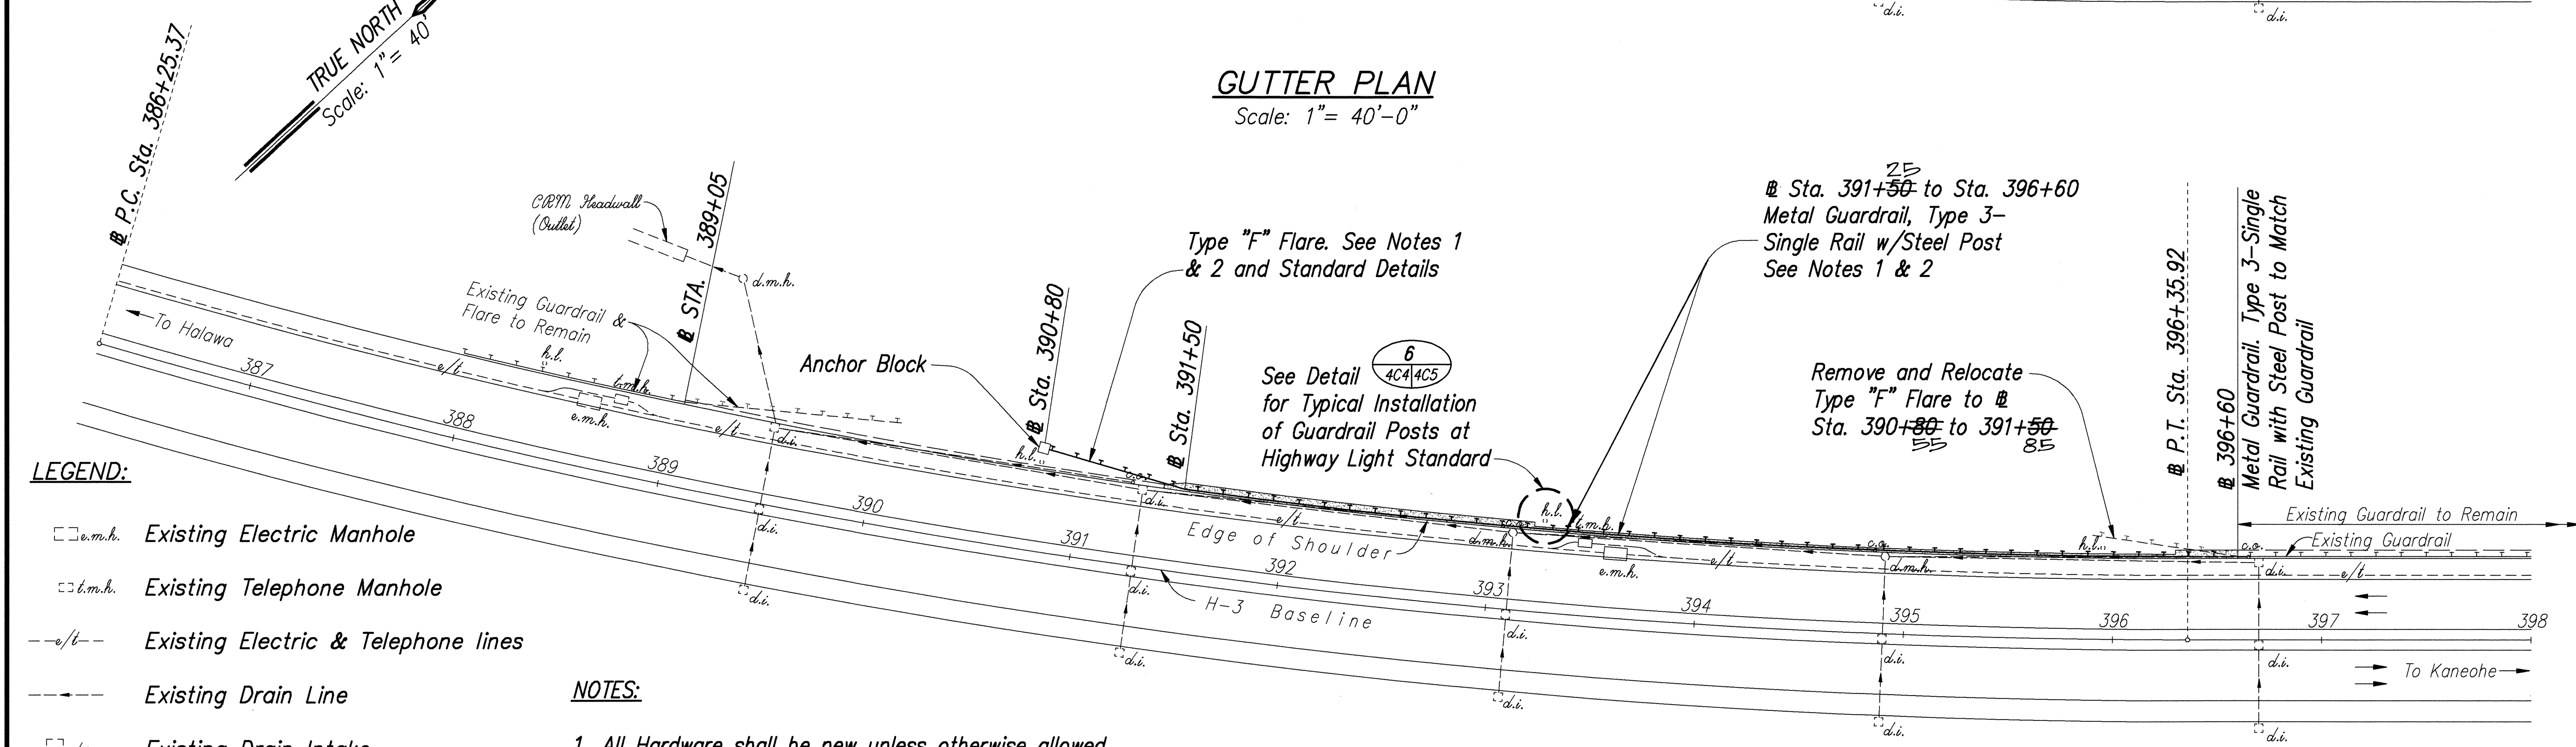

GUARDRAIL PLAN
Scale: 1"= 40'-0"

- LEGEND:**
- e.m.h. Existing Electric Manhole
 - t.m.h. Existing Telephone Manhole
 - e/t- Existing Electric & Telephone lines
 - - - Existing Drain Line
 - d.i. Existing Drain Intake
 - d.m.h. Existing Drain Manhole
 - c.o. Existing Cleanout
 - h.l. Existing Highway Light Standard
 - - - Existing Guardrail
 - - - New Guardrail


- NOTES:**
- All Hardware shall be new unless otherwise allowed by the Engineer.
 - Only undamaged Rail Elements and Posts shall be reused. Unacceptable material shall be replaced by the Contractor at no additional cost to the State.
 - The accepted Transition Gutter will be paid for under "Transition Gutter".

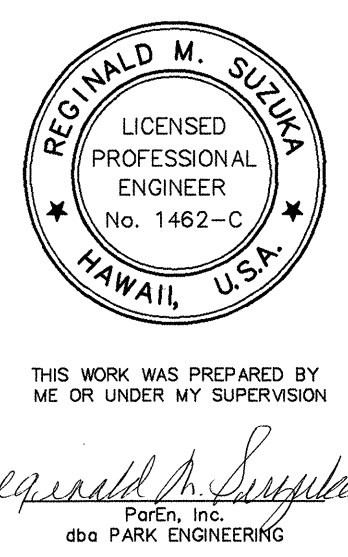

STATE OF HAWAII
DEPARTMENT OF TRANSPORTATION
HIGHWAYS DIVISION
NORTH HALAWA VALLEY
ROADWAY CONSTRUCTION
GUTTER AND GUARDRAIL
H-3 FINISH (UNIT II)
FAIP NO. I-H3-1(75) UNIT II
LEEWARD SECTION

SCALE: AS NOTED
DATE: FEB. 1997
SHEET No. 404 OF 22 SHEETS



FED. ROAD DIST. NO.	STATE	PROJ. NO.	FISCAL YEAR	SHEET NO.	TOTAL SHEETS
HAWAII	HAW.	I-H3-1(75) UNIT II	1997	C.O. 799S-1	1102

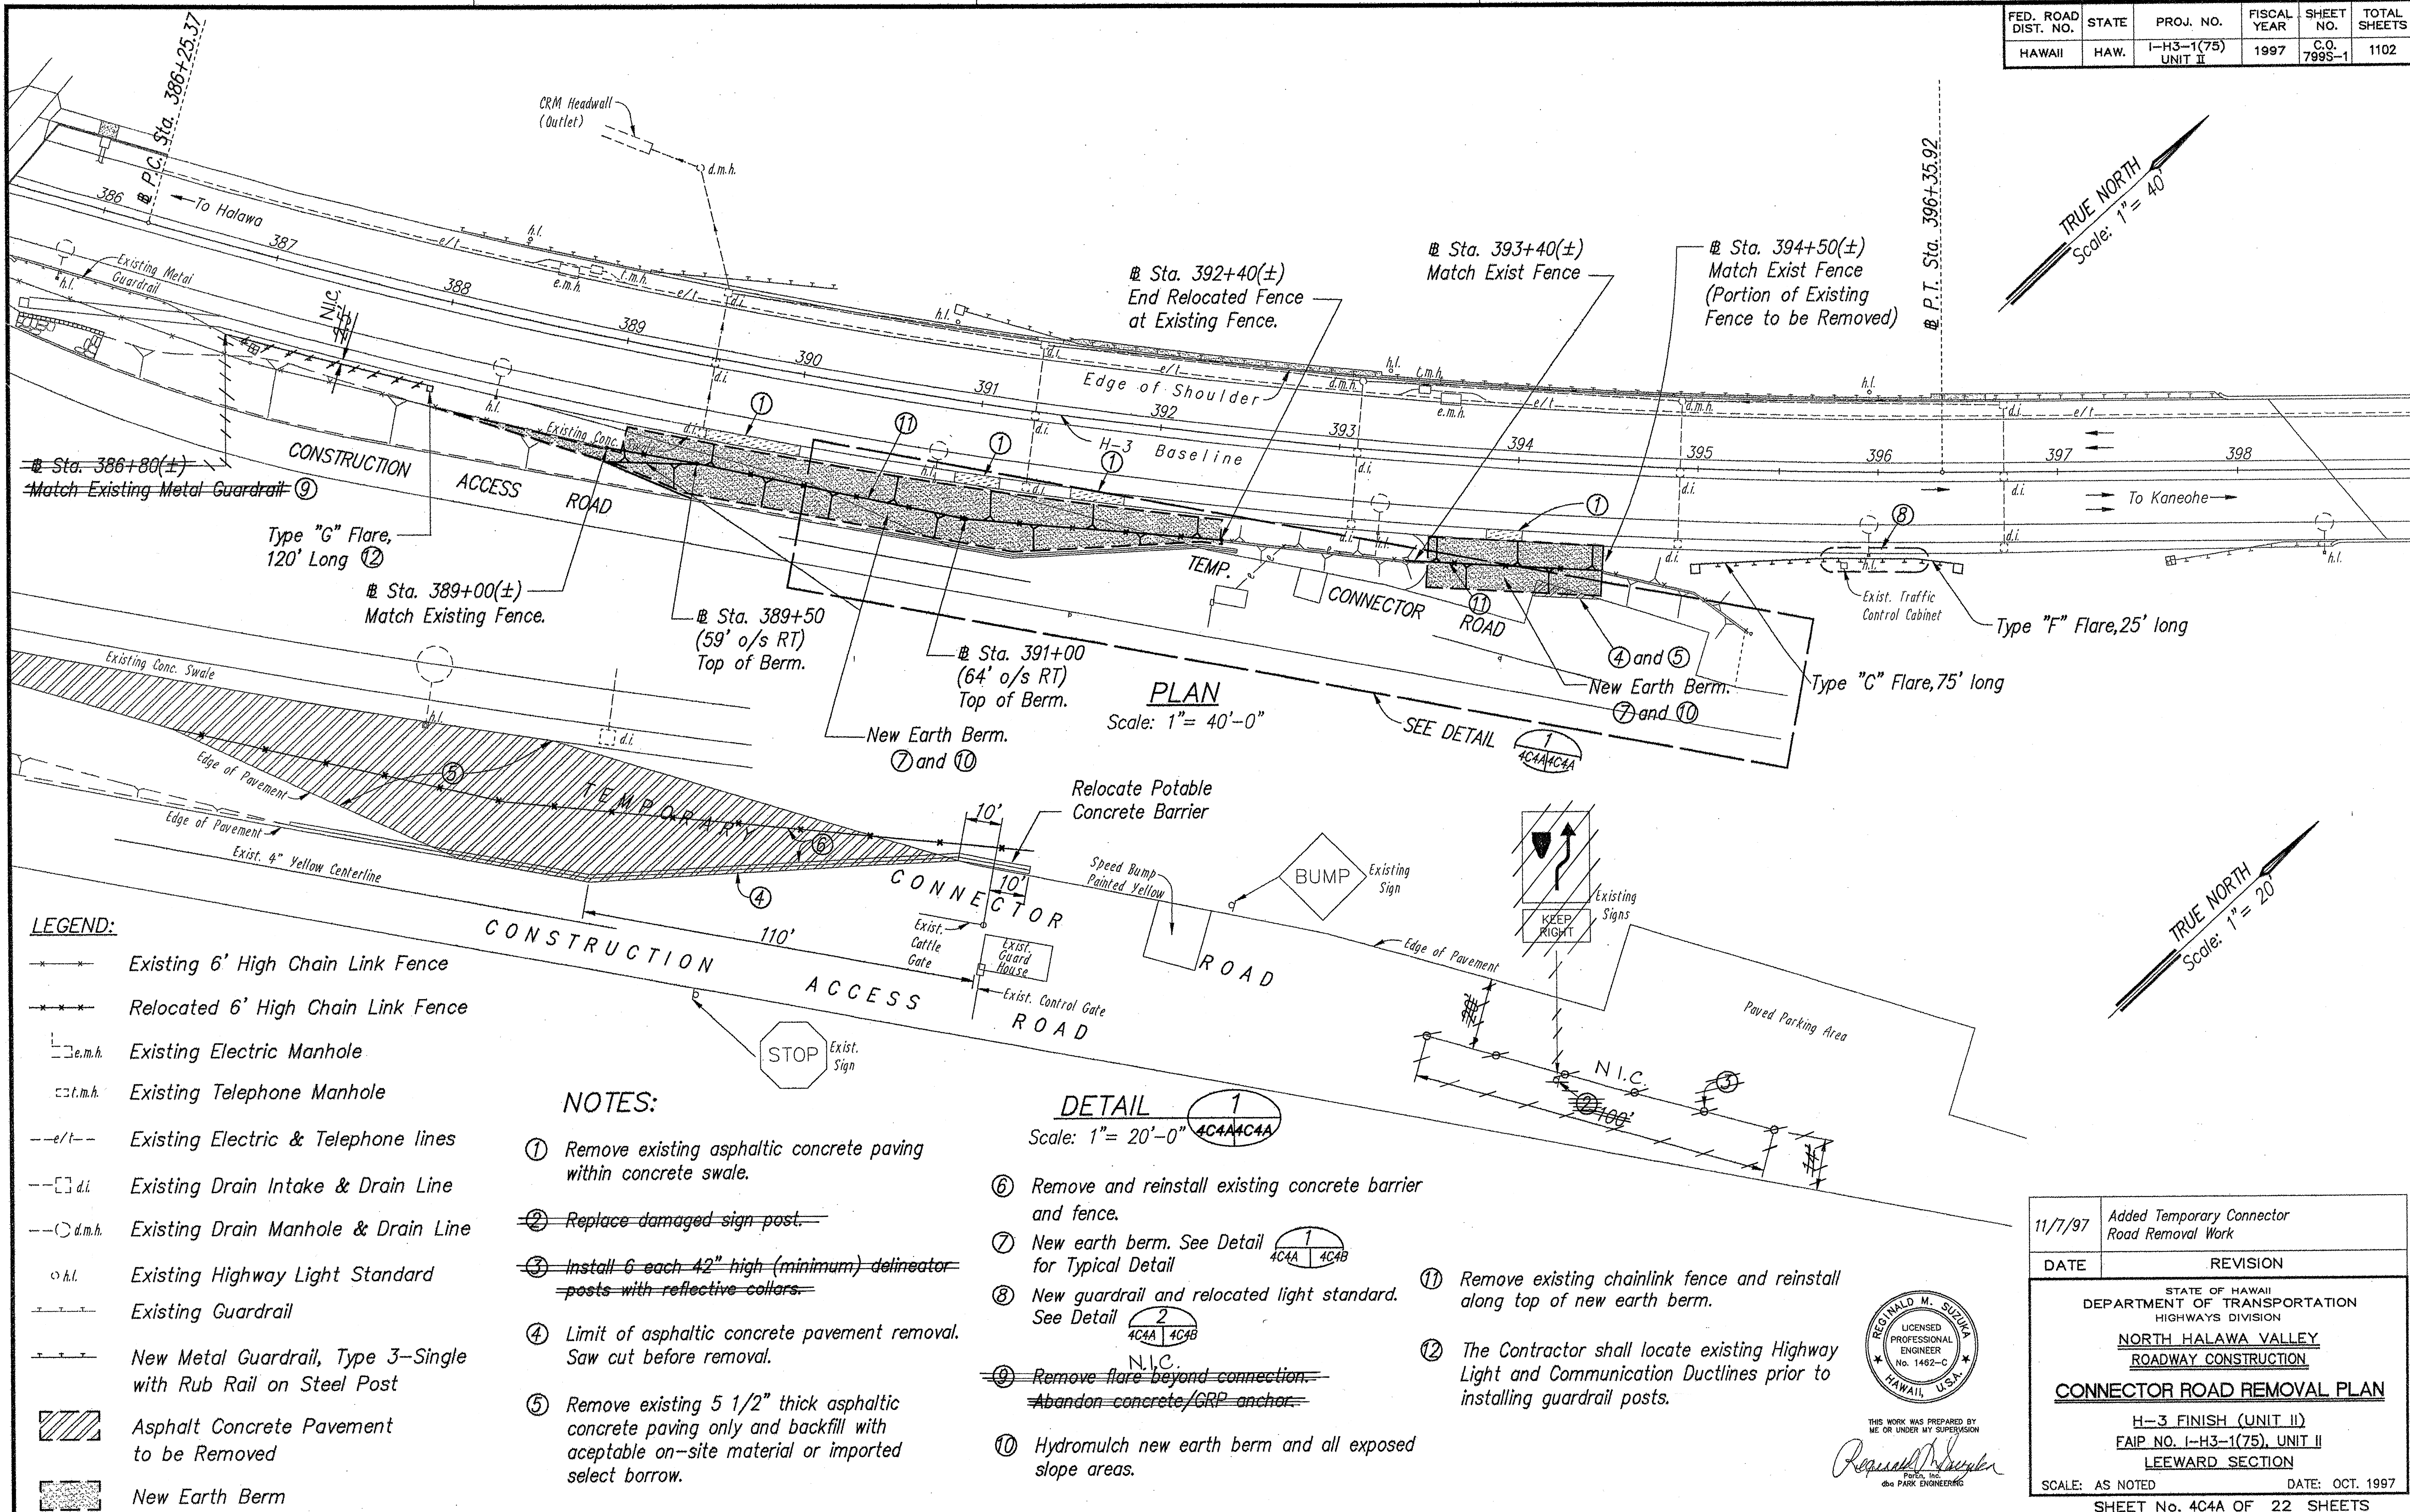

- LEGEND:**
- Existing 6' High Chain Link Fence
 - Relocated 6' High Chain Link Fence
 - Existing Electric Manhole
 - Existing Telephone Manhole
 - Existing Electric & Telephone lines
 - Existing Drain Intake & Drain Line
 - Existing Drain Manhole & Drain Line
 - Existing Highway Light Standard
 - Existing Guardrail
 - New Metal Guardrail, Type 3-Single with Rub Rail on Steel Post
 - Asphalt Concrete Pavement to be Removed
 - New Earth Berm

- NOTES:**
- Remove existing asphaltic concrete paving within concrete swale.
 - Replace damaged sign post.
 - Install 6 each 42" high (minimum) delineator posts with reflective collars.
 - Limit of asphaltic concrete paving removal. Saw cut before removal.
 - Remove existing 5 1/2" thick asphaltic concrete paving only and backfill with acceptable on-site material or imported select borrow.
 - Remove and reinstall existing concrete barrier and fence.
 - New earth berm. See Detail 1 for Typical Detail
 - New guardrail and relocated light standard. See Detail 2
 - Remove flare beyond connection. Abandon concrete/GRP anchor.
 - Hydromulch new earth berm and all exposed slope areas.


DETAIL 1
Scale: 1"= 20'-0"

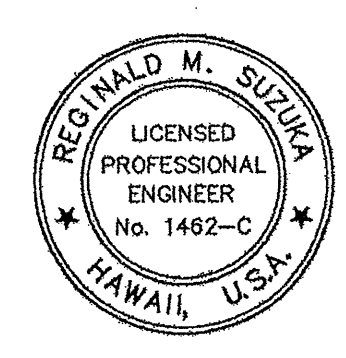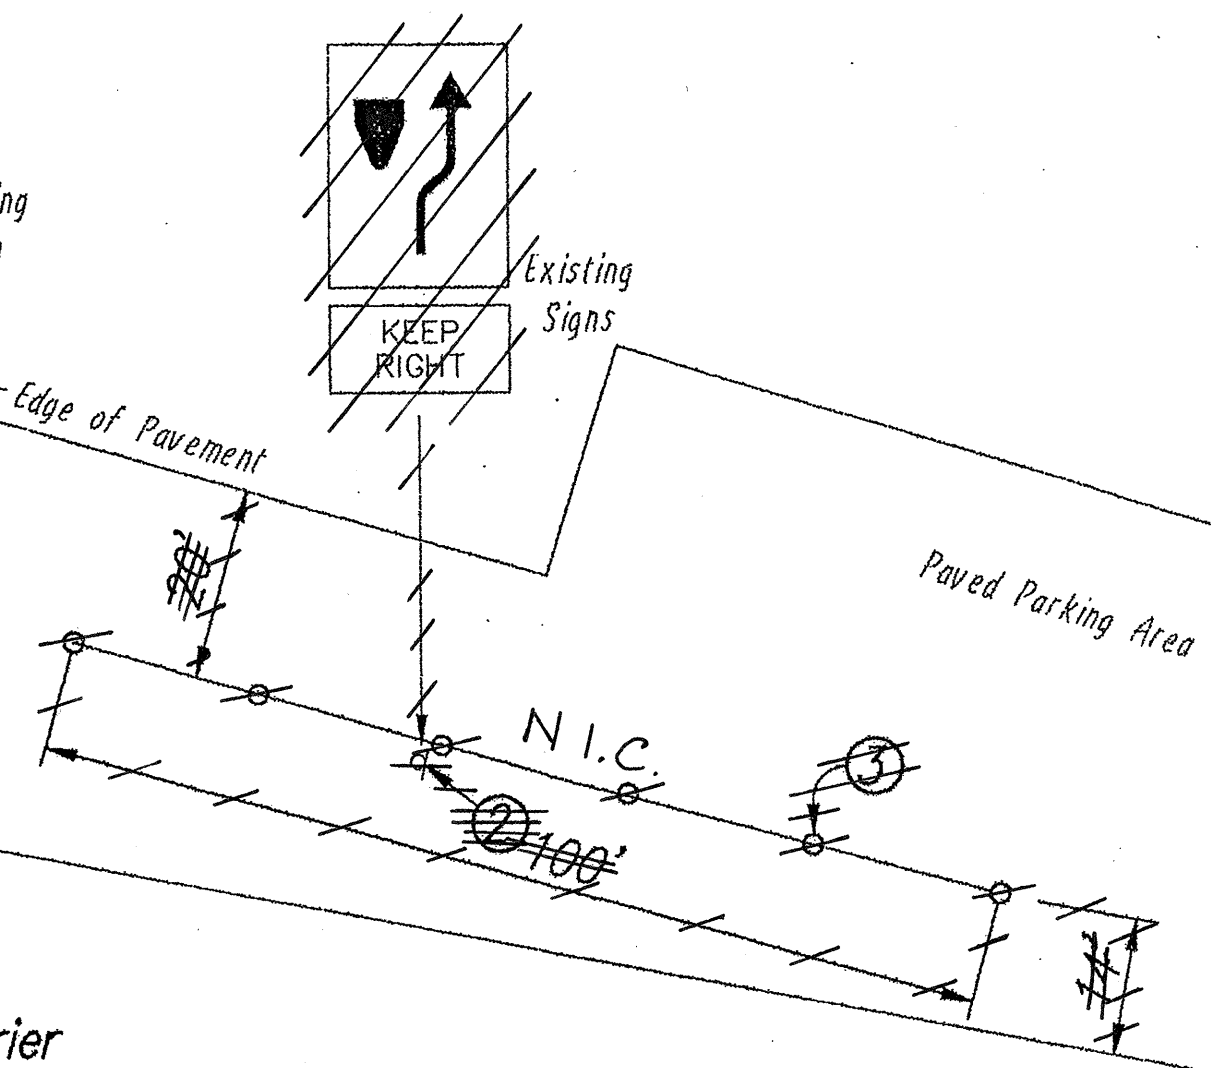

11/7/97	Added Temporary Connector Road Removal Work
DATE	REVISION
STATE OF HAWAII DEPARTMENT OF TRANSPORTATION HIGHWAYS DIVISION NORTH HALAWA VALLEY ROADWAY CONSTRUCTION CONNECTOR ROAD REMOVAL PLAN H-3 FINISH (UNIT II) FAIP NO. I-H3-1(75), UNIT II LEEWARD SECTION SCALE: AS NOTED DATE: OCT. 1997 SHEET No. 4C4A OF 22 SHEETS	


C.O. 799S-1

FED. ROAD DIST. NO.	STATE	PROJ. NO.	FISCAL YEAR	SHEET NO.	TOTAL SHEETS
HAWAII	HAW.	I-H3-1(75) UNIT II	1997	C.O. 799S-2	1102

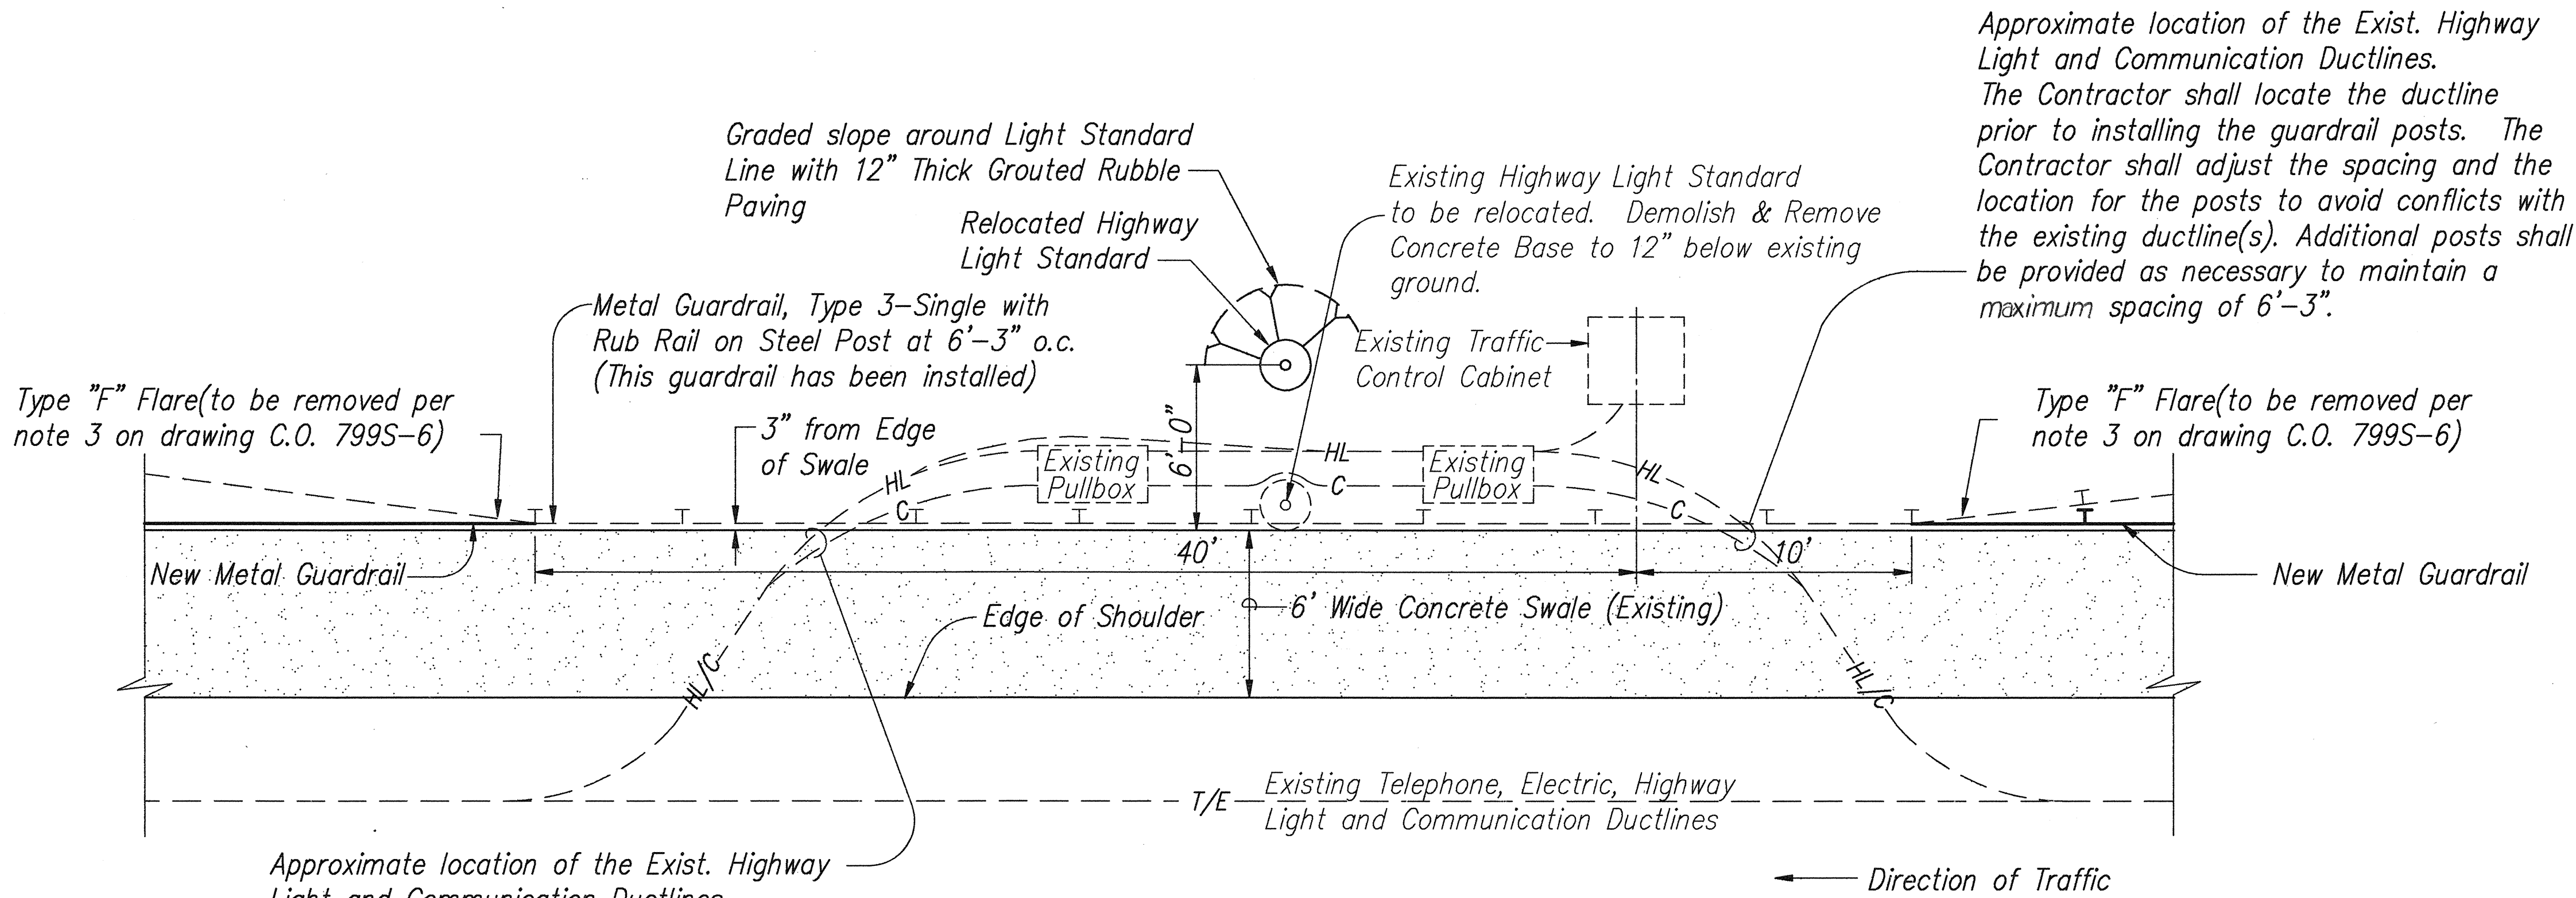

Approximate location of the Exist. Highway Light and Communication Ductlines. The Contractor shall locate the ductline prior to installing the guardrail posts. The Contractor shall adjust the spacing and the location for the posts to avoid conflicts with the existing ductline(s). Additional posts shall be provided as necessary to maintain a maximum spacing of 6'-3".


DETAIL 2
NOT TO SCALE
4C4A 4C4B

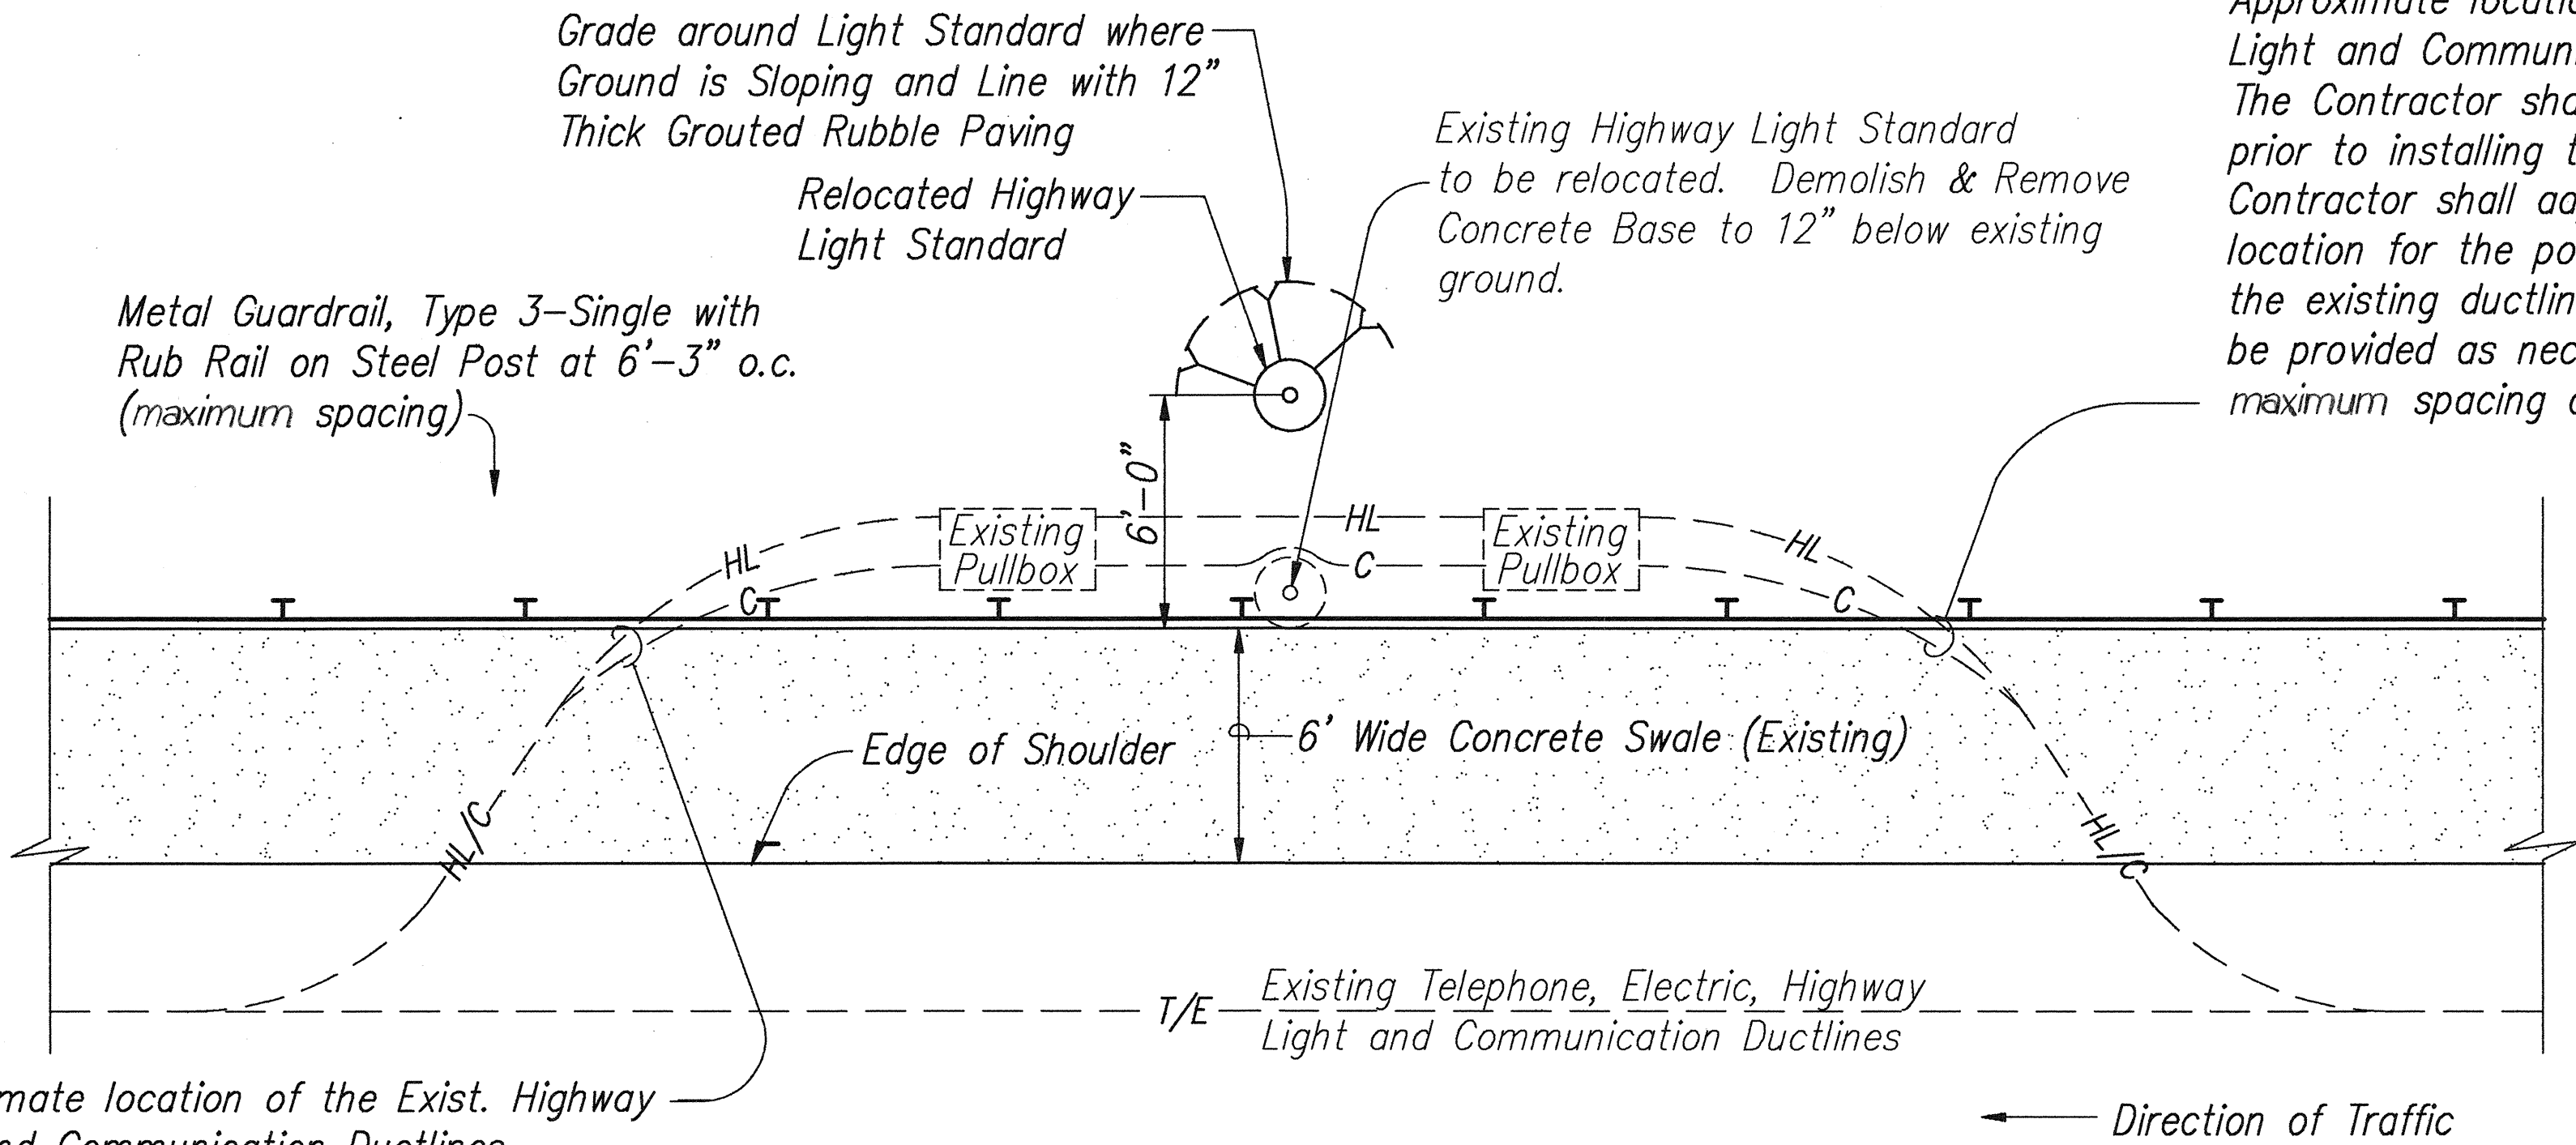


Approximate location of the Exist. Highway Light and Communication Ductlines. The Contractor shall locate the ductline prior to installing the guardrail posts. The Contractor shall adjust the spacing and the location for the posts to avoid conflicts with the existing ductline(s). Additional posts shall be provided as necessary to maintain a maximum spacing of 6'-3".

DETAIL 3
NOT TO SCALE
4C4F 4C4B

Approximate location of the Exist. Highway Light and Communication Ductlines. The Contractor shall locate the ductline prior to installing the guardrail posts. The Contractor shall adjust the spacing and the location for the posts to avoid conflicts with the existing ductline(s). Additional posts shall be provided as necessary to maintain a maximum spacing of 6'-3".

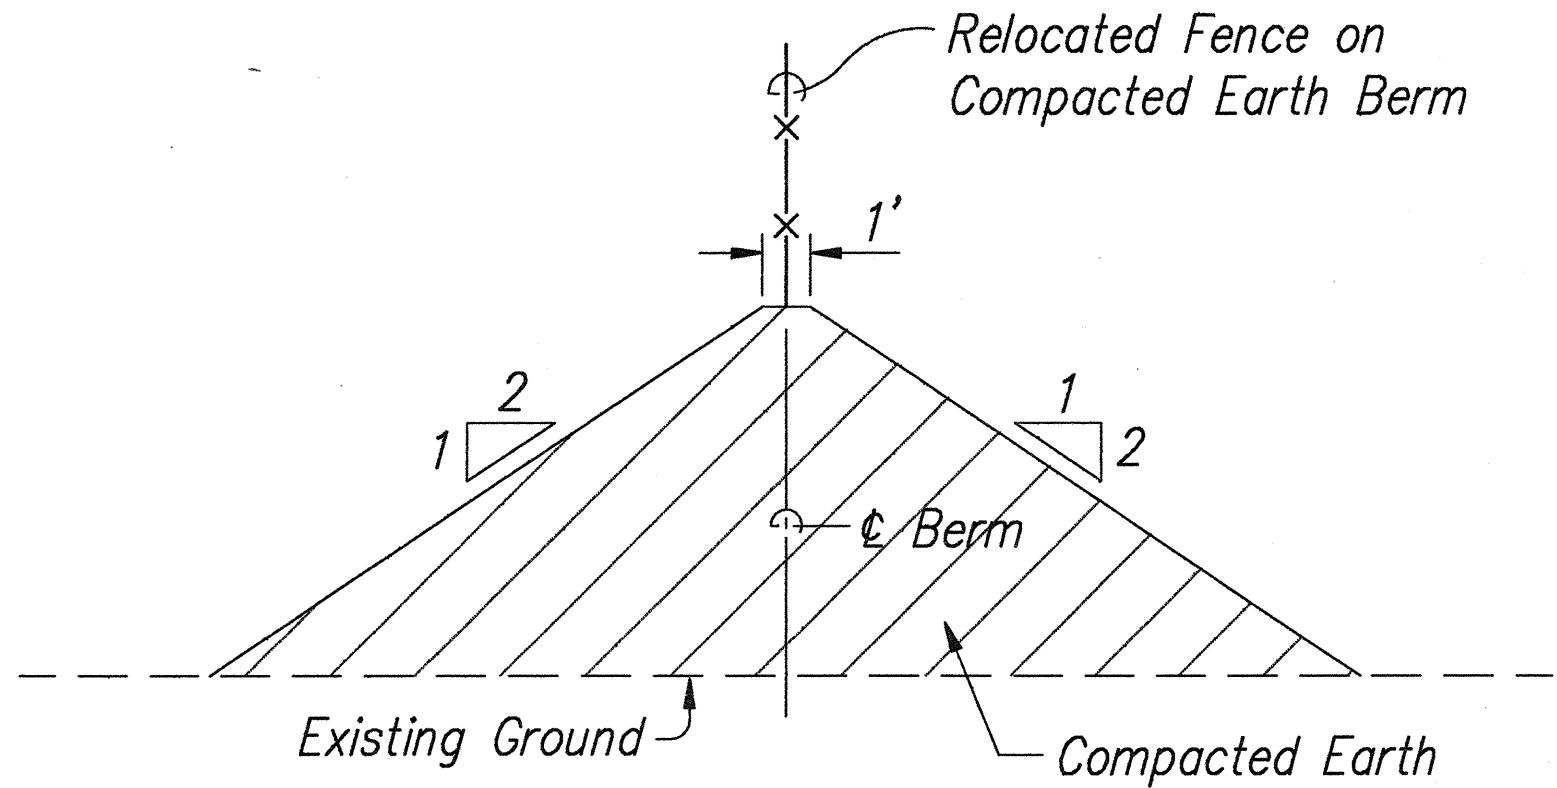

TYPICAL EARTH BERM
NOT TO SCALE
4C4A 4C4B

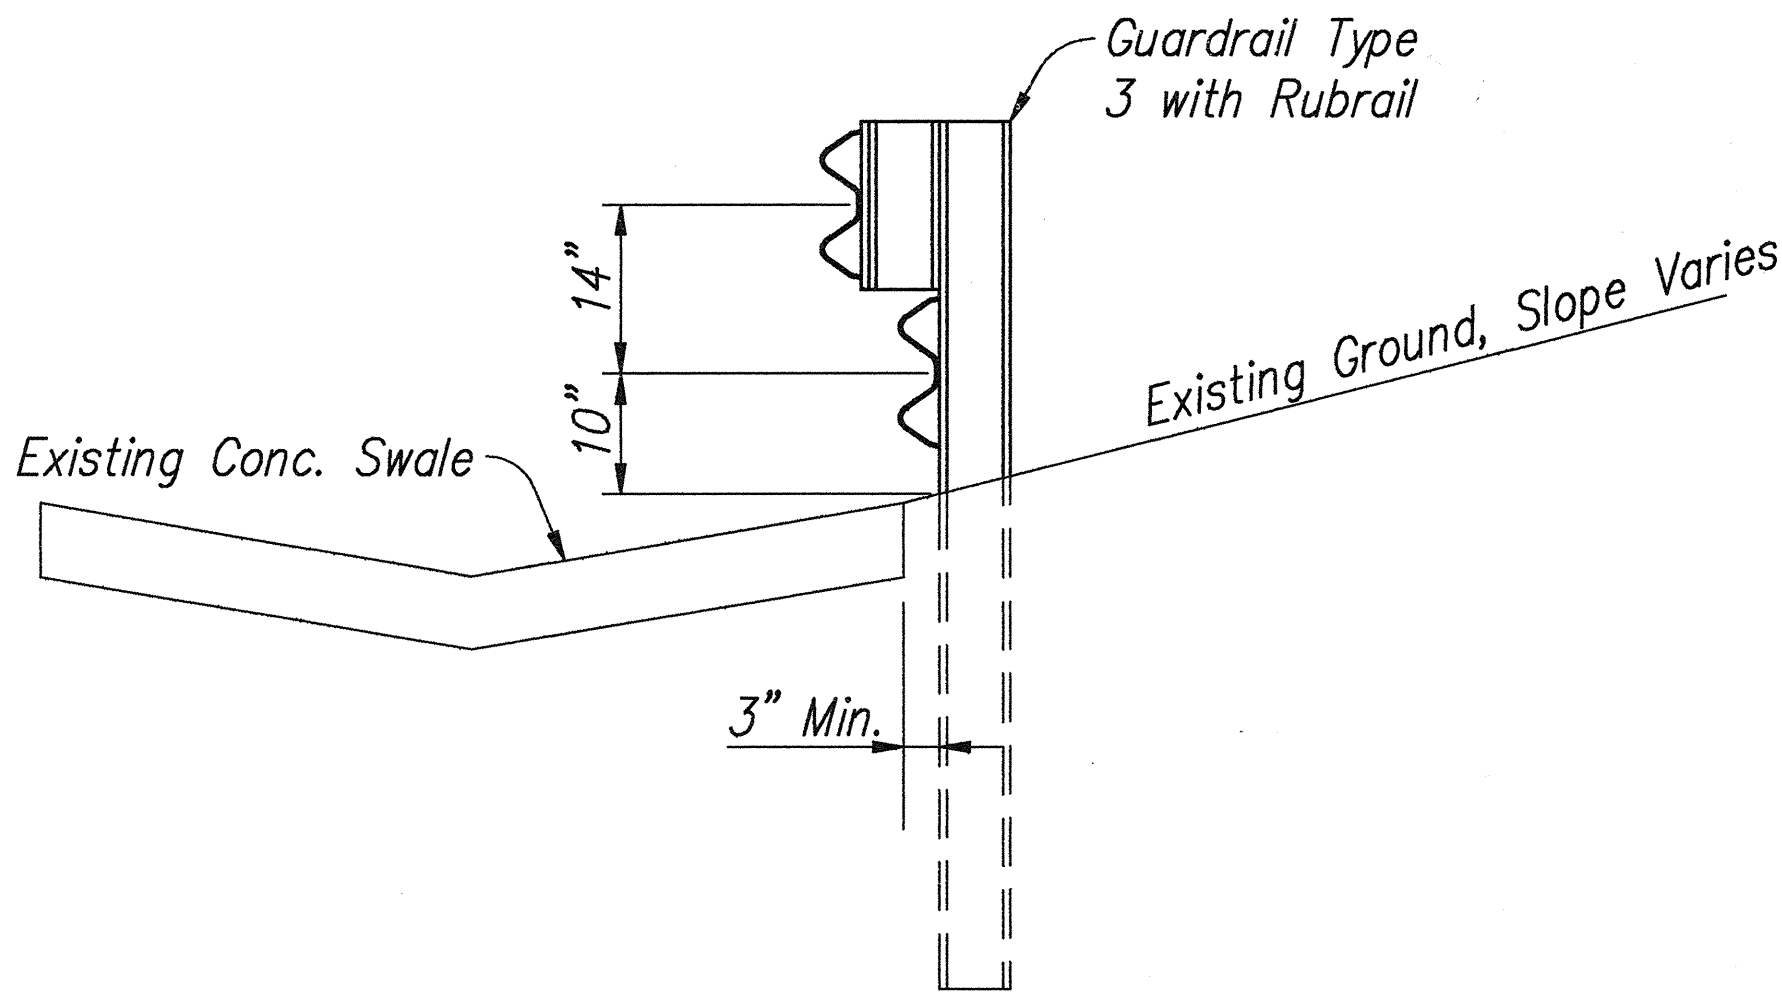

GUARDRAIL INSTALLATION 4
SCALE: 3/4" = 1'-0"
4C4F 4C4B

2/18/98	Added Detail 3 and Detail 4
11/7/97	Details for Temporary Connector Road Removal Work
DATE	REVISION



THIS WORK WAS PREPARED BY ME OR UNDER MY SUPERVISION
Reginald M. Suiyko
Professional Engineer
State of Hawaii

STATE OF HAWAII DEPARTMENT OF TRANSPORTATION HIGHWAYS DIVISION NORTH HALAWA VALLEY ROADWAY CONSTRUCTION DETAIL SHEET H-3 FINISH (UNIT II) FAIP NO. I-H3-1(75), UNIT II LEEWARD SECTION SCALE: AS NOTED DATE: OCT. 1997
--


SHEET No. 4C4B OF 22 SHEETS

C.O. 799S-2

SURVEY PLOTTED BY	DATE
DRAWN BY	
DESIGNED BY	
QUANTITIES BY	
CHECKED BY	
ORIGINAL PLAN	
NOTE BOOK	
No.	


FED. ROAD DIS. NO.	STATE	FED. AID PROJ. NO.	FISCAL YEAR	SHEET NO.	TOTAL SHEETS
HAWAII	HAW.	I-H3-1(75) UNIT II	1997	C.O. 799S-3	211

100 110

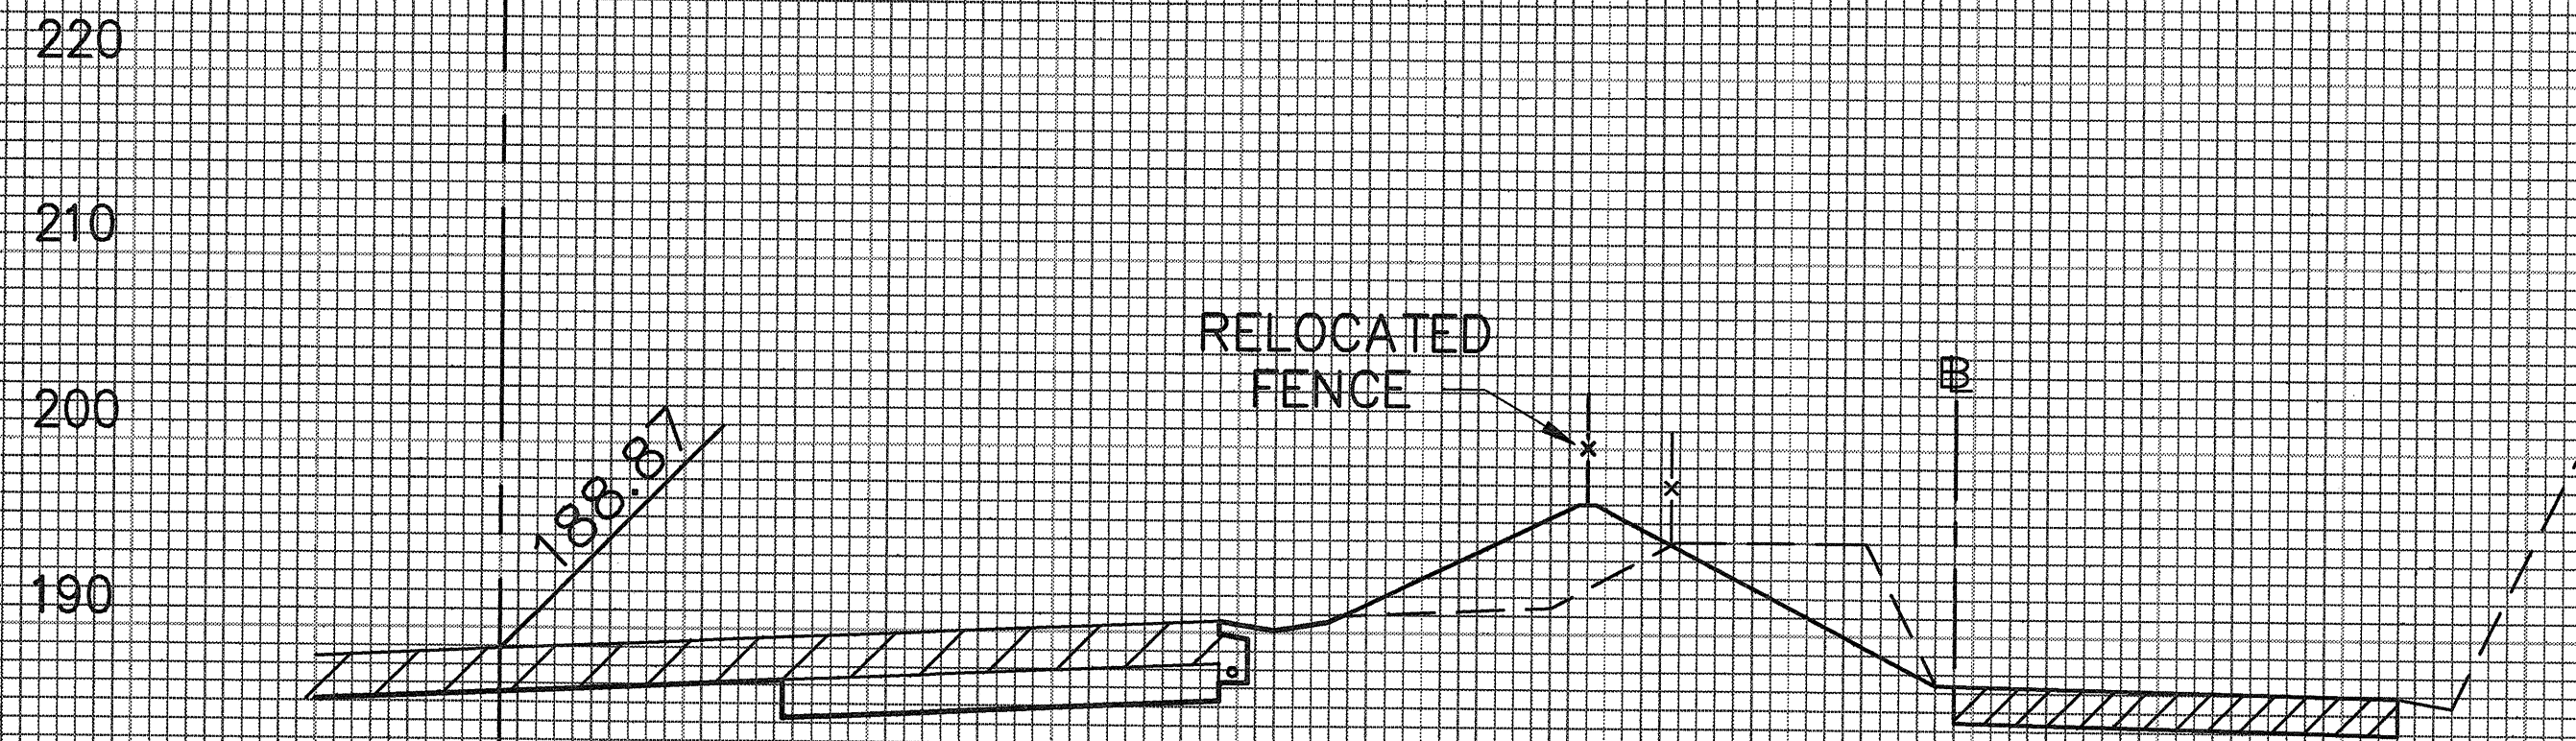

389+50


CUT = 45 SF
FILL = 45 SF
EXC = 42 CY
EMB = 42 CY

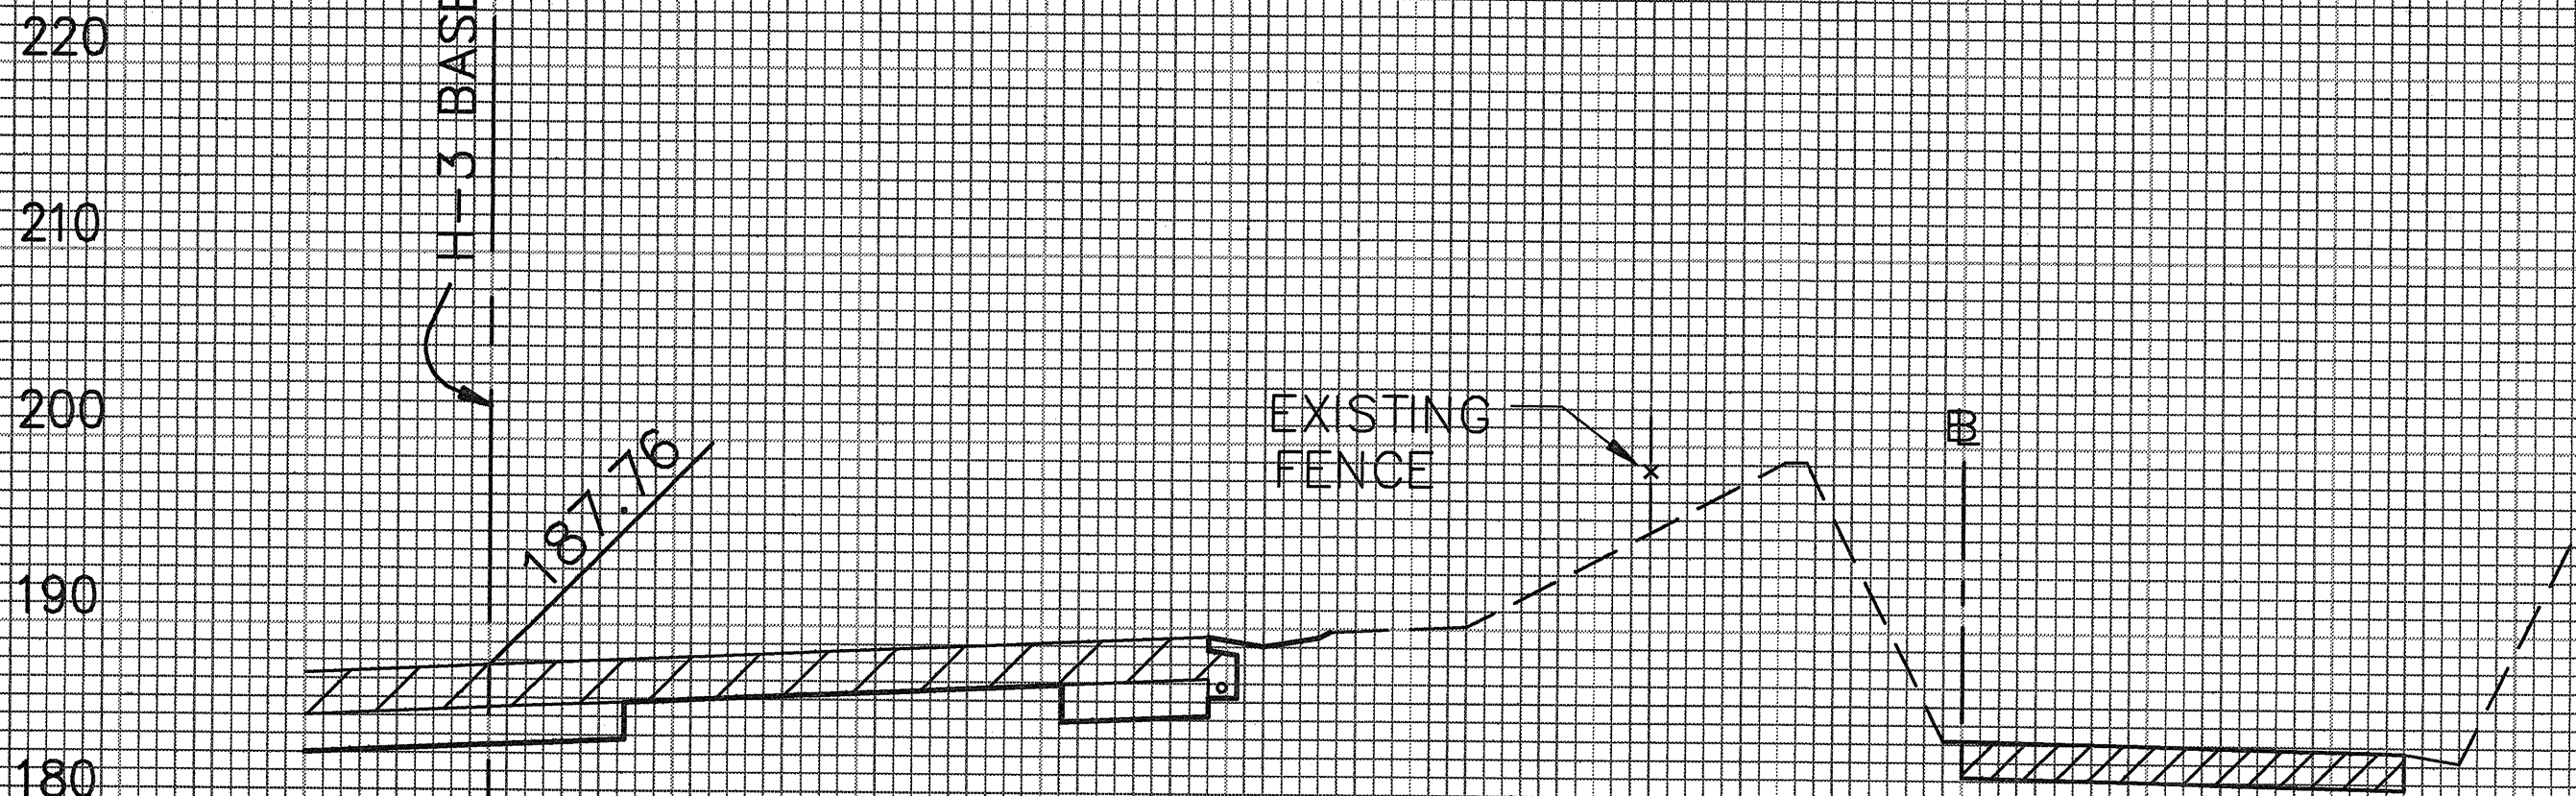

389+00


CUT = 0 SF
FILL = 0 SF

IH-3

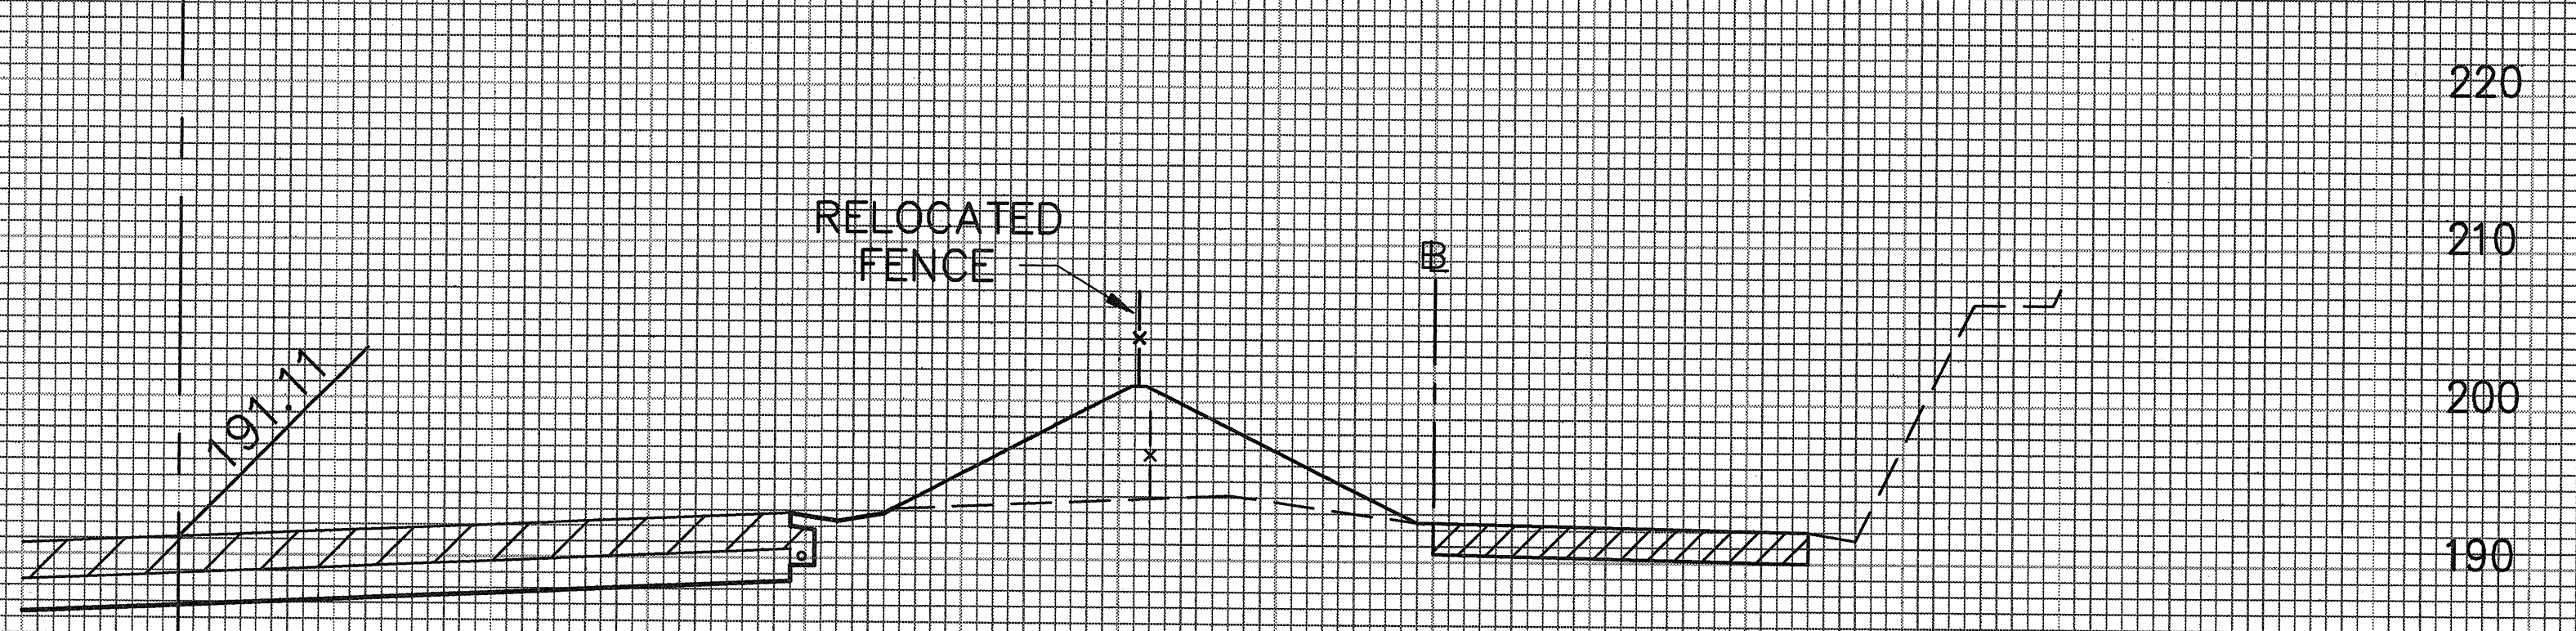

390+50

CUT = 0
FILL = 110 SF
EXC = 0
EMB = 194 CY

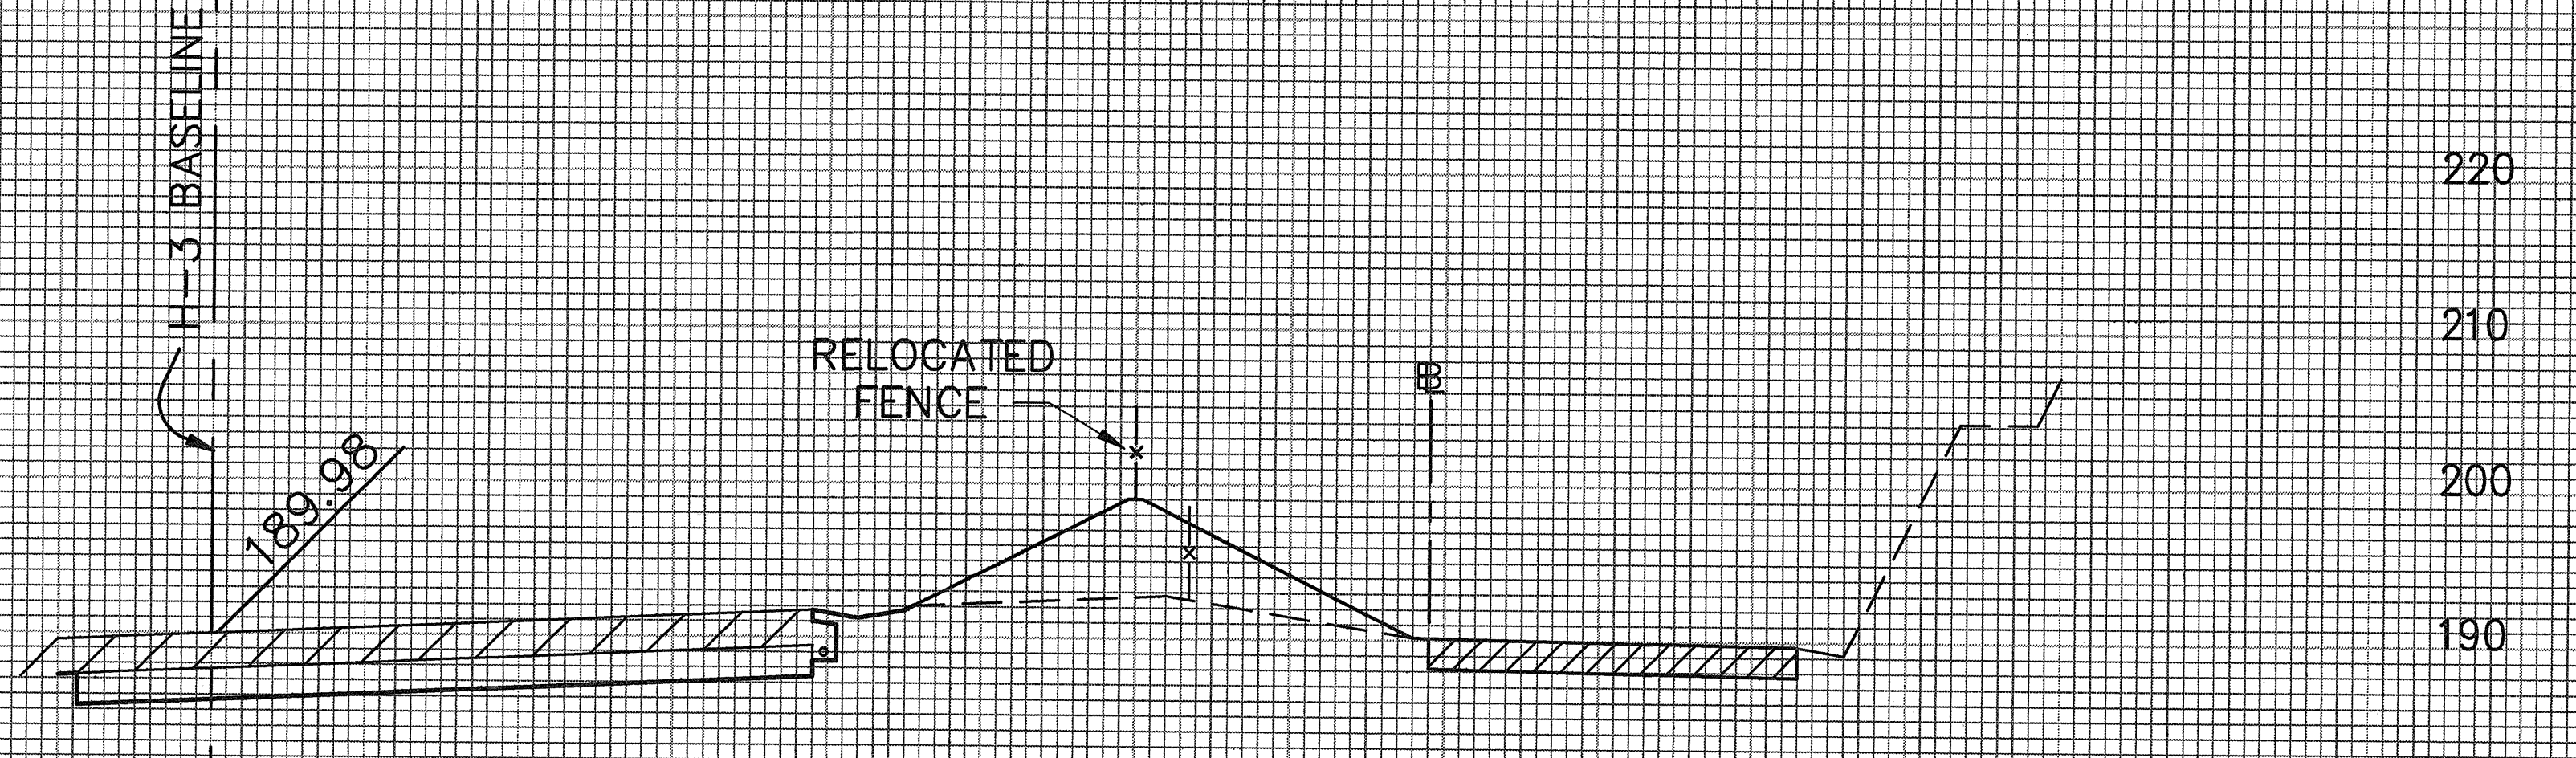


390+00

CUT = 0
FILL = 100 SF
EXC = 42 CY
EMB = 134 CY

IH-3

SURVEY PLATTED BY	DATE
DRAWN BY	
TRACED BY	
NOTED BY	
CHECKED BY	
No.	

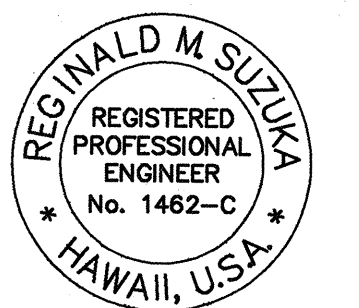

THIS WORK WAS PREPARED BY
ME OR UNDER MY SUPERVISION
Reginald M. Suzuki
FOR: INC.
dbs: PARK ENGINEERING

80 90 100 110


11/07/97	EARTHWORK FOR NEW BERM
DATE	REVISION

4C4C OF 22

C.O. 799S-3

FED. ROAD DIS. NO.	STATE	FED. AID PROJ. NO.	FISCAL YEAR	SHEET NO.	TOTAL SHEETS
HAWAII	HAW.	I-H3-1(75) UNIT II	1997	C.O. 799S-4	211


100 110

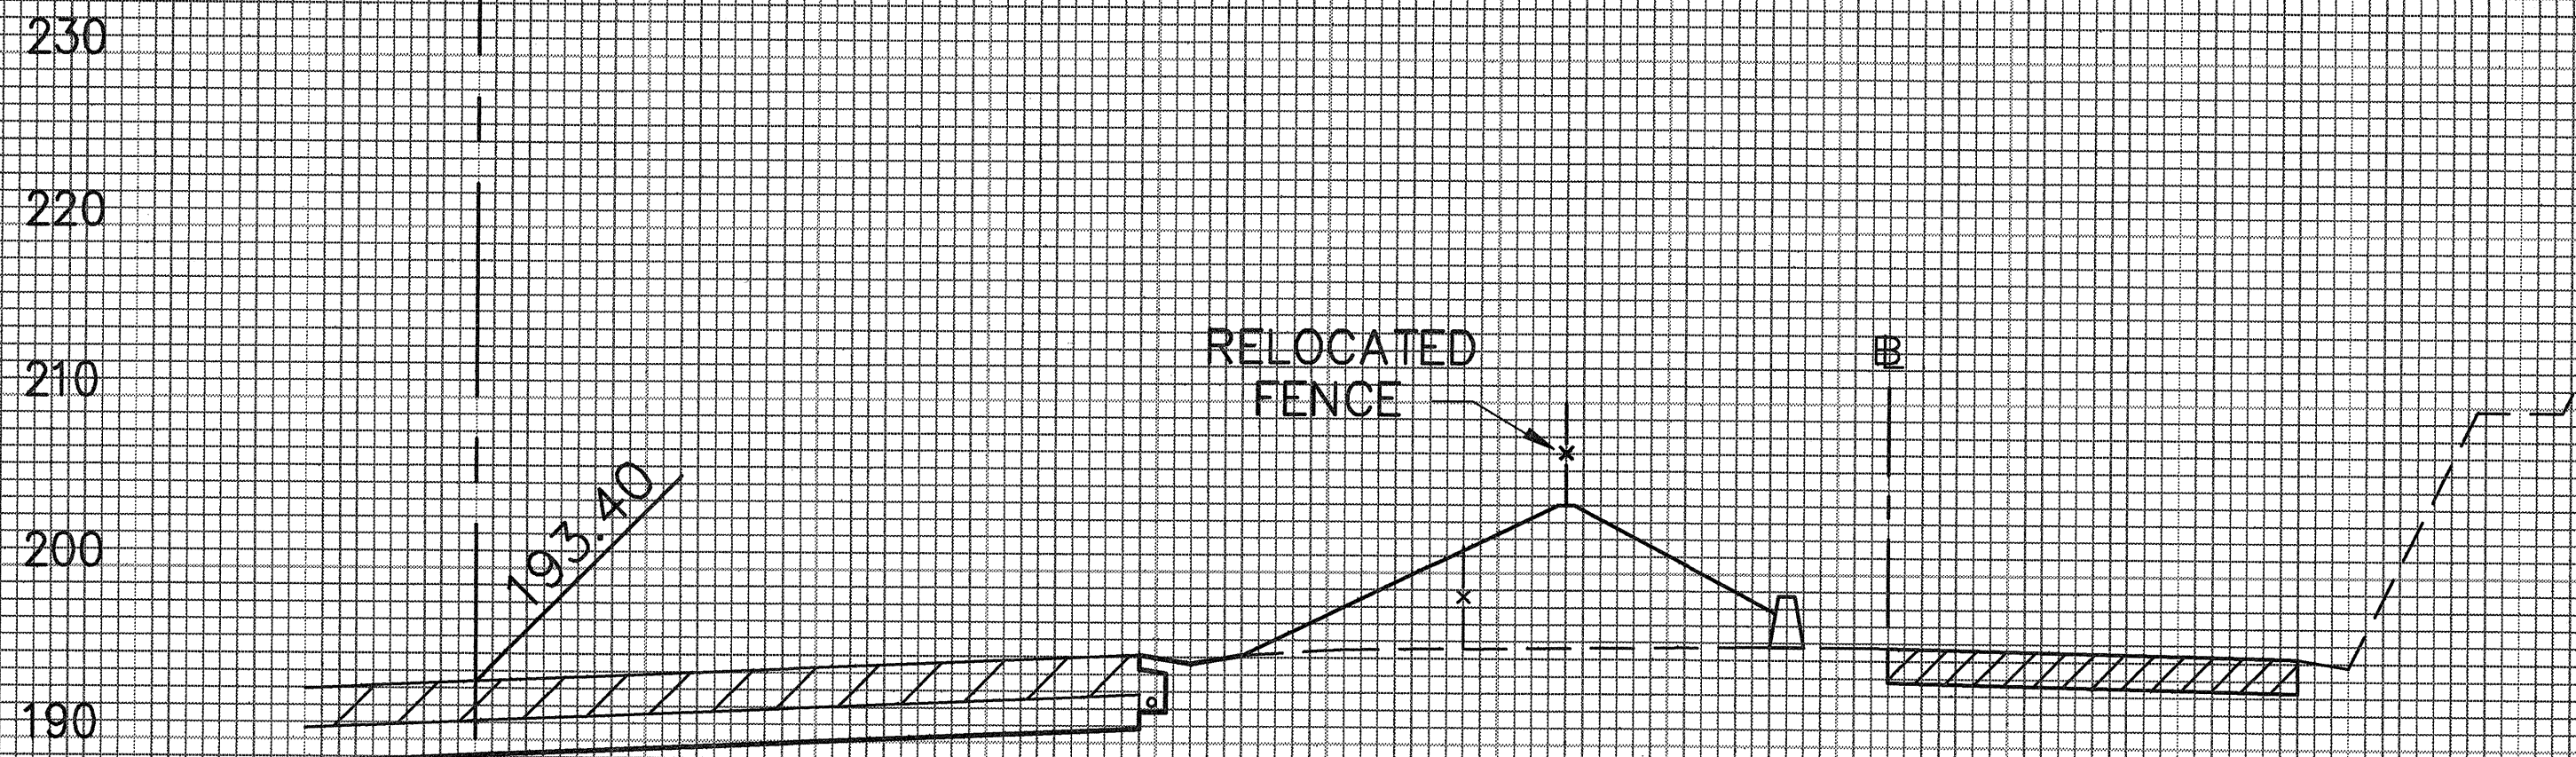

391+50

CUT = 0 SF
FILL = 120 SF

EXC = 0 CY
EMB = 250 CY

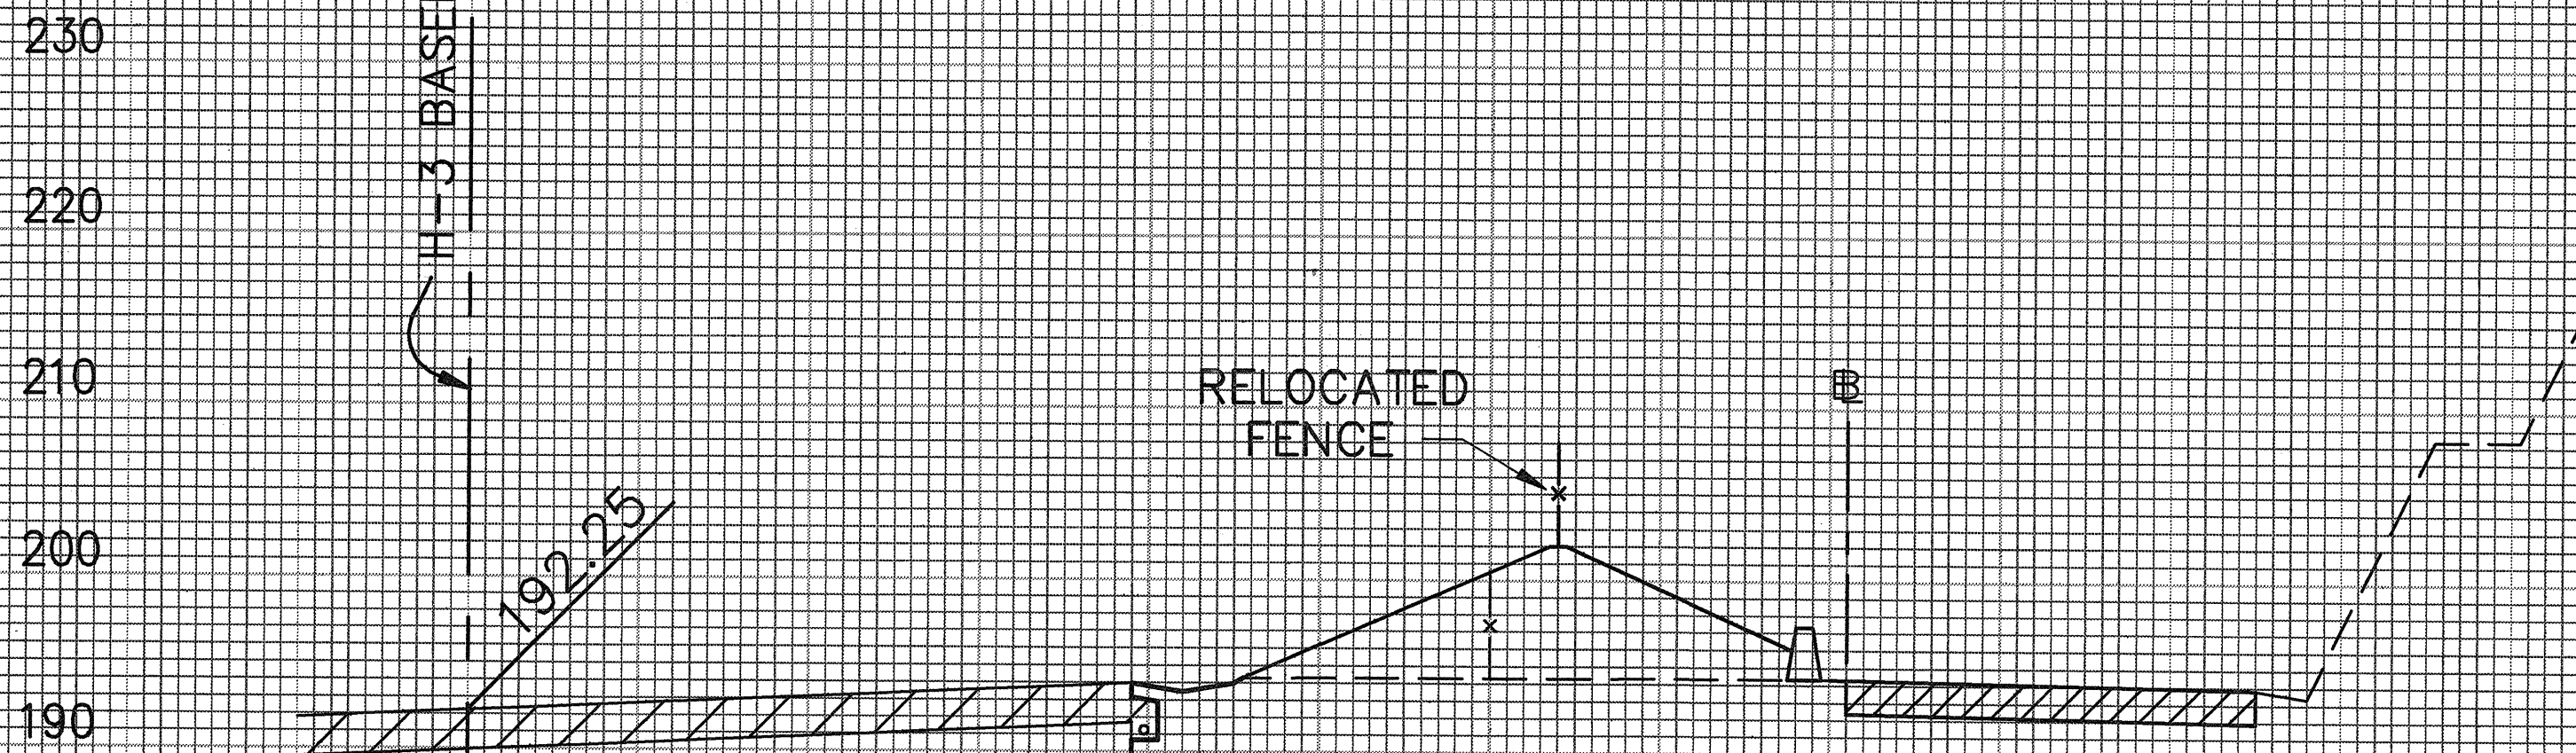


391+00

CUT = 0 SF
FILL = 150 SF

EXC = 0 CY
EMB = 241 CY


IH-3

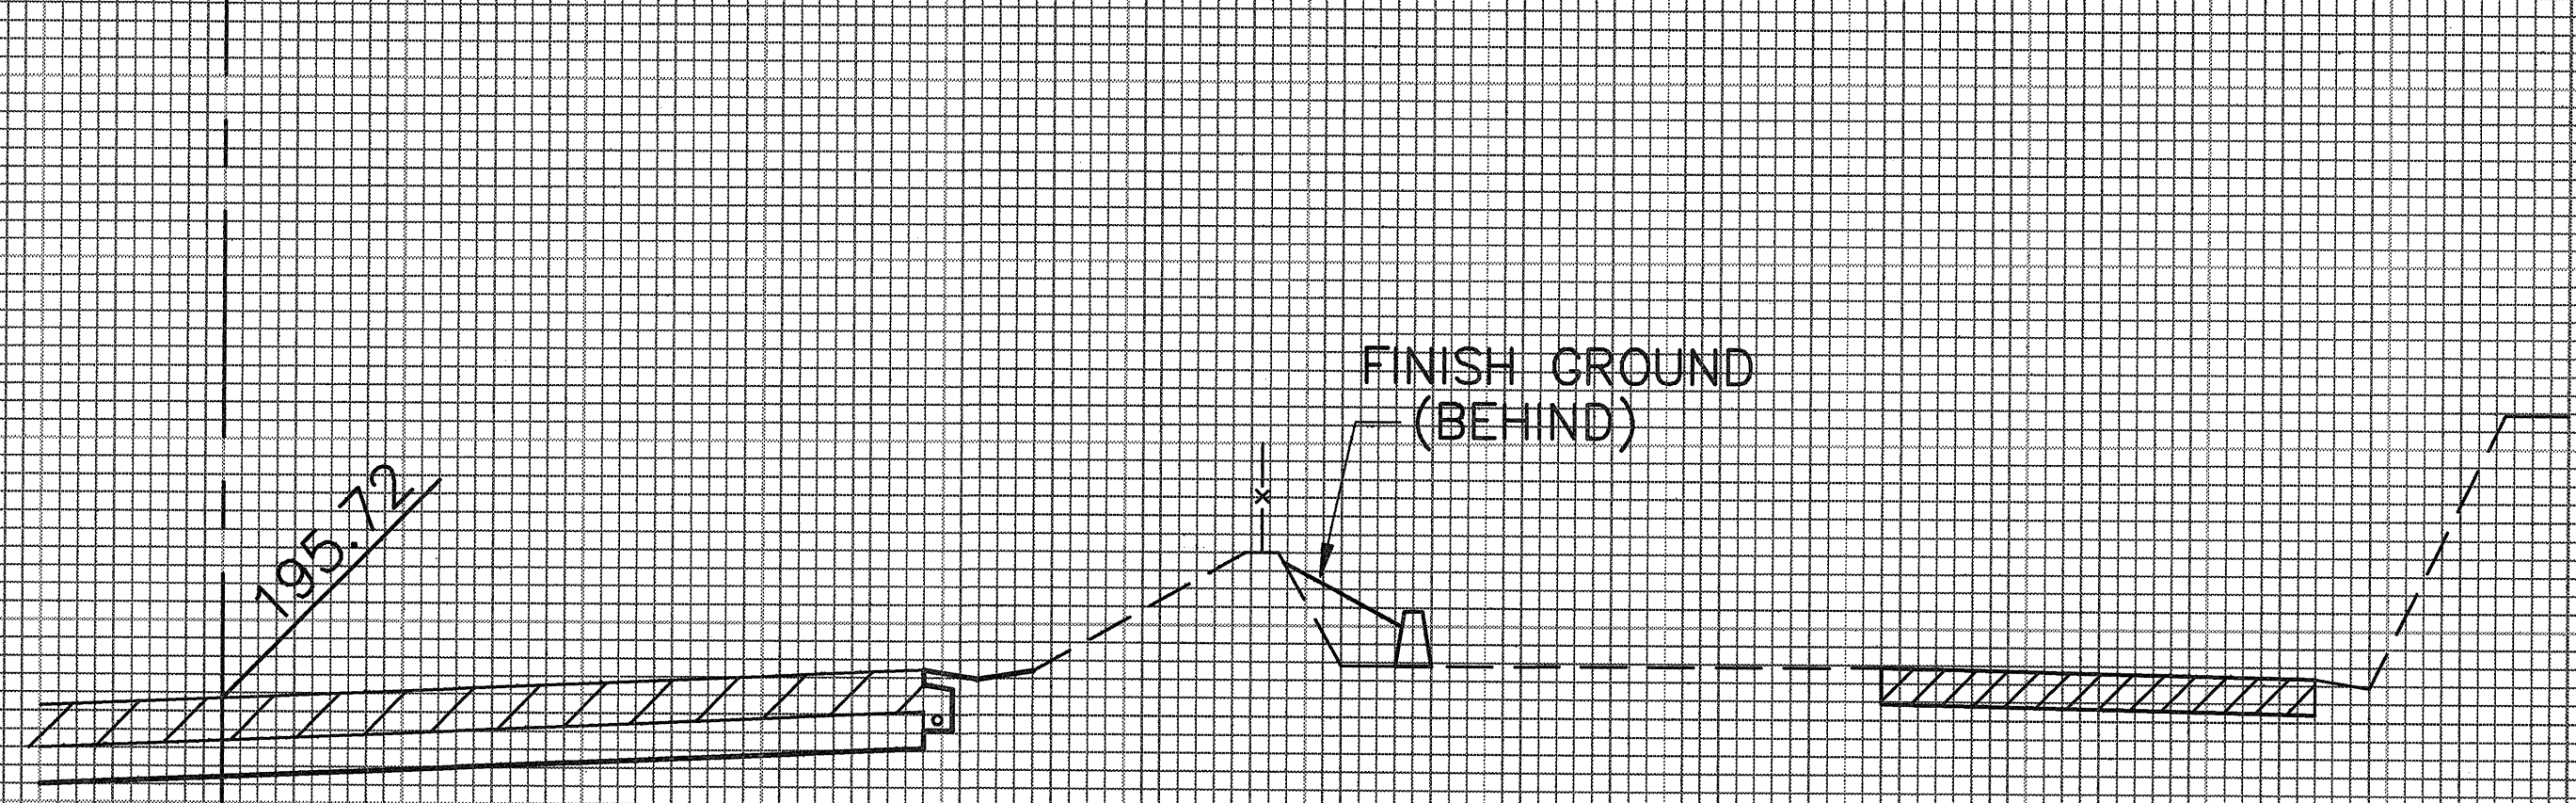

392+50

CUT = 0 SF
FILL = 0 SF

EXC = 0 CY
EMB = 52 CY

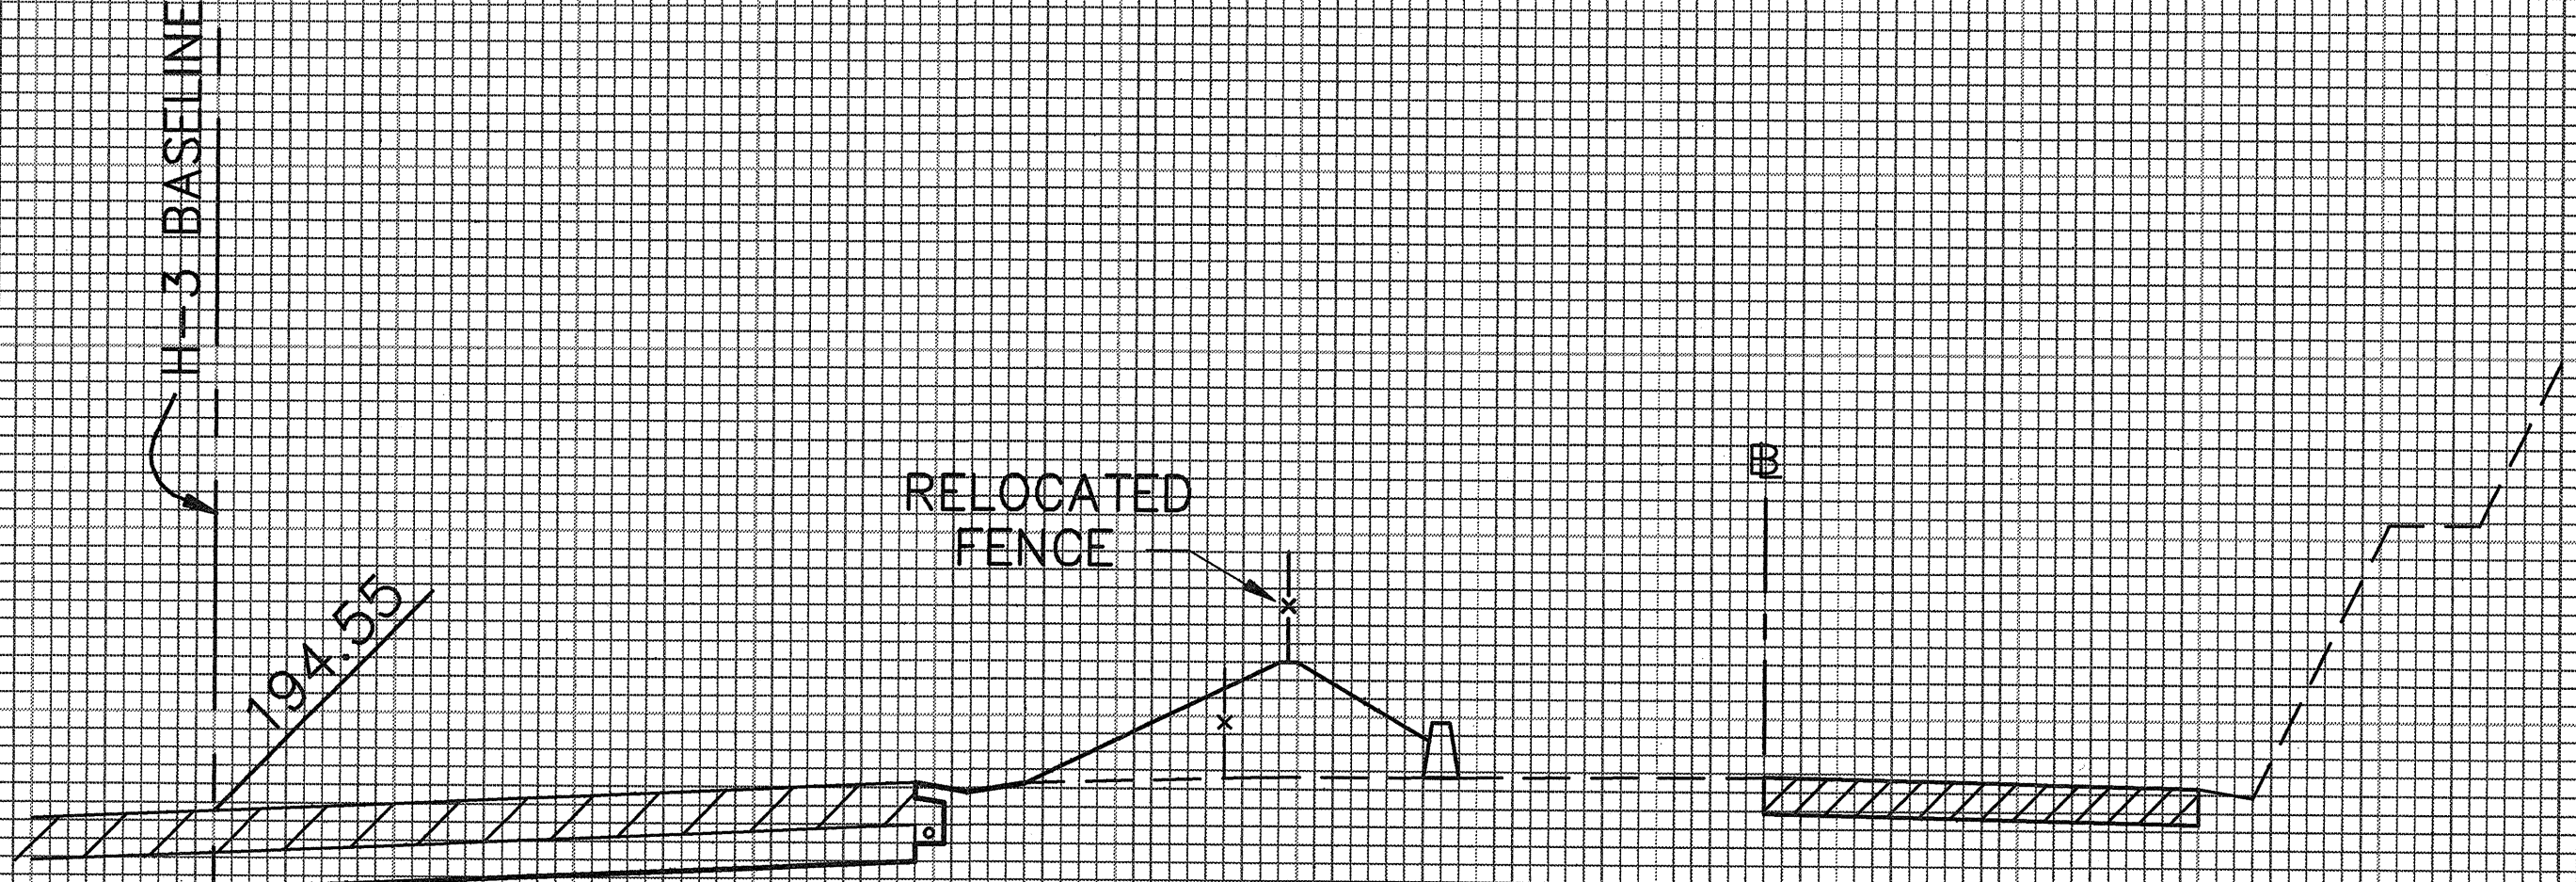


392+00

CUT = 0 SF
FILL = 70 SF

EXC = 0 CY
EMB = 176 CY

IH-3

ORIGINAL PLAN	DATE
DRAWN BY	
CHECKED BY	
NOTED BY	
QUANTITY BY	
NO.	

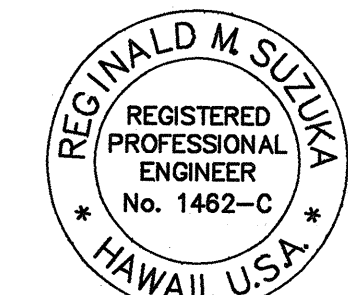


THIS WORK WAS PREPARED BY ME OR UNDER MY SUPERVISION
Ronald M. Suzuki
dba: PARK ENGINEERING

11/07/97	EARTHWORK FOR NEW BERM
DATE	REVISION

C.O. 799S-4

FED. ROAD DIS. NO.	STATE	FED. AID PROJ. NO.	FISCAL YEAR	SHEET NO.	TOTAL SHEETS
HAWAII	HAW.	I-H3-1(75) UNIT II	1997	C.O. 799 S-5	211

TOTAL QUANTITIES
EXCAVATION = 83 C.Y.
EMBANKMENT = 1344 C.Y.

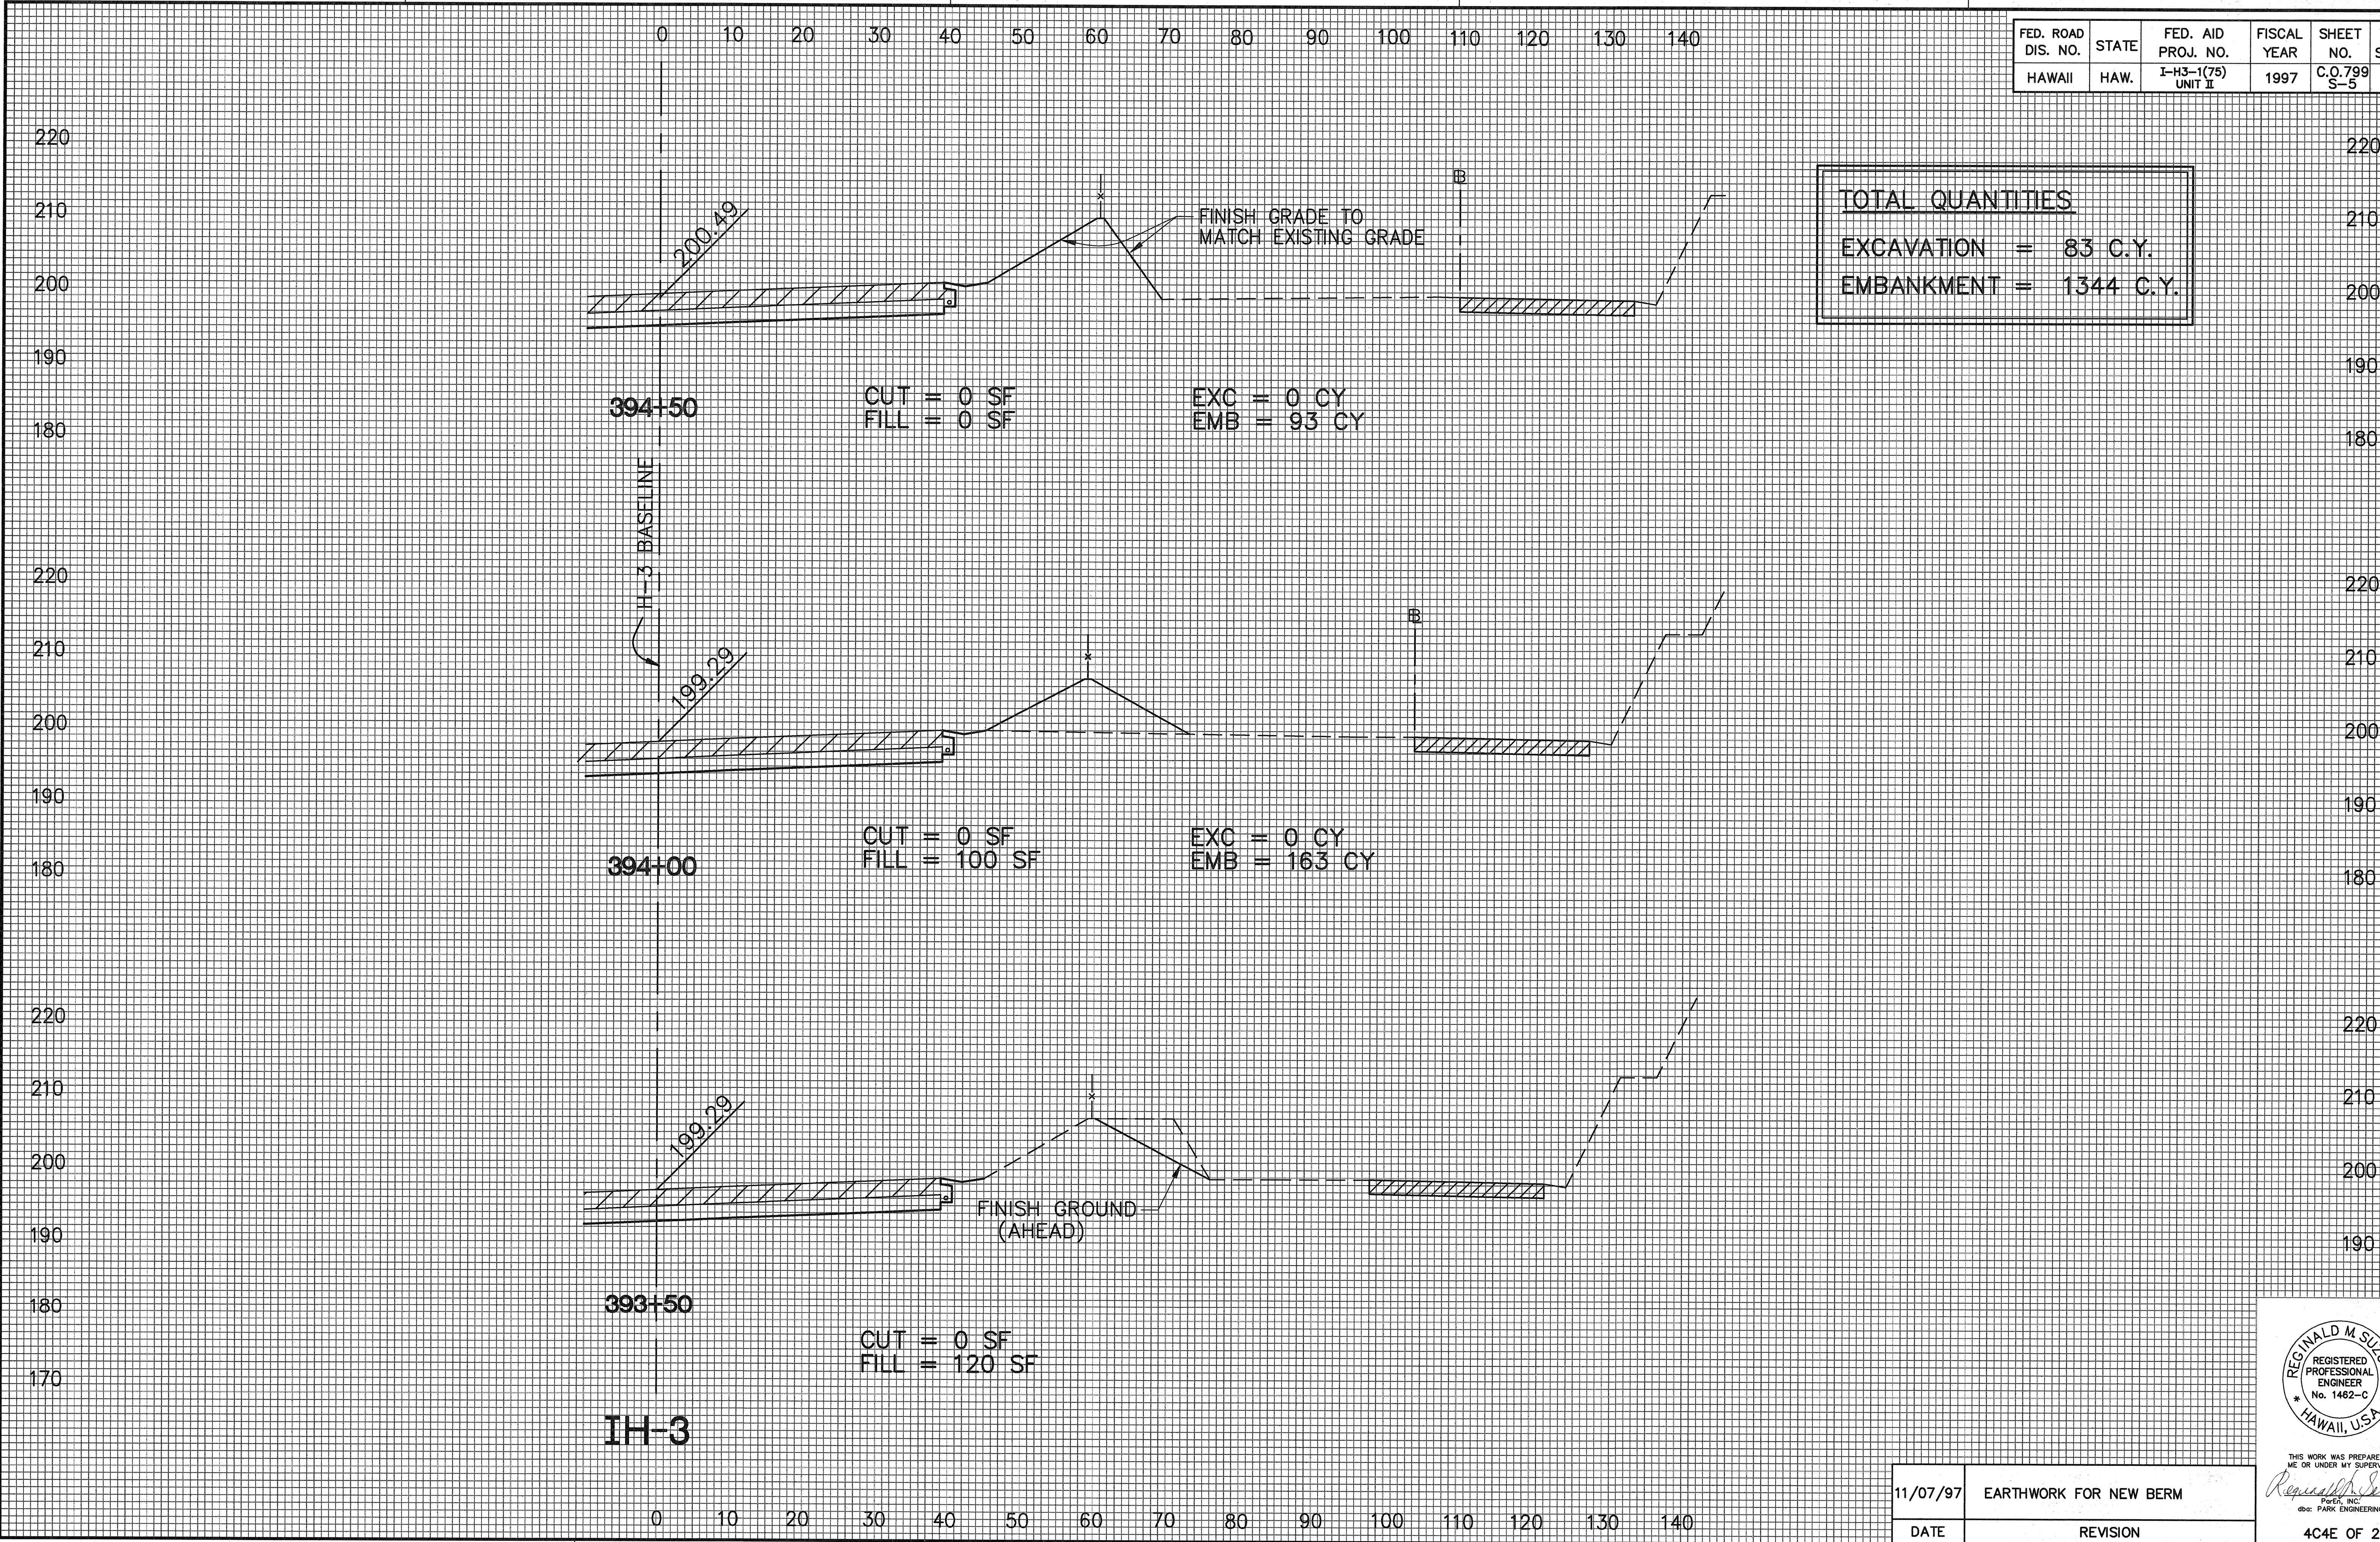


SURVEY PLANNED BY	DATE
DRAWN BY	
TRACED BY	
CHECKED BY	
QUANTITIES BY	
CHECKED BY	
ORIGINAL PLAN	
NOTES	
NO.	

REGINALD M. SUZUKI
REGISTERED
PROFESSIONAL
ENGINEER
No. 1462-C
HAWAII, U.S.A.

THIS WORK WAS PREPARED BY
ME OR UNDER MY SUPERVISION

Reginald M. Suzuki
P.E., INC.
dba: PARK ENGINEERING

FED. ROAD DIST. NO.	STATE	PROJ. NO.	FISCAL YEAR	SHEET NO.	TOTAL SHEETS
HAWAII	HAW.	1-H3-1(75) UNIT II	1997	C.O. 799S-6	1102

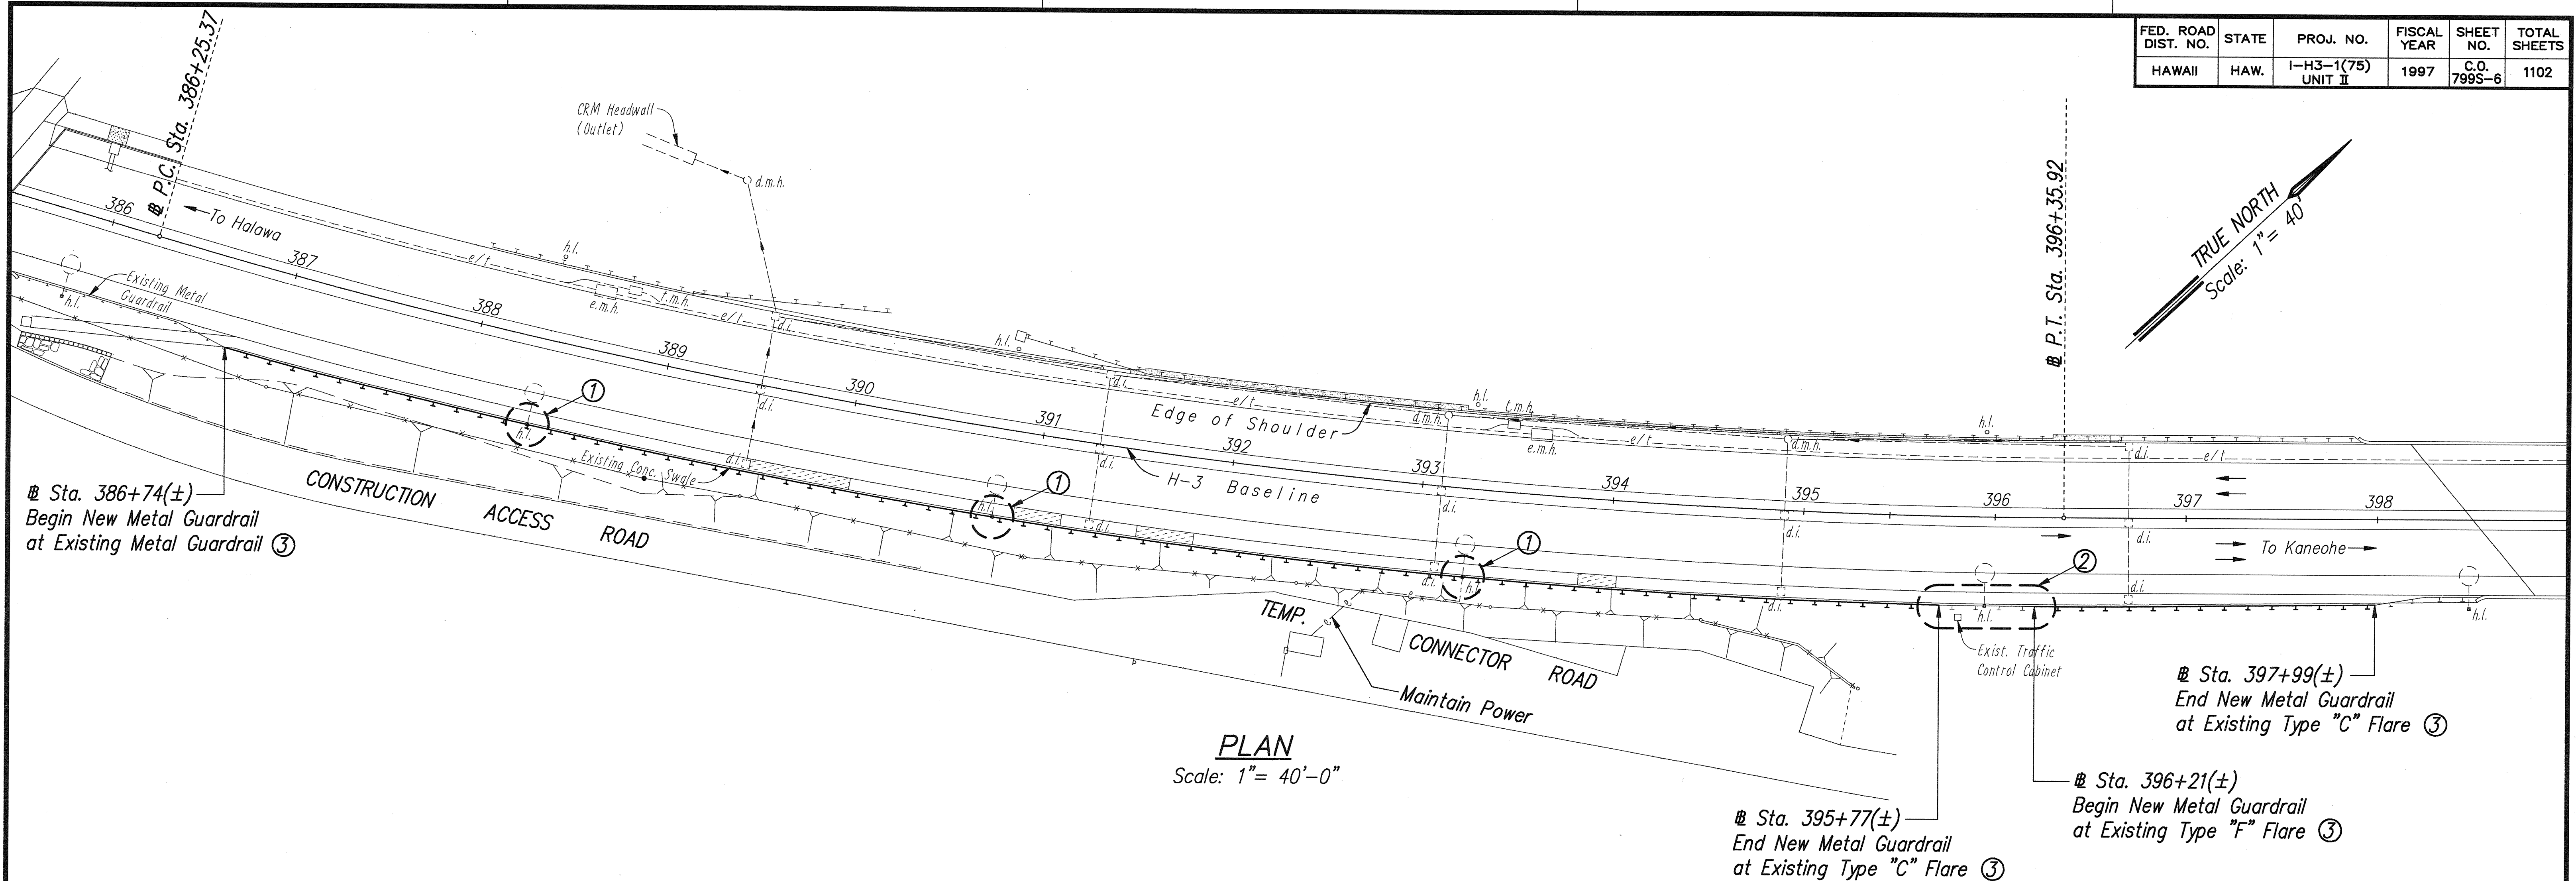


LEGEND:

- Existing 6' High Chain Link Fence
- Existing Electric Manhole
- Existing Telephone Manhole
- Existing Electric & Telephone lines
- Existing Drain Intake & Drain Line
- Existing Drain Manhole & Drain Line
- Existing Highway Light Standard
- Existing Guardrail
- New Metal Guardrail, Type 3-Single with Rub Rail on Steel Post

NOTES:

- New guardrail and relocated light standard. See Detail 3 (4C4F, 4C4B)
- Existing guardrail and light standard. See Detail 2 (4C4A, 4C4B)
- Remove flare beyond connection. Also remove concrete/GRP anchor.

SURVEY PLOTTED BY	DATE
DRAWN BY	
TRACED BY	
CHECKED BY	
ORIGINAL PLAN	
NOTE BOOK	
No.	

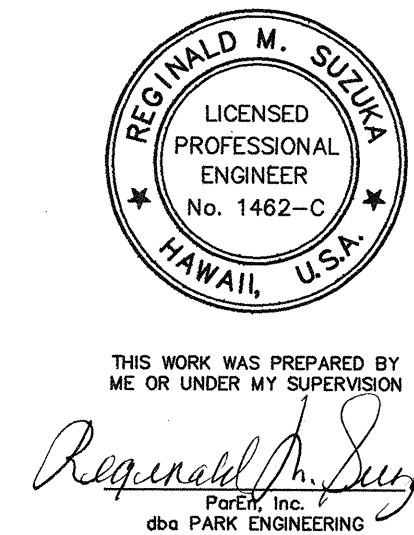


3/3/98	New Sheet Added for Additional Guardrails
DATE	REVISION
STATE OF HAWAII DEPARTMENT OF TRANSPORTATION HIGHWAYS DIVISION NORTH HALAWA VALLEY ROADWAY CONSTRUCTION ADD'L. GUARDRAILS PLAN H-3 FINISH (UNIT II) FAIP NO. 1-H3-1(75), UNIT II LEEWARD SECTION SCALE: AS NOTED DATE: OCT. 1997 SHEET No. 4C4F OF 22 SHEETS	

C.O. 799S-6


FED. ROAD DIST. NO.	STATE	PROJ. NO.	FISCAL YEAR	SHEET NO.	TOTAL SHEETS
HAWAII	HAW.	I-H3-1(75) UNIT II	1997	800	1102

Approximate location of the Exist. Highway Light and Communication Ductlines.
The Contractor shall locate the ductline prior to installing the guardrail posts. The Contractor shall adjust the spacing and the location for the posts to avoid conflicts with the existing ductline(s). If necessary, the Contractor shall install additional posts to maintain a minimum spacing of 6'-3".


Approximate location of the Exist. Highway Light and Communication Ductlines.
The Contractor shall locate the ductline prior to installing the guardrail posts. The Contractor shall adjust the spacing and the location for the posts to avoid conflicts with the existing ductline(s). If necessary, the Contractor shall install additional posts to maintain a minimum spacing of 6'-3".

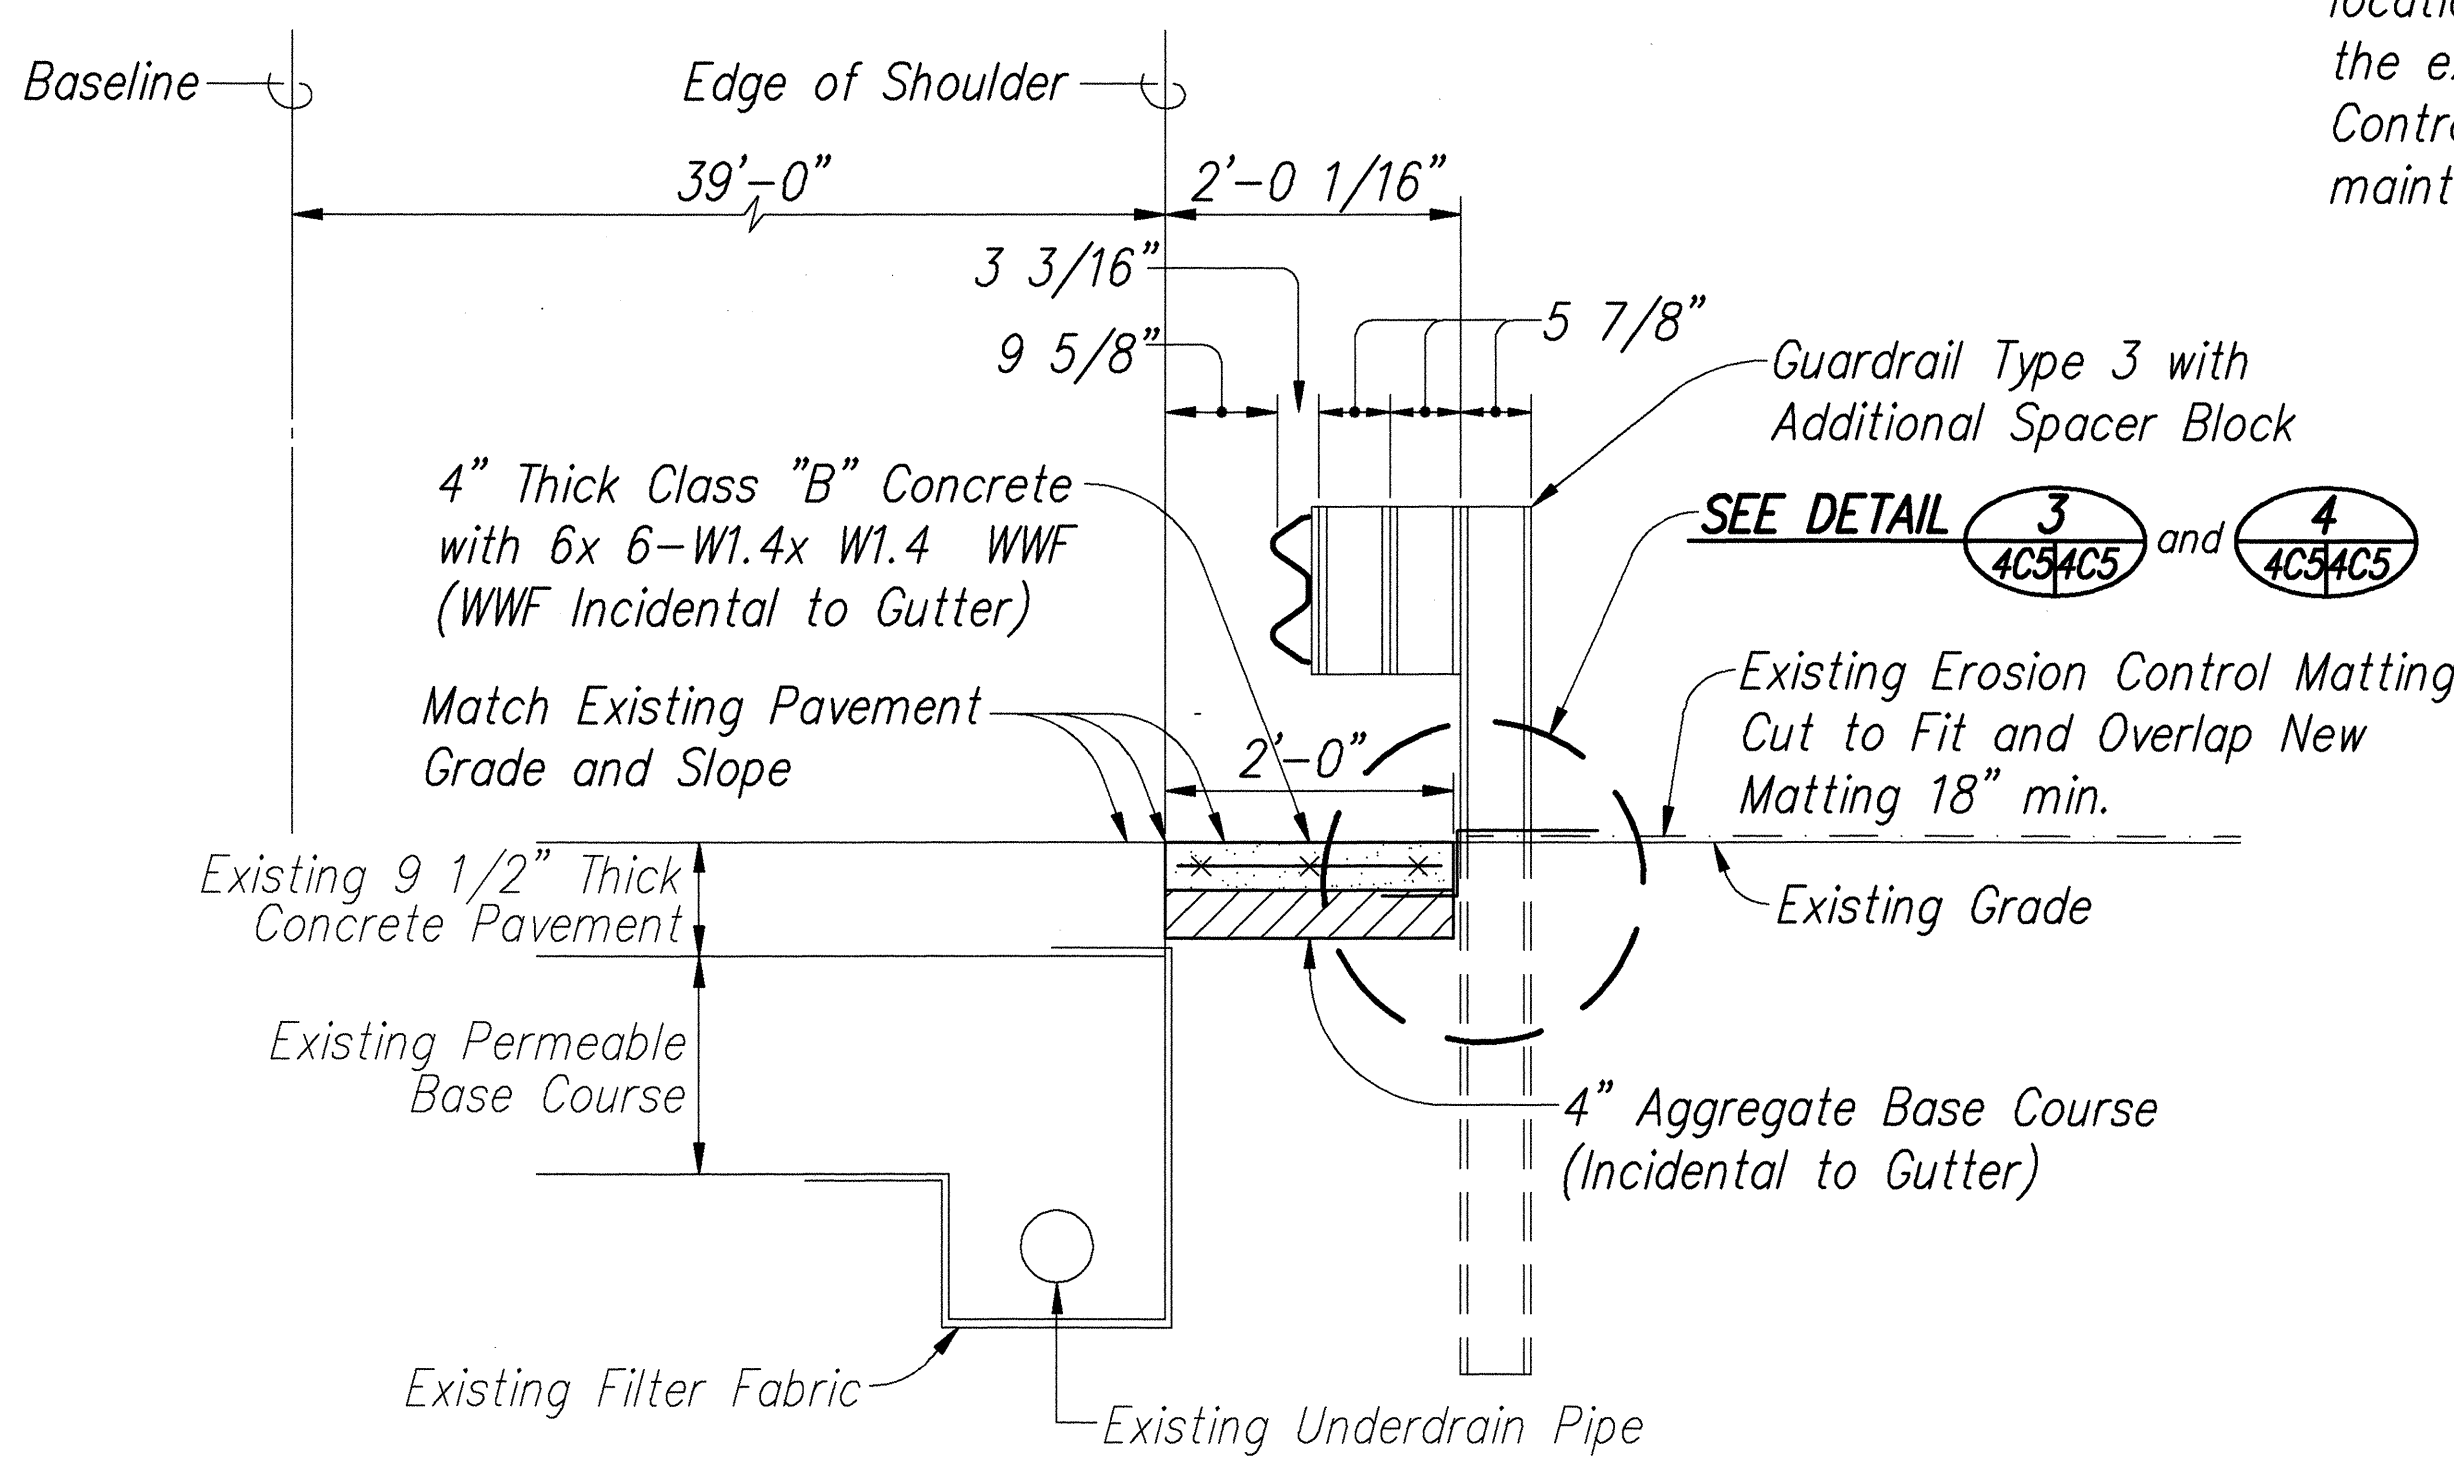


TYPICAL TYPE 2G REVERSE GUTTER 2
SCALE: 3/4" = 1'-0" 4C44C5

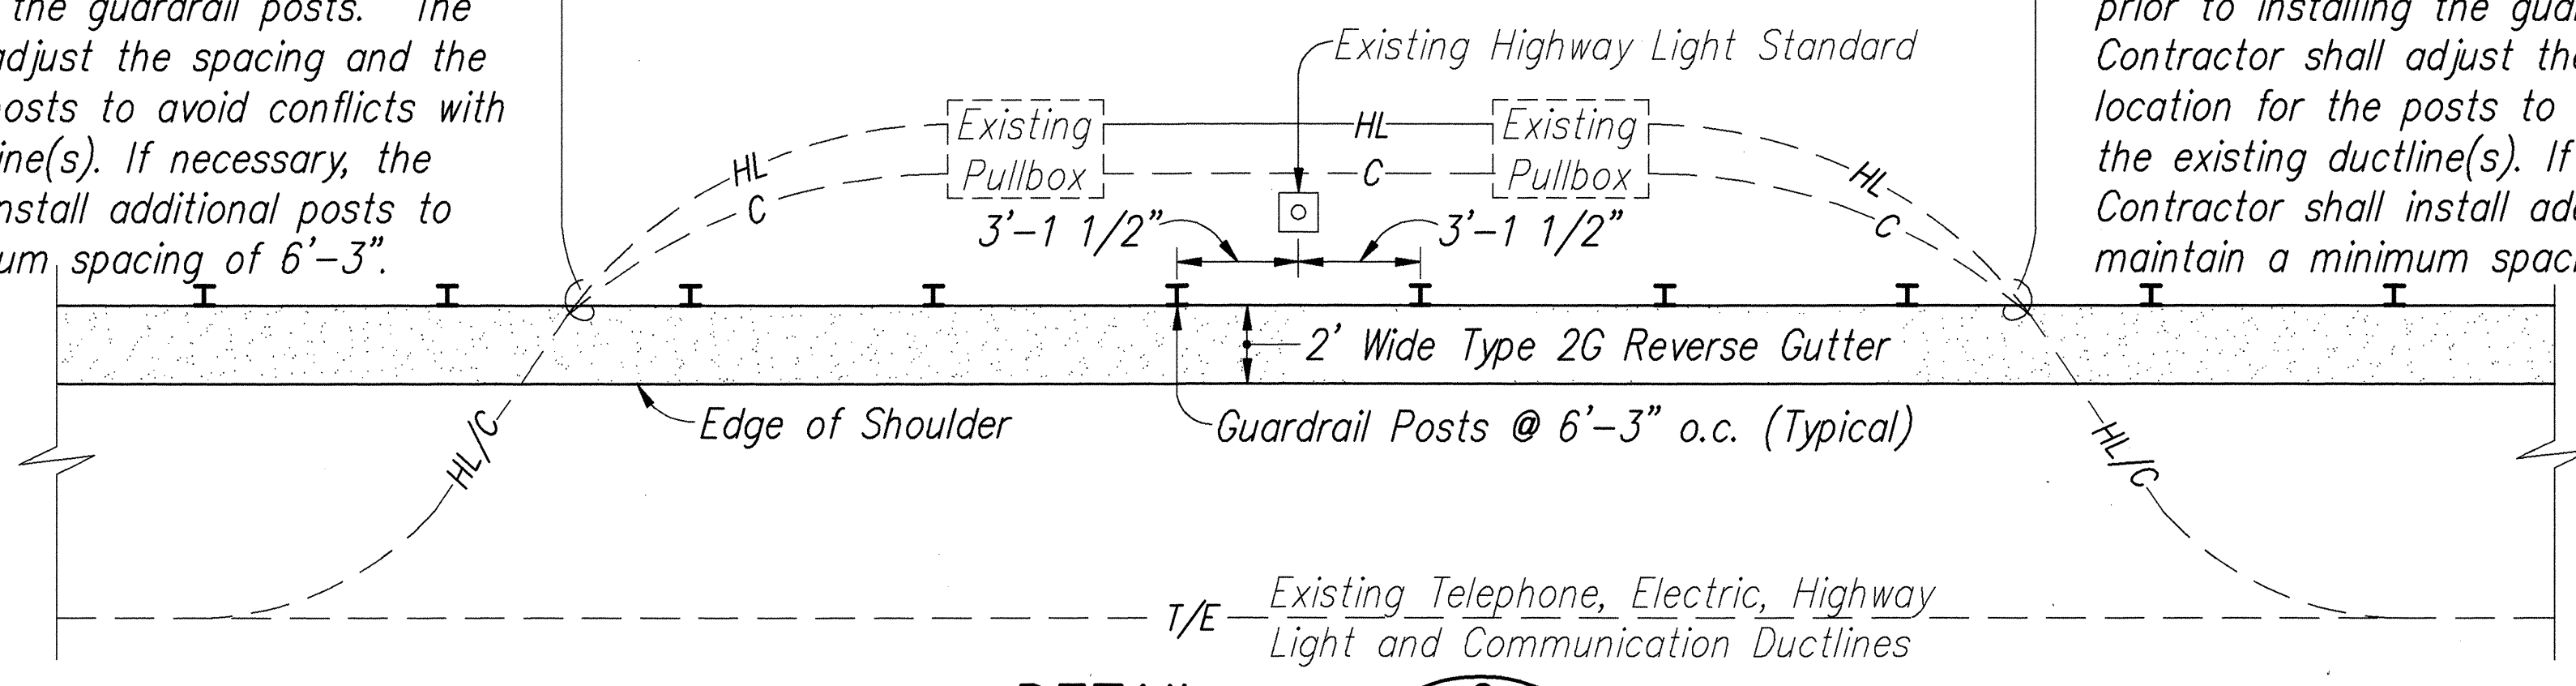


DETAIL 6
NOT TO SCALE 4C44C5

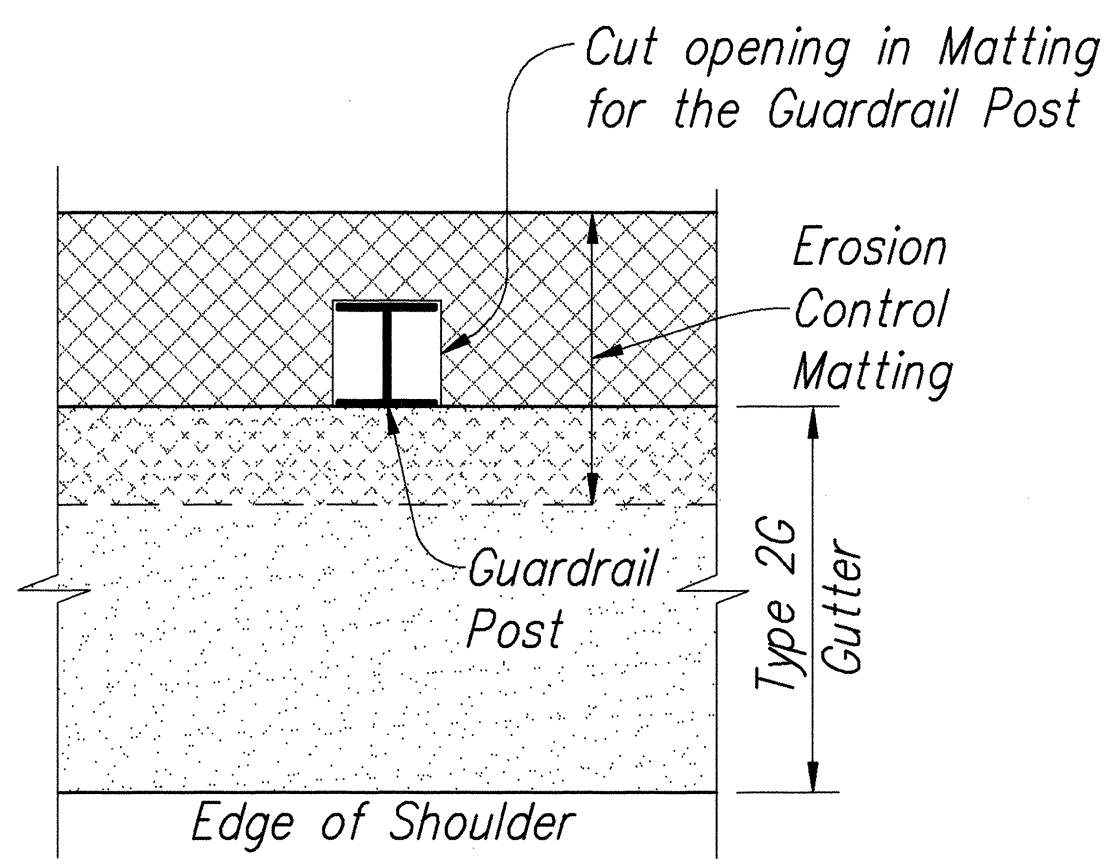


DETAIL 3
SCALE: 1" = 1'-0" 4C54C5

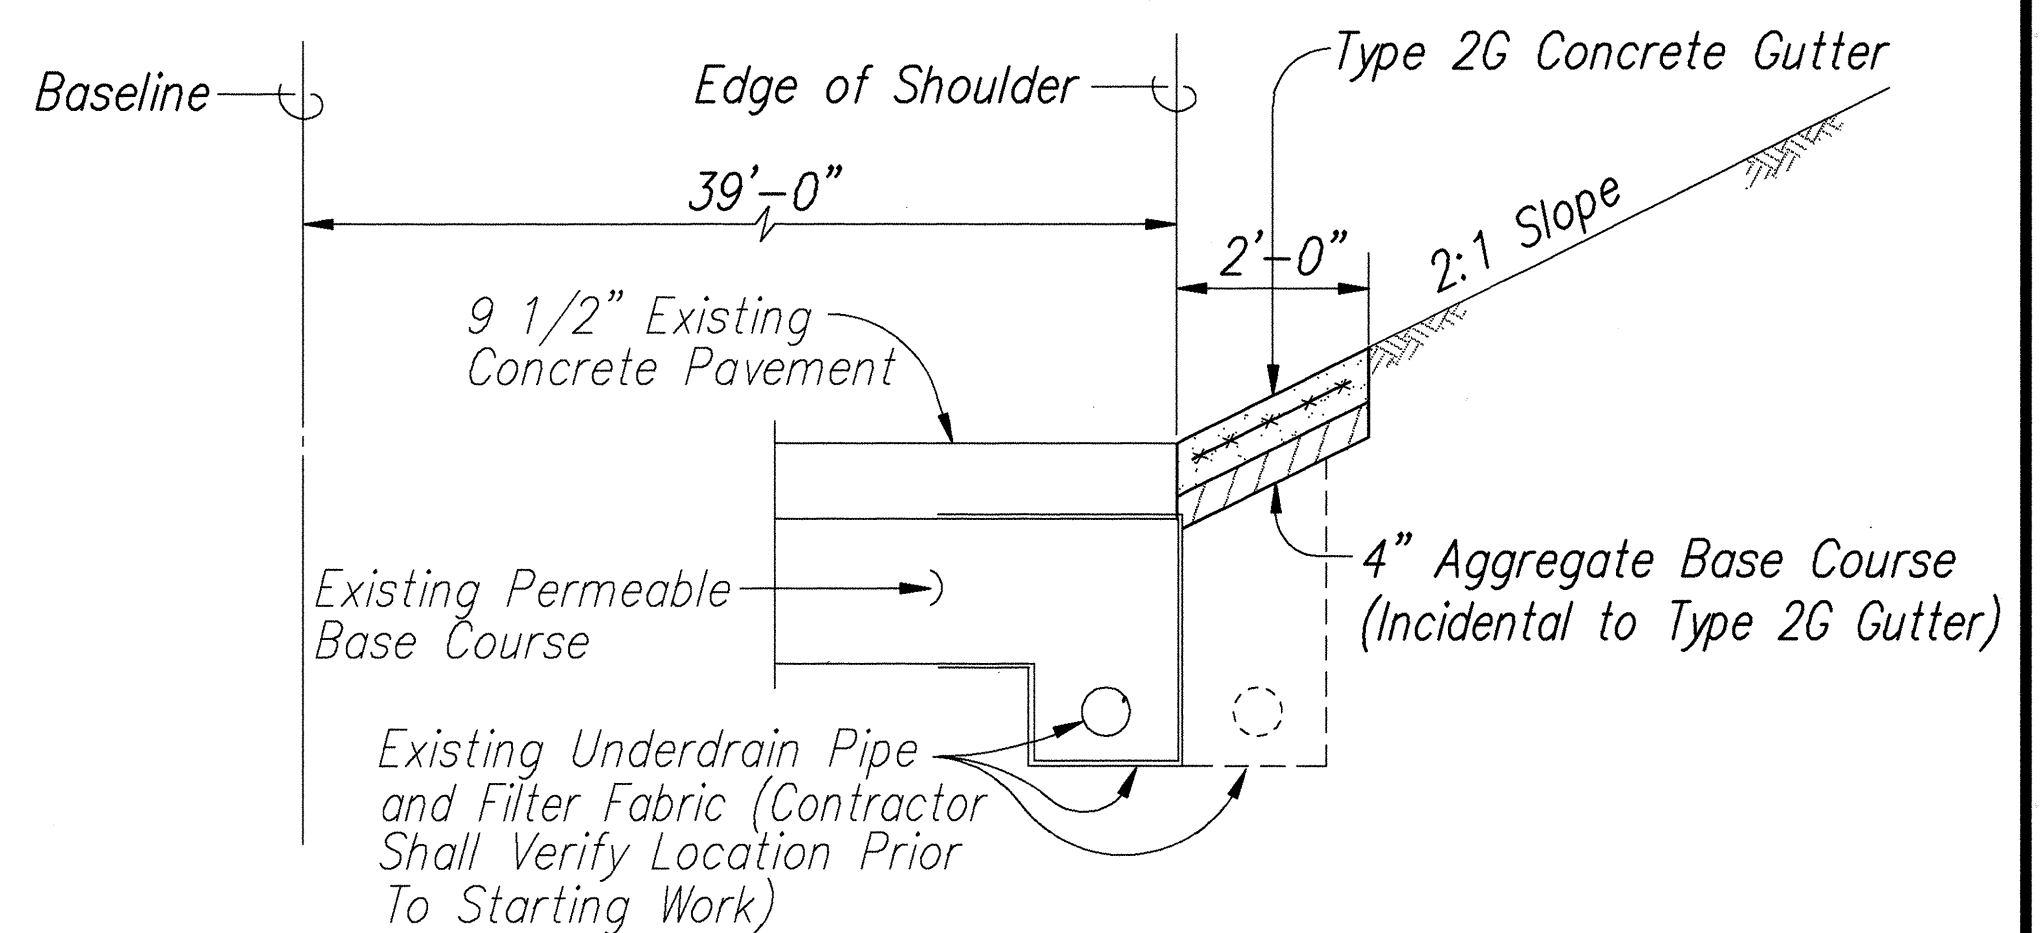


TYPE 2G GUTTER @ STA. 391+40±
DETAIL 7
SCALE: 1/2" = 1'-0" 4C44C5

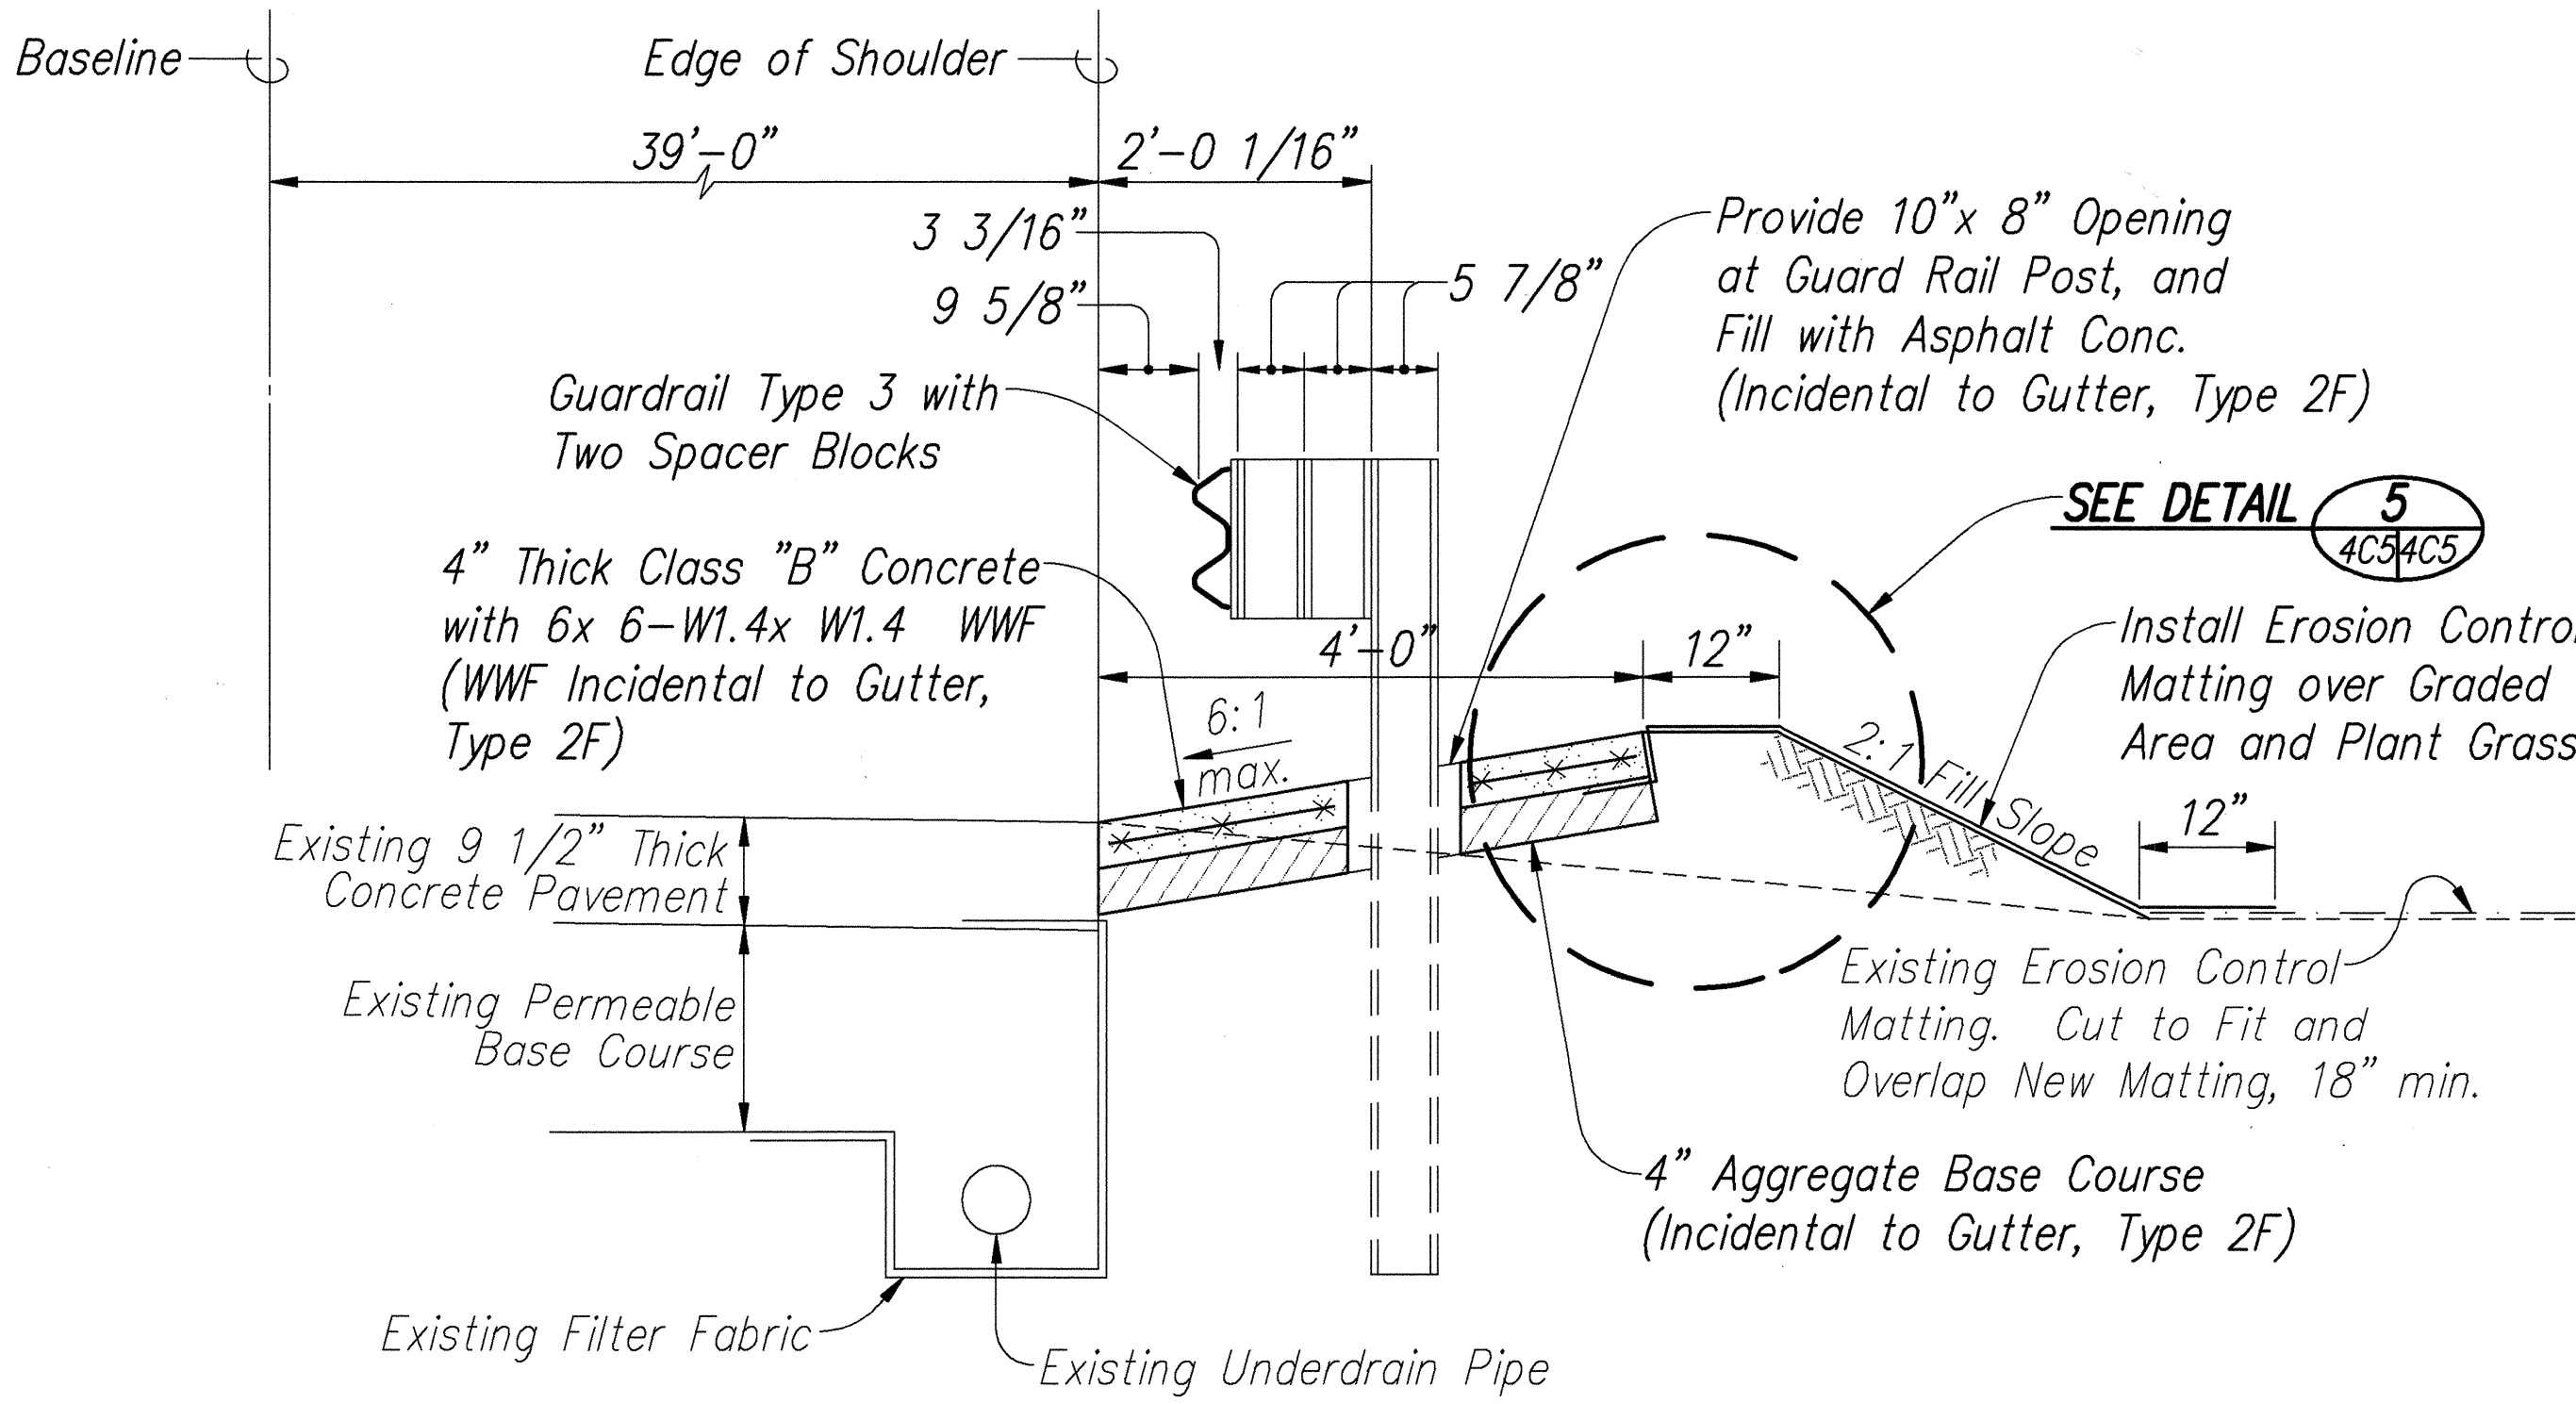

TYPICAL TYPE 2F GUTTER DETAIL 1
SCALE: 3/4" = 1'-0" 4C44C5

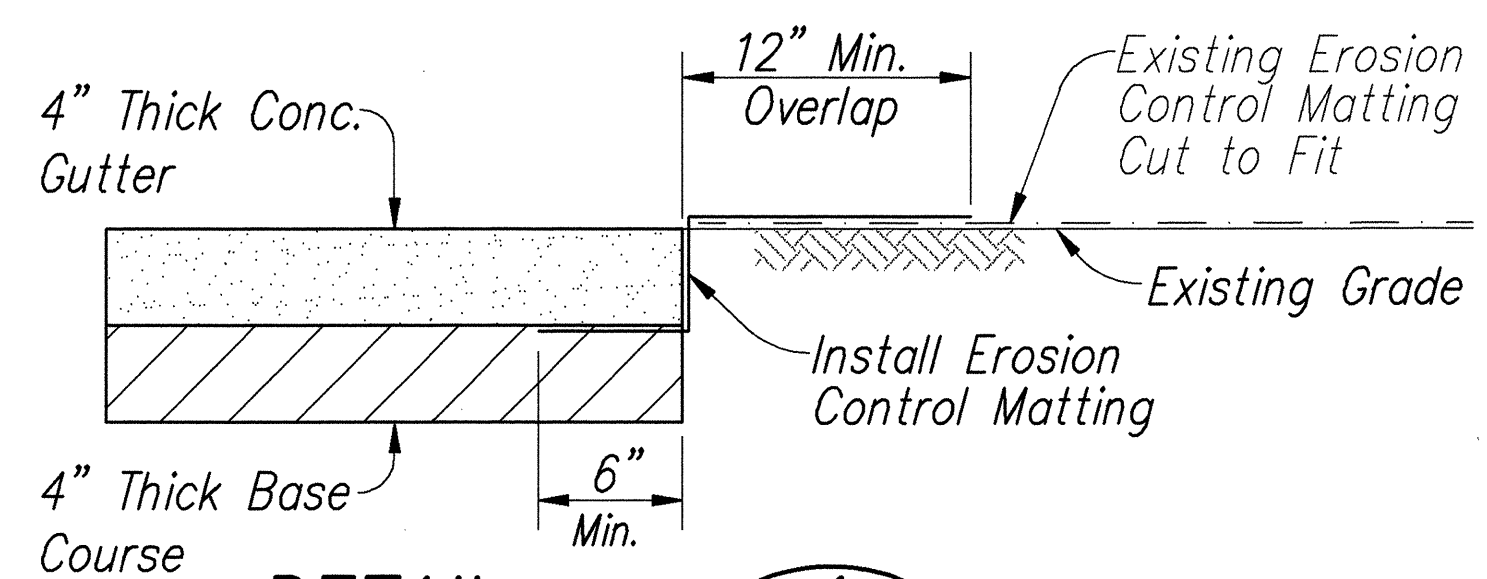

DETAIL 4
SCALE: 1 1/2" = 1'-0" 4C54C5

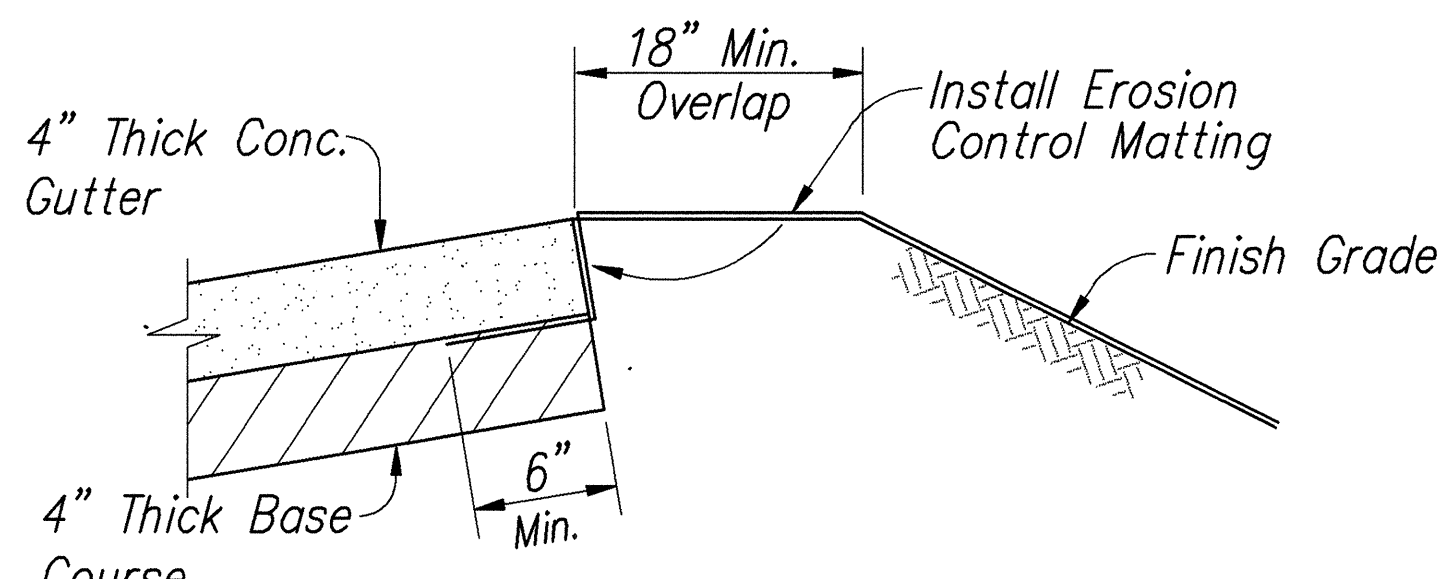

DETAIL 5
SCALE: 1 1/2" = 1'-0" 4C54C5

REGINALD M. SUDANA
LICENSED PROFESSIONAL ENGINEER
No. 1462-C
HAWAII, U.S.A.

THIS WORK WAS PREPARED BY ME OR UNDER MY SUPERVISION

Reginald M. Sudana
P.E., Inc.
dbs PARK ENGINEERING

STATE OF HAWAII
DEPARTMENT OF TRANSPORTATION
HIGHWAYS DIVISION

NORTH HALAWA VALLEY
ROADWAY CONSTRUCTION

GUTTER AND GUARDRAIL DETAILS

H-3 FINISH (UNIT II)
FAIP NO. I-H3-1(75), UNIT II
LEEWARD SECTION


SCALE: AS NOTED DATE: FEB. 1997

SHEET No. 4C5 OF 22 SHEETS


ORIGINAL PLAN	SURVEY PLOTTED BY	DATE
DESIGNED BY	DRAWN BY	
CHECKED BY	NOTED BY	
NO.		

LIB: STATE/DOH/H-3/H3052/43FINISH
GUTDET1 2/11/97 AMM


FED. ROAD DIST. NO.	STATE	PROJ. NO.	FISCAL YEAR	SHEET NO.	TOTAL SHEETS
HAWAII	HAW.	I-H3-1(75) UNIT II	1997	801	1102

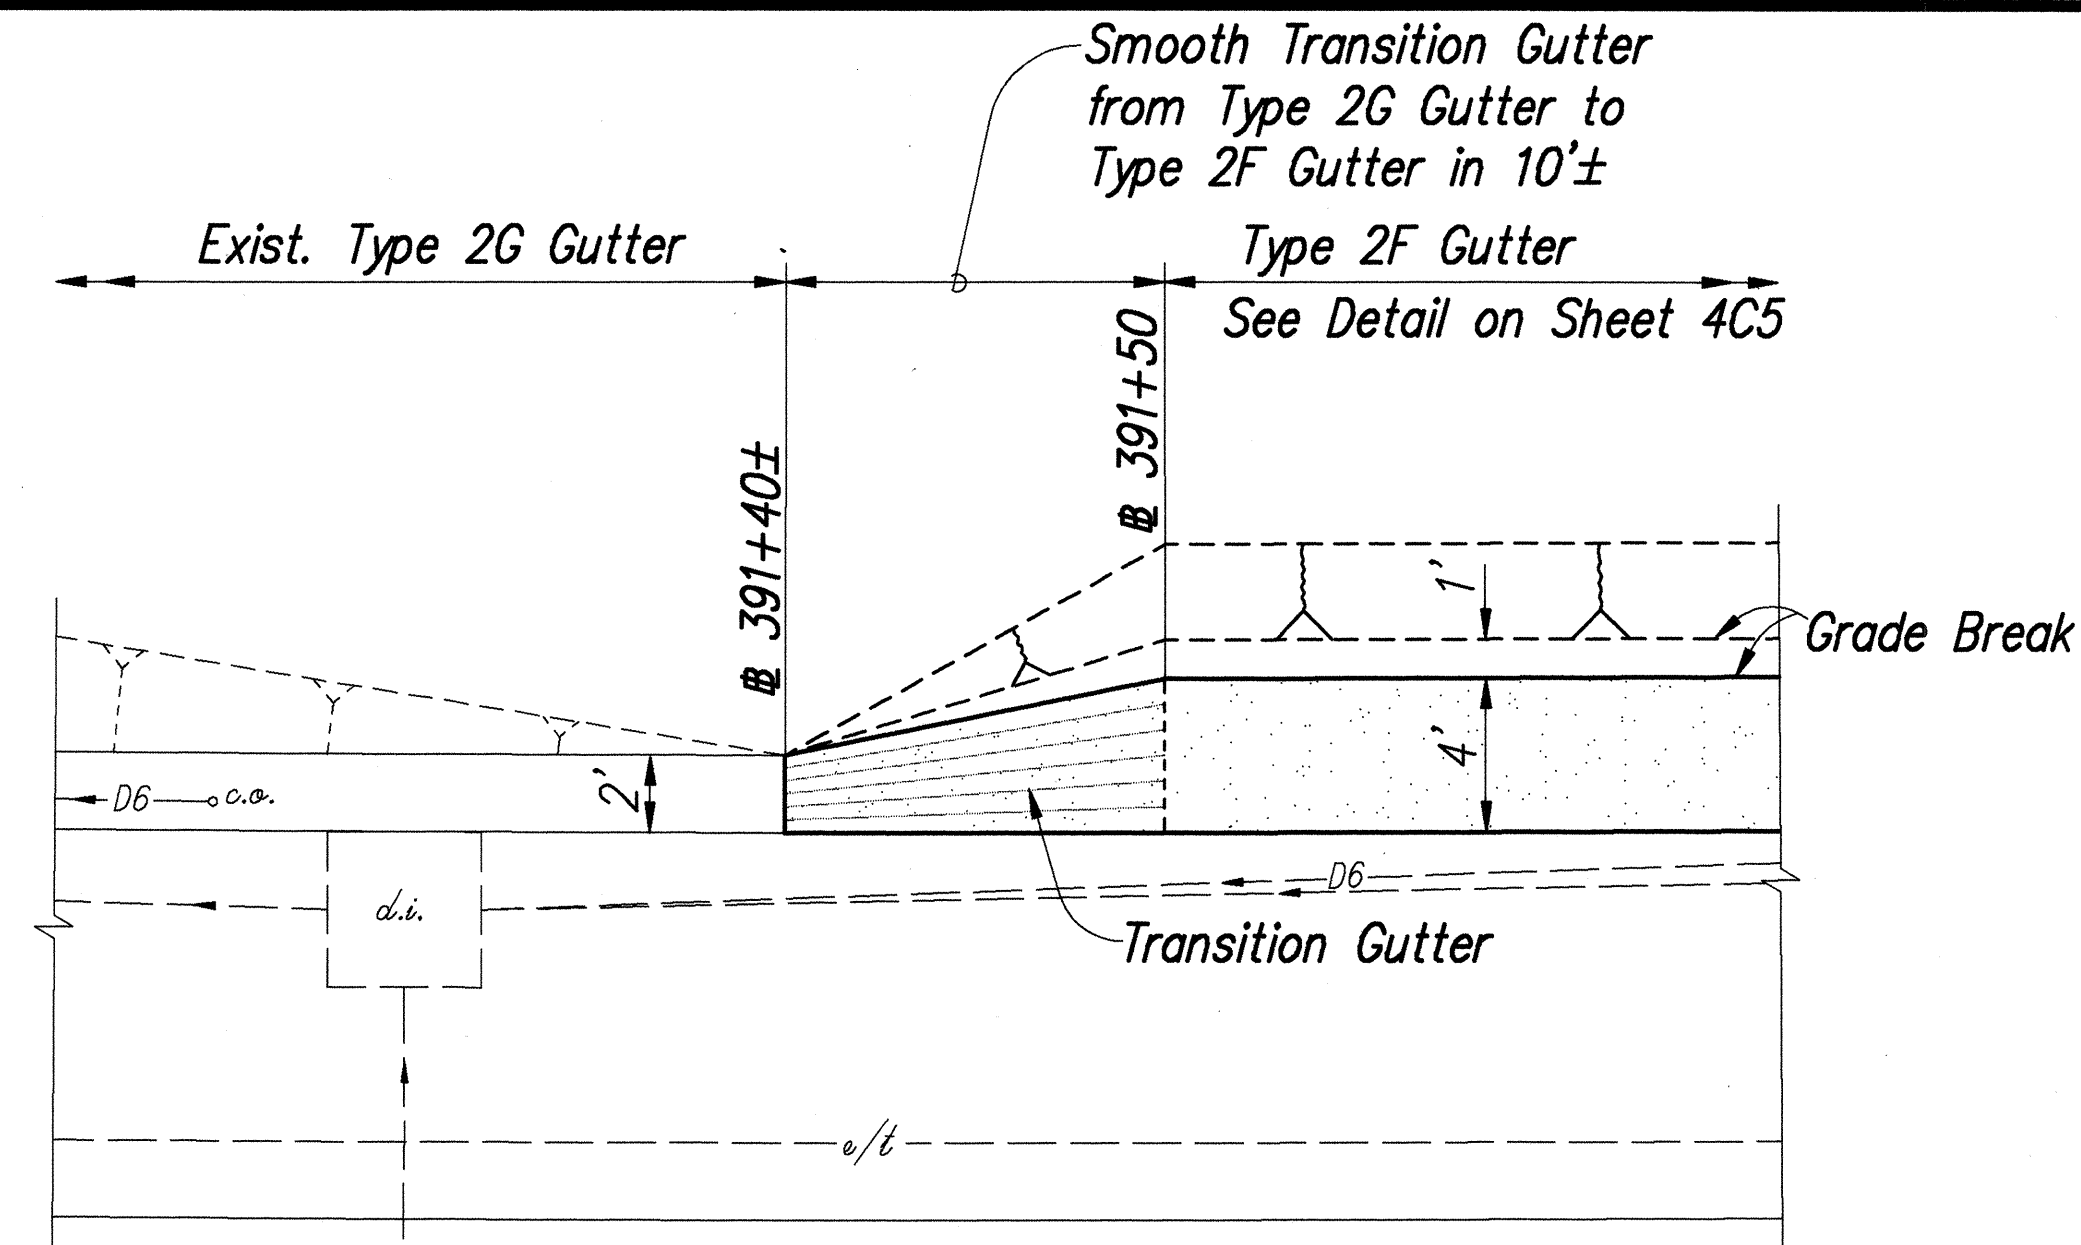


DETAIL 1
Scale: 1" = 5' 4C44C6

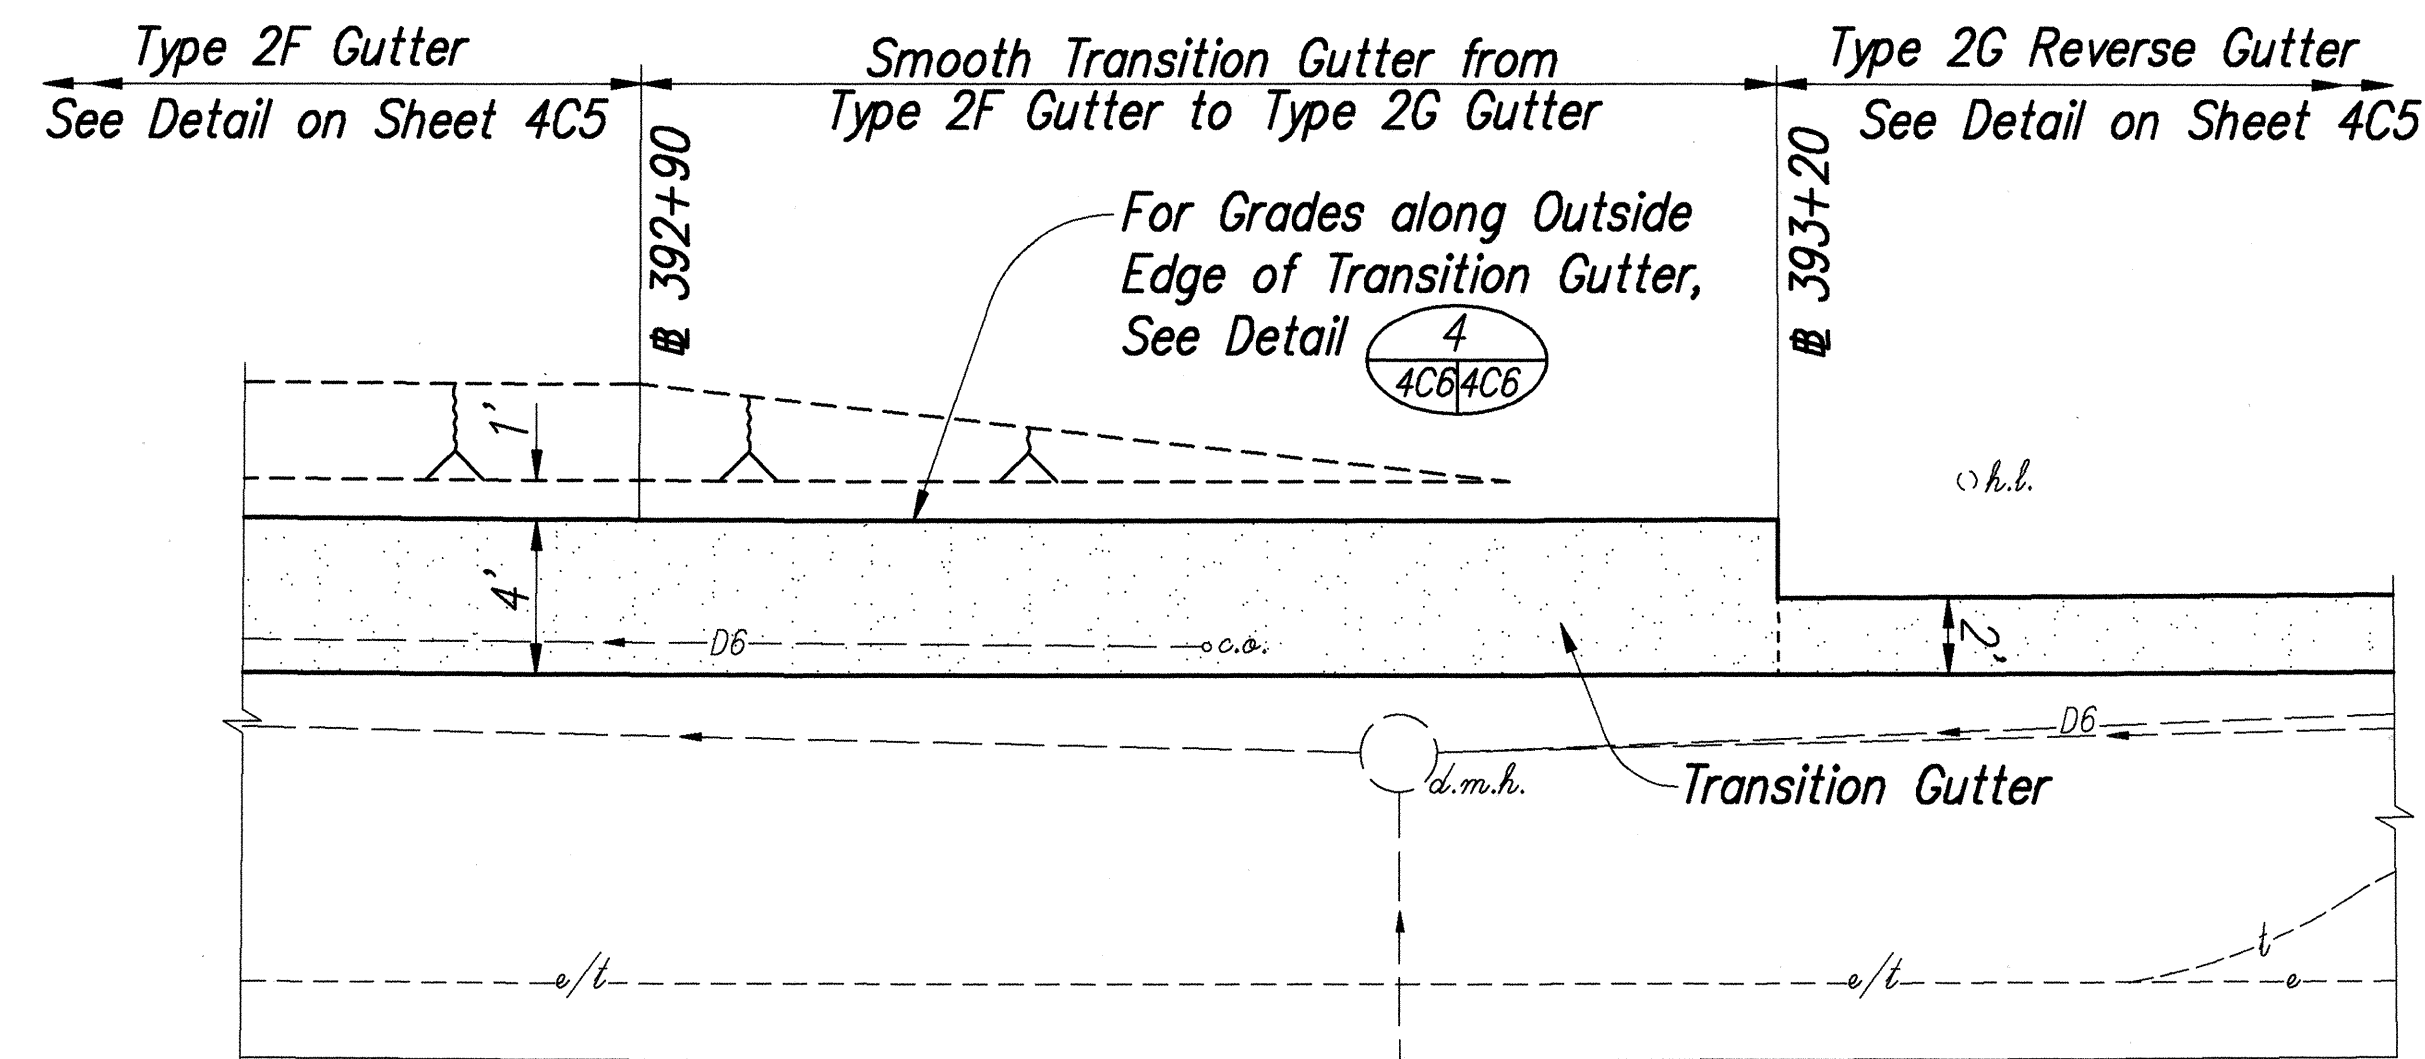


DETAIL 2
Scale: 1" = 5' 4C44C6

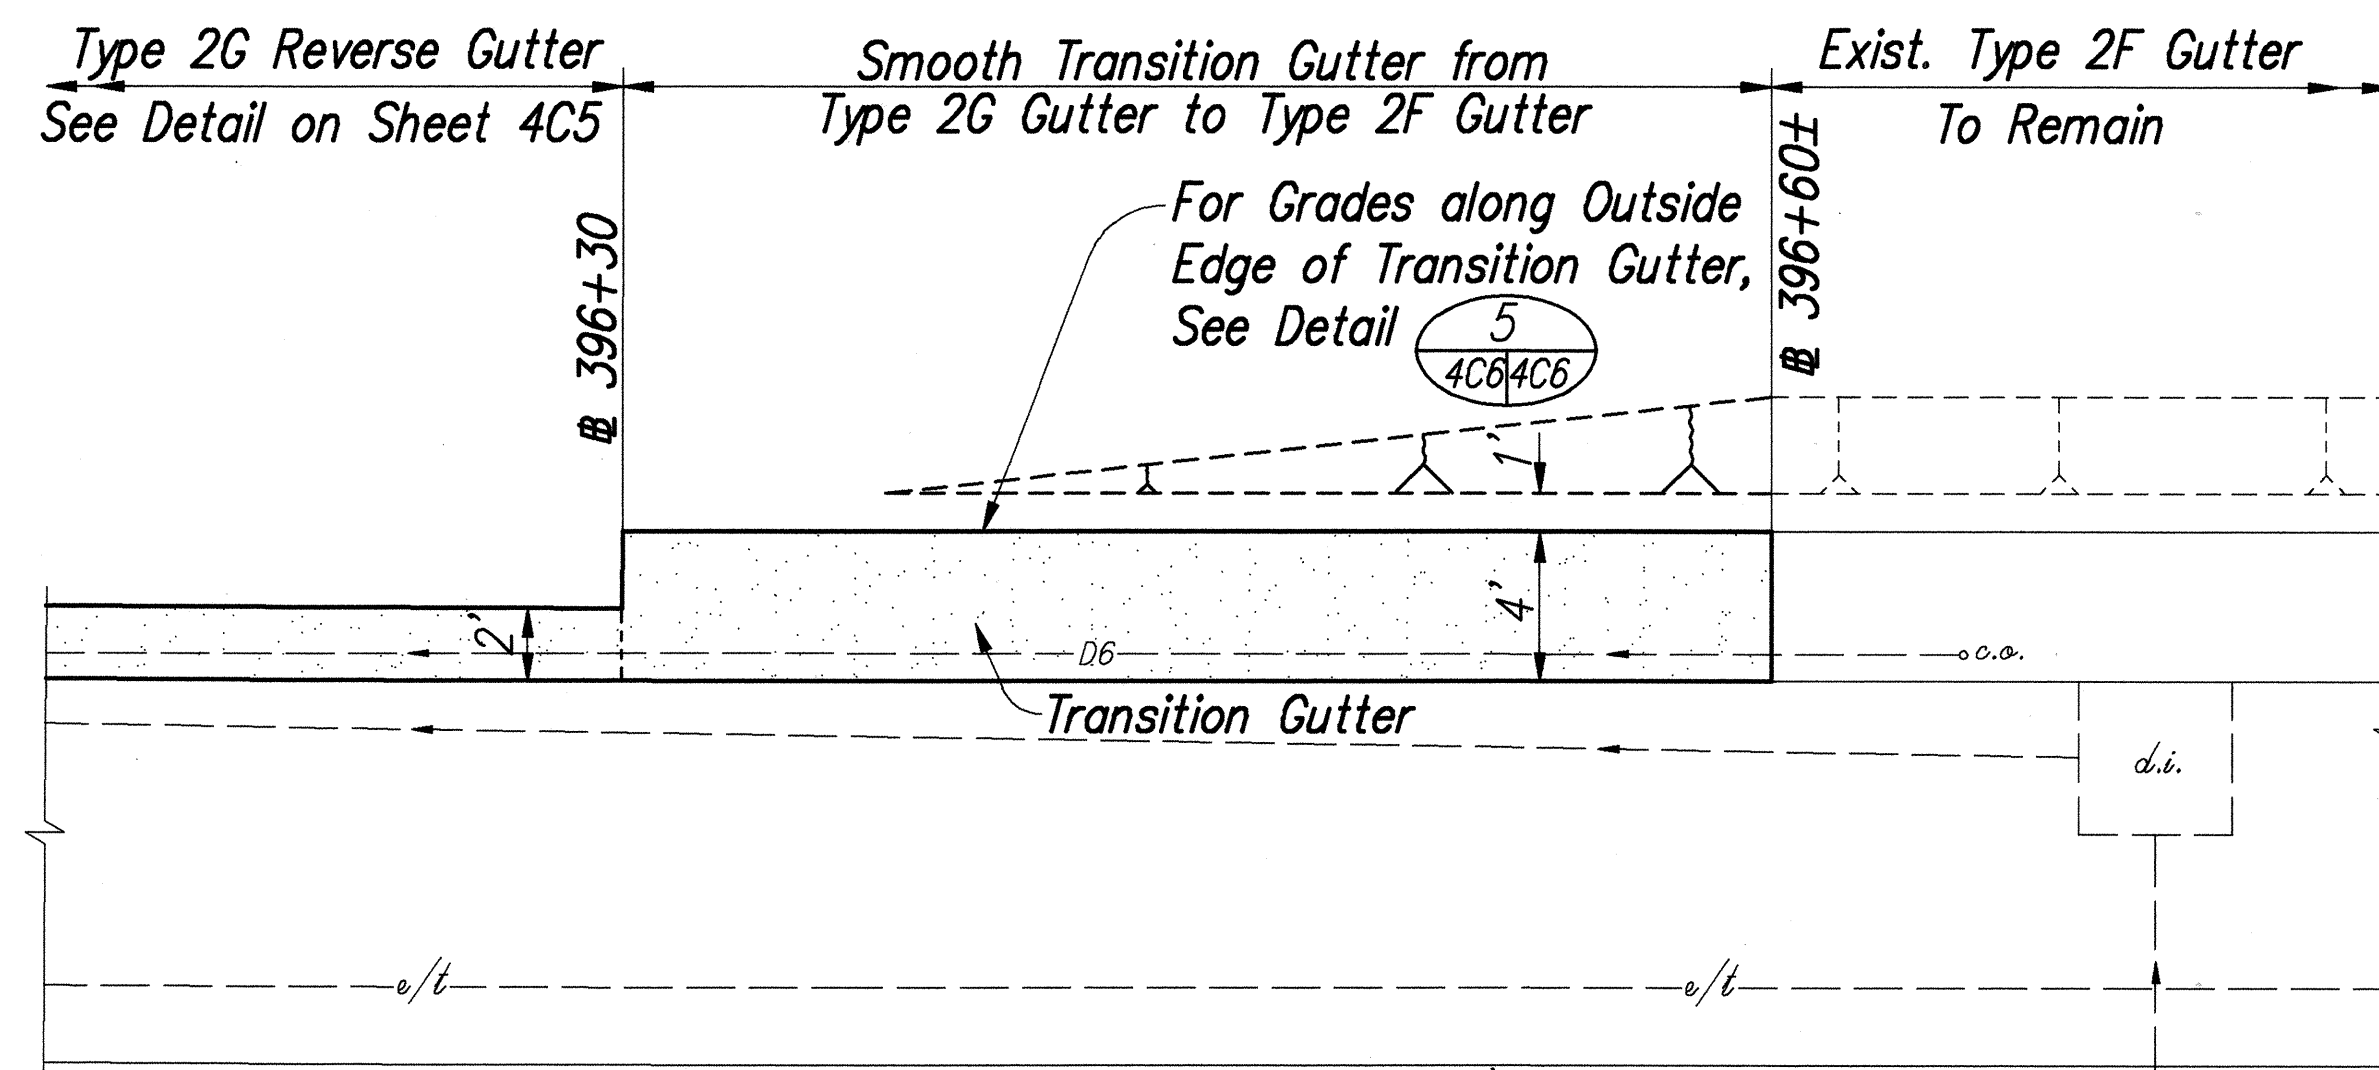


DETAIL 3
Scale: 1" = 5' 4C44C6

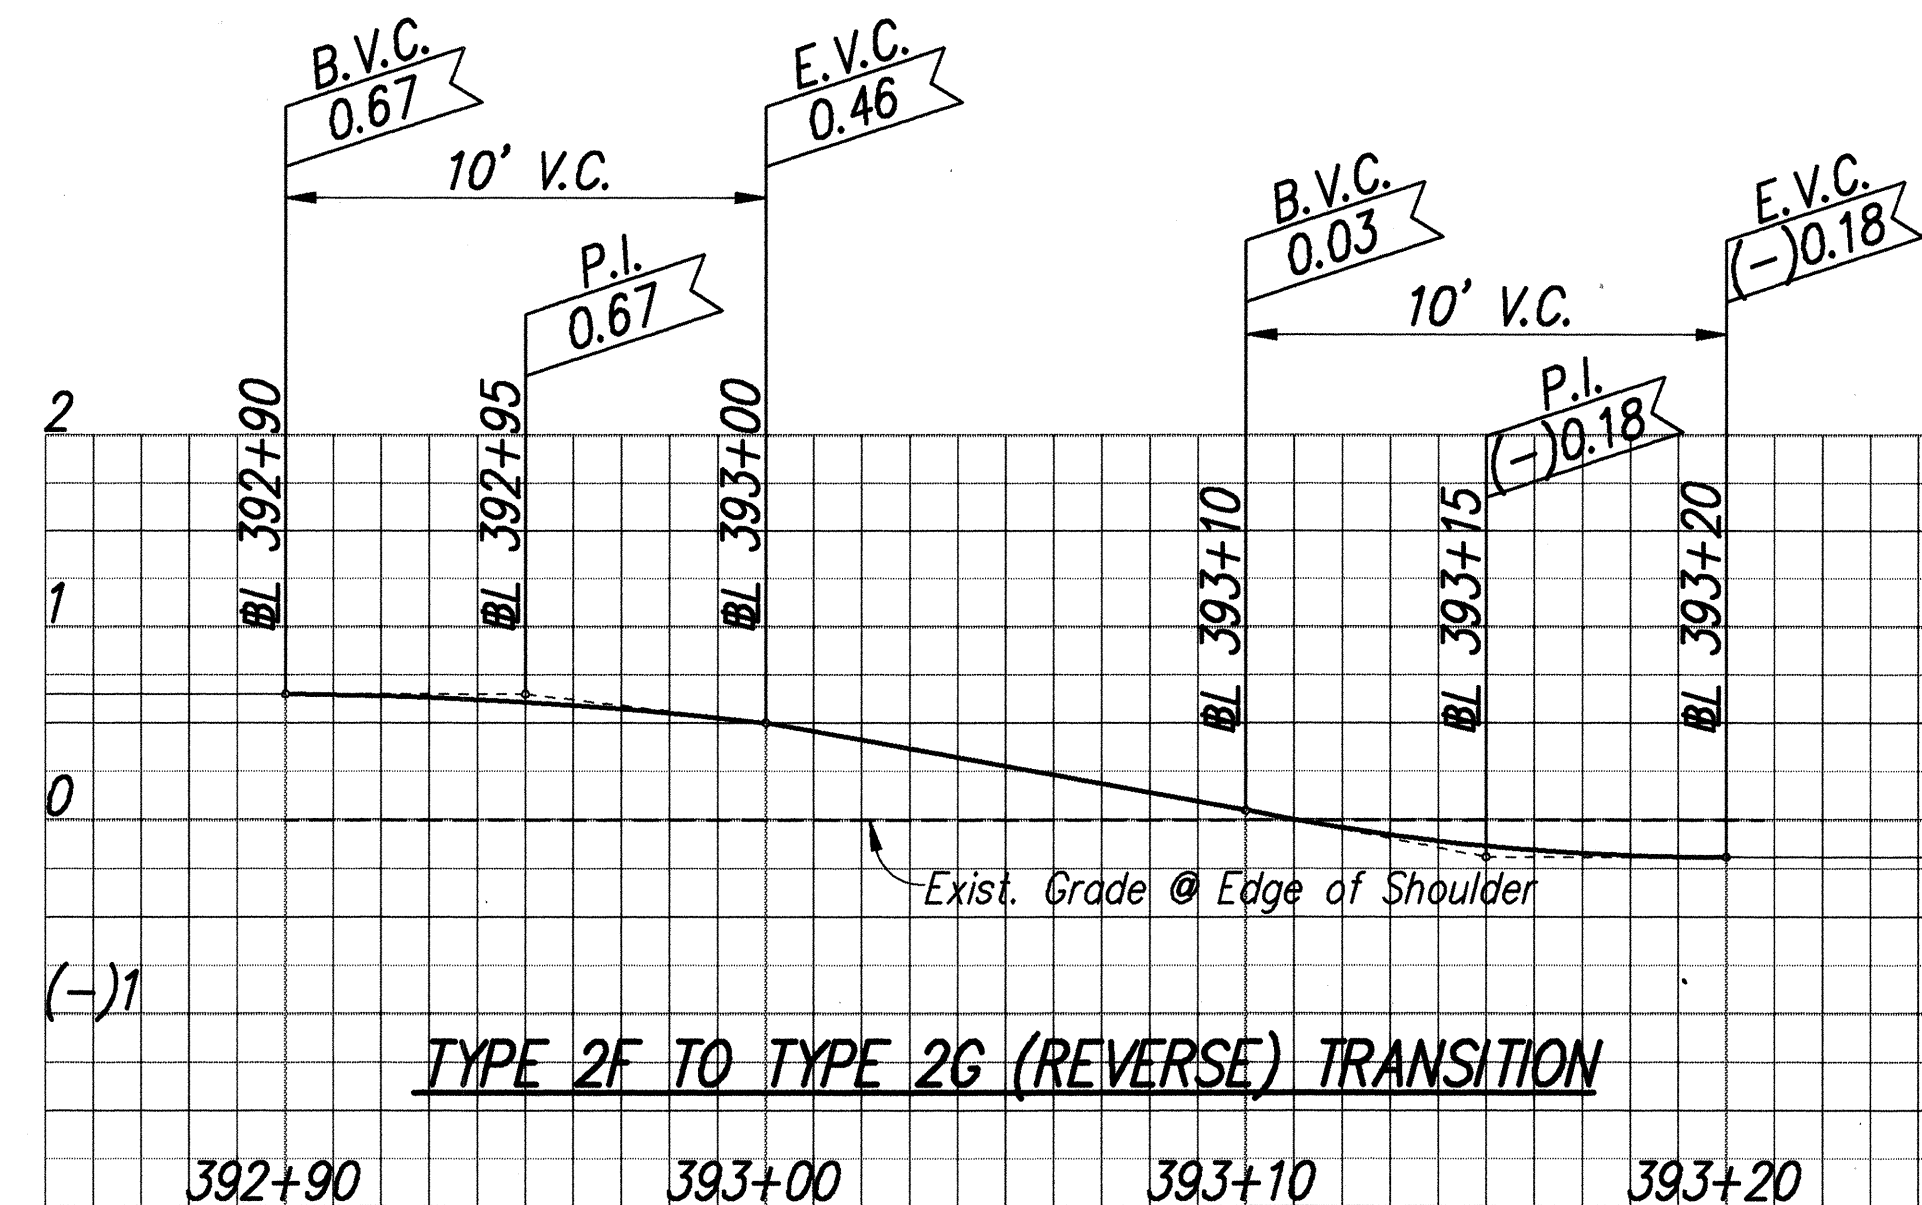

DETAIL 4
Scale: Horiz. 1" = 4' Vert. 1" = 1' 4C64C6

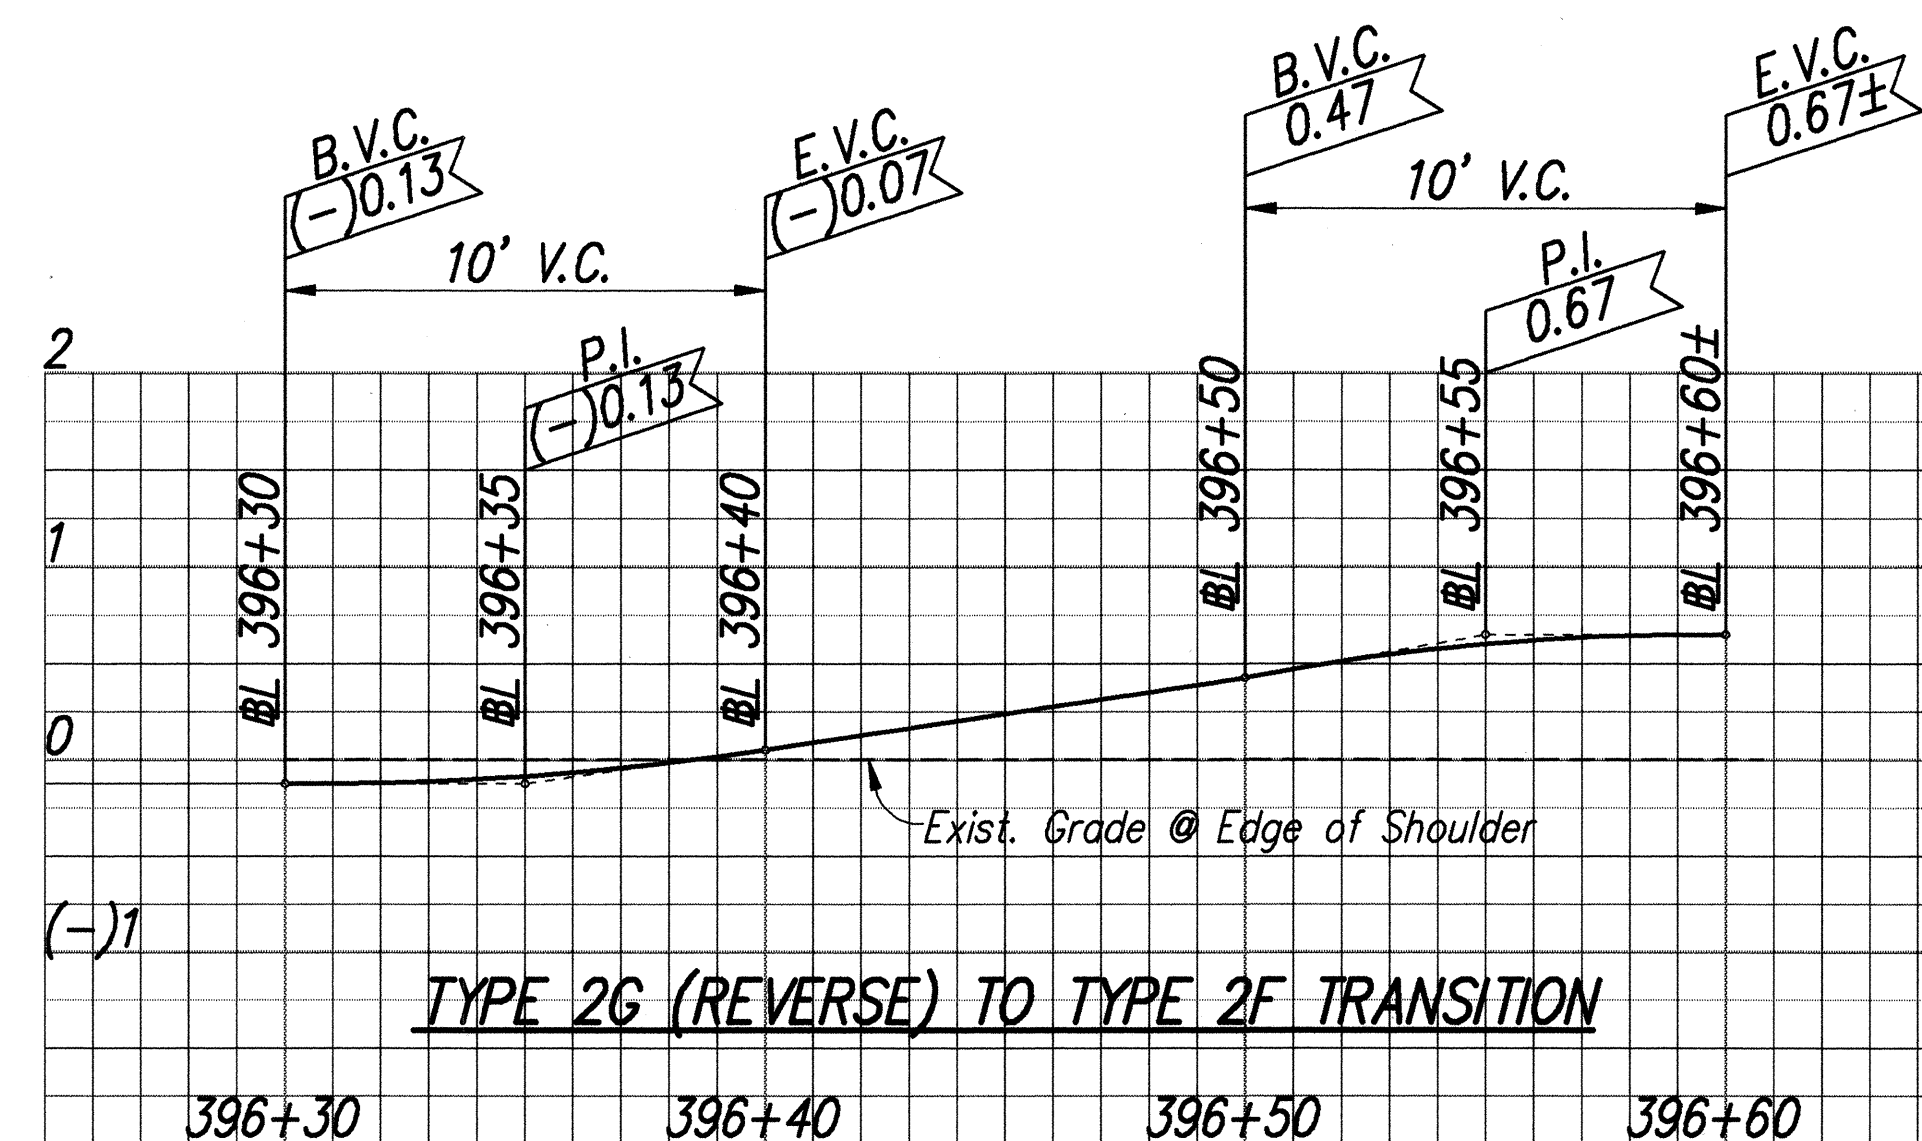


DETAIL 5
Scale: Horiz. 1" = 4' Vert. 1" = 1' 4C64C6

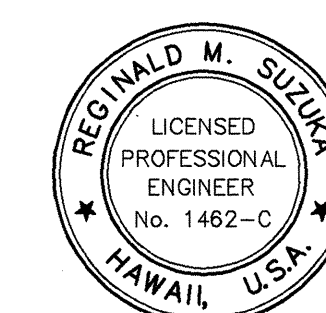


THIS WORK WAS PREPARED BY ME OR UNDER MY SUPERVISION
Ronald M. Sultua
Professional Engineer
No. 1462-C
HAWAII, U.S.A.
dba PARK ENGINEERING

STATE OF HAWAII
DEPARTMENT OF TRANSPORTATION
HIGHWAYS DIVISION
NORTH HALAWA VALLEY
ROADWAY CONSTRUCTION
GUTTER AND GUARDRAIL DETAILS
H-3 FINISH (UNIT II)
FAIP NO. I-H3-1(75), UNIT II
LEEWARD SECTION
SCALE: AS NOTED DATE: FEB. 1997
SHEET No. 4C6 OF 22 SHEETS


FED. ROAD DIST. NO.	STATE	PROJ. NO.	FISCAL YEAR	SHEET NO.	TOTAL SHEETS
HAWAII	HAW.	I-H3-1(75) UNIT II	1997	802	1102

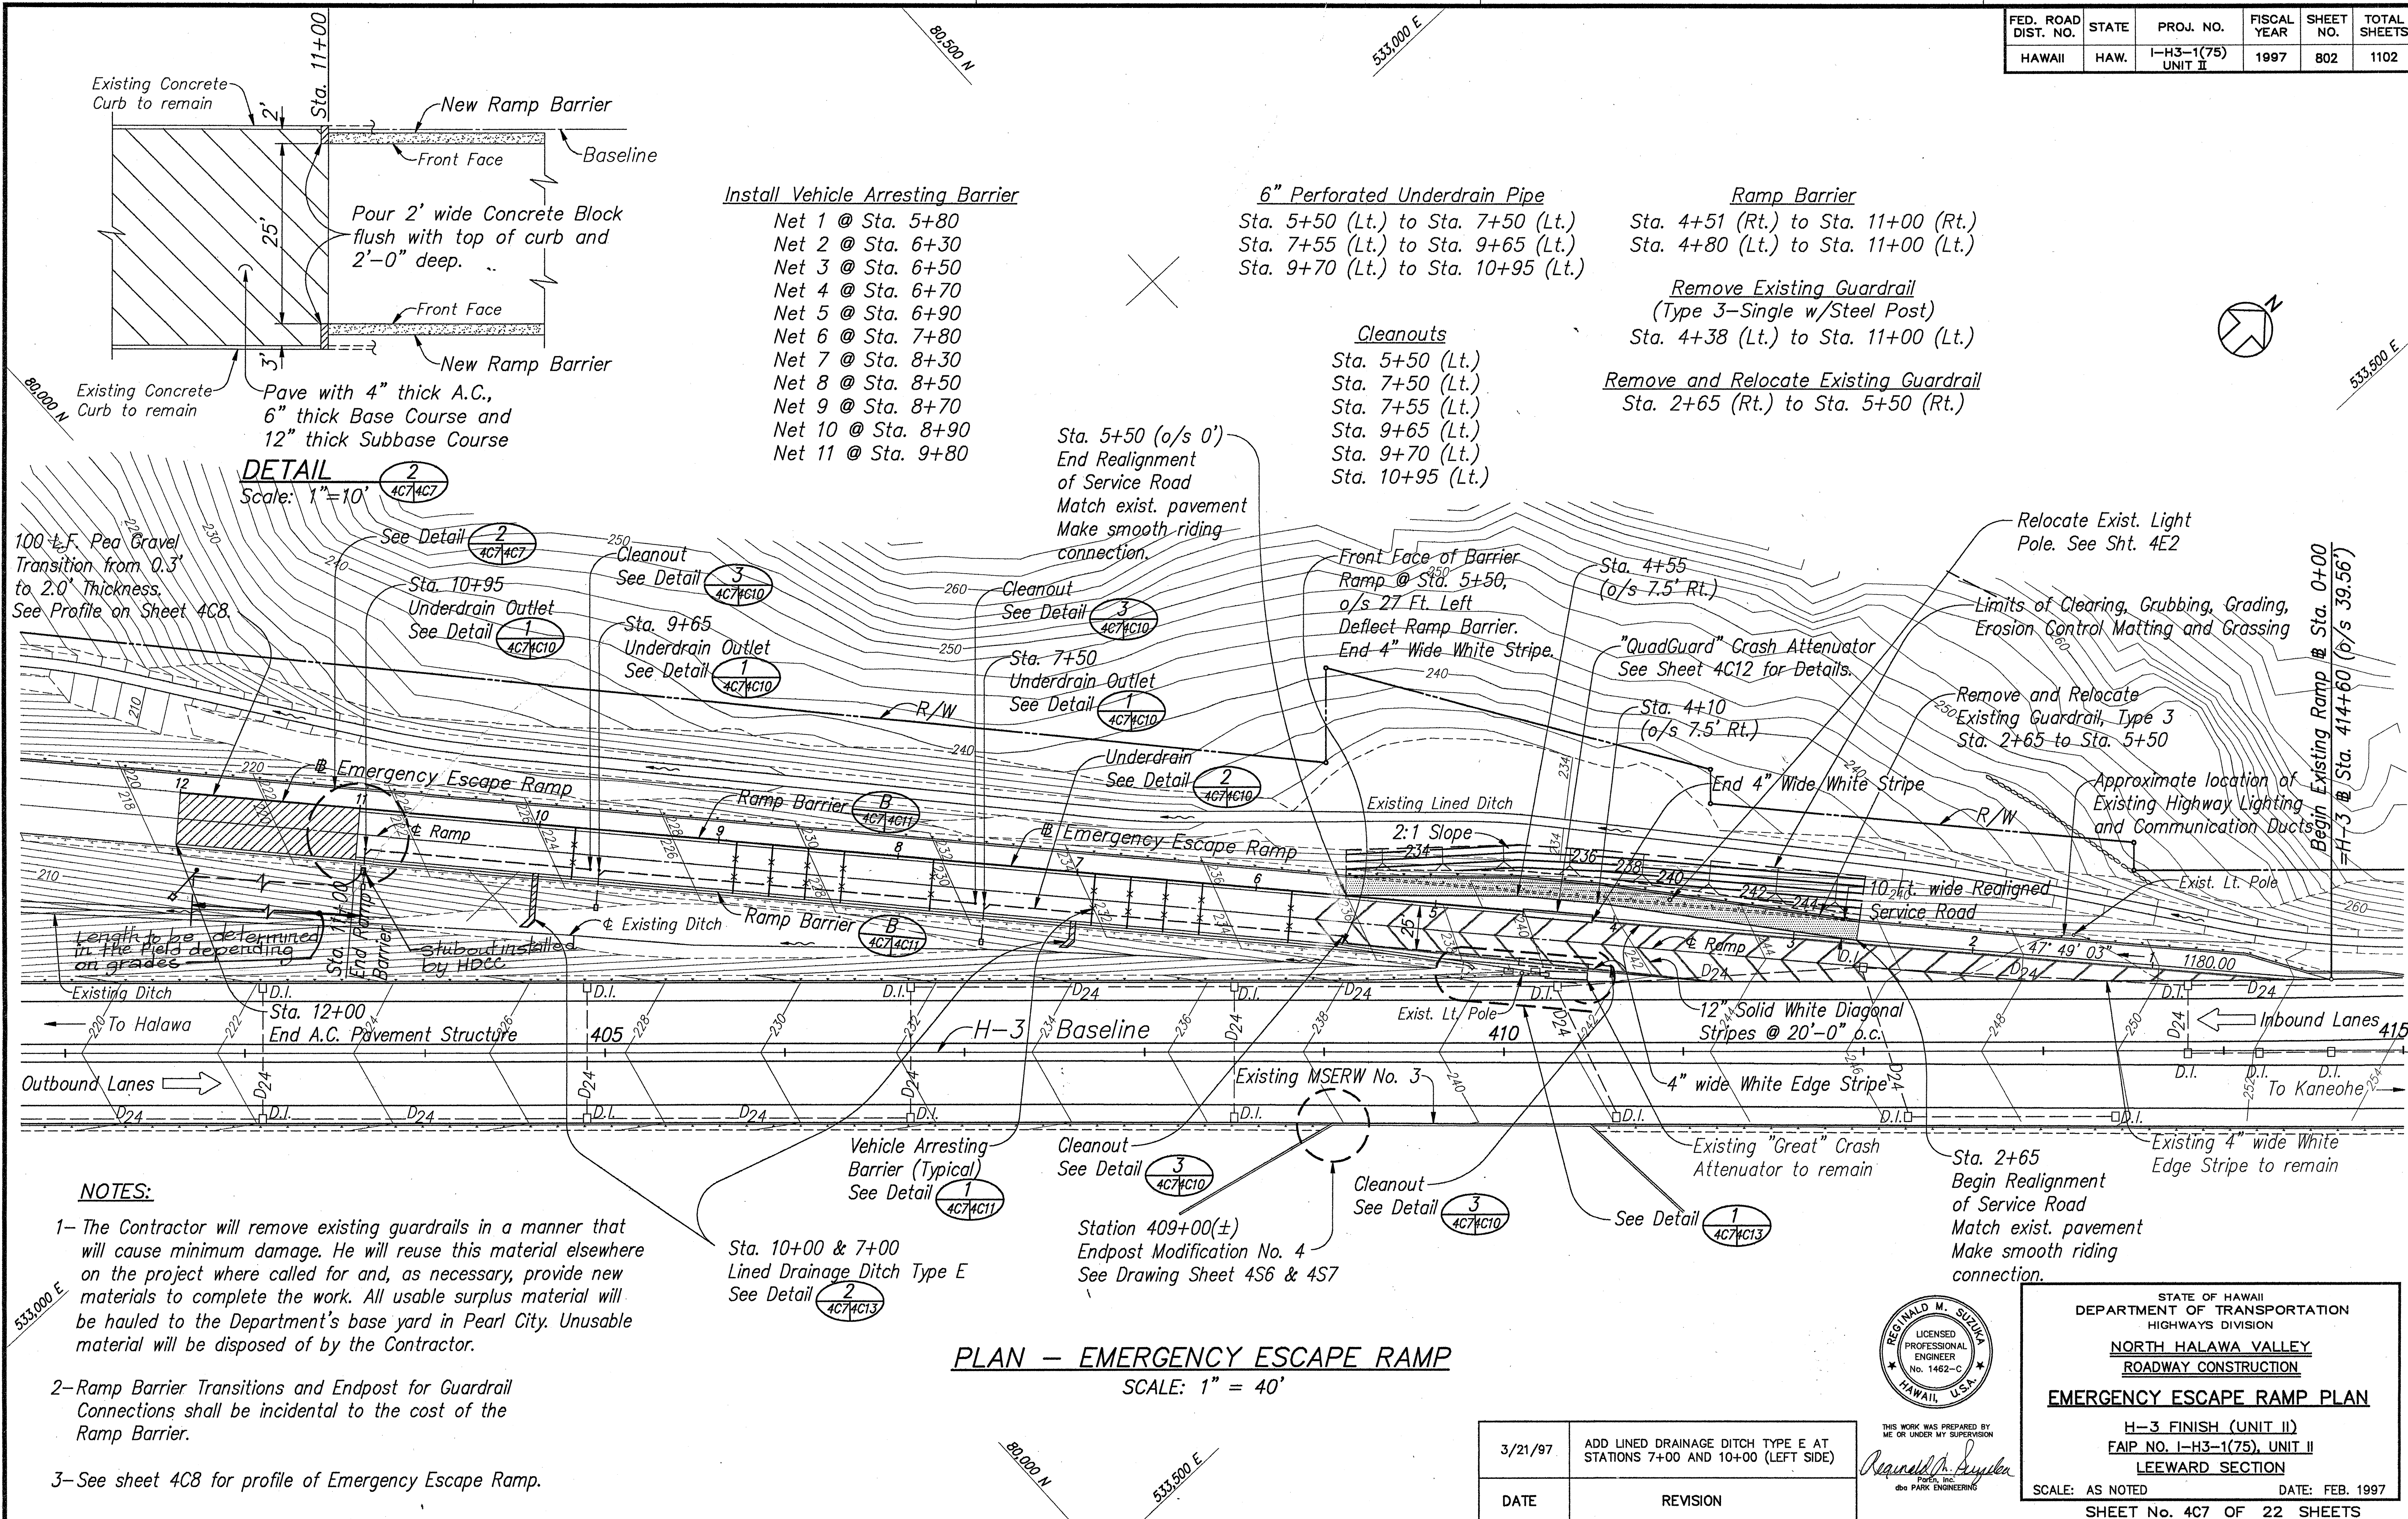

FED. ROAD DIST. NO.	STATE	PROJ. NO.	FISCAL YEAR	SHEET NO.	TOTAL SHEETS
HAWAII	HAW.	I-H3-1(75) UNIT II	1997	803	1102

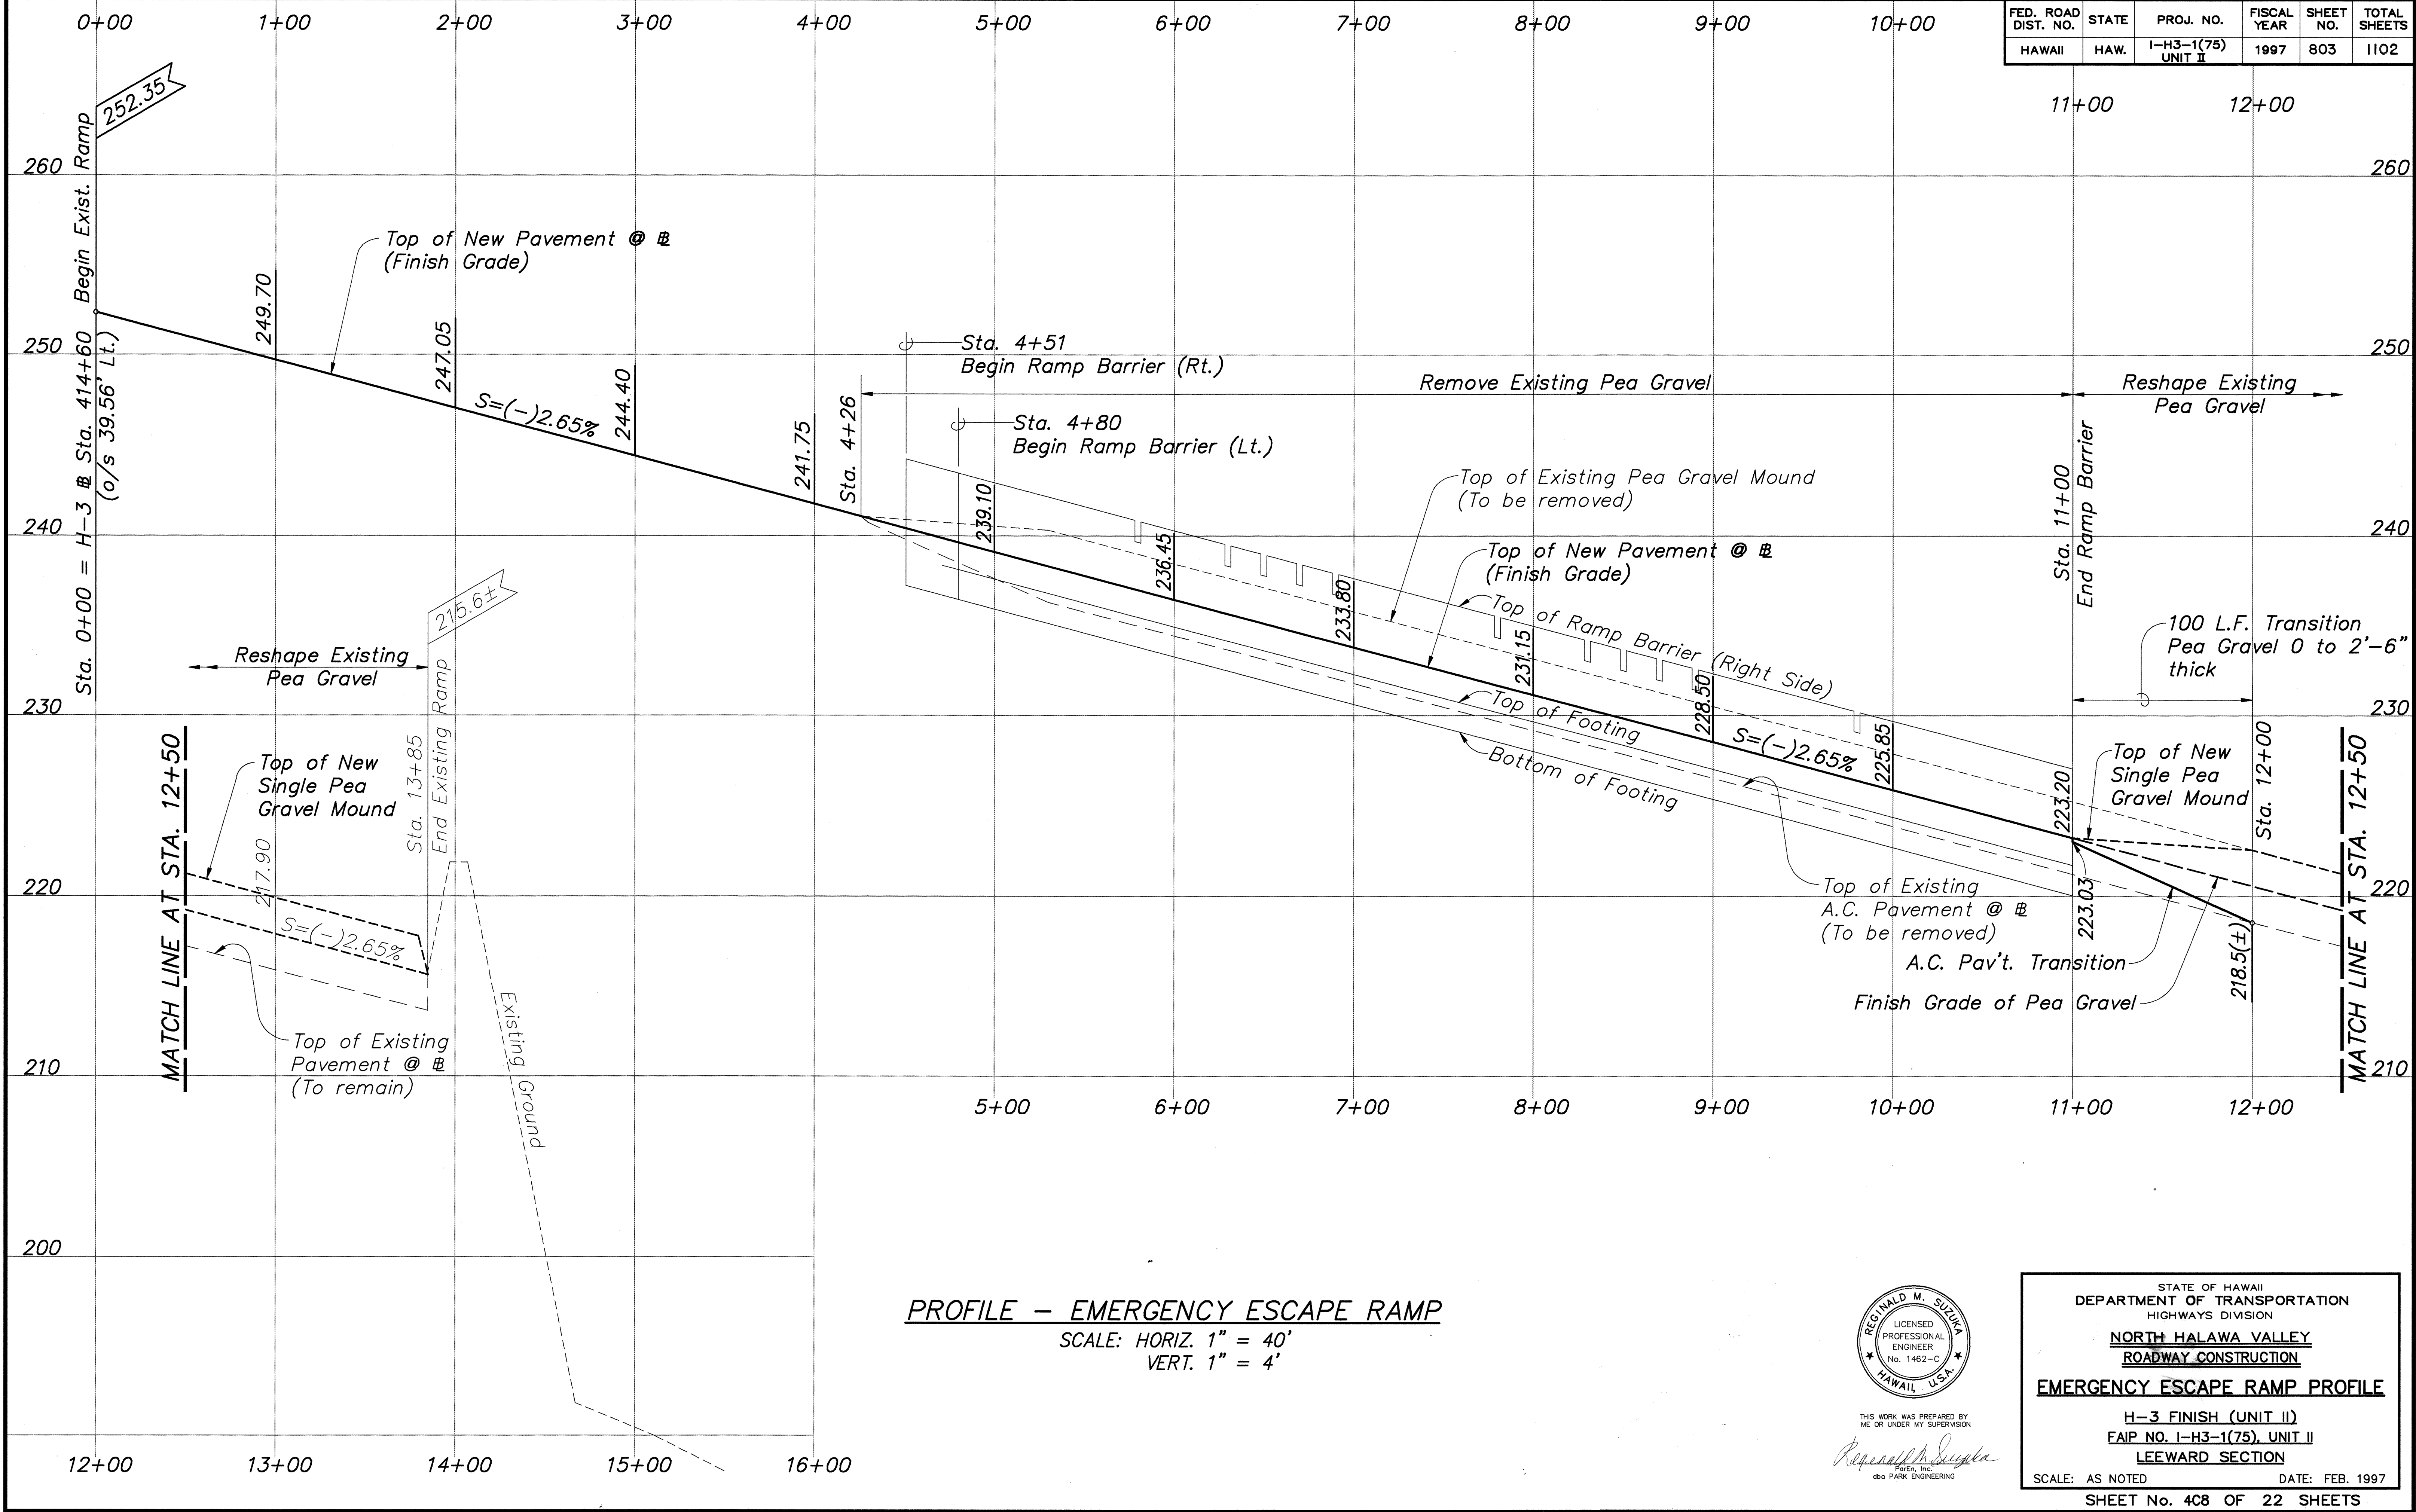

PROFILE - EMERGENCY ESCAPE RAMP
SCALE: HORIZ. 1" = 40'
VERT. 1" = 4'

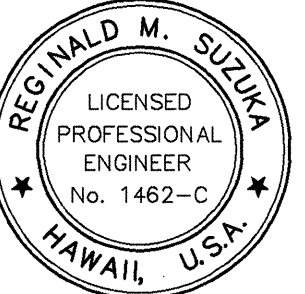

THIS WORK WAS PREPARED BY
ME OR UNDER MY SUPERVISION
Reginald M. Suzuki
P.E., INC.
dba PARK ENGINEERING





STATE OF HAWAII
DEPARTMENT OF TRANSPORTATION
HIGHWAYS DIVISION
NORTH HALAWA VALLEY
ROADWAY CONSTRUCTION
EMERGENCY ESCAPE RAMP PROFILE
H-3 FINISH (UNIT II)
FAIP NO. I-H3-1(75), UNIT II
LEEWARD SECTION
SCALE: AS NOTED DATE: FEB. 1997
SHEET No. 408 OF 22 SHEETS

ORIGINAL	SURVEY PLOTTED BY	DATE
PLAN	DRAWN BY	
NOTE BOOK	DESIGNED BY	
	QUANTITIES BY	
	CHECKED BY	


LIB: STATE/DOH/H-3/1052/UNIT II
RAMP/PROT. 2/13/97 AM

FED. ROAD DIST. NO.	STATE	PROJ. NO.	FISCAL YEAR	SHEET NO.	TOTAL SHEETS
HAWAII	HAW.	I-H3-1(75) UNIT II	1997	804	1102

Note:
Transition New Pea Gravel Mound from 0" to 2'-6" between Sta. 11+00 to 12+00.

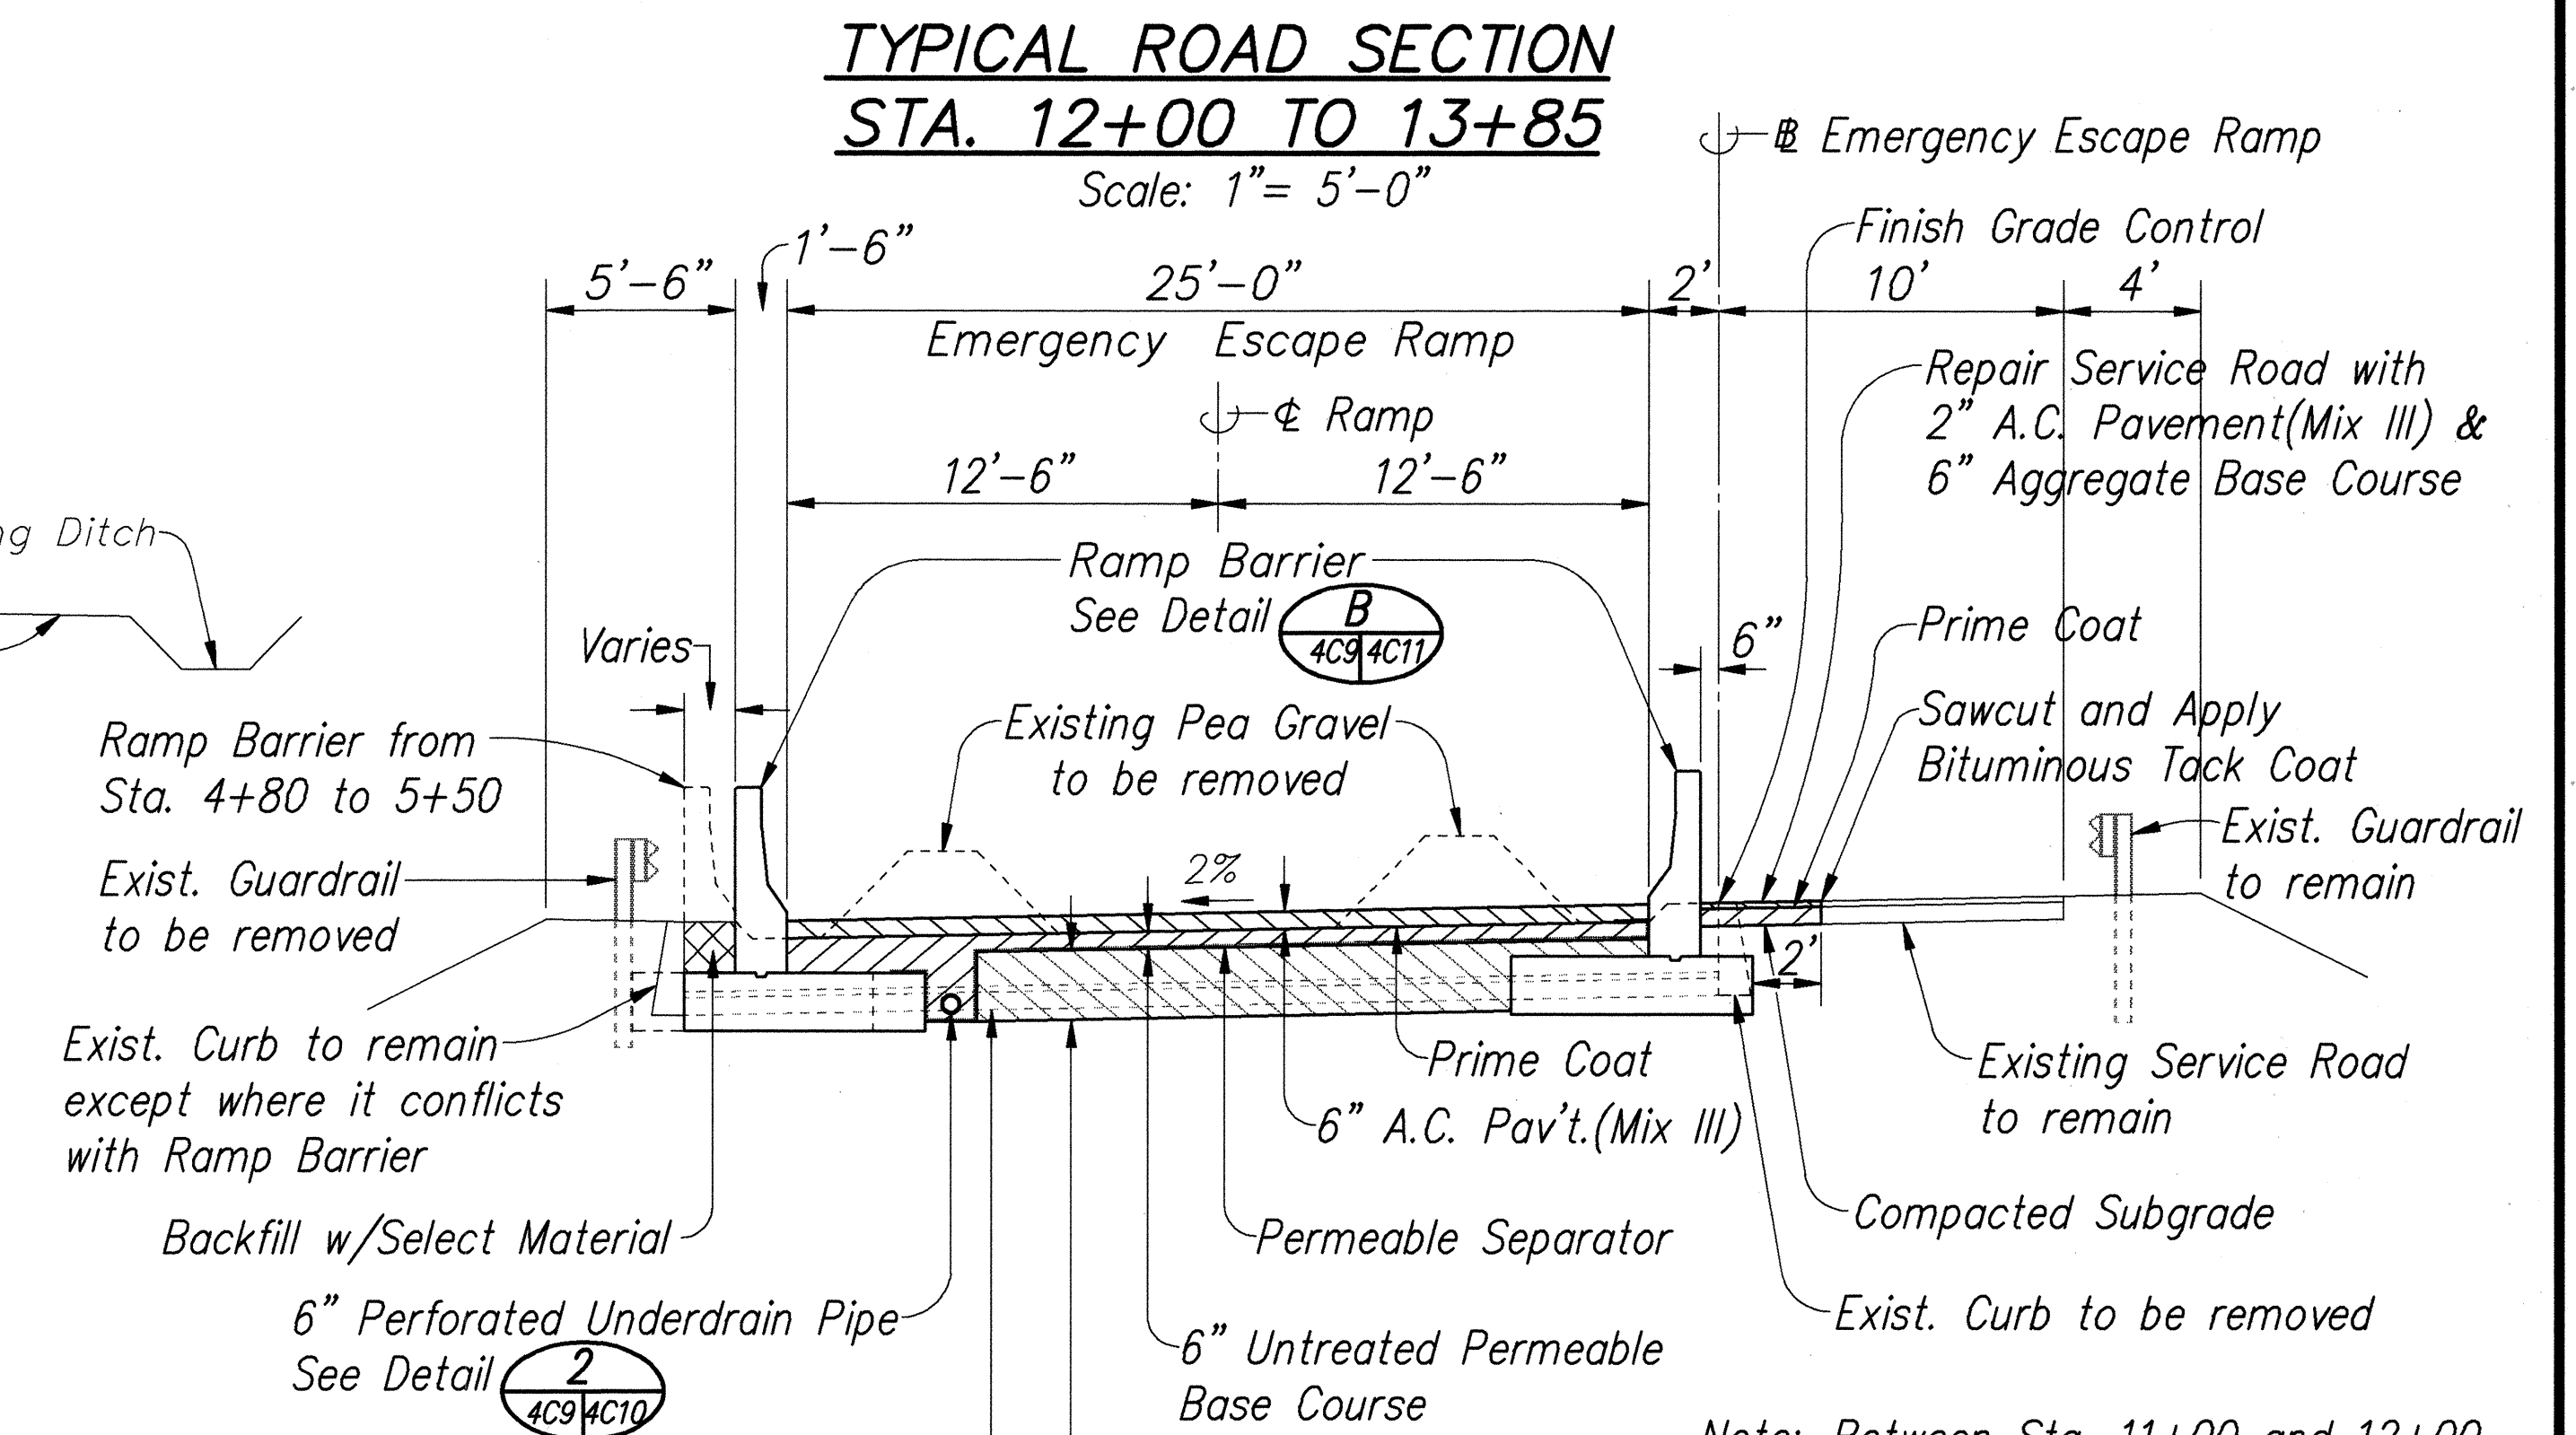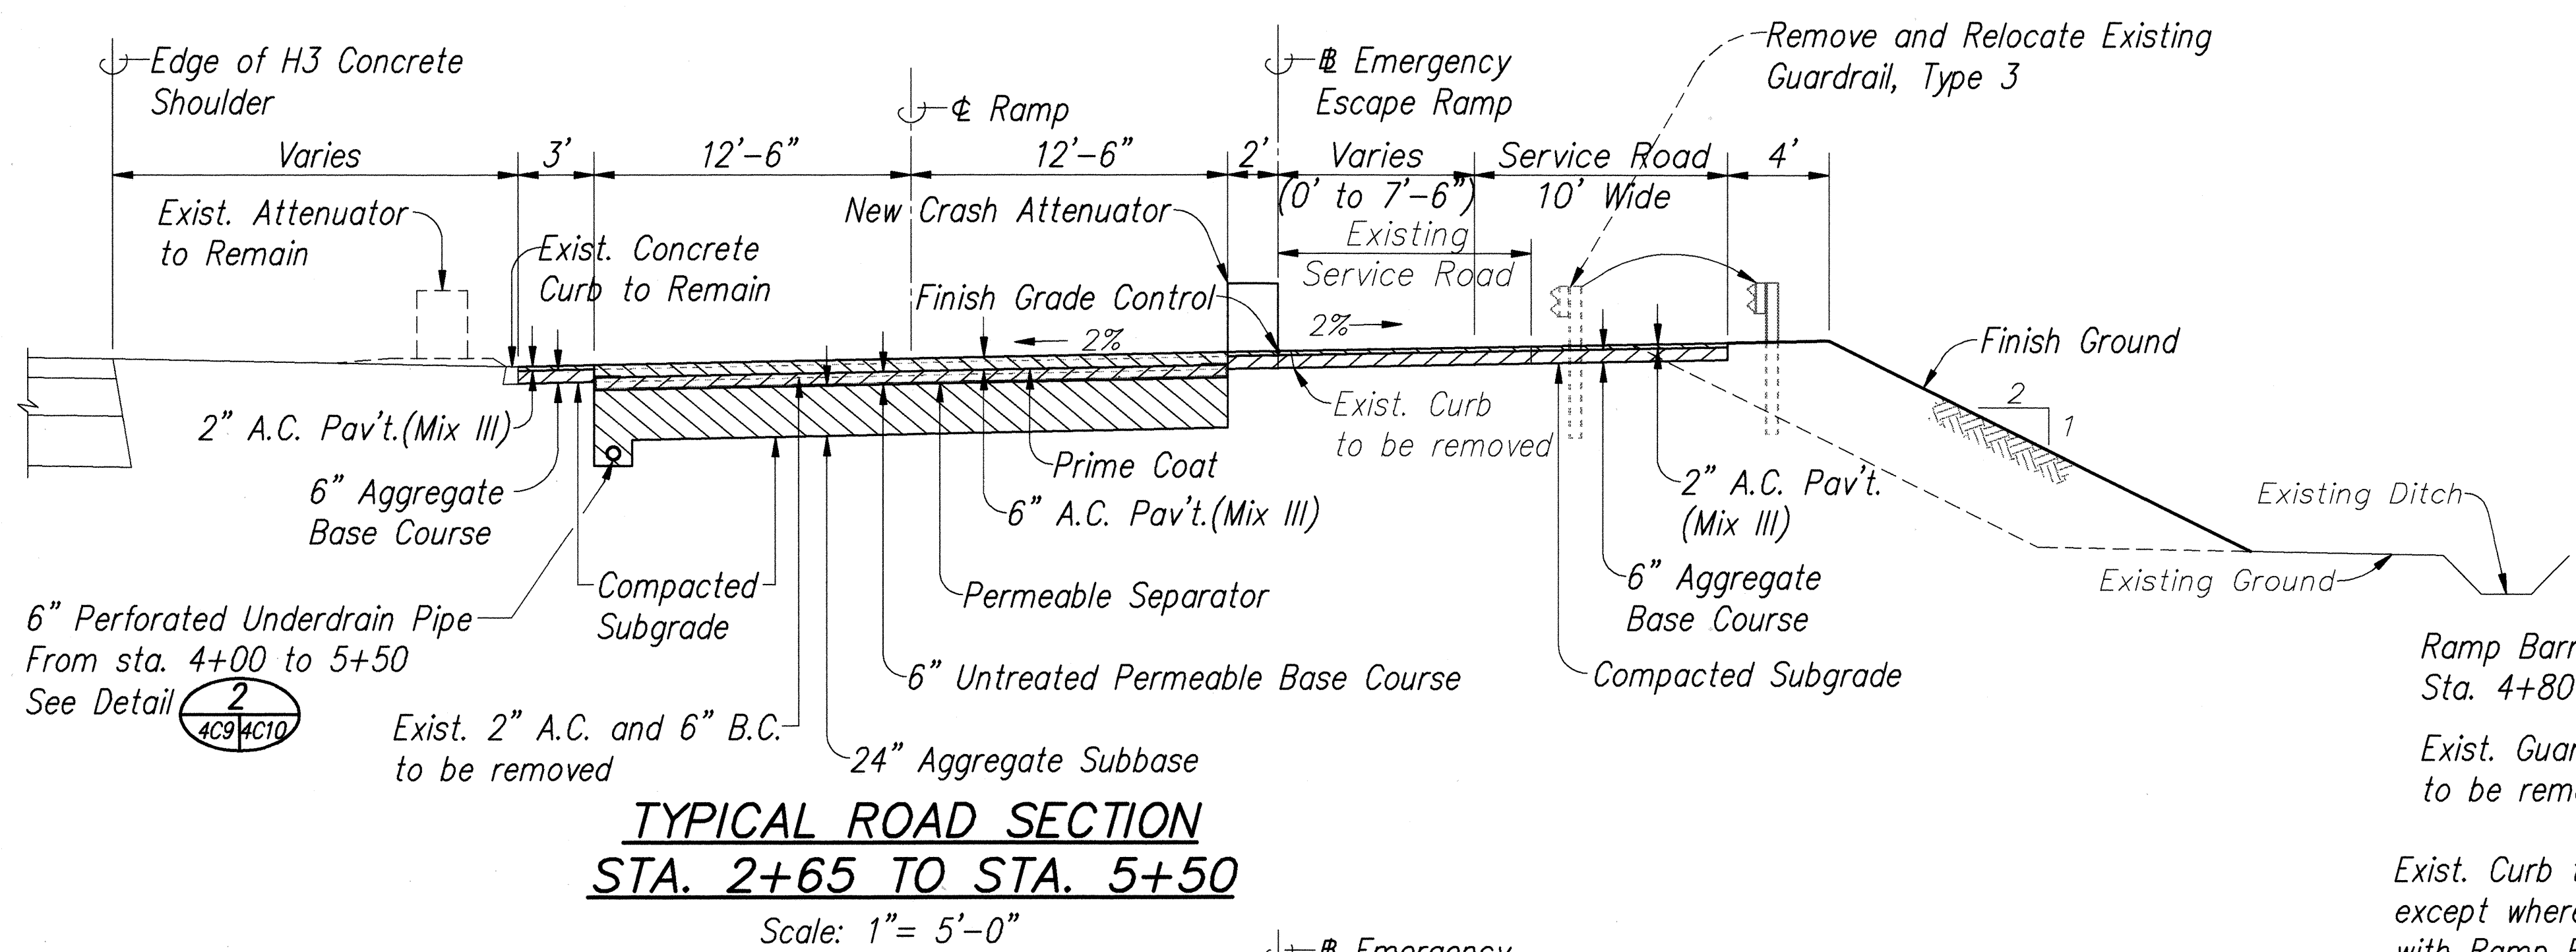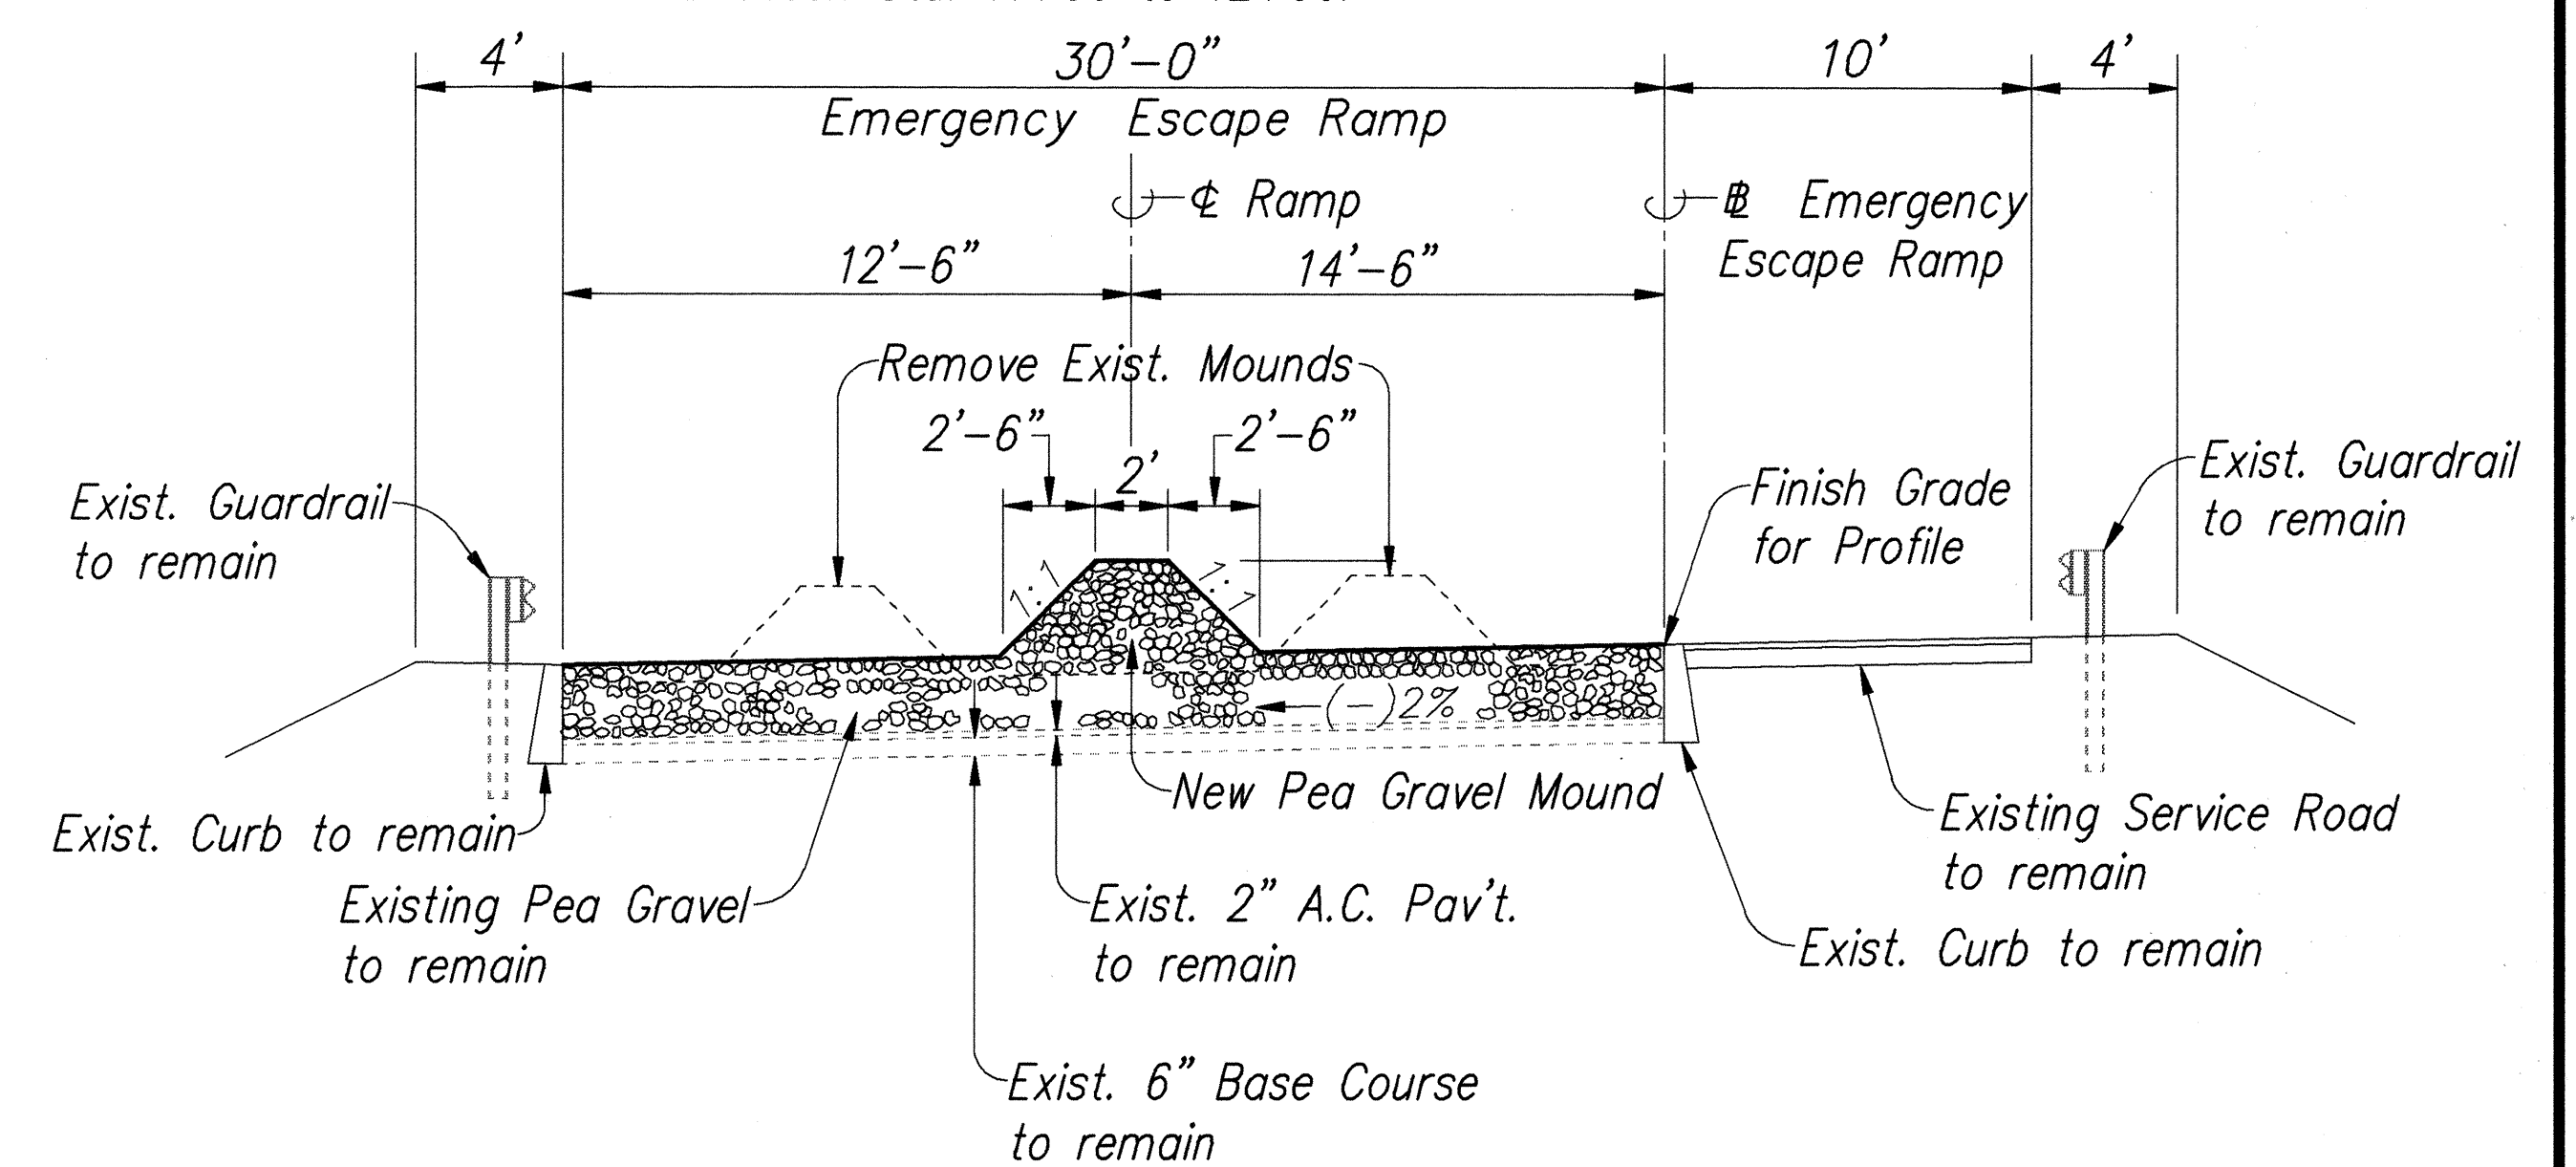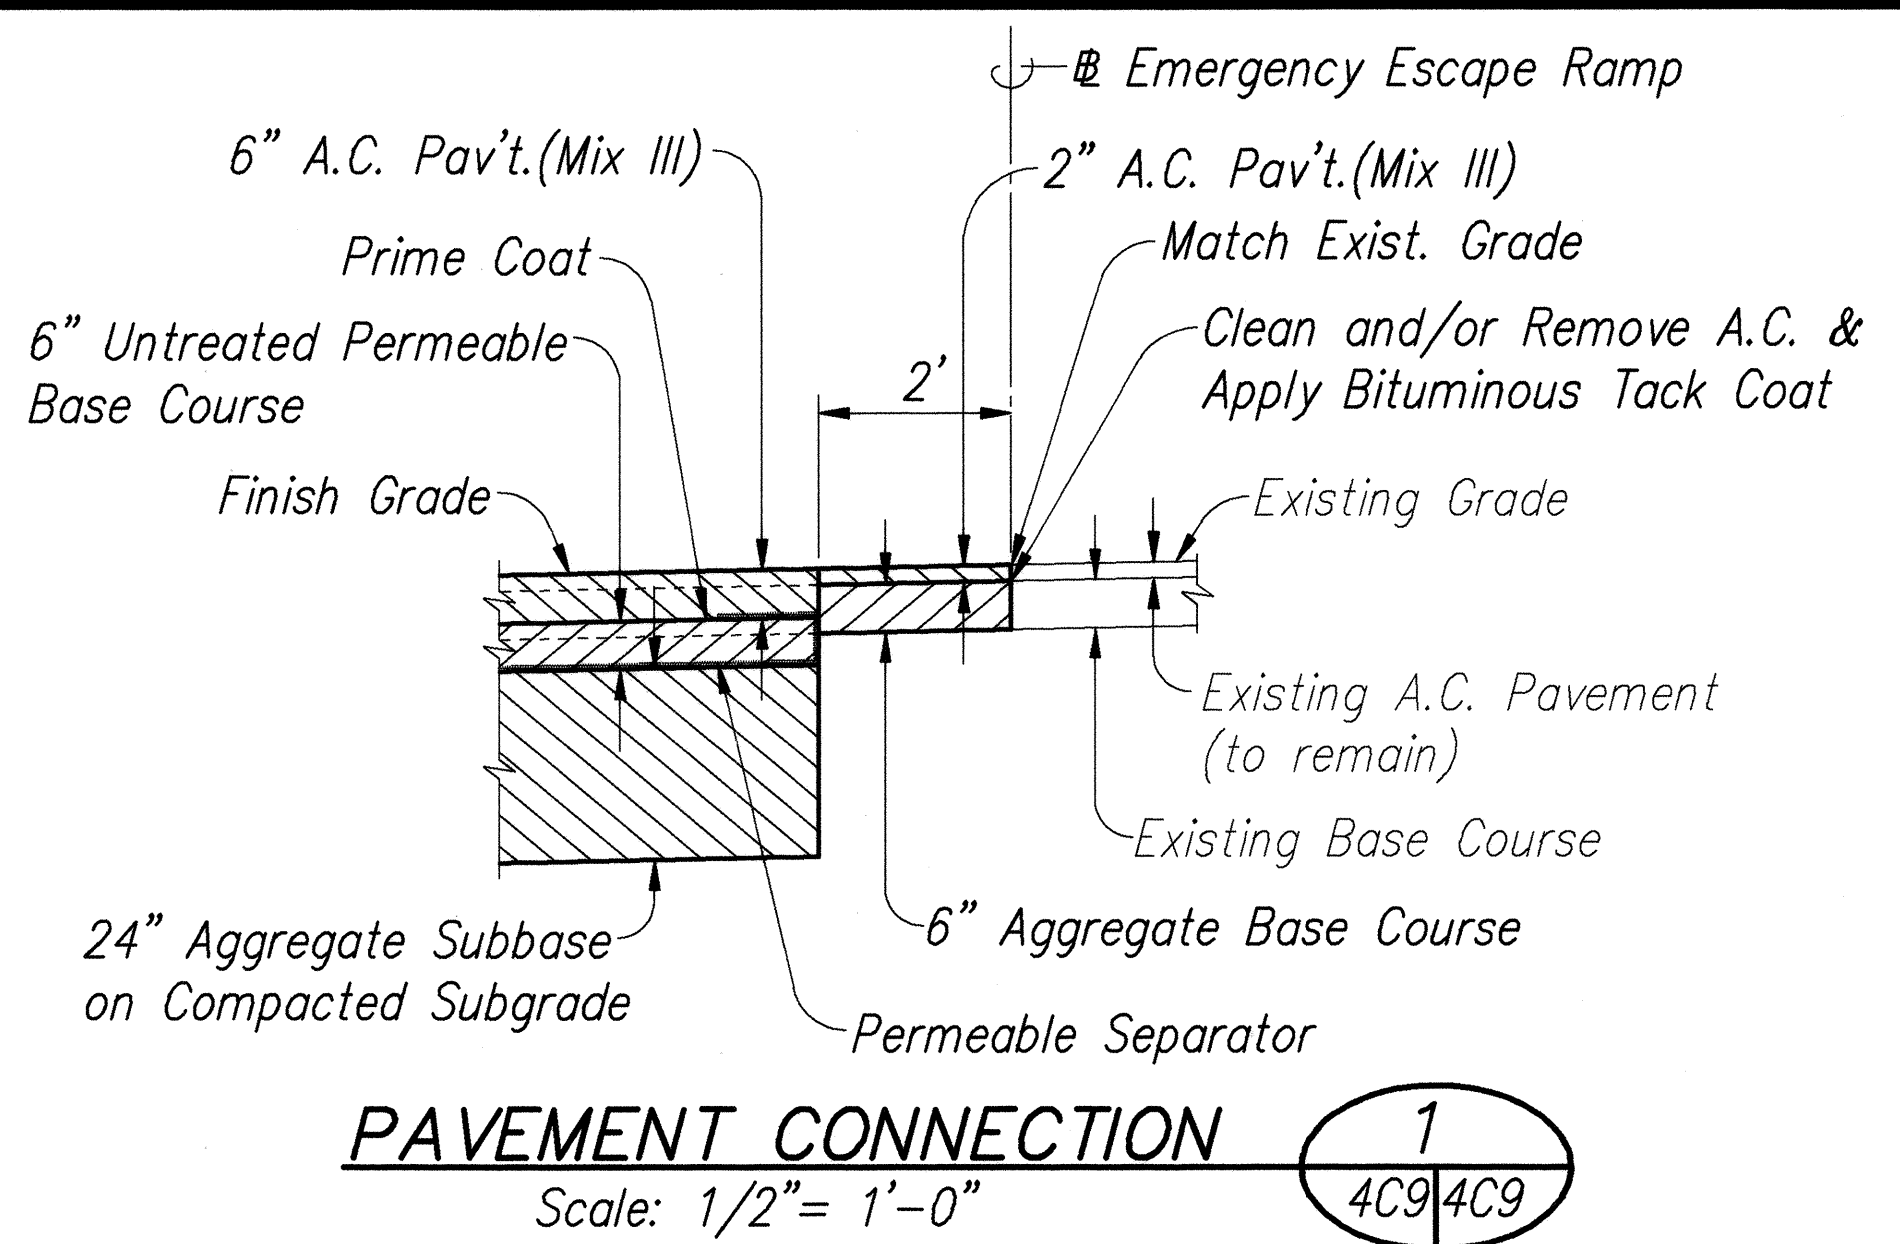

Note: Between Sta. 11+00 and 12+00, Provide 4" thick A.C. Pavement, 6" thick Base Course and 12" thick Aggregate Subbase.

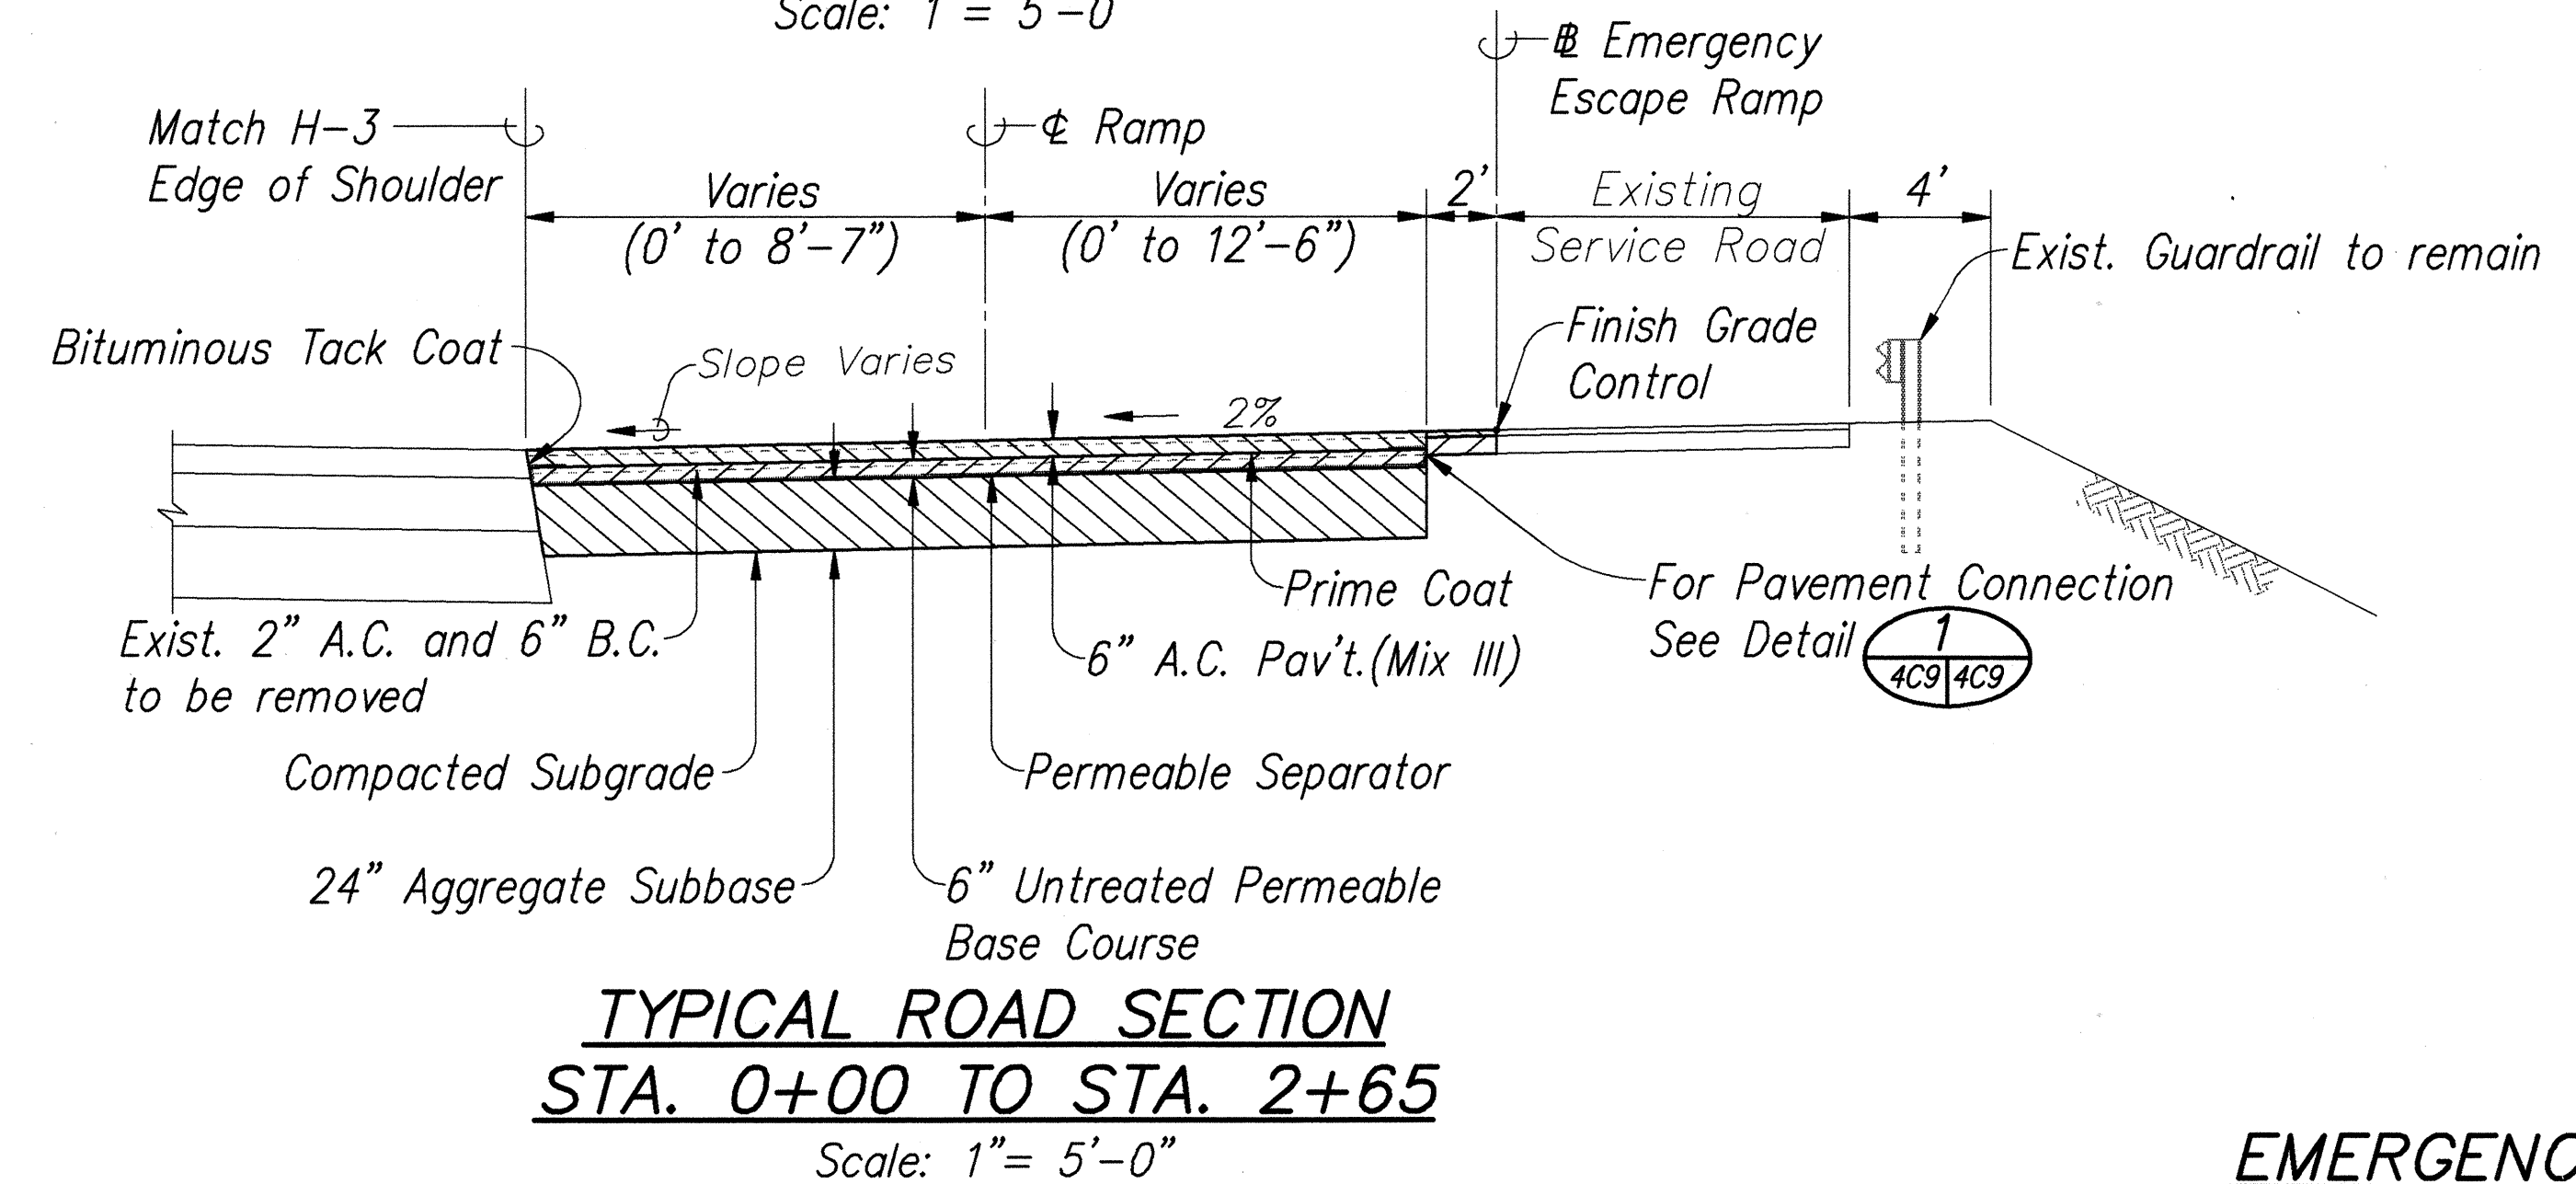

EMERGENCY ESCAPE RAMP
Scale: 1" = 5'-0"


REGINALD M. SUZUKA
LICENSED PROFESSIONAL ENGINEER
No. 1462-C
HAWAII, U.S.A.
THIS WORK WAS PREPARED BY ME OR UNDER MY SUPERVISION
R. M. Suzuki
PARK ENGINEERING

STATE OF HAWAII
DEPARTMENT OF TRANSPORTATION
HIGHWAYS DIVISION
NORTH HALAWA VALLEY
ROADWAY CONSTRUCTION
EMERGENCY ESCAPE RAMP SECTIONS
H-3 FINISH (UNIT II)
FAIP NO. I-H3-1(75), UNIT II
LEEWARD SECTION
SCALE: AS NOTED DATE: FEB. 1997
SHEET No. 4C9 OF 22 SHEETS

ORIGINAL PLAN	DATE
DRAWN BY	
DESIGNED BY	
CHECKED BY	
NOTED BY	
NO.	



LIB: STATE DOT-H-3V-3052-V3FINISH
RAMP/SECT 2/21/97 AMM

FED. ROAD DIST. NO.	STATE	PROJ. NO.	FISCAL YEAR	SHEET NO.	TOTAL SHEETS
HAWAII	HAW.	I-H3-1(75) UNIT II	1997	805	1102

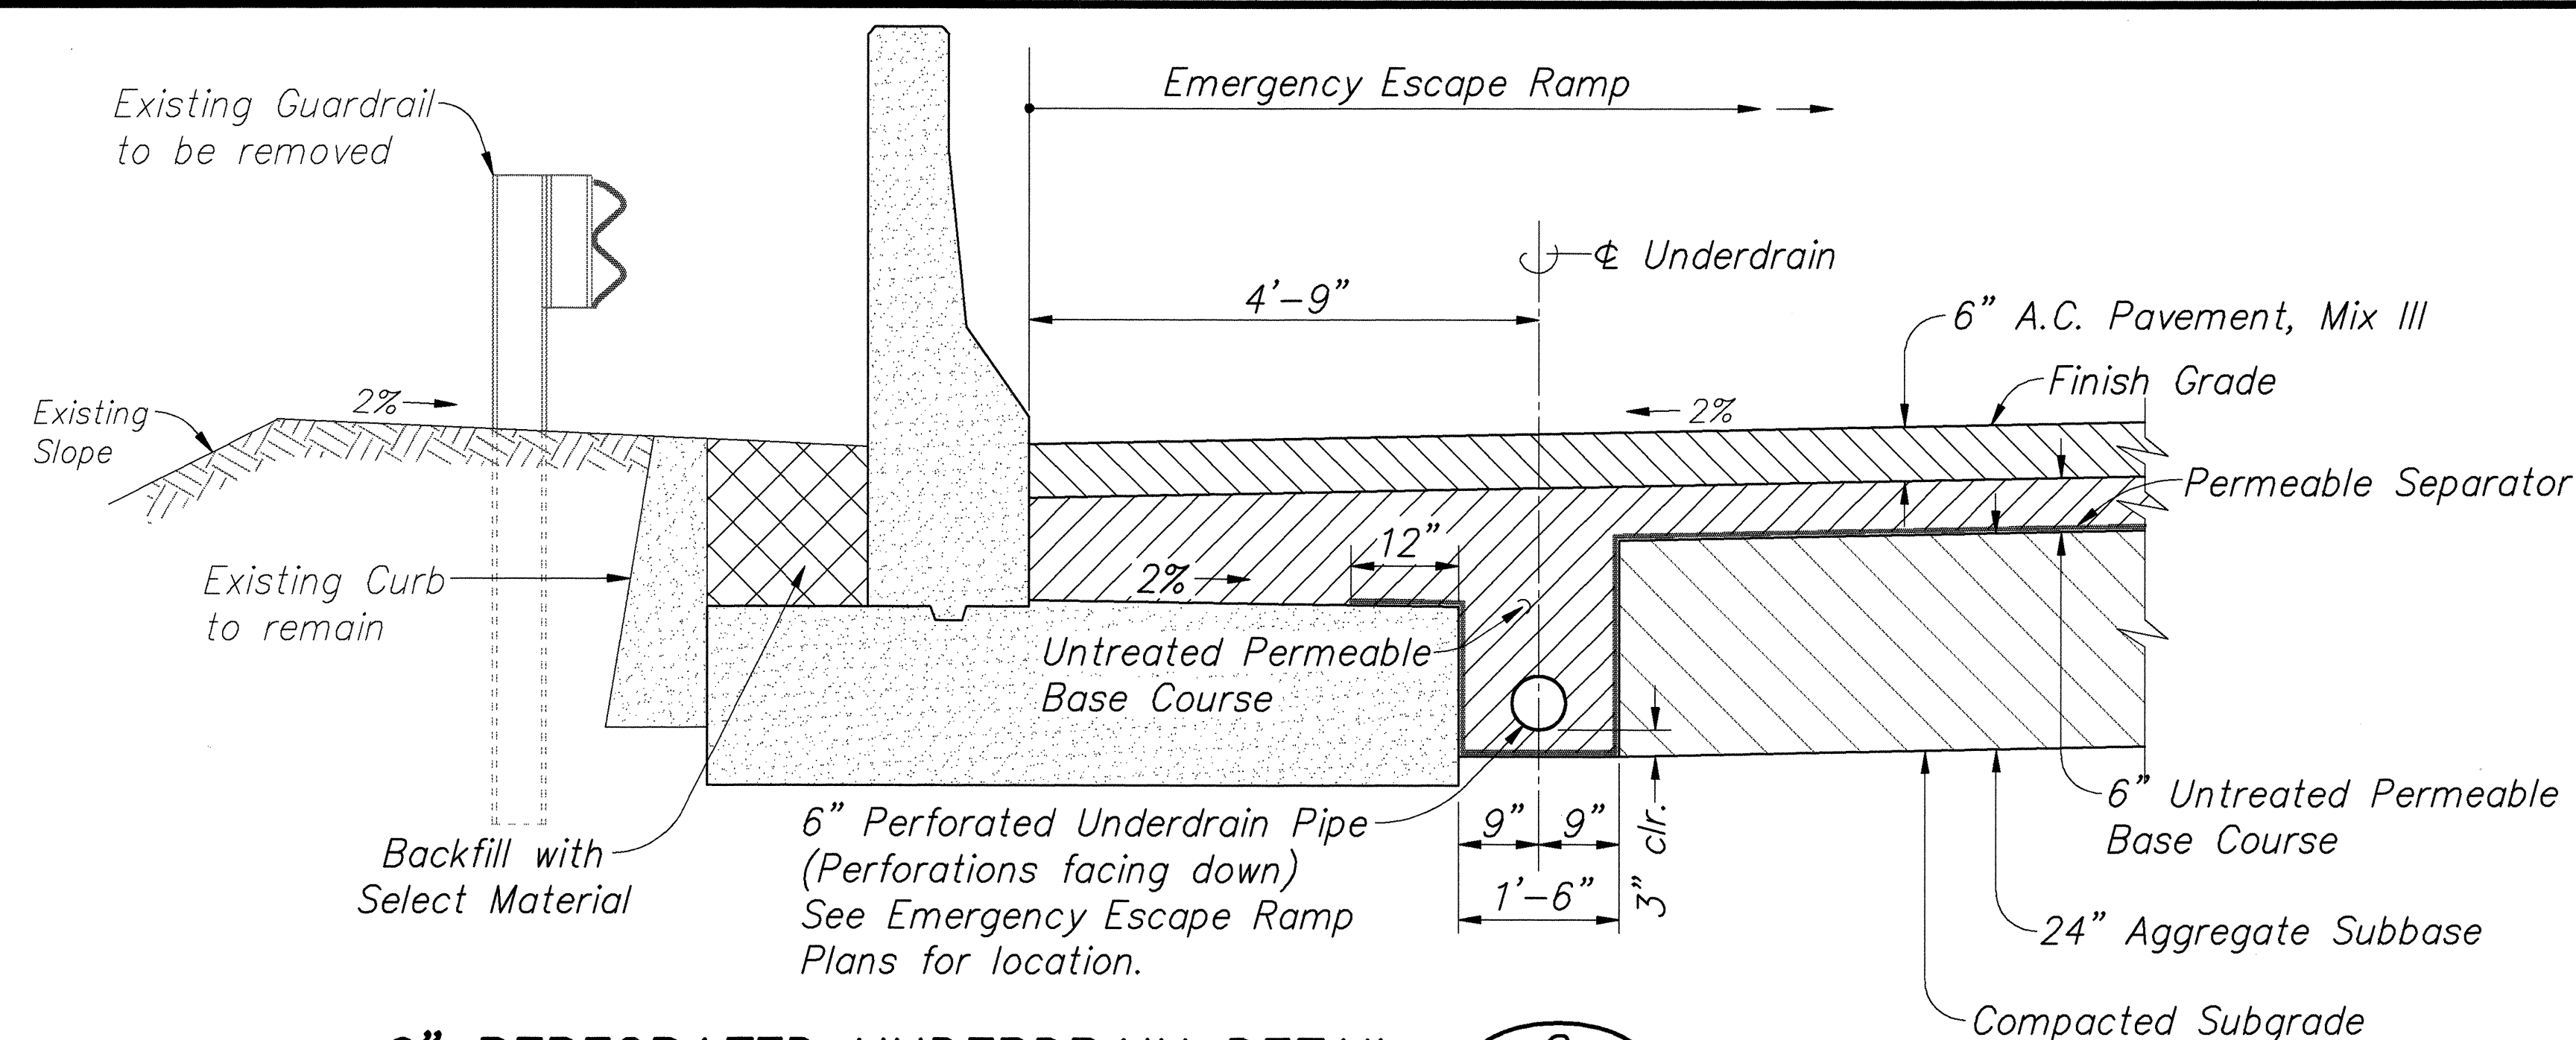


6" PERFORATED UNDERDRAIN DETAIL 2
Scale: 3/4" = 1'-0" 4C7, 4C9, 4C10

(IB Sta. 525+75±)
EMERGENCY ESCAPE RAMP
[Symbol]
2 Cover "1" with overlay panel shown. Overlay panel shall be 8" black number with yellow reflectorized background.
MODIFICATION TO SIGN AT IB STA. 525+75±
N.T.S.

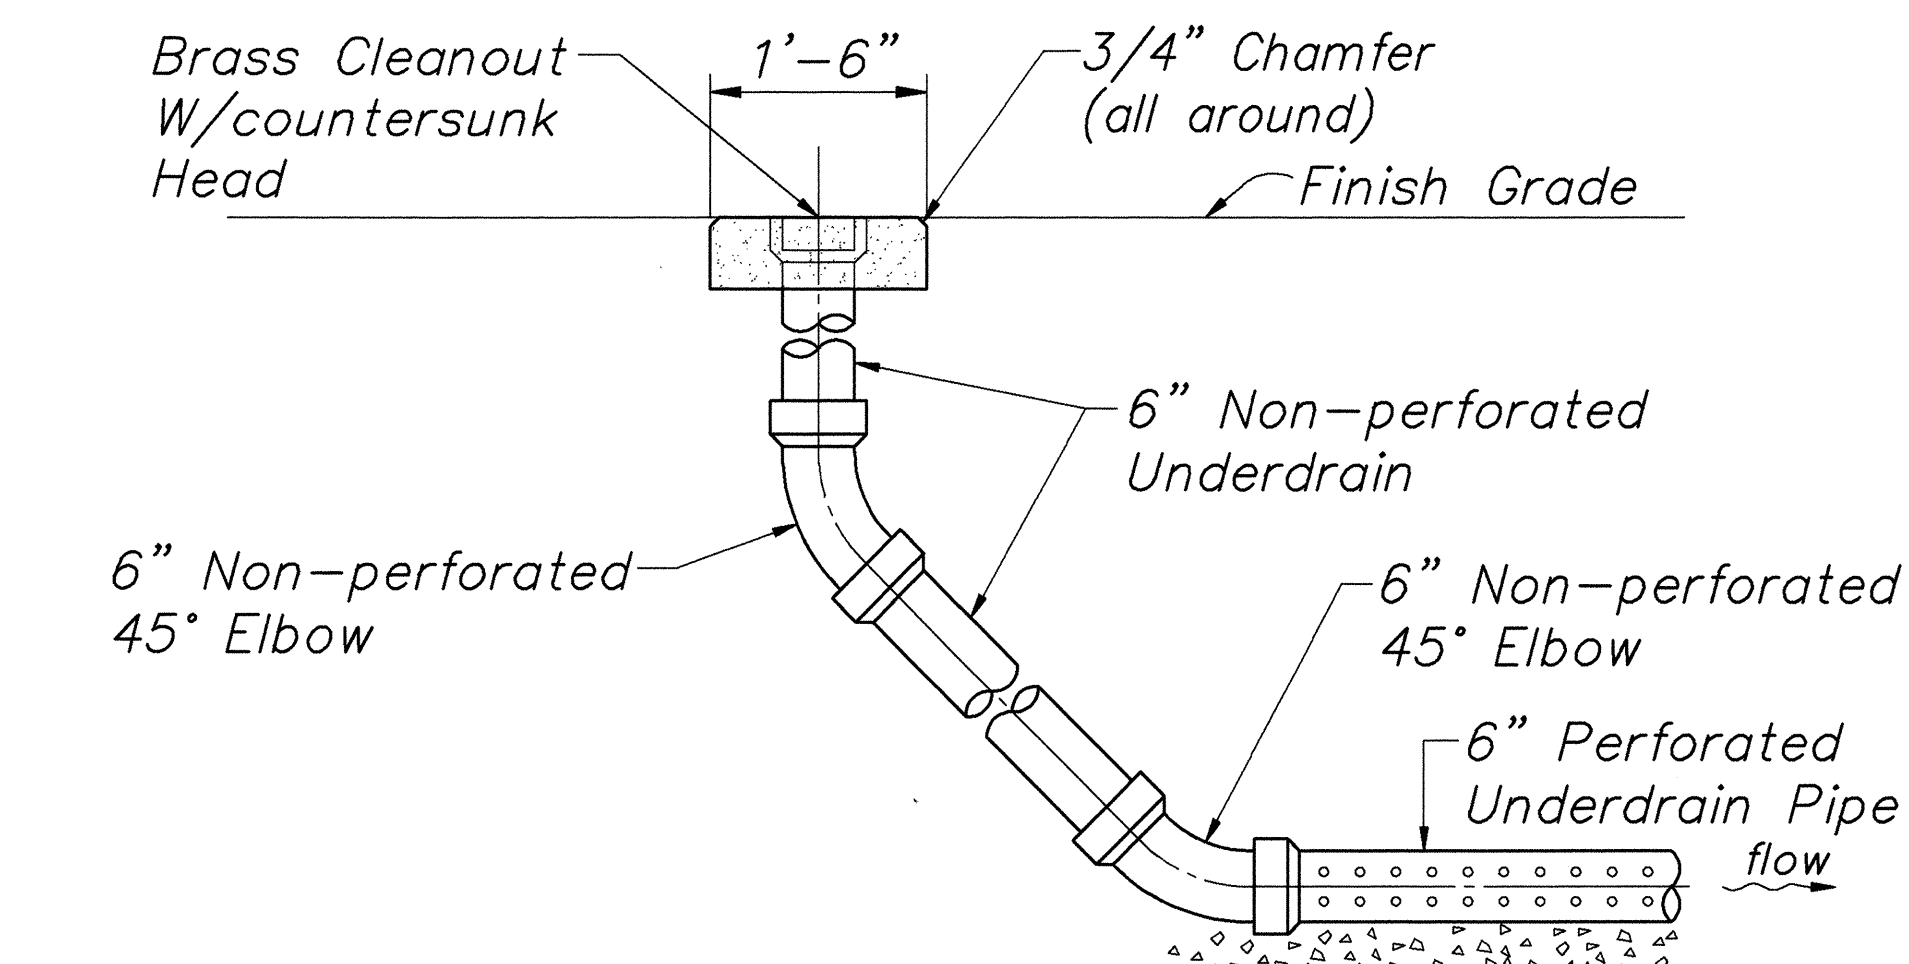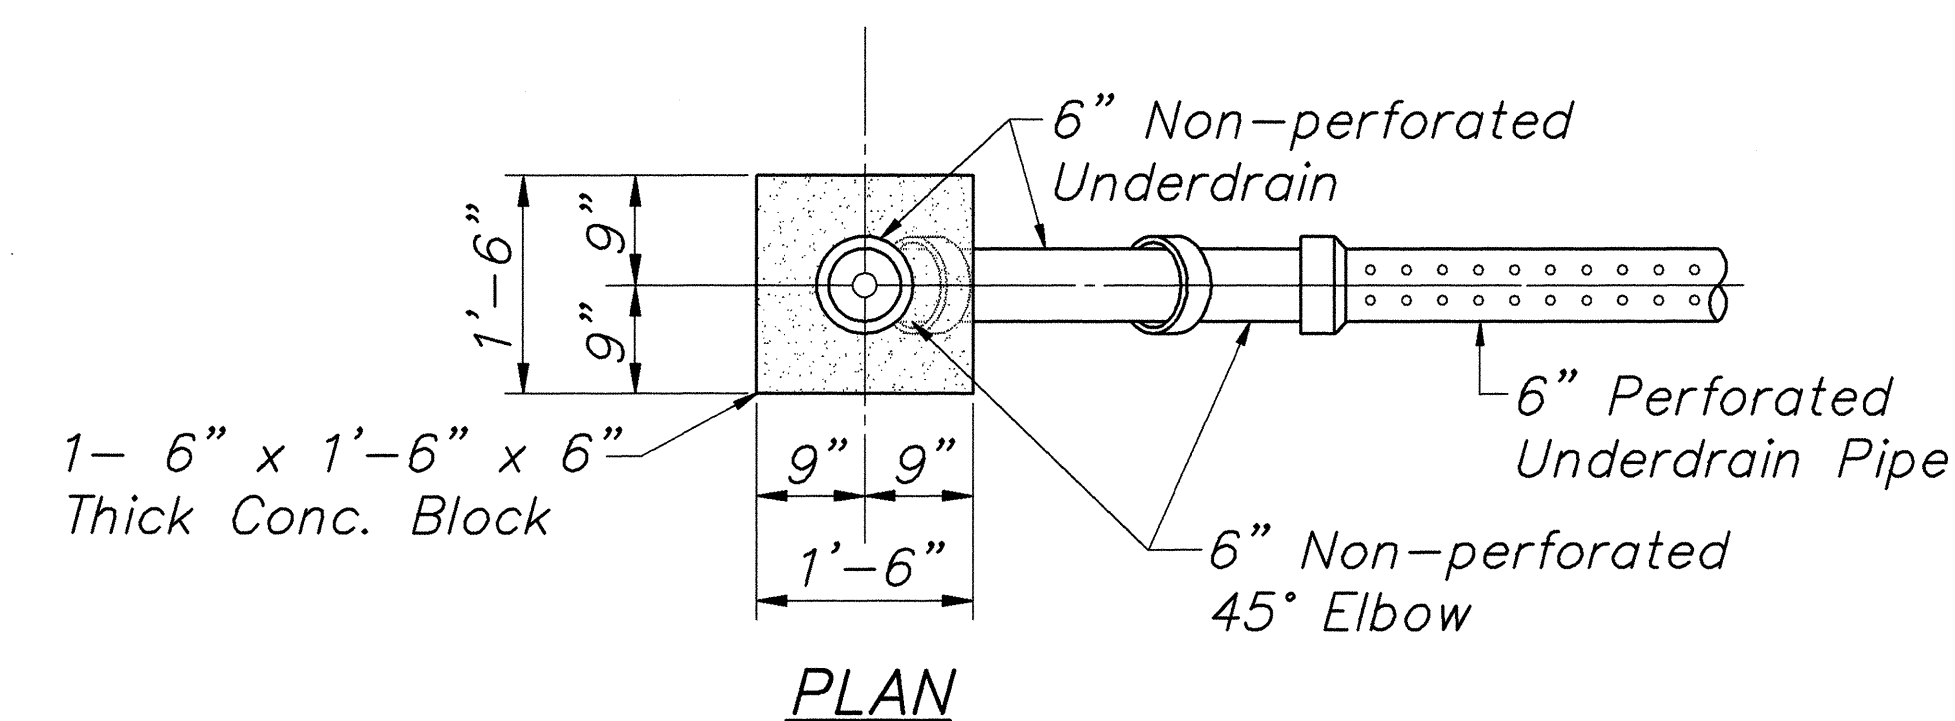


TYPICAL UNDERDRAIN CLEANOUT DETAIL 3
Scale: 3/4" = 1'-0" 4C7, 4C10

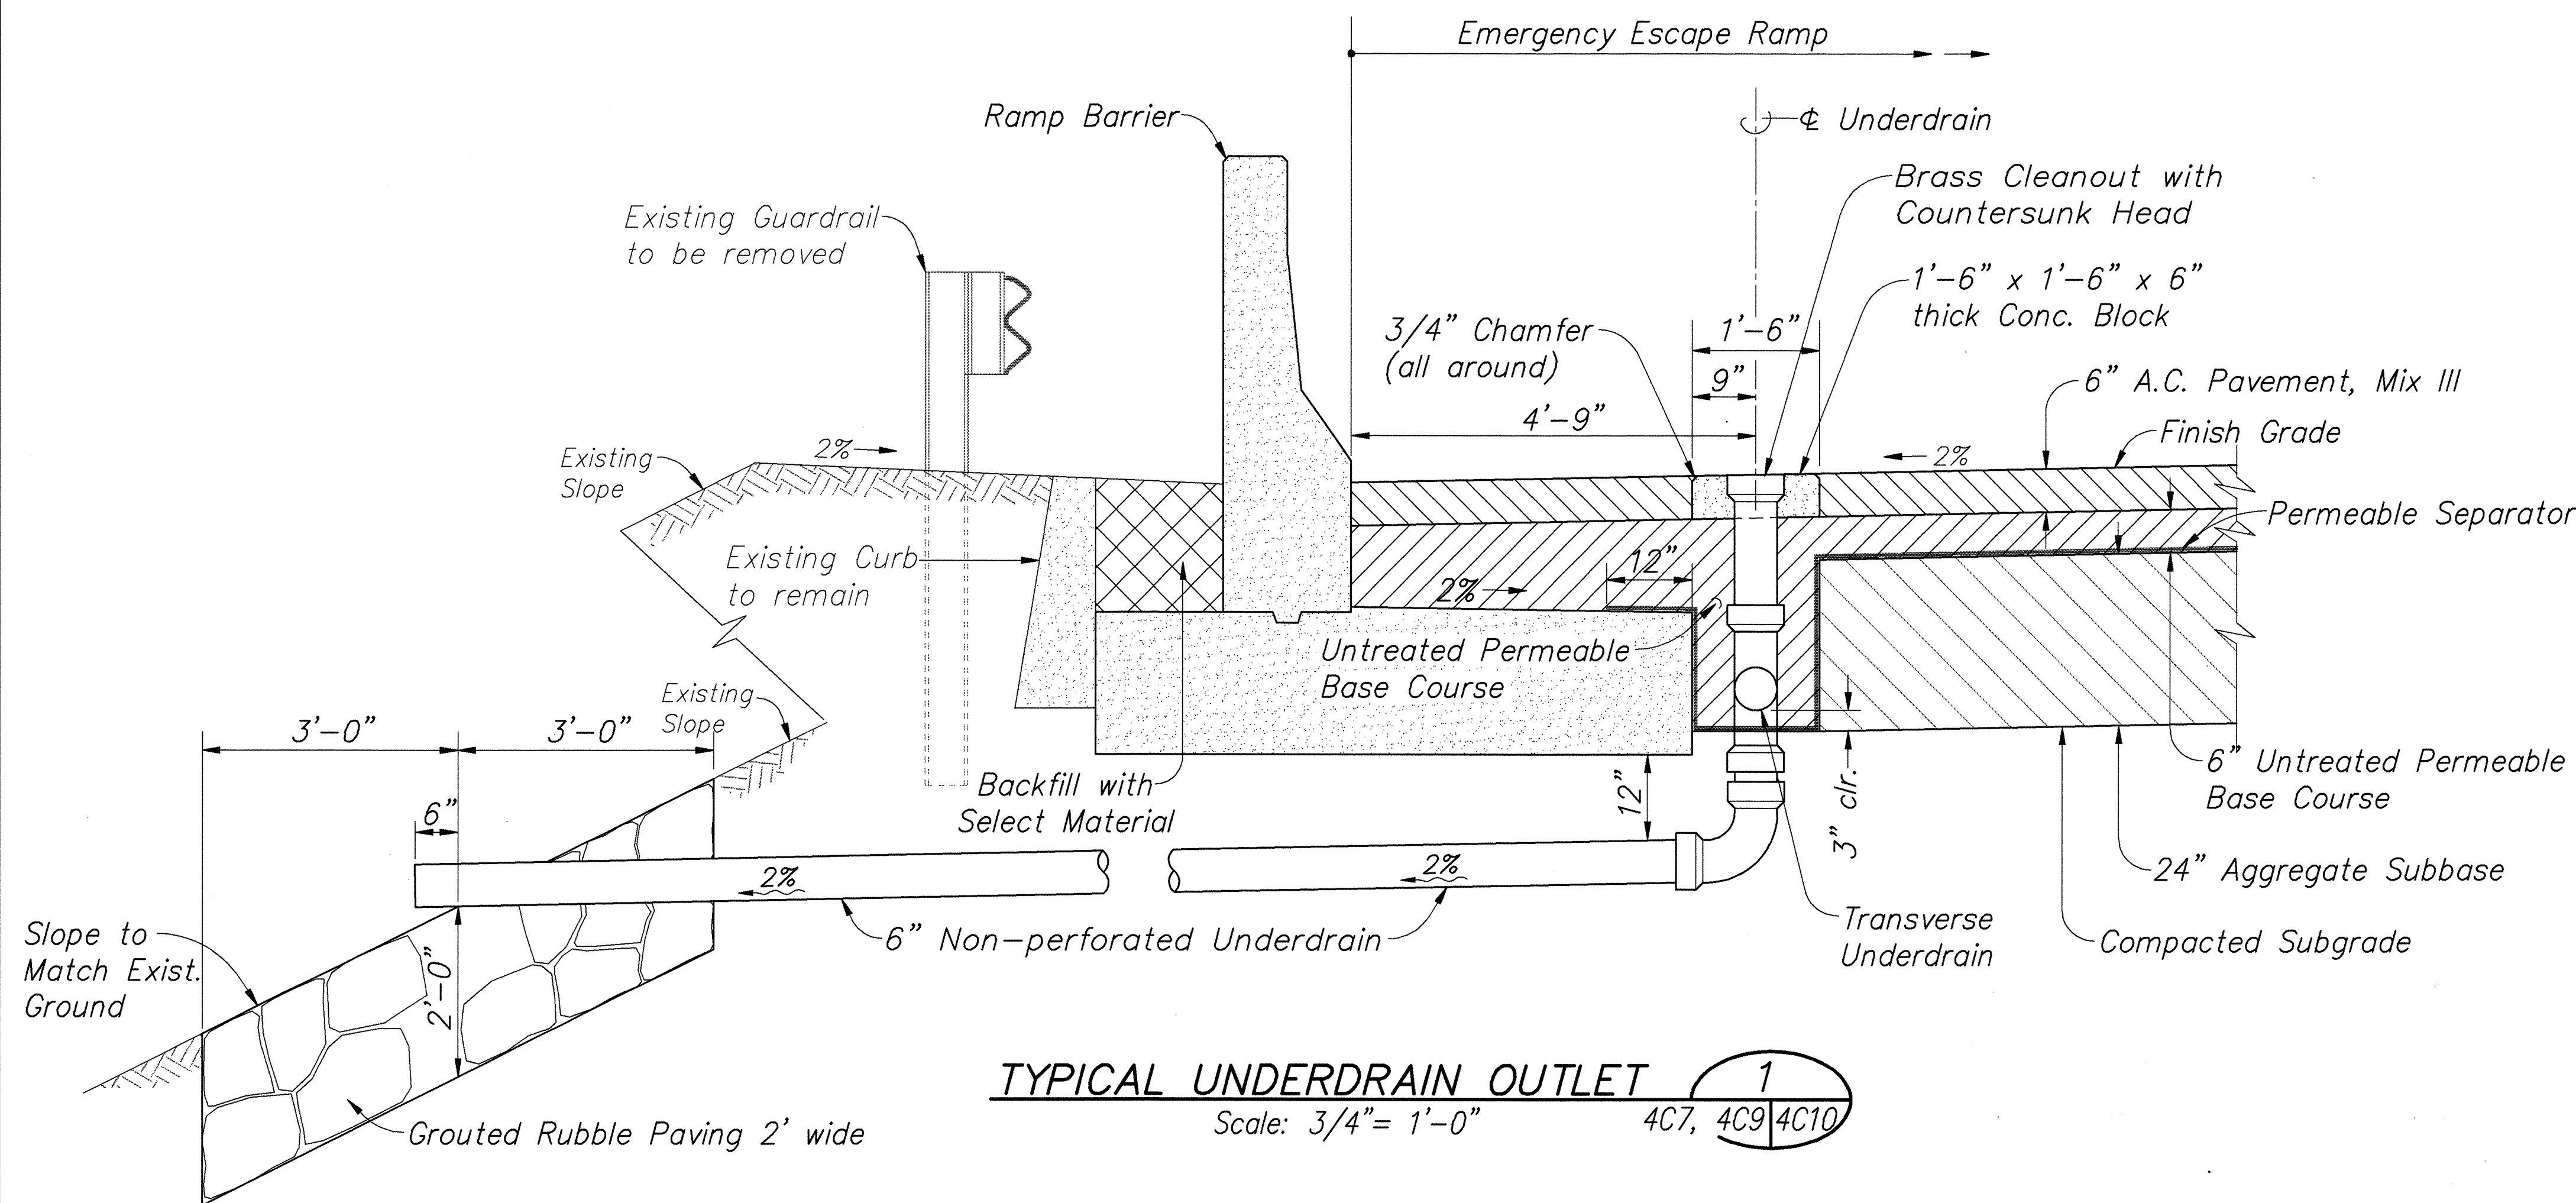

TYPICAL UNDERDRAIN OUTLET 1
Scale: 3/4" = 1'-0" 4C7, 4C9, 4C10

SURVEY PLOTTED BY	DATE
DESIGNED BY	
TRAINED BY	
NOTED BY	
CHECKED BY	
NO.	

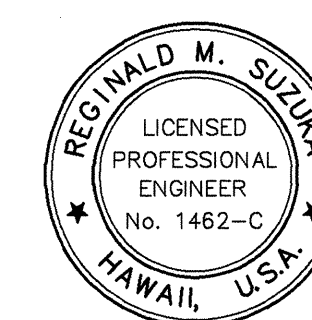

THIS WORK WAS PREPARED BY
ME OR UNDER MY SUPERVISION

Reginald M. Suzuki
P.E., Inc.
dba PARK ENGINEERING

STATE OF HAWAII
DEPARTMENT OF TRANSPORTATION
HIGHWAYS DIVISION

**NORTH HALAWA VALLEY
ROADWAY CONSTRUCTION**



EMERGENCY ESCAPE RAMP DETAILS

H-3 FINISH (UNIT II)
FAIP NO. I-H3-1(75), UNIT II
LEEWARD SECTION


SCALE: AS NOTED DATE: FEB. 1997

SHEET No. 4C10 OF 22 SHEETS


FED. ROAD DIST. NO.	STATE	PROJ. NO.	FISCAL YEAR	SHEET NO.	TOTAL SHEETS
HAWAII	HAW.	I-H3-1(75) UNIT II	1997	806	1102

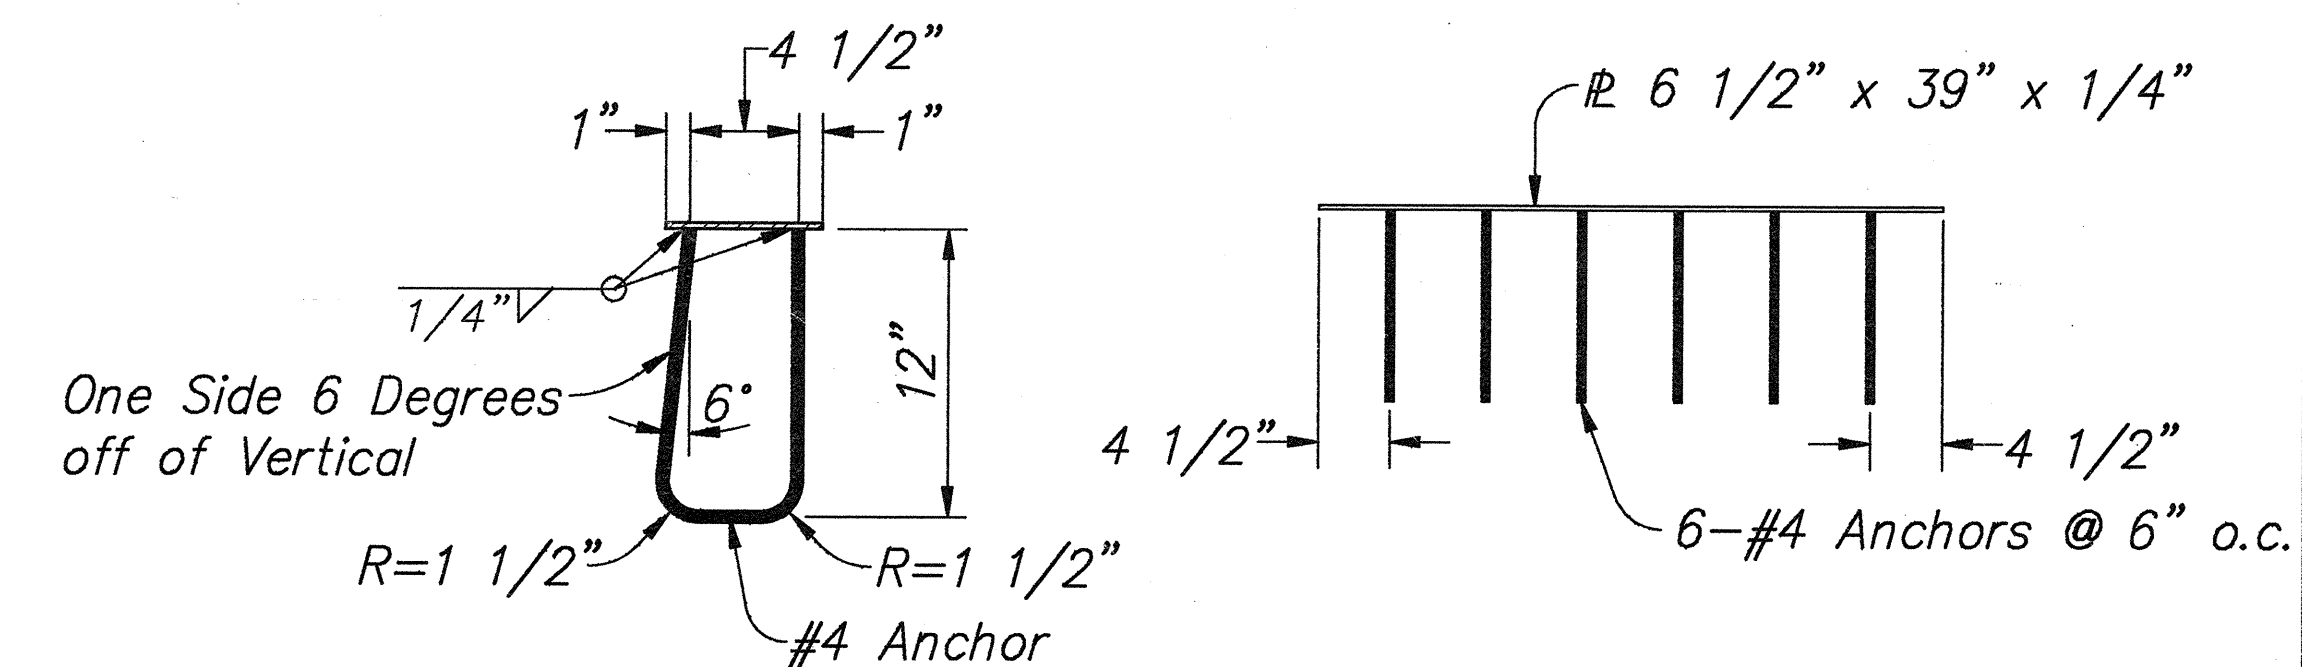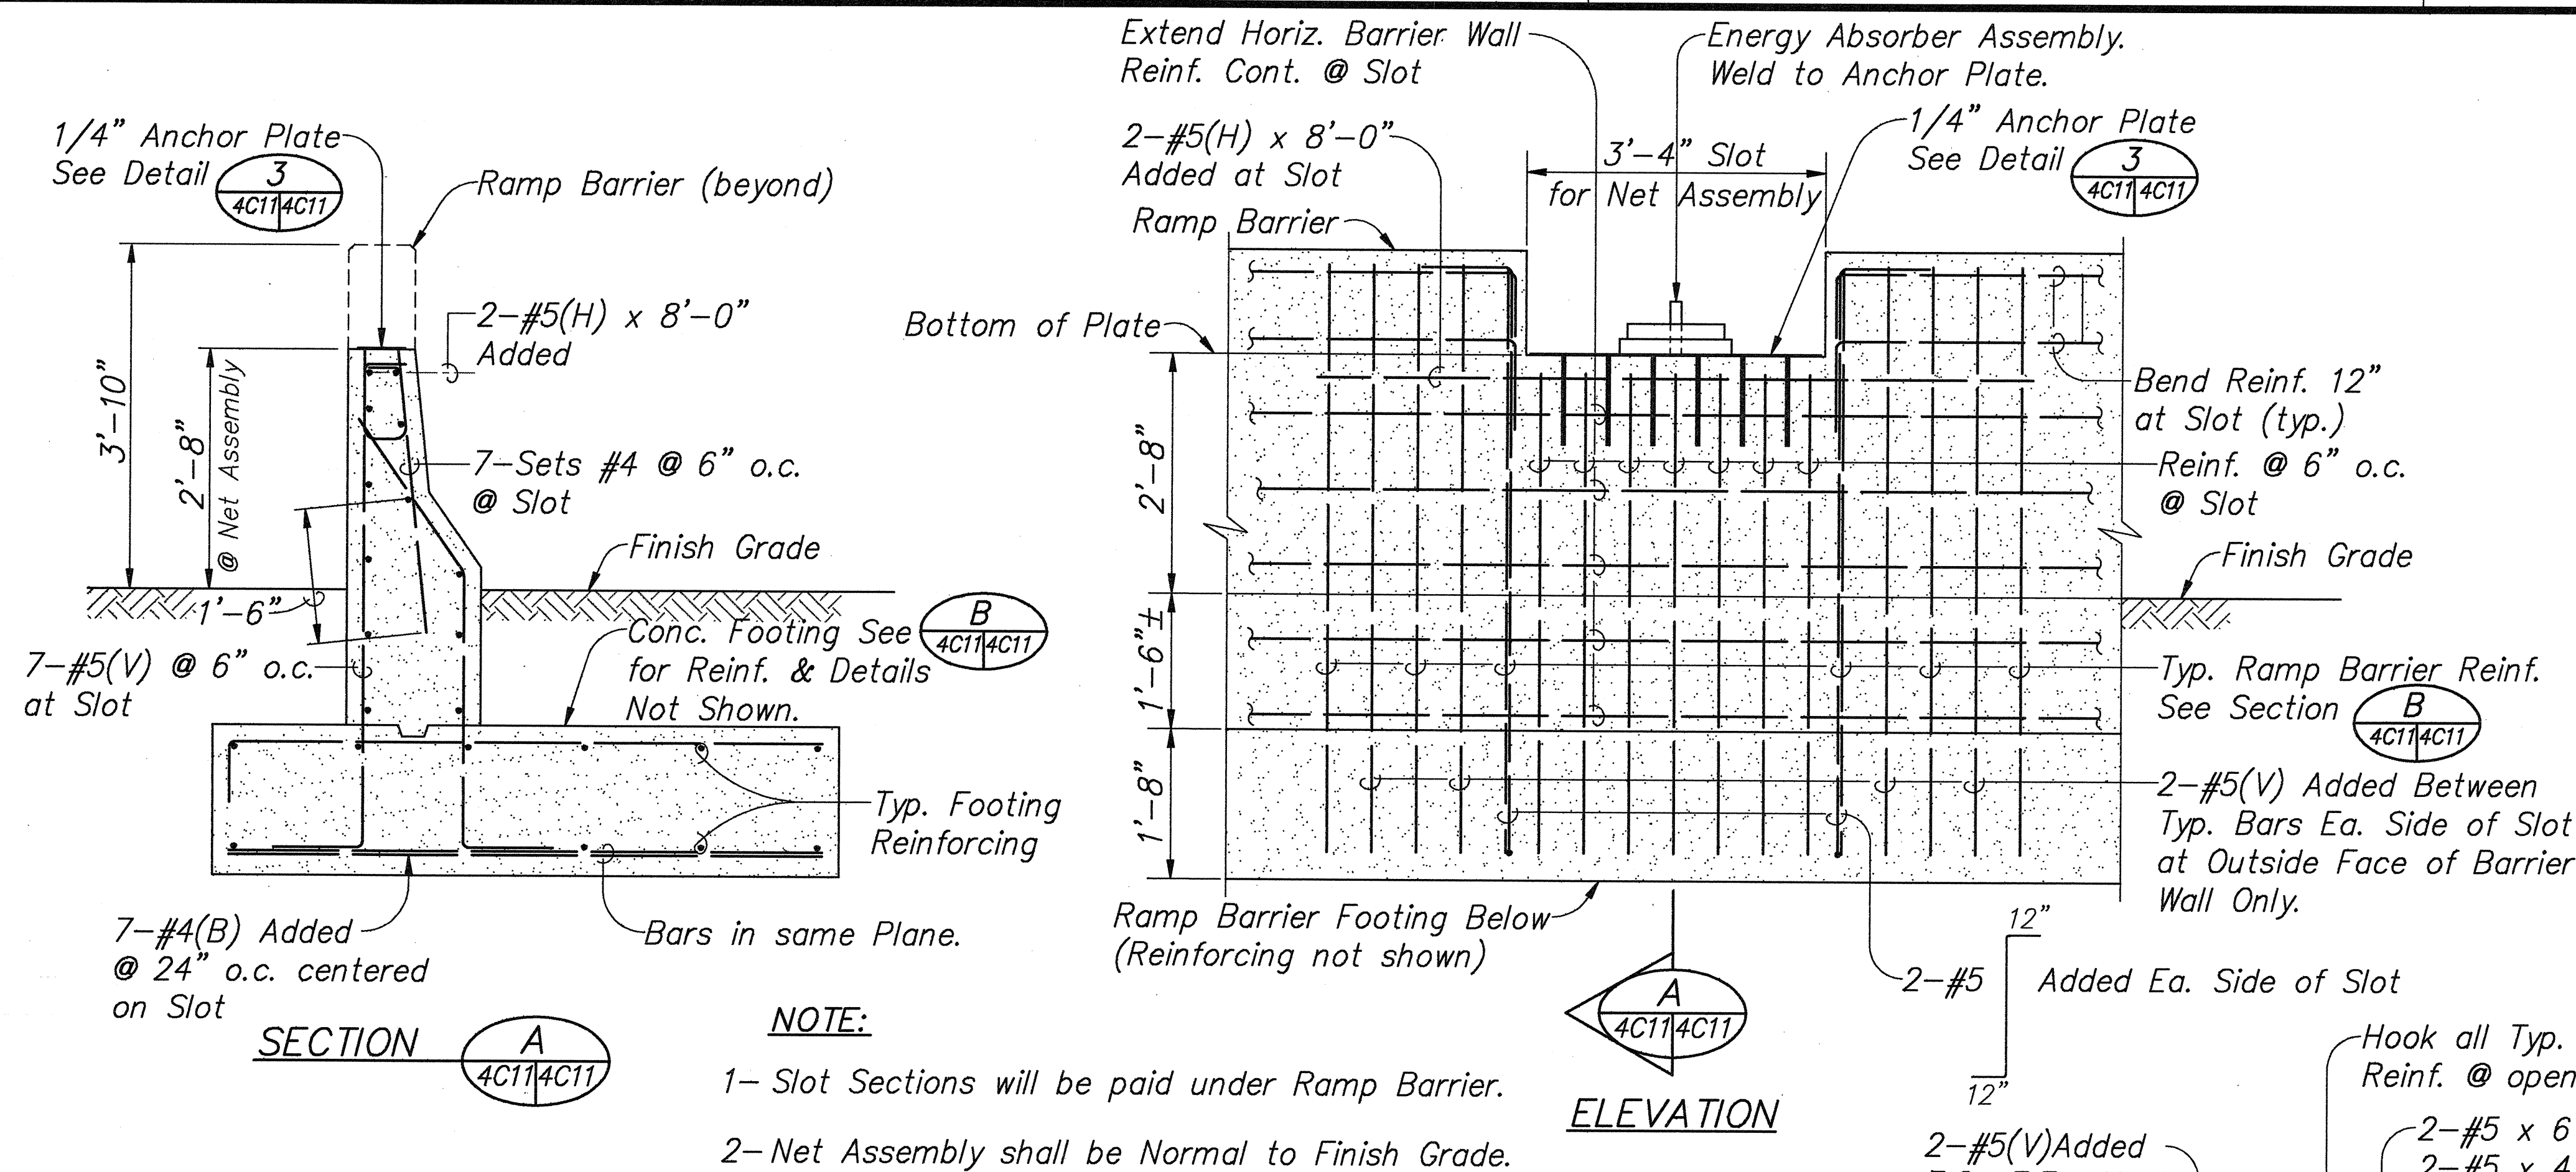


ANCHOR PLATE FOR NET/ENERGY ABSORBER 3
Scale: $3/4" = 1'-0"$ 4C11/4C11

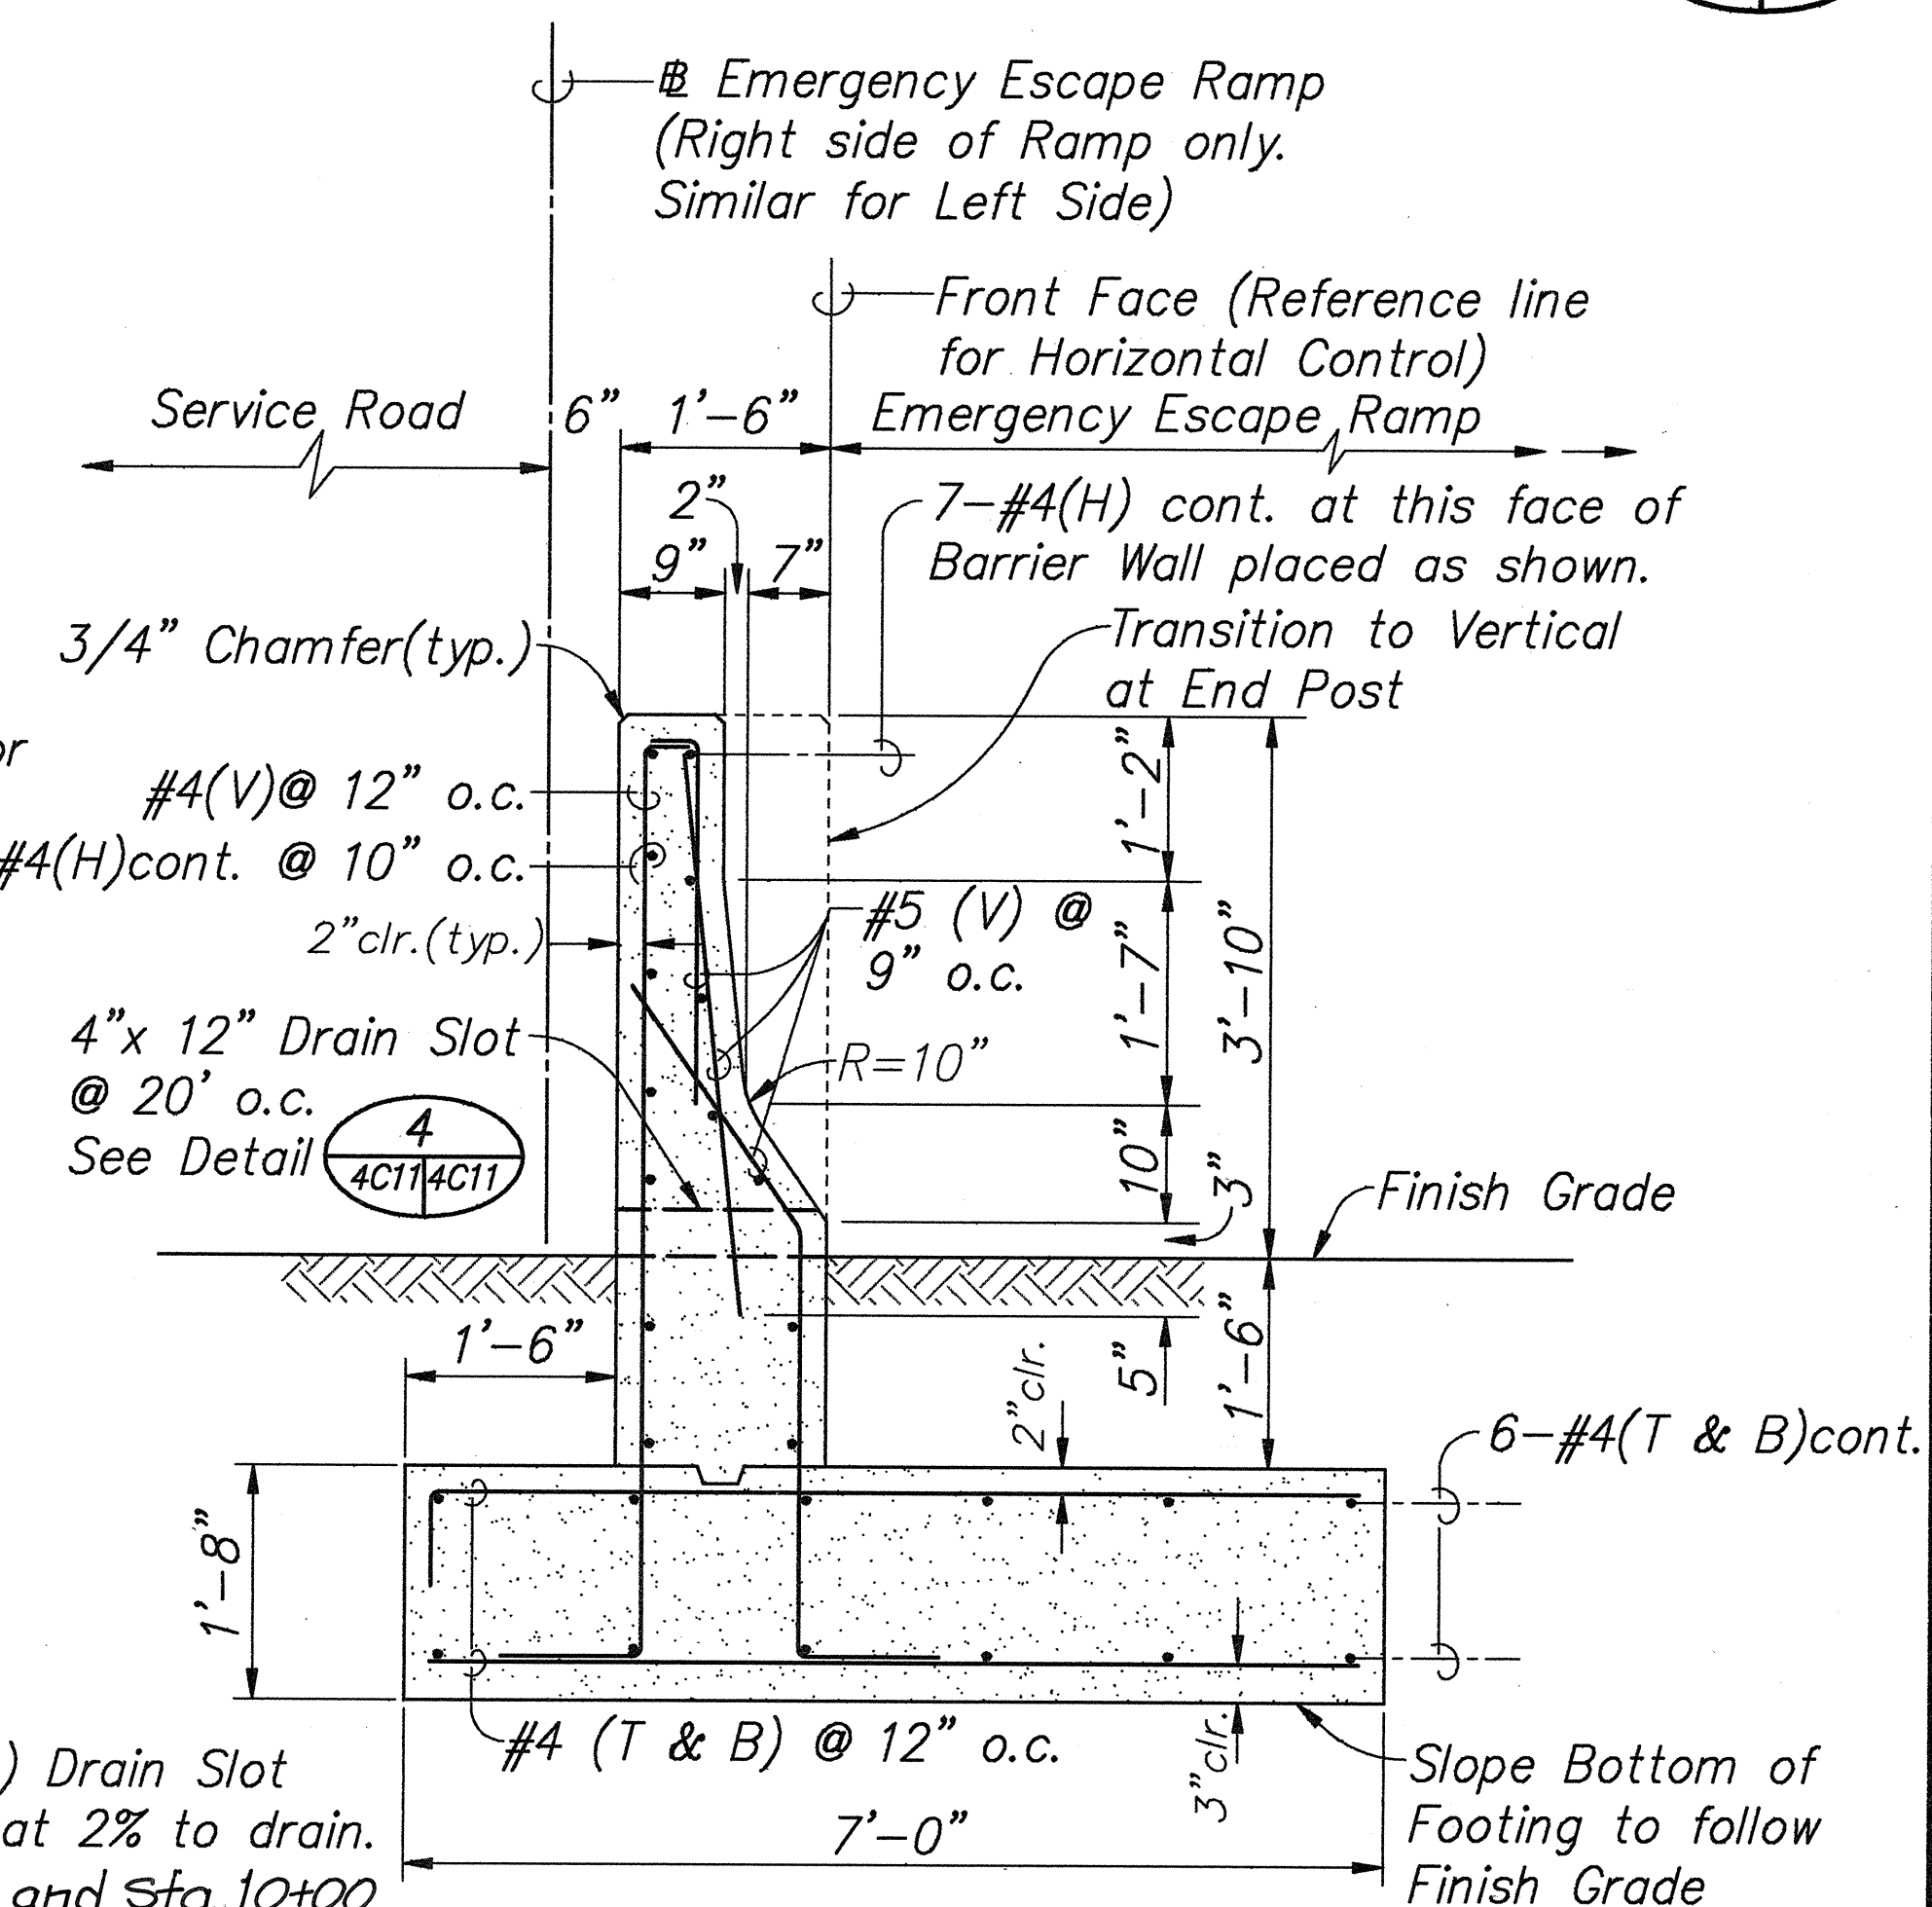

TYPICAL RAMP BARRIER
AND TRANSITION SECTION 
Scale: 3/4" = 1'-0" 4C7, 4C9, 4C11, 4C11

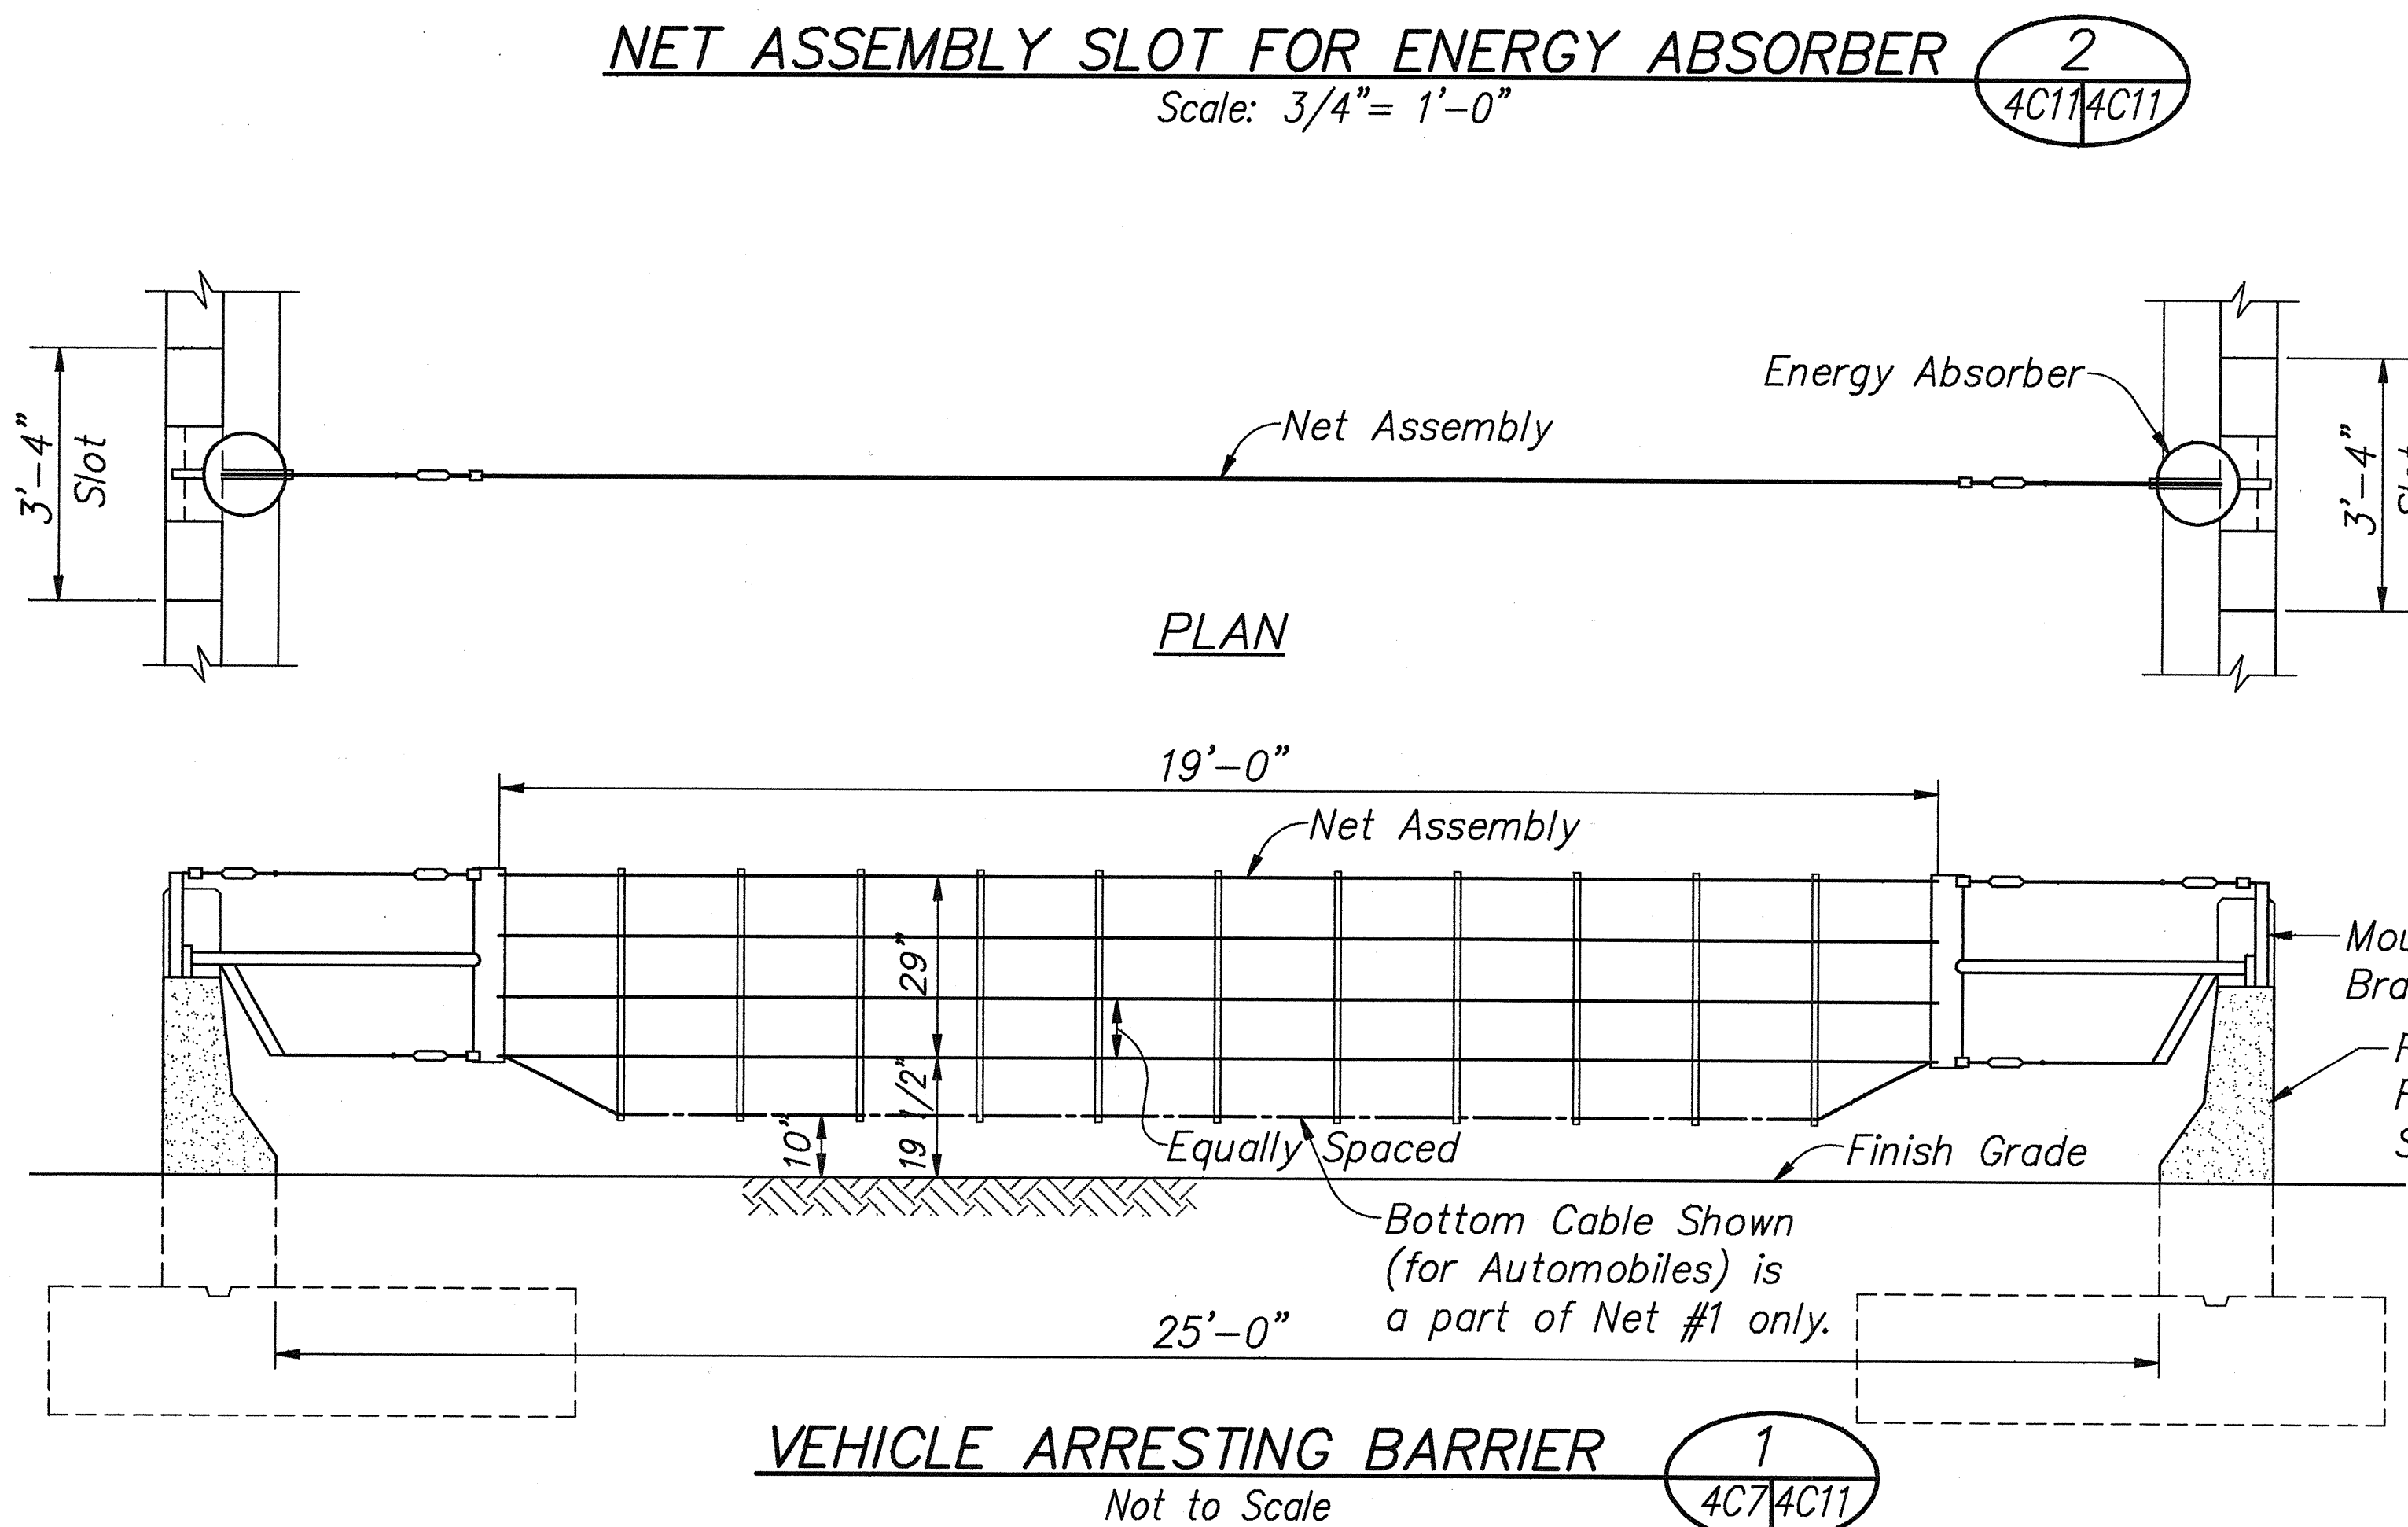

VEHICLE ARRESTING BARRIER 1
Not to Scale 4C74C11

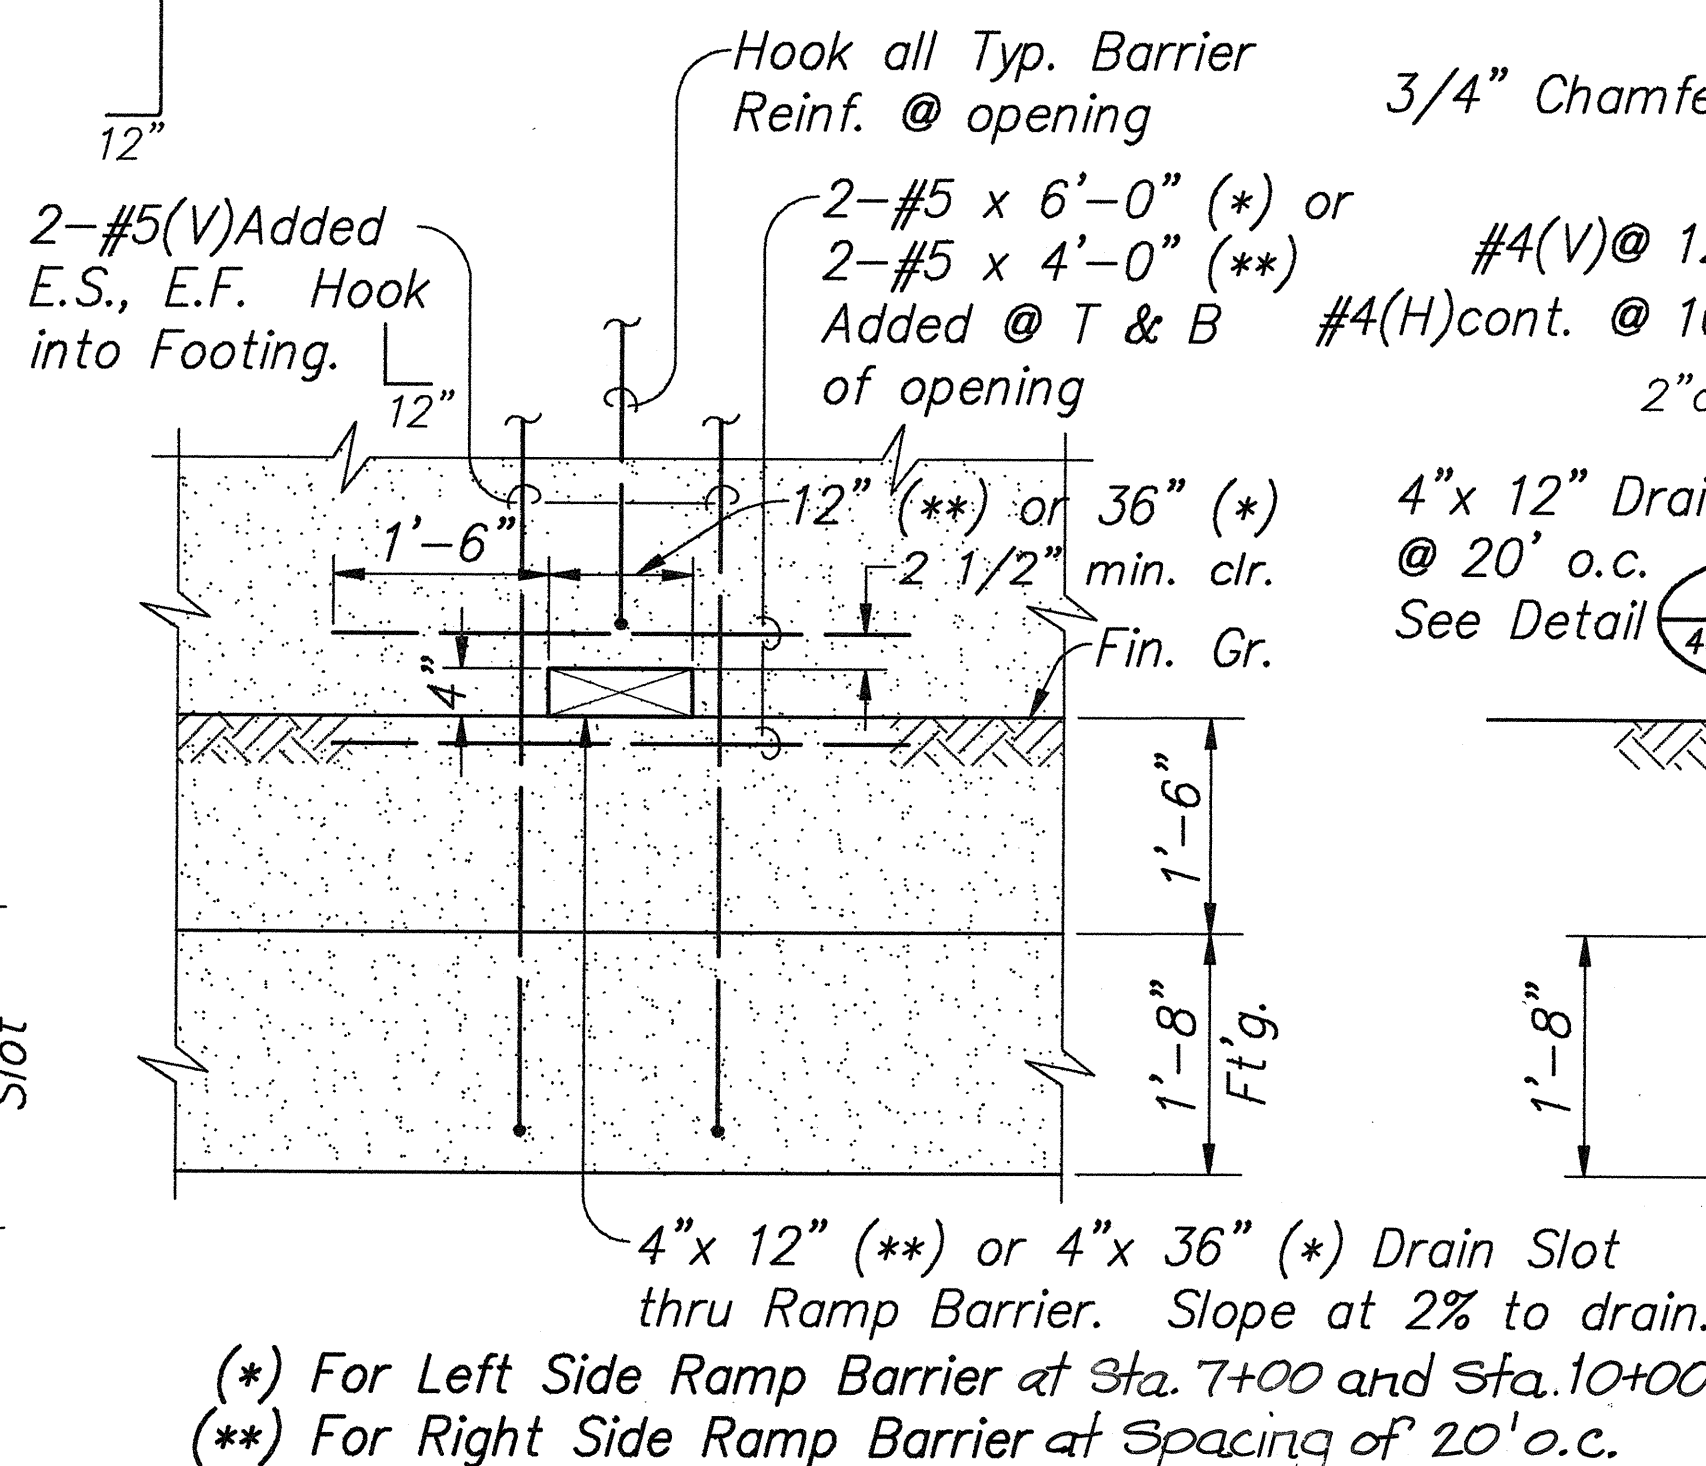

DRAIN SLOT DETAIL 4 *Construction JT.
N.T.S. 4C11, 4C13 4C11 @ Right Side

EXPANSION JTS (LT & RT) JOIN AT STATIONS	CONTRACTION JTS (LT & RT) @ STATION
5+15	4+85 *
6+05	5+45
6+95	5+75
7+85	6+35
8+75	6+65
9+65	7+25
10+55	7+55

EXPANSION AND CONTRACTION JOINT LOCATIONS

3/21/97	REVISE DETAIL 4/4C11/4C11 FOR 4" x 36" DRAIN SLOT THRU RAMP BARRIER.
DATE	REVISION




THIS WORK WAS PREPARED
ME OR UNDER MY SUPERVISI


Ronald H. L...
Park, Inc.
PARK ENGINEERING

STATE OF HAWAII
DEPARTMENT OF TRANSPORTATION
HIGHWAYS DIVISION
NORTH HALAWA VALLEY
ROADWAY CONSTRUCTION
EMERGENCY ESCAPE RAMP DETAILS
H-3 FINISH (UNIT II)
FAIP NO. 1-H3-1(75), UNIT II
LEEWARD SECTION
SCALE: AS NOTED DATE: FEB. 1997
SHEET NO. 4C11 OF 22 SHEETS

FED. ROAD DIST. NO.	STATE	PROJ. NO.	FISCAL YEAR	SHEET NO.	TOTAL SHEETS
HAWAII	HAW.	I-H3-1(75) UNIT II	1997	807	1102

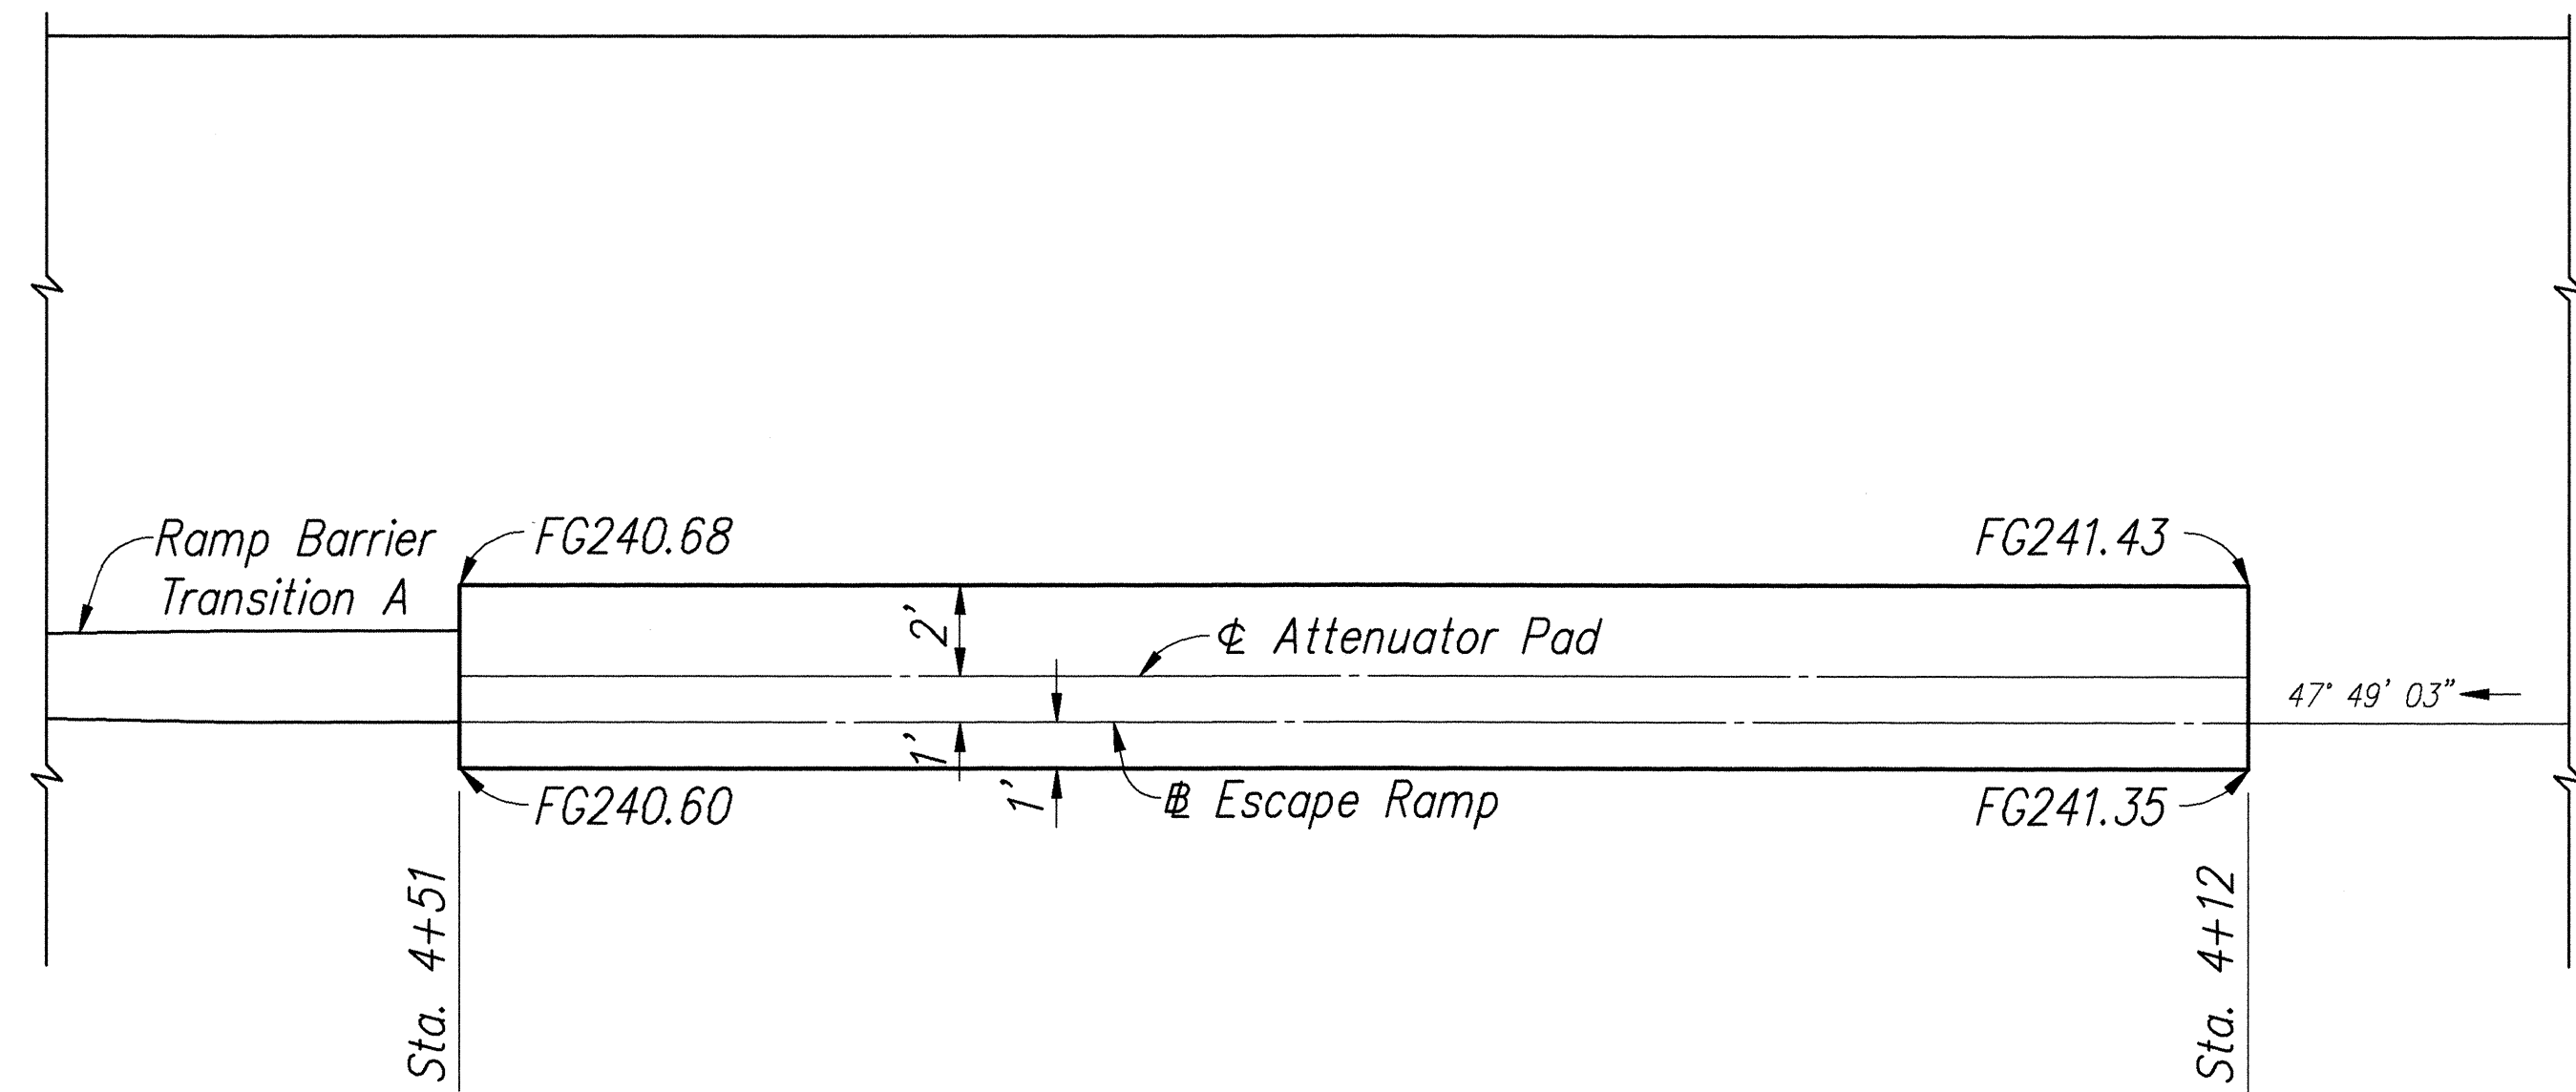


ATTENUATOR PAD GRADING PLAN 2
Scale: 1/4" = 1'-0"

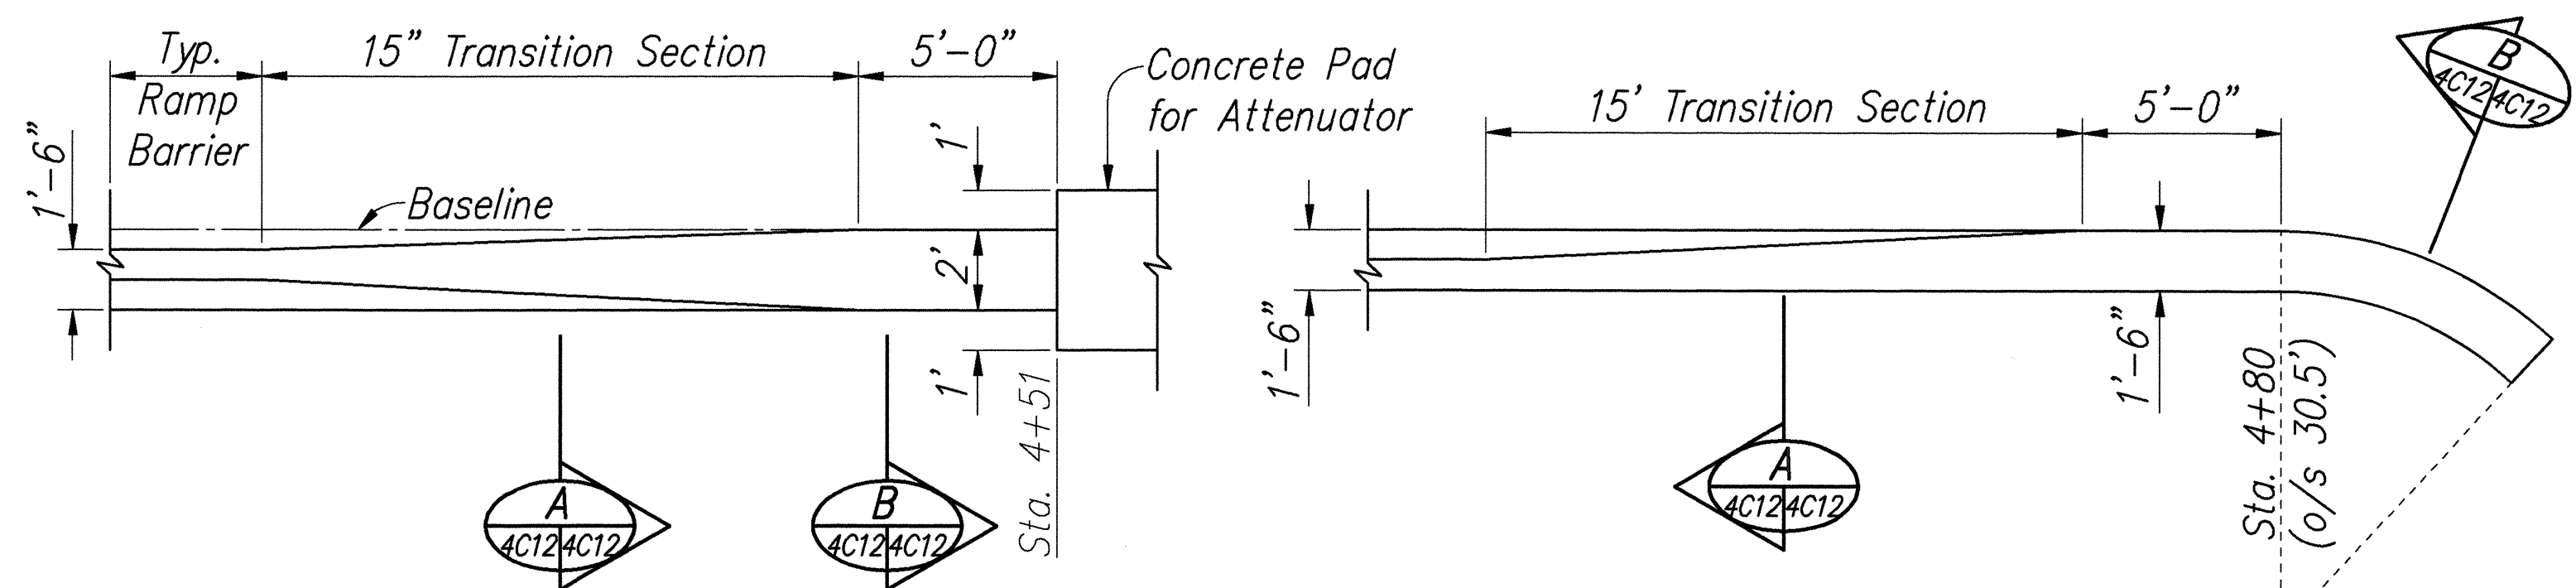


TRANSITION A
Scale: 1/4" = 1'-0"

TRANSITION B
Scale: 1/4" = 1'-0"

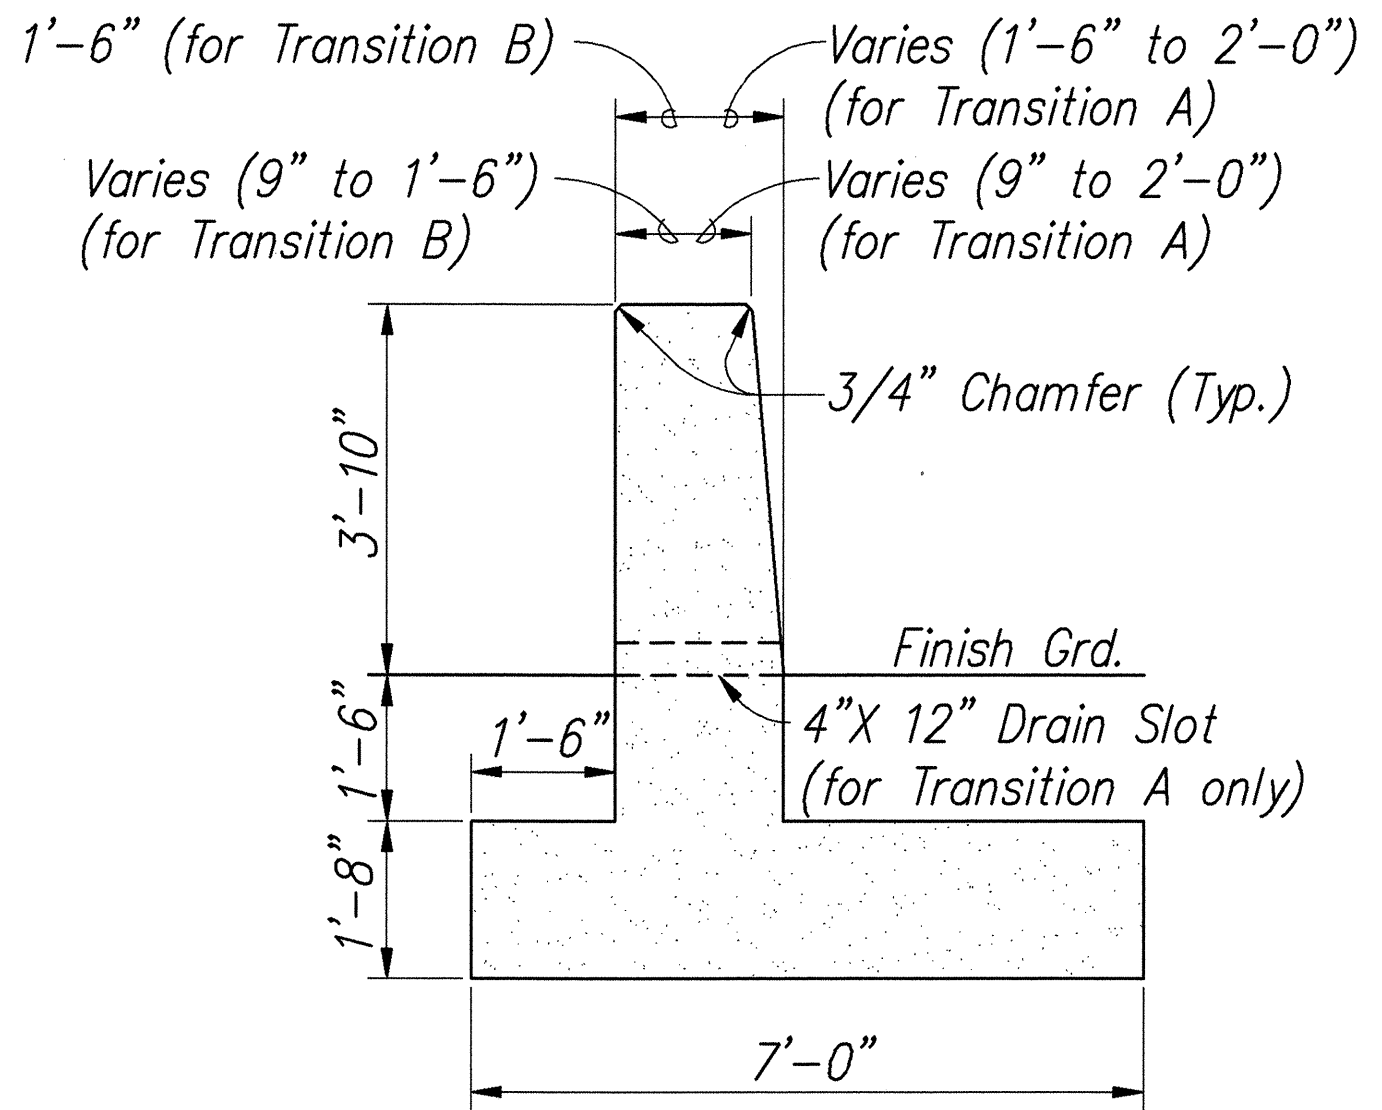


SECTION A A
Scale: 1/2" = 1'-0"

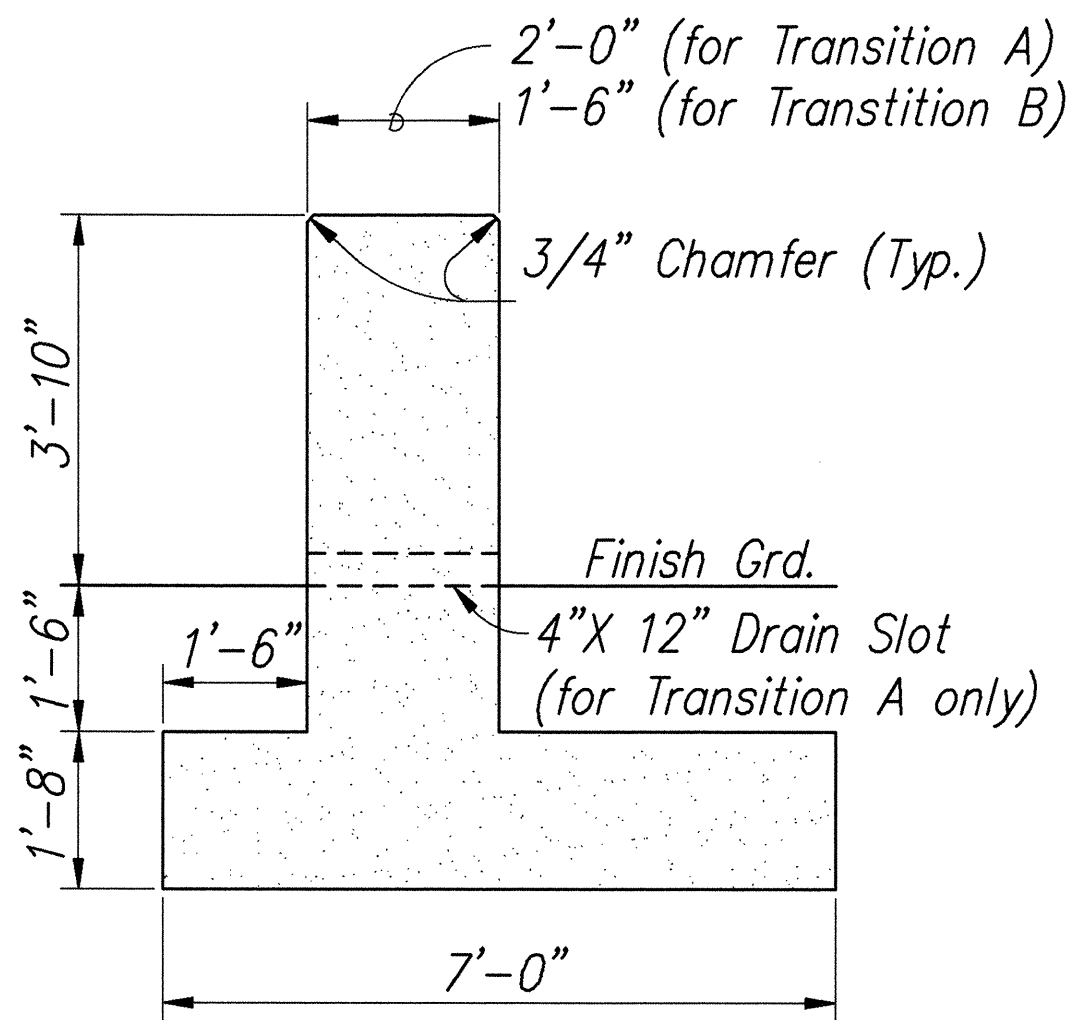


SECTION B B
Scale: 1/2" = 1'-0"


PLAN - RAMP BARRIER TRANSITIONS 1
4C12, 4C13 | 4C12

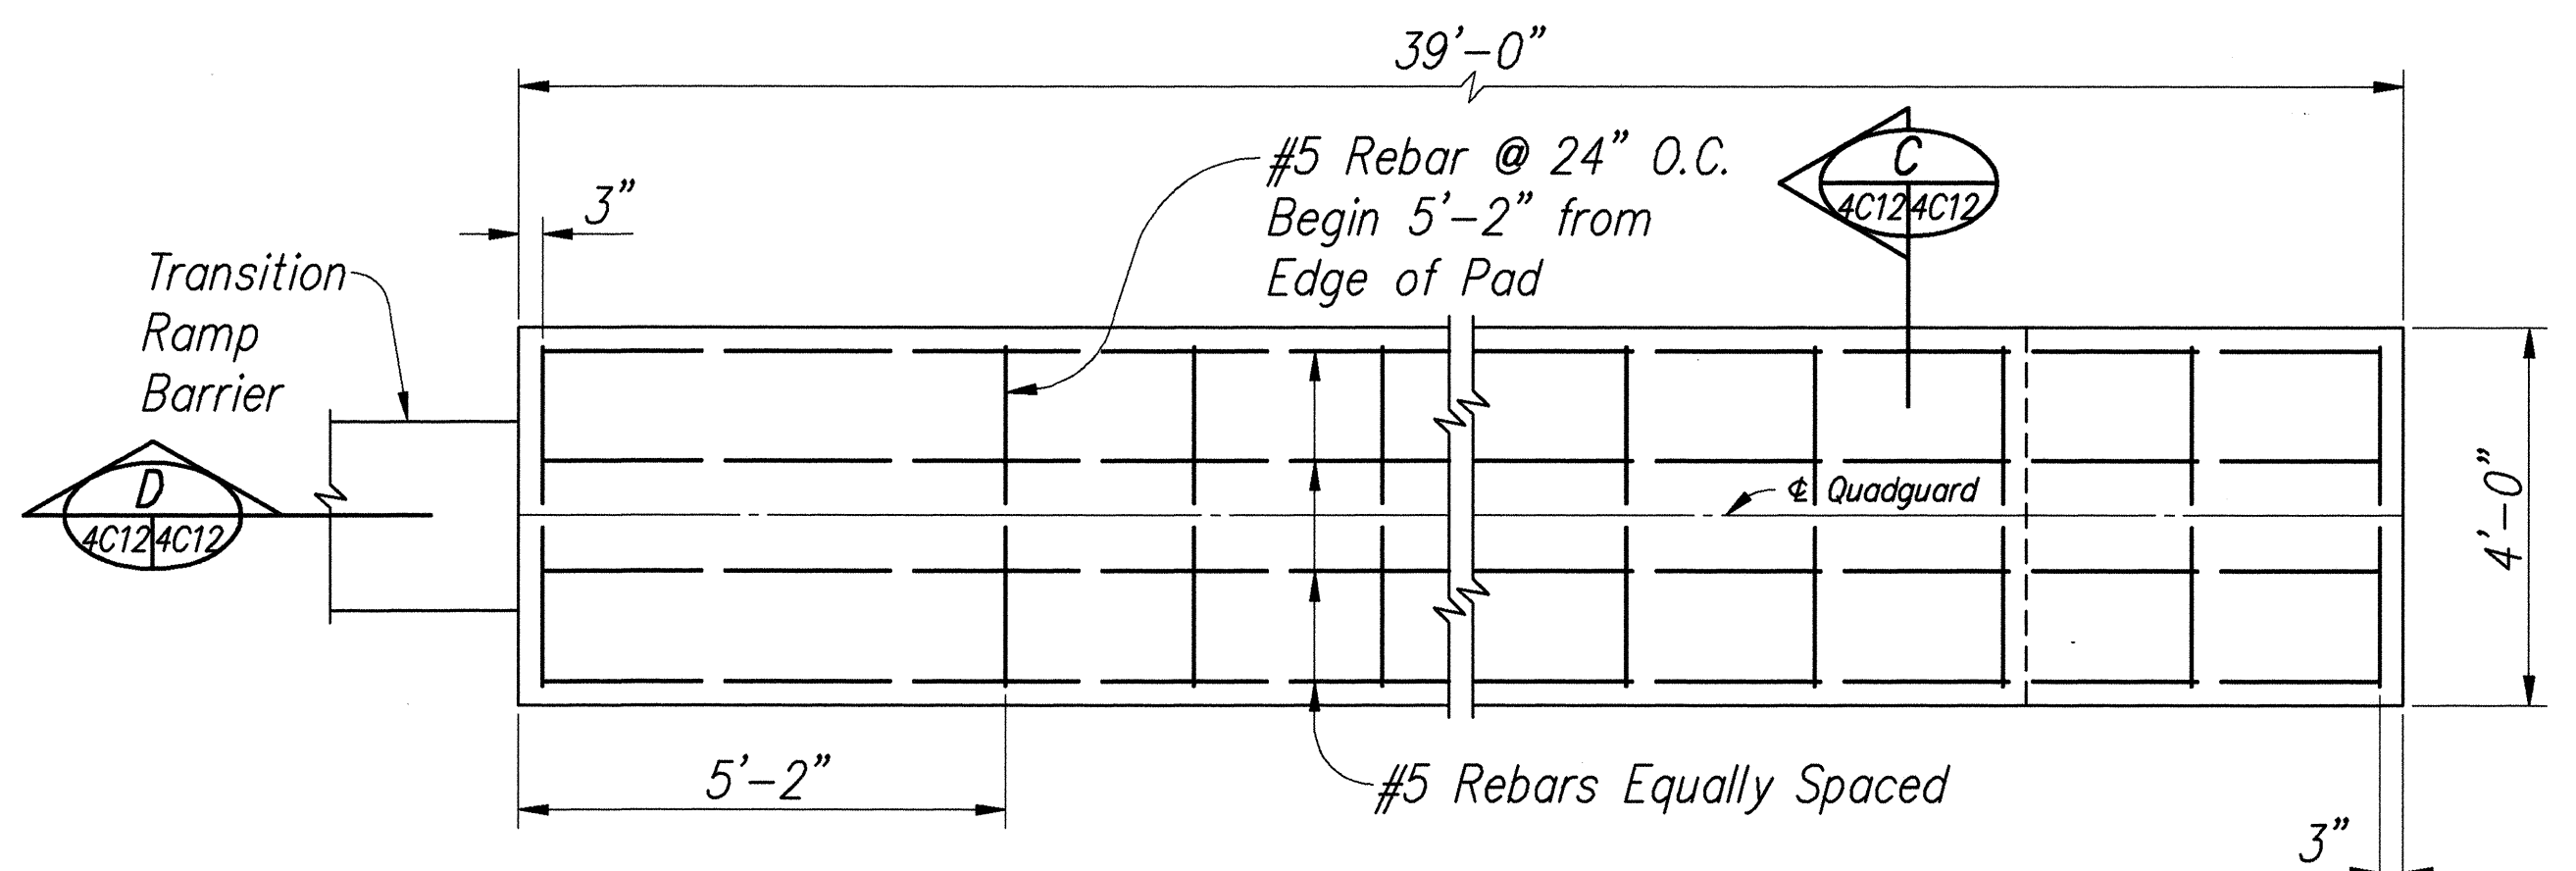

PLAN Place #5 Rebar at 3" from Edge of Pad

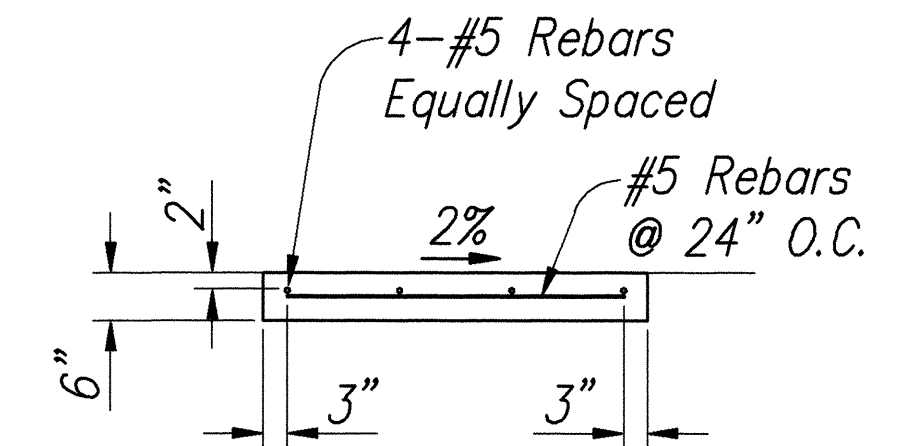


SECTION C C
4C12 | 4C12

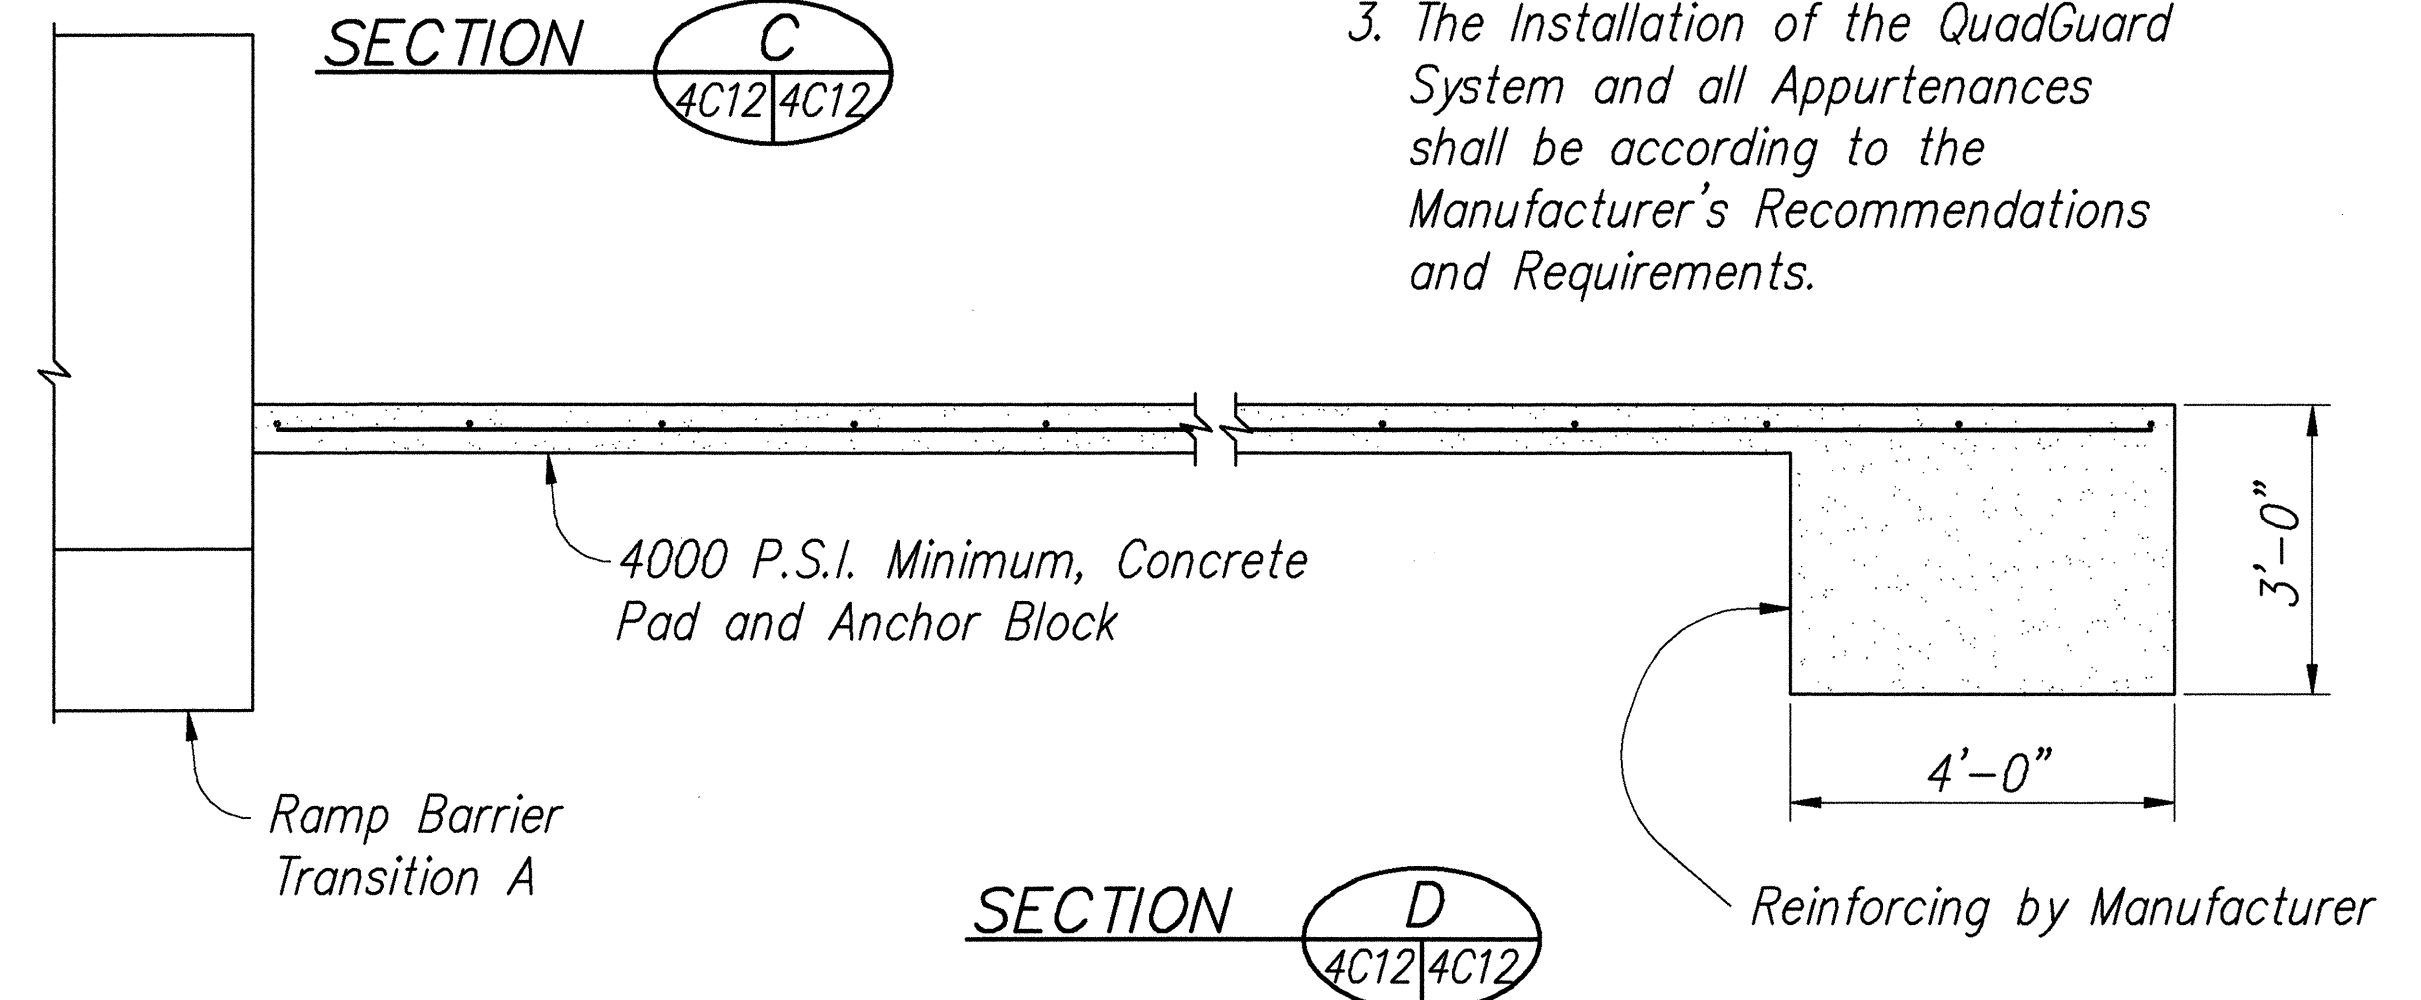

SECTION D D
4C12 | 4C12

CONCRETE PAD FOR ATTENUATOR DETAIL 3
Scale: 1/2" = 1'-0"

- Notes:**
1. Attenuator shall be the QuadGuard System or Accepted Equivalent.
 2. Additional Design & Details Required for the Installation of the QuadGuard System shall be Provided by the Manufacturer.
 3. The Installation of the QuadGuard System and all Appurtenances shall be according to the Manufacturer's Recommendations and Requirements.

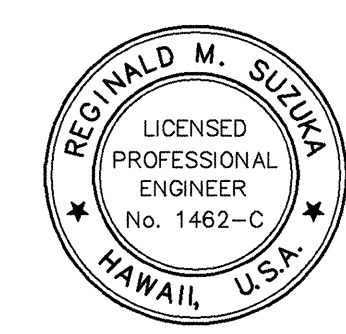


THIS WORK WAS PREPARED BY
ME OR UNDER MY SUPERVISION
Ronald M. Suzuki
PARK, INC.
600 PARK ENGINEERING

STATE OF HAWAII
DEPARTMENT OF TRANSPORTATION
HIGHWAYS DIVISION
NORTH HALAWA VALLEY
ROADWAY CONSTRUCTION
MISCELLANEOUS DETAILS
H-3 FINISH (UNIT II)
FAIP NO. I-H3-1(75), UNIT II
LEEWARD SECTION
SCALE: AS NOTED DATE: FEB. 1997
SHEET No. 4C12 OF 22 SHEETS

SURVEY PLOTTED BY	DATE
DRAWN BY	
DESIGNED BY	
QUANTITIES BY	
CHECKED BY	
ORIGINAL PLAN	
NOTE BOOK	
No.	

FED. ROAD DIST. NO.	STATE	PROJ. NO.	FISCAL YEAR	SHEET NO.	TOTAL SHEETS
HAWAII	HAW.	1-H3-1(75) UNIT II	1997	808	1102

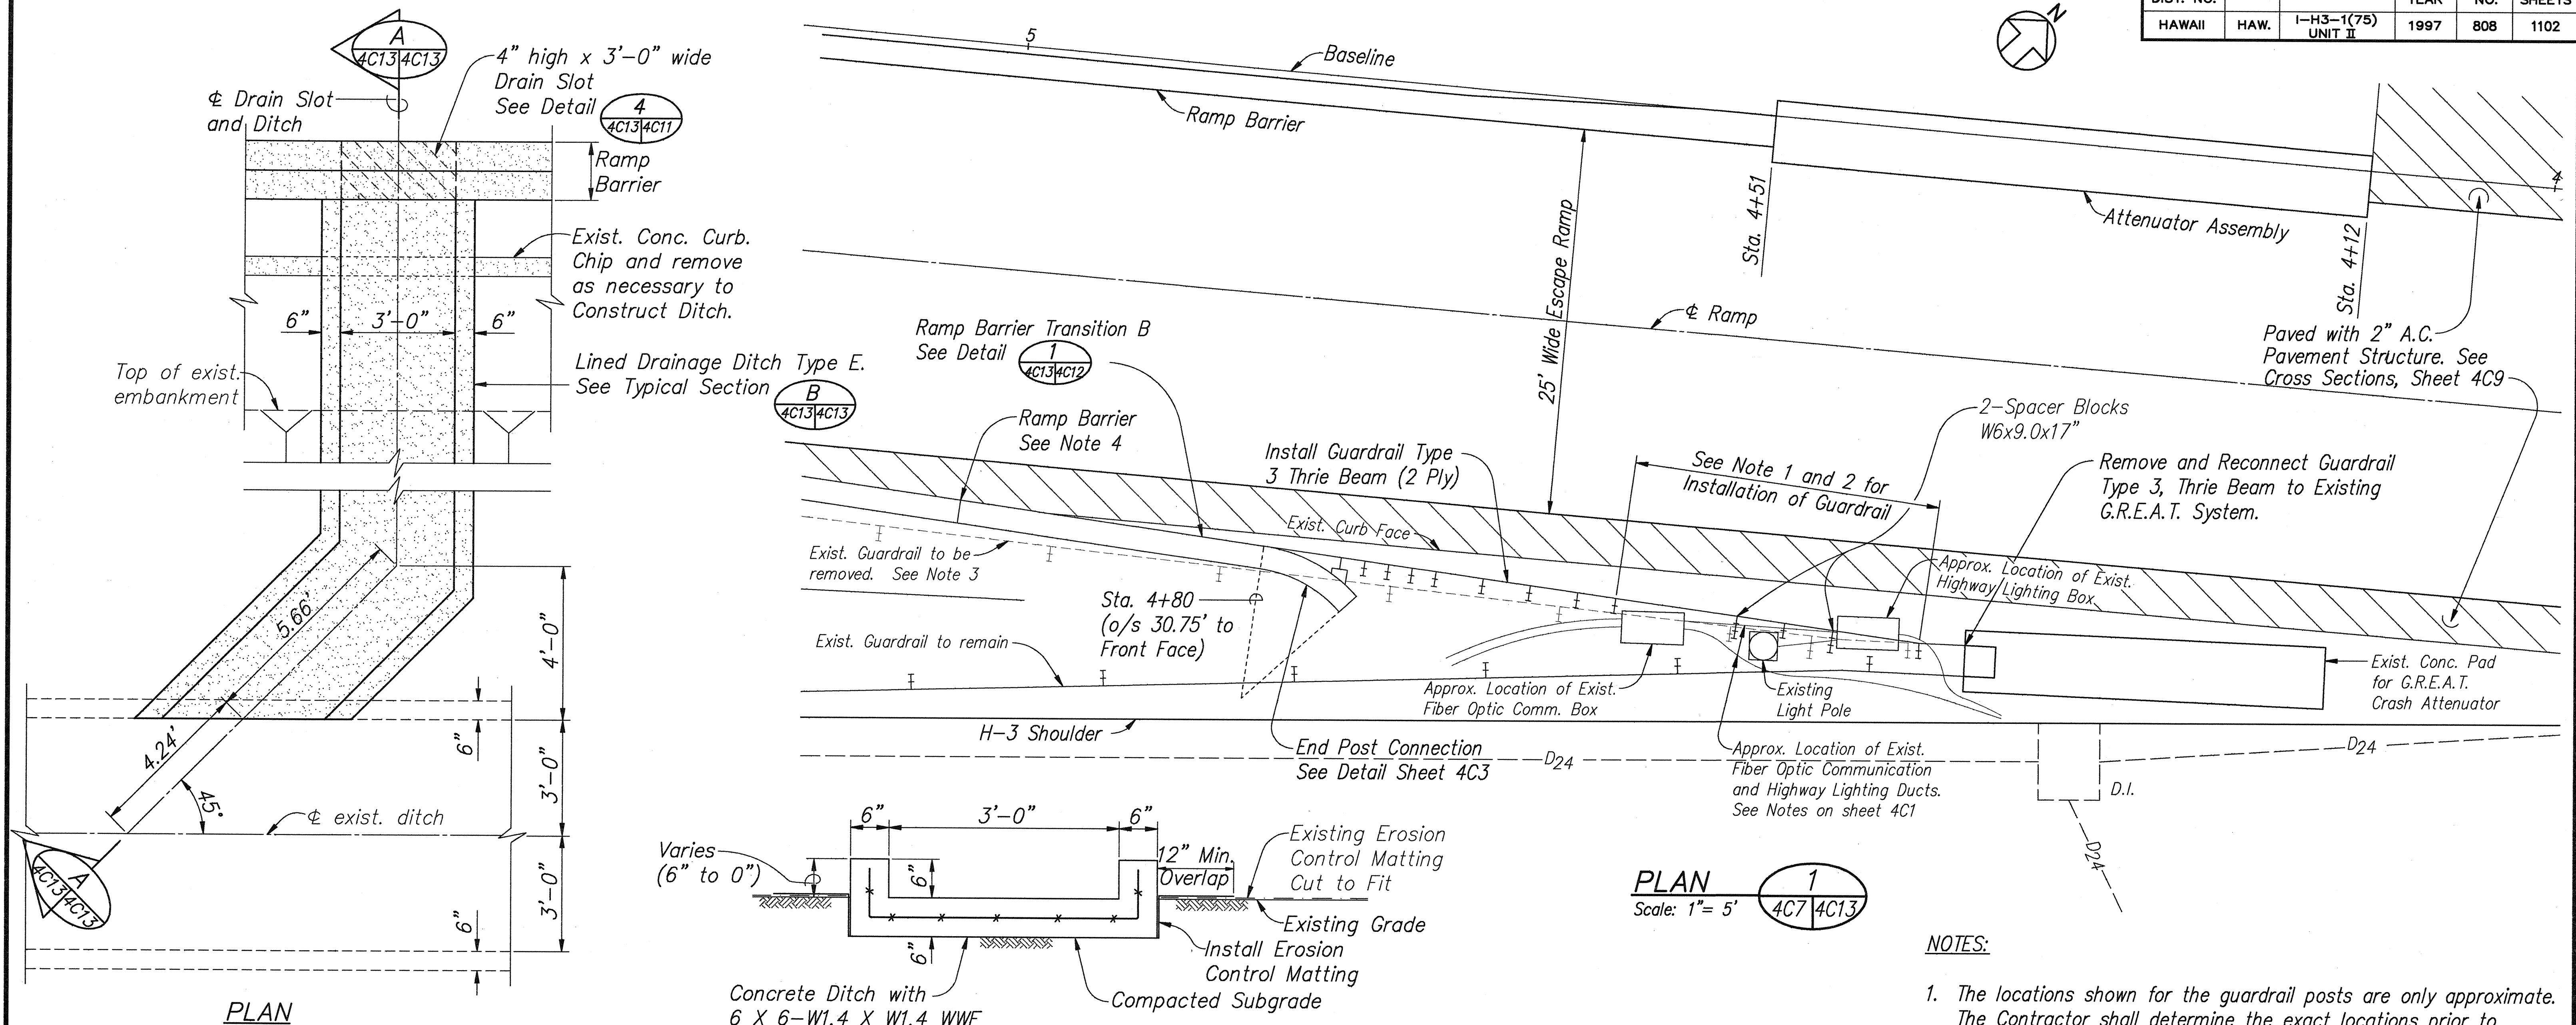


NOTES:

1. The locations shown for the guardrail posts are only approximate. The Contractor shall determine the exact locations prior to installing the posts by probing and locating the existing lighting and communication ducts. The Contractor is advised that he will not be allowed to relocate the existing ducts. He will therefore make field adjustments as deemed necessary and appropriate to fit the field conditions.
2. Provide additional W6x9.0x17" Spacer Blocks where necessary.
3. Repair A.C. Pavement damaged by removal of Guardrail Posts.
4. Repair A.C. Pavement damaged by construction of Ramp Barrier.


PLAN
TYPE E DITCH
Scale: 1/2"= 1'-0"
2 4C7/4C13

TYPICAL SECTION
Scale: 1"= 1'-0"
B 4C13/4C13

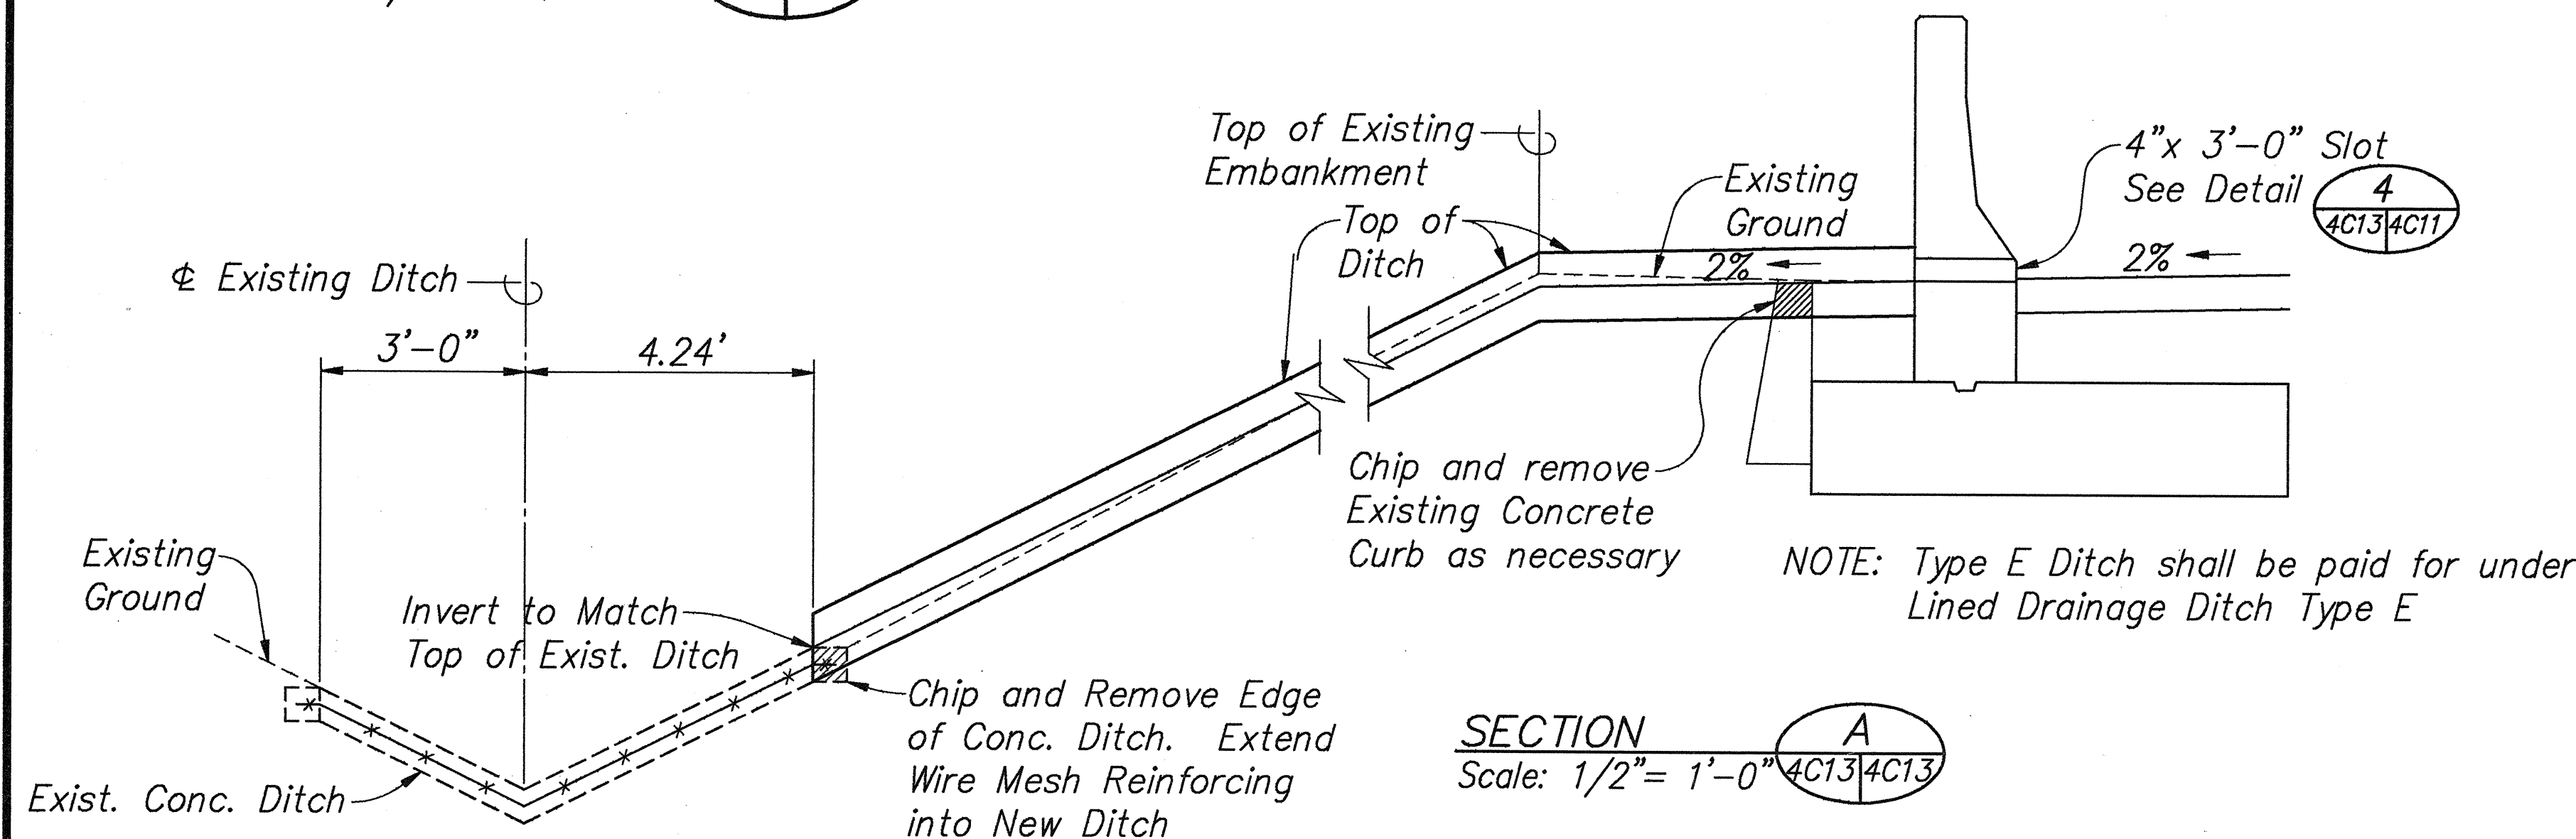

SECTION
Scale: 1/2"= 1'-0"
A 4C13/4C13

3/21/97	ADD LINED DRAINAGE DITCH TYPE E AT STATIONS 7+00 AND 10+00 (LEFT SIDE)
DATE	REVISION

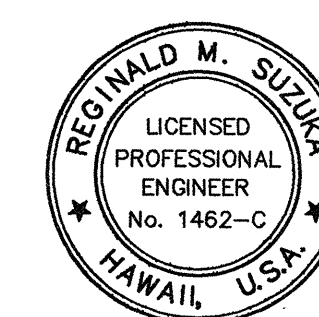

THIS WORK WAS PREPARED BY ME OR UNDER MY SUPERVISION
Reginald M. Suzuki
P.E., INC.
d/b/a PARK ENGINEERING

STATE OF HAWAII
DEPARTMENT OF TRANSPORTATION
HIGHWAYS DIVISION
NORTH HALAWA VALLEY
ROADWAY CONSTRUCTION
MISCELLANEOUS DETAILS
H-3 FINISH (UNIT II)
FAIP NO. 1-H3-1(75), UNIT II
LEEWARD SECTION
SCALE: AS NOTED
DATE: FEB. 1997
SHEET No. 4C13 OF 22 SHEETS

FED. ROAD DIST. NO.	STATE	FED. AID PROJ. NO.	FISCAL YEAR	SHEET NO.	TOTAL SHEETS
HAWAII	HAW.	I-H3-1(75), UNIT II	1997	809	1102



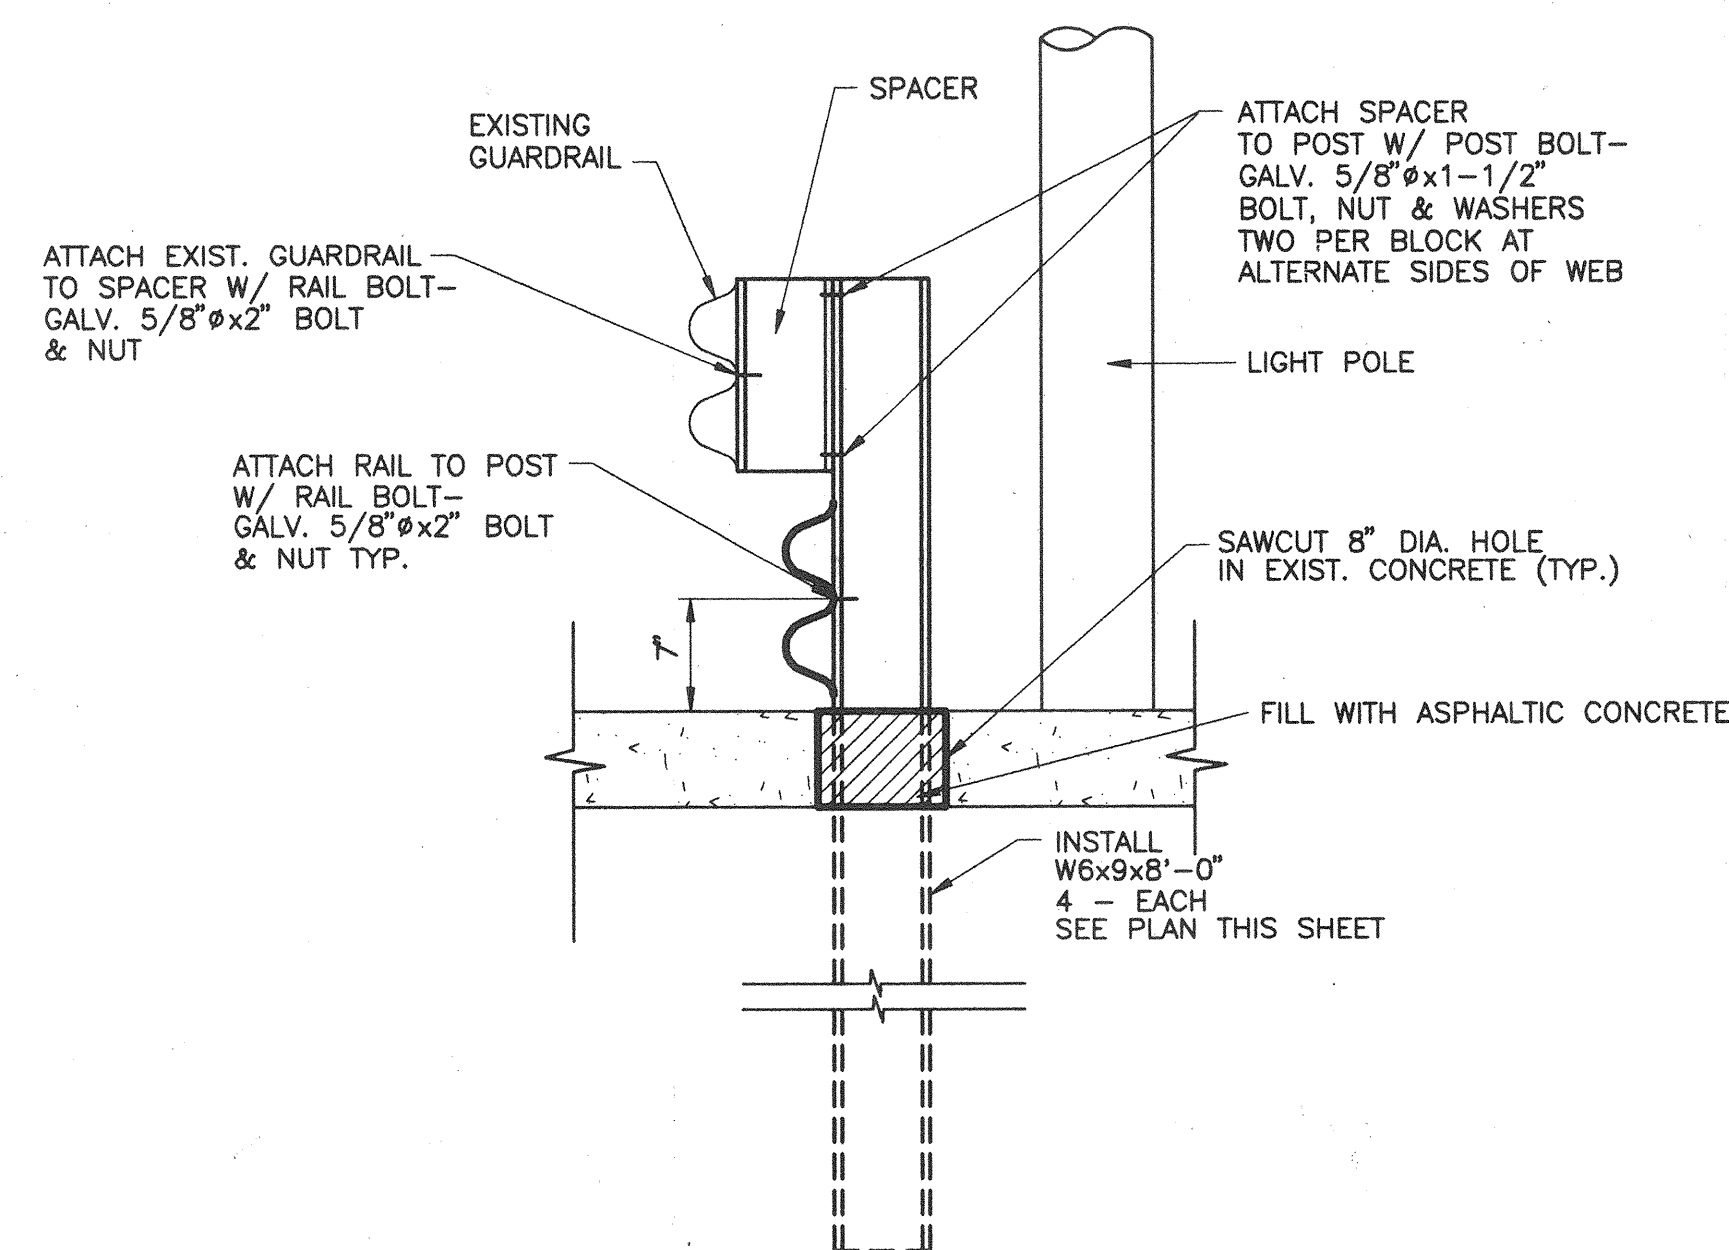



TABLE 1

LIGHT POLE NUMBER	STATION	SIDE (LOOKING UPSTATION)
86	480+45	LEFT
110	512+15	LEFT
123	529+84	RIGHT
125	532+15	RIGHT
127	534+65	RIGHT

TYPICAL SECTION AT
W6x9x8'-0" POST WITH RUBRAIL

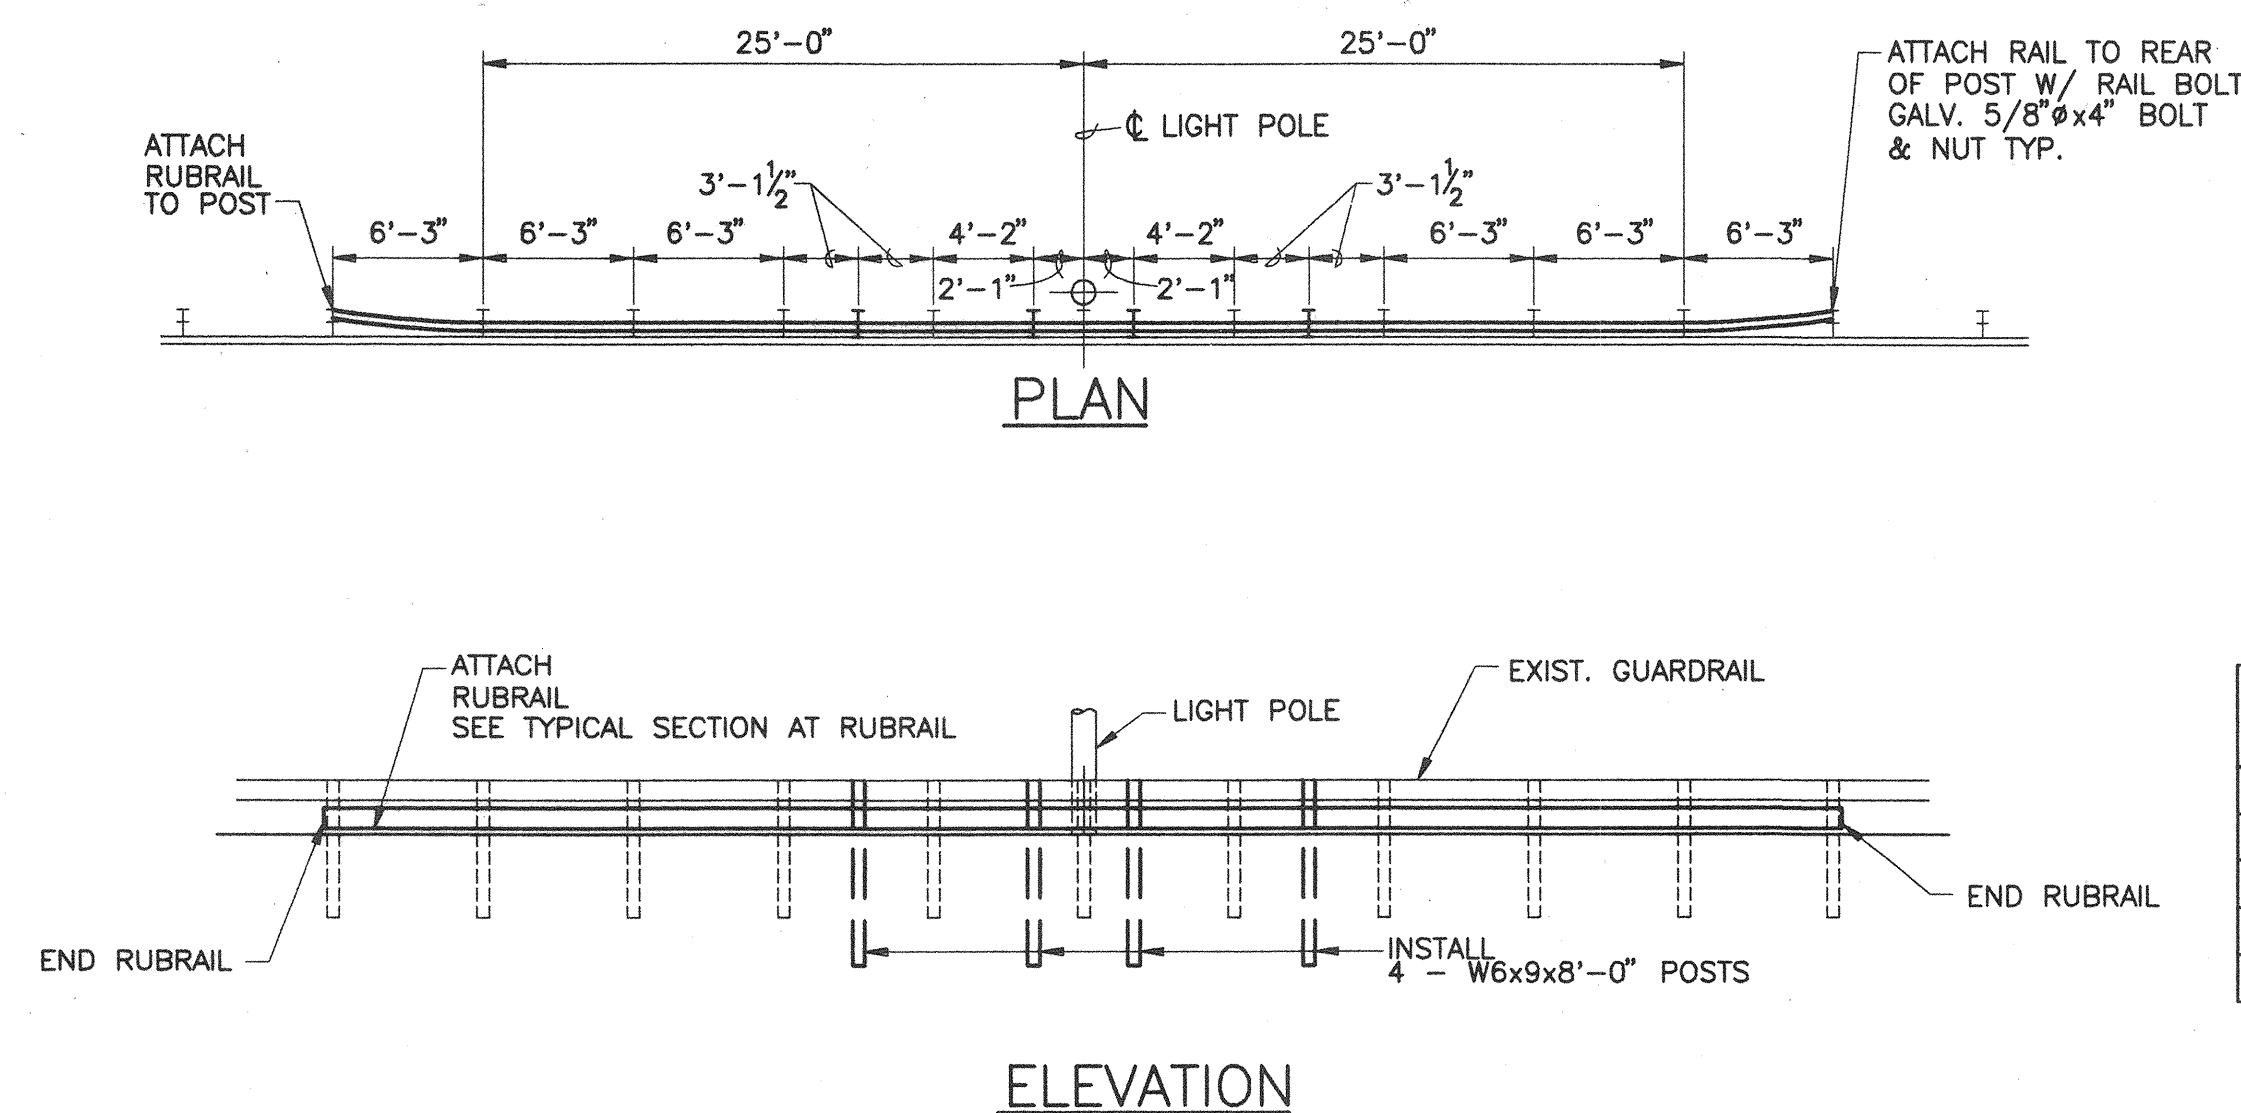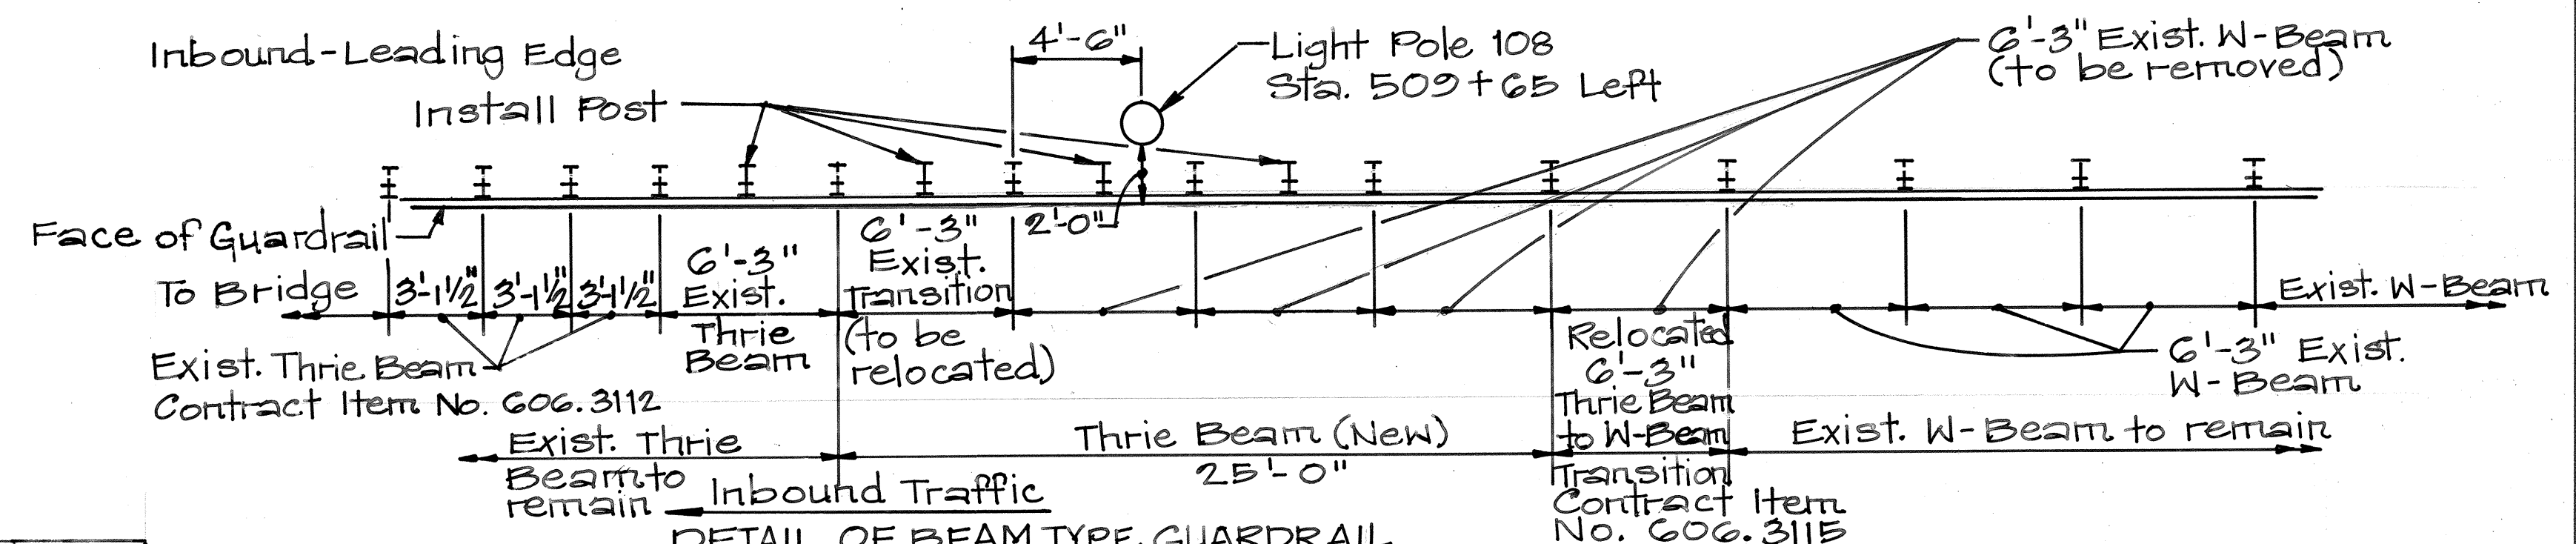

DETAIL OF BEAM TYPE GUARDRAIL
AT LIGHT POLE 108 R

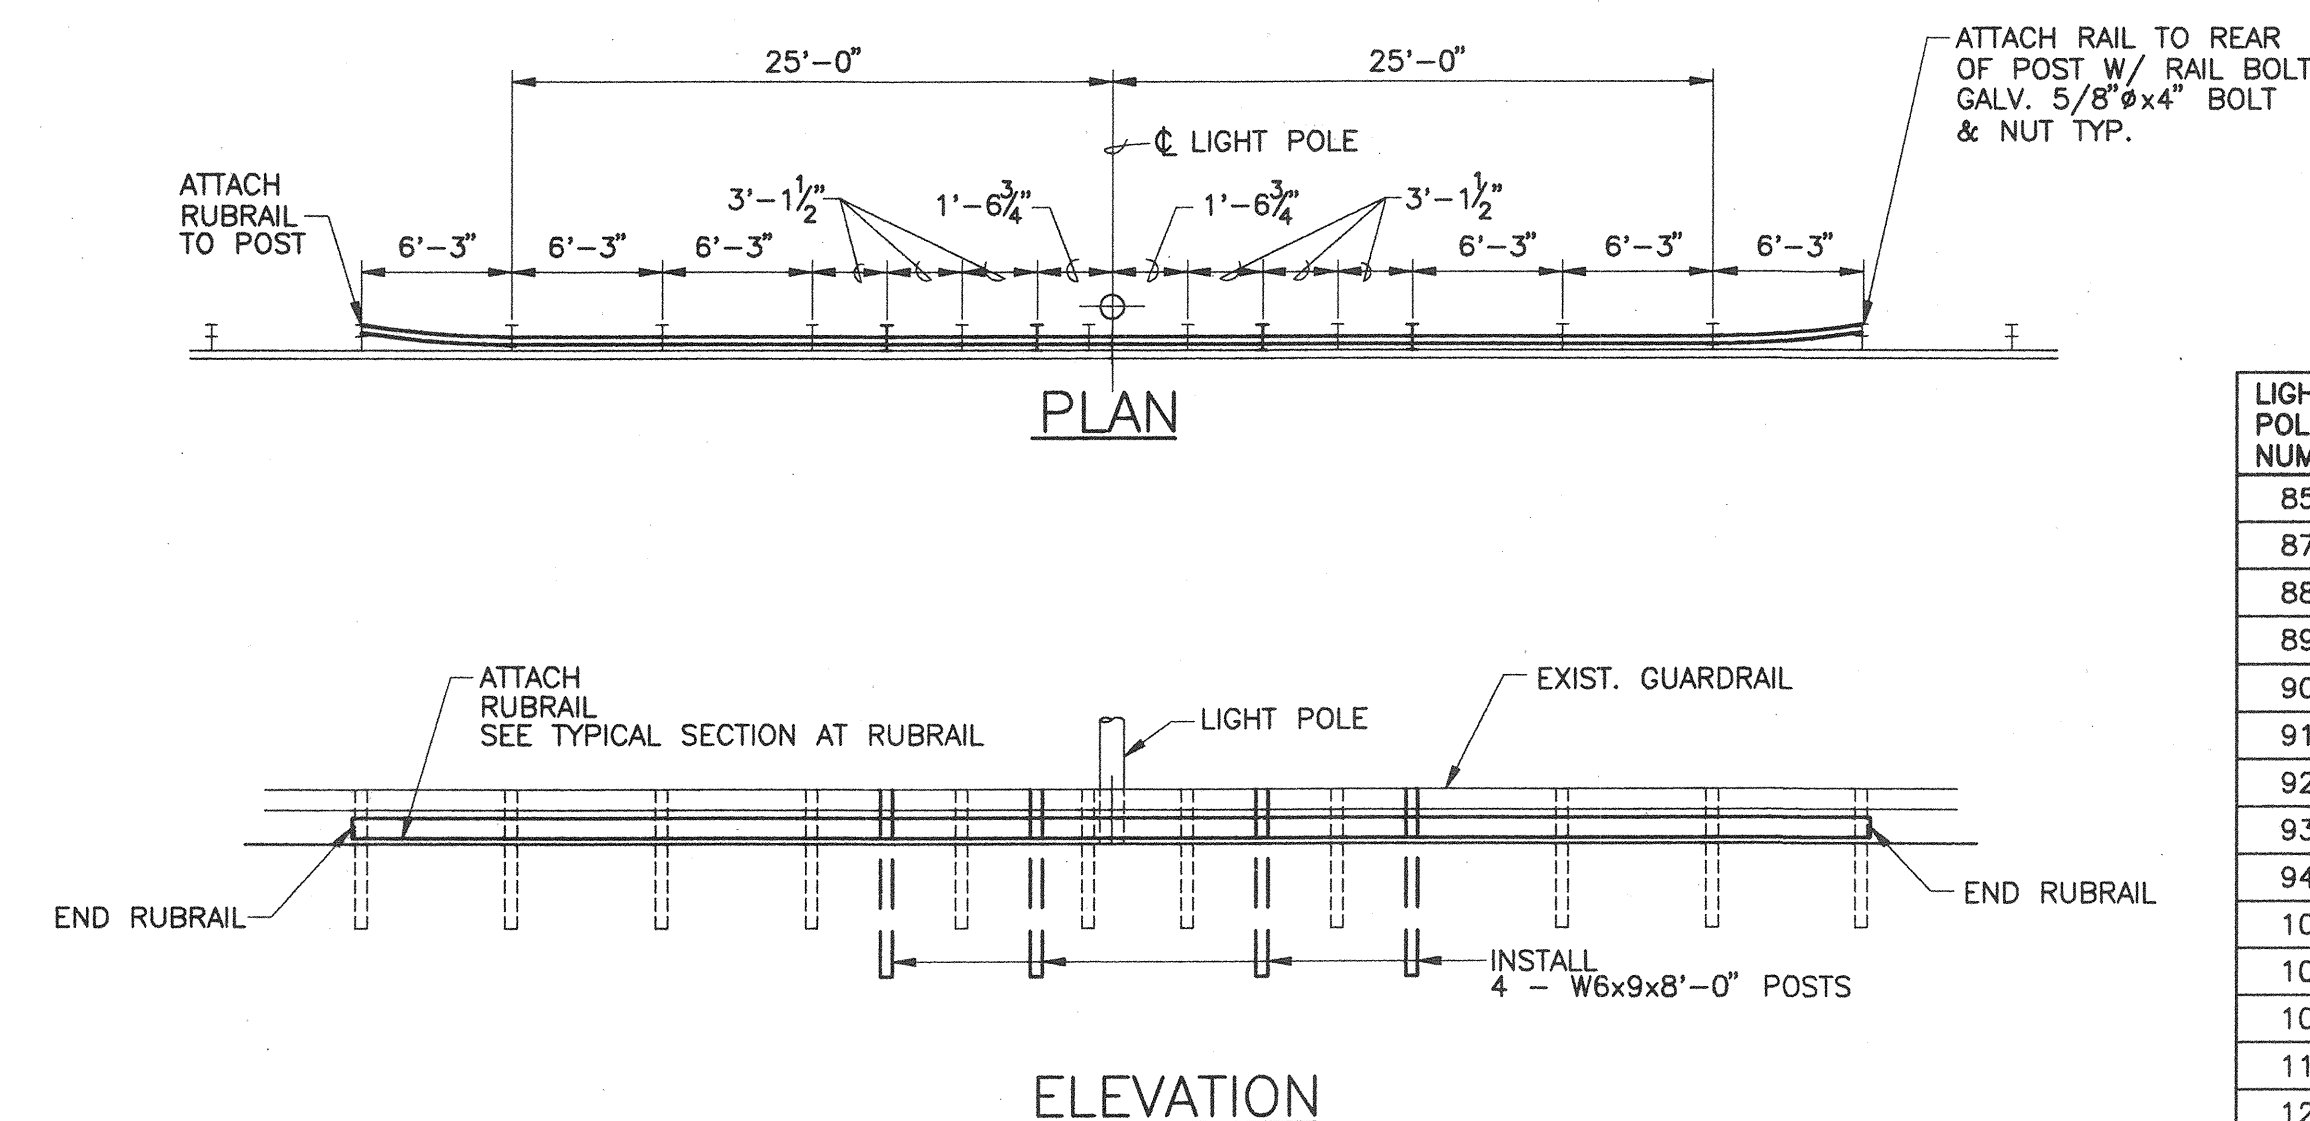


DETAIL OF BEAM TYPE GUARDRAIL W/ RUBRAIL
SCALE: 1/8" = 1'-0" (SEE TABLE 2)

TABLE 2

LIGHT POLE NUMBER	STATION	SIDE (LOOKING UPSTATION)	DELETE RULERAIL (FT.)
85	480+45	RIGHT	
87	483+10	RIGHT	
88	483+10	LEFT	
89	485+75	RIGHT	
90	485+75	LEFT	
91	488+35	RIGHT	-02.5ft
92	488+35	LEFT	
93	490+95	RIGHT	-02.5ft.
94	490+95	LEFT	
107	509+65	RIGHT	-02.5ft
108	509+65	LEFT	-02.5ft
109	512+15	RIGHT	-02.5ft.
119	524+89	RIGHT	-02.5ft.
121	527+38	RIGHT	
122	527+45	LEFT	
124	529+95	LEFT	
126	532+15	LEFT	
128	534+75	LEFT	

Outbound - Trailing Edge
Exist Thrie Beans


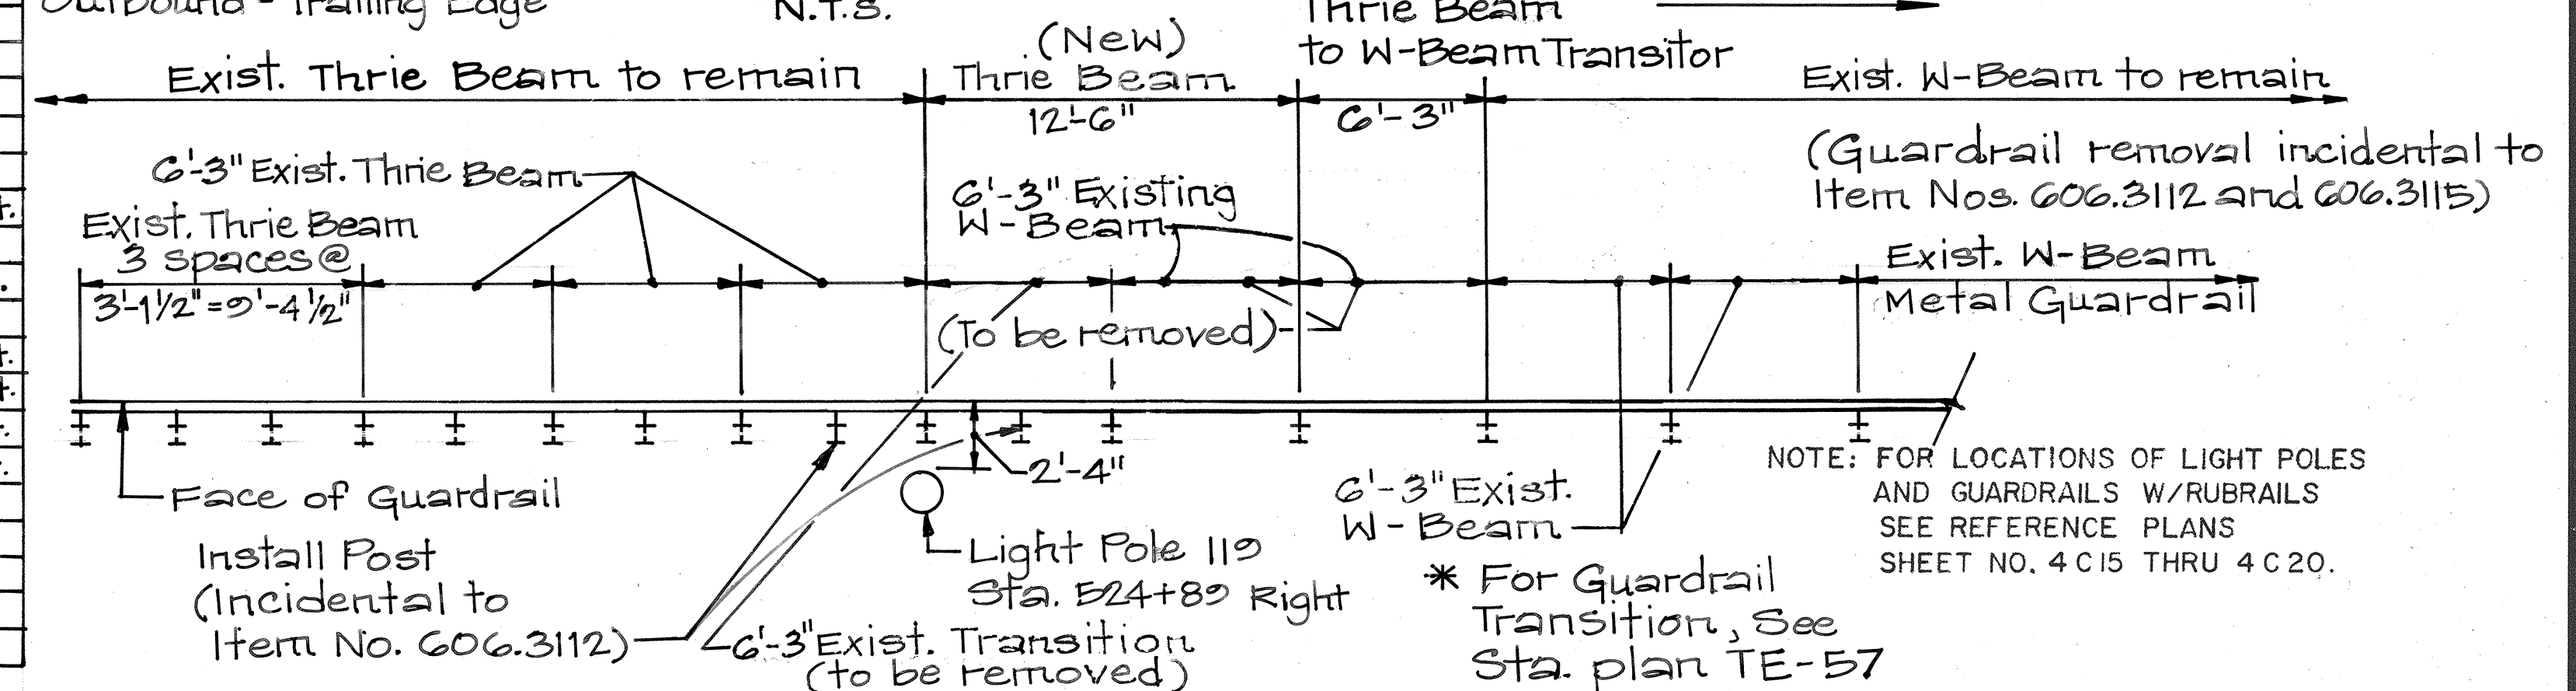


DETAIL OF BEAMTYPE GUARDRAIL
AT LIGHT POLE 119
N.T.S.

TABLE 3
ADDITION OF RUBRAILS TO EXIST. GUARDRAILS

STATION	SIDE (LOOKING UPSTATION)	ADD. RUBRAILS (FT.)
536+87 ±	RIGHT	+62.5 ft.
587+12 ±	RIGHT	+62.5 ft.

GRAPHIC SCALES:

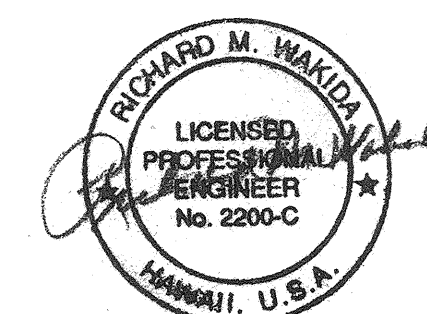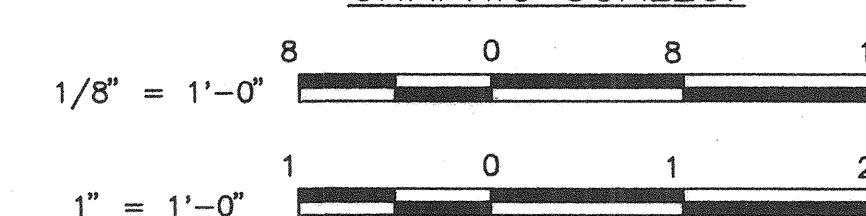

STATE OF HAWAII
DEPARTMENT OF TRANSPORTATION
HIGHWAYS DIVISION
NORTH HALAWA VALLEY HIGHWAY, UNIT II
RUBRAIL DETAILS


H-3 FINISH (UNIT II)
FAIP NO. 1-H3-1(75), UNIT II
LEEWARD SECTION

SCALE: AS SHOWN **DATE:** JAN. 1997



SHEET No.4C14 OF 22 SHEETS

FED. ROAD DIST. NO.	STATE	FED. AID PROJ. NO.	FISCAL YEAR	SHEET NO.	TOTAL SHEETS
HAWAII	HAW.	I-H3-1(75), UNIT II	1997	811	1102

DATE	_____
SURVEY PLOTTED BY	_____
DRAWN BY	_____
DESIGNED BY	_____
CHECKED BY	_____
NO.	_____

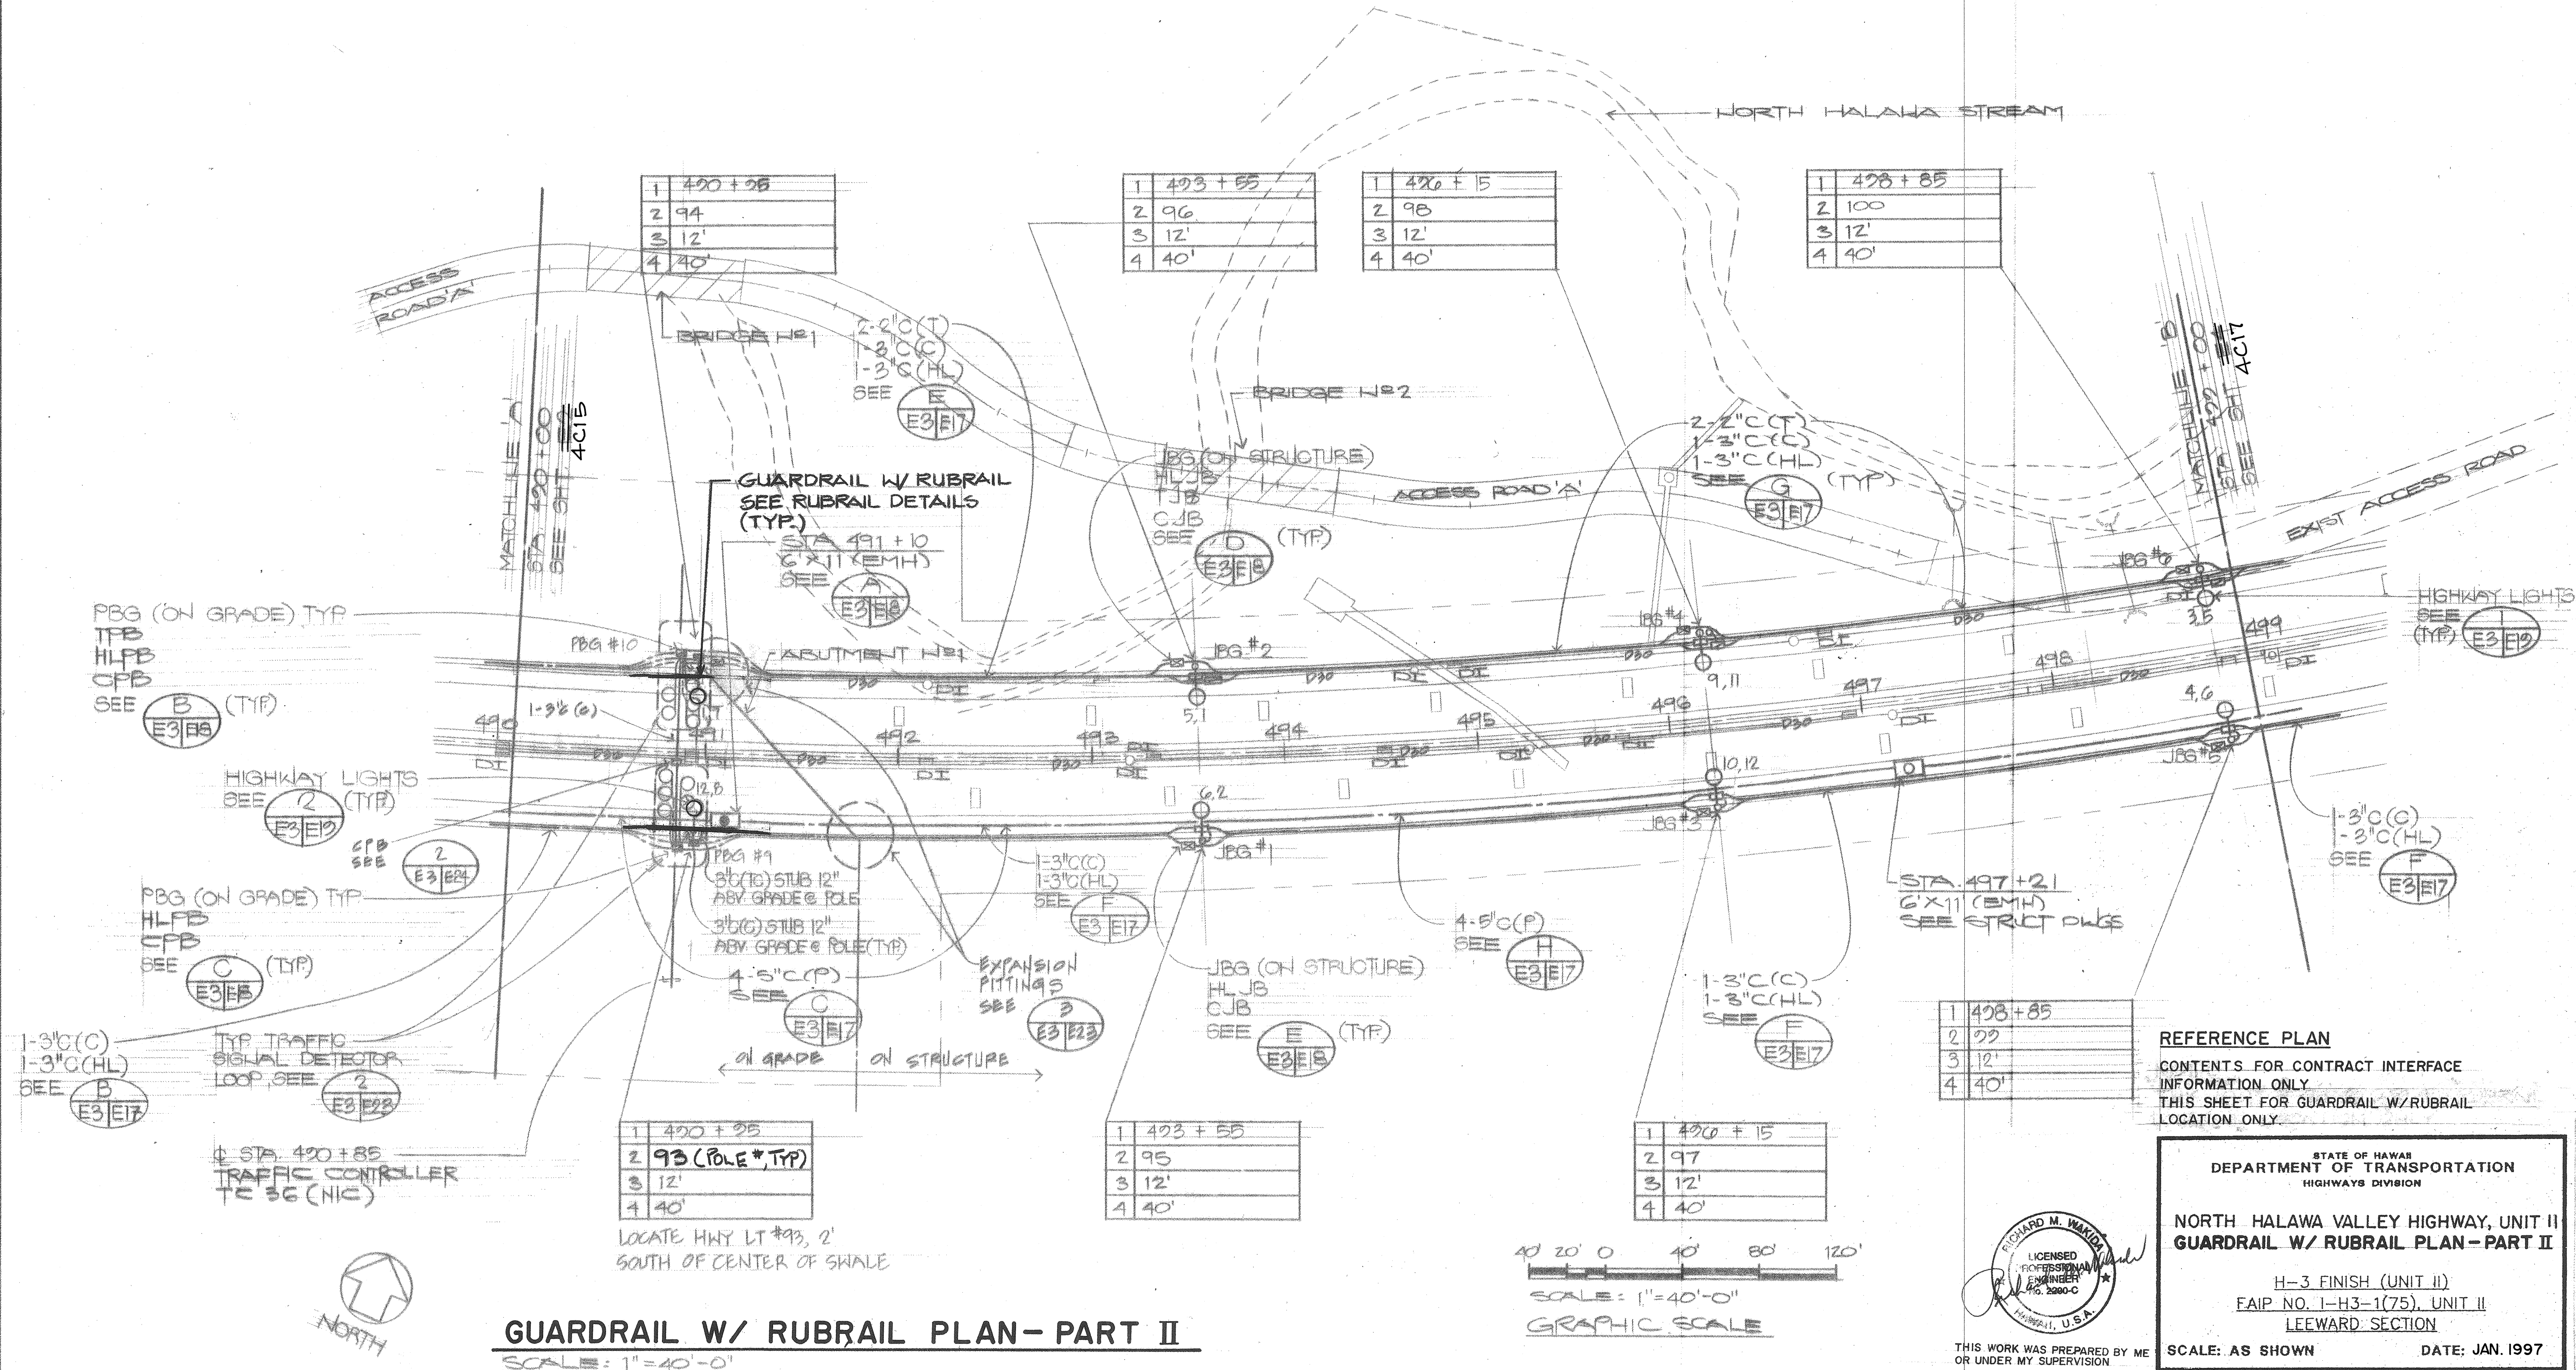

GUARDRAIL W/ RUBRAIL PLAN - PART II
 SCALE: 1"=40'-0"

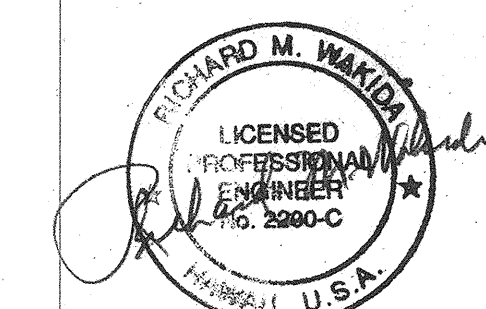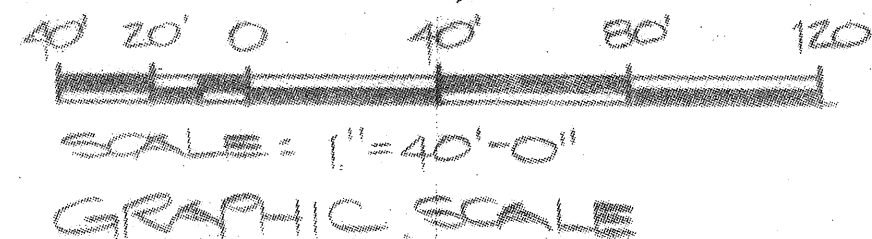

THIS WORK WAS PREPARED BY ME
 OR UNDER MY SUPERVISION

REFERENCE PLAN
 CONTENTS FOR CONTRACT INTERFACE
 INFORMATION ONLY
 THIS SHEET FOR GUARDRAIL W/ RUBRAIL
 LOCATION ONLY


STATE OF HAWAII
DEPARTMENT OF TRANSPORTATION
HIGHWAYS DIVISION

NORTH HALAWA VALLEY HIGHWAY, UNIT II
GUARDRAIL W/ RUBRAIL PLAN - PART II


H-3 FINISH (UNIT II)
FAIP NO. I-H3-1(75), UNIT II
LEEWARD SECTION

SCALE: AS SHOWN
DATE: JAN. 1997

FED. ROAD DIST. NO.	STATE	FED. AID PROJ. NO.	FISCAL YEAR	SHEET NO.	TOTAL SHEETS
HAWAII	HAW.	I-H3-1(75), UNIT II	1997	812	1102


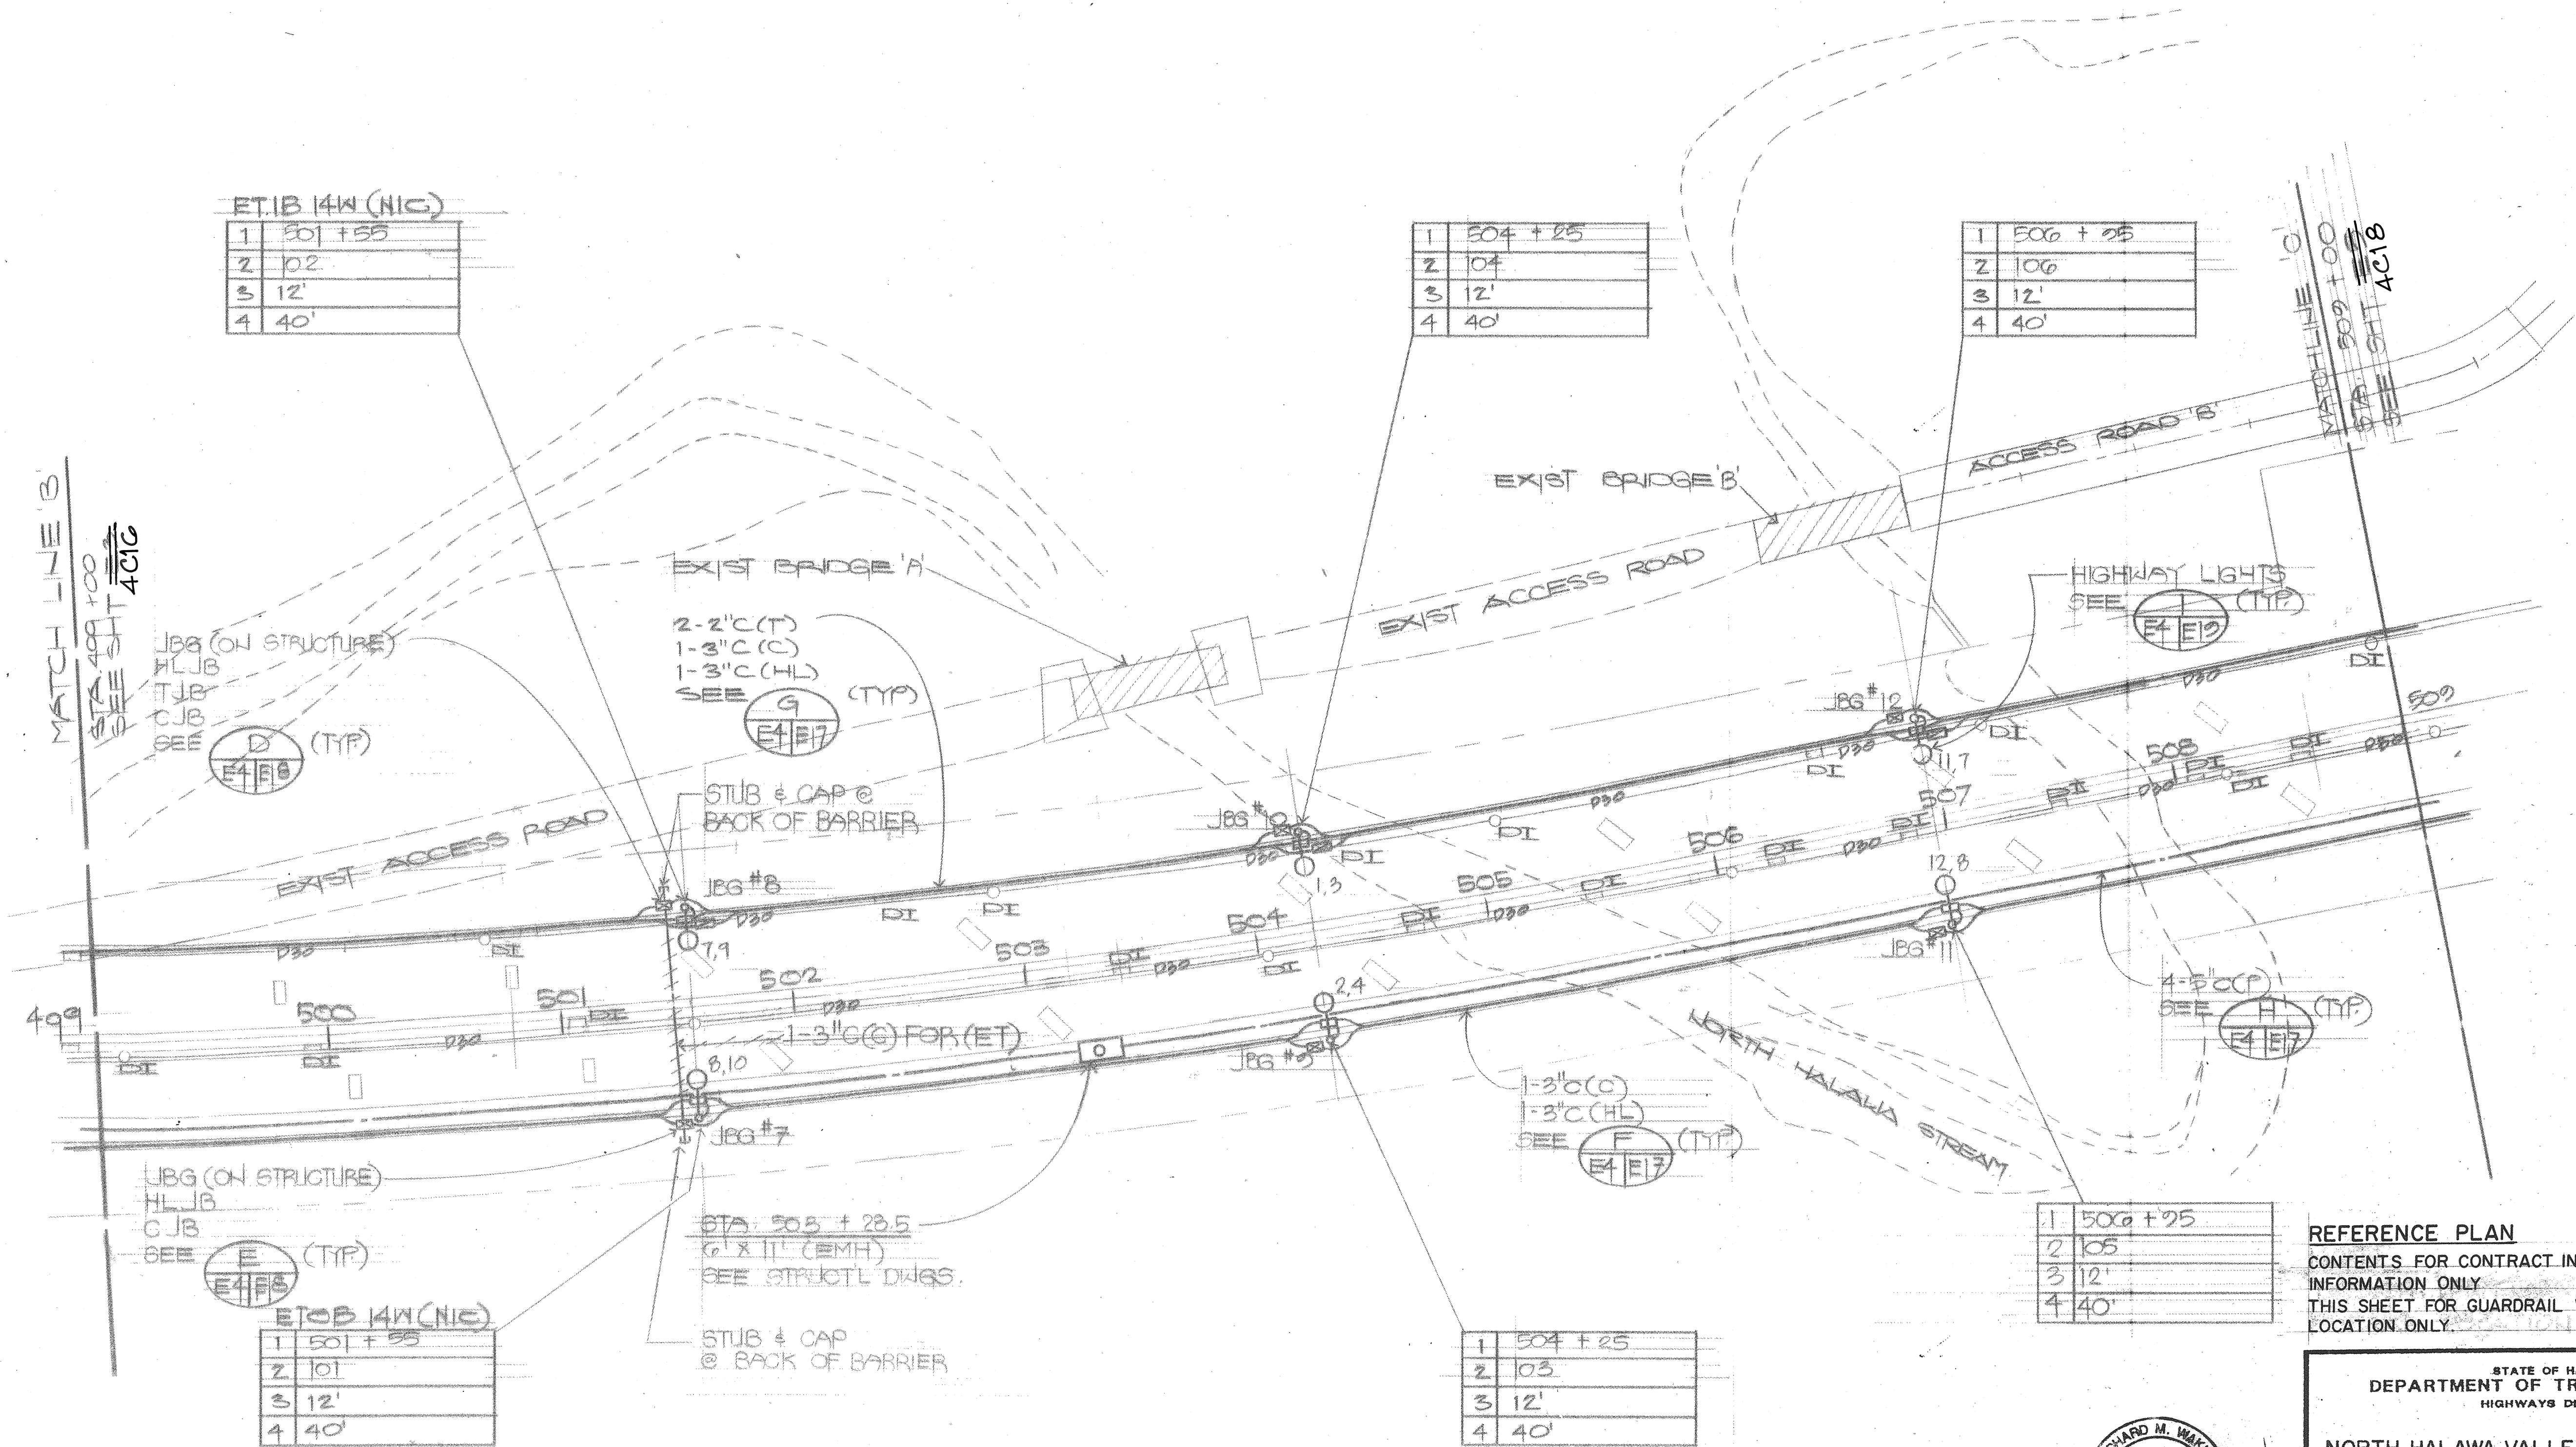


DATE	
DESIGNED BY	
CHECKED BY	
NOTED BY	
QUANTITIES BY	
TRACED BY	
DRAWN BY	
ORIGINAL PLAN	

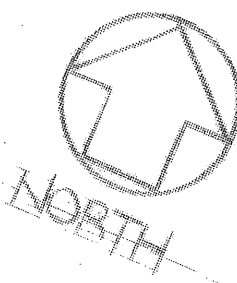

GUARDRAIL W/ RUBRAIL PLAN - PART III

SCALE: 1" = 40'-0"

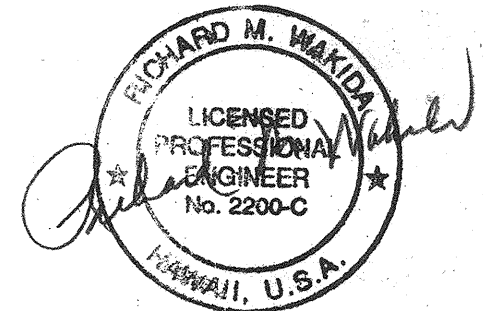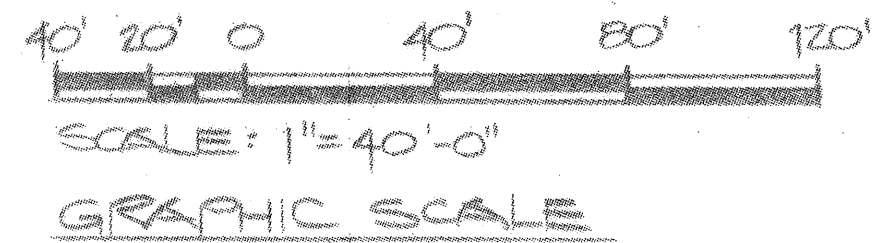

THIS WORK WAS PREPARED BY ME OR UNDER MY SUPERVISION

REFERENCE PLAN
 CONTENTS FOR CONTRACT INTERFACE
 INFORMATION ONLY
 THIS SHEET FOR GUARDRAIL W/ RUBRAIL
 LOCATION ONLY

STATE OF HAWAII

DEPARTMENT OF TRANSPORTATION

HIGHWAYS DIVISION

NORTH HALAWA VALLEY HIGHWAY UNIT II

GUARDRAIL W/ RUBRAIL PLAN - PART III

H-3 FINISH (UNIT II)

FAIP NO. 1-H3-1(75), UNIT II

LEEWARD SECTION

SCALE: AS SHOWN


DATE: JAN. 1997

SHEET No. 4C17 OF 22

SHEETS



FED. ROAD DIST. NO.	STATE	FED. AID PROJ. NO.	FISCAL YEAR	SHEET NO.	TOTAL SHEETS
HAWAII	HAW.	I-H3-1(75), UNIT II	1997	813	1102

ORIGINAL PLAN	SURVEY PLOTTED BY	DATE
NOTE BOOK	DRAWN BY	
QUANTITIES BY	DESIGNED BY	
CHECKED BY	QUANTITIES BY	
NO.	CHECKED BY	

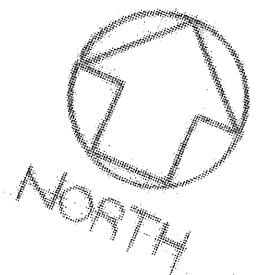

GUARDRAIL W/ RUBRAIL PLAN-PART IV

SCALE: 1"=40'-0"

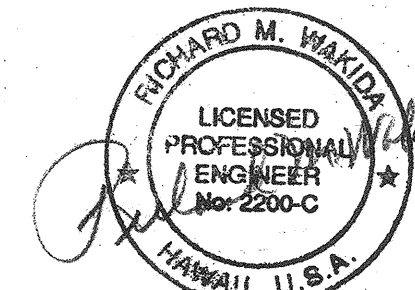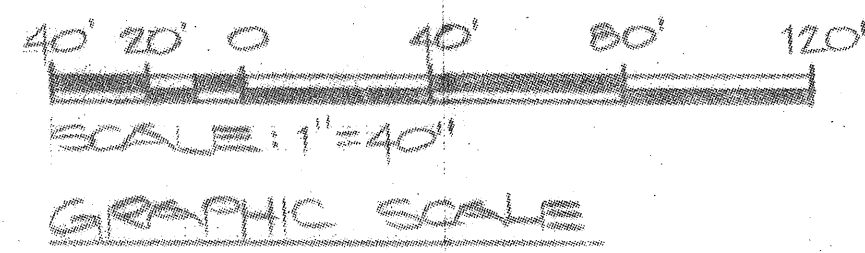

THIS WORK WAS PREPARED BY ME
OR UNDER MY SUPERVISION

REFERENCE PLAN
 CONTENTS FOR CONTRACT INTERFACE
 INFORMATION ONLY
 THIS SHEET FOR GUARDRAIL W/RUBRAIL
 LOCATION ONLY

STATE OF HAWAII

DEPARTMENT OF TRANSPORTATION

HIGHWAYS DIVISION

NORTH HALAWA VALLEY HIGHWAY UNIT II

GUARDRAIL W/RUBRAIL PLAN-PART IV

H-3 FINISH (UNIT II)

FAIP NO. I-H3-1(75), UNIT II


LEEWARD SECTION

SCALE: AS SHOWN

DATE: JAN. 1997

SHEET No.4C18 OF 22

SHEETS

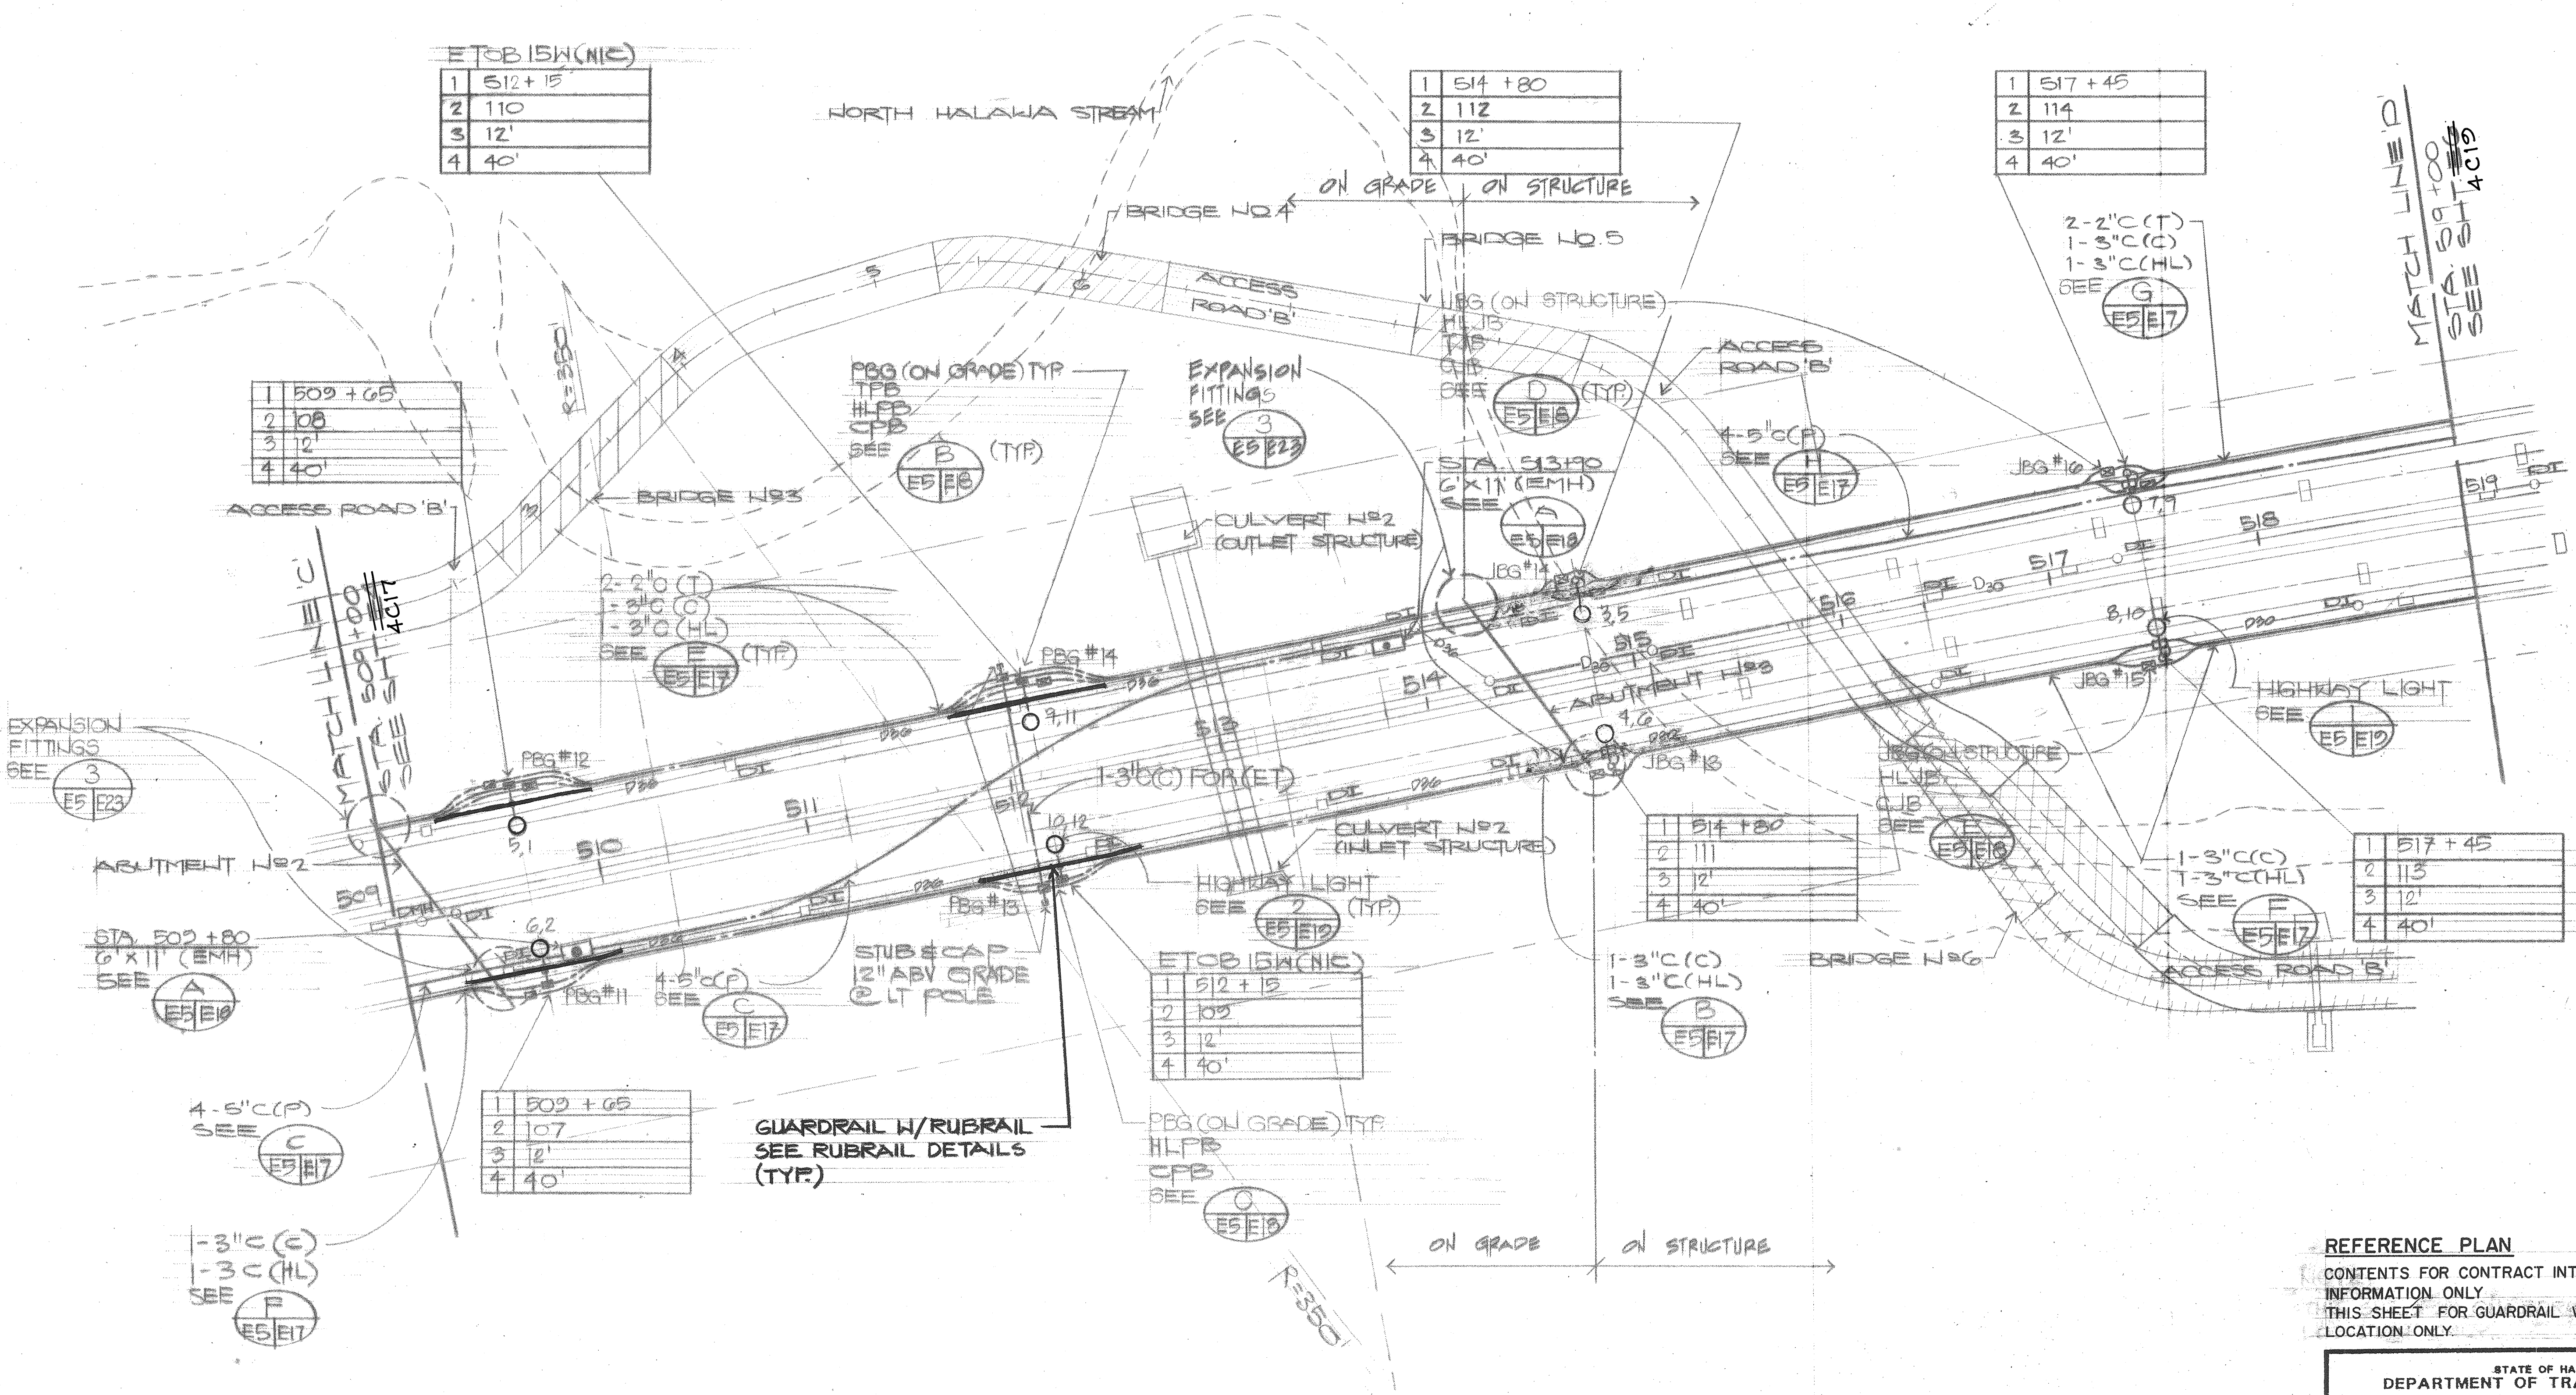

ETOB ISH(NIC)	
1	512+15
2	110
3	12'
4	40'

1	514+80
2	112
3	12'
4	40'

1	517+45
2	114
3	12'
4	40'

1	509+65
2	108
3	12'
4	40'


1	514+80
2	111
3	12'
4	40'

1	517+45
2	113
3	12'
4	40'

1	509+65
2	107
3	12'
4	40'

ETOB ISH(NIC)	
1	512+15
2	109
3	12'
4	40'



FED. ROAD DIST. NO.	STATE	FED. AID PROJ. NO.	FISCAL YEAR	SHEET NO.	TOTAL SHEETS
HAWAII	HAW.	1-H3-11751, UNIT II	1997	814	1102

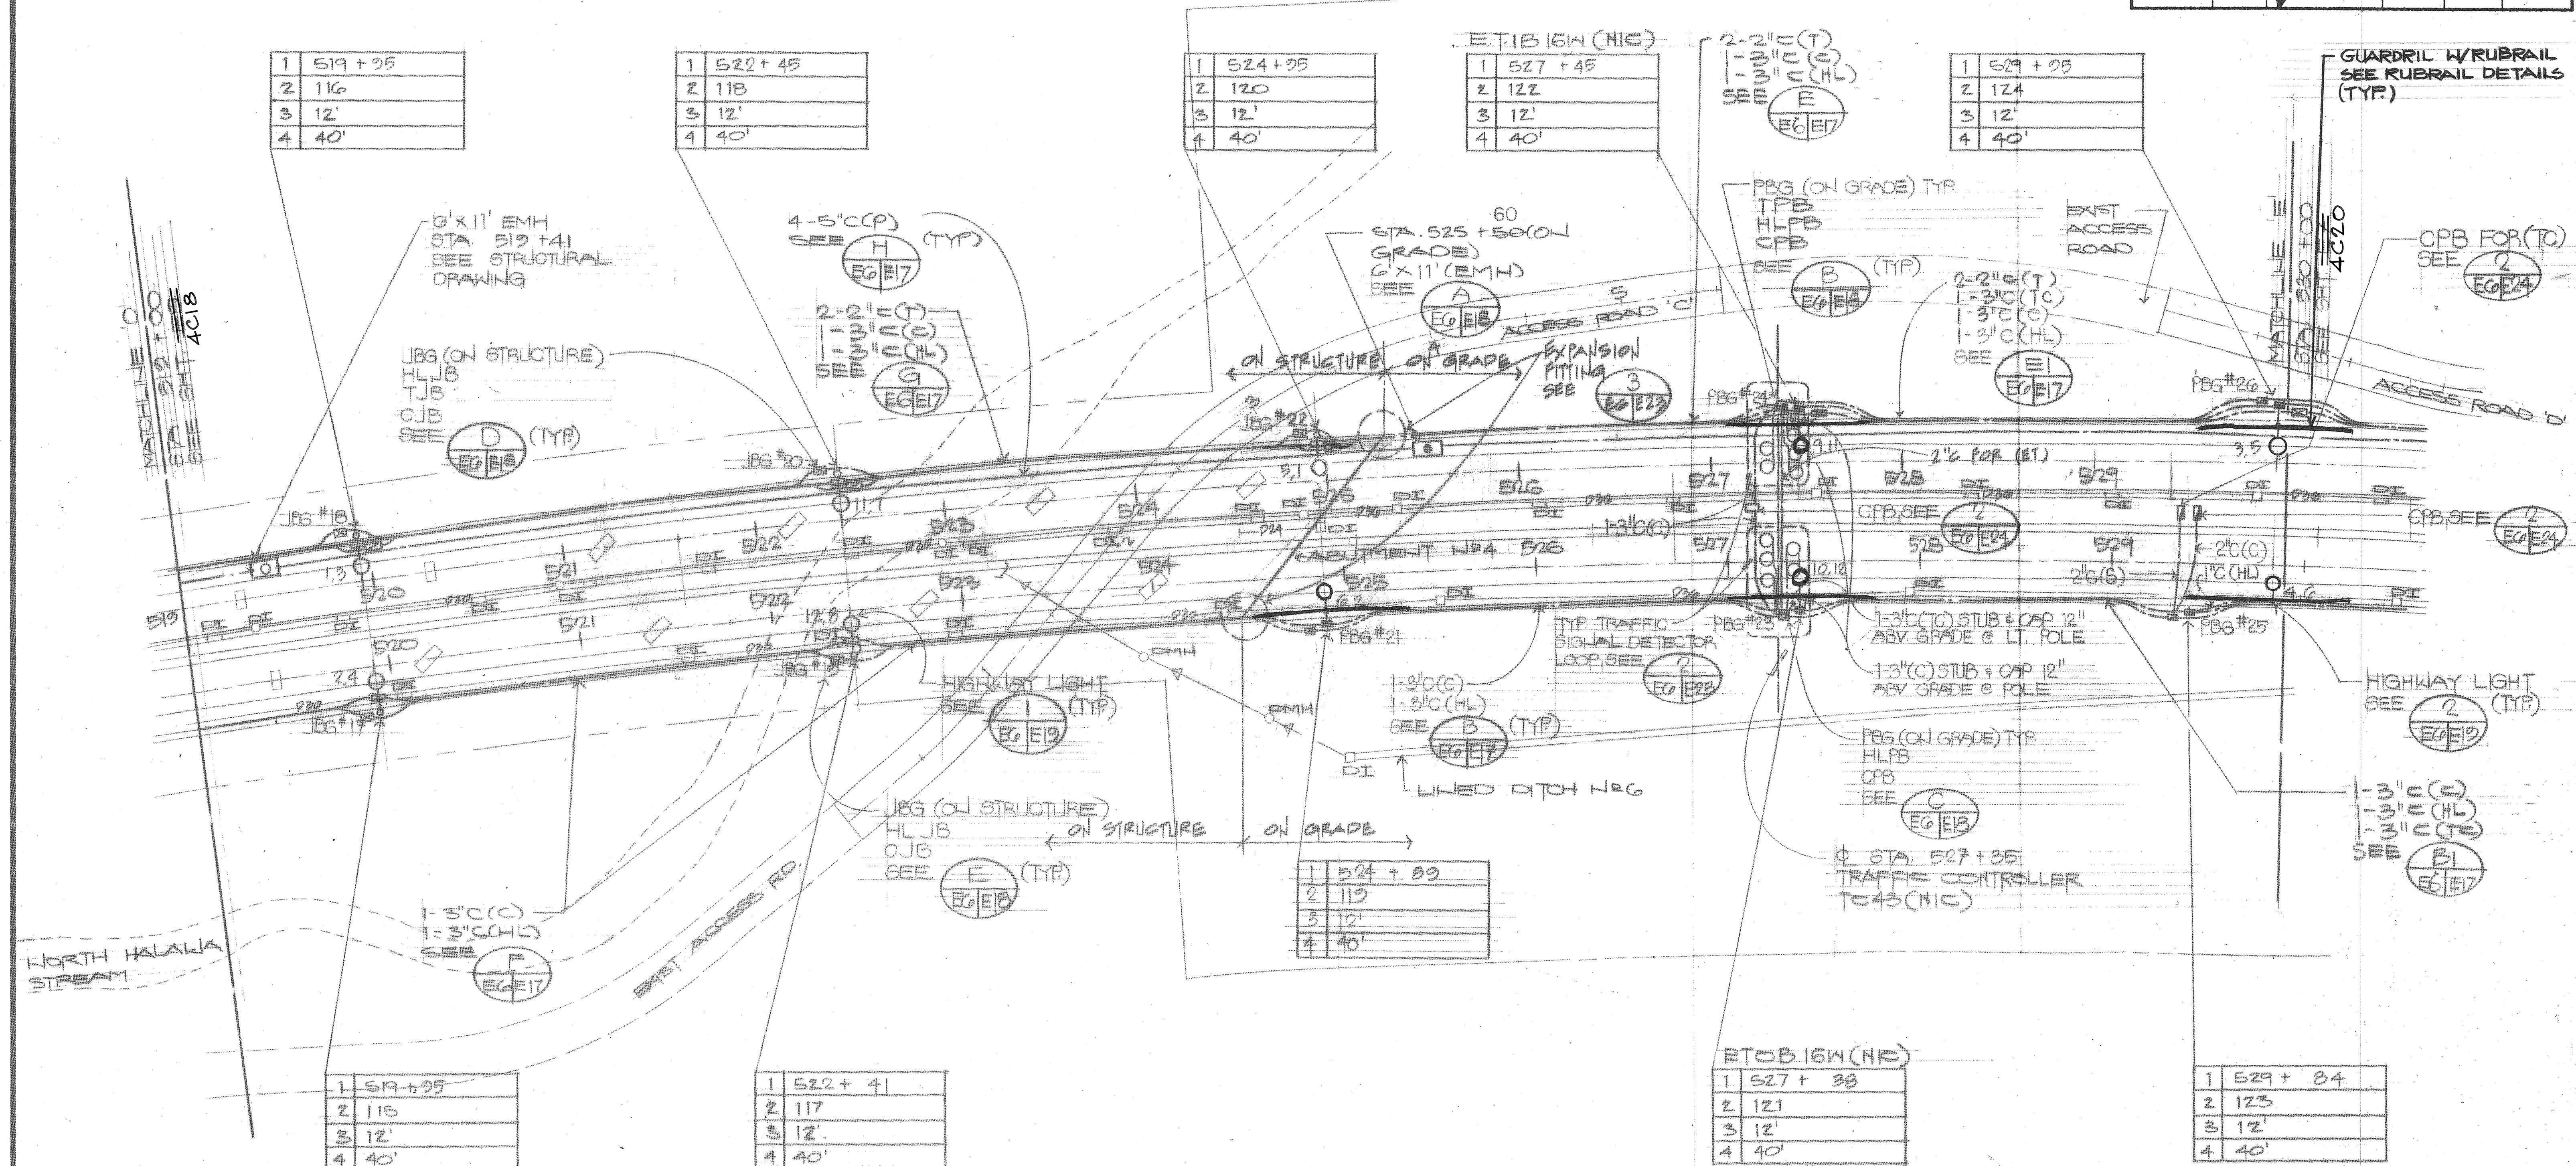

ORIGINAL PLAN	DATE
SURVEY PLOTTED BY	
DESIGNED BY	
NOTED BY	
CHECKED BY	



GUARDRAIL W/ RUBRAIL PLAN - PART V SCALE: 1" = 40'-0"

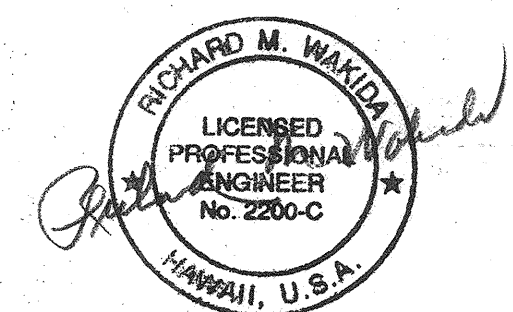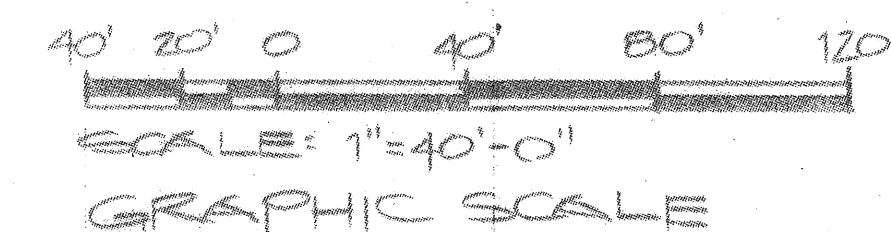

THIS WORK WAS PREPARED BY ME OR UNDER MY SUPERVISION

REFERENCE PLAN
 CONTENTS FOR CONTRACT INTERFACE
 INFORMATION ONLY
 THIS SHEET FOR GUARDRAIL W/ RUBRAIL
 LOCATION ONLY

STATE OF HAWAII
 DEPARTMENT OF TRANSPORTATION
 HIGHWAYS DIVISION


**NORTH HALAWA VALLEY HIGHWAY, UNIT II
 GUARDRAIL W/ RUBRAIL PLAN - PART V**

H-3 FINISH (UNIT II)
 FAIP NO. 1-H3-1(75), UNIT II
 LEeward SECTION

SCALE: AS SHOWN DATE: JAN. 1997


FED. ROAD DIST. NO.	STATE	FED. AID PROJ. NO.	FISCAL YEAR	SHEET NO.	TOTAL SHEETS
HAWAII	HAW.	I-H3-1(75), UNIT II	1997	815	1102

ORIGINAL PLAN	DATE
DRAWN BY	
DESIGNED BY	
QUANTITIES BY	
CHECKED BY	

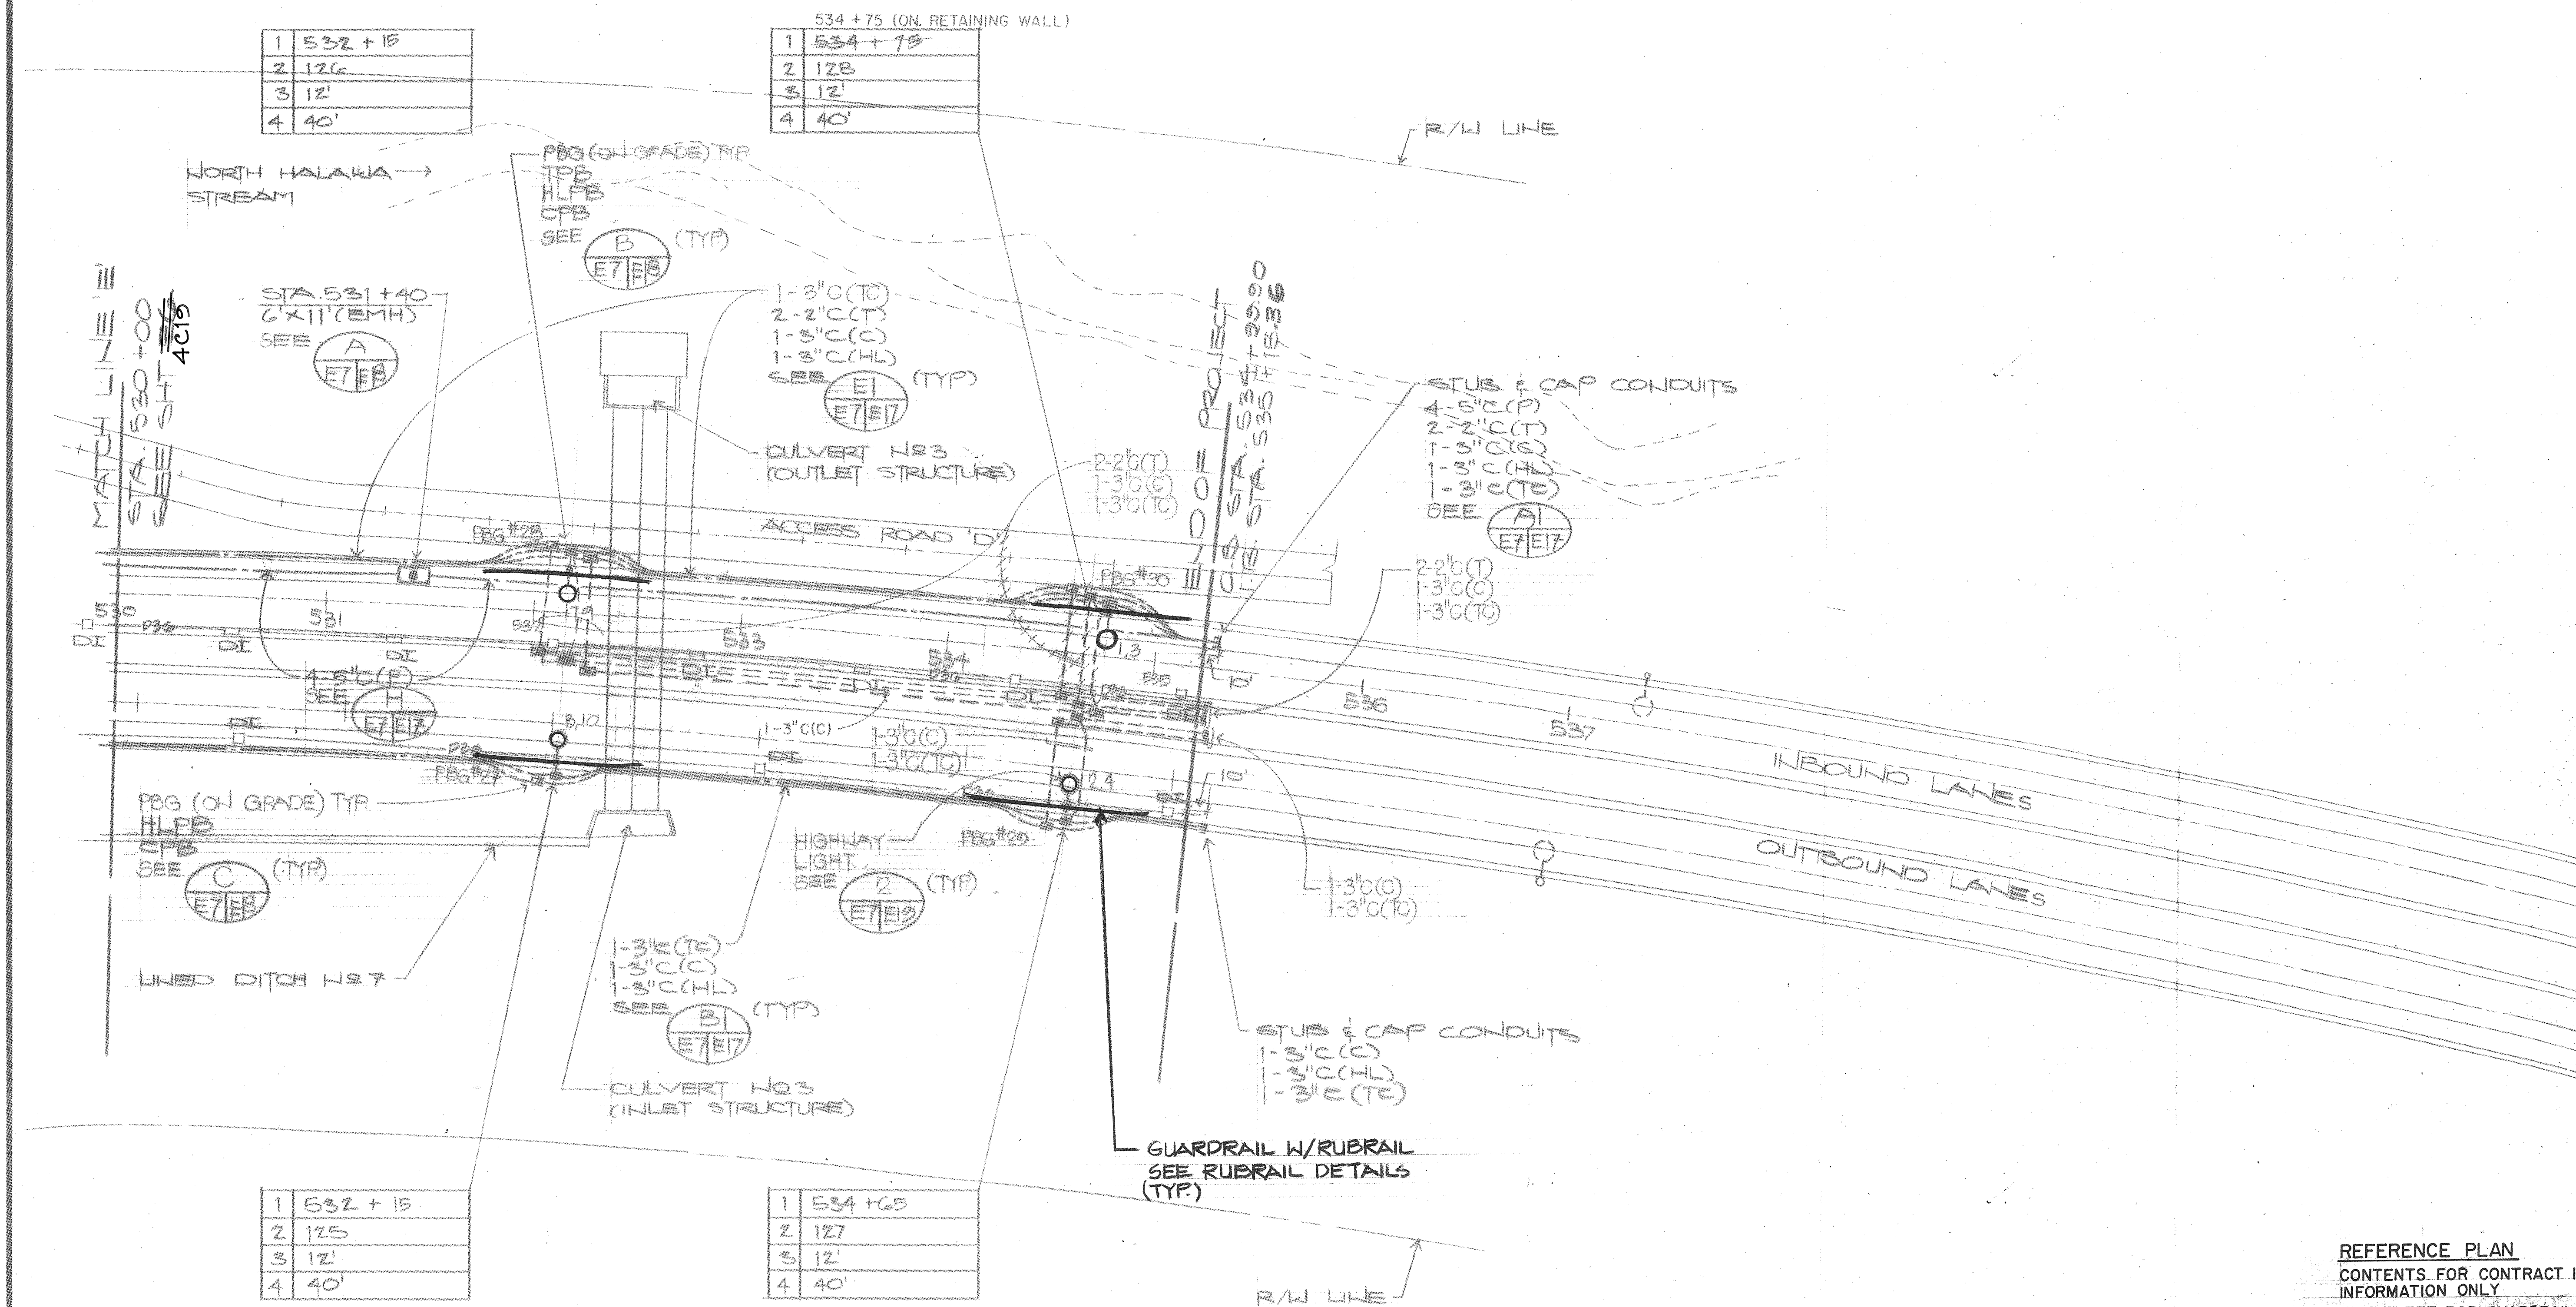



1	532 + 15
2	125
3	12'
4	40'

1	534 + 75
2	127
3	12'
4	40'

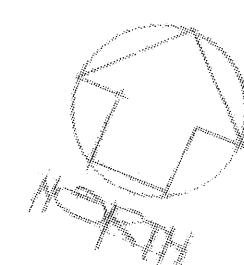

GUARDRAIL W/ RUBRAIL PLAN-PART VI

SCALE: 1"=40'-0"

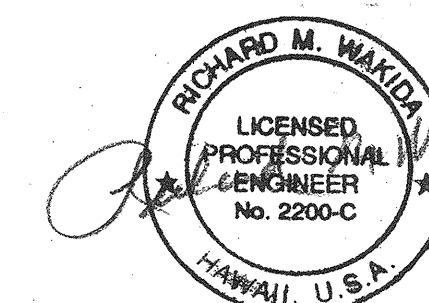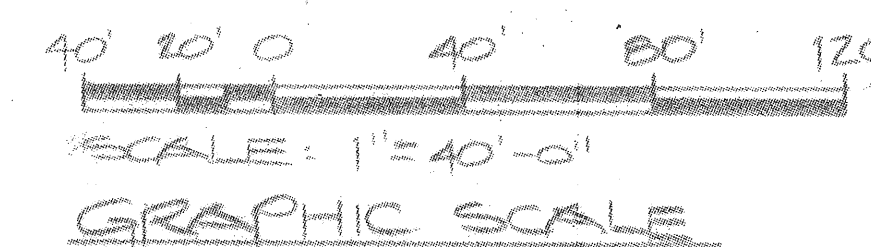

THIS WORK WAS PREPARED BY ME OR UNDER MY SUPERVISION

REFERENCE PLAN
 CONTENTS FOR CONTRACT INTERFACE
 INFORMATION ONLY
 THIS SHEET FOR GUARDRAIL W/RUBRAIL
 LOCATION ONLY

STATE OF HAWAII
 DEPARTMENT OF TRANSPORTATION
 HIGHWAYS DIVISION


NORTH HALAWA VALLEY HIGHWAY, UNIT II
GUARDRAIL W/ RUBRAIL PLAN-PART VI

H-3 FINISH (UNIT II)
 FAIP NO. I-H3-1(75), UNIT II
 LEeward SECTION

SCALE: AS SHOWN DATE: JAN. 1997


FED. ROAD DIST. NO.	STATE	FED. AID PROJ. NO.	FISCAL YEAR	SHEET NO.	TOTAL SHEETS
HAWAII	HAW.	I-H3-1(75), UNIT II	1997	816	1102

LEGEND:

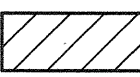 10" Plain Concrete Pad


NOTES:

- Concrete for the 10" Plain Concrete Pad shall be 4000 psi minimum strength Portland Cement Concrete with graded aggregate and 3" maximum slump.
- Sawed contraction joints for the 10" Plain Concrete Pad shall be spaced 15' apart and extend into the slab to a depth of 1 1/2". Contractor shall saw cut the joints within 12 hours after the completion of concrete placement. Fill contraction joints with poured-type joint sealer, Specifications Section 705.04(A).
- The Engineer will not pay for the 10" Plain Concrete Pad nor sawed contraction joints separately and will consider payment incidental to the Movable Steel Gate System.
- Payment for Expansion Joint shall be considered incidental to Movable Steel Gate System.

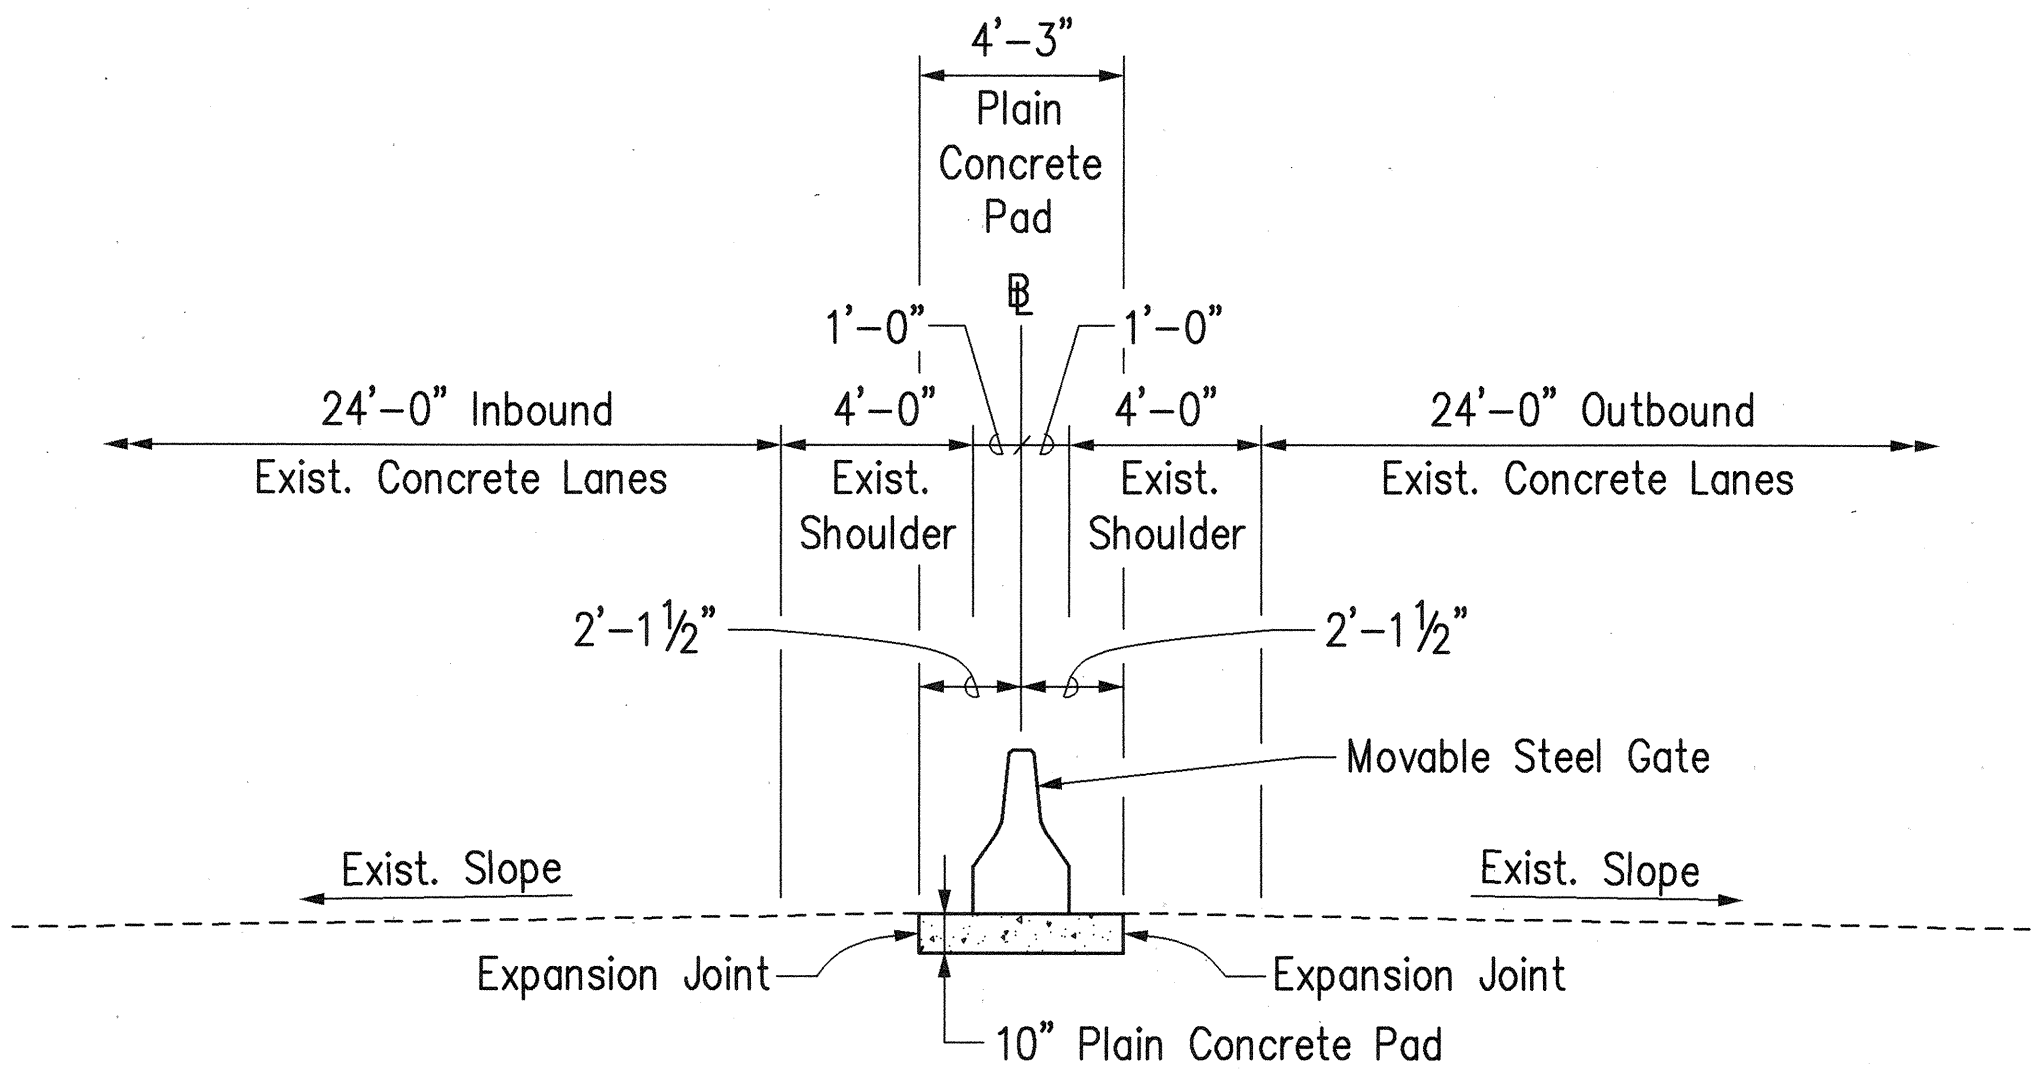


TYPICAL SECTION – INBOUND AND OUTBOUND LANES

Scale: 1/4" = 1'-0"

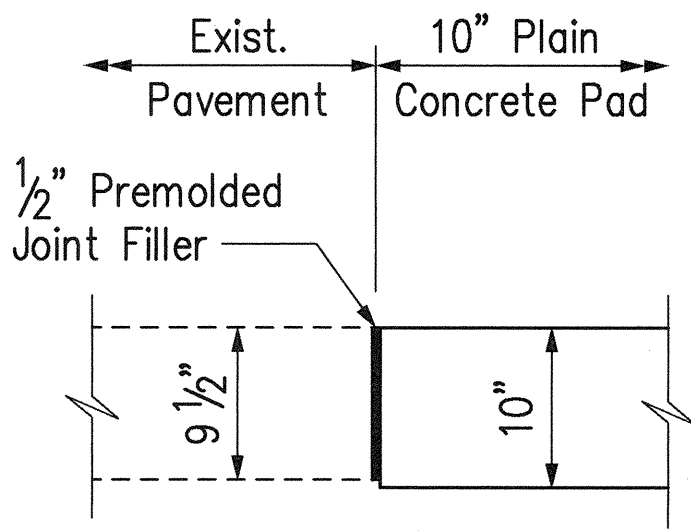


EXPANSION JOINT

Scale: 1" = 1'-0"

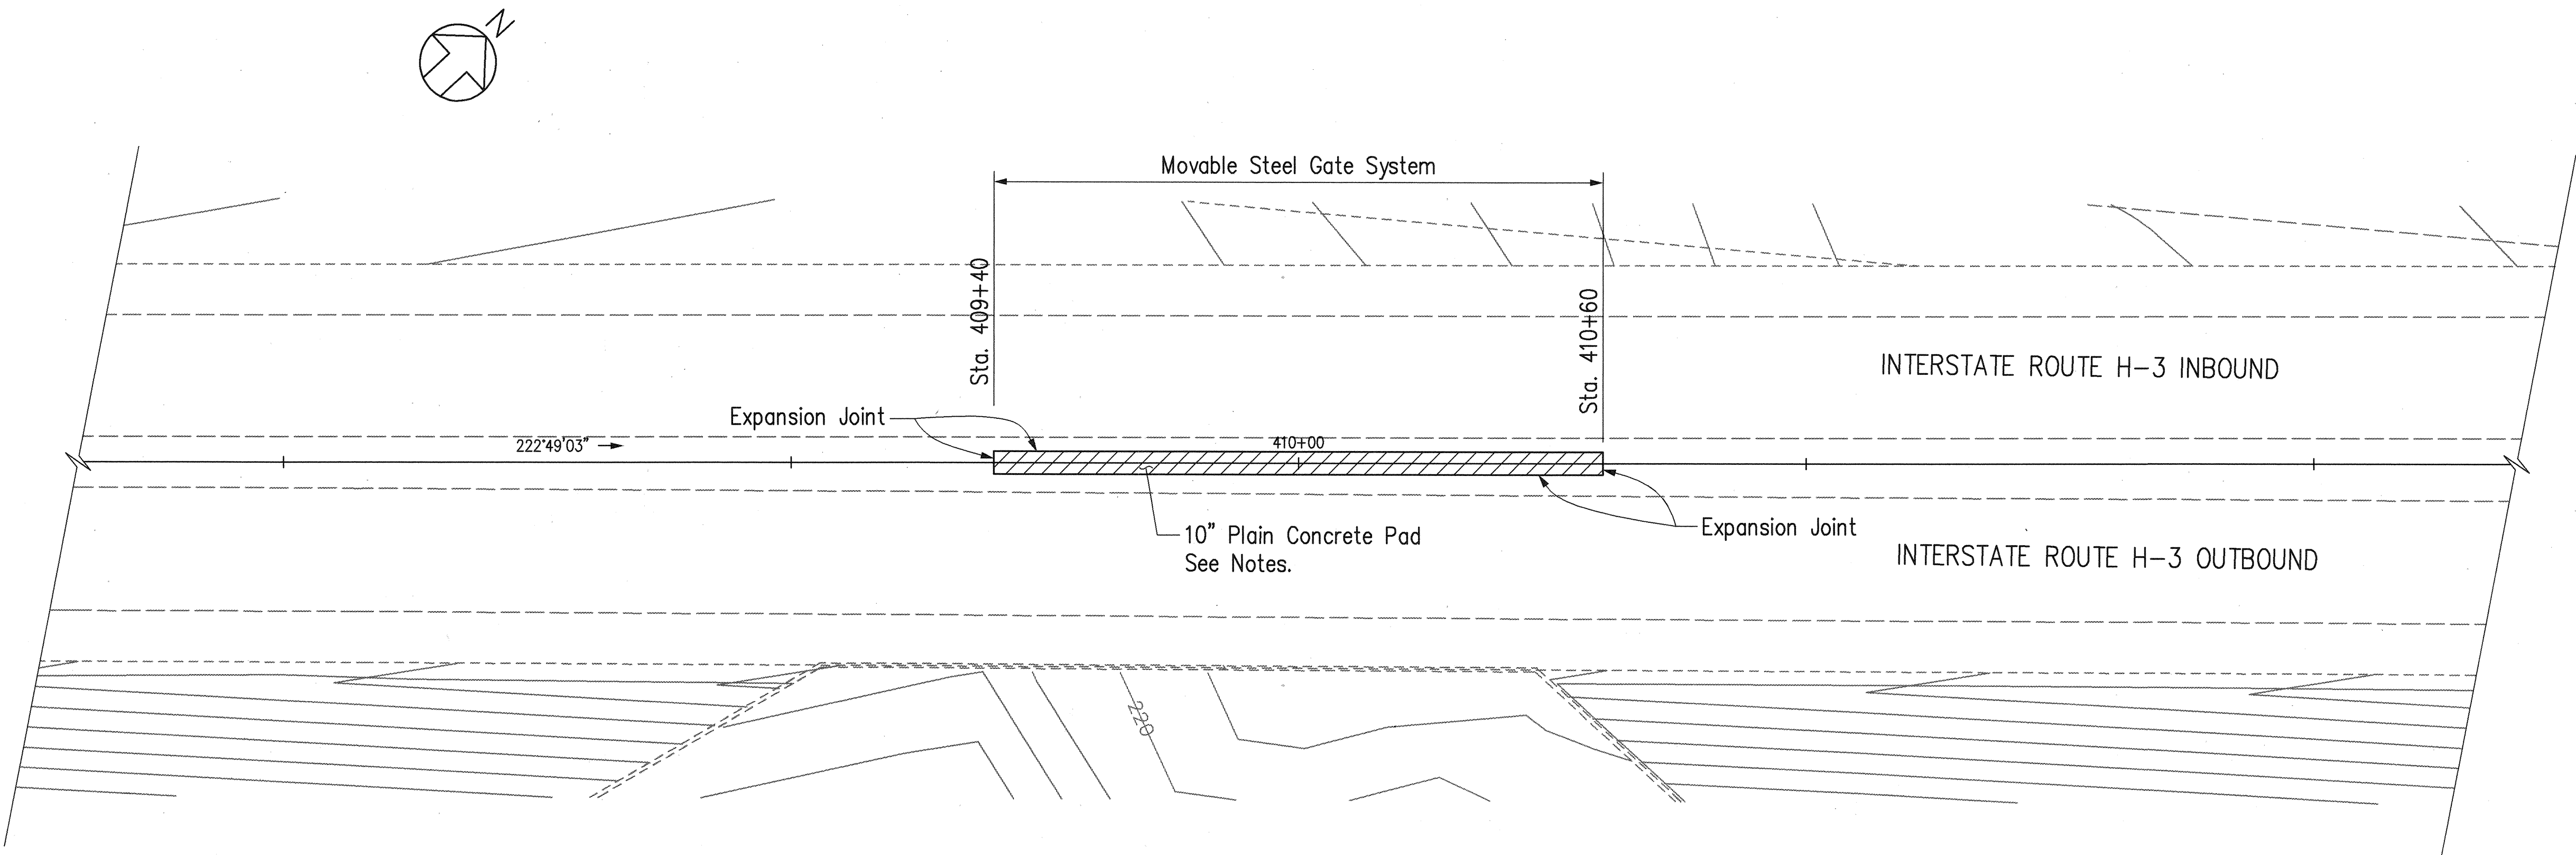

PLAN

Scale: 1" = 20'

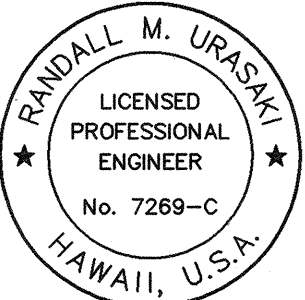

THIS WORK WAS PREPARED BY ME
OR UNDER MY SUPERVISION

Randall M. Urasky

STATE OF HAWAII
DEPARTMENT OF TRANSPORTATION
HIGHWAYS DIVISION

**HALAWA VALLEY
ROADWAY CONSTRUCTION
EMERGENCY CROSSOVER**

H-3 FINISH (UNIT II)
FAIP NO. I-H3-1(75), UNIT II
LEEWARD SECTION



SCALE: AS SHOWN DATE: JANUARY 1997

SHEET NO. 4C21 OF 22 SHEETS

SURVEY PLOTTED BY	DATE
DRAWN BY	
DESIGNED BY	
NOTED BY	
CHECKED BY	
No.	

EOB by J. Minura, 35-52


FED. ROAD DIST. NO.	STATE	FED. AID PROJ. NO.	FISCAL YEAR	SHEET NO.	TOTAL SHEETS
HAWAII	HAW.	I-H3-1(75), UNIT II	1997	817	1102

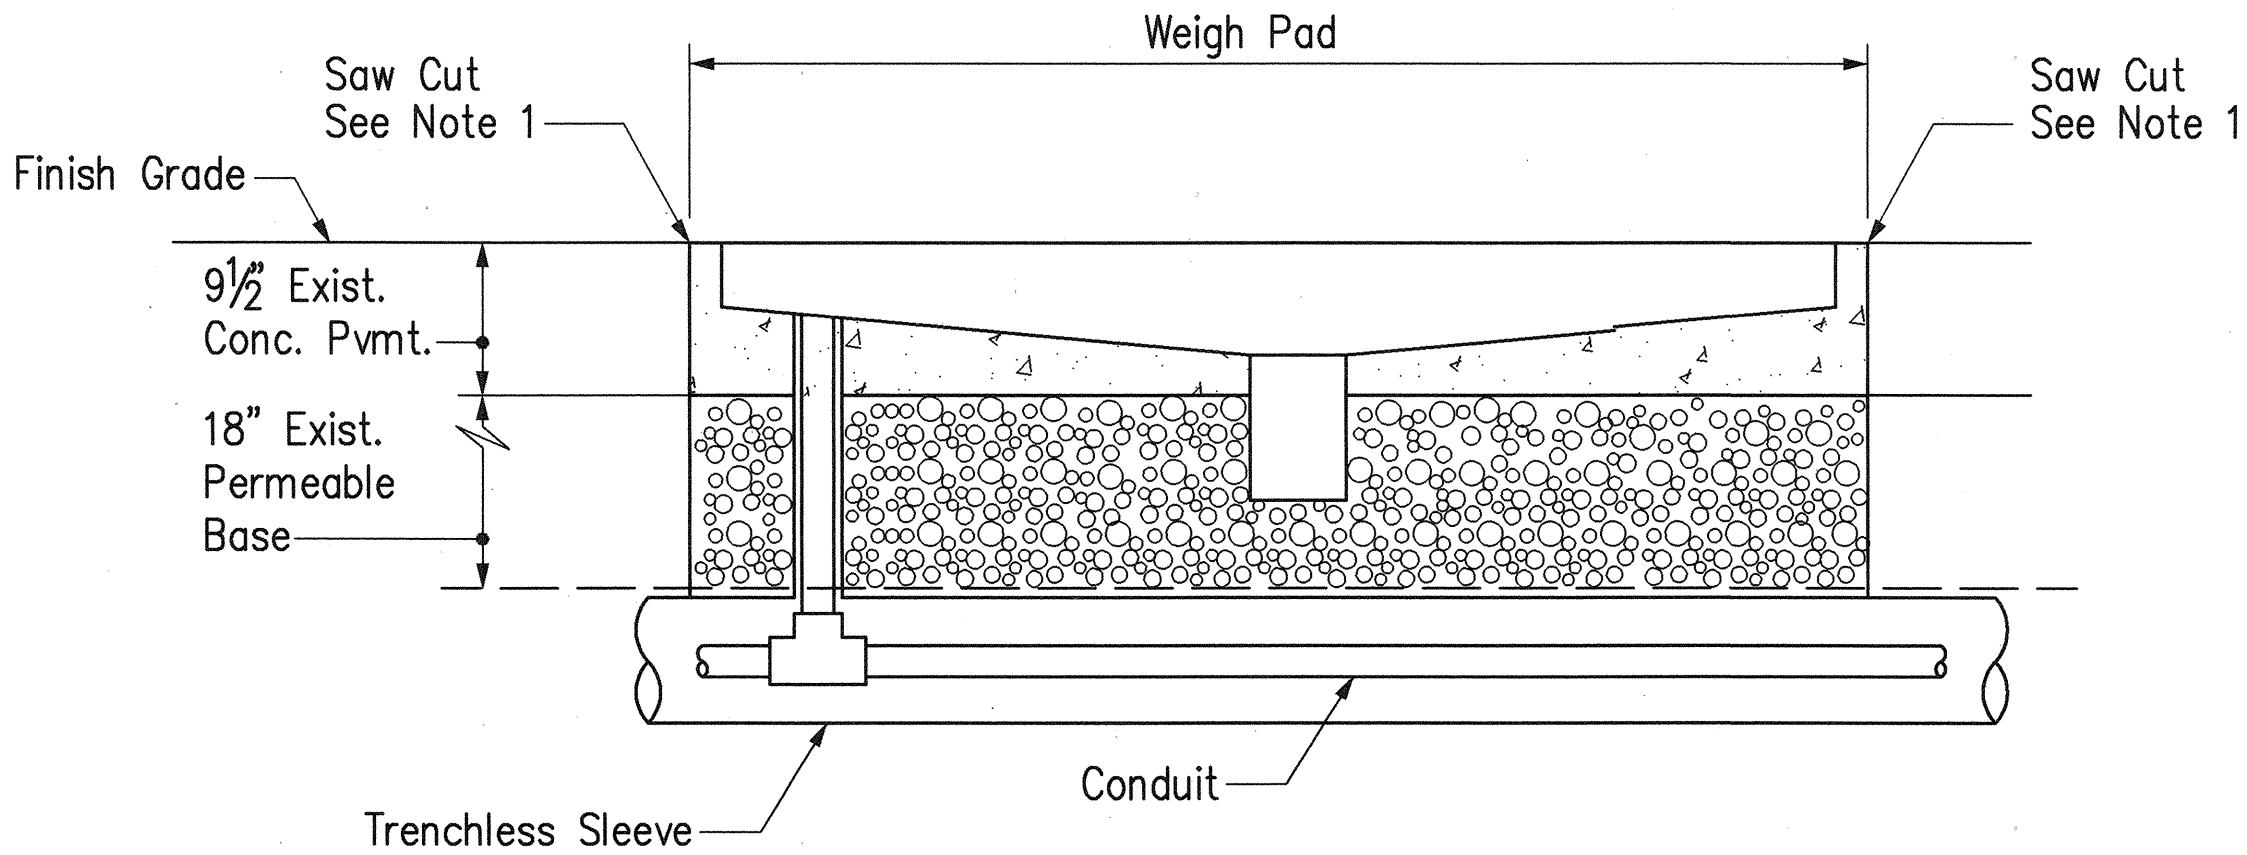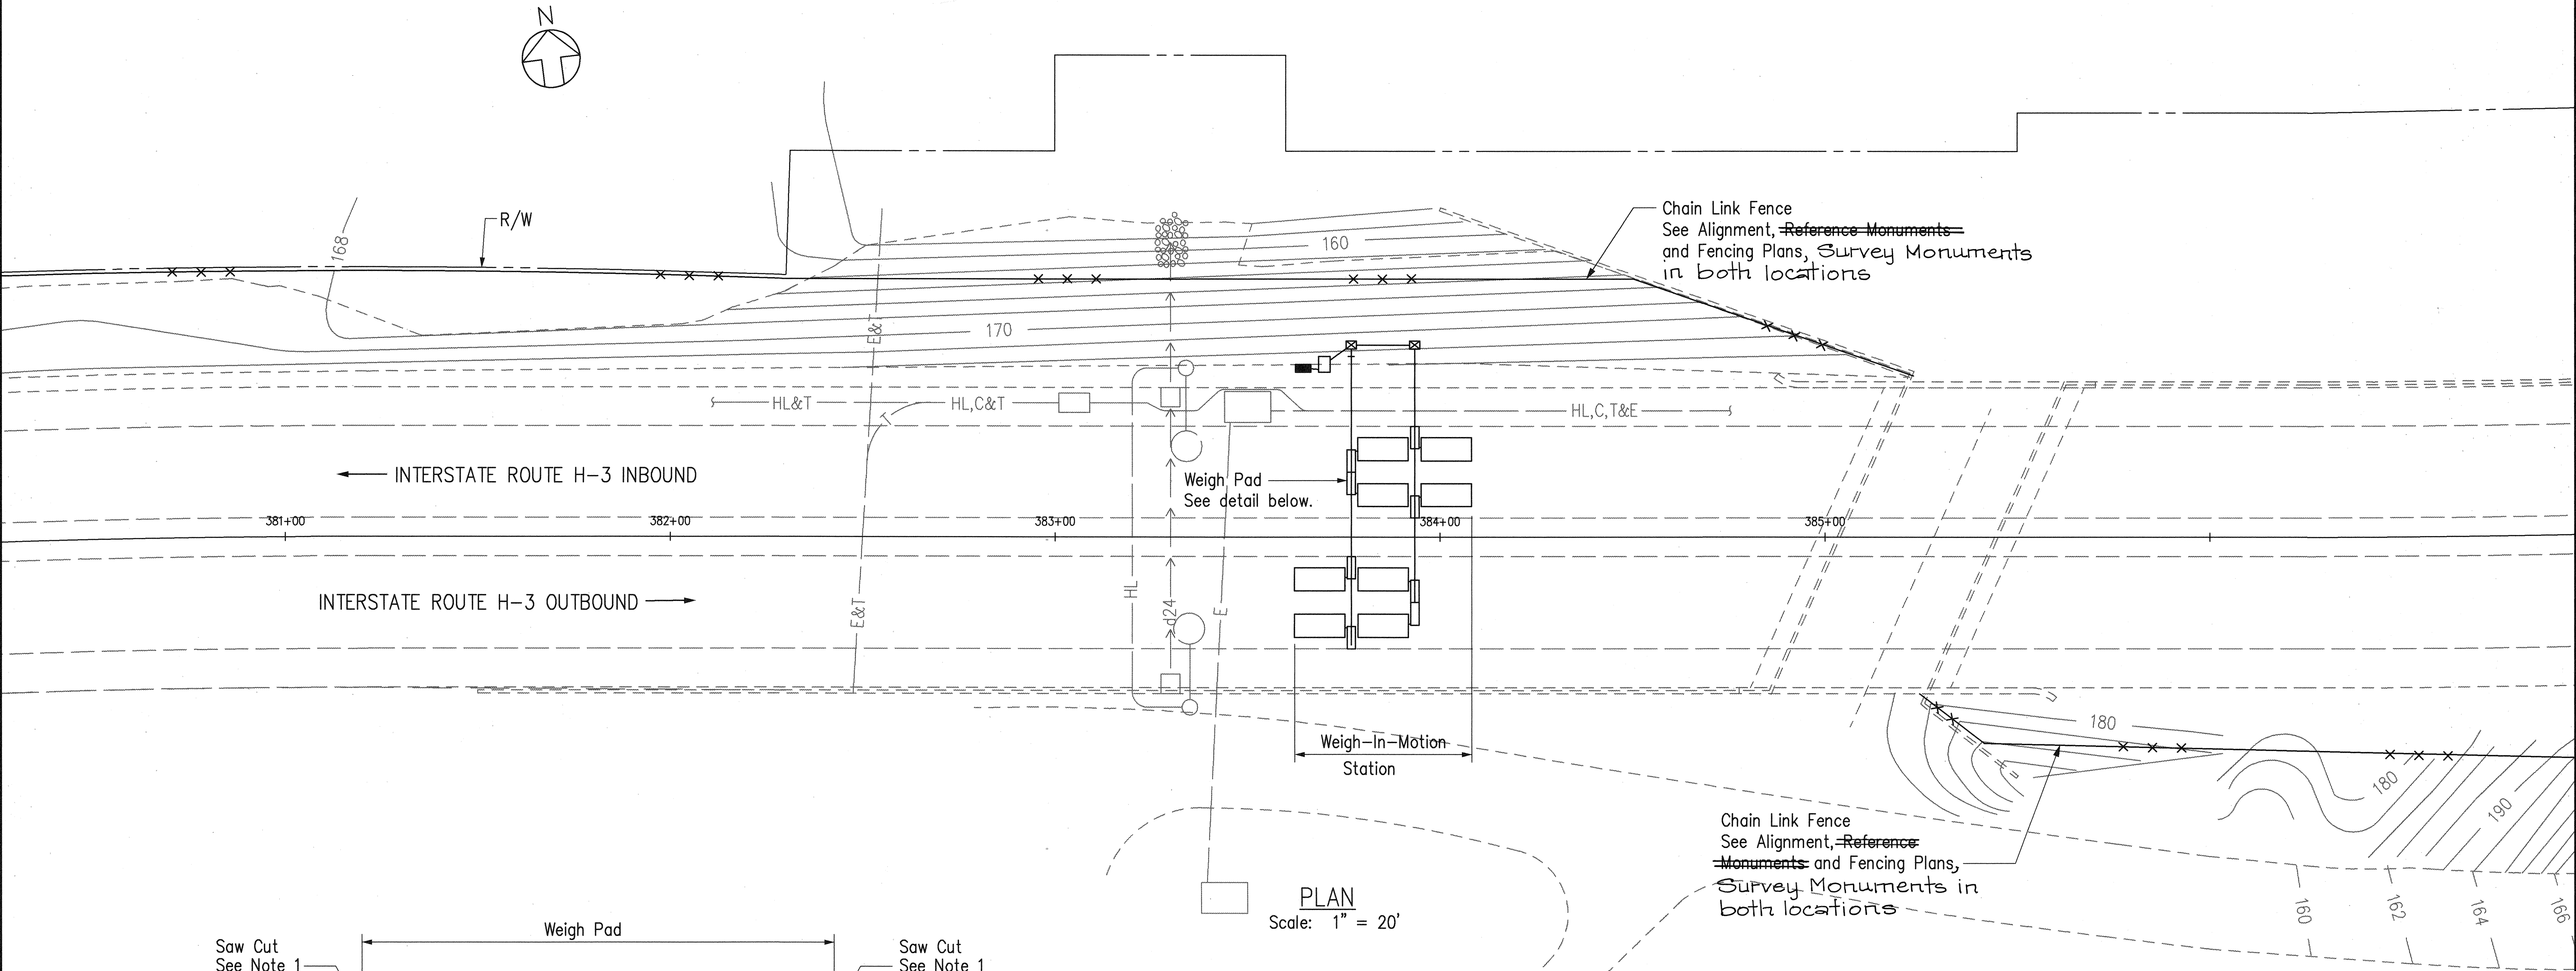

ELEVATION

WEIGH PAD
Not to Scale

- NOTES:
1. Saw cut pavement to a depth of 9-1/2" and remove Exist. Concrete Pavement.
 2. Provide shoring along walls parallel to conduit and excavate to expose trenchless sleeve.
 3. Restore Permeable Base and install Weigh Pad.
 4. See Systems Plans for Weigh-In-Motion Station details.

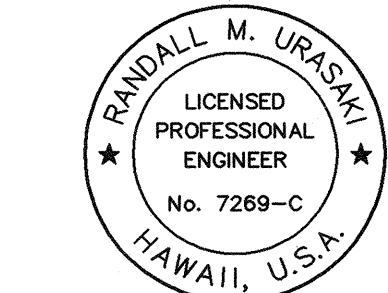


THIS WORK WAS PREPARED BY ME
OR UNDER MY SUPERVISION
R. M. Urashima

5/2/97	Relocated Weigh-In-Motion Station Added Weigh Pad detail Added Notes
Date	Revision
STATE OF HAWAII DEPARTMENT OF TRANSPORTATION HIGHWAYS DIVISION NORTH HALAWA VALLEY ROADWAY CONSTRUCTION WEIGH-IN-MOTION STATION H-3 FINISH (UNIT II) FAIP NO. I-H3-1(75), UNIT II LEEWARD SECTION SCALE: AS SHOWN DATE: JANUARY 1997 SHEET NO. 4C22 OF 22 SHEETS	

SURVEY PLOTTED BY	DATE
DRAWN BY	
CHECKED BY	
NOTE BOOK	
QUANTITIES BY	
CHECKED BY	
No.	

FED. ROAD DIST. NO.	STATE	FED. AID PROJ. NO.	FISCAL YEAR	SHEET NO.	TOTAL SHEETS
HAWAII	HAW.	I-H3-1(75), UNIT II	1997	818	1102

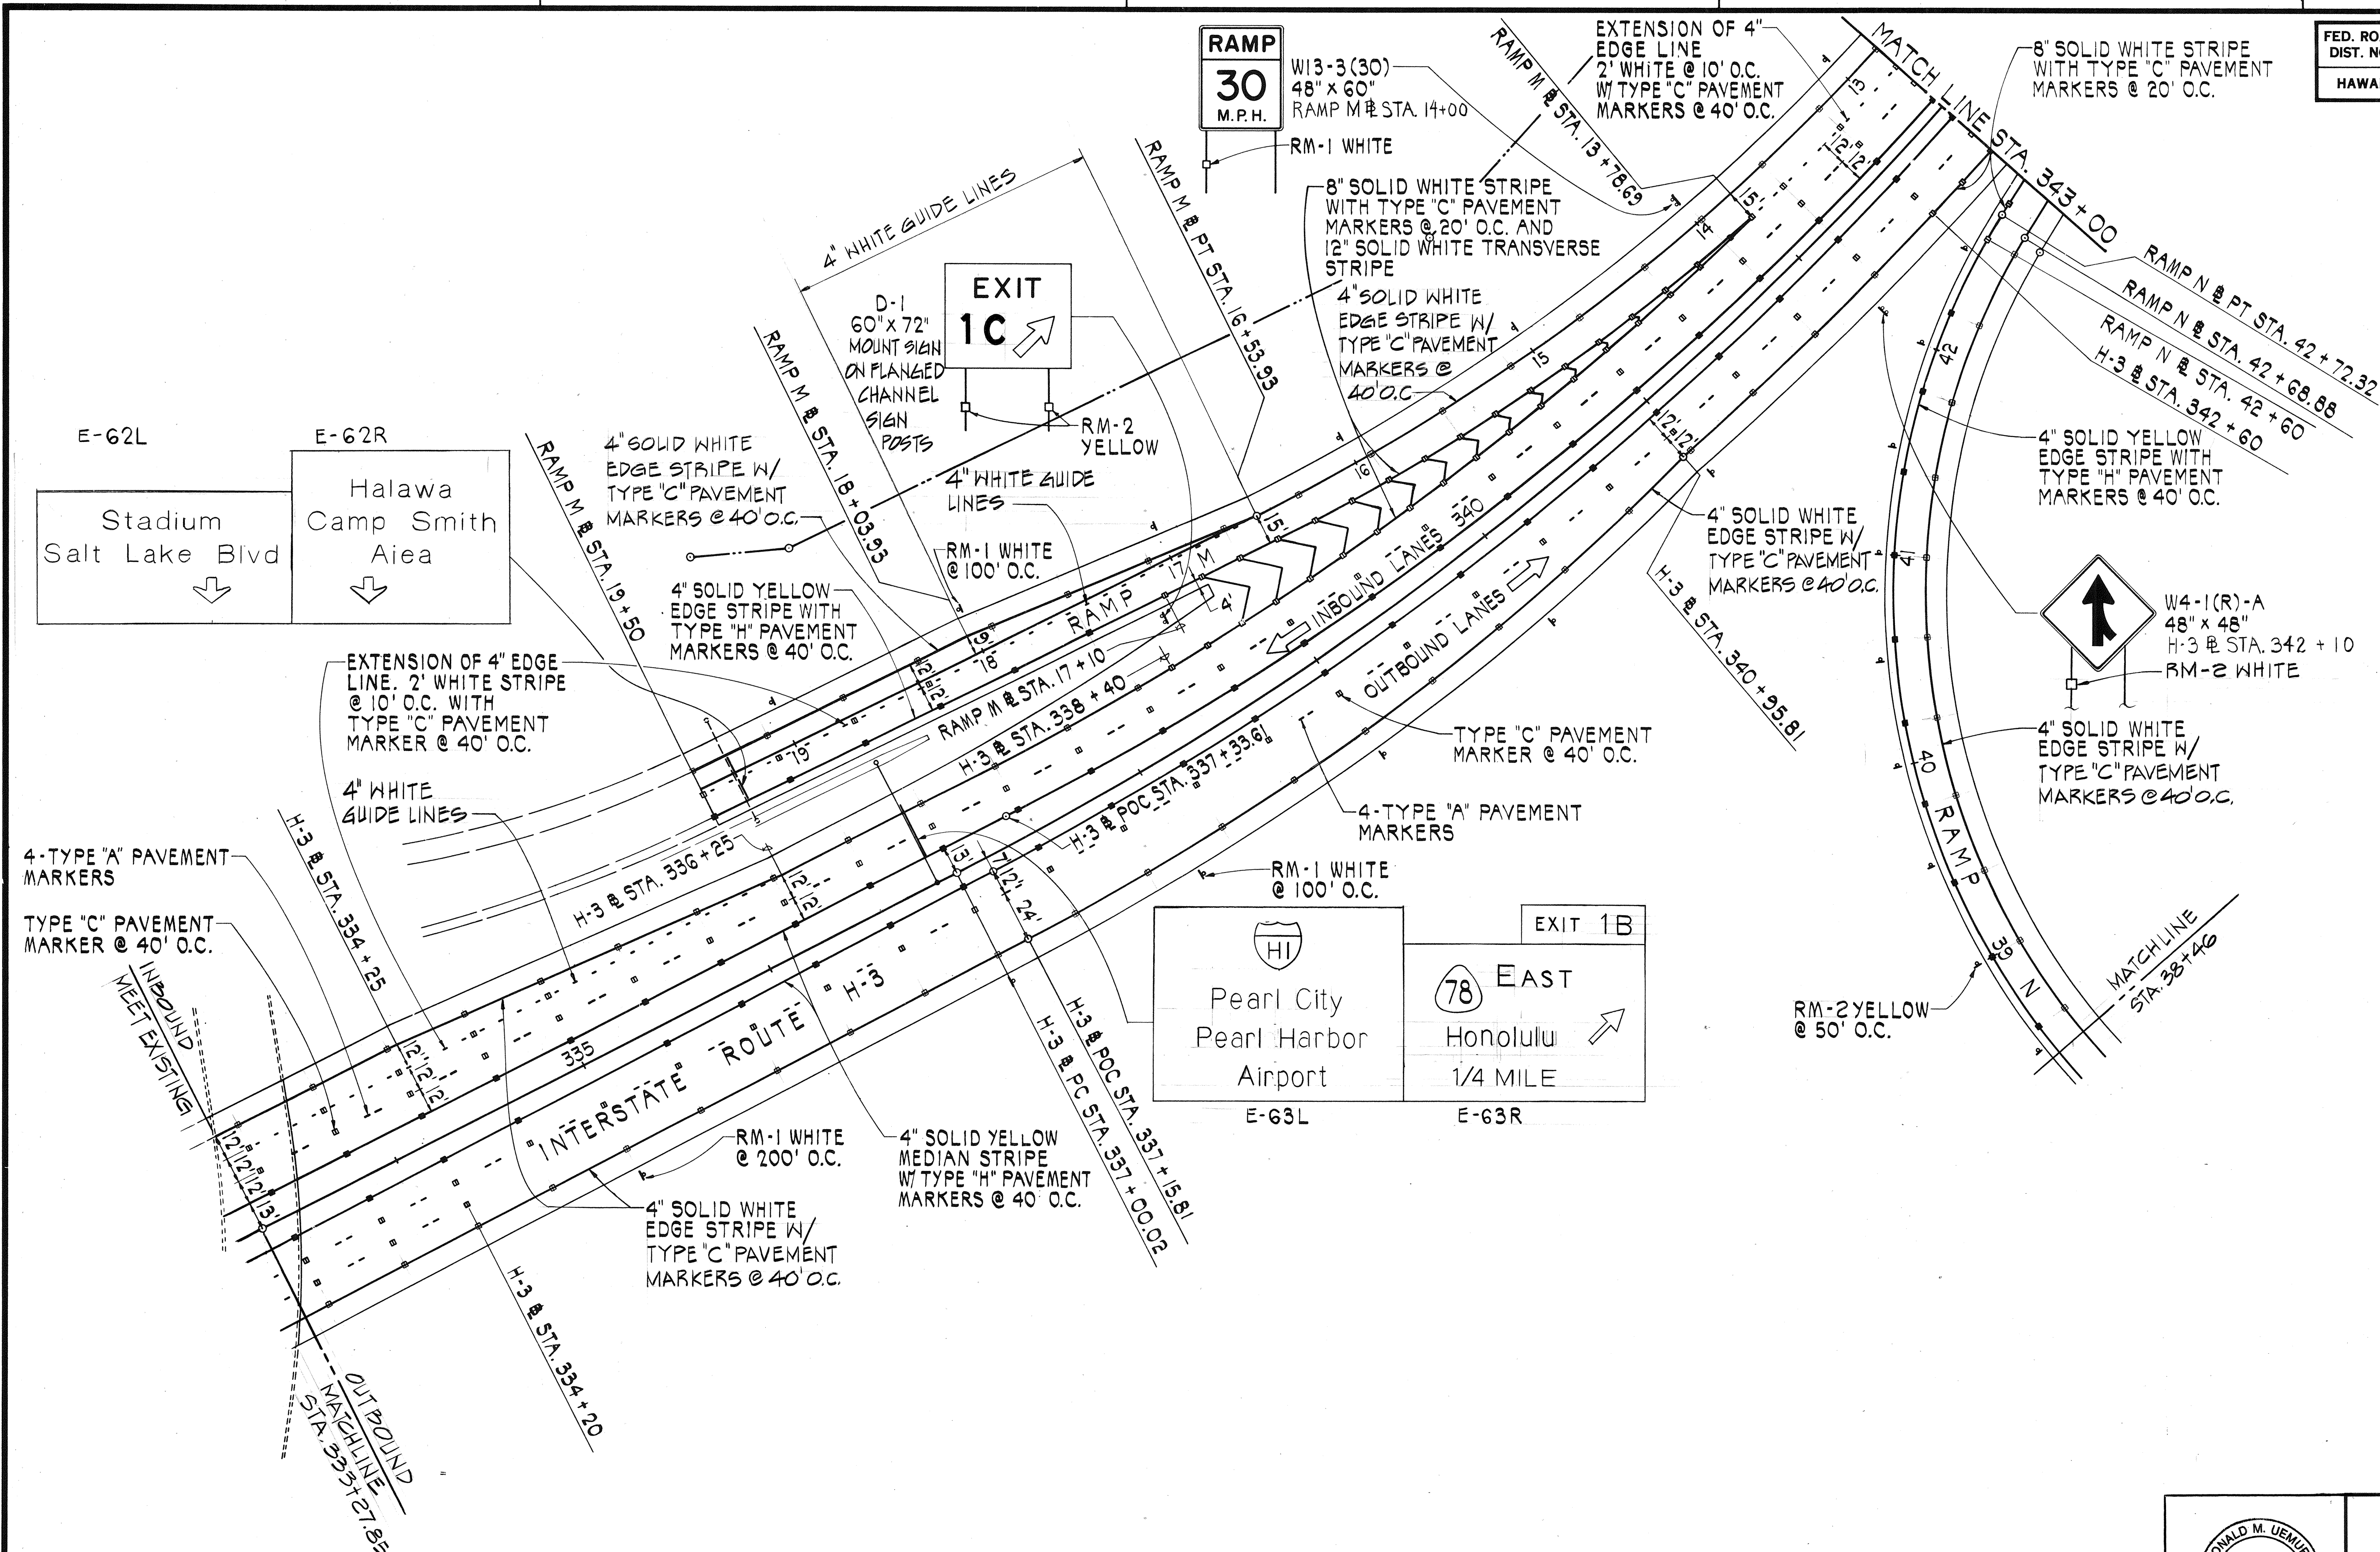

SURVEY PLOTTED BY	DATE
DRAWN BY	
TRACED BY	
NOTED BY	
CHECKED BY	
ORIGINAL PLAN	
NOTE BOOK	
No.	

RONALD M. UEMURA
LICENSED PROFESSIONAL ENGINEER
No. 4441-C
HAWAII, U.S.A.

STATE OF HAWAII
DEPARTMENT OF TRANSPORTATION
HIGHWAYS DIVISION



SIGNING & PAVEMENT MARKINGS
MAKAI QUARRY VIADUCT
STA. 333+27.85 TO STA. 343+00

H-3 FINISH (UNIT II)
FAIP NO. I-H3-1(75), UNIT II
LEEWARD SECTION

SCALE: 1" = 40' DATE: JAN. 1997



SHEET No. 4PI OF 3 SHEETS

DATE	REVISION

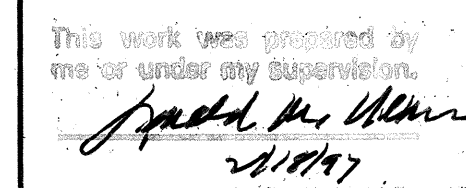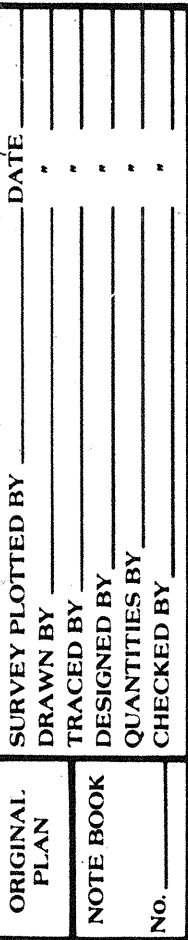

SHEET No.4P2OF 3 SHEETS

FED. ROAD DIST. NO.	STATE	FED. AID PROJ. NO.	FISCAL YEAR	SHEET NO.	TOTAL SHEETS
HAWAII	HAW.	I-H3-1(75), UNIT II	1997	820	1102

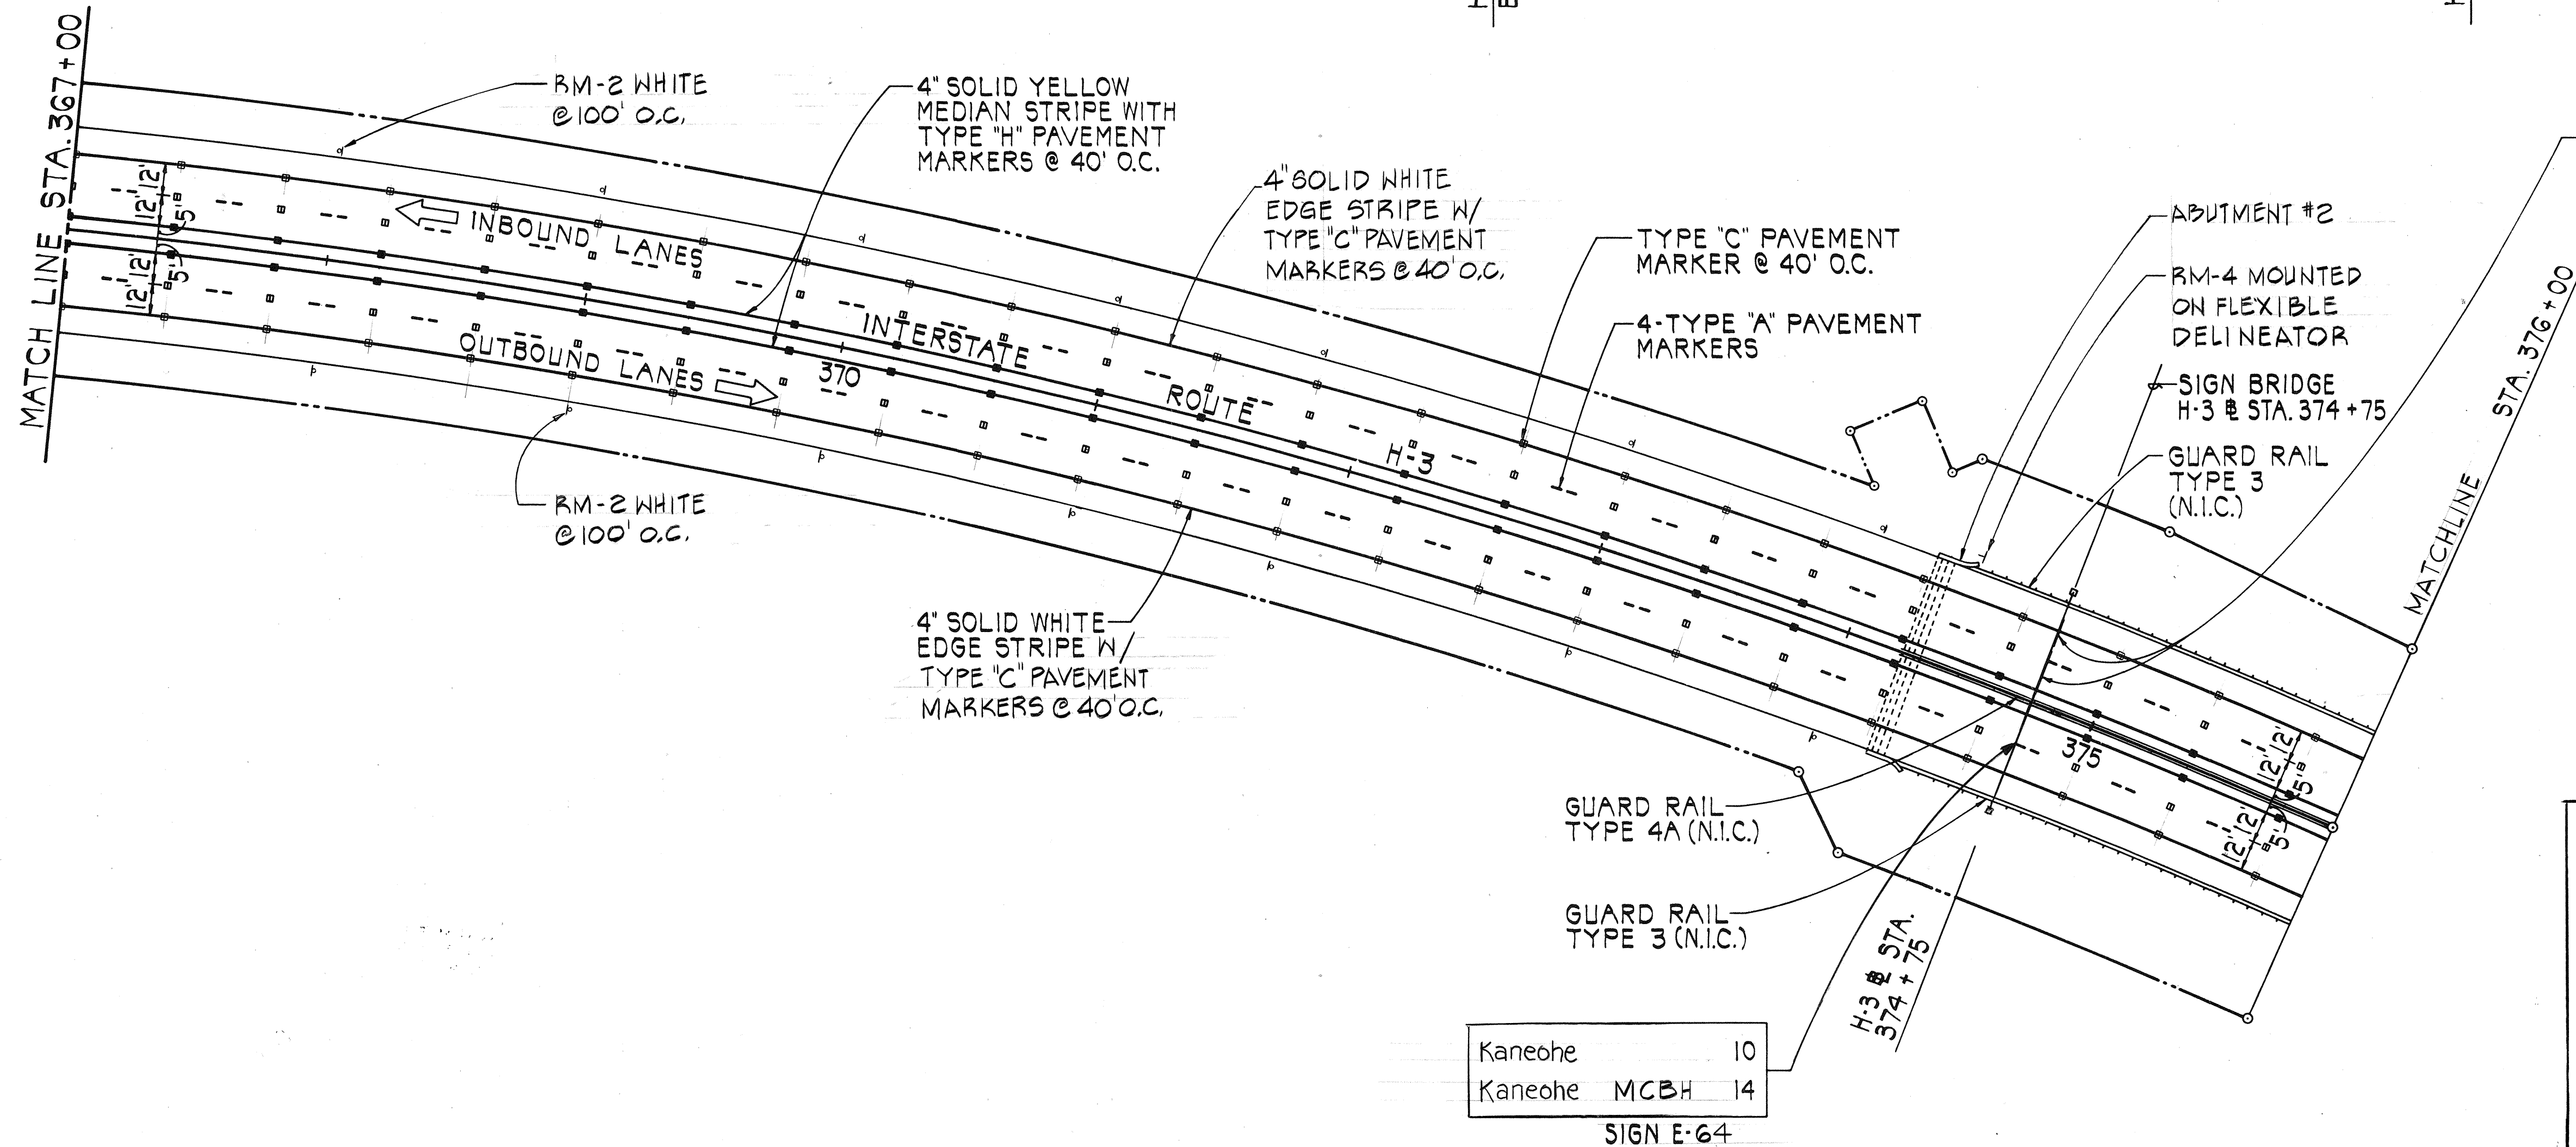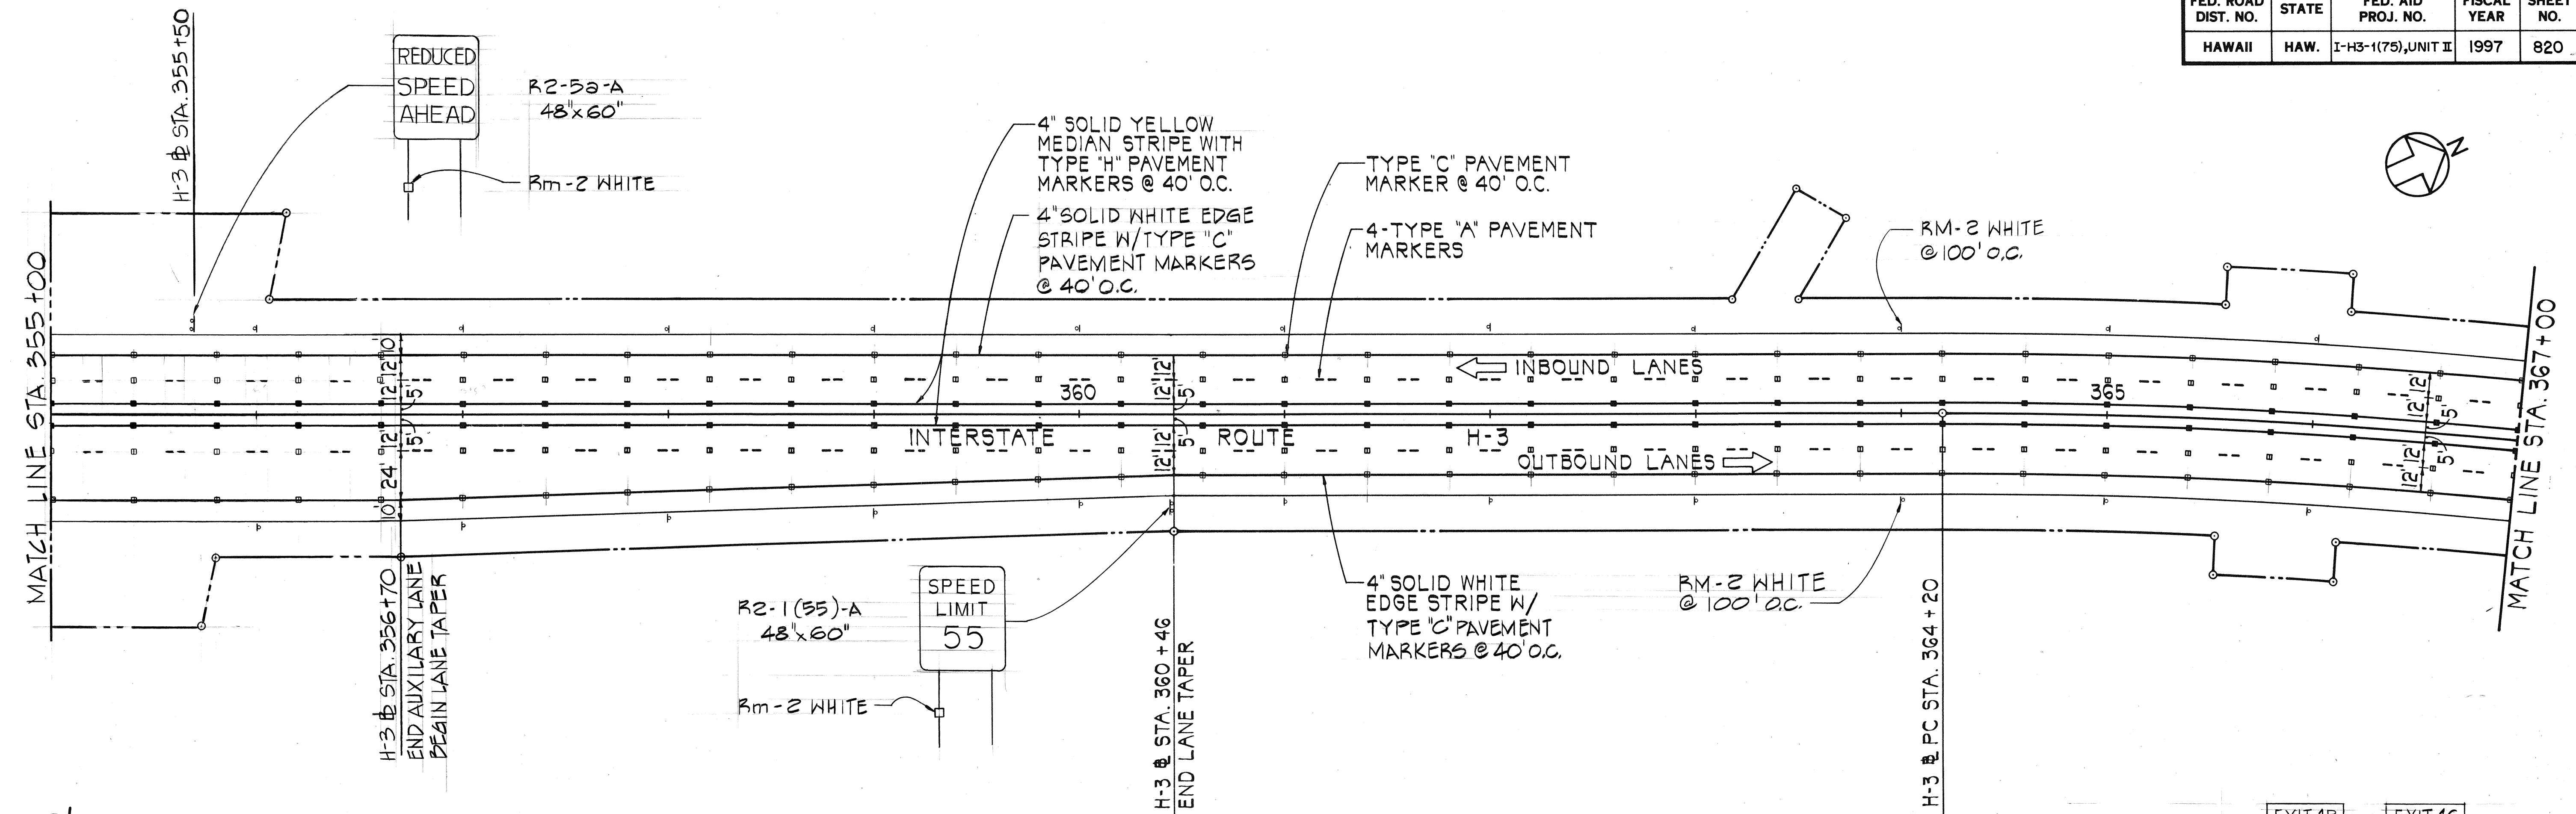

	EXIT 1B	EXIT 1C
 Pearl Harbor Pearl City Airport SIGN E-60L	EAST Honolulu 1 MILE SIGN E-60C	Stadium Halewā Aiea 1/2 MILE SIGN E-60R

THIS WORK WAS PREPARED BY ME OR UNDER MY SUPERVISION
Ronald M. Uemura
1/18/97

STATE OF HAWAII
DEPARTMENT OF TRANSPORTATION
HIGHWAYS DIVISION

SIGNING & PAVEMENT MARKINGS

MAKAI QUARRY VIADUCT

STA. 355+00 TO STA. 376+00

H-3 FINISH (UNIT II)
FAIP NO. I-H3-1(75), UNIT II
LEEWARD SECTION

SCALE: 1" = 40' DATE: JAN. 1997

SHEET NO. 4P3 OF 3 SHEETS

Kaneohe	10
Kaneohe MCBH	14
SIGN E-64	

SURVEY PLOTTED BY	DATE
DRAWN BY	
CHECKED BY	
NOTE BOOK	
QUANTITIES BY	
CHECKED BY	
NO.	

ABBREVIATIONS:

HL = HIGHWAY LIGHTING CONDUCTORS
hl = EXISTING HIGHWAY LIGHTING CONDUCTORS
C = COMMUNICATIONS CABLES
c = EXISTING COMMUNICATIONS CABLES
e = EXISTING HECO PRIMARY CABLES
t = EXISTING HECO CABLES
CKTS = CIRCUITS
GND = GROUND CONDUCTOR

ELECTRICAL SYMBOLS:

[Symbol] EXISTING HIGHWAY LIGHTING PULL BOX, IN GRADE

[Symbol] EXISTING COMMUNICATION PULL BOX, IN GRADE

[Symbol] EXISTING HIGHWAY LIGHTING METAL STANDARD, BRACKET ARM AND LUMINAIRE

[Symbol] RELOCATED HIGHWAY LIGHTING METAL STANDARD, BRACKET ARM AND LUMINAIRE MOUNTED ON NEW CONCRETE BASE

[Symbol] EXISTING UNDERGROUND DUCT WITH EXISTING WIRES, "EXISTING HIGHWAY LIGHT DUCT AND CONDUCTORS" INDICATED


[Symbol] UNDERGROUND DUCT WITH HIGHWAY LIGHTING CONDUCTORS

[Symbol] DUCT SECTION INDICATOR, "SEE DUCT SECTION 'A'" INDICATED, SEE DETAIL ON THIS SHEET


GENERAL NOTES:

- PAYMENT FOR THE ACCEPTED HIGHWAY LIGHTING SYSTEM WILL BE MADE ACCORDING TO "SECTION 622-HIGHWAY LIGHTING SYSTEM" OF THE SPECIAL PROVISIONS, PROPOSAL CONTRACT AND BOND OF THE PROJECT.
- ALL HIGHWAY LIGHTING DUCT MAINS TO BE 3 INCH SCHEDULE 40 PVC DUCTS ENCASED IN A 3" MINIMUM CLASS "B" CONCRETE JACKET.
- ALL HIGHWAY PULLBOX TO HIGHWAY LIGHTING CONCRETE FOUNDATION SHALL BE 2 INCH SCHEDULE 40 PVC DUCTS ENCASED IN A 3 INCH MINIMUM CLASS B CONCRETE JACKET.

FED. ROAD DIST. NO.	STATE	PROJ. NO.	FISCAL YEAR	SHEET NO.	TOTAL SHEETS
HAWAII	HAW.	1-H3-1(75) UNIT II	1997	C.O. 821	1102

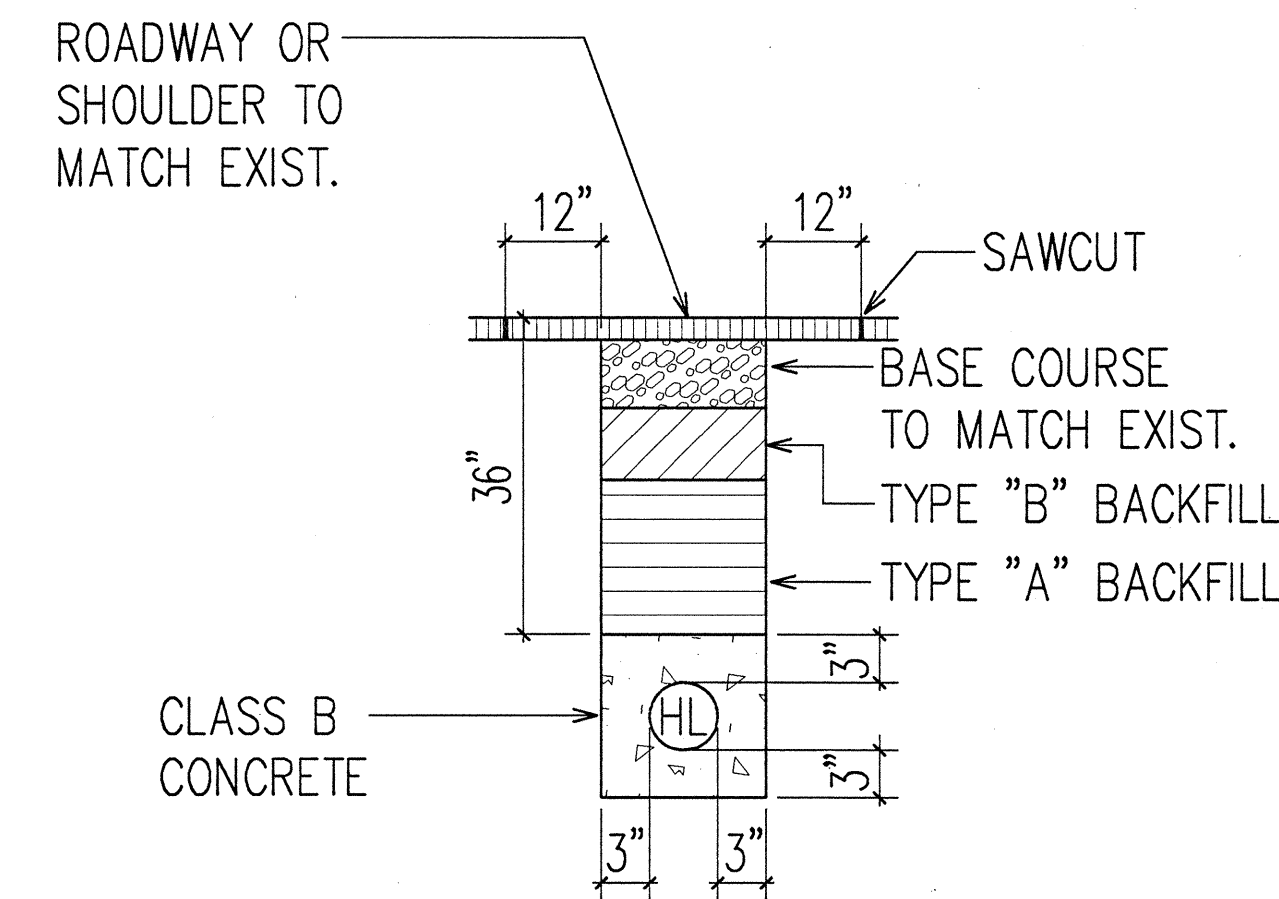

HIGHWAY LIGHTING DUCT SECTION "A"
N.T.S.

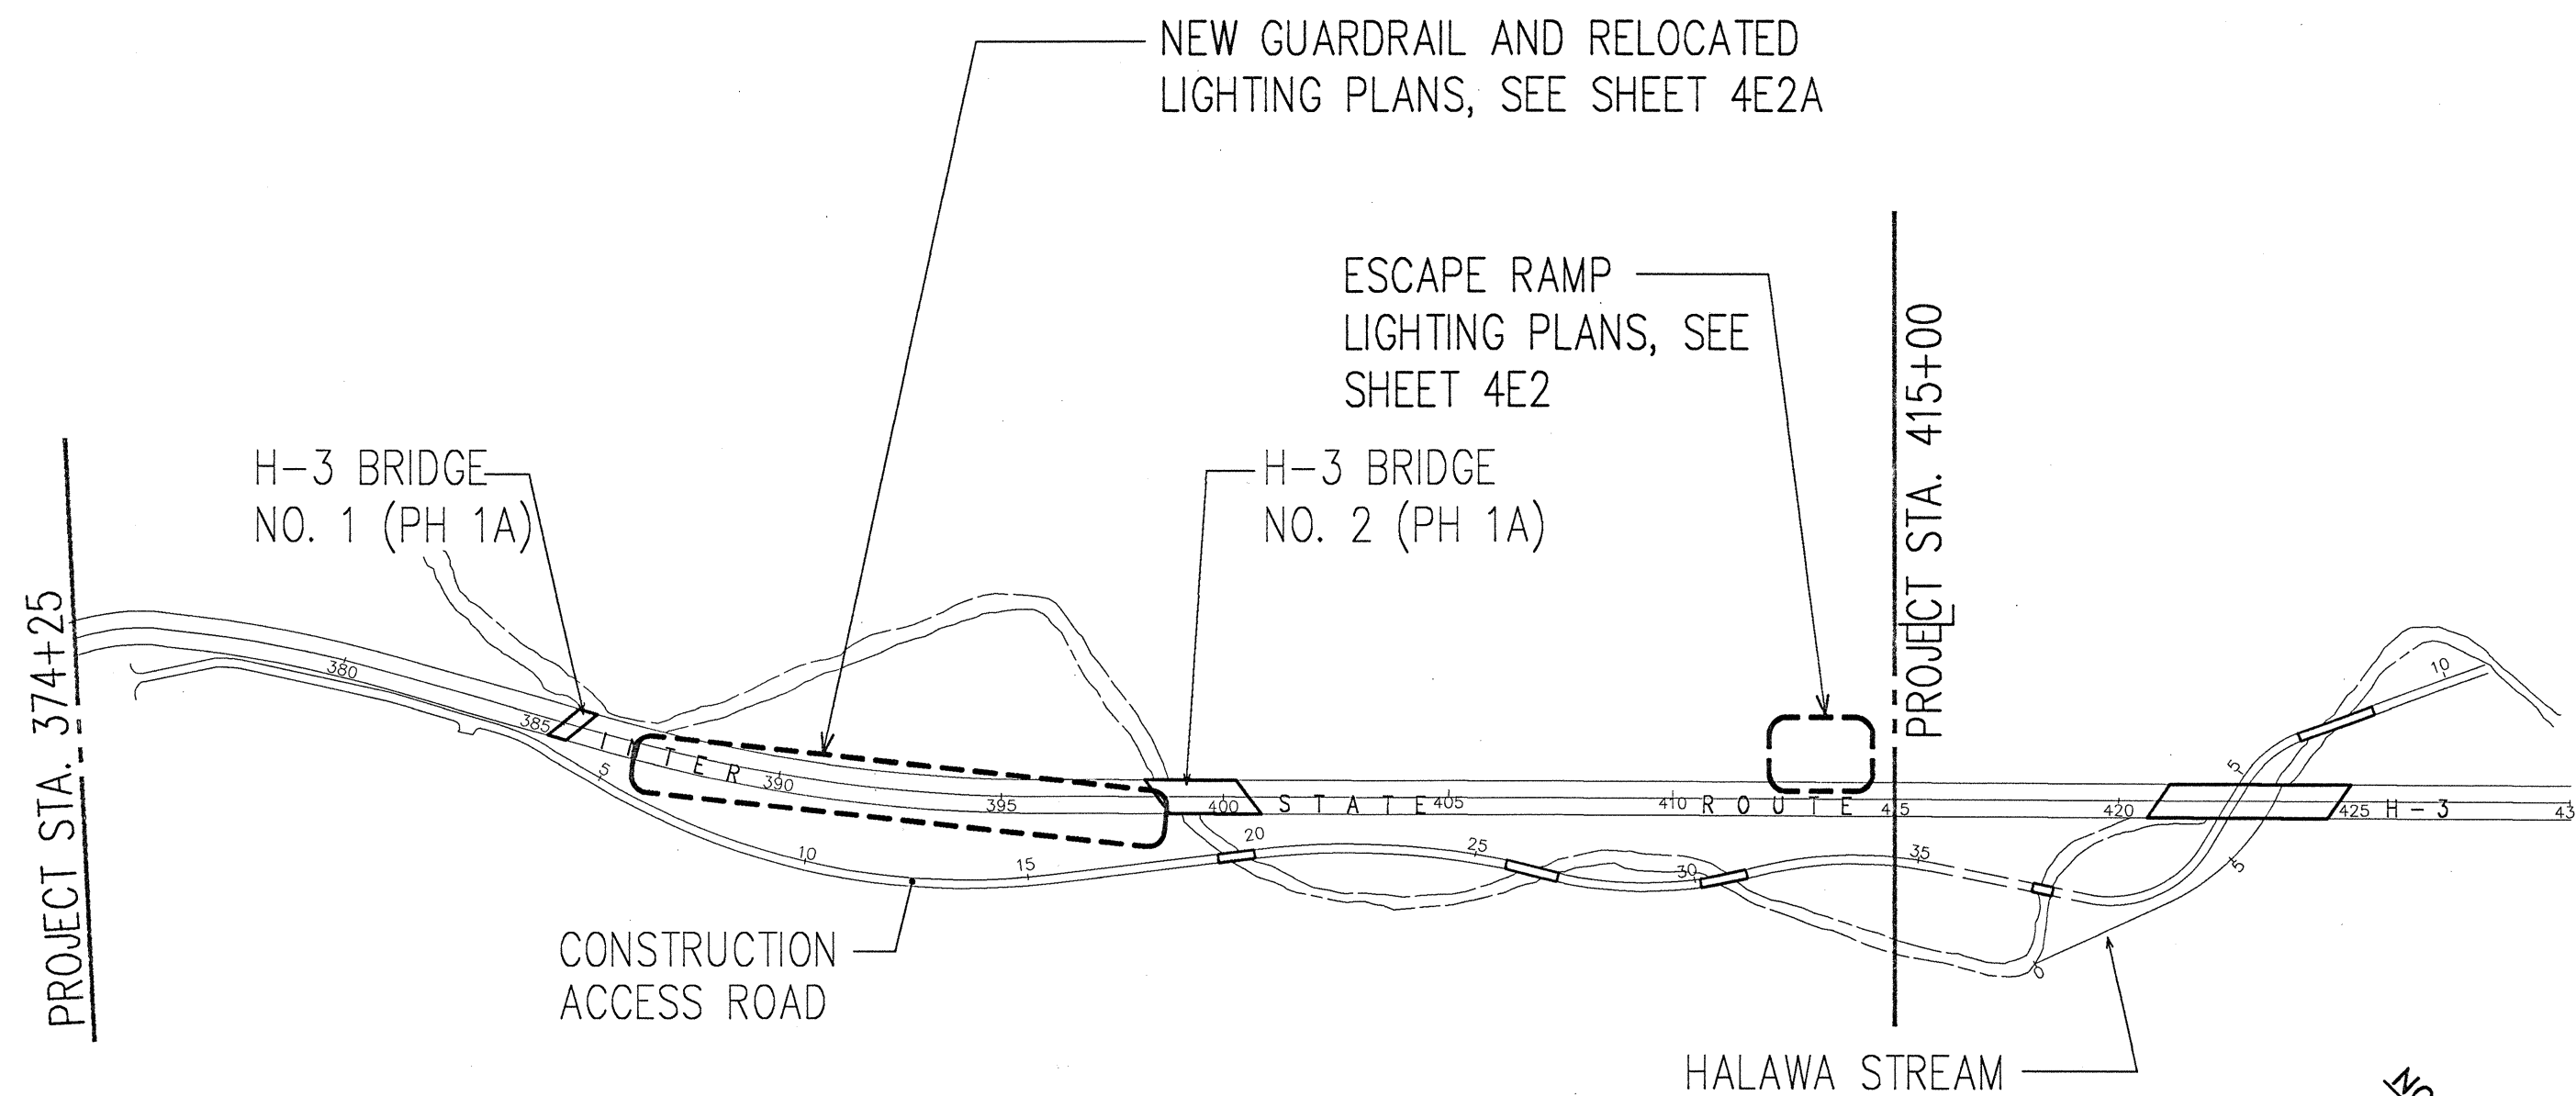


PROJECT LOCATION PLAN
N.T.S.




THIS WORK WAS PREPARED BY ME OR UNDER MY SUPERVISION.
Andrew I. Miyasato
RONALD N. S. HO & ASSOC., INC.
ELECTRICAL ENGINEERS

11/7/97	ADDED RELOCATED LIGHTING WORK
DATE	REVISION
STATE OF HAWAII DEPARTMENT OF TRANSPORTATION HIGHWAYS DIVISION NORTH HALAWA VALLEY ROADWAY CONSTRUCTION ELECTRICAL SYMBOLS, LOCATION MAP H-3 FINISH (UNIT II) FAIP NO. 1-H3-1(75), UNIT II LEEWARD SECTION SCALE: AS NOTED DATE: FEB. 1997 SHEET No. 4E1 OF 3 SHEETS	

FED. ROAD DIST. NO.	STATE	PROJ. NO.	FISCAL YEAR	SHEET NO.	TOTAL SHEETS
HAWAII	HAW.	I-H3-1(75) UNIT II	1997	C.O. 822 S-1	1102

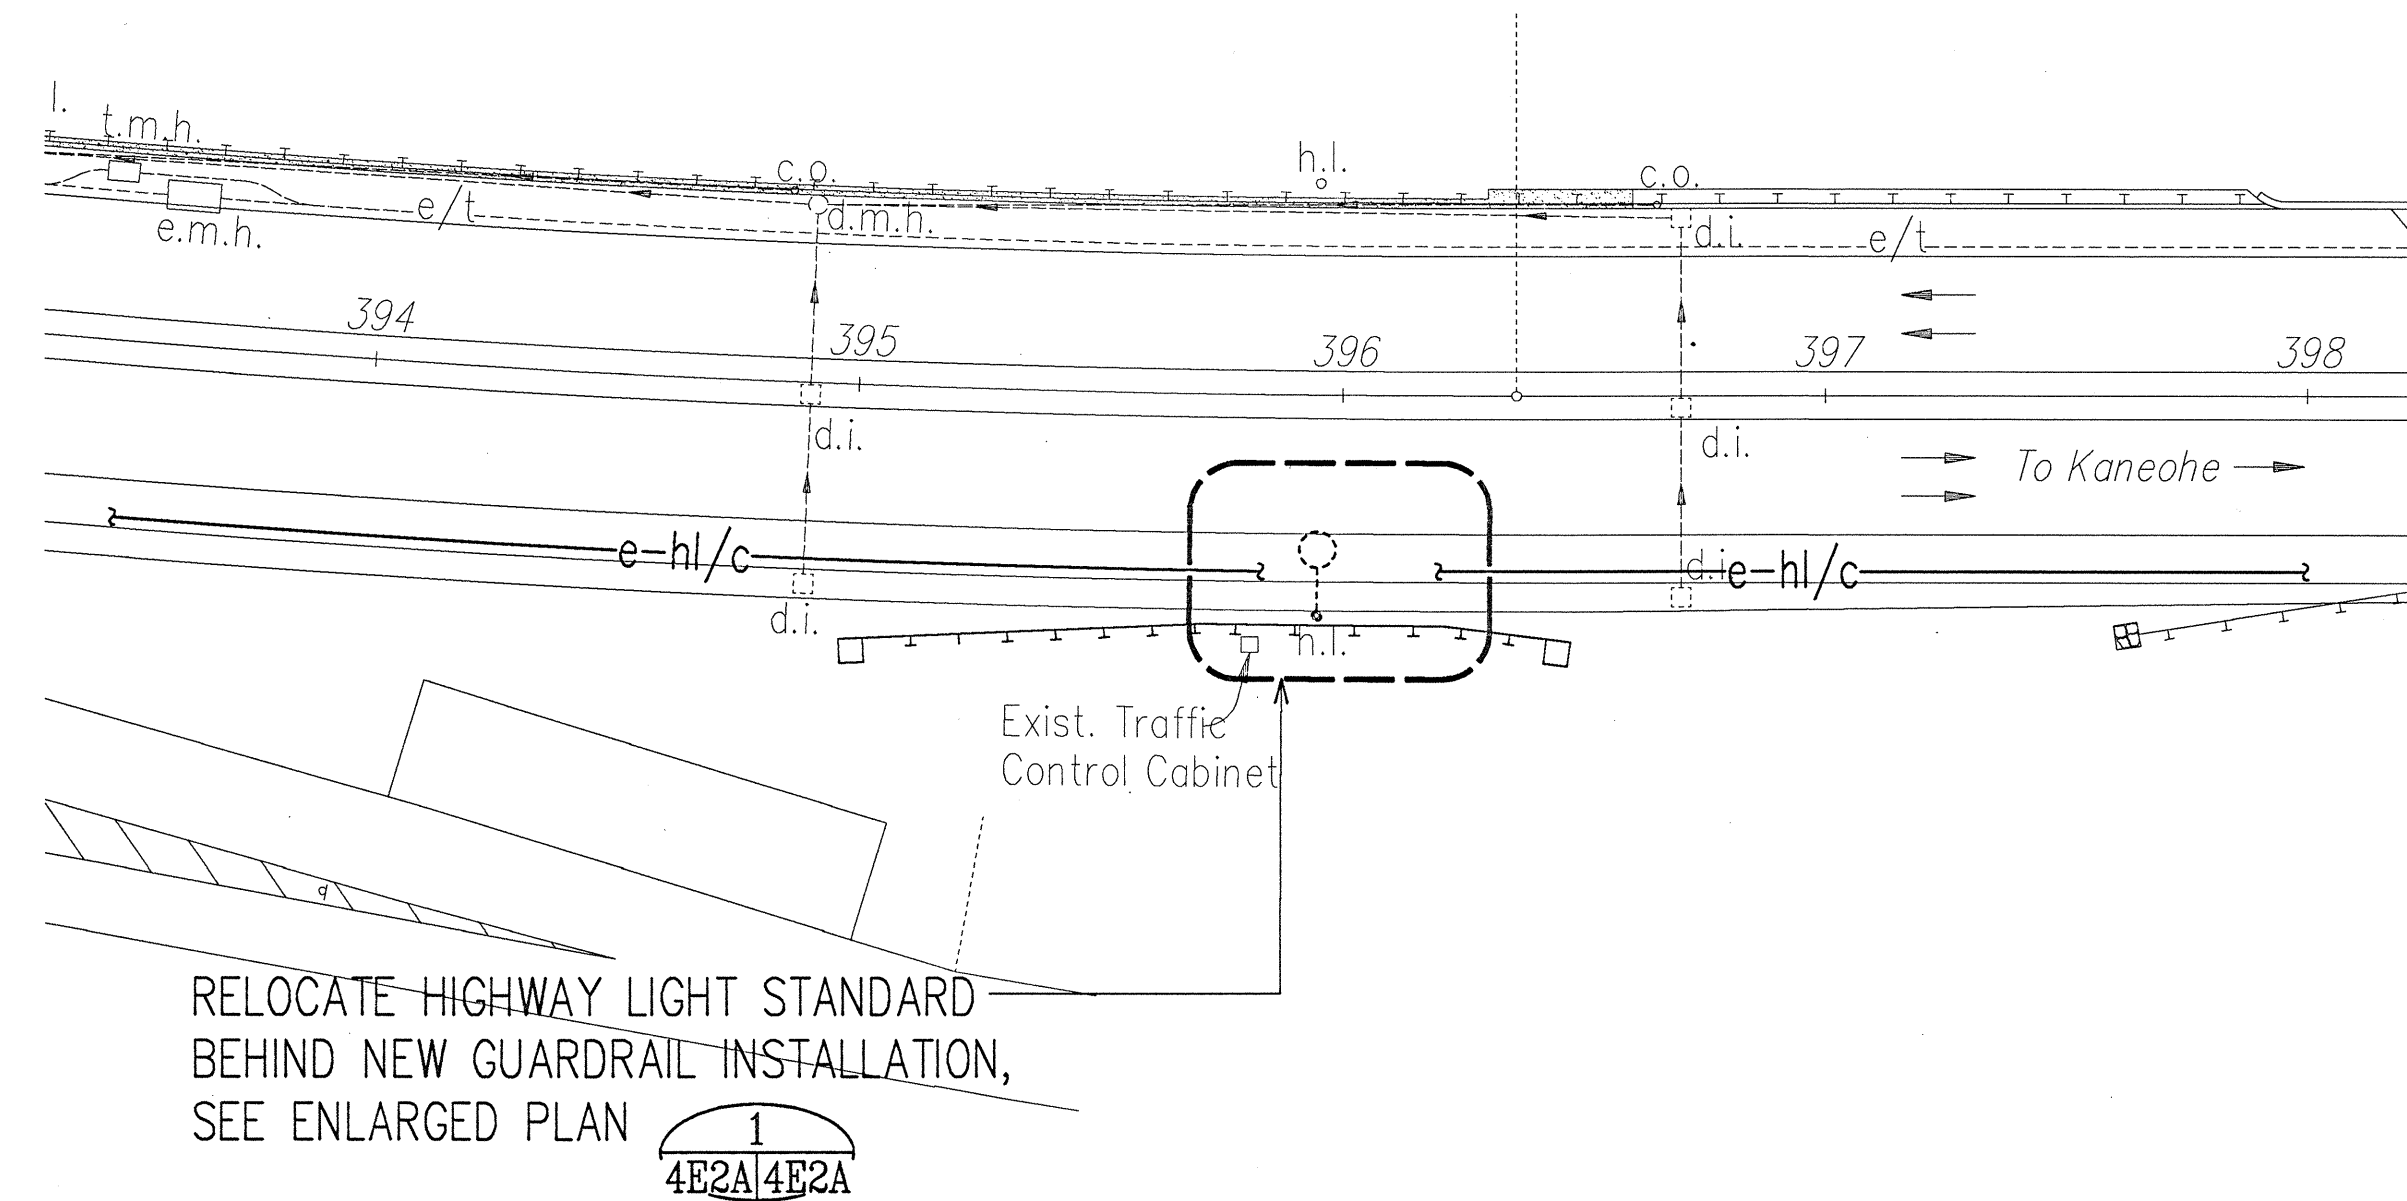


HIGHWAY LIGHTING RELOCATION PLAN
SCALE: 1"=40'


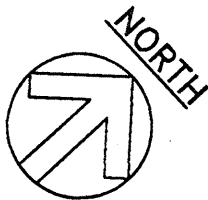


PLAN NOTES:

- 1 EXISTING HIGHWAY LIGHT STANDARD, BRACKET ARM AND LUMINAIRE TO BE RELOCATED. DEMOLISH AND REMOVE CONCRETE BASE AND ANCHOR BOLTS TO 12" BELOW GRADE.
- 2 REMOVE HIGHWAY LIGHT WIRES, ABANDON CONDUIT BELOW GRADE.
- 3 RELOCATED EXISTING HIGHWAY LIGHT STANDARD, BRACKET ARM, AND LUMINAIRE ONTO NEW CONCRETE BASE, SEE DETAIL 4 4E2A/4E3
- 4 PROVIDE 2" CONDUIT, 2#6, 1#8 GROUND FROM EXISTING HIGHWAY LIGHT PULLBOX TO THE RELOCATED HIGHWAY LIGHT STANDARD, SEE DETAIL 5 4E2A/4E3

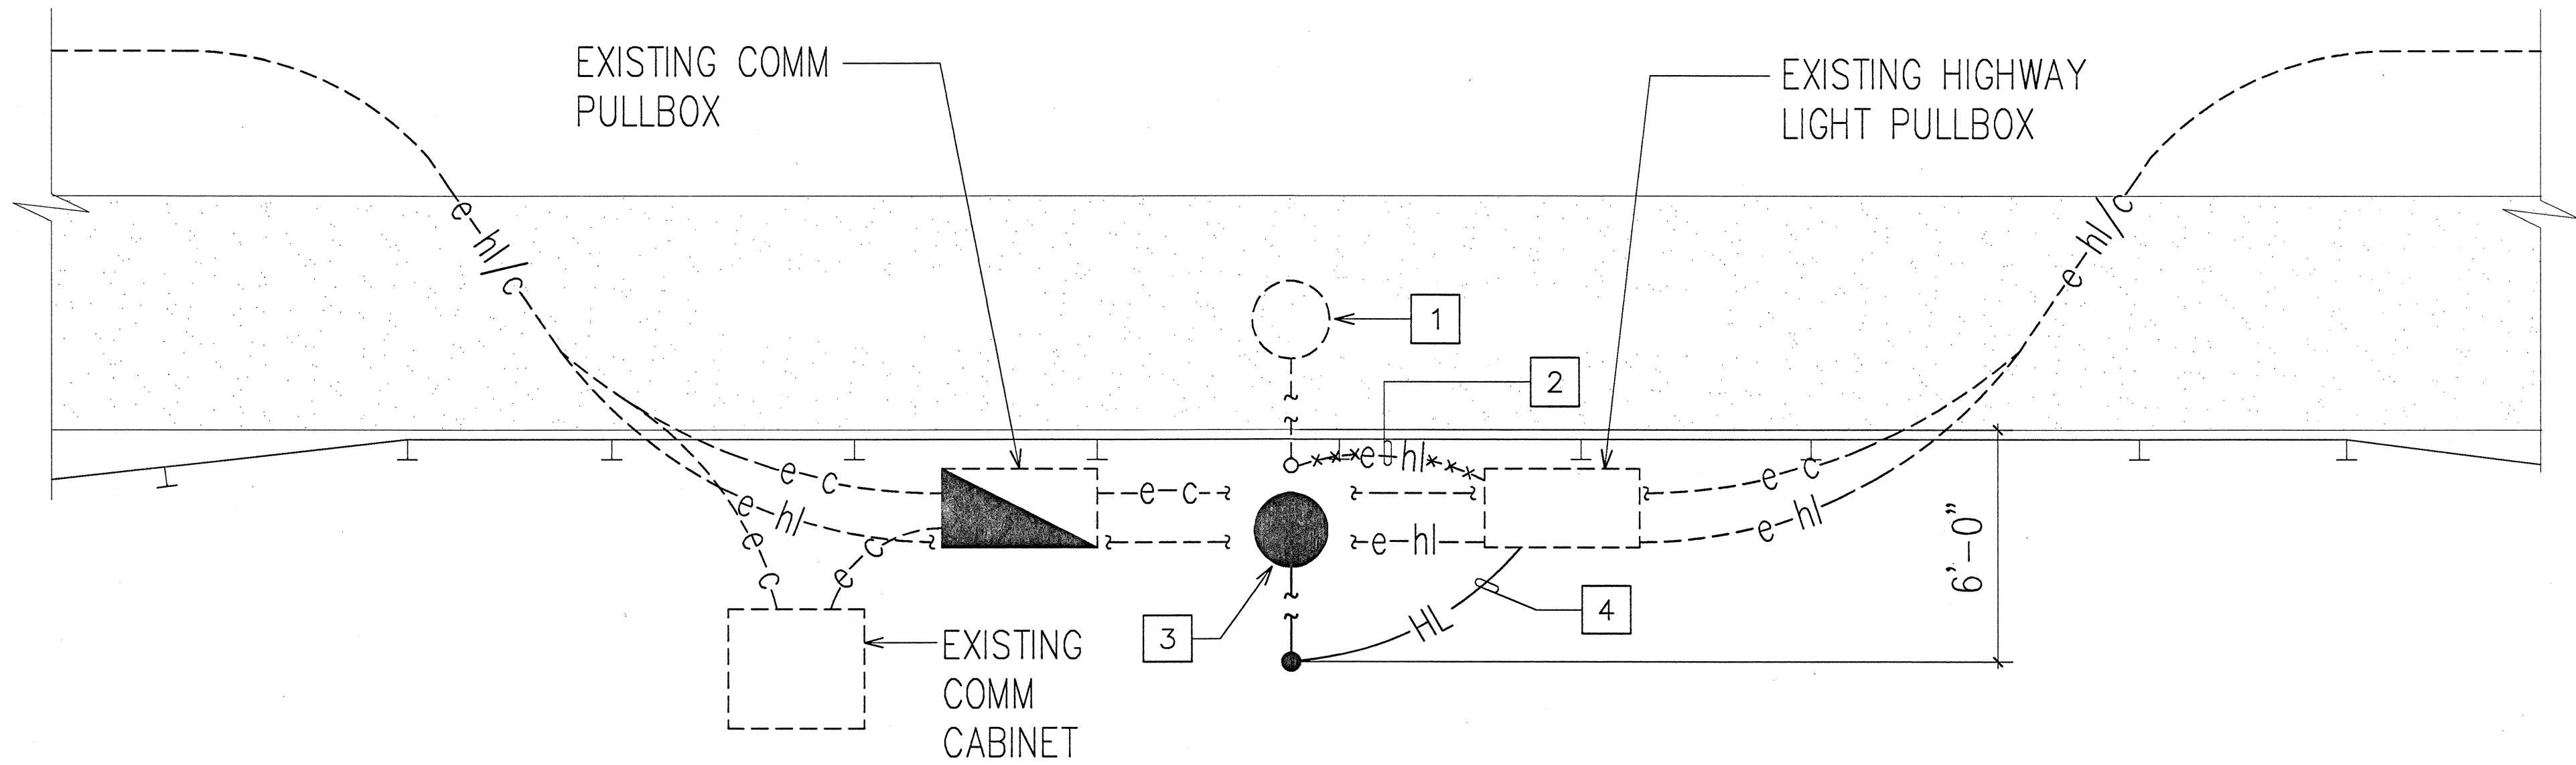

1 HIGHWAY LIGHT STANDARD RELOCATION PLAN
4E2A/4E2A NOT TO SCALE

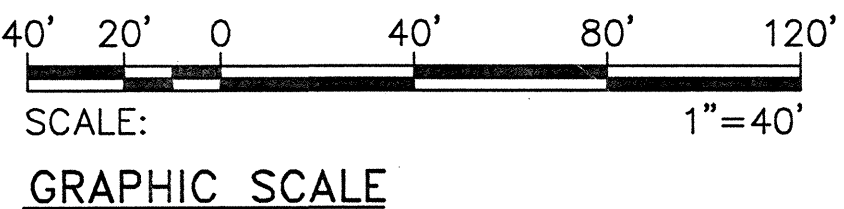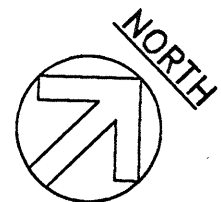

THIS WORK WAS PREPARED BY ME OR UNDER MY SUPERVISION.
Andrew I. Miyasato
RONALD N. S. HO & ASSOC., INC.
ELECTRICAL ENGINEERS

11/7/97	ADDED NEW SHEET FOR ADDITIONAL AREA OF LIGHTING MODIFICATION WORK
DATE	REVISION
STATE OF HAWAII DEPARTMENT OF TRANSPORTATION HIGHWAYS DIVISION NORTH HALAWA VALLEY ROADWAY CONSTRUCTION HIGHWAY LIGHTING RELOCATION PLANS H-3 FINISH (UNIT II) FAIP NO. I-H3-1(75), UNIT II LEEWARD SECTION SCALE: AS NOTED DATE: FEB. 1997 SHEET No. 4E2A OF 3 SHEETS	

ORIGINAL PLAN	SURVEY PLOTTED BY	DATE
NOTE BOOK	DRAWN BY	
	TRACED BY	
	DESIGNED BY	
	QUANTITIES BY	
No.	CHECKED BY	

17 0 08:06:26 BY: AM PLOT SC 1/A "3"
 93002A93002B102B21.3A XREFS: XREFD72




- 1 EXISTING HIGHWAY LIGHT STANDARD, BRACKET ARM AND LUMINAIRE TO BE RELOCATED. DEMOLISH AND REMOVE CONCRETE BASE AND ANCHOR BOLTS TO 12" BELOW GRADE.
- 2 REMOVE HIGHWAY LIGHT WIRES, ABANDON CONDUIT BELOW GRADE.
- 3 RELOCATED EXISTING HIGHWAY LIGHT STANDARD, BRACKET ARM, AND LUMINAIRE ONTO NEW CONCRETE BASE, SEE DETAIL
- 4 PROVIDE 2" CONDUIT, 2#6, 1#8 GROUND FROM EXISTING HIGHWAY LIGHT PULLBOX TO THE RELOCATED HIGHWAY LIGHT STANDARD, SEE DETAIL



THIS WORK WAS PREPARED BY ME
OR UNDER MY SUPERVISION.
Andrew J. Miyasaka
RONALD N. S. HO & ASSOC., INC.
ELECTRICAL ENGINEERS


FED. ROAD DIST. NO.	STATE	PROJ. NO.	FISCAL YEAR	SHEET NO.	TOTAL SHEETS
HAWAII	HAW.	I-H3-1(75) UNIT II	1997	C.O. 822 S-3	1102

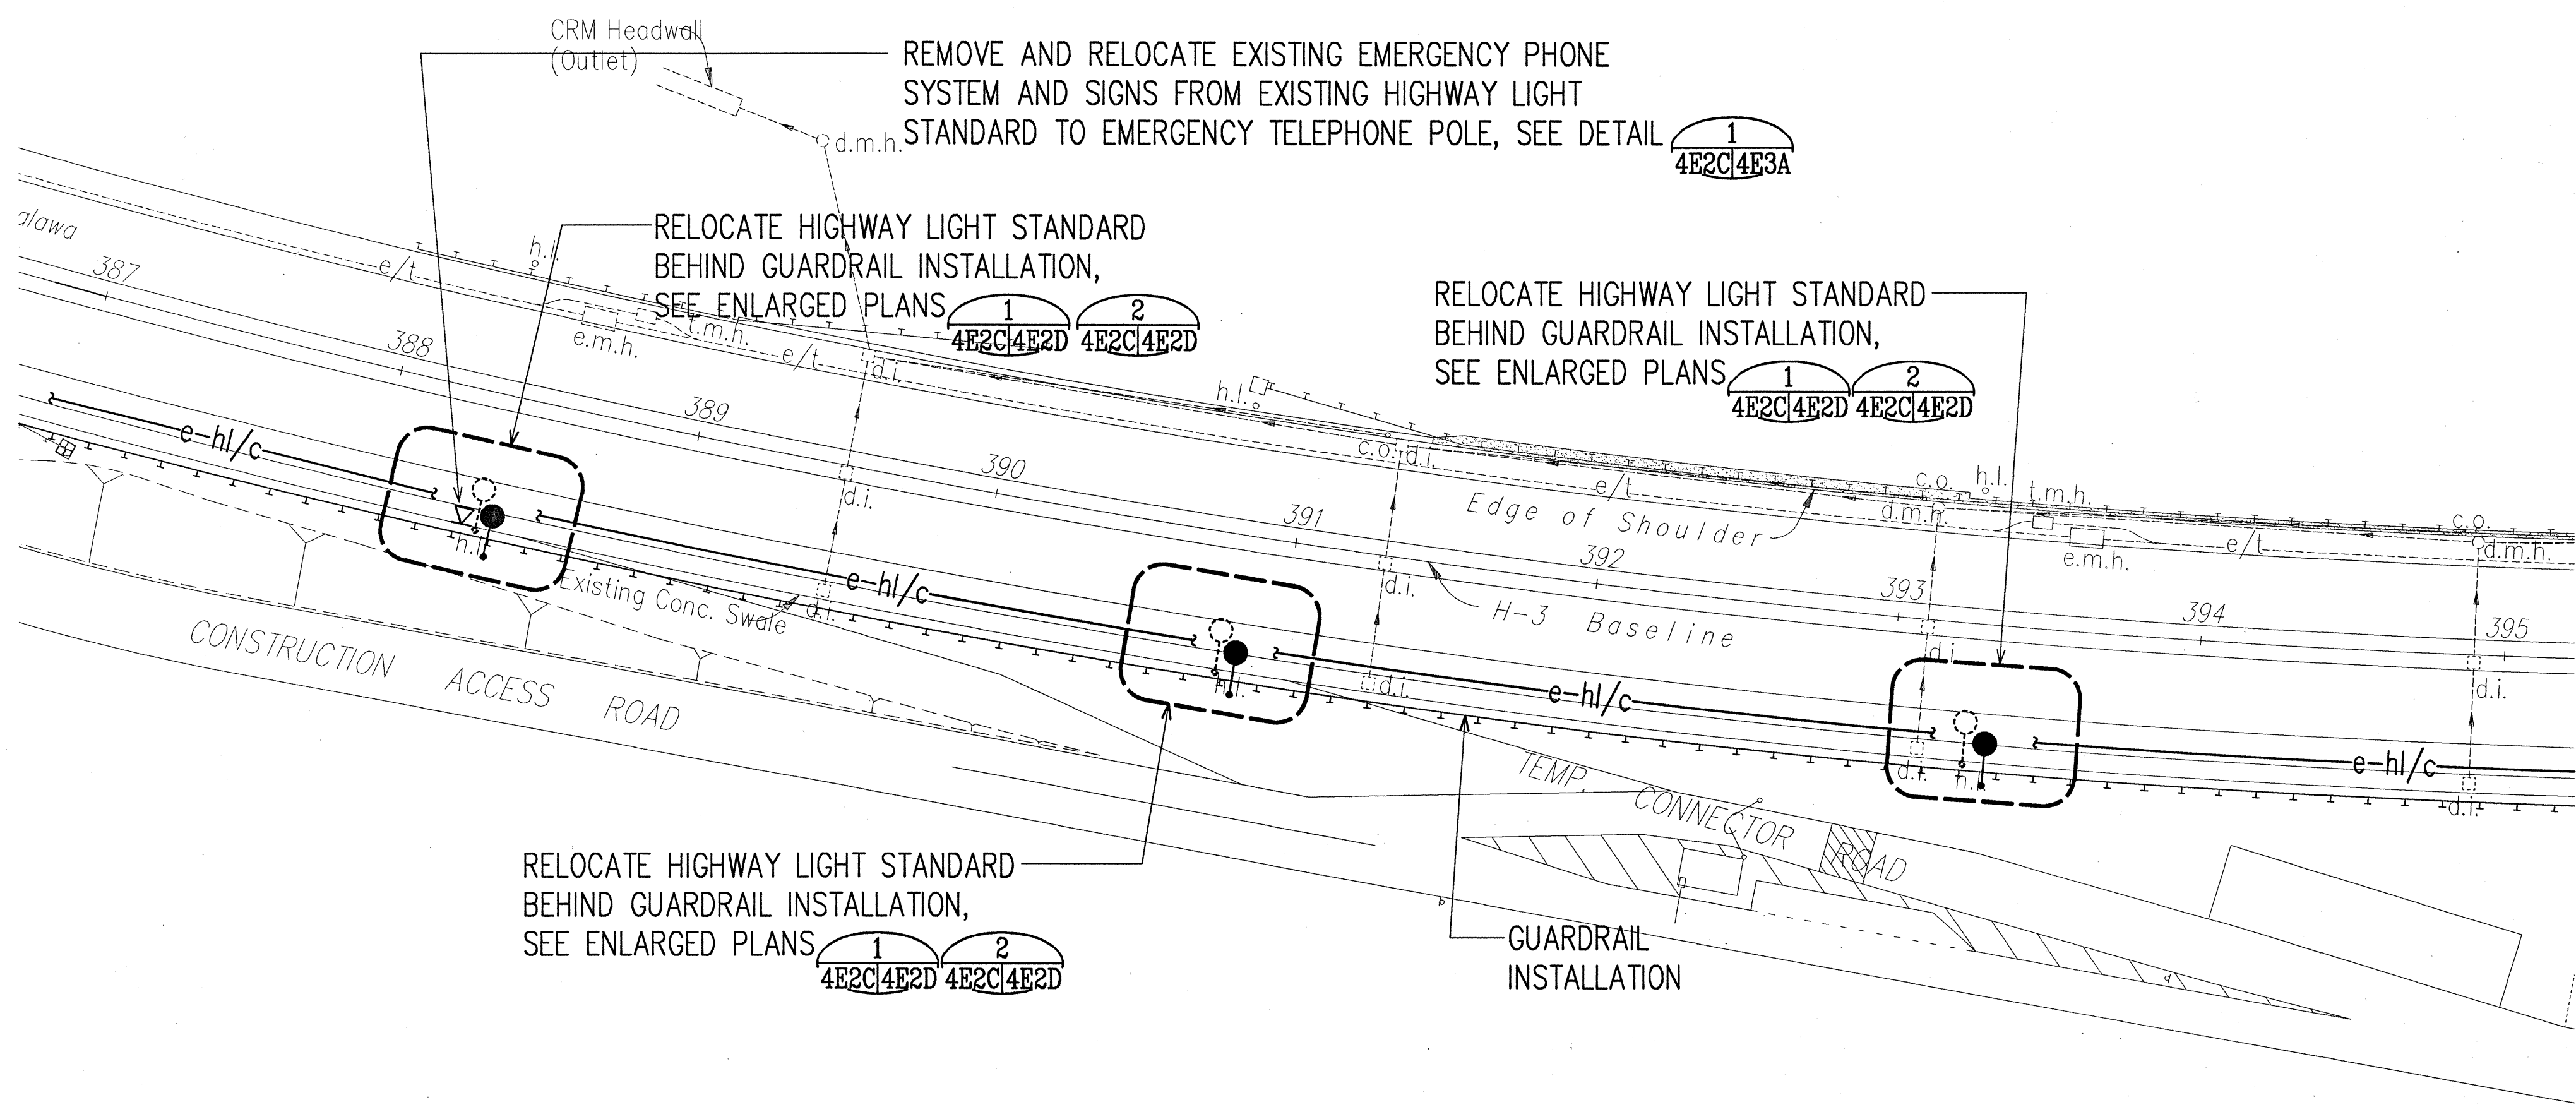

HIGHWAY LIGHTING RELOCATION PLAN
 SCALE: 1"=40'

ORIGINAL PLAN	SURVEY PLOTTED BY	DATE
NOTE BOOK	DRAWN BY	
	TRACED BY	
	QUANTITIES BY	
	CHECKED BY	
	NO.	

LAST SAVE: 02/27/98 @ 13:35:45 BY: AM PLOT \$5.1=-0
 C:\ADWD\PROJECTS\GENERAL\95009\95009\$3002802\028P128.XREFS.XREFPLAN

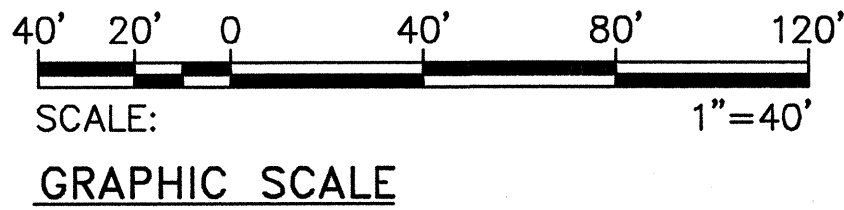

THIS WORK WAS PREPARED BY ME OR UNDER MY SUPERVISION.
Andrew I. Miyasato
 2/27/98
 RONALD W. S. HO & ASSOC., INC.
 ELECTRICAL ENGINEERS

3/3/98 ADDED NEW SHEET FOR ADDITIONAL AREA OF LIGHTING MODIFICATION WORK

DATE REVISION

STATE OF HAWAII
 DEPARTMENT OF TRANSPORTATION
 HIGHWAYS DIVISION

**NORTH HALAWA VALLEY
 ROADWAY CONSTRUCTION**

HIGHWAY LIGHTING RELOCATION WORK

H-3 FINISH (UNIT II)

FAIP NO. I-H3-1(75), UNIT II

LEEWARD SECTION


SCALE: AS NOTED

DATE: FEB. 1998


SHEET No. 4E2C OF 3 SHEETS

C.O. 822 S-3

FED. ROAD DIST. NO.	STATE	PROJ. NO.	FISCAL YEAR	SHEET NO.	TOTAL SHEETS
HAWAII	HAW.	I-H3-1(75) UNIT II	1997	C.O. 822 S-4	1102

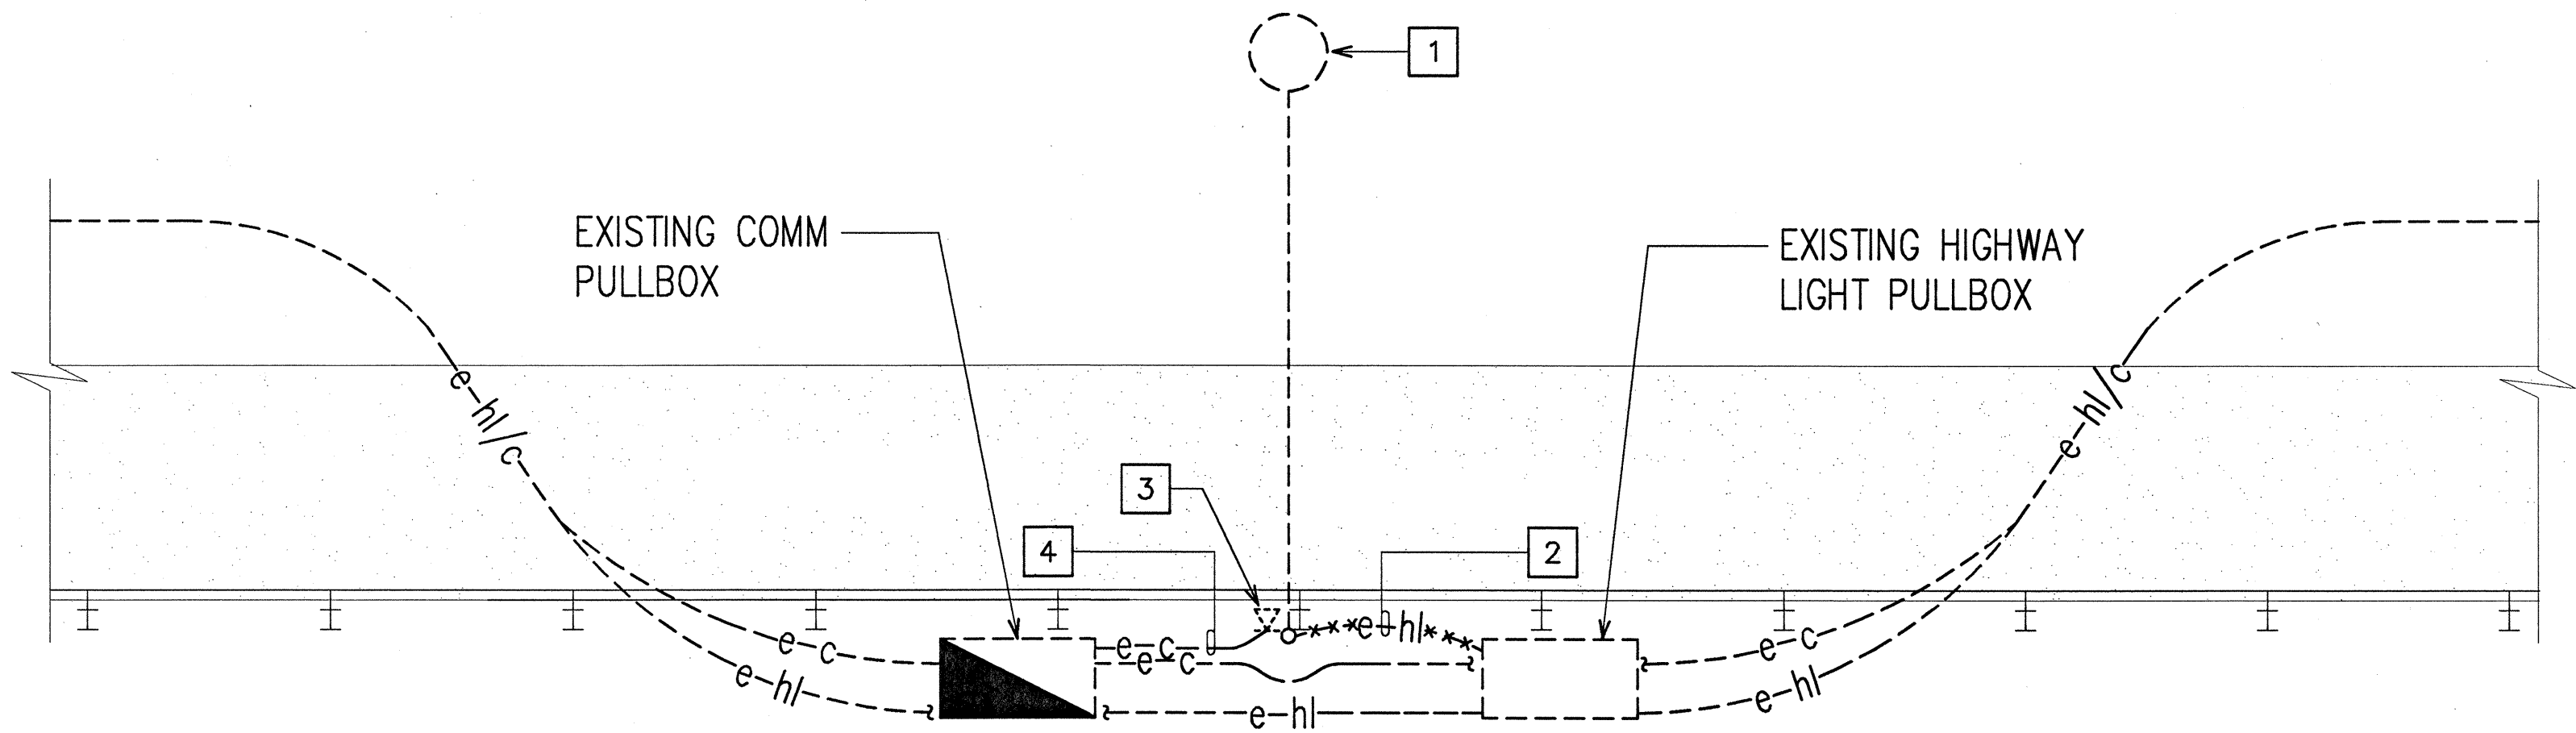

1 TYPICAL HIGHWAY LIGHT STANDARD RELOCATION PLAN I
4E2D/4E2D NOT TO SCALE

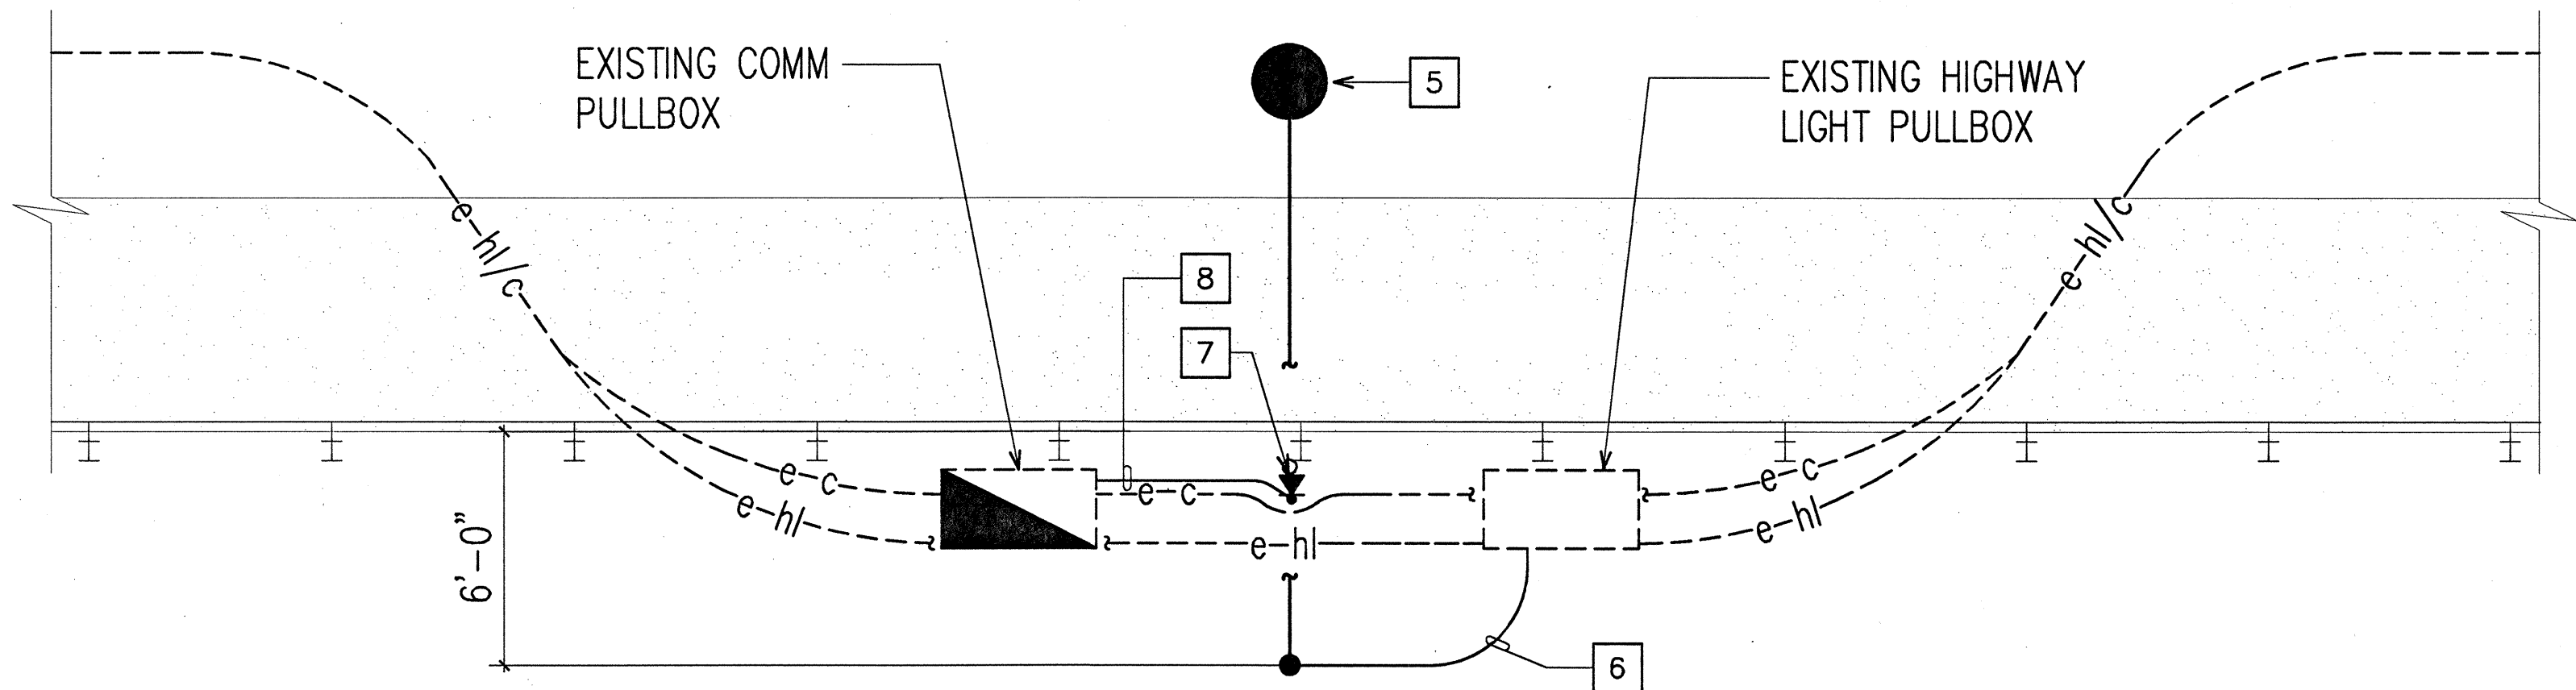

2 TYPICAL HIGHWAY LIGHT STANDARD RELOCATION PLAN II
4E2C/4E2D NOT TO SCALE

PLAN NOTES:

- EXISTING HIGHWAY LIGHT STANDARD, BRACKET ARM AND LUMINAIRE TO BE RELOCATED. DEMOLISH AND REMOVE CONCRETE BASE AND ANCHOR BOLTS TO 12" BELOW GRADE.
- REMOVE HIGHWAY LIGHT WIRES, ABANDON CONDUIT BELOW GRADE.
- EXISTING EMERGENCY PHONE SYSTEM TO BE REMOVED AND RELOCATED ONTO NEW POLE. EXISTING EMERGENCY PHONE SYSTEM ONLY AT HIGHWAY LIGHT STANDARD LOCATION STA. 388+35.
- PULL OUT EXISTING WIRES AND REINSTALL NEW CONDUIT, AT NEW EMERGENCY PHONE LOCATION. BE CAREFUL NOT TO DAMAGE CABLE.
- RELOCATED EXISTING HIGHWAY LIGHT STANDARD, BRACKET ARM, AND LUMINAIRE ONTO NEW CONCRETE BASE, SEE DETAIL 4E2D/4E3
- PROVIDE 2" PVC, SCH 80 CONDUIT, 2#6, 1#8 GROUND FROM EXISTING HIGHWAY LIGHT PULLBOX TO THE RELOCATED HIGHWAY LIGHT STANDARD, SEE DETAIL 4E2D/4E3 EXISTING EMERGENCY PHONE SYSTEM ONLY AT HIGHWAY LIGHT STANDARD LOCATION STA. 388+35.
- RELOCATED EXISTING EMERGENCY PHONE SYSTEM ON NEW POLE, SEE DETAIL 4E2D/4E3A
- PROVIDE 1" RGS CONDUIT, AND REINSTALL EXISTING COMMUNICATION CABLE, AND RECONNECT TO EMERGENCY PHONE SYSTEM. TEST EMERGENCY PHONE SYSTEM TO INSURE PROPER OPERATION. SEE DETAIL 4E2D/4E3A

3/3/98 ADDED NEW SHEET FOR HIGHWAY LIGHT STANDARD DETAIL RELOCATION PLANS

DATE REVISION

STATE OF HAWAII
DEPARTMENT OF TRANSPORTATION
HIGHWAYS DIVISION

NORTH HALAWA VALLEY
ROADWAY CONSTRUCTION

HIGHWAY LIGHT RELOCATION PLANS

H-3 FINISH (UNIT II)

FAIP NO. I-H3-1(75), UNIT II

LEEWARD SECTION

SCALE: AS NOTED







DATE: FEB. 1998

SHEET No. 4E2D OF 3 SHEETS



THIS WORK WAS PREPARED BY ME
OR UNDER MY SUPERVISION.
Andrew I. Miyasato
2/27/98
RONALD B. S. HO & ASSOC., INC.
ELECTRICAL ENGINEERS



FED. ROAD DIST. NO.	STATE	PROJ. NO.	FISCAL YEAR	SHEET NO.	TOTAL SHEETS
HAWAII	HAW.	1-H3-1(75) UNIT II	1997	C.O. 823	1102

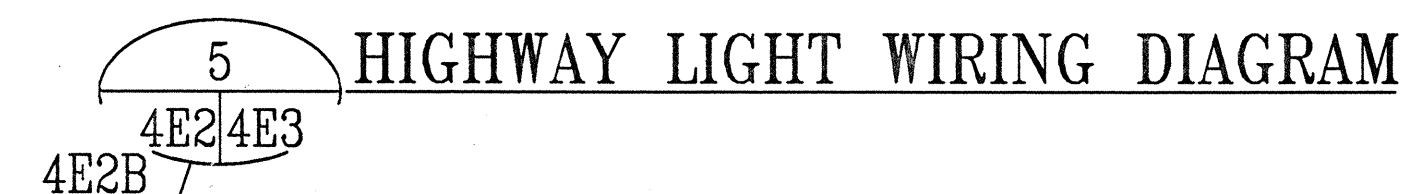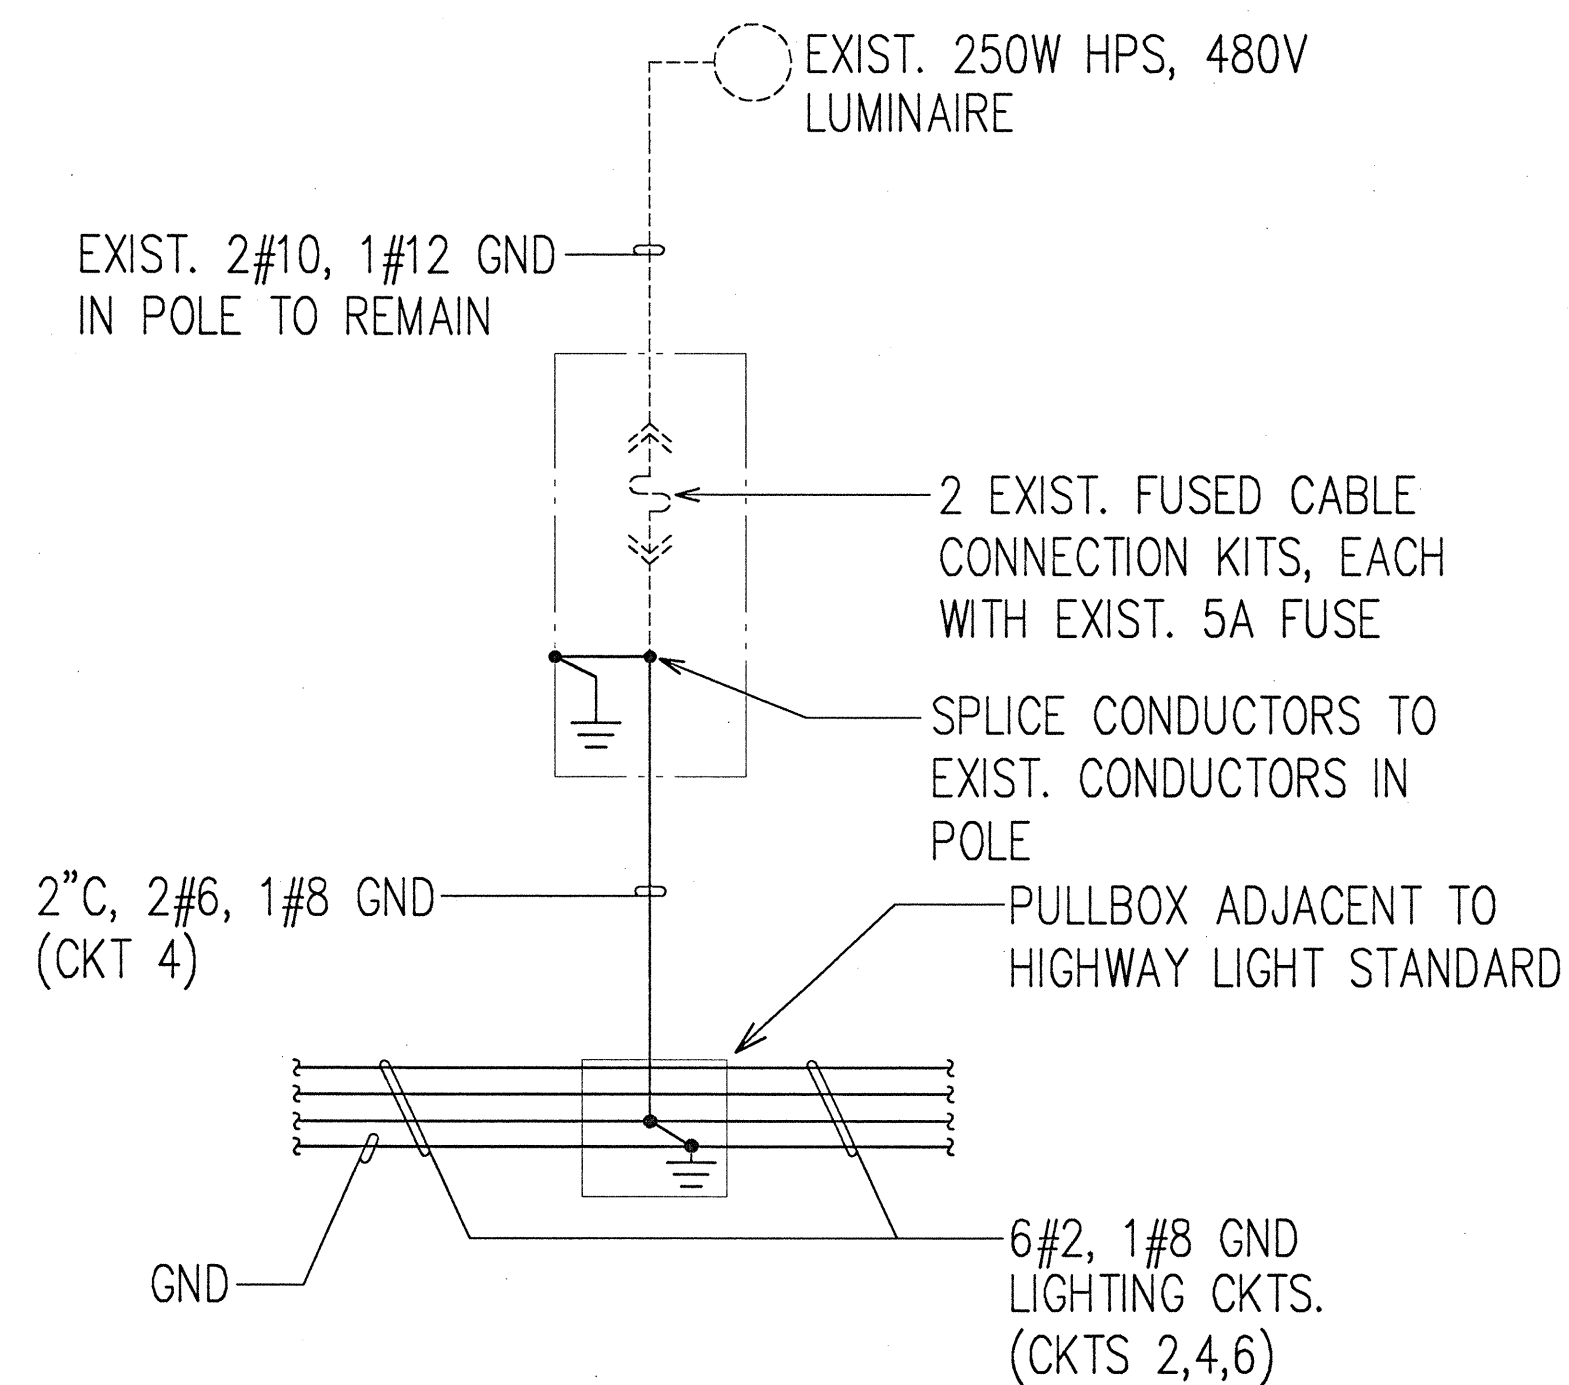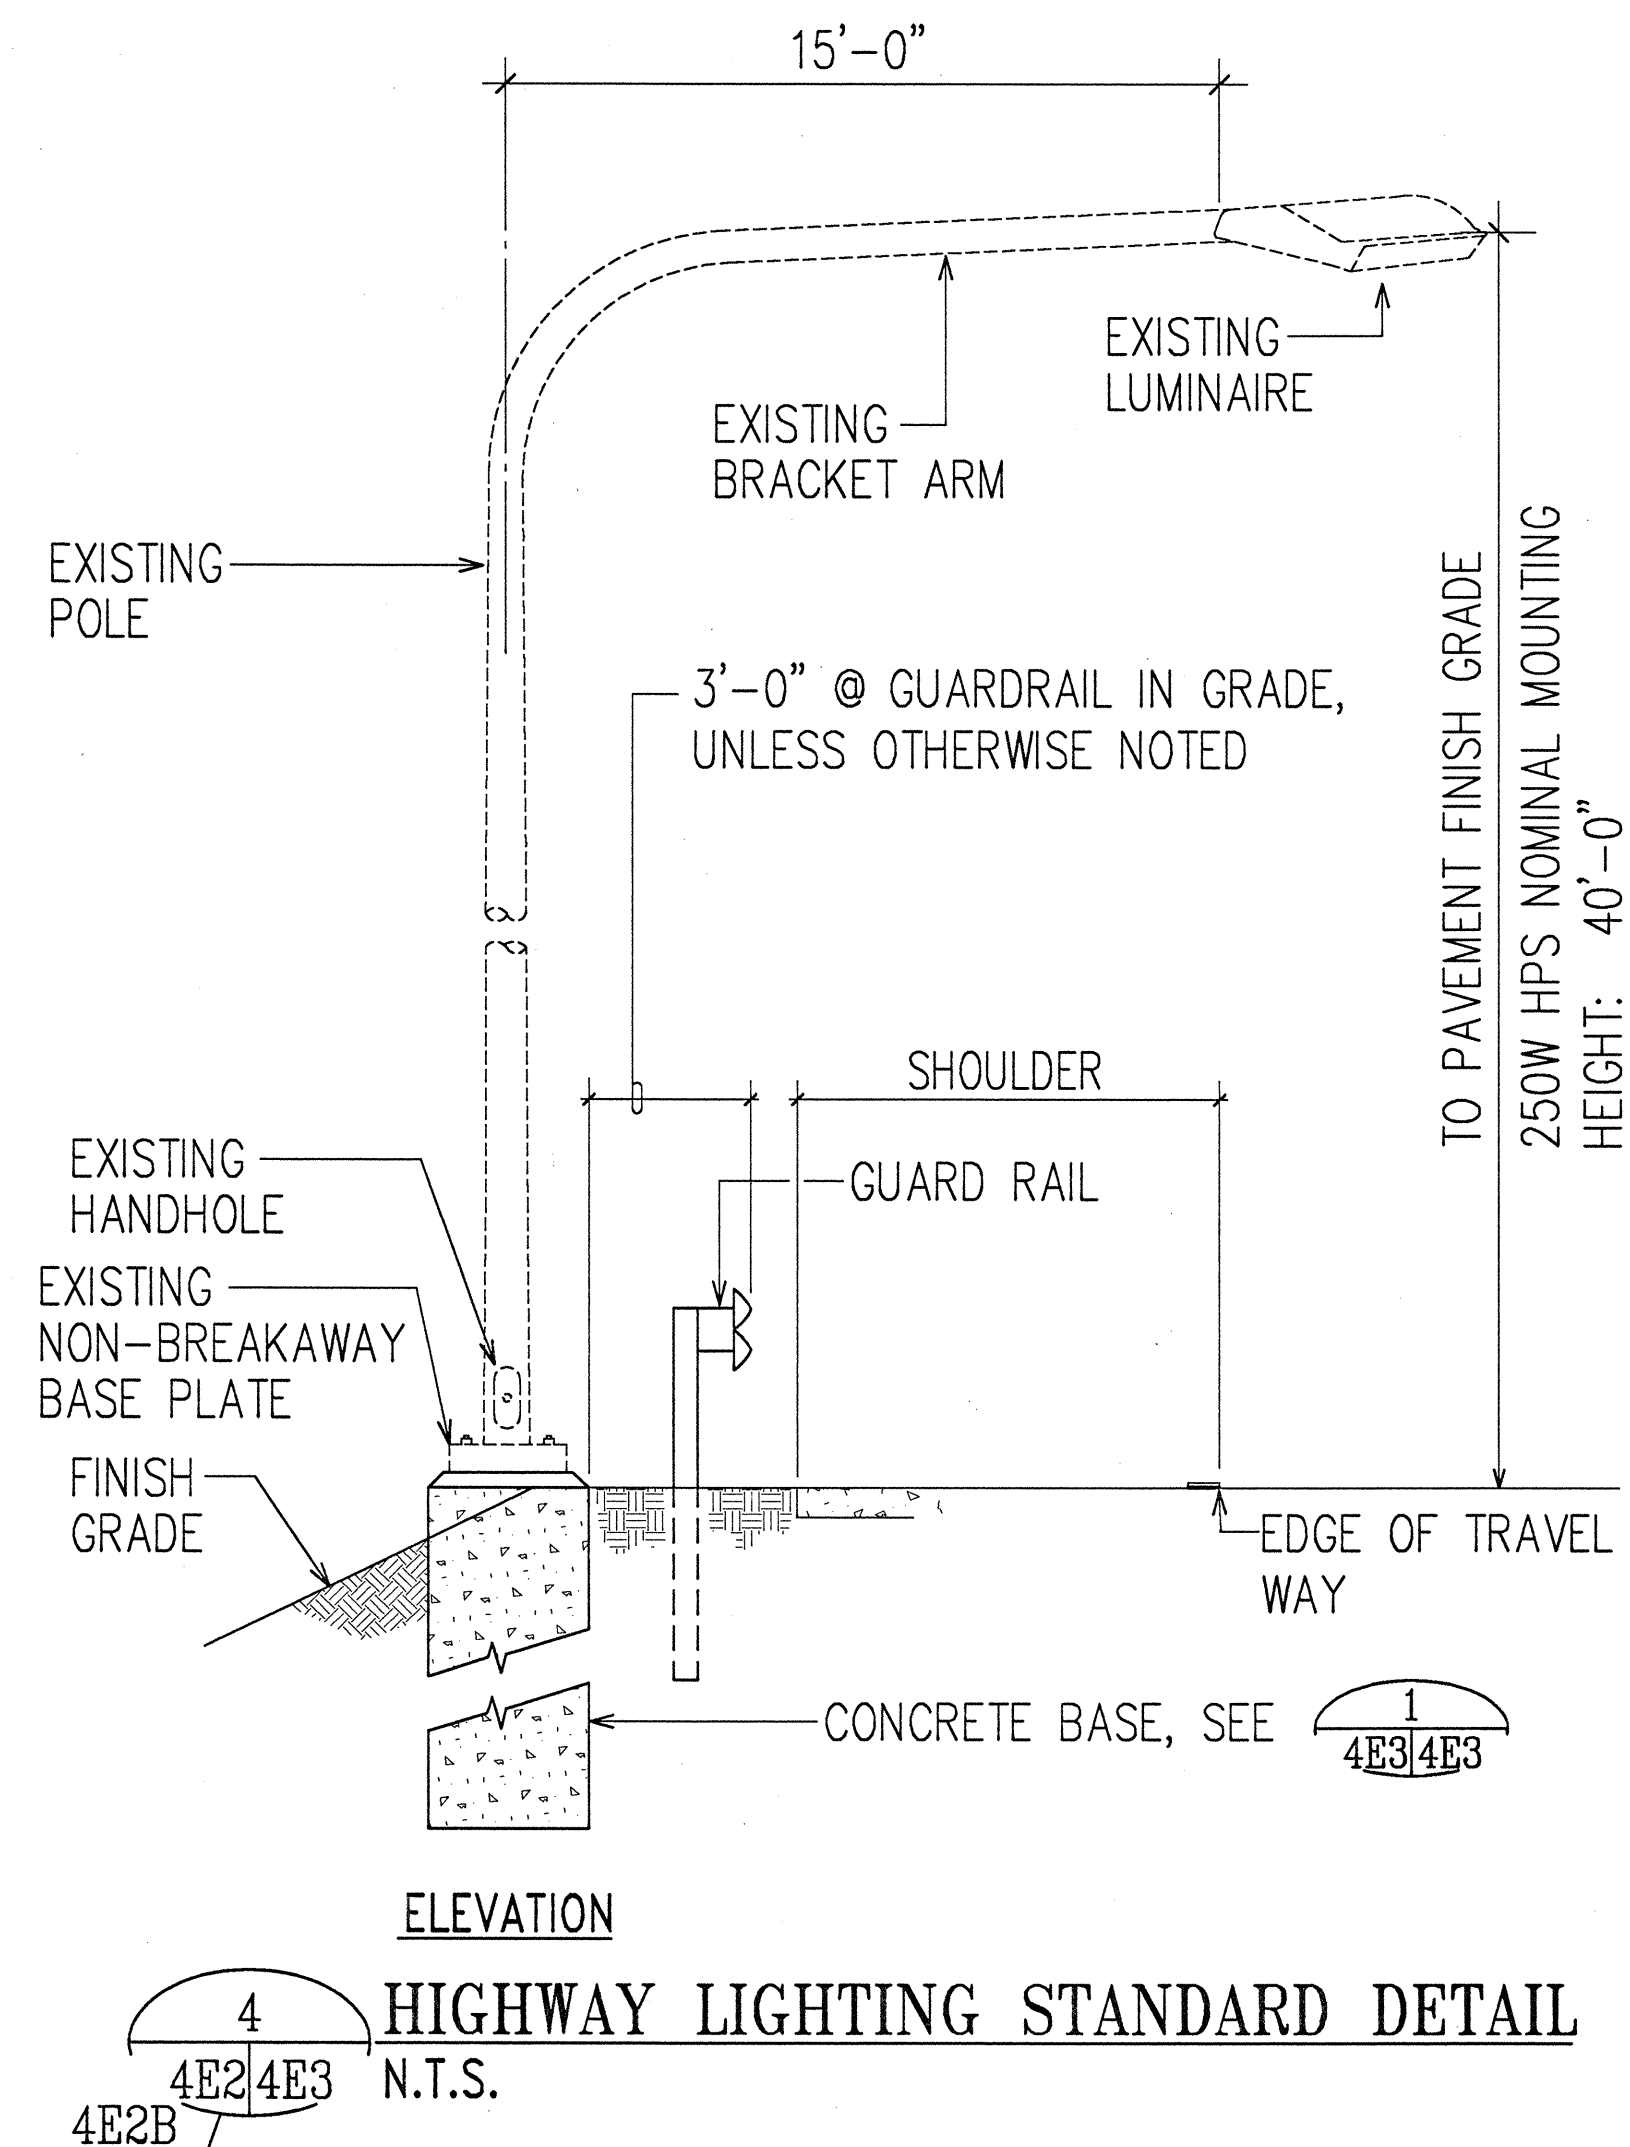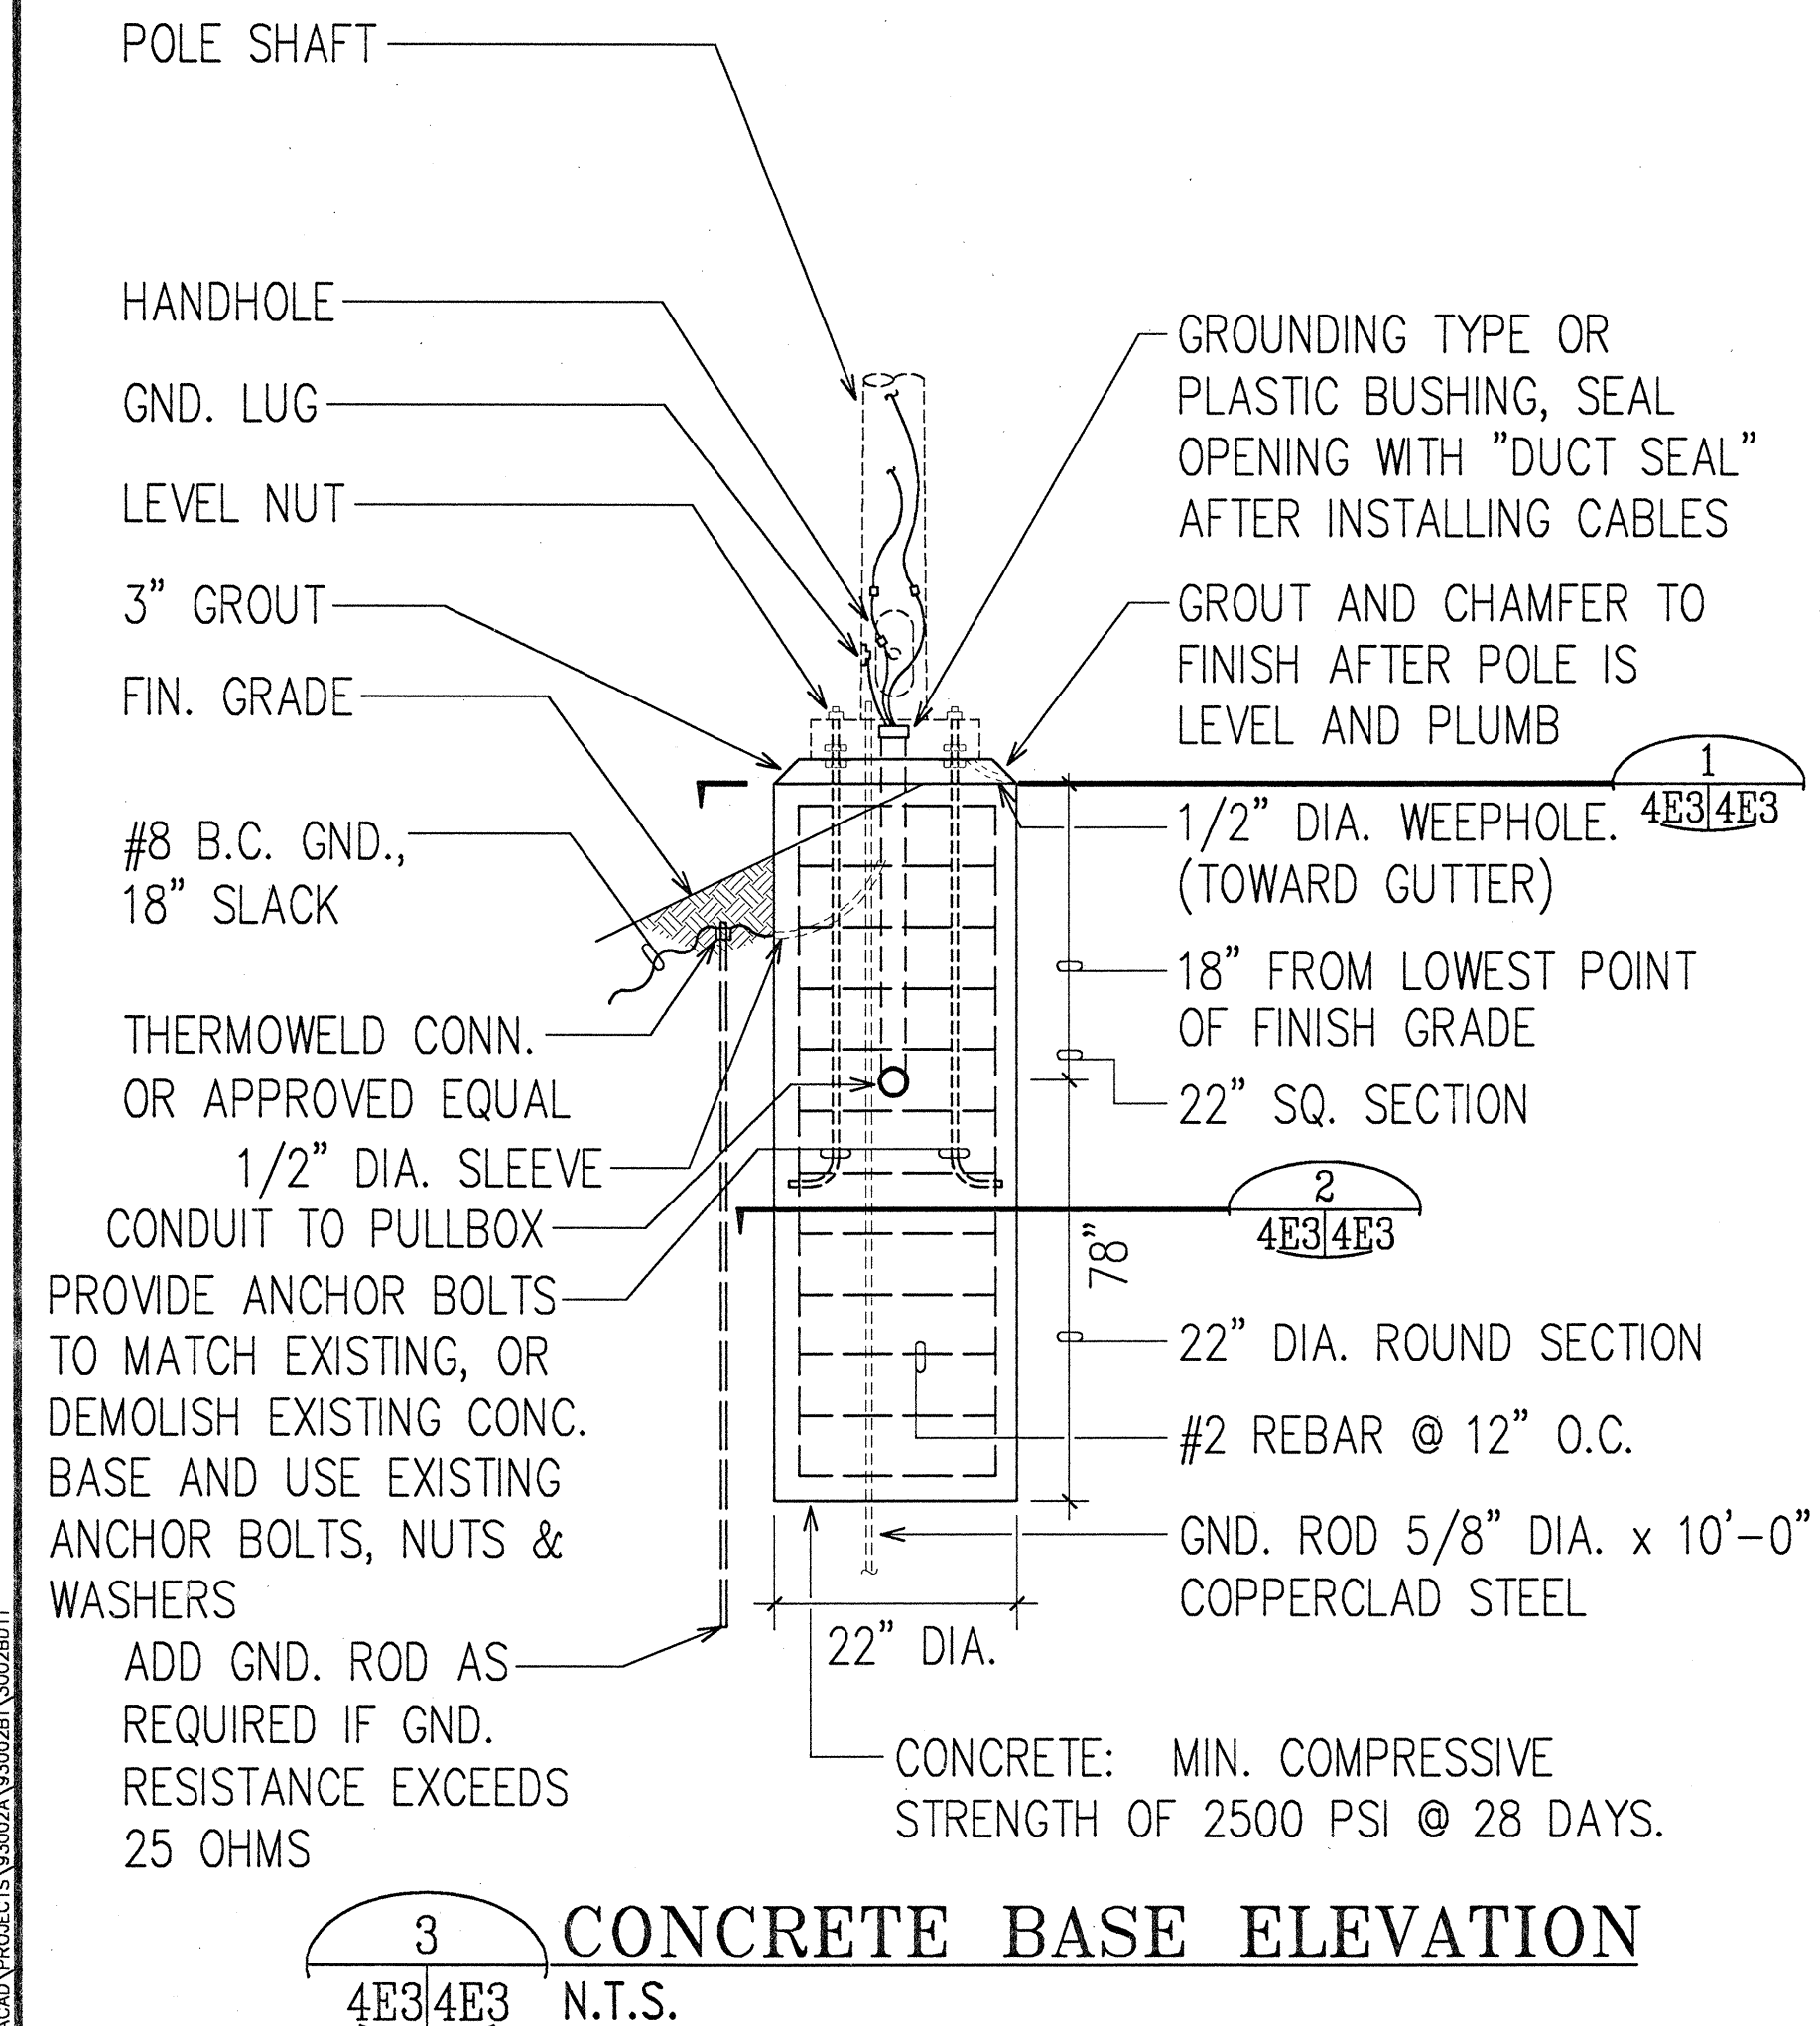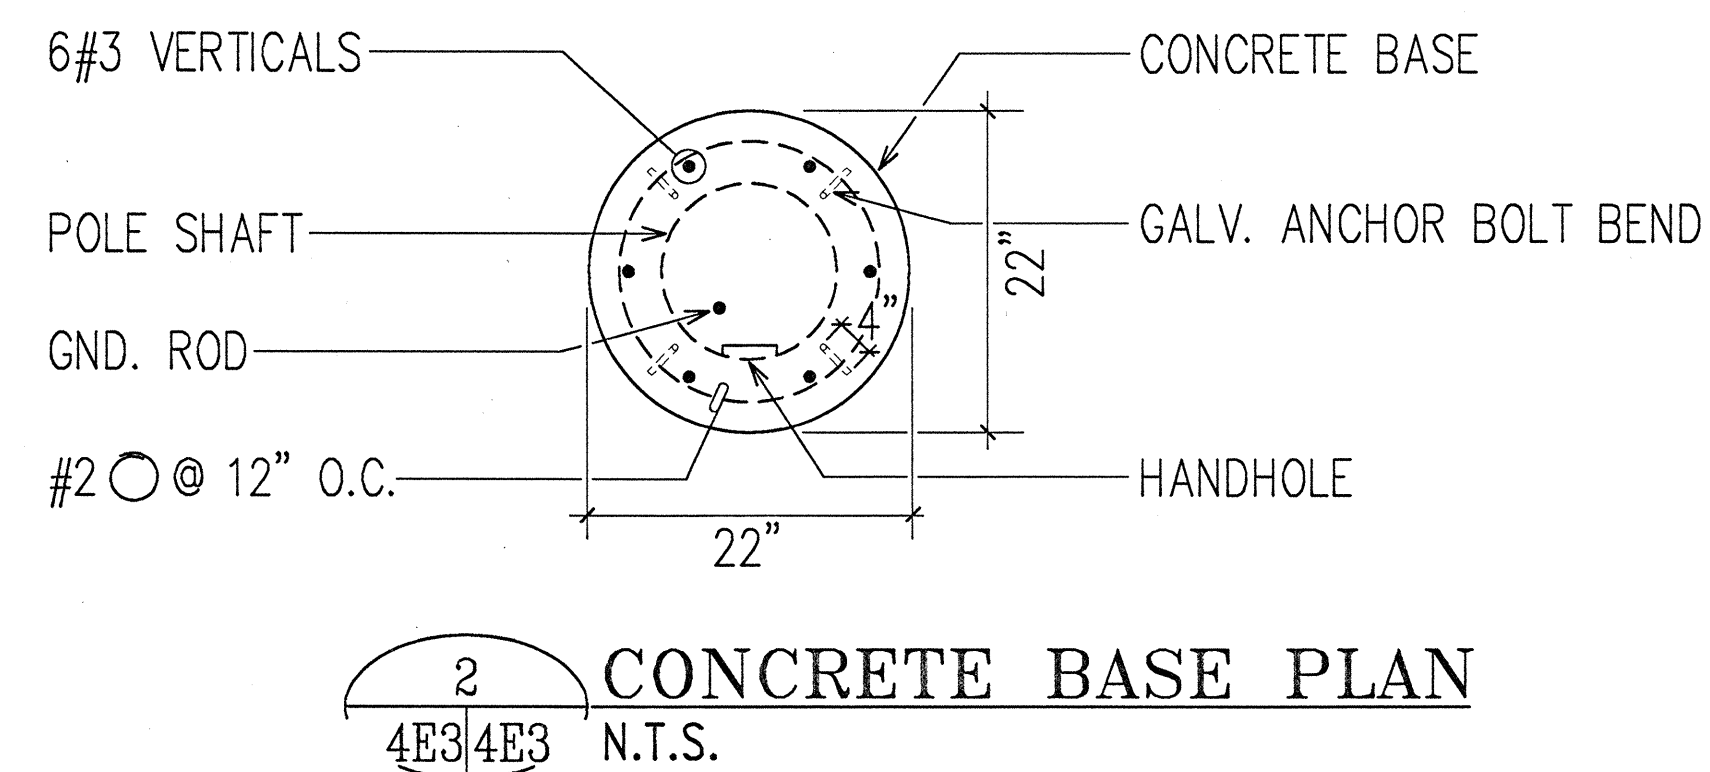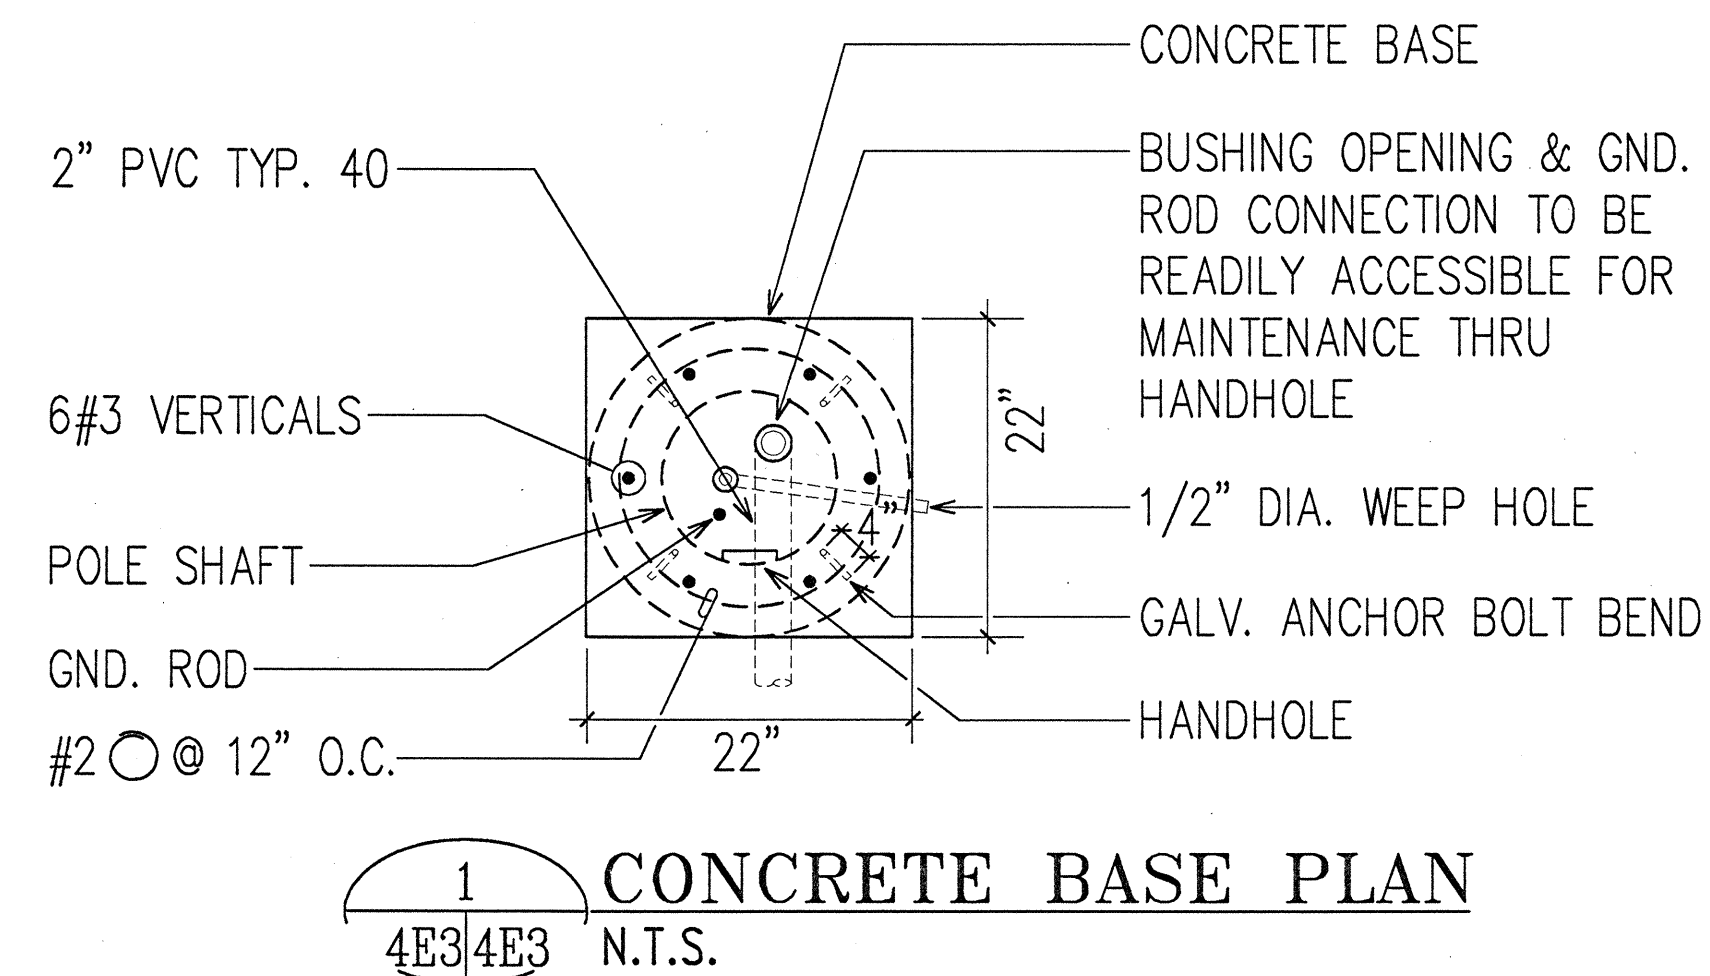

THIS WORK WAS PREPARED BY ME
OR UNDER MY SUPERVISION.
Andrew I. Myaso
RONALD N. S. HO & ASSOC., INC.
ELECTRICAL ENGINEERS

10/31/97	REVISED MOUNTING CLEARANCE BEHIND GUARD RAIL
DATE	REVISION
STATE OF HAWAII DEPARTMENT OF TRANSPORTATION HIGHWAYS DIVISION <u>NORTH HALAWA VALLEY</u> <u>ROAD CONSTRUCTION</u> <u>HIGHWAY LIGHT BASE DETAILS</u> <u>H-3 FINISH (UNIT II)</u> <u>FAIP NO. 1-H3-1(75), UNIT II</u> <u>LEEWARD SECTION</u>	
SCALE: AS NOTED	DATE: FEB. 1997
SHEET No. 4E3 OF 3 SHEETS	

FED. ROAD DIST. NO.	STATE	PROJ. NO.	FISCAL YEAR	SHEET NO.	TOTAL SHEETS
HAWAII	HAW.	I-H3-1(75) UNIT II	1997	C.O. 823 S-1	1102

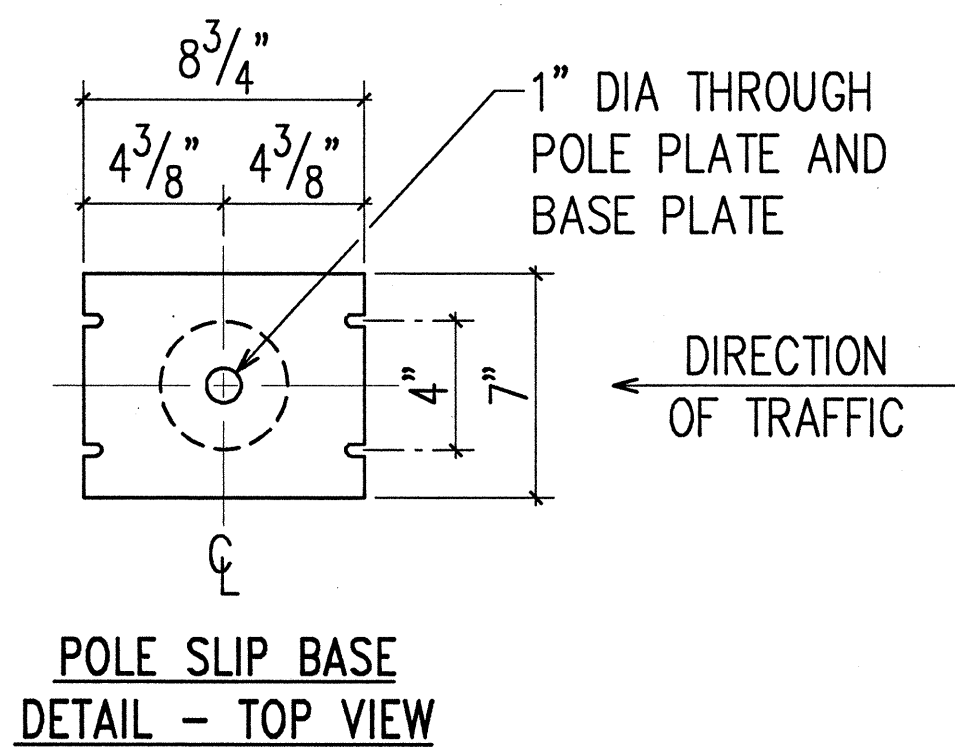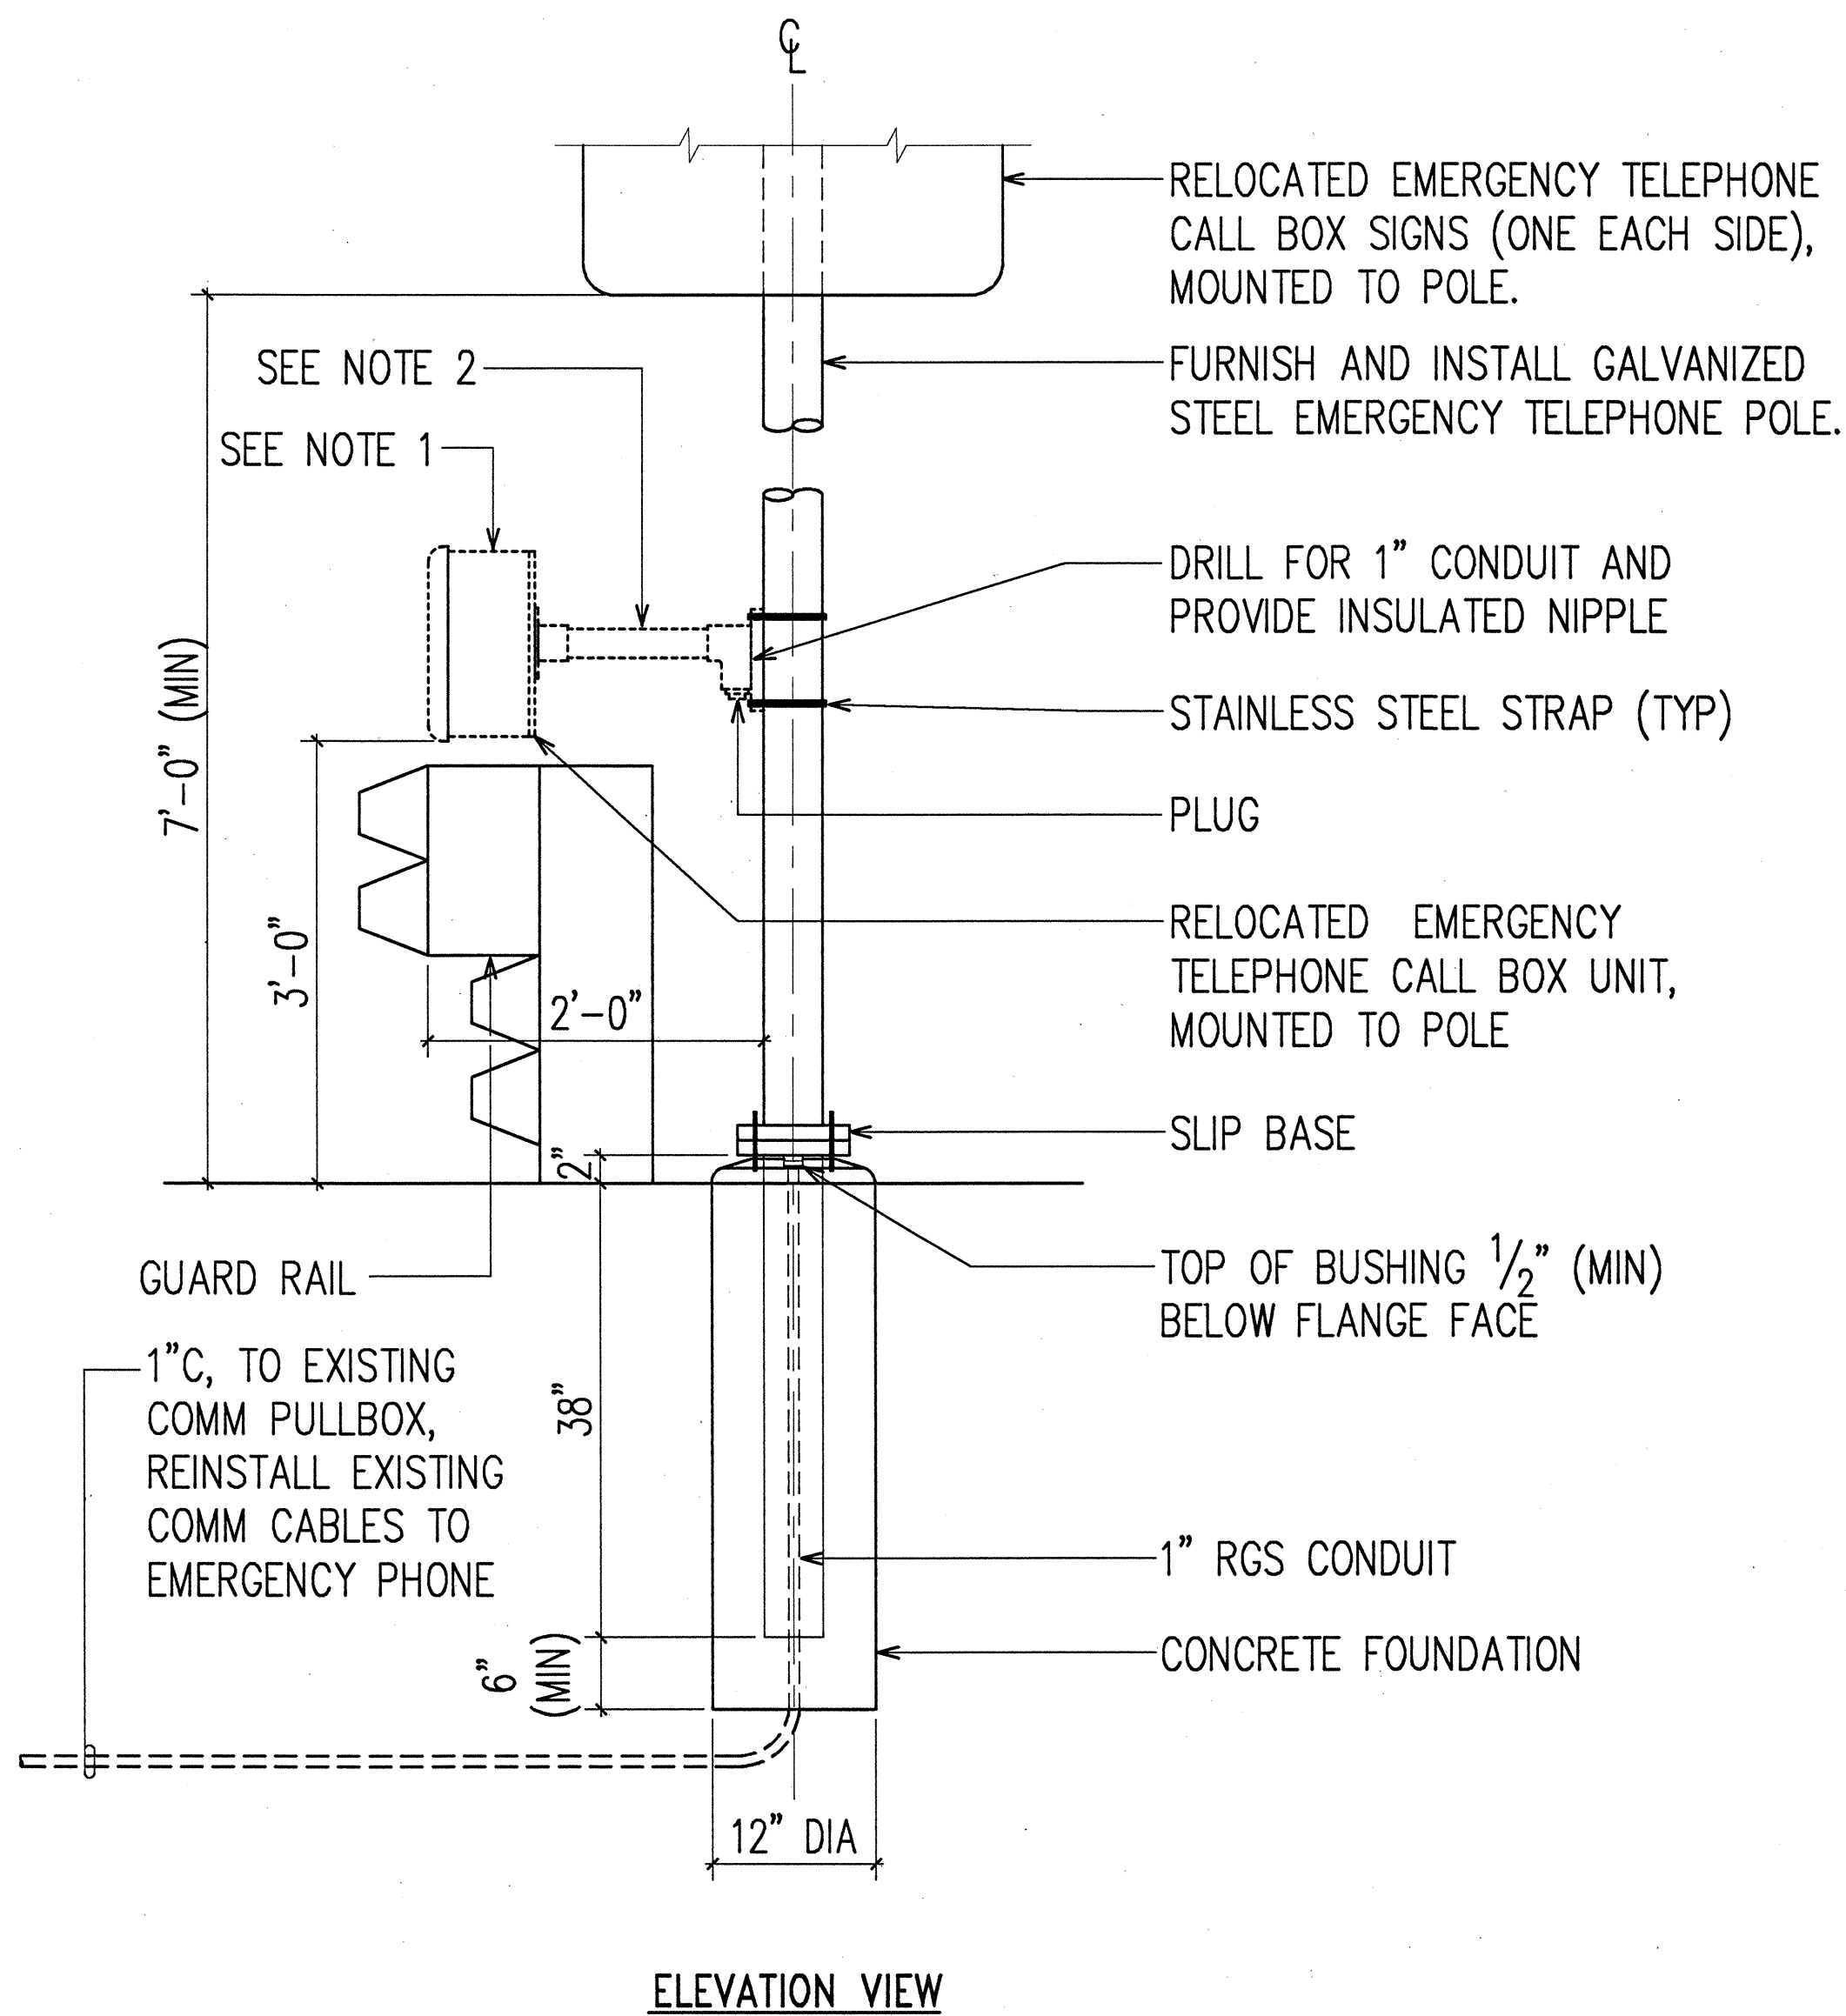

- NOTES:**
- EMERGENCY TELEPHONE POLE AND EMERGENCY TELEPHONE CALL BOX UNIT SHALL BE GROUNDED, ACCORDING TO NEC.
 - ADJUST CONDUIT LENGTH AS REQUIRED TO FIT LOCATION.

1

4E2D


4E3A

INSTALLATION DETAIL OF RELOCATED EMERGENCY PHONE AND SIGNS ON EMERGENCY TELEPHONE POLE

NOT TO SCALE

ORIGINAL PLAN	SURVEY PLOTTED BY	DATE
NOTE BOOK	DRAWN BY	
	TRACED BY	
	CHECKED BY	
	QUANTITIES BY	
	CHECKED BY	
	NO.	

LAST SAVE: 02/27/98 @ 15:21:21 BY: ANILOT SE 1' 0" 0"
G:\ACAD\PROJECTS\GENERAL\823\823E3A.DWG

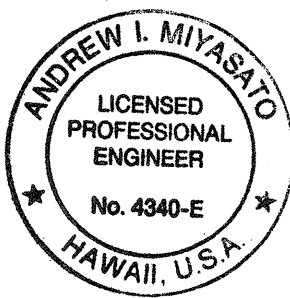

THIS WORK WAS PREPARED BY ME
OR UNDER MY SUPERVISION.
Andrew I. Miyamoto
2/27/98
RONALD N. S. HO & ASSOC., INC.
ELECTRICAL ENGINEERS


3/3/98 ADDED NEW SHEET FOR EMERGENCY
PHONE RELOCATION DETAILS

DATE REVISION

STATE OF HAWAII
DEPARTMENT OF TRANSPORTATION
HIGHWAYS DIVISION
NORTH HALAWA VALLEY
ROADWAY CONSTRUCTION
EMERGENCY PHONE RELOCATION DETAILS
H-3 FINISH (UNIT II)
FAIP NO. I-H3-1(75), UNIT II
LEEWARD SECTION
SCALE: AS NOTED DATE: FEB. 1998
SHEET No. 4E3A OF 3 SHEETS


C.O. 823 S-1

FED. ROAD DIST. NO.	STATE	PROJ. NO.	FISCAL YEAR	SHEET NO.	TOTAL SHEETS
HAWAII	HAW.	I-H3-1(75) UNIT II	1997	825	1102

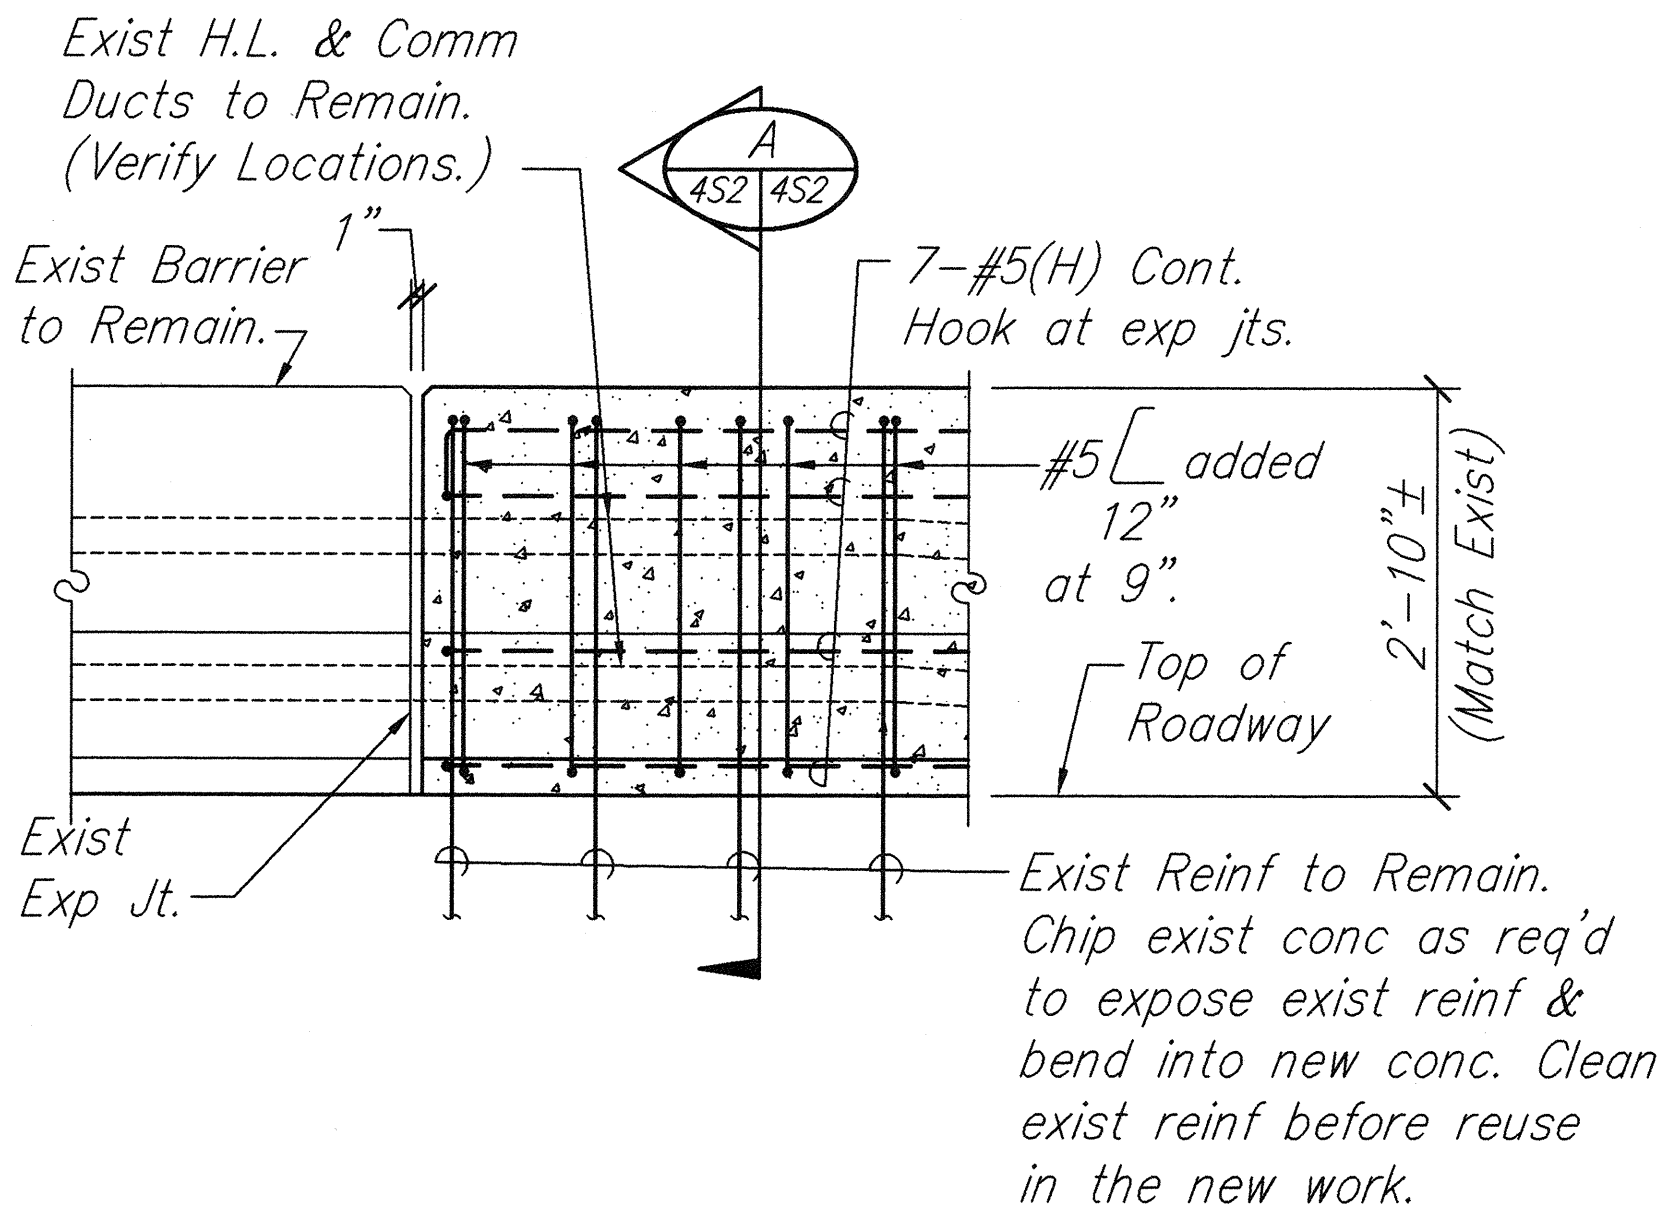

ELEVATION AT EXP JT

Scale: 3/4" = 1'-0"

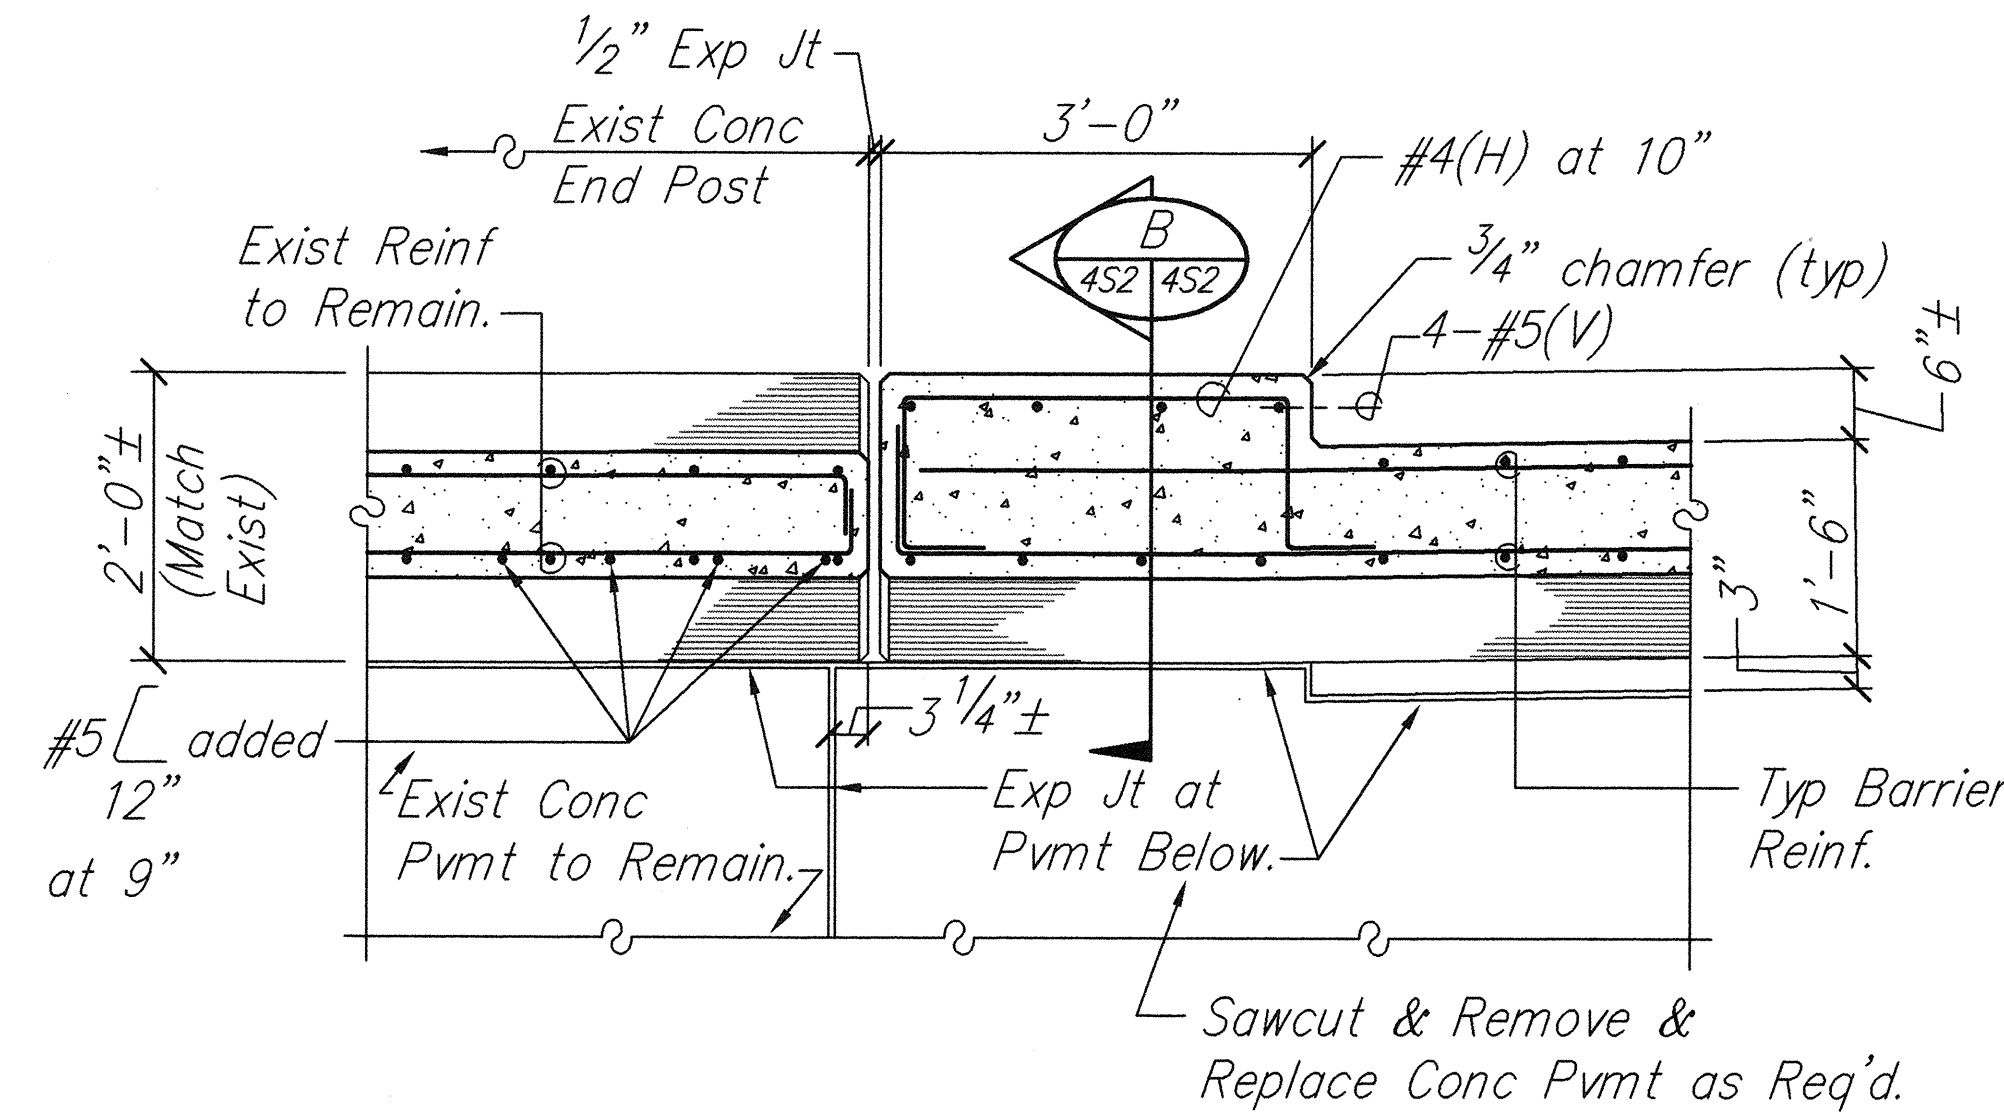


PLAN/SECTION

Scale: 3/4" = 1'-0"


Sawcut & Remove Exist Conc Pavement as Req'd. Chip 3 3/4"x1" deep cont keyway. Clean & Roughen Jt & Pour P.C.C. Pvmnt to Match Exist.

#5x24" Epoxy Grouted Dowels at 30".

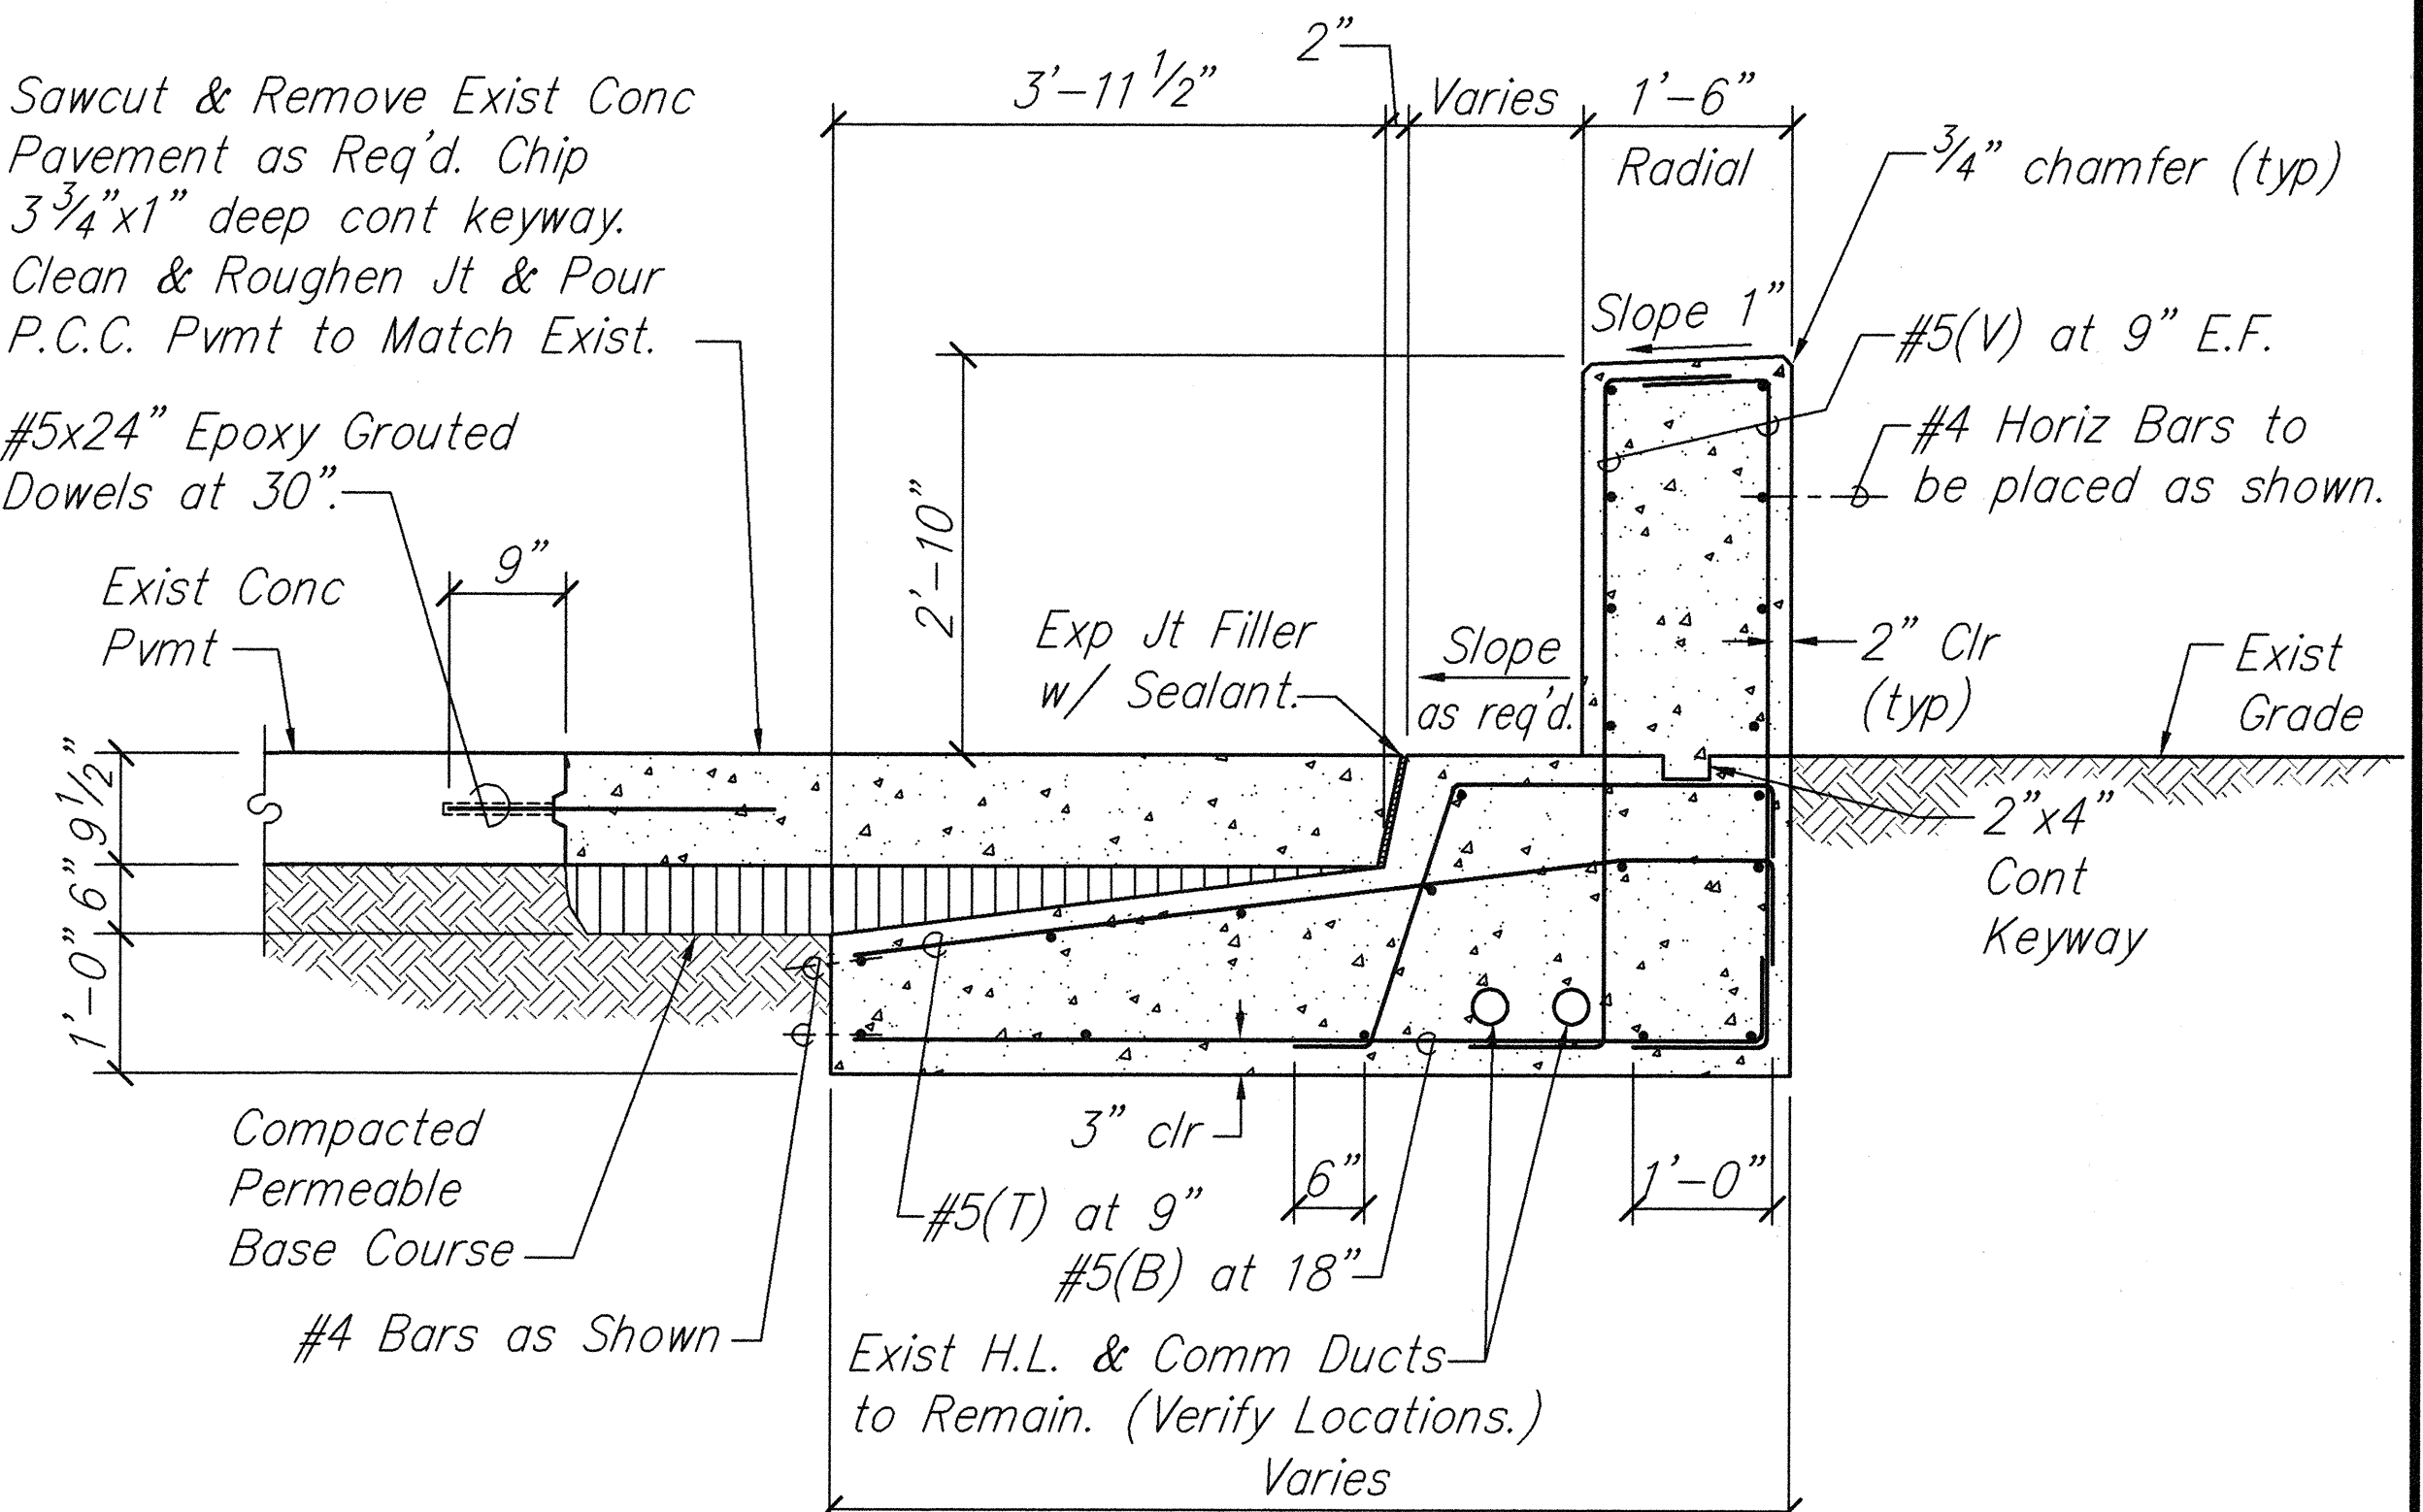

SECTION


Scale: 3/4" = 1'-0"

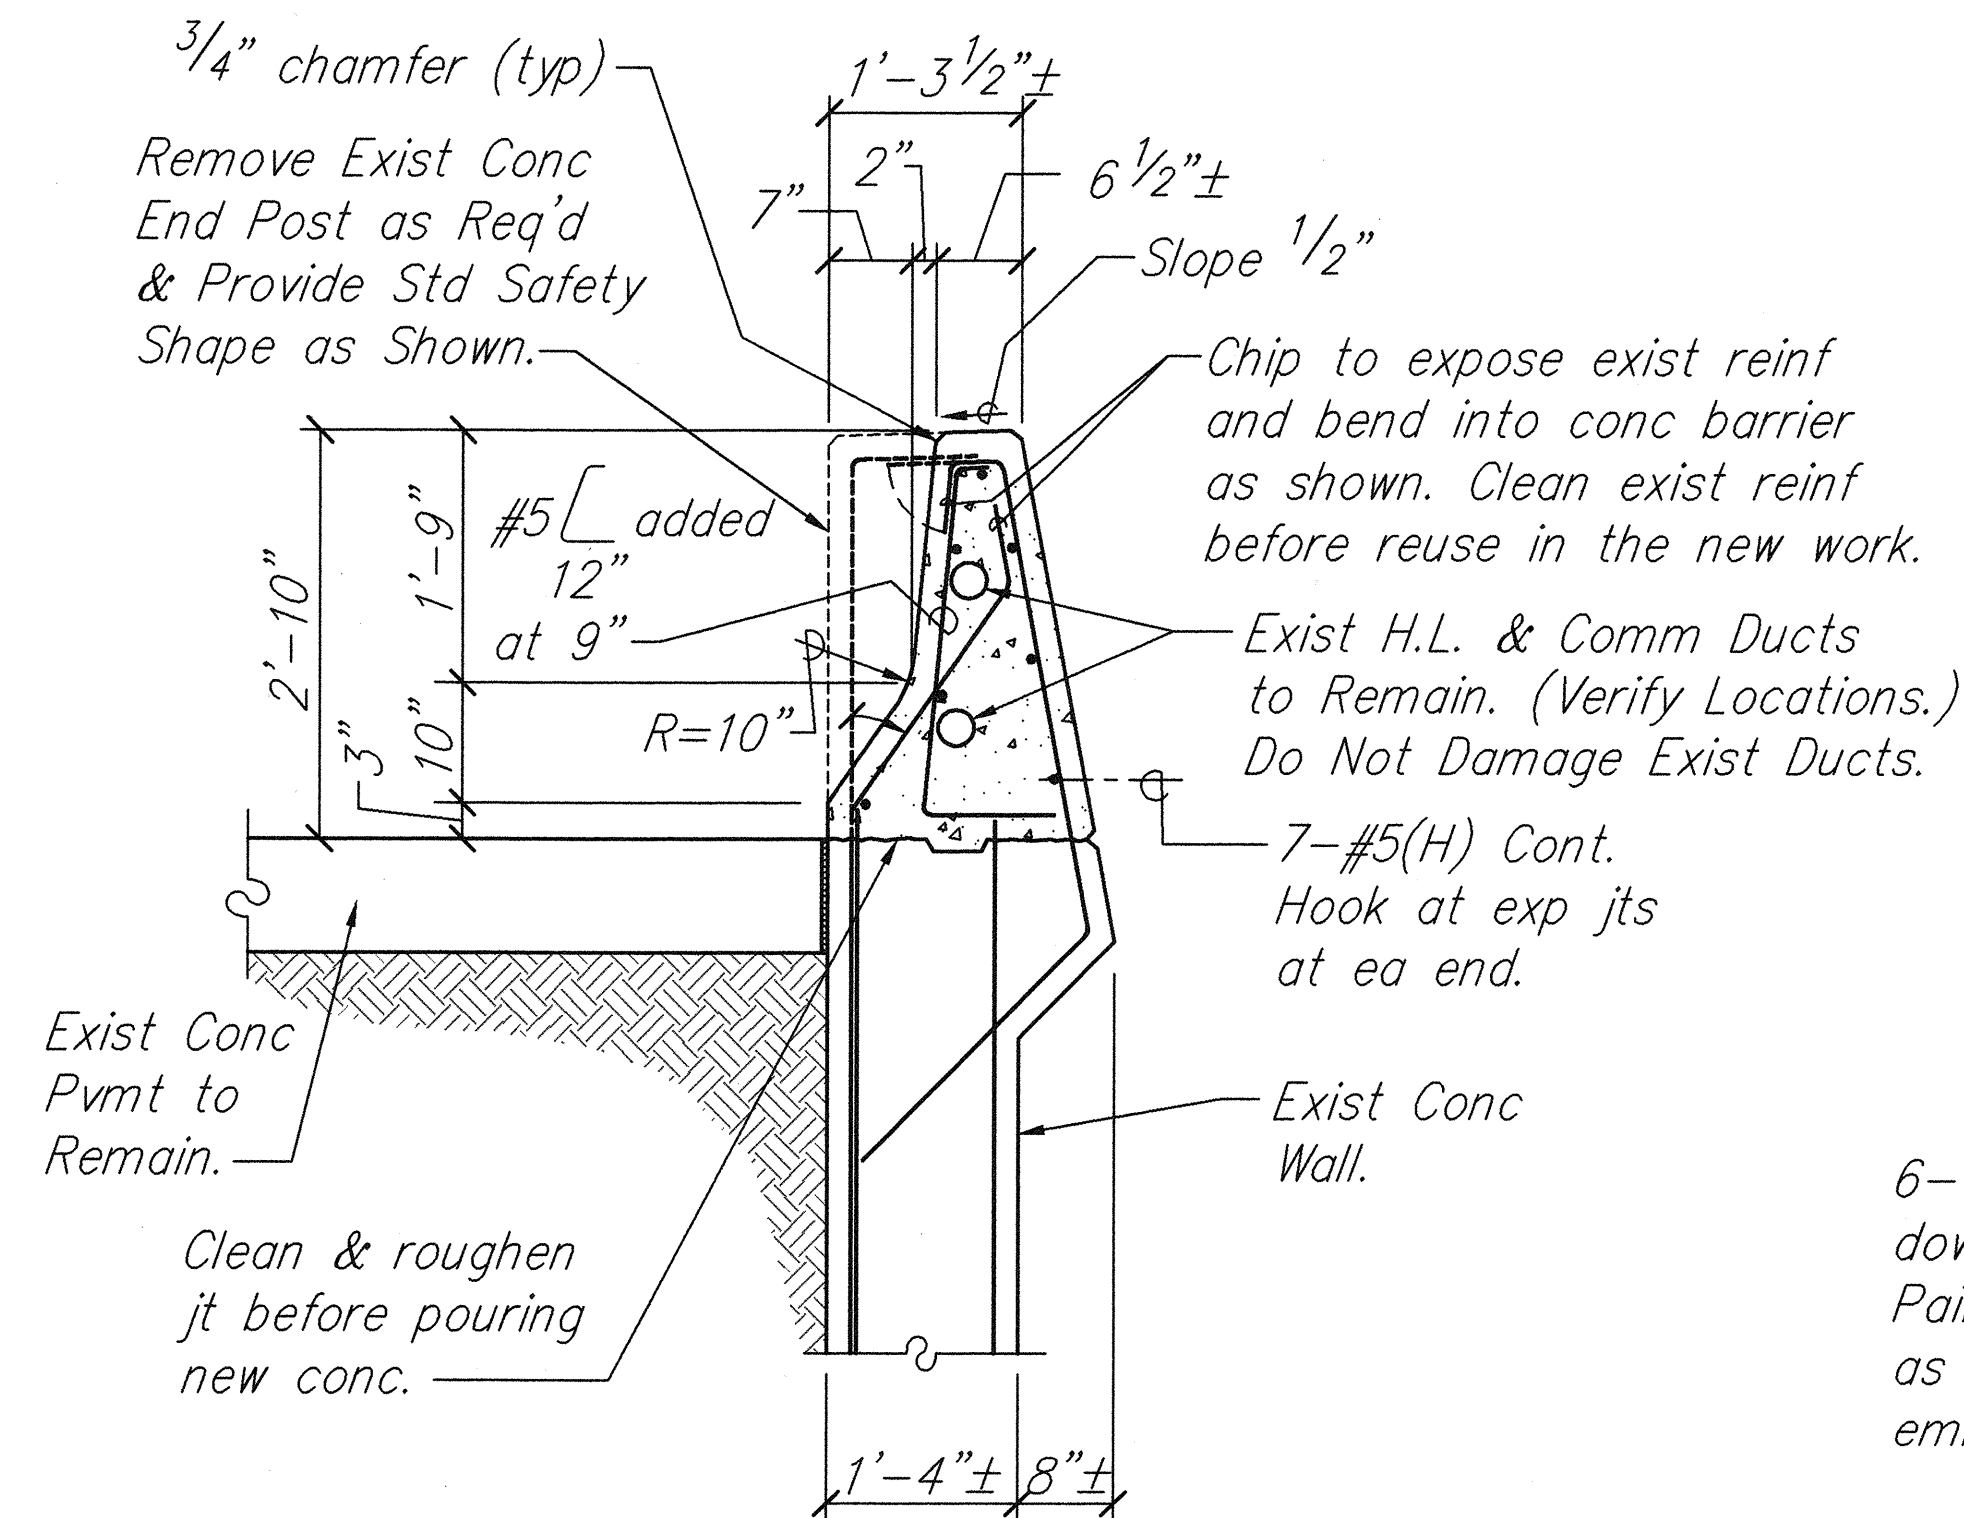

SECTION THRU EXIST END POST

Scale: 3/4" = 1'-0"


Sawcut & Remove & Replace Exist Conc Pvmnt as Req'd.

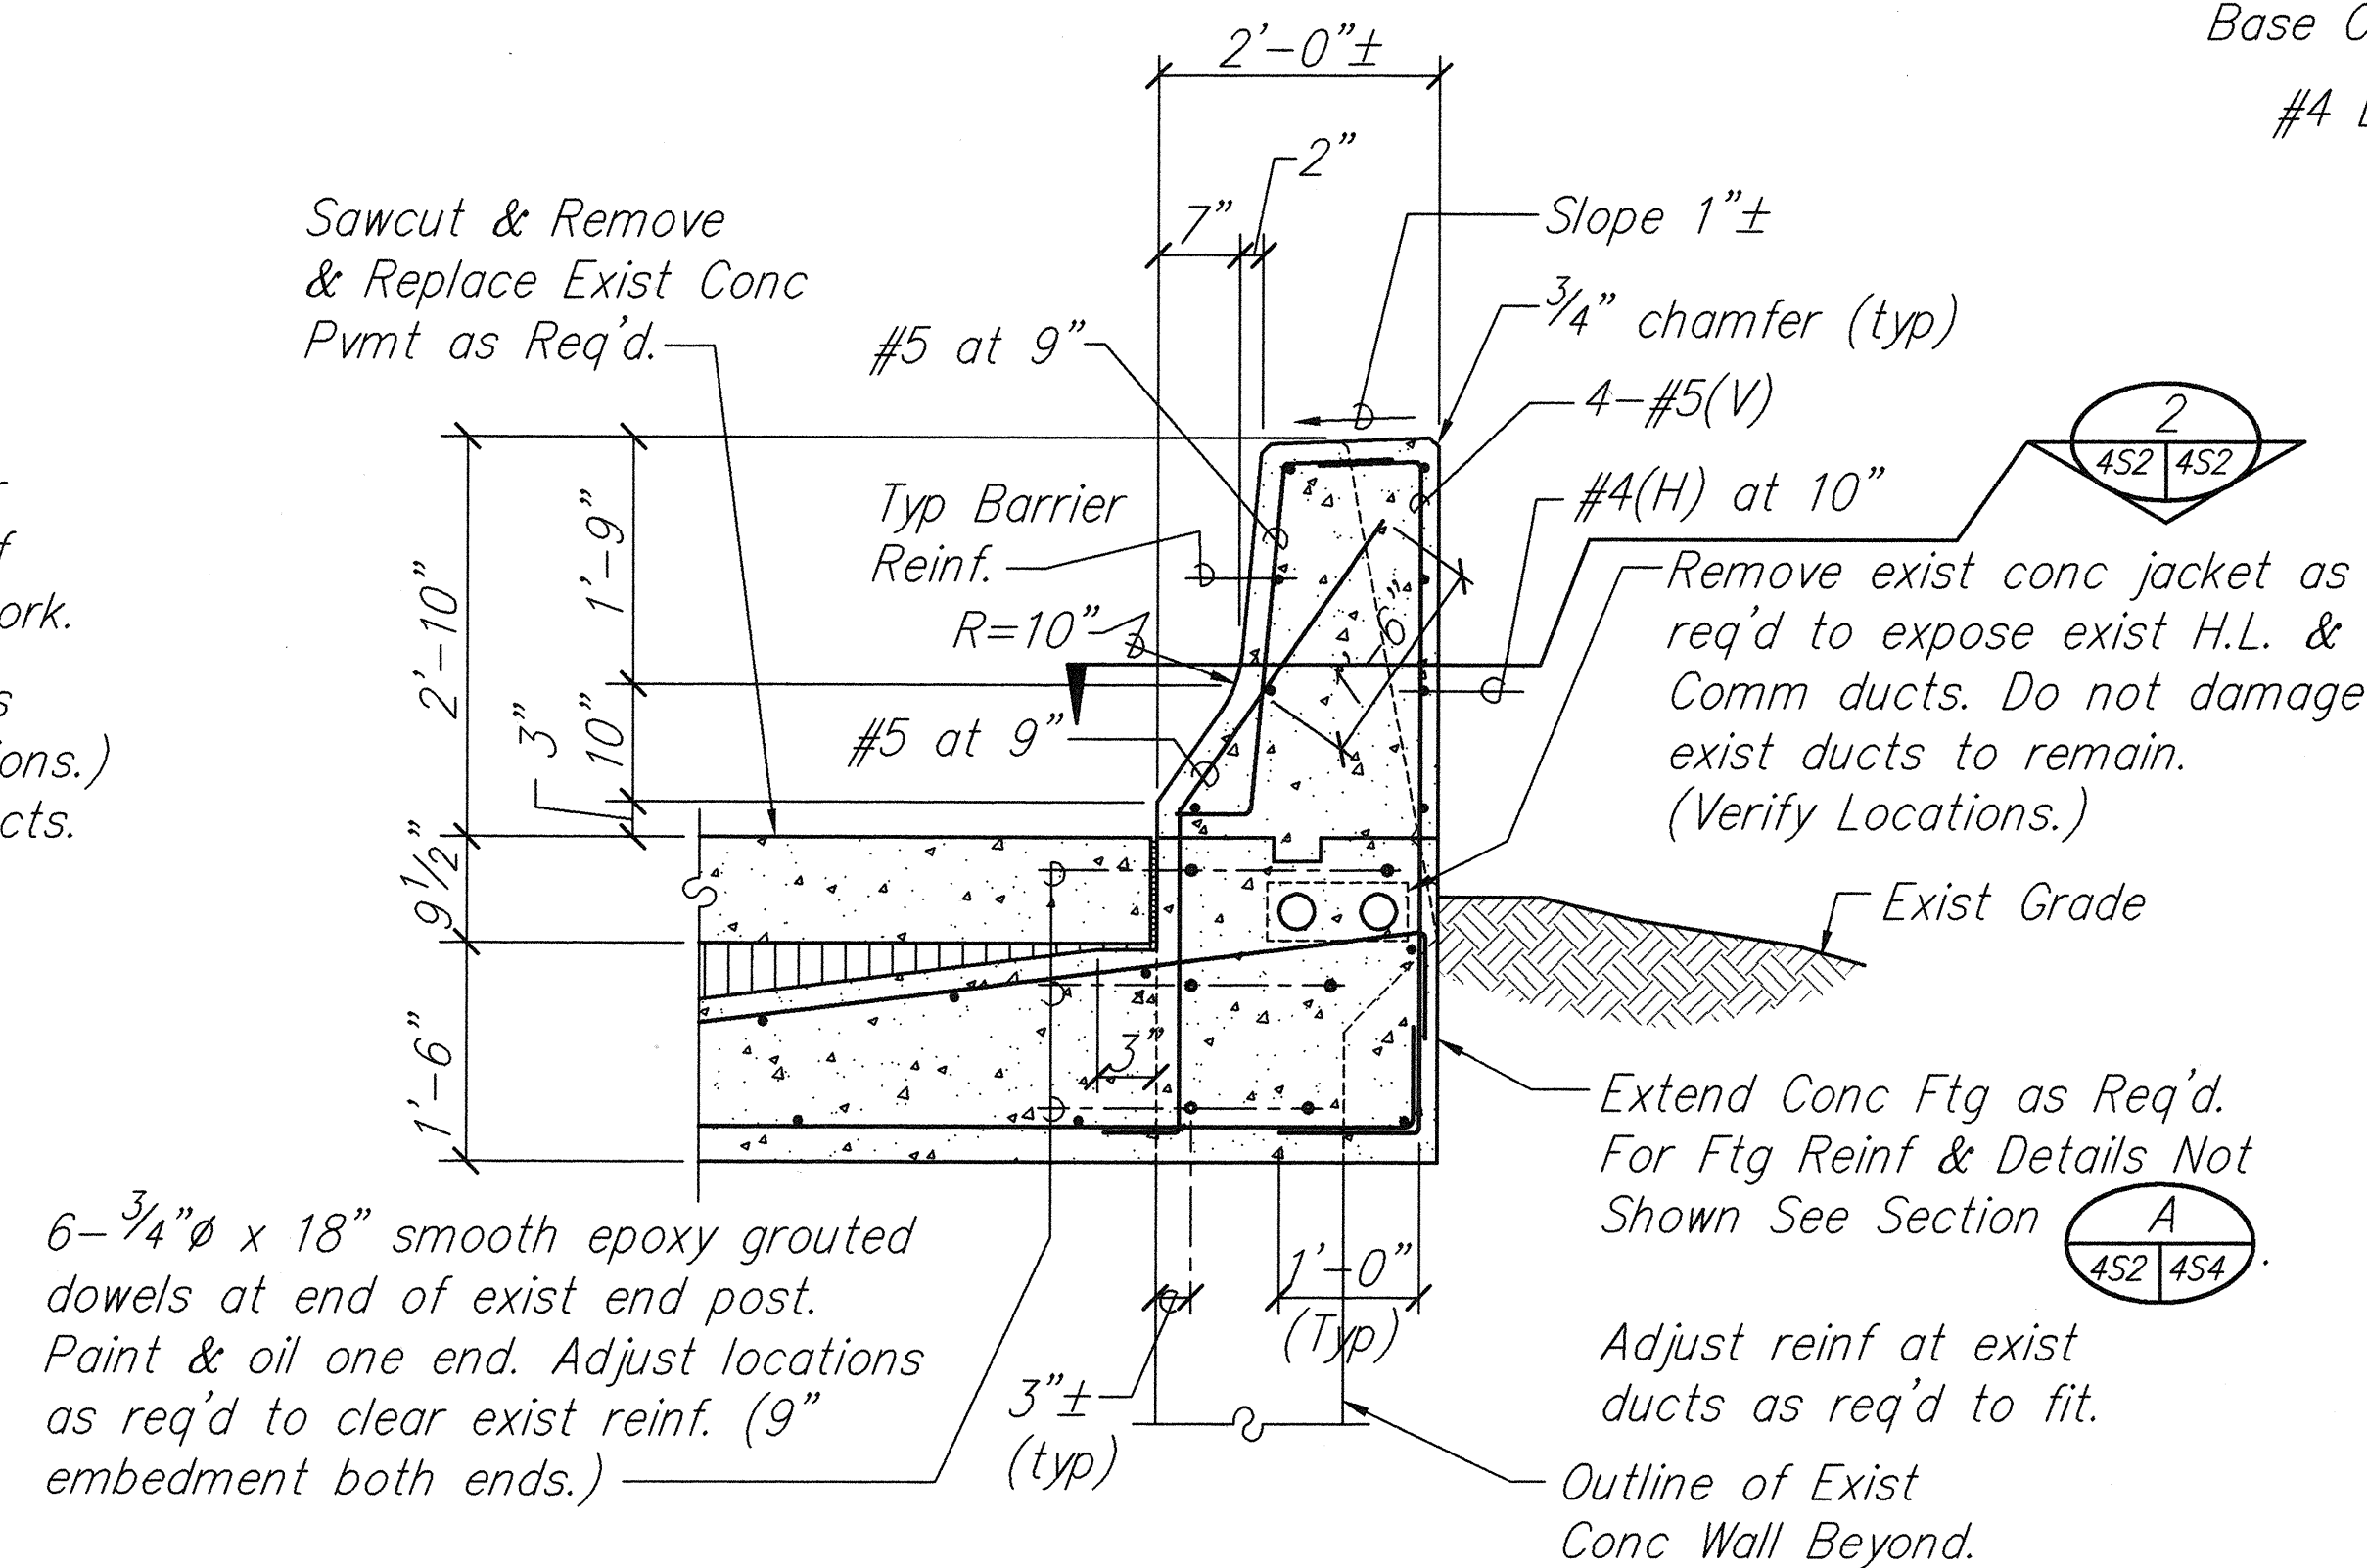

SECTION

Scale: 3/4" = 1'-0"


DATE	_____
SURVEY PLOTTED BY	_____
DRAWN BY	_____
TRACED BY	_____
NOTE BOOK	_____
QUANTITIES BY	_____
CHECKED BY	_____
ORIGINAL PLAN	_____
No.	_____

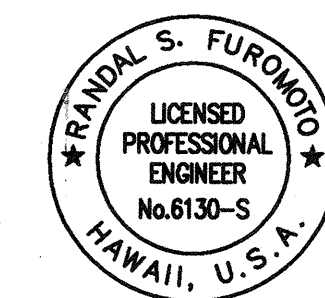

Signature
This work was prepared by me or under my supervision.

STATE OF HAWAII DEPARTMENT OF TRANSPORTATION HIGHWAYS DIVISION NORTH HALAWA VALLEY BARRIER AND GUARDRAIL MODIFICATIONS CONCRETE BARRIER NO. 1 H-3 FINISH (UNIT II) FAIP NO. I-H3-1(75), UNIT II LEEWARD SECTION SCALE: AS NOTED DATE: FEB 1997 SHEET No. 4S2 OF 10 SHEETS
--

FED. ROAD DIST. NO.	STATE	PROJ. NO.	FISCAL YEAR	SHEET NO.	TOTAL SHEETS
HAWAII	HAW.	I-H3-1(75) UNIT II	1997	826	1102


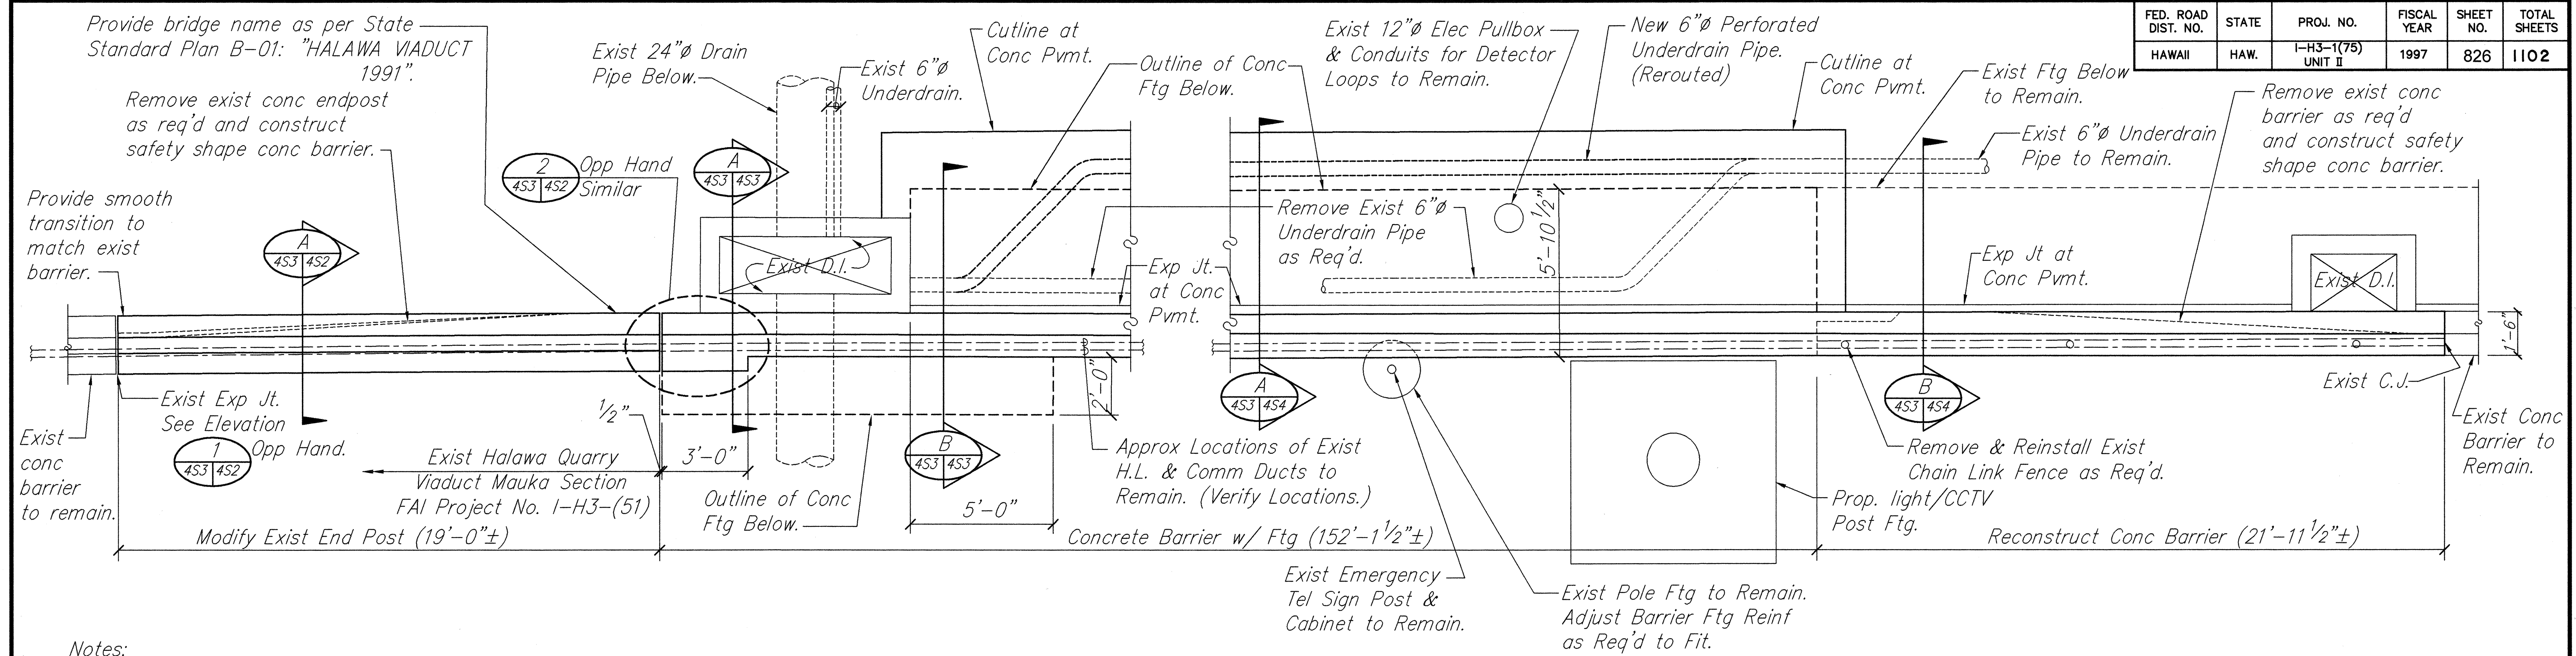


- Notes:**
- See Sheet 4S4 for Concrete Barrier and Guardrail General Notes.
 - Concrete Barrier construction and expansion joints shall be located by the Contractor as approved by the Engineer. See Detail 1/4S3 4S4 for joint layout. Refer to State Standard Plan B-01 for barrier wall joint details.

PLAN/SECTION AT CONCRETE BARRIER NO. 2

Scale: 3/8" = 1'-0"

SURVEY PLOTTED BY	DATE
DRAWN BY	
DESIGNED BY	
QUANTITIES BY	
CHECKED BY	
ORIGINAL PLAN	
NOTE BOOK	
No.	

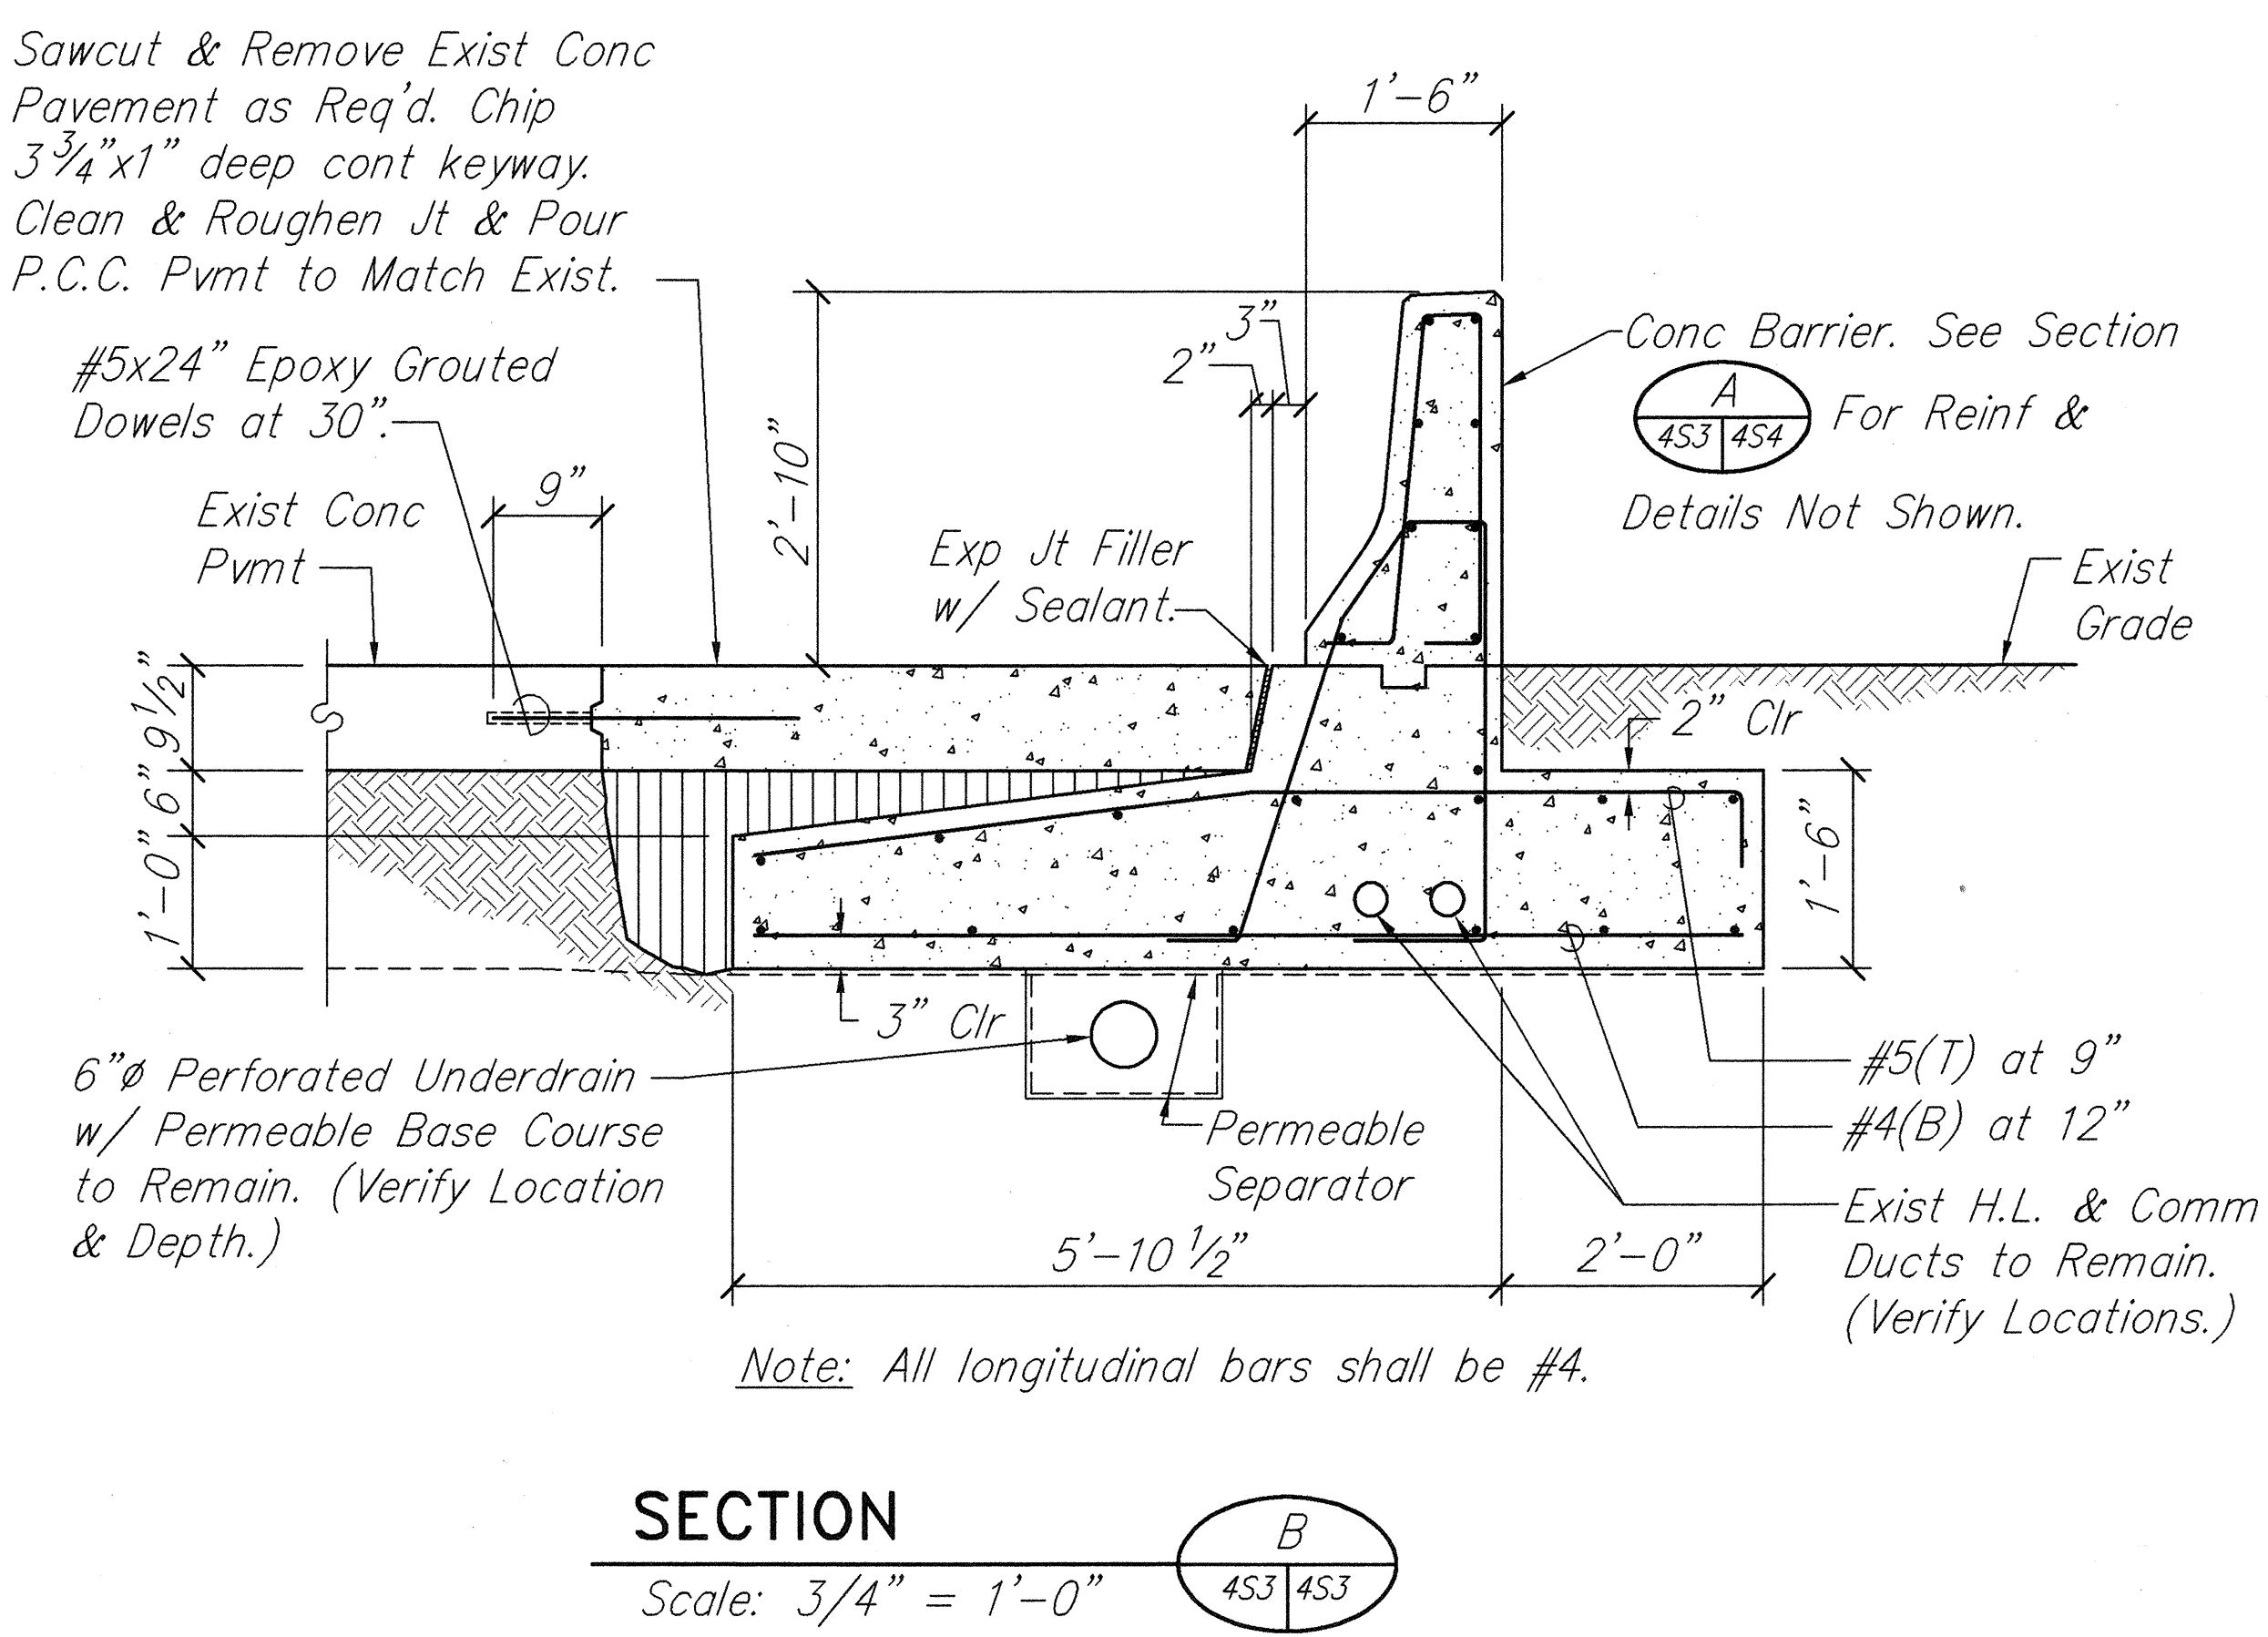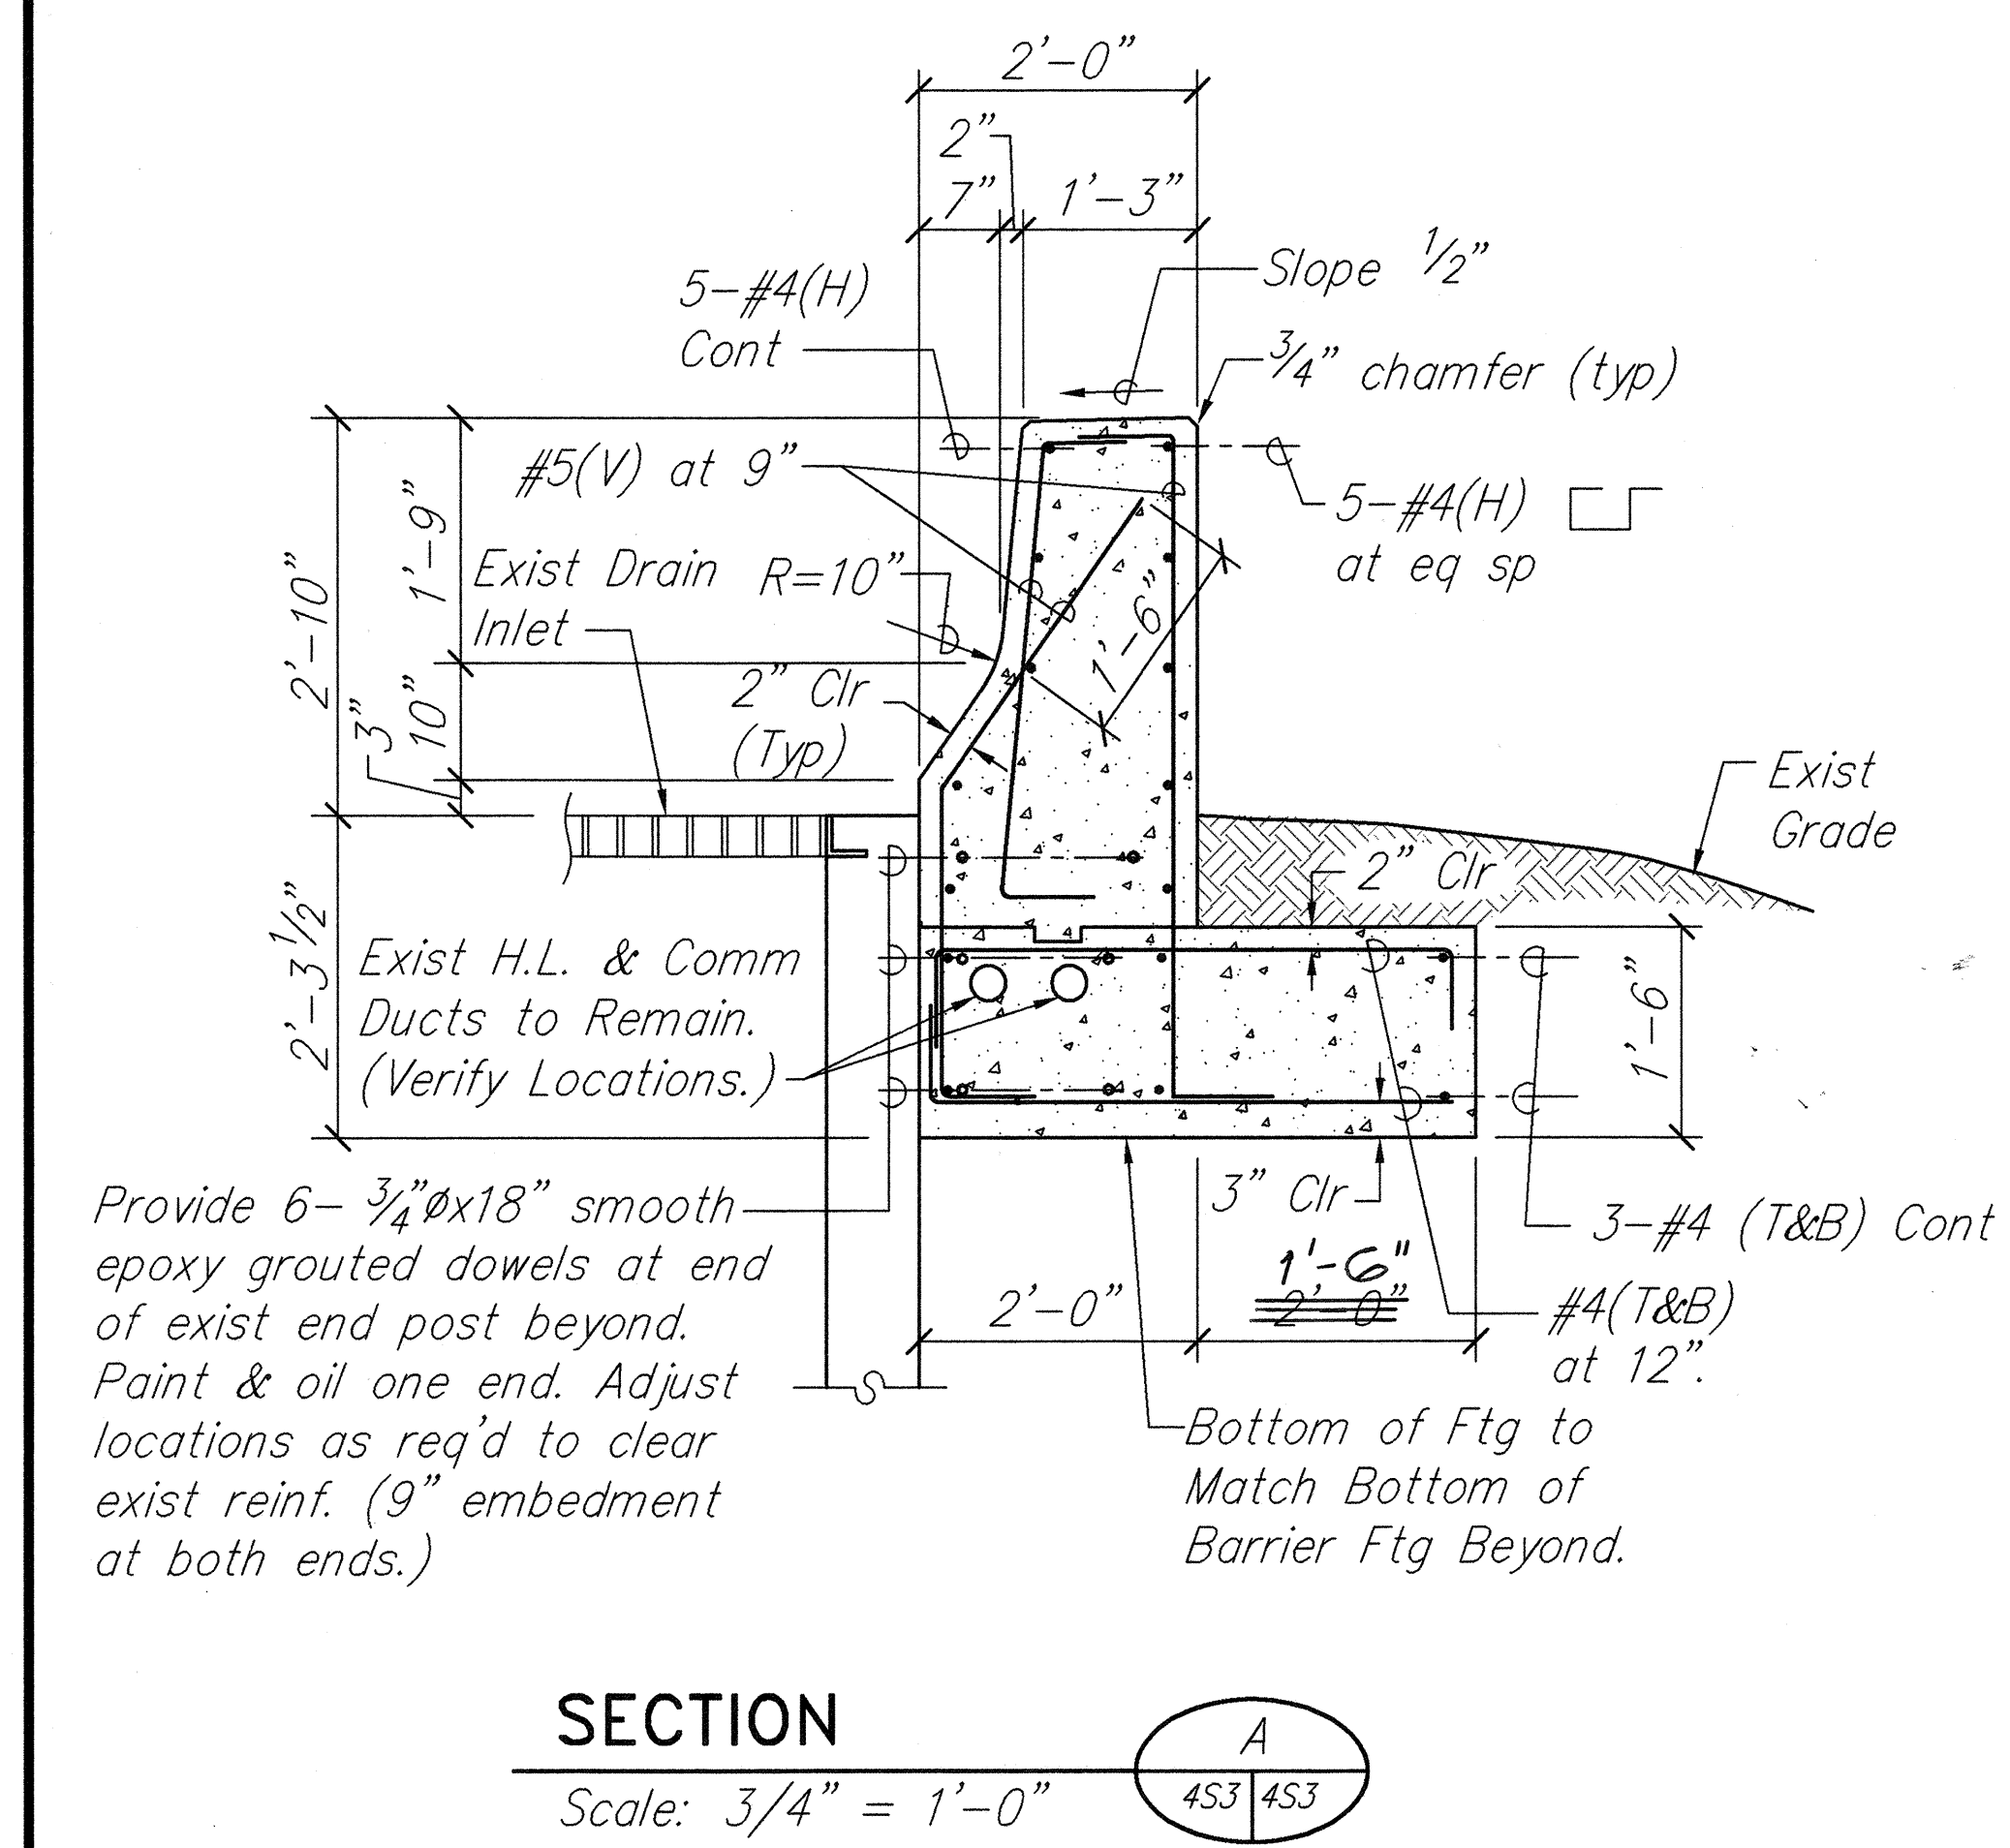


RANDAL S. FUROMOTO
 LICENSED PROFESSIONAL ENGINEER
 No. 6130-S
 HAWAII, U.S.A.
 Signature
 This work was prepared by me or under my supervision.

STATE OF HAWAII
 DEPARTMENT OF TRANSPORTATION
 HIGHWAYS DIVISION
 NORTH HALAWA VALLEY
 BARRIER AND GUARDRAIL MODIFICATIONS
 CONCRETE BARRIER NO. 2

H-3 FINISH (UNIT II)
 FAIP NO. I-H3-1(75), UNIT II
 LEeward SECTION



SCALE: AS NOTED
 DATE: FEB 1997
 SHEET No. 4S3 OF 10 SHEETS

FED. ROAD DIST. NO.	STATE	PROJ. NO.	FISCAL YEAR	SHEET NO.	TOTAL SHEETS
HAWAII	HAW.	I-H3-1(75) UNIT II	1997	827	1102

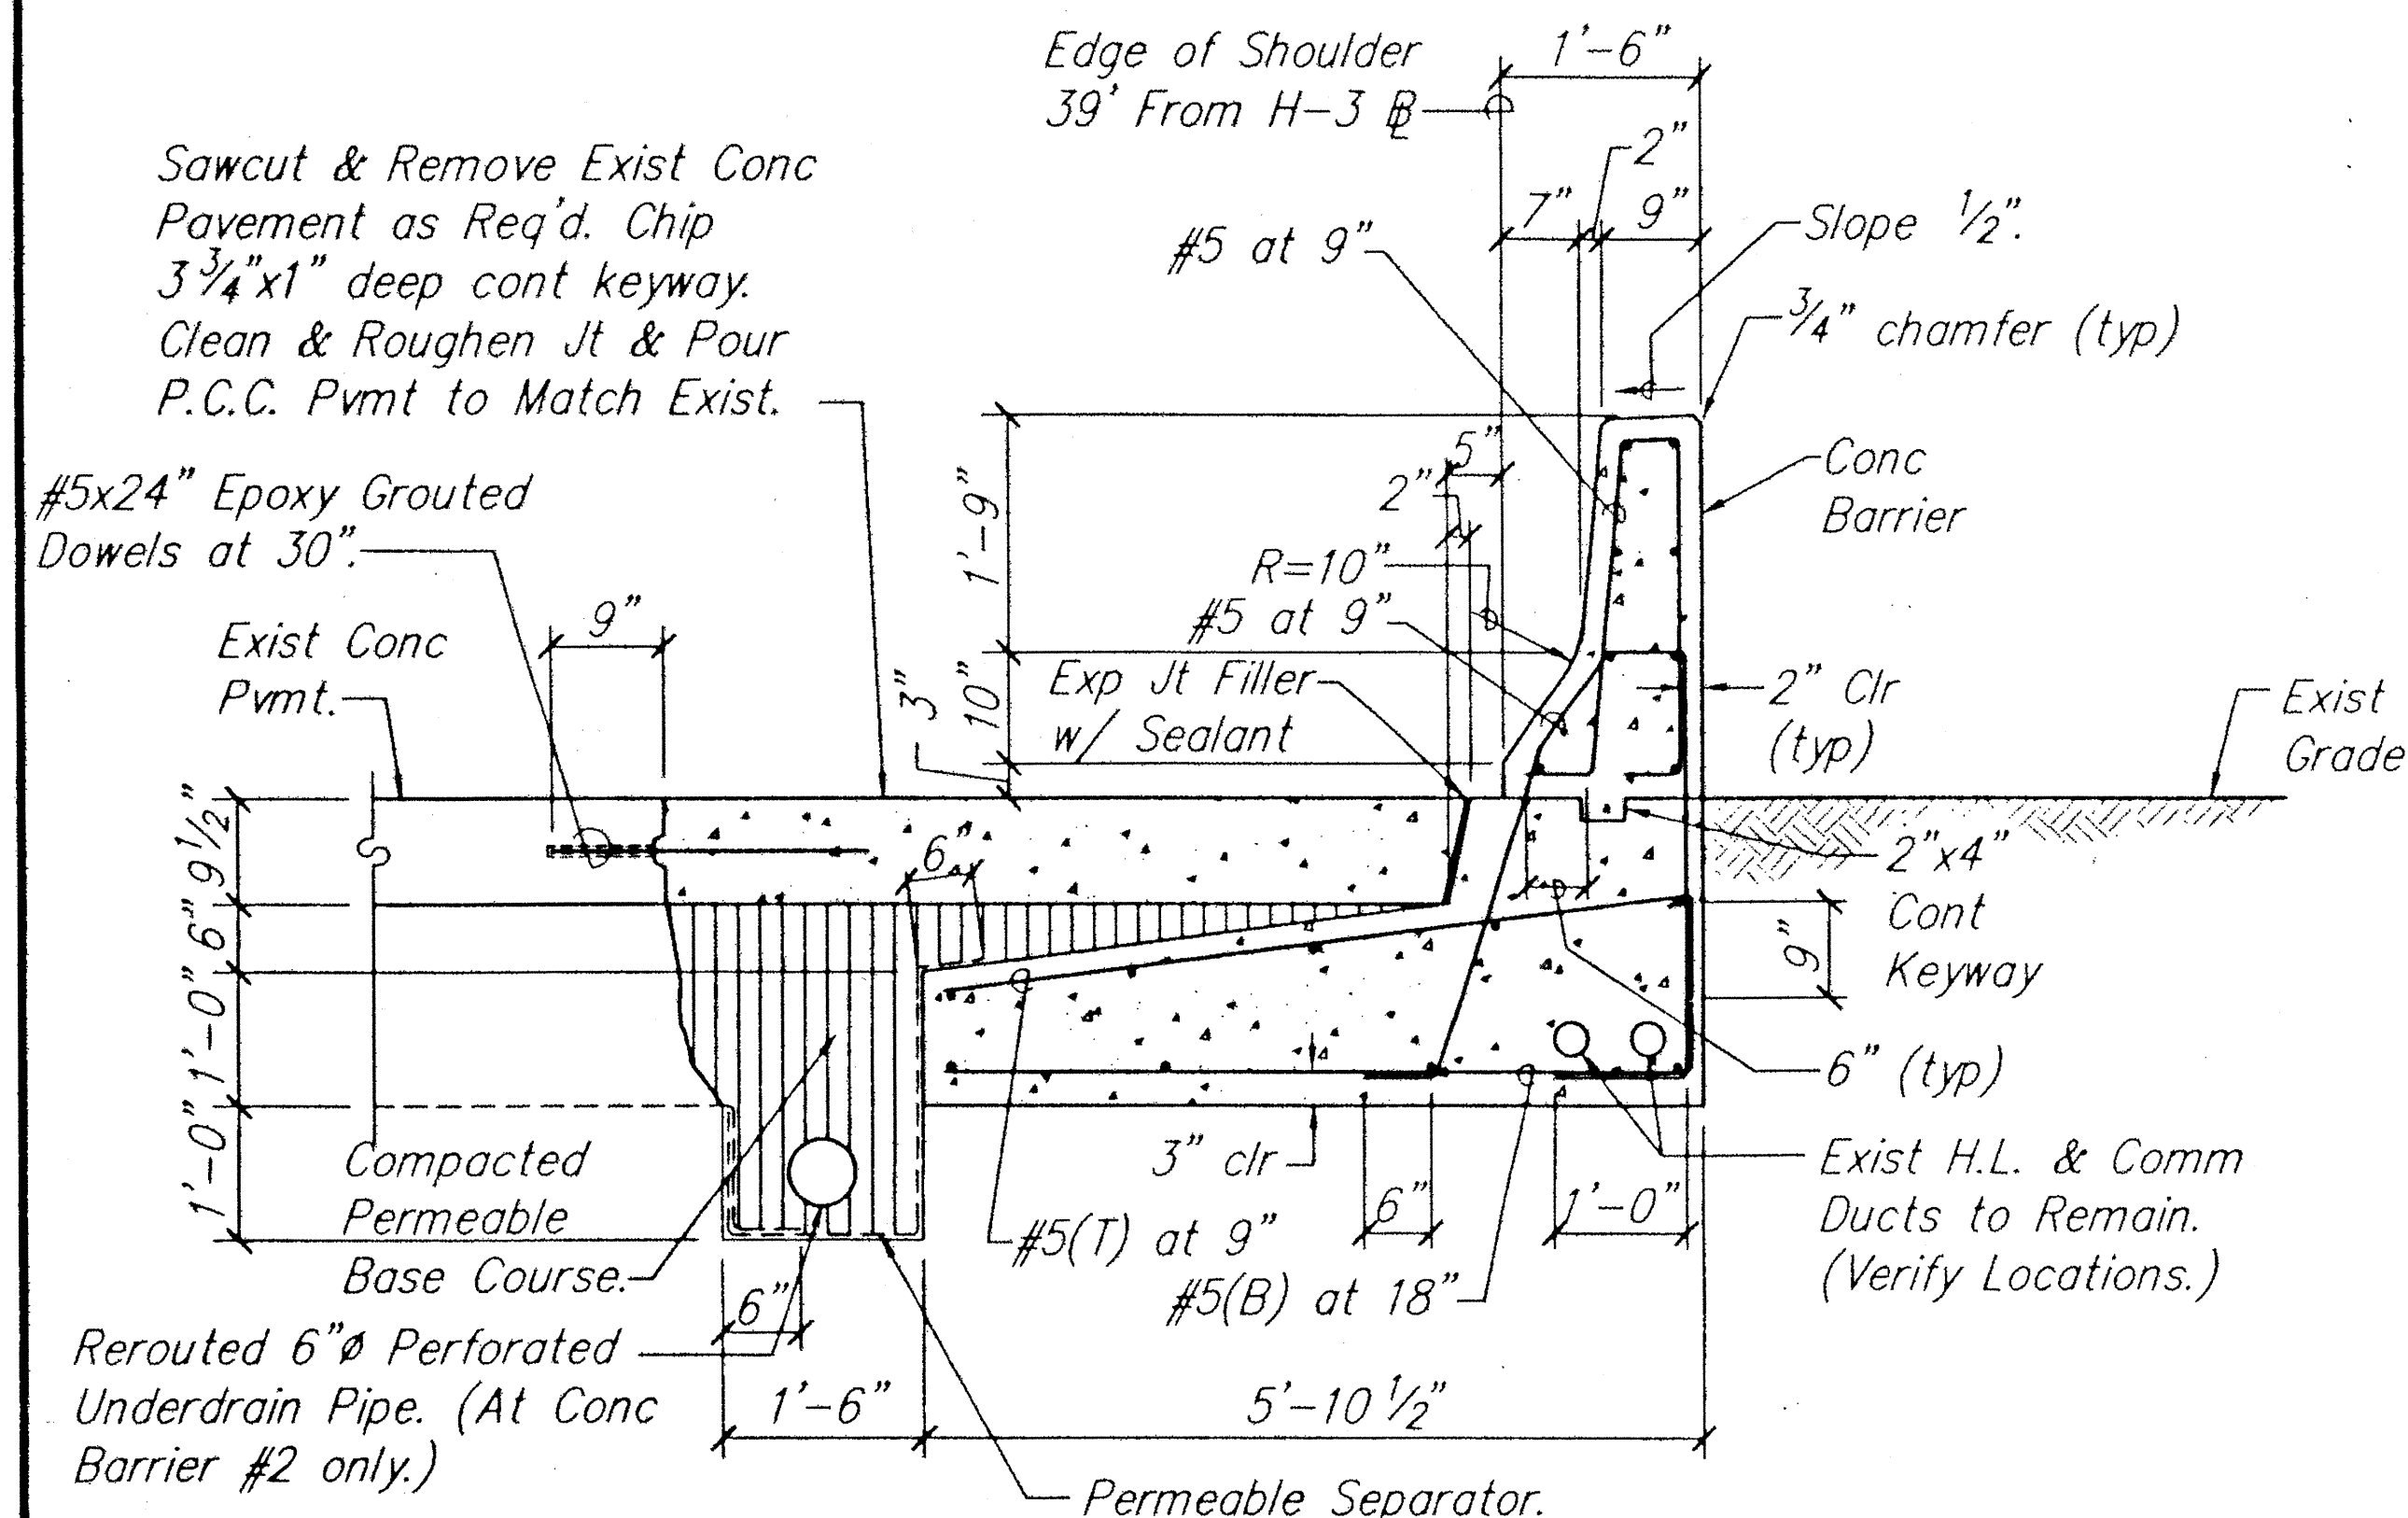


SECTION AT TYP BARRIER FOOTING

Scale: $\frac{3}{4}$ " = 1'-0"

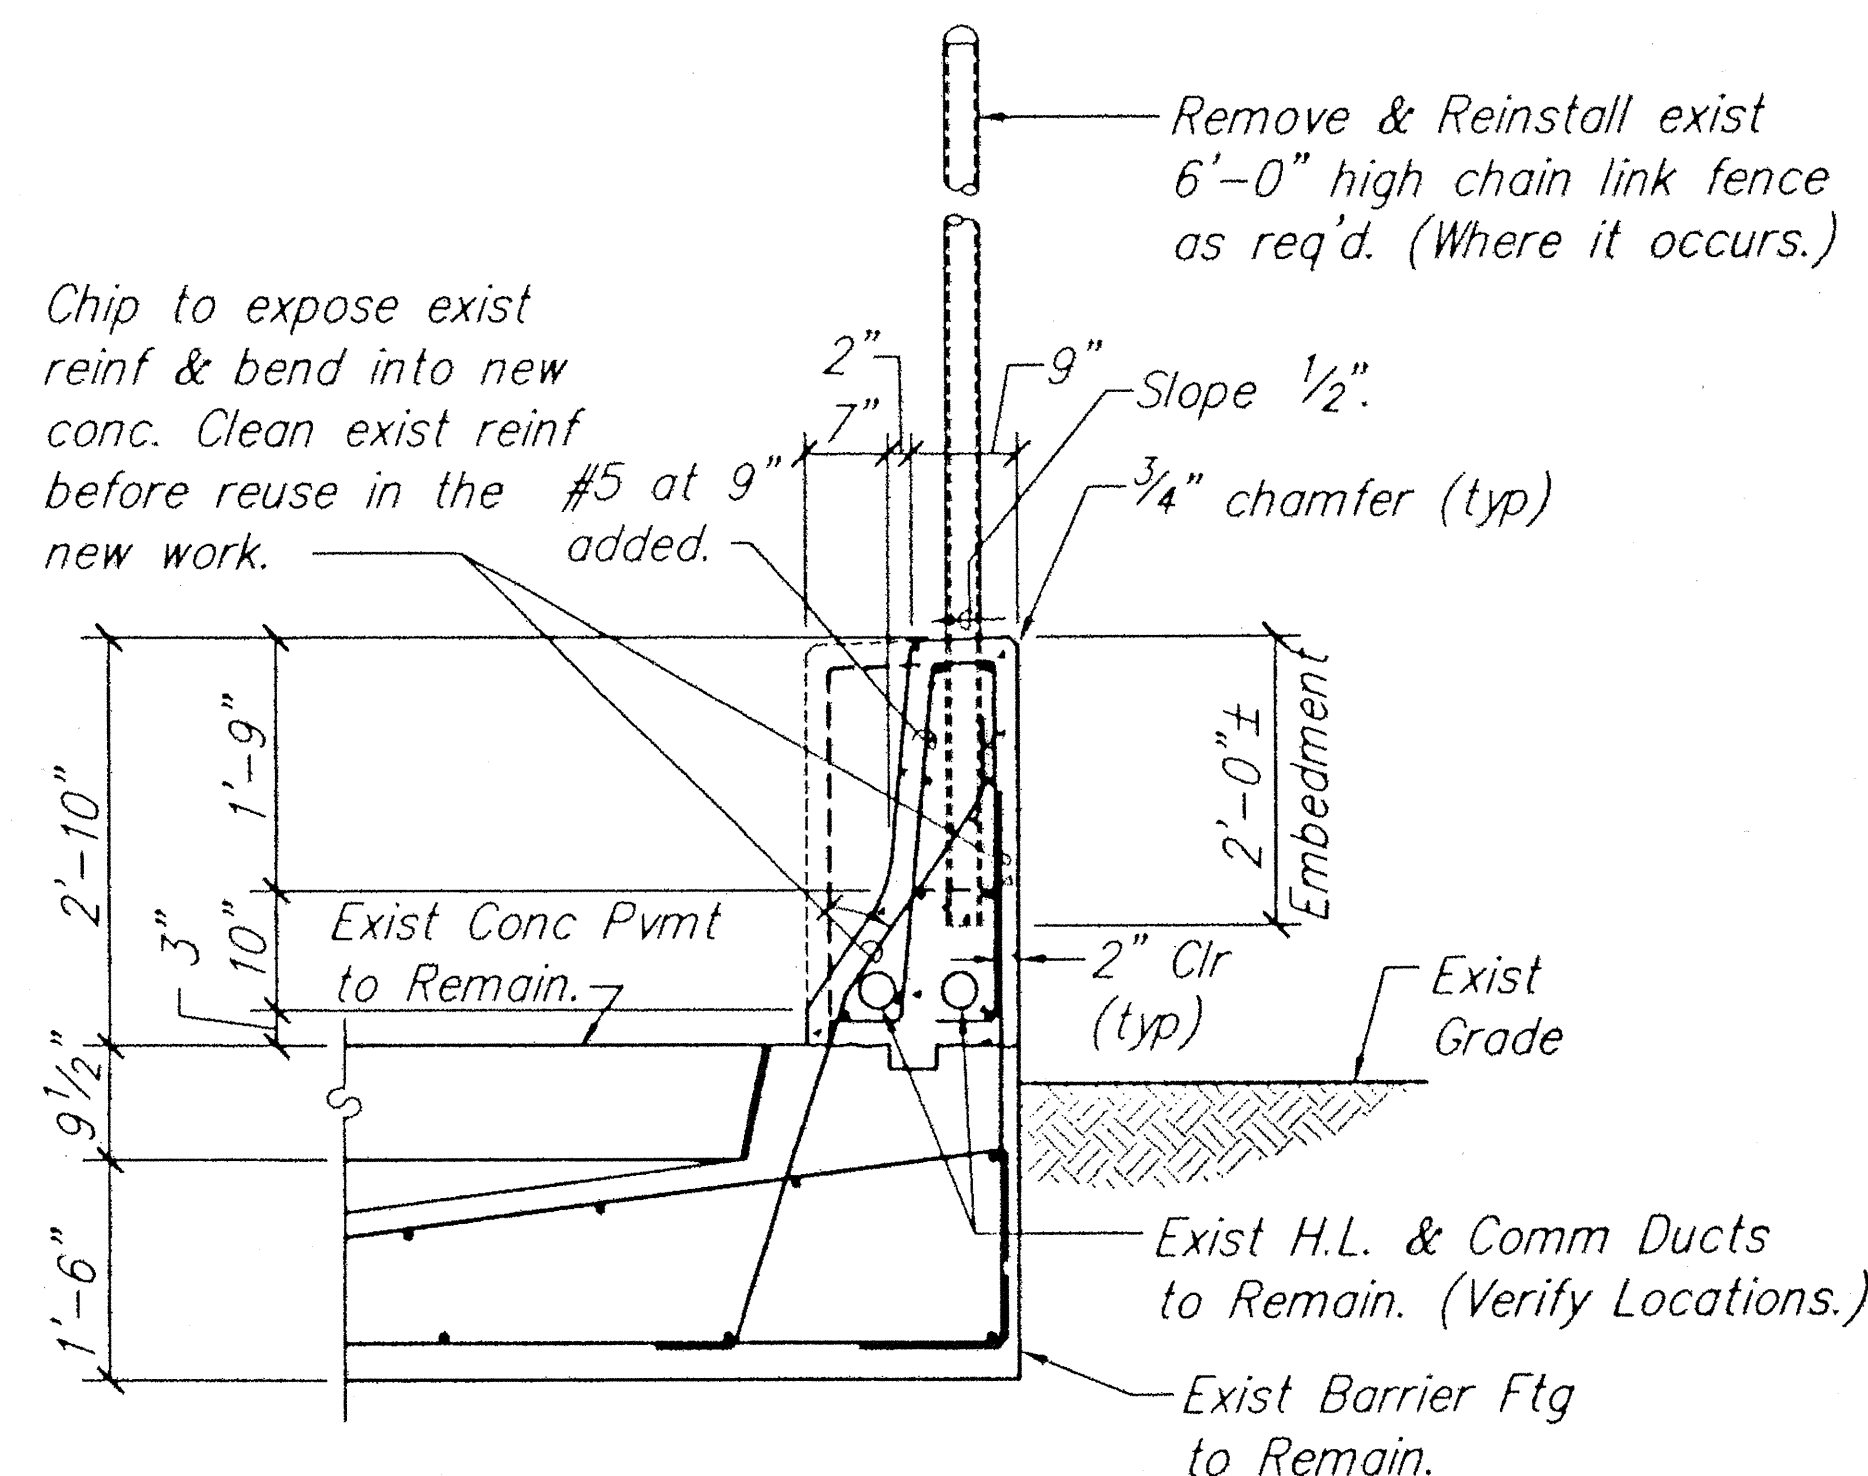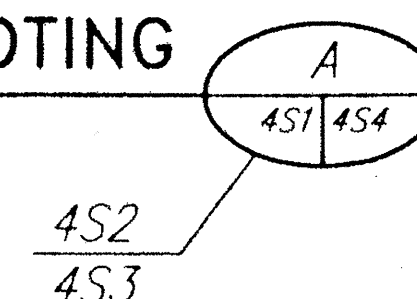


SECTION

Scale: $\frac{3}{4}$ " = 1'-0"

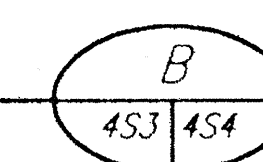



Concrete Barrier & Guardrail General Notes:

- Contractor shall verify all dimensions and existing conditions before commencing work. Any discrepancies and/or inconsistencies shall be reported to the Engineer for clarification.
- Existing duct locations shown are approximate. Contractor shall verify the actual locations (in plan and elevations) of the existing highway lighting and communication ducts. Concrete encasement shall be removed and ducts rerouted and/or adjusted as needed to install the barrier and guardrail work shown. Contractor shall exercise care during demolition and removal of concrete around ductlines to remain. Damaged ducts shall be removed and replaced as directed. Concrete encasement shall be replaced as needed upon completion of the foundation work.
- Design Specifications: 15th Edition of AASHTO "Standard Specifications for Highway Bridges", 1992 with subsequent interim specifications.
- See State Standard Plans for typical metal guardrail details not shown.
- Refer to Sht 4C3 for typical end post connection details.
- Concrete shall be Class A ($f'c = 3,000$ psi).
- Reinforcing steel shall conform to ASTM A615, Grade 40.
- All steel items exposed to weather shall be hot dipped galvanized after fabrication.
- Structural steel shapes and plates shall conform to ASTM A36.
- High strength anchor bolts shall conform to ASTM A325 and be galvanized.
- Machine bolts shall conform to ASTM A307 and be galvanized.
- Epoxy bonding agents shall conform to ASTM C881, Type IV or V, Class C, Grade as suitable for the use intended.

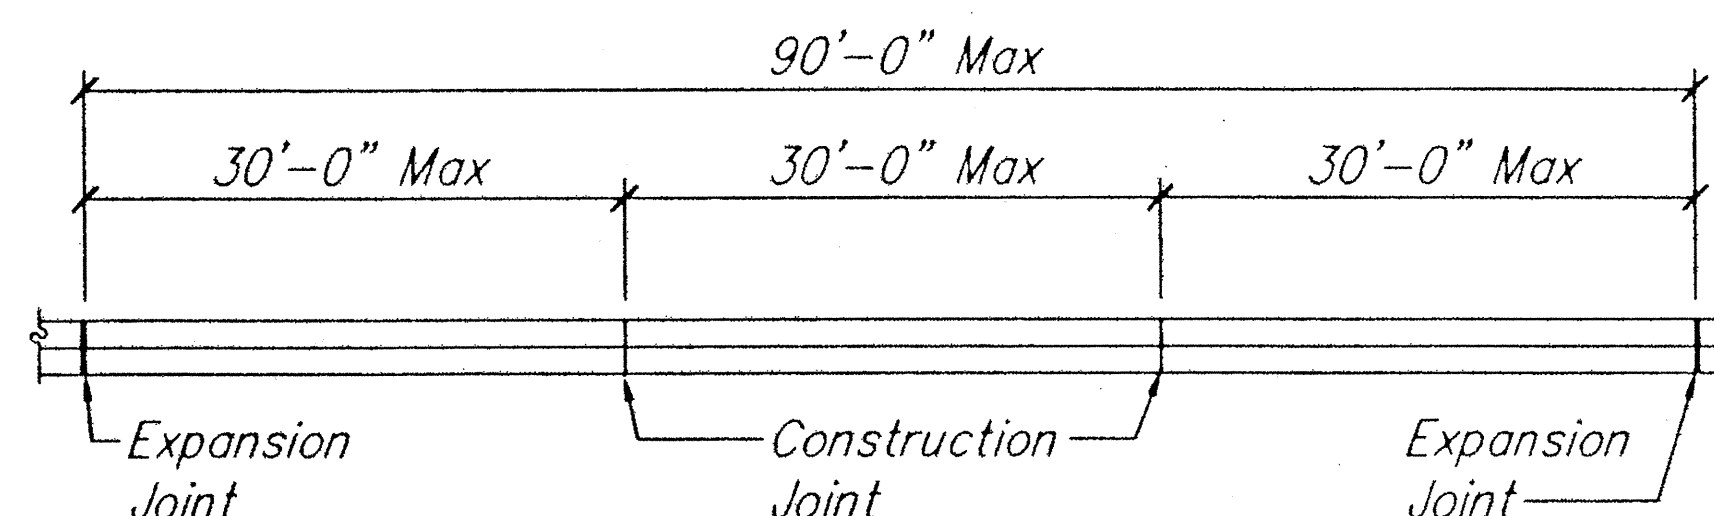

JOINT LAYOUT PLAN

Not to Scale

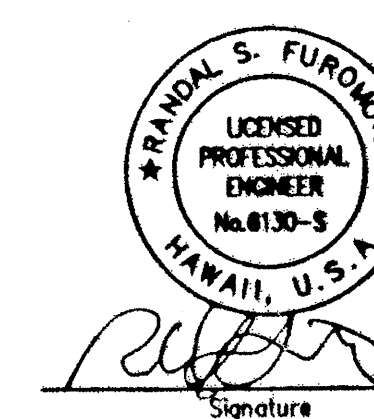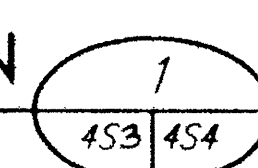

This work was prepared by me or under my supervision.


STATE OF HAWAII
DEPARTMENT OF TRANSPORTATION
HIGHWAYS DIVISION
NORTH HALAWA VALLEY
BARRIER AND GUARDRAIL CONNECTIONS
CONCRETE BARRIERS NO. 1 & 2

H-3 FINISH (UNIT II)
FAIP NO. I-H3-1(75). UNIT II
LEEWARD SECTION

SCALE: AS NOTED DATE: FEB 1997


SHEET No. 454 OF 10 SHEETS

FED. ROAD DIST. NO.	STATE	PROJ. NO.	FISCAL YEAR	SHEET NO.	TOTAL SHEETS
HAWAII	HAW.	I-H3-1(75) UNIT II	1997	828	1102

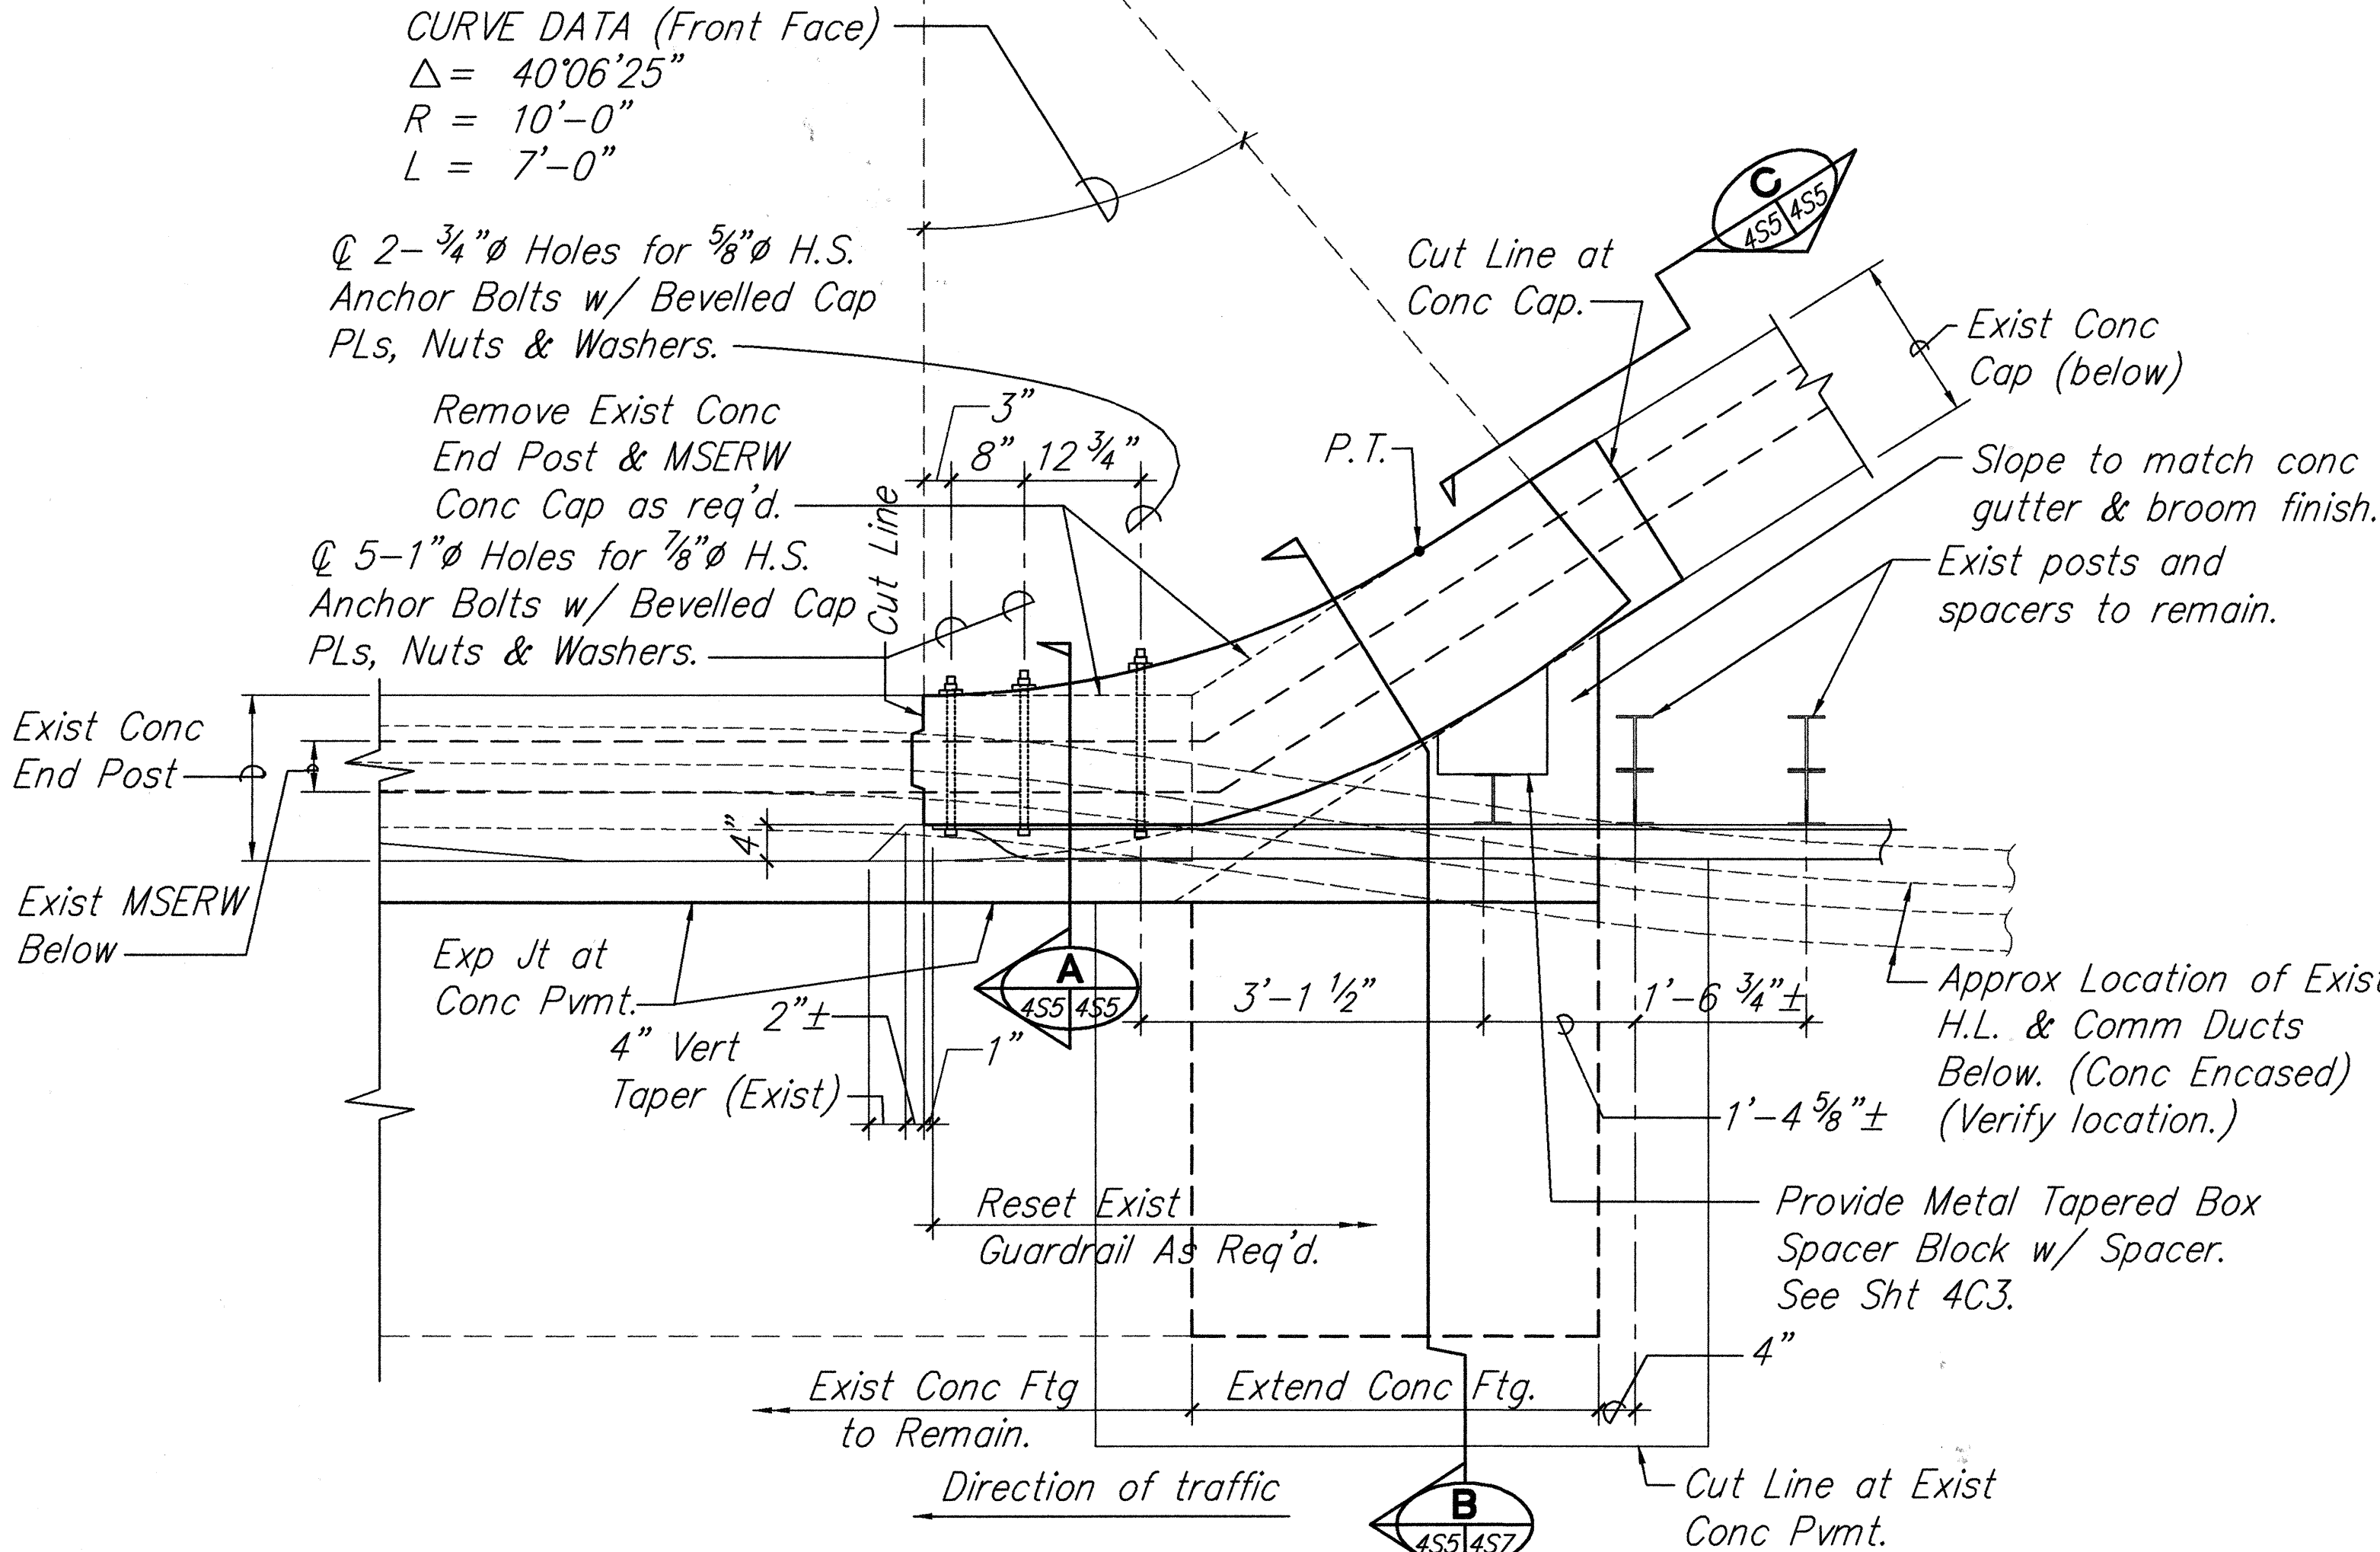

PLAN AT END POST MODIFICATION NO. 3


Scale: 3/4" = 1'-0"

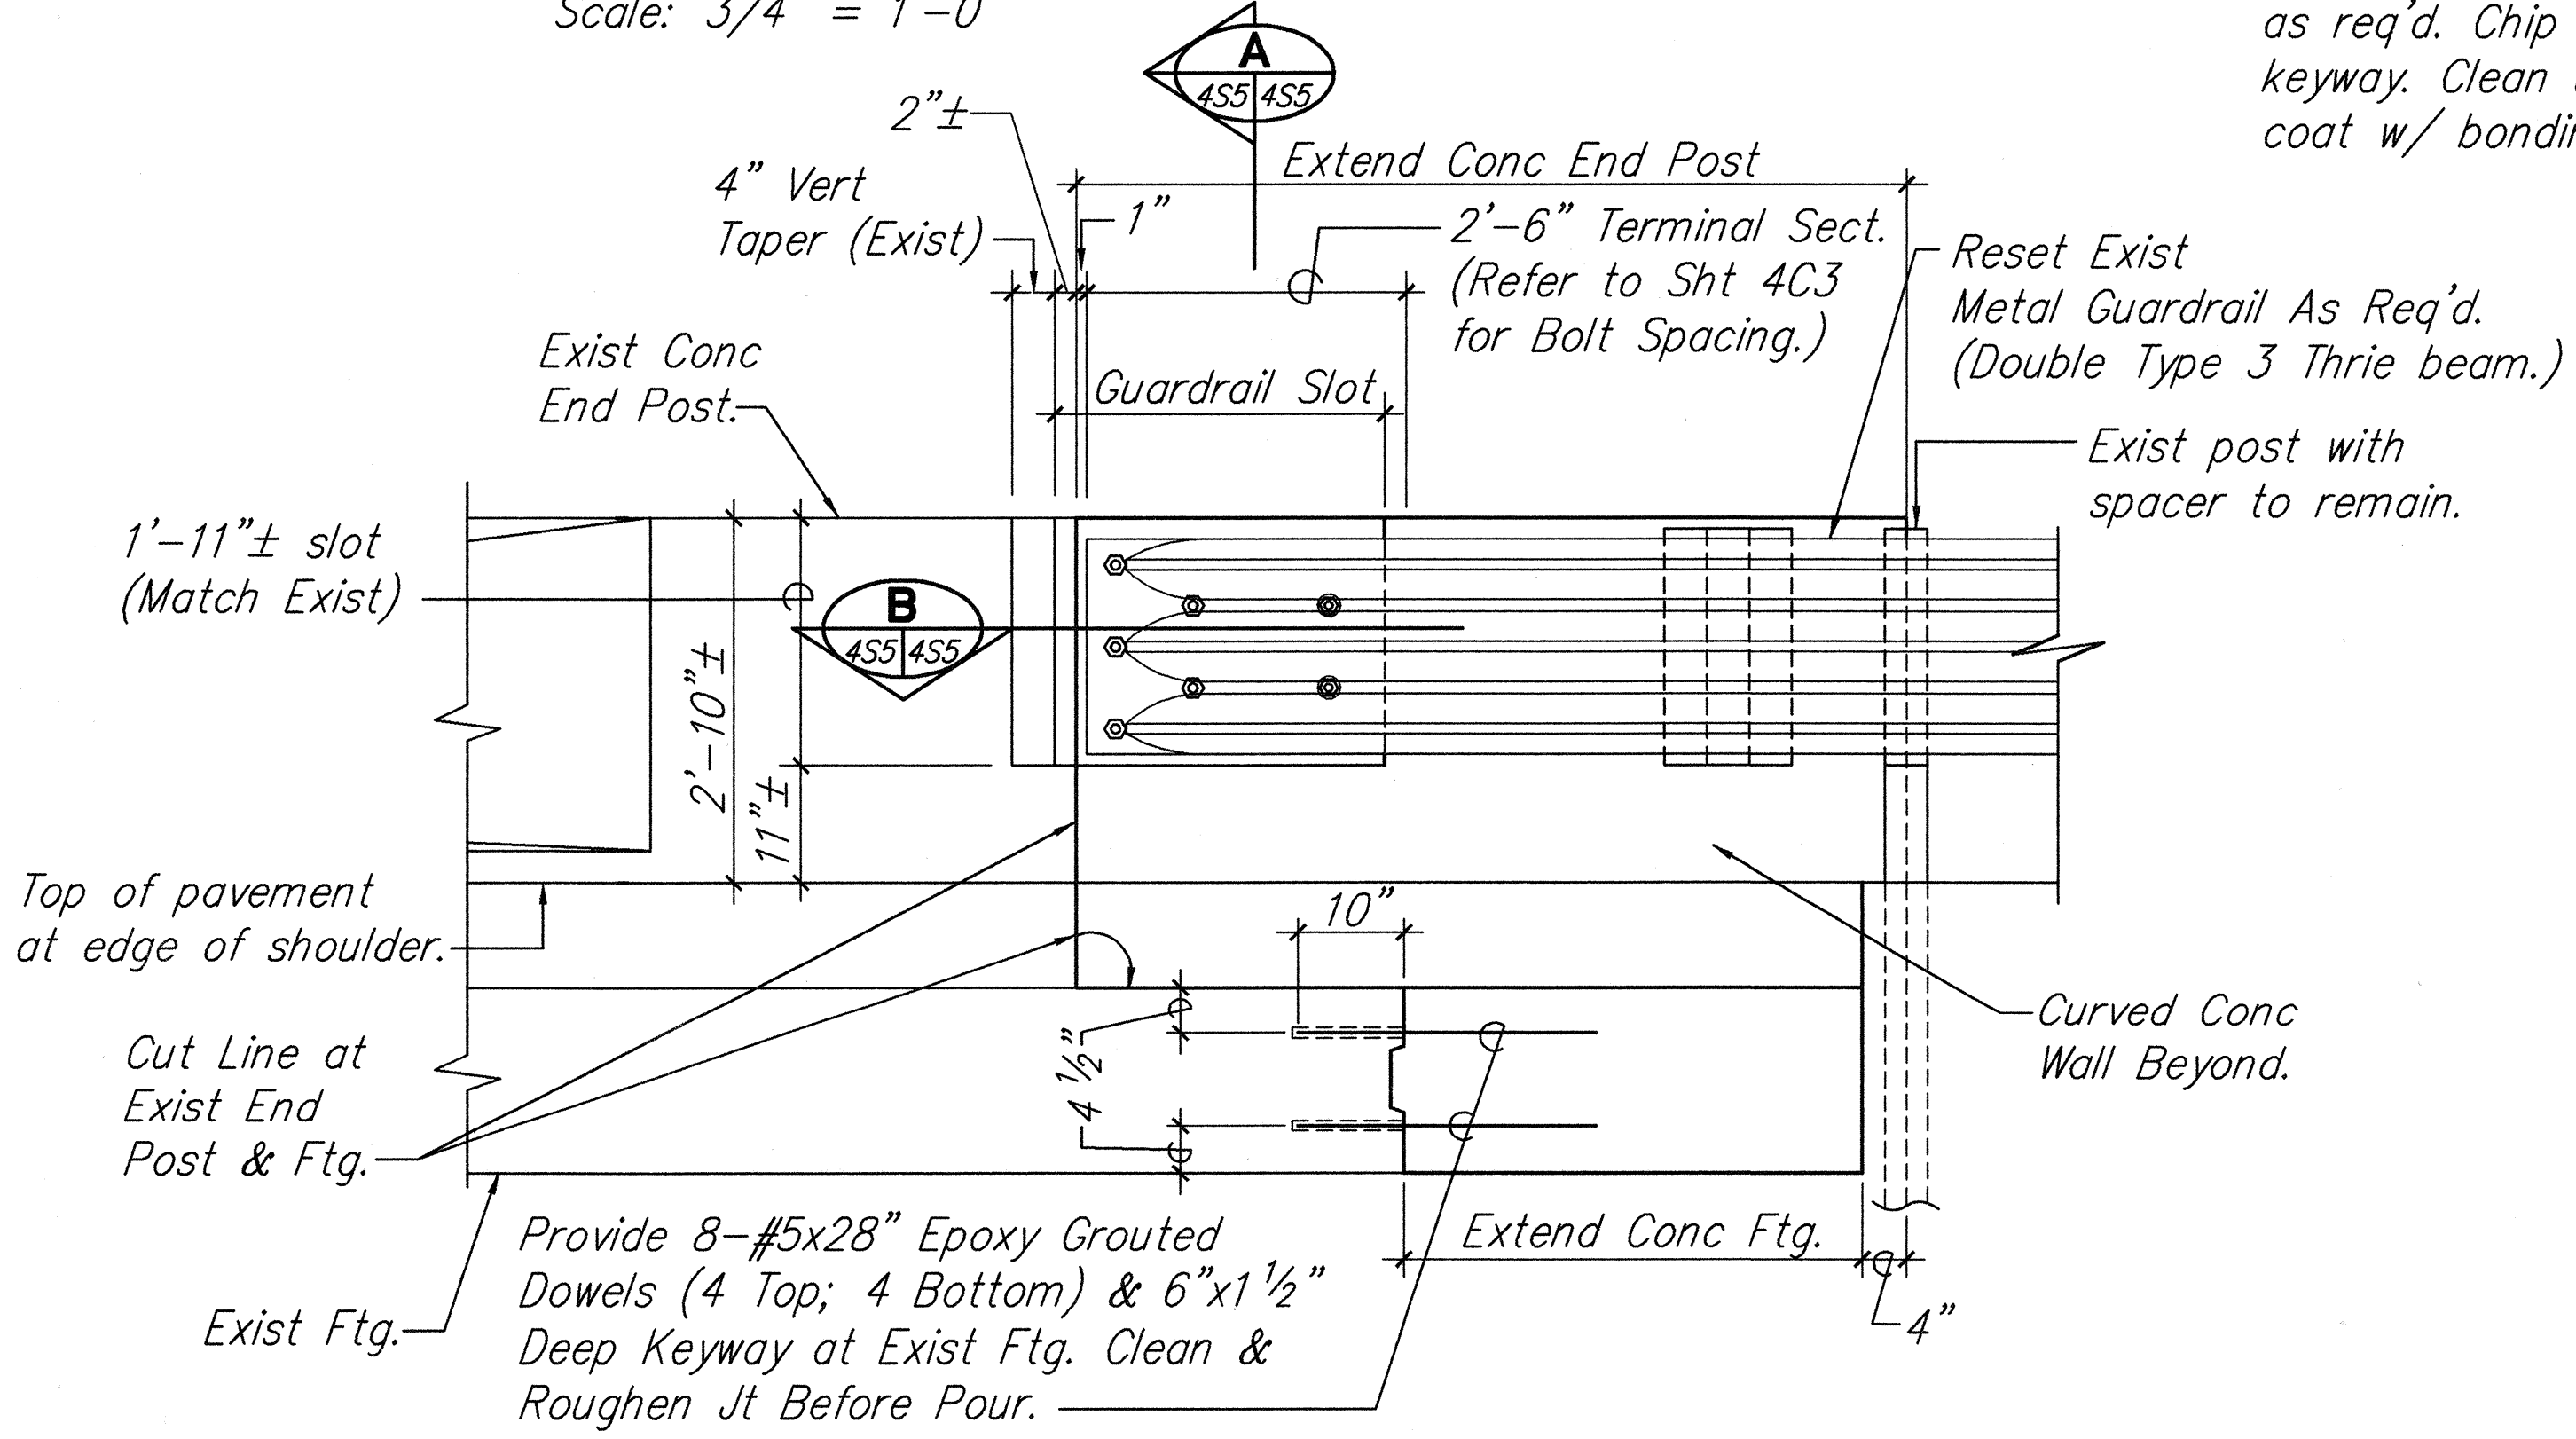

ELEVATION AT END POST MODIFICATION NO. 3


Scale: 3/4" = 1'-0"

Sawcut & remove exist end post as req'd. Chip 4"x1" deep vert keyway. Clean & roughen jt & coat w/ bonding agent before pour.

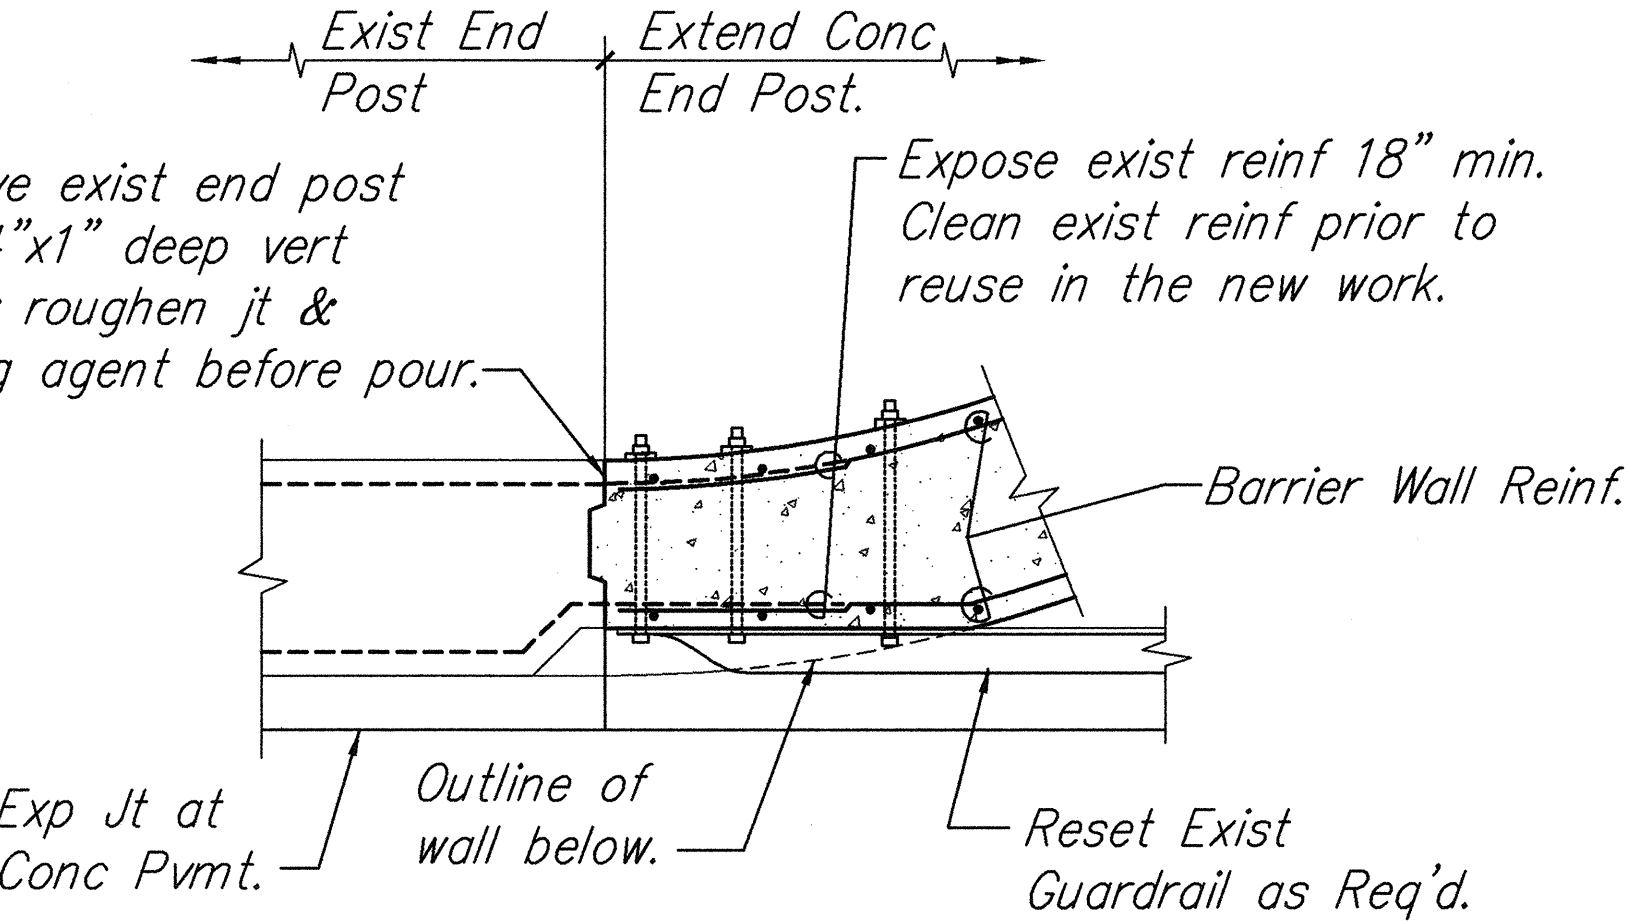


PLAN / SECTION

Scale: 3/4" = 1'-0"

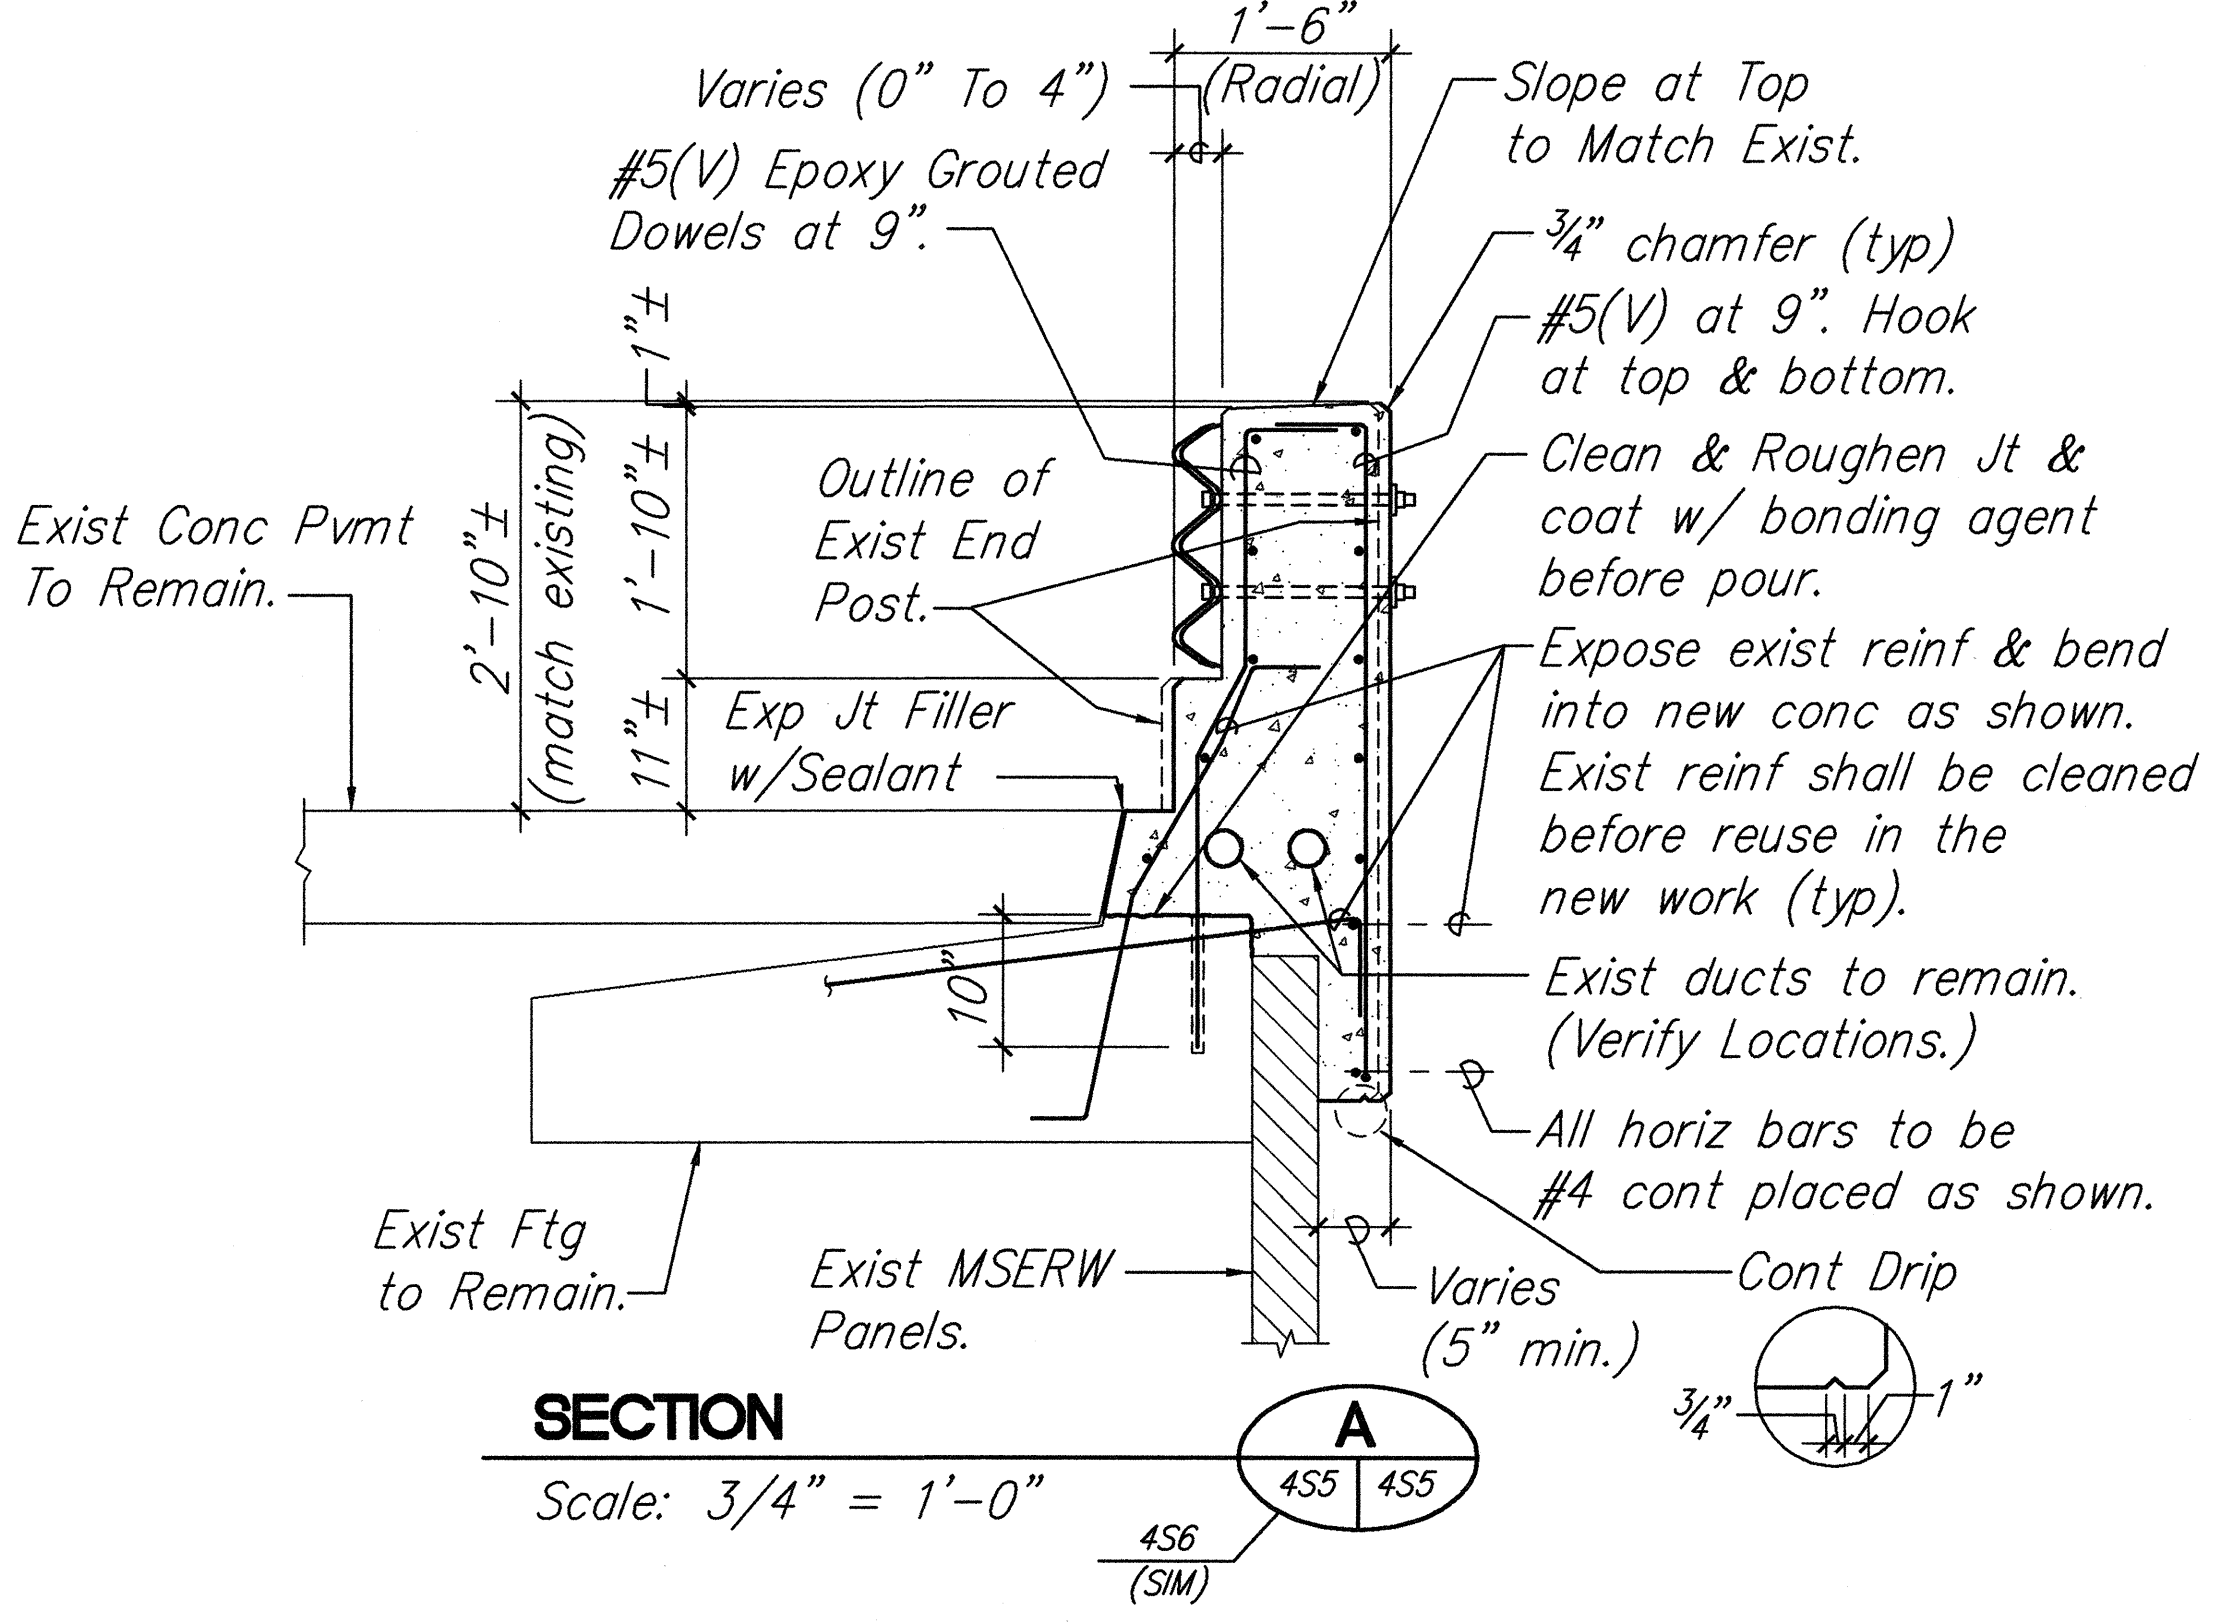


SECTION

Scale: 3/4" = 1'-0"

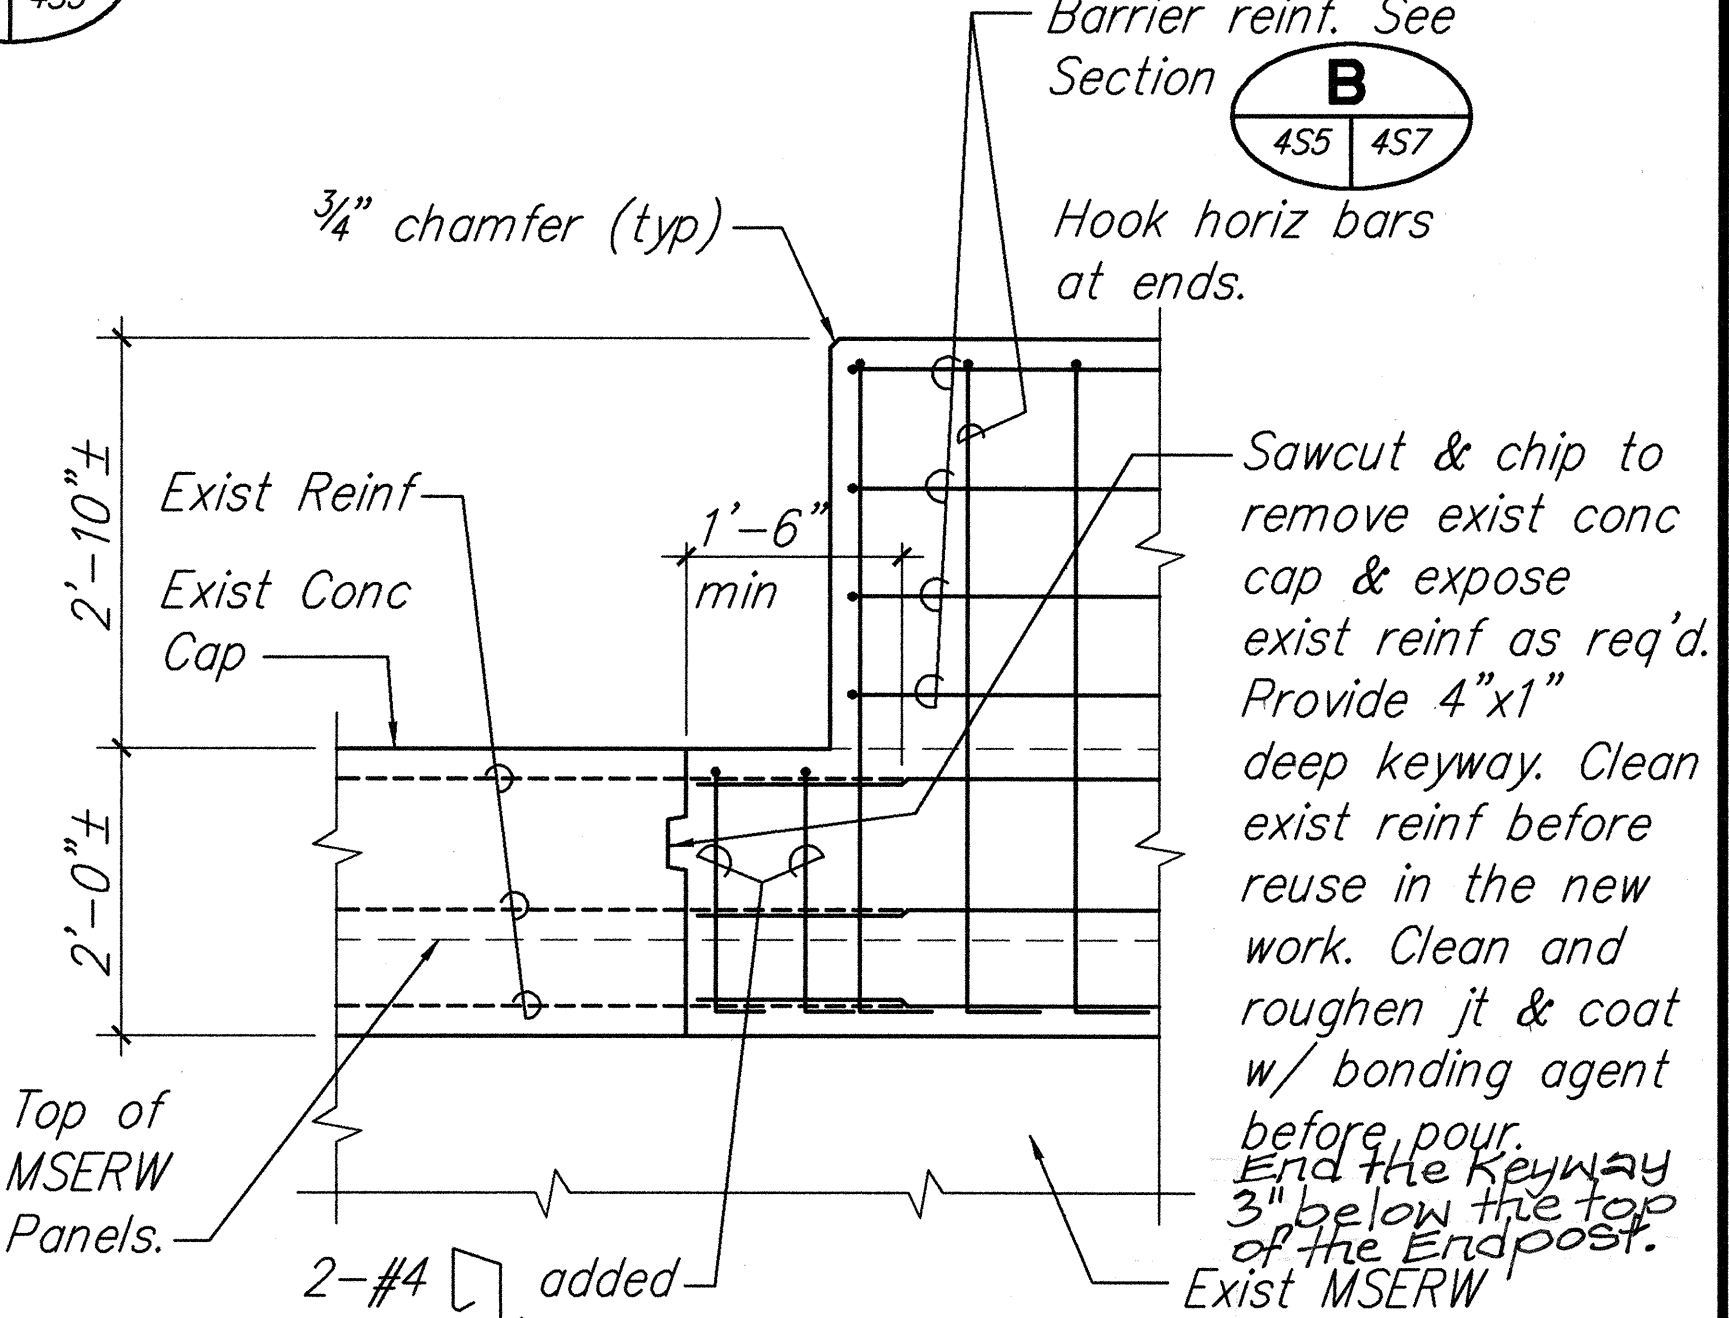

ELEVATION

Scale: 3/4" = 1'-0"

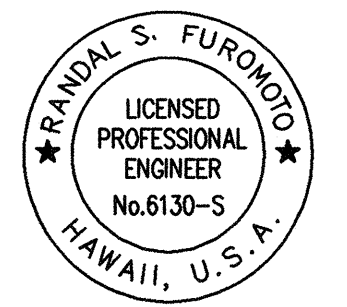


THIS WORK WAS PREPARED BY ME OR UNDER MY SUPERVISION.
Signature

STATE OF HAWAII
DEPARTMENT OF TRANSPORTATION
HIGHWAYS DIVISION
NORTH HALAWA VALLEY
BARRIER AND GUARDRAIL MODIFICATIONS
END POST MODIFICATION NO. 3


H-3 FINISH (UNIT II)
FAIP NO. I-H3-1(75), UNIT II
LEEWARD SECTION

SCALE: AS NOTED DATE: FEB 1997
SHEET No. 455 OF 10 SHEETS

ORIGINAL PLAN	SURVEY PLOTTED BY _____ DATE _____
NOTE BOOK	DRAWN BY _____ " _____
	TRACED BY _____ " _____
	DESIGNED BY _____ " _____
	QUANTITIES BY _____ " _____
No. _____	CHECKED BY _____

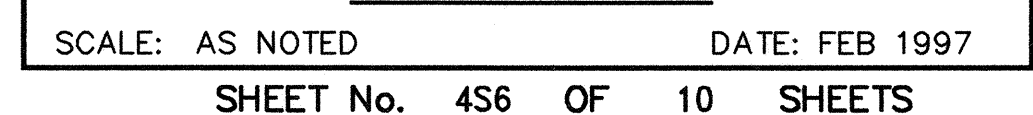


FED. ROAD DIST. NO.	STATE	PROJ. NO.	FISCAL YEAR	SHEET NO.	TOTAL SHEETS
HAWAII	HAW.	I-H3-1(75) UNIT II	1997	830	1102

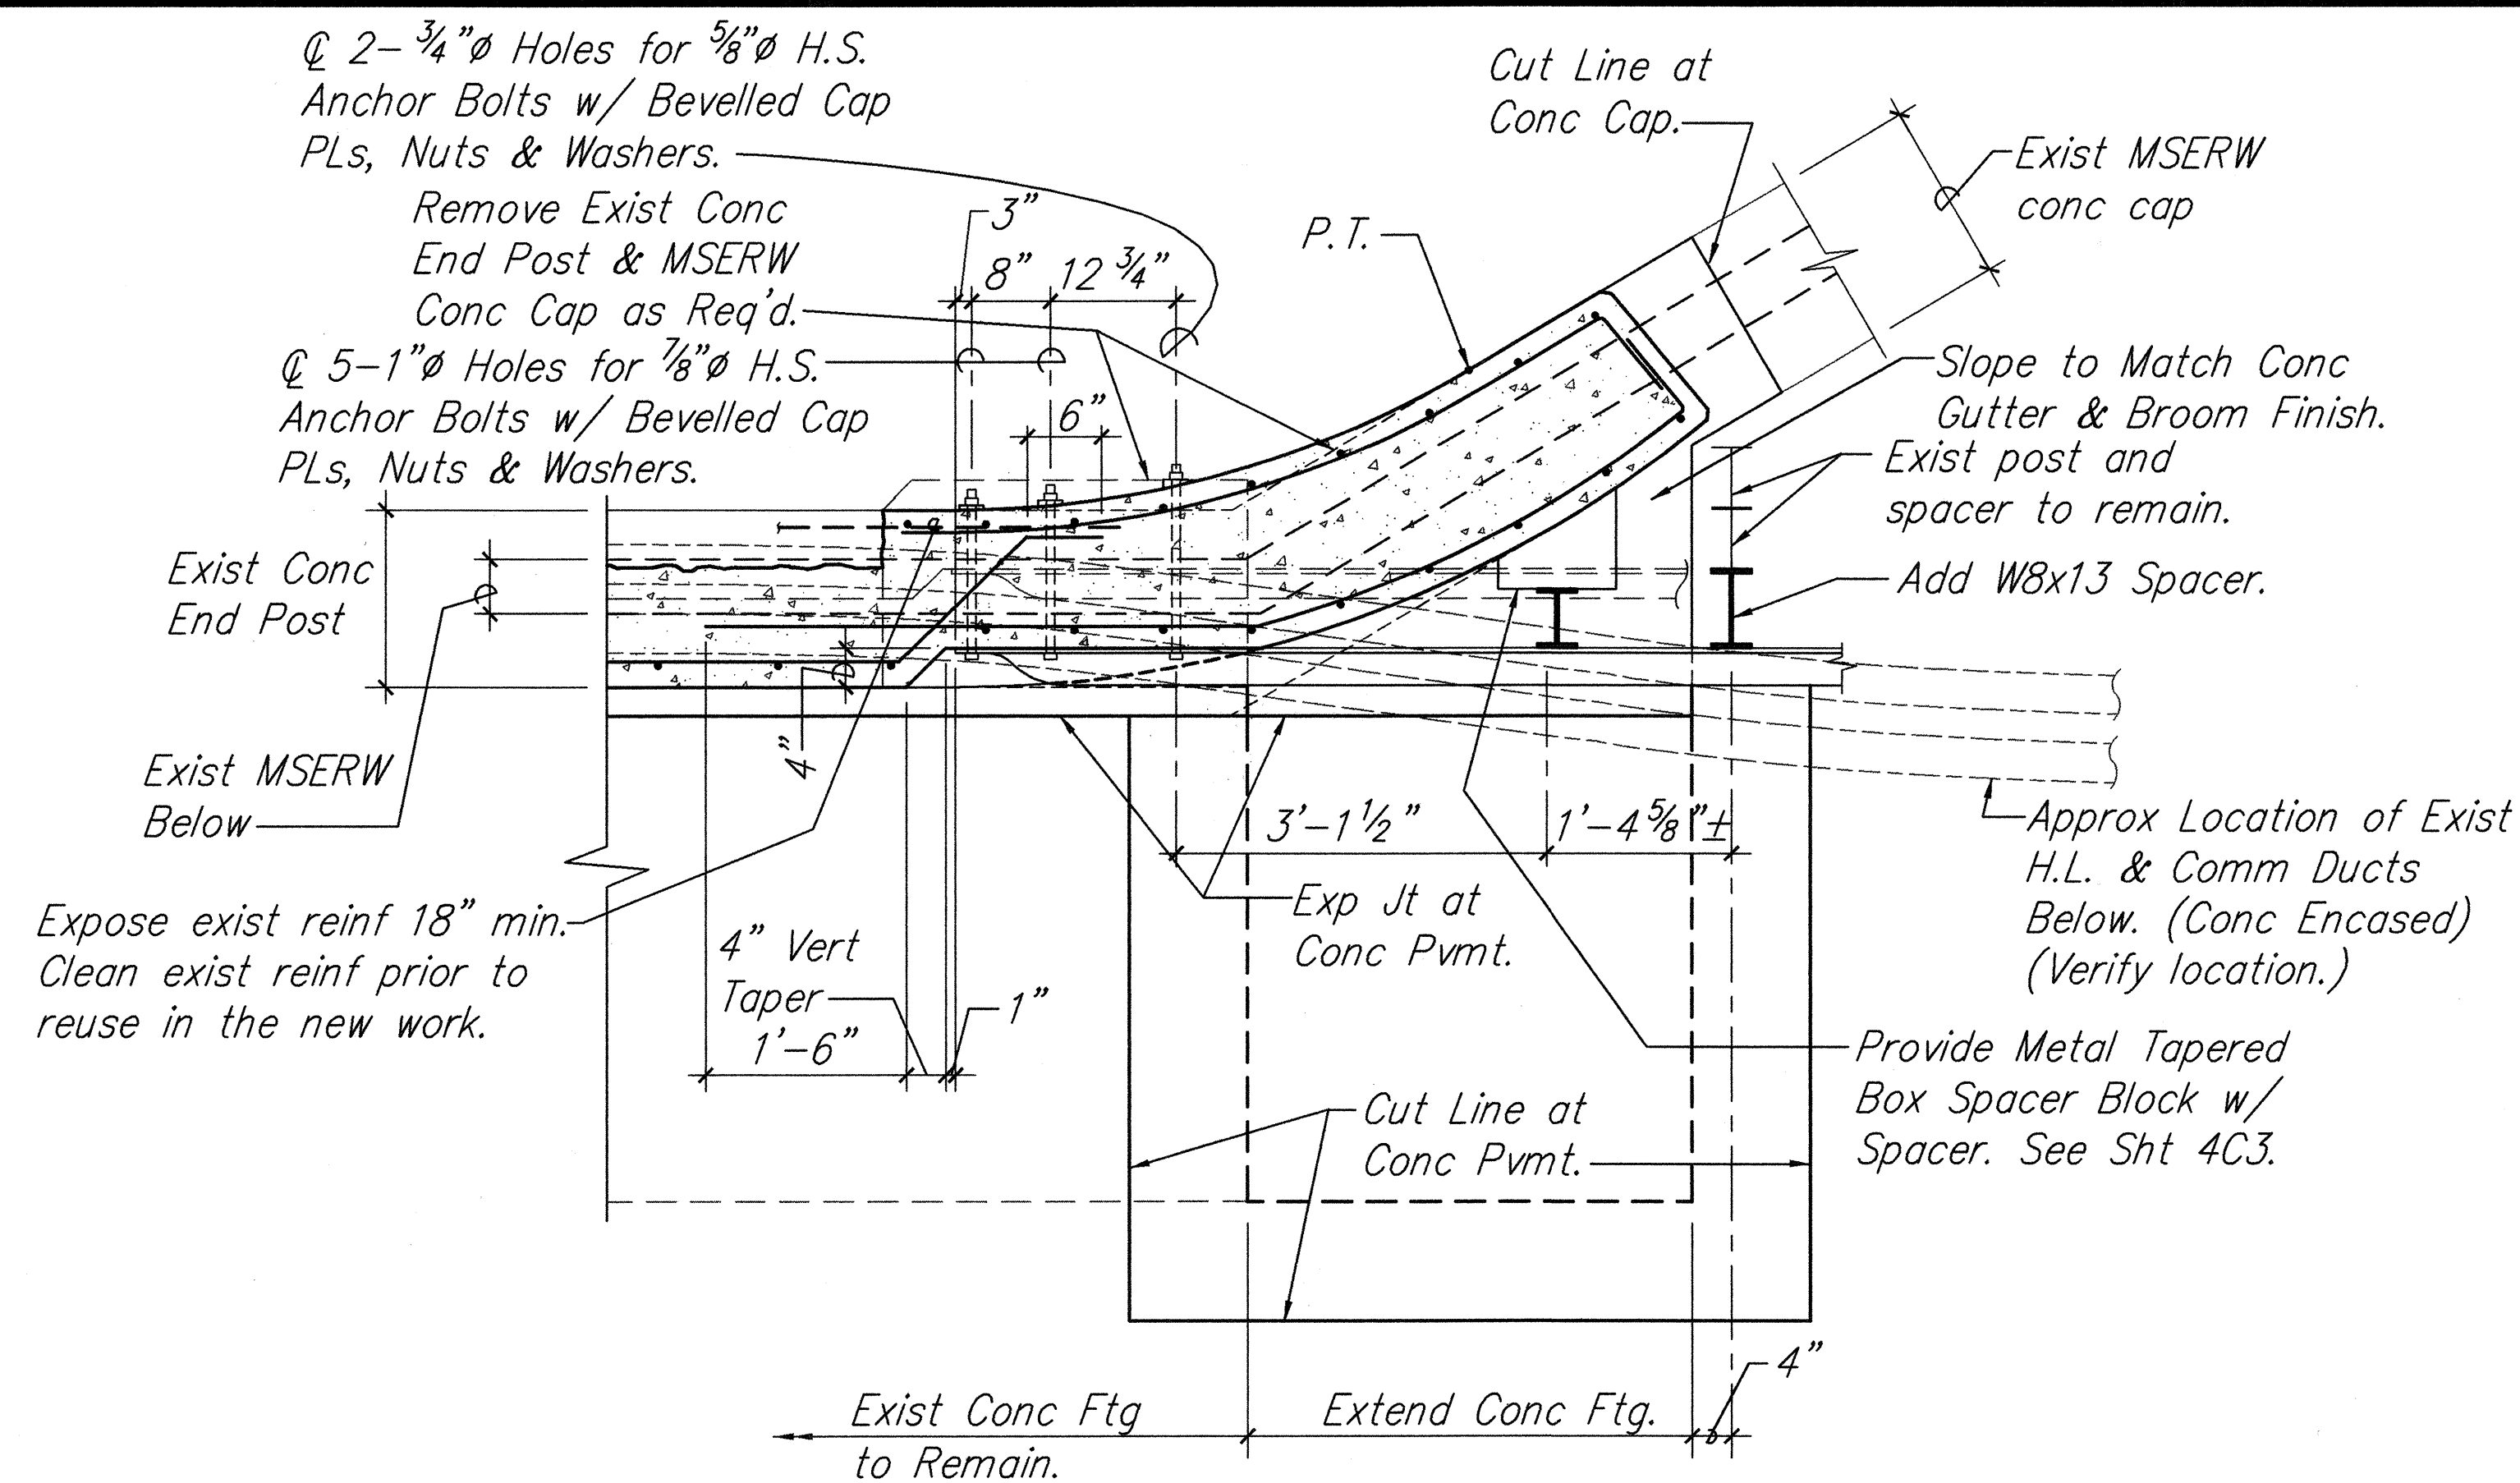


PLAN / SECTION AT END POST MODIFICATION NO. 4

Scale: $\frac{3}{4}$ " = 1'-0"

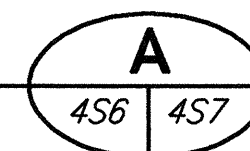


Sawcut & remove exist conc pavement as req'd. Chip $3\frac{3}{4}$ "x1" deep cont keyway. Clean & roughen jt & pour P.C.C. pvmt to match exist.

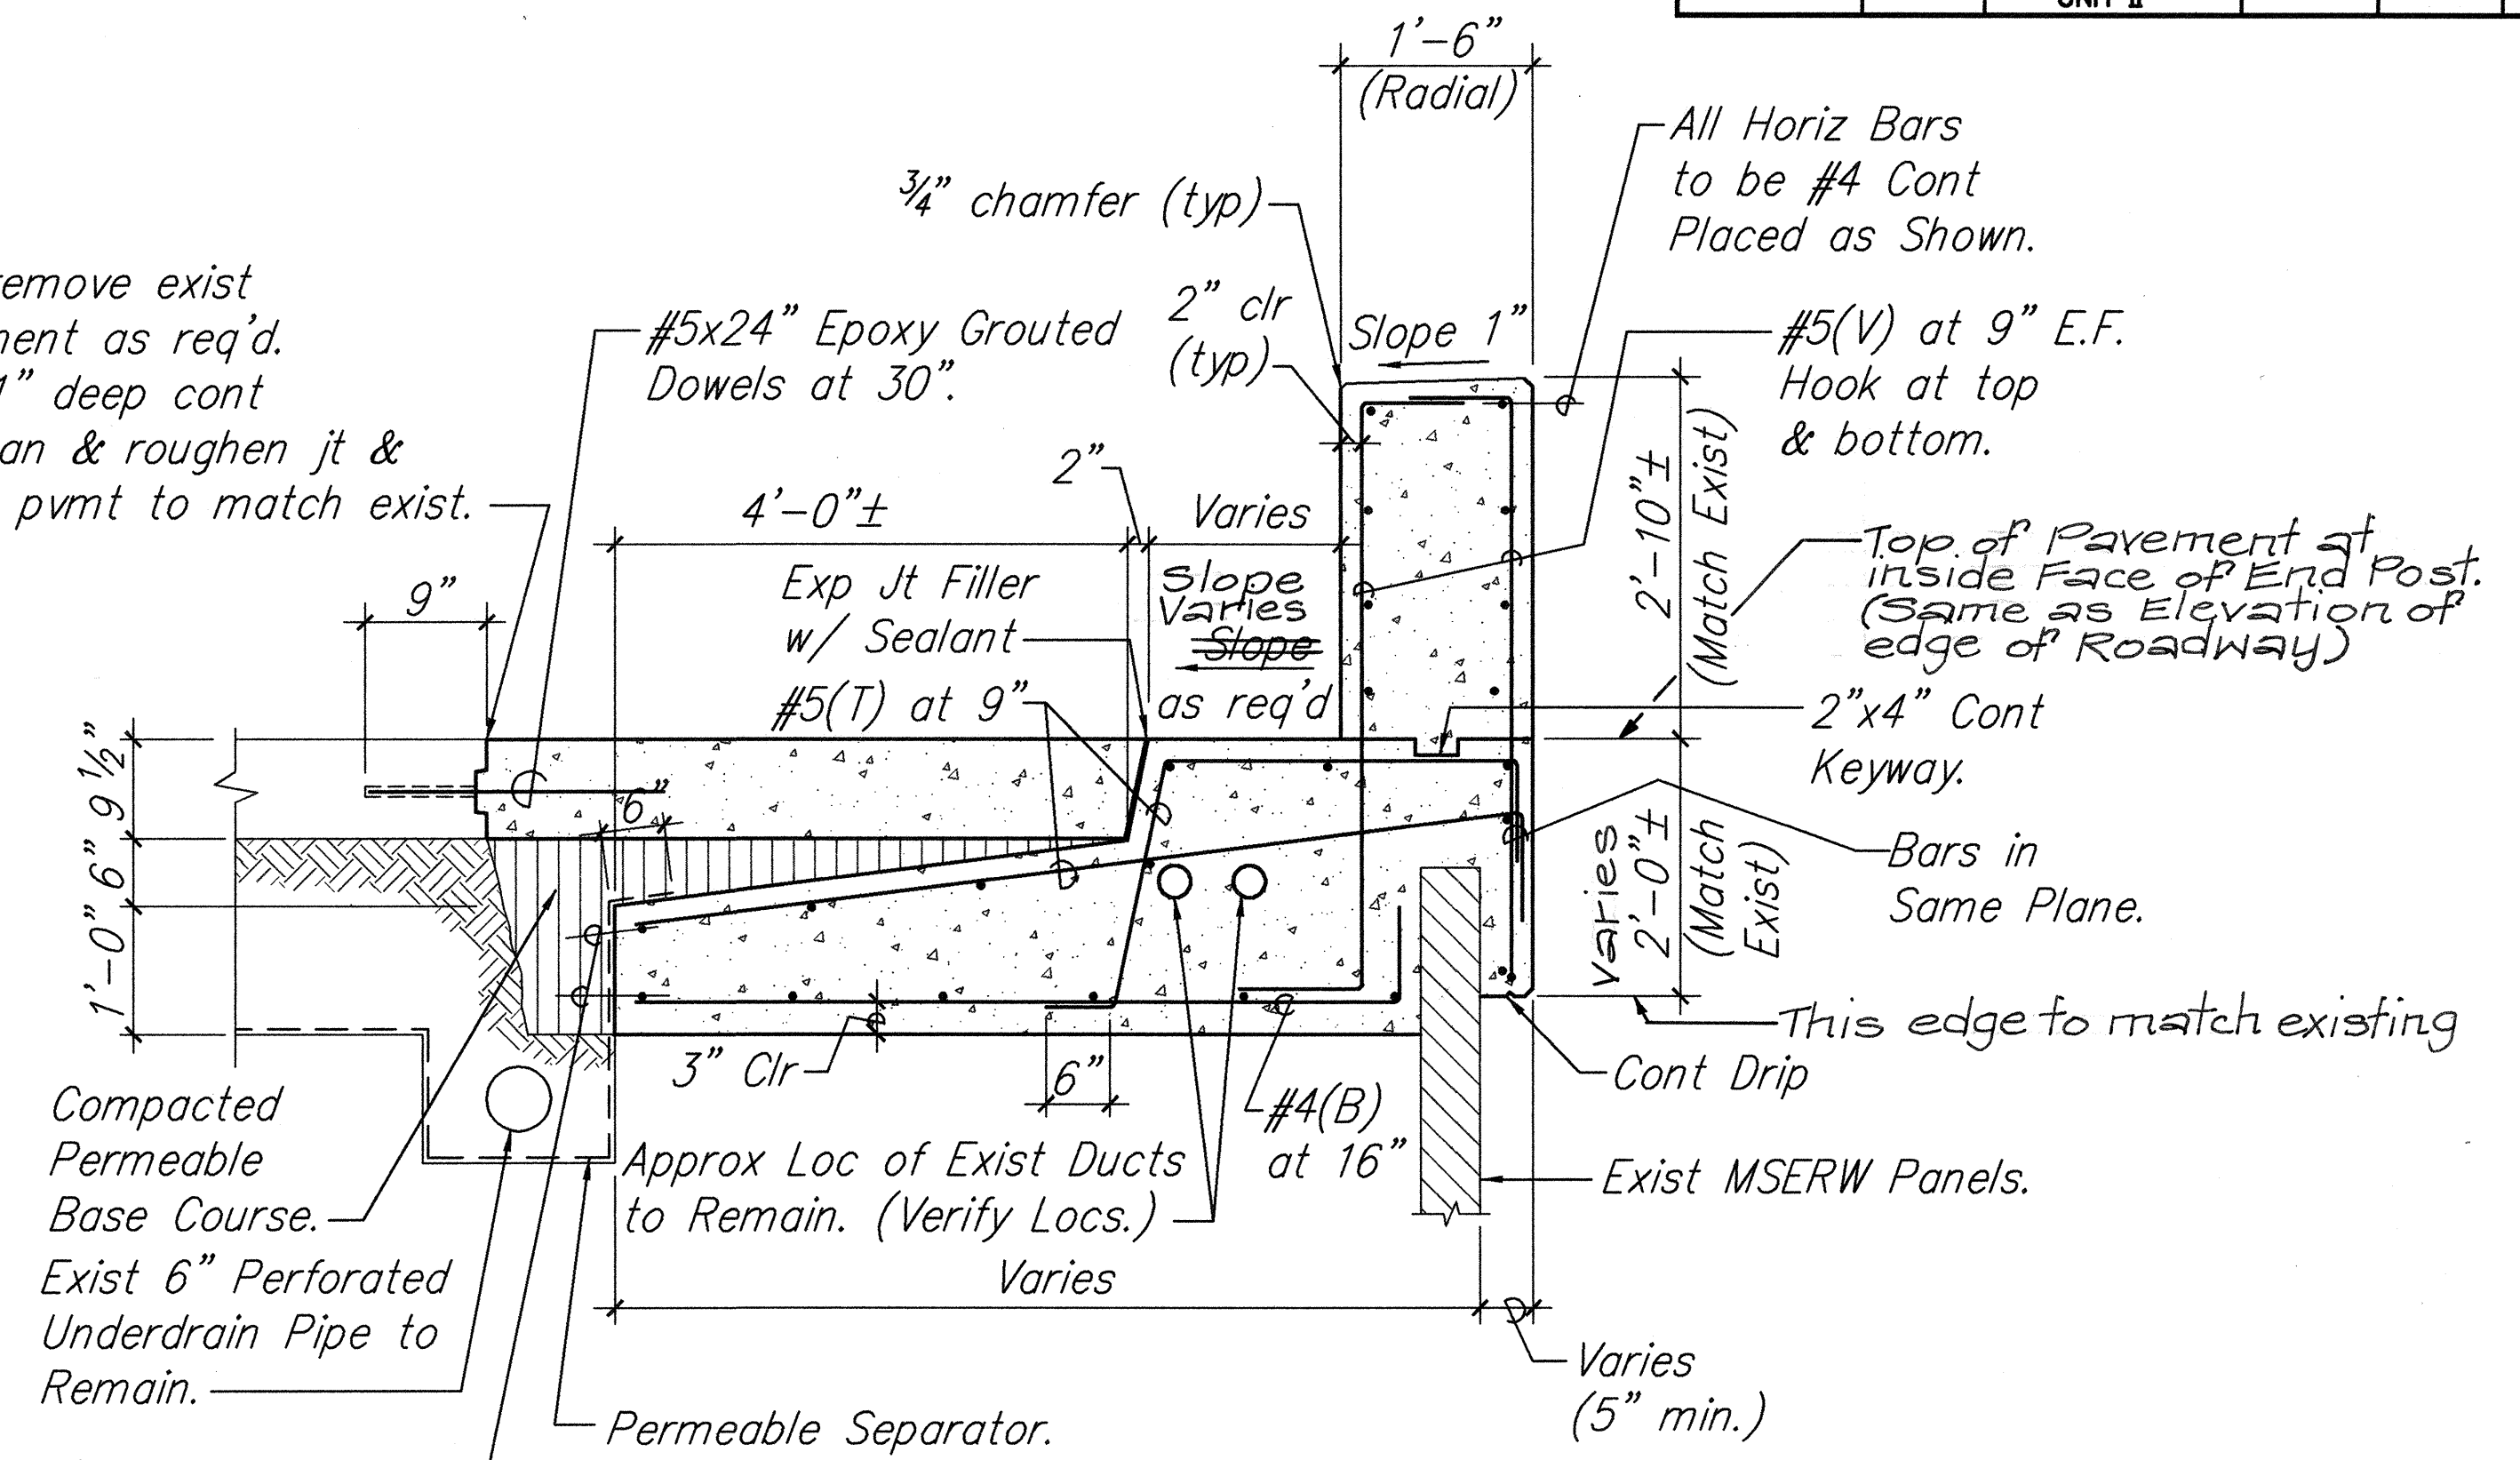


SECTION

Scale: $\frac{3}{4}$ " = 1'-0"

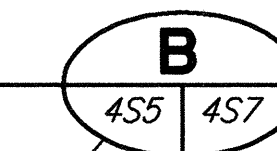



DATE	_____
DESIGNED BY	_____
CHECKED BY	_____
NOTED BY	_____
ORIGINAL PLAN	_____
NOTE BOOK	_____
No.	_____

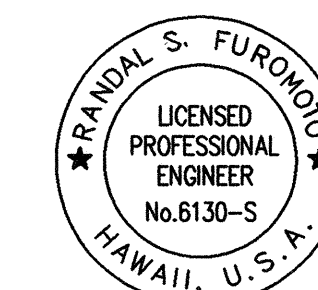


THIS WORK WAS PREPARED BY
 ME OR UNDER MY SUPERVISION.
 Signature

STATE OF HAWAII
 DEPARTMENT OF TRANSPORTATION
 HIGHWAYS DIVISION
 NORTH HALAWA VALLEY
 BARRIER AND GUARDRAIL MODIFICATIONS
 END POST MODIFICATION NO. 4
 H-3 FINISH (UNIT II)
 FAIP NO. I-H3-1(75), UNIT II
 LEEWARD SECTION
 SCALE: AS NOTED DATE: FEB 1997
 SHEET No. 4S7 OF 10 SHEETS

FED. ROAD DIST. NO.	STATE	FED. AID PROJ. NO.	FISCAL YEAR	SHEET NO.	TOTAL SHEETS
HAWAII	HAW.	I-H3-1(75), UNIT II	1997	831	1102

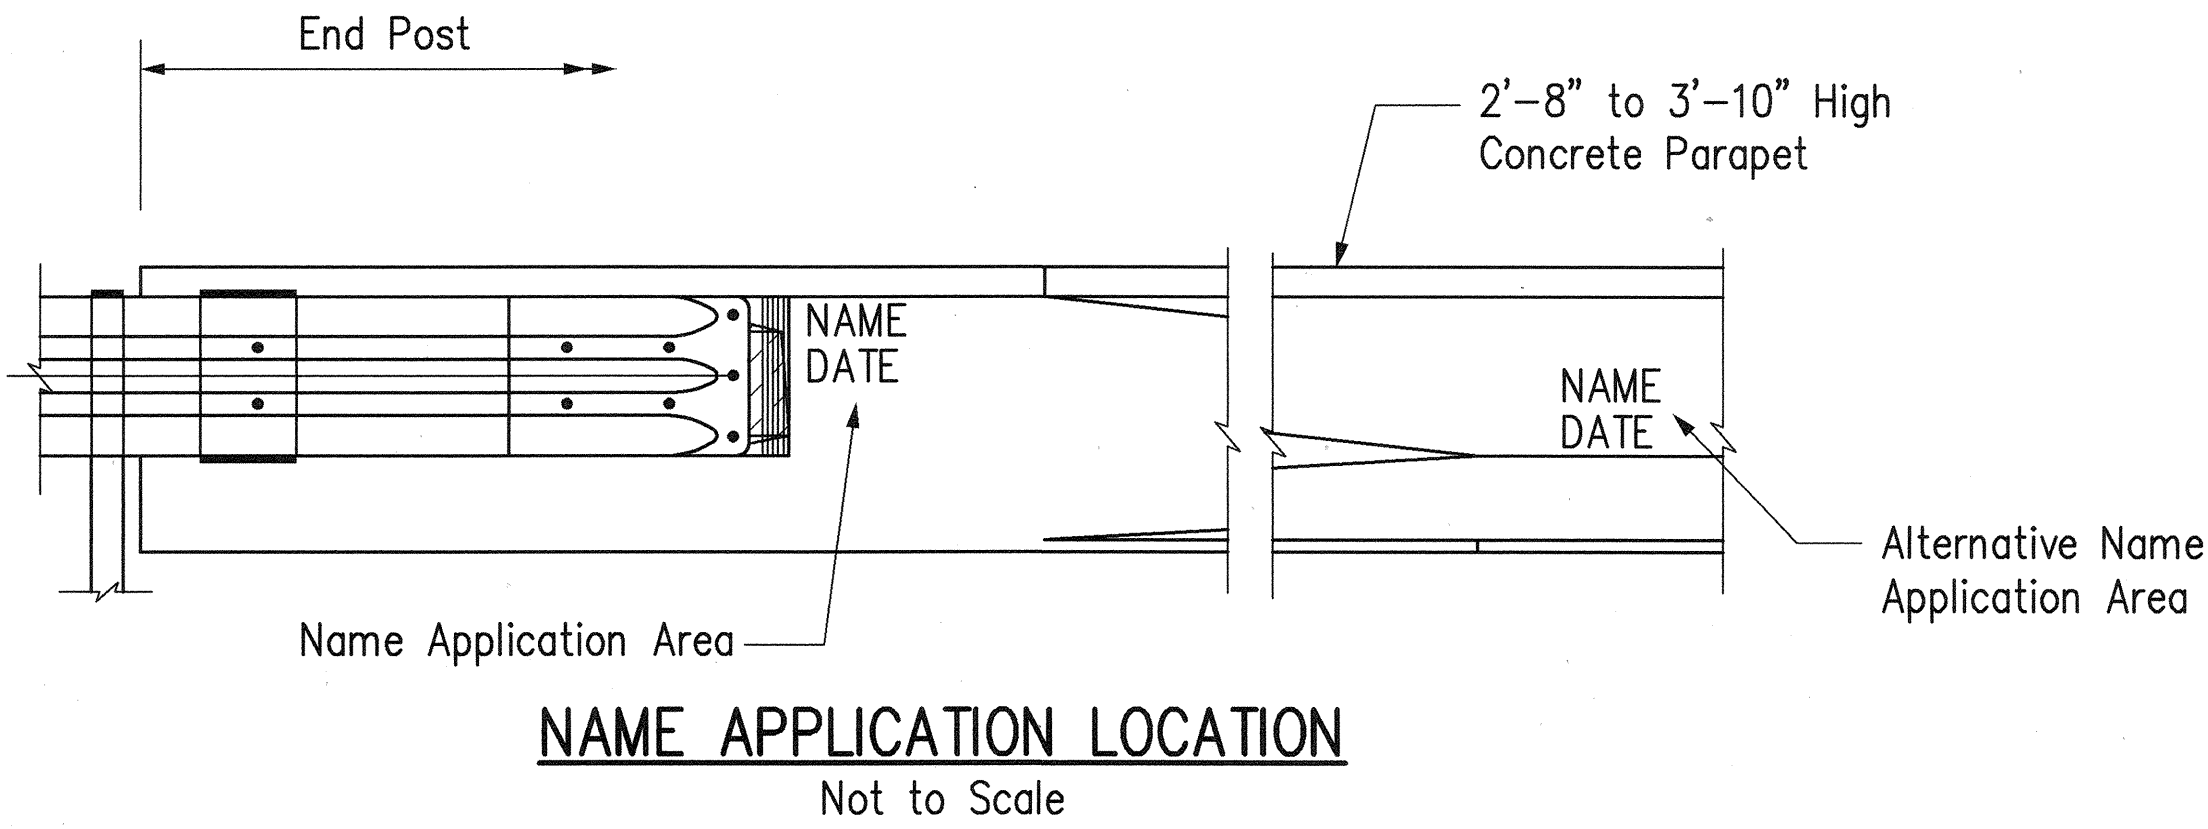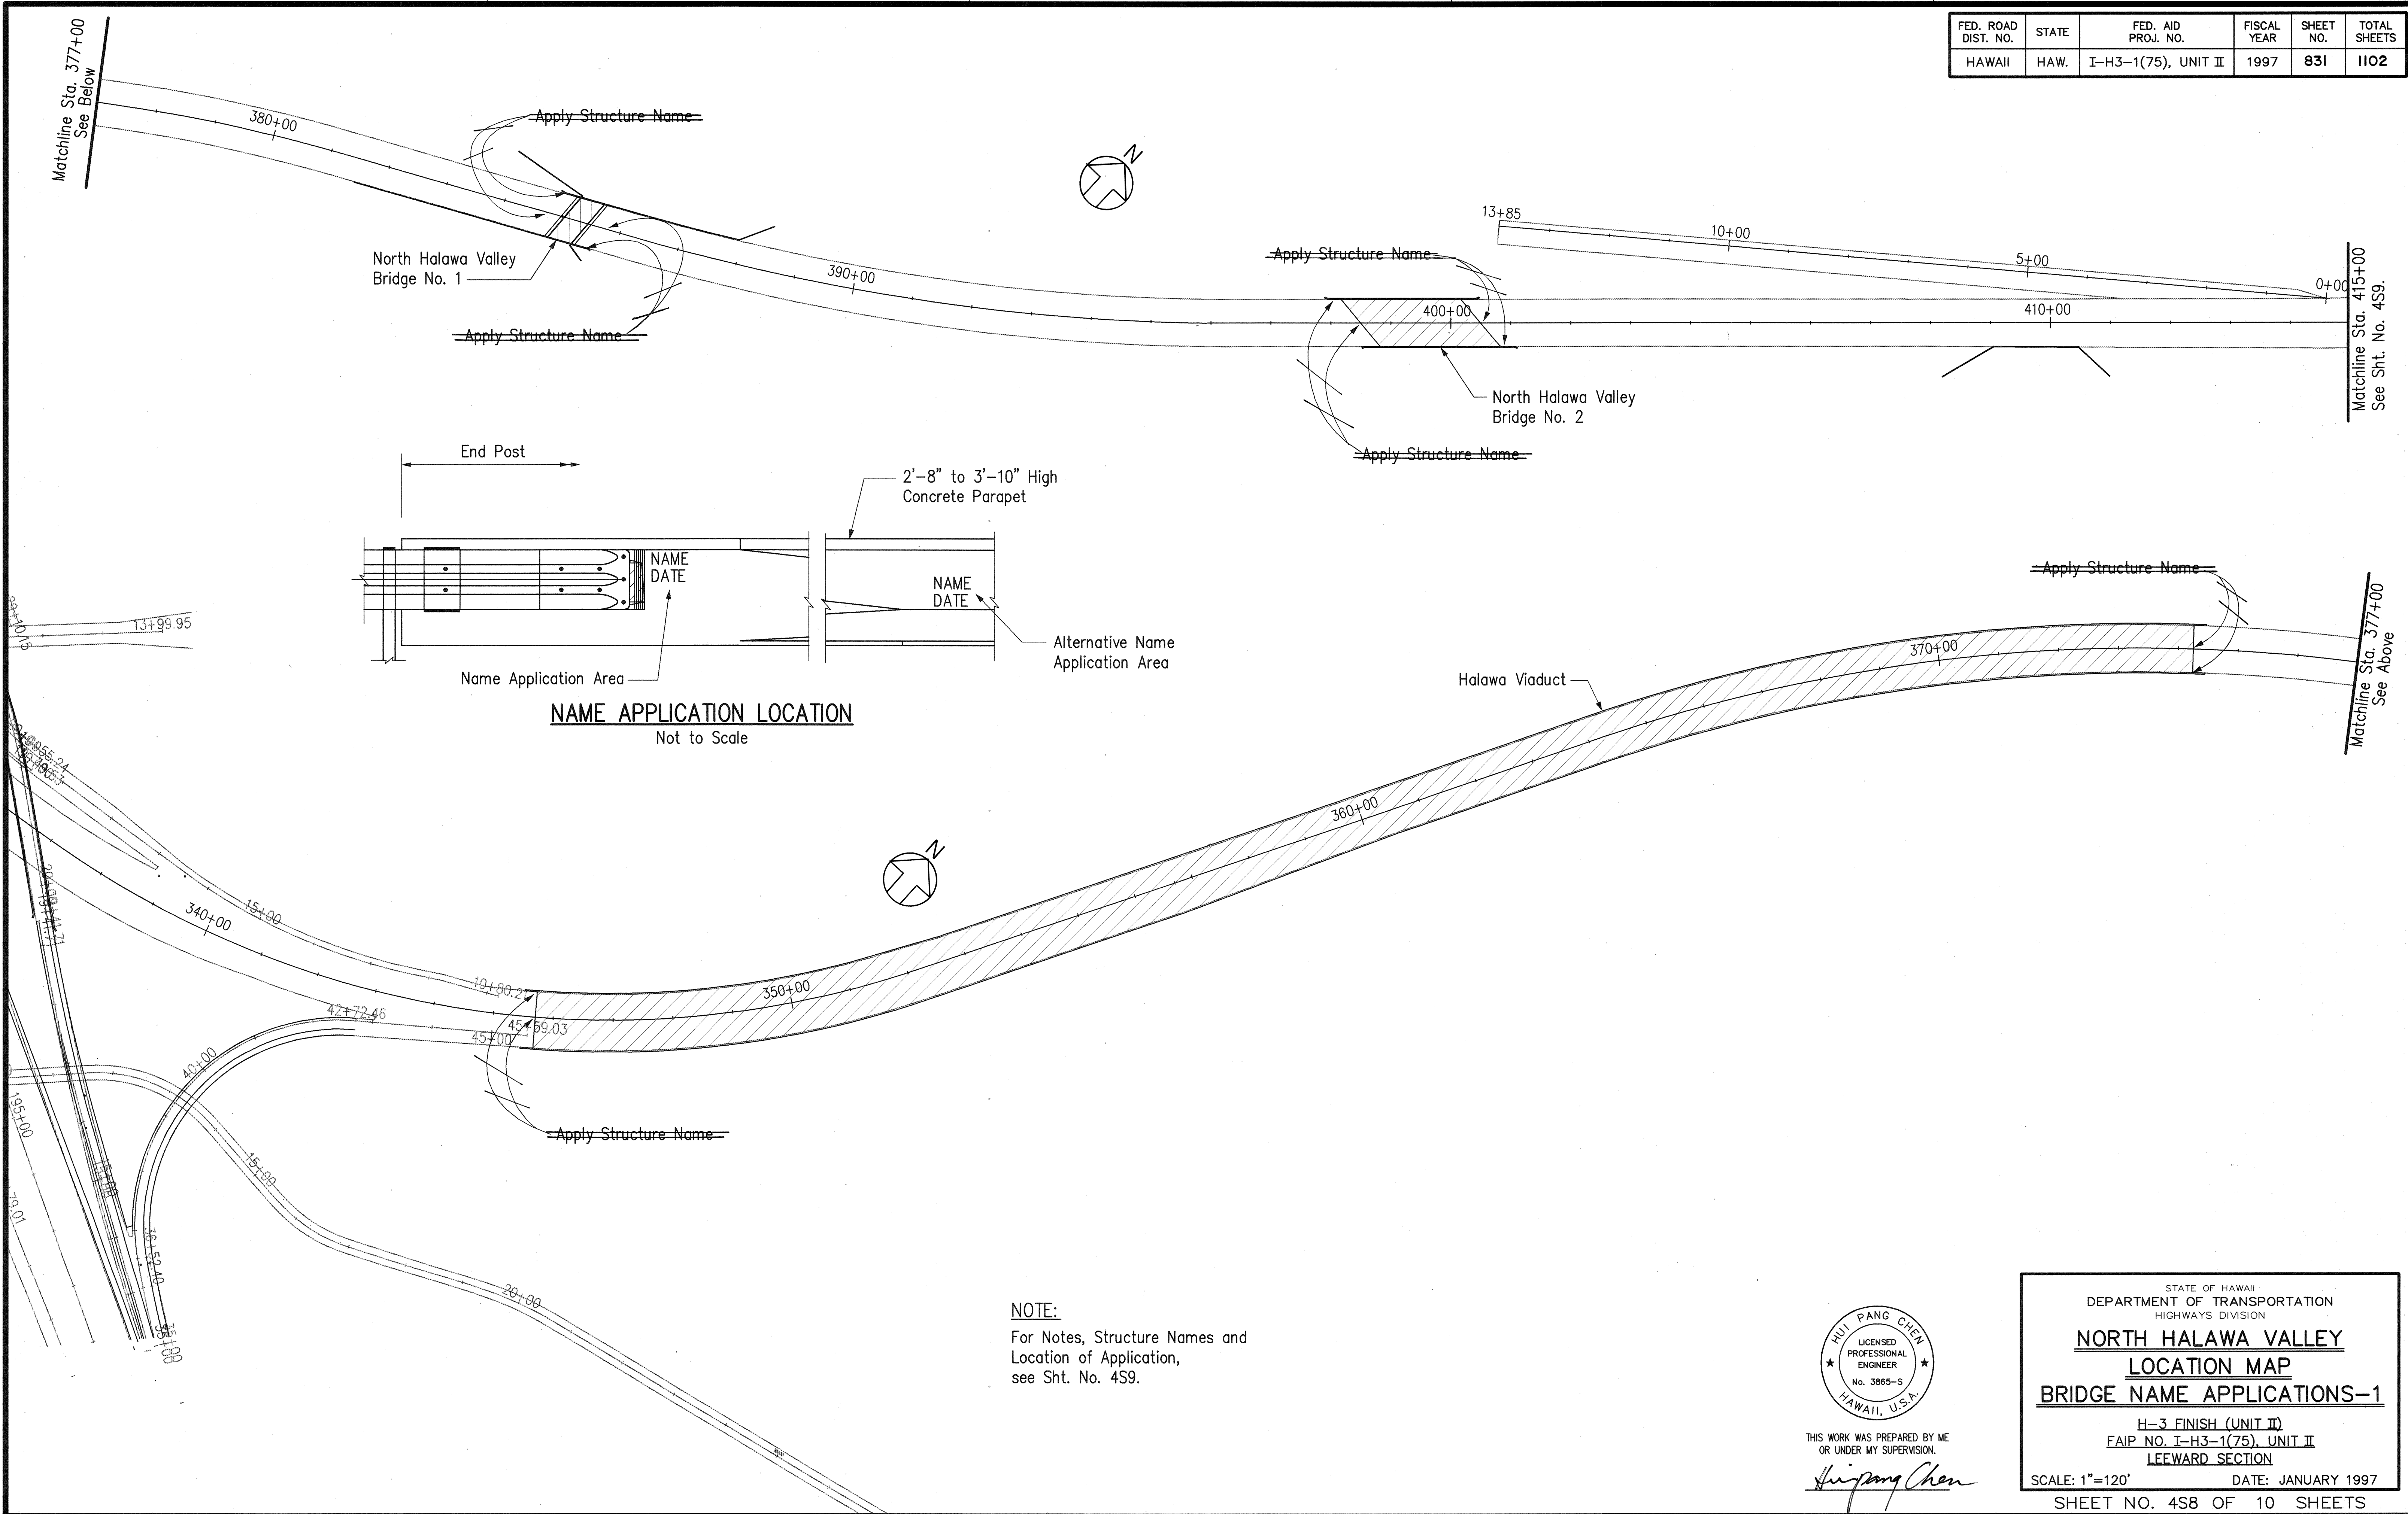

NOTE:
For Notes, Structure Names and
Location of Application,
see Sht. No. 4S9.

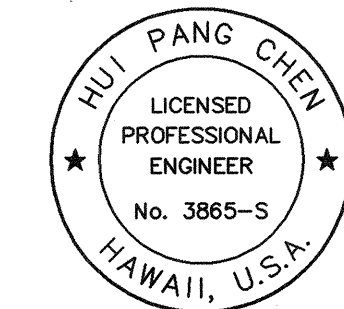


THIS WORK WAS PREPARED BY ME
OR UNDER MY SUPERVISION.
Hui Pang Chen

STATE OF HAWAII
DEPARTMENT OF TRANSPORTATION
HIGHWAYS DIVISION
NORTH HALAWA VALLEY
LOCATION MAP
BRIDGE NAME APPLICATIONS-1
H-3 FINISH (UNIT II)
FAIP NO. I-H3-1(75), UNIT II
LEEWARD SECTION
SCALE: 1"=120' DATE: JANUARY 1997
SHEET NO. 4S8 OF 10 SHEETS

SURVEY PLOTTED BY	DATE
DESIGNED BY	DATE
NOTED BY	DATE
CHECKED BY	DATE
NO.	


FED. ROAD DIST. NO.	STATE	FED. AID PROJ. NO.	FISCAL YEAR	SHEET NO.	TOTAL SHEETS
HAWAII	HAW.	I-H3-1(75), UNIT II	1997	832	1102

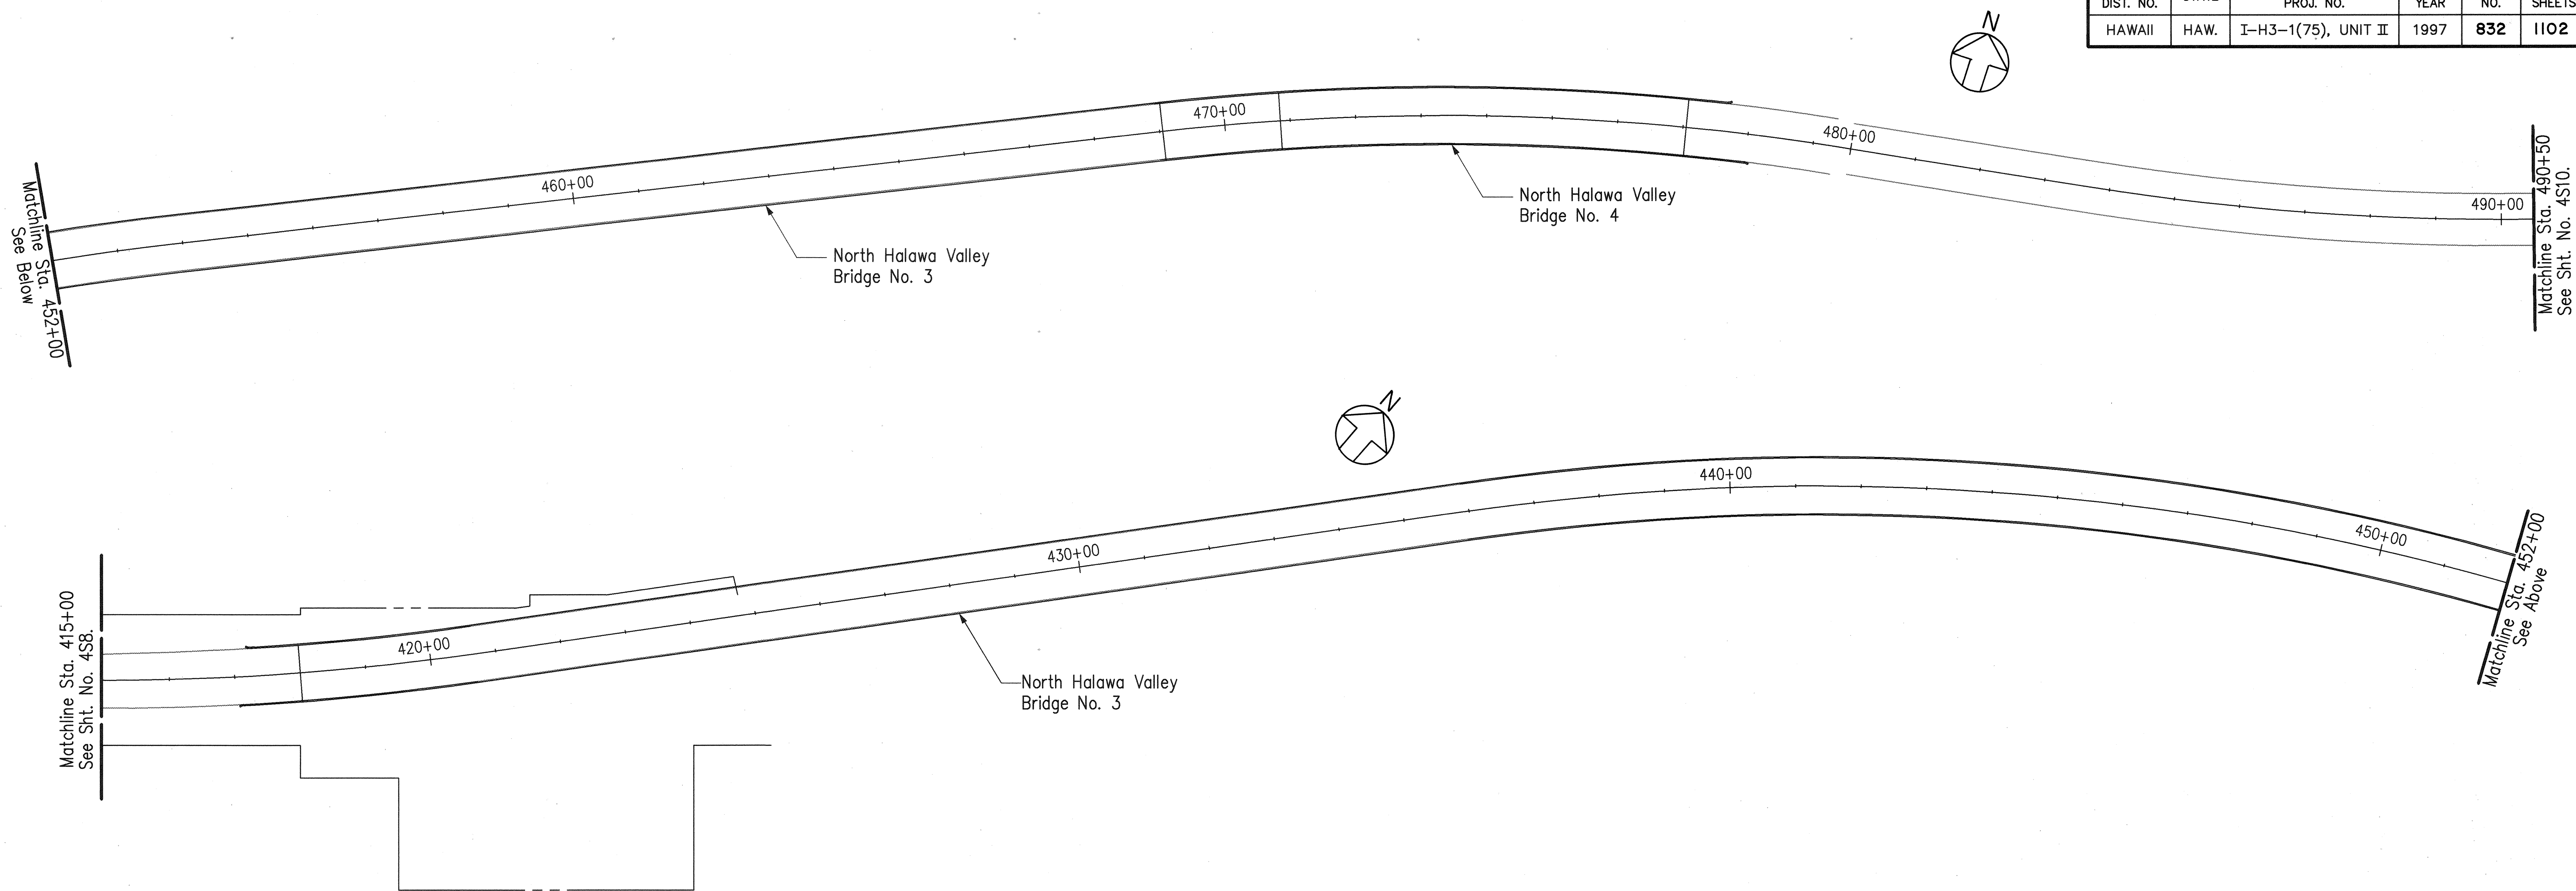

PROJECT NAME	PROJECT NO.	STRUCTURE NAME	BEGIN STA.	END STA.	NO. OF APPLICATIONS
Halawa Quarry Viaduct Makai Section	I-H3-1(54)	HALAWA QUARRY VIADUCT 1992			2 0
Halawa Quarry Viaduct Mauka Section	I-H3-1(51)	HALAWA QUARRY VIADUCT 1991			
Unit 1A Bridge No. 1	I-H3-1(59)	NORTH HALAWA VALLEY BRIDGE NO. 1 1995	384+98	385+50	2 0
Unit 1A Bridge No. 2	I-H3-1(59)	NORTH HALAWA VALLEY BRIDGE NO. 2 1995	398+50	400+50	2 0
Unit 2 Bridge No. 5	I-H3-1(69) I-H3-1(70)	NORTH HALAWA VALLEY BRIDGE NO. 5 1996	491+40	509+20	2
Unit 1A Bridge No. 6	I-H3-1(69) I-H3-1(70)	NORTH HALAWA VALLEY BRIDGE NO. 6 1996	514+60 IB 514+60 OB	525+10 IB 524+60 OB	2 2
North Halawa Valley Viaduct	I-H3-1(71)	NORTH HALAWA VALLEY VIADUCT 1995	537+70 IB 539+80 OB	599+95 IB 524+60 OB	2 2
Trans-Koolau Tunnel Approach Bridge	I-H3-1(54)	HARANO TUNNEL APPROACH BRIDGE 1995			2 1
Total					24 15

NOTES:

- Structure names are to be engraved on bridge parapet at the locations shown. See Sht. No. 4S8.
- For style and size of lettering see Standard Plan B-01. The engraved lettering need not conform to V-shaped indentation.
- The Contractor shall submit the proposed method of applying the names onto the bridge parapet and provide a sample of the lettering for acceptance.

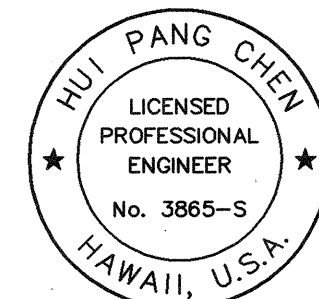

THIS WORK WAS PREPARED BY ME
OR UNDER MY SUPERVISION.

Hui Pang Chen

STATE OF HAWAII
DEPARTMENT OF TRANSPORTATION
HIGHWAYS DIVISION

NORTH HALAWA VALLEY
LOCATION MAP
BRIDGE NAME APPLICATIONS-2

H-3 FINISH (UNIT II)
FAIP NO. I-H3-1(75), UNIT II
LEEWARD SECTION


SCALE: 1"=120' DATE: JANUARY 1997

SHEET NO. 4S9 OF 10 SHEETS

ORIGINAL PLAN	SURVEY PLOTTED BY	DATE
NOTE BOOK	DESIGNED BY	
No.	CHECKED BY	

CAD by D. Burgess, 55-52

FED. ROAD DIST. NO.	STATE	FED. AID PROJ. NO.	FISCAL YEAR	SHEET NO.	TOTAL SHEETS
HAWAII	HAW.	I-H3-1(75), UNIT II	1997	833	1102

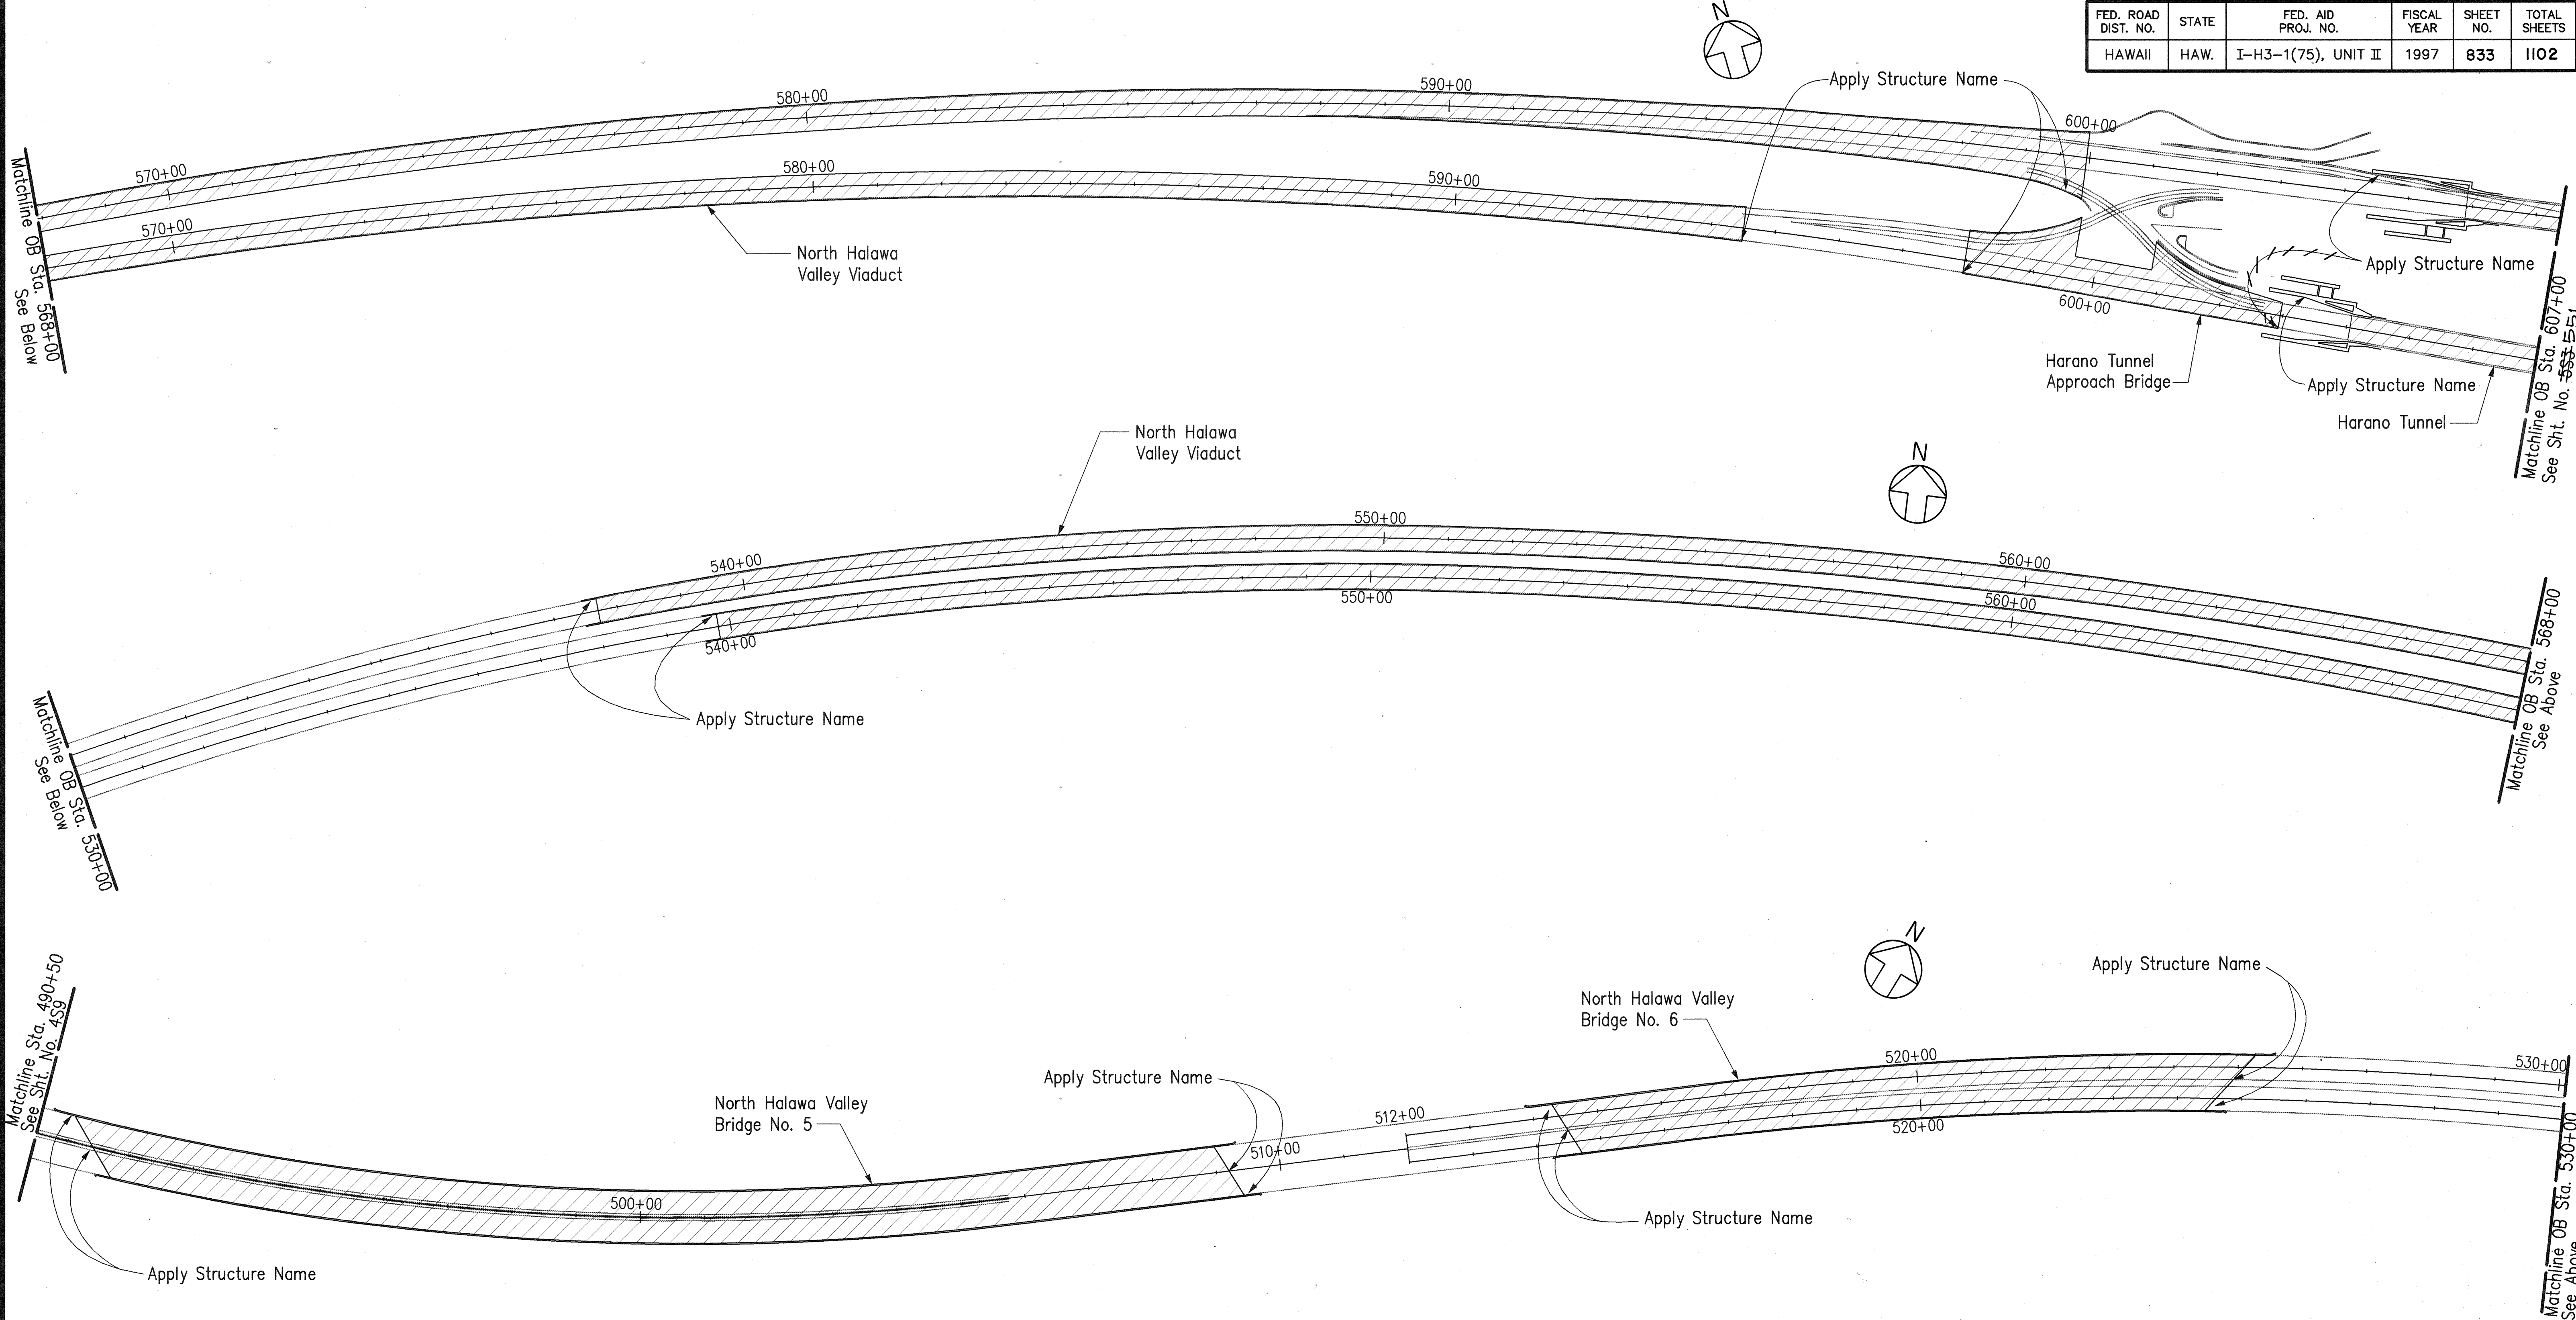


ORIGINAL PLAN	DATE
SURVEY PLOTTED BY	
DRAWN BY	
DESIGNED BY	
CHECKED BY	
NO.	

CAD by D. Burgess, 55-32

NOTE:

For Notes, Structure Names and Location of Application, see Sht. No. 4S9.

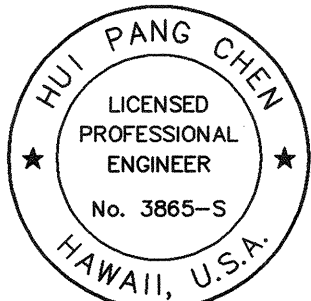

THIS WORK WAS PREPARED BY ME OR UNDER MY SUPERVISION.

Hui Pang Chen

STATE OF HAWAII
DEPARTMENT OF TRANSPORTATION
HIGHWAYS DIVISION
NORTH HALAWA VALLEY
LOCATION MAP
BRIDGE NAME APPLICATIONS-3
H-3 FINISH (UNIT II)
FAIP NO. I-H3-1(75), UNIT II
LEEWARD SECTION
SCALE: 1"=120'
DATE: JANUARY 1997
SHEET NO. 4S10 OF 10 SHEETS

833