

INDEX TO DRAWINGS	
SHEET NO.	DESCRIPTION
1	TITLE SHEET - VOLUME 1
2 18	GENERAL
19 2 494 4	INTERSTATE ROUTE H-1
495	TITLE SHEET - VOLUME 2
496 586	MOANALUA FREEWAY
587 776	HALAWA INTERCHANGE
777 833	NORTH HALAWA VALLEY
834 844 9	WINDWARD
845 892	DESTINATION SIGNS
893 1012 12	SYSTEMS
1013 1102 14	ELECTRICAL


Plan Sht. Nos. ① 175S-1, ② 18S-1, ③ 21S-1, 102S-1 To 102S-3, 113S-1, 114S-1, 116S-1, 127S-1, 128S-1, 130S-1, 173S-1 To 173S-3, 177S-1, 181S-1 To 181S-5, 183S-1 To 183S-4, 187S-1, 189S-1, 189S-2, 193S-1 To 193S-8, 195S-1, 205S-1, 257S-1 To 257S-9, 269S-1, 270S-1 To 270S-8, 292S-1, 307S-1, 329S-1, 363S-1, 364S-1, 364S-2, 369S-1, 393S-1, 399S-1 To 399S-8, ④ 494S-1, ⑤ 515S-1, 517S-1, ⑥ 607S-1, 617S-1, 621S-1, 636S-1, 644S-1, 666S-1, 733S-1, 775S-1, 775S-2, ⑦ 799S-1 To 799S-6, 822S-1 To 822S-4, 823S-1, ⑧ 837S-1 To 837S-11, 839S-1 To 839S-6, 842S-1, ⑨ 844S-1, ⑩ 856S-1, 862S-1, 862S-2, 877S-1 To 877S-2, 884S-1, ⑪ 948S-1, 949S-1, 949S-2, 951S-1, 951S-2, 954S-1, 977S-1 To 977S-24, 983S-1, 983S-2, 984S-1, ⑫ 1012S-1 To 1012S-11, ⑬ 1069S-1, 1069S-2, 1081S-1, 1085S-1 To 1085S-26 & ⑭ 1102S-1, 1102S-2, 1102S-2A, 1102S-3 To 1102S-31 are supplementary sheets to this project, added during Addendum & "AS BUILT" postings.

TOTAL SHEET COUNT after Addendum & "AS BUILT" postings is 1327 sheets.

STATE OF HAWAII
DEPARTMENT OF TRANSPORTATION
HIGHWAYS DIVISION
HONOLULU, HAWAII
"AS BUILT"
PLANS FOR

CONSTRUCTION OF A PORTION OF
INTERSTATE ROUTE H-3
H-3 FINISH (UNIT II)
LEEWARD SECTION

FEDERAL AID INTERSTATE PROJECT NO. I-H3-I(75), UNIT II
DISTRICT OF EWA, KOOLAUPOKO AND HONOLULU
ISLAND OF OAHU
VOLUME 1 OF 2



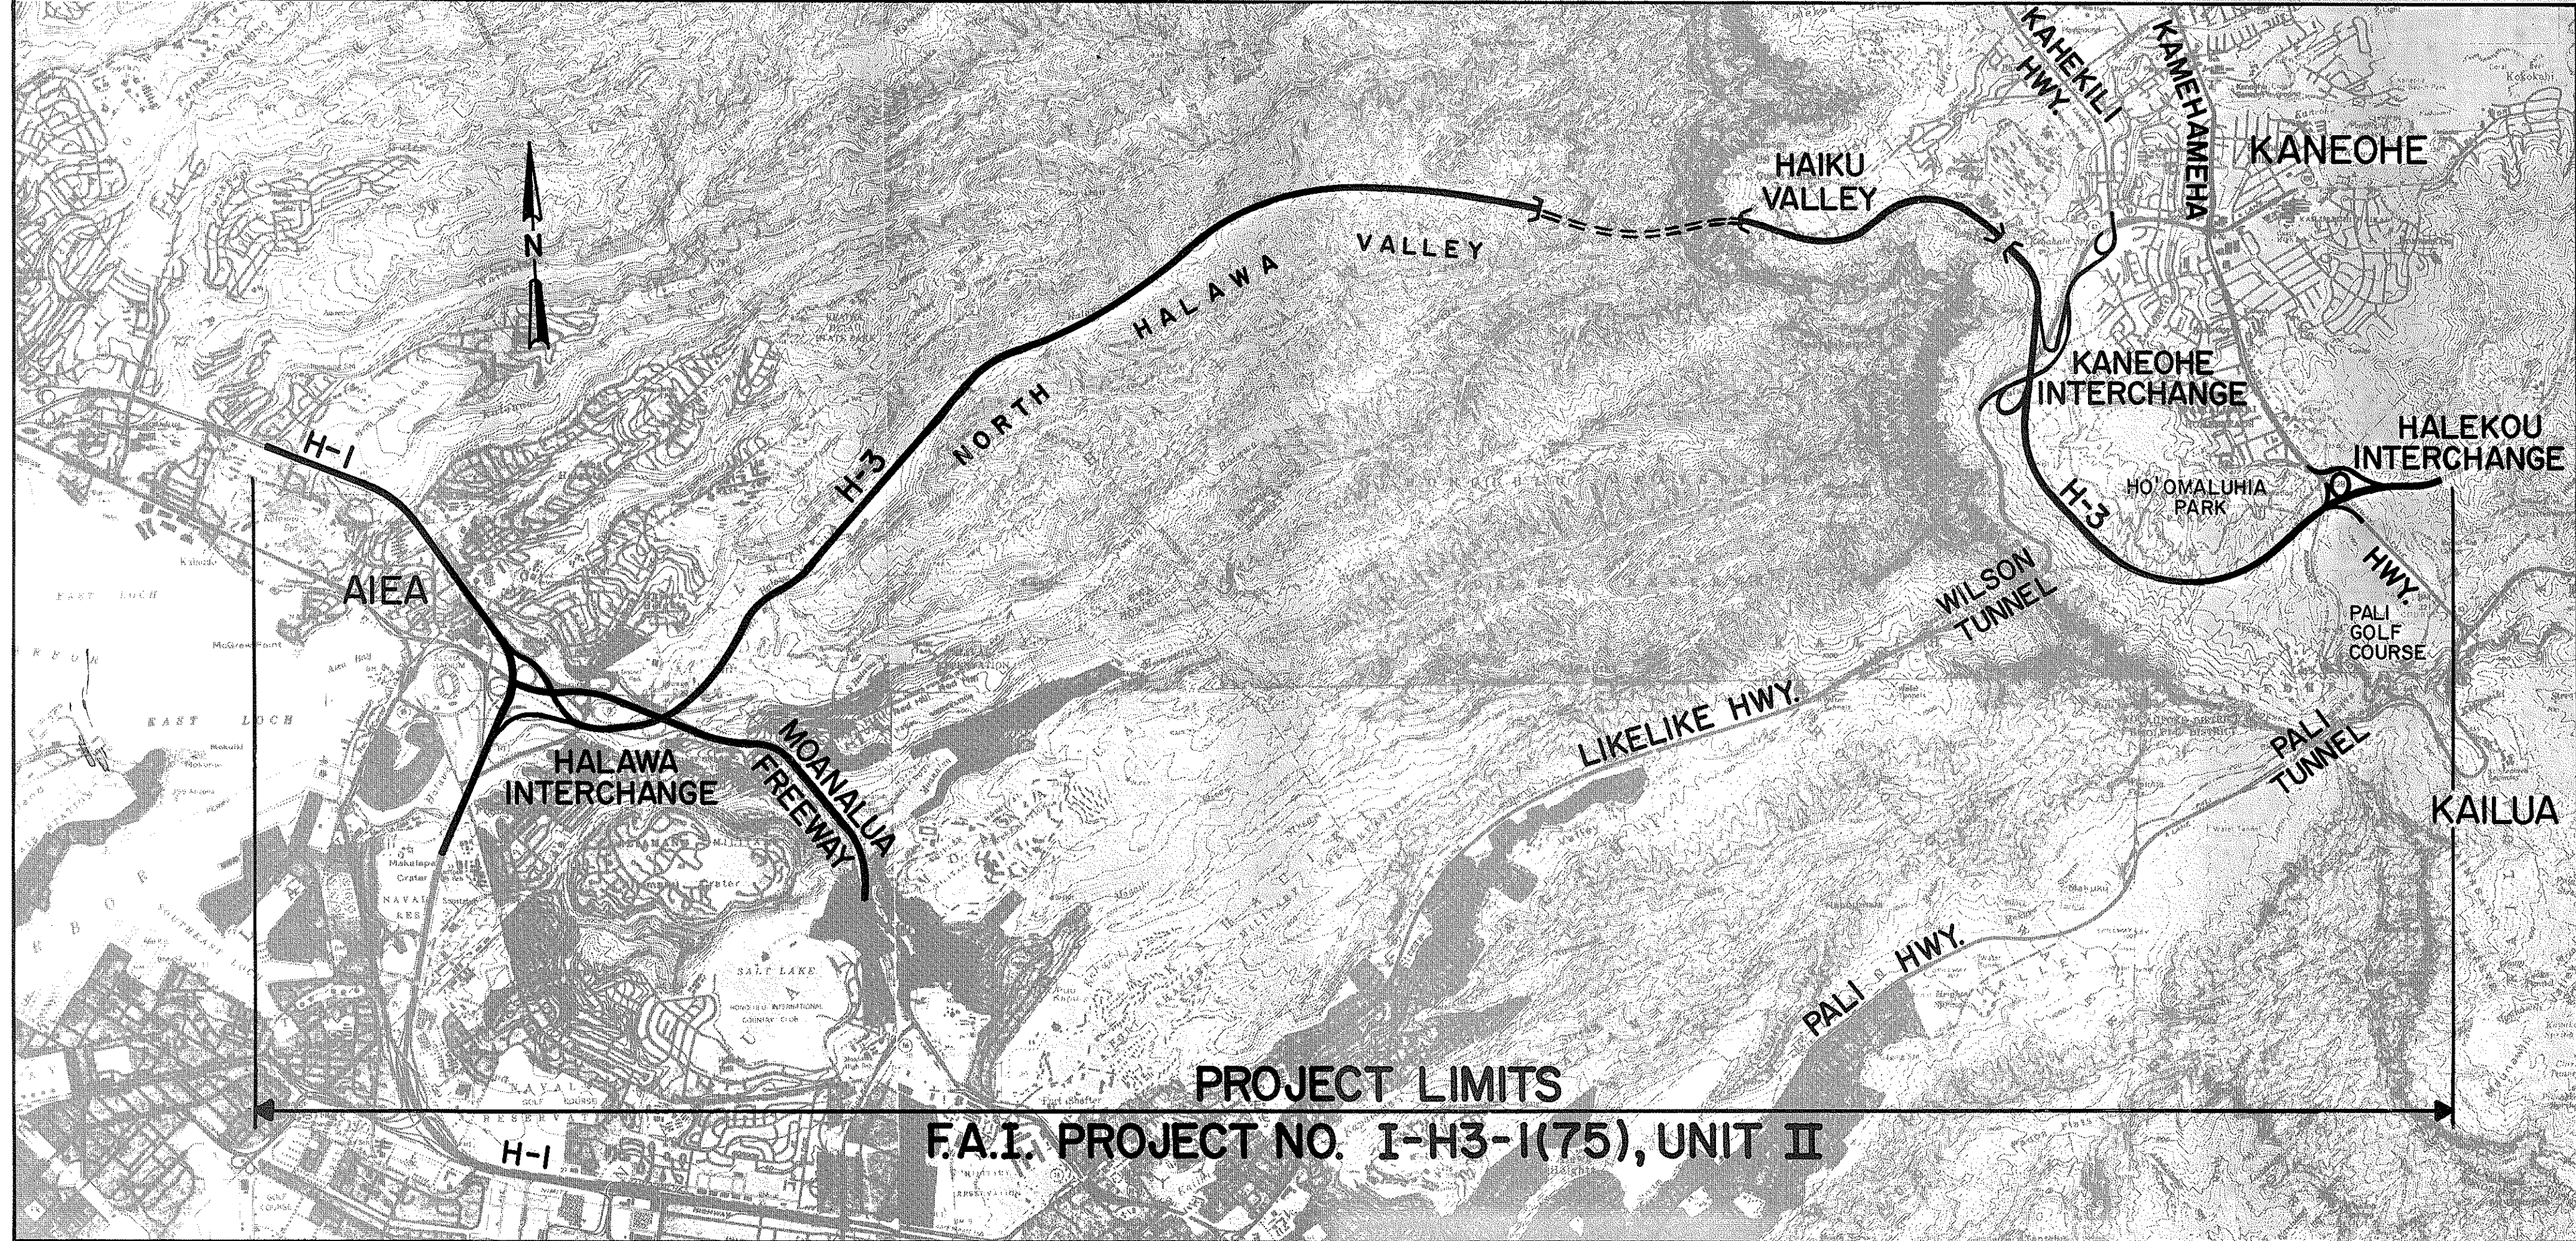


PROJECT LIMITS
F.A.I. PROJECT NO. I-H3-I(75), UNIT II

LAYOUT PLAN



FED. ROAD DIST. NO.	STATE	FED. AID PROJ. NO.	FISCAL YEAR	SHEET NO.	TOTAL SHEETS
HAWAII	HAW.	I-H3-I(75), UNIT II	1997	I	1102

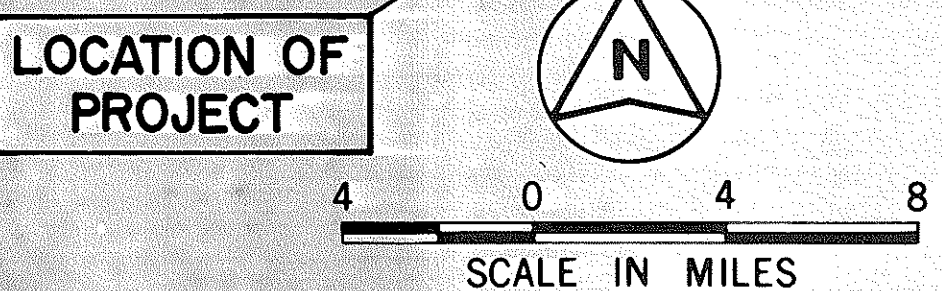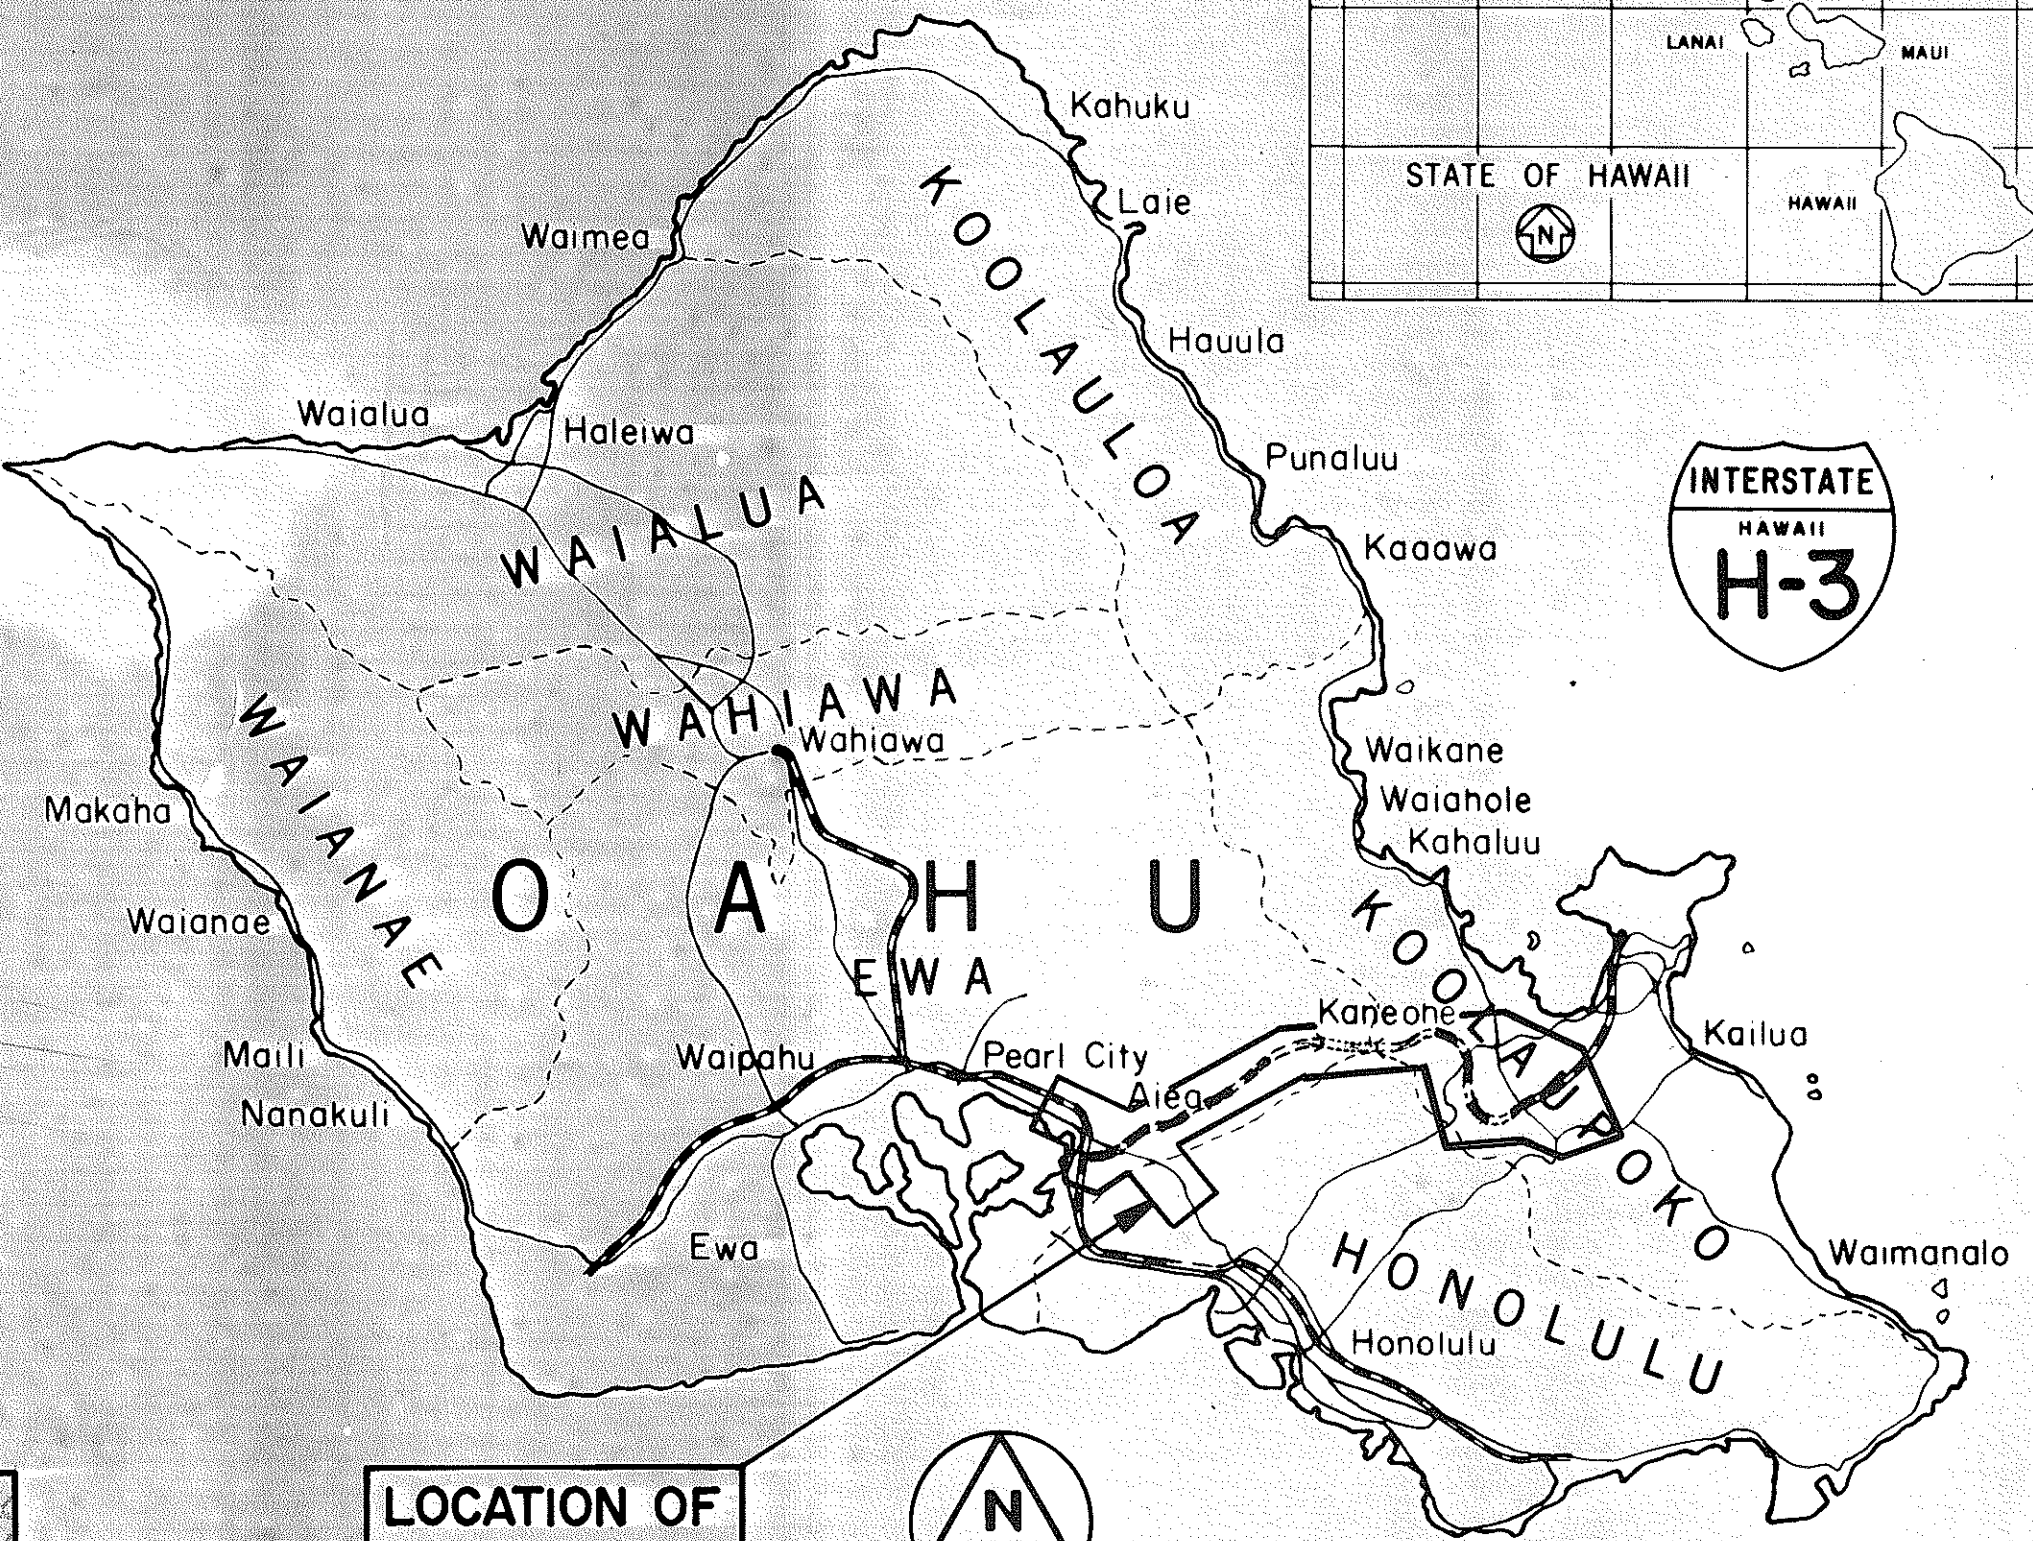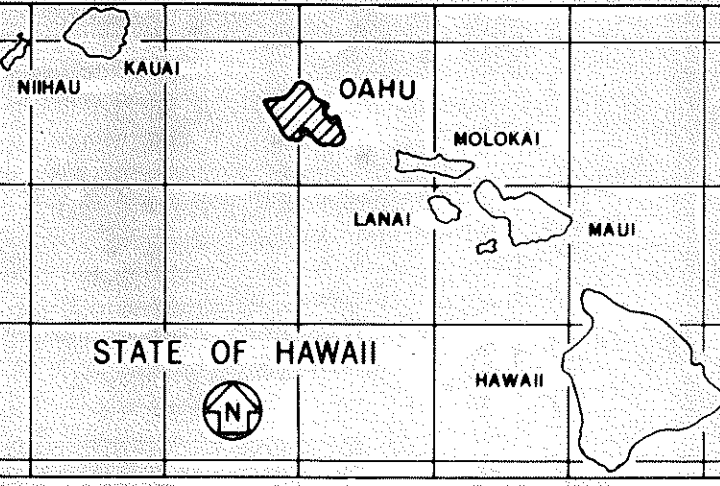

FEDERAL AID INTERSTATE PROJECTS PREVIOUSLY CONSTRUCTED OR UNDER CONSTRUCTION

DESIGN DESIGNATION

FUTURE ADT (1998)	---	39,430
DESIGN ADT (2008)	---	45,220
DHV	---	4,282
D	---	76/24
T	---	2.1%
T ₂₄	---	4.1%
V	---	60 M. P.H.

CHANGES MADE DURING CONSTRUCTION HAVE BEEN INCORPORATED ON THESE PLANS EXCEPT CHANGES IN THE ORIGINAL THEORETICAL QUANTITIES. FOR ACTUAL QUANTITIES, REFER TO PROJECT LEDGER AND/OR COMPUTATION BOOK.

RESIDENT ENGINEER

DATE

DEPARTMENT OF TRANSPORTATION STATE OF HAWAII	
APPROVED:	
DIR. OF TRANSPORTATION	DATE