





FED. ROAD DIST. NO.	STATE	PROJ. NO.	FISCAL YEAR	SHEET NO.	TOTAL SHEETS
HAWAII	HAW.	I-H3-1(75), UNIT II	1997	834	1102

NOTES:



- The location of existing underground facilities are from existing records with varying degrees of accuracy and are not guaranteed as shown. The Contractor shall exercise extreme caution whenever construction crosses or is in close proximity of underground lines.
- For verification of HECO underground lines or for assistance in supporting and protecting these lines, the Contractor shall call HECO's underground division at 543-7345 a minimum of 72 hours in advance.
- Any damage to HECO's facilities will be reported immediately to HECO's trouble dispatcher at 543-7874. The repair work shall be done by HECO, or by the Contractor under HECO's supervision at no additional cost to the State.
- All existing underground facilities shown on these plans or whose approximate locations within the project boundaries have been made known by any reasonable means at any time to the Contractor, shall be protected at all times by the Contractor during construction. The Contractor shall be responsible for repair of existing facilities damaged as a result of installation work of guardrail and at no cost to the State.
- Azimuth and coordinates are based on Hawaiian Plane Coordinate Grid System Zone 1, referred to "Kailua" Δ , 80,135.23 N & 575,640.57E
- For Metal Guardrail Detail, see Standard Plan TE-50 & 51.
- For Type "G" Flare and Anchor Block Detail, See Standard Plan TE-59 & TE-60 respectively. Payment for Flared End Section and Conc. Anchor Block shall be considered incidental to the various contract items.
- Payment for Breakout of Existing CRM and Grout required for Guardrail Installation shall be considered incidental to the various contract items.

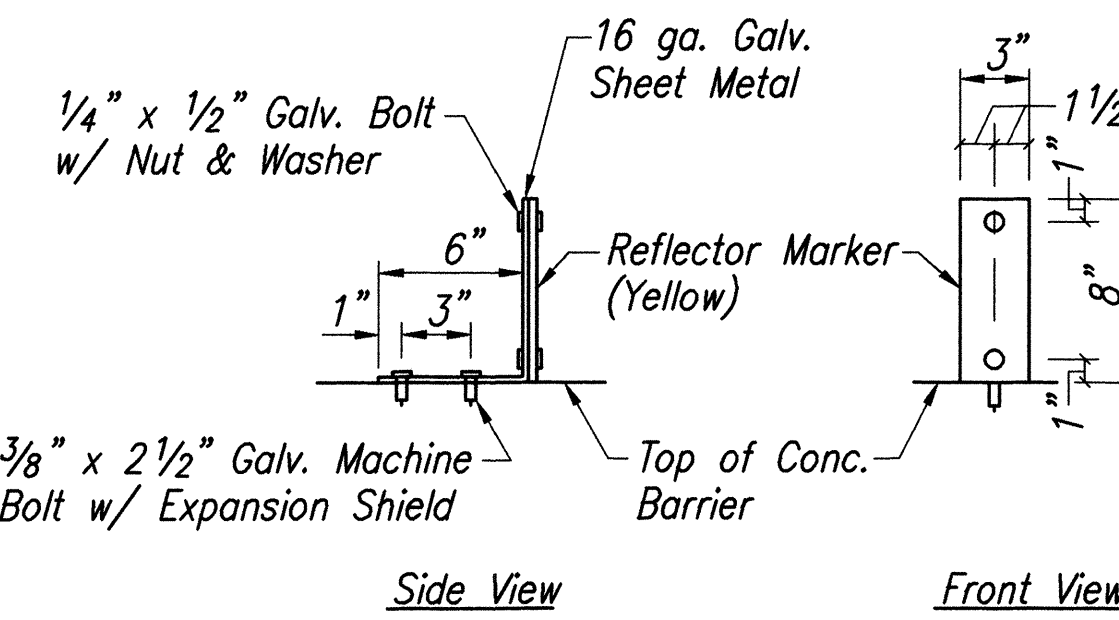

Side View
Front View
3 5C15C1 RM-2 MARKER MOUNTED ON CONCRETE WALL TRANSITION
Not to Scale

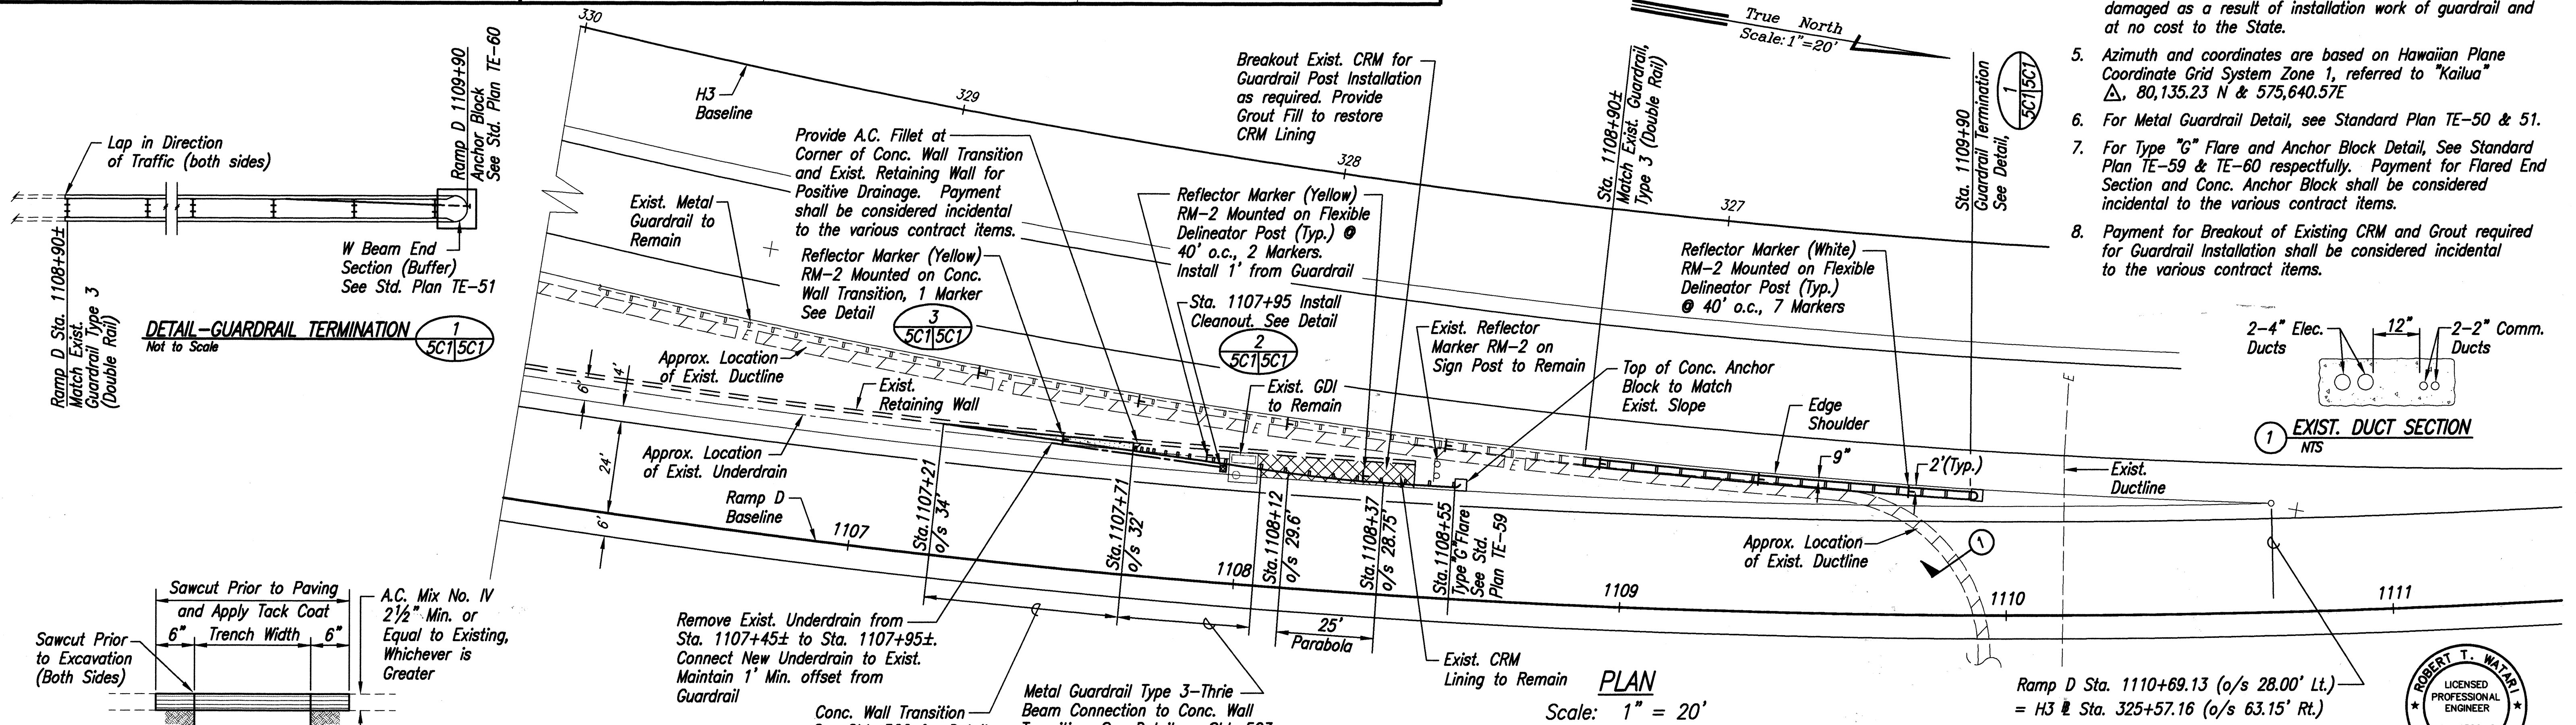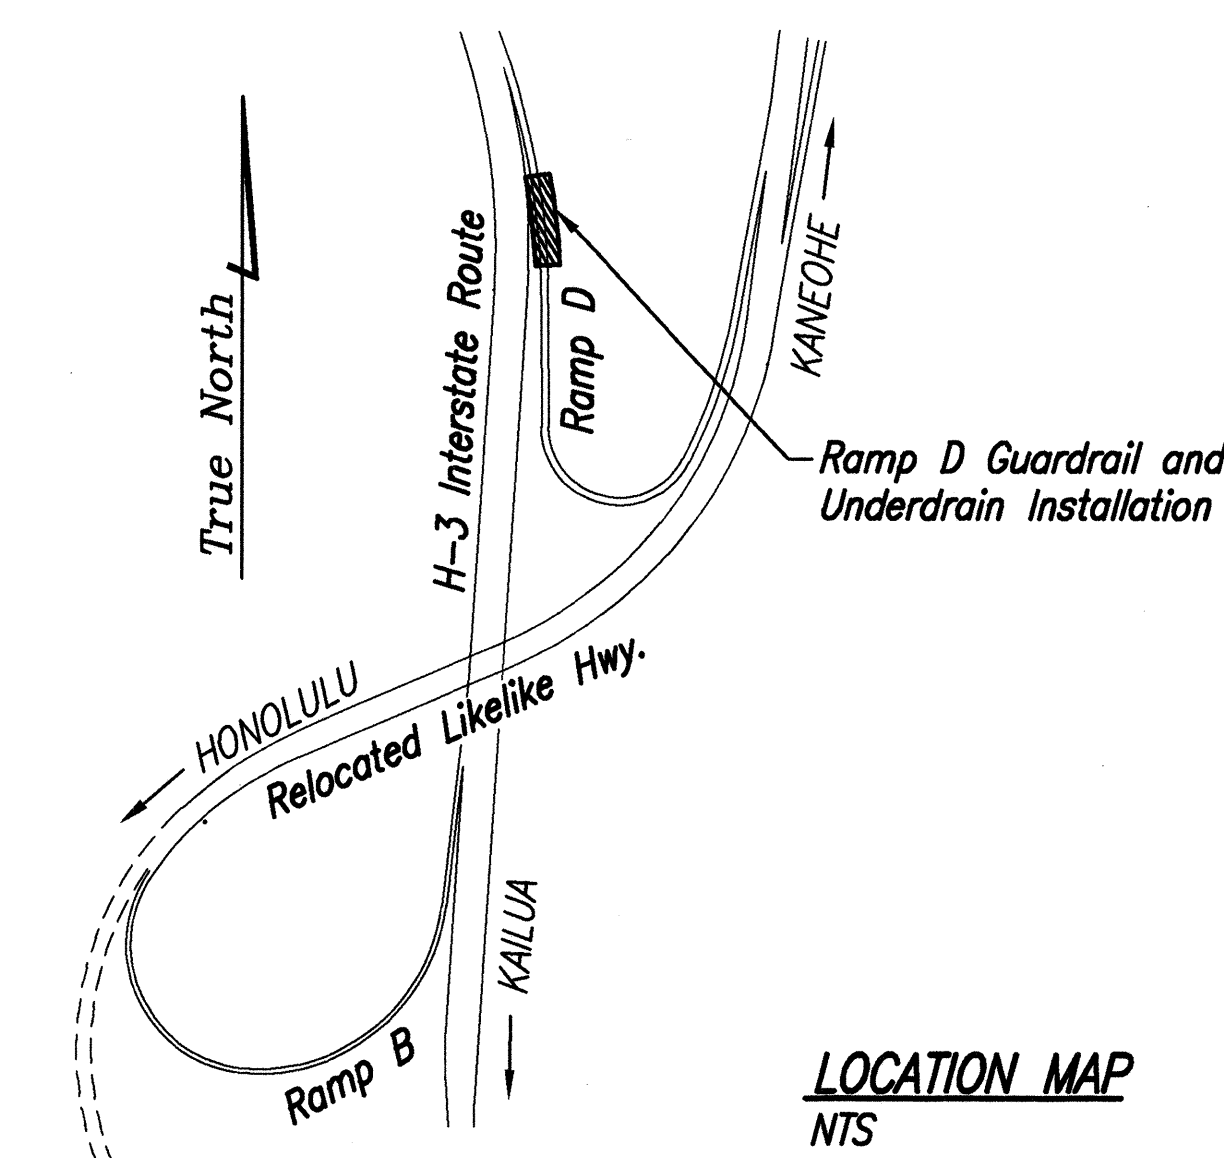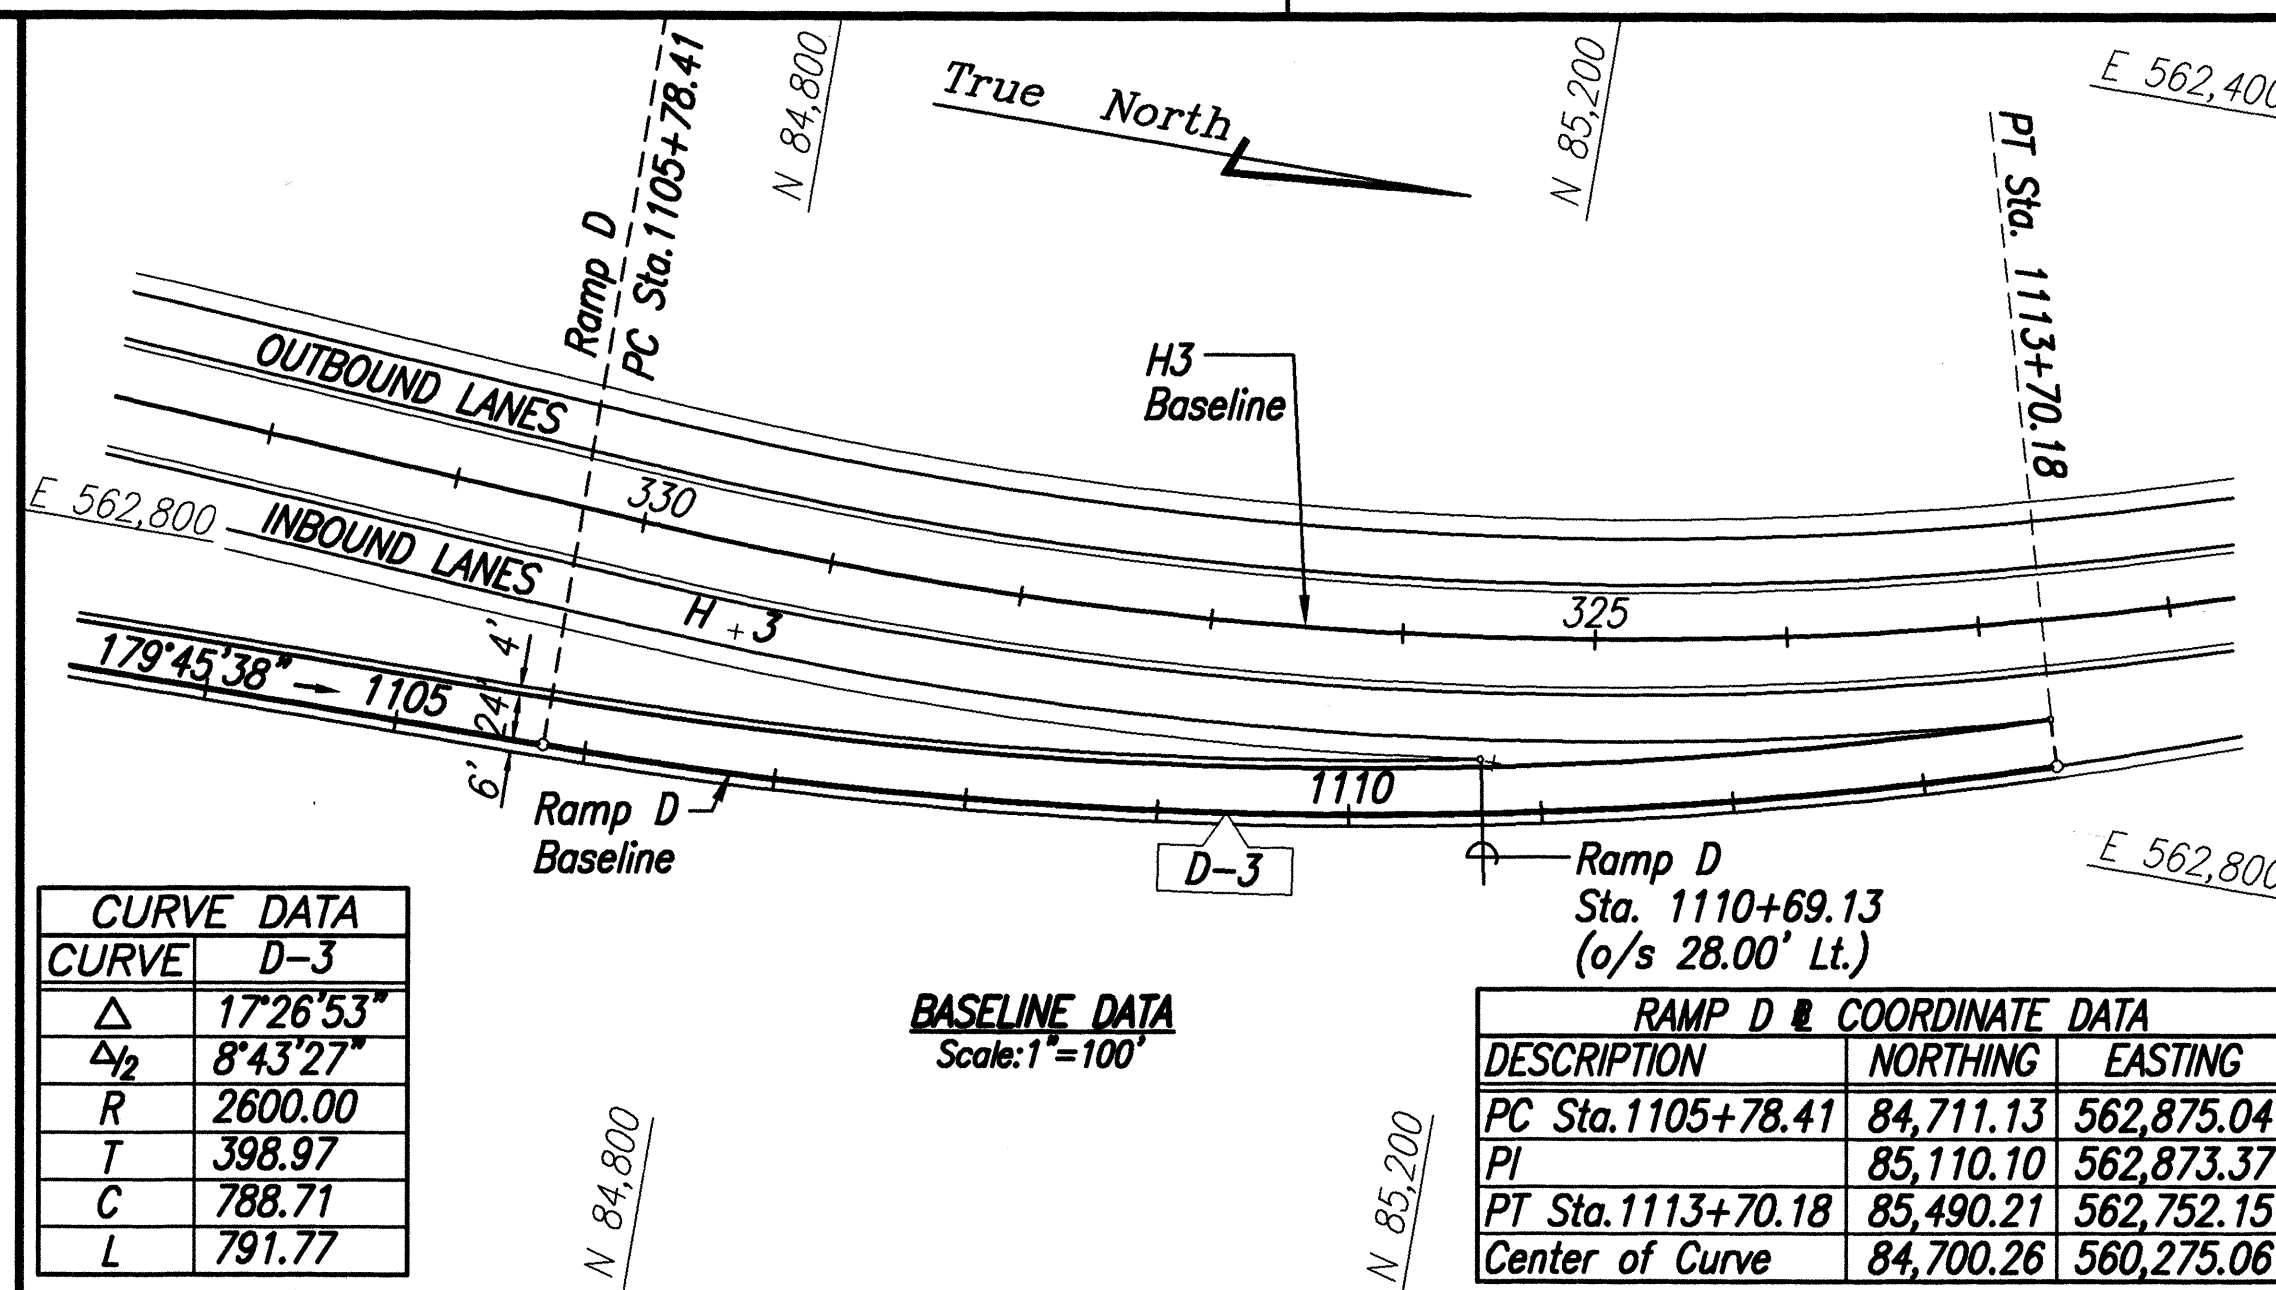




Underdrain Schedule
 Cleanout 6" Perforated Underdrain Pipe
 Sta. 1107+95 Sta. 1107+45± to Sta. 1107+95 Lt.
 Metal Guardrail, Type 3 - Single w/ Steel Posts
 Ramp D Sta. 1108+05 to Sta. 1108+55 Lt. (50 Lin. Ft.)
 Metal Guardrail, Type 3 - Double w/ Steel Posts
 Ramp D Sta. 1108+90± to Sta. 1109+90 Lt. (100 Lin. Ft.)

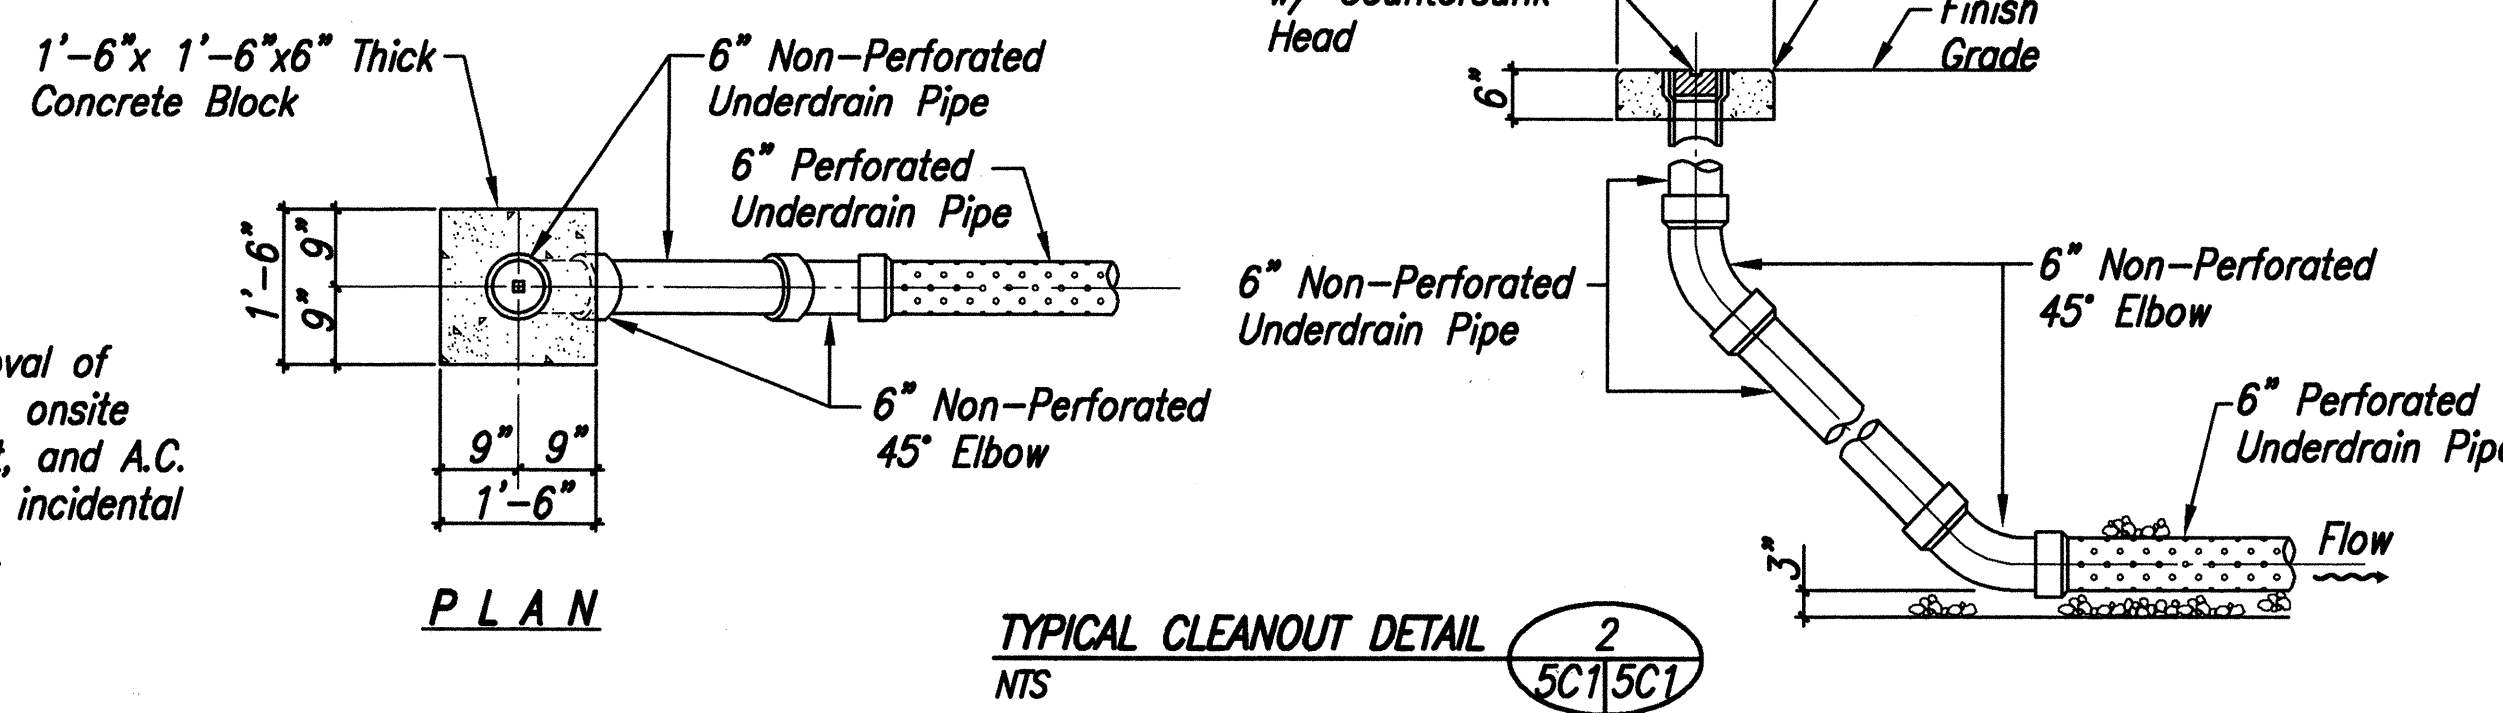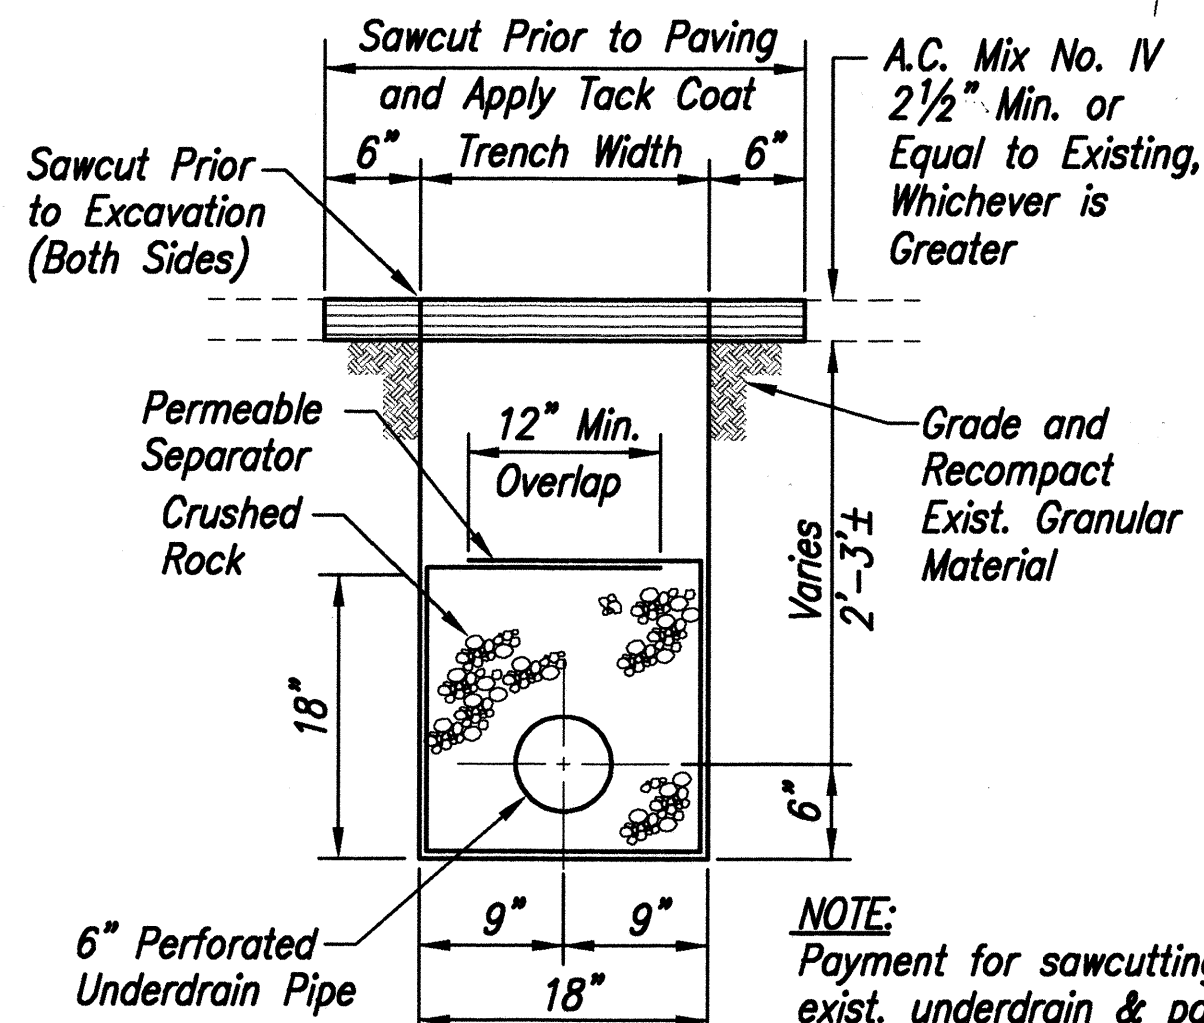

THIS WORK WAS PREPARED BY
ME OR UNDER MY SUPERVISION.
Robert T. Watari

STATE OF HAWAII
DEPARTMENT OF TRANSPORTATION
HIGHWAYS DIVISION
WINDWARD
ROADWAY CONSTRUCTION
KANEOHE INTERCHANGE
H-3 FINISH (UNIT II)
F.A.I. PROJ. NO. I-H3-1(75), UNIT II
LEEWARD SECTION
SCALE: AS NOTED DATE: JAN. 1997
SHEET No. 5C1 OF 4 SHEETS

FED. ROAD DIST. NO.	STATE	FED. AID PROJ. NO.	FISCAL YEAR	SHEET NO.	TOTAL SHEETS
HAWAII	HAW.	I-H3-1(75) UNIT II	1997	835	1102

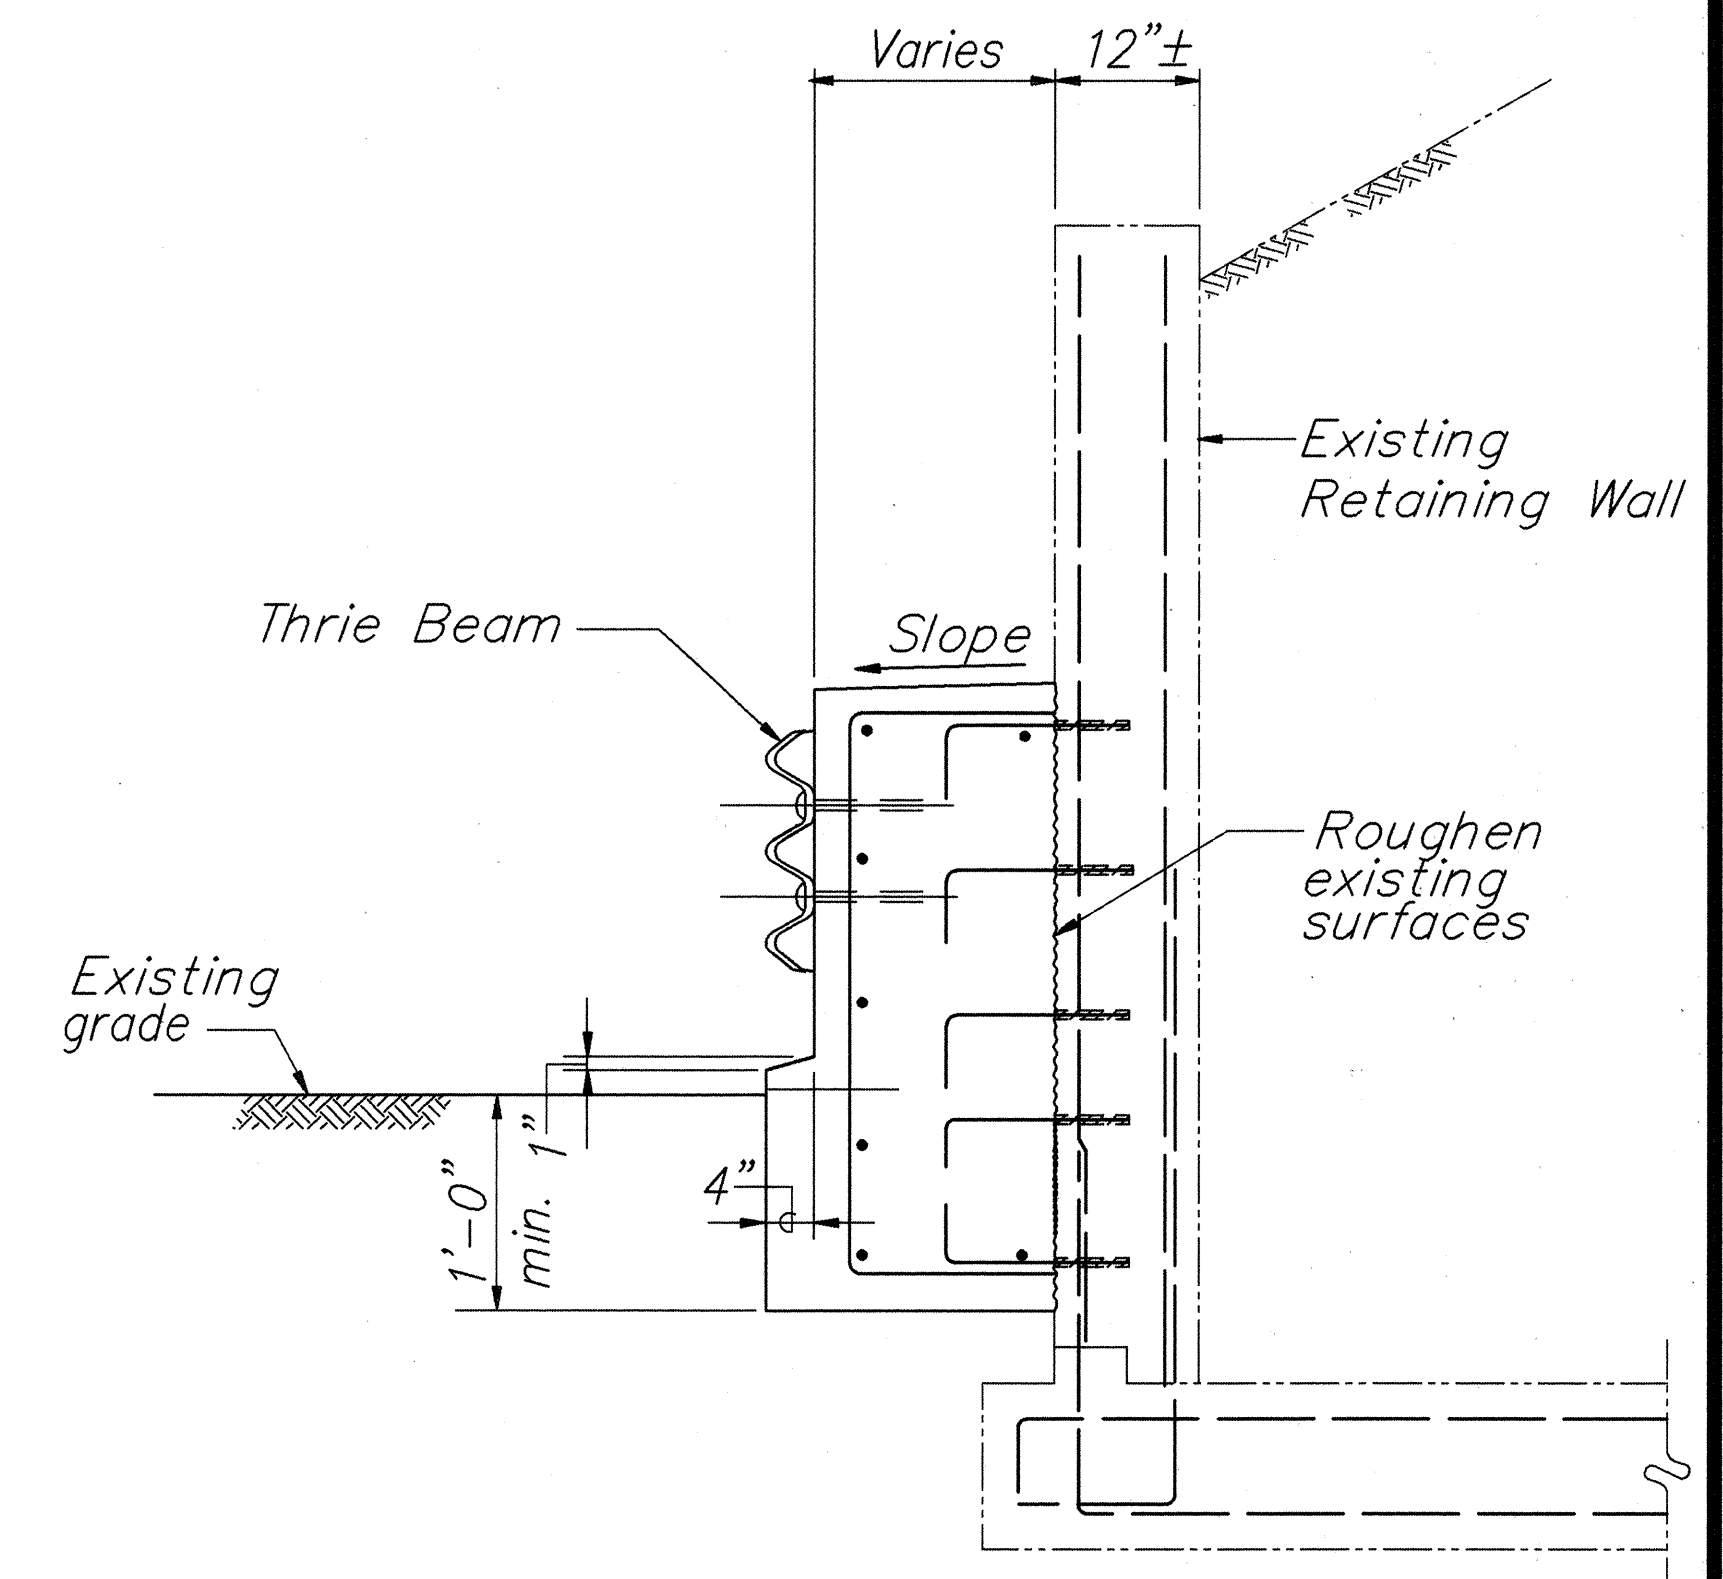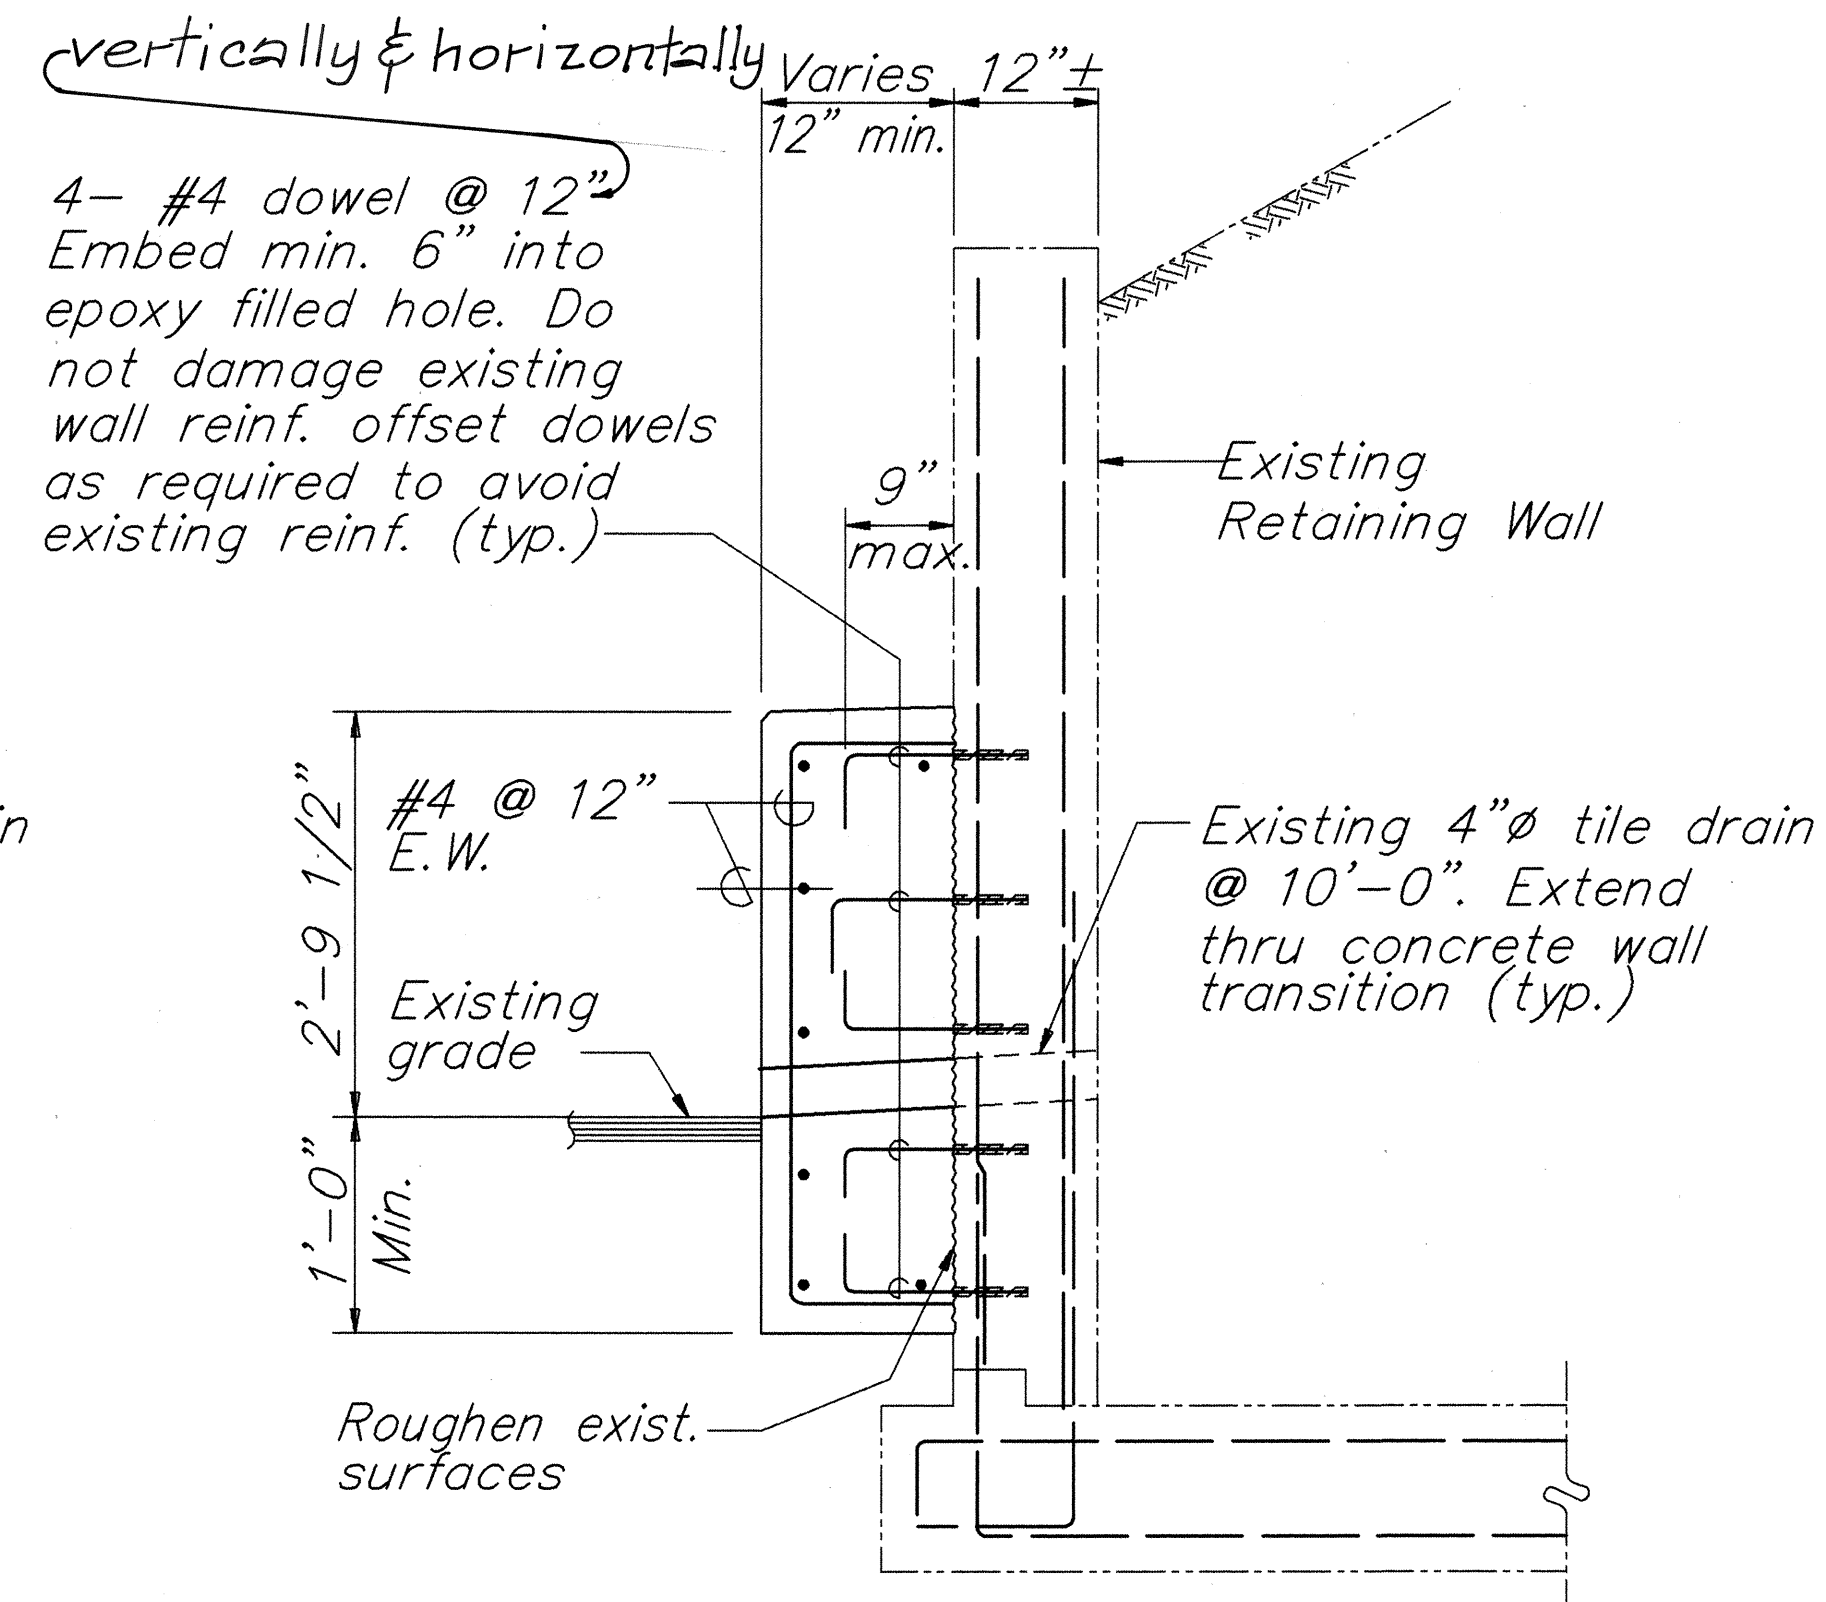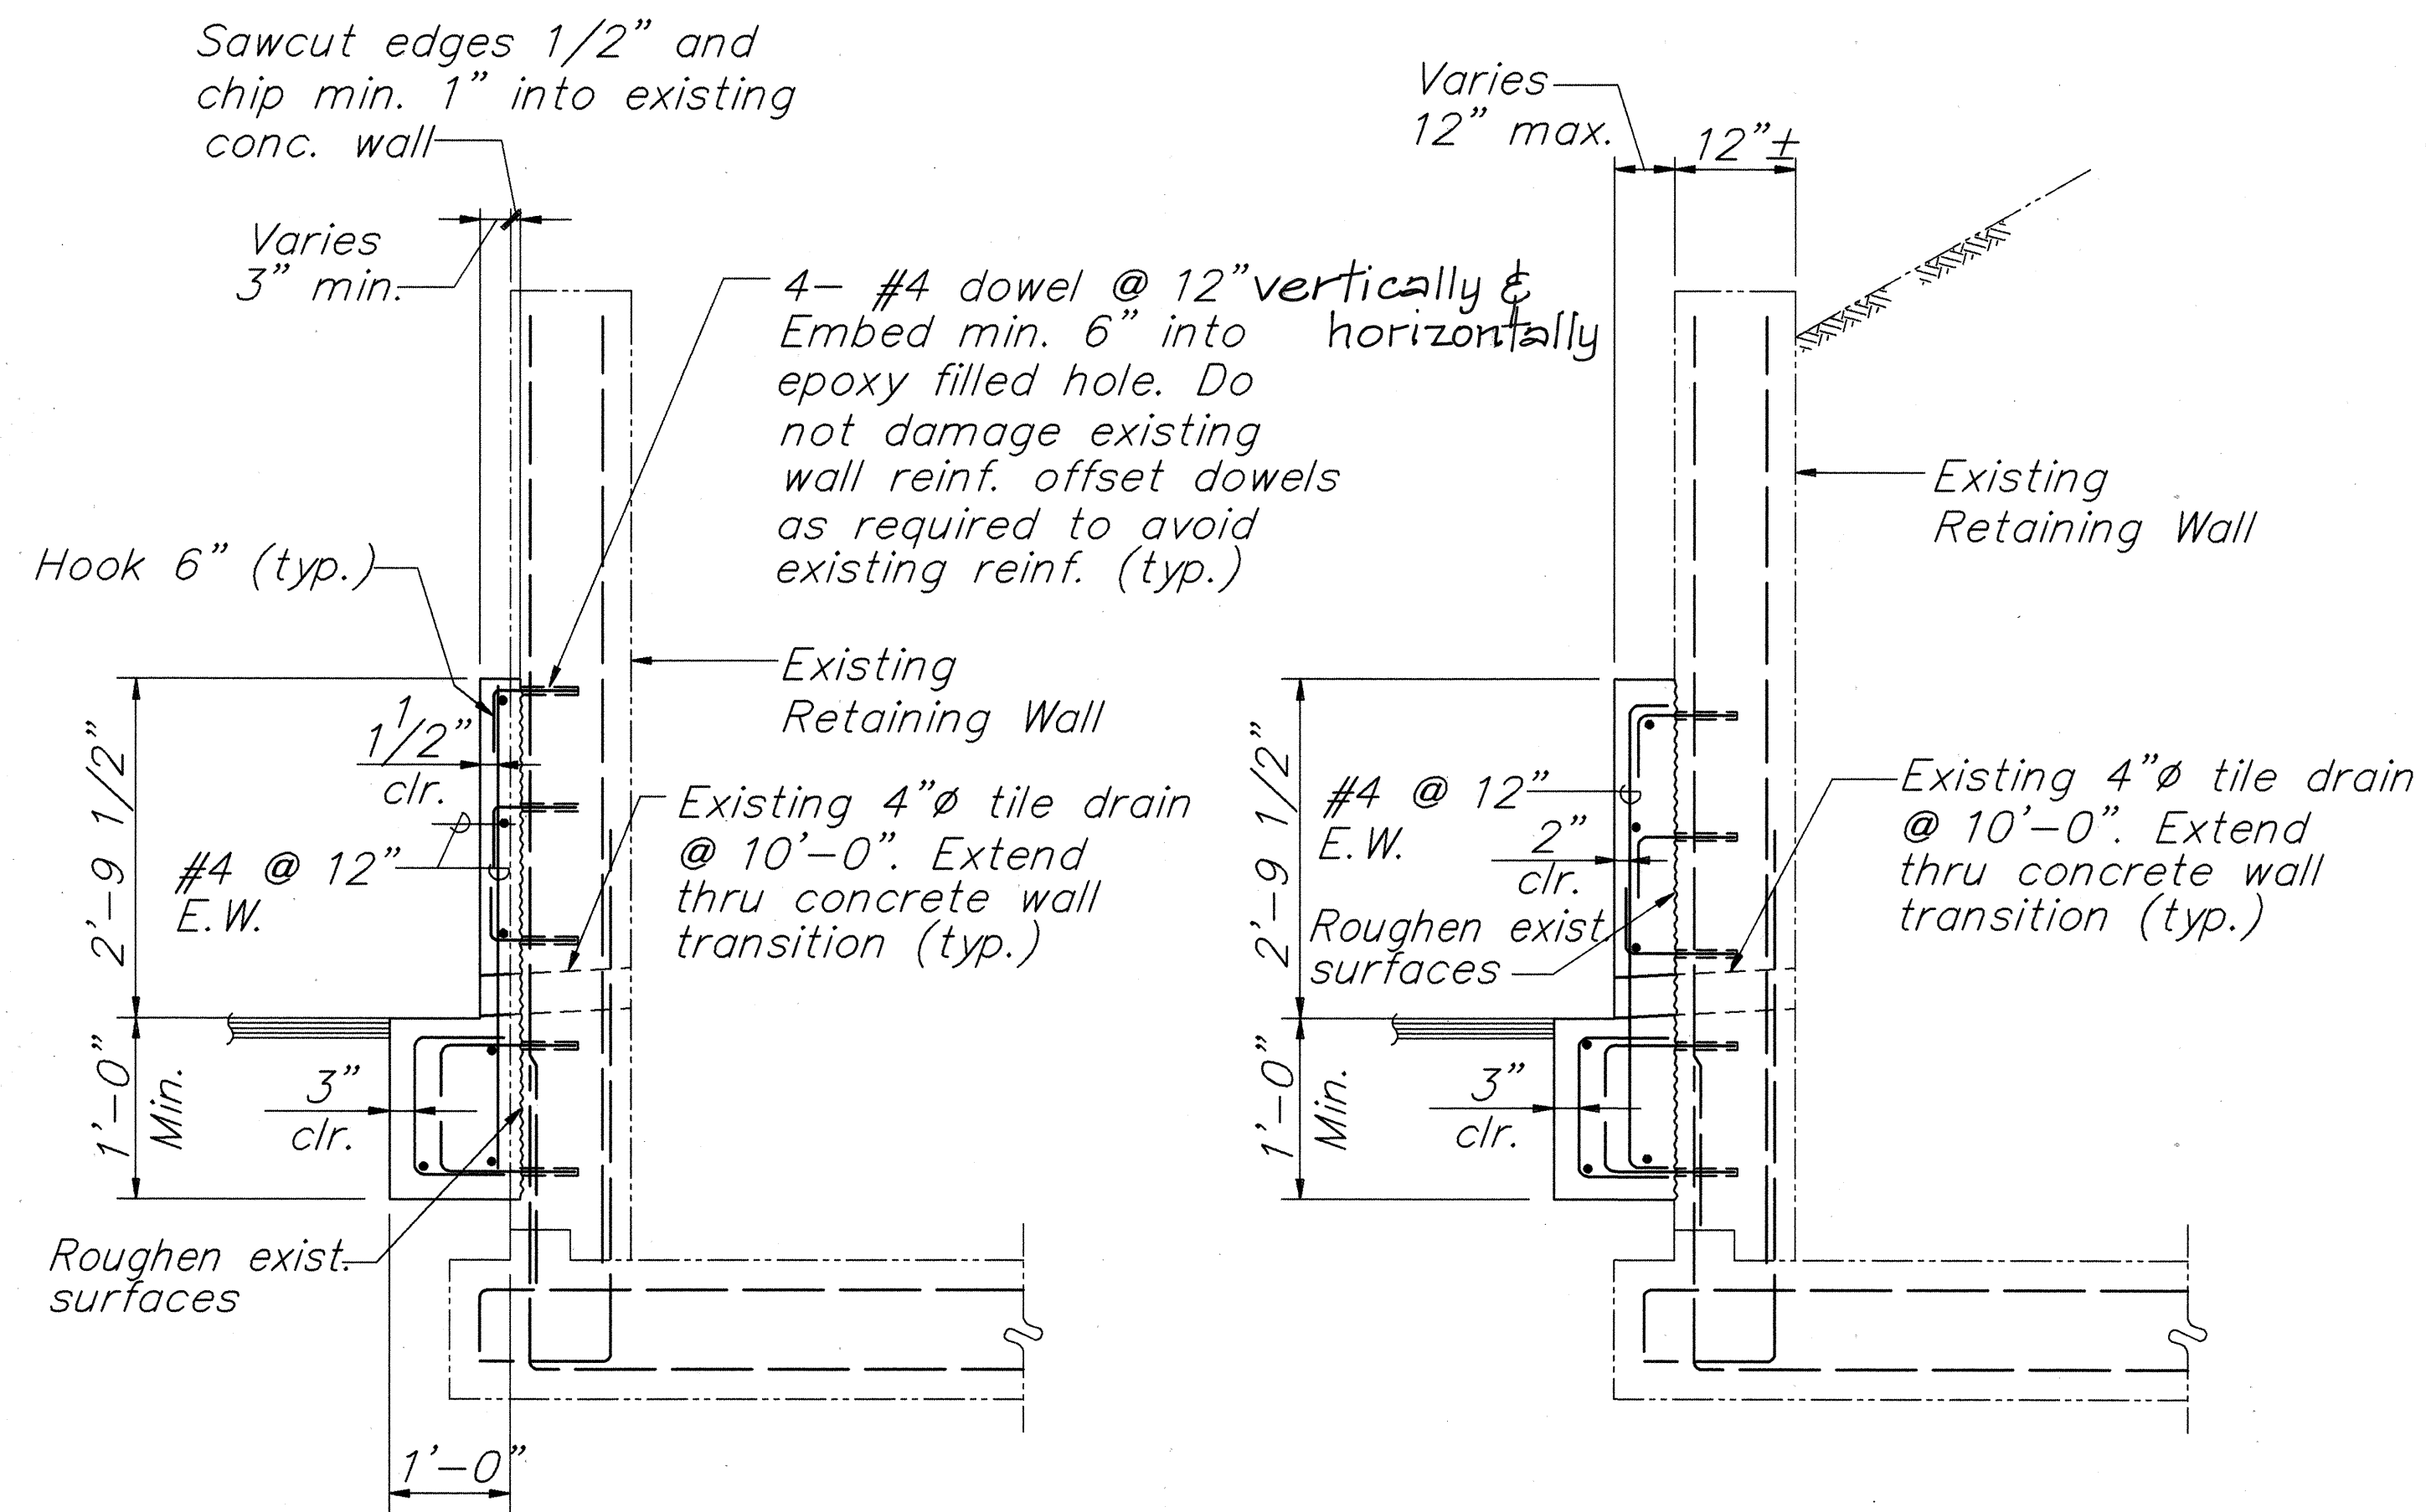


SECTION A
Scale: 3/4" = 1'-0" 5C2 5C2

TYPICAL SECTION ≤ 12" WIDE B
Scale: 3/4" = 1'-0" 5C2 5C2

TYPICAL SECTION > 12" WIDE C
Scale: 3/4" = 1'-0" 5C2 5C3

SECTION C
Scale: 3/4" = 1'-0" 5C3 5C2

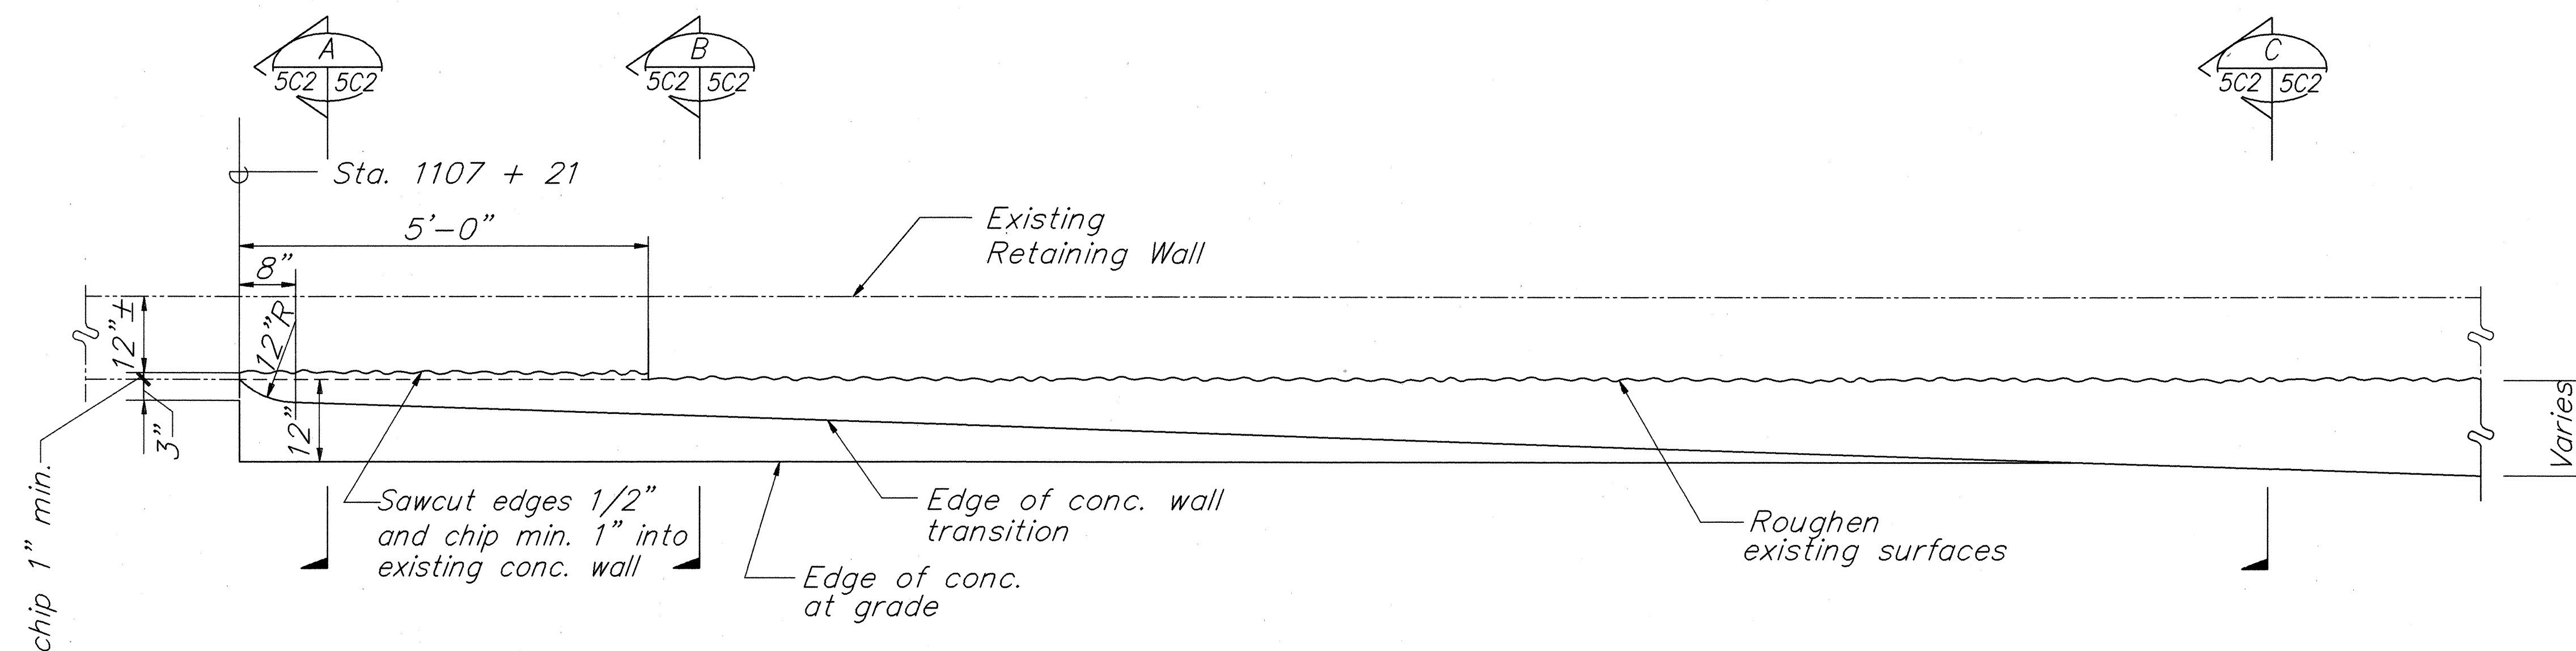



PLAN OF CONCRETE WALL TRANSITION
Scale: 3/4" = 1'-0"



THIS WORK WAS PREPARED BY ME OR UNDER MY SUPERVISION
H. Takashi Miyamoto

DATE:	REVISION
	STATE OF HAWAII DEPARTMENT OF TRANSPORTATION HIGHWAYS DIVISION WINDWARD CONCRETE WALL TRANSITION PLAN AND SECTIONS H-3 FINISH (UNIT II) F.A.I. PROJ. NO. I-H3-1(75), UNIT II LEEWARD SECTION SCALE: AS NOTED DATE: JAN. 1997 SHEET No. 5C2 OF 4 SHEETS



FED. ROAD DIST. NO.	STATE	FED. AID PROJ. NO.	FISCAL YEAR	SHEET NO.	TOTAL SHEETS
HAWAII	HAW.	I-H3-1(75) UNIT II	1997	836	1102

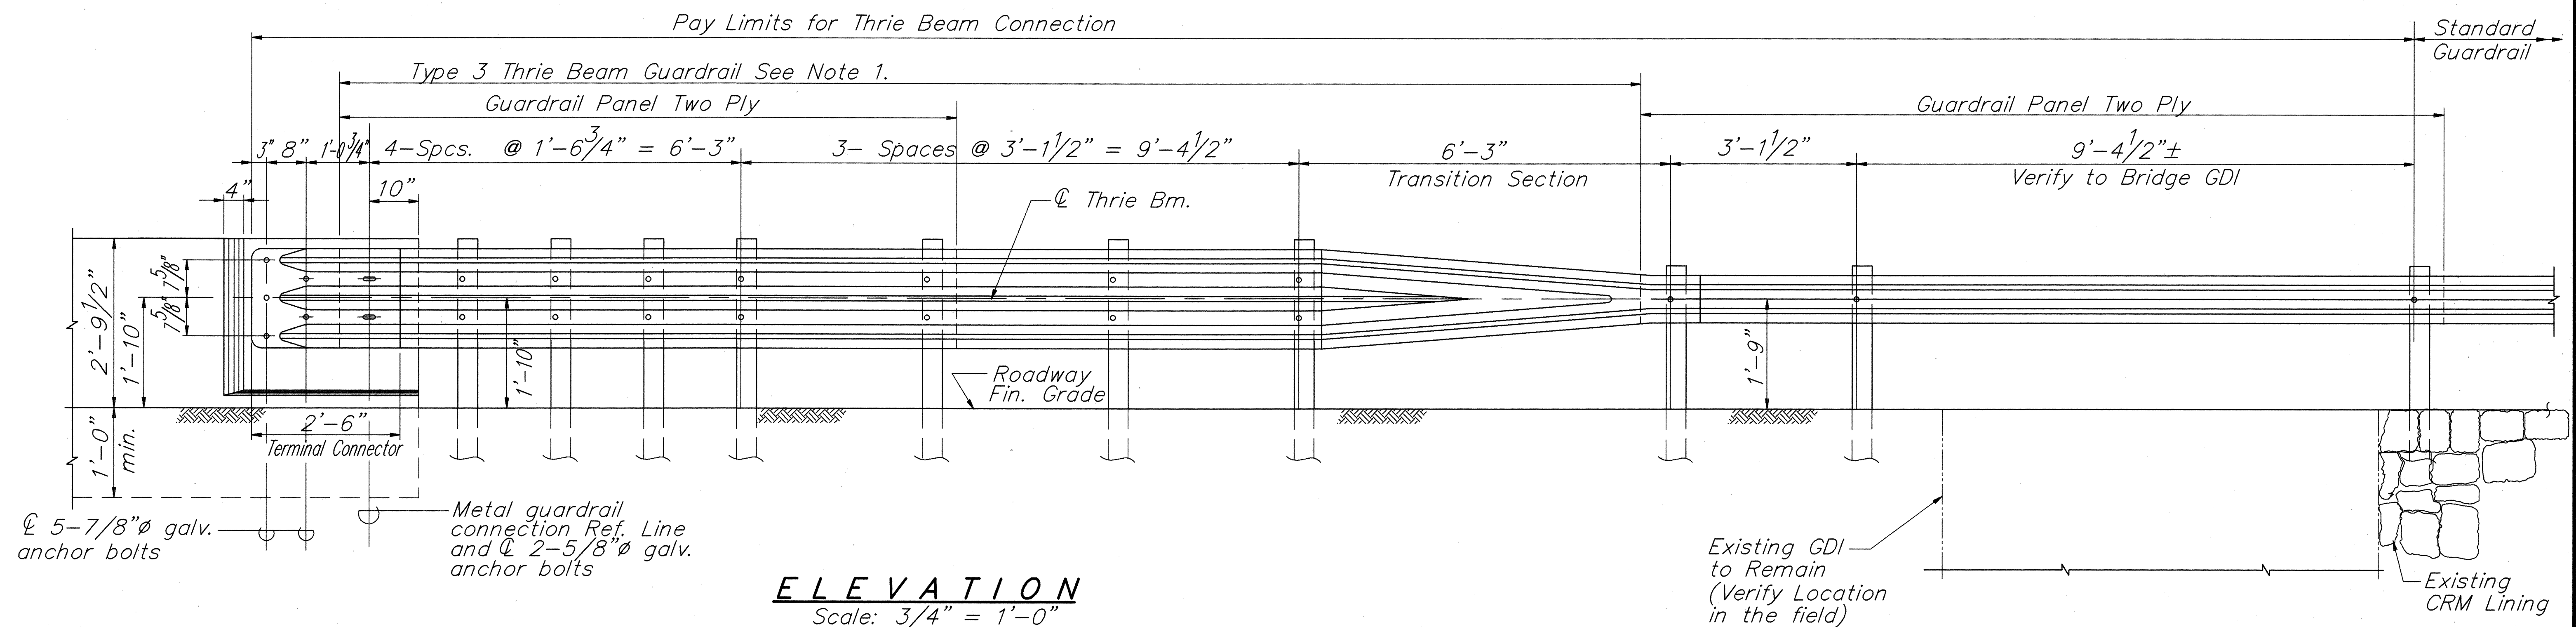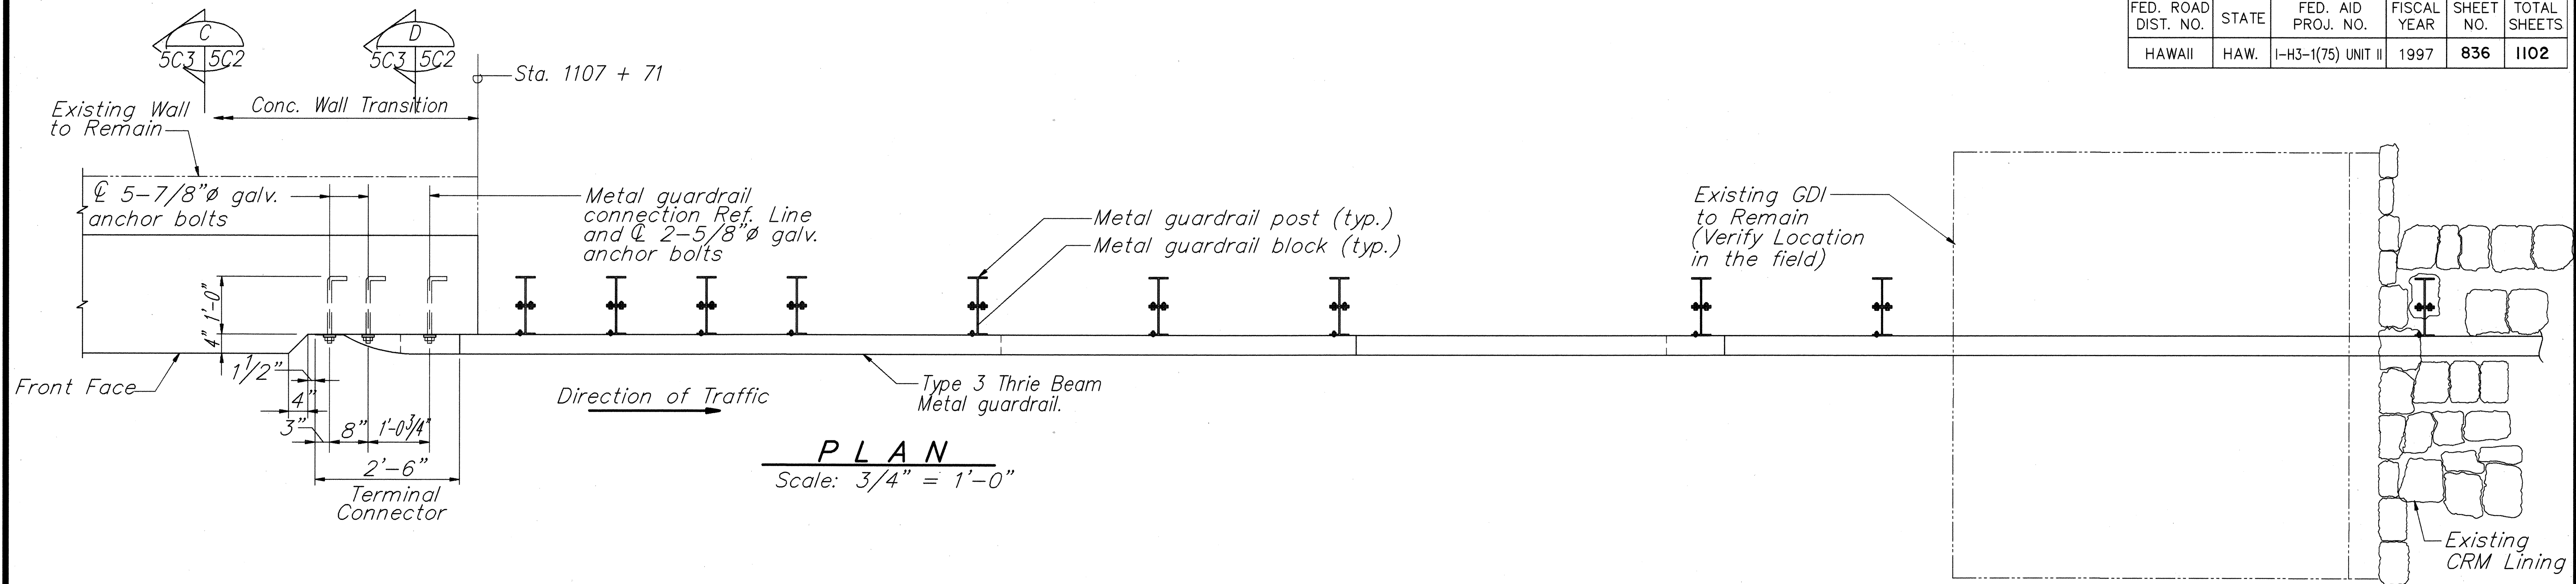

METAL GUARDRAIL CONNECTION TO CONCRETE WALL TRANSITION -DETAIL
Scale: As Noted

NOTE:

1. See Standard Plan TE-57 for Guardrail Type 3 Thrie Beam detail.
2. Concrete strength = 3,000 psi Use - 3/8" max. aggregate
3. Reinforcing steel shall be ASTM A615 Grade 40, All bars shall be #4.
4. Anchor bolts shall be ASTM A307 and hot dip galvanized.
5. Chipping, Excavation for footing, dowelling and reinforcing steel are incidental to concrete in transition wall.

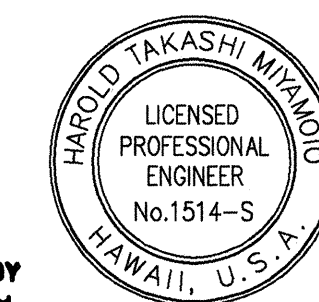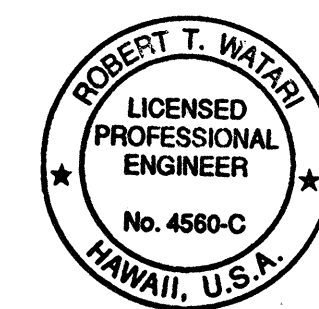

THIS WORK WAS PREPARED BY
ME OR UNDER MY SUPERVISION
Robert T. Watan






THIS WORK WAS PREPARED BY
ME OR UNDER MY SUPERVISION
Harold Takashi Mizuno

DATE:	REVISION
	STATE OF HAWAII DEPARTMENT OF TRANSPORTATION HIGHWAYS DIVISION WINDWARD METAL GUARDRAIL CONNECTION TO CONCRETE WALL TRANSITION DETAIL H-3 FINISH (UNIT II) F.A.I. PROJ. NO. I-H3-1(75) UNIT II LEEWARD SECTION SCALE: AS NOTED DATE: JAN. 1997 SHEET No. 5C3 OF 4 SHEETS


FED. ROAD DIST. NO.	STATE	FED. AID PROJ. NO.	FISCAL YEAR	SHEET NO.	TOTAL SHEETS
HAWAII	HAW.	I-H3-1(75), UNIT II	1997	837	1102

NOTES:


- The existing portable concrete barrier shall remain the property of the State. The Contractor shall deliver these barriers to Kaneohe Baseyard or at a location ordered by the Engineer. This work will be considered incidental to Concrete Rigid Barrier, Modified Type 4G.
- See Standard Plan TE-63 & TE-65 for General Notes, Expansion Joint Detail, Construction & control Joint Detail, & optional Construction Joint Details.
- The accepted quantity of Concrete Rigid Barrier Transition Type 4G will be paid under Concrete Rigid Barrier, Type 4G. The accepted quantity of Concrete Rigid Barrier Transition, Modified Type 4G will be paid under Concrete Rigid Barrier, Modified Type 4G.

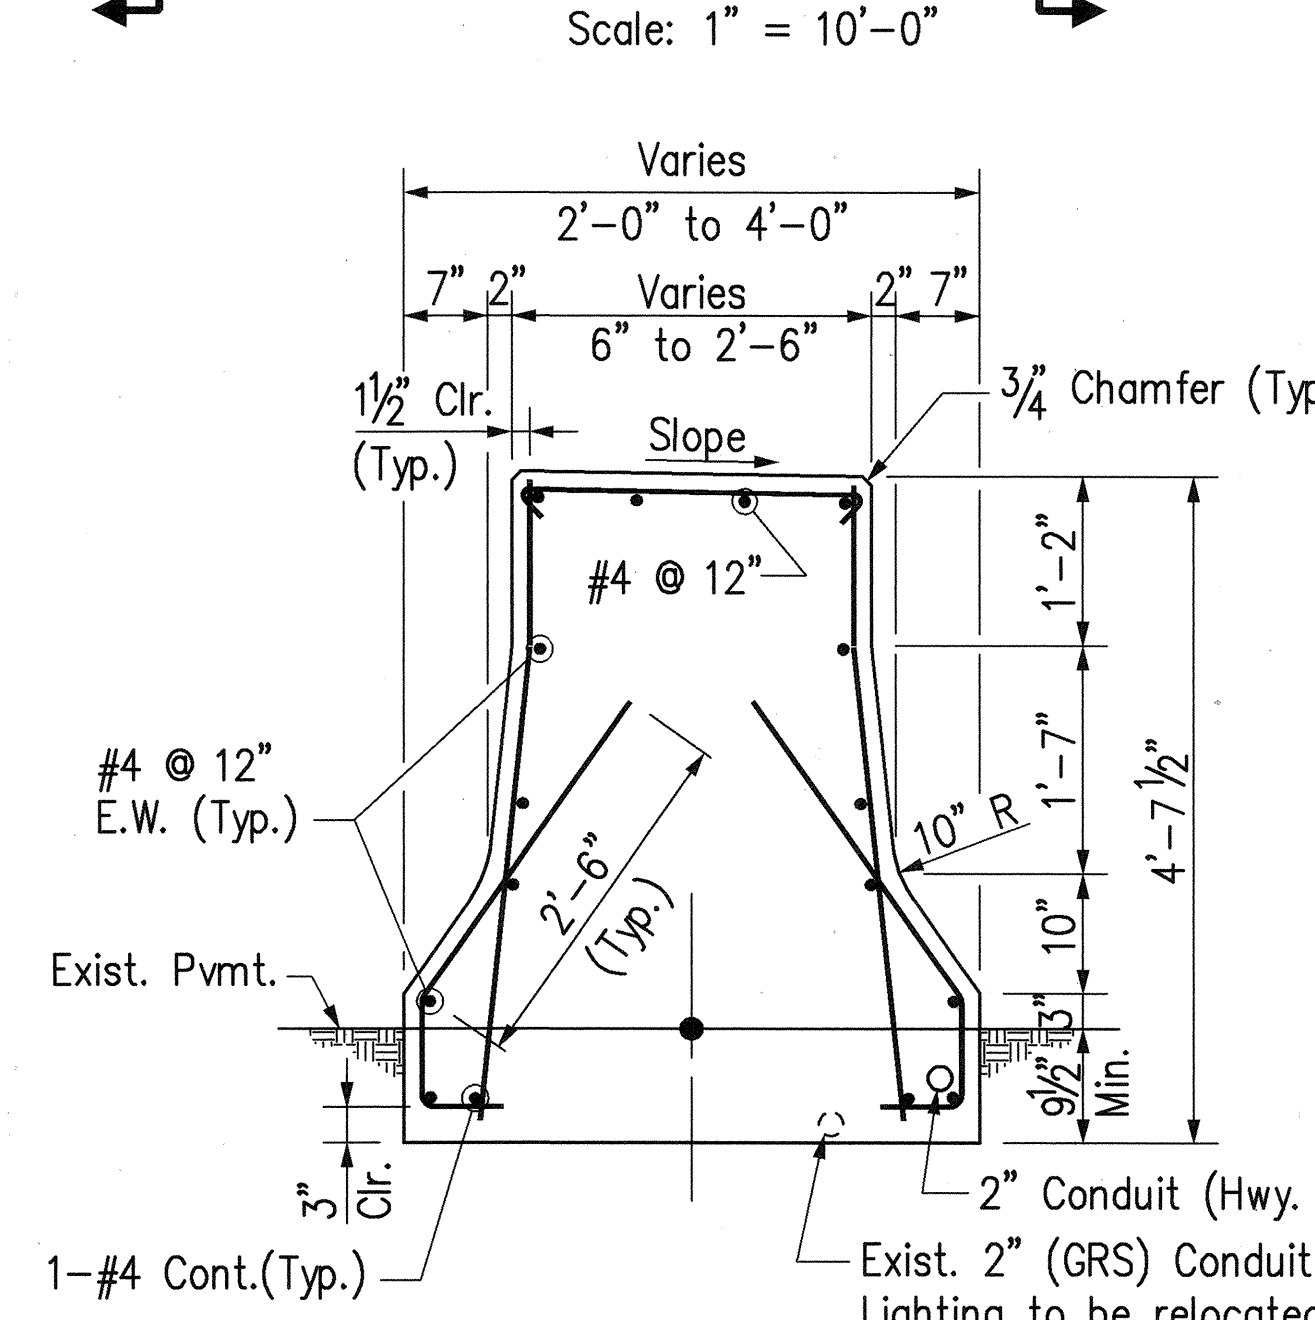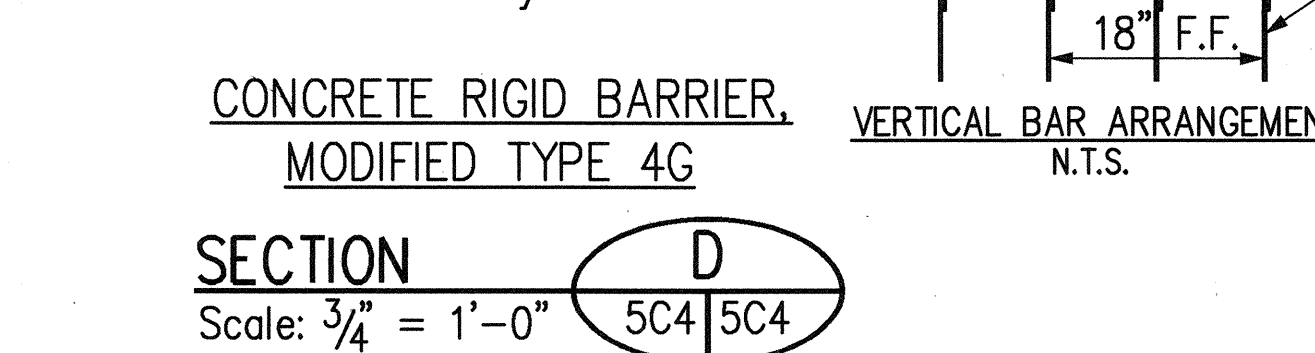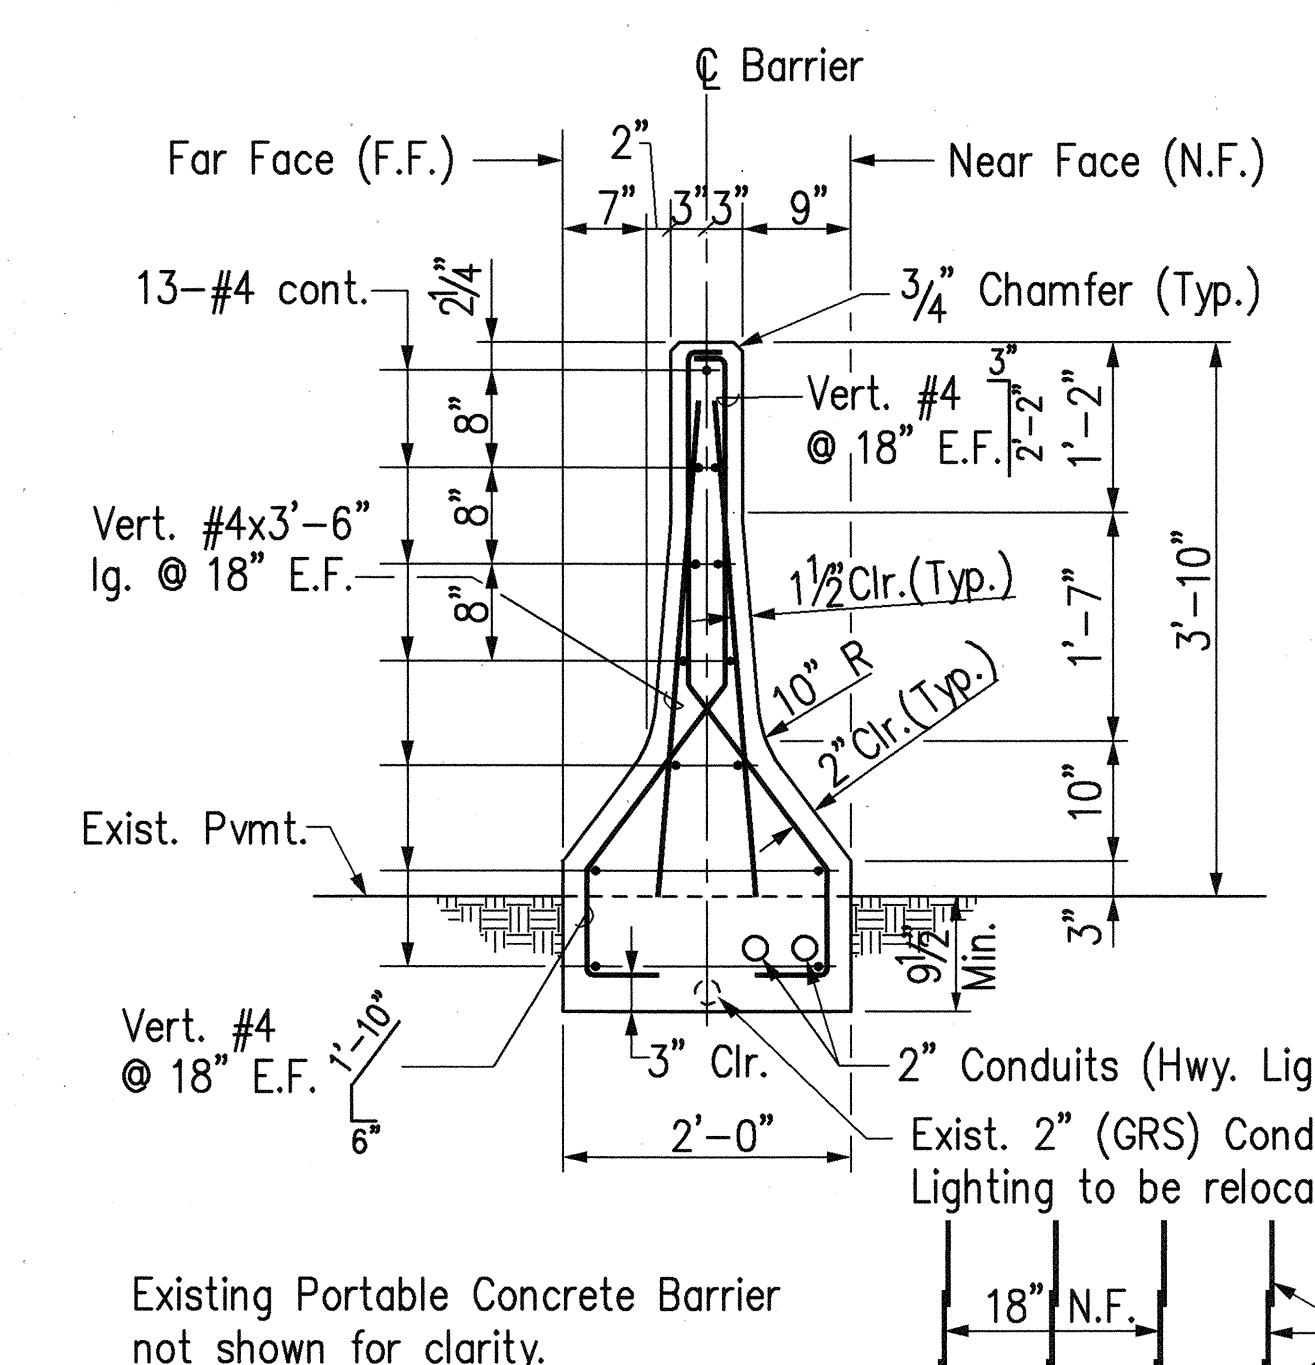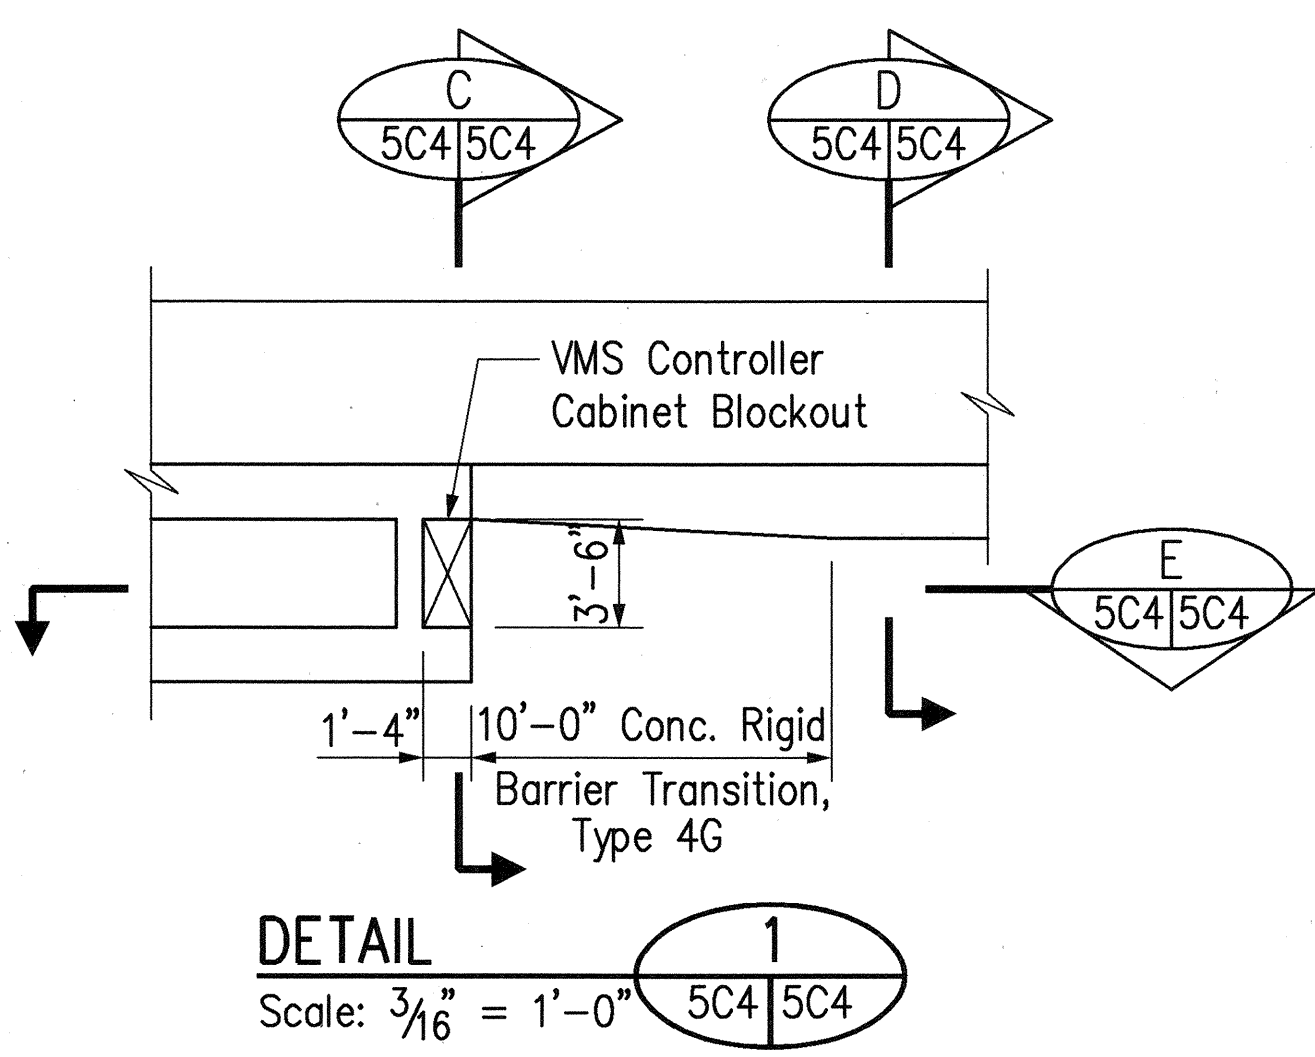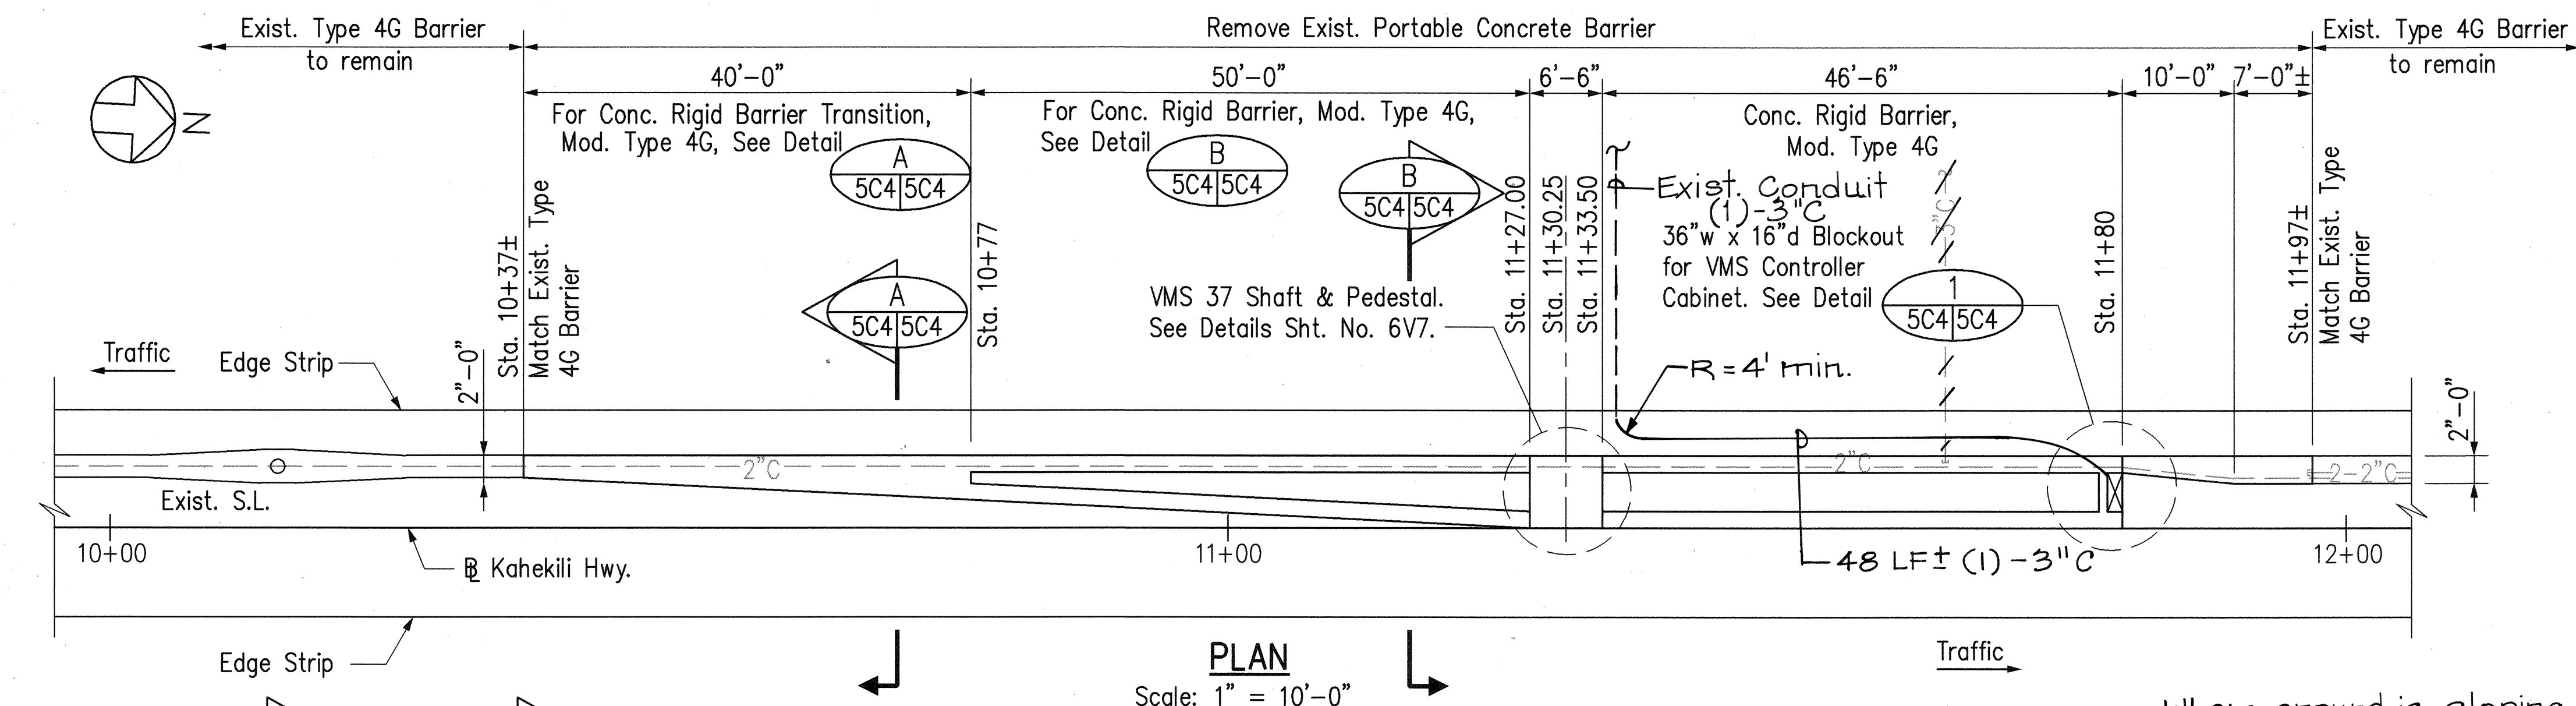


CONCRETE RIGID BARRIER TRANSITION, MODIFIED TYPE 4G

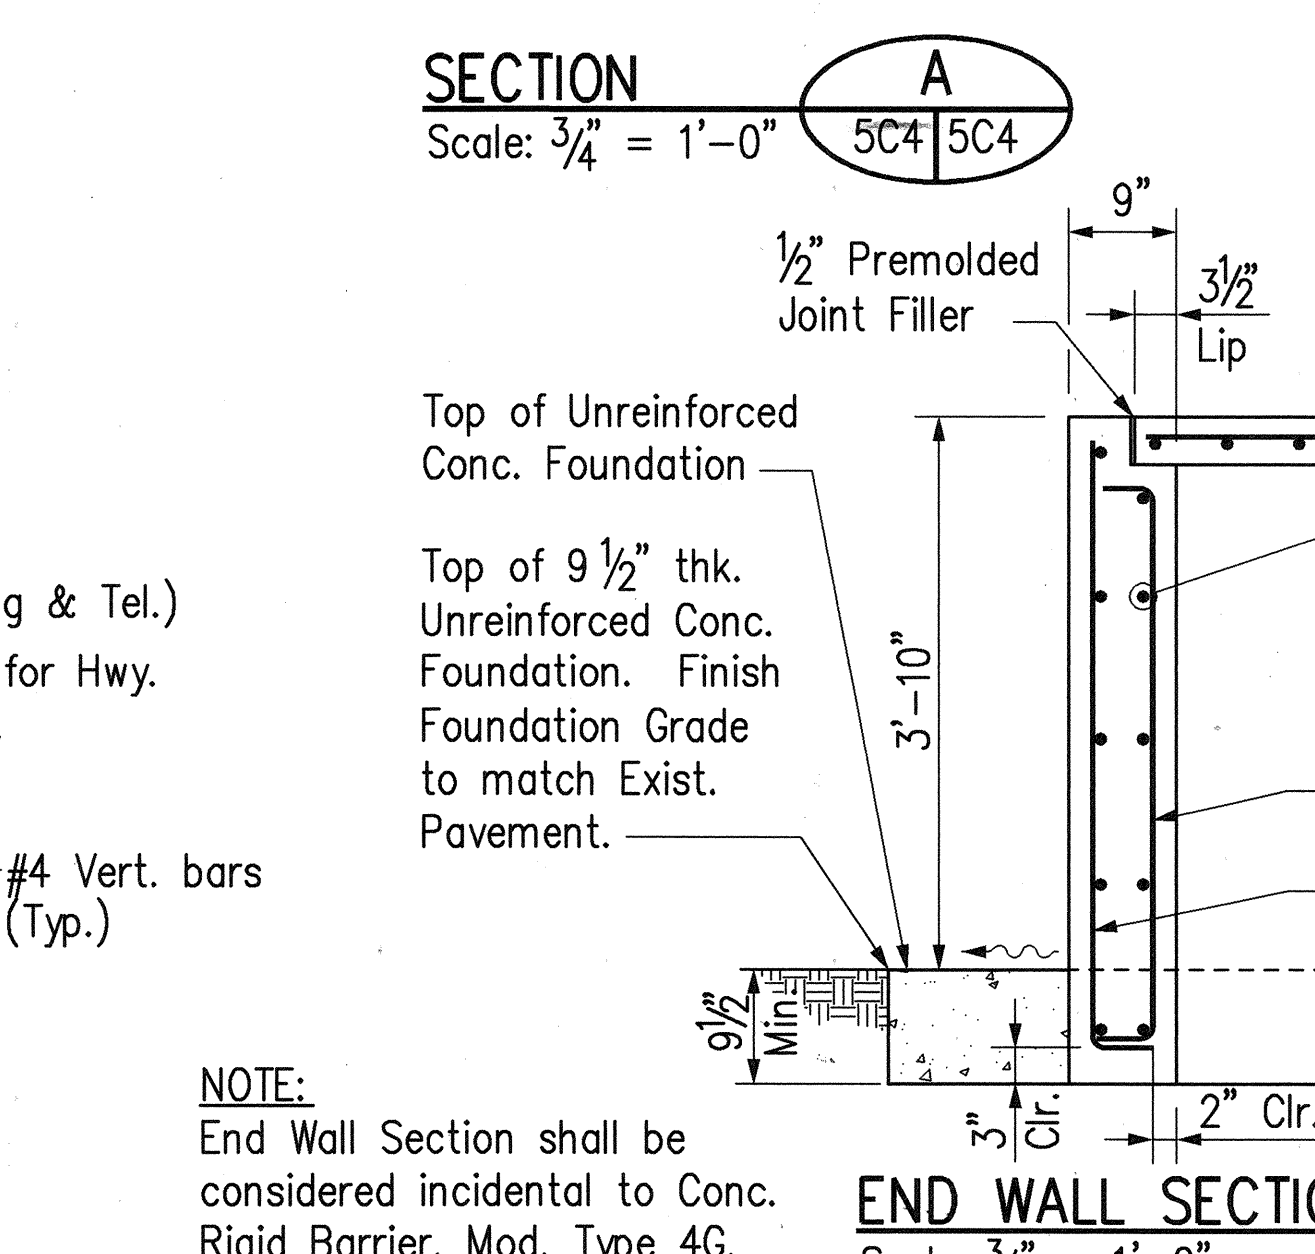


CONCRETE RIGID BARRIER, MODIFIED TYPE 4G

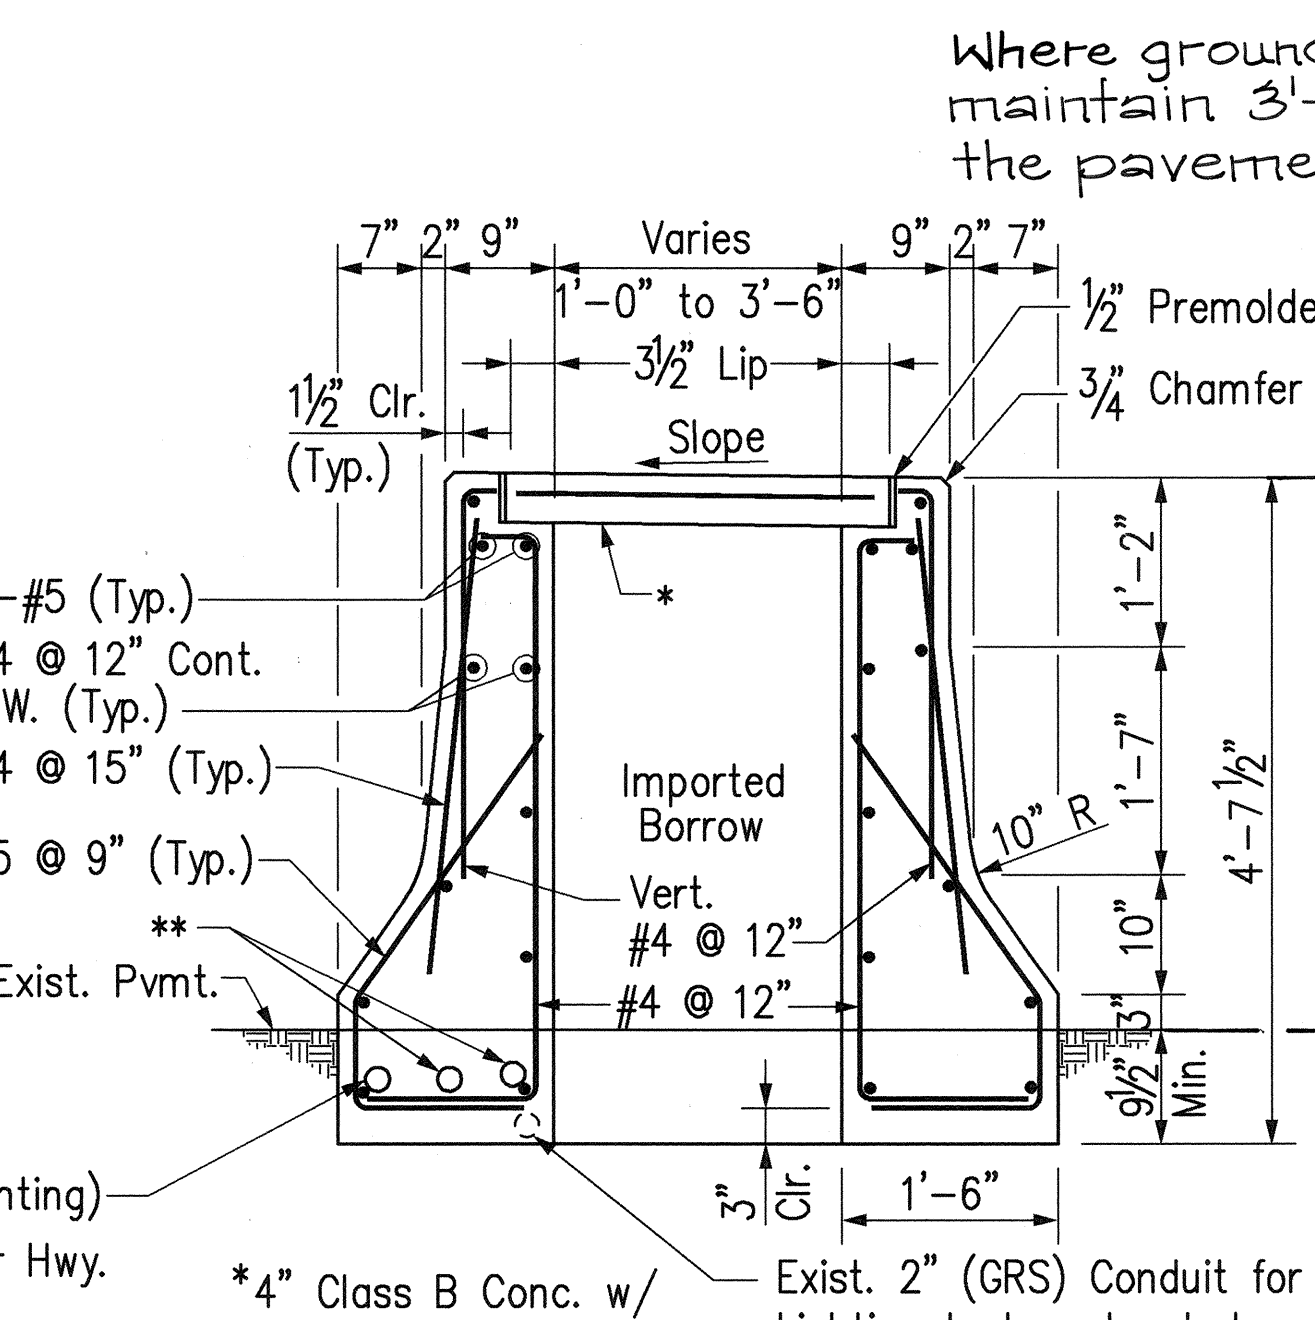


CONCRETE RIGID BARRIER, MODIFIED TYPE 4G

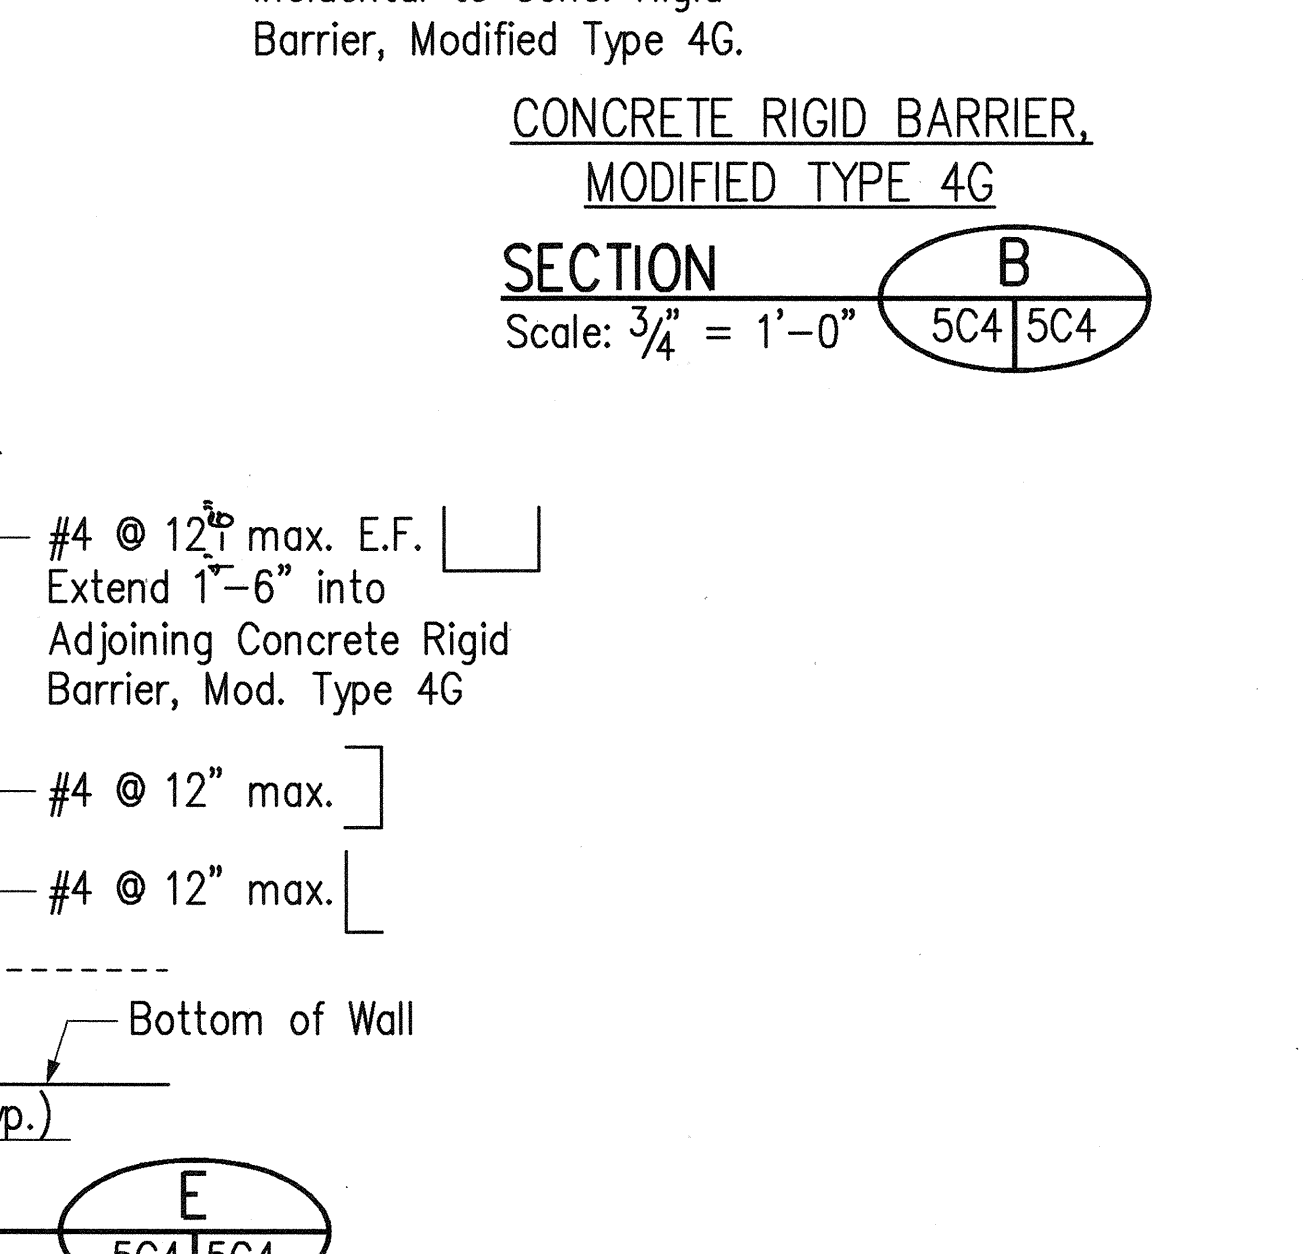


CONCRETE RIGID BARRIER, MODIFIED TYPE 4G

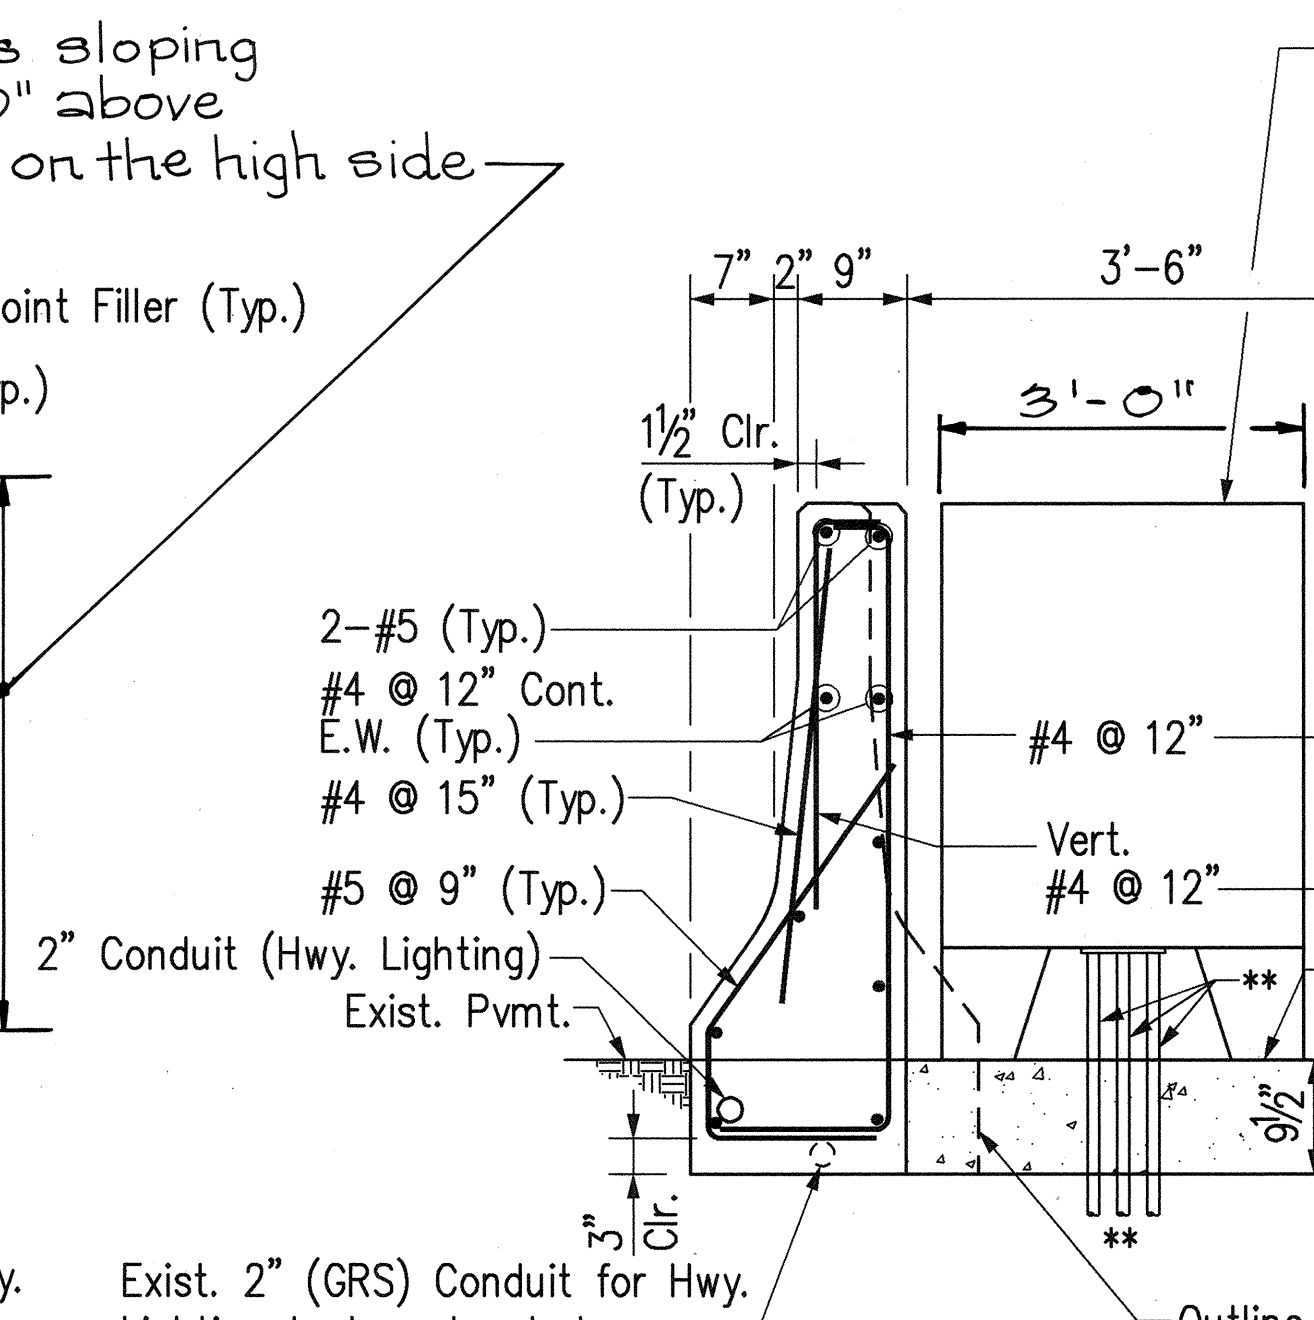


CONCRETE RIGID BARRIER, MODIFIED TYPE 4G

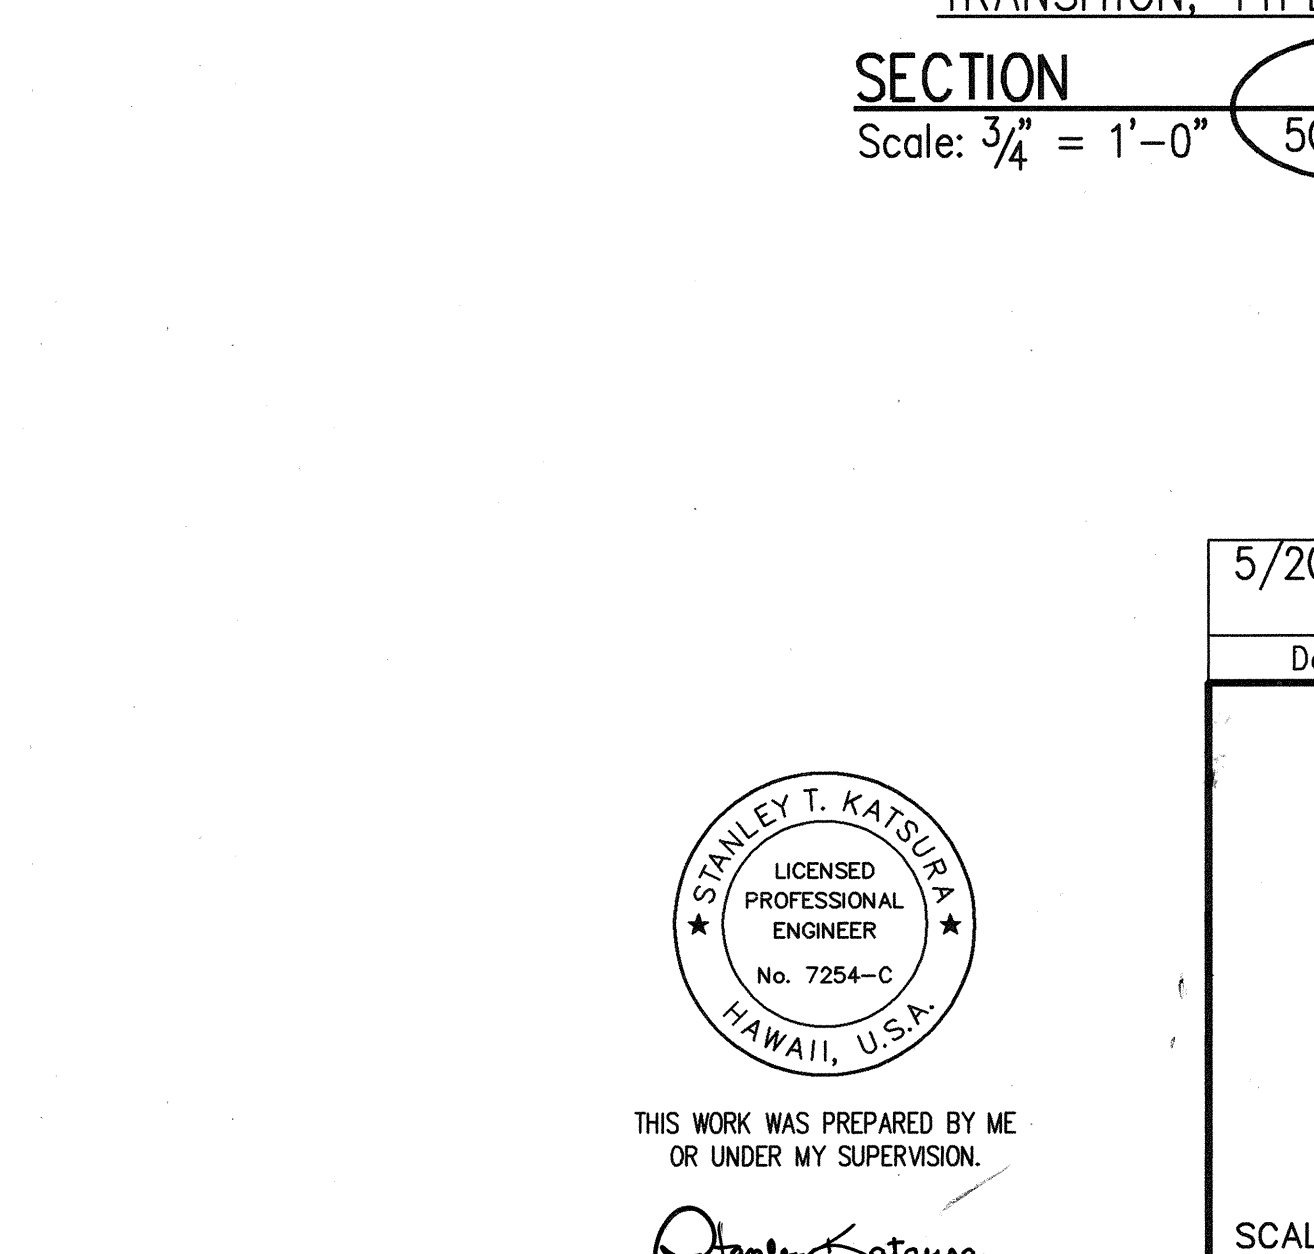


CONCRETE RIGID BARRIER, MODIFIED TYPE 4G

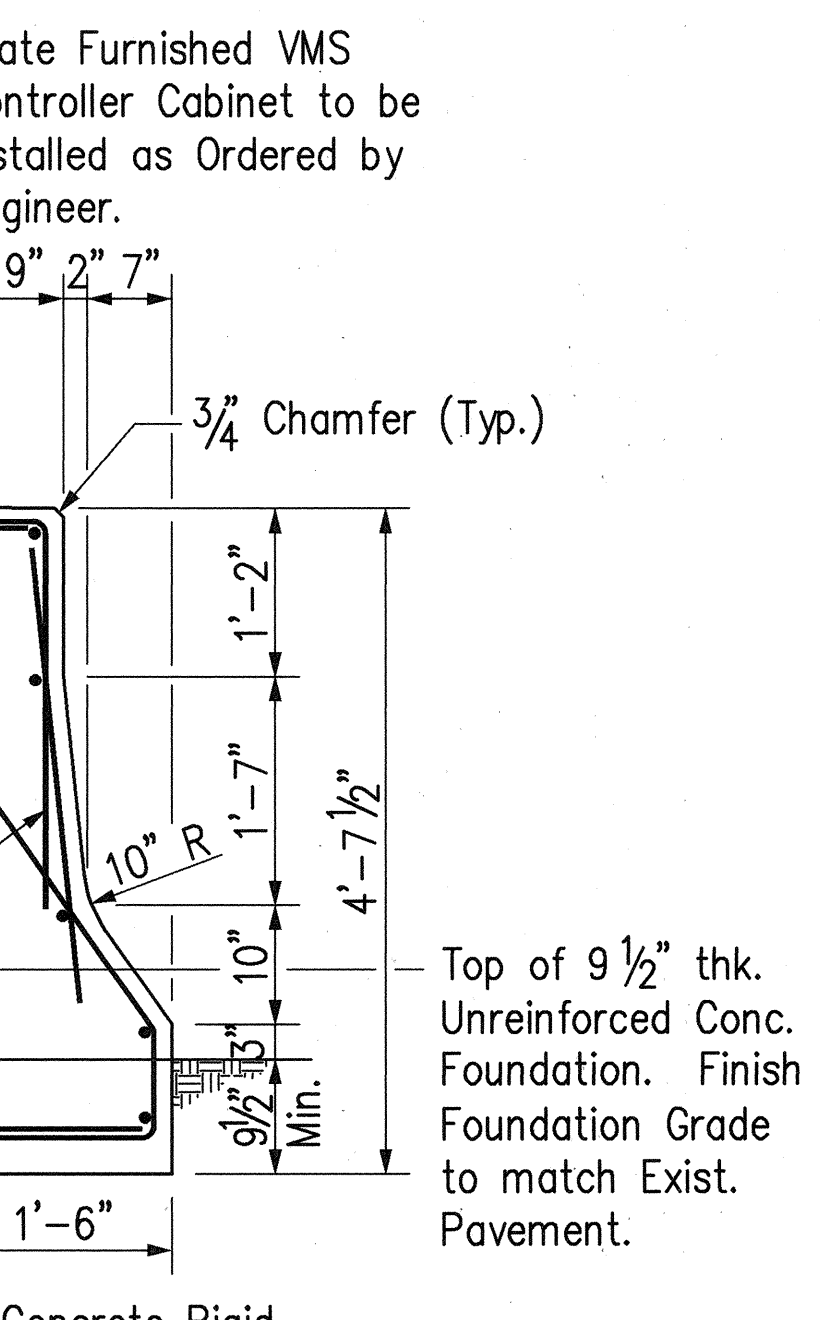

CONCRETE RIGID BARRIER, MODIFIED TYPE 4G

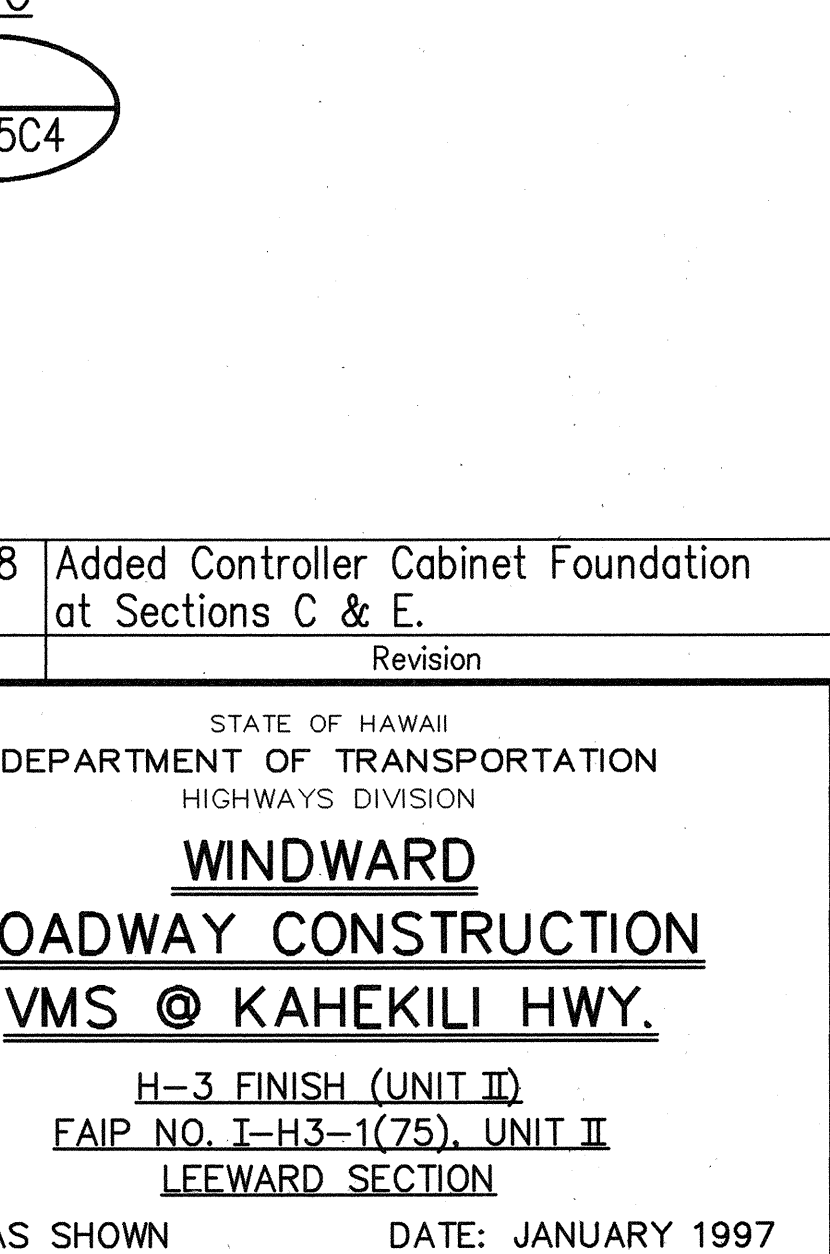

CONCRETE RIGID BARRIER, MODIFIED TYPE 4G

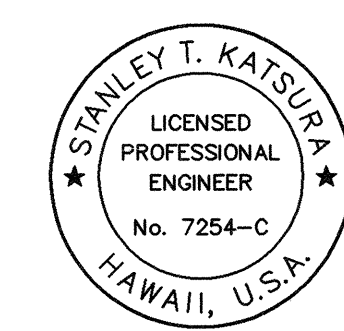




THIS WORK WAS PREPARED BY ME OR UNDER MY SUPERVISION.

Stanley T. Katsura

5/20/98	Added Controller Cabinet Foundation at Sections C & E.
Date	Revision
STATE OF HAWAII DEPARTMENT OF TRANSPORTATION HIGHWAYS DIVISION WINDWARD ROADWAY CONSTRUCTION VMS @ KAHEKILI HWY. H-3 FINISH (UNIT II) FAIP NO. I-H3-1(75), UNIT II LEEWARD SECTION SCALE: AS SHOWN DATE: JANUARY 1997 SHEET NO. 5C4 OF 4 SHEETS	

C.O. 837

FED. ROAD DIST. NO.	STATE	FED. AID PROJ. NO.	FISCAL YEAR	SHEET NO.	TOTAL SHEETS
HAWAII	HAW.	I-H3-1(75), UNIT II	1997	C.O. 837S-1	1102

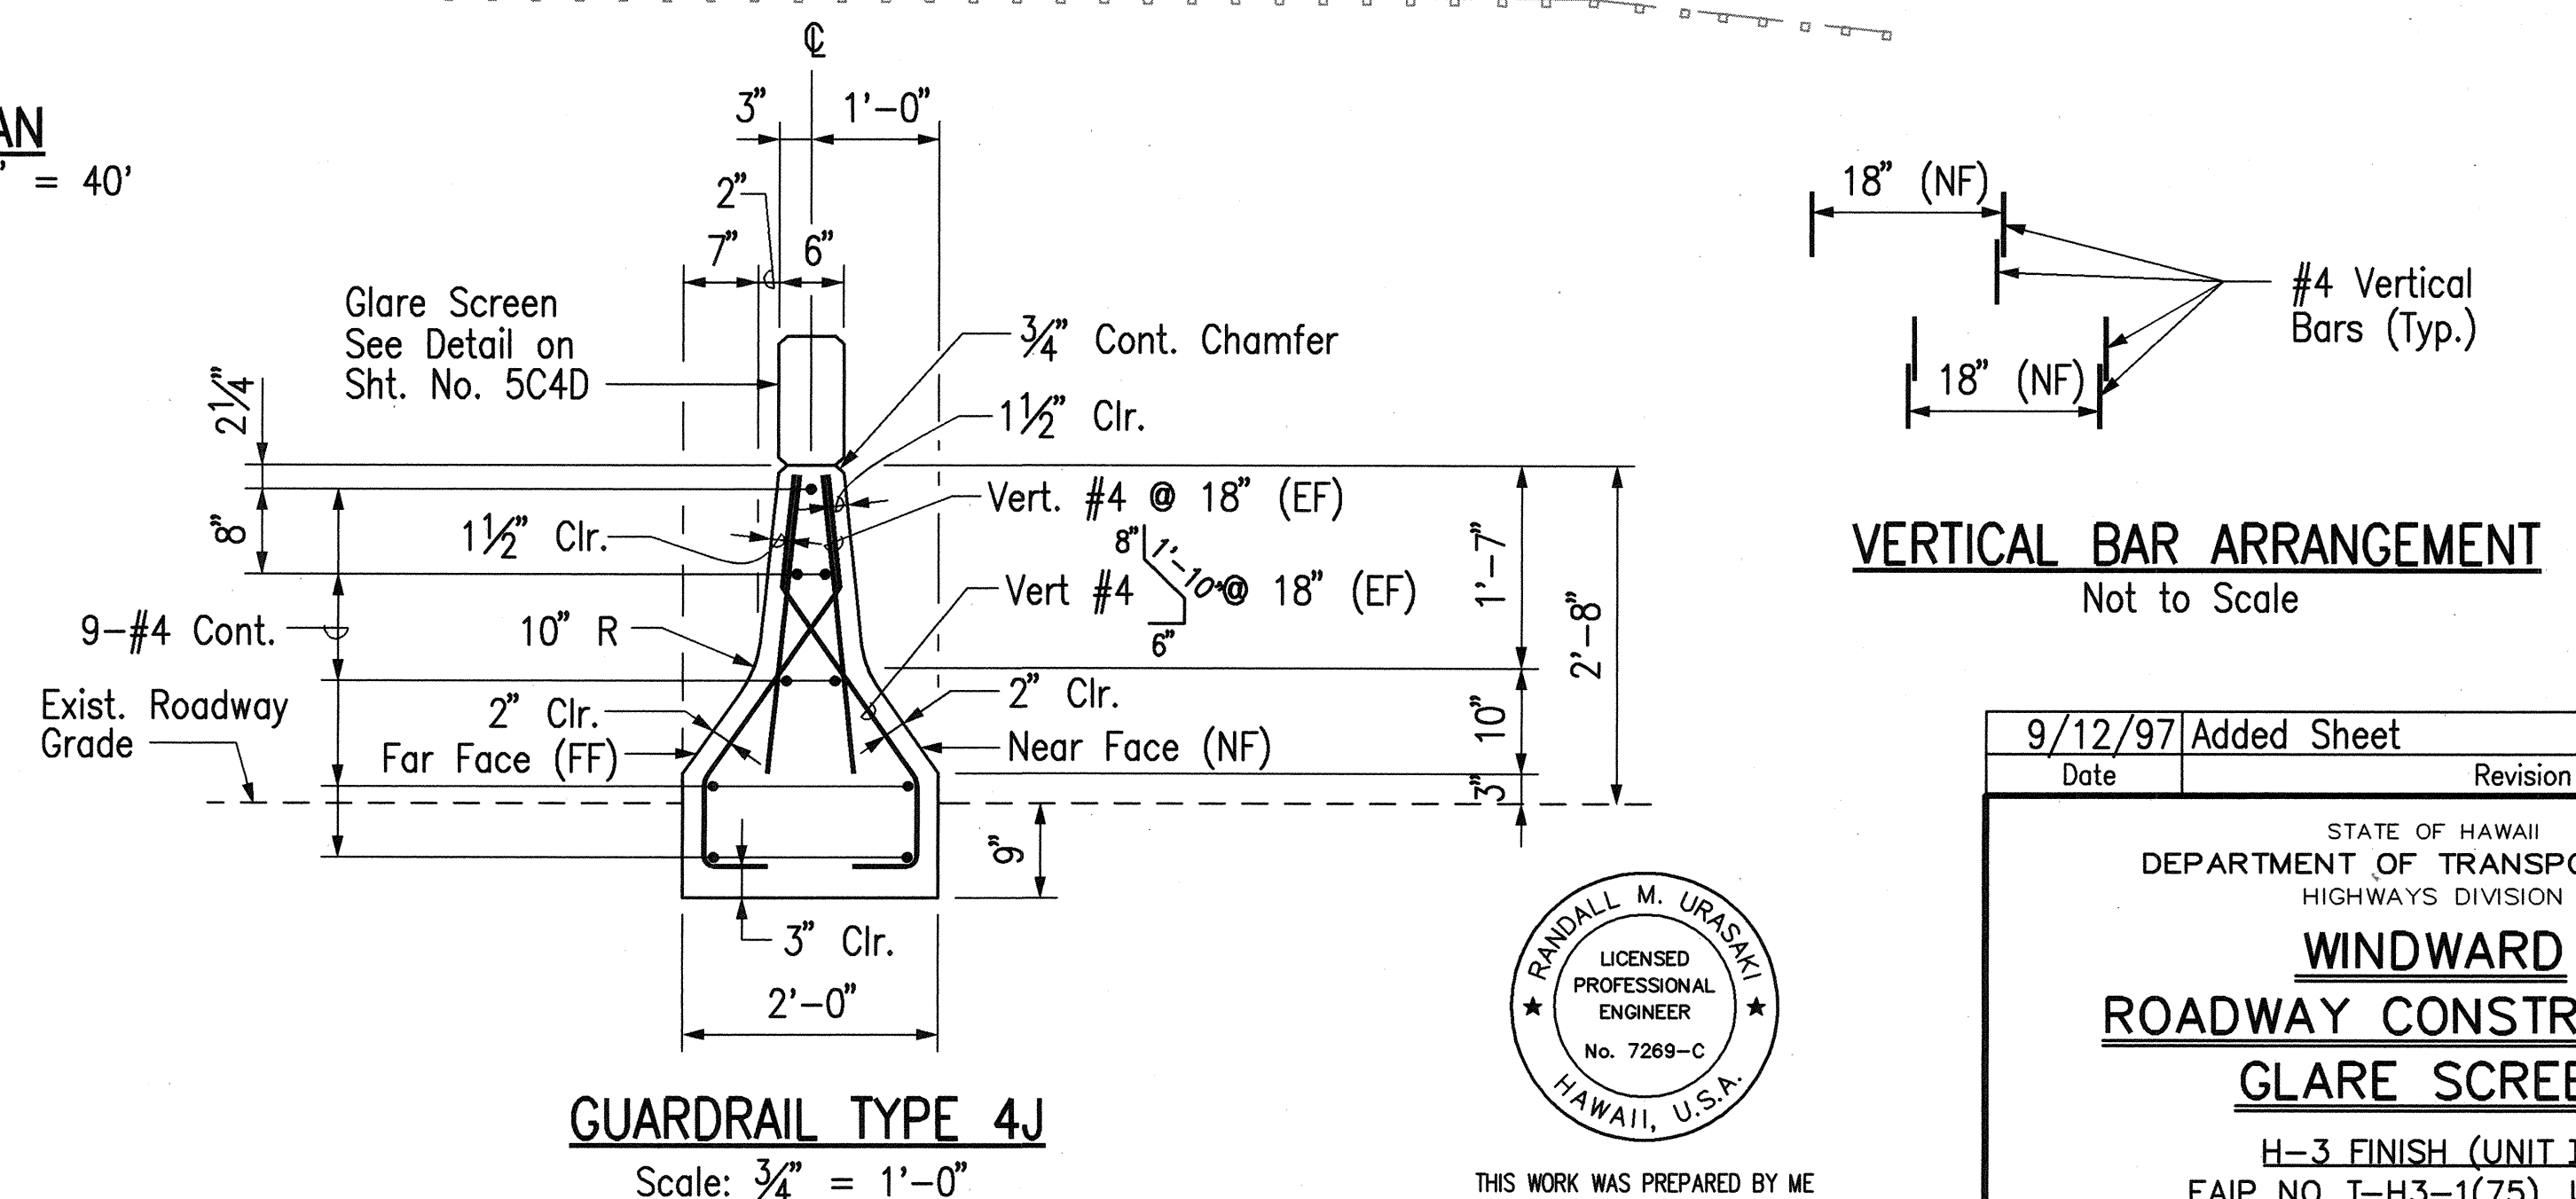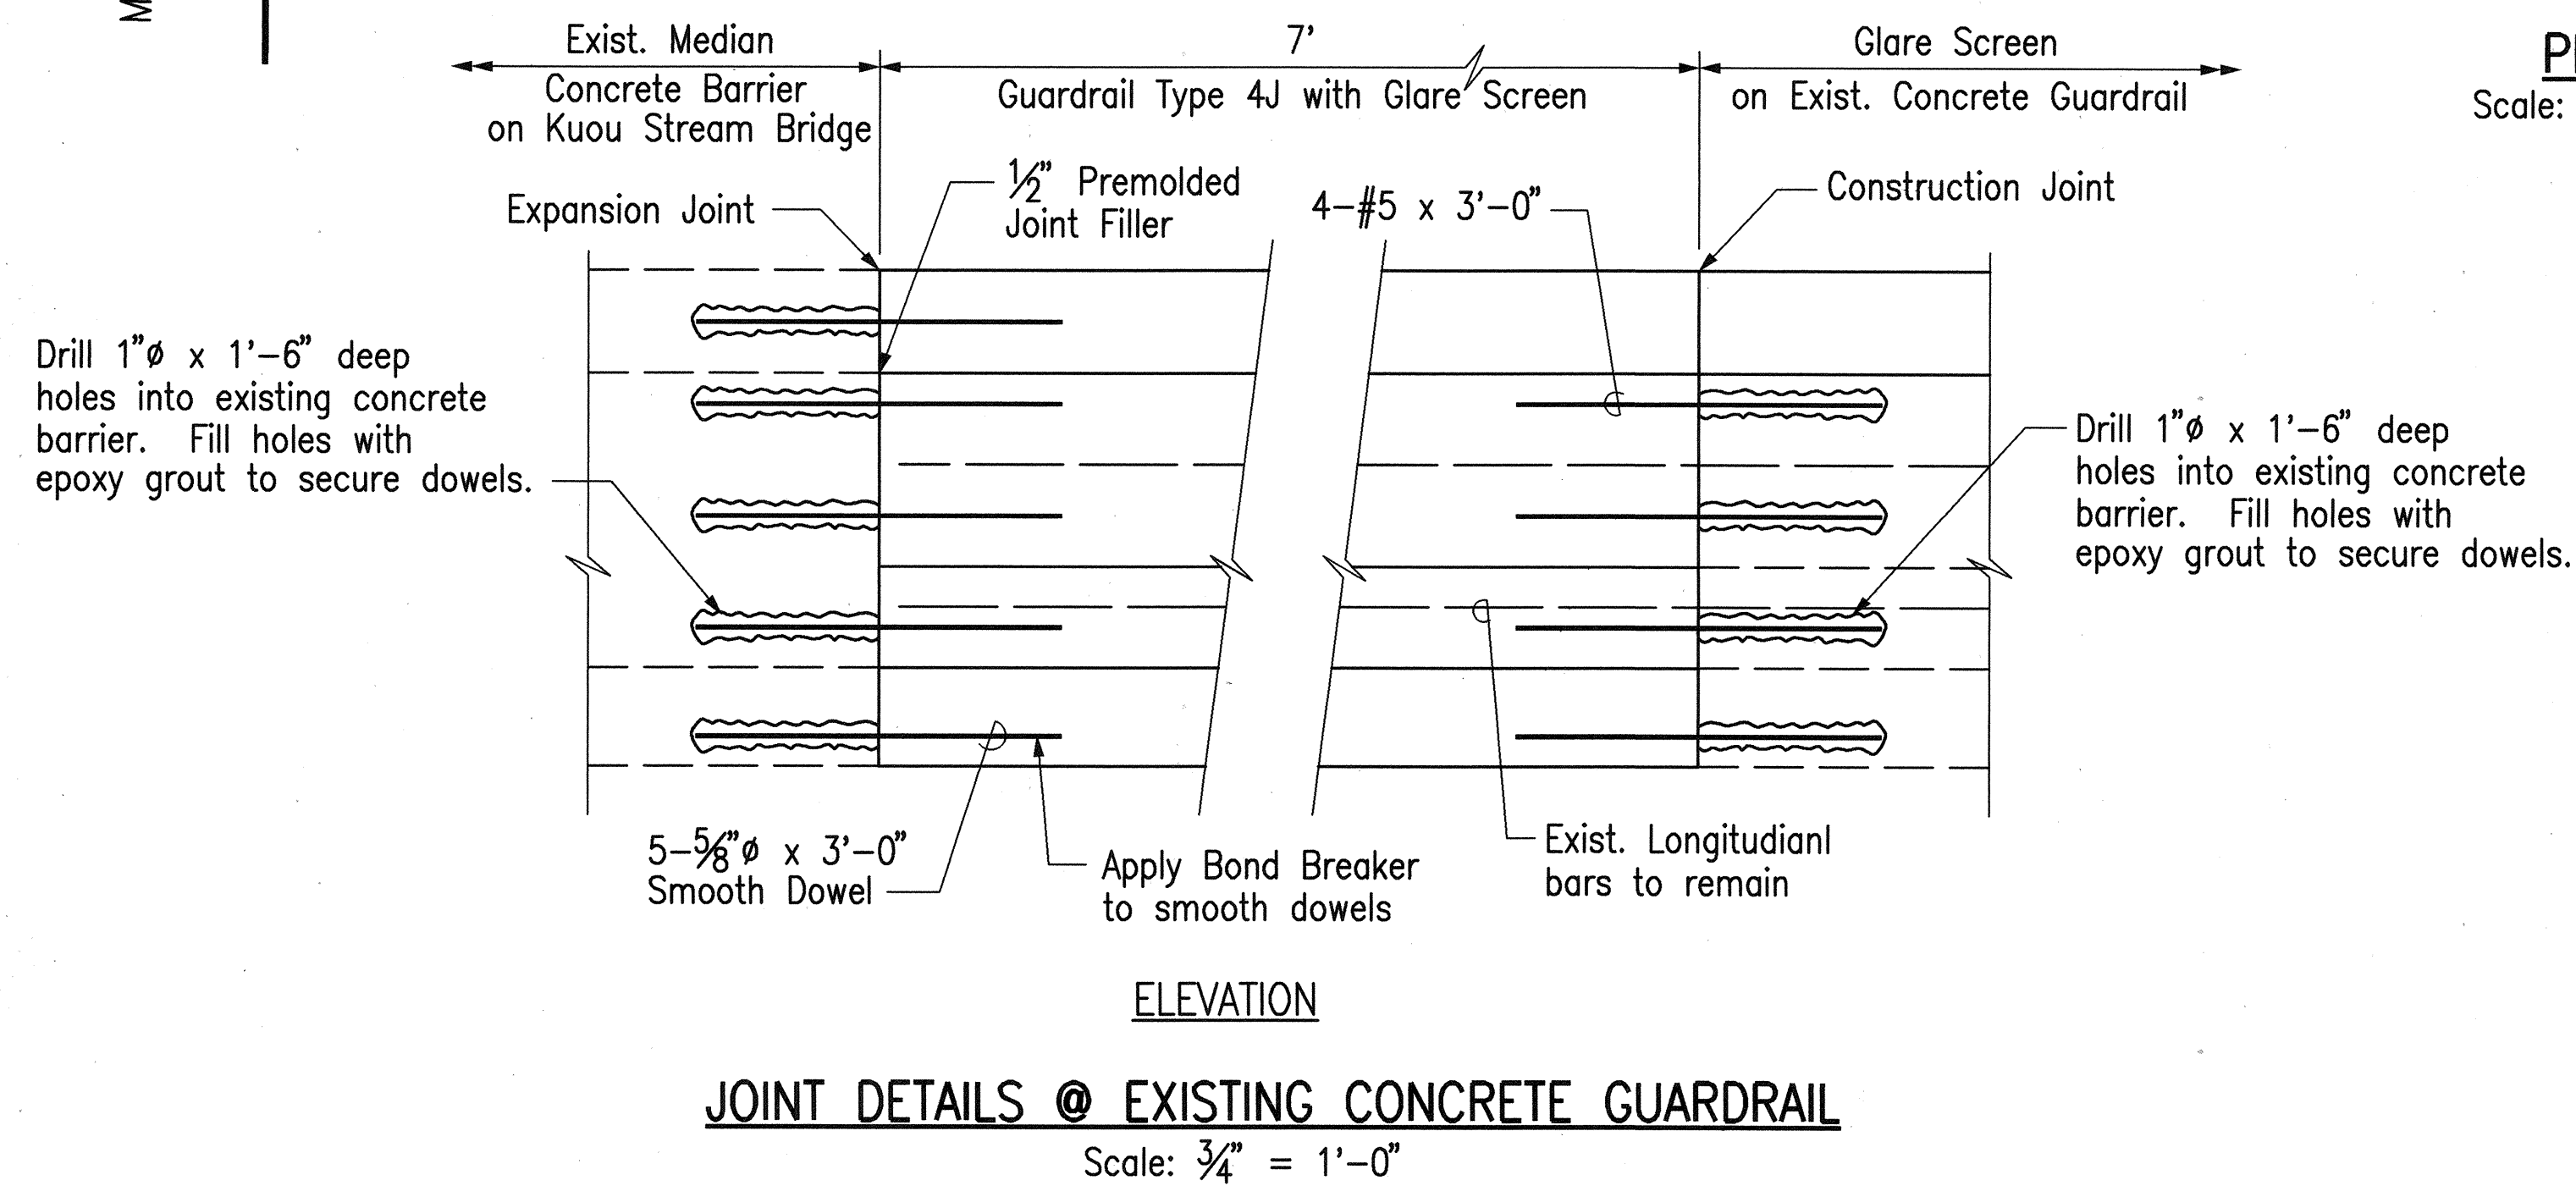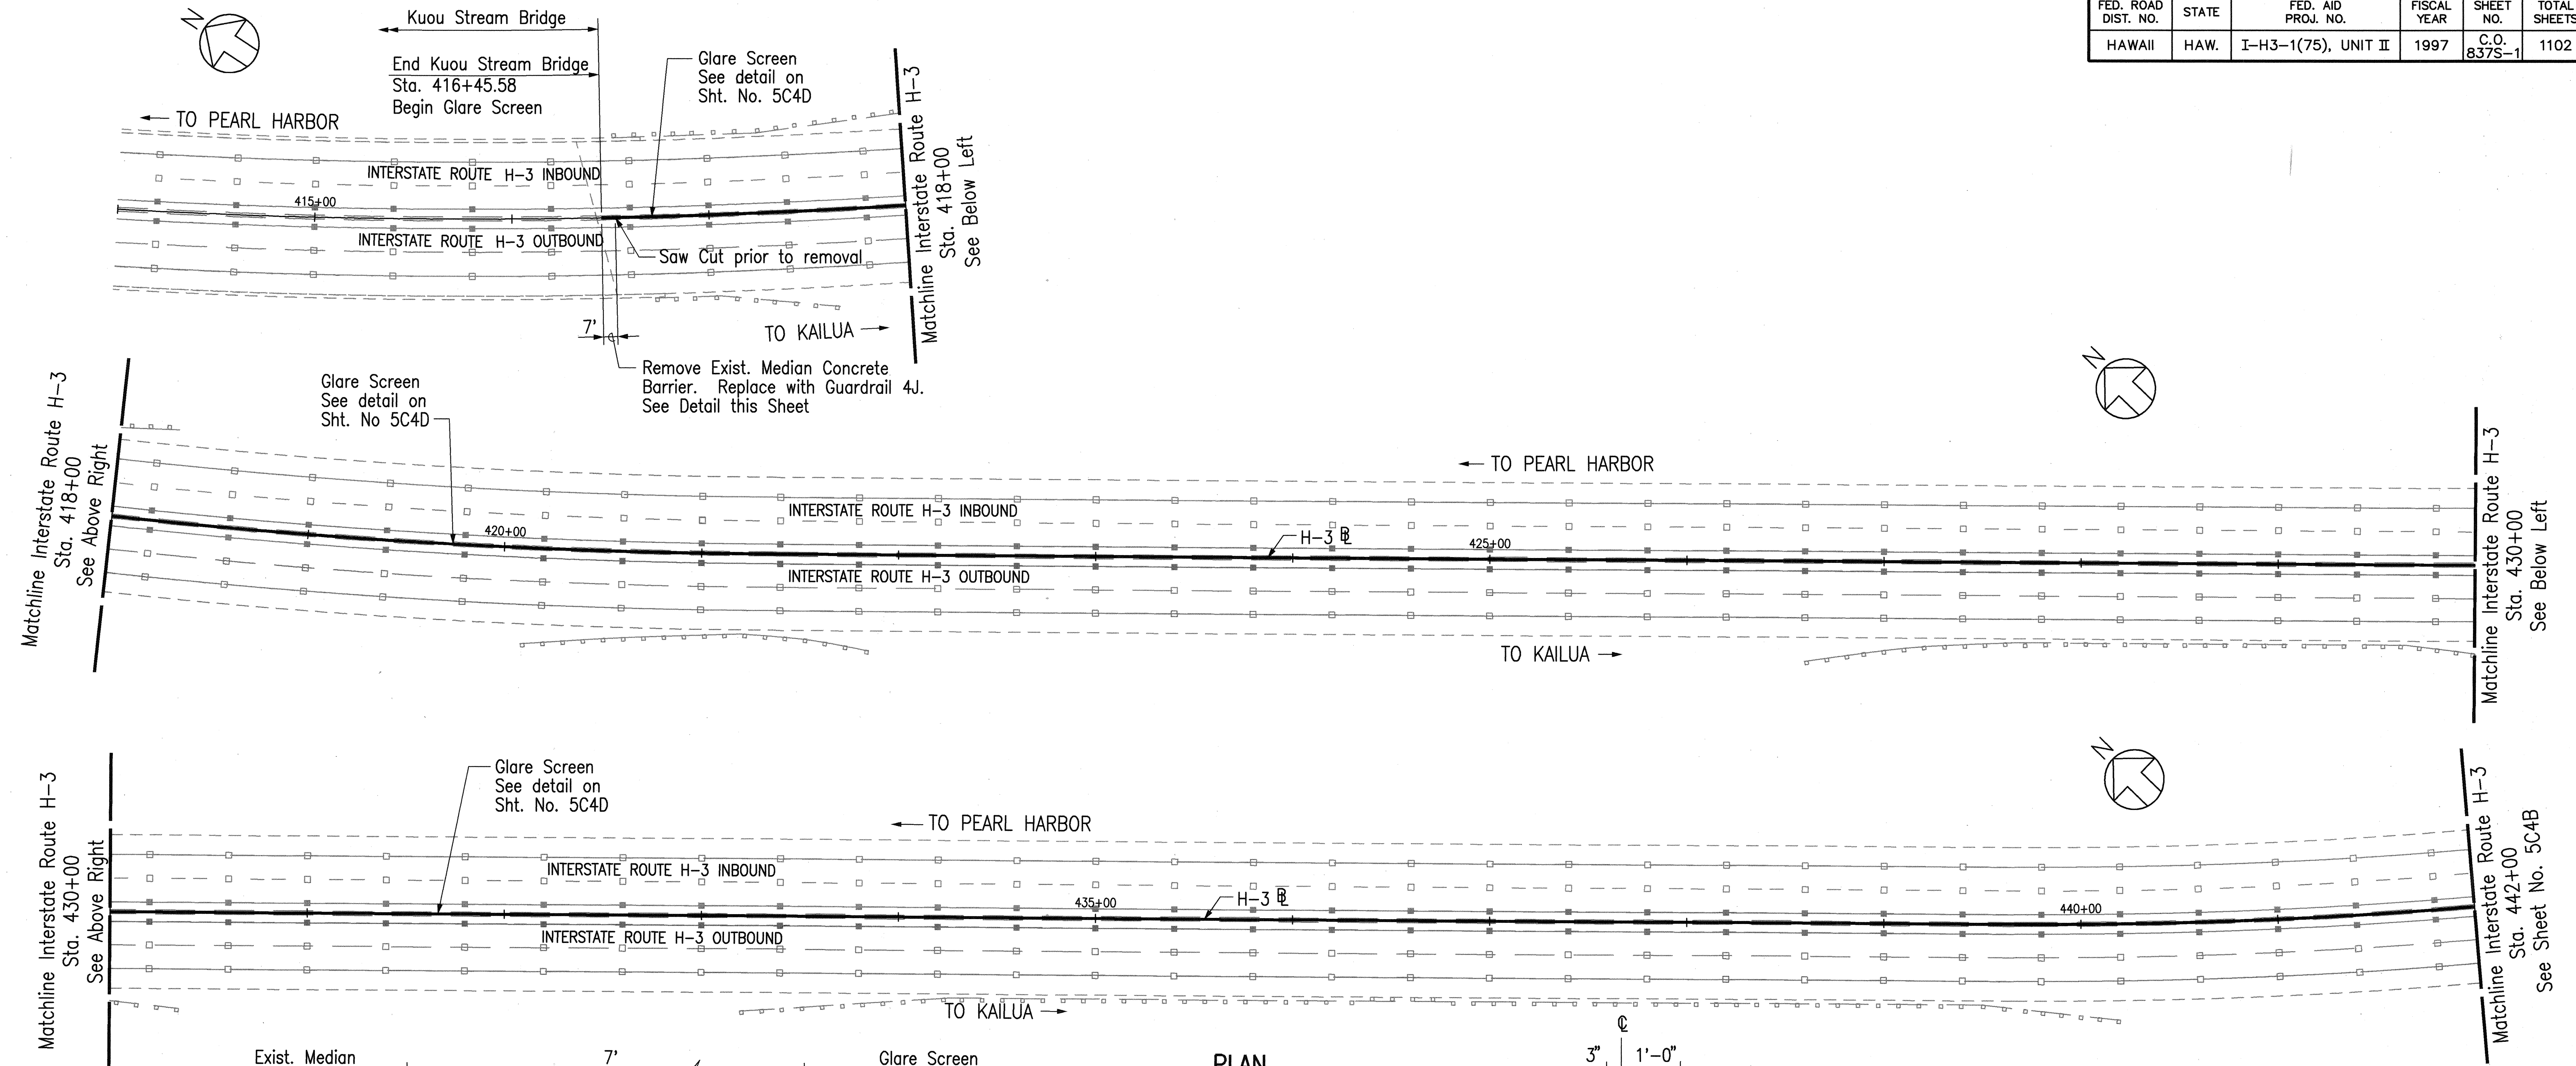

9/12/97	Added Sheet
Date	Revision

STATE OF HAWAII
DEPARTMENT OF TRANSPORTATION
HIGHWAYS DIVISION

WINDWARD

ROADWAY CONSTRUCTION

GLARE SCREEN




H-3 FINISH (UNIT II)
FAIP NO. I-H3-1(75), UNIT II
LEEWARD SECTION

SCALE: AS SHOWN DATE: SEPTEMBER 1997

SHEET NO. 5C4A OF 4 SHEETS

C.O. 837S-1

FED. ROAD DIST. NO.	STATE	FED. AID PROJ. NO.	FISCAL YEAR	SHEET NO.	TOTAL SHEETS
HAWAII	HAW.	I-H3-1(75), UNIT II	1997	C.O. 837S-2	1102

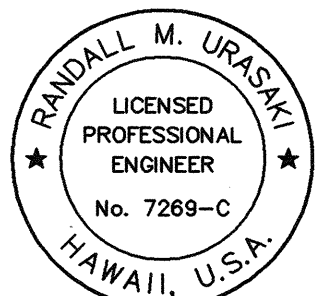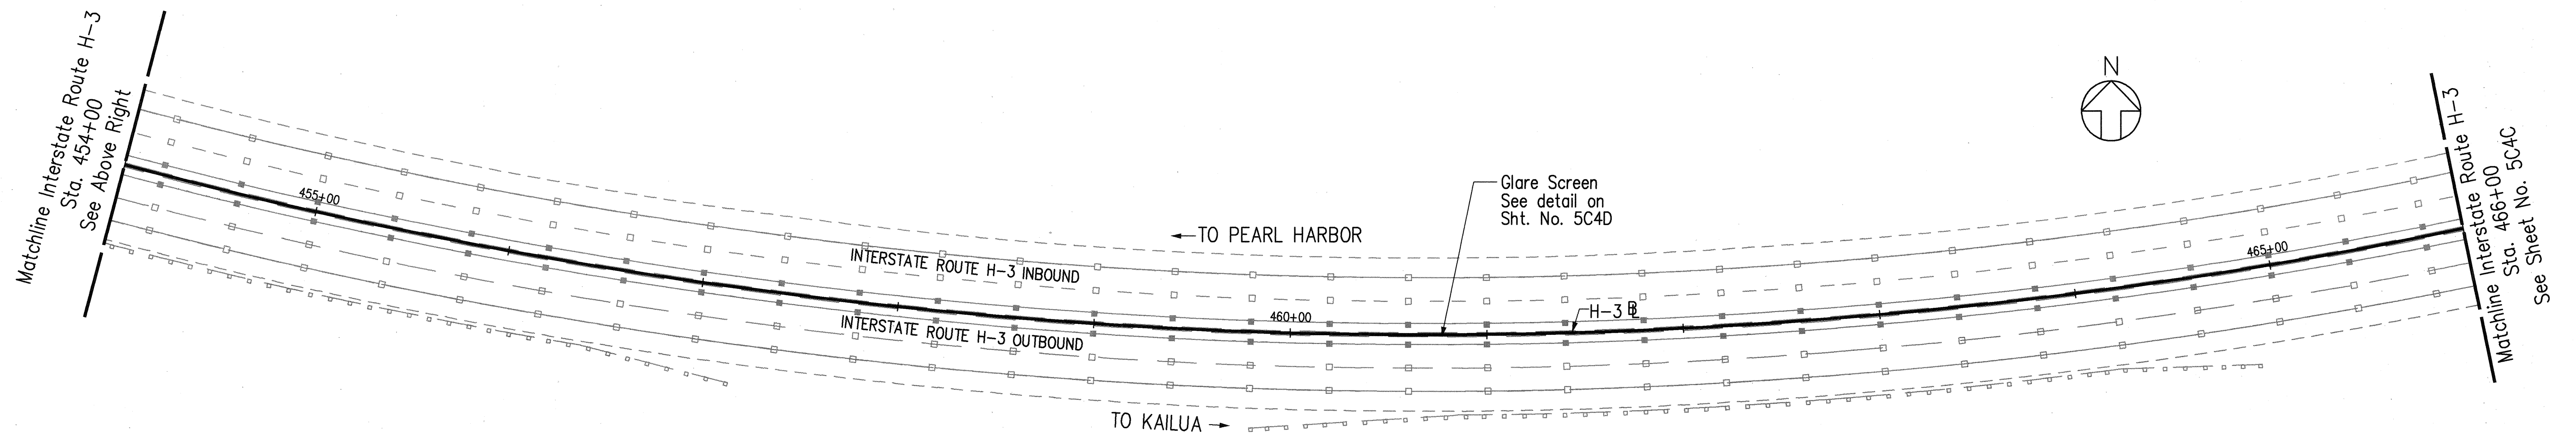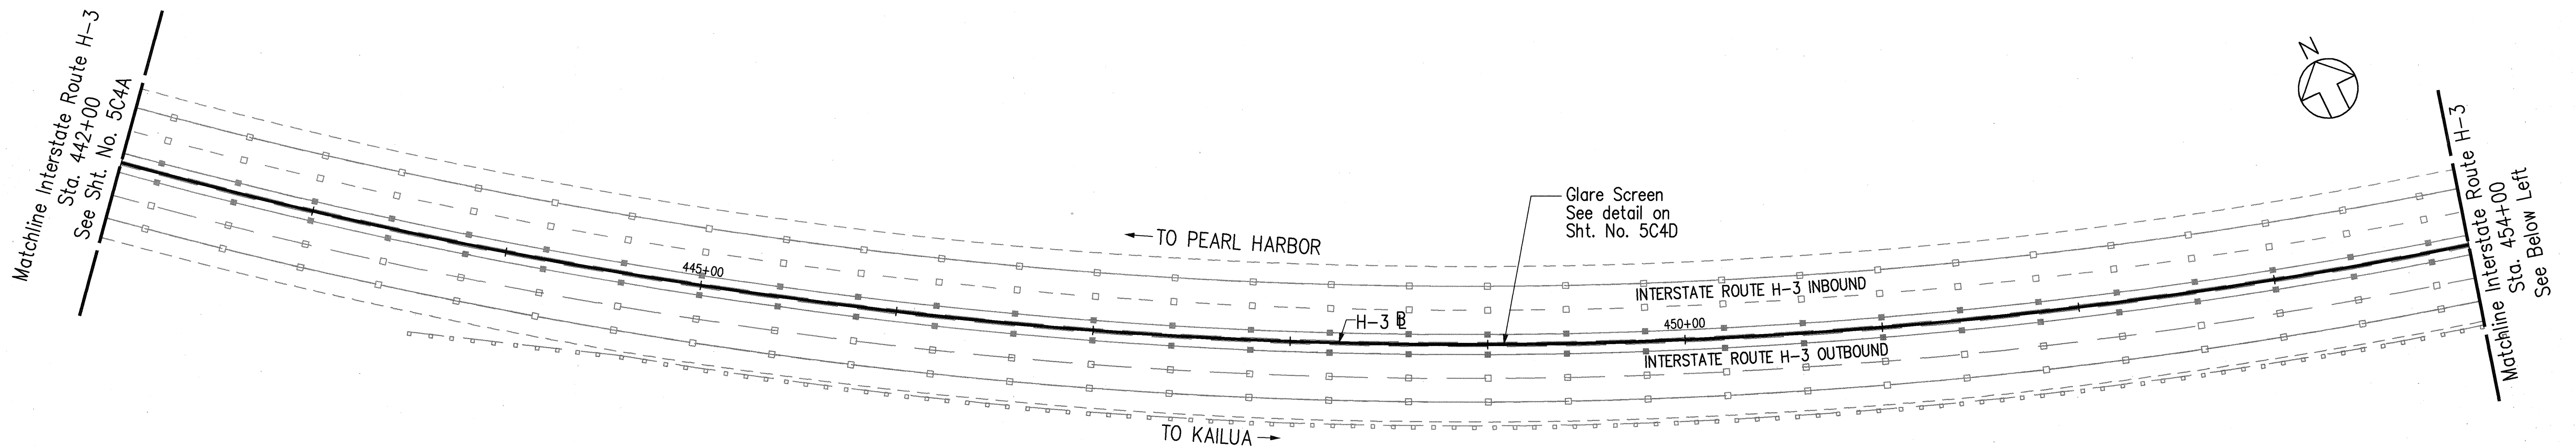

THIS WORK WAS PREPARED BY ME
OR UNDER MY SUPERVISION.

Randall M. Uralski

9/12/97	Added Sheet
Date	Revision
STATE OF HAWAII DEPARTMENT OF TRANSPORTATION HIGHWAYS DIVISION WINDWARD ROADWAY CONSTRUCTION GLARE SCREEN H-3 FINISH (UNIT II) FAIP NO. I-H3-1(75), UNIT II LEEWARD SECTION	
SCALE: 1" = 40'	DATE: SEPTEMBER 1997


SHEET NO. 5C4B OF 4 SHEETS

C.O. 837S-2

ORIGINAL	SURVEY PLOTTED BY	DATE
PLAN	DESIGNED BY	
NOTE BOOK	QUANTITIES BY	
No.	CHECKED BY	


CAD by J. Minoura, 55-52

FED. ROAD DIST. NO.	STATE	FED. AID PROJ. NO.	FISCAL YEAR	SHEET NO.	TOTAL SHEETS
HAWAII	HAW.	I-H3-1(75), UNIT II	1997	C.O. 837S-3	1102

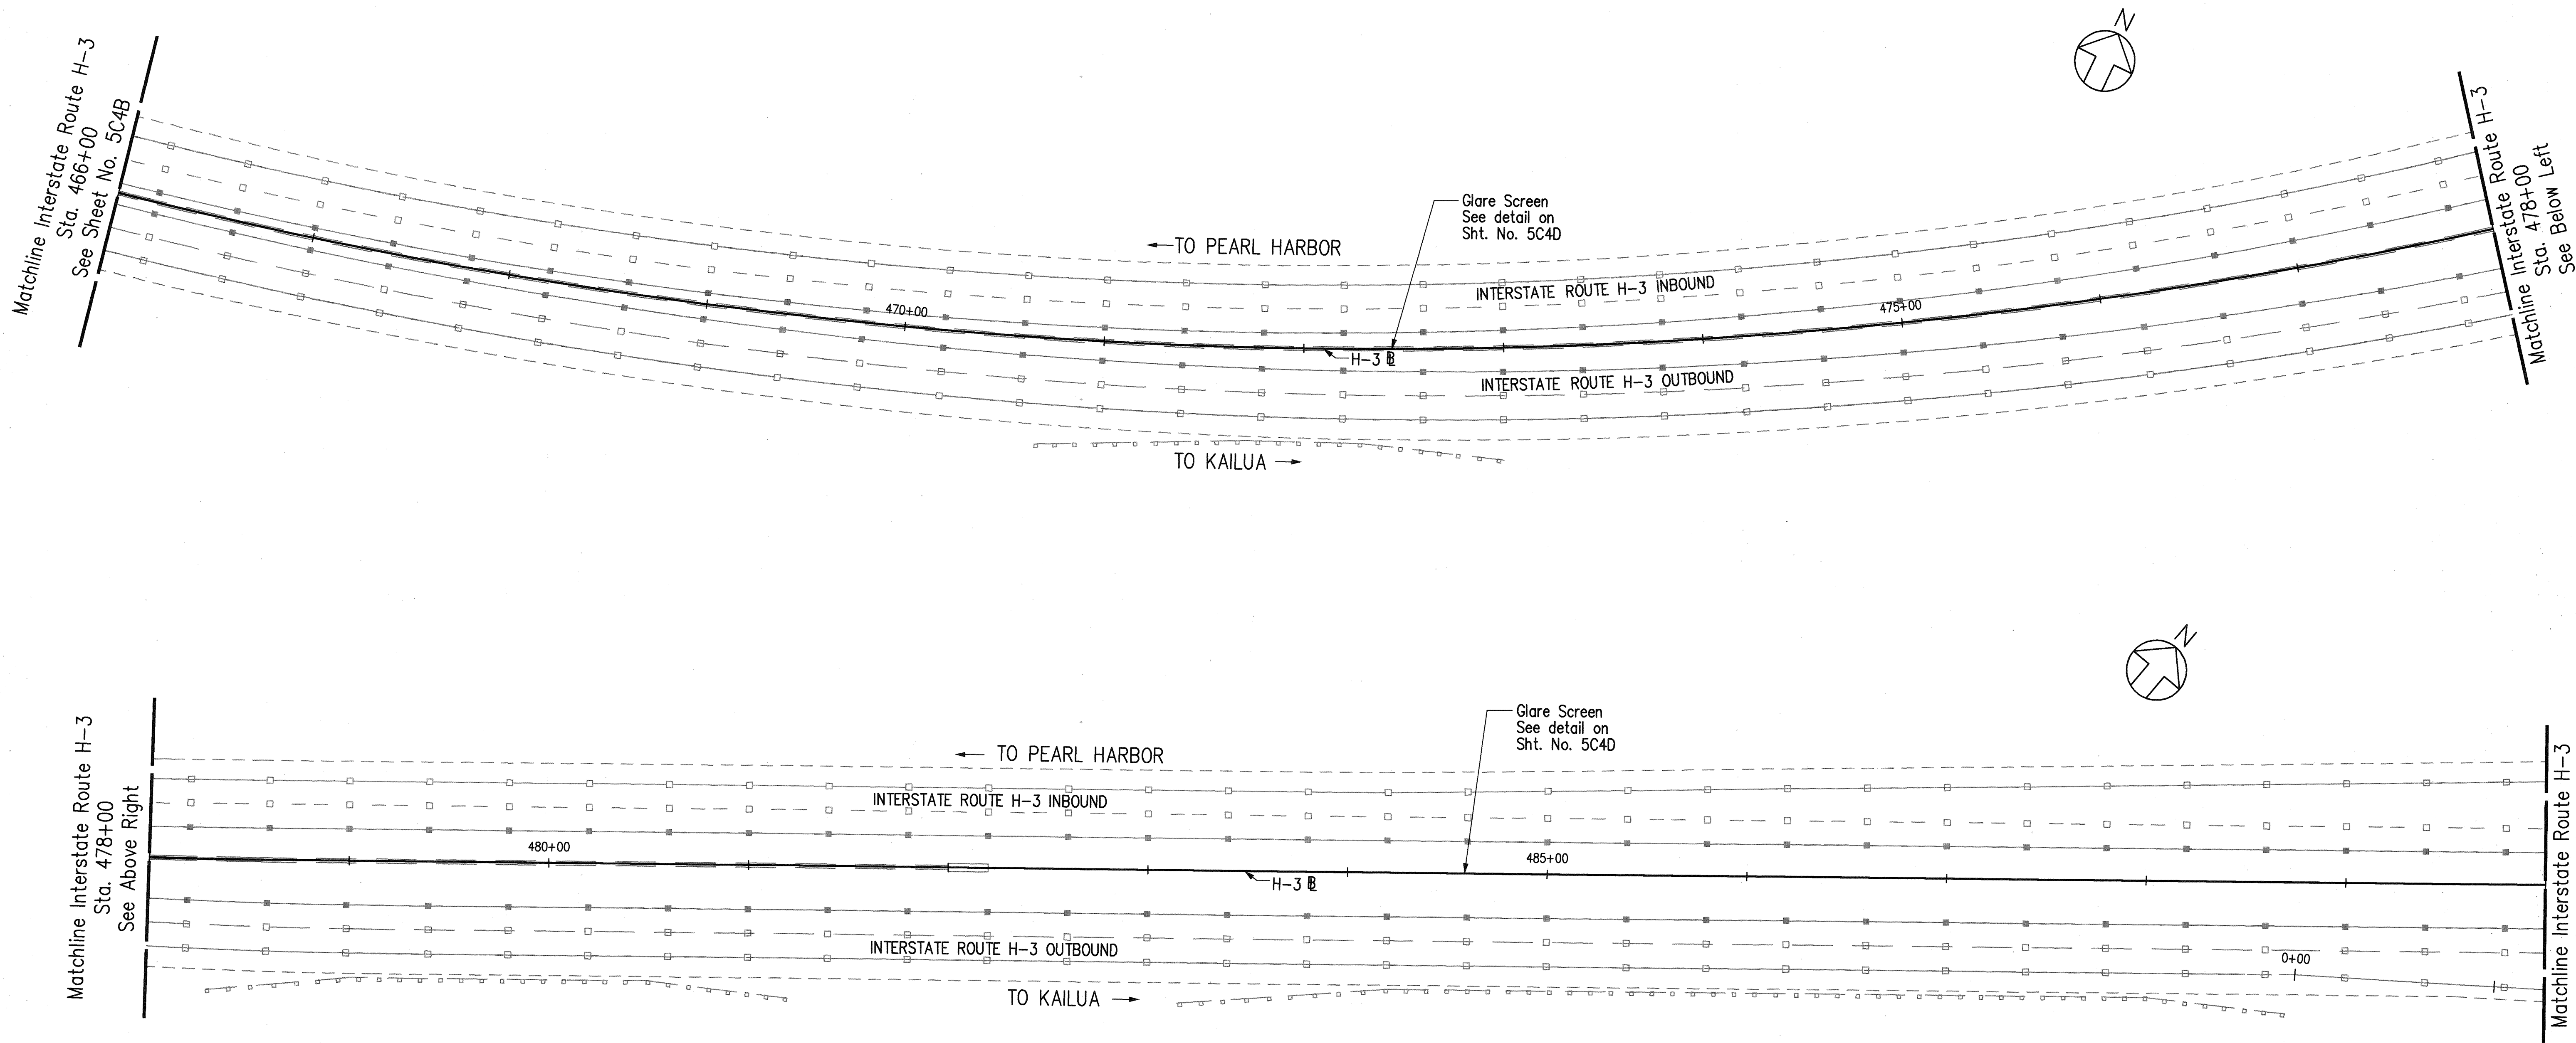

ORIGINAL PLAN	SURVEY PLOTTED BY	DATE
NOTE BOOK	DRAWN BY	
	DESIGNED BY	
	CHECKED BY	
No.		

CAD by J. Mimura, 55-52

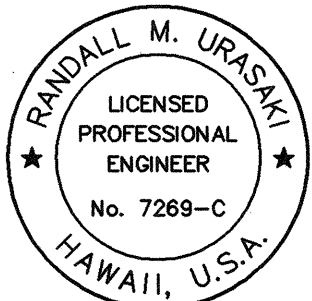


THIS WORK WAS PREPARED BY ME OR UNDER MY SUPERVISION.


Randall M. Urasky

Date	Revision
9/12/97	Added Sheet
STATE OF HAWAII DEPARTMENT OF TRANSPORTATION HIGHWAYS DIVISION WINDWARD ROADWAY CONSTRUCTION GLARE SCREEN H-3 FINISH (UNIT II) FAIP NO. I-H3-1(75), UNIT II LEEWARD SECTION	
SCALE: 1" = 40'	DATE: SEPTEMBER 1997
SHEET NO. 5C4C OF 4 SHEETS	

FED. ROAD DIST. NO.	STATE	FED. AID PROJ. NO.	FISCAL YEAR	SHEET NO.	TOTAL SHEETS
HAWAII	HAW.	I-H3-1(75), UNIT II	1997	C.O. 837S-4	1102

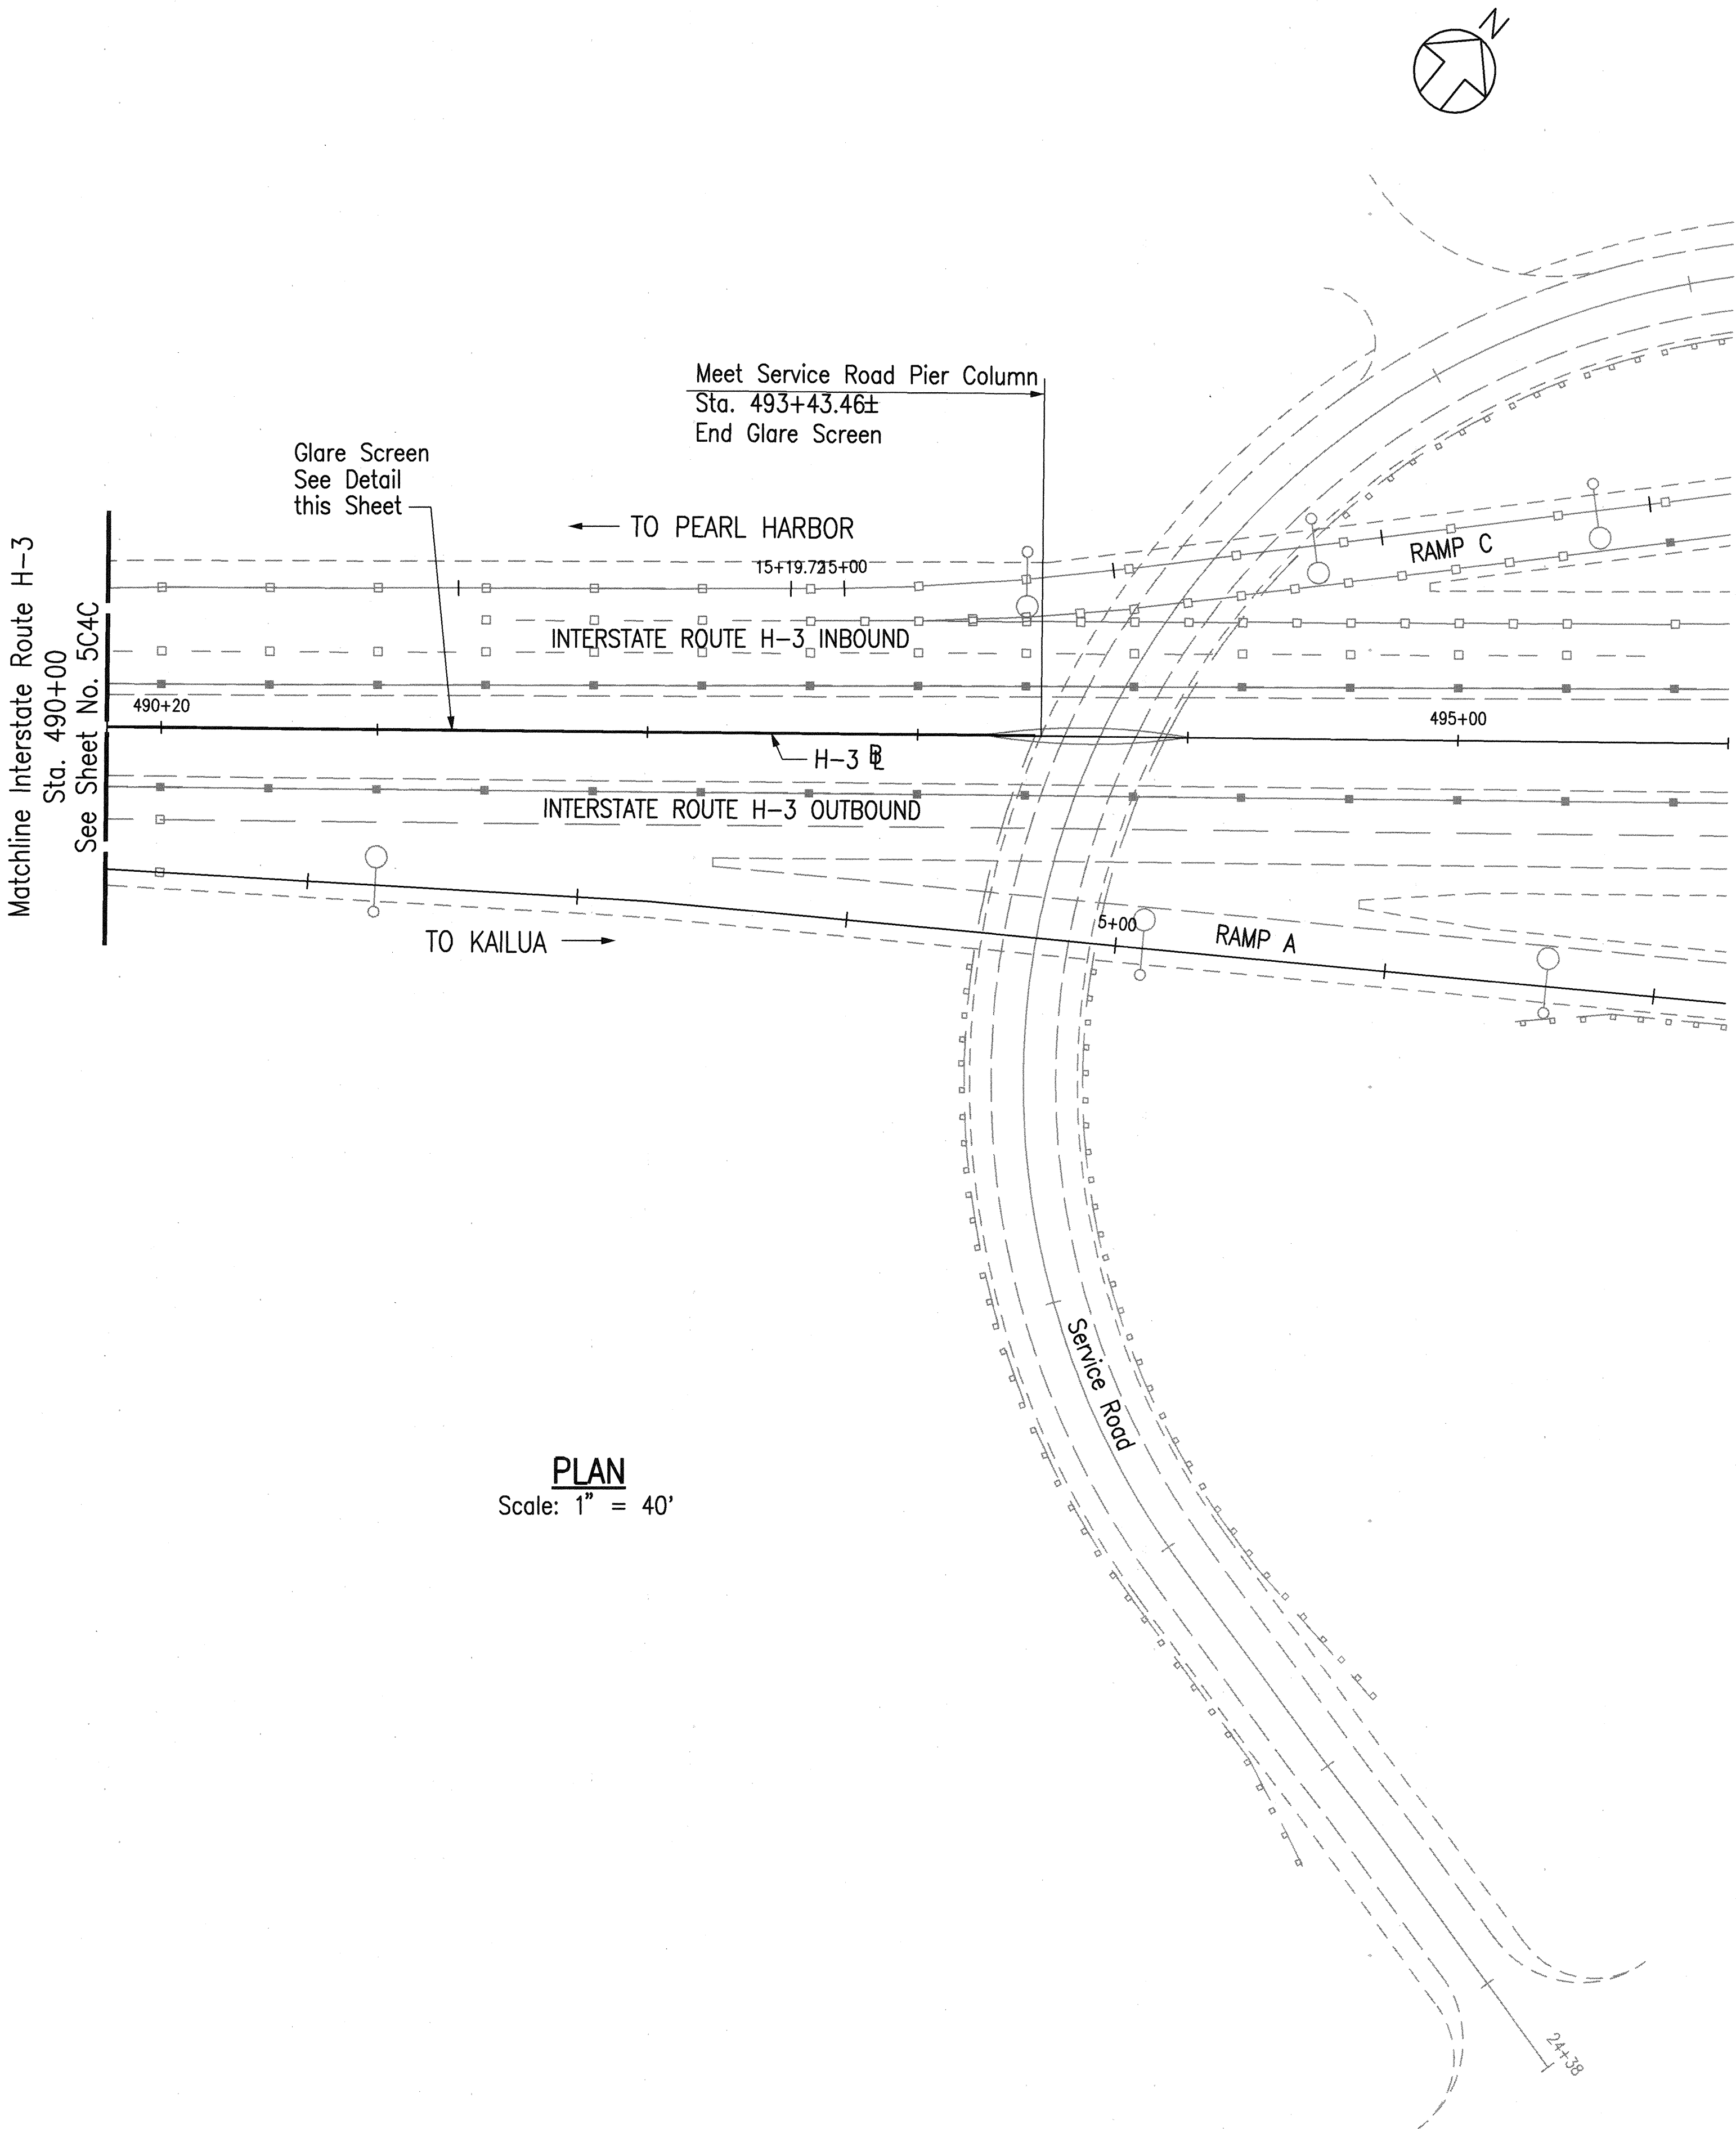

PLAN
Scale: 1" = 40'

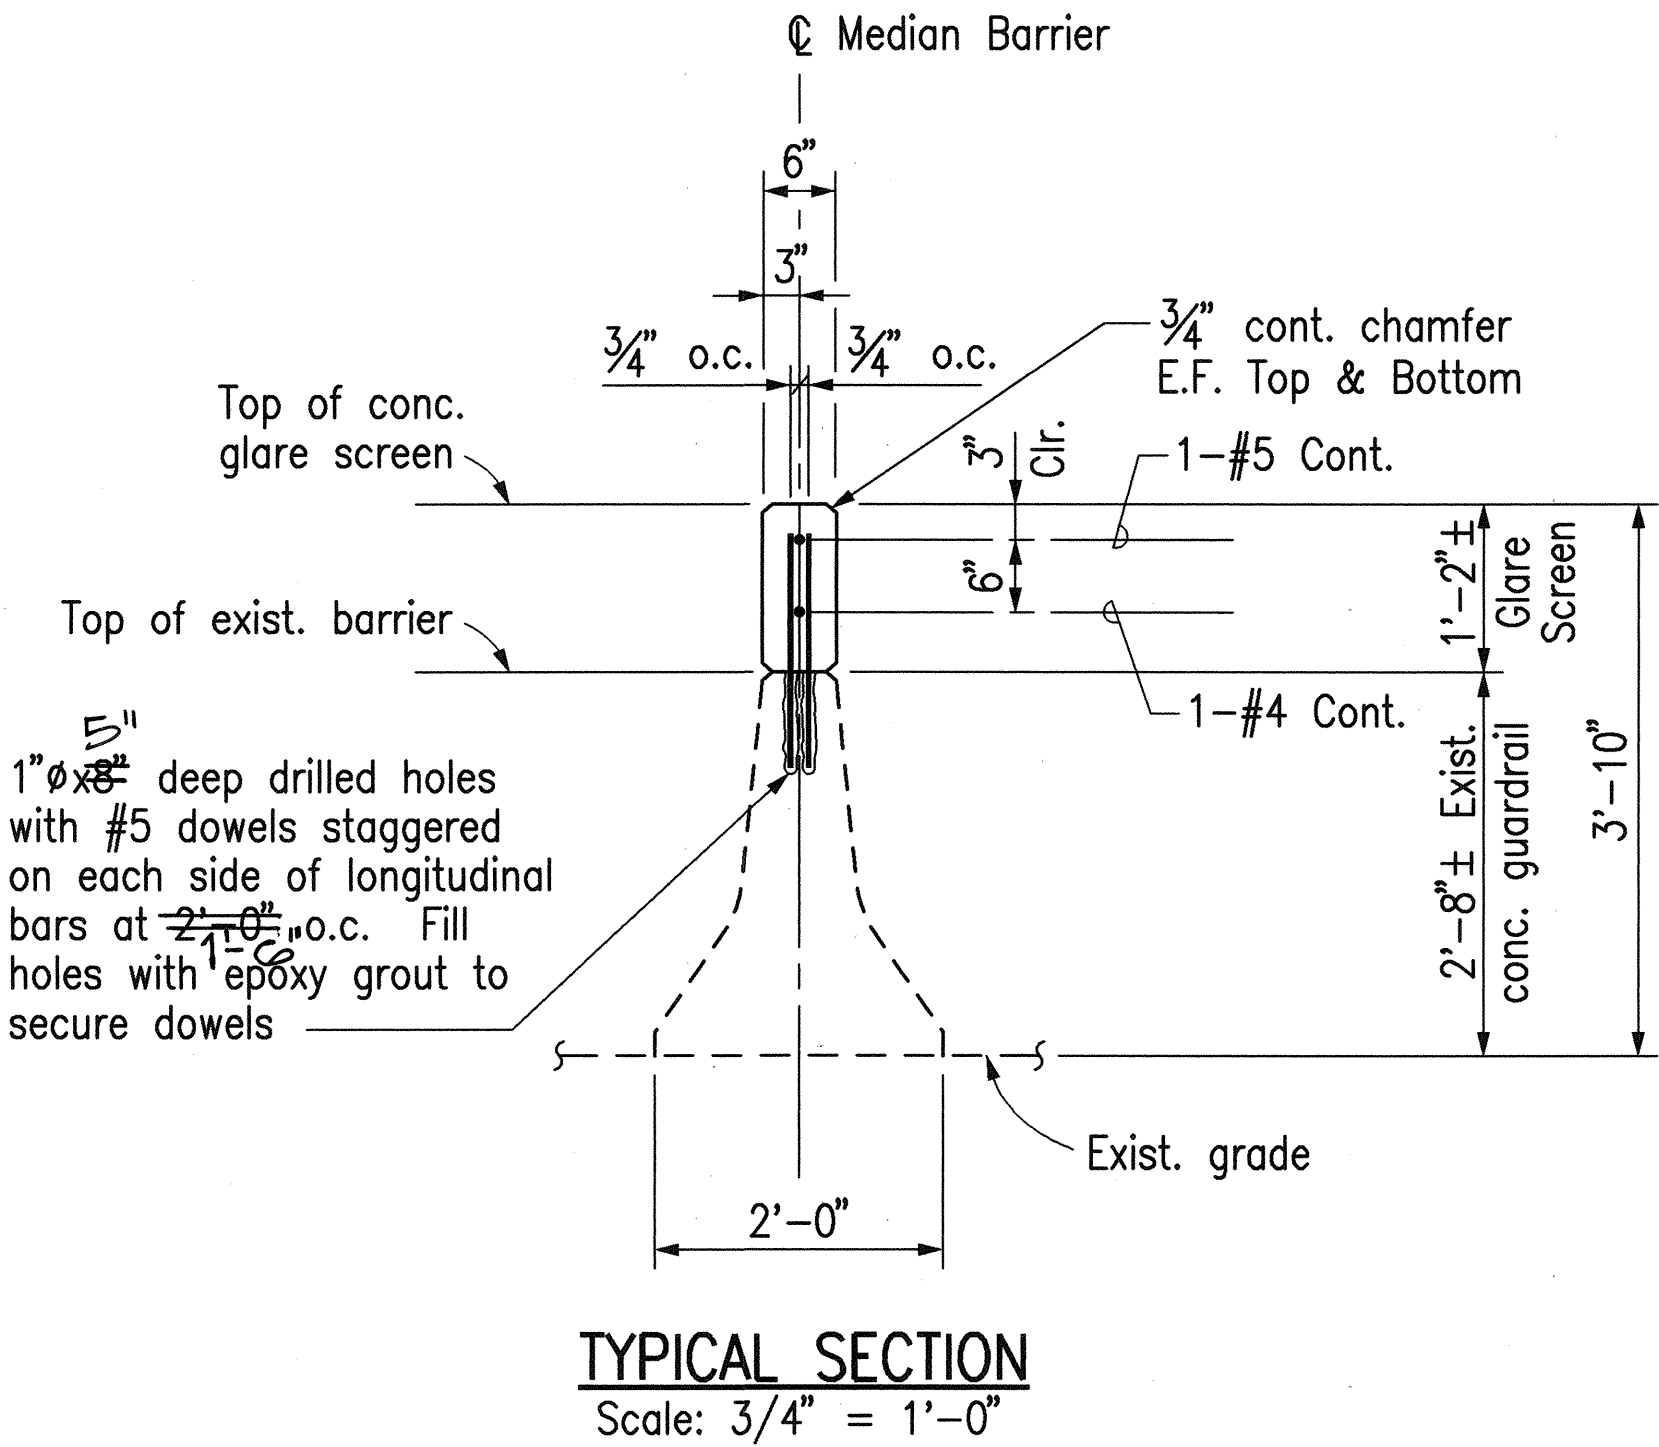

CONCRETE GLARE SCREEN ON EXISTING CONCRETE MEDIAN BARRIER


NOTES:

- Top of Glare Screen shall be 3'-10" measured from the Pearl Harbor bound roadway.
- Contractor shall remove exist. grout pad on top of exist. median barrier, prior to construction of Glare Screen. Payment shall be considered incidental to Glare Screen.
- The Glare Screen shall be centered in the middle of the widened concrete barrier as it approaches the Service Road Pier Column.

ORIGINAL PLAN	SURVEY PLOTTED BY	DATE
NOTE BOOK	DRAWN BY	
No.	DESIGNED BY	
	CHECKED BY	

CAD by J. Kimura, SS-52

Last Saved: J:\H3RF\RFU2\CO\WINDWARD\CO-RCPL6.dwg 09/19/97 at 13:47

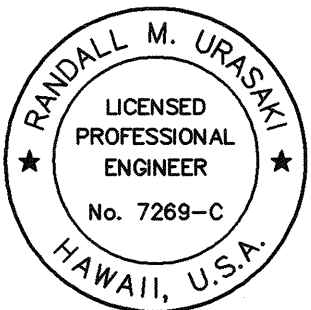


THIS WORK WAS PREPARED BY ME
OR UNDER MY SUPERVISION.
Randall M. Urasaki

9/12/97	Added Sheet
Date	Revision
STATE OF HAWAII DEPARTMENT OF TRANSPORTATION HIGHWAYS DIVISION WINDWARD ROADWAY CONSTRUCTION GLARE SCREEN H-3 FINISH (UNIT II) FAIP NO. I-H3-1(75), UNIT II LEEWARD SECTION	
SCALE: AS SHOWN	DATE: SEPTEMBER 1997

SHEET NO. 5C4D OF 4 SHEETS

C.O. 837S-4


CURVE	RADIUS	LENGTH	TANGENT	CHORD	DELTA	COORDINATES OF INTERSECTION	POINT OF TANGENTS
X-1	2200.00'	987.20'	502.05	978.94'	25°42'37"	N 81806.95	E 562563.82

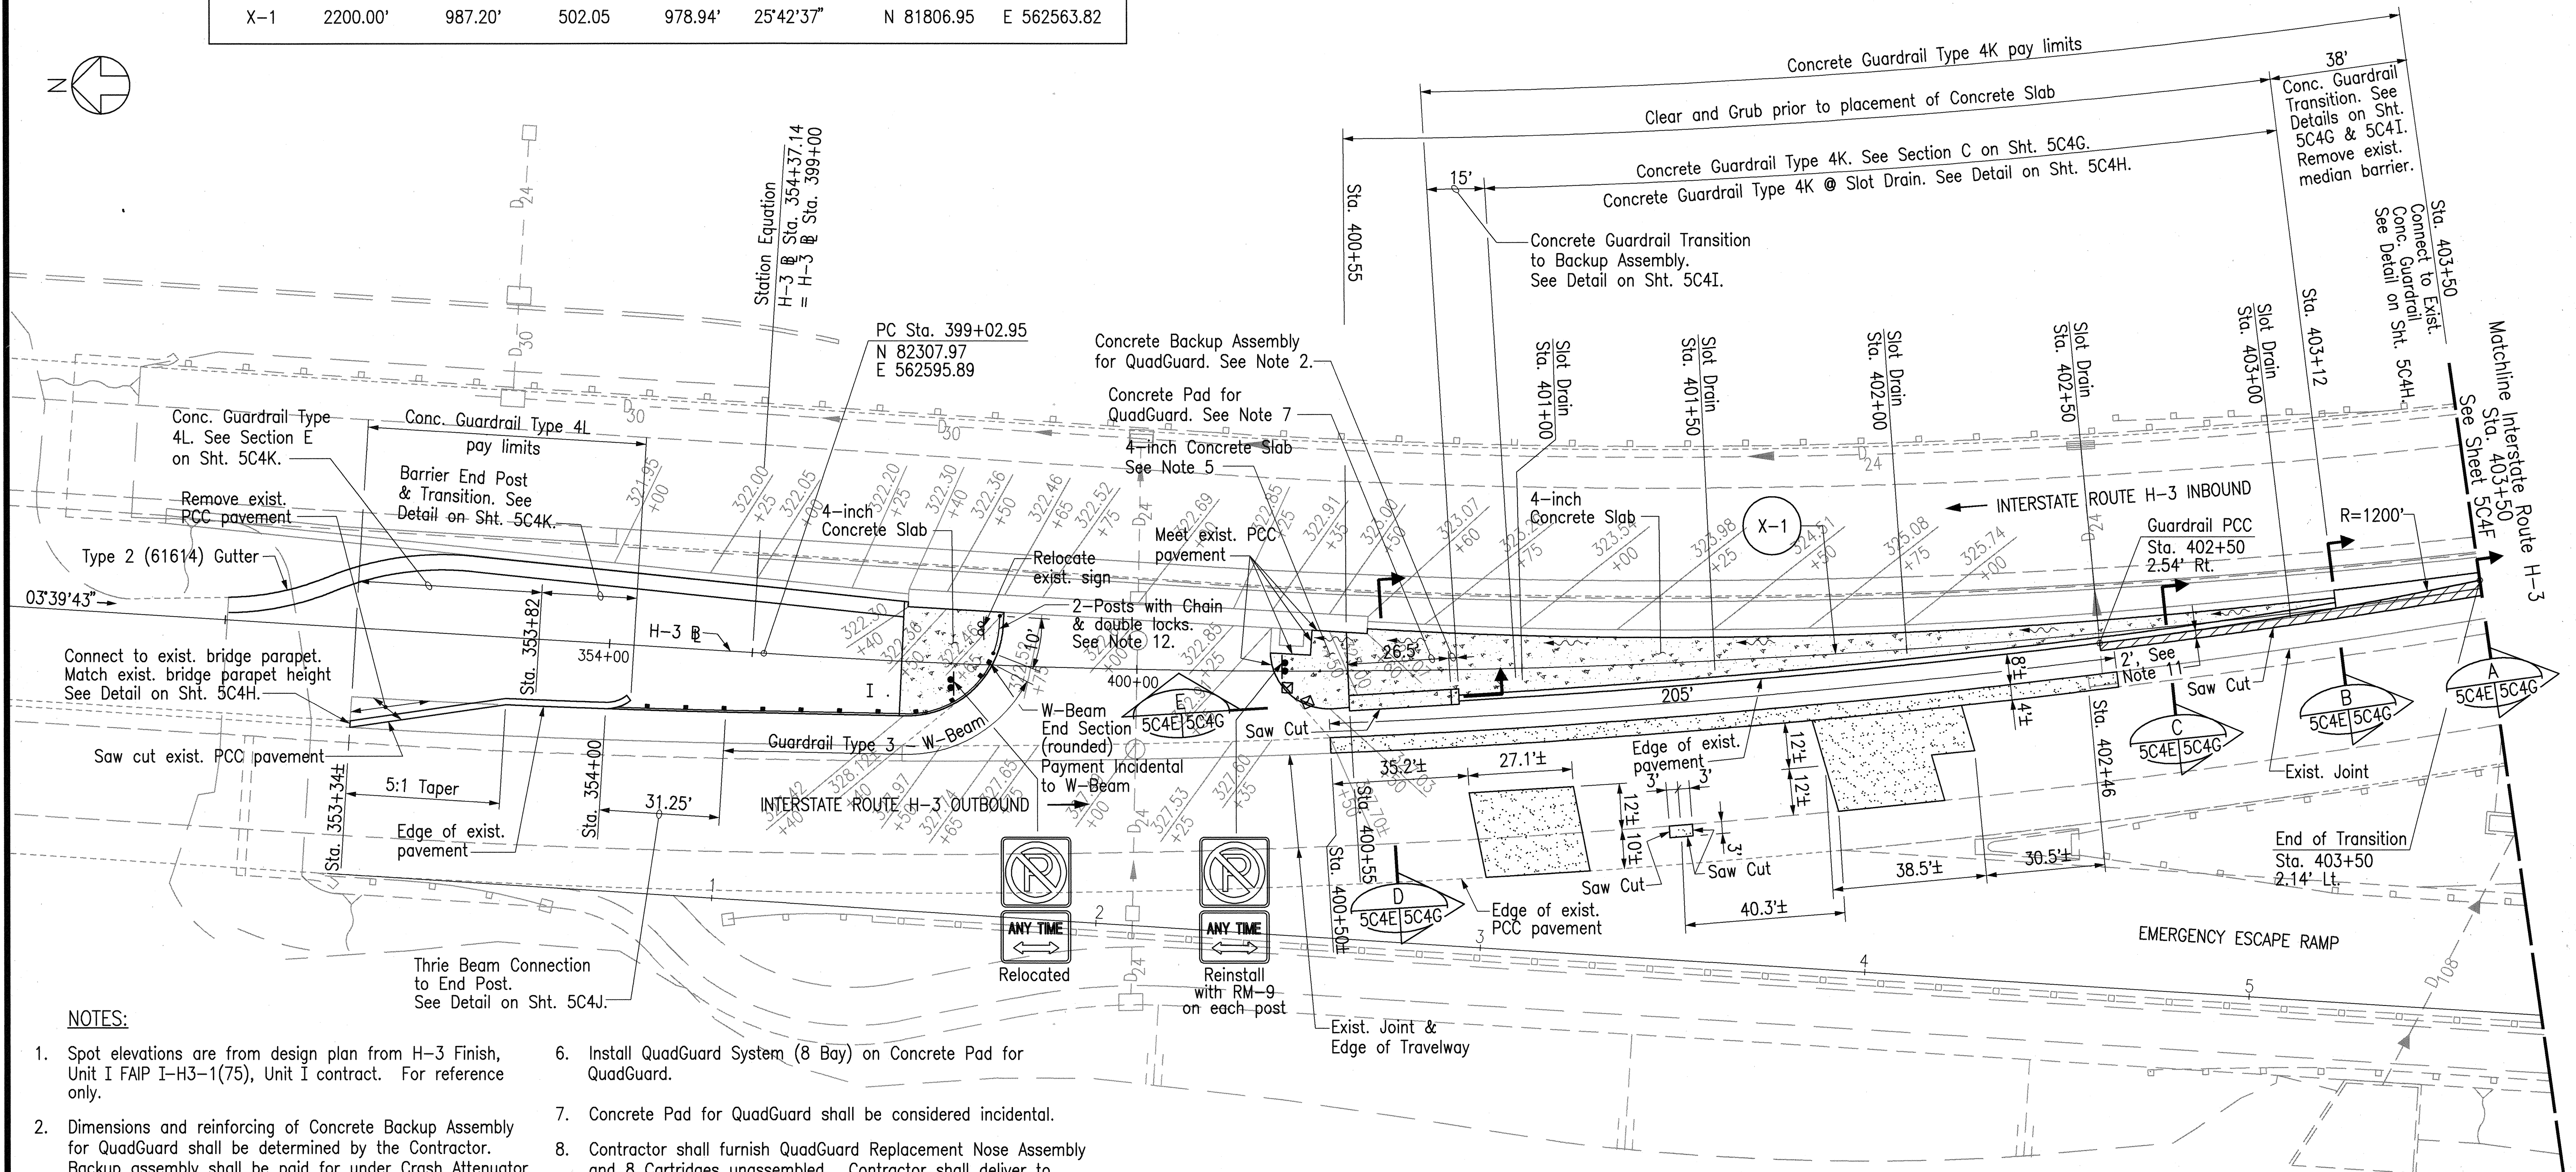

1. Spot elevations are from design plan from H-3 Finish, Unit I FAIP I-H3-1(75), Unit I contract. For reference only.
2. Dimensions and reinforcing of Concrete Backup Assembly for QuadGuard shall be determined by the Contractor. Backup assembly shall be paid for under Crash Attenuator (8 Bay QuadGuard System, including Replacement Nose Assembly and 8 Cartridges).
3. Saw cut and remove existing pavement along existing joints, or saw cut where noted, for 9" Concrete Pavement Reconstruction. Match existing transverse and longitudinal joints.
4. For joint details for pavement reconstruction, see Interior Slab Reconstruction (Excluding H-1 Sta. 144+80 to 149+65 and H-1 Sta. 162+50 to 169+50). See Joint Details on Shts. 1C20 & 1C21.
5. Warp 4" Plain Concrete to meet concrete pad. Payment shall be made under 4-inch Concrete Slab (Including Excavation and Bed Course Material).
6. Install QuadGuard System (8 Bay) on Concrete Pad for QuadGuard.
7. Concrete Pad for QuadGuard shall be considered incidental.
8. Contractor shall furnish QuadGuard Replacement Nose Assembly and 8 Cartridges unassembled. Contractor shall deliver to location specified by Engineer.
9. Coordinates are based on "Kailua Trig. Station".
10. Striping Quantities:

4-inch Pavement Striping (Type II Tape or Thermoplastic Extrusion)	265 Lin. Ft.
Type A Pavement Marker	8 Each
Type C Pavement Marker	4 Each
Type H Pavement Marker	6 Each
11. From existing edge of pavement, remove 2 feet of existing pavement between Sta. 402+50 to Sta. 403+50.
12. Keys for double locks shall be given to the Engineer.



 9" Concrete Pavement
 18" Untreated Permeable Base Course
 9" Concrete Pavement Reconstruction
 Reflector Marker, RM-9
 See Standard Plan TE-16
 for mounting detail
 Direction of Flow
 Slope to drain

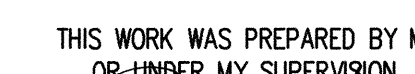

C.O. 837S-5


FED. ROAD DIST. NO.	STATE	FED. AID PROJ. NO.	FISCAL YEAR	SHEET NO.	TOTAL SHEETS
HAWAII	HAW.	I-H3-1(75), UNIT II	1997	C.O. 837S-6	1102

CURVE	RADIUS	LENGTH	TANGENT	CHORD	DELTA	COORDINATES OF POINT OF INTERSECTION OF TANGENTS	
X-1	2200.00'	987.20'	502.05'	978.94'	25°42'37"	N 81806.95	E 562563.82
X-2	3300.00'	1247.88'	631.48'	1240.49'	21°39'58.10"	N 80756.31	E 562989.34

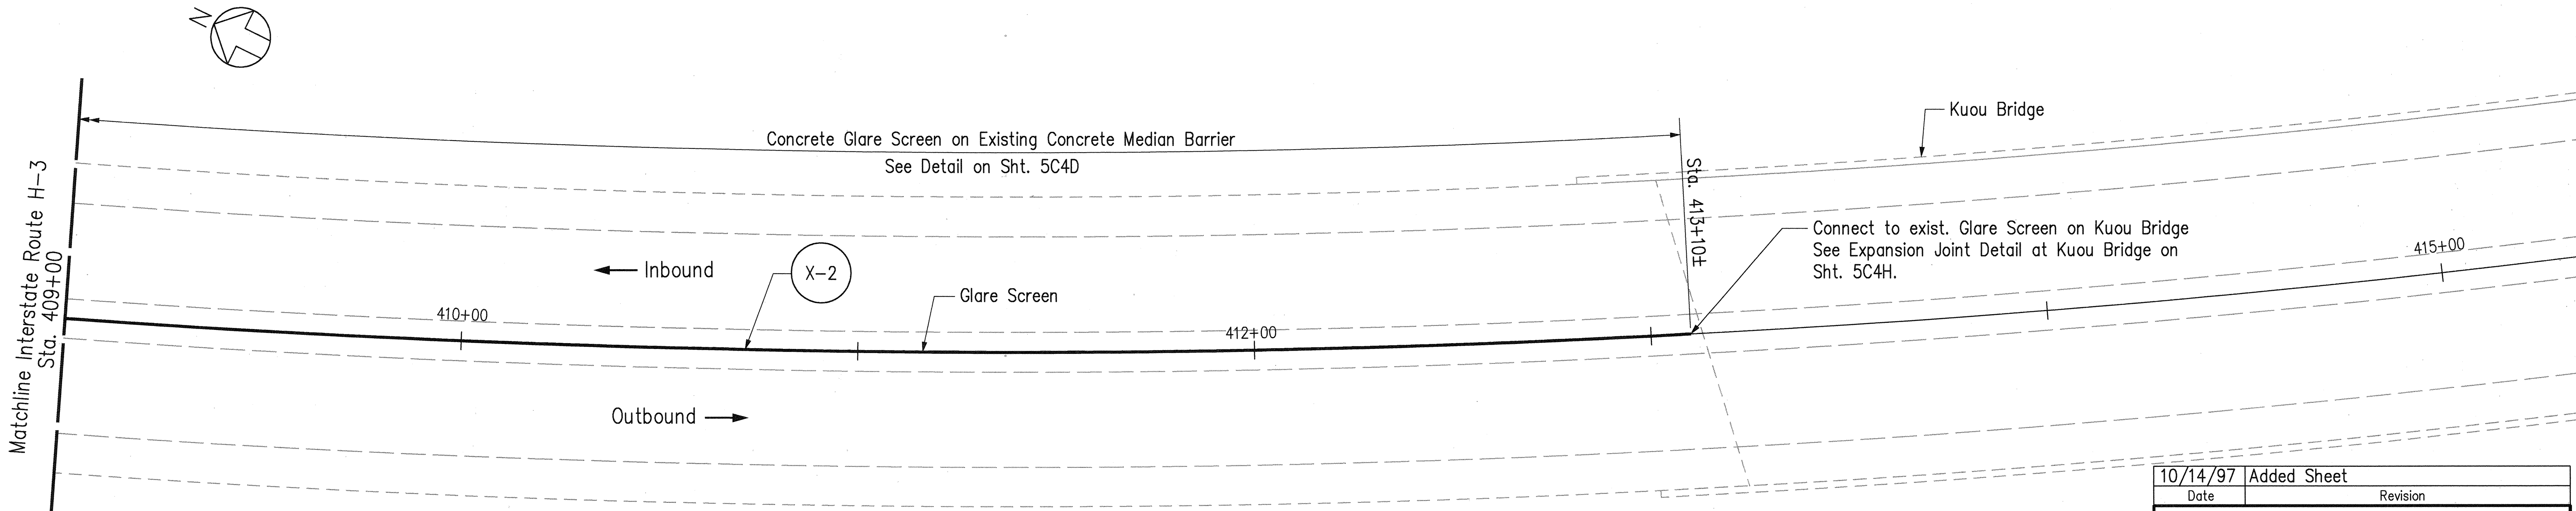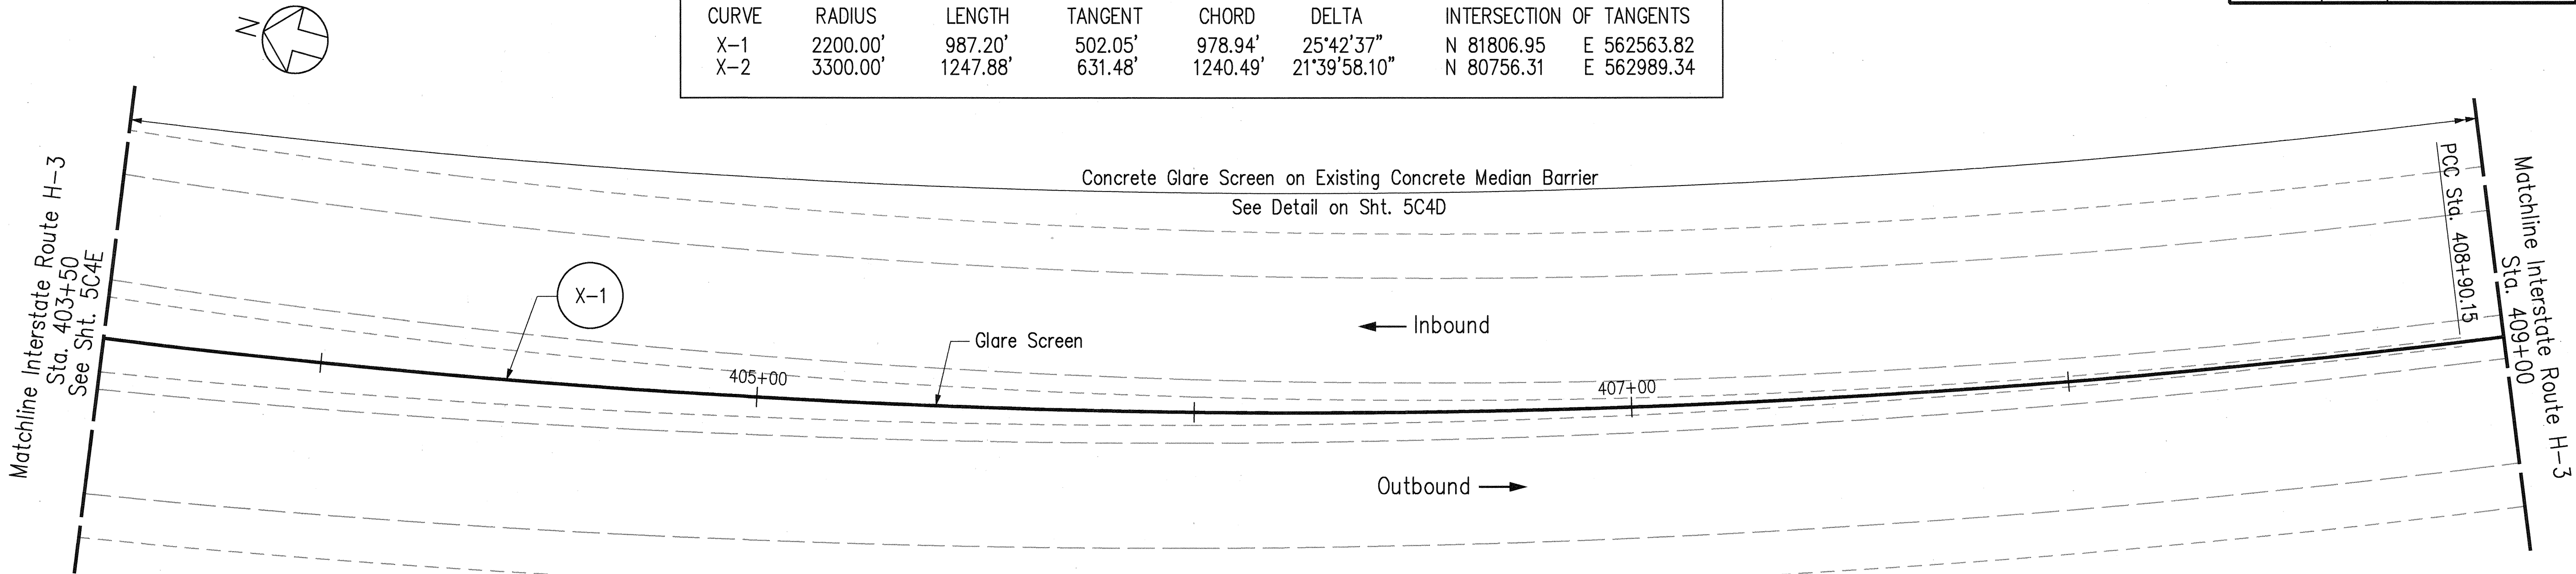

ORIGINAL	SURVEY PLOTTED BY	DATE
PLAN	DRAWN BY	
NOTE BOOK	DESIGNED BY	
No.	CHECKED BY	

CAD by D. Burgess, 55-52





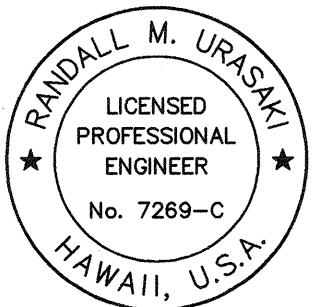


THIS WORK WAS PREPARED BY ME
OR UNDER MY SUPERVISION.

Randall M. Urasky

Date	Added Sheet	Revision
10/14/97	Added Sheet	
STATE OF HAWAII DEPARTMENT OF TRANSPORTATION HIGHWAYS DIVISION		
WINDWARD		
ROADWAY CONSTRUCTION		
WINDWARD HIGHWAY		
H-3 FINISH (UNIT II)		
FAIP NO. I-H3-1(75), UNIT II		
LEEWARD SECTION		
SCALE: 1" = 20'		DATE: OCTOBER 1997
SHEET NO. 5C4F OF 4 SHEETS		


FED. ROAD DIST. NO.	STATE	FED. AID PROJ. NO.	FISCAL YEAR	SHEET NO.	TOTAL SHEETS
HAWAII	HAW.	I-H3-1(75), UNIT II	1997	C.O. 837S-7	1102

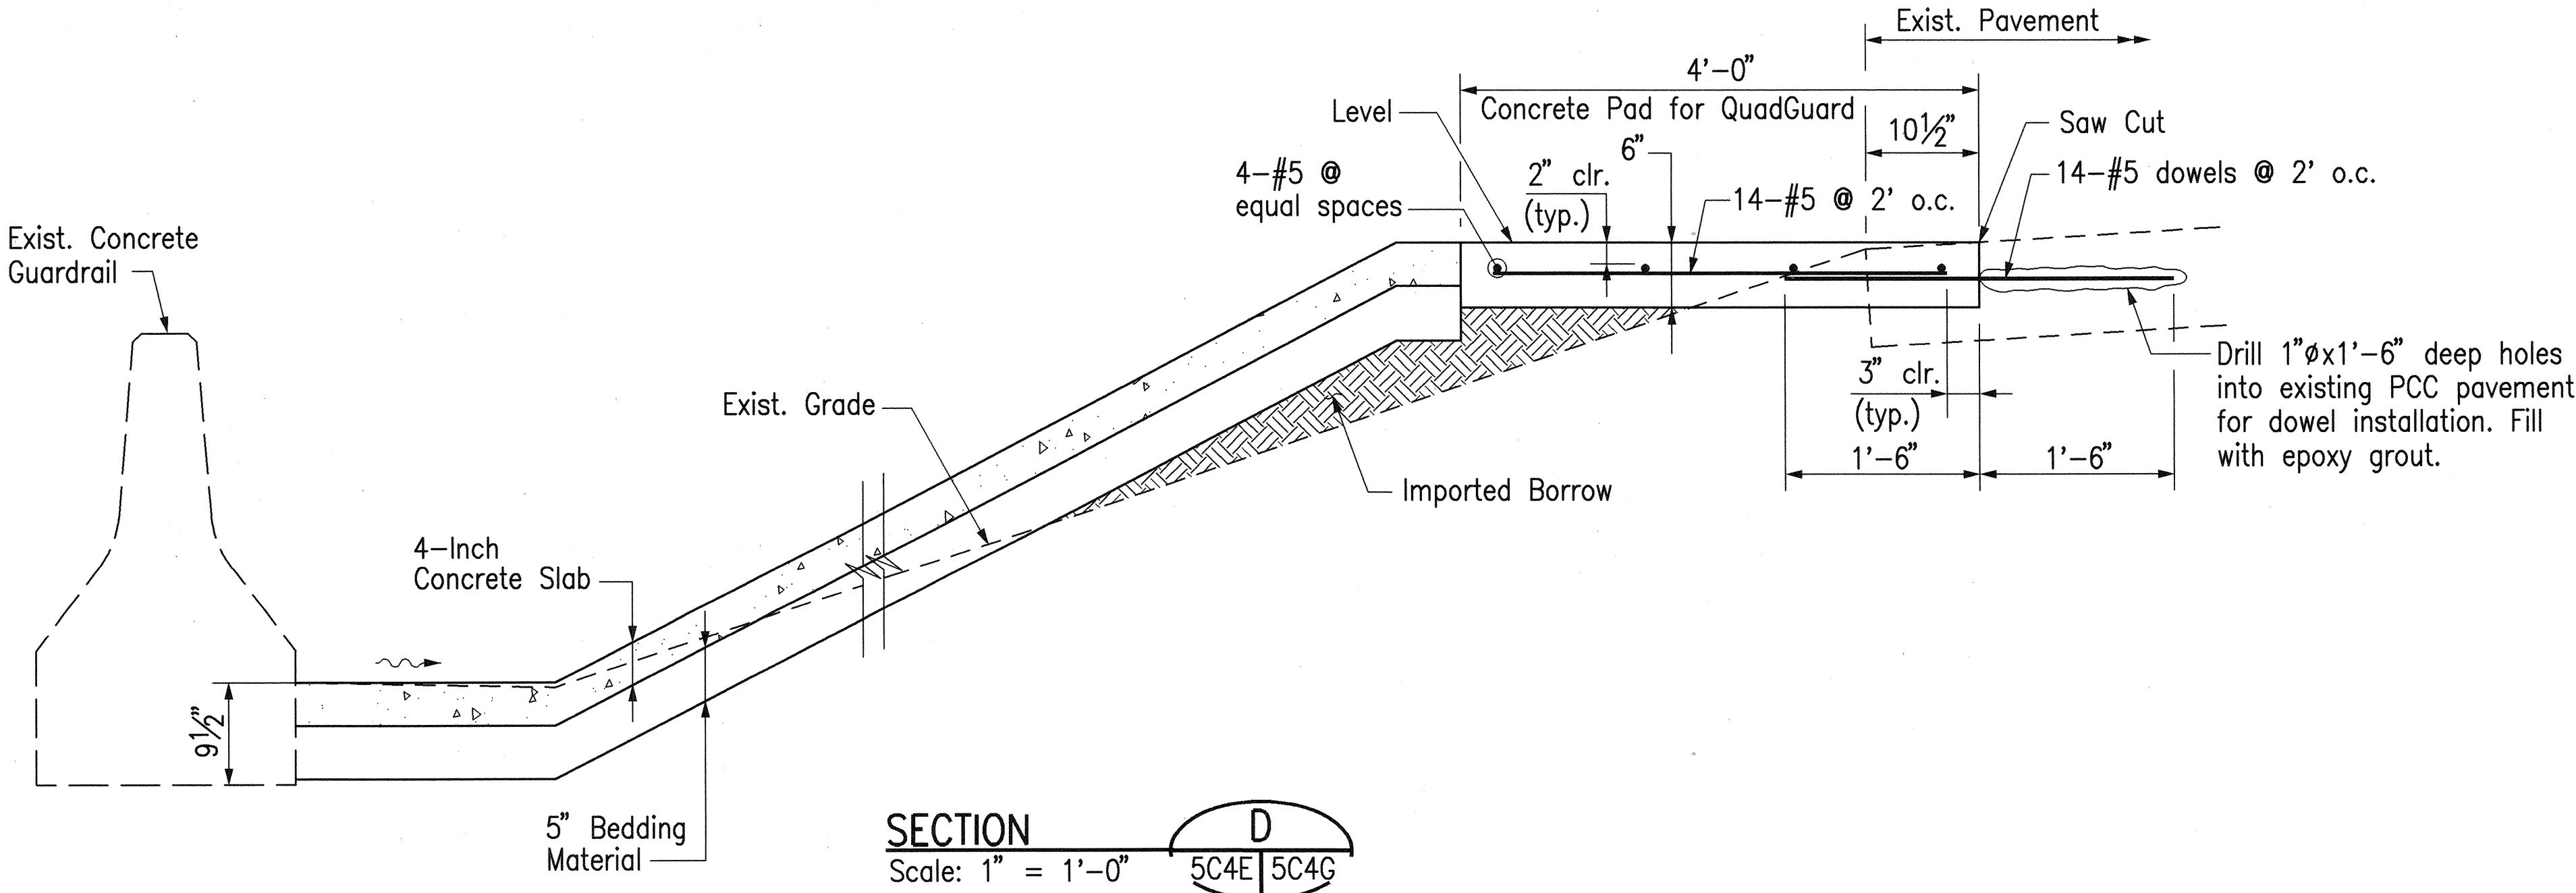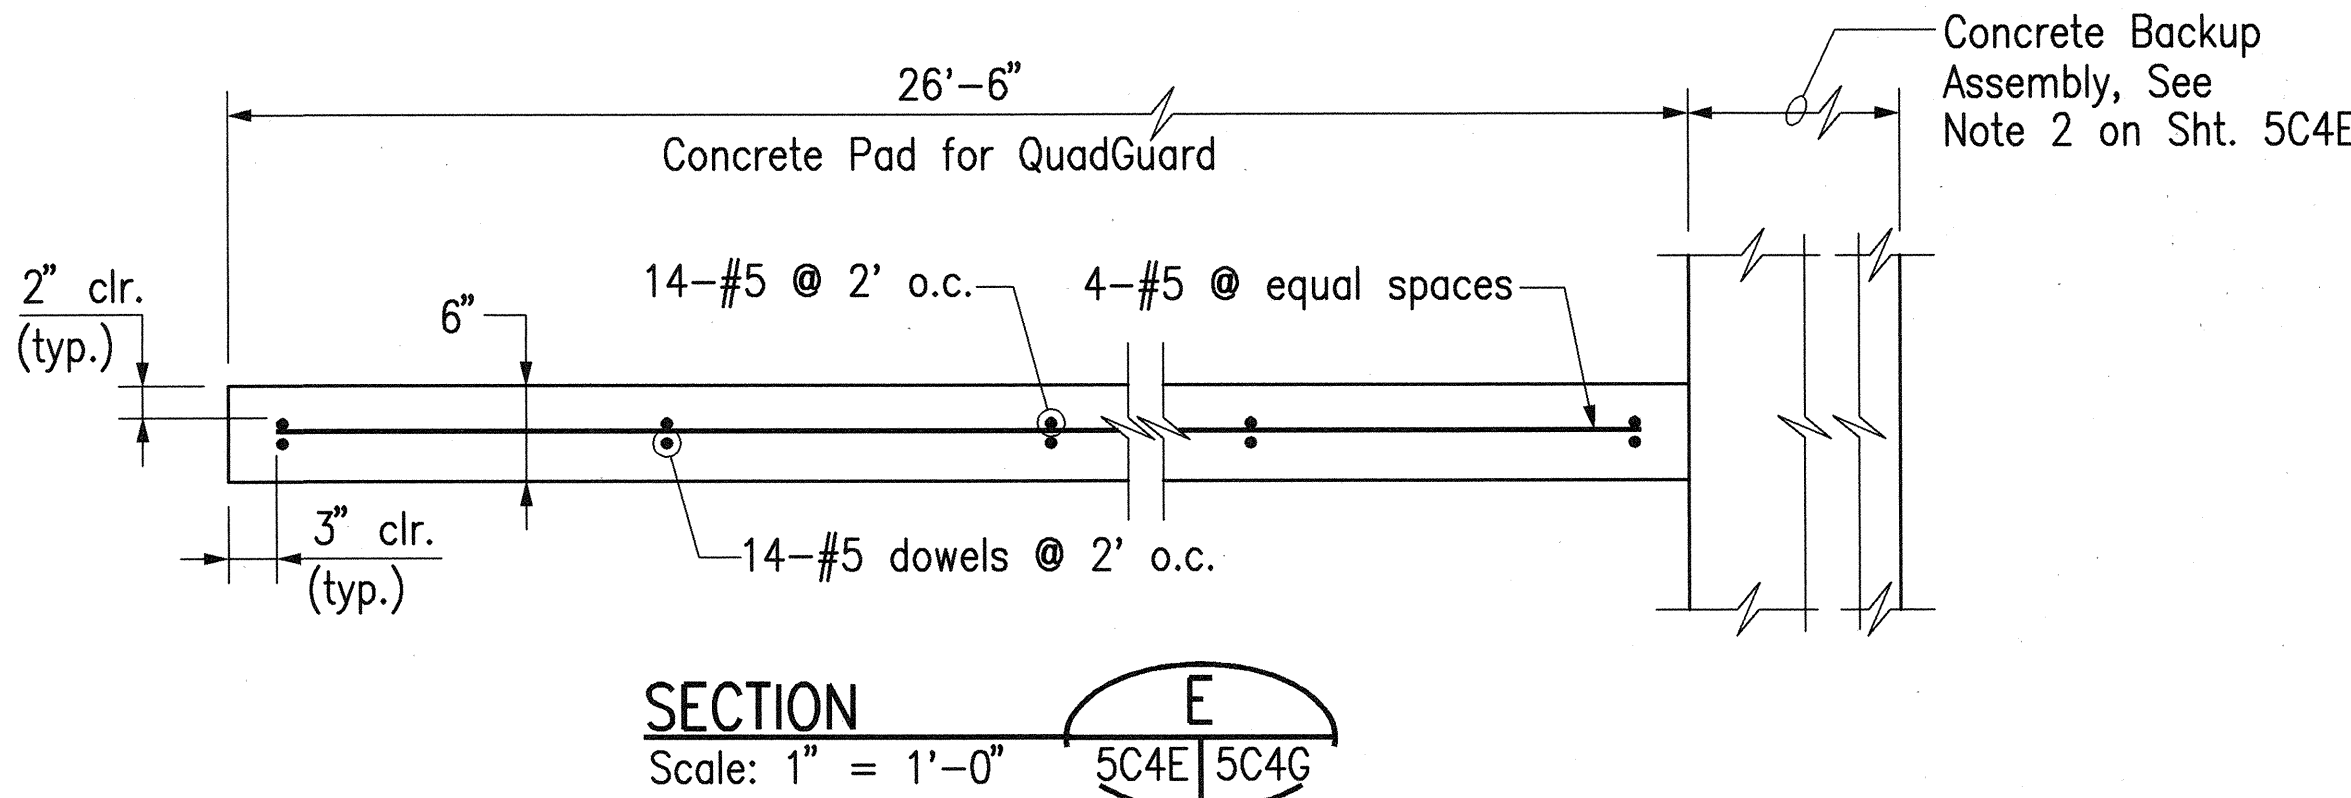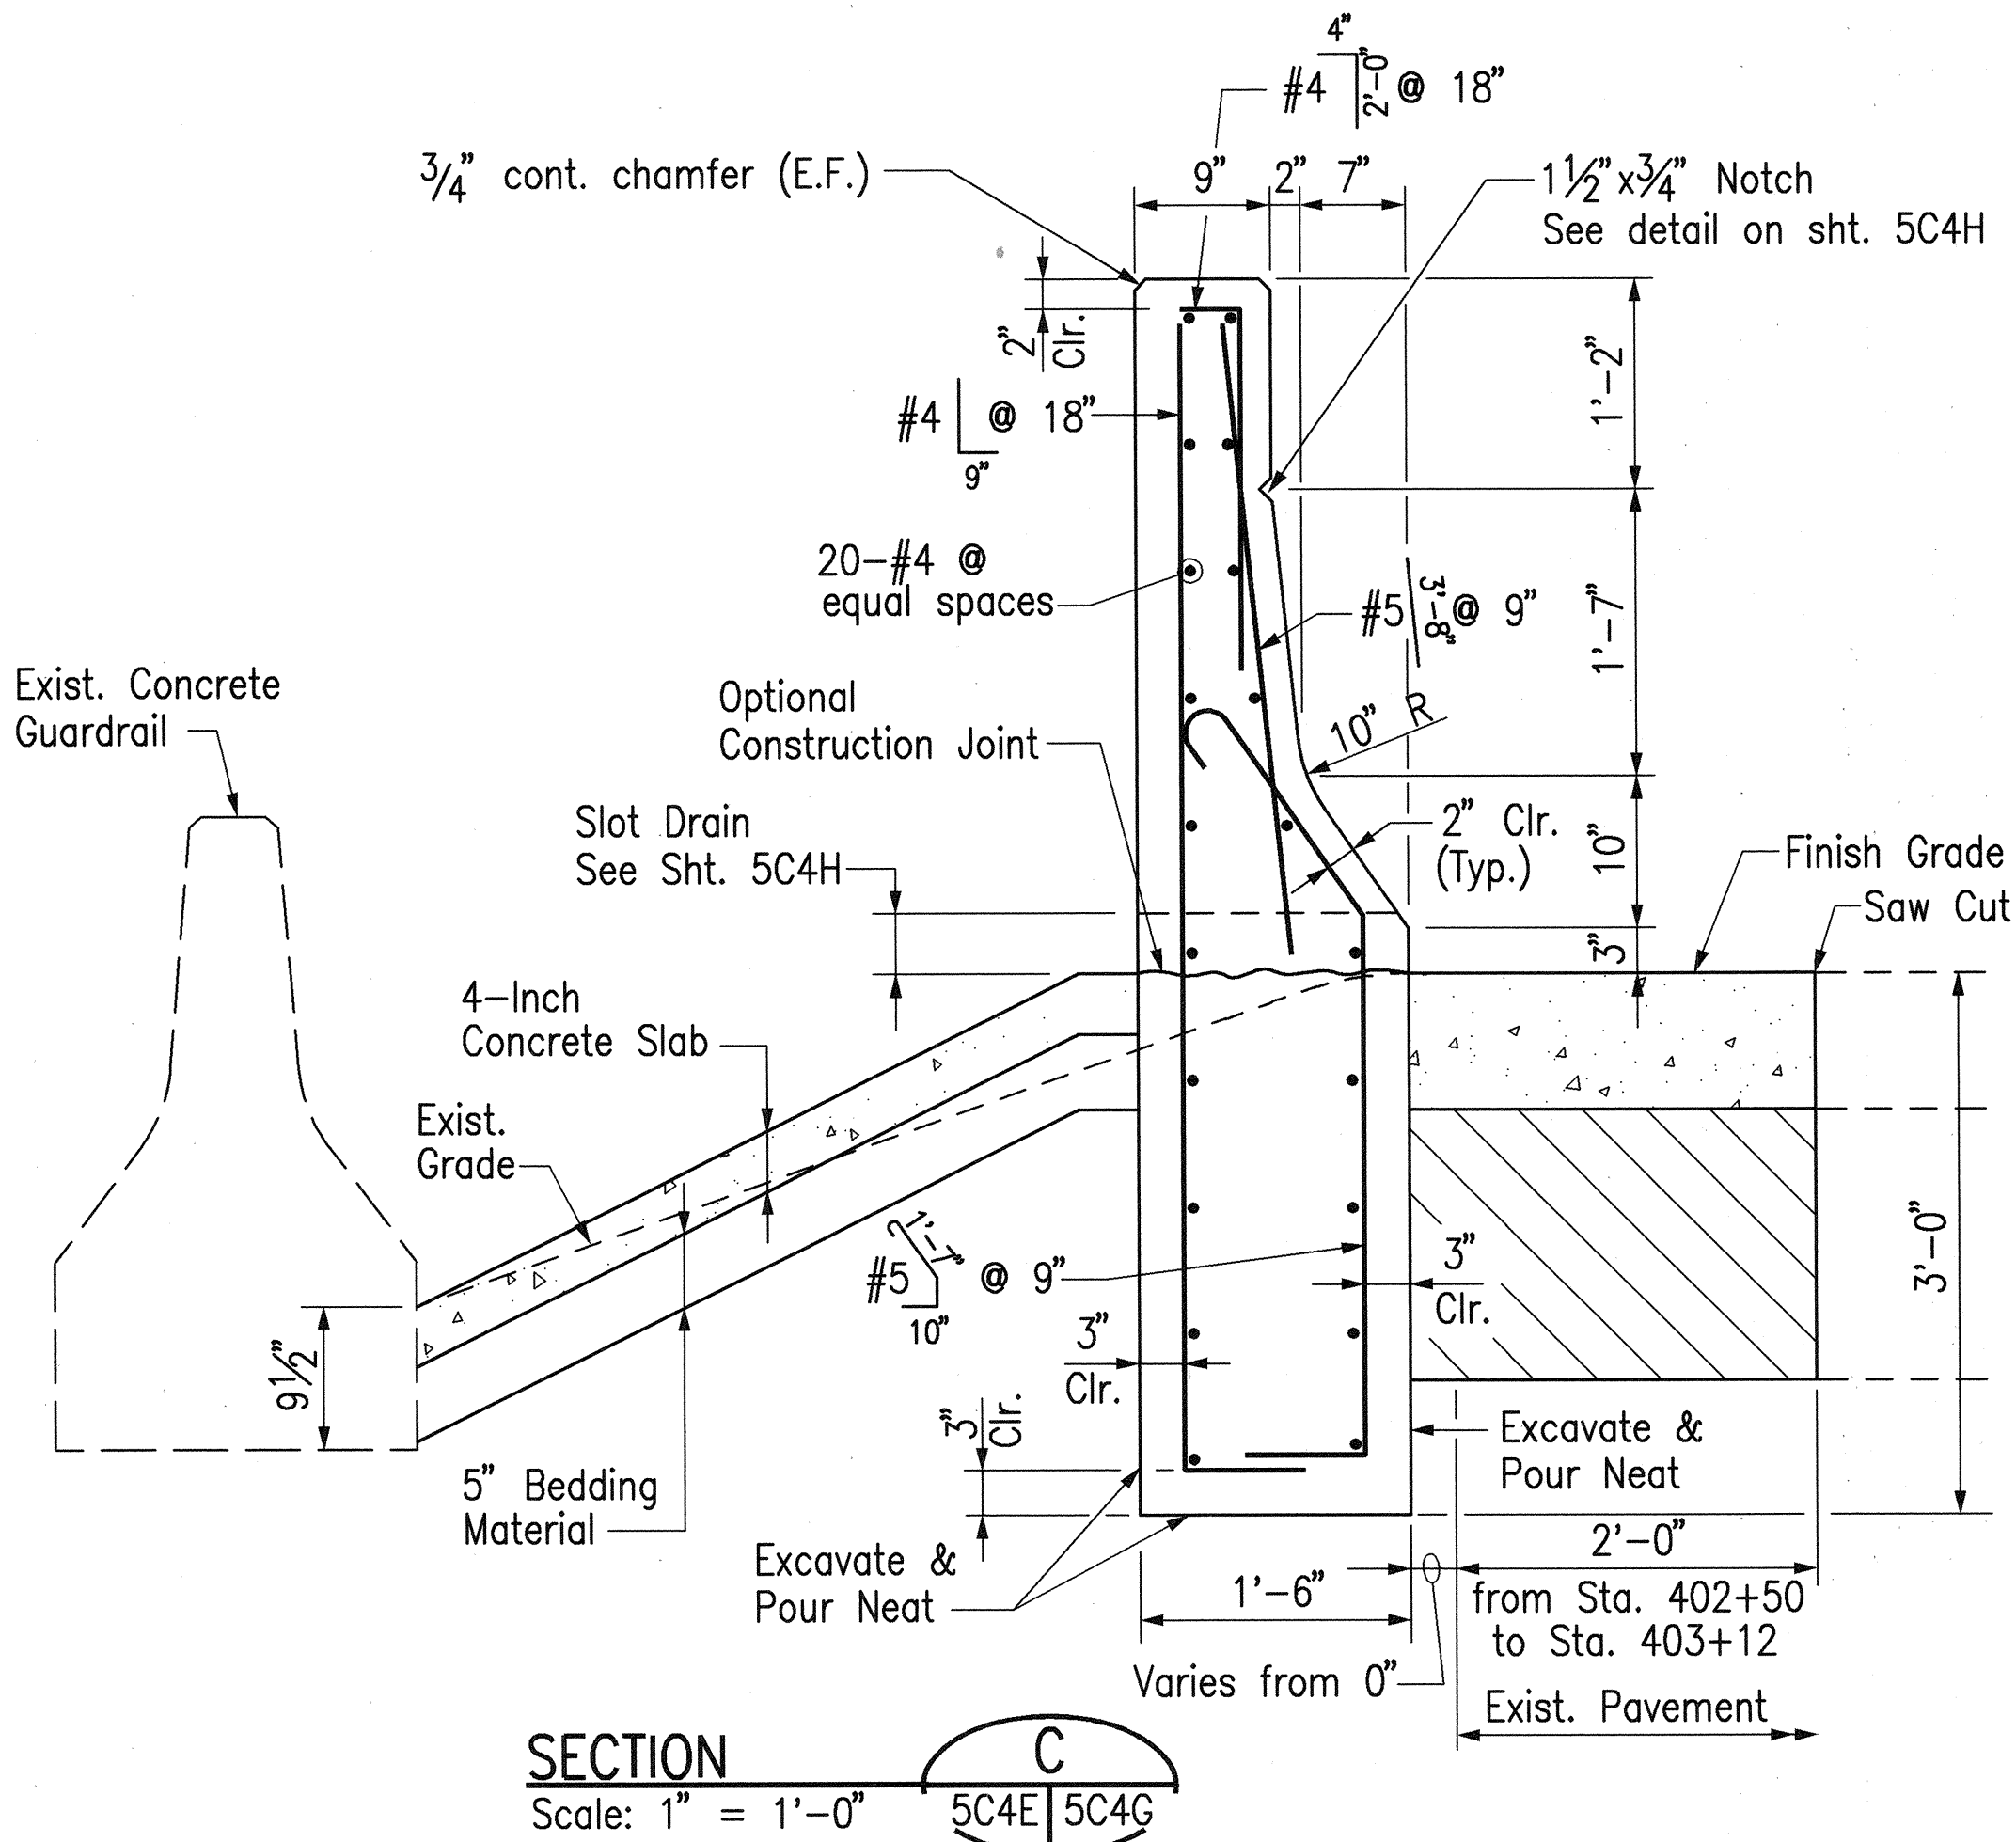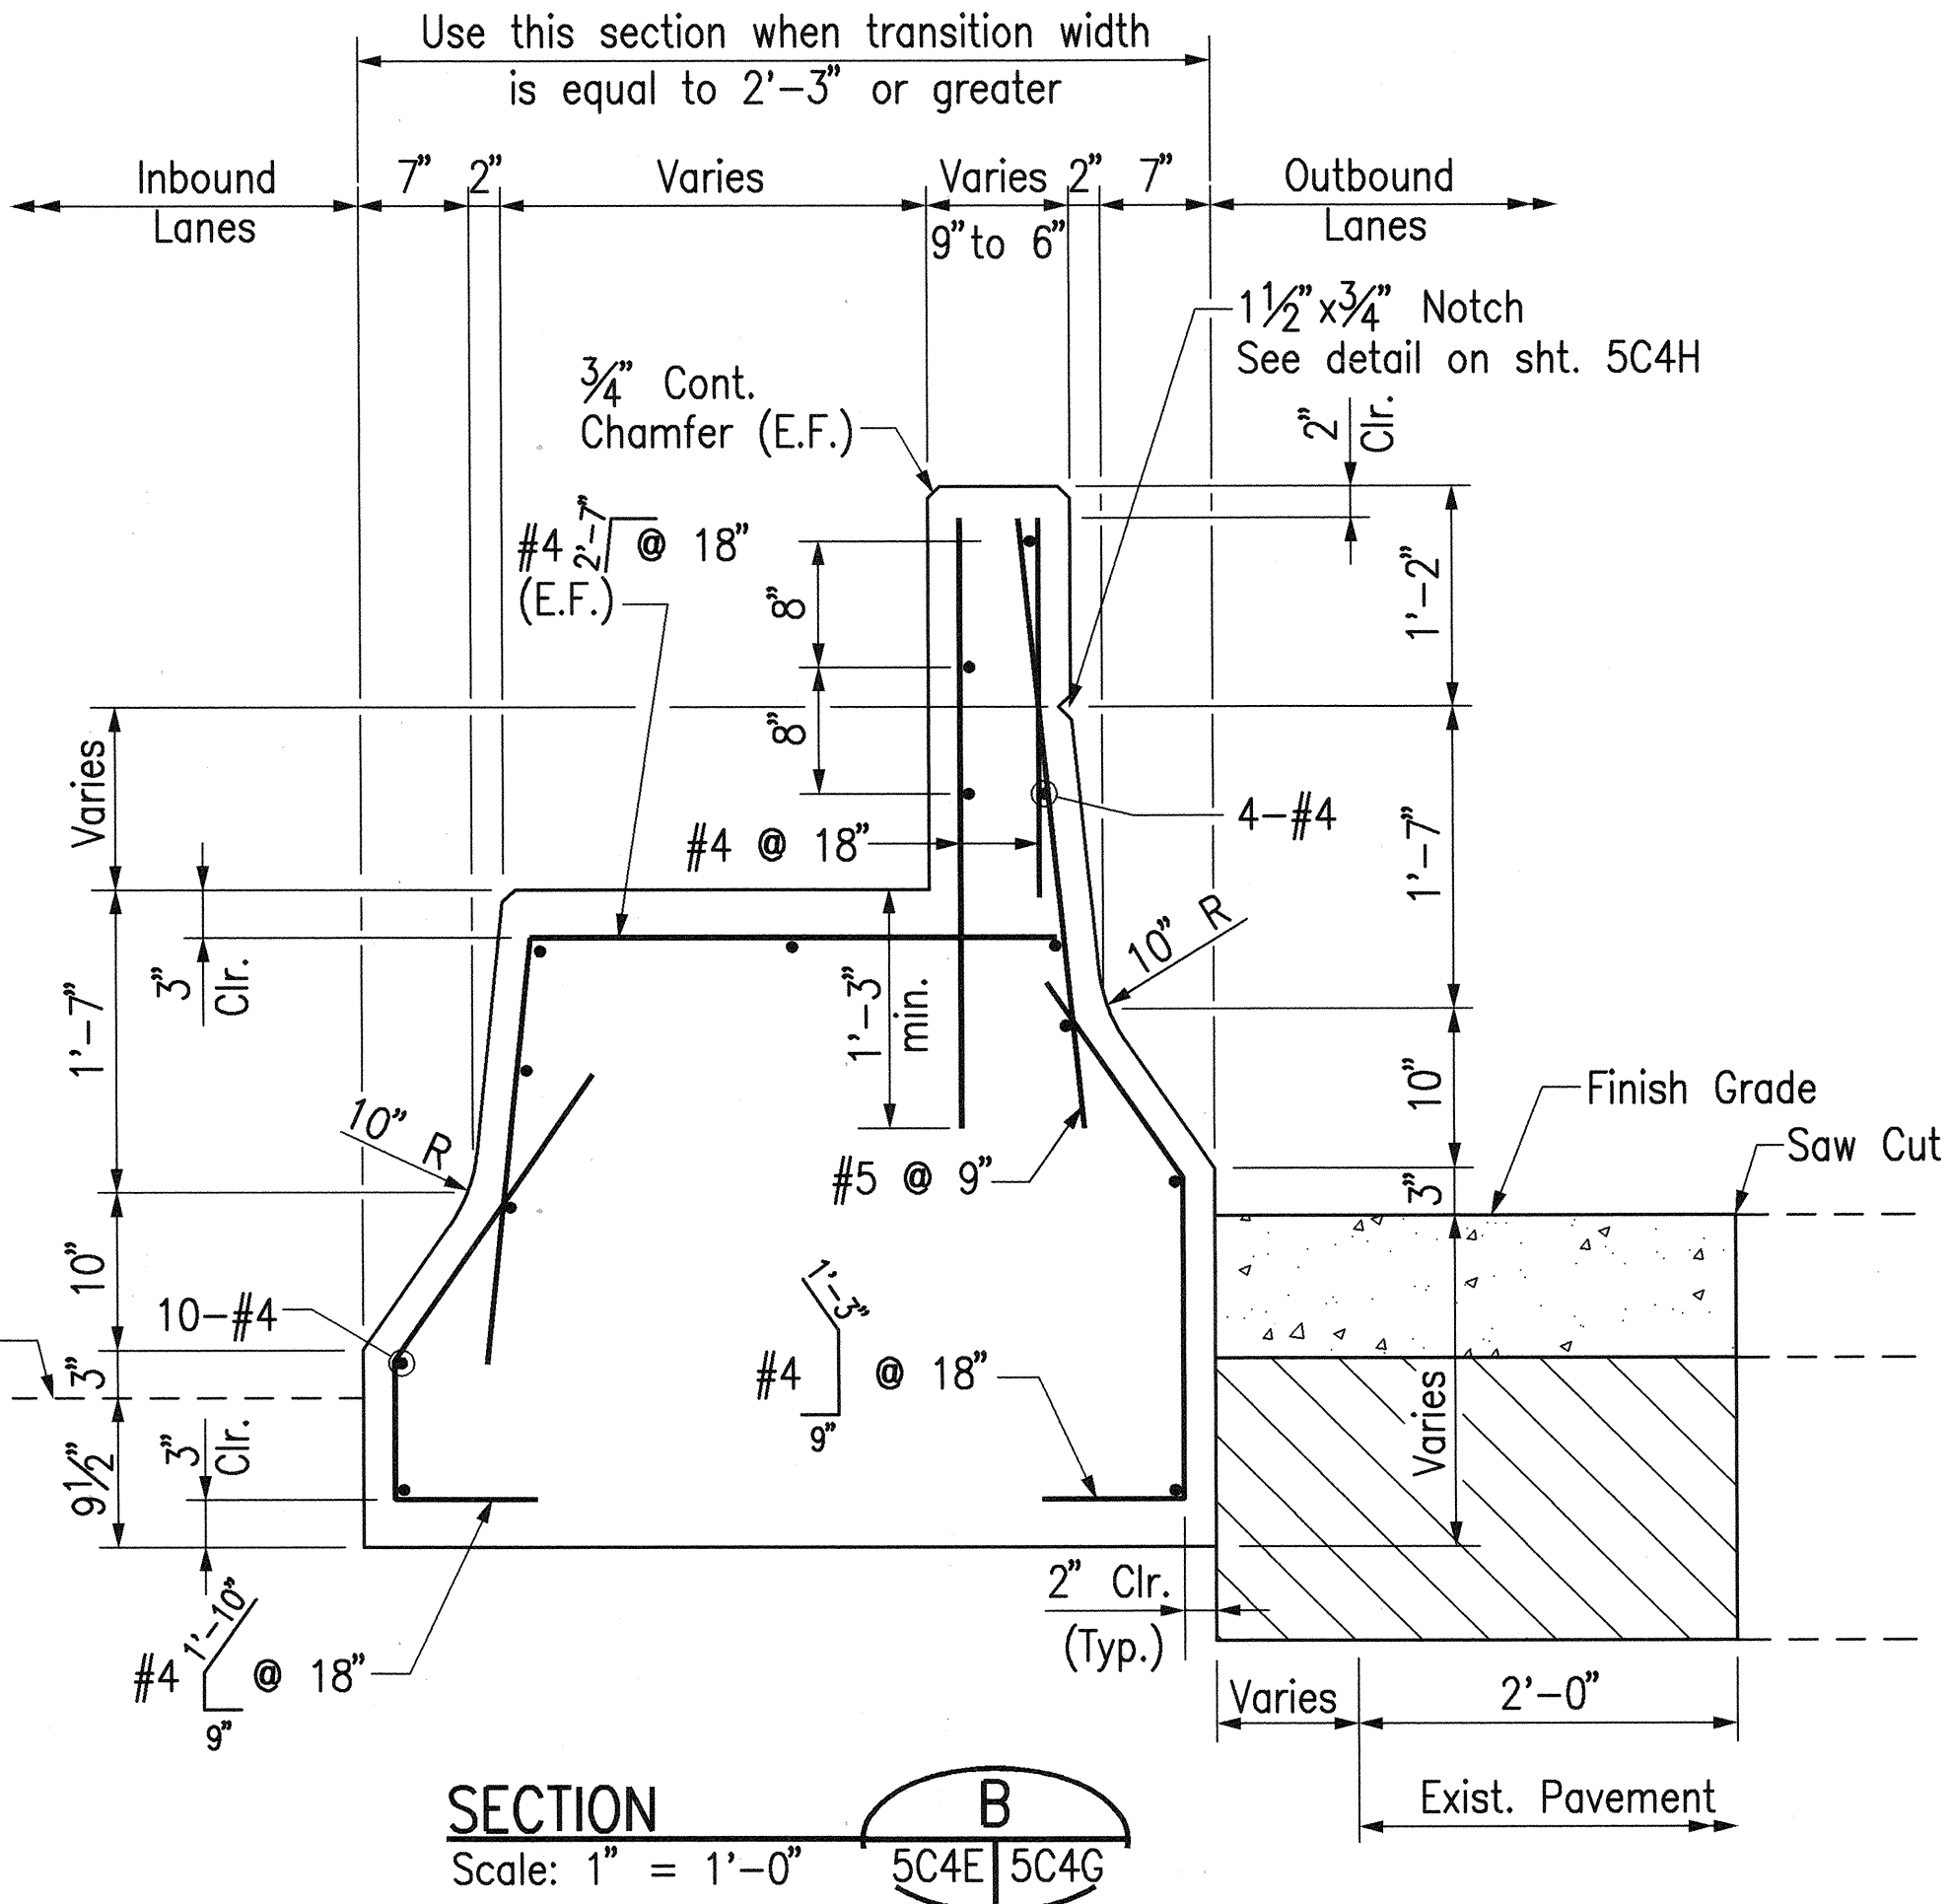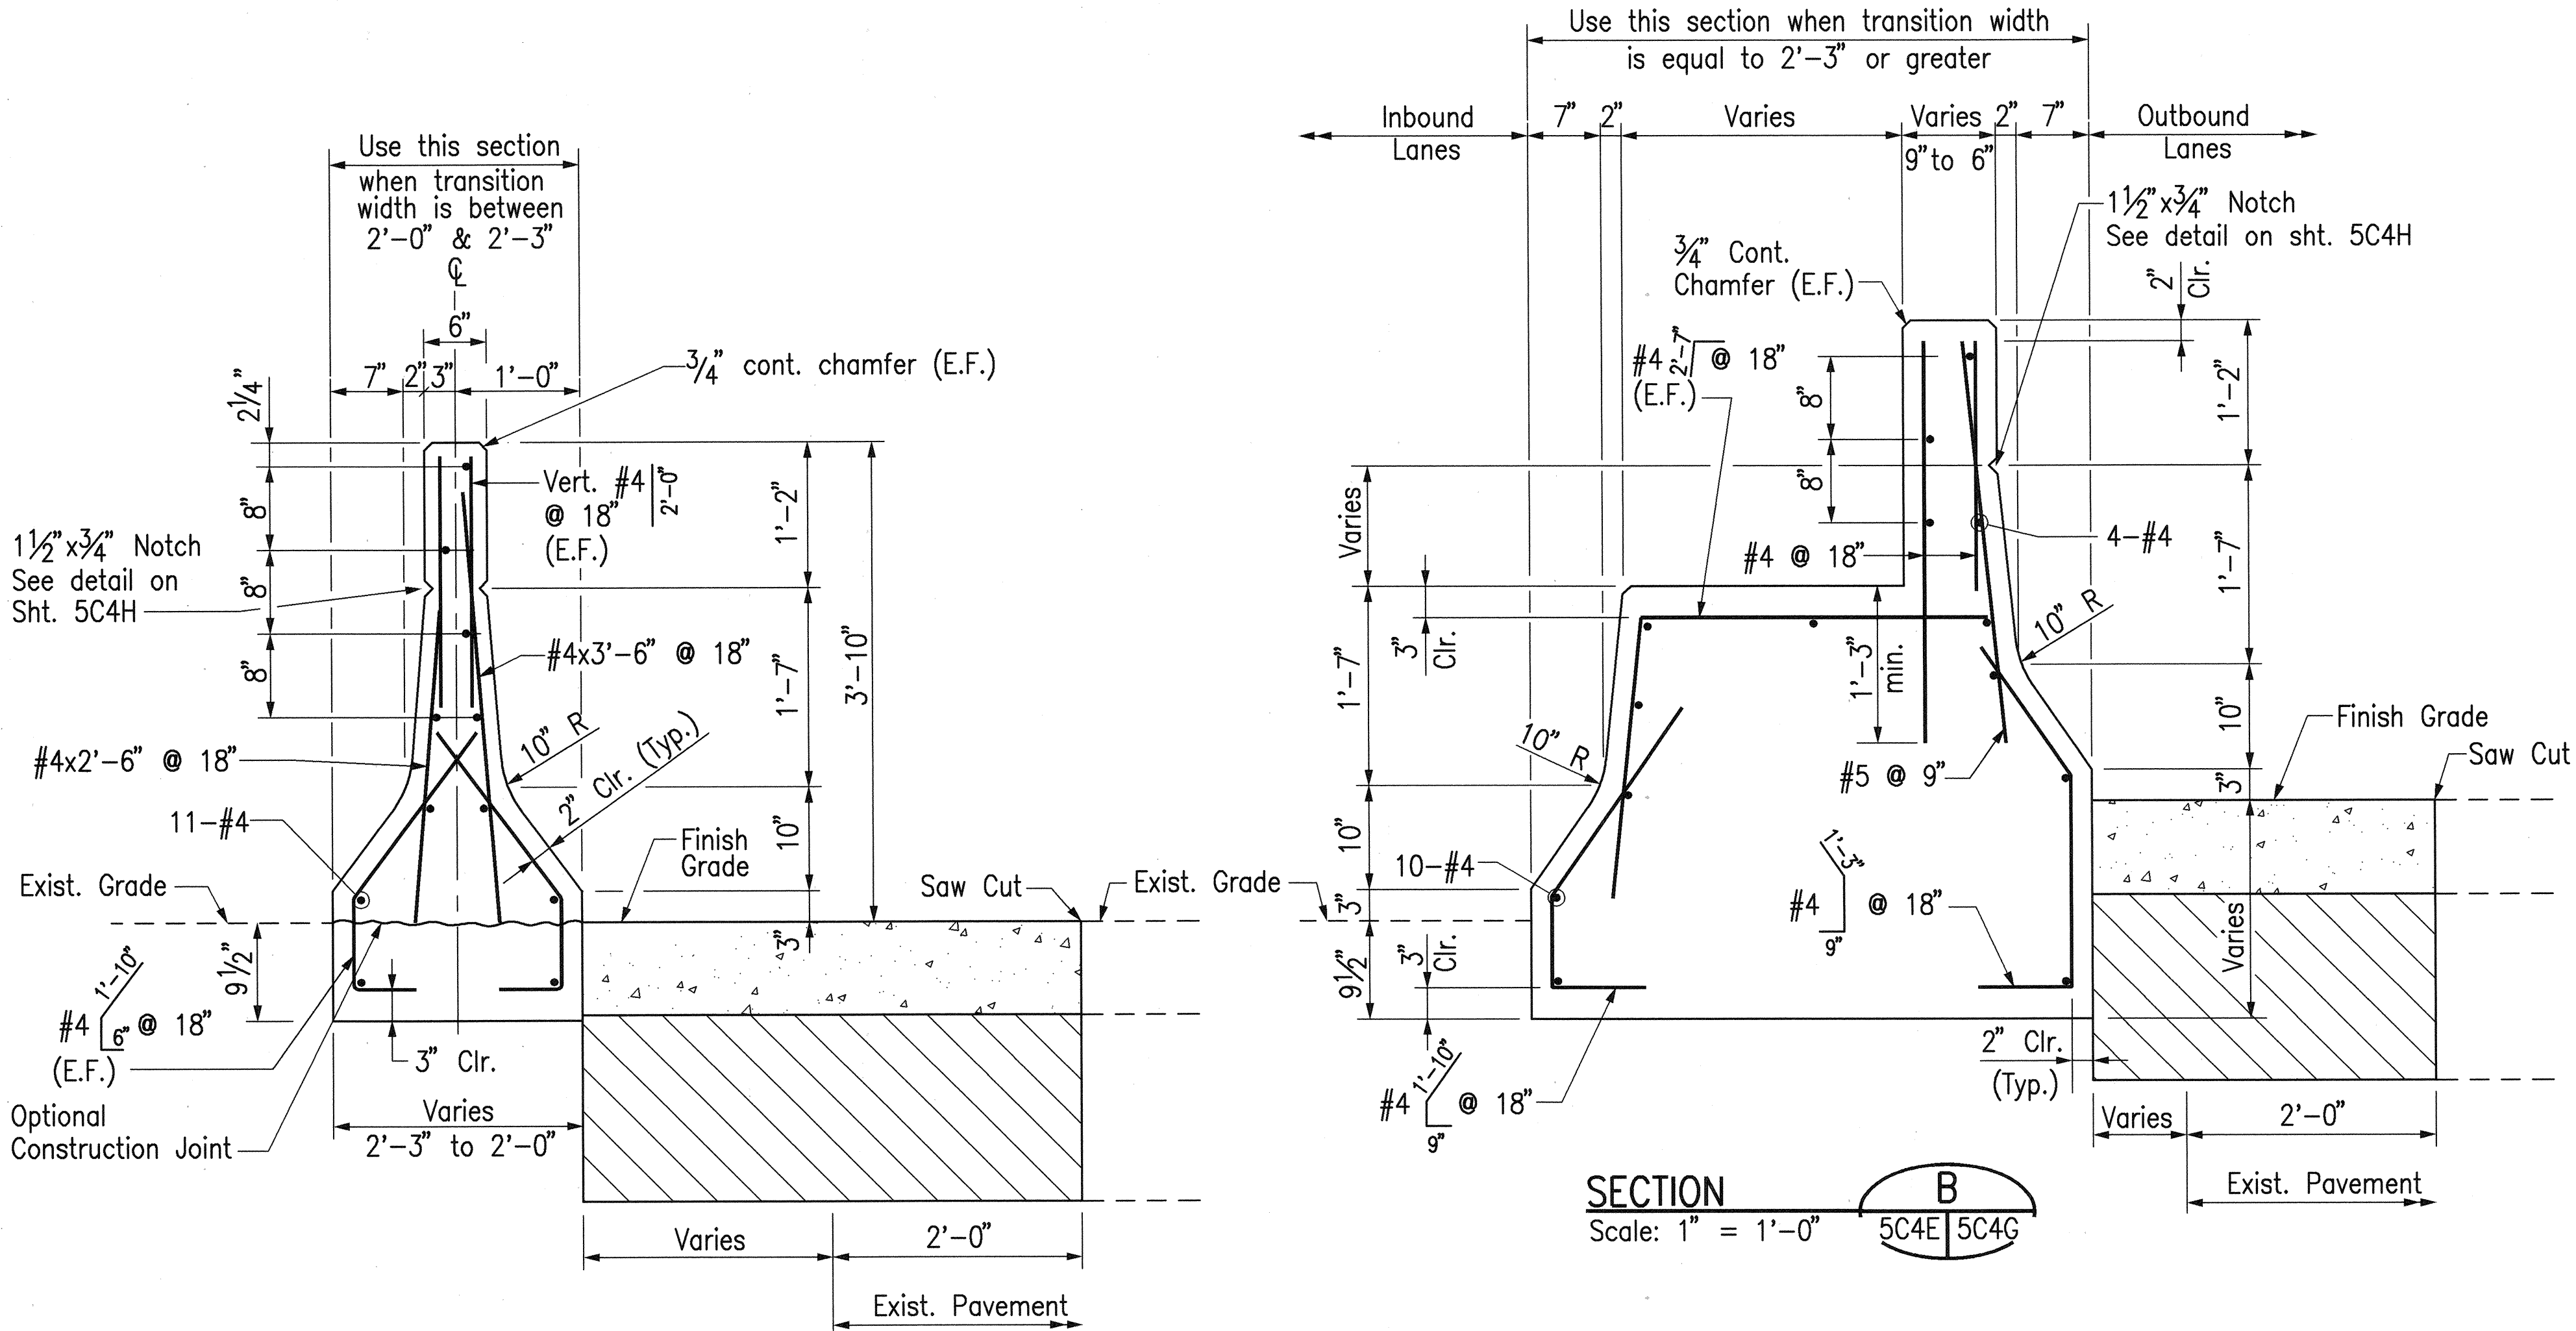

DATE	_____
SURVEY PLOTTED BY	_____
TRACED BY	_____
DESIGNED BY	_____
QUANTITIES BY	_____
CHECKED BY	_____
No.	_____


CAD by J. Minerva, SS-52

Last Saved: J:\H3RF\RU2\CO\WINDWARD\CO-RC01.dwg 01/22/98 at 11:47

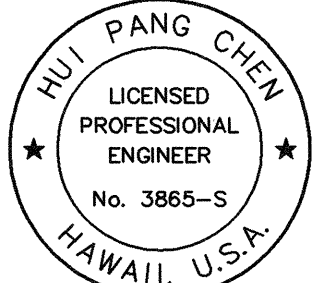

THIS WORK WAS PREPARED BY ME
OR UNDER MY SUPERVISION.

Hui Pang Chen

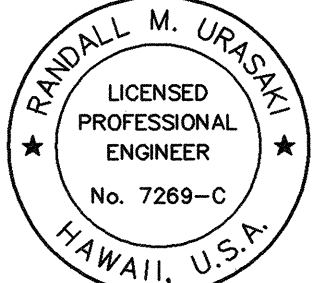


THIS WORK WAS PREPARED BY ME
OR UNDER MY SUPERVISION.

Randall M. Urasaki

10/14/97	Added Sheet
Date	Revision
STATE OF HAWAII DEPARTMENT OF TRANSPORTATION HIGHWAYS DIVISION	
WINDWARD	
ROADWAY CONSTRUCTION	
DETAILS	
H-3 FINISH (UNIT II)	
FAIP NO. I-H3-1(75), UNIT II	
LEEWARD SECTION	
SCALE: AS SHOWN	DATE: OCTOBER 1997
SHEET NO. 5C4G OF 4 SHEETS	



C.O. 837S-7

FED. ROAD DIST. NO.	STATE	FED. AID PROJ. NO.	FISCAL YEAR	SHEET NO.	TOTAL SHEETS
HAWAII	HAW.	I-H3-1(75), UNIT II	1997	C.O. 837S-8	1102

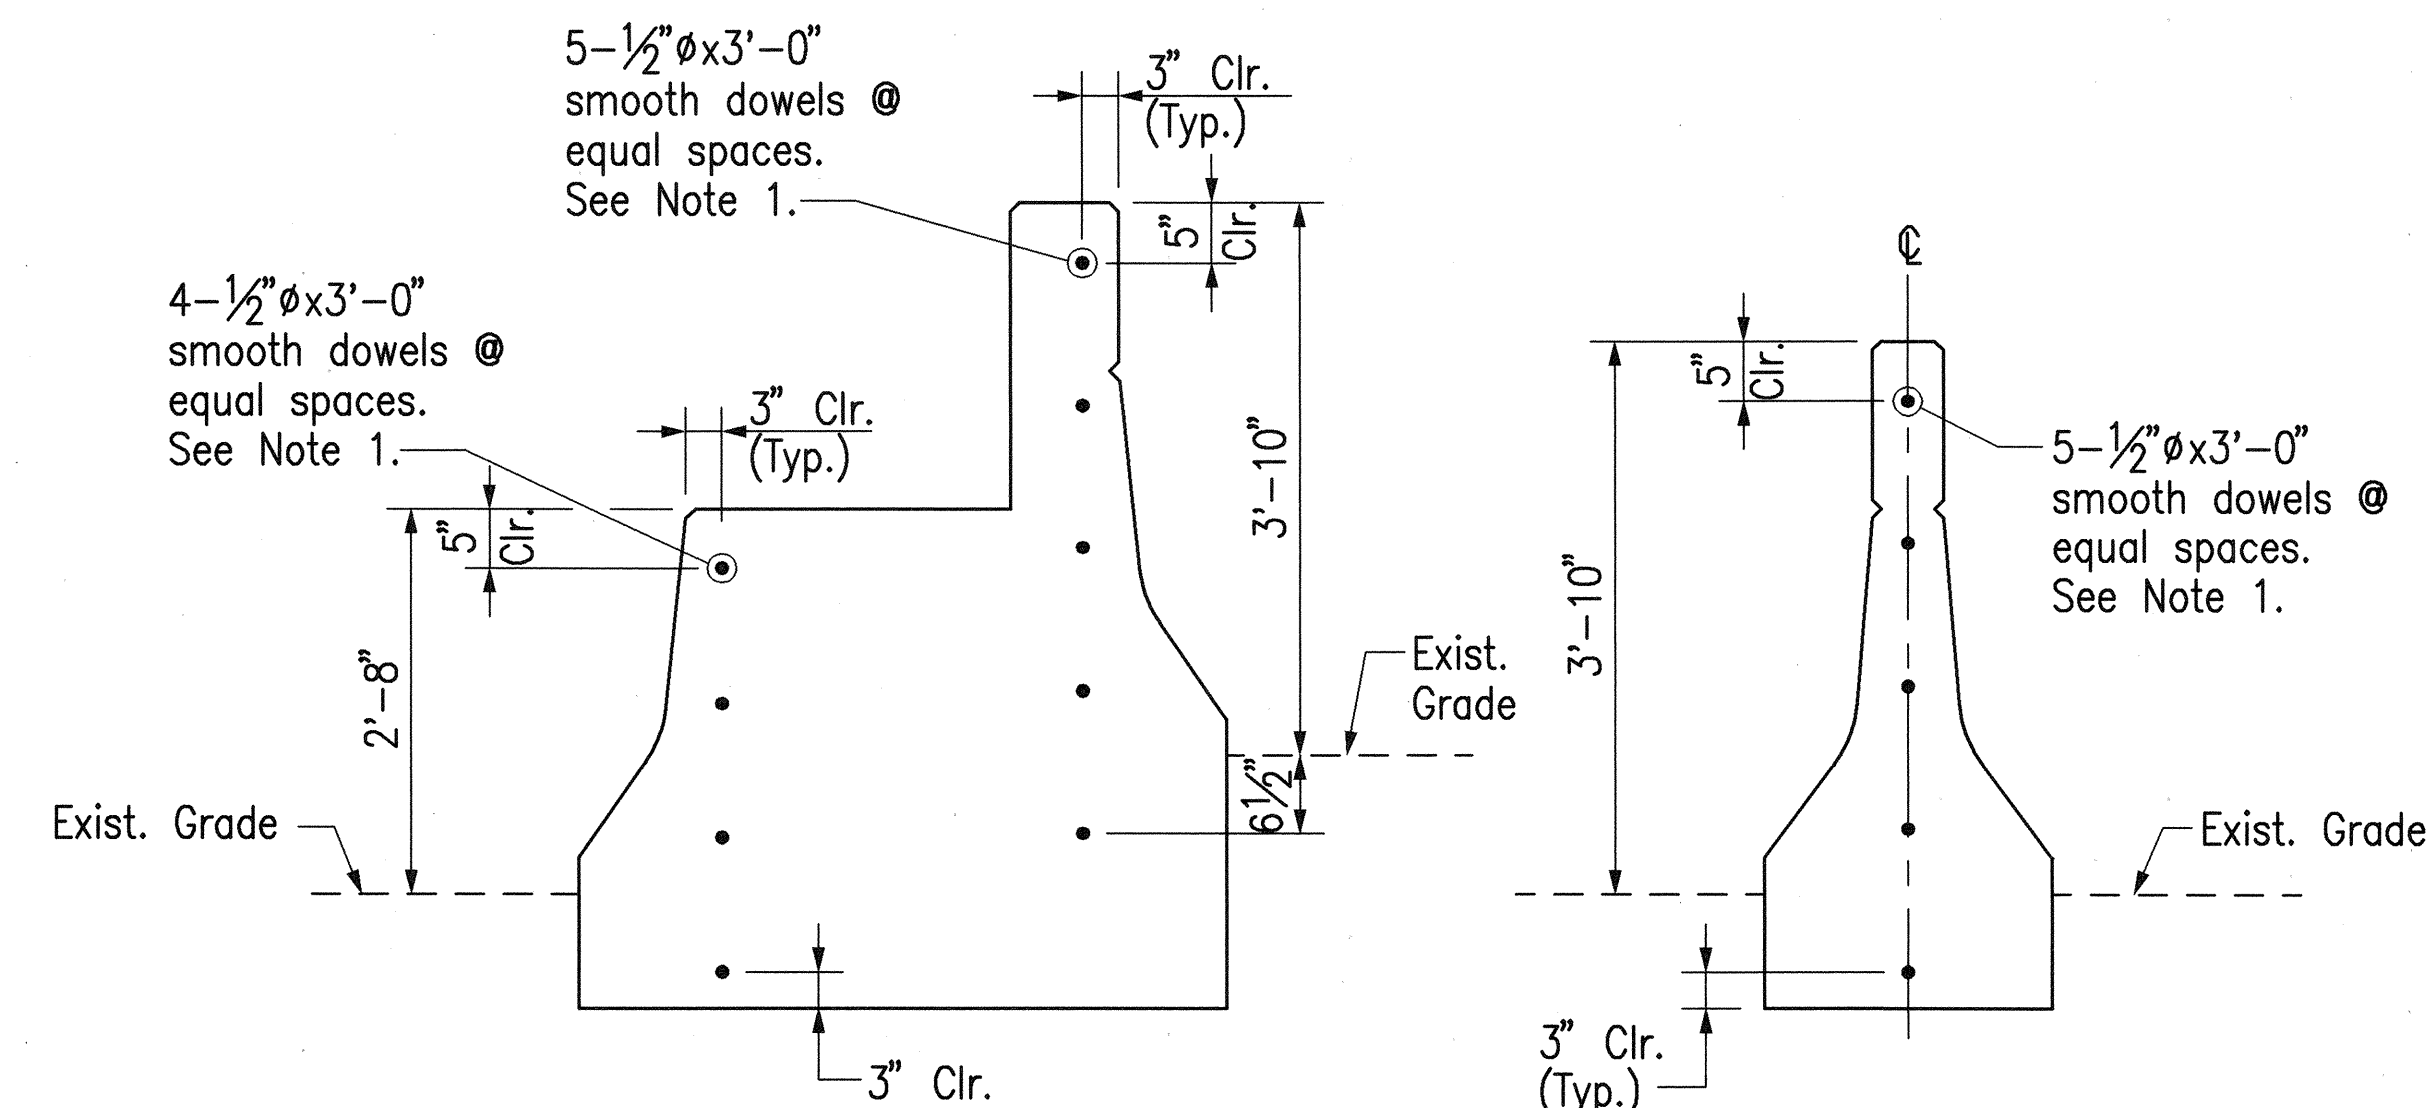


TYPICAL SECTION
H-3 @ Sta. 403+12

TYPICAL SECTION
H-3 @ Sta. 403+50

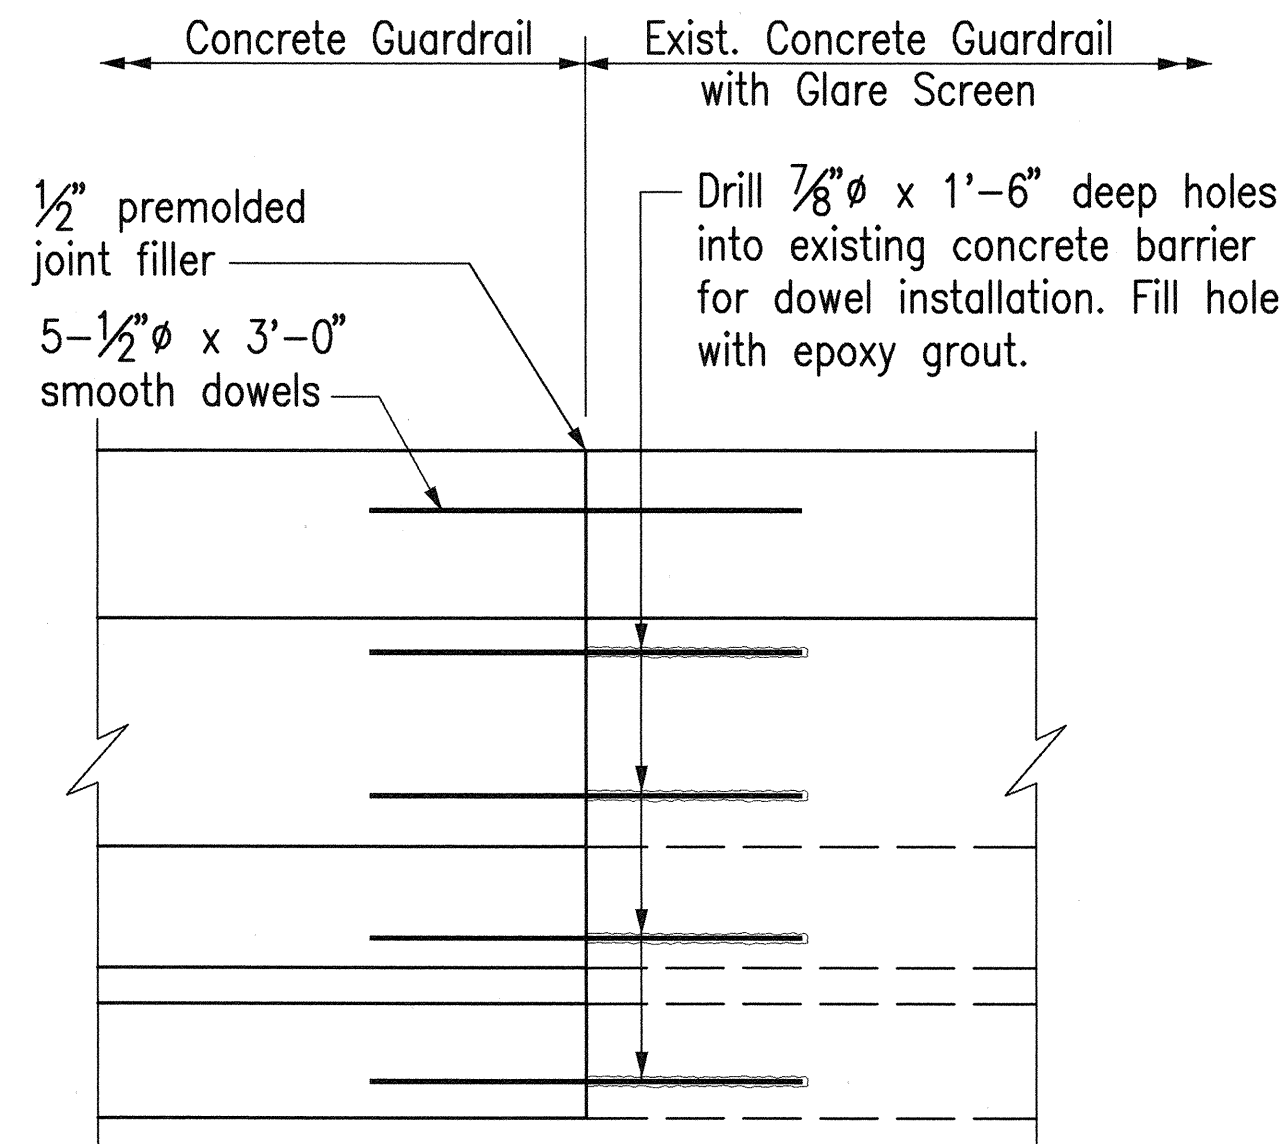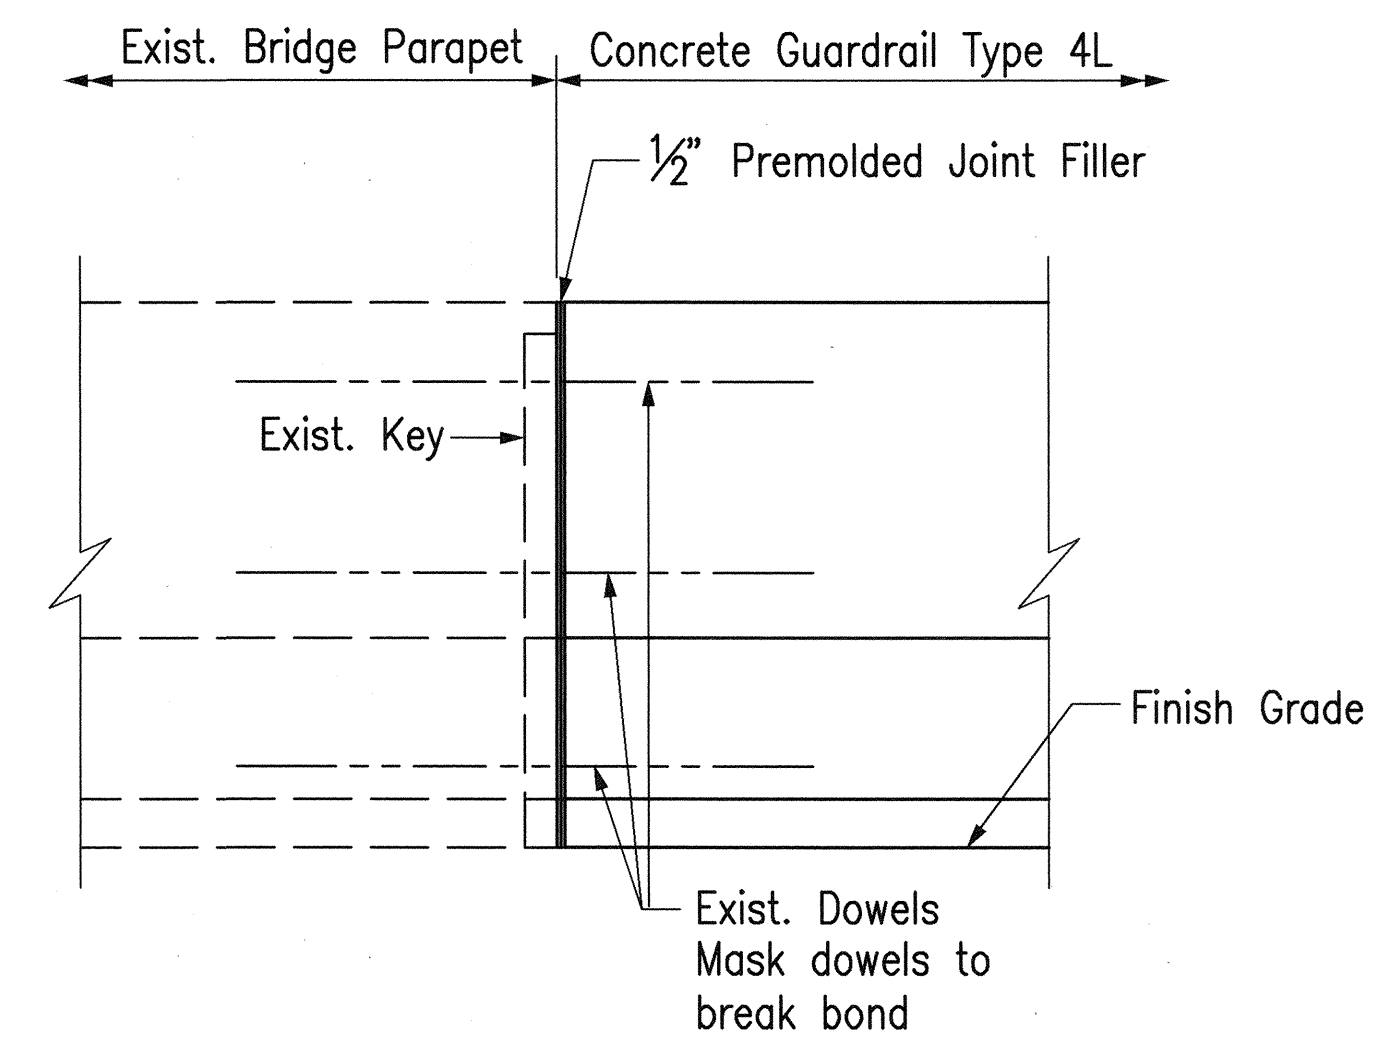ELEVATION

EXPANSION JOINT @ EXISTING BRIDGE PARAPET

Not to Scale

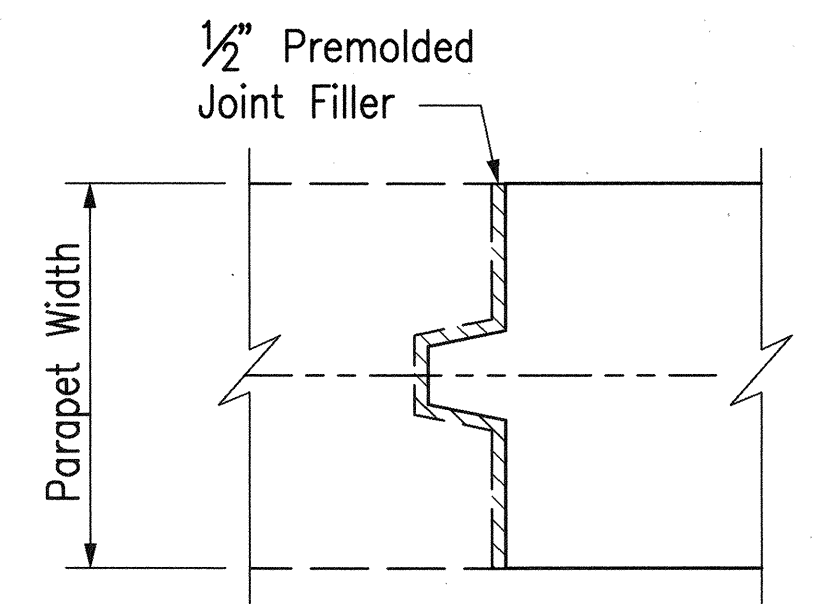


PLAN

KEY DETAIL


EXPANSION JOINT DETAIL @ EXISTING CONCRETE GUARDRAIL

Scale: $\frac{3}{4}" = 1'-0"$

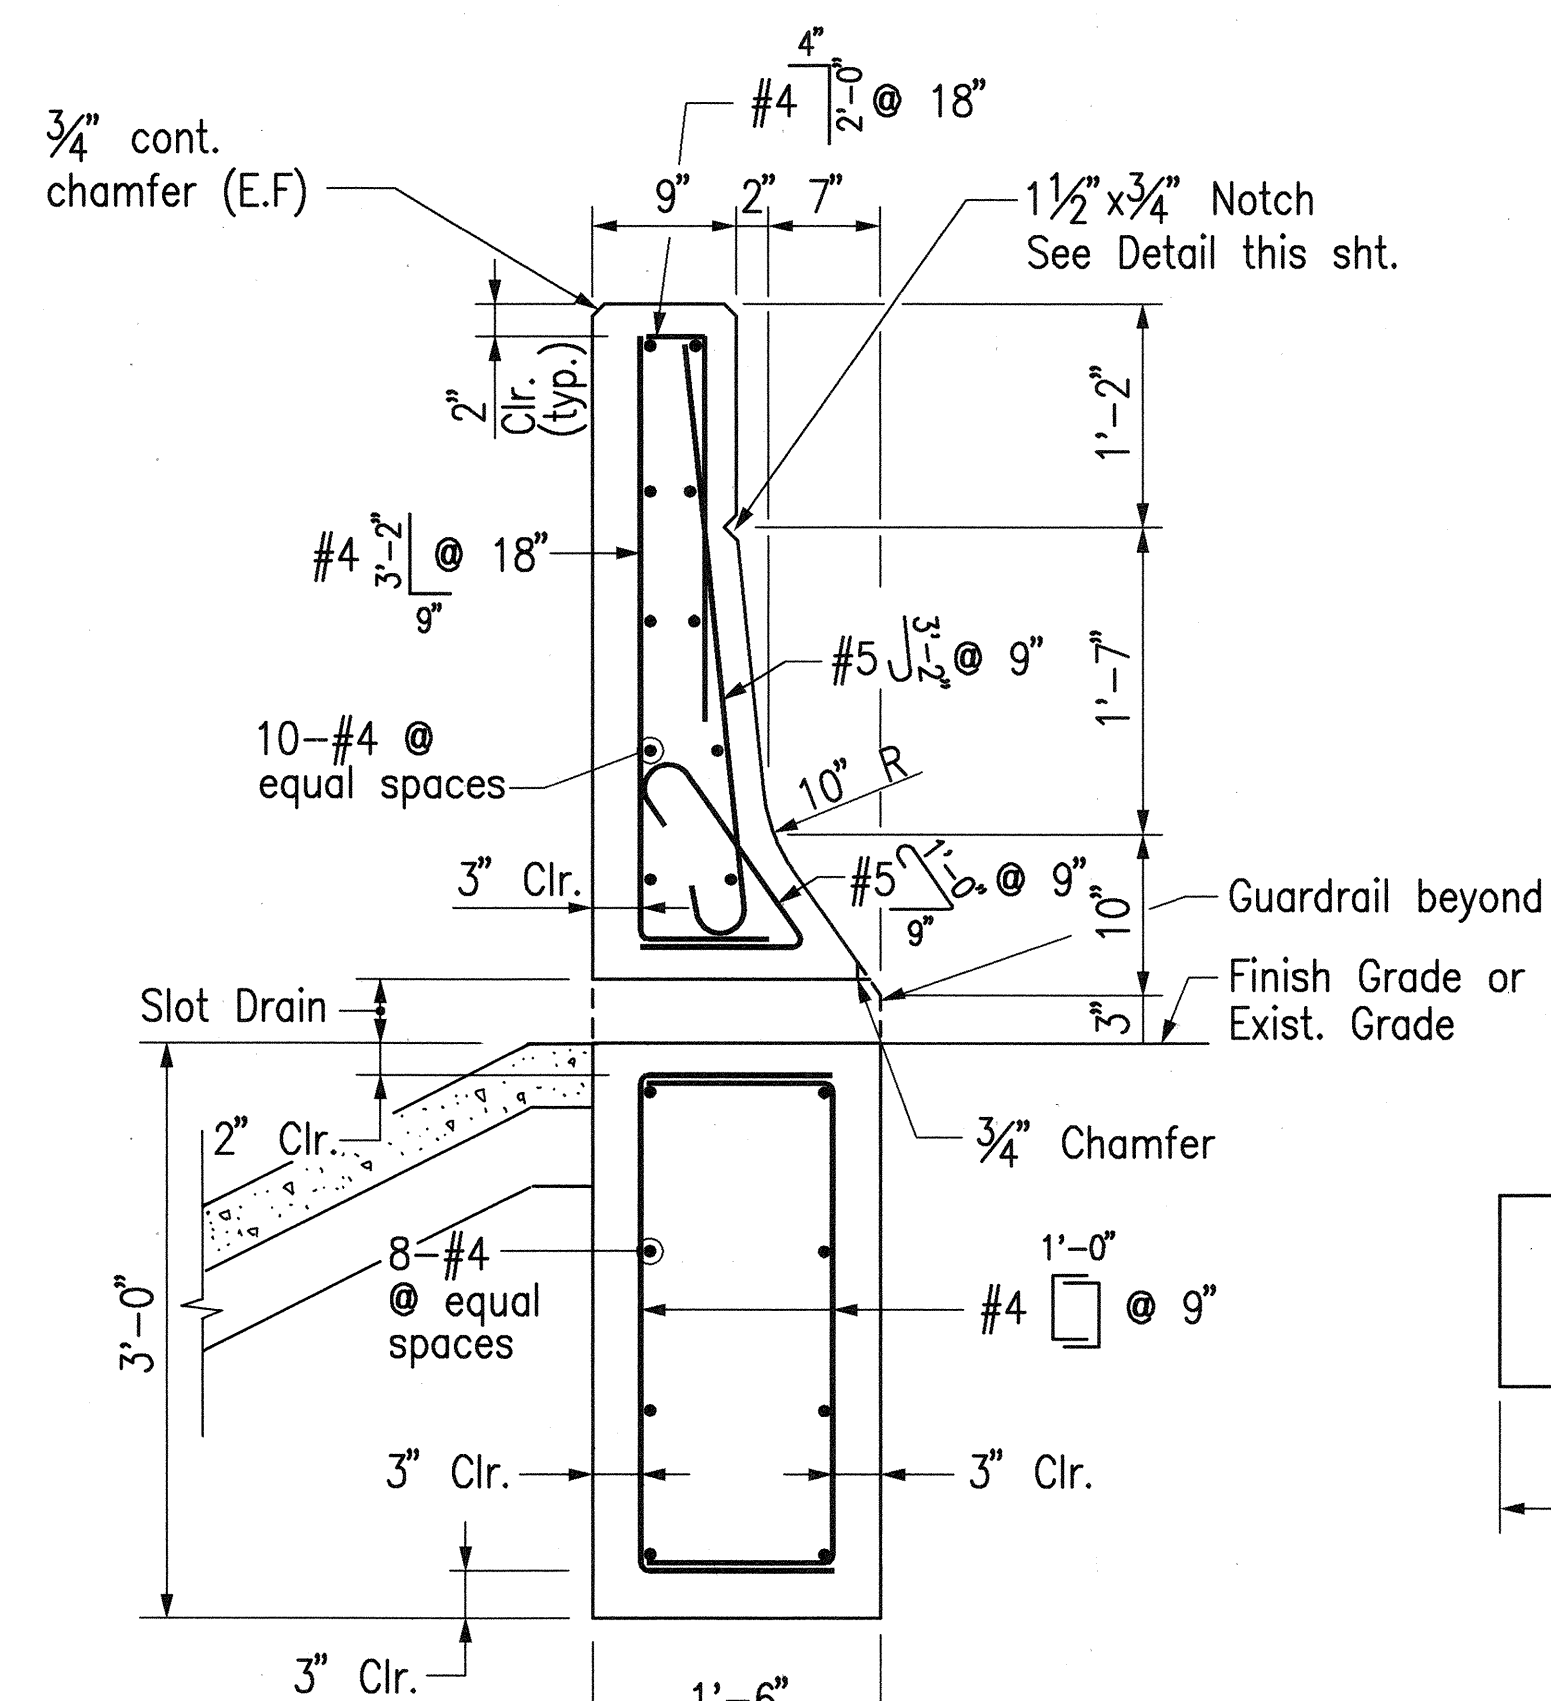


SECTION
Scale: 1" = 1'-0"

CONCRETE GUARDRAIL TYPE 4K @ SLOT DRAIN

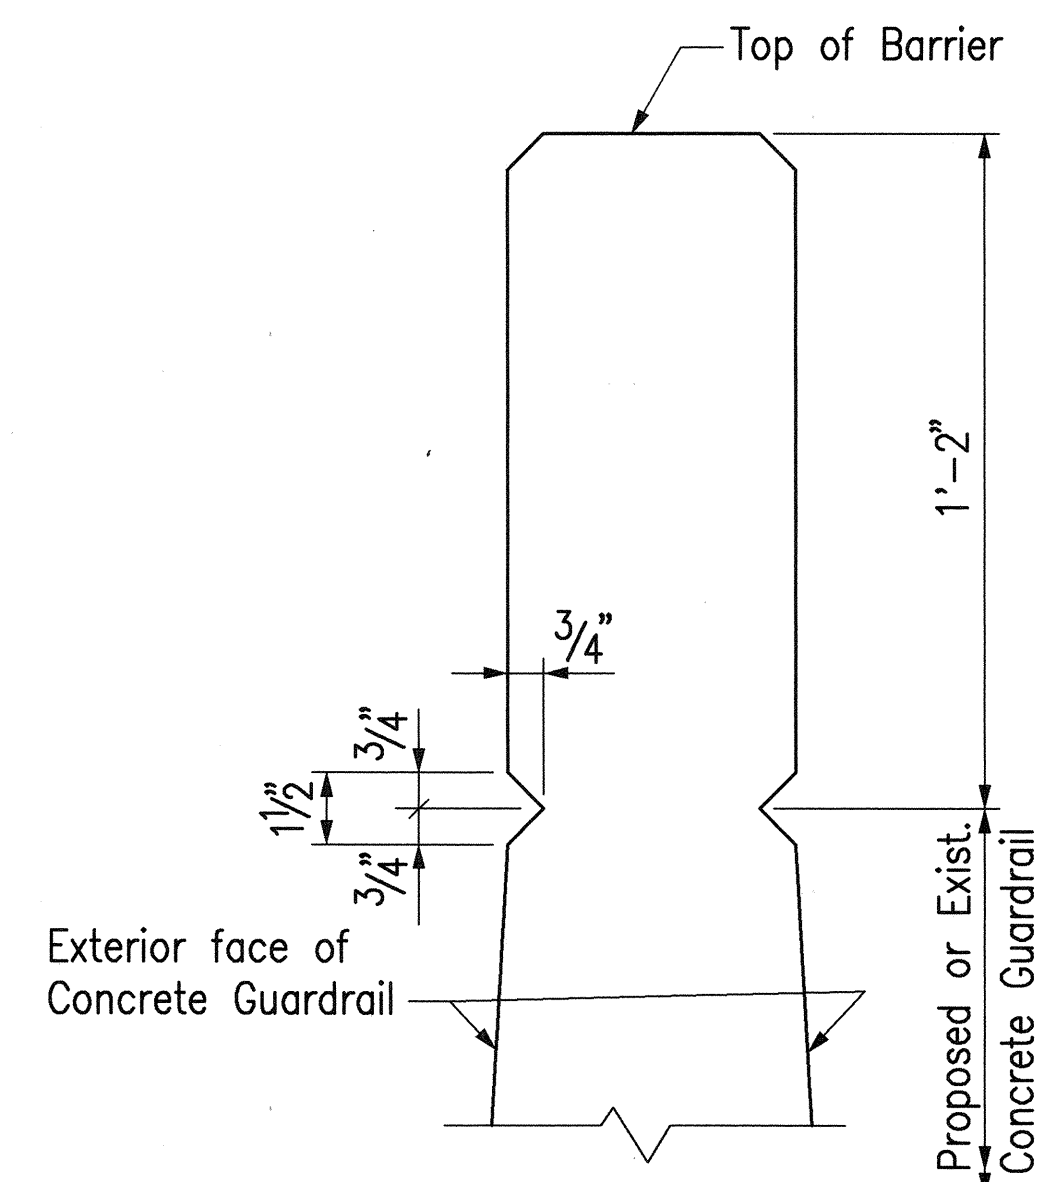

NOTCH DETAIL

Scale: 3" = 1'-0"

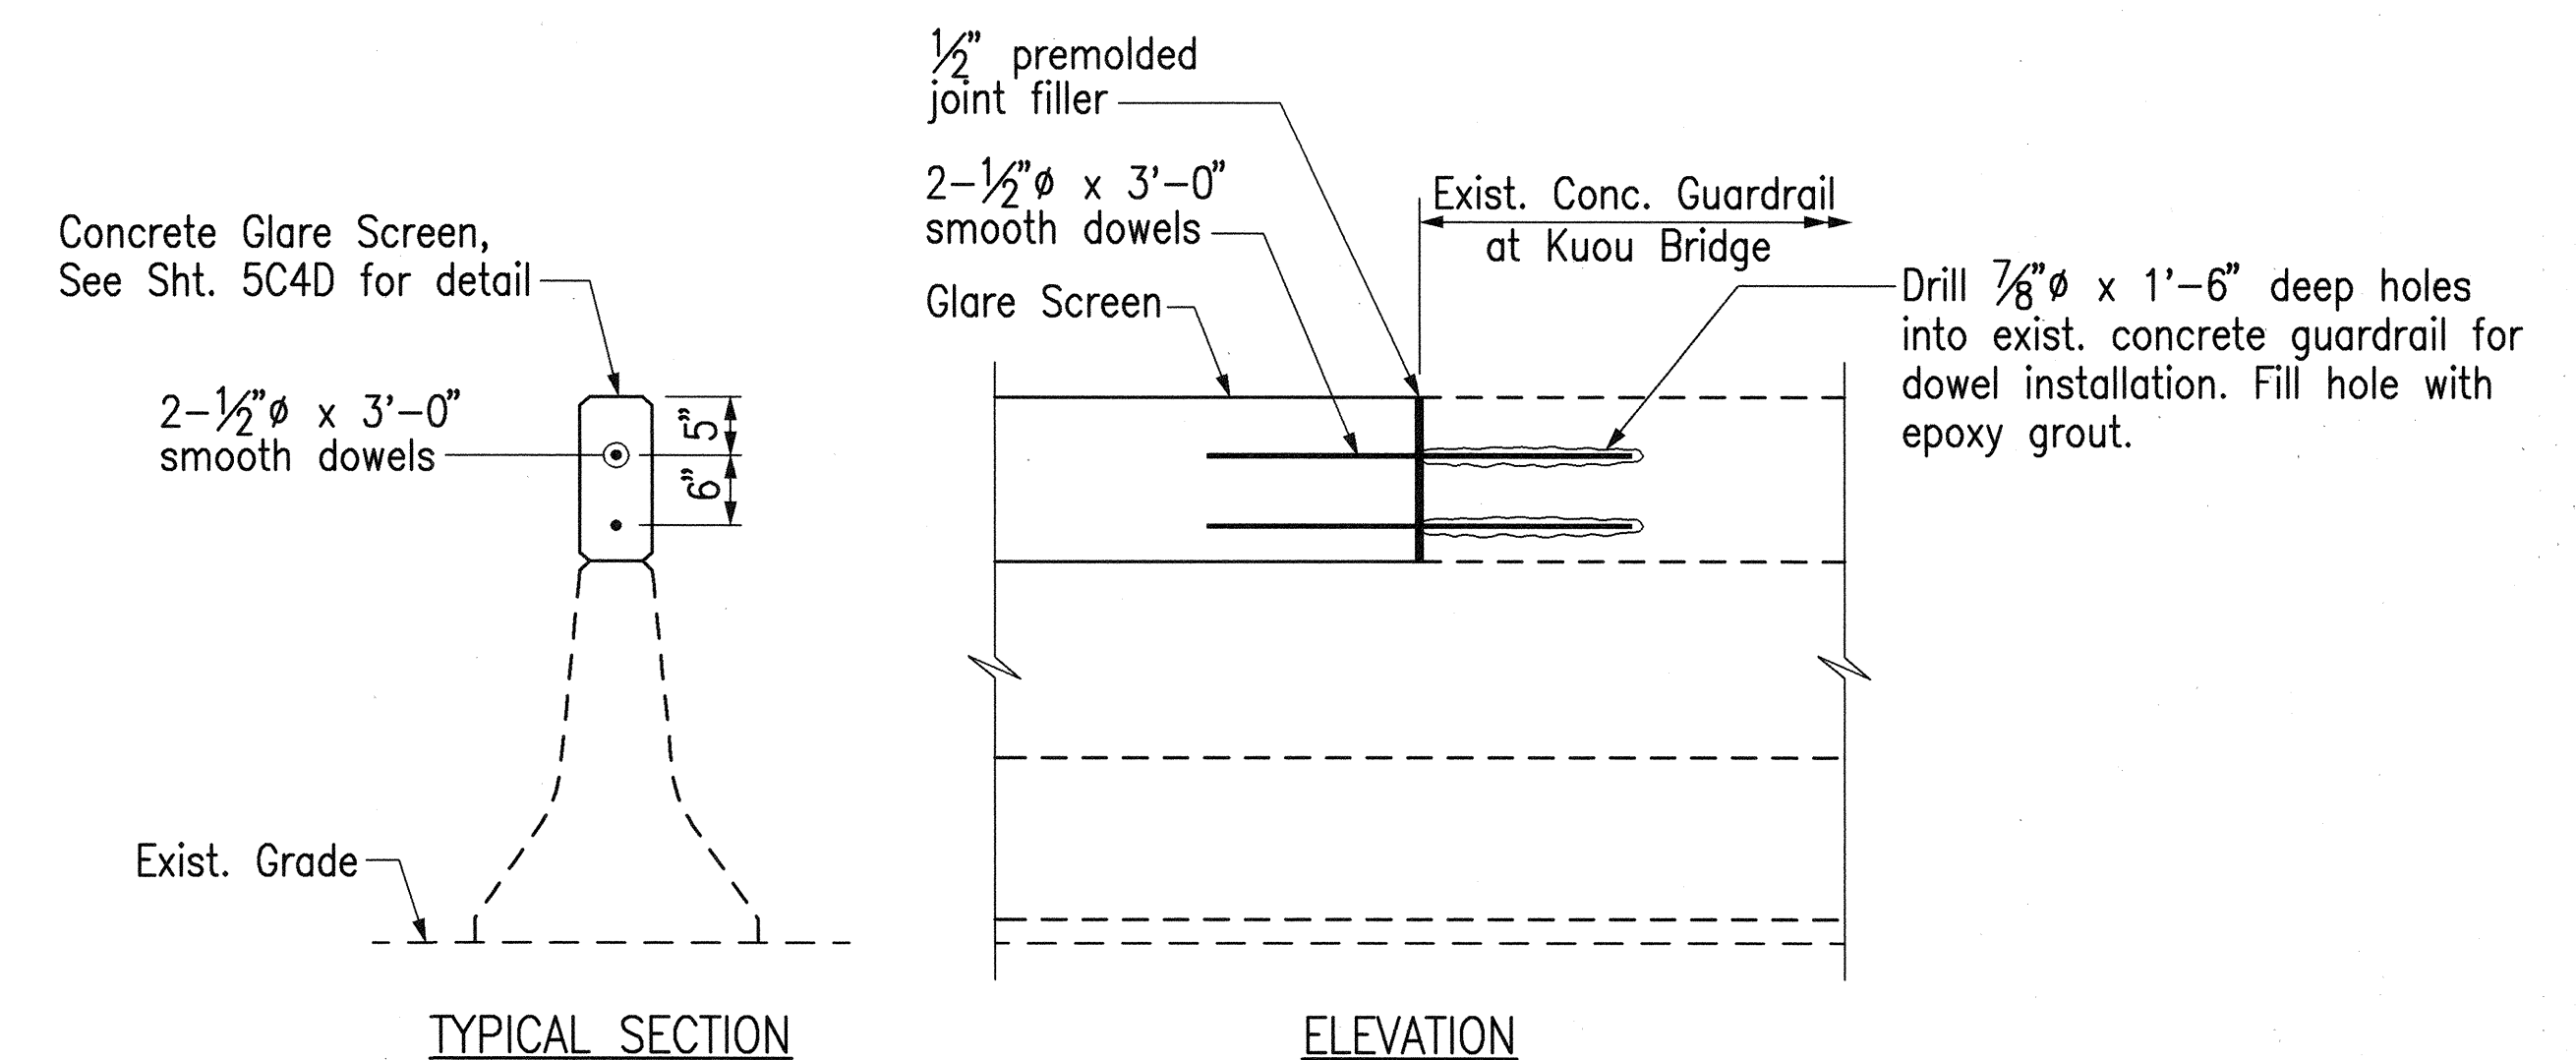

EXPANSION JOINT DETAIL FOR CONCRETE GLARE SCREEN AT KUOU BRIDGE

Scale: $3/4" = 1'-0"$

10/14/97	Added Sheet
Date	Revision

STATE OF HAWAII
 DEPARTMENT OF TRANSPORTATION
 HIGHWAYS DIVISION

WINDWARD

ROADWAY CONSTRUCTION

DETAILS

H-3 FINISH (UNIT II)
 FAIP NO. T-H3-1(75). UNIT II

LEEWARD SECTION

SCALE: AS SHOWN DATE: OCTOBER 1997

SHEET NO. 5C4H OF 4 SHEETS

C.O. 837S-8

ORIGINAL PLAN	SURVEY PLOTTED BY _____ DATE _____
NOTE BOOK	DRAWN BY _____
	TRACED BY _____
	DESIGNED BY _____
	QUANTITIES BY _____
No. _____	CHECKED BY _____

55-52

Last Saved: J:\H3RF\RFU2\CO\WINDWARD\CO-RCD2.dwg 01/26/98 at 14:10



THIS WORK WAS PREPARED BY ME
OR UNDER MY SUPERVISION.


Huiyang Chen



THIS WORK WAS PREPARED BY ME
OR UNDER MY SUPERVISION.

Frank M. White


FED. ROAD DIST. NO.	STATE	FED. AID PROJ. NO.	FISCAL YEAR	SHEET NO.	TOTAL SHEETS
HAWAII	HAW.	I-H3-1(75), UNIT II	1997	C.O. 837S-9	1102

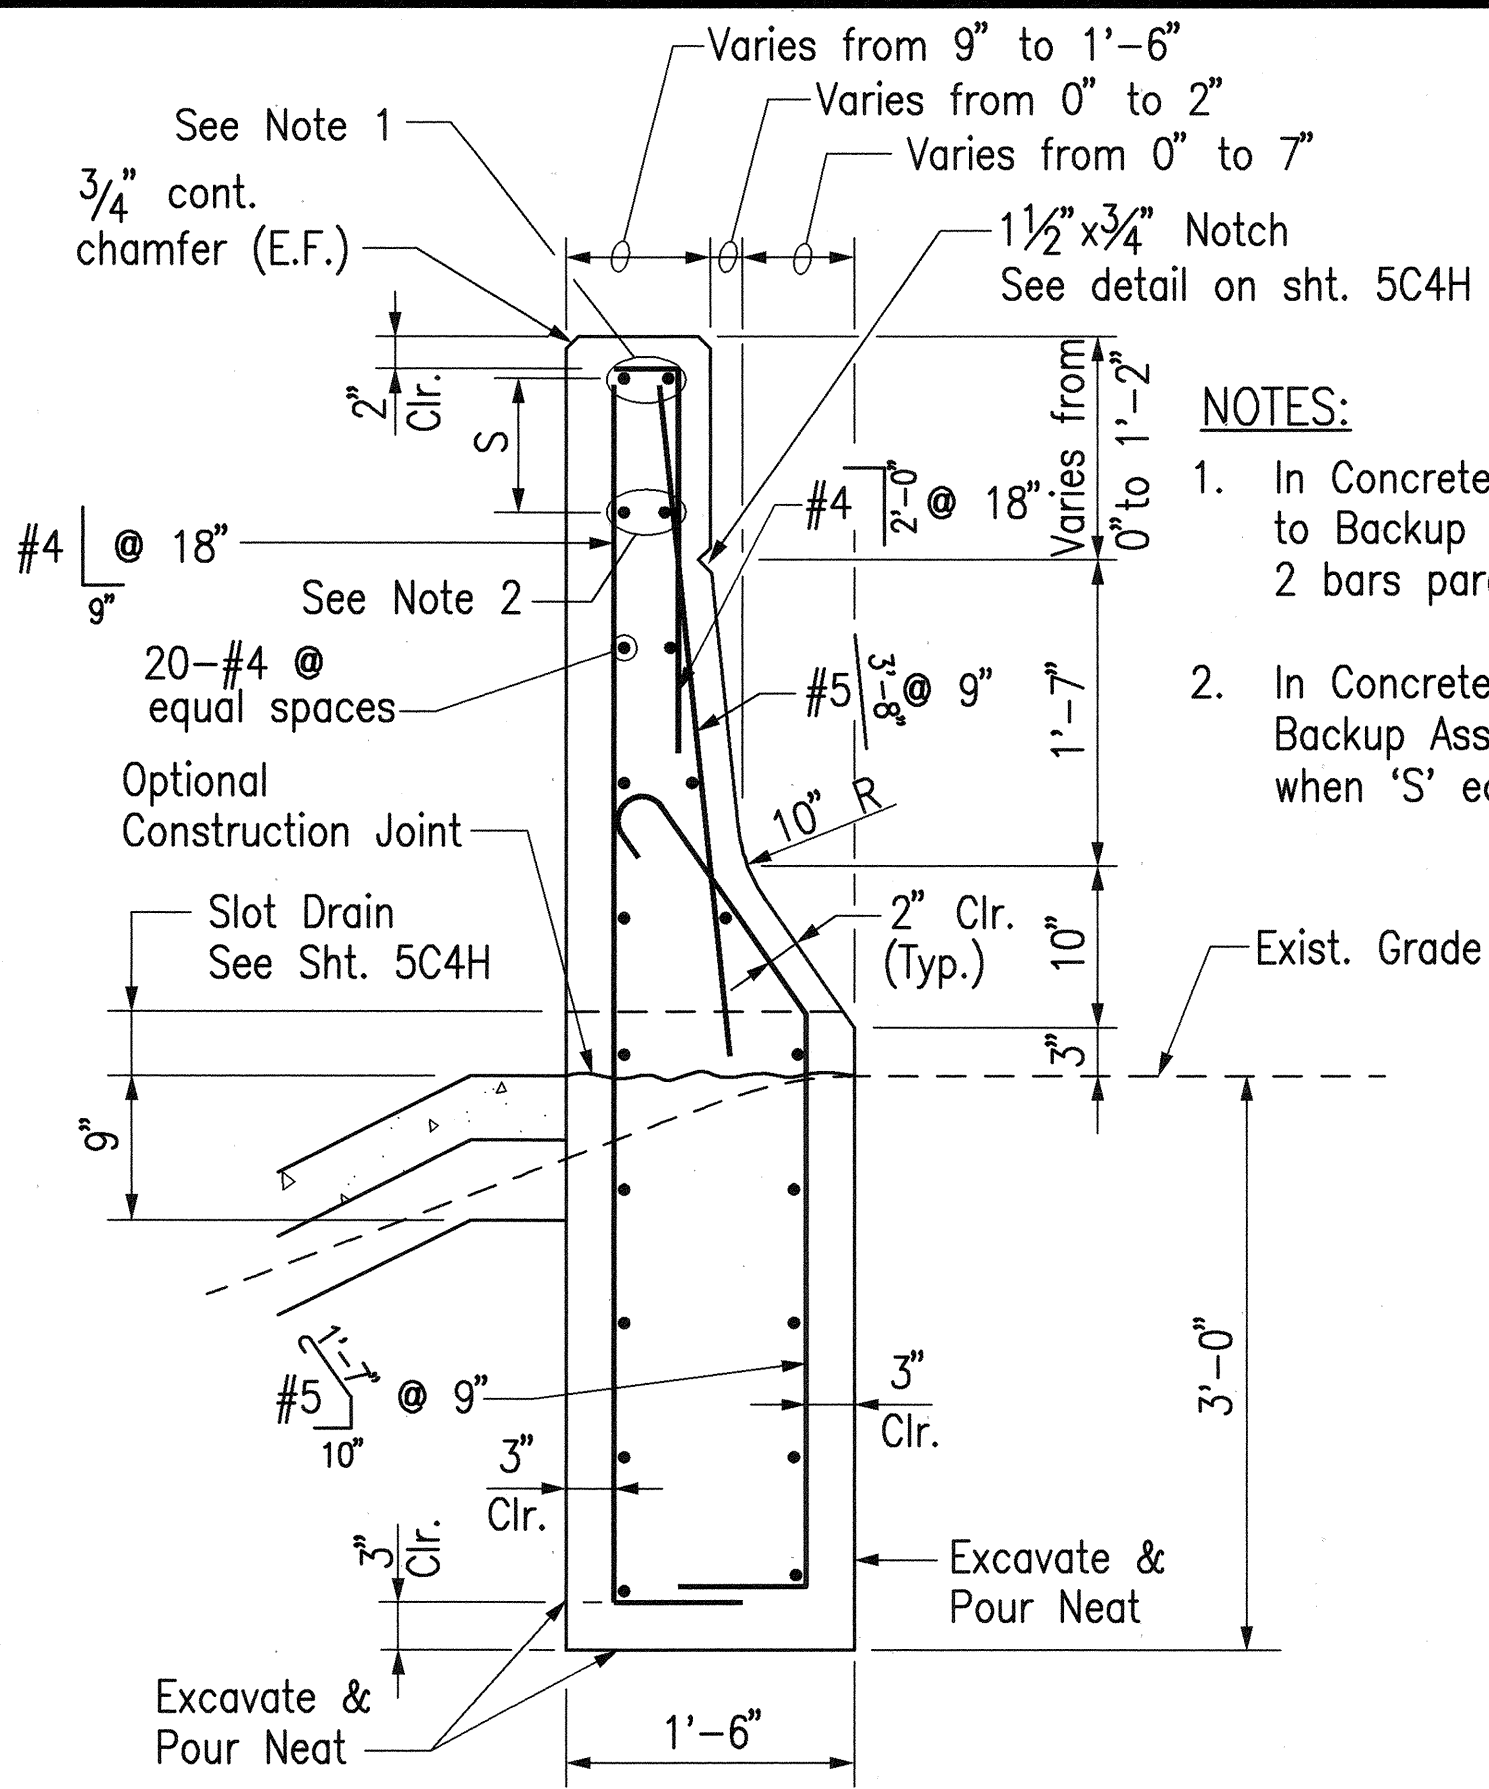

NOTES:


1. In Concrete Guardrail Transition to Backup Assembly run these 2 bars parallel to top of barrier.
2. In Concrete Guardrail Transition to Backup Assembly cut-off these 2 bars when 'S' equals 4".

SECTION 'C'
Scale: 1" = 1'-0"

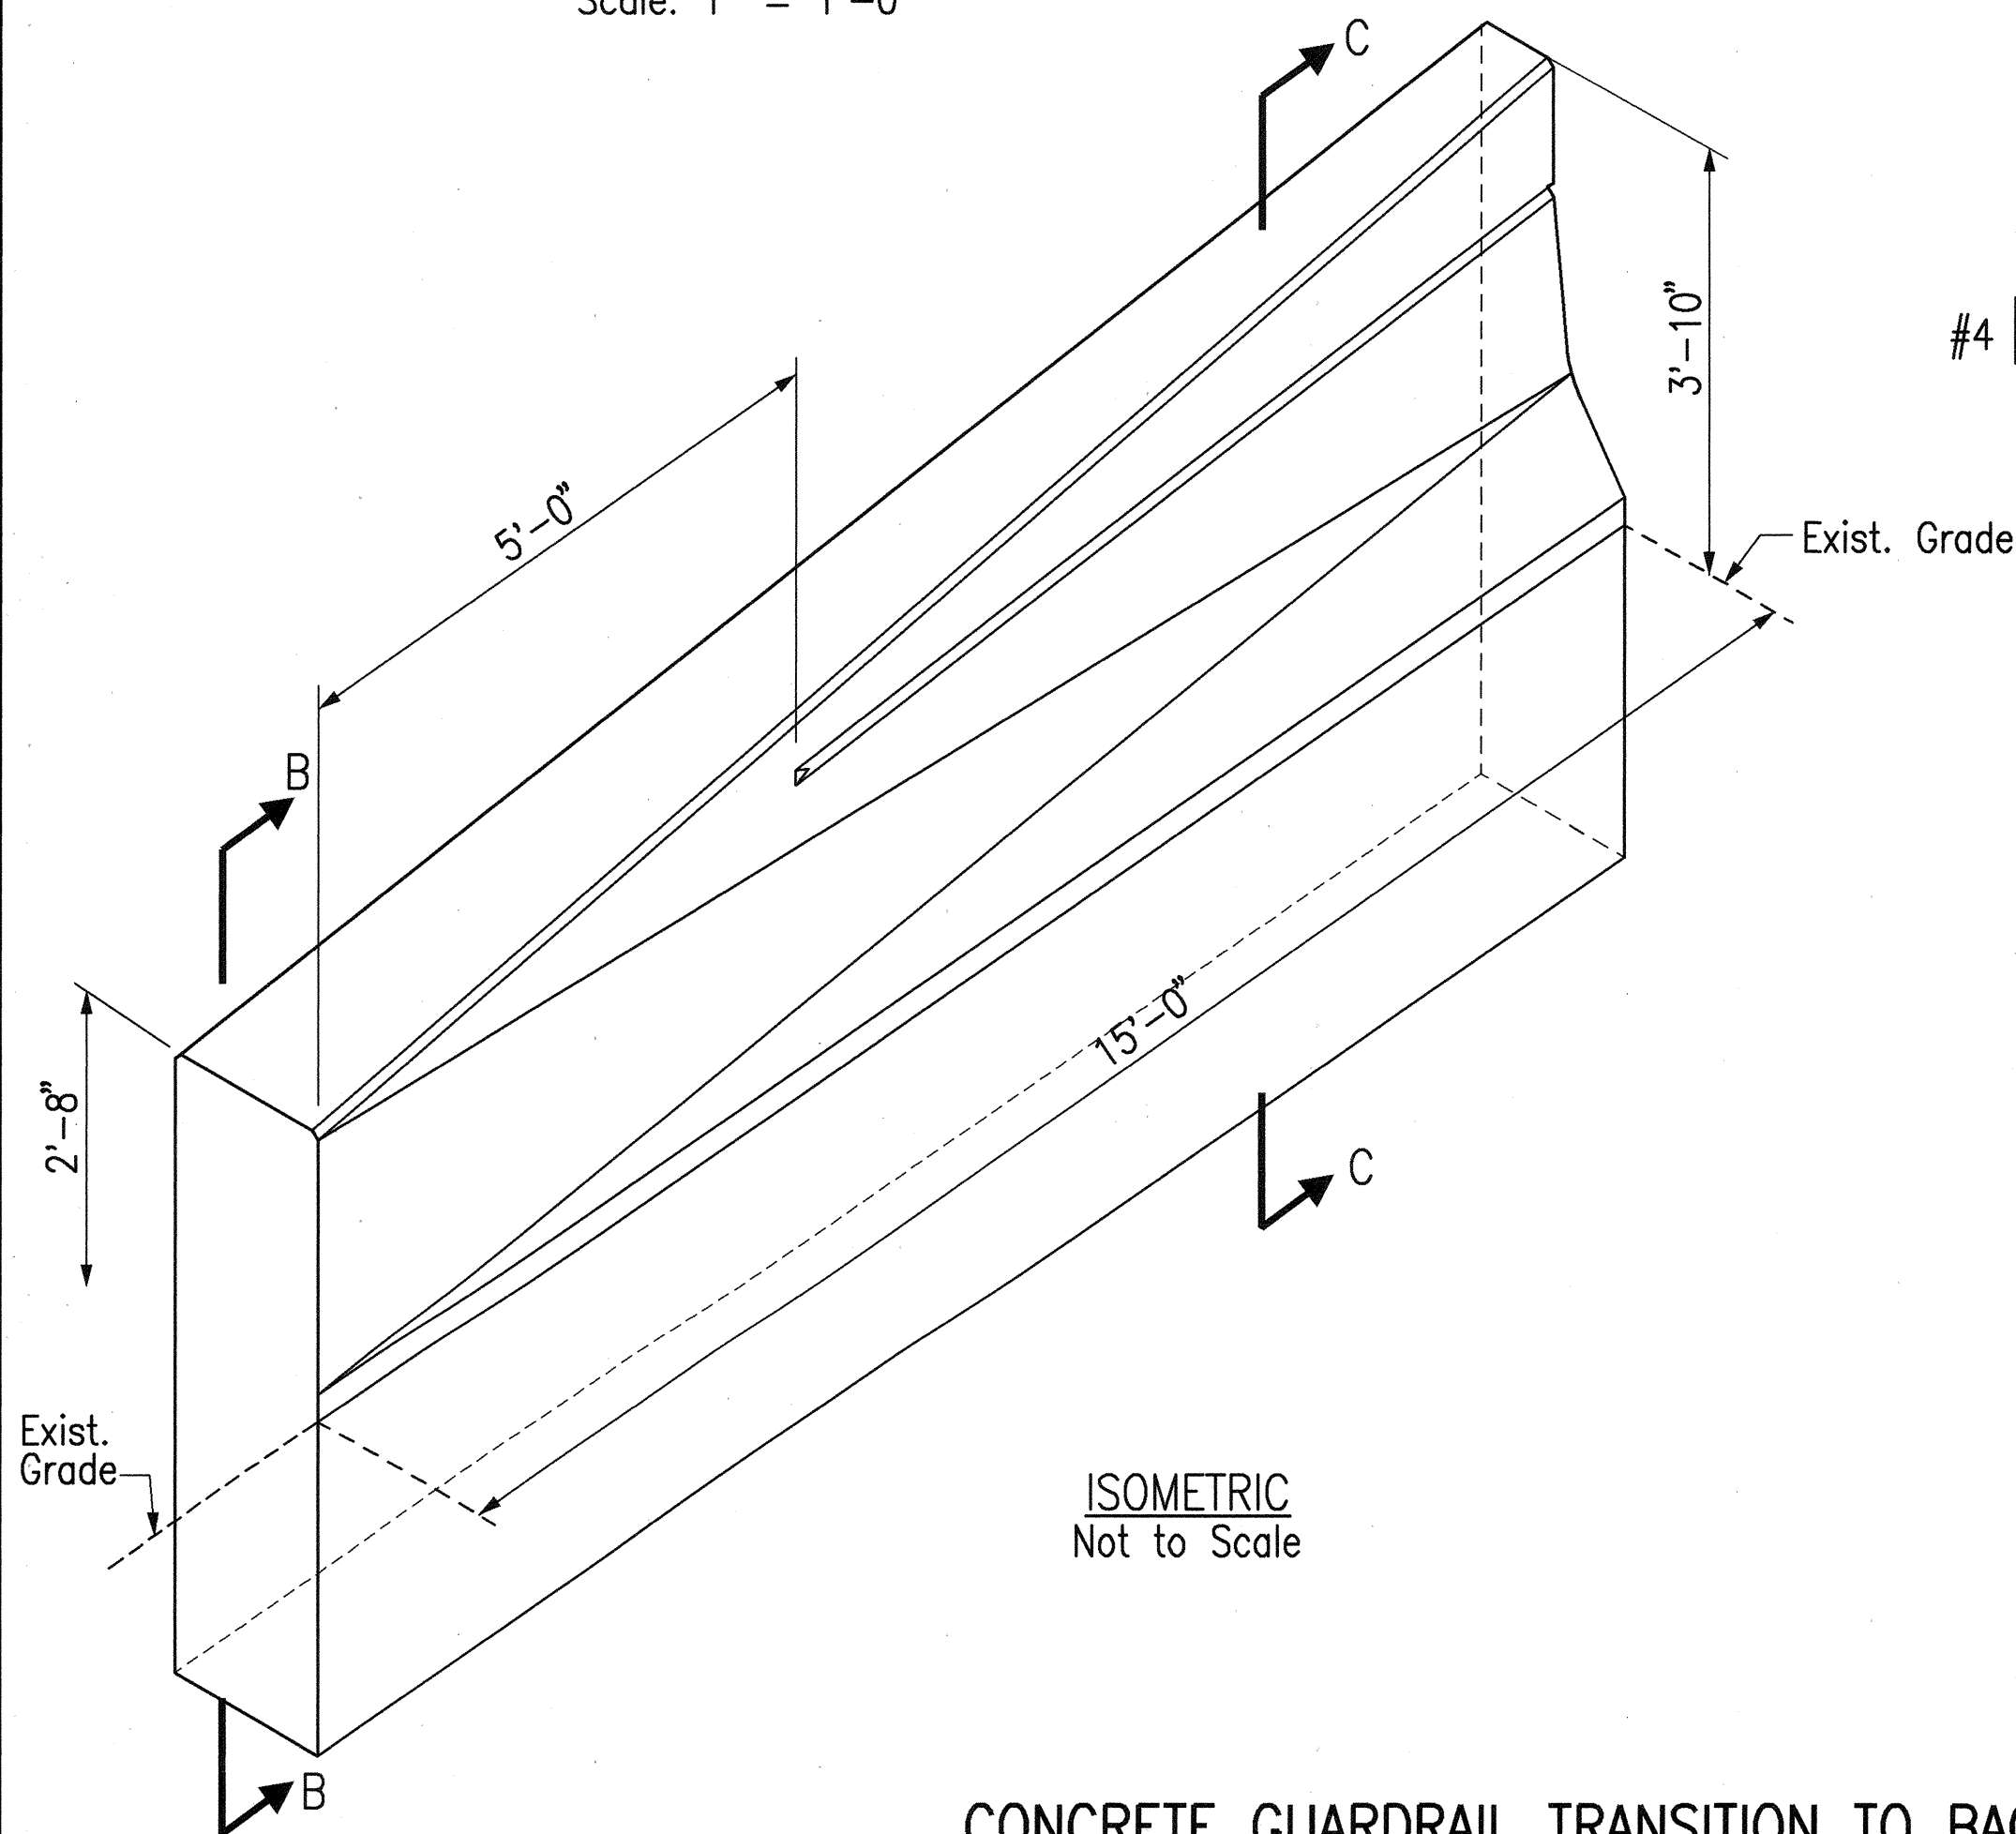


ISOMETRIC
Not to Scale

CONCRETE GUARDRAIL TRANSITION TO BACKUP ASSEMBLY

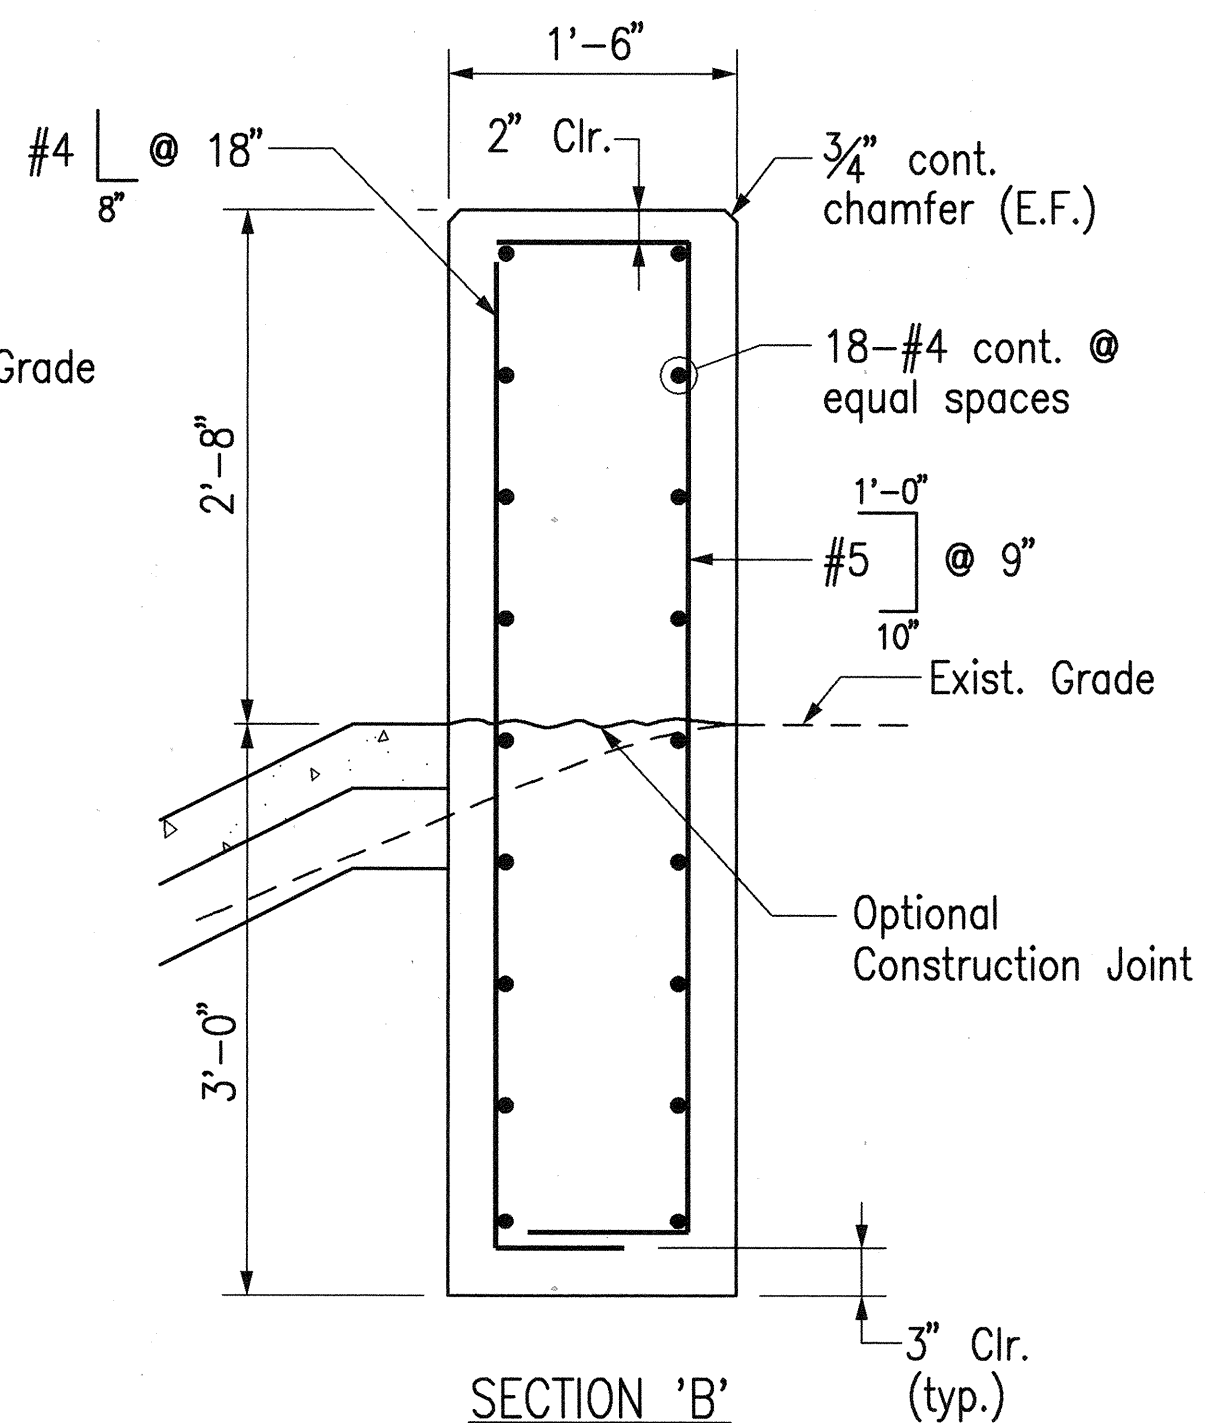


SECTION 'B'
Scale: 1" = 1'-0"

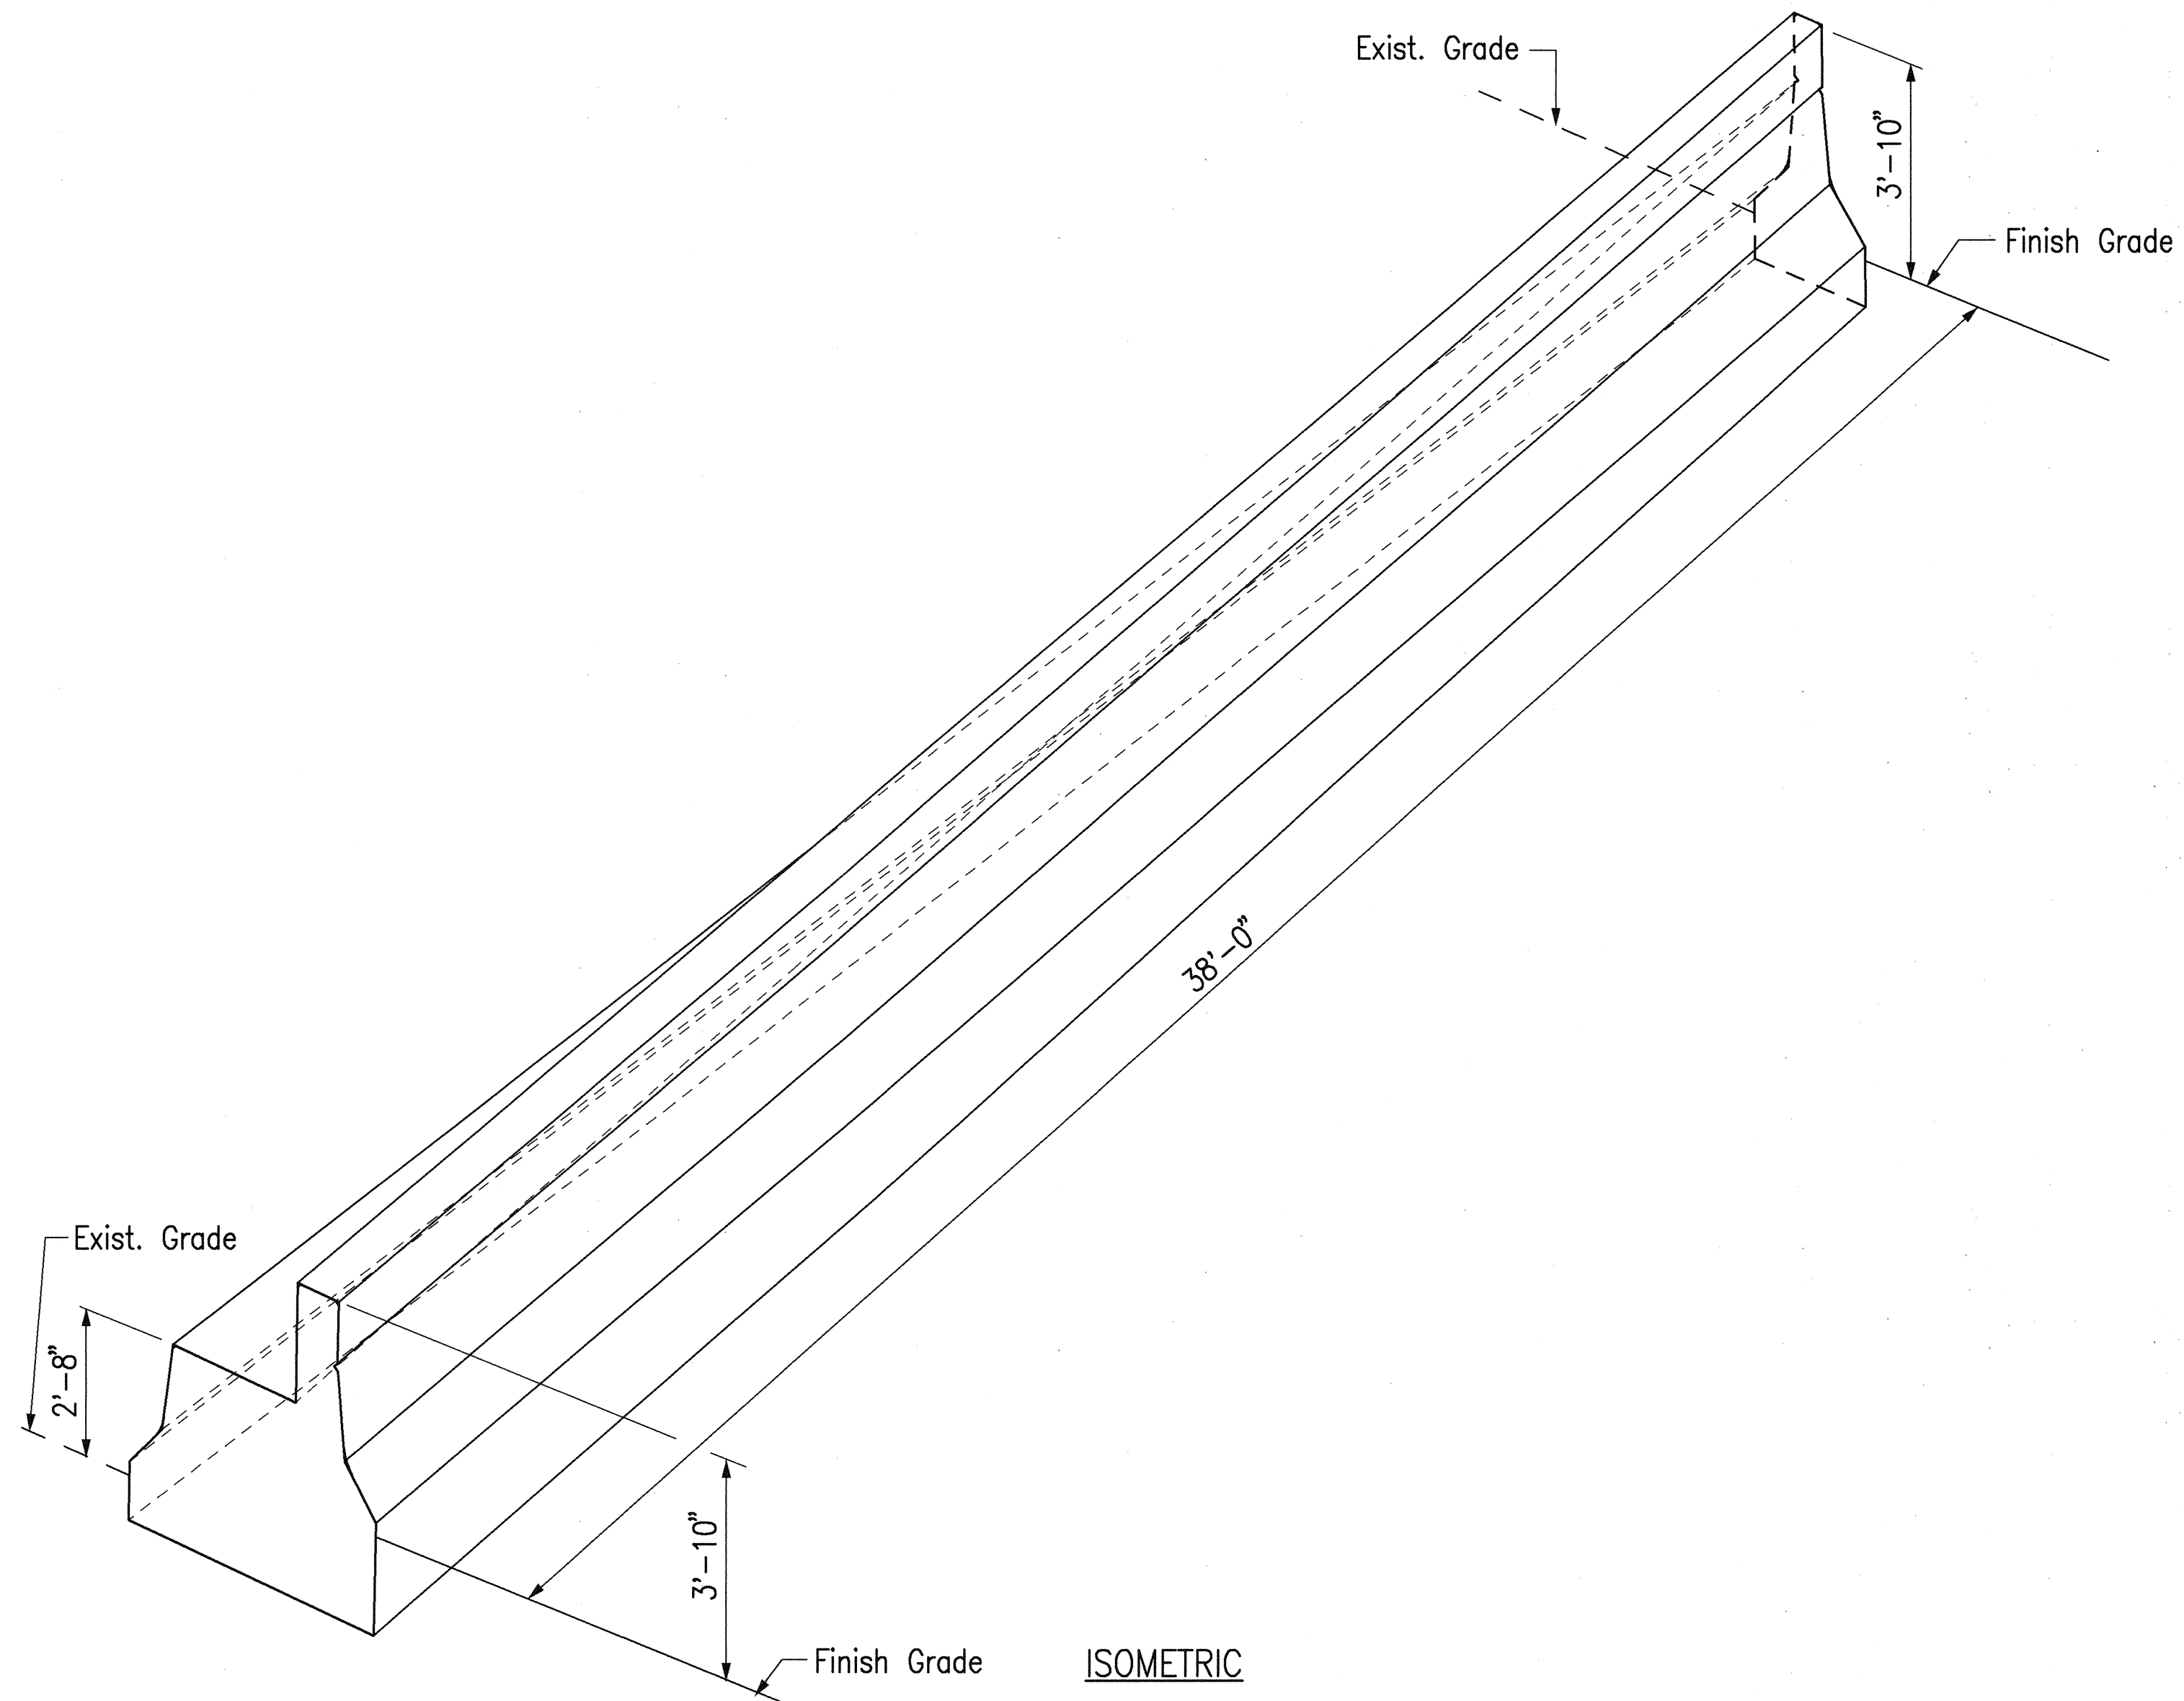


ISOMETRIC

CONCRETE GUARDRAIL TRANSITION
Not to Scale

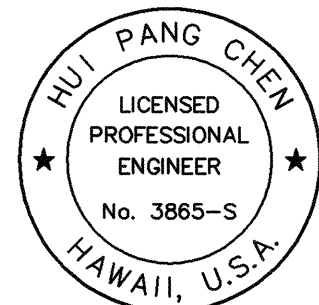

THIS WORK WAS PREPARED BY ME
OR UNDER MY SUPERVISION.

Hui Pang Chen

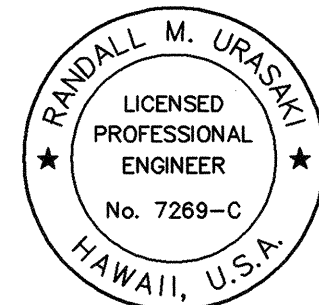

THIS WORK WAS PREPARED BY ME
OR UNDER MY SUPERVISION.

Randall M. Urashki





10/14/97	Added Sheet
Date	Revision
STATE OF HAWAII DEPARTMENT OF TRANSPORTATION HIGHWAYS DIVISION	
WINDWARD	
ROADWAY CONSTRUCTION	
DETAILS	
H-3 FINISH (UNIT II)	
FAIP NO. I-H3-1(75), UNIT II	
LEEWARD SECTION	
SCALE: AS SHOWN	DATE: OCTOBER 1997
SHEET NO. 5C4I OF 4 SHEETS	

C.O. 837S-9

ORIGINAL PLAN	SURVEY PLOTTED BY	DATE
NOTE BOOK	DRAWN BY	
	TRACED BY	
	DESIGNED BY	
	CHECKED BY	
	No.	

CD by J. Minura, 95-52




FED. ROAD DIST. NO.	STATE	FED. AID PROJ. NO.	FISCAL YEAR	SHEET NO.	TOTAL SHEETS
HAWAII	HAW.	I-H3-1(75), UNIT II	1997	C.O. 837S-11	1102

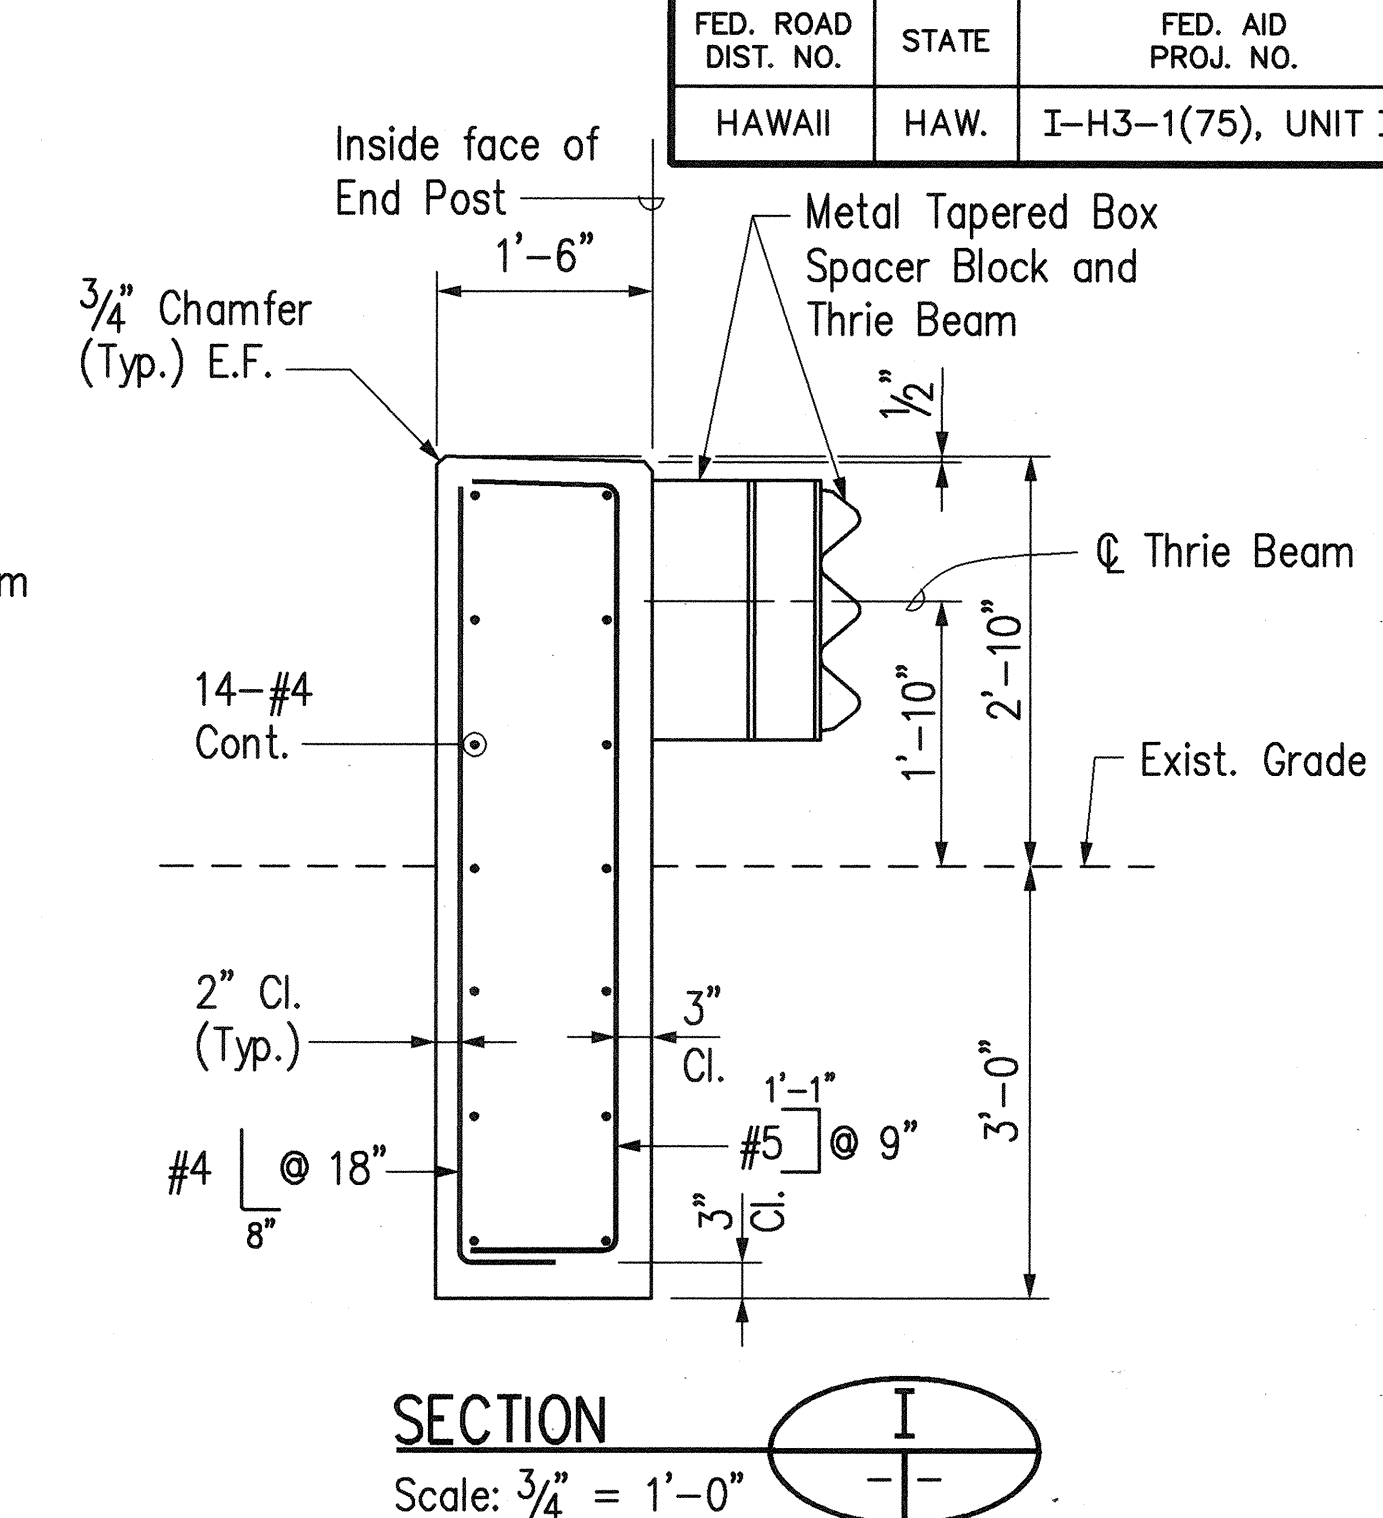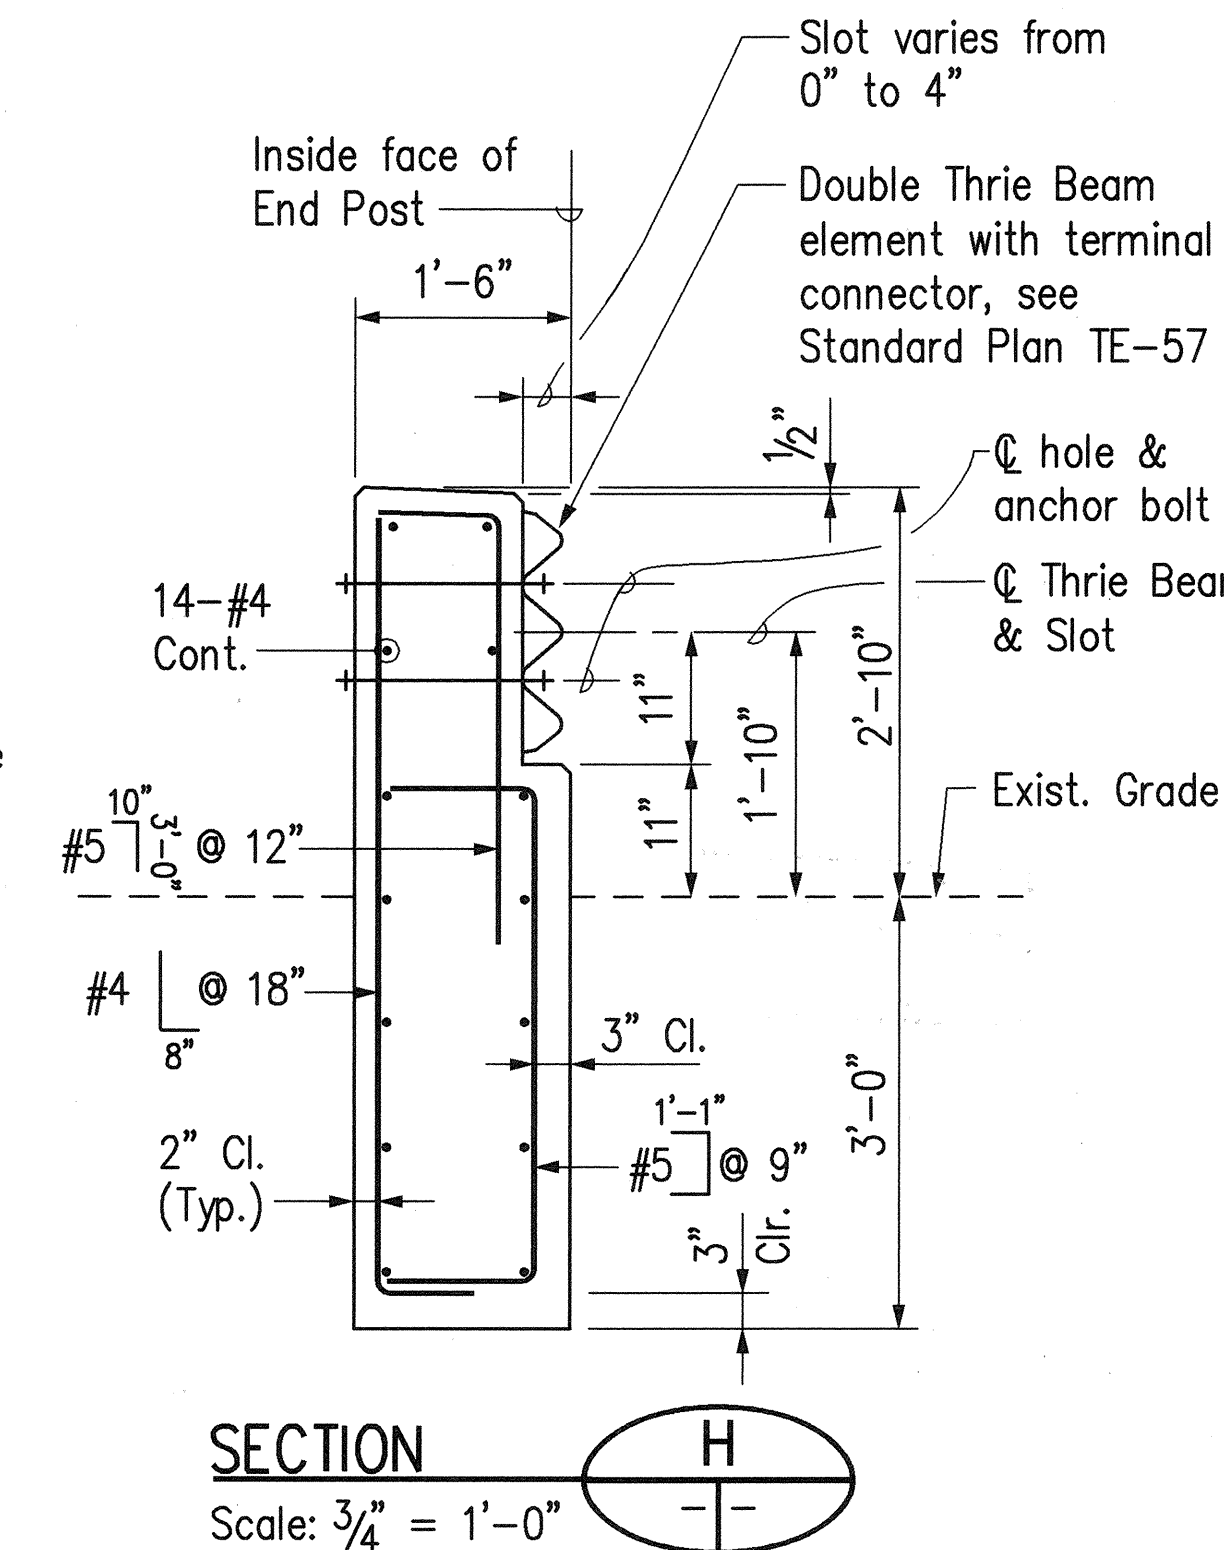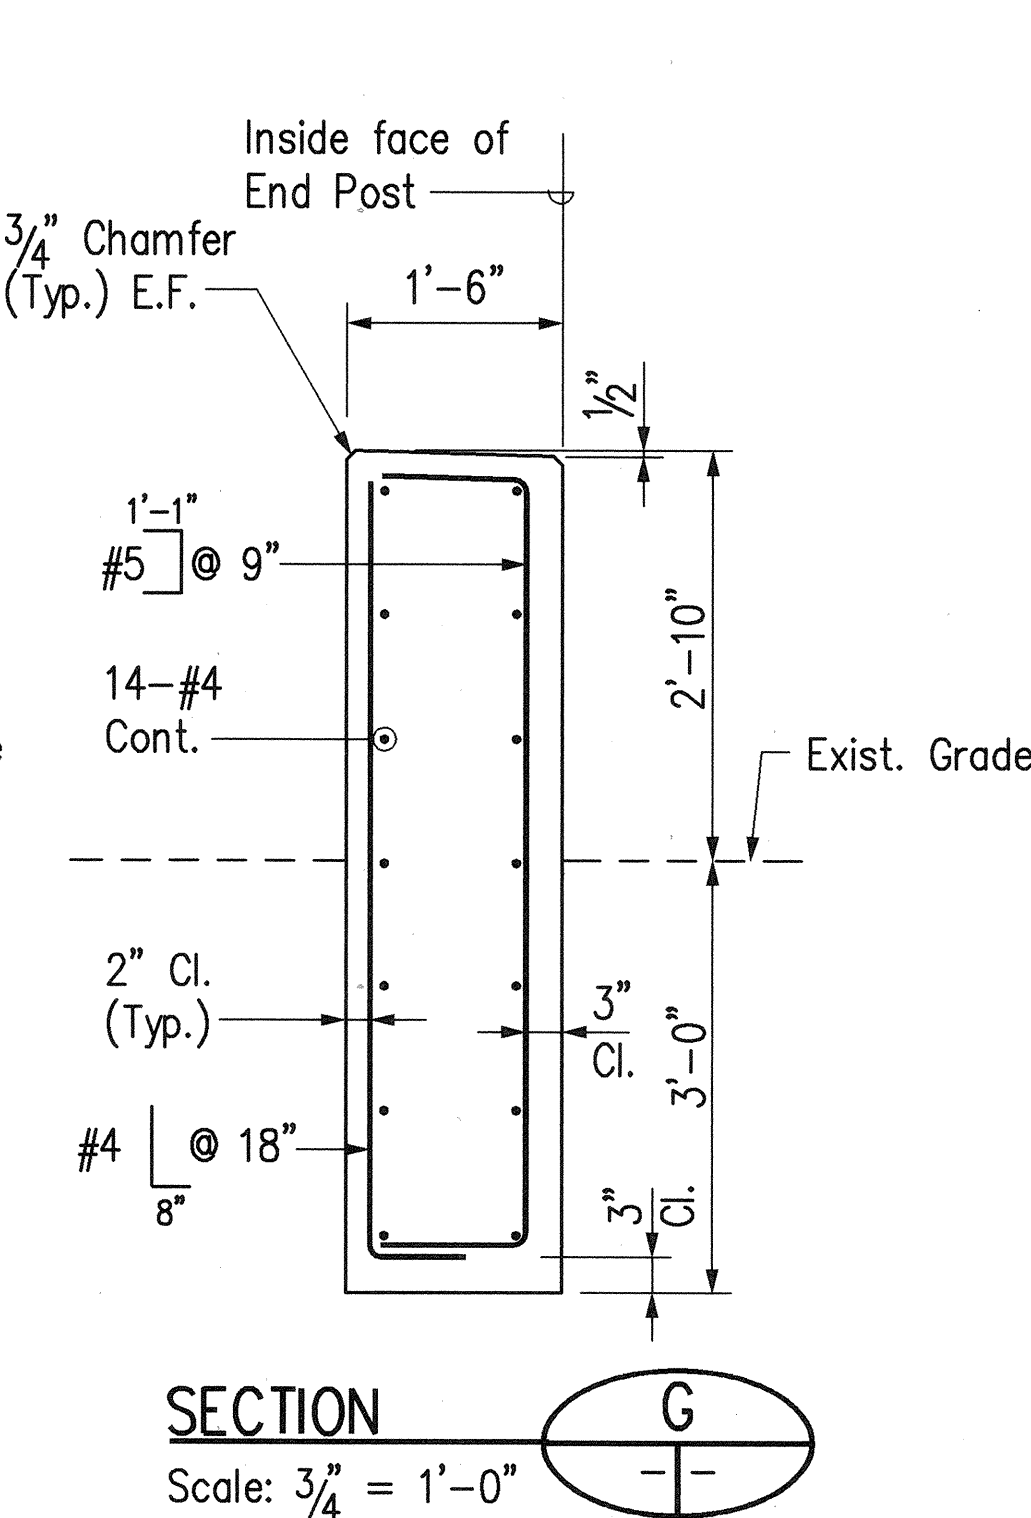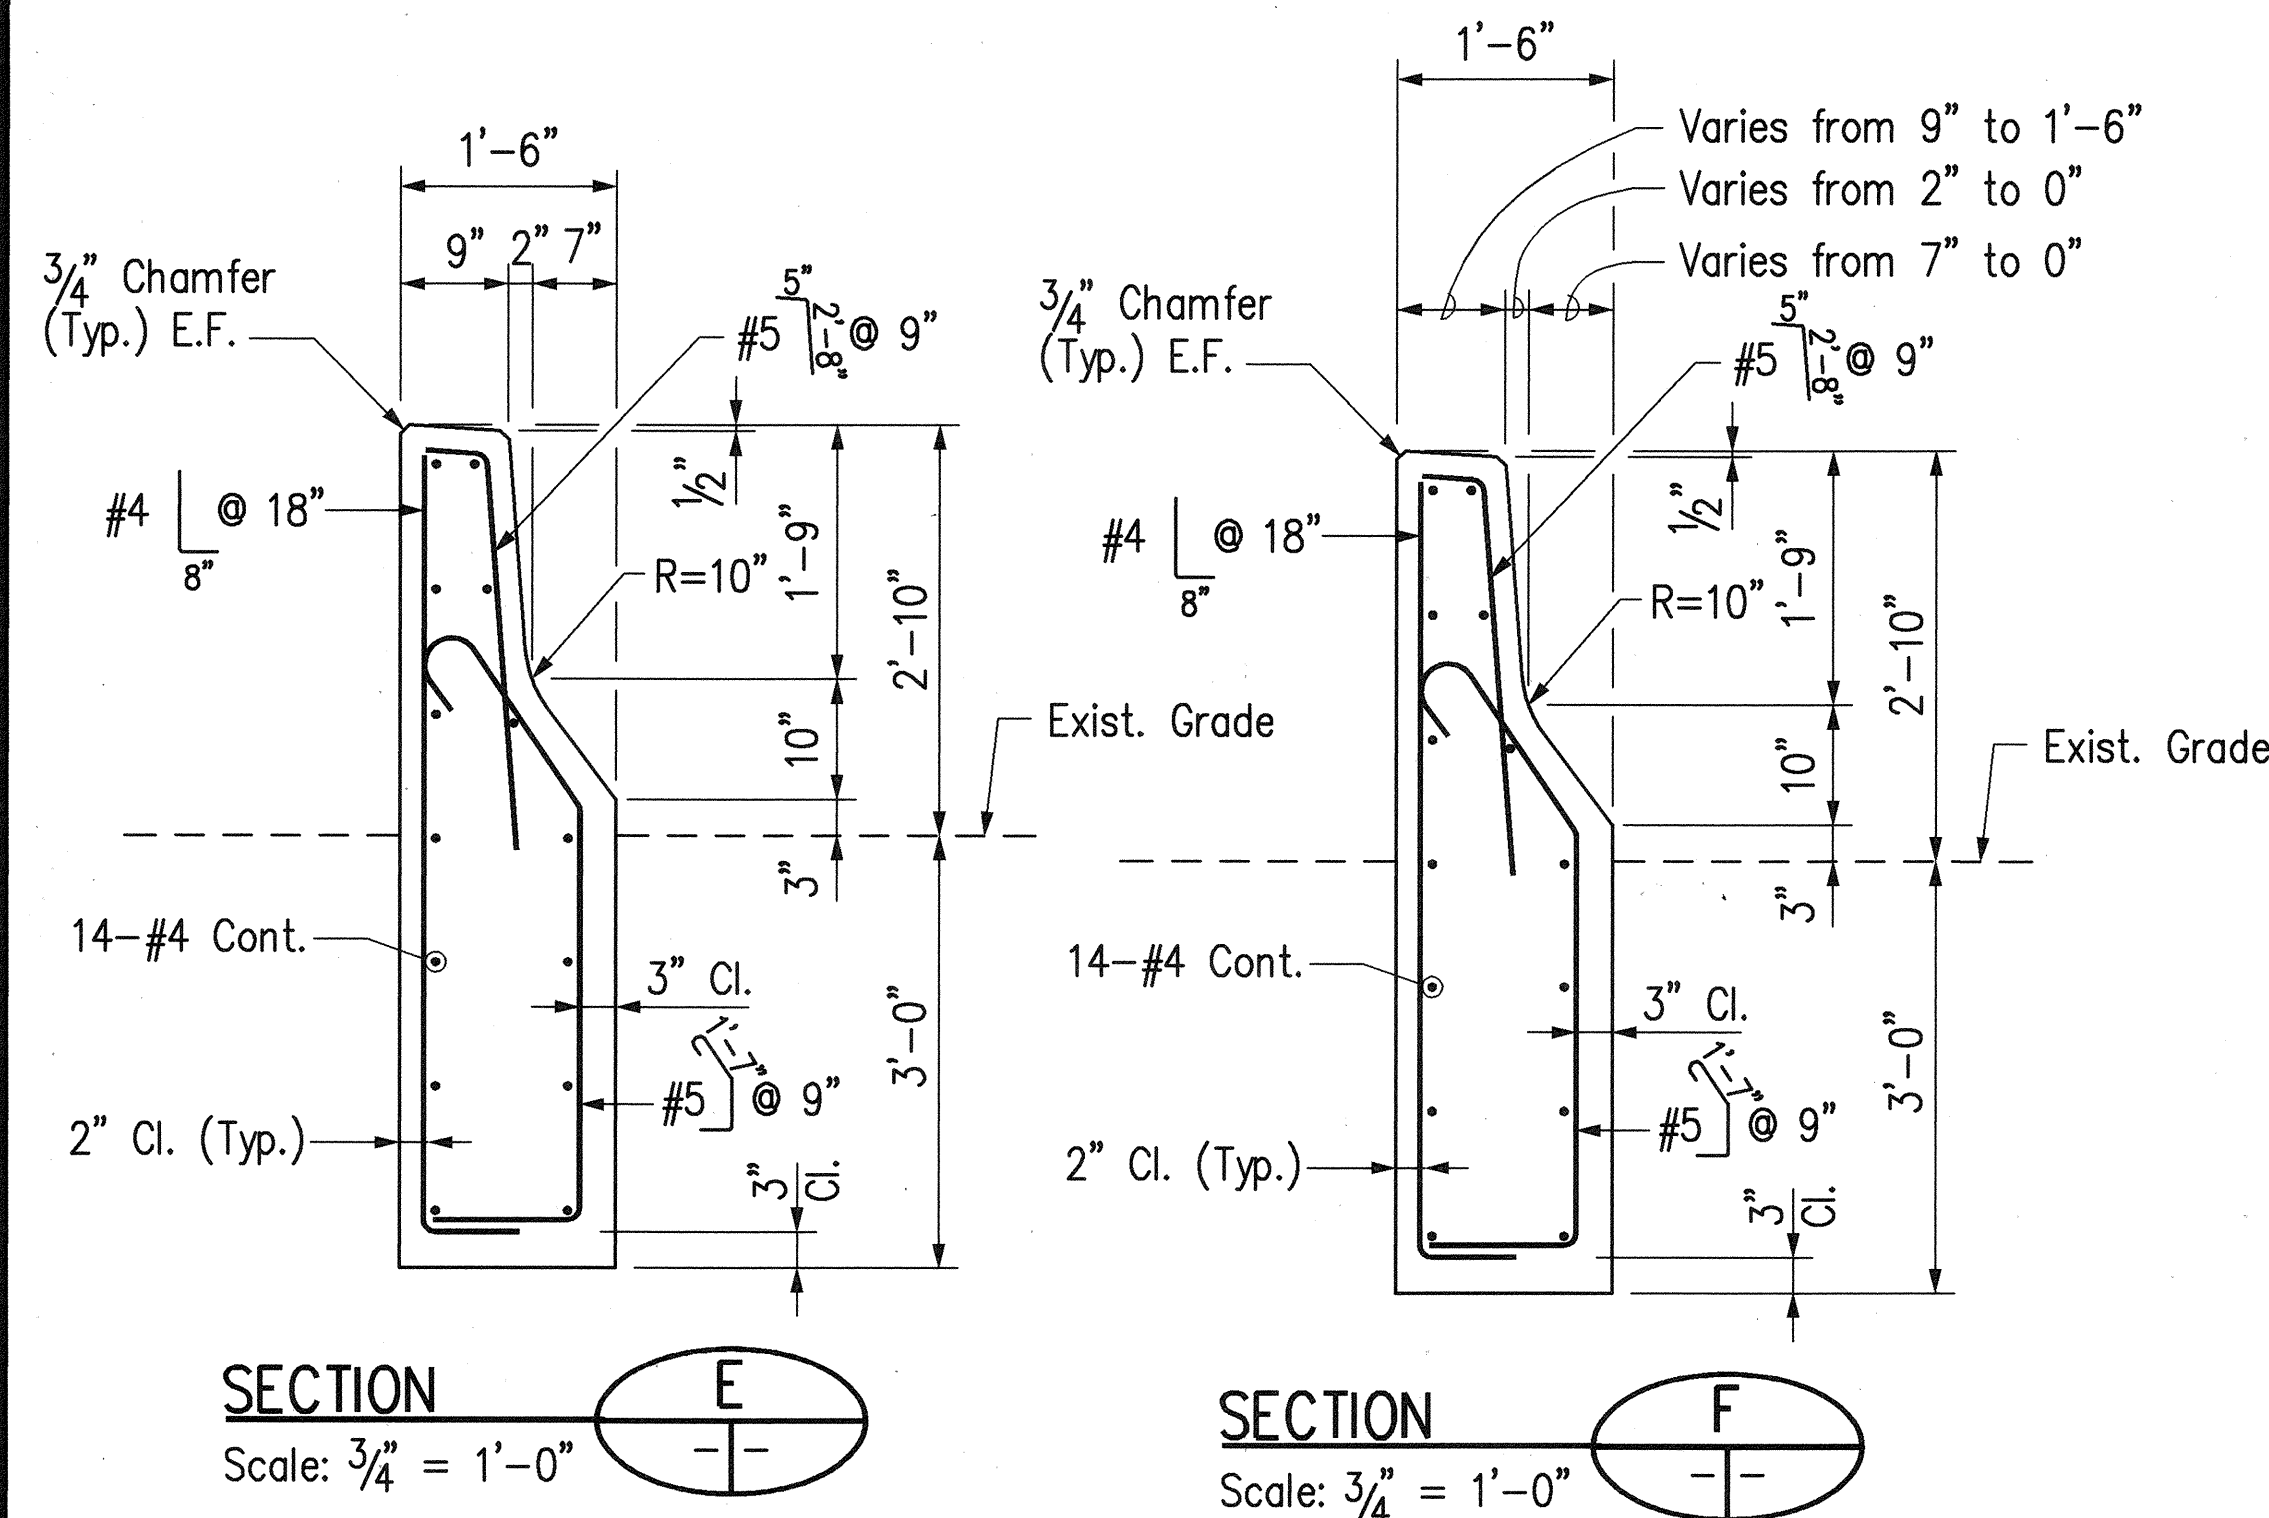

Metal guardrail connection ref. line & $\varnothing 2-3/4''$ holes for $5/8''$ H.S. anchor bolts w/ bevel cap Pl., nut & washer.

$\varnothing 5-1''$ holes for $7/8''$ H.S. anchor bolts w/ bevel cap Pl., nut & washer. See thrie beam Terminal Connector details on Standard Plan TE-57 for spacing.

CURVE DATA:
(Inside face)
 $\Delta = 40^\circ-06'-25''$
 $R = 10'-0''$
 $L = 7'-0''$

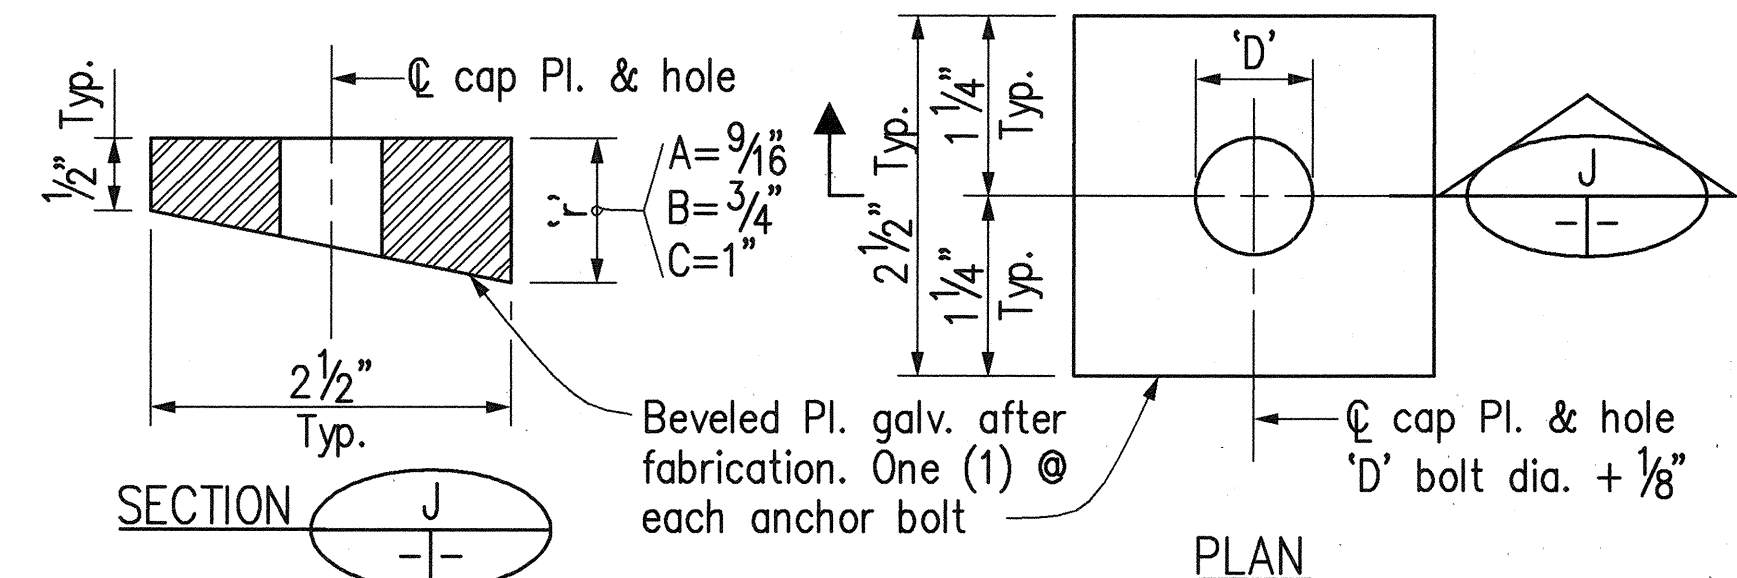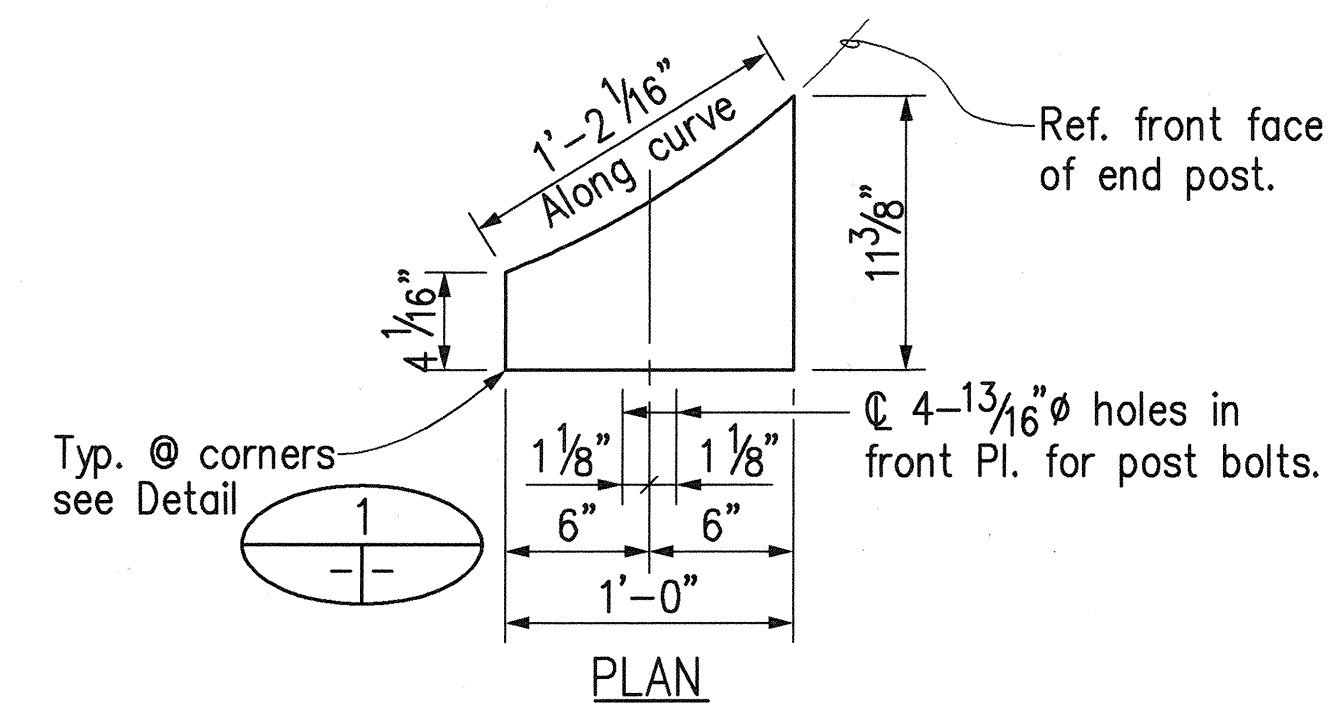
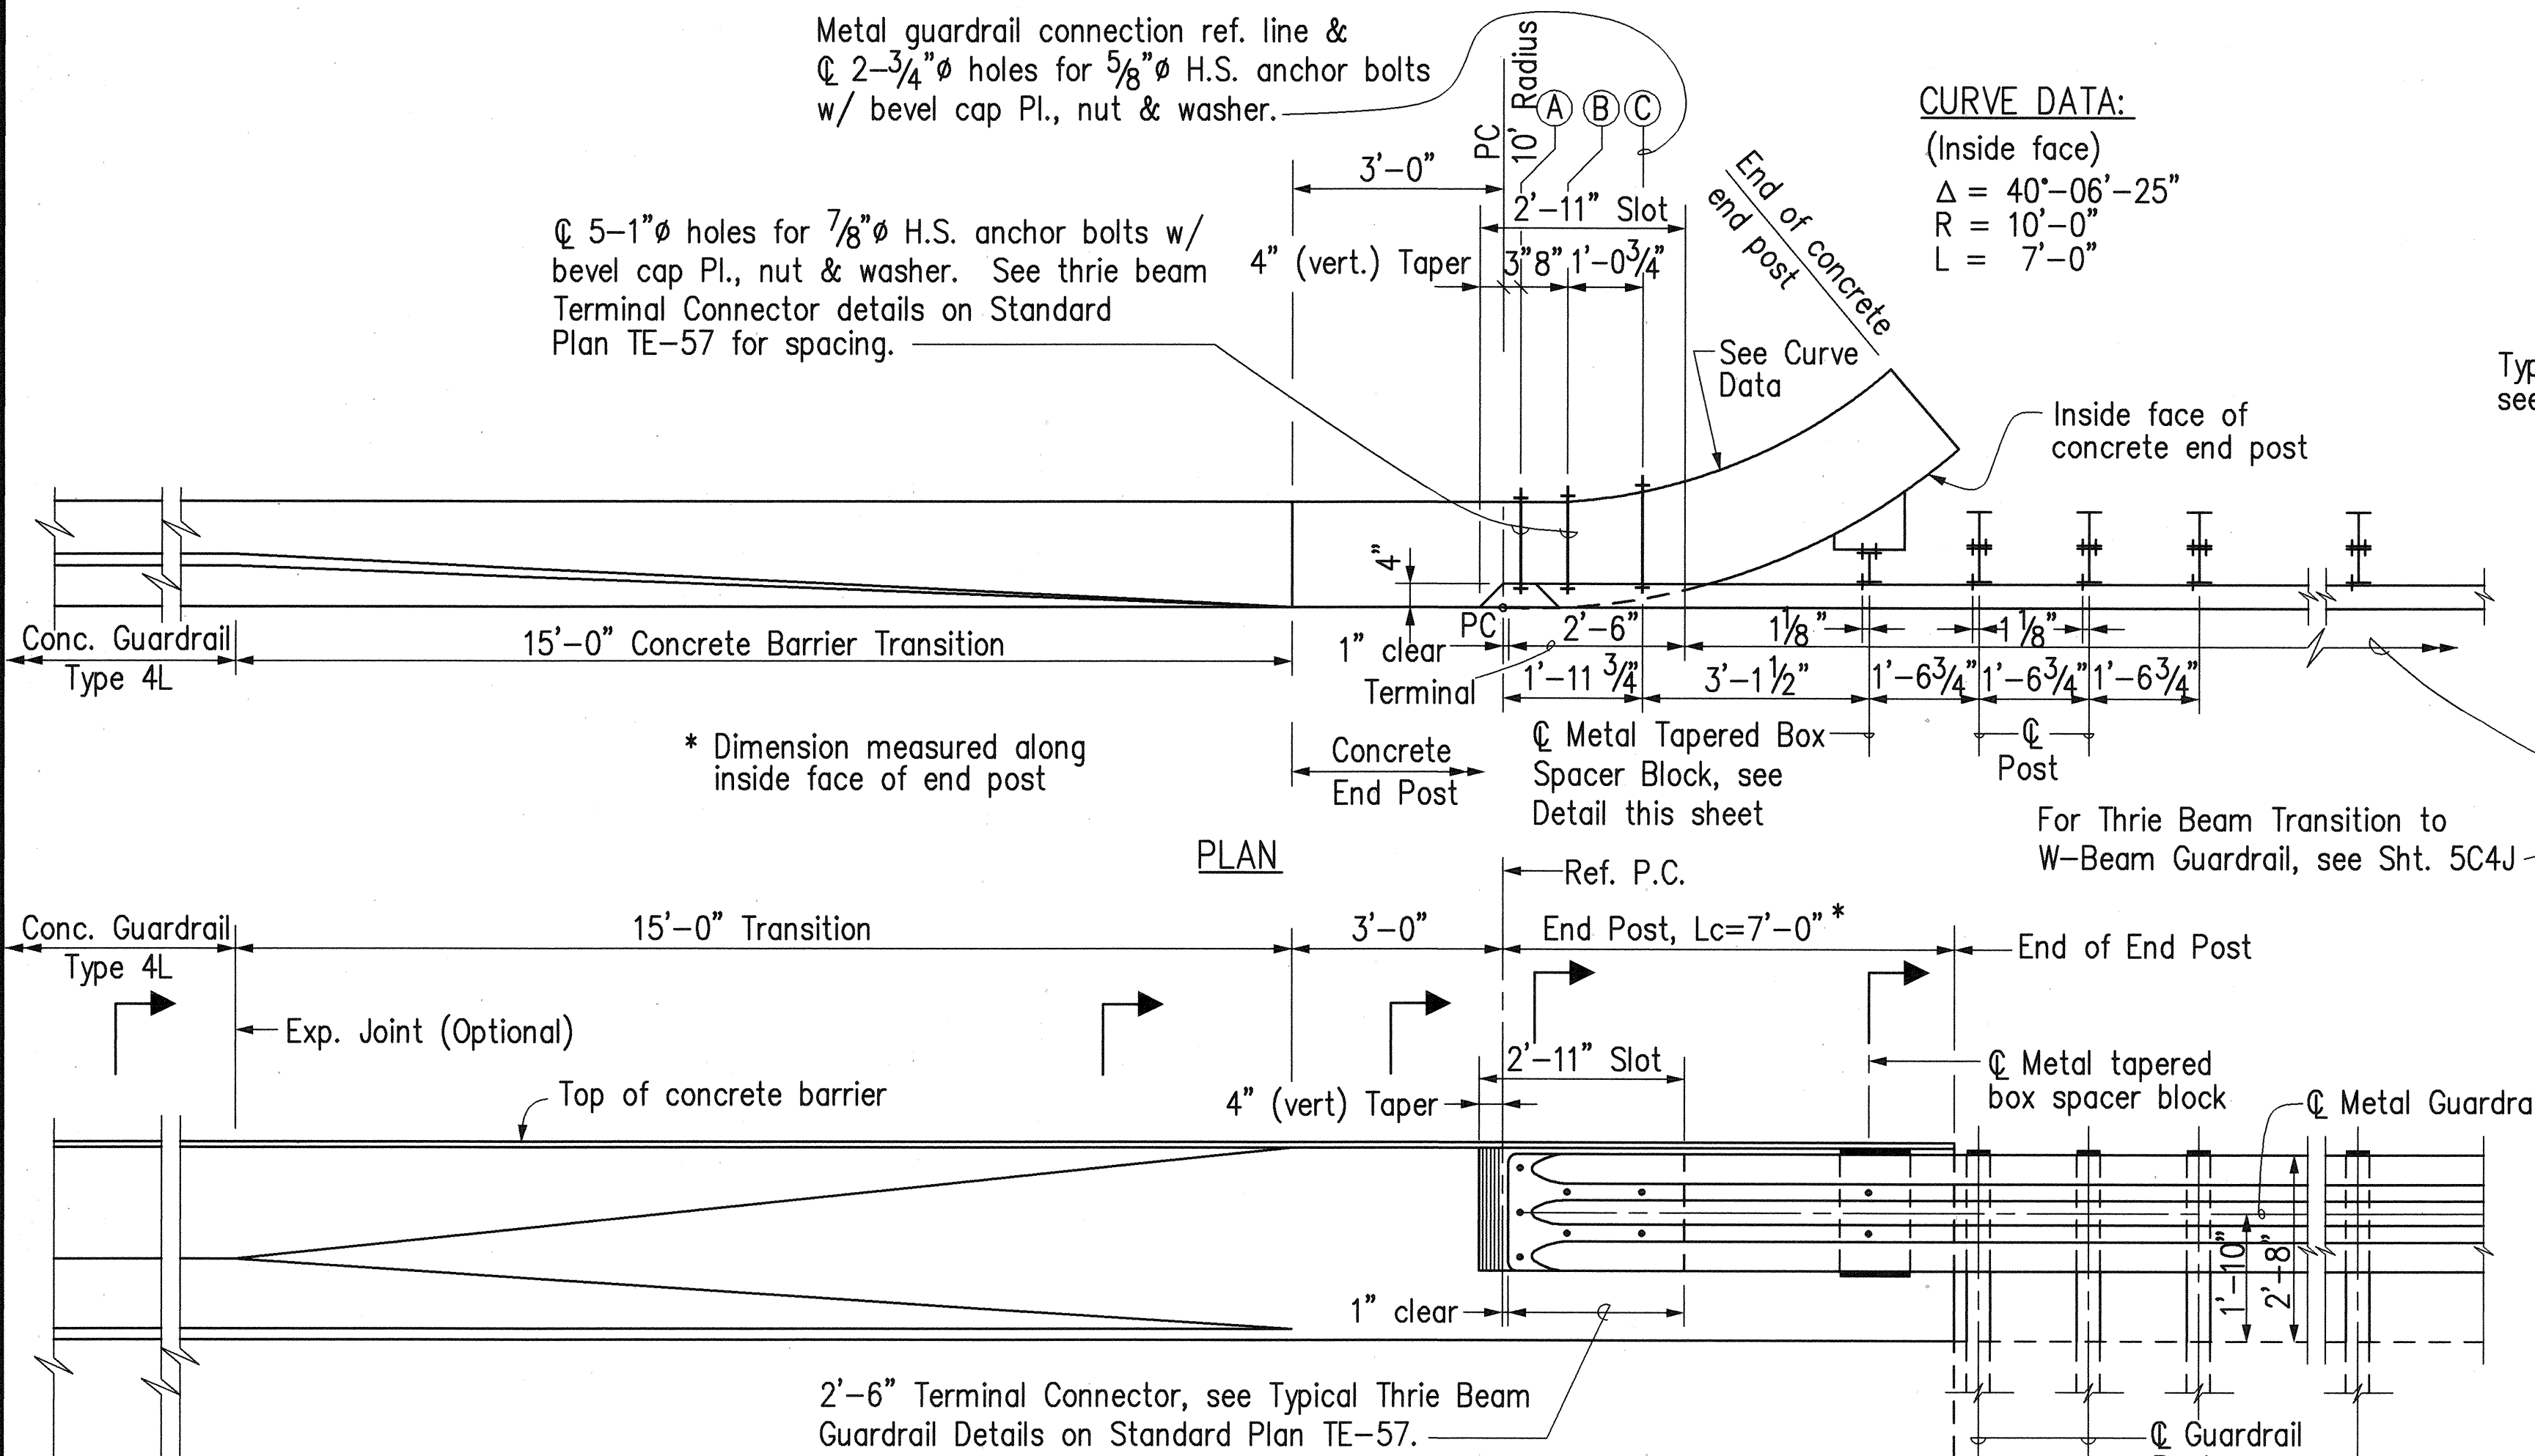


CAP (BEARING) PLATE DETAIL

Scale: $\frac{3}{4}'' = 1''$

NOTES:


- All reinforcing shall be ASTM A615 Grade 60.
- Cap Plate and tapered box spacer block shall be fabricated from ASTM A36 steel and hot-dip galvanized after fabrication.
- Cap Plates, tapered box spacer block, anchor bolts including nuts and washers and other appurtenances shall be incidental to concrete railing and will not be paid for separately.
- All anchor bolts shall be high strength conforming to the requirements of ASTM A325 and shall be galvanized.

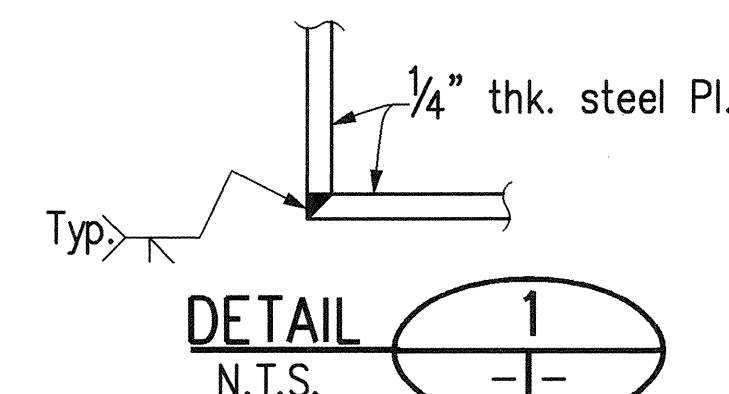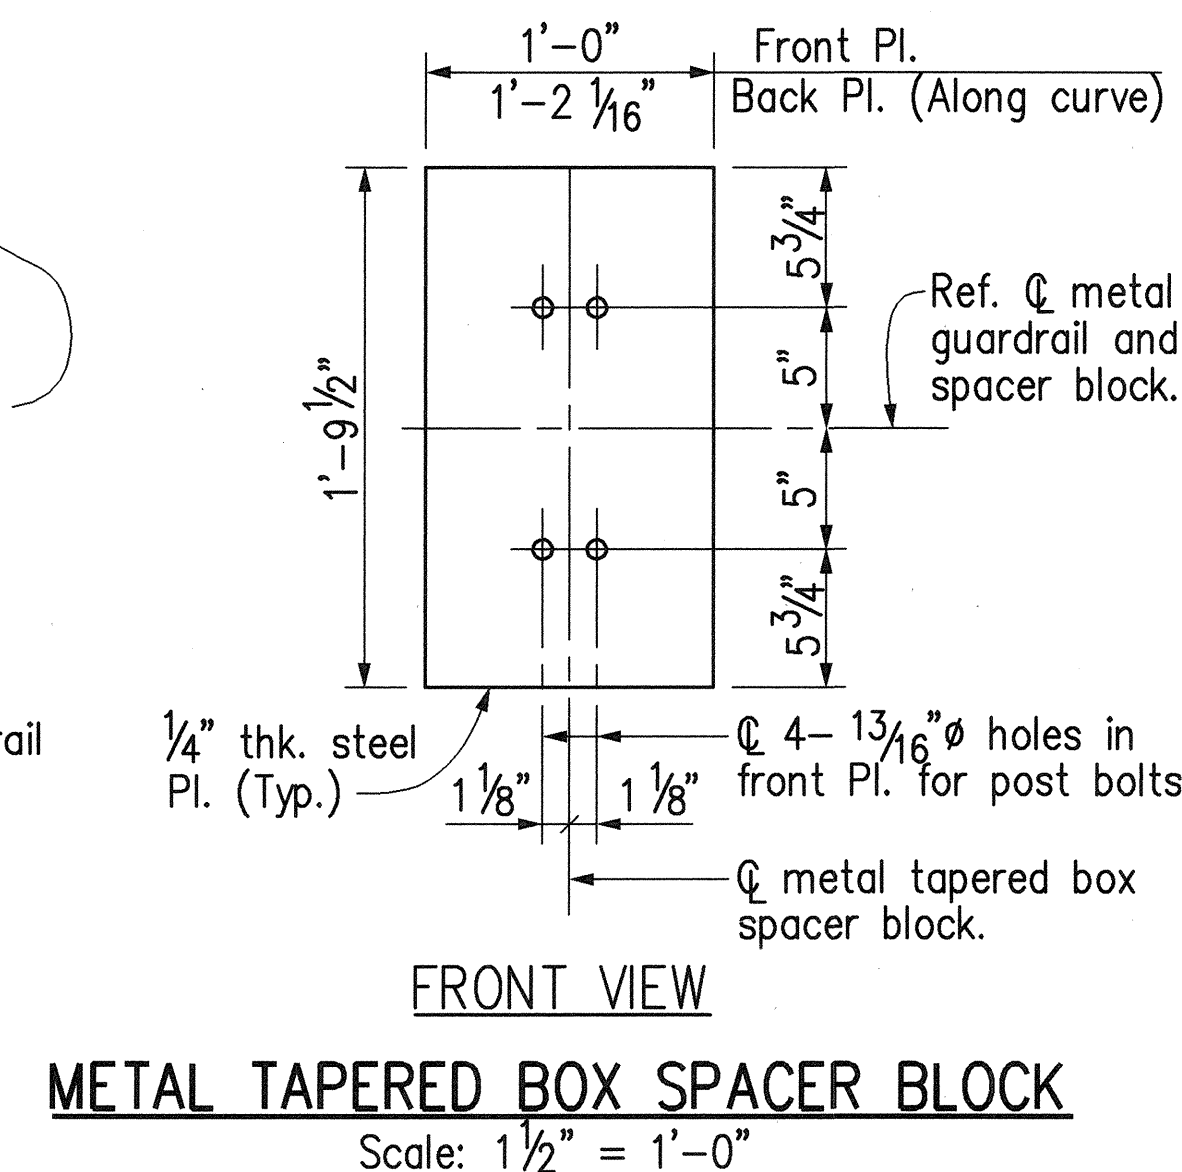

ELEVATION

BARRIER END POST AND TRANSITION

Scale: $\frac{1}{2}'' = 1'-0''$

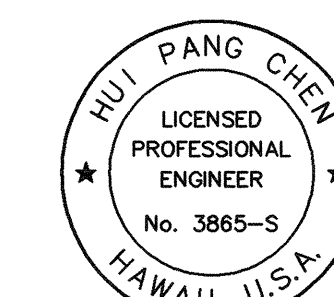

THIS WORK WAS PREPARED BY ME OR UNDER MY SUPERVISION.

Rui Pang Chen








10/14/97	Added Sheet
Date	Revision
STATE OF HAWAII DEPARTMENT OF TRANSPORTATION HIGHWAYS DIVISION	
WINDWARD	
ROADWAY CONSTRUCTION	
DETAILS	
H-3 FINISH (UNIT II) FAIP NO. I-H3-1(75), UNIT II LEEWARD SECTION	
SCALE: AS SHOWN	DATE: OCTOBER 1997
SHEET NO. 5C4K OF 4 SHEETS	

C.O. 837S-11

DATE
DRAWN BY
CHECKED BY
DESIGNED BY
QUANTITIES BY
No.




CAD by J. Minura, 55-32

FED. ROAD DIST. NO.	STATE	PROJ. NO.	FISCAL YEAR	SHEET NO.	TOTAL SHEETS
HAWAII	HAW.	1-H3-1(75) UNIT II	1997	838	1102

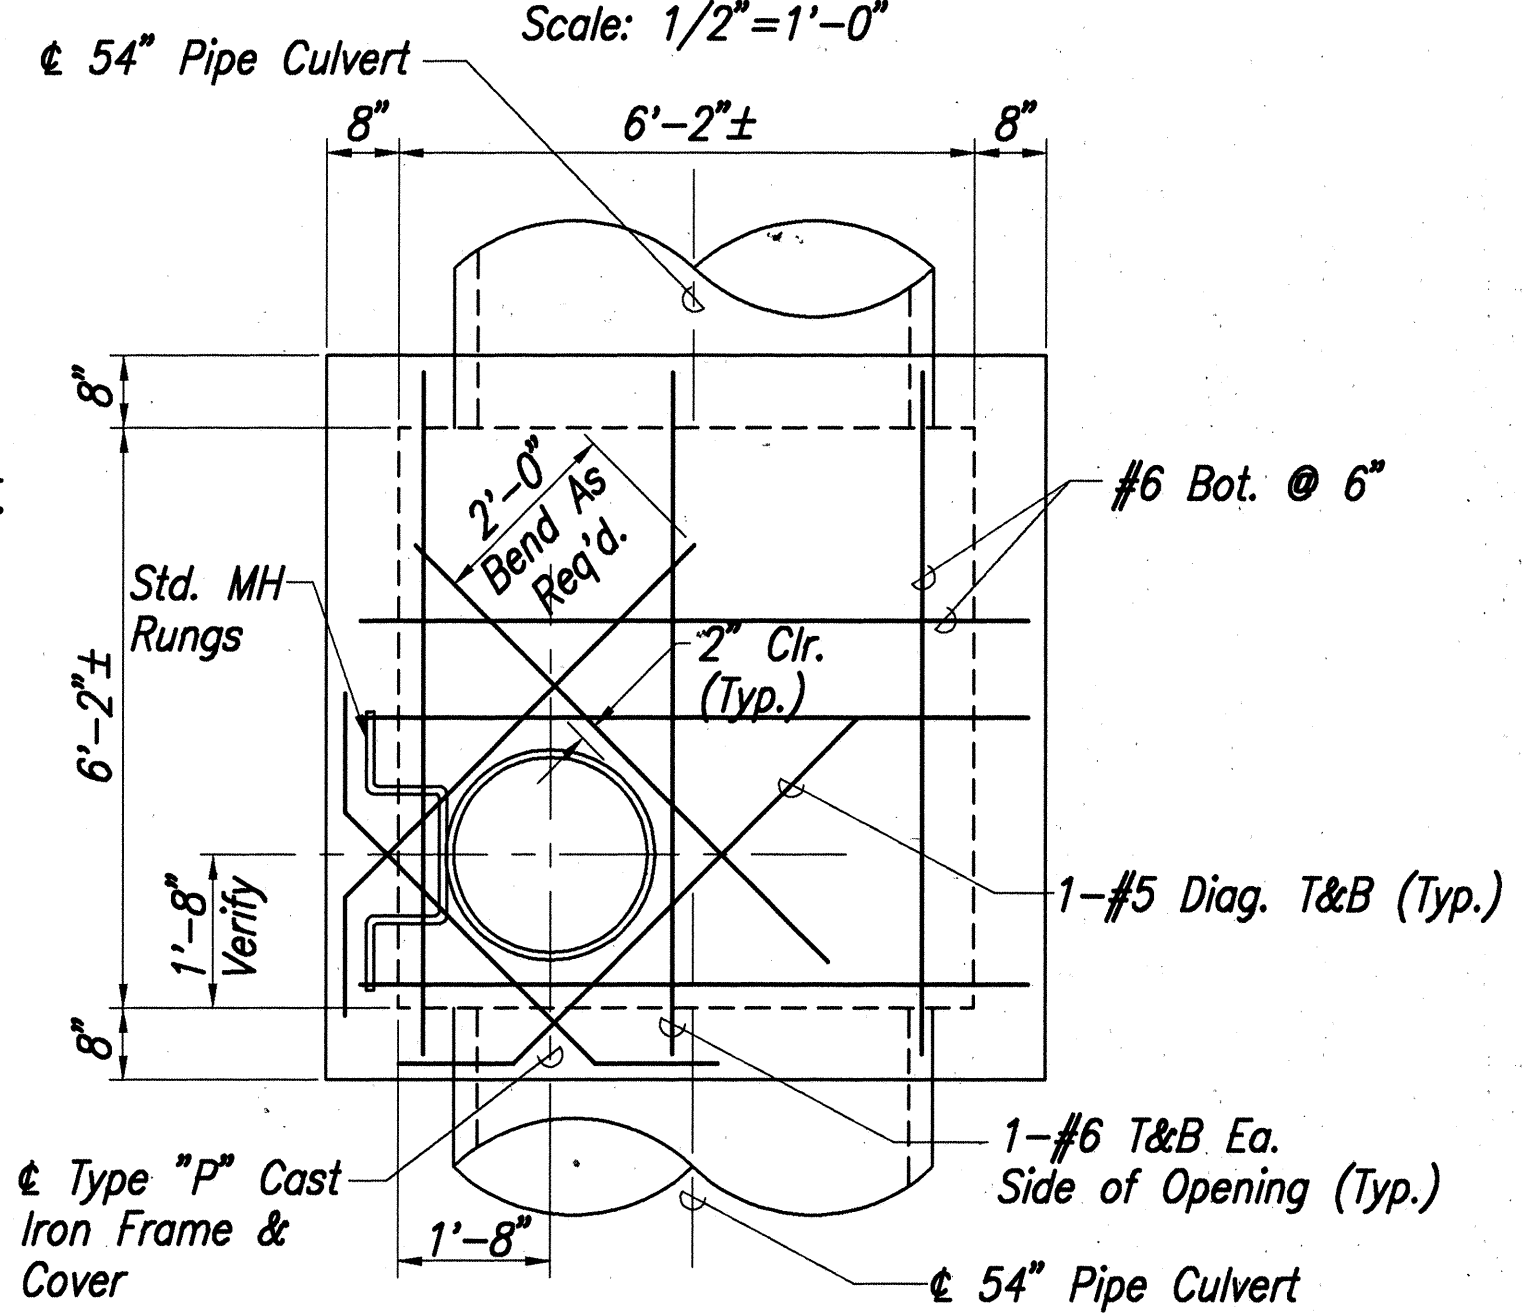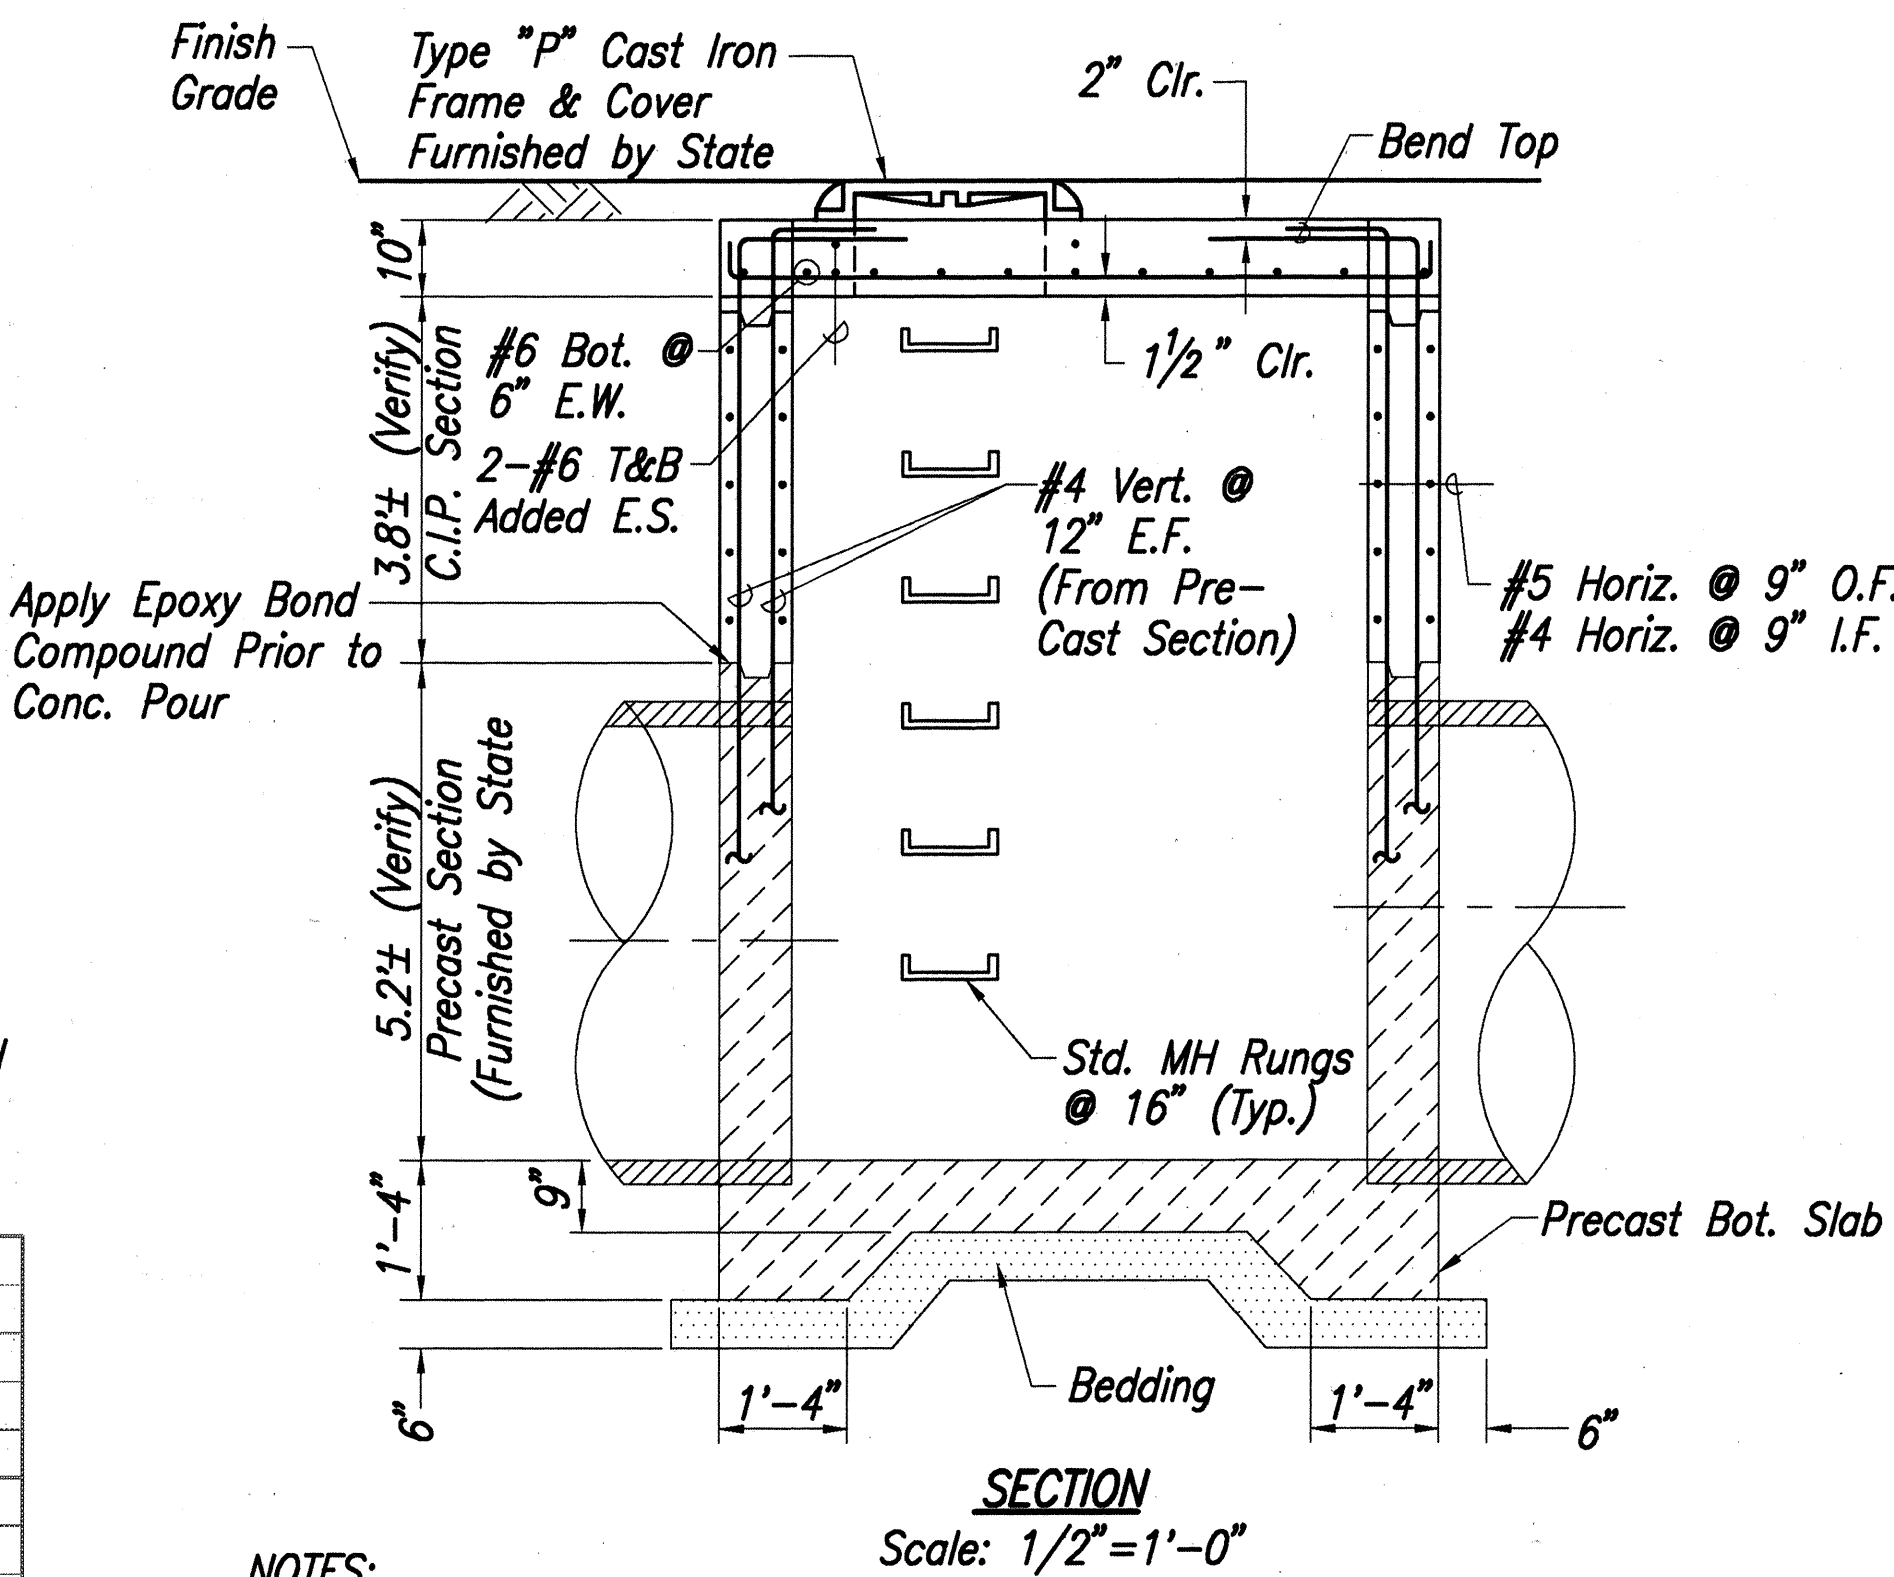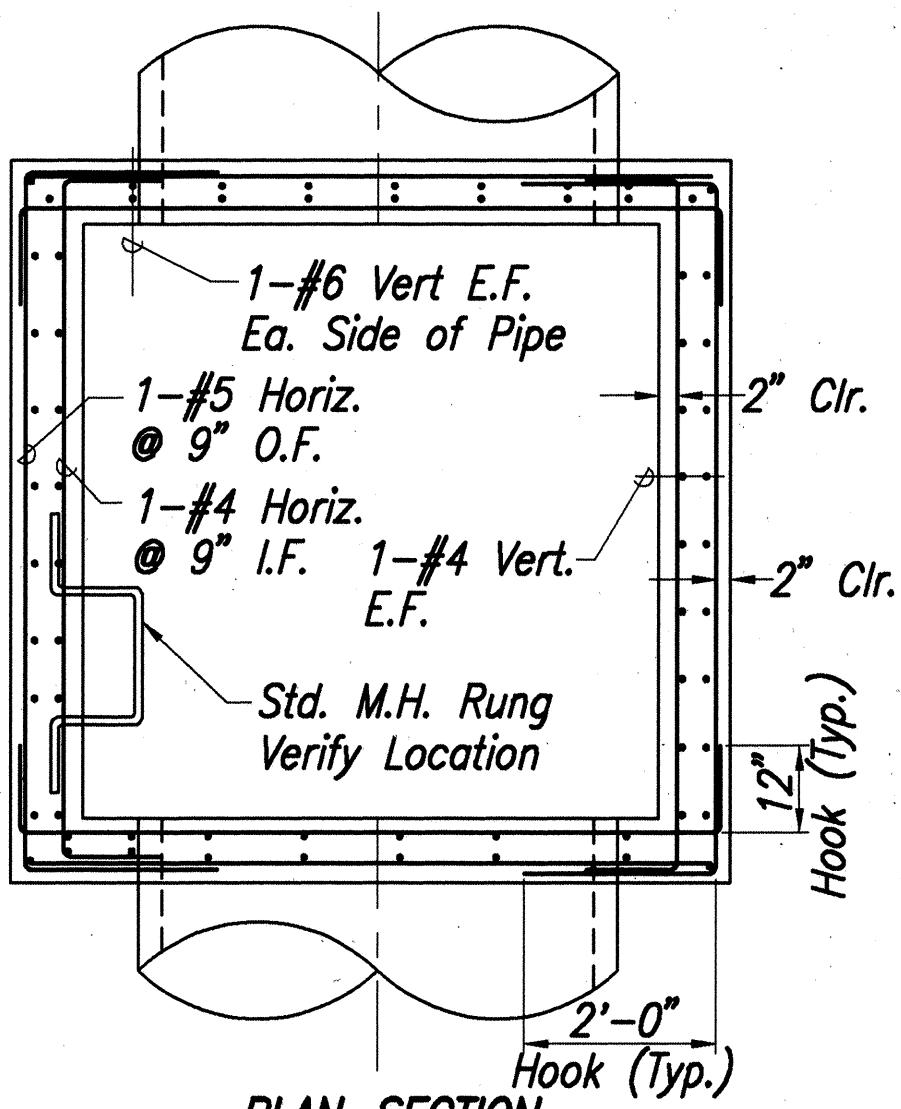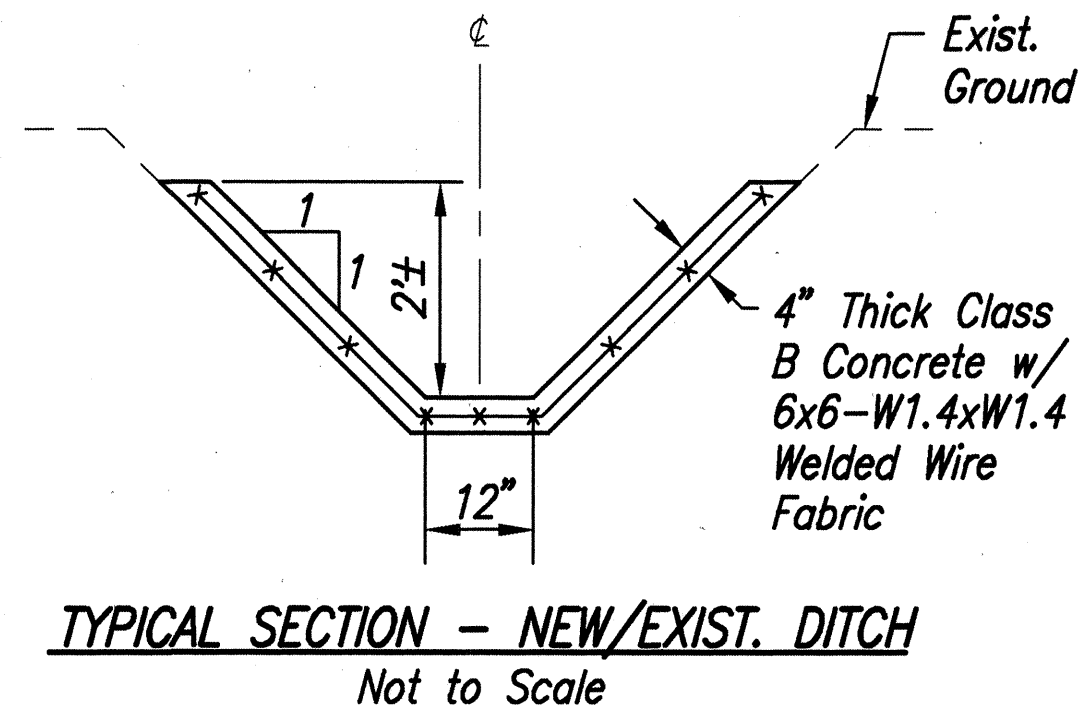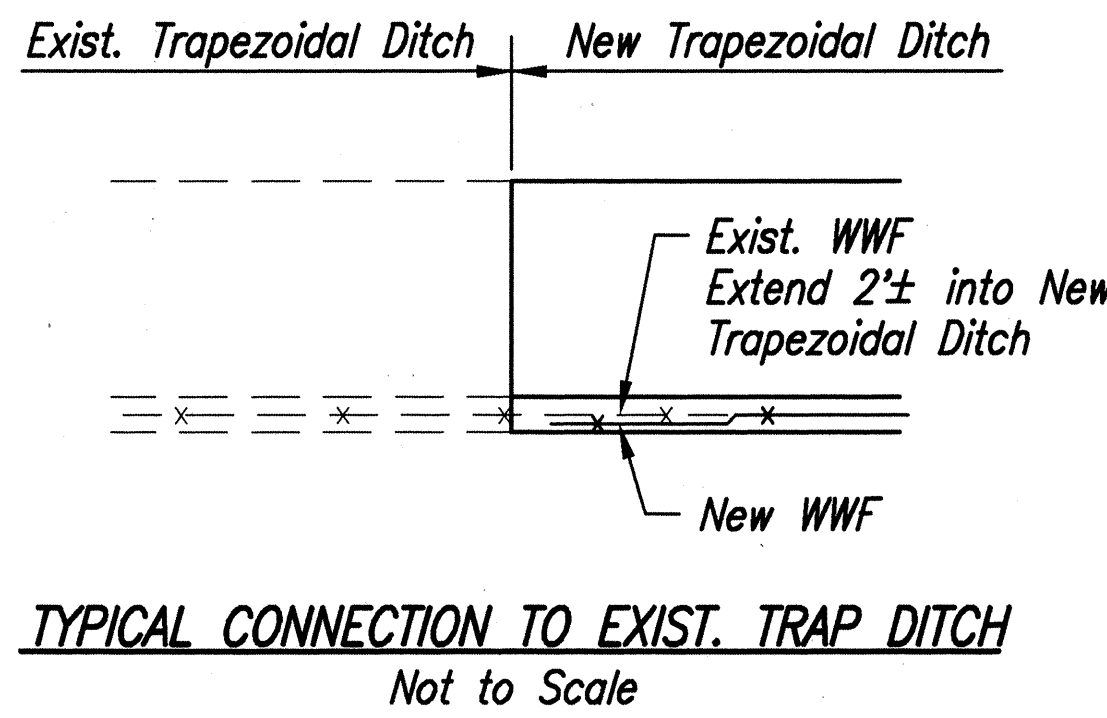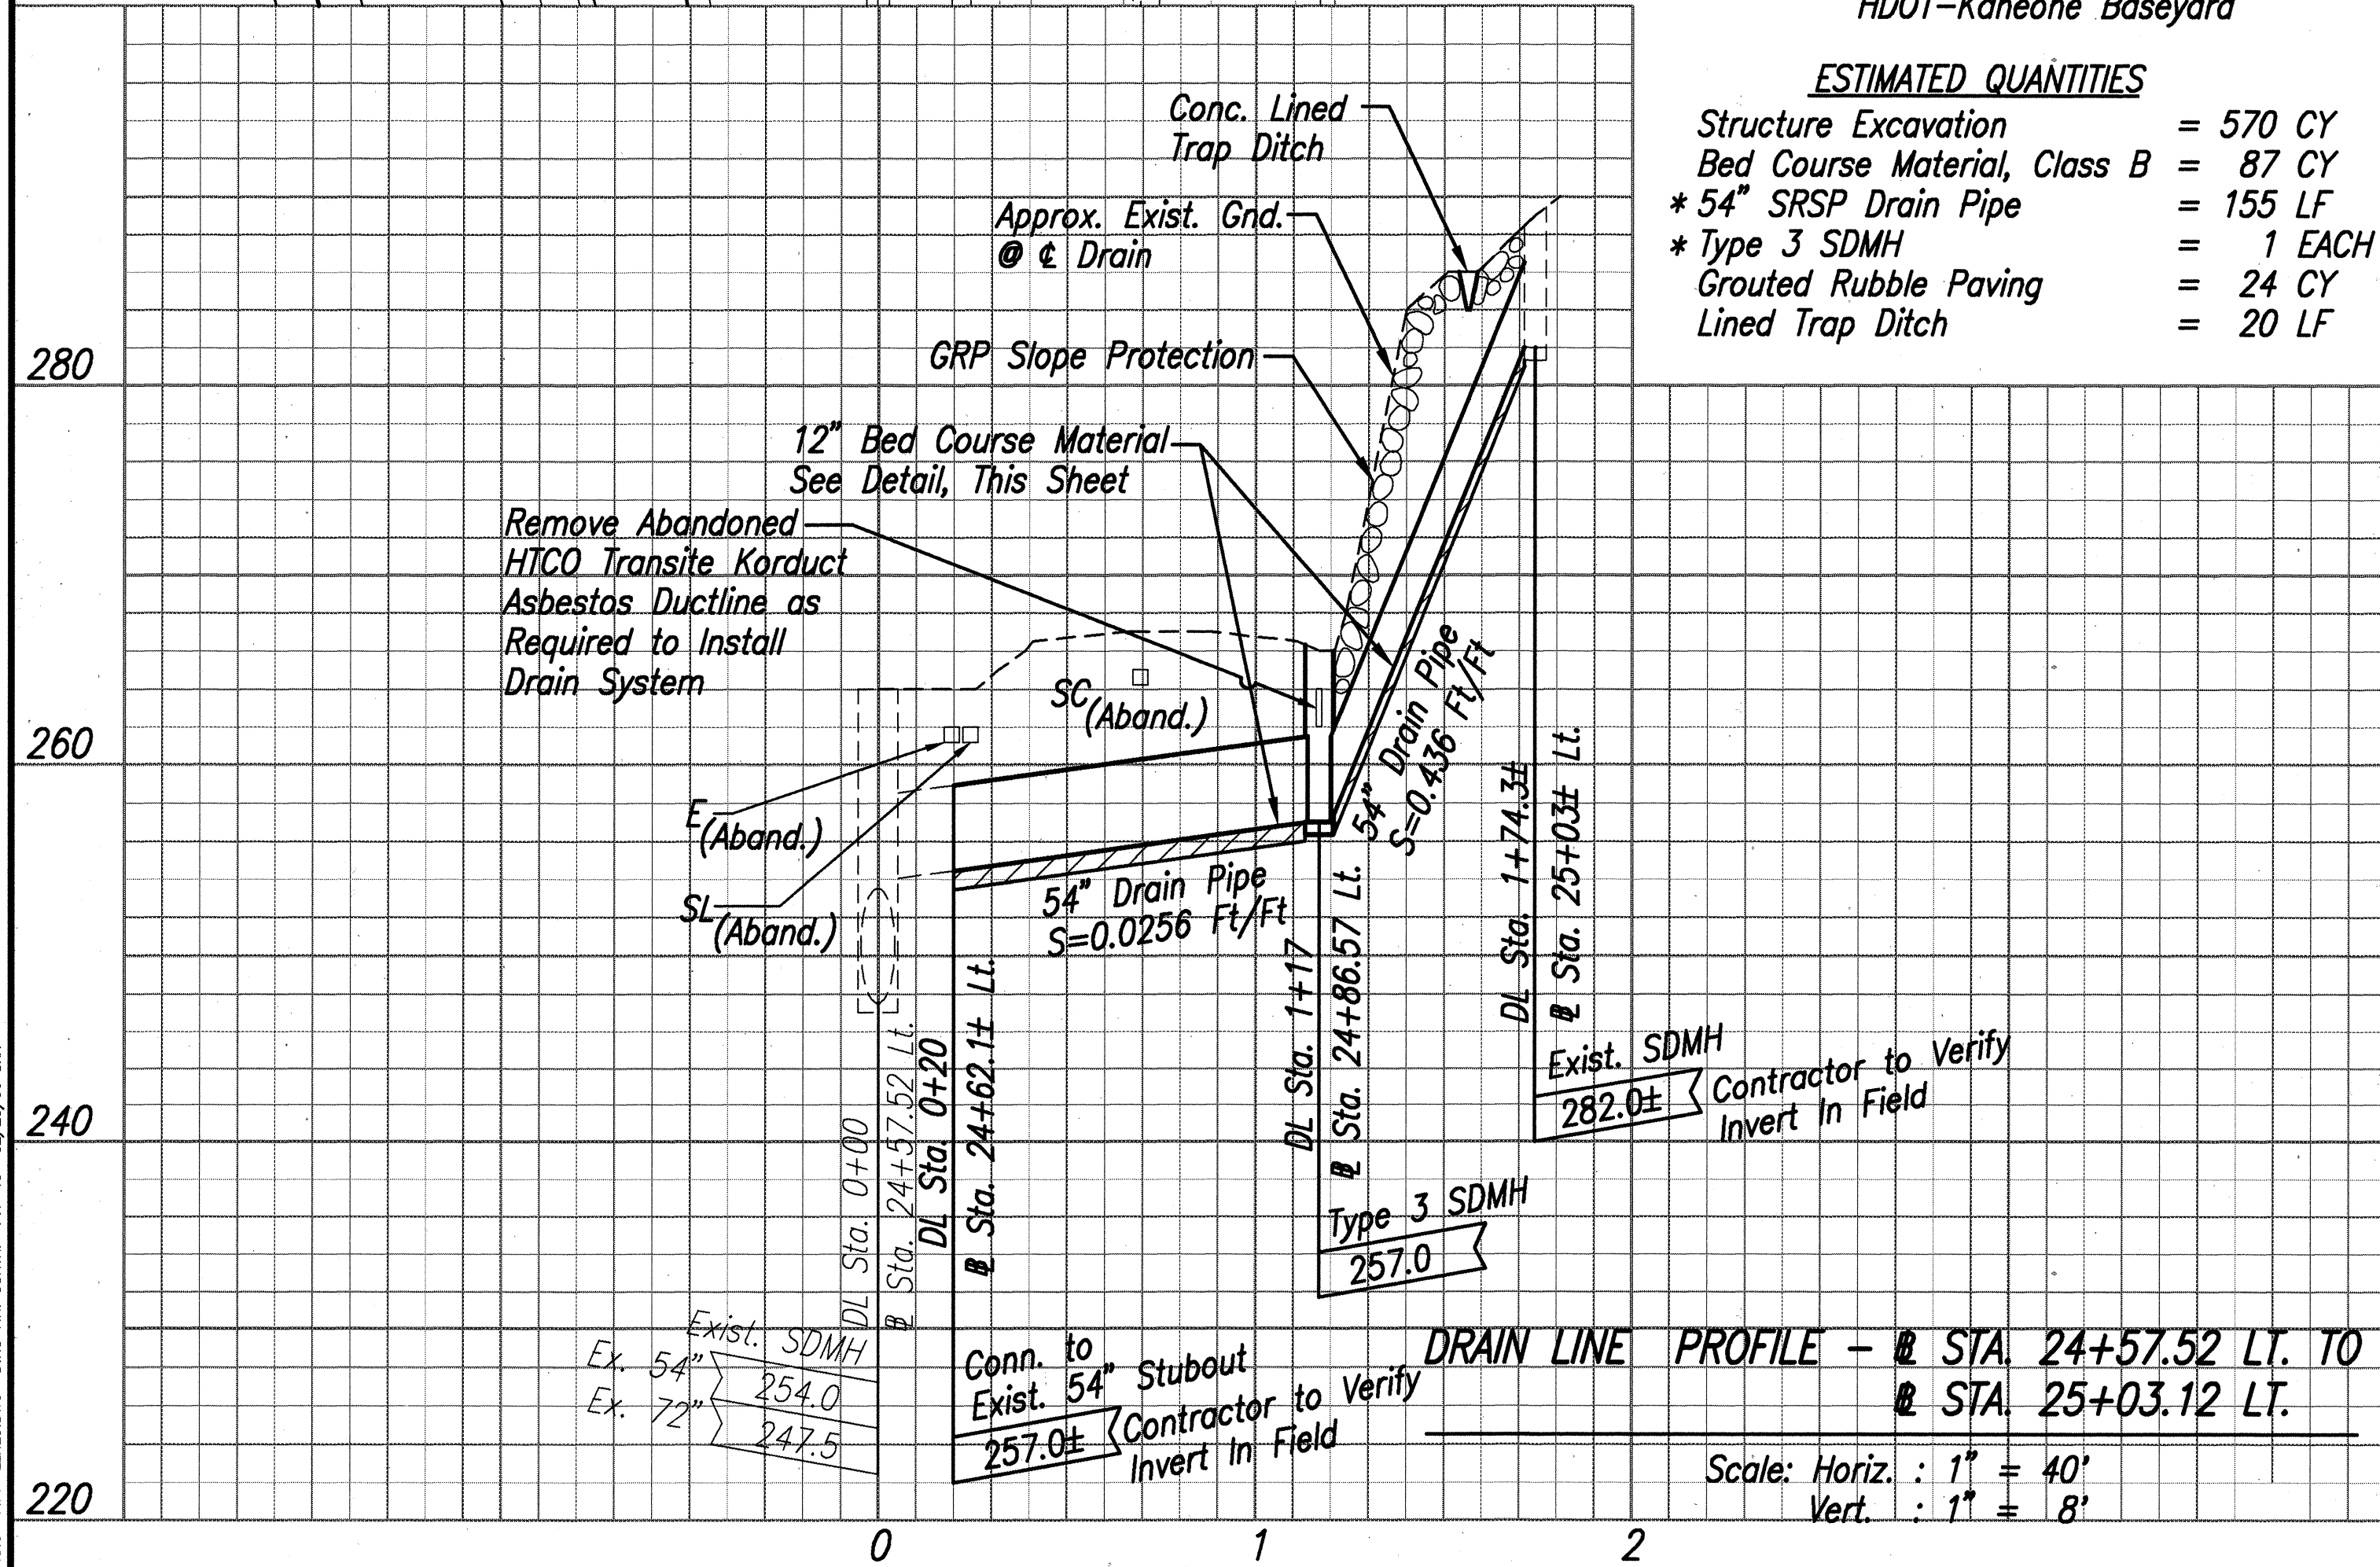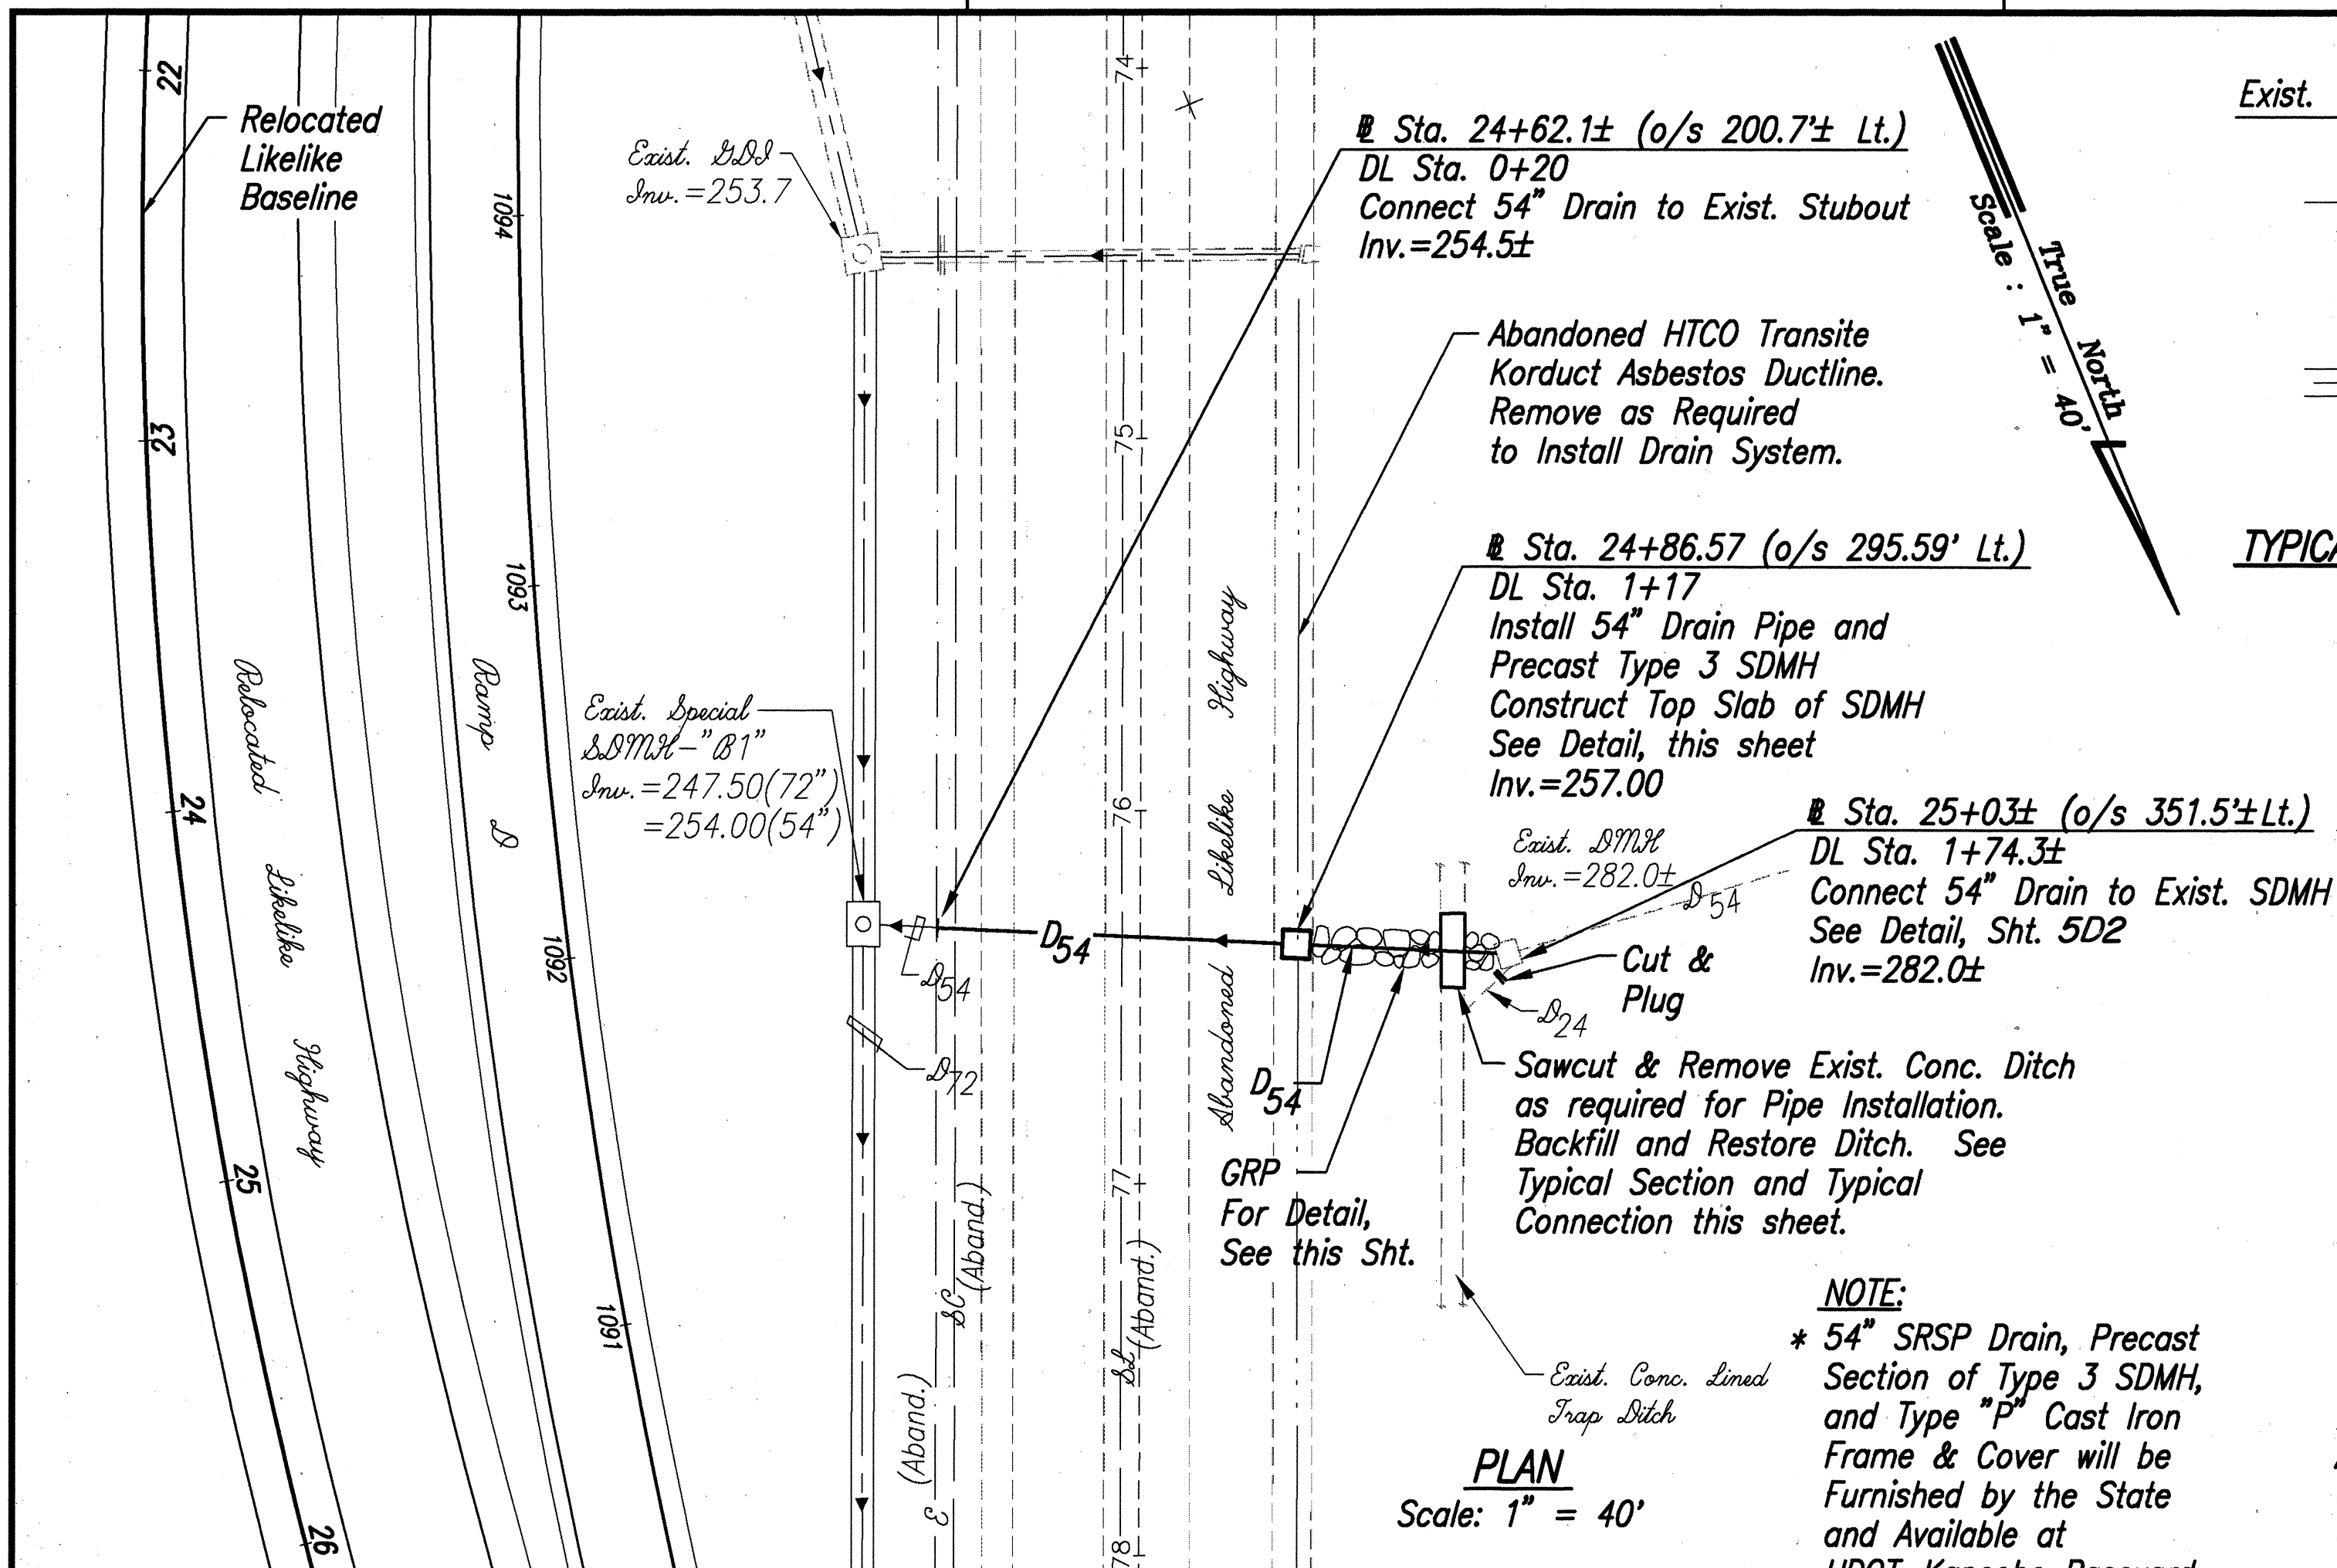






- NOTES:
- VERIFY DIMENSIONS OF STATE FURNISHED PRECAST PORTION OF MANHOLE
 - CLEAN REINFORCING STEEL AS REQUIRED.

TYPE 3 STORM DMH DETAIL

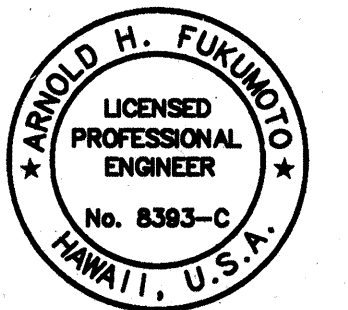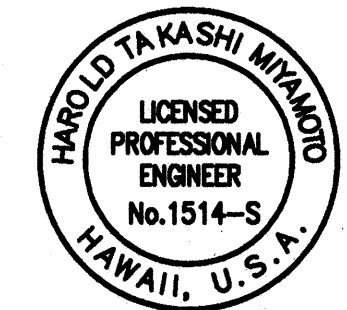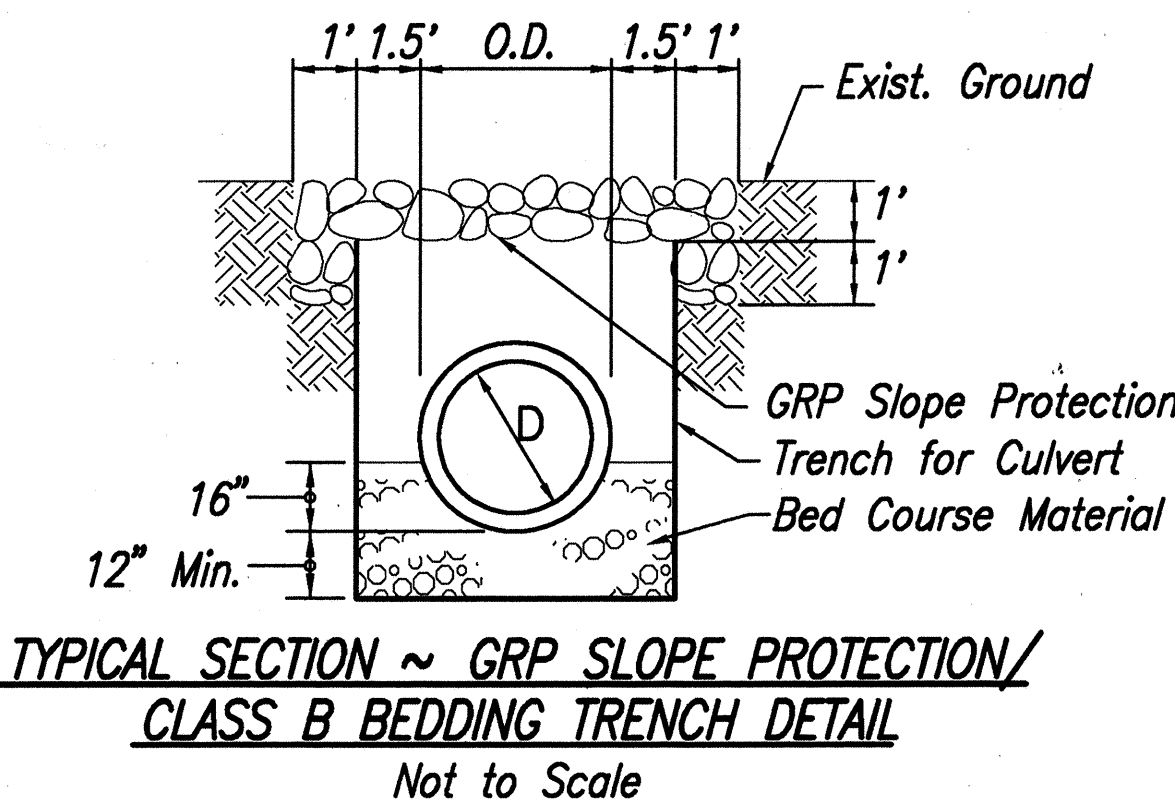

STATE OF HAWAII
DEPARTMENT OF TRANSPORTATION
HIGHWAYS DIVISION
54" SRSP DRAIN
AT RELOCATED LIKELIKE HIGHWAY
H-3 FINISH (UNIT II)
F.A.I. PROJ. NO. 1-H3-1(75) UNIT II
LEEWARD SECTION
SCALE: AS NOTED DATE: JAN., 1997
SHEET No. 5D1 OF 2 SHEETS

FED. ROAD DIST. NO.	STATE	PROJ. NO.	FISCAL YEAR	SHEET NO.	TOTAL SHEETS
HAWAII	HAW.	I-H3-1(75), UNIT II	1997	839	1102

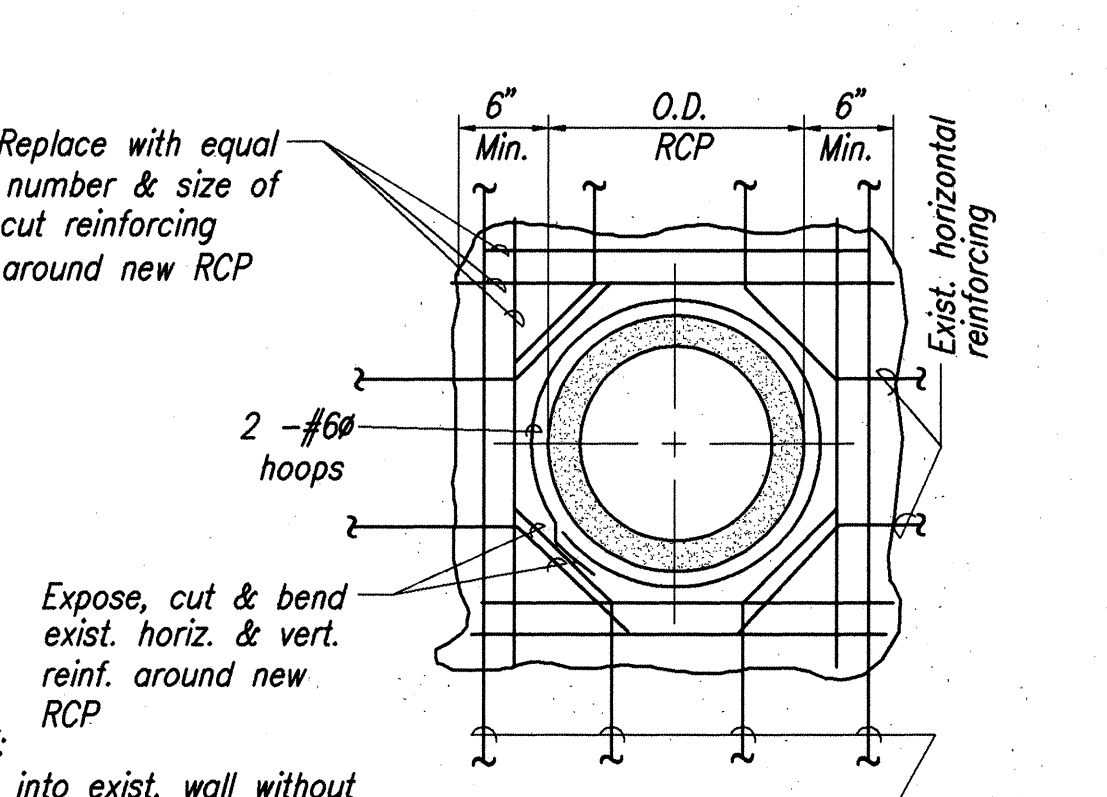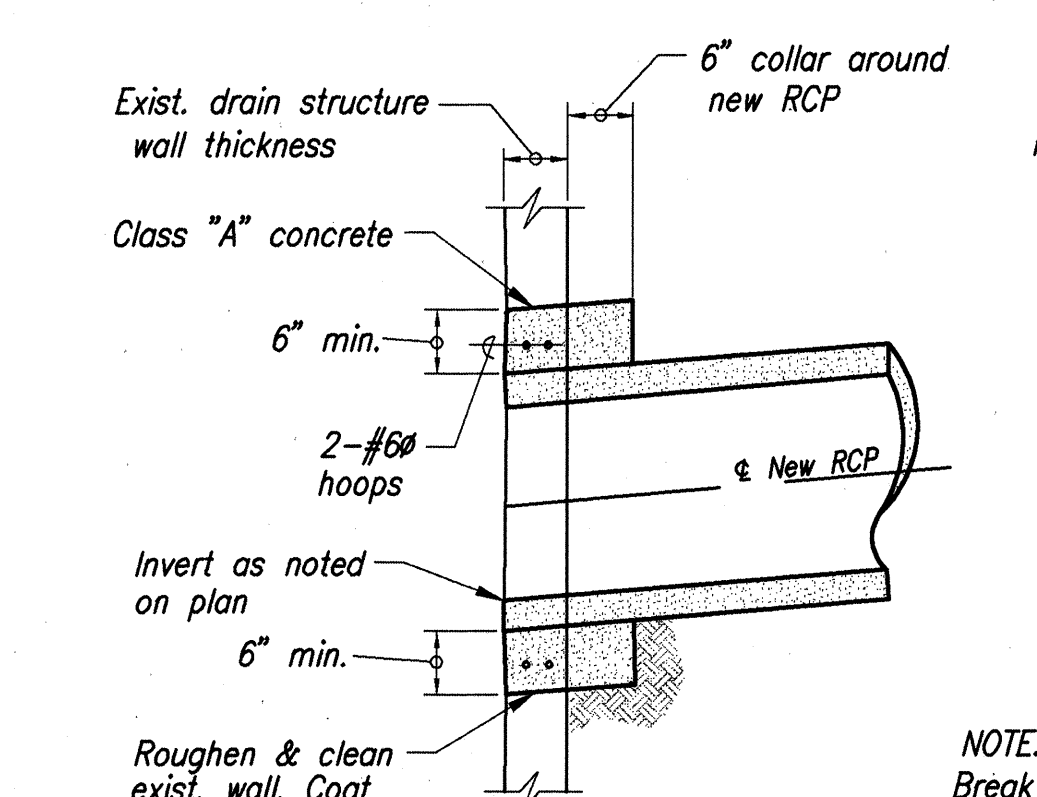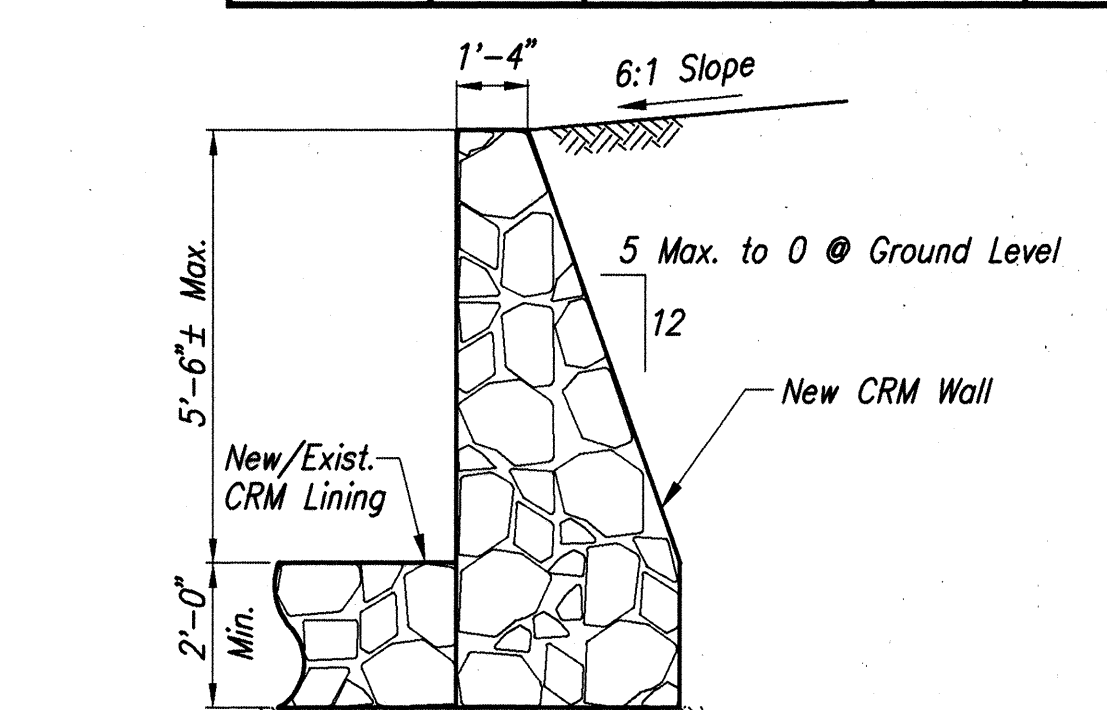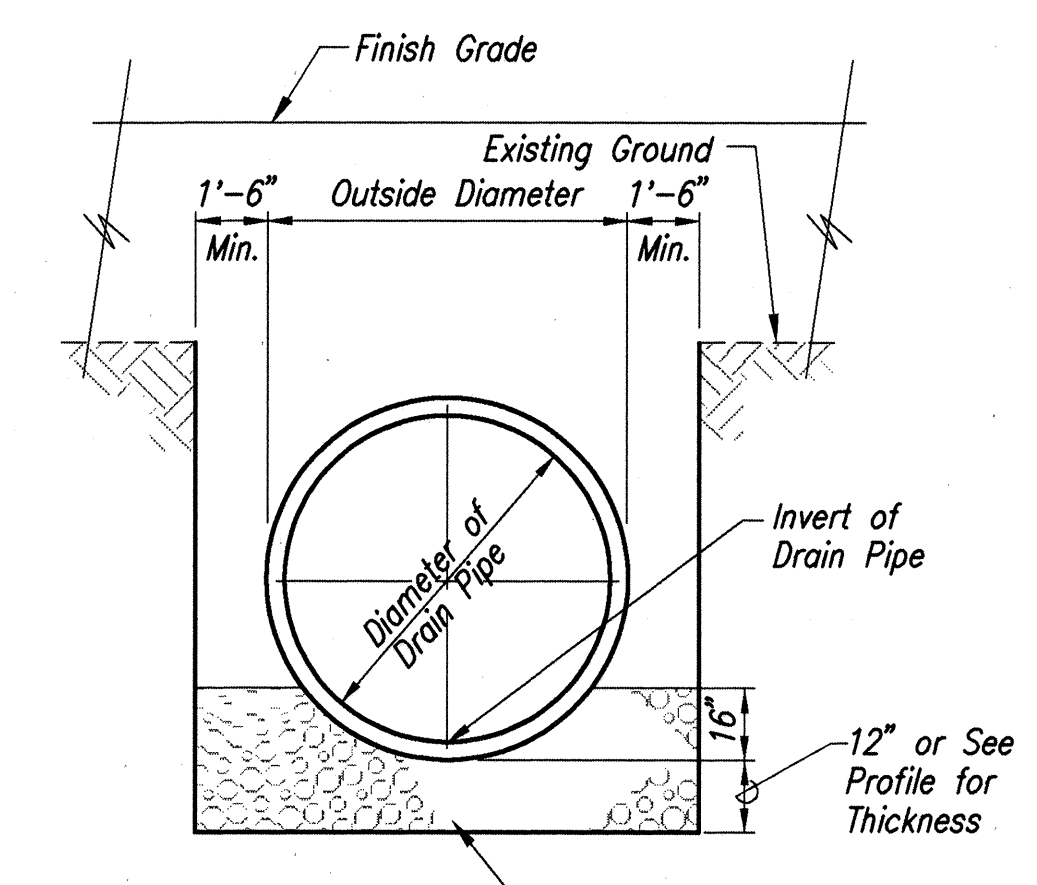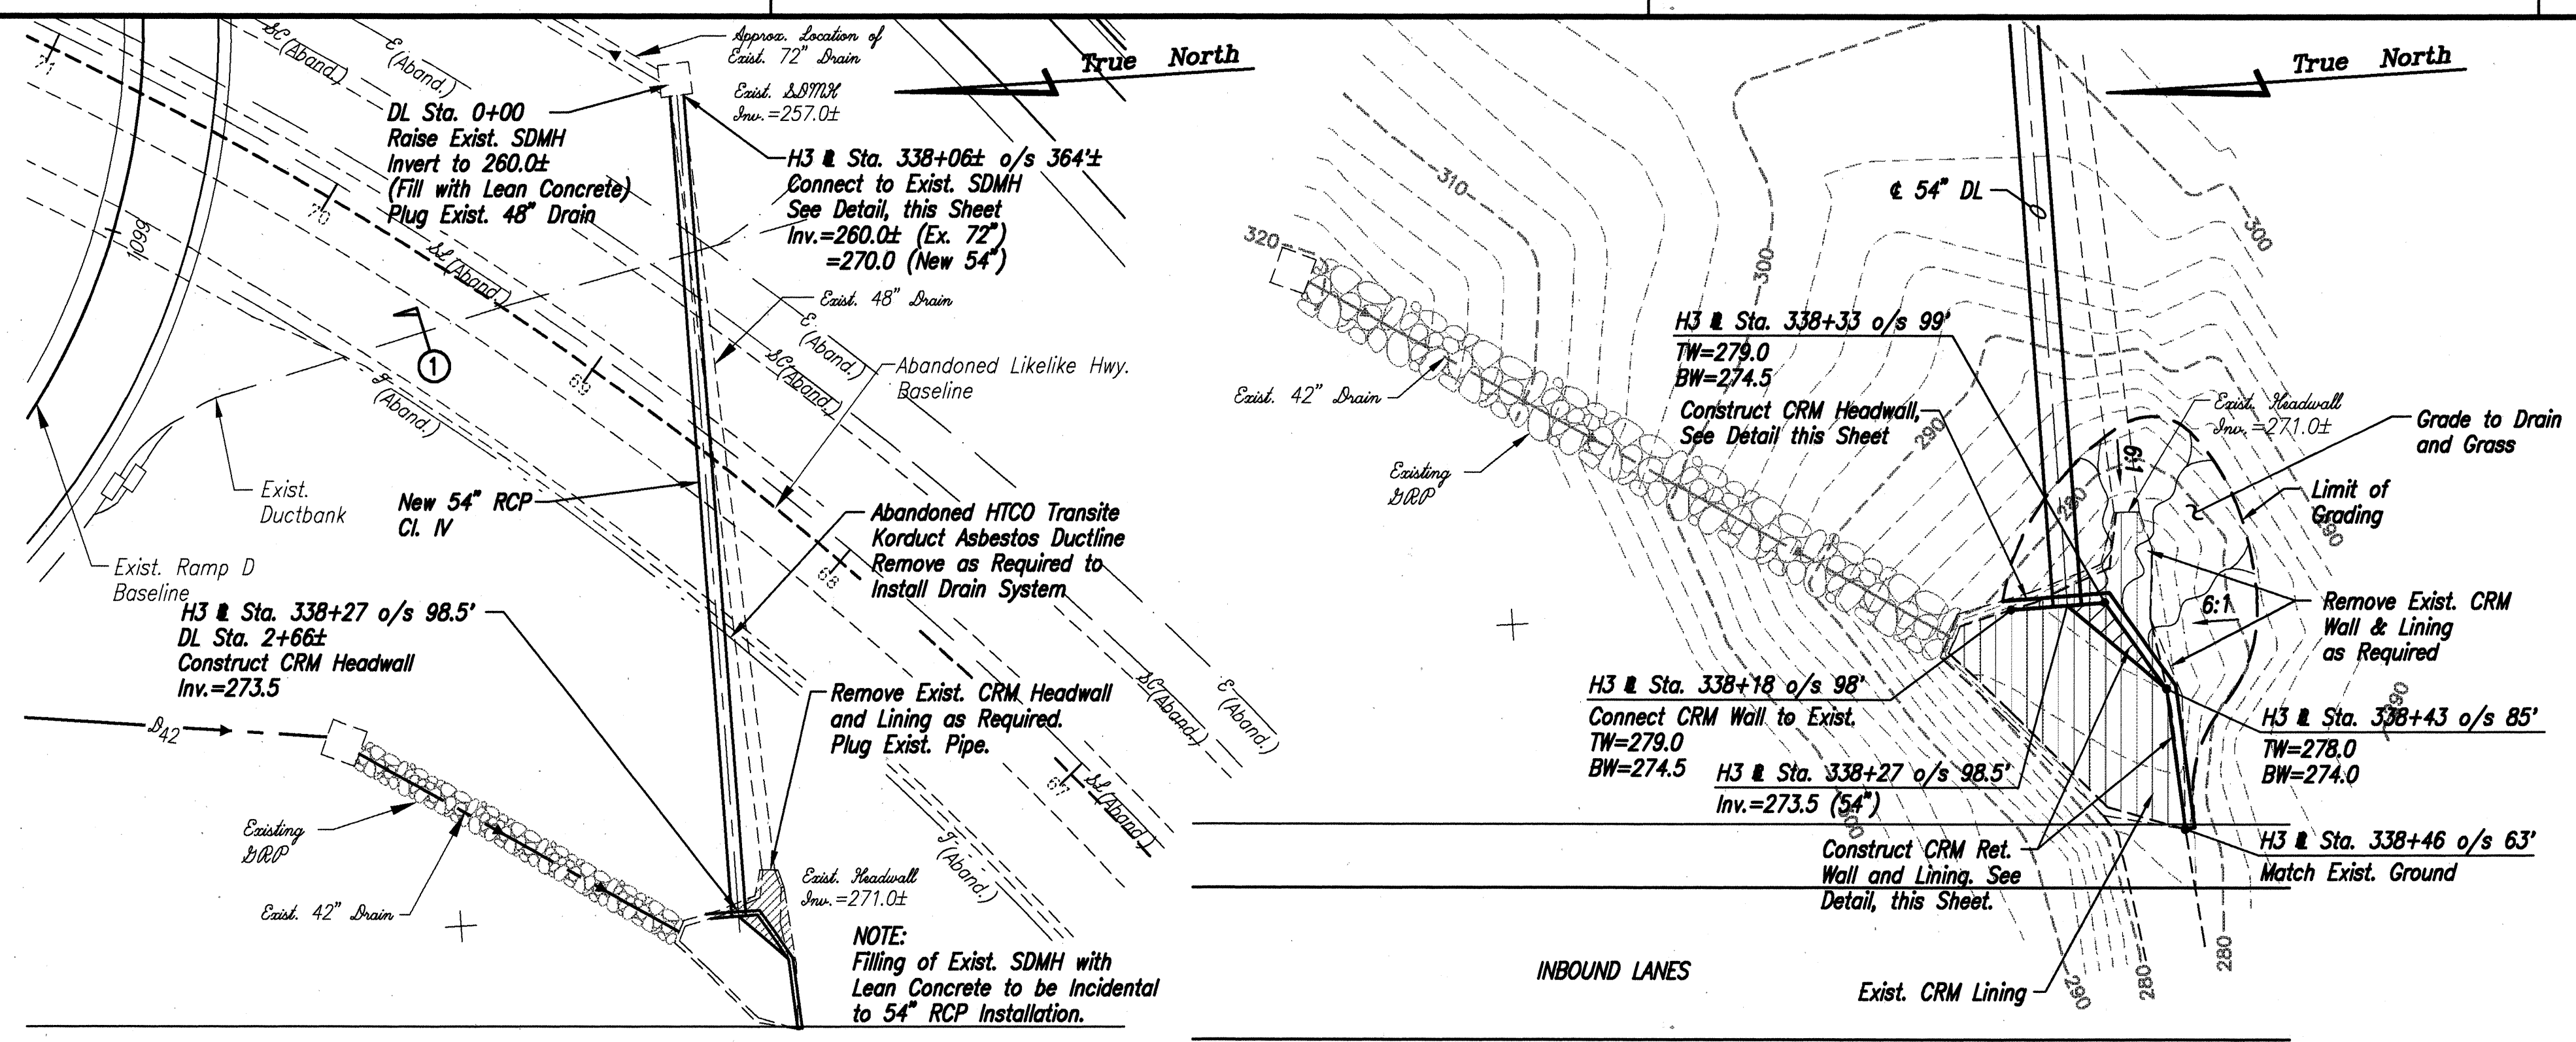


PIPE CONNECTION TO EXISTING DRAIN STRUCTURE
H3 STA. 338+06 & RLL STA. 25+03
NOT TO SCALE

ESTIMATED QUANTITIES


Structure Excavation	=	2080 C.Y.
Cement Rubble Masonry	=	30 C.Y.
Bed Course Material, Class B	=	145 C.Y.
54" RCP, Class IV	=	266 L.F.

HECO NOTES:

- LOCATION OF HECO FACILITIES**
The location of HECO's underground facilities shown on the plans are from existing records with varying degrees of accuracy and are not guaranteed as shown. The Contractor shall exercise extreme caution whenever construction crosses or is in close proximity of underground lines and shall maintain adequate clearance when operating equipment within or under any overhead lines.
- UNDERGROUND LINES**
For verification of underground lines or for assistance in supporting and protecting these lines, the Contractor shall call HECO's underground division at 543-7345 a minimum of 72 hours in advance.
- EXCAVATIONS**
When trench excavation is adjacent to or beneath HECO existing structures or facilities, the Contractor is responsible for:
A) Sheeting and bracing the excavation to prevent slides, cave-ins and settlements.
B) Protecting existing structures or facilities with beams, struts, or under-pinning.
- DAMAGE TO HECO FACILITIES**
Any damage to HECO's facilities will be reported immediately to HECO's trouble dispatcher at 543-7874.
- LIABILITY FOR DAMAGES**
All HECO overhead and underground facilities shown on these plans or whose approximate locations within the project boundaries have been made known by any reasonable means at any time to the Contractor, shall be protected at all times by the Contractor during construction. Cost for damages to HECO facilities may be borne by the Contractor. This repair work shall be done by HECO, or by the Contractor under HECO's supervision.

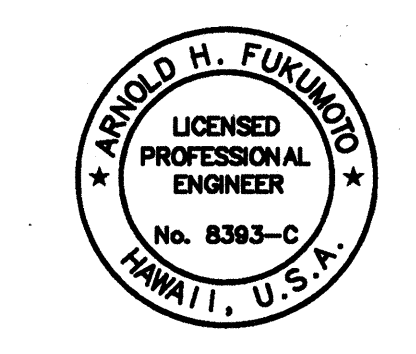

THIS WORK WAS PREPARED BY ME OR UNDER MY SUPERVISION.
Arnold H. Fukumoto
ENGINEERS SURVEYORS HAWAII, INC.

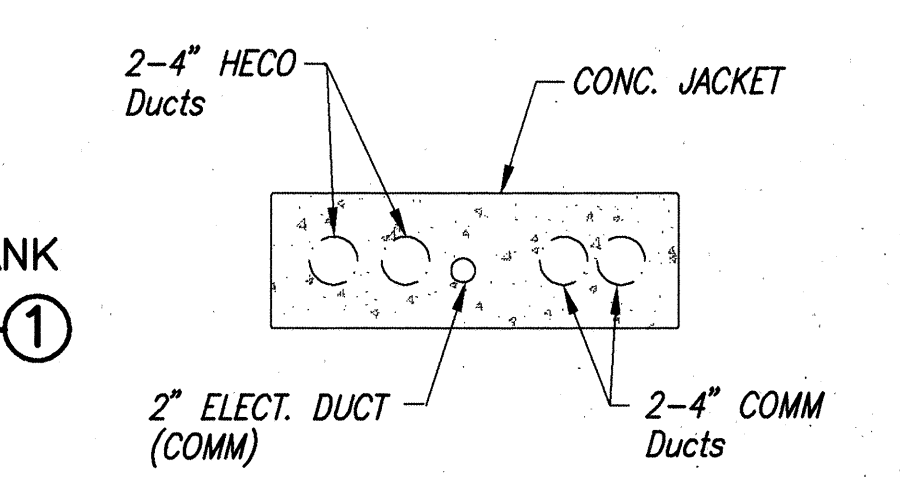

DATE	REVISION
STATE OF HAWAII DEPARTMENT OF TRANSPORTATION HIGHWAYS DIVISION WINDWARD 54" RCP DRAIN AT STA. 338+27 H-3 FINISH (UNIT II) F.A.I. PROJ. NO. I-H3-1(75), UNIT II SCALE: AS NOTED DATE: JAN., 1997	



ORIGINAL PLAN
DESIGNED BY
CHECKED BY
DATE
NO.

83-45.5 File:DRAIN-1.DWG Disk:43 HOSPITAL ROCK TUNNEL Plot:1=40 Date:02/23/96 SRA


FED. ROAD DIST. NO.	STATE	FED. AID PROJ. NO.	FISCAL YEAR	SHEET NO.	TOTAL SHEETS
HAWAII	HAW.	I-H3-1(75), UNIT II	1997	ADD. 839S-1	1102

QUANTITY	COMMON NAME	BOTANICAL NAME	HT. / SP.	SIZE
85	KUKUI NUT	Aleurites moluccana	6'-8' HT. 1" CAL	15 GAL.
48	HALA	Pandanus odoratissimus	2'-3' SP.	15 GAL.
245	GREEN TI	Cordyline terminalis	1'-2' HT.	1 GAL.

- NOTE:
- Contractor shall clear and grub planting areas prior to planting trees and shrubs. See Specifications 619.03(A) Advanced Preparation of Planting Areas.
 - Contractor is responsible for watering of plant material as needed for healthy growth. The watering of plant material shall be considered to be incidental to the contract and shall be at no additional cost to the State.
 - See Plan Sheet 1L8 for Planting Details.

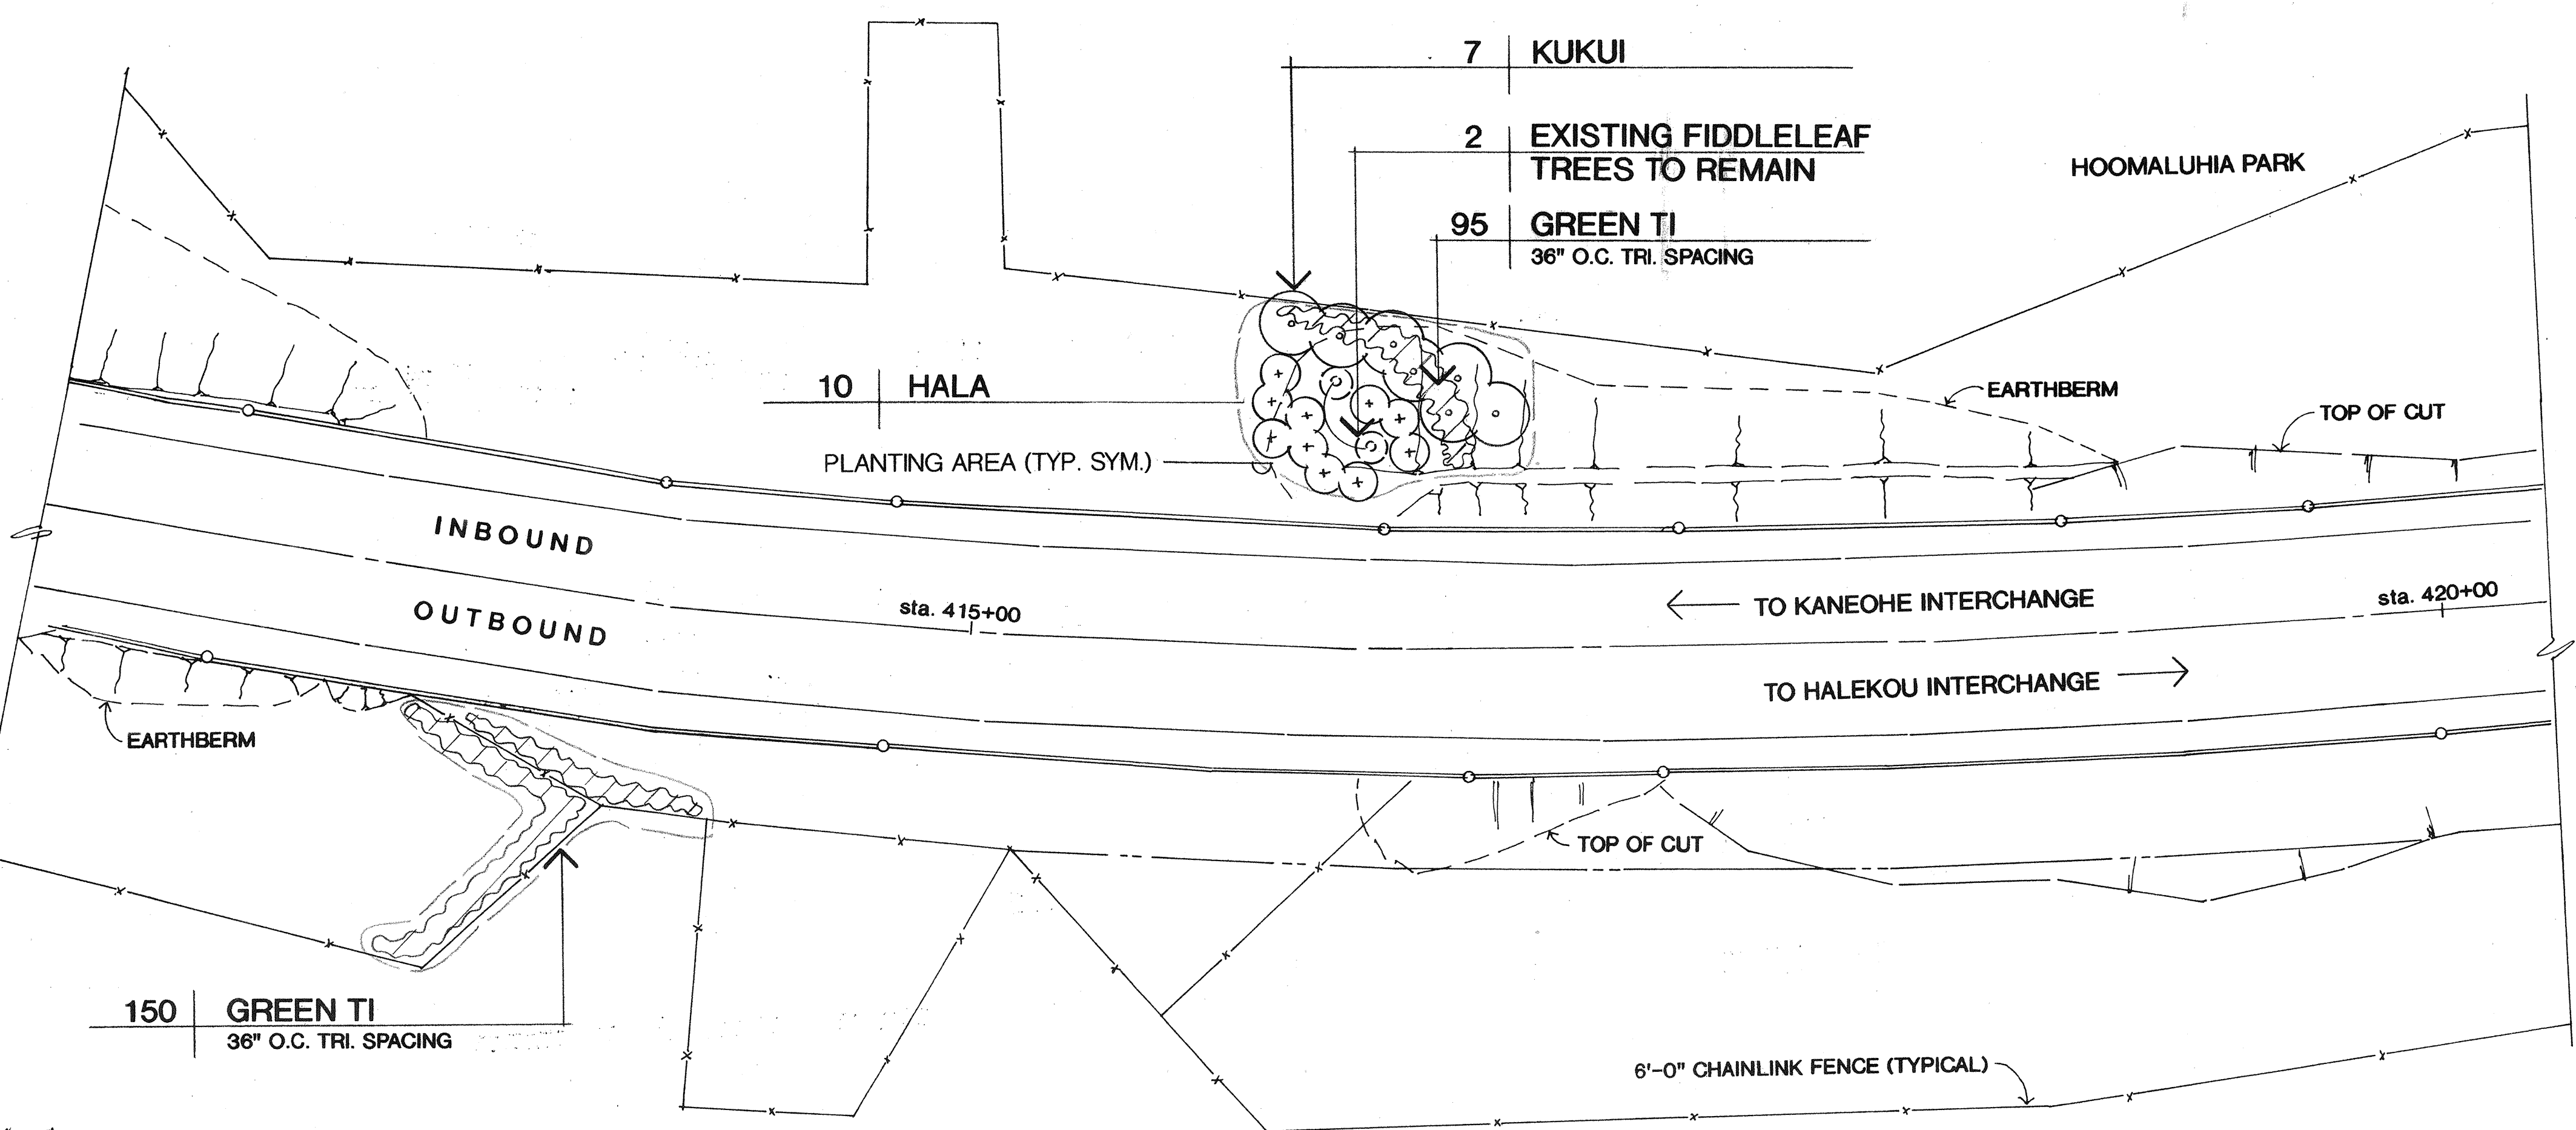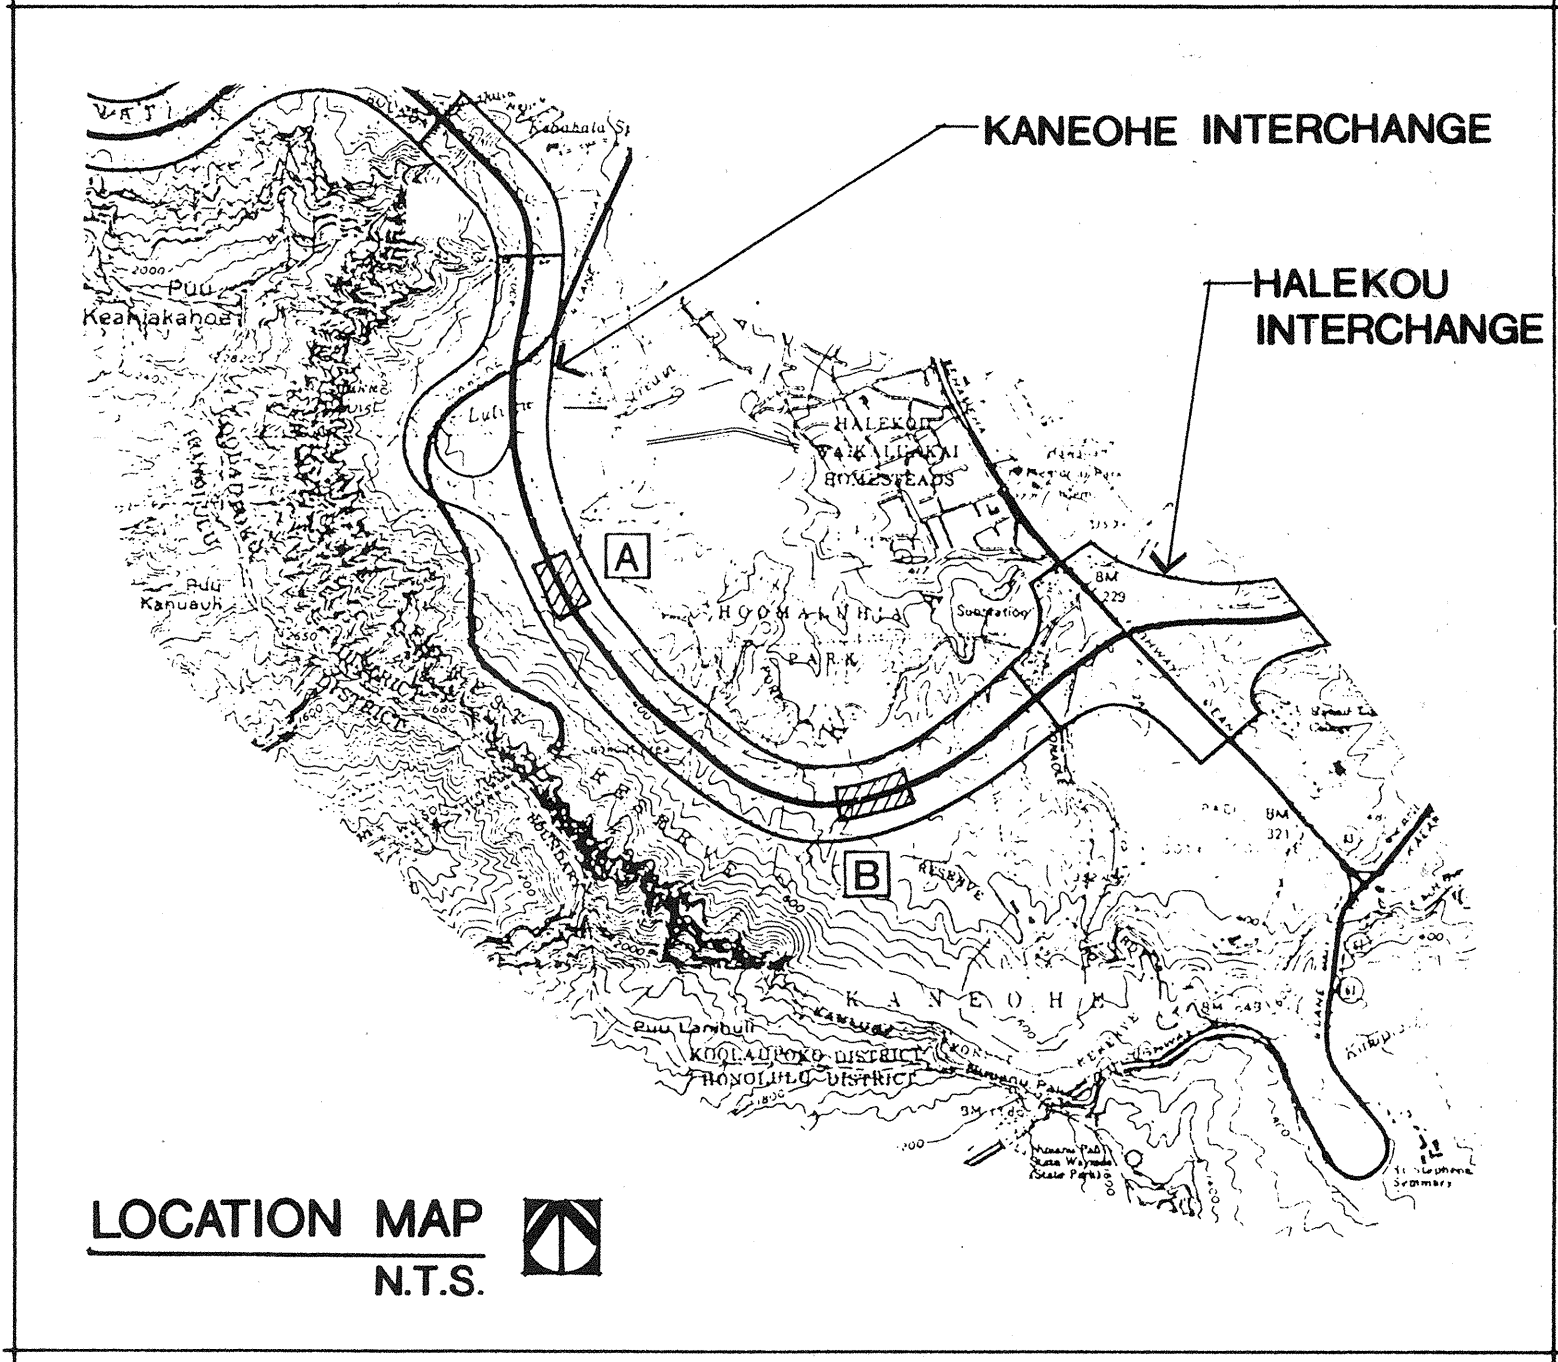


A PLAN VIEW AT STATION 415+00

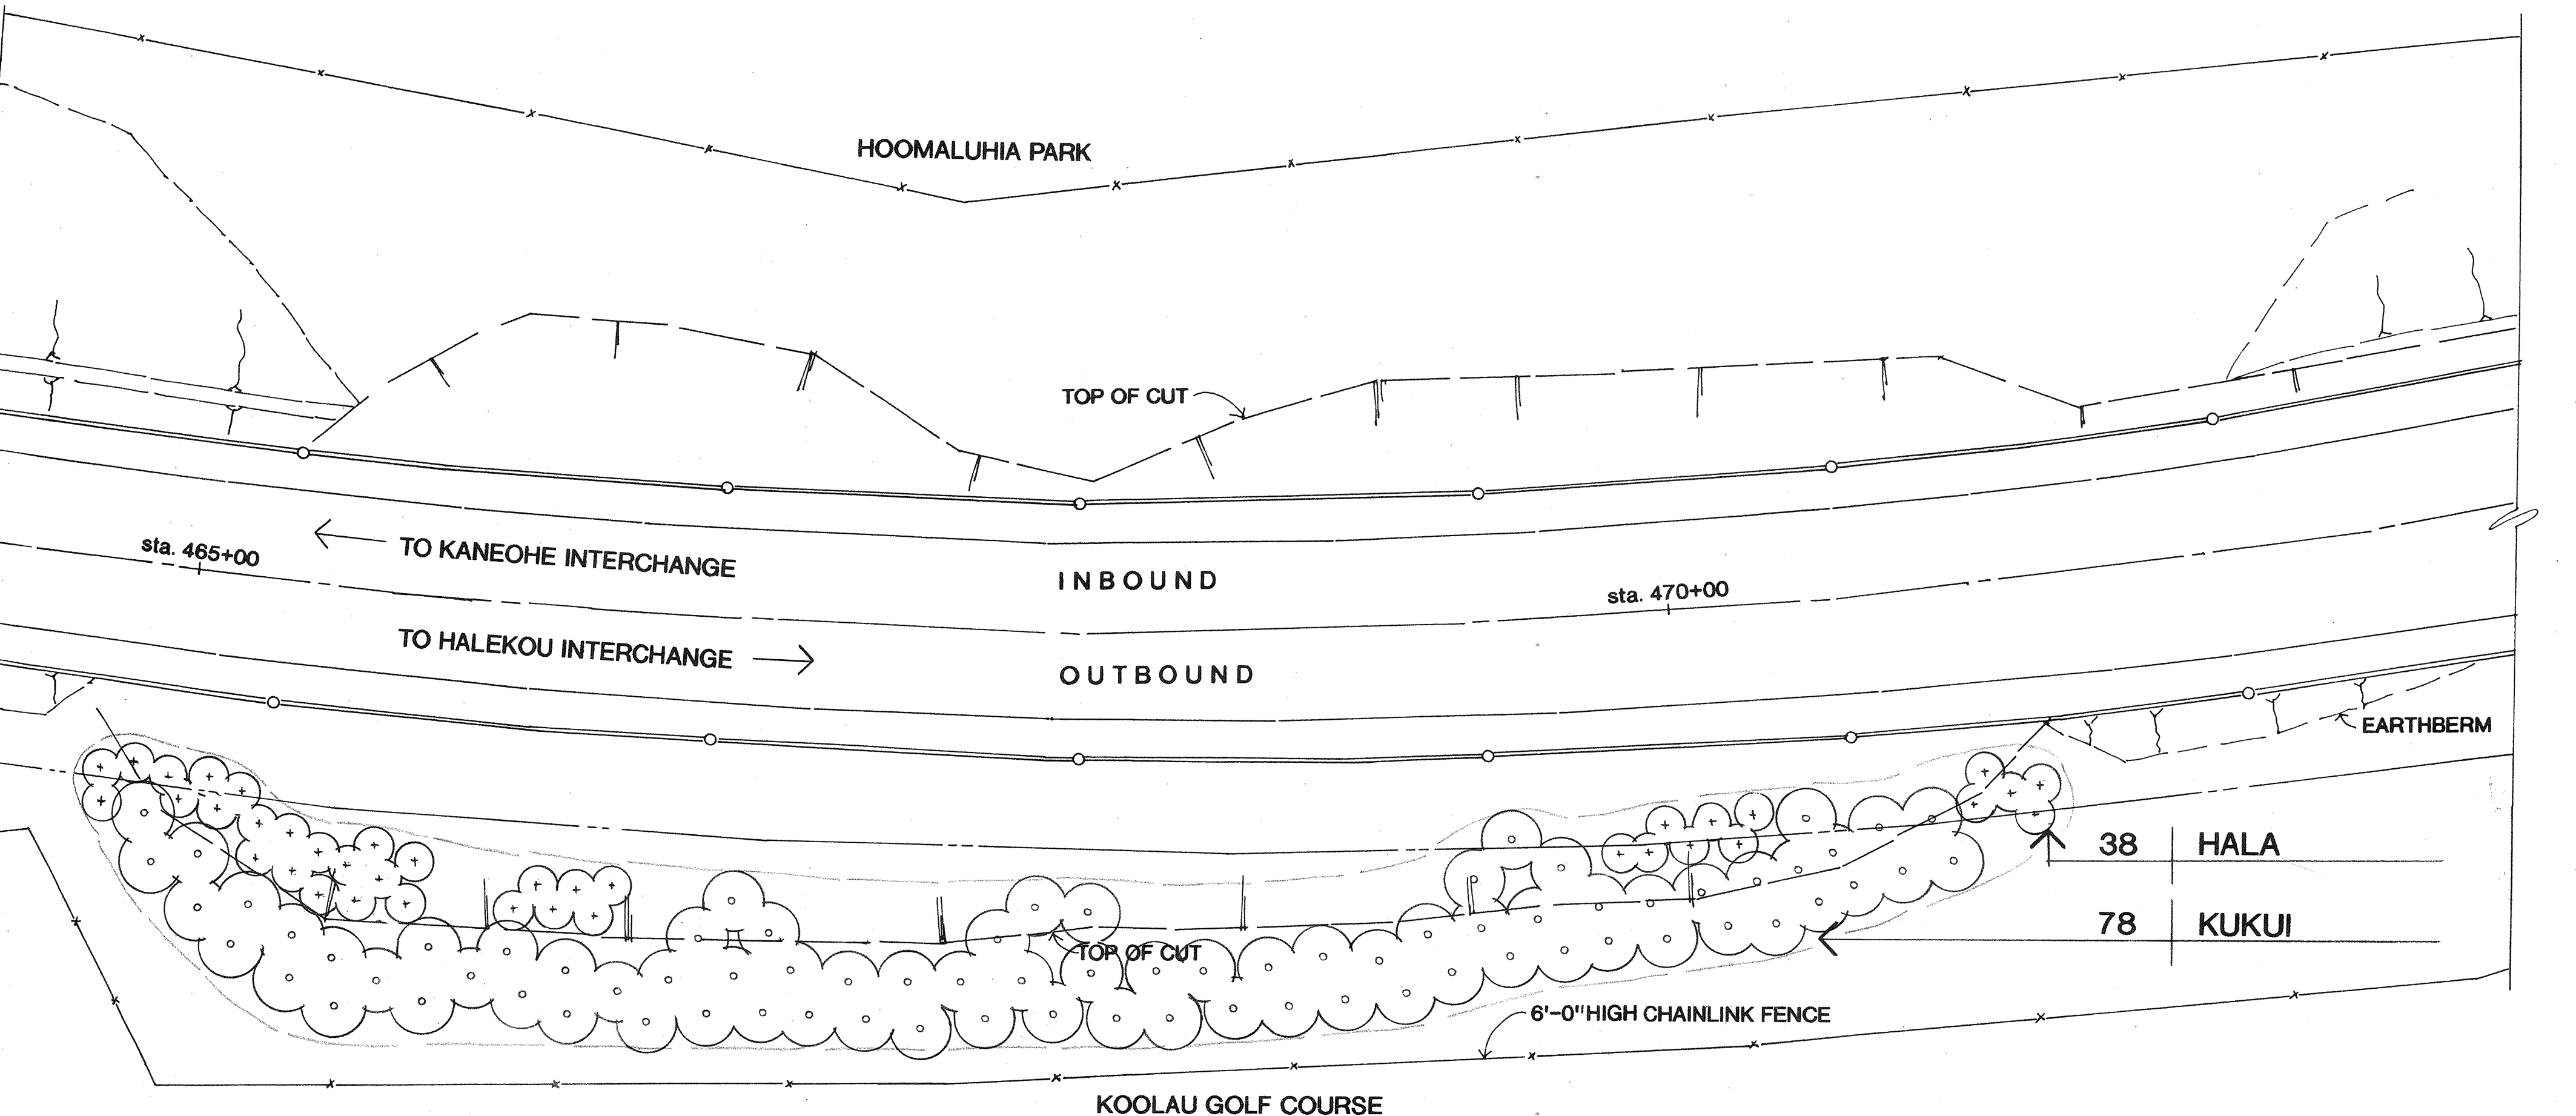

B PLAN VIEW AT STATION 470+00

DATE: _____
 SURVEY PLOTTED BY: _____
 DESIGNED BY: _____
 CHECKED BY: _____
 NO. _____

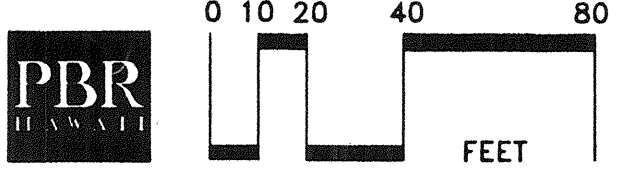

THIS WORK WAS PREPARED BY
 ME OR UNDER MY SUPERVISION.

DATE	ADDED SHEET
4/16/97	REVISION
STATE OF HAWAII DEPARTMENT OF TRANSPORTATION HIGHWAYS DIVISION WINDWARD LANDSCAPE PLANTING PLAN H-3 FINISH (UNIT II) FAIP NO. I-H3-1(75), UNIT II LEEWARD SECTION	
SCALE: 1"=40'	DATE: JANUARY 1997
SHEET NO. 5L1 OF 1	SHEETS

ADD.839S-1

ORIGINAL PLAN	SURVEY PLOTTED BY	DATE
NOTE BOOK	DRAWN BY	
No.	DESIGNED BY	
	CHECKED BY	

CAD by L.Yoshimura, 95-92

Last Saved: J:\H3RF\RFU2\WINDWARD\NOTES.dwg 04/29/97 at 21:18


FED. ROAD DIST. NO.	STATE	FED. AID PROJ. NO.	FISCAL YEAR	SHEET NO.	TOTAL SHEETS
HAWAII	HAW.	I-H3-1(75), UNIT II	1997	ADD 839S-2	1102

GENERAL NOTES FOR TRAFFIC CONTROL PLAN

LEGEND

.....	CONES OR DELINEATORS FOR WORK AREA. FOR SPACING, SEE SECTION 645-TRAFFIC CONTROL, TABLE 645-I - FOR TRAFFIC CONTROL PLAN
xxxxxx	CONES OR DELINEATORS FOR TAPER AND TANGENT. FOR SPACING, SEE SECTION 645-TRAFFIC CONTROL, TABLE 645-I - FOR TRAFFIC CONTROL PLAN
←	DETOUR TRAFFIC DIRECTION
←	EXISTING TRAFFIC DIRECTION
↔	FLASHING ARROW BOARD
oooooo	INERTIAL BARRIER
—	PORTABLE CONCRETE GUARDRAIL
I I I	TYPE I BARRICADE
////	WORK AREA

- The Contractor shall make minor adjustments at intersections, bridges, structures, etc., to fit field conditions.
- Cones or delineators shall be extended to a point where they are visible to approaching traffic.
- Traffic control devices shall be installed such that the sign or device farthest from the work area shall be placed first. The others shall then be placed progressively toward the work area.
- Regulatory and warning signs within the construction zone that are in conflict with the Traffic Control Plans shall be removed or covered. All signs shall be restored upon completion of the work.
- Flaggers and/or police officers shall be in sight of each other or in direct communications at all times.
- When required by the District Engineer, the Contractor shall install a flashing arrow signal as shown on the Traffic Control Plans.
- Sign spacings (L), taper lengths (T) and spacings of cones or delineators shall be as shown in Table 1 of Section 645 in the Specifications, unless otherwise noted on the Traffic Control Plans.
- All traffic lanes shall be minimum of 11 feet wide.
- All construction warning signs shall be promptly removed or covered whenever the message is not applicable or not in use.
- The backs of all signs used for traffic control shall be appropriately covered to preclude the display of inapplicable sign messages (i.e., when signs have messages on both faces).
- At the end of each day's work or as soon as the work is completed, the Contractor shall remove all traffic control devices no longer needed to permit free and safe passage of public traffic. Removal shall be in the reverse order of installation.
- Replace permanent pavement markings and traffic signs upon completion of each phase of work.
- All lane closures and other traffic pattern changes (detours) not shown on the plans shall be submitted to the Engineer for approval in accordance with Specifications Section 645 - Traffic Control. For restrictions on lane closures, detours, construction work during peak hours, and other requirements regarding maintaining vehicular and pedestrian traffic, see Section 107.13 - Public Convenience and Safety and Section 645 - Traffic Control.
- All existing ramp lanes shall be open to traffic during non-working hours.
- Portable concrete guardrail panels not in use during the construction work shall not be stockpiled or otherwise stored within the highway right-of-way except at locations approved by the Engineer.
- The locations of pavement markings and signs, delineators and portable concrete guardrail panels used in the Construction Phasing shall be as shown on the plans and/or as determined in the field by the Engineer.
- Damage to signs, temporary pavement markers, delineators and portable concrete guardrail panels caused by the public shall be repaired or replaced by the Contractor as directed by the Engineer and paid for under Section 645. Damage caused by the Contractor's negligence shall be repaired or replaced at the Contractor's expense.
- The Contractor shall provide sand bags or other accepted weights for the Type I Barricades.
- Furnishing portable concrete guardrail will be paid under Specifications Section 649-Portable Concrete Guardrail. Transporting, setting, resetting and removing portable concrete guardrail will be paid under Specifications Section 672-Reset Portable Concrete Guardrail Section.
- The Contractor shall provide steady burn amber lamps during hours of darkness. The lamps shall be attached on the Type I Barricade end closest to the traveled way. One (1) lamp shall be attached to each portable concrete barrier along the traveled way. The lamps shall be visible to the motorist.

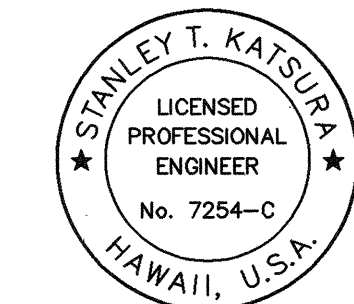






THIS WORK WAS PREPARED BY ME OR UNDER MY SUPERVISION.

Stanley T. Katsura

5/2/97	Added Sheet
Date	Revision
STATE OF HAWAII DEPARTMENT OF TRANSPORTATION HIGHWAYS DIVISION WINDWARD TRAFFIC CONTROL PLAN NOTES & LEGEND H-3 FINISH (UNIT II) FAIP NO. I-H3-1(75), UNIT II LEEWARD SECTION SCALE: NONE DATE: SHEET NO. 5F1 OF 5 SHEETS	


ADD. 839S-2

FED. ROAD DIST. NO.	STATE	FED. AID PROJ. NO.	FISCAL YEAR	SHEET NO.	TOTAL SHEETS
HAWAII	HAW.	I-H3-1(75), UNIT II	1997	ADD 839S-3	1102

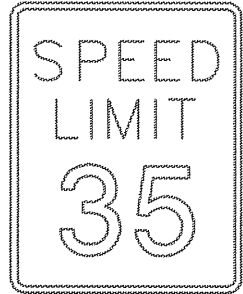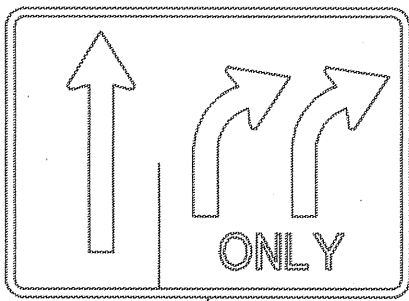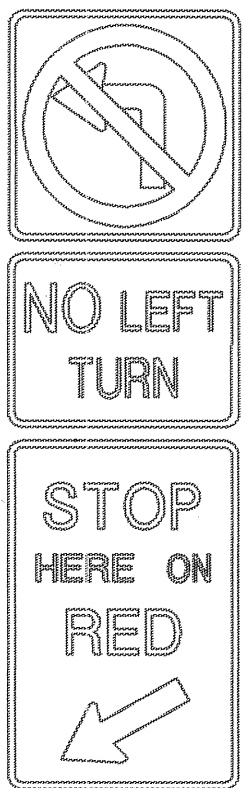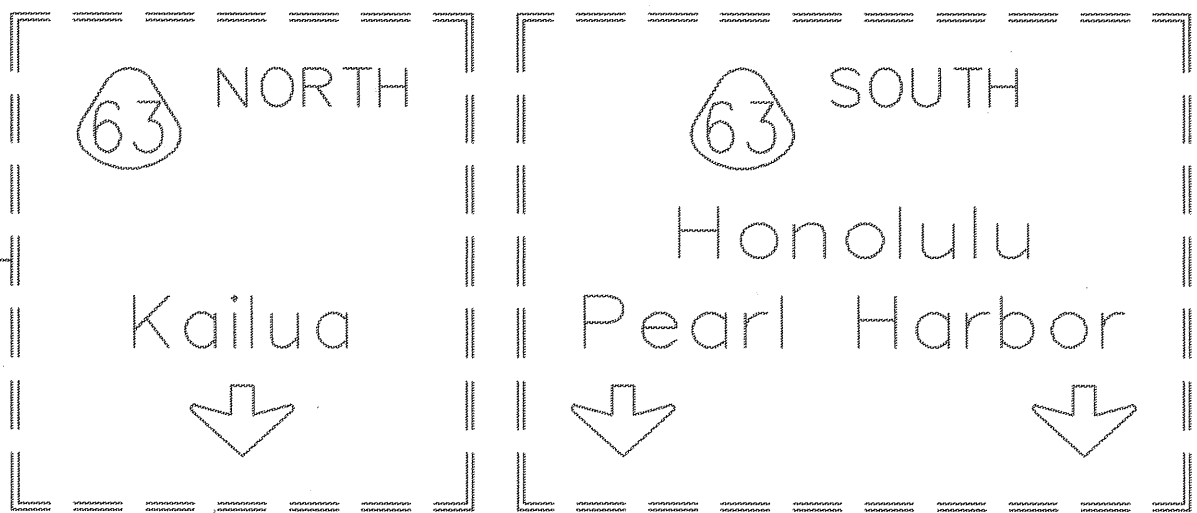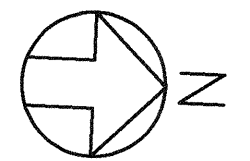


CW21-5(250)A
48"x48"


Matchline
Kahekili Hwy. @ Sta. 15
See Sht. No. 5F3

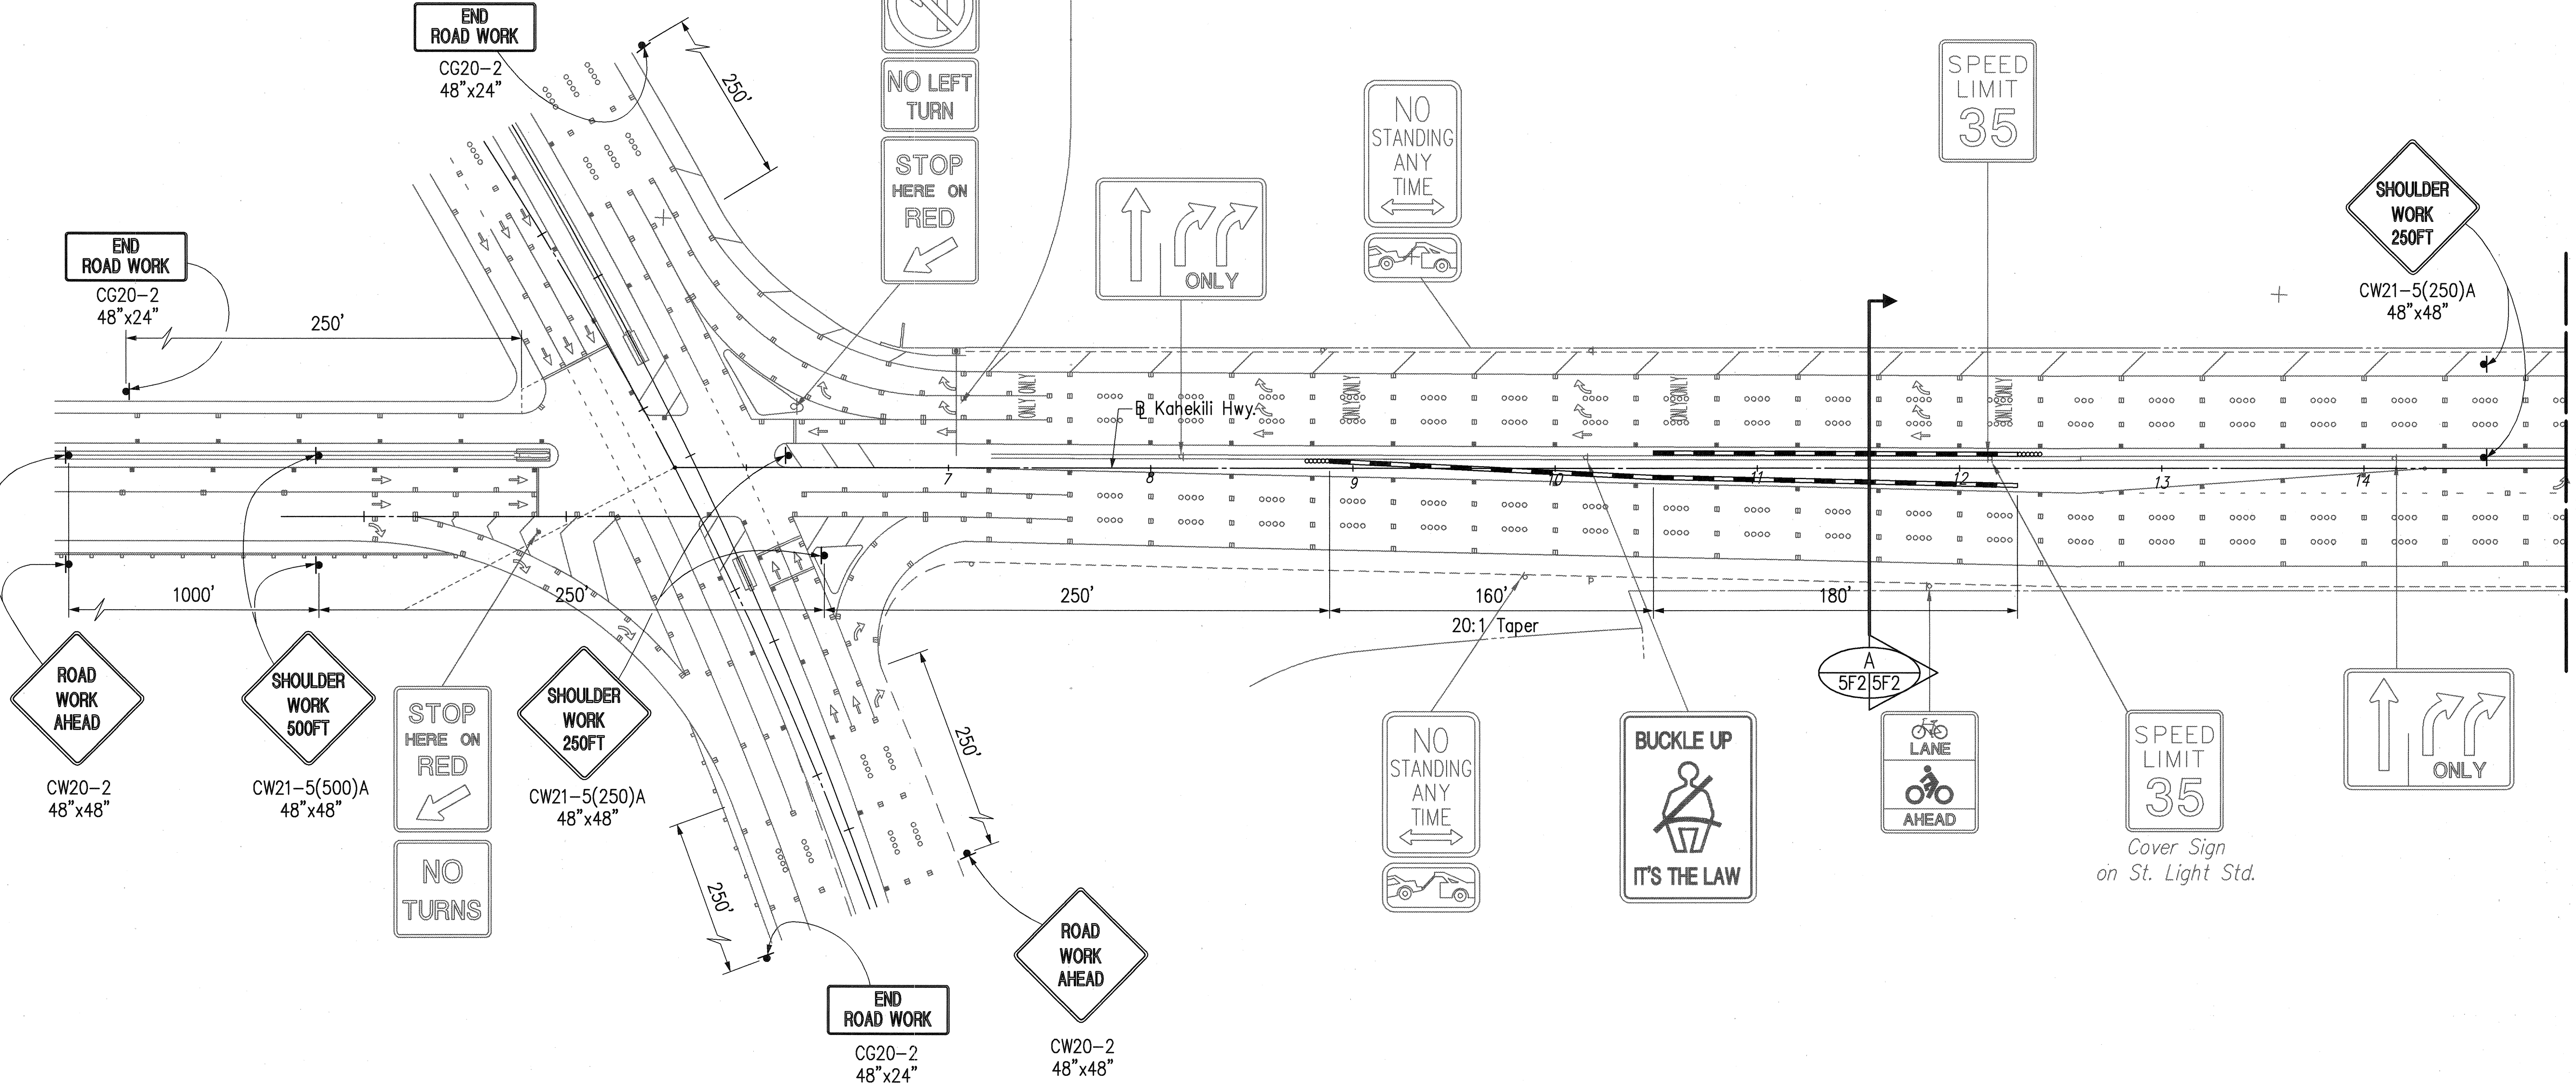

PHASE I - NON WORK HOURS

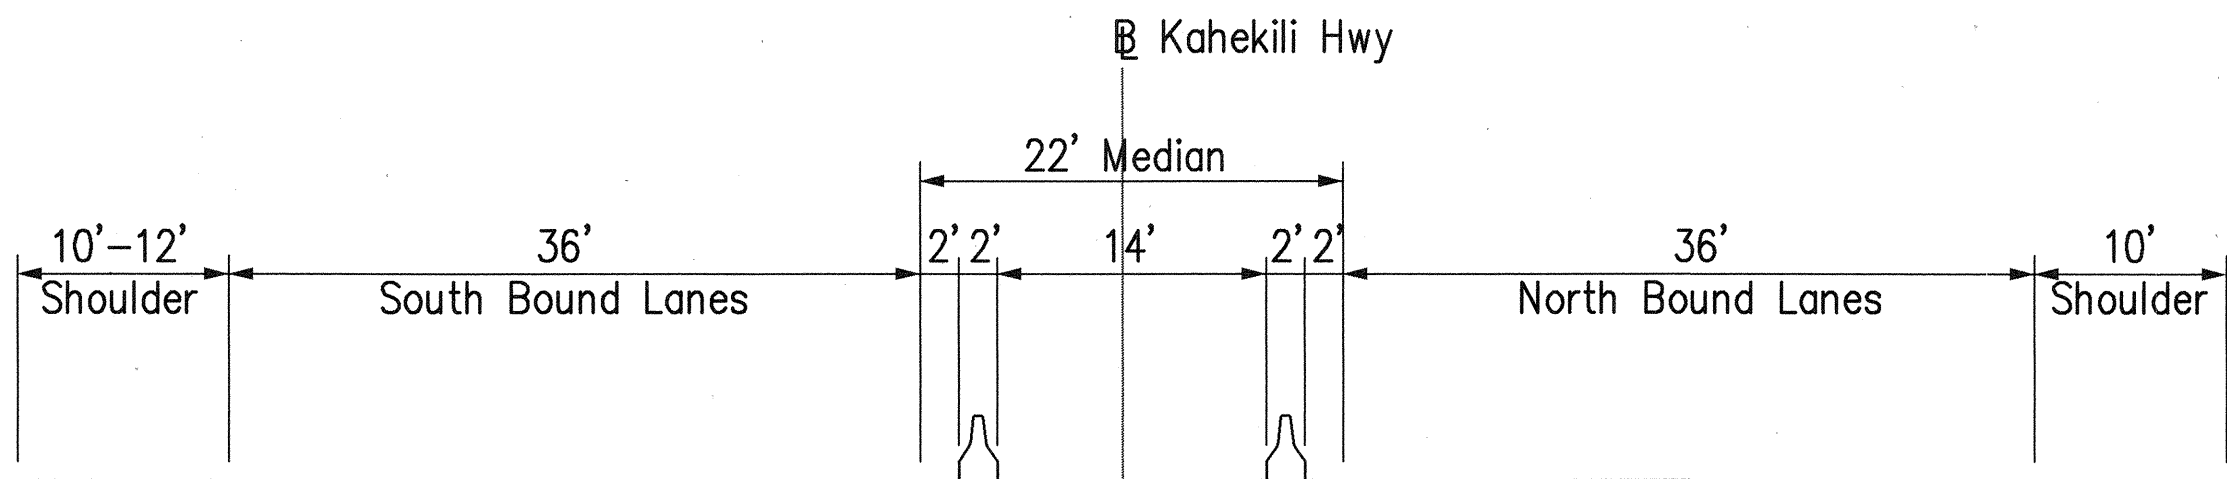

A SECTION
5F2 | 5F2 Scale: 1' = 10'-0"

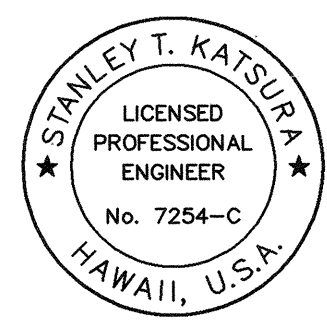

THIS WORK WAS PREPARED BY ME
OR UNDER MY SUPERVISION.

Stanley T. Katsura


5/2/97	Added sheet
Date	Revision
STATE OF HAWAII DEPARTMENT OF TRANSPORTATION HIGHWAYS DIVISION	
WINDWARD	
TRAFFIC CONTROL PLAN - 1	
VMS @ KAHEKILI HIGHWAY	
H-3 FINISH (UNIT II) FAIP NO. I-H3-1(75), UNIT II LEEWARD SECTION	
SCALE: 1' = 40'	DATE: MAY 1997
SHEET NO. 5F2 OF 5 SHEETS	

ADD. 839S-3

ORIGINAL PLAN	DATE
DRAWN BY	
TRACED BY	
DESIGNED BY	
CHECKED BY	
No.	

CAD by L. Yoshimura, 55-52

FED. ROAD DIST. NO.	STATE	FED. AID PROJ. NO.	FISCAL YEAR	SHEET NO.	TOTAL SHEETS
HAWAII	HAW.	I-H3-1(75), UNIT II	1997	ADD 839S-4	1102

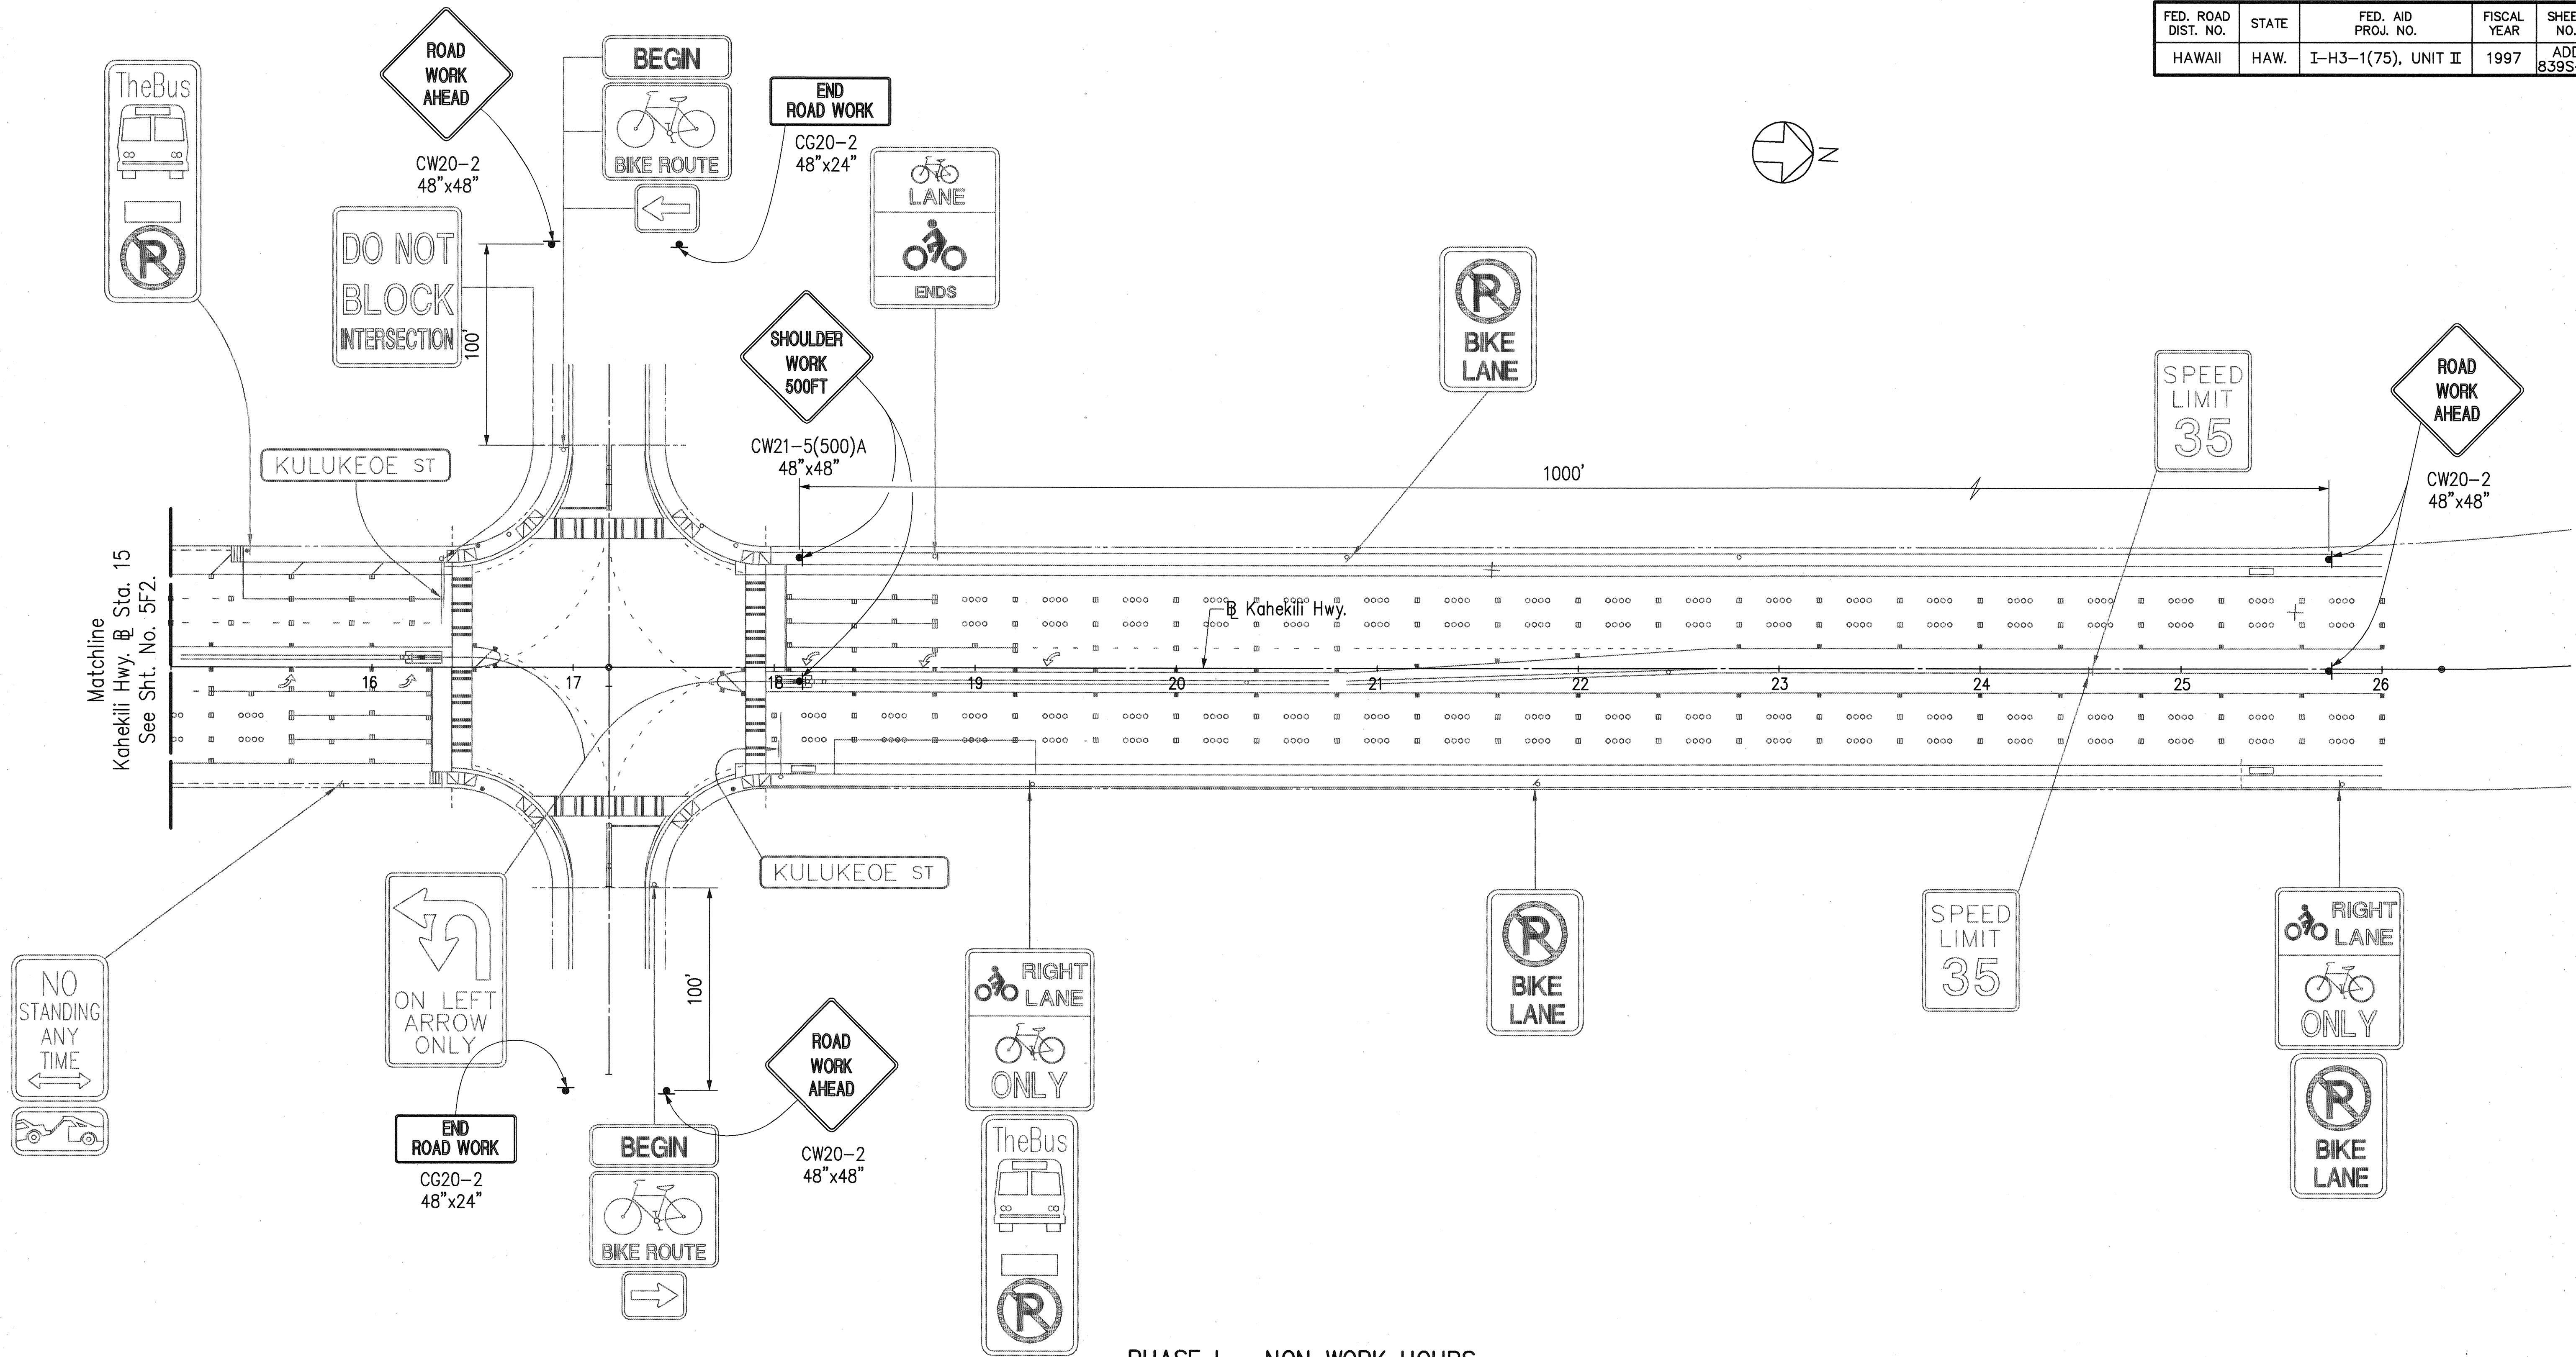


PHASE I - NON WORK HOURS

ORIGINAL PLAN	SURVEY PLOTTED BY	DATE
NOTE BOOK	DRAWN BY	
	DESIGNED BY	
	CHECKED BY	
No.		

CAD by L. Yoshimura, 55-52

Last Saved: J:\H3RF\RFU2\WINDWARD\TOPKHA1B.dwg 05/01/97 at 15:30

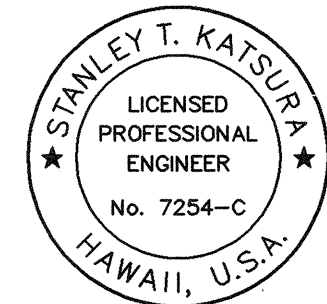



THIS WORK WAS PREPARED BY ME
OR UNDER MY SUPERVISION.

Stanley T. Katsura




5/2/97	Added sheet
Date	Revision
STATE OF HAWAII DEPARTMENT OF TRANSPORTATION HIGHWAYS DIVISION	
WINDWARD	
TRAFFIC CONTROL PLAN - 2	
VMS @ KAHEKILI HIGHWAY	
H-3 FINISH (UNIT II)	
FAIP NO. I-H3-1(75), UNIT II	
LEEWARD SECTION	
SCALE: 1" = 40'	DATE: MAY 1997
SHEET NO. 5F3 OF 5 SHEETS	

ADD. 839S-4

FED. ROAD DIST. NO.	STATE	FED. AID PROJ. NO.	FISCAL YEAR	SHEET NO.	TOTAL SHEETS
HAWAII	HAW.	I-H3-1(75), UNIT II	1997	ADD 839S-5	1102

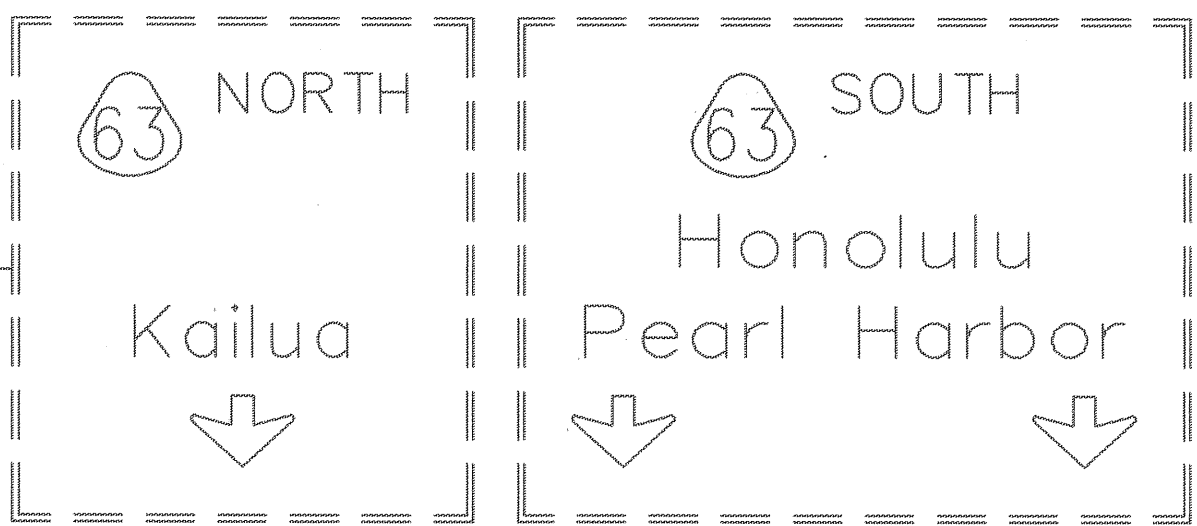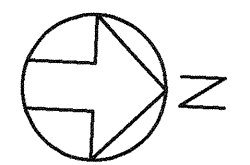

Cover Sign
on St. Light Std.

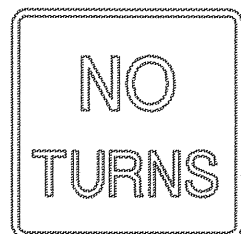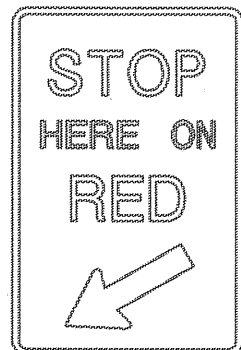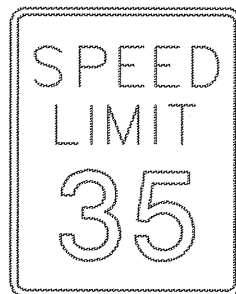


END
ROAD WORK



CG20-2
48"x24"

END
ROAD WORK

CG20-2
48"x24"

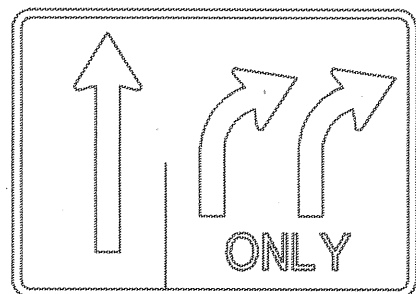

Flashing Arrow Board (Typ.)

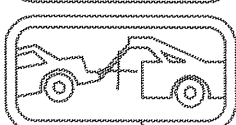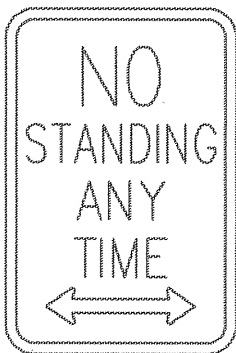

120'

250'

Taper

Matchline
Kahekili Hwy. @ Sta. 15
See Sht. No. 5F5


Work Area



CW20-1A(750)
48"x48"
CW13-1(25)A
24"x24"



CW20-5(500)(L)
48"x48"
CW13-1(25)A
24"x24"

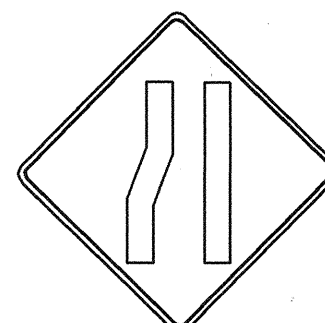

CW4-2(L)A
48"x48"
CW13-1(25)A
24"x24"






END
ROAD WORK

CG20-2
48"x24"





CW20-2
48"x48"

PHASE II - WORK HOURS

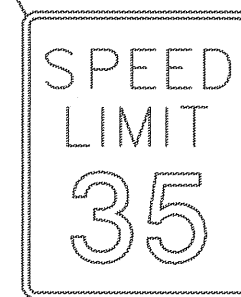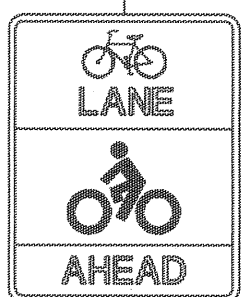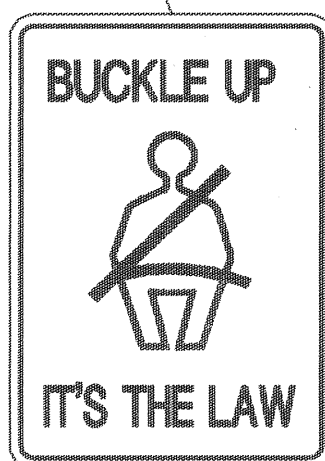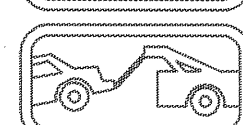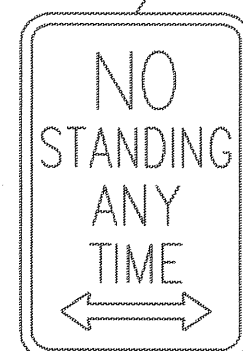

Cover Sign
on St. Light Std.

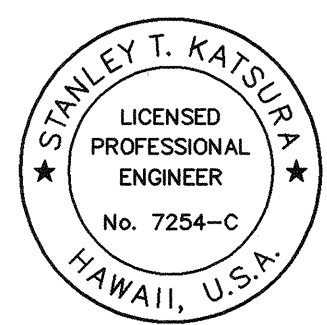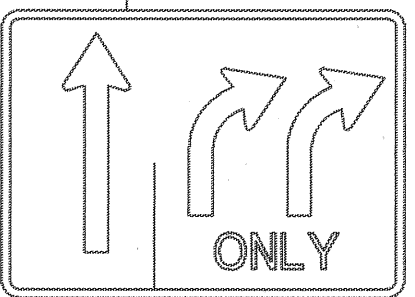

THIS WORK WAS PREPARED BY ME
OR UNDER MY SUPERVISION.

Stanley T. Katsura

Date	Revision
5/2/97	Added sheet
STATE OF HAWAII DEPARTMENT OF TRANSPORTATION HIGHWAYS DIVISION	
WINDWARD	
TRAFFIC CONTROL PLAN - 3	
VMS @ KAHEKILI HIGHWAY	
H-3 FINISH (UNIT II)	
FAIP NO. I-H3-1(75), UNIT II	
LEEWARD SECTION	
SCALE: 1' = 40'	DATE: MAY 1997
SHEET NO. 5F4 OF 5 SHEETS	


ADD. 839S-5

ORIGINAL PLAN	SURVEY PLOTTED BY	DATE
NOTE BOOK	DRAWN BY	
	DESIGNED BY	
	CHECKED BY	
No.		

CAD by L. Yoshimura, 55-52

Last Saved: J:\H3RF\RFU2\WINDWARD\TOPKAH2A.dwg 04/29/97 at 20:48


FED. ROAD DIST. NO.	STATE	FED. AID PROJ. NO.	FISCAL YEAR	SHEET NO.	TOTAL SHEETS
HAWAII	HAW.	I-H3-1(75), UNIT II	1997	ADD 839S-6	1102

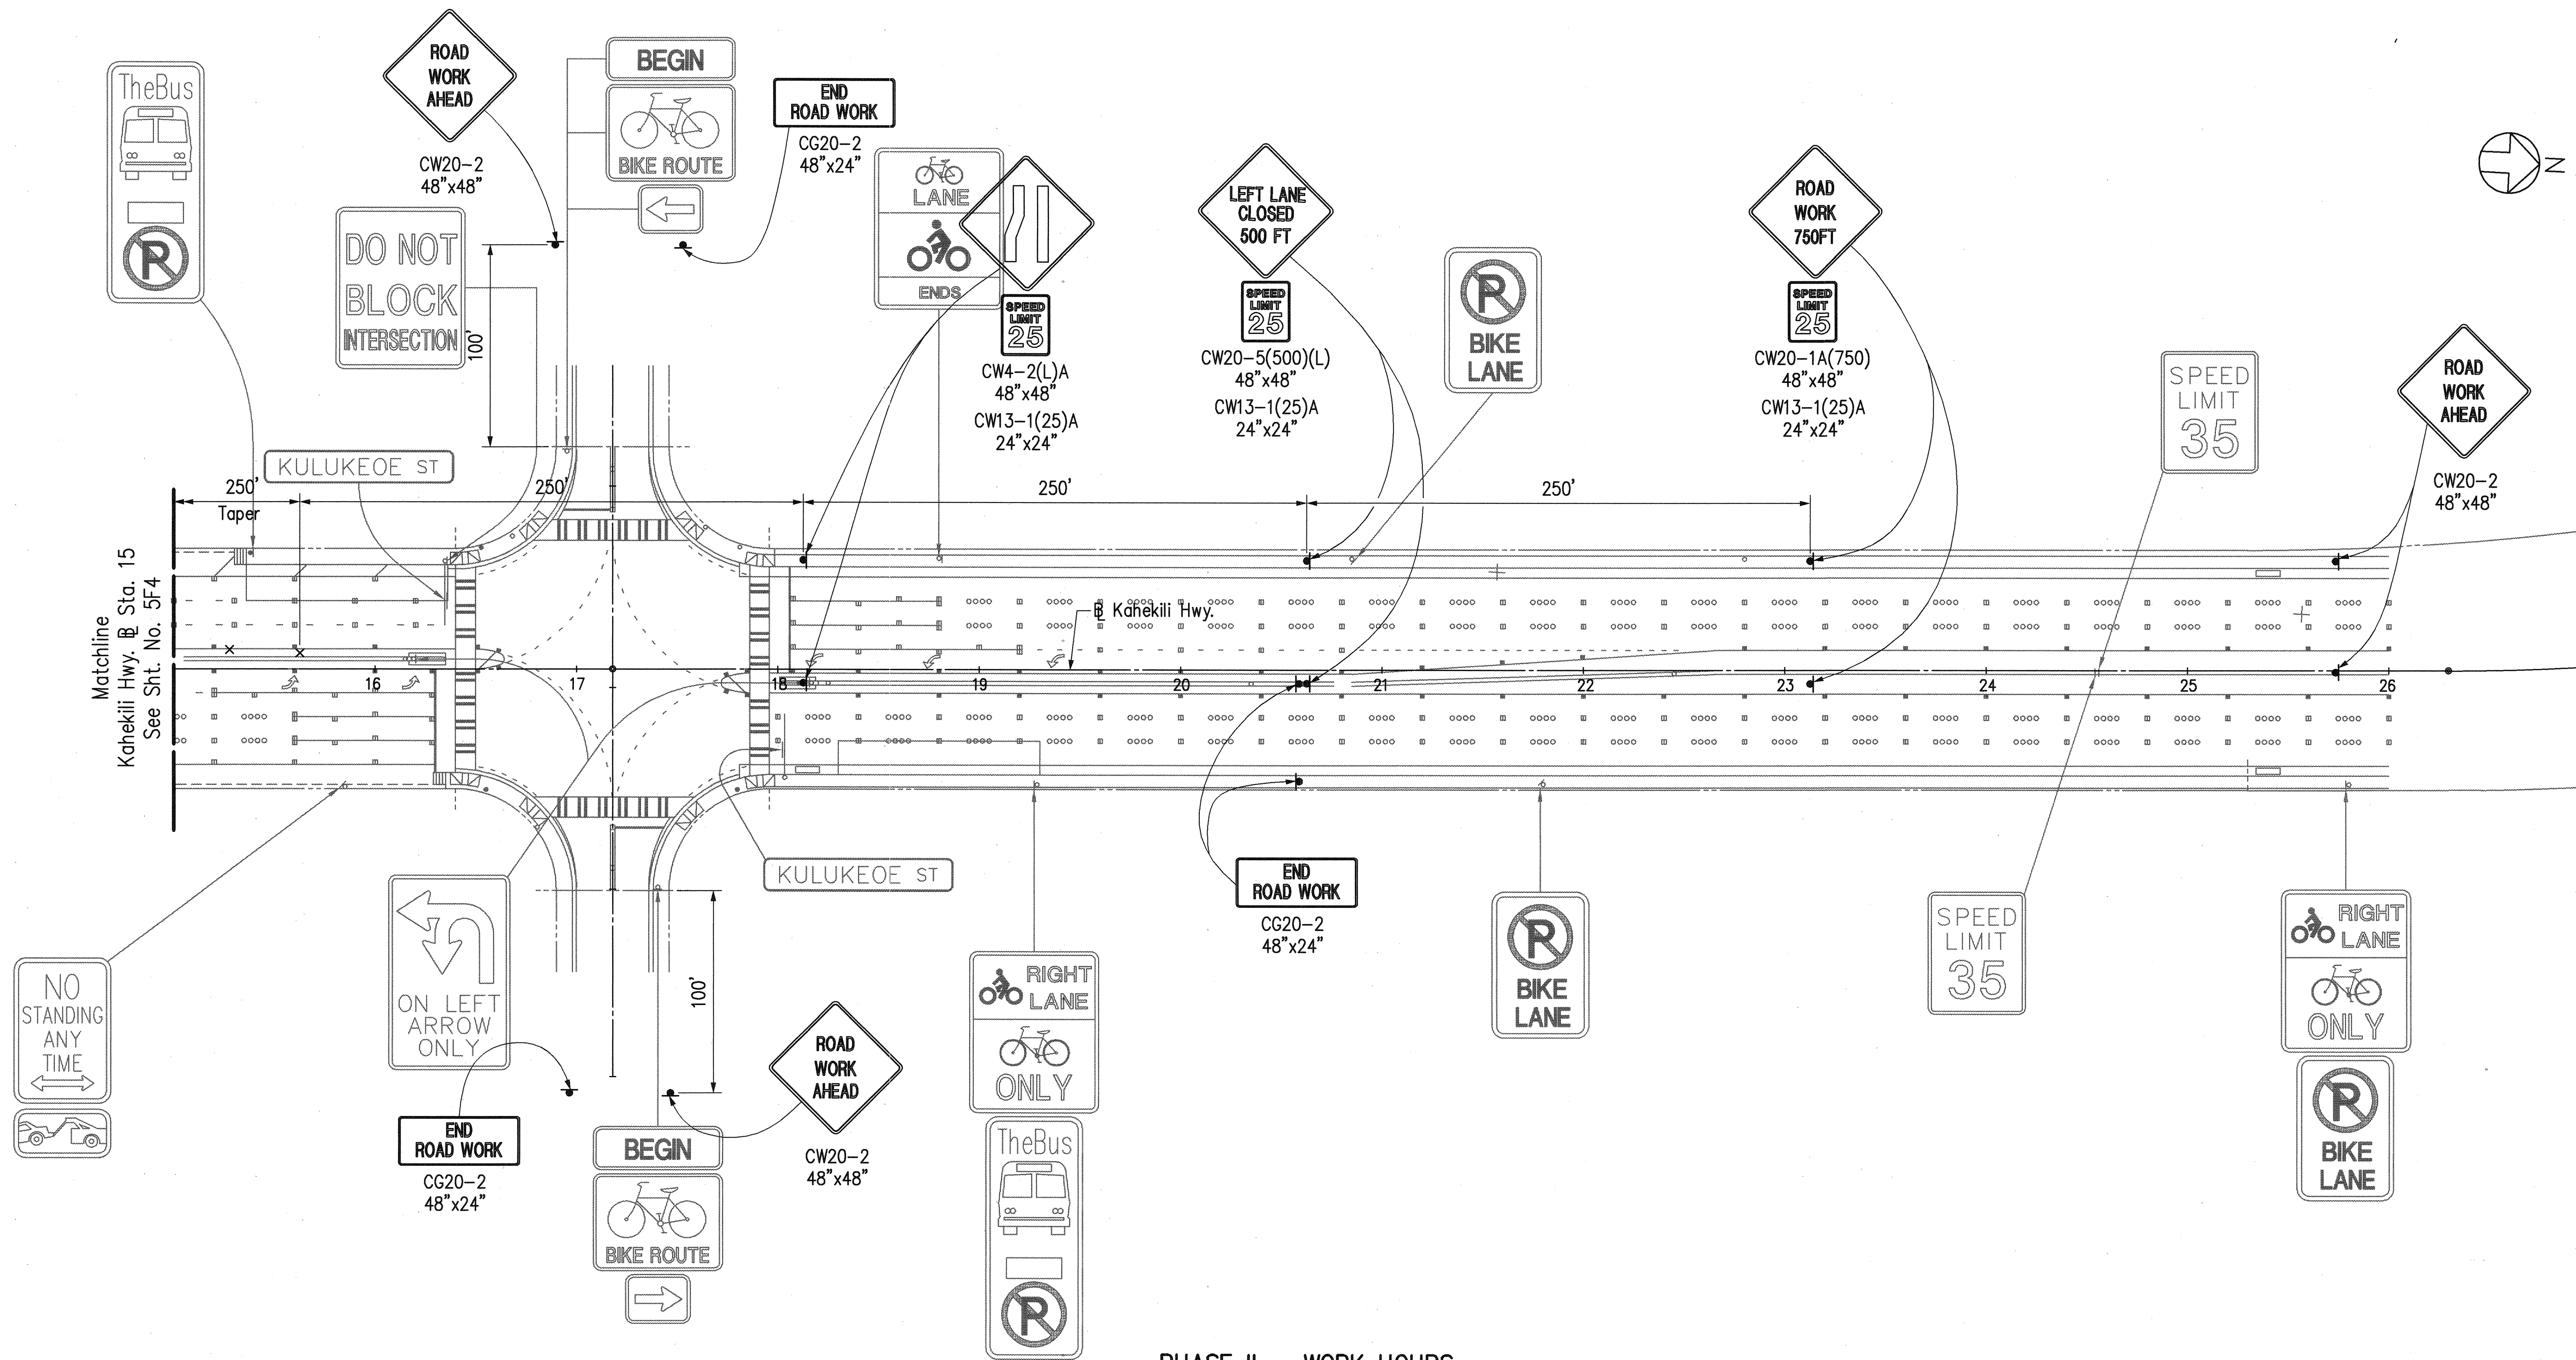

PHASE II - WORK HOURS

ORIGINAL PLAN	SURVEY PLOTTED BY	DATE
NO. 1	DRAWN BY	
NO. 2	TRACED BY	
NO. 3	DESIGNED BY	
NO. 4	CHECKED BY	

CAD by L. Yoshimura, 55-52

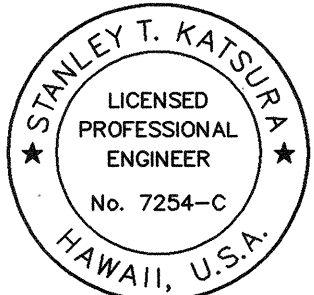


THIS WORK WAS PREPARED BY ME
OR UNDER MY SUPERVISION.

Stanley Katsura

5/2/97	Added sheet
Date	Revision
STATE OF HAWAII DEPARTMENT OF TRANSPORTATION HIGHWAYS DIVISION	
WINDWARD	
TRAFFIC CONTROL PLAN - 4	
VMS @ KAHEKILI HIGHWAY	
H-3 FINISH (UNIT II)	
FAIP NO. I-H3-1(75), UNIT II	
LEEWARD SECTION	
SCALE: 1" = 40'	DATE: MAY 1997
SHEET NO. 5F5 OF 5 SHEETS	

ADD. 839S-6


FED. ROAD DIST. NO.	STATE	FED. AID PROJ. NO.	FISCAL YEAR	SHEET NO.	TOTAL SHEETS
HAWAII	HAW.	I-H3-1(75), UNIT II	1997	840	1102

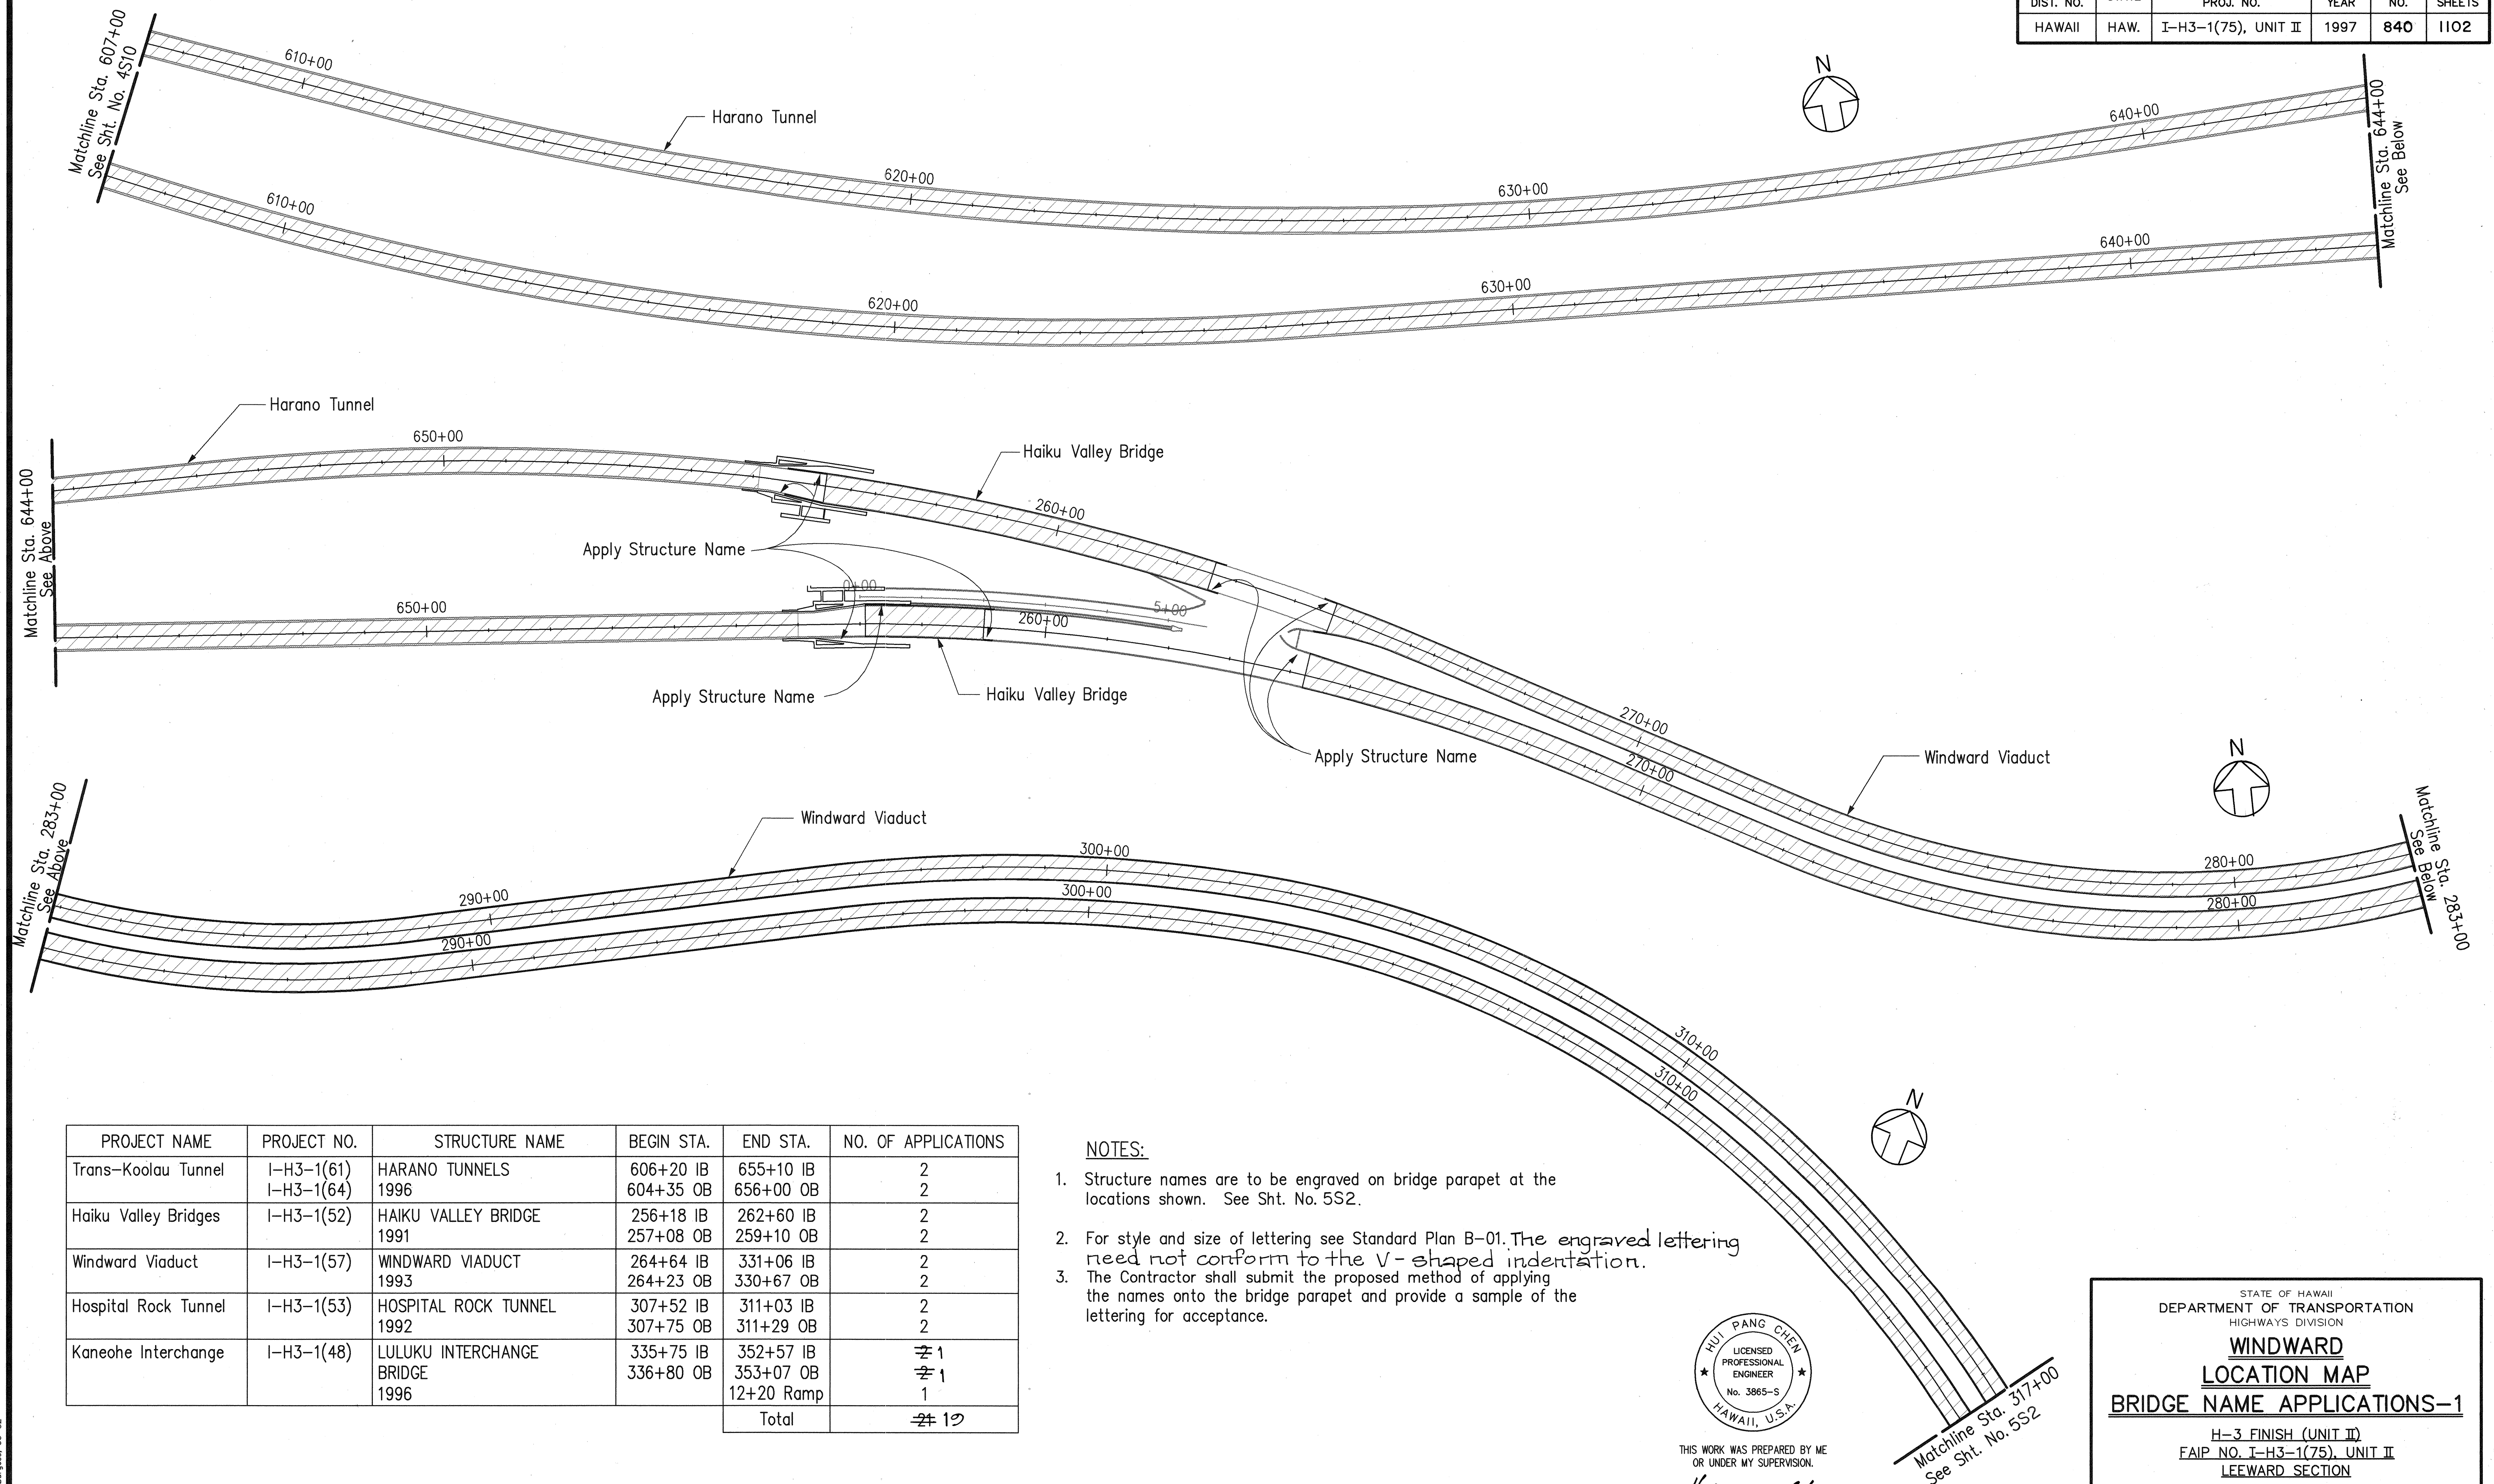

PROJECT NAME	PROJECT NO.	STRUCTURE NAME	BEGIN STA.	END STA.	NO. OF APPLICATIONS
Trans-Koolau Tunnel	I-H3-1(61)	HARANO TUNNELS 1996	606+20 IB	655+10 IB	2
	I-H3-1(64)		604+35 OB	656+00 OB	2
Haiku Valley Bridges	I-H3-1(52)	HAIKU VALLEY BRIDGE 1991	256+18 IB	262+60 IB	2
			257+08 OB	259+10 OB	2
Windward Viaduct	I-H3-1(57)	WINDWARD VIADUCT 1993	264+64 IB	331+06 IB	2
			264+23 OB	330+67 OB	2
Hospital Rock Tunnel	I-H3-1(53)	HOSPITAL ROCK TUNNEL 1992	307+52 IB	311+03 IB	2
			307+75 OB	311+29 OB	2
Kaneohe Interchange	I-H3-1(48)	LULUKU INTERCHANGE BRIDGE 1996	335+75 IB	352+57 IB	2 1
			336+80 OB	353+07 OB 12+20 Ramp	2 1 1
				Total	21 12

NOTES:

1. Structure names are to be engraved on bridge parapet at the locations shown. See Sht. No. 5S2.
2. For style and size of lettering see Standard Plan B-01. ~~The engraved lettering need not conform to the V-shaped indentation.~~
3. The Contractor shall submit the proposed method of applying the names onto the bridge parapet and provide a sample of the lettering for acceptance.


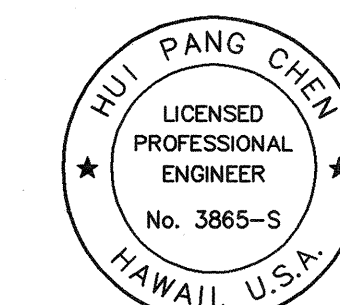


THIS WORK WAS PREPARED BY ME
OR UNDER MY SUPERVISION.

Shirong Chen


STATE OF HAWAII
DEPARTMENT OF TRANSPORTATION
HIGHWAYS DIVISION
WINDWARD
LOCATION MAP
BRIDGE NAME APPLICATIONS—1
H-3 FINISH (UNIT II)
FAIP NO. I-H3-1(75), UNIT II
LEEWARD SECTION
SCALE: 1"=120' DATE: JANUARY 1997
SHEET NO. 5S1 OF 3 SHEETS

FED. ROAD DIST. NO.	STATE	FED. AID PROJ. NO.	FISCAL YEAR	SHEET NO.	TOTAL SHEETS
HAWAII	HAW.	I-H3-1(75), UNIT II	1997	841	1102

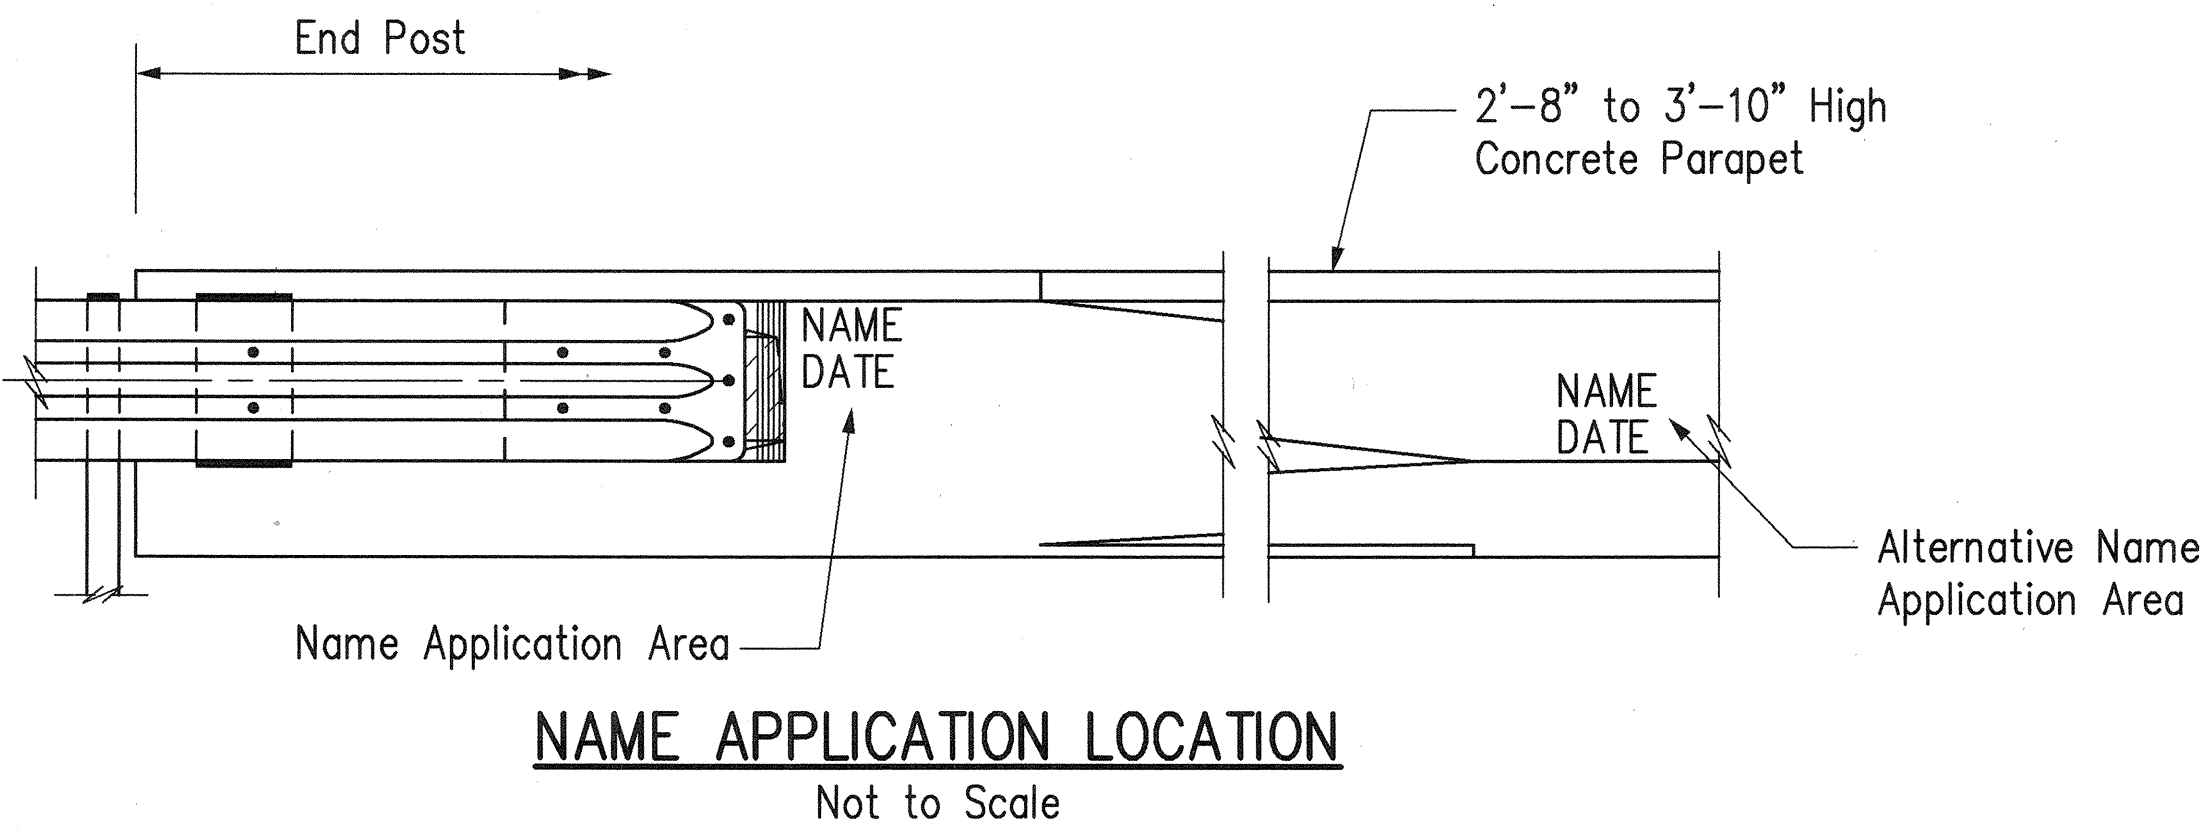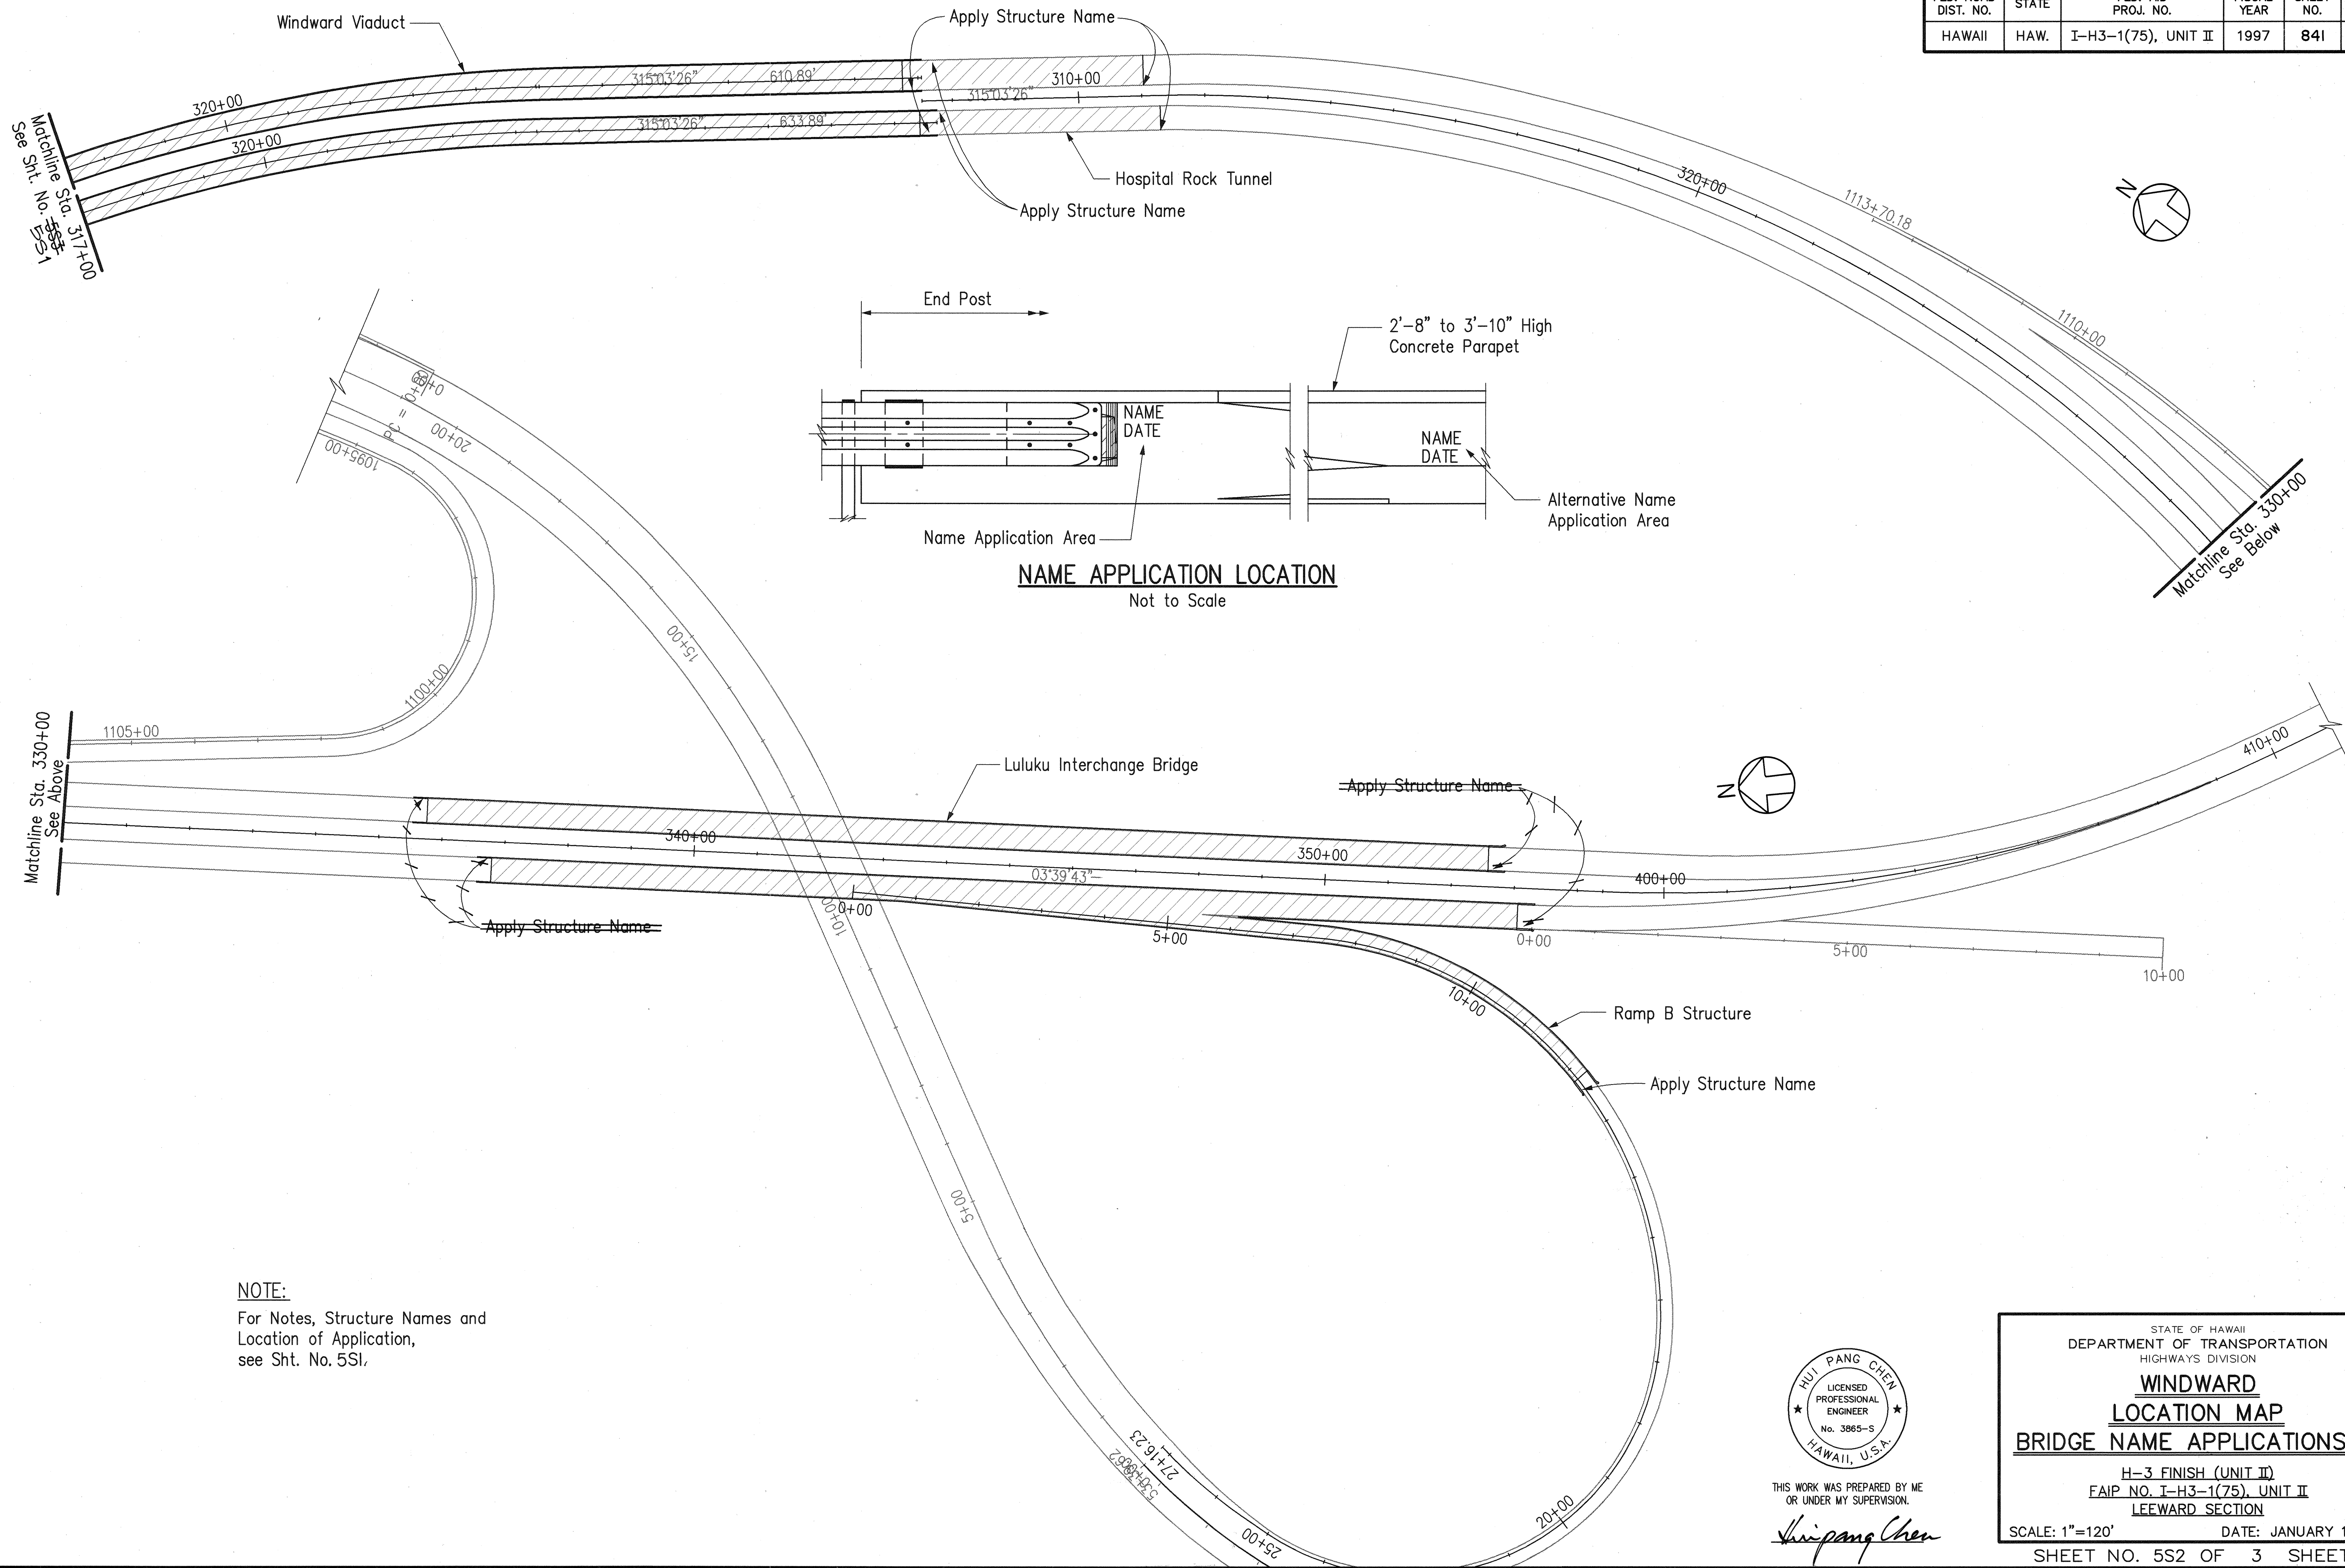

NOTE:
For Notes, Structure Names and Location of Application, see Sht. No. 5S1,

ORIGINAL PLAN	SURVEY PLOTTED BY	DATE
NOTE BOOK	DRAWN BY	
	TRACED BY	
	DESIGNED BY	
	CHECKED BY	
	No.	

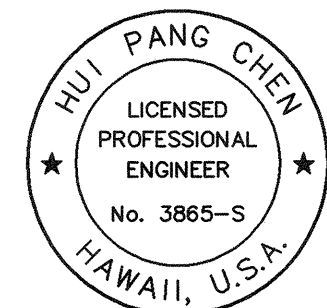

THIS WORK WAS PREPARED BY ME
OR UNDER MY SUPERVISION.
Hui Pang Chen

STATE OF HAWAII
DEPARTMENT OF TRANSPORTATION
HIGHWAYS DIVISION

**WINDWARD
LOCATION MAP**

BRIDGE NAME APPLICATIONS-2

H-3 FINISH (UNIT II)
FAIP NO. I-H3-1(75), UNIT II
LEEWARD SECTION

SCALE: 1"=120' DATE: JANUARY 1997

SHEET NO. 5S2 OF 3 SHEETS

FED. ROAD DIST. NO.	STATE	FED. AID PROJ. NO.	FISCAL YEAR	SHEET NO.	TOTAL SHEETS
HAWAII	HAW.	I-H3-1(75), UNIT II	1997	842	1102

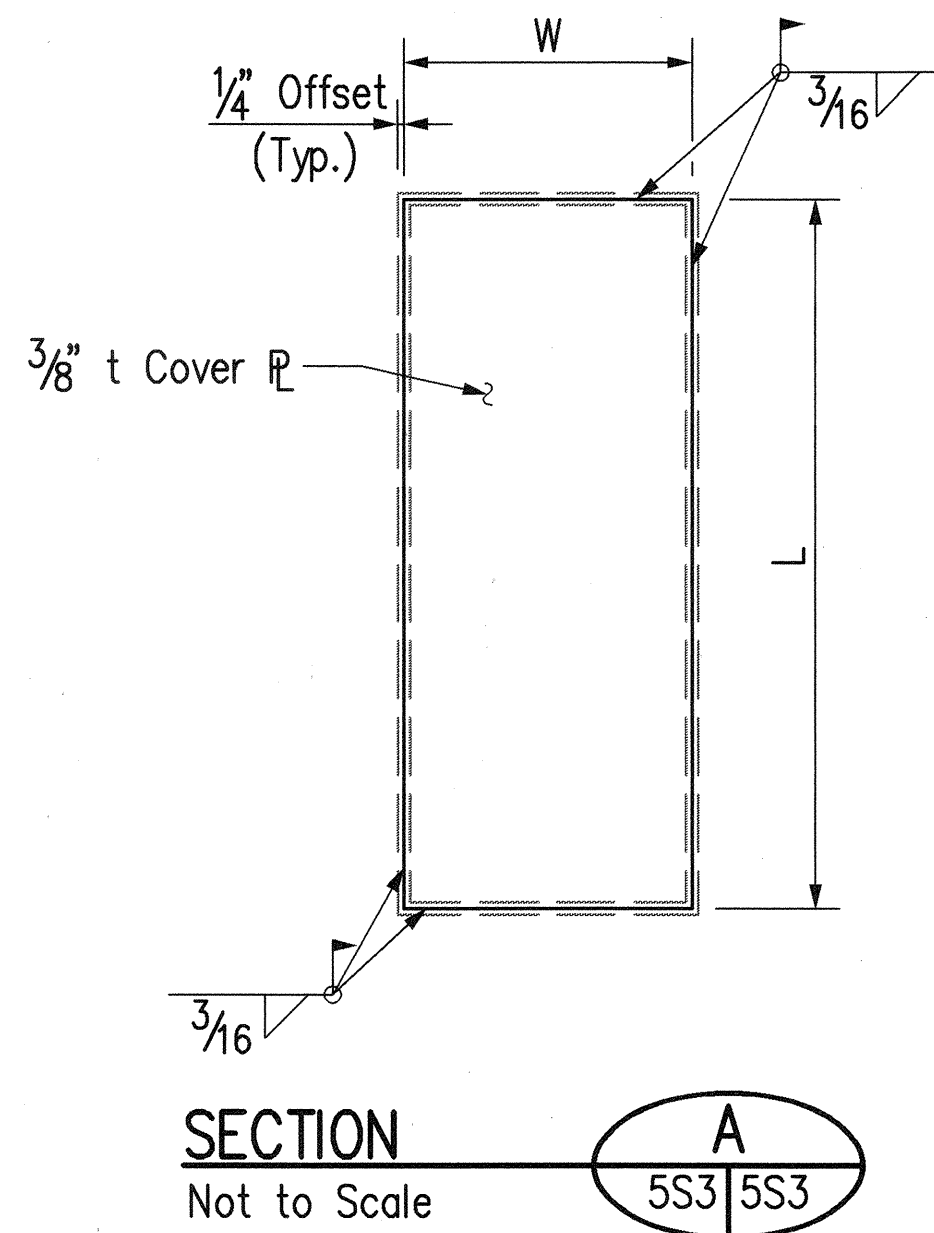


TABLE A										
STATION	APPURTENANCE MOUNTED ON STRUCTURE	LEFT POST			MIDDLE POST			RIGHT POST		
		H	COVER PLATE		H	COVER PLATE		H	COVER PLATE	
			W	L		W	L		W	L
IB 258+66.00	LCD	Not Applicable			Not Applicable			13'-4"	0'-7 1/2"	0'-11 1/2"
IB 273+73.70	FB	18'-8 1/2"	0'-7 1/2"	1'-3 1/2"	Not Applicable			15'-11"	0'-7 1/2"	1'-3 1/2"
IB 290+75.53	OHD	15'-0"	0'-7 1/2"	0'-11 1/2"	Not Applicable			14'-5"	0'-7 1/2"	0'-11 1/2"
IB 311+05.53	LCD	9'-7"	0'-7 1/2"	0'-11 1/2"	Not Applicable			Not Applicable		
OB 259+40.00	FB	20'-1"	0'-7 1/2"	0'-11 1/2"	Not Applicable			21'-9 5/16"	0'-7 1/2"	0'-11 1/2"
OB 261+40.00	LCD	Not Applicable			13'-8 9/16"	0'-7 1/2"	1'-3 1/2"	13'-8 9/16"	0'-7 1/2"	1'-3 1/2"


IB = Inbound
OB = Outbound


FB = Flashing Beacon
OHD = Overheight Detector
LCD = Lane Control Display

NOTES:

- For dimensions 'H', 'W', and 'L', see Table A. The dimension 'H' is approximate. The contractor shall verify the dimension in the field.
- Cover Plate shall conform to ASTM A36.
- All existing support structures shall remain erect, complete and in-place during post modification work at the locations shown in Table A.
- Welds shall be continuous and shall be done in the field only where shown on plans.
- Field welds shall be performed by a certified welder. All welding shall conform to the requirements of ANSI/AASHTO/AWS D1.5-88, "Bridge Welding Code".
- See Special Provisions Sections 501.03(1)(J), "Removal of Excess Height of the Existing Structural Tubing Posts".
- The Contractor shall take precautionary measures so that existing, complete in-place support structures and existing support structures-mounted appurtenances are not damaged during post modification work. The appurtenances include lane control displays, traffic signals, variable message signs, weather monitoring devices, changeable message signs, fixed message signs, luminaires, cameras, flashing beacons, and overheight detectors.


LEGEND:

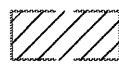 Existing Structure to be removed

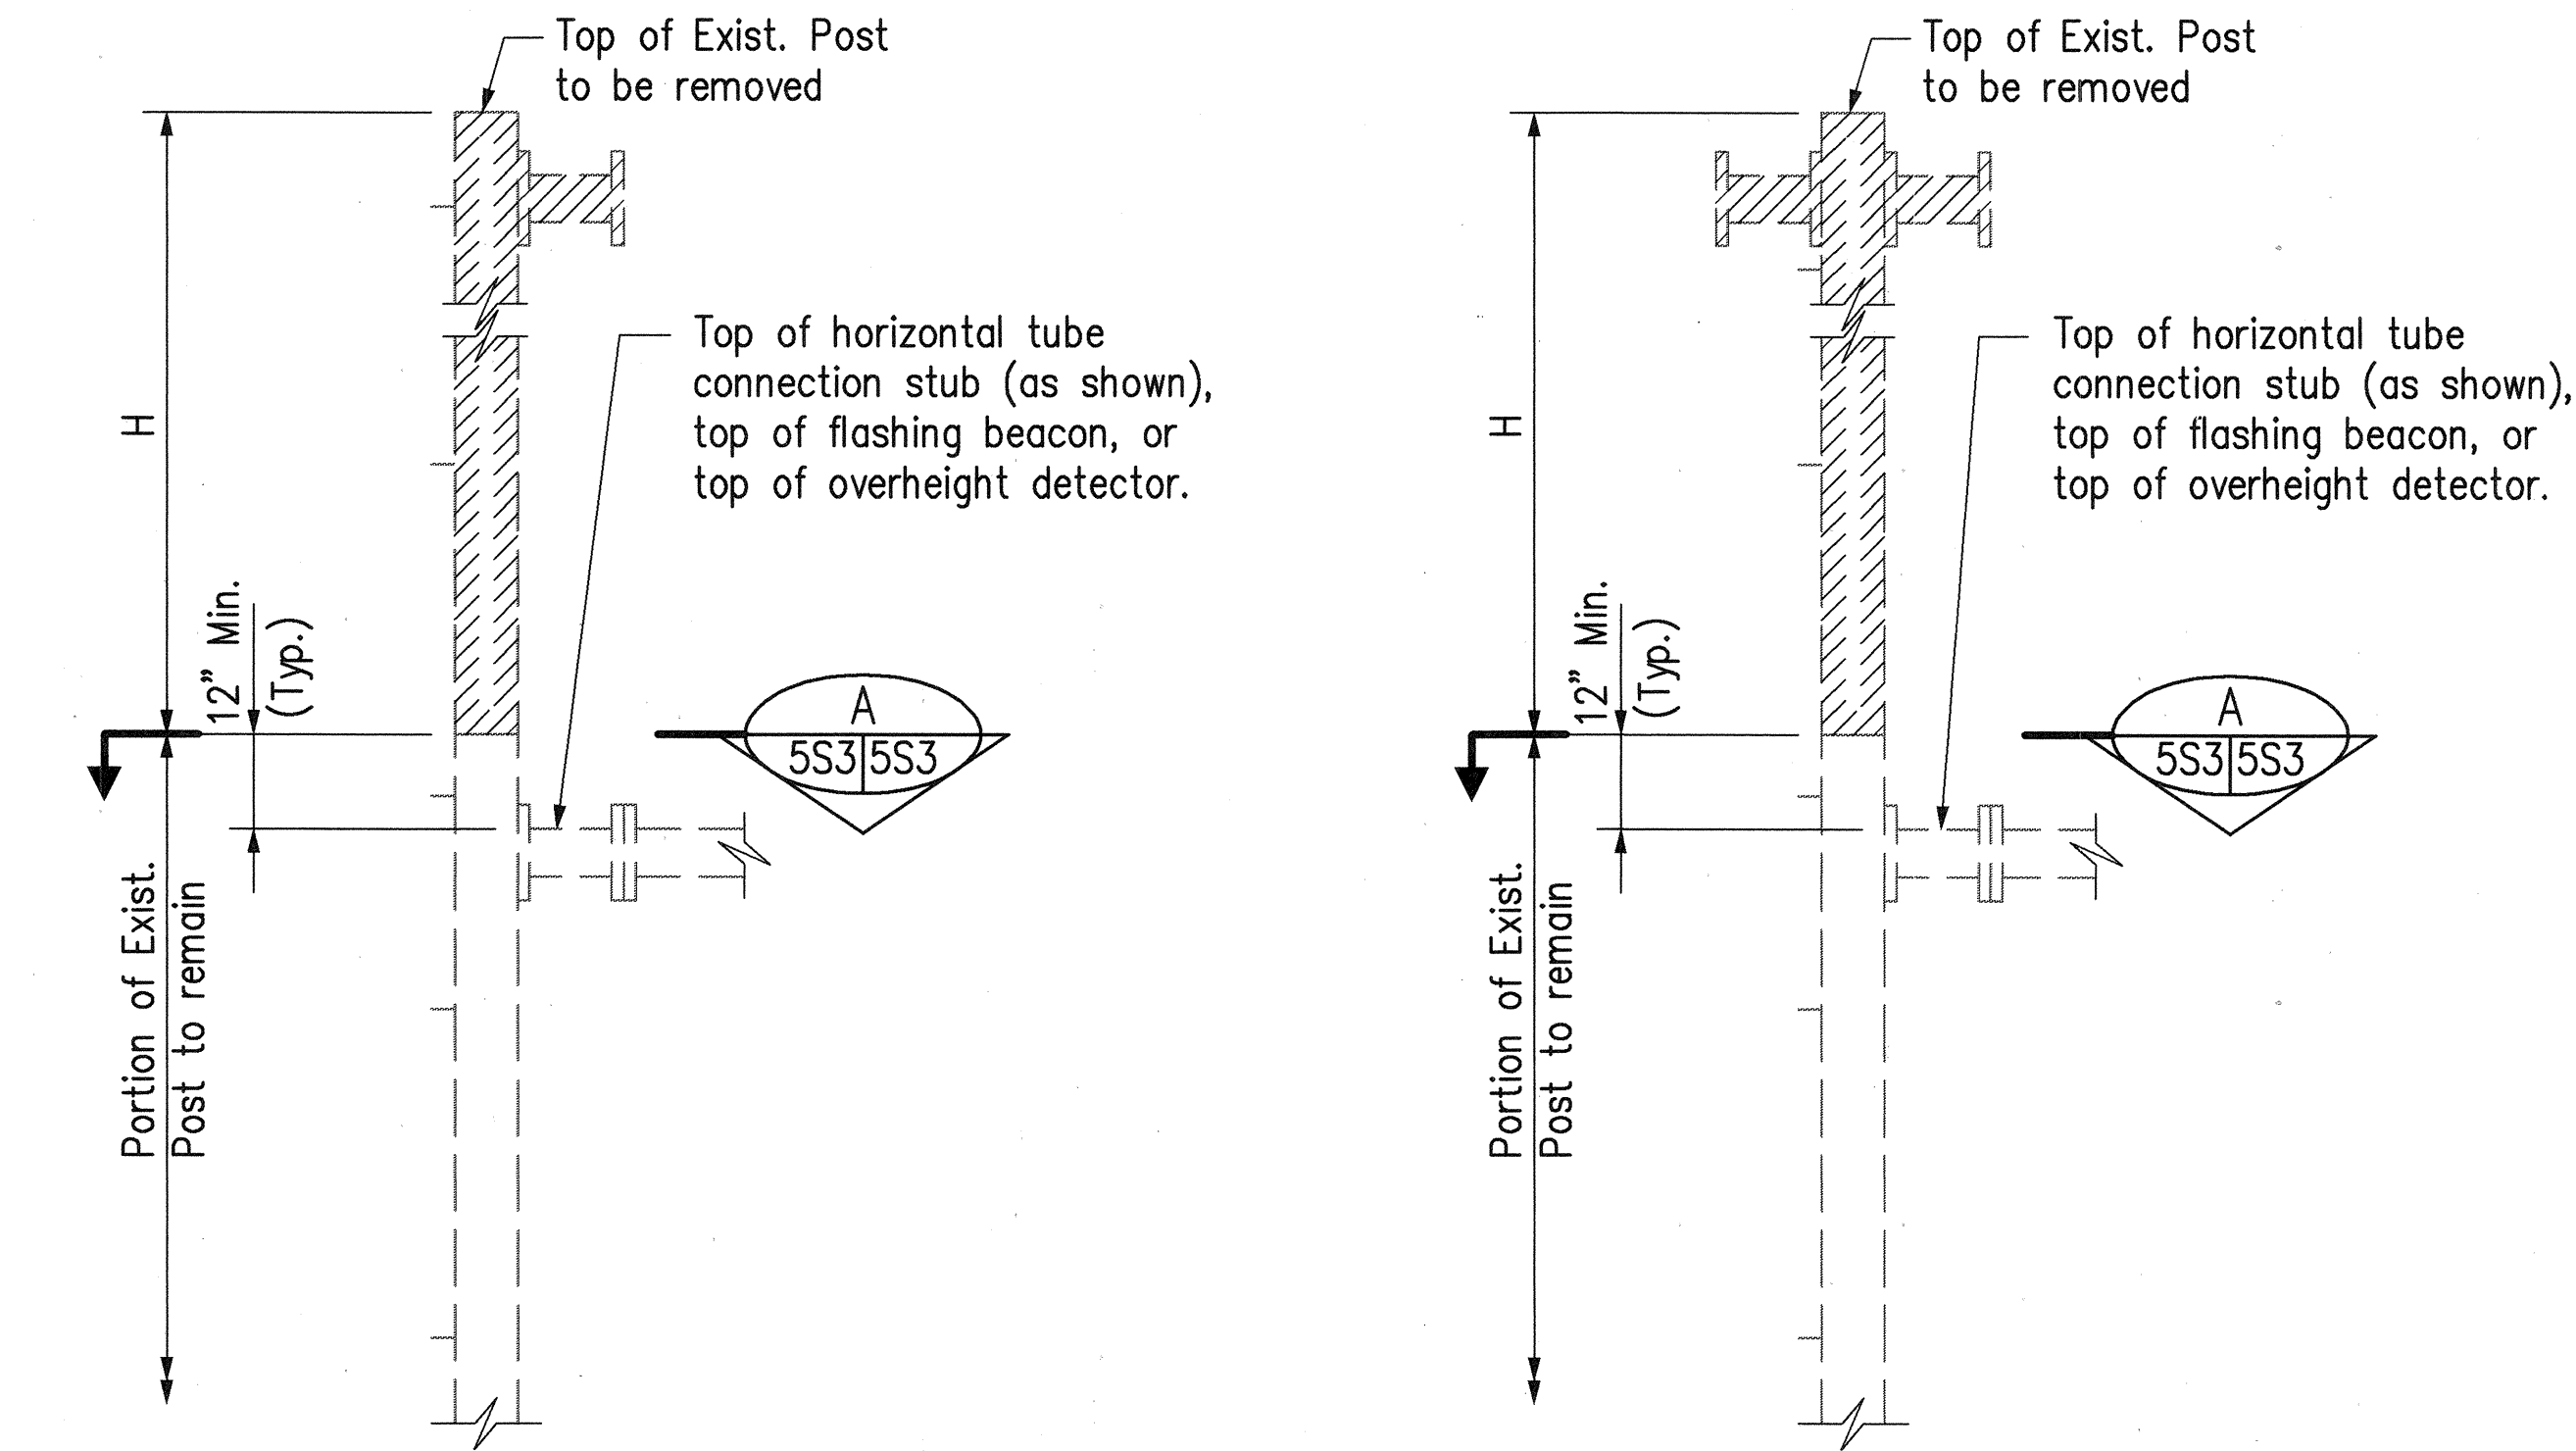

LEFT POST (AS SHOWN)
RIGHT POST (SIMILAR EXCEPT OPPOSITE)

LANE CONTROL DISPLAY
SUPPORT STRUCTURE
(LOOKING UPSTATION)
Scale: 1/2" = 1'-0"

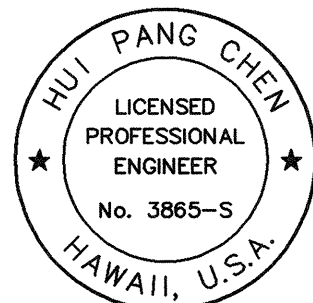


THIS WORK WAS PREPARED BY ME
OR UNDER MY SUPERVISION.

Hui Pang Chen


STATE OF HAWAII
DEPARTMENT OF TRANSPORTATION
HIGHWAYS DIVISION
WINDWARD
EXISTING SUPPORT STRUCTURES
POST MODIFICATIONS
H-3 FINISH (UNIT II)
FAIP NO. I-H3-1(75), UNIT II
LEEWARD SECTION
SCALE: AS SHOWN DATE: JANUARY 1997
SHEET NO. 5S3 OF 3 SHEETS

FED. ROAD DIST. NO.	STATE	FED. AID PROJ. NO.	FISCAL YEAR	SHEET NO.	TOTAL SHEETS
HAWAII	HAW.	I-H3-1(75), UNIT II	1997	C.O. 842S-1	1102


***NOTE A:**
The Contractor shall verify the tilt of post to determine dimension 't' prior to fabrication of the shim plates. All shim plates shall be ASTM A36 steel hot-dipped galvanized after fabrication.

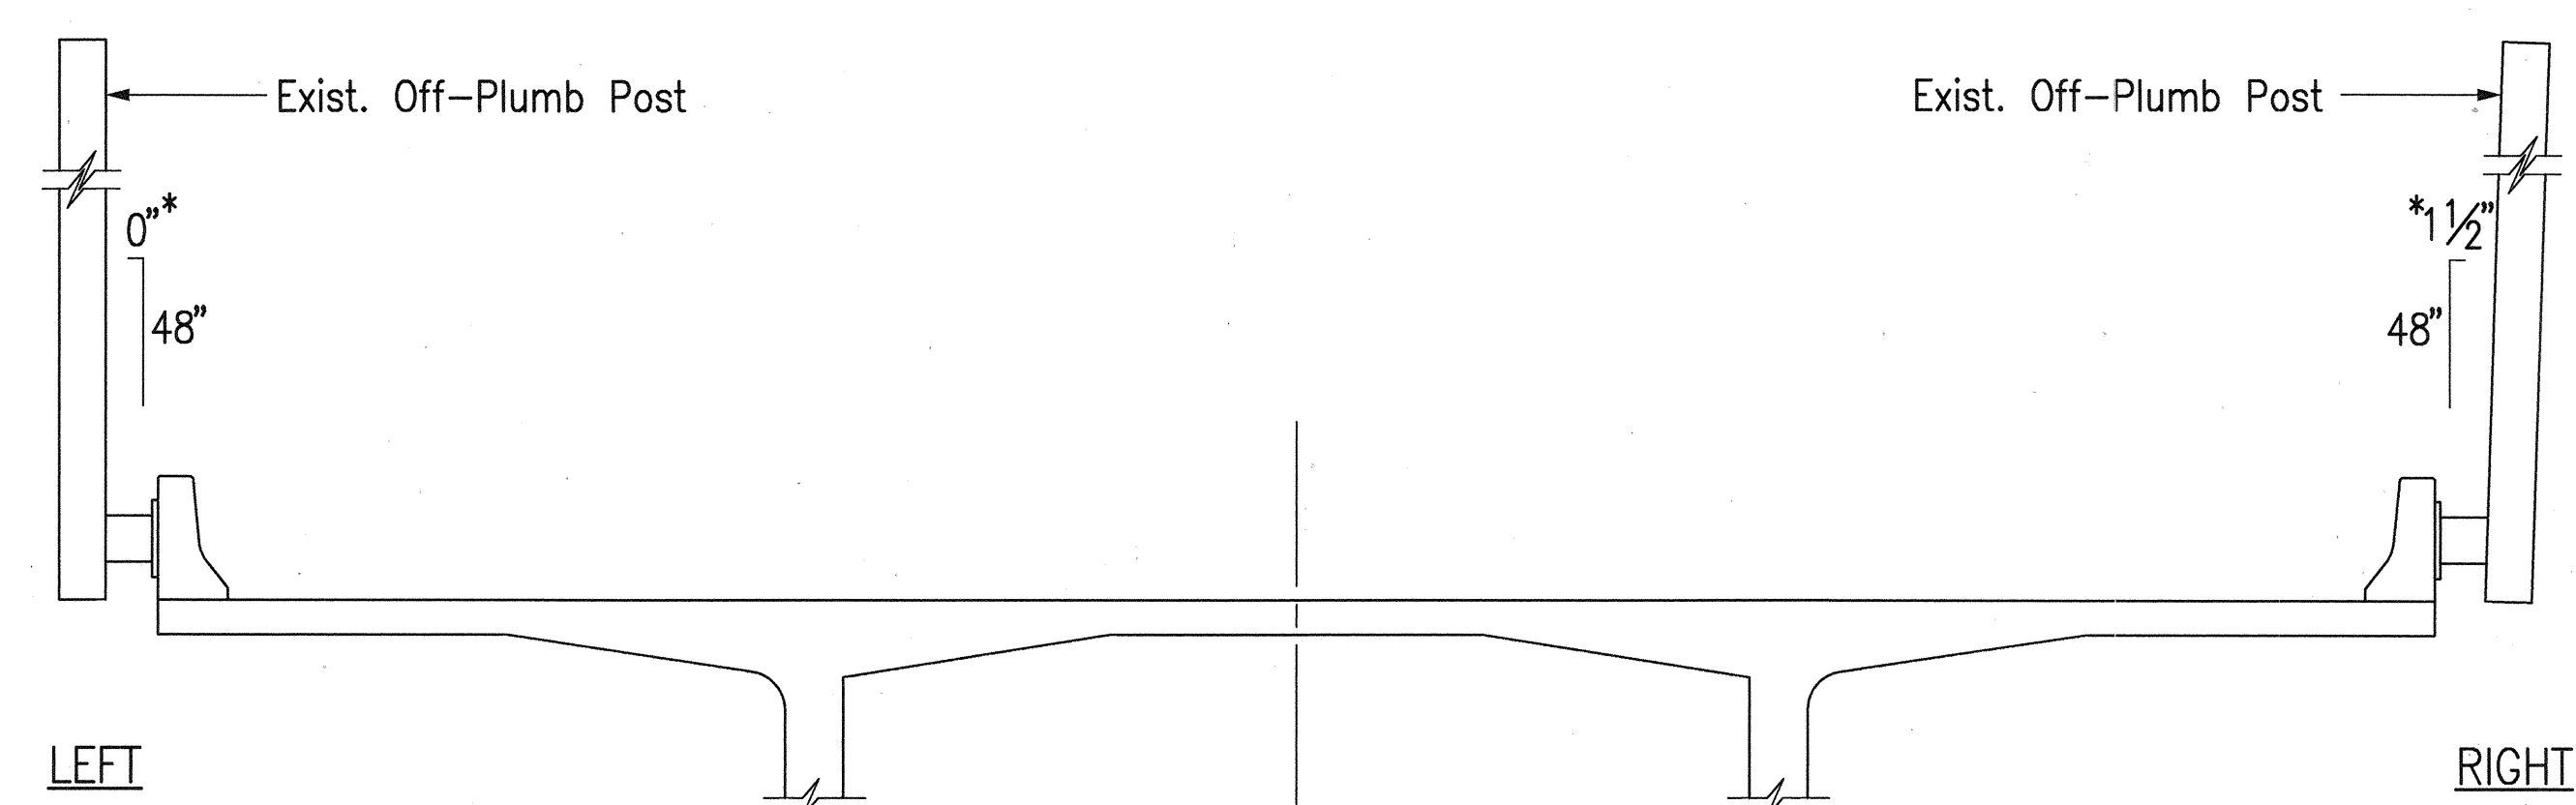


I.B. STA. 273+73.70
(10 Bolt Pattern)
(Looking Toward T-K Tunnel)
Not to Scale

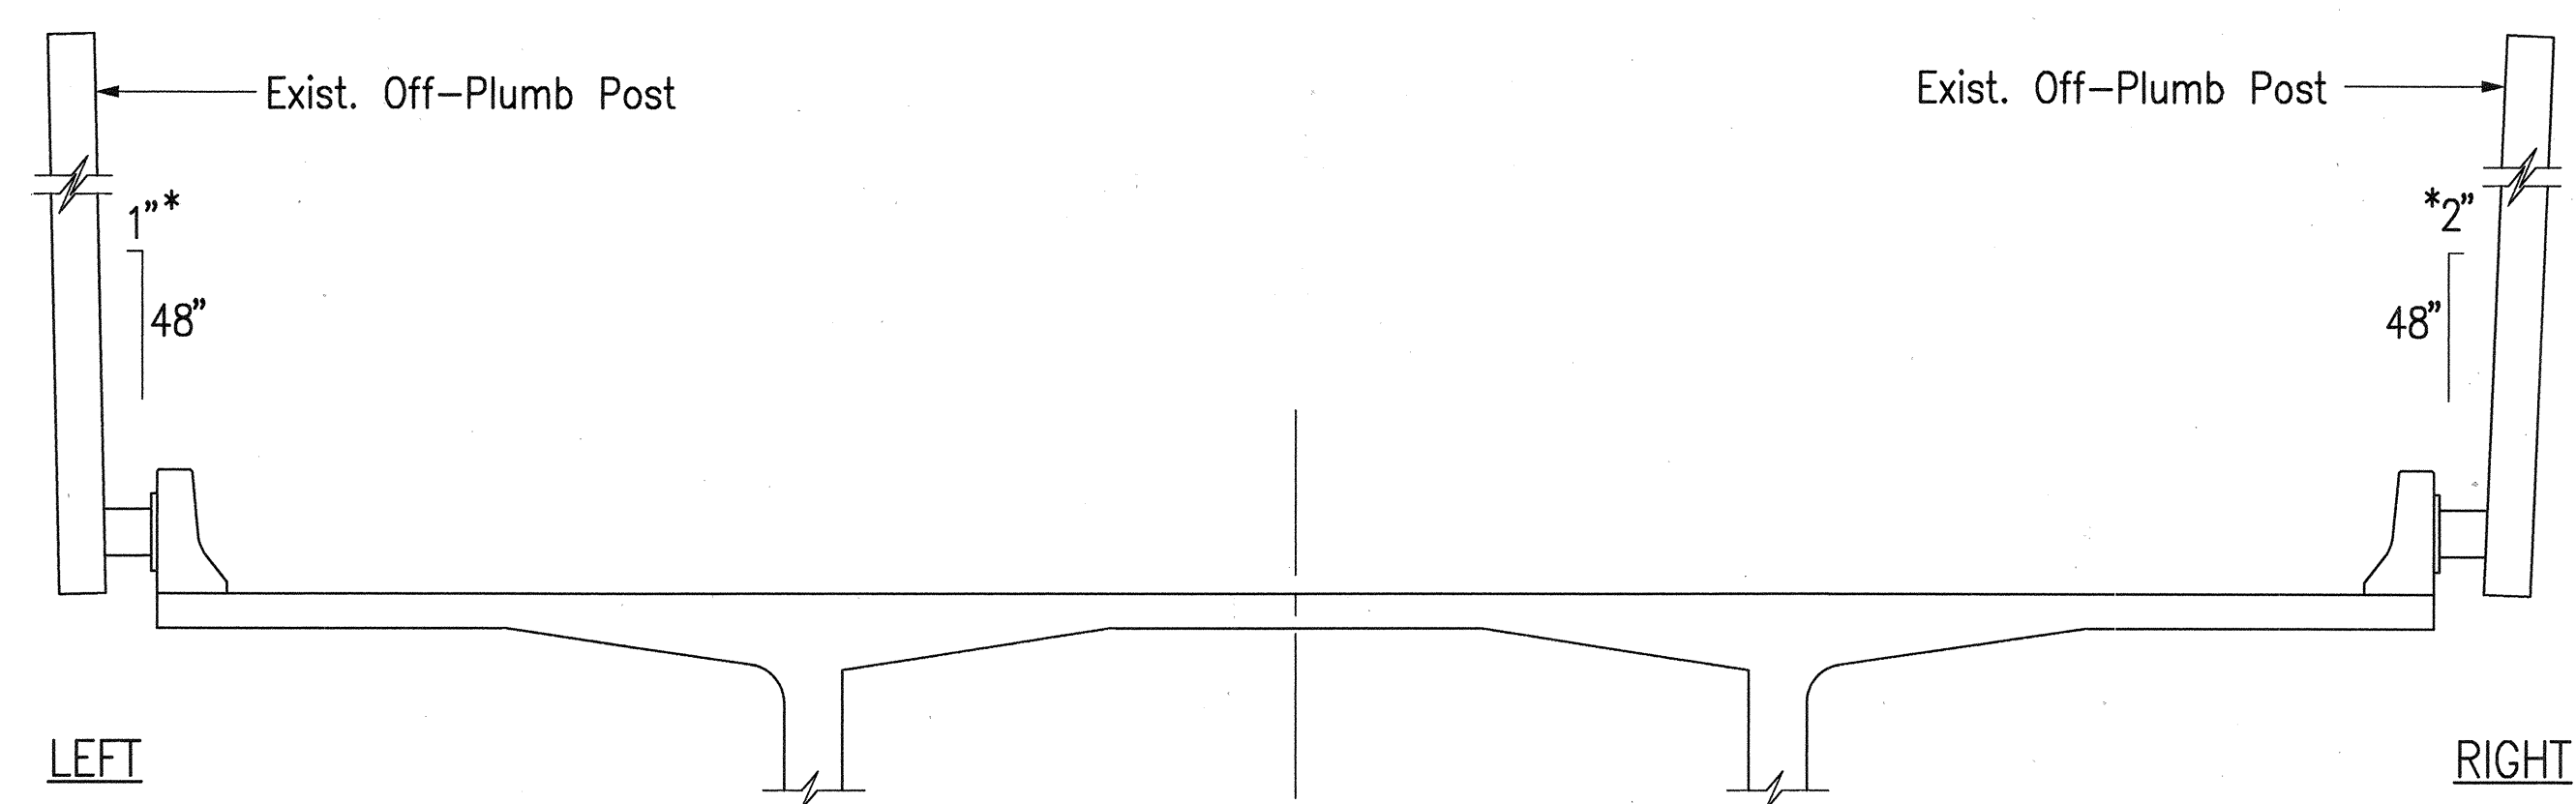


I.B. STA. 290+73.53
(6 Bolt Pattern)
(Looking Toward T-K Tunnel)
Not to Scale

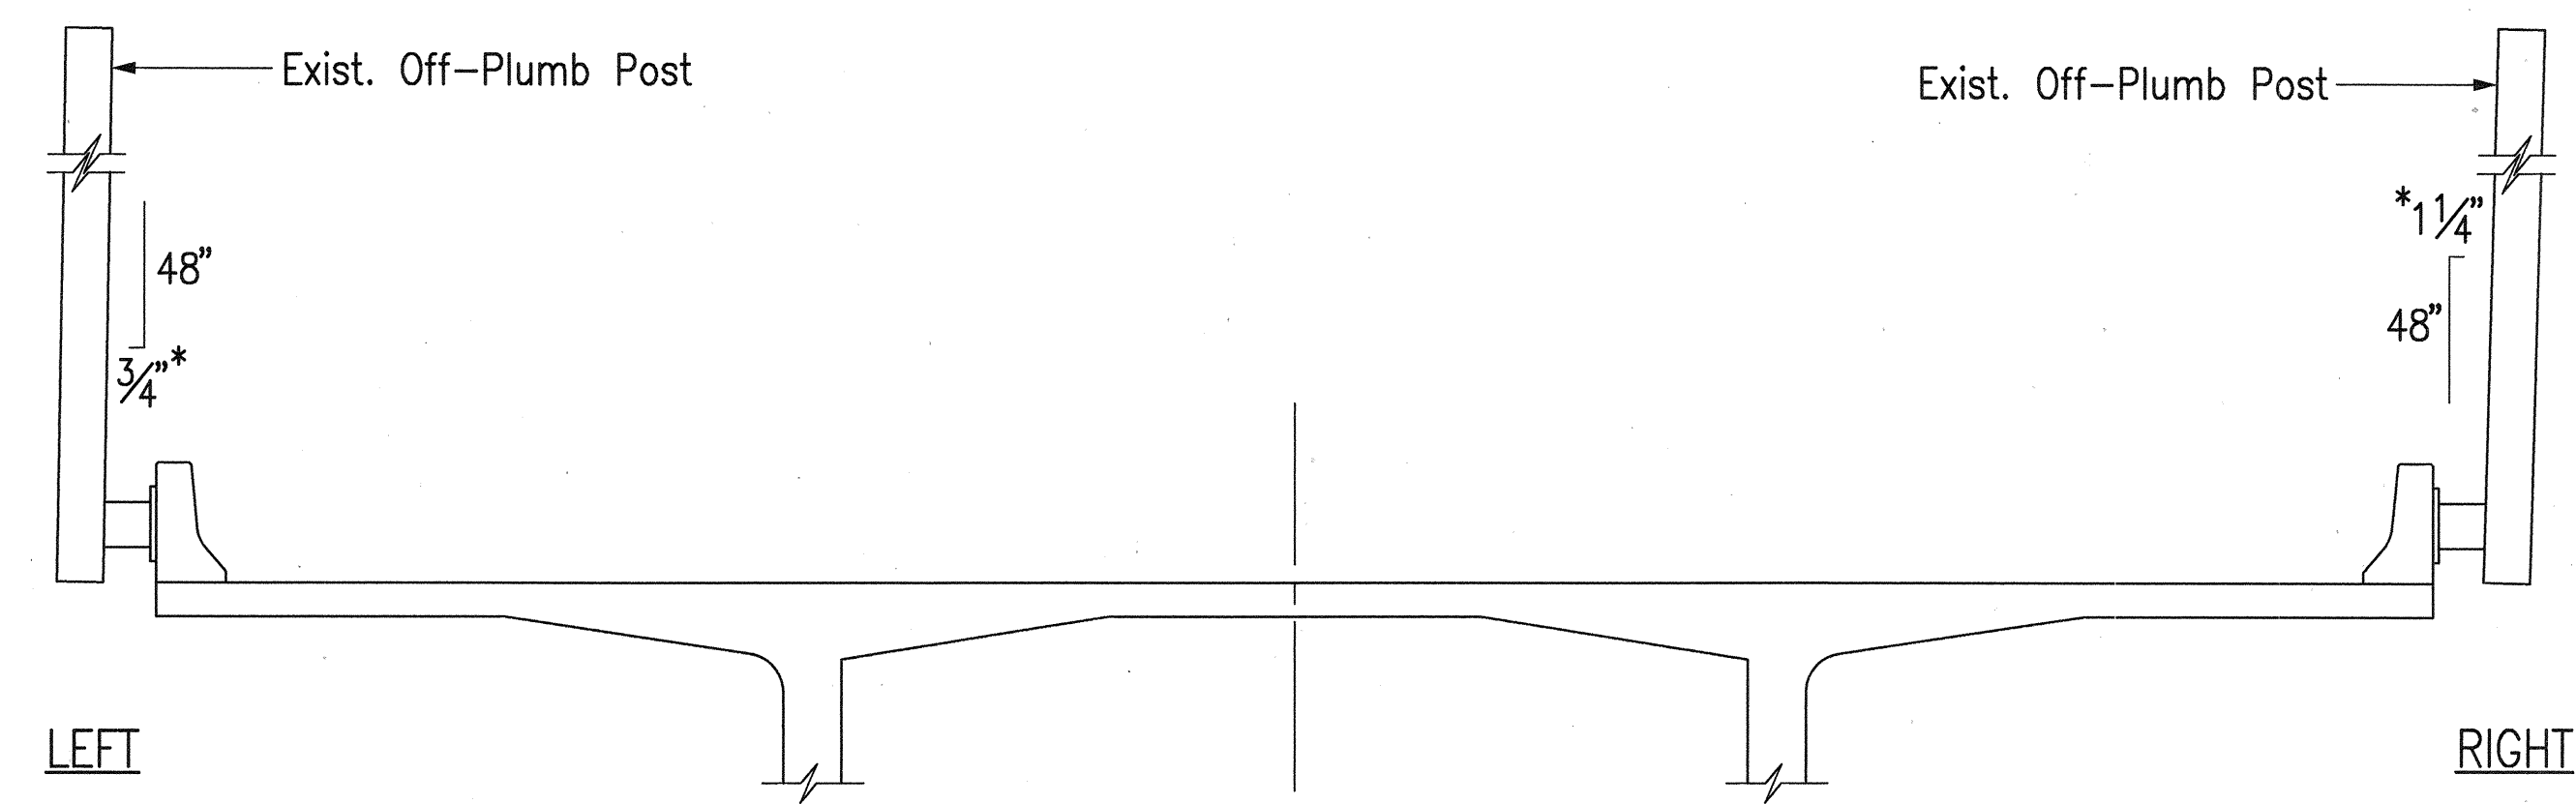

I.B. STA. 311+55.53
(6 Bolt Pattern)
(Looking Toward T-K Tunnel)
Not to Scale

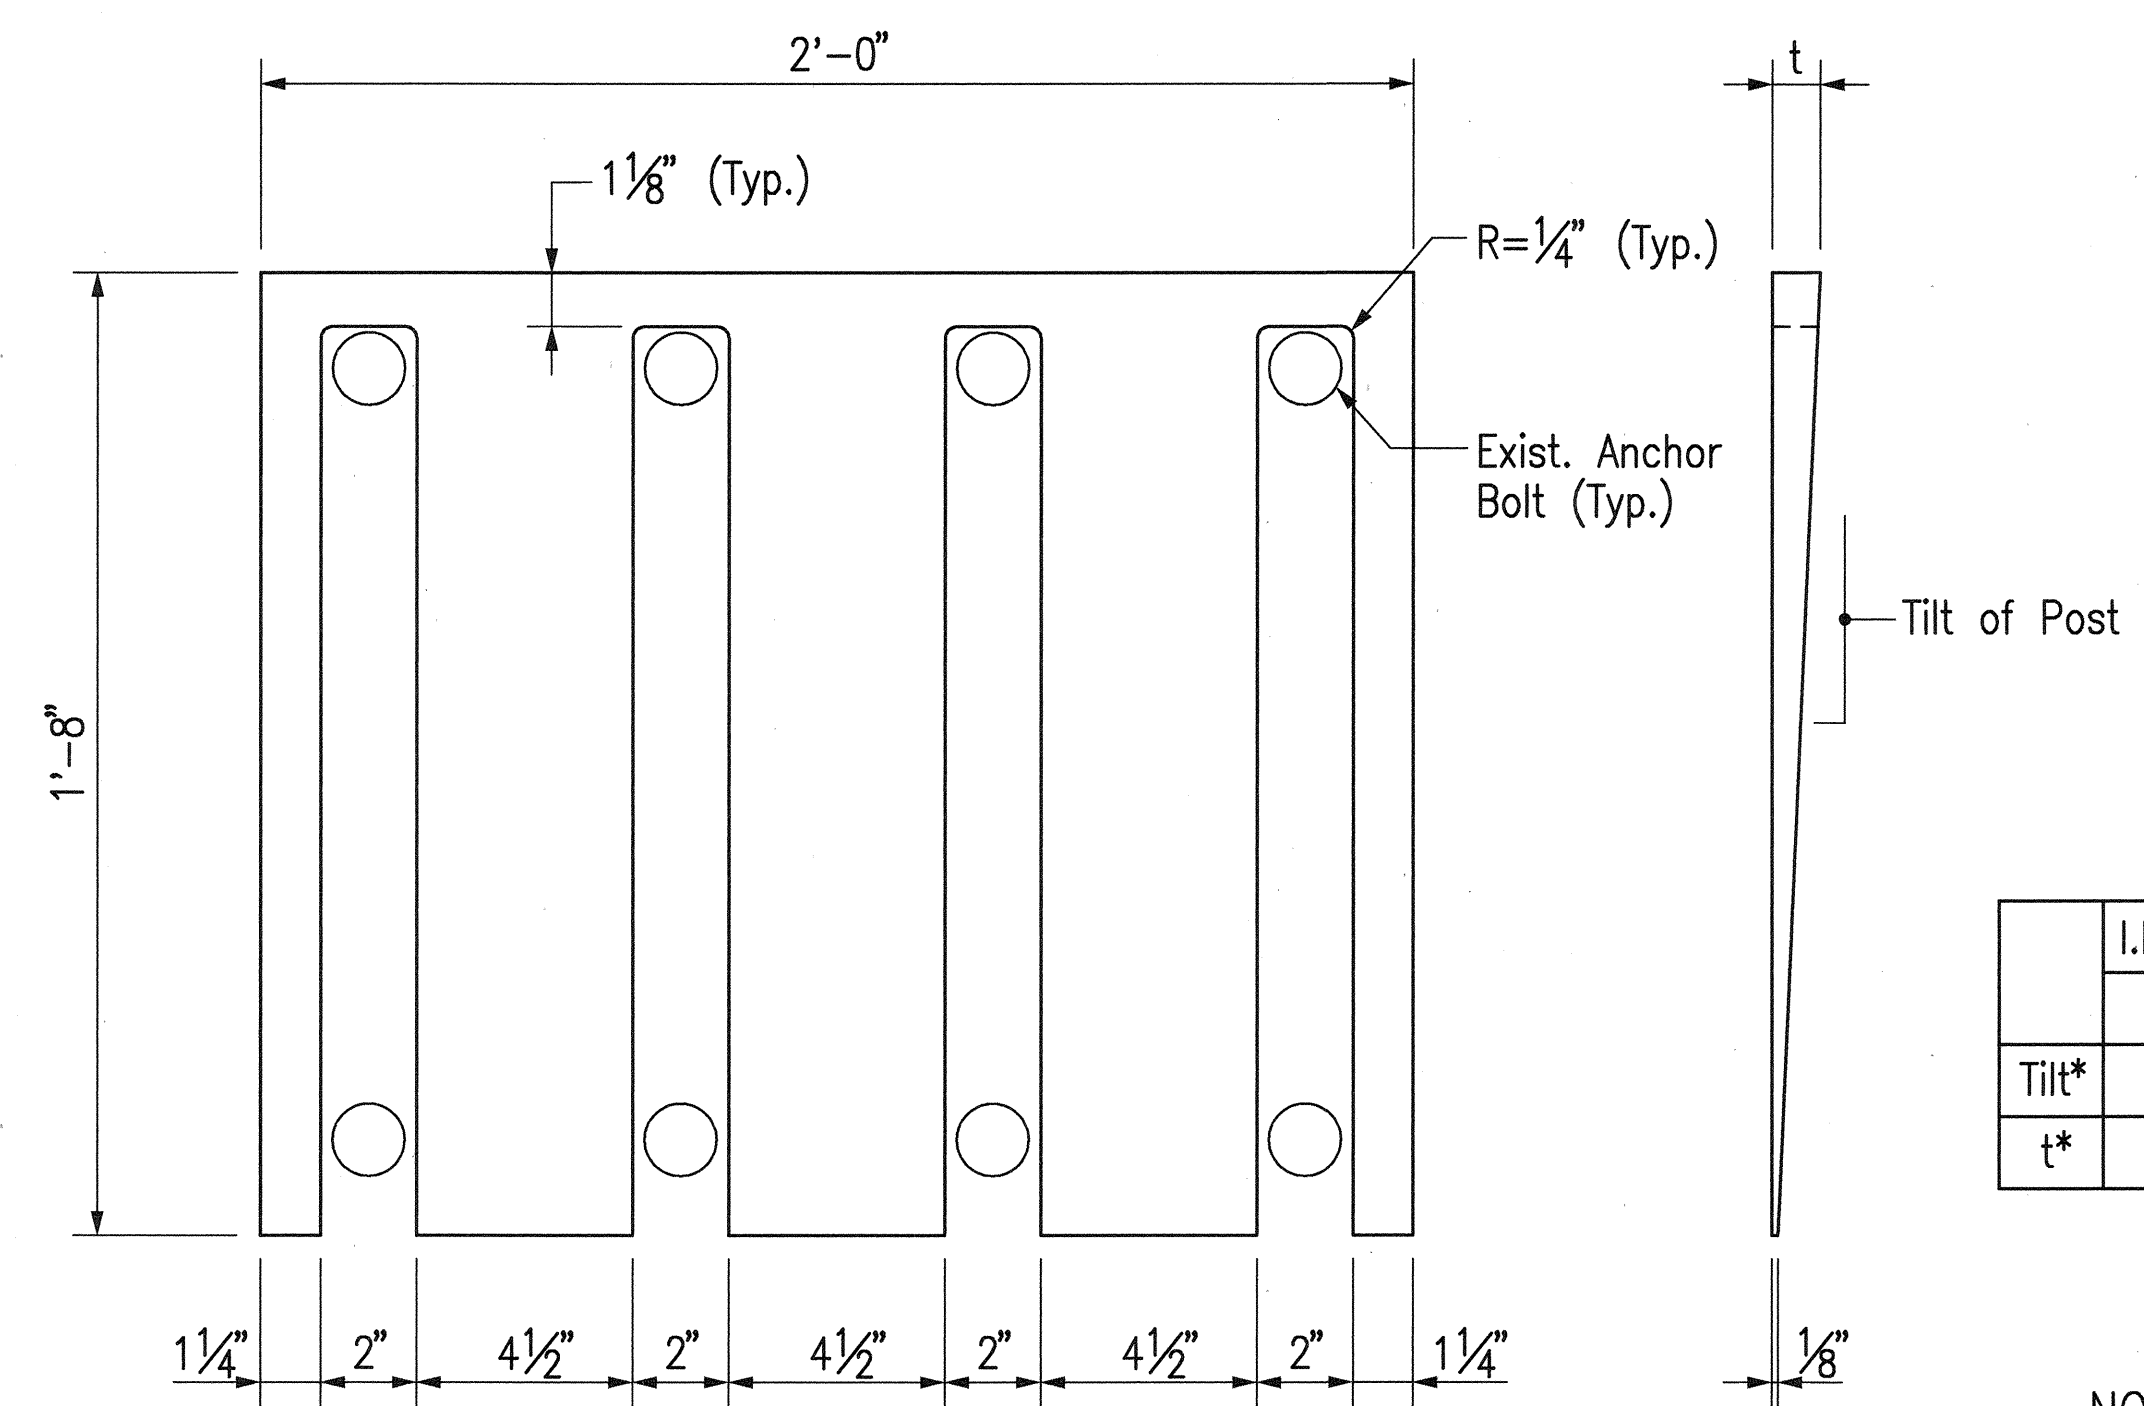


ELEVATION
SHIM PLATE FOR 10 BOLT PATTERN
Scale: 3" = 1'-0"

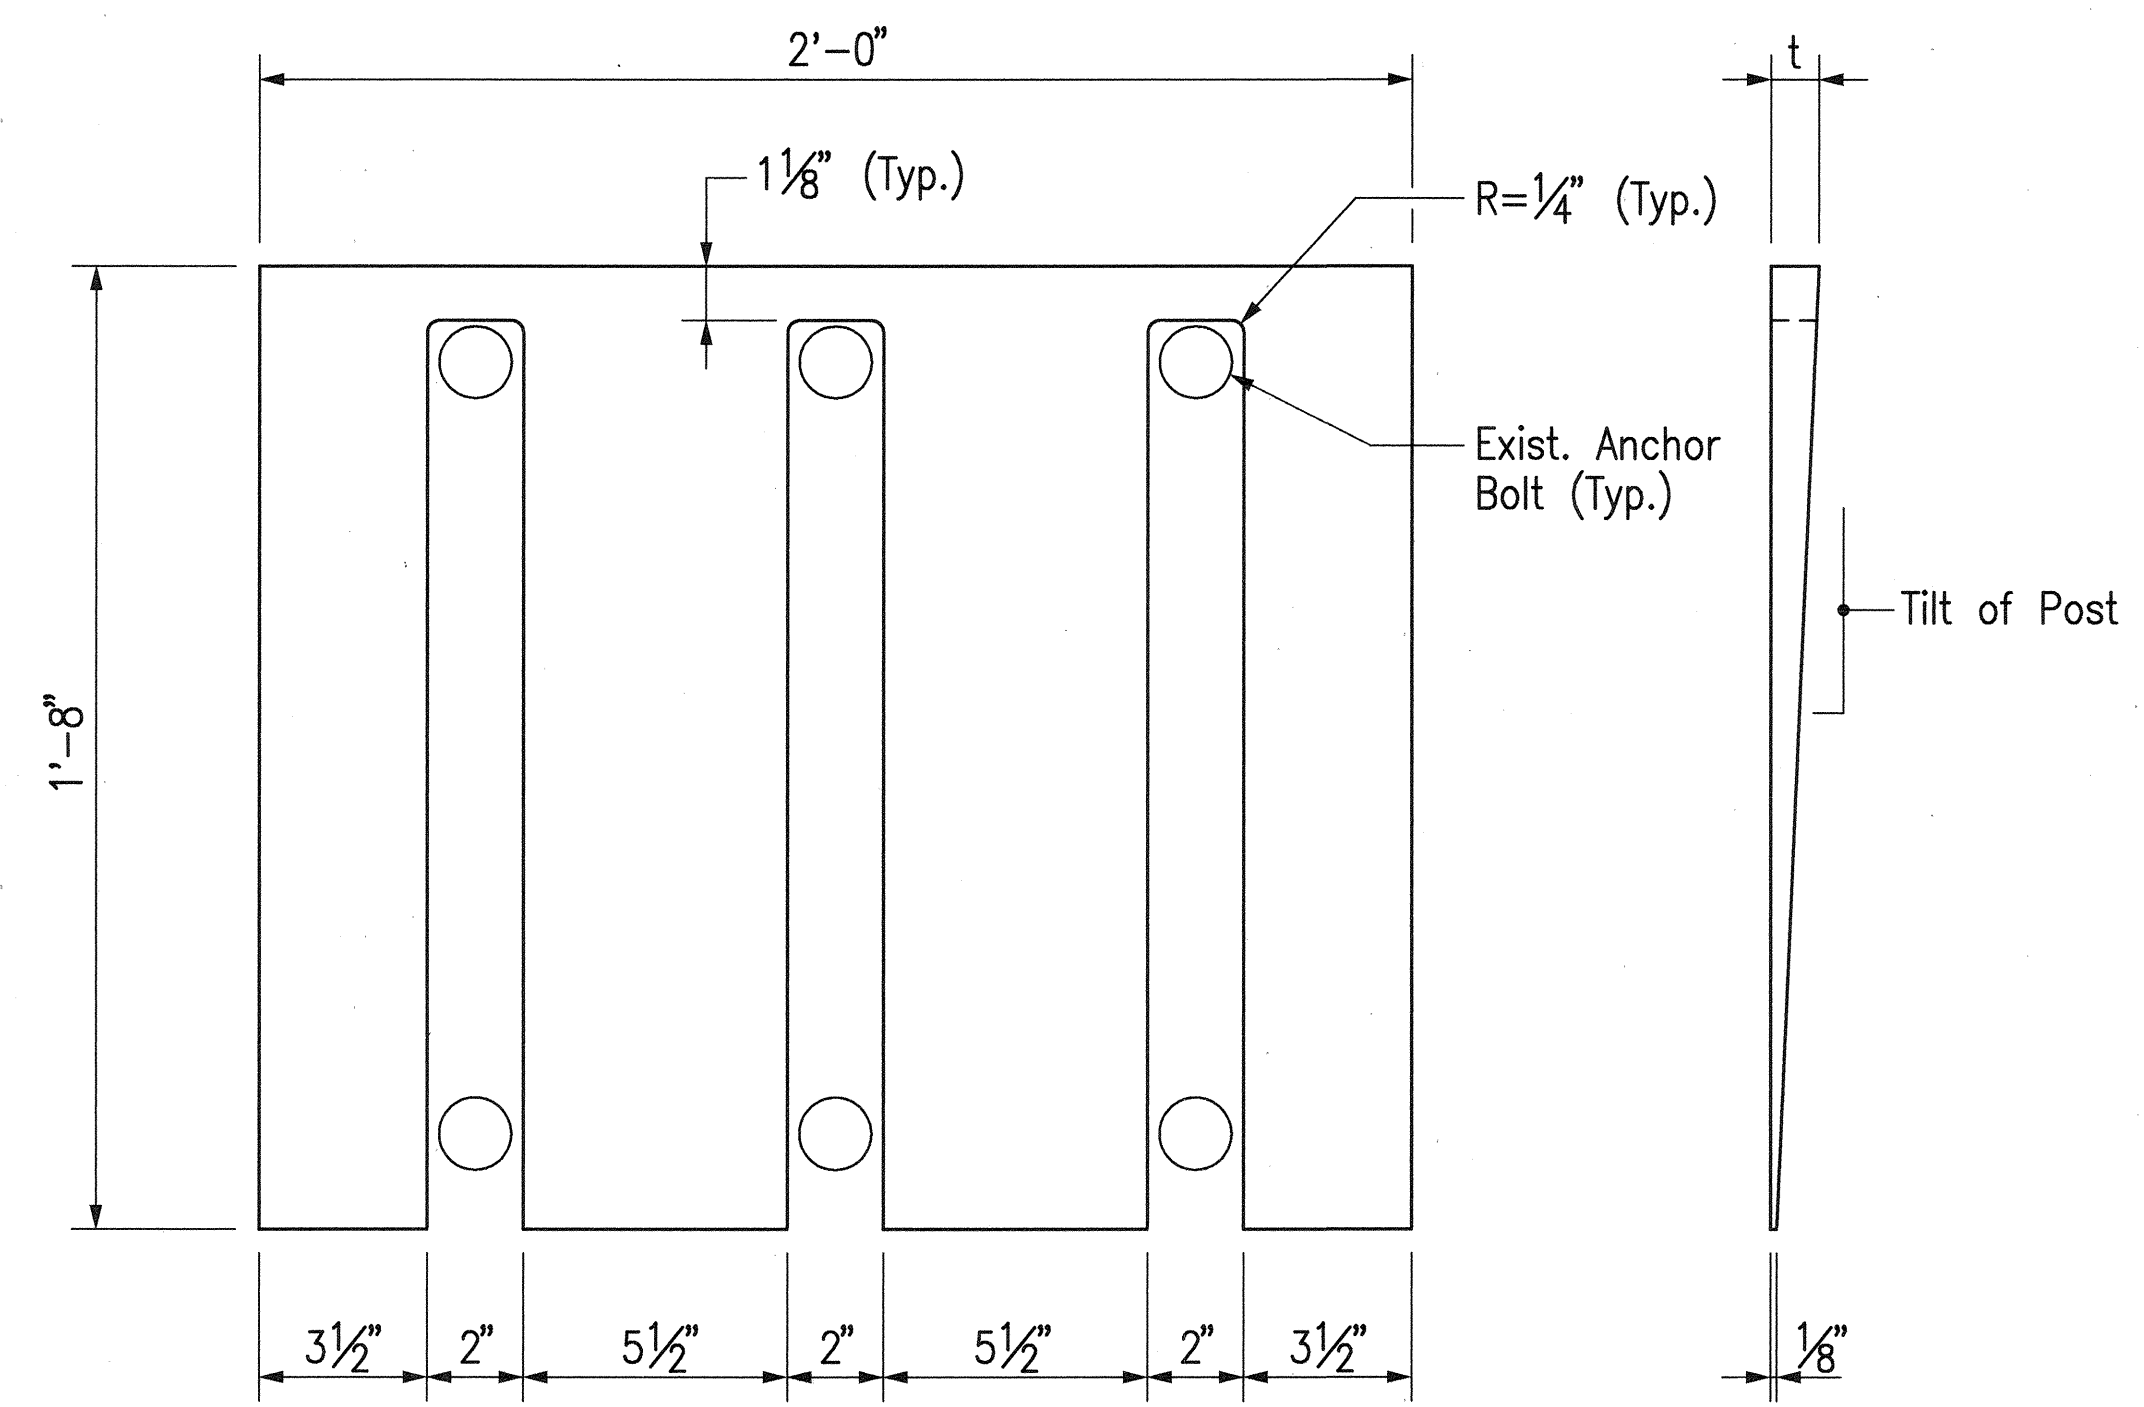

ELEVATION
SHIM PLATE FOR 6 BOLT PATTERN
Scale: 3" = 1'-0"

	I.B. STA. 273+73.70		I.B. STA. 290+73.53		I.B. STA. 311+55.53	
	LEFT	RIGHT	LEFT	RIGHT	LEFT	RIGHT
Tilt*	0:48	1 1/2:48	1:48	2:48	3/4:48	1 1/4:48
t*	0	3/4	9/16	15/16	7/16	5/8

NOTE:
The existing off-plumb post shall be corrected by loosening the existing anchor bolt nuts, pushing out the post slightly, inserting the shim plate between the post base plate and the parapet to correct the tilt, and then re-tightening the high strength bolts and nuts per requirements of specifications.

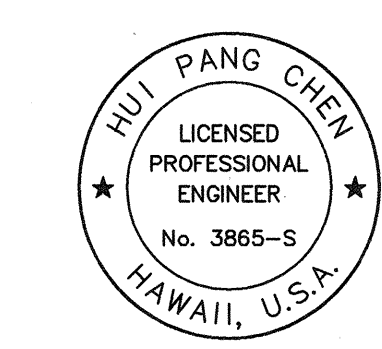

THIS WORK WAS PREPARED BY ME
OR UNDER MY SUPERVISION.
Hui Pang Chen

10/10/97	Added this sheet.
Date	Revision

STATE OF HAWAII
DEPARTMENT OF TRANSPORTATION
HIGHWAYS DIVISION

WINDWARD
EXISTING SUPPORT STRUCTURES
POST MODIFICATIONS

H-3 FINISH (UNIT II)
FAIP NO. I-H3-1(75), UNIT II
LEEWARD SECTION

SCALE: AS SHOWN DATE: OCTOBER 1997


SHEET NO. 5S3A OF 3 SHEETS

C.O. 842S-1

ORIGINAL	DATE
DESIGNED BY	
NOTED BY	
QUANTITIES BY	
CHECKED BY	
No.	

CAD by D. Burgess, 55-52


FED. ROAD DIST. NO.	STATE	FED. AID PROJ. NO.	FISCAL YEAR	SHEET NO.	TOTAL SHEETS
HAWAII	HAW.	I-H3-1(75), UNIT II	1997	843	1102

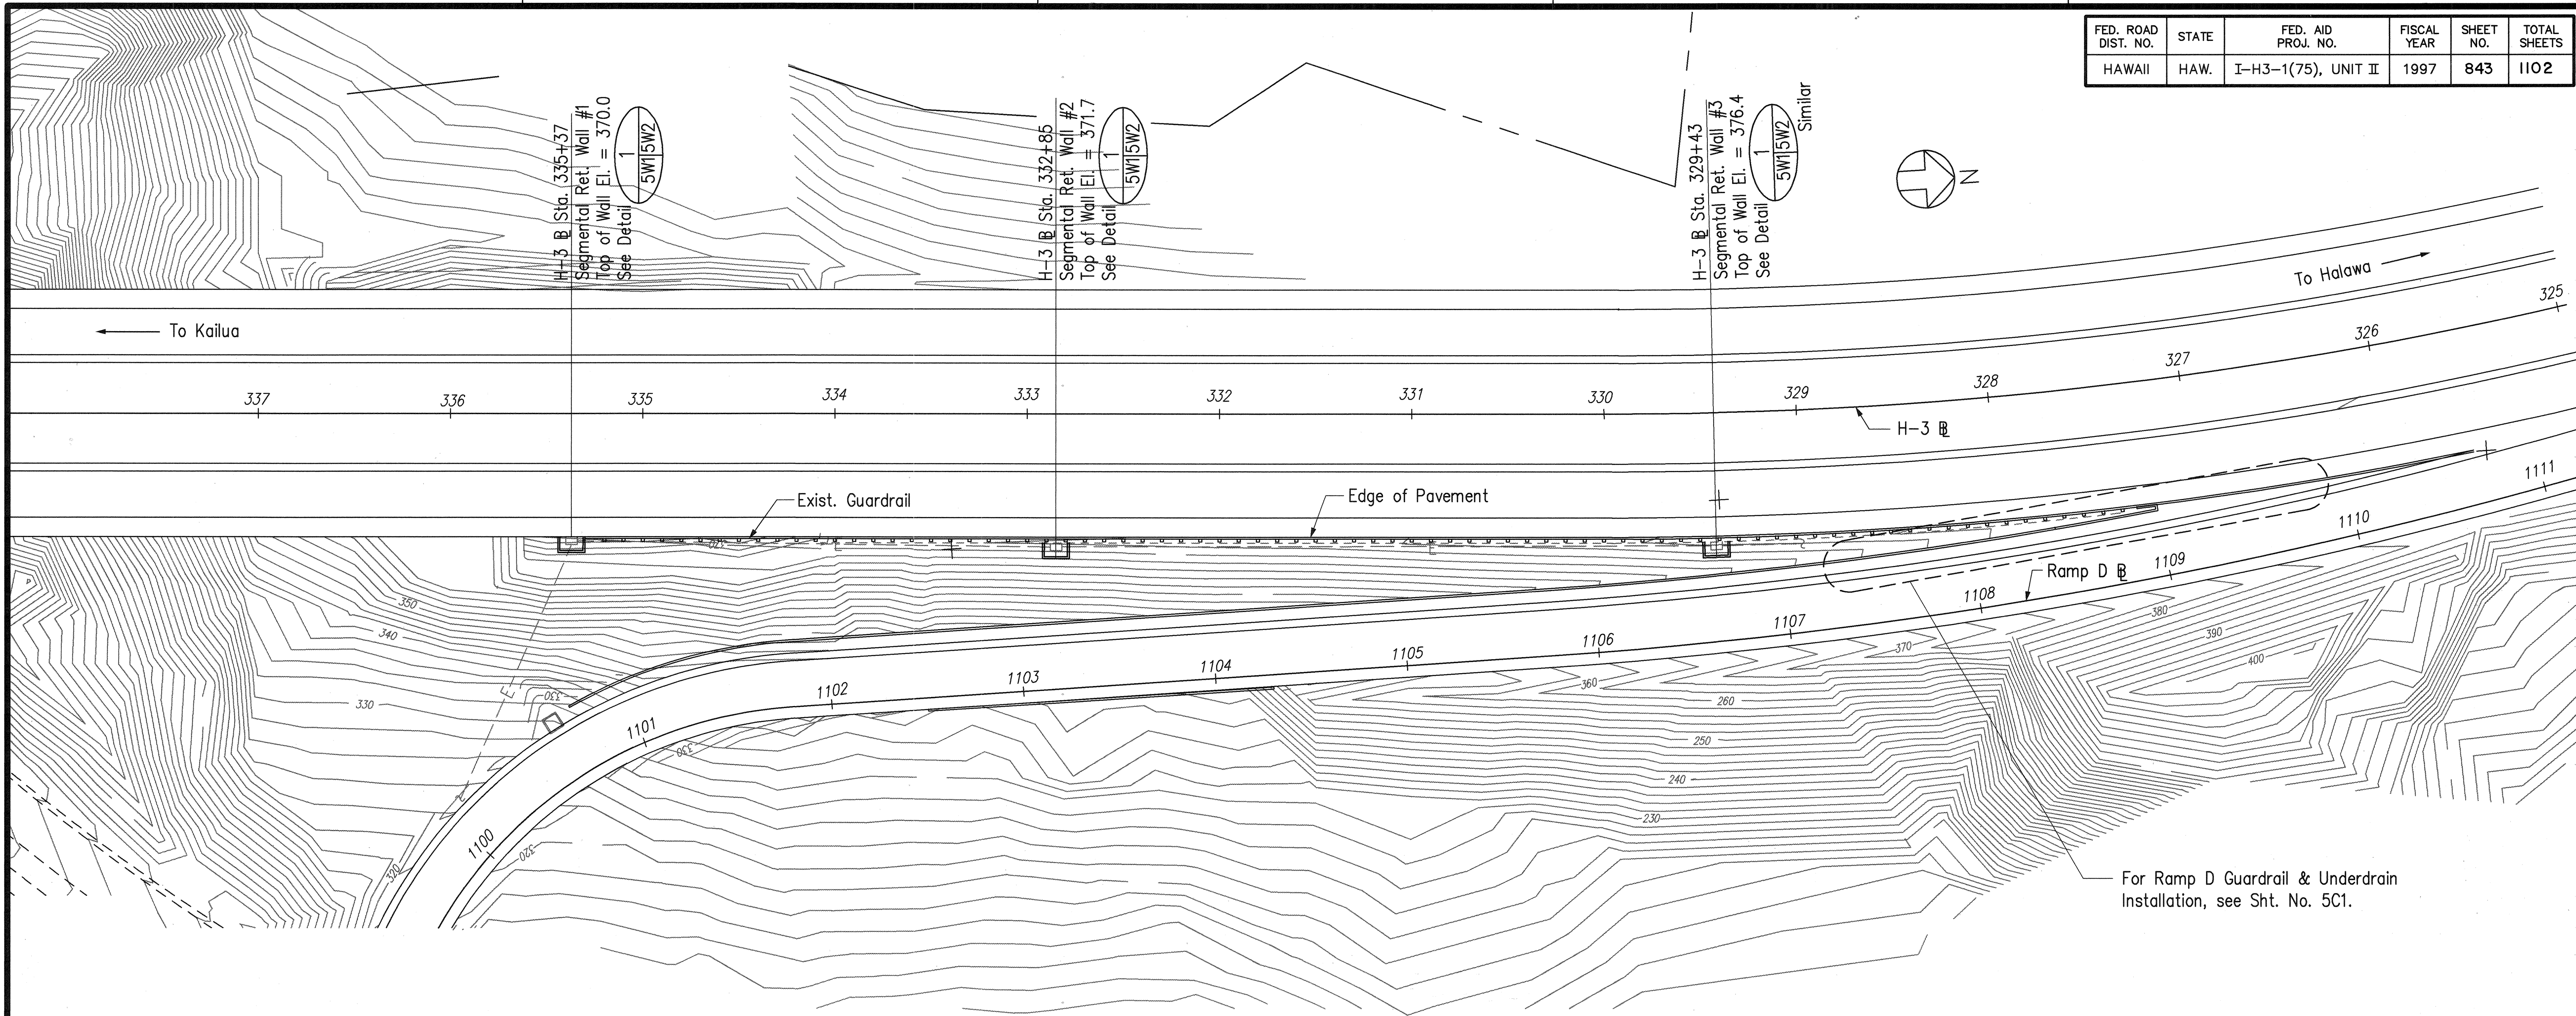


PLAN
Scale: 1" = 40'

NOTES:

- The location of underground facilities are from existing records with varying degrees of accuracy and are not guaranteed as shown. The Contractor shall exercise extreme caution whenever construction crosses or is in close proximity of underground lines.
- The Contractor shall comply with the State of Hawaii's Occupational Safety and Health Law (DOSH).
- The Contractor shall obtain an excavation permit from HECO's Mapping and Records Division located at 820 Ward Avenue, 4th Floor, two weeks prior to starting construction.
- For verification of HECO's underground lines or for assistance in supporting and protecting these lines, the Contractor shall call HECO's Underground Division at 543-7345 a minimum of 72 hours in advance.
- When excavation is adjacent to or beneath HECO's existing structures or facilities, the Contractor is responsible for providing adequate shoring of the excavation to prevent slides, cave-ins and settlements, and for protecting existing structures or facilities with beams, struts, or under-pinning, at no additional cost to the State.
- Any work required to relocate HECO facilities shall be done by HECO and the Contractor shall be responsible for all coordination, at no additional cost to the State.
- Any damage to HECO's facilities will be reported immediately to HECO's Trouble Dispatcher at 543-7874. This repair work shall be done by HECO or by the Contractor under HECO's supervision at no additional cost to the State.
- All existing underground facilities shown on these plans or whose approximate locations within the project boundaries have been made known by any reasonable means at any time to the Contractor shall be protected at all times by the Contractor during construction. The Contractor shall be responsible for repair of existing facilities damaged as a result of installation work of the segmental retaining wall at no additional cost to the State.

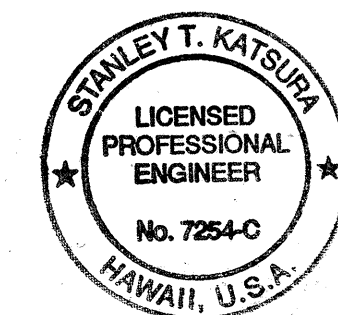

THIS WORK WAS PREPARED BY ME
OR UNDER MY SUPERVISION.

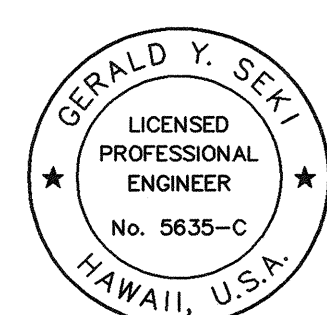

THIS WORK WAS PREPARED BY ME
OR UNDER MY SUPERVISION.


STATE OF HAWAII
DEPARTMENT OF TRANSPORTATION
HIGHWAYS DIVISION

WINDWARD
SEGMENTAL - RETAINING WALL
HANDHOLE LOCATION - PLAN

H-3 FINISH (UNIT II)
FAIP NO. I-H3-1(75), UNIT II
LEEWARD SECTION

SCALE: AS SHOWN DATE: JANUARY 1997
SHEET NO. 5W1 OF 2 SHEETS


FED. ROAD DIST. NO.	STATE	FED. AID PROJ. NO.	FISCAL YEAR	SHEET NO.	TOTAL SHEETS
HAWAII	HAW.	I-H3-1(75), UNIT II	1997	844	1102

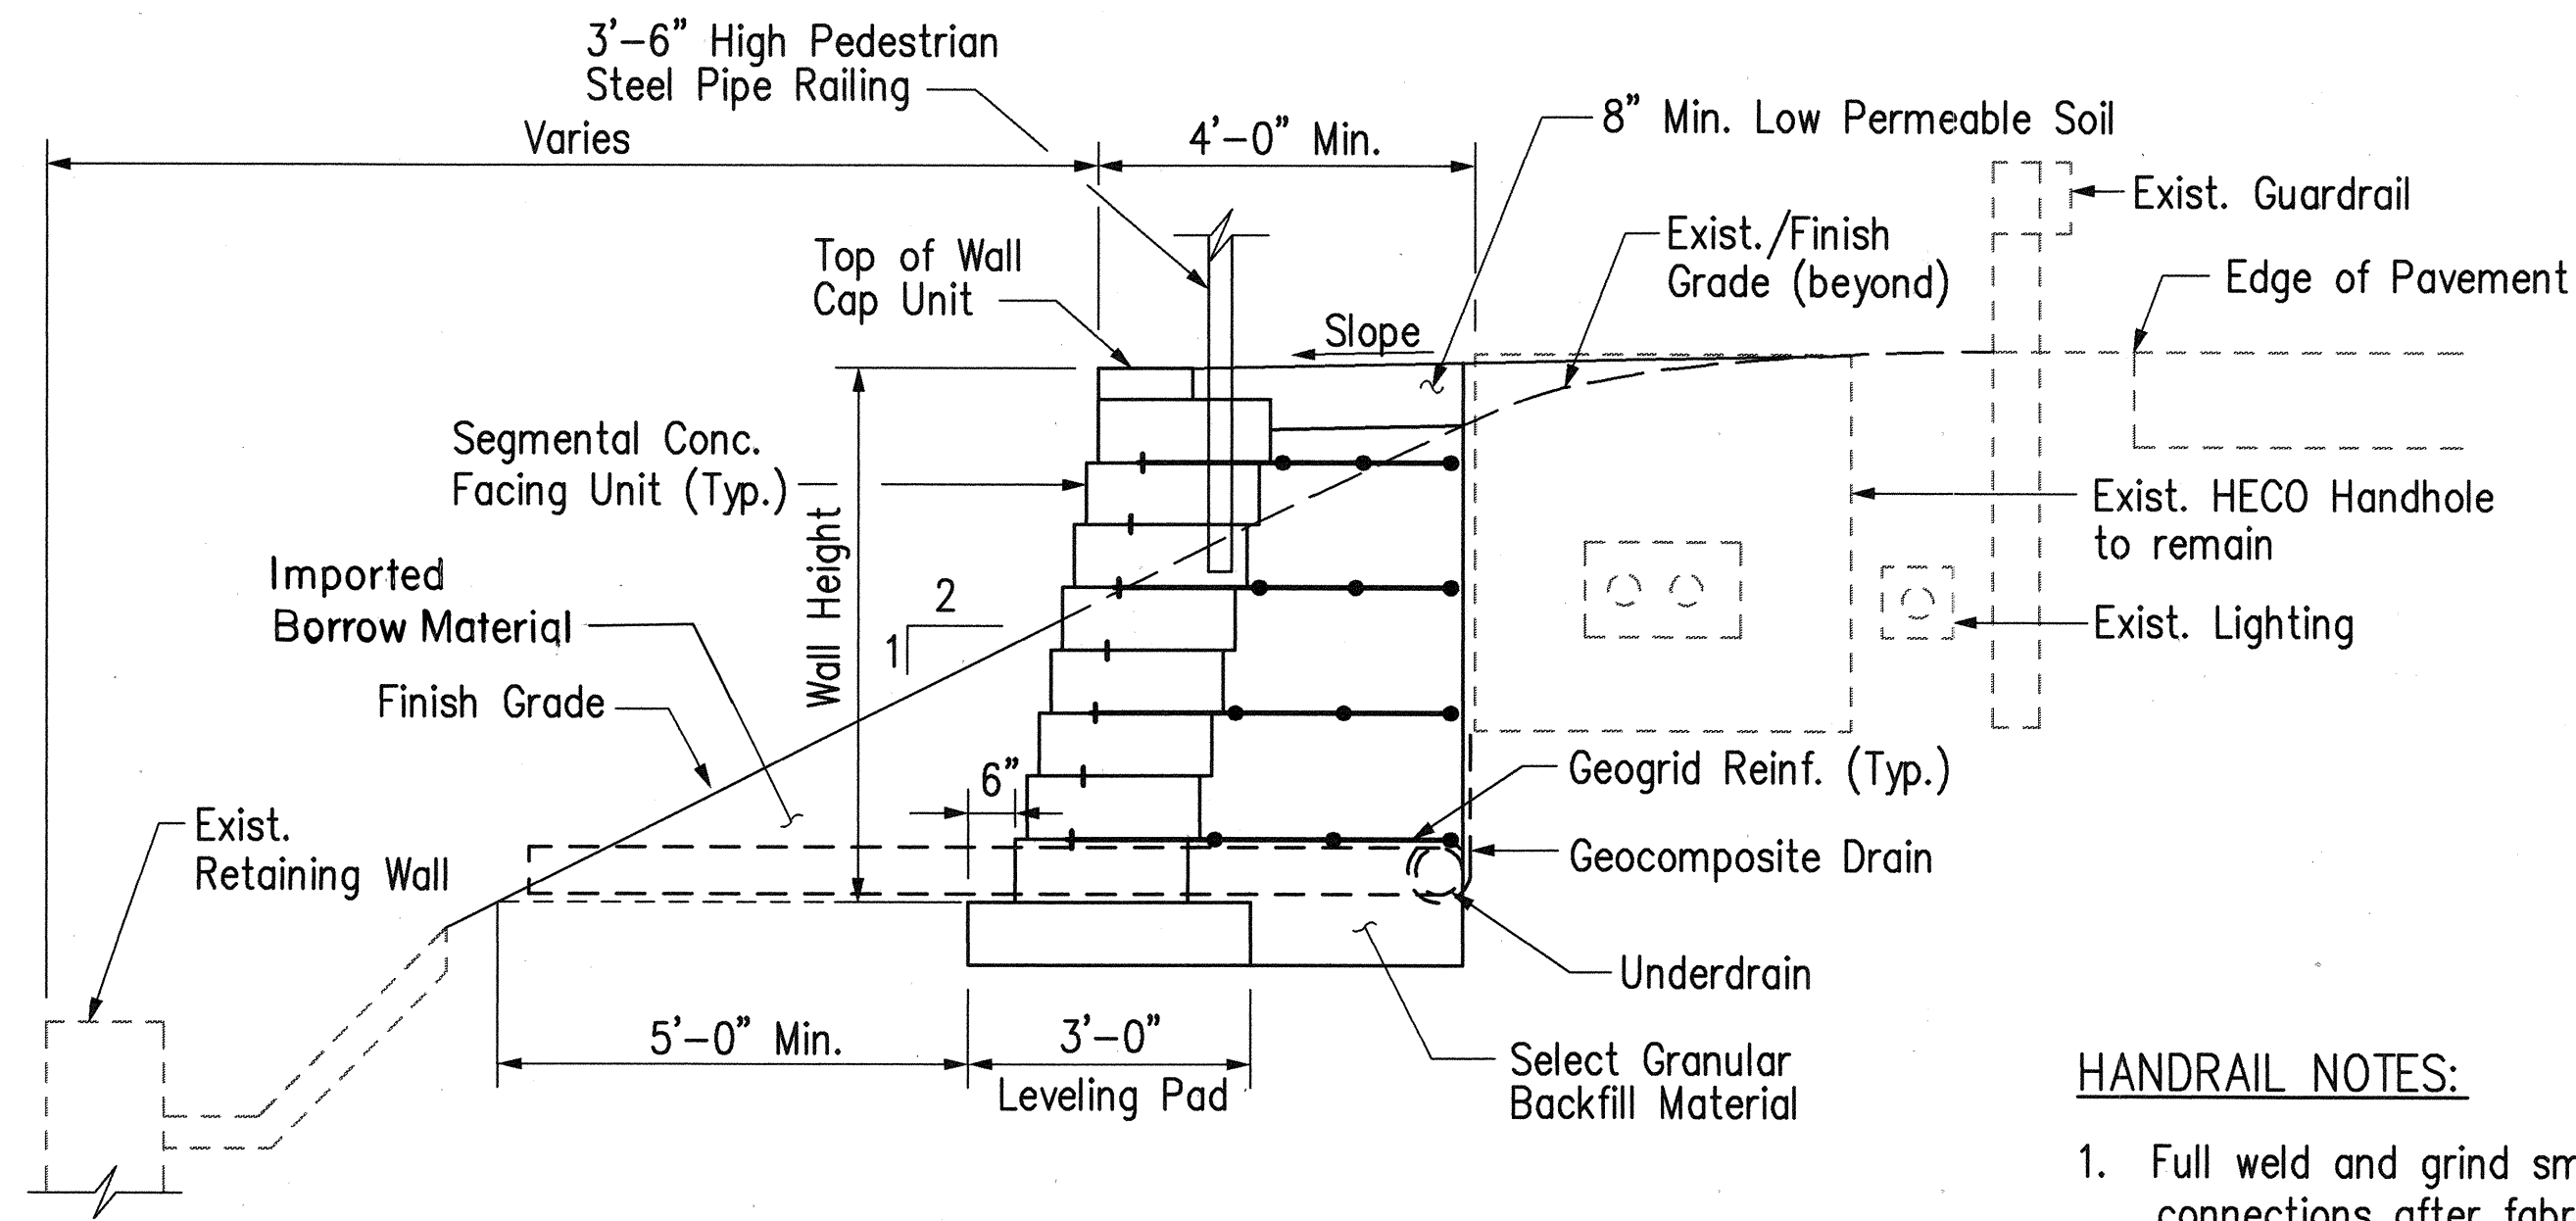

SRW #1 & #2

HANDRAIL NOTES:


1. Full weld and grind smooth all connections after fabrication.
2. Paint pipe rail black with approved metal paint.

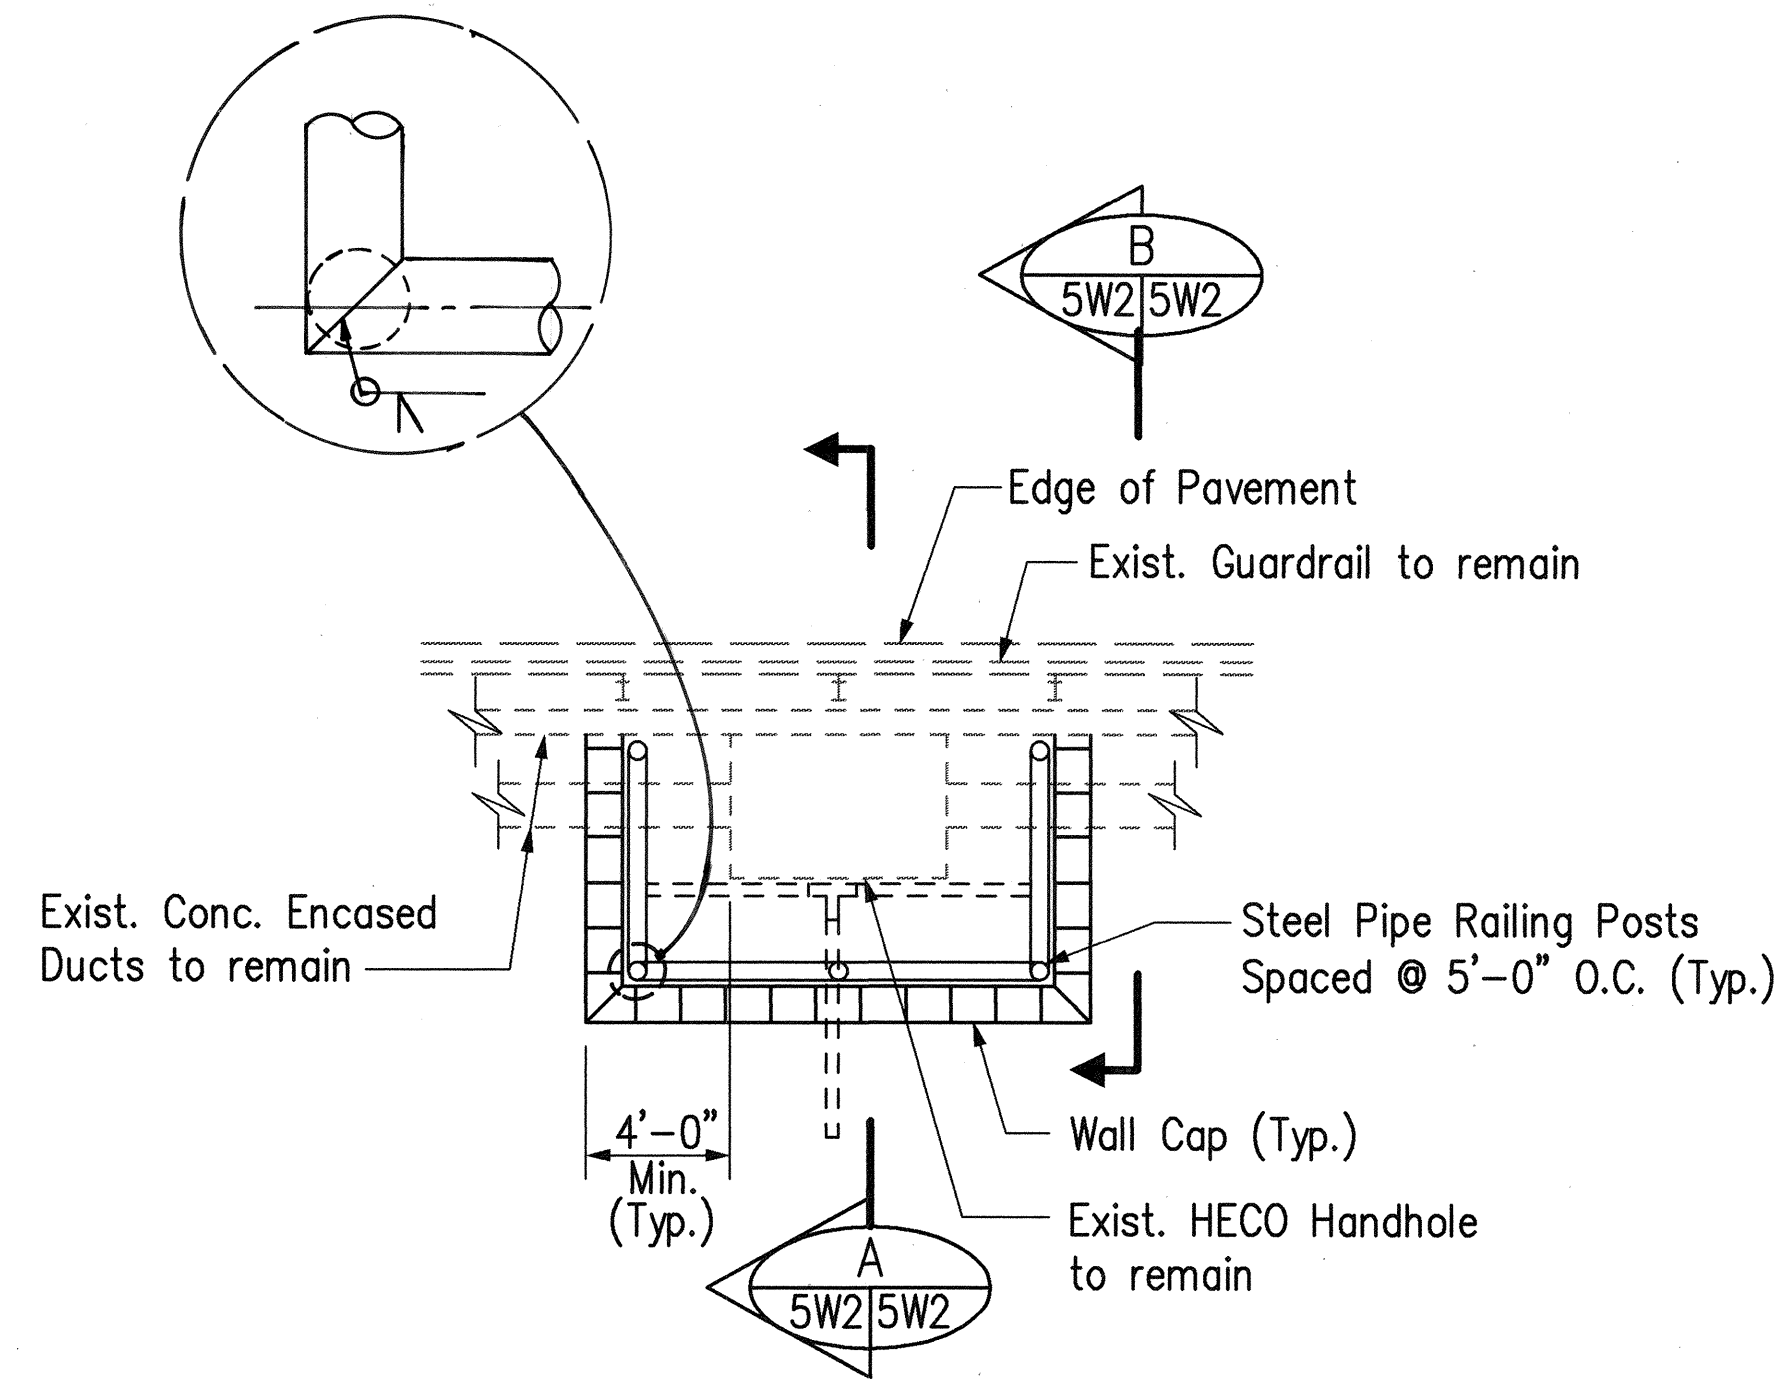


TYPICAL SEGMENTAL RETAINING WALL DETAIL

Scale: $\frac{3}{16}'' = 1'-0''$

1
5W1/5W2

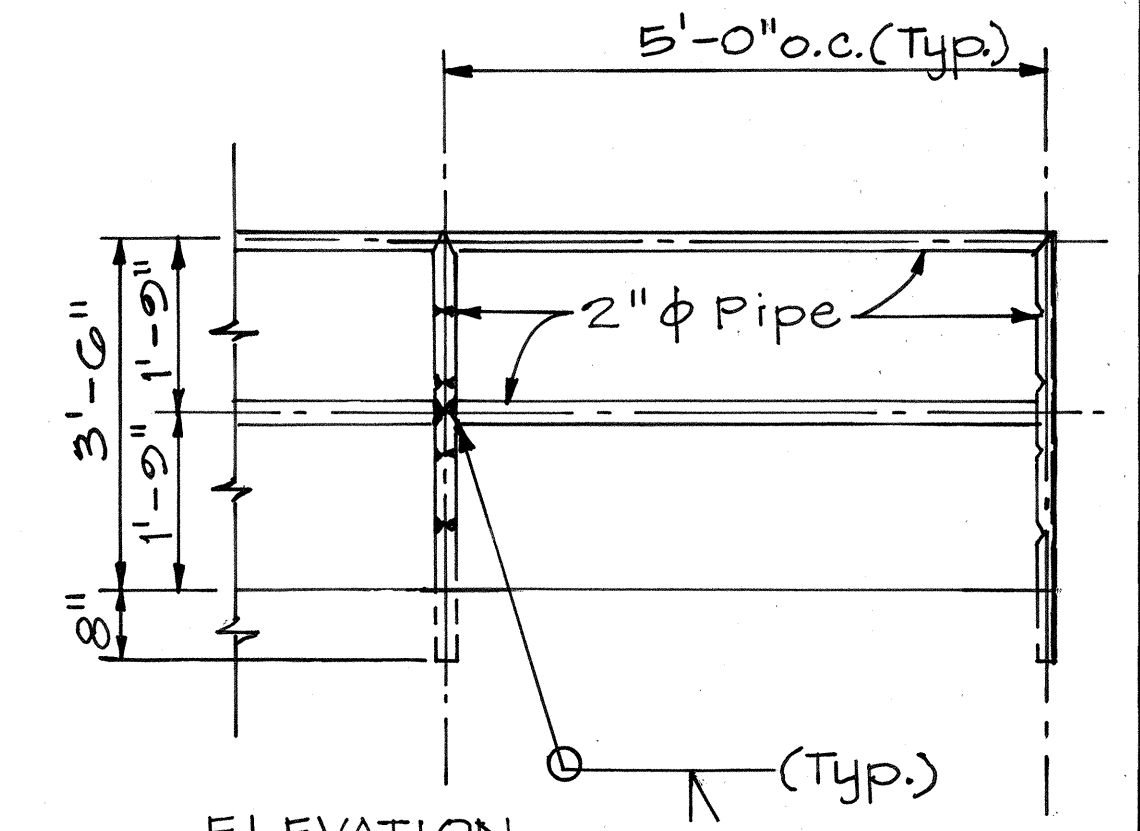

SEGMENTAL WALL PIPE RAILING DETAIL
N.T.S.

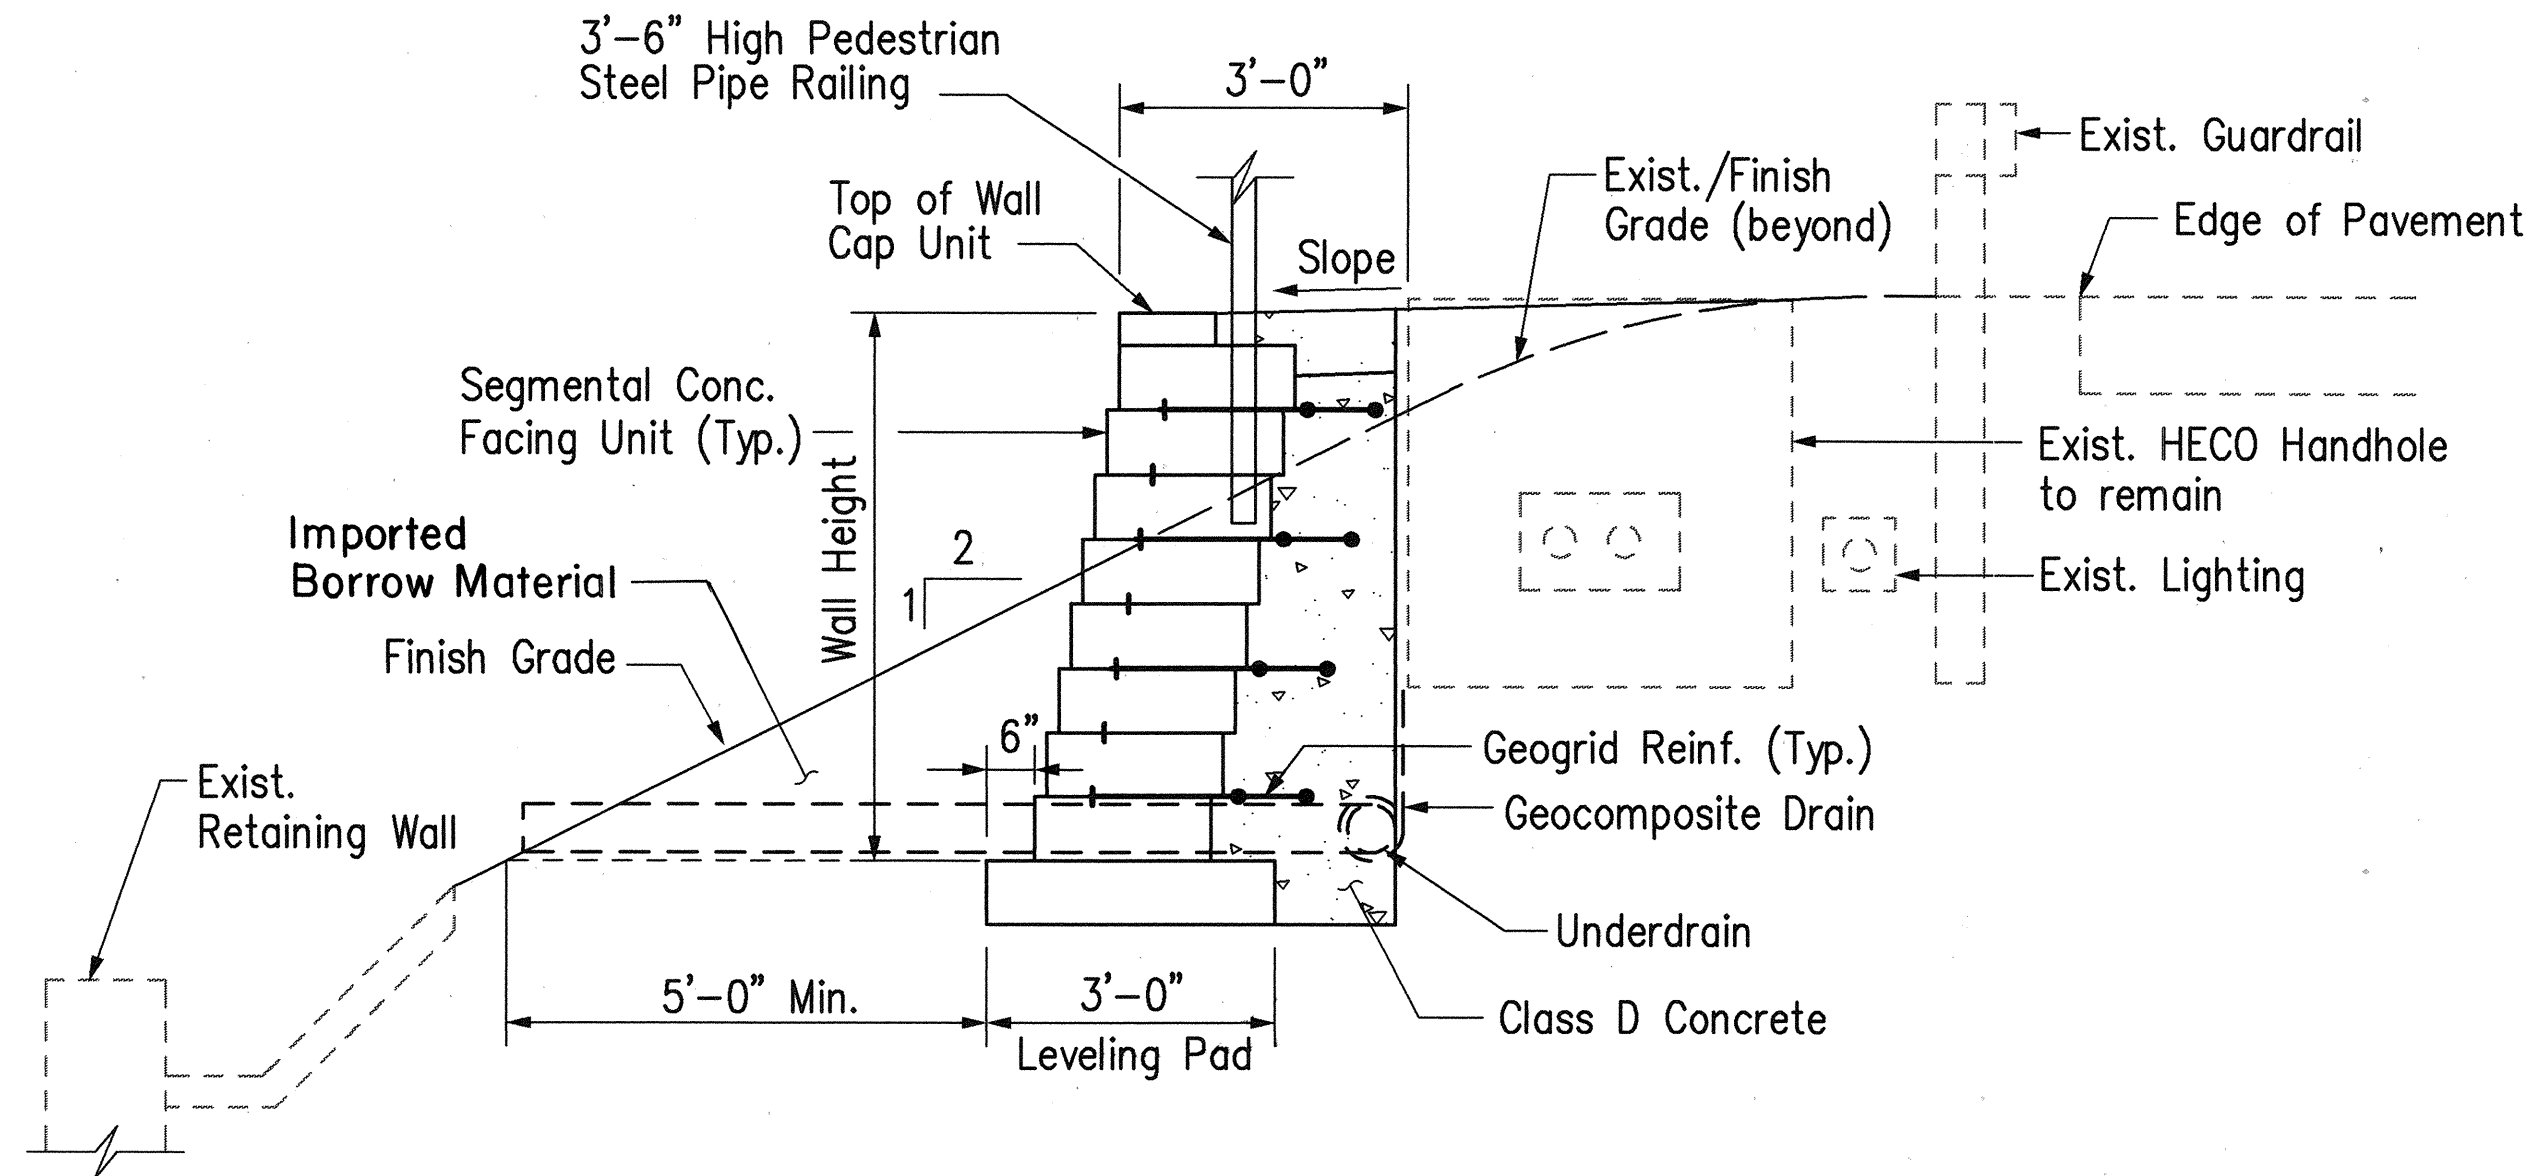


SRW #3

SECTION

Scale: $\frac{1}{2}'' = 1'-0''$


A
5W2/5W2

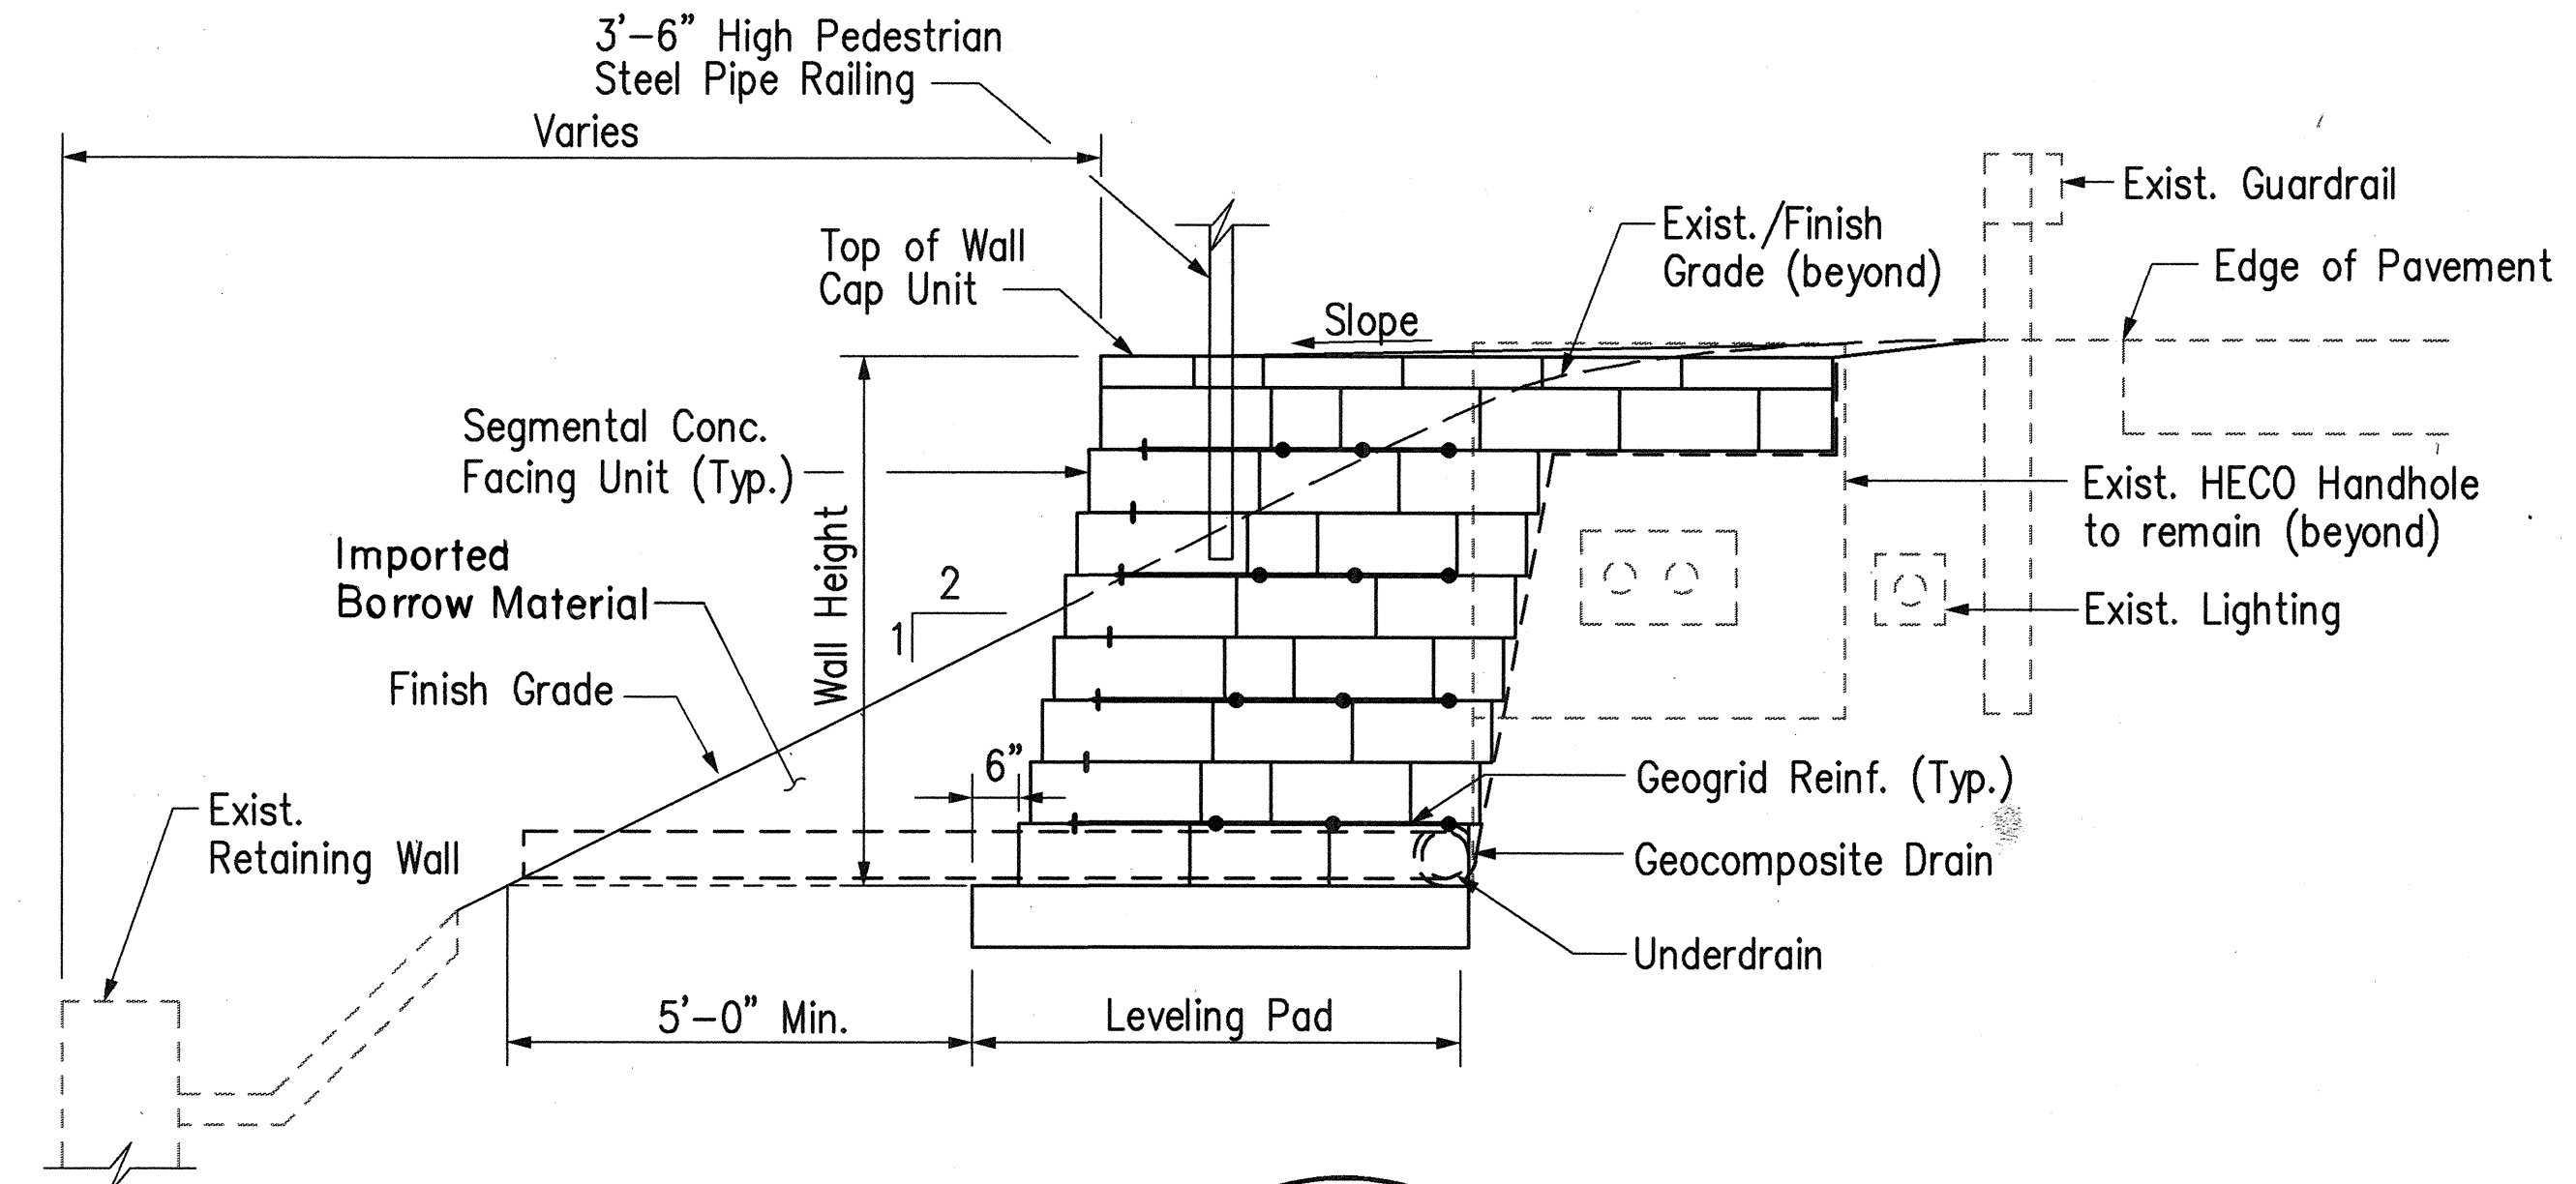


SECTION

Scale: $\frac{1}{2}'' = 1'-0''$

B
5W2/5W2

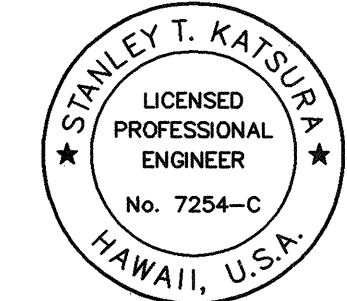

THIS WORK WAS PREPARED BY ME OR UNDER MY SUPERVISION.

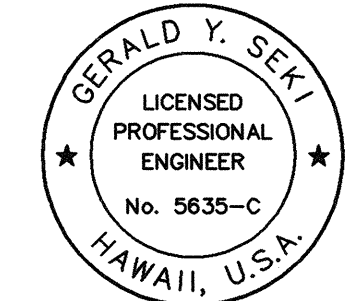

THIS WORK WAS PREPARED BY ME OR UNDER MY SUPERVISION.

Date	Revised Detail & Sections
4/21/97	Revision
STATE OF HAWAII DEPARTMENT OF TRANSPORTATION HIGHWAYS DIVISION	
WINDWARD	
SEGMENTAL - RETAINING WALL	
HANDHOLE LOCATION - DETAILS	
H-3 FINISH (UNIT II) FAIP NO. I-H3-1(75), UNIT II LEEWARD SECTION	
SCALE: AS SHOWN	DATE: JANUARY 1997
SHEET NO. 5W2 OF 2 SHEETS	

ADD. 844

SURVEY PLOTTED BY	DATE
DRAWN BY	
TRACED BY	
DESIGNED BY	
CHECKED BY	
NO.	


FED. ROAD DIST. NO.	STATE	FED. AID PROJ. NO.	FISCAL YEAR	SHEET NO.	TOTAL SHEETS
HAWAII	HAW.	I-H3-1(75), UNIT II	1997	ADD. 844S-1	1102

SIGN LOCATIONS - OUTBOUND	
STATION	SIGN
264+26 (LT)	R8-3-A*
267+91 (RT)	R2-5b(45)-A
267+91 (LT)	R2-5b(45)-A*
271+77 (RT)	R2-1(45)-A
271+77 (LT)	R2-1(45)-A*
274+62 (LT)	R8-4-A*
288+49 (RT)	W7-1+
288+49 (LT)	W7-1*+
292+17 (RT)	M1-10**+
294+03 (RT)	1M-1(1)+, IM3-2+
299+57 (RT)	R2-1(45)-A
303+37 (RT)	W7-4B**+
316+00 (RT)	D10-4**
318+92 (RT)	R2-1(45)-A+
328+95 (RT)	R2-1(45)-A+

NOTES:


- 1) SIGNS PER STATE STANDARD PLANS TE-04, TE-05, TE-06, TE-13, AND TE-18.
- 2) ALL SIGNS SHALL BE FURNISHED BY THE CONTRACTOR UNLESS OTHERWISE NOTED. + INDICATES SIGNS TO BE FURNISHED BY THE STATE. SIGNS FURNISHED BY THE STATE SHALL BE AVAILABLE TO THE CONTRACTOR AT THE STATE DOT KANEOHE BASEYARD.
- 3) SIGNS SHALL BE ATTACHED TO LIGHT OR VERTICAL POLES PER STATE STANDARD PLAN TE-01, UNLESS OTHERWISE NOTED.
- 4) * INDICATES SIGN TO BE MOUNTED ON CONCRETE PARAPET. SEE DETAIL SHEET 1P76.
- 5) ** SEE DETAIL THIS SHEET.

SIGN LOCATIONS - INBOUND	
STATION	SIGN
264+49 (RT)	R8-3a-A*
265+35 (LT)	R5-1-A
265+35 (RT)	R5-1-A*
272+85 (LT)	R2-1(55)-A
279+46 (LT)	R8-4-A
291+67 (LT)	M1-10**+
295+54 (LT)	R8-4-A
296+54 (RT)	R4-3-A*
297+57 (LT)	R2-1(45)-A
310+11 (LT)	R8-4-A+
315+97 (LT)	D10-4+
319+95 (RT)	R4-3-A**
319+95 (LT)	R2-1(45)-A+
330+83 (LT)	W4-2(R)-A**

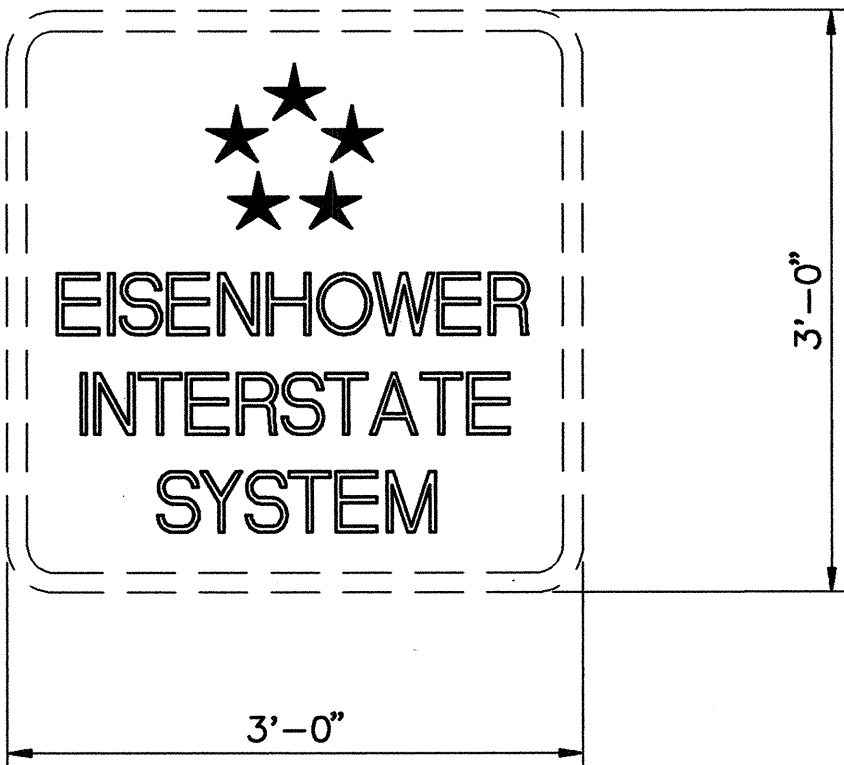


M1-10 SIGN DETAIL

SCALE: 1"=1'-0"

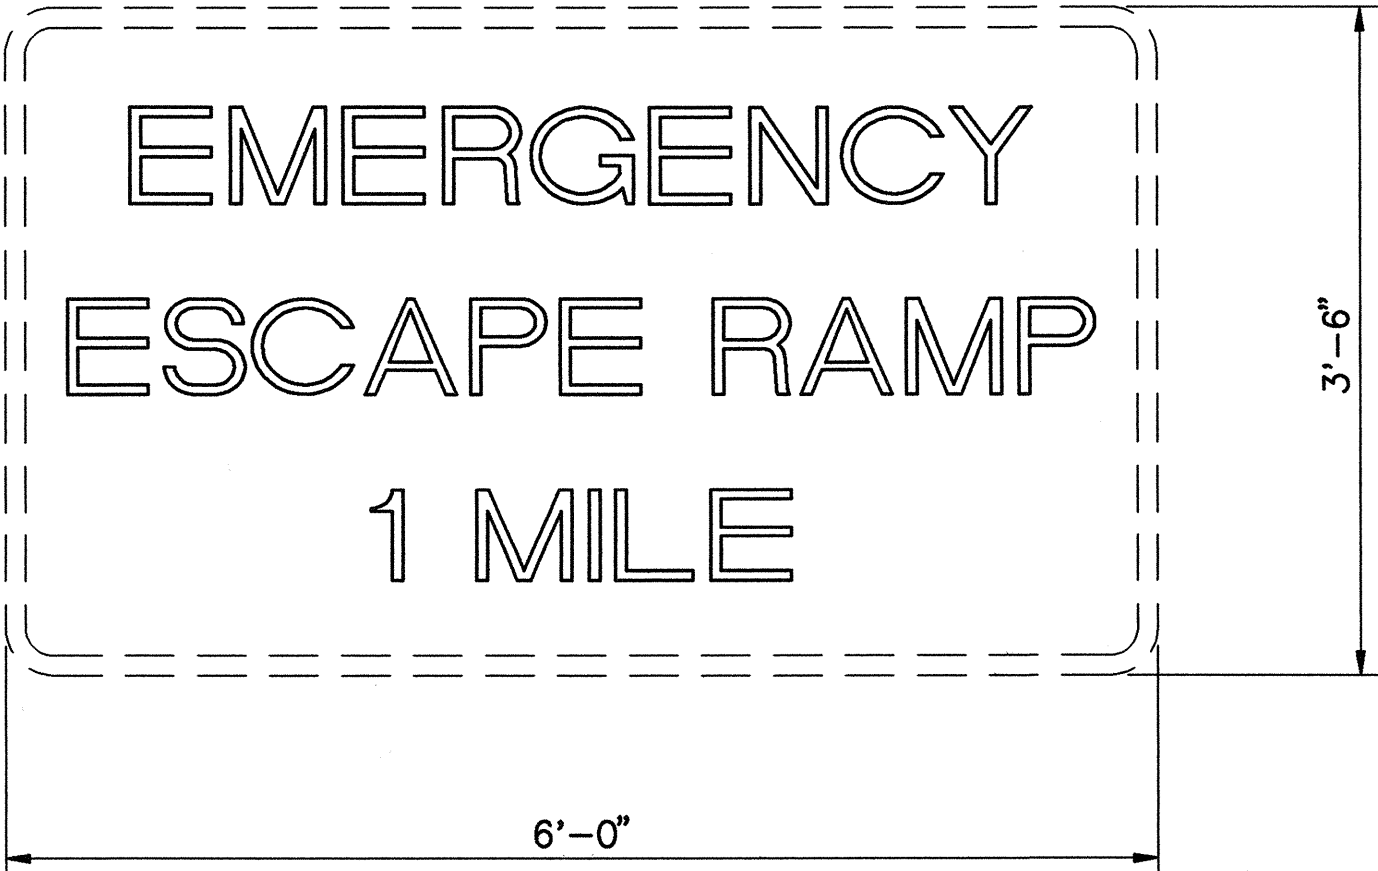

W7-4B SIGN DETAIL

SCALE: 1"=1'-0"

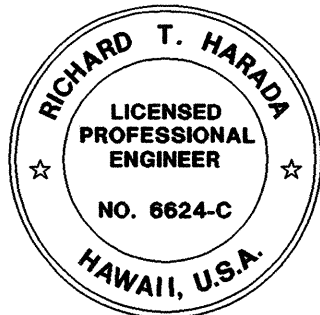

THIS WORK WAS PREPARED BY ME OR UNDER MY SUPERVISION

Richard T. Harada

4/21/97	Added Tables and Details
DATE	REVISION
STATE OF HAWAII DEPARTMENT OF TRANSPORTATION HIGHWAYS DIVISION SIGNING PLAN INTERSTATE ROUTE H-3 HAIKU APPROACH H-3 FINISH (UNIT II) FAIP NO. I-H3-1(75), UNIT II LEEWARD SECTION	
SCALE: AS NOTED	DATE: APRIL 1997

SHEET No. 5P1 OF 1 SHEETS

ADD. 844S-1

SURVEY PLOTTED BY	DATE
DRAWN BY	
DESIGNED BY	
NOTED BY	
QUANTITIES BY	
CHECKED BY	

ORIGINAL PLAN	No.
NOTEBOOK	

DATE: 04/21/97
BY: RTH