


FED. ROAD DIST. NO.	STATE	FED. AID PROJ. NO.	FISCAL YEAR	SHEET NO.	TOTAL SHEETS
HAWAII	HAW.	NH-H201(006)	2020	97	111

FIXTURE NUMBER	H201 BASELINE	OFFSET
1/1A	146+50.47	0.6' LT
2/2A	148+02.03	0.55' LT
3/3A	149+53.33	0.48' LT
4/4A	151+03.97	0.05' RT
5/5A	152+53.89	0.05' RT
6/6A	154+04.00	0.25' LT
7/7A	155+54.64	0.02' RT
8/8A	157+05.20	0.01' LT
9/9A	158+55.58	0.00'
10/10A	160+05.89	0.00'
11/11A	161+55.66	0.00'
12/12A	163+05.79	0.15' RT
G4A	163+51.07	127.07' LT
13/13A	164+55.82	0.43' RT
14/14A	165+82.99	0.67' RT
G5A	166+23.99	100.95' LT
15/15A	167+33.01	0.00'
16/16A	169+68.83	0.04' RT
17/17A	171+19.13	0.16' LT
18/18A	172+70.13	0.32' LT
19/19A	174+23.77	0.40' LT
20/20A	175+73.93	0.36' LT
21/21A	177+24.12	0.26' LT
22/22A	178+74.32	0.24' LT
22B	177+69.76	82.26' LT
23/23A	180+24.75	0.22' LT
23B	180+68.30	86.98' LT
24/24A	181+75.11	0.27' LT
25/25A	183+24.30	0.23' LT
25B	182+82.40	102.93' LT
26/26A	184+75.28	0.10' LT
27/27A	186+26.09	0.13' LT

Per RFI 011:
Light Pole 1 eliminated

ORIGINAL PLAN	SURVEY PLOTTED BY _____		DATE _____
	DESIGNED BY _____	CHECKED BY _____	
NOTE BOOK No. _____	QUANTITIES BY _____		
	CHECKED BY _____		

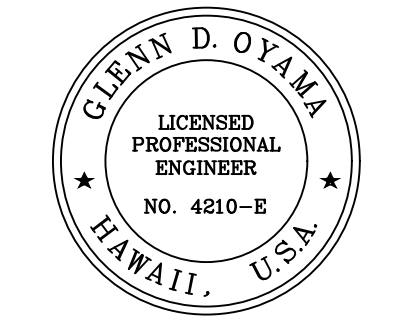

Glenn D. Oyama
EXPIRATION DATE OF THE LICENSE: 11/30/2022
THIS WORK WAS PREPARED BY ME OR UNDER MY SUPERVISION

STATE OF HAWAII
DEPARTMENT OF TRANSPORTATION
HIGHWAYS DIVISION
STREET LIGHT LOCATIONS
MOANALUA FREEWAY, HIGHWAY LIGHTING IMPROVEMENTS
Halawa to H-3 Freeway Underpass
FAP NO. NH-H201(006)

Scale: _____ Date: July 2020

SHEET No. E-15 OF 29 SHEETS