


FED. ROAD DIST. NO.	STATE	FED. AID PROJ. NO.	FISCAL YEAR	SHEET NO.	TOTAL SHEETS
HAWAII	HAW.	NH-H201(005) Ph2	2020	87	140

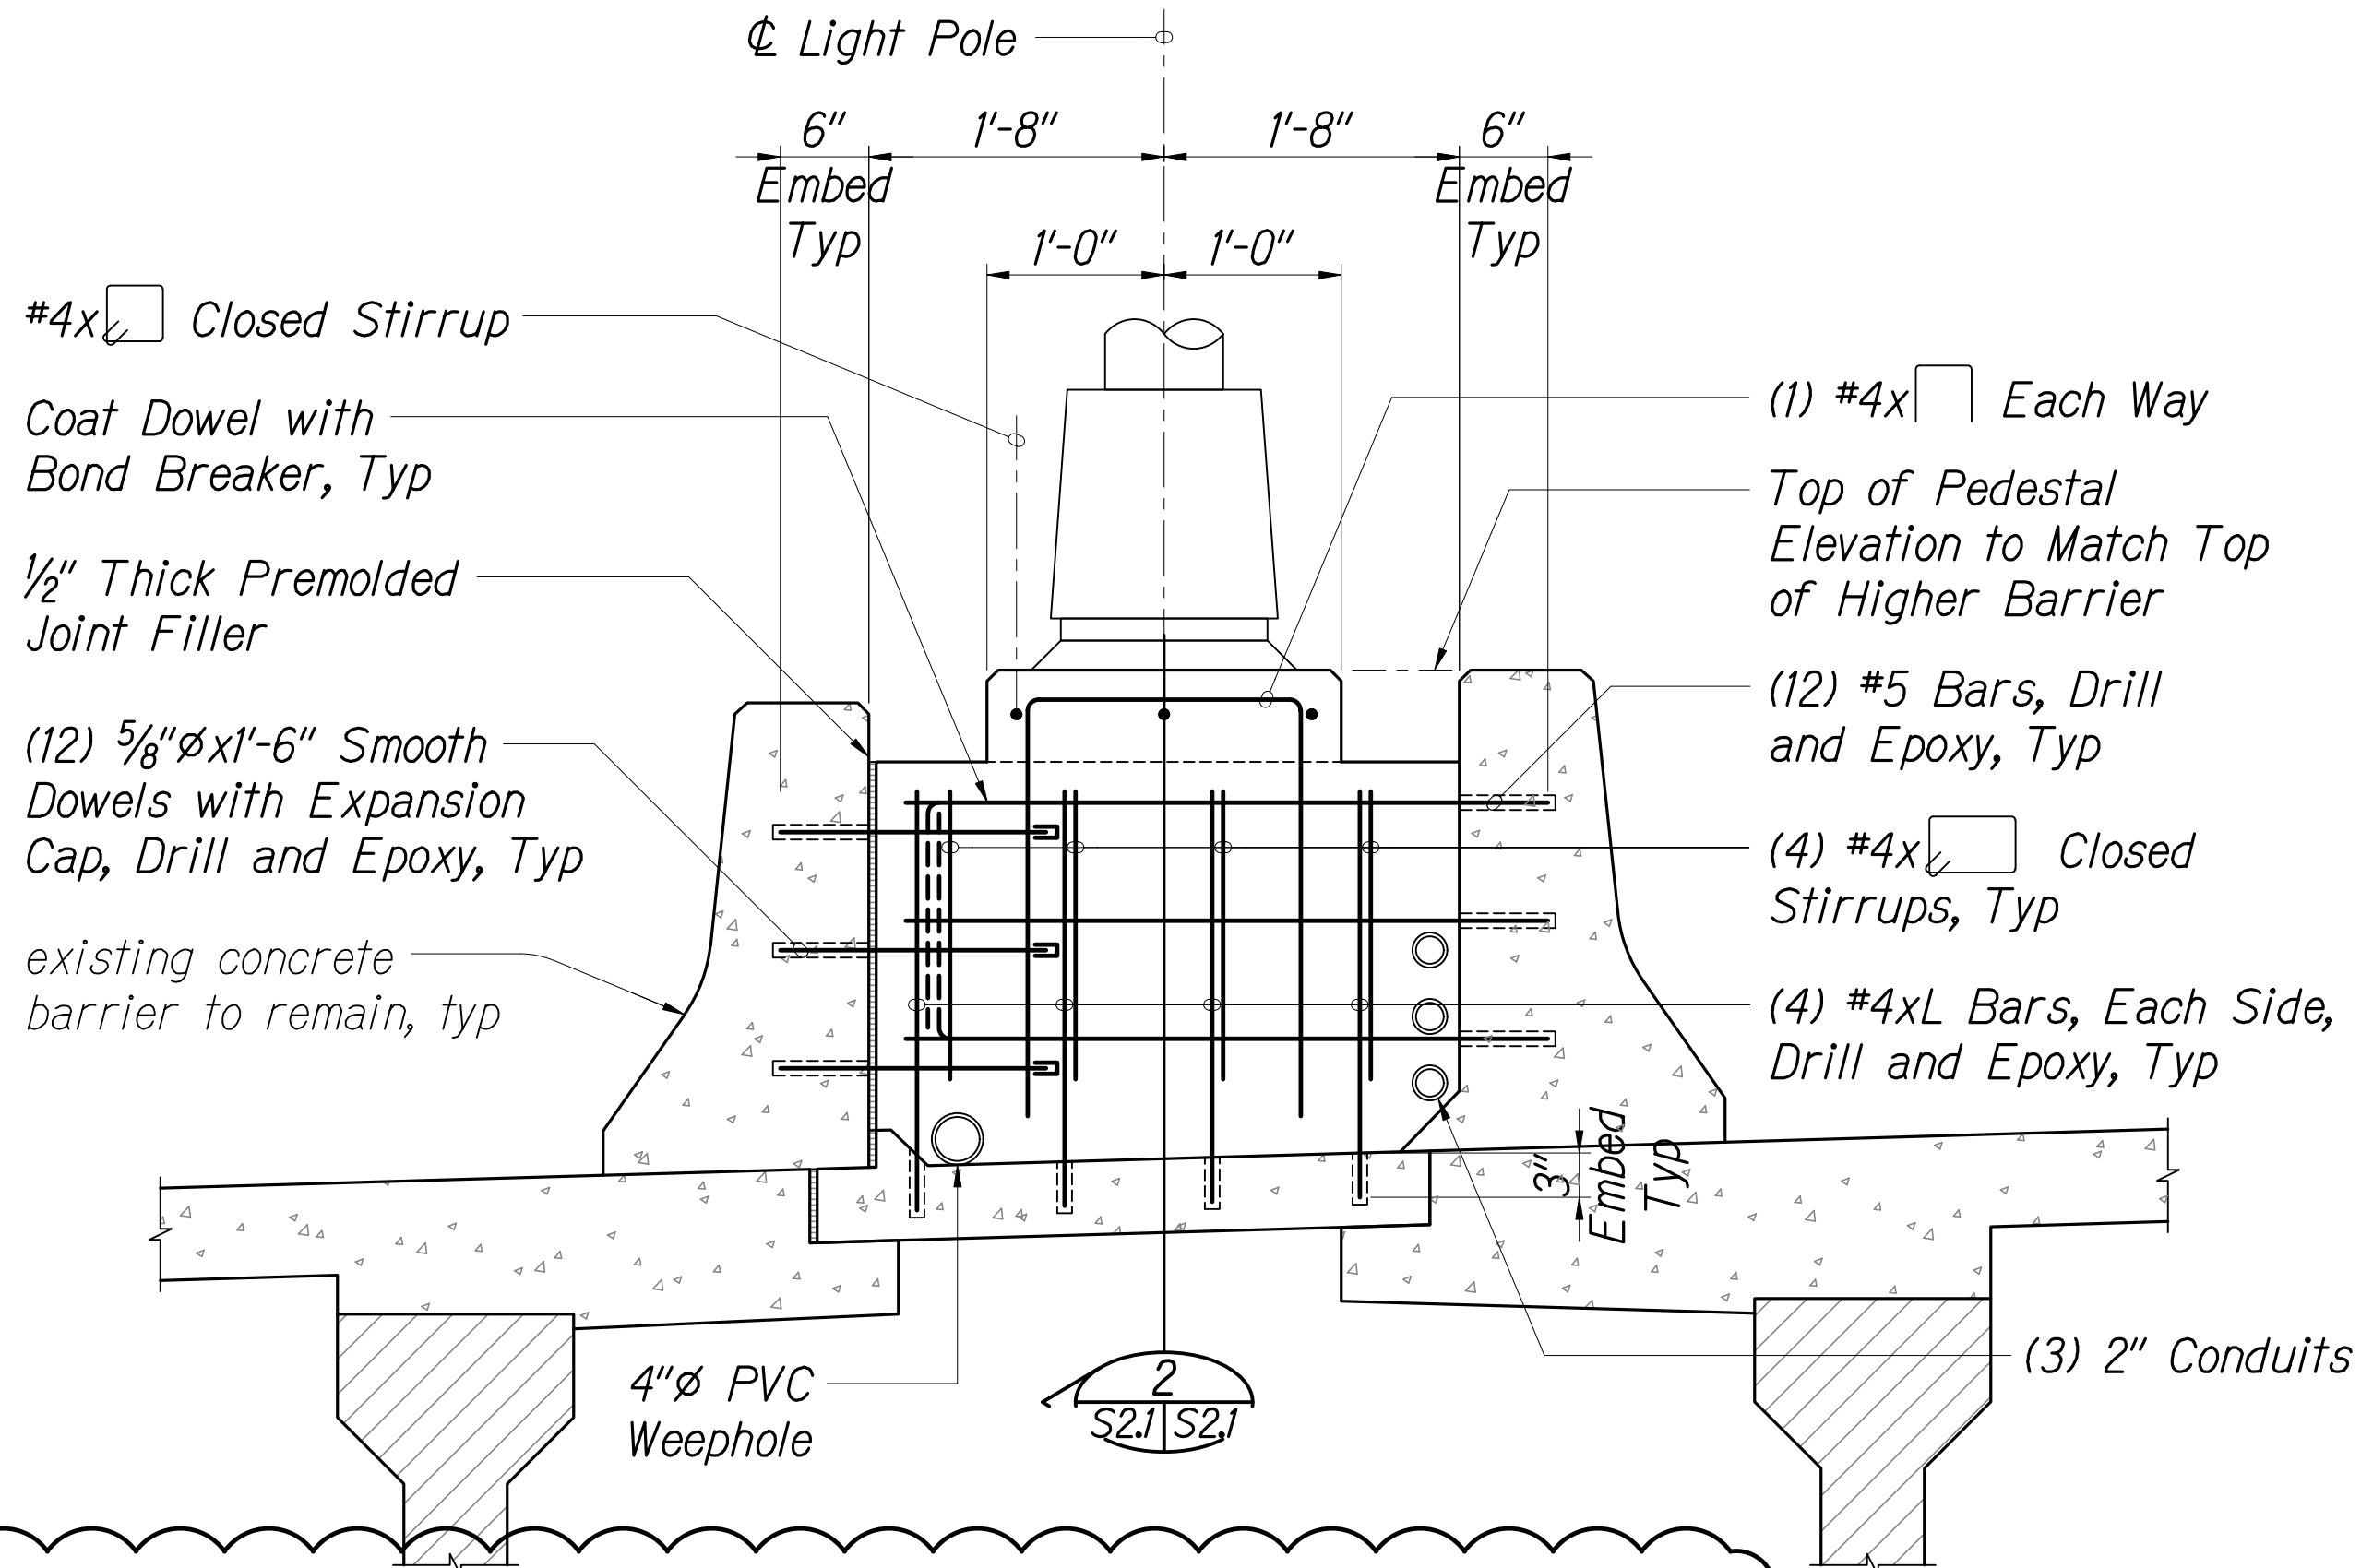


LIGHT POLE 36 SUPPORT SECTION

Scale: 1" = 1'-0"

1  
S2.1 S2.1

1

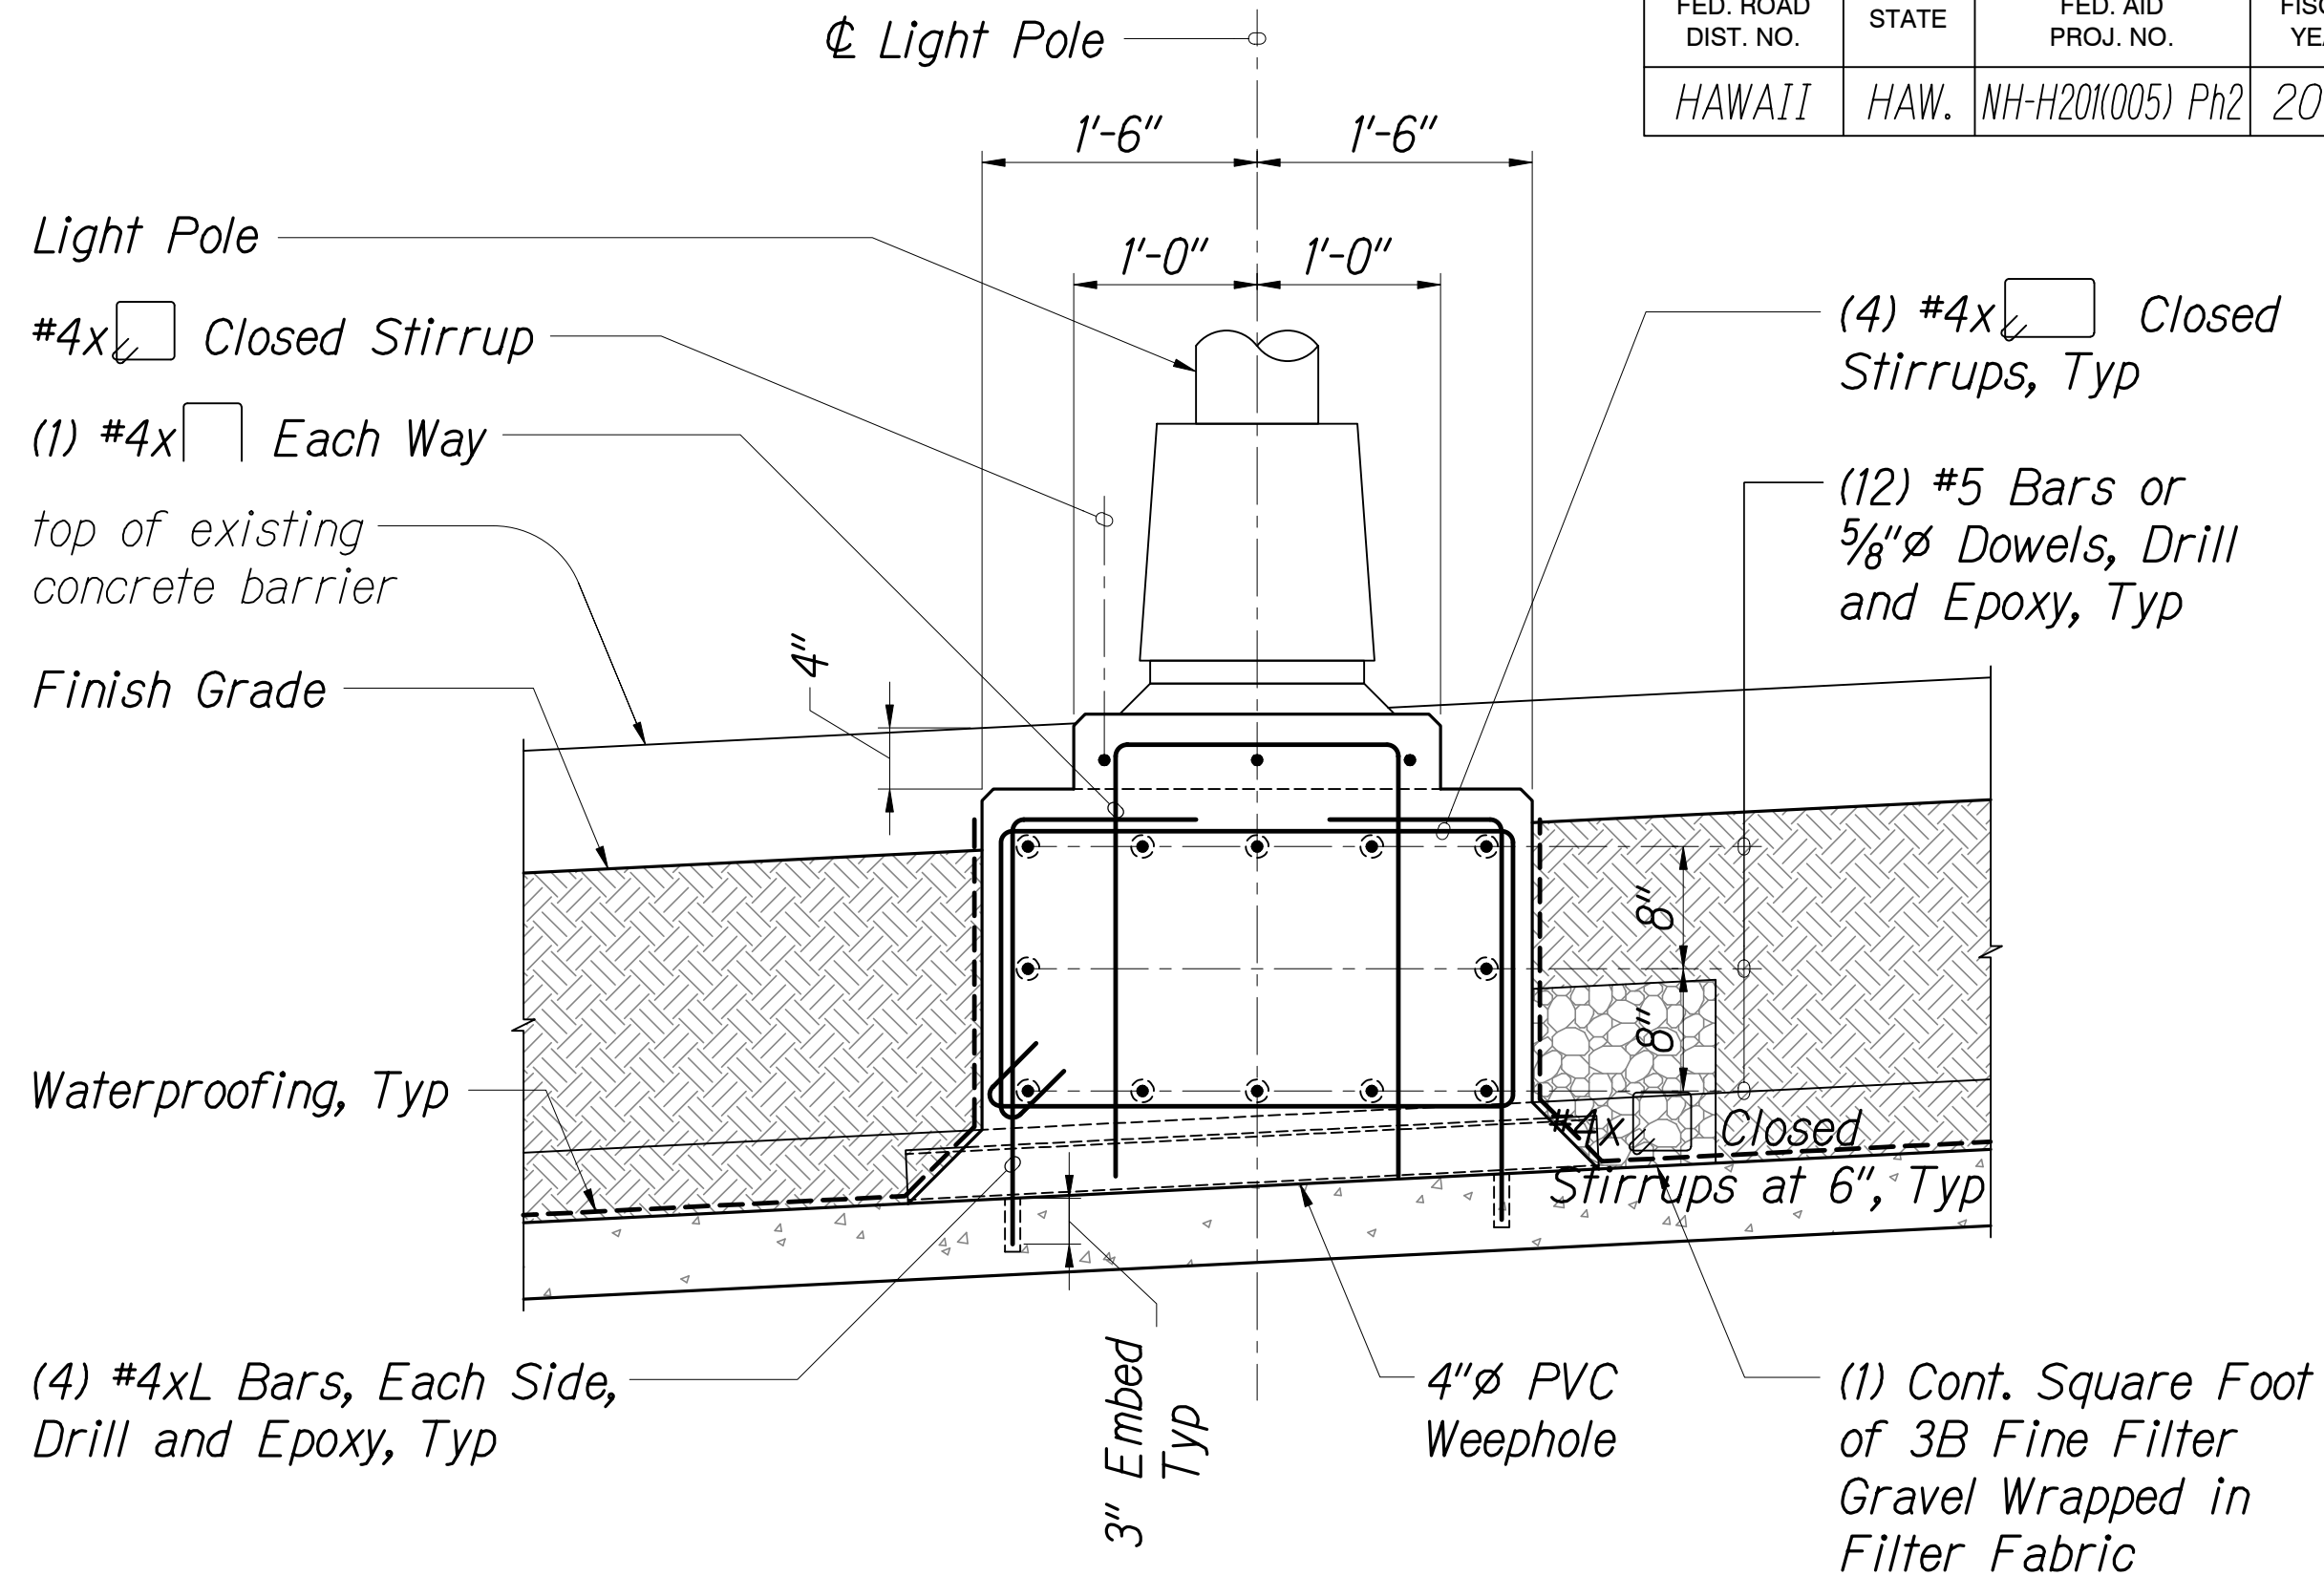

LIGHT POLE 36 SUPPORT SECTION

Scale: 1" = 1'-0"

2  
S2.1 S2.1

1

ORIGINAL PLAN	DATE
DESIGNED BY	
TRACED BY	
NOTE BOOK	
QUANTITIES BY	
CHECKED BY	




02/18/21

Revised Light Pole 36 Support

DATE

REVISION

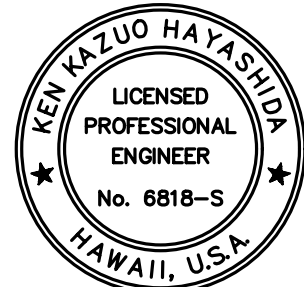

EXPIRATION DATE OF THE LICENSE 4/30/2022  
THIS WORK WAS PREPARED BY  
ME OR UNDER MY SUPERVISION

STATE OF HAWAII  
DEPARTMENT OF TRANSPORTATION  
HIGHWAYS DIVISION  
**LIGHT POLE 36  
SECTIONS**

MOANALUA FREEWAY, HIGHWAY LIGHTING IMPROVEMENTS  
Halawa Heights Off-ramp to Middle St. Overpass  
FAP NO. NH-H201(005) PHASE 2


Scale: As Shown

Date: July 2020


SHEET No. S2.1 OF 25 SHEETS

ADD. 87


FED. ROAD DIST. NO.	STATE	FED. AID PROJ. NO.	FISCAL YEAR	SHEET NO.	TOTAL SHEETS
HAWAII	HAW.	NH-H20(K005) Ph2	2020	97	140

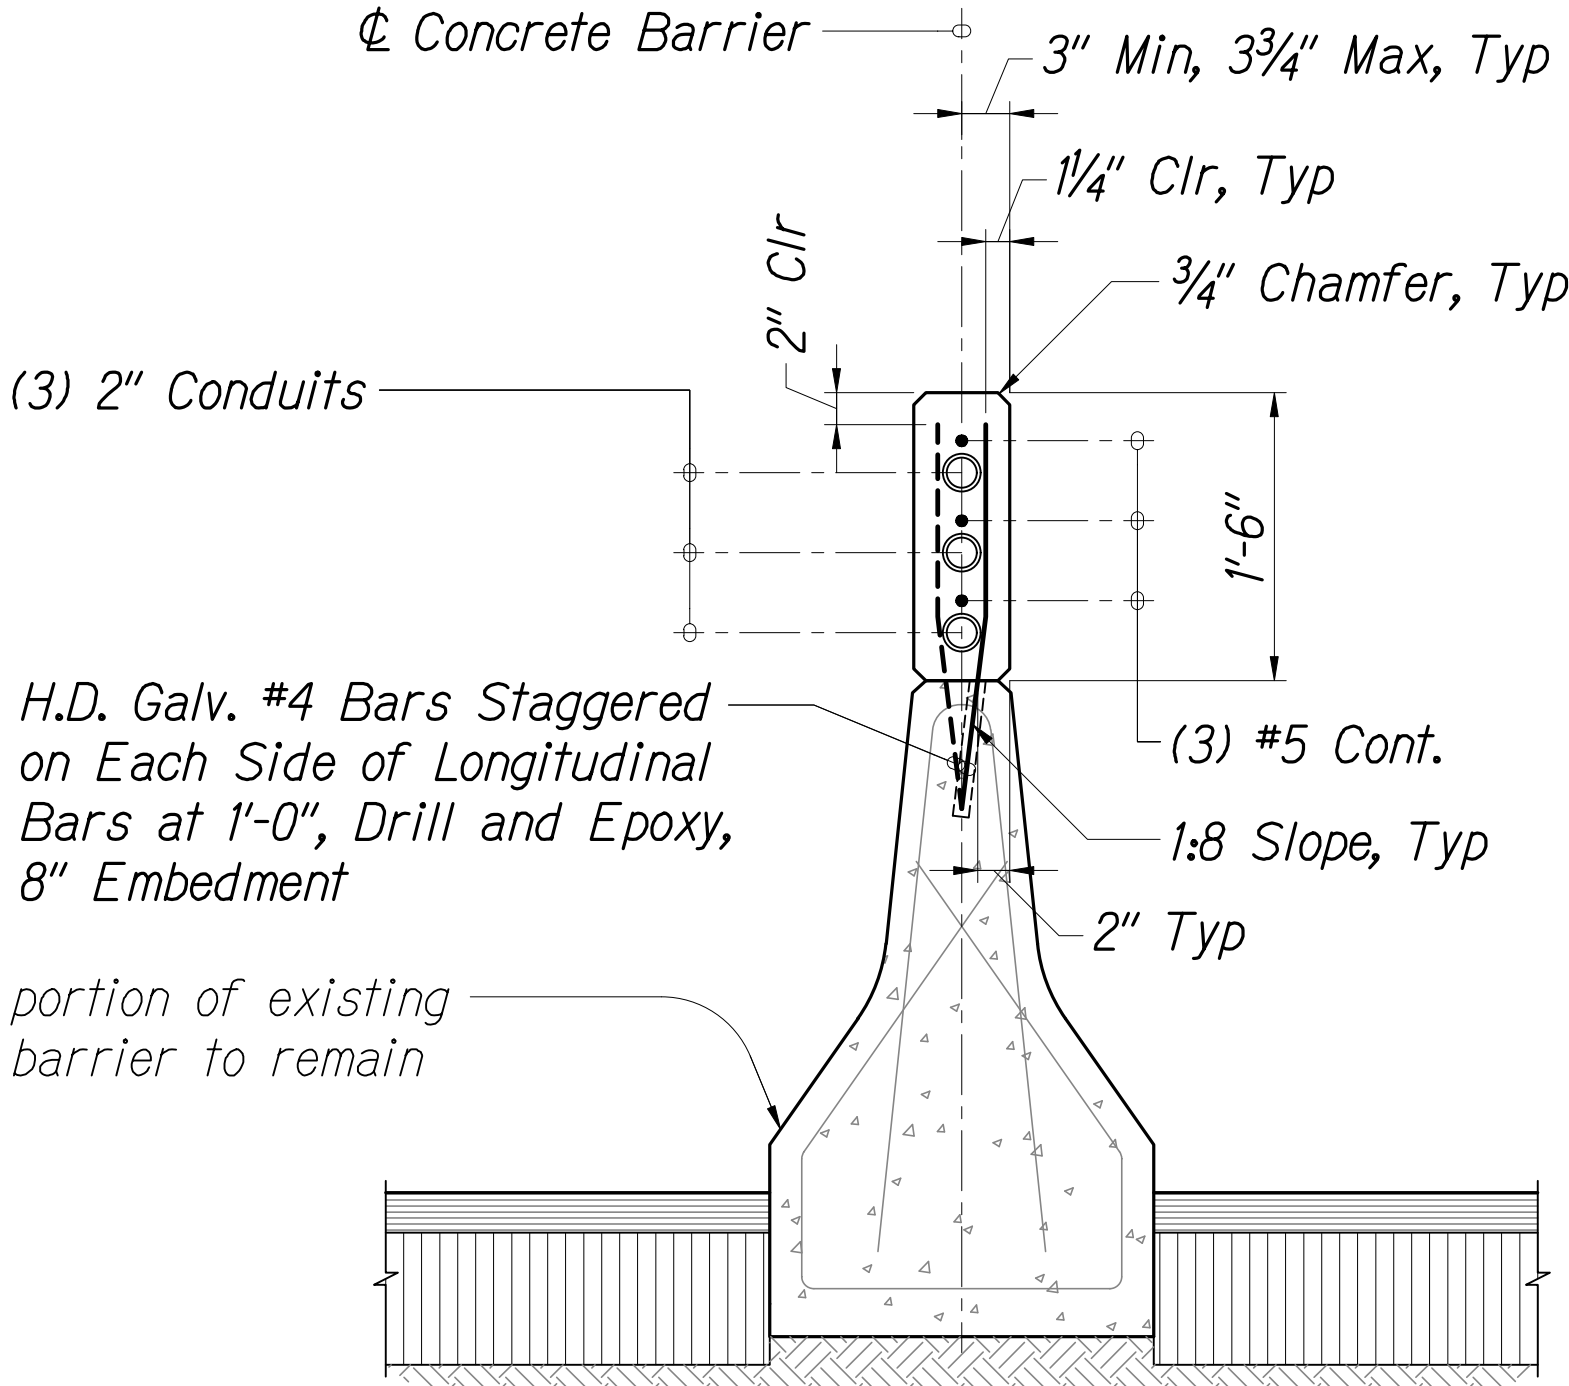


GLARE SCREEN  
RECONSTRUCTION SECTION  
Scale: 1" = 1'-0" S5.2, S5.4 S5.6

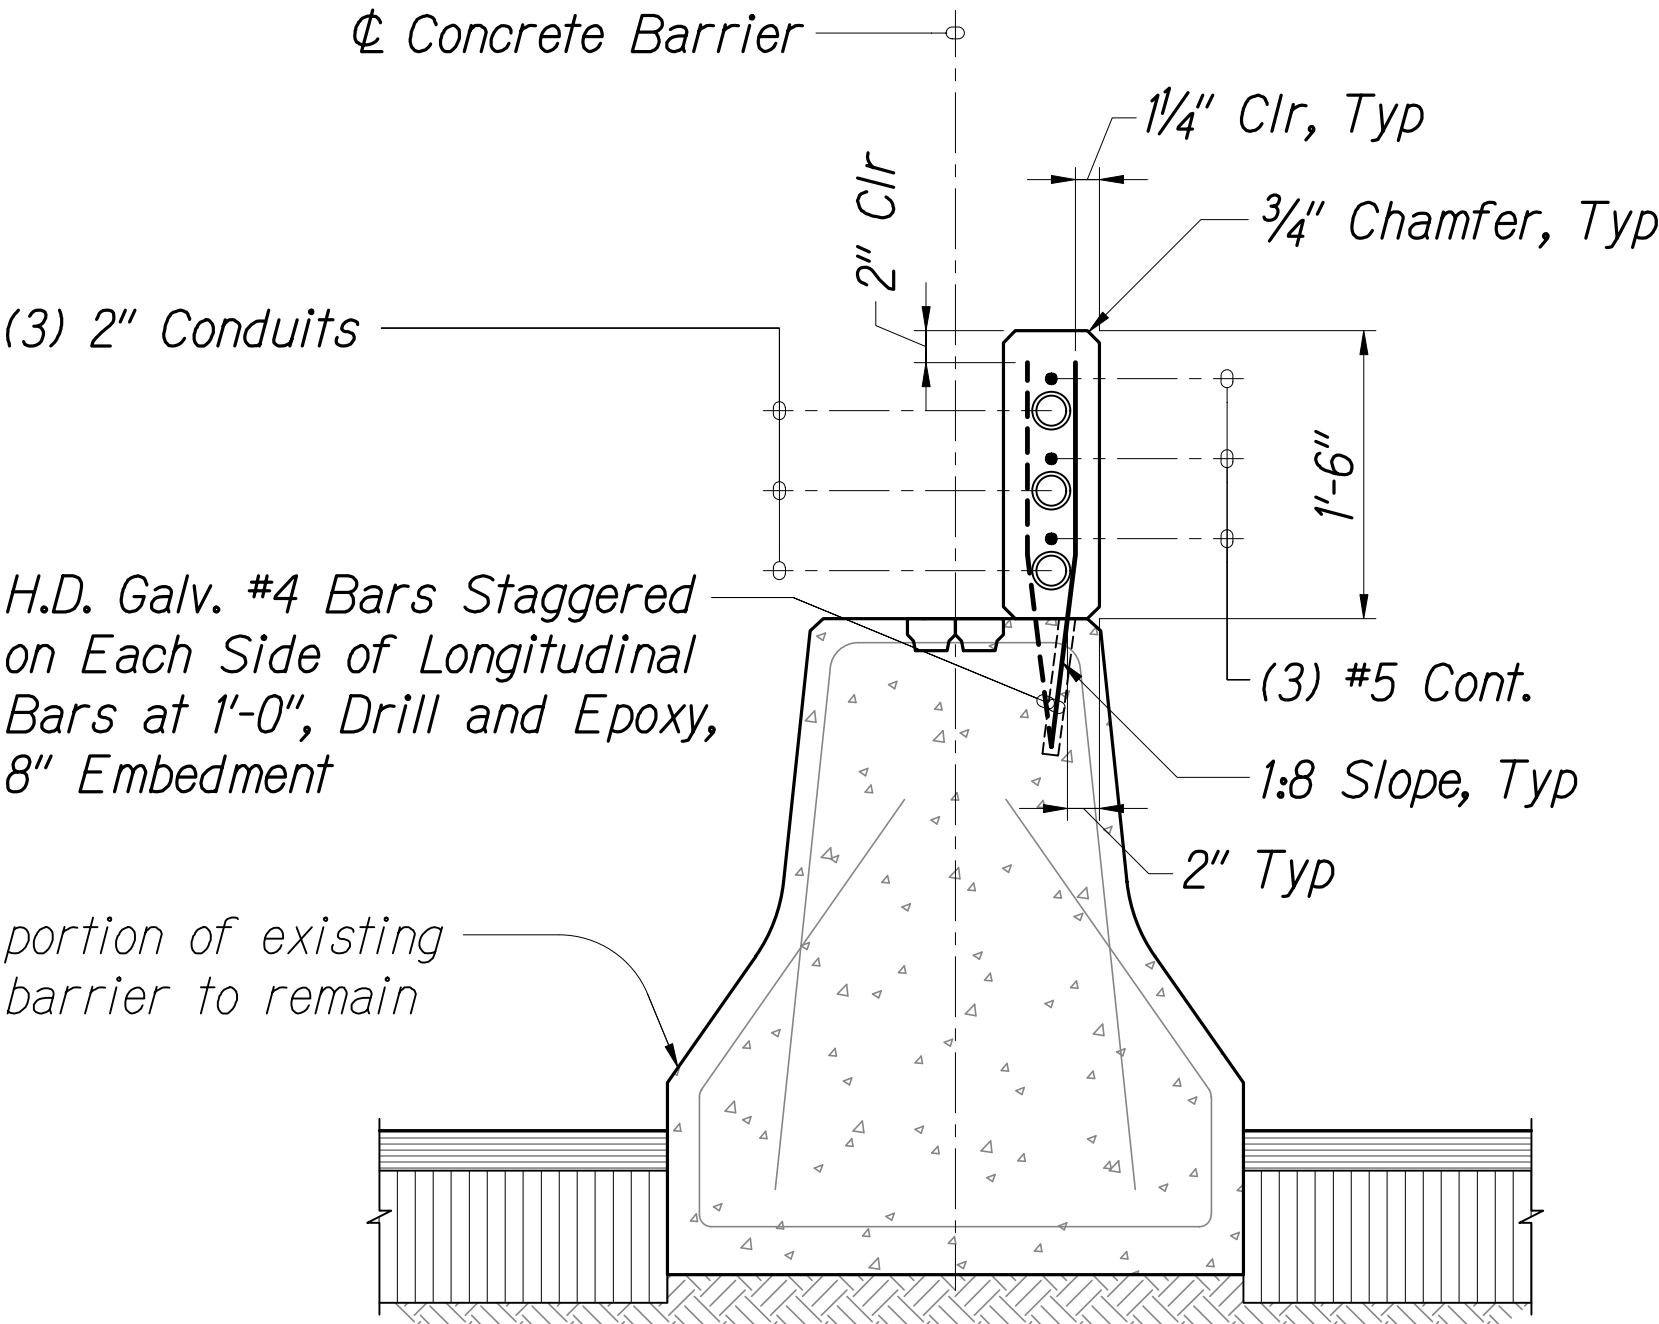


MEDIAN BARRIER  
RECONSTRUCTION SECTION  
Scale: 1" = 1'-0" S5.2, S5.4 S5.6

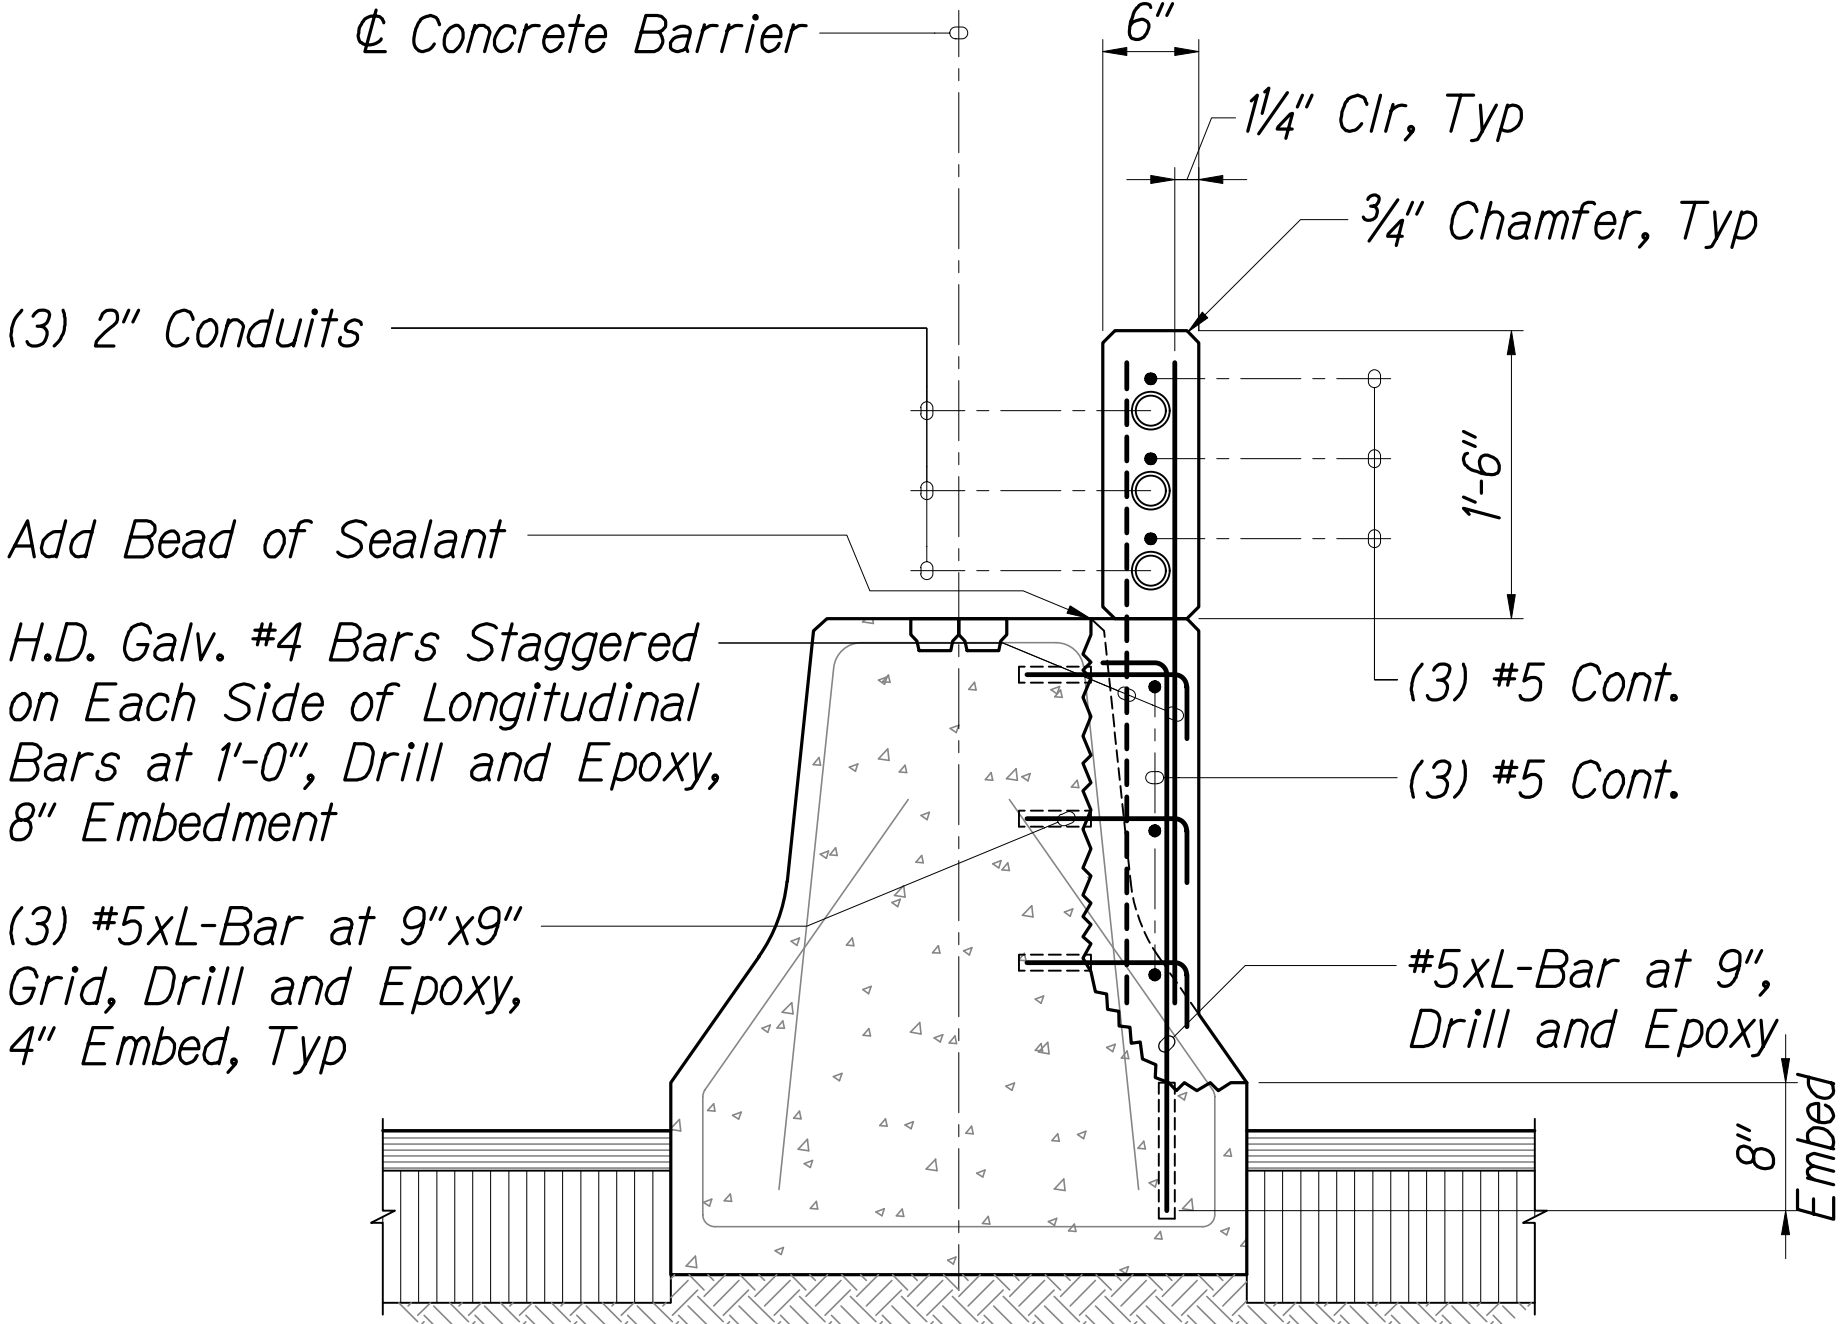

MEDIAN BARRIER  
RECONSTRUCTION SECTION  
Scale: 1" = 1'-0" S5.2, S5.4 S5.6

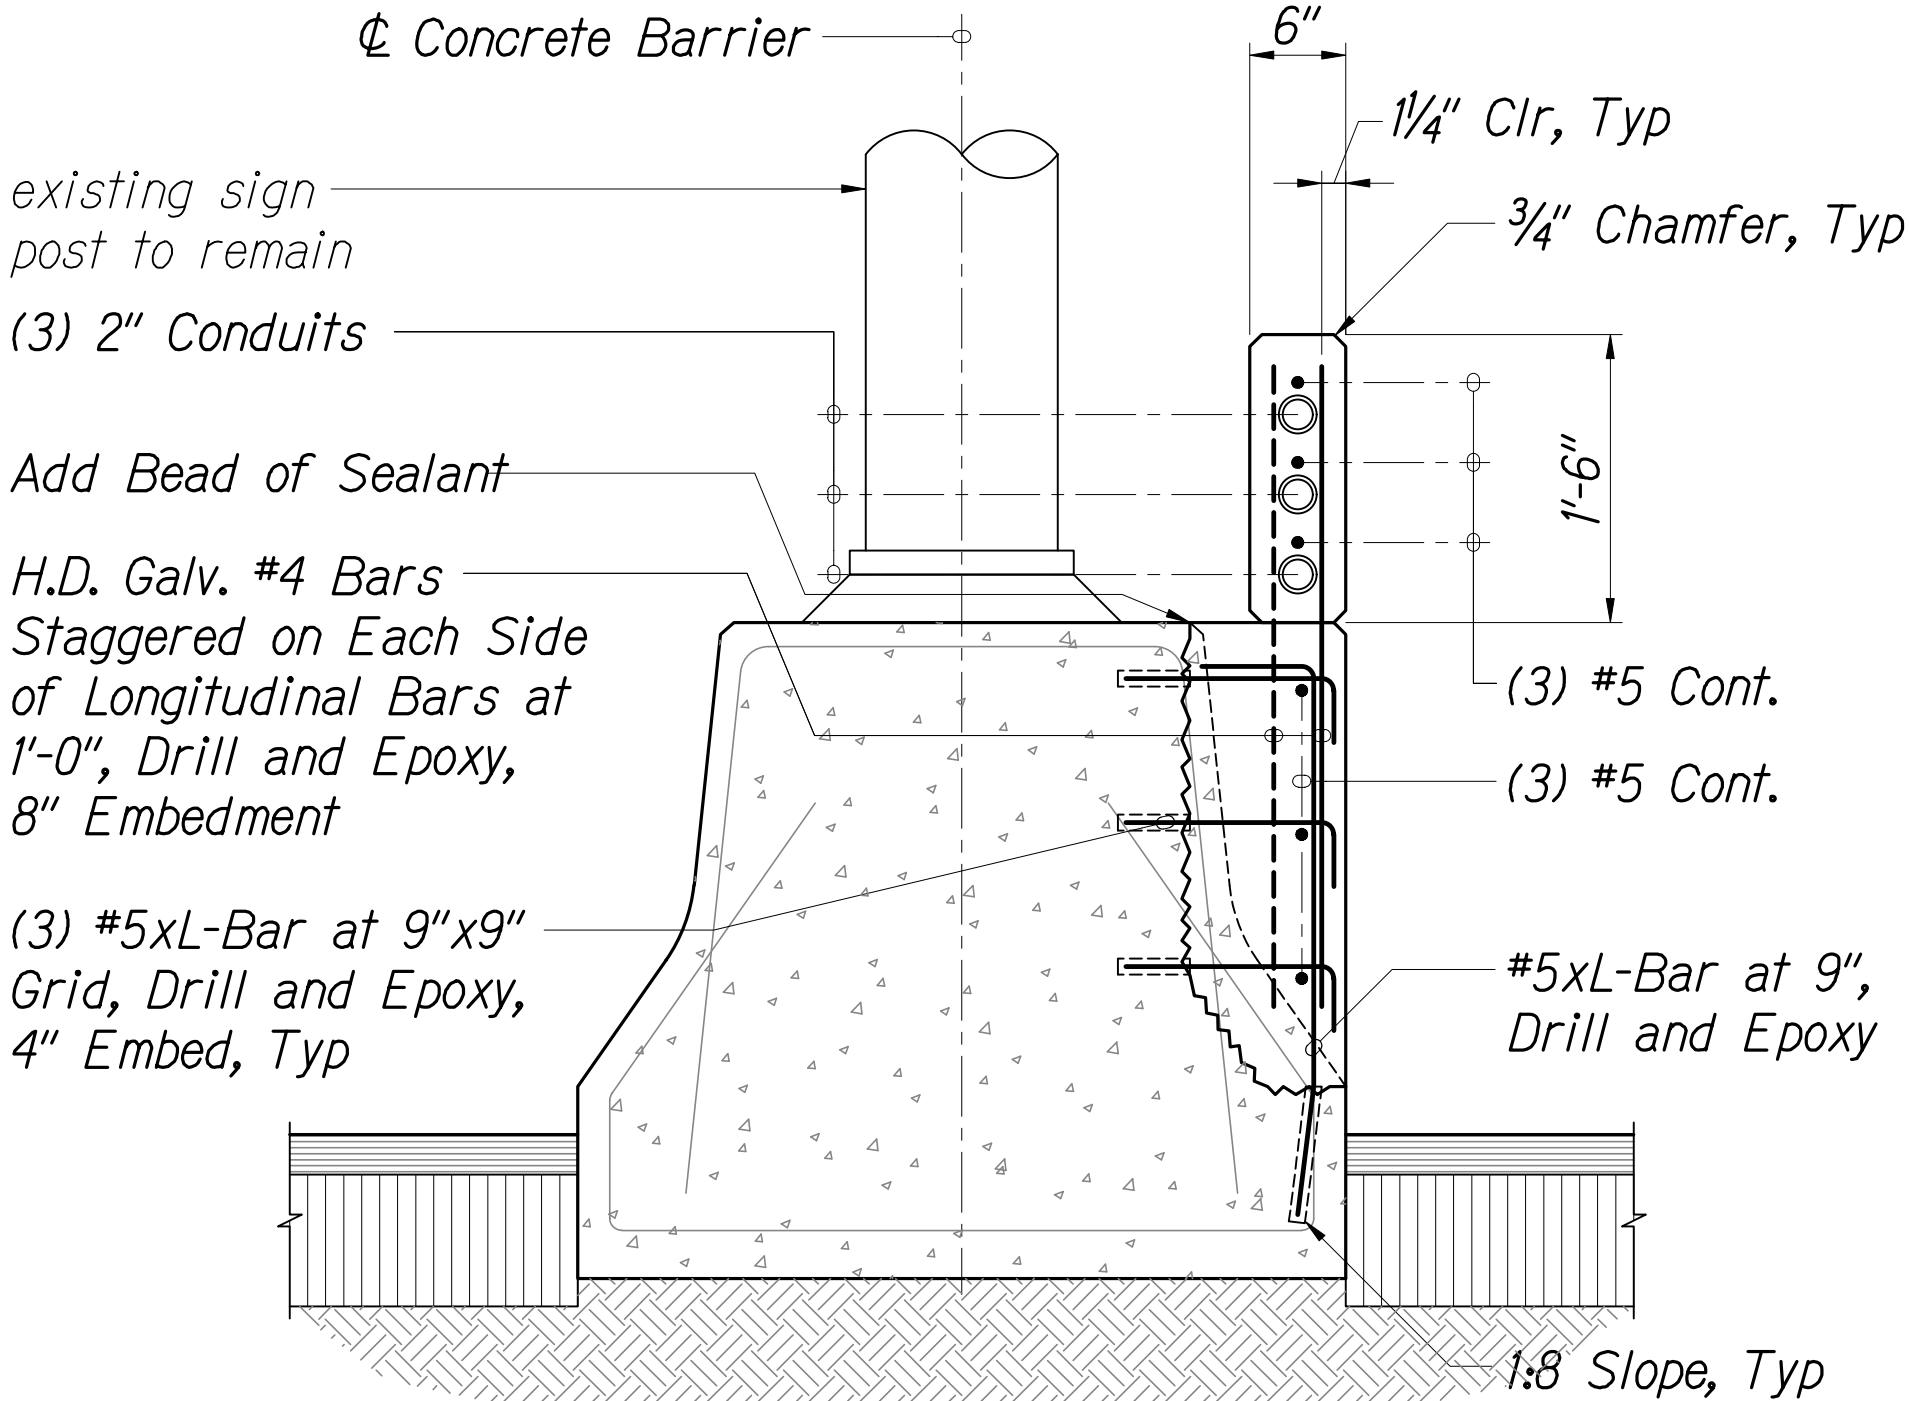

SIGN POST  
RECONSTRUCTION SECTION  
Scale: 1" = 1'-0" S5.2, S5.4 S5.6

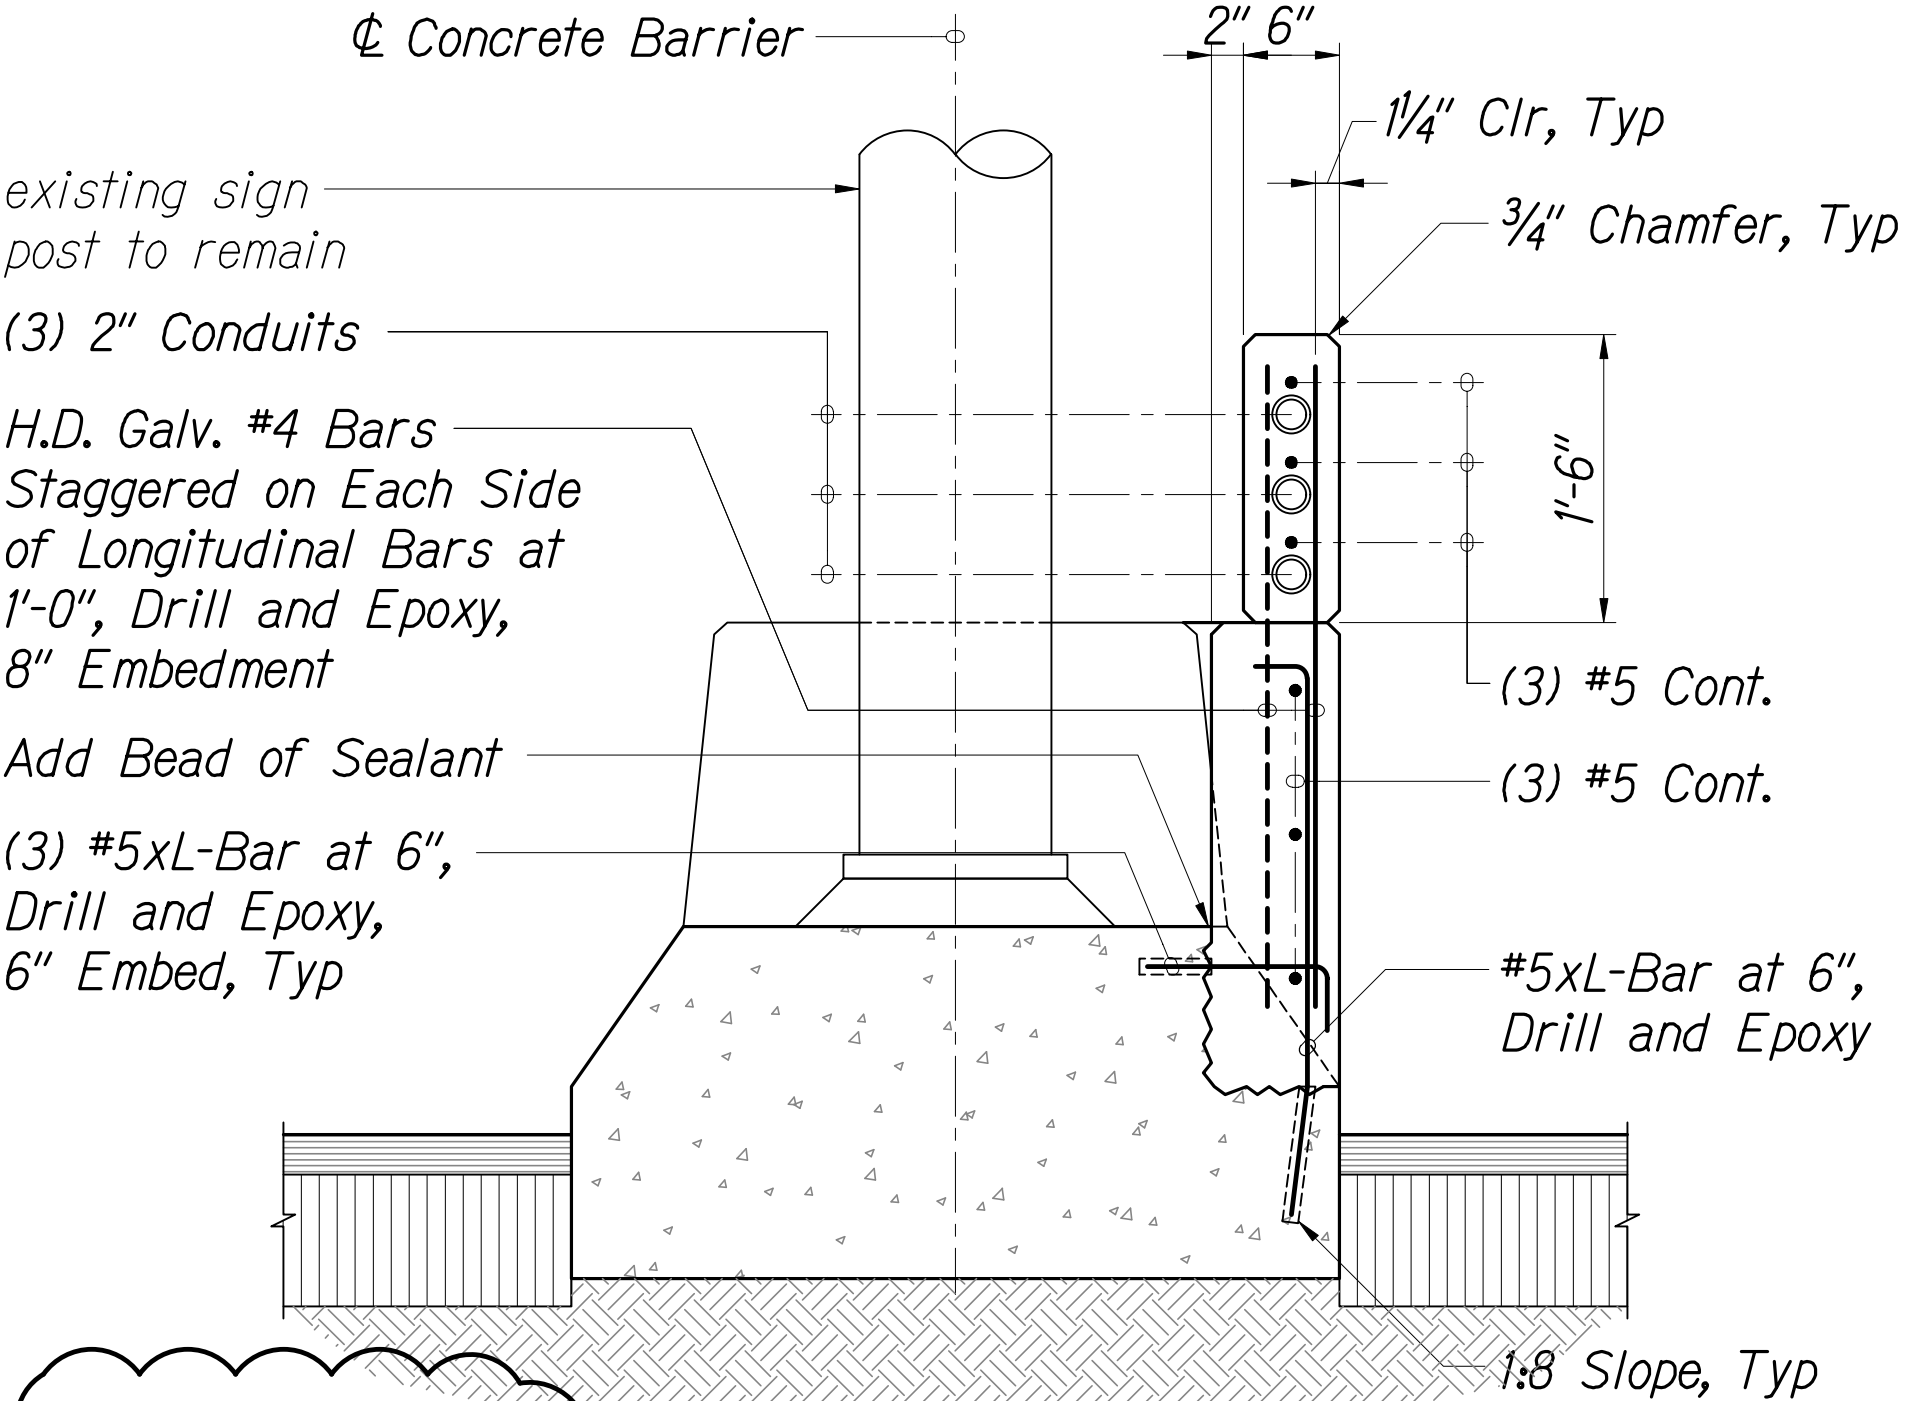

SIGN POST  
RECONSTRUCTION SECTION  
Scale: 1" = 1'-0" S5.2, S5.4 S5.6

Note:  
1. Locations and sizes of contraction and/or expansion joints shall match existing wall joints.  
2. Roughen surface to 1/4"-inch amplitude Typ. (CSP 9) where concrete will be placed on existing.

02/18/21

Added Section

DATE	REVISION

STATE OF HAWAII  
DEPARTMENT OF TRANSPORTATION  
HIGHWAYS DIVISION

**SIGN POST MEDIAN  
BARRIER SECTIONS - 1**

MOANALUA FREEWAY, HIGHWAY LIGHTING IMPROVEMENTS  
Halawa Heights Off-ramp to Middle St. Overpass  
FAP NO. NH-H20(K005) PHASE 2

Scale: As Shown



Date: July 2020

KEN KAZUO HAYASHIDA  
LICENSED PROFESSIONAL ENGINEER  
No. 6818-S  
HAWAII, U.S.A.

EXPIRATION DATE OF THE LICENSE: 4/30/2022  
THIS WORK WAS PREPARED BY ME OR UNDER MY SUPERVISION

SHEET No. S5.6 OF 25 SHEETS

FED. ROAD DIST. NO.	STATE	FED. AID PROJ. NO.	FISCAL YEAR	SHEET NO.	TOTAL SHEETS
HAWAII	HAW.	NH-H201(K005) Ph2	2020	98A	140

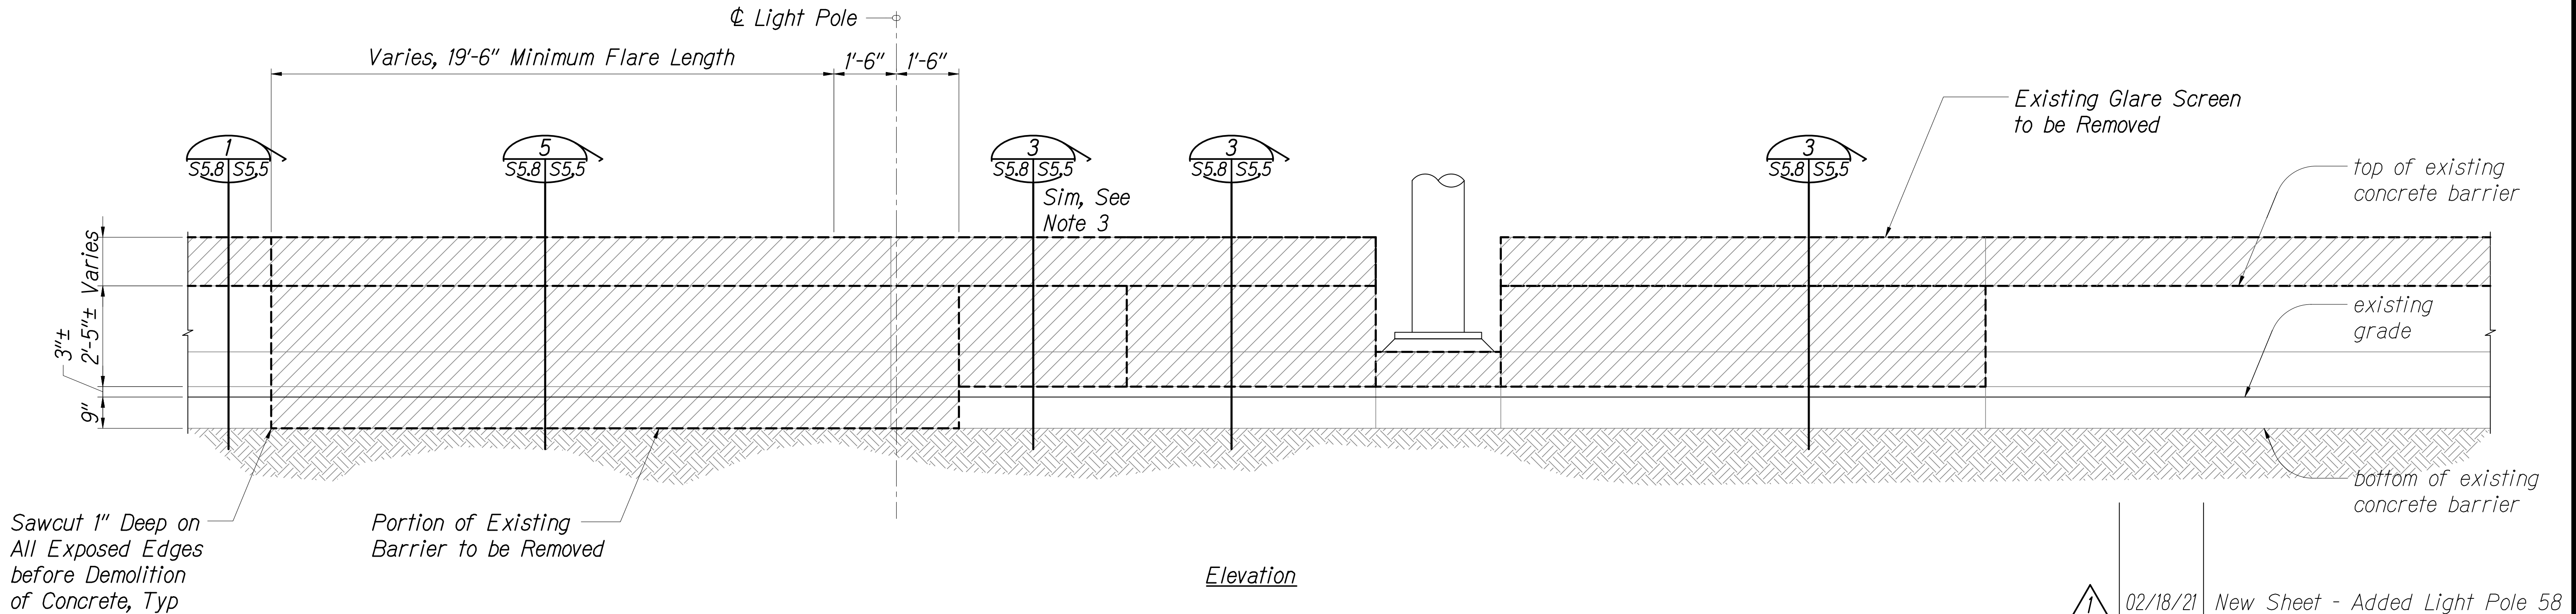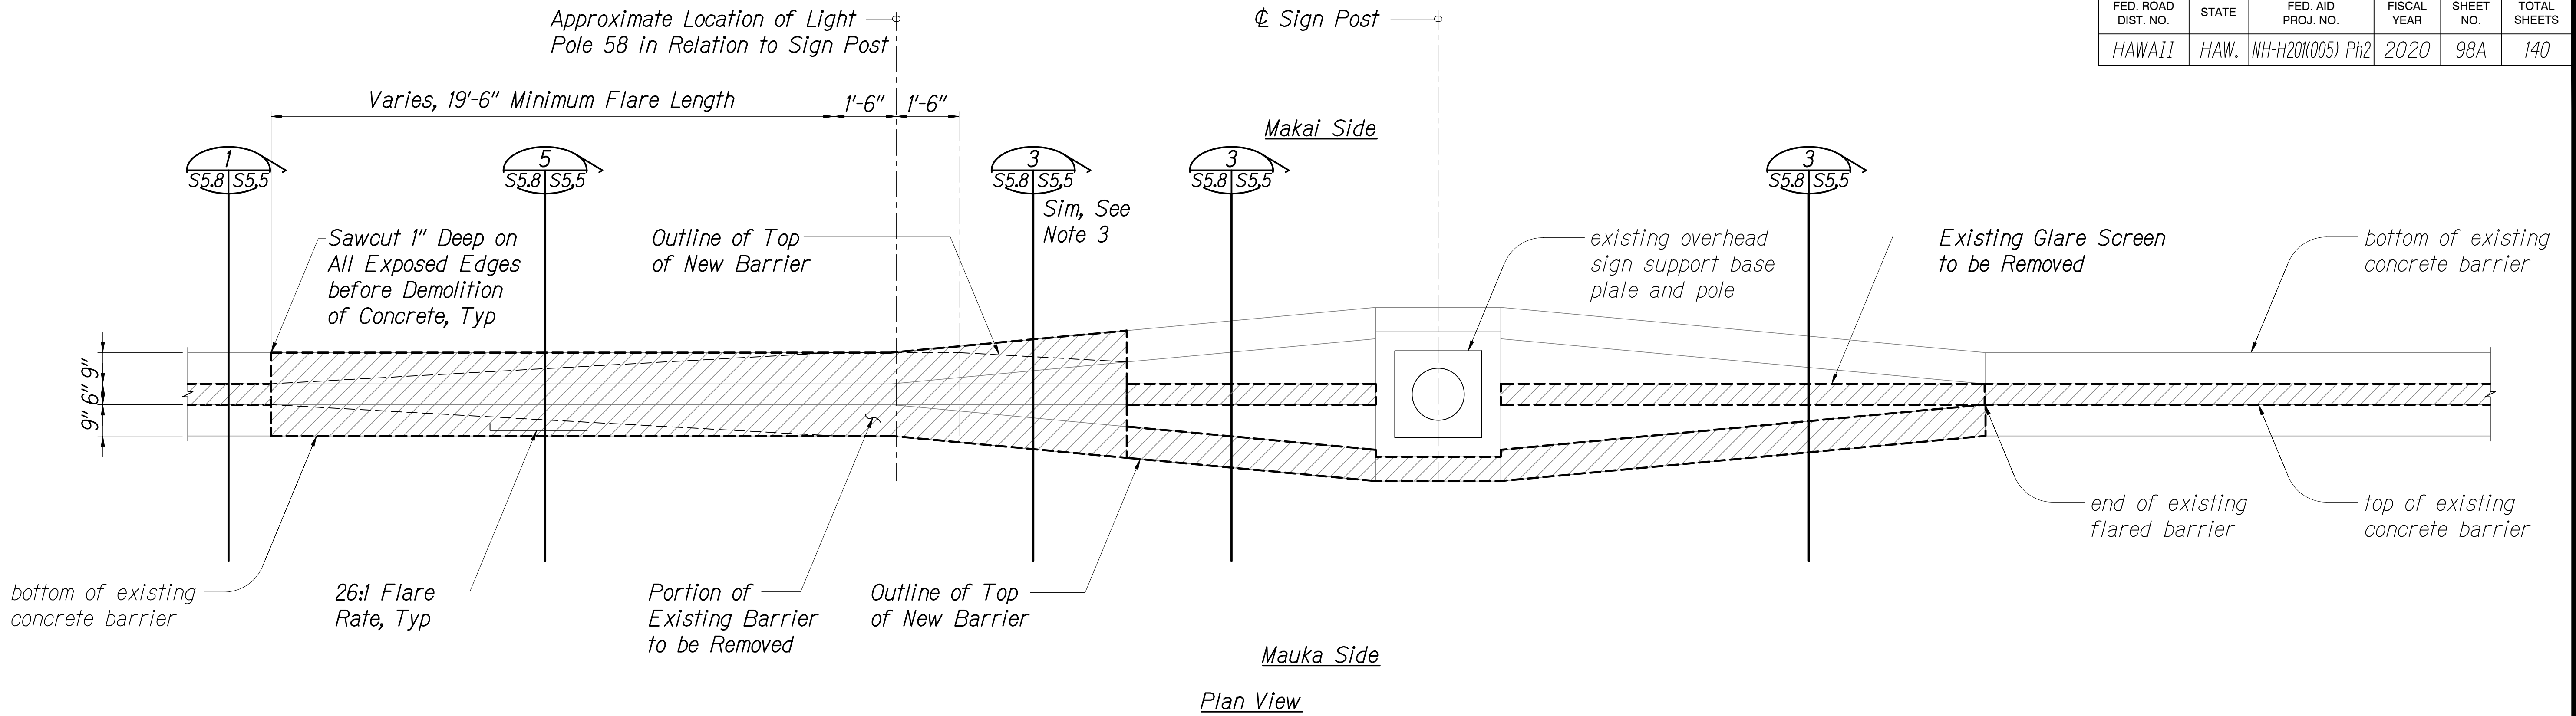


- Notes:
- Where there was an expansion joint in the existing section of wall that was removed, a new expansion joint shall be placed at the end of the new wall nearest the removed joint. See sheet S1.8 for joint details.
  - Where Existing Joint in Barrier is less than 5'-0" from End of Flare Length, Extend Demolition to Existing Joint. See Sheet S1.1 for details.
  - Demolition of sloped barrier face shall occur on both sides instead of just one side as shown on referenced detail.

ORIGINAL PLAN	DATE
DESIGNED BY	
TRACED BY	
NOTE BOOK	
QUANTITIES BY	
CHECKED BY	
No.	

LIGHT POLE 58  
MEDIAN BARRIER DEMOLITION

Not to Scale

1 55.8 55.8


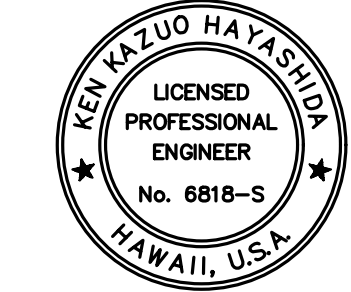


EXPIRATION DATE OF THE LICENSE 4/30/2022  
THIS WORK WAS PREPARED BY  
ME OR UNDER MY SUPERVISION

02/18/21	New Sheet - Added Light Pole 58
DATE	REVISION

STATE OF HAWAII  
DEPARTMENT OF TRANSPORTATION  
HIGHWAYS DIVISION  
**SIGN POST MEDIAN  
BARRIER DEMOLITION**  
MOANALUA FREEWAY, HIGHWAY LIGHTING IMPROVEMENTS  
Halawa Heights Off-ramp to Middle St. Overpass  
FAP NO. NH-H201(K005) PHASE 2  
Scale: As Shown Date: July 2020  
SHEET No. S5.8 OF 25 SHEETS

FED. ROAD DIST. NO.	STATE	FED. AID PROJ. NO.	FISCAL YEAR	SHEET NO.	TOTAL SHEETS
HAWAII	HAW.	NH-H20(K005) Ph2	2020	98B	140

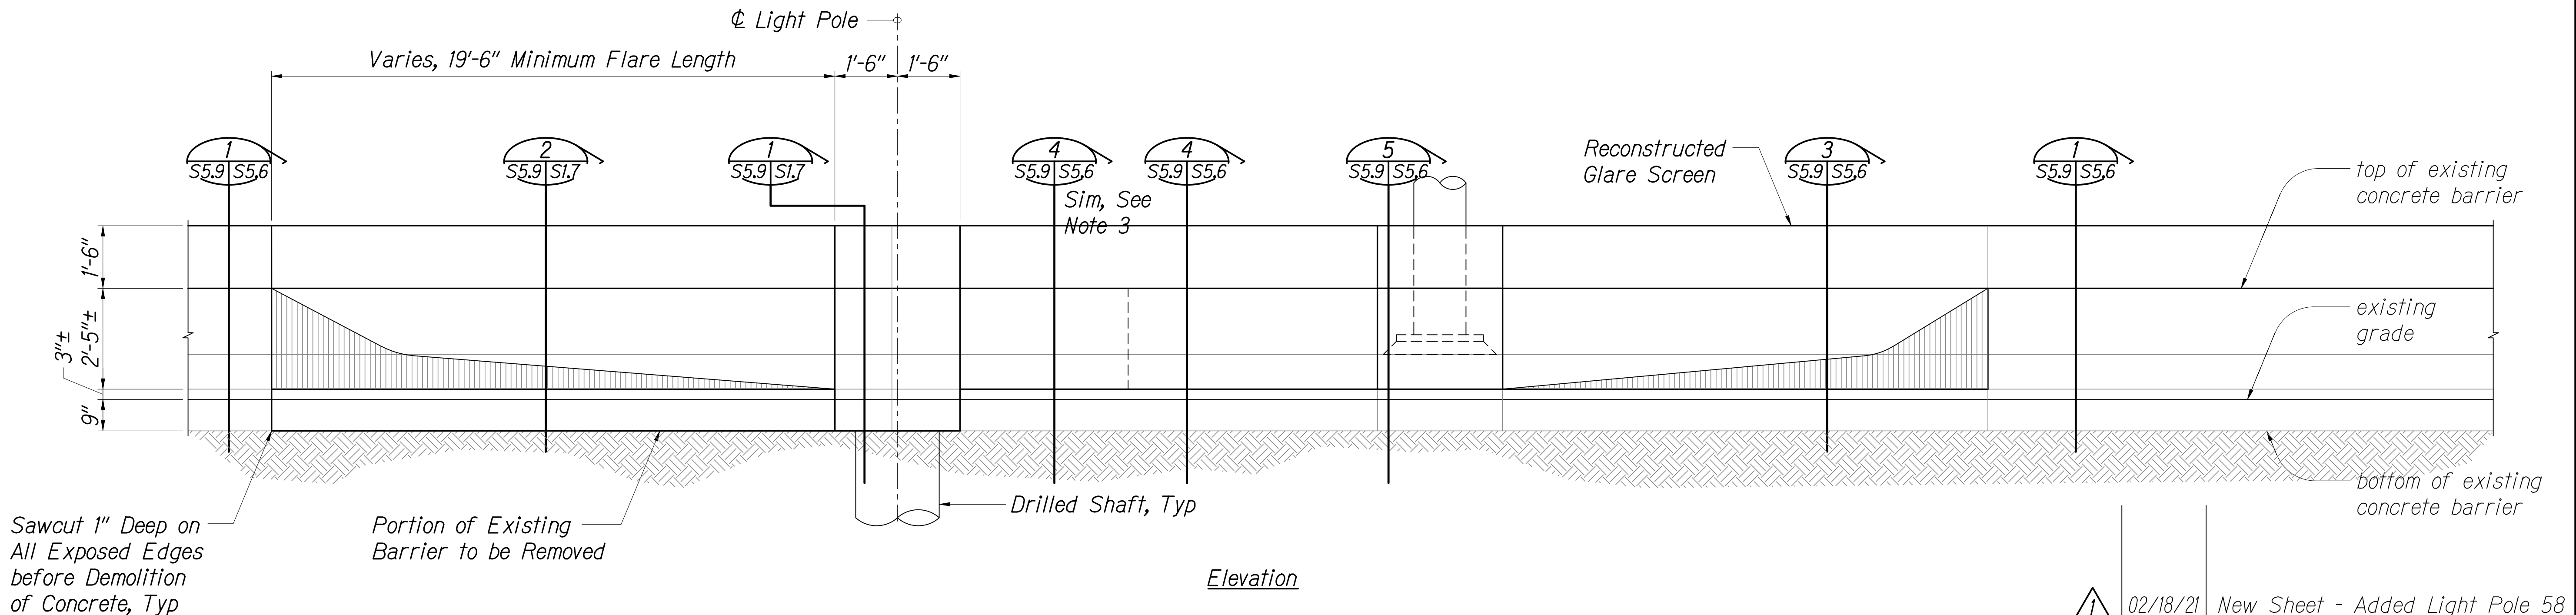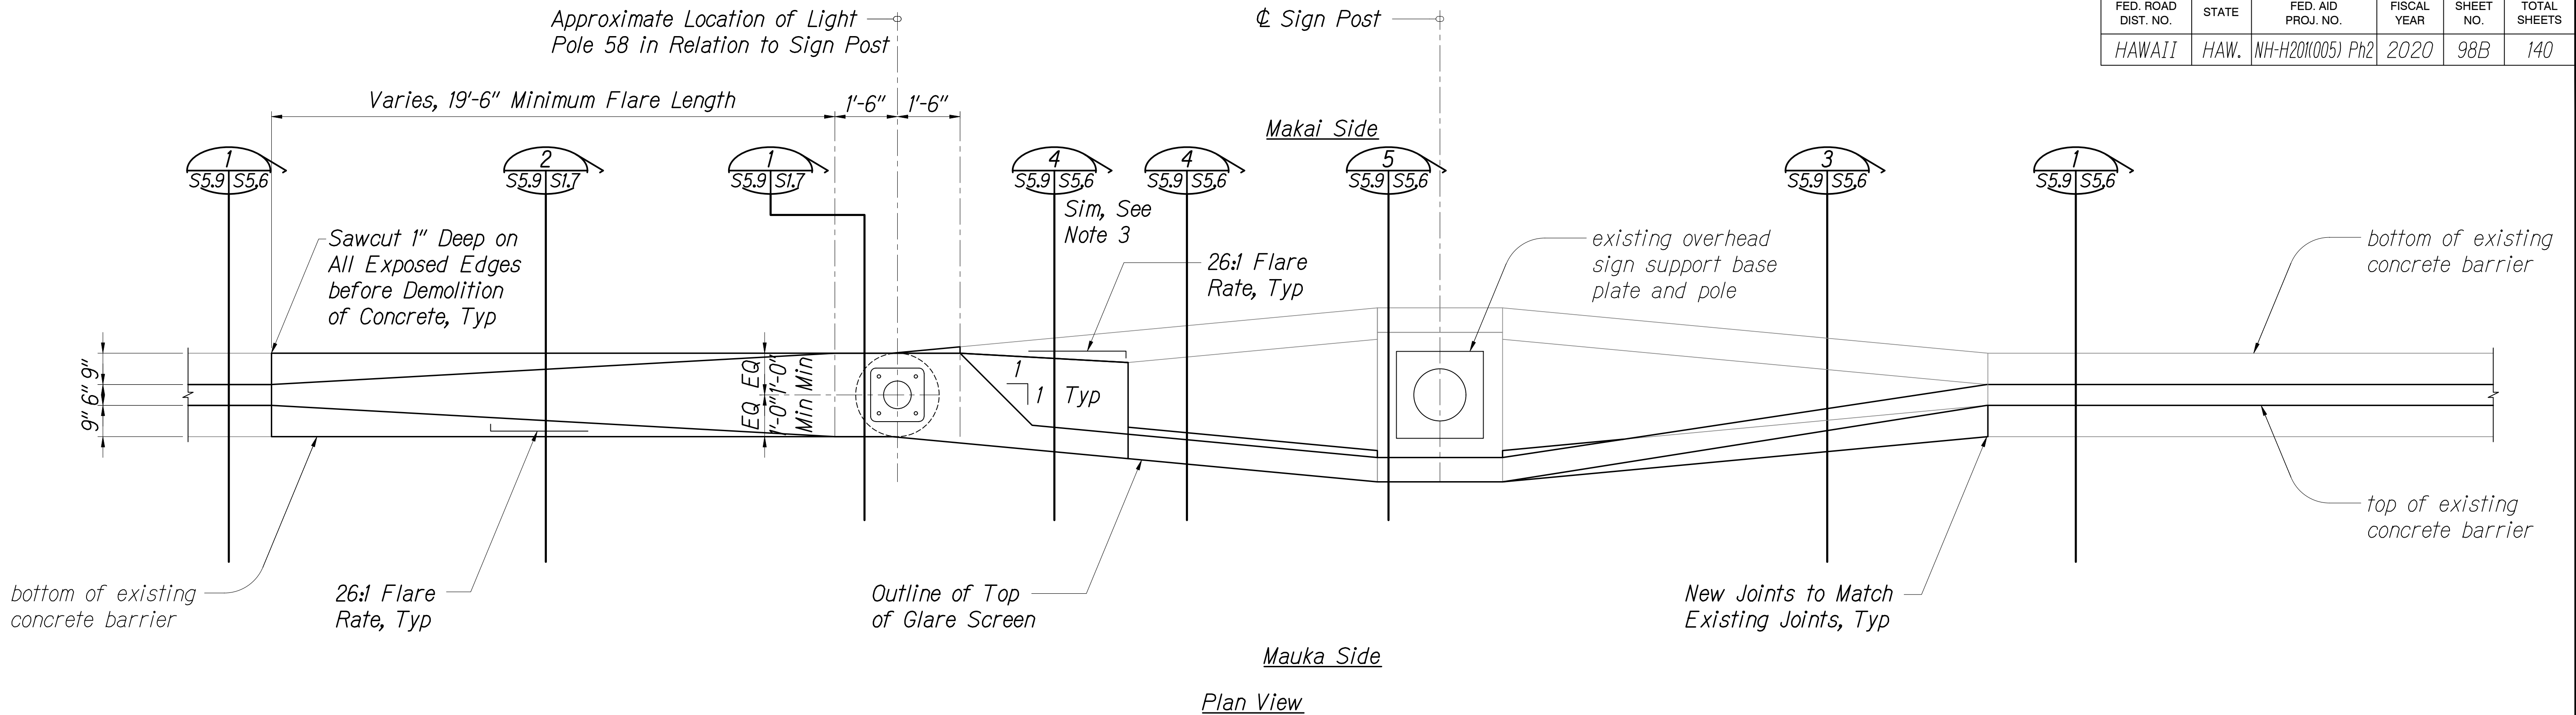


- Notes:
- Where there was an expansion joint in the existing section of wall that was removed, a new expansion joint shall be placed at the end of the new wall nearest the removed joint. See sheet S1.8 for joint details.
  - Where Existing Joint in Barrier is less than 5'-0" from End of Flare Length, Extend Demolition to Existing Joint. See Sheet S1.1 for details.
  - Reconstruction of sloped barrier face shall occur on both sides instead of just one side as shown on referenced detail. Detail 3 55.9 | S5.6 shall be referenced for reconstruction on Makai Side and Detail 4 55.9 | S5.6 shall be referenced for reconstruction on Mauka Side.

LIGHT POLE 58  
MEDIAN BARRIER RECONSTRUCTION

Not to Scale

1 55.9 | S5.9

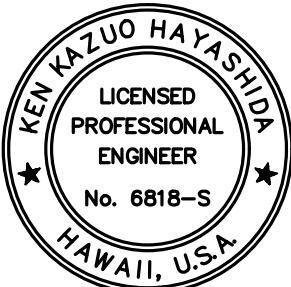

EXPIRATION DATE OF THE LICENSE: 4/30/2022  
THIS WORK WAS PREPARED BY  
ME OR UNDER MY SUPERVISION



02/18/21 New Sheet - Added Light Pole 58

DATE REVISION

STATE OF HAWAII  
DEPARTMENT OF TRANSPORTATION  
HIGHWAYS DIVISION  
**SIGN POST MEDIAN  
BARRIER RECONSTRUCTION**

MOANALUA FREEWAY, HIGHWAY LIGHTING IMPROVEMENTS  
Halawa Heights Off-ramp to Middle St. Overpass  
FAP NO. NH-H20(K005) PHASE 2

Scale: As Shown

Date: July 2020

SHEET No. S5.9 OF 25 SHEETS

ADD. 98B



GENERAL NOTES:

1.

This project includes the furnishing and installation of a new LED highway lighting system that complies with the latest AASHTO roadway lighting design standard and as specified by this contract. Demolish and remove the existing highway lighting system within the specified project limits. Modify existing median and retaining wall structures to accommodate new street lights. Pave over existing planter area with concrete. Drill shafts and pour foundations for new street lights. Furnish and install new conduits in the ground via trenching or directional boring and surface mounted to existing strictures. Furnish and install new pullboxes, median wall cutouts, metal covers, and junction boxes as necessary to create a complete and operable lighting system. Furnish and install new LED street lights mounted on new poles and under overpasses.

A.

Base Bid: Provide new LED highway lighting system for Moanalua Freeway H201 between Pu'uloa Rd interchange and Kikowaena St & Kaua St overpass.

B.

Additive Alternates:

1)

Additive Alternate #1: Provide new LED highway lighting system between H-1 EB on-ramp and Pu'uloa Rd interchange.
2.

Existing condition based on limited field observation and reference drawings. Contractor to verify existing condition and report discrepancy to engineer prior to construction.

3.

All electrical work shall comply with the requirements of the Department of Transportation, NEC and local codes and amendments, State of Hawaii rules and regulations, NEC (ANSI C2), utility applicable company standards and requirements.

4.

Coordinate all work with utility companies.

5.

Drawings are diagrammatic and symbolic and may not show all components and details. Install all work in a neat and logical manner and provide all components for a complete and operable system within intent indicated on drawings and specifications.

6.

See erosion control, traffic control, and structural plans and details, and provide electrical work as appropriate.

7.

Coordinate all work with other trades to avoid conflicts. Adjust location of the new electrical equipment and wiring as required to clear obstructions and equipment. Provide the required mounting accessories needed to properly install the electrical equipment and wiring.

8.

Tone using GPR area of new trenches prior to new underground work.

9.

All wires shall be insulated copper conductors and installed in raceways unless indicated otherwise.

10.

Provide ground wires for all street light circuits.

11.

Repair any damage made to structures and utilities caused by construction.

12.

All raceways shall be PVC coated GRS where exposed, concrete encased schedule 40 PVC For underground use, and flexible metal conduit for installation of dry type transformers and galvanized rigid metal conduit elsewhere in properly rated weatherproof enclosures.

13.

Exposed junction boxes shall be cast metal type or NEMA 4X S/S with no unused factory knock-outs. All electrical apparatus shall have NEMA 4X S/S enclosures.

14.

Paint all exposed metal raceways and boxes with two coats two-part epoxy based primer and two coats polyurethane enamel finish to match surrounding surfaces.

15.

Test complete street lighting system within the project limits, and make adjustments to the street lighting system as necessary to correct any measured and observed lighting level deficiencies. Reconnect any existing street lights that may have been disconnected by this work.

16.

Existing highway lighting system shall remain in operation at all times. Remove light poles and conductors only after the new lighting system is in operation. See detail 5/S6.1 in the structural drawings for foundation and anchor bolt removal instructions.

17.

Trace existing highway lighting & electrical circuits. Maintain power to all street lights & other circuits.

18.

Remove street lighting assembly where indicated on plans, including the associated wires. Remove exposed conduit & handholes that are no longer in use. Abandon in place underground ductlines and inaccessible handholes. Field verify existing condition.

19.

Restore landscaping to match existing condition in shoulder areas. Planter area to be paved over with concrete with welded wire reinforcement per Standard Specification 634.

20.

Salvage all luminaires and return to Department of Transportation as directed.

21.

Contractor to notify contracting officer of the existence of any devices and equipment mounted to the existing street lights that are being removed. Remove and return to Department of Transportation as directed unless noted on the drawings.

ELECTRICAL SYMBOLS			
EXISTING	REMOVAL	NEW	DESCRIPTION
			Street Lighting Assembly - Single 120 Watt LED Luminaire
			Street Lighting Assembly - Twin 120 Watt LED Luminaires
			Underpass Light LED Canopy-Soffit Light Fixture CREE CPY250, PY250-B-DM-D-A-UH-BZ-40K
			Pullbox - Type as Specified on Drawing
			Underground Ductlines, Exposed Raceways or Concealed Raceways Within Structure, with Wires, Quantity and Size as Specified on Drawing
			Underground Ductline Stub-out, 5'-0" From Edge of Pavement or as Indicated on Plan. Provide Concrete Stub-out Marker.
			Weather Proof Junction Box, Wall Mounted, NEMA 4X S/S Size per NEC
			Cut

2 SL 4 (A) New Duct Section Identifier

DUCT DESIGNATION

STREET LIGHT POLE TAG DETAIL

Glenn D. Oyama  
THIS WORK WAS PREPARED BY  
ME OR UNDER MY SUPERVISION

1

02/18/21

Revised Note 19 for planter concrete to include welded wire reinforcement.

DATE	REVISION
<div>STATE OF HAWAII DEPARTMENT OF TRANSPORTATION HIGHWAYS DIVISION <b>GENERAL ELECTRICAL NOTES,</b> <b>SYMBOLS</b></div> <div>MOANALUA FREEWAY, HIGHWAY LIGHTING IMPROVEMENTS Halawa Heights Off-ramp to Middle St. Overpass FAP NO. NH-H201(005) PHASE 2</div> <div>Scale: Date: July 2020</div>	
SHEET No. E-1 OF 39 SHEETS	

ADD. 102

