
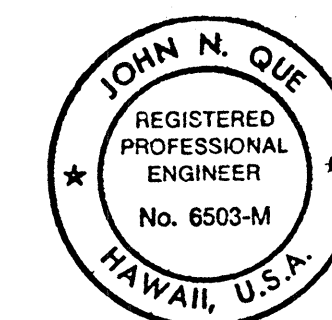
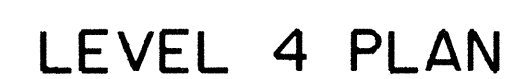
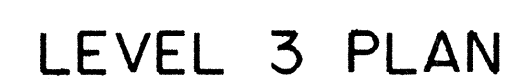


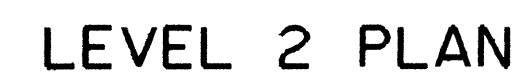

DATE	REVISION
STATE OF HAWAII DEPARTMENT OF TRANSPORTATION HIGHWAYS DIVISION	
<u>HAIKU PORTAL BUILDING</u> <u>IB - PLANS</u> <u>F & I VENTILATION FANS</u> <u>INTERSTATE ROUTE H-3</u> <u>F.A.I. PROJ. NO. I-H3-I(60)</u>	
SCALE: $\frac{1}{8}" = 1'-0"$ DATE: NOV 1987	
SHEET NO. 12 OF 23 SHEETS	

ORIGINAL PLAN	SURVEY PLOTTED BY	DATE
	DRAWN BY	
	TRACED BY	
NOTE BOOK	DESIGNED BY	
	QUANTITIES BY	
	CHECKED BY	
NO.		