



N

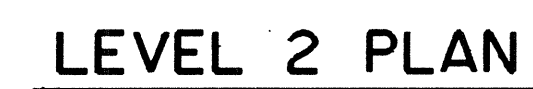

LEVEL 3 PLAN

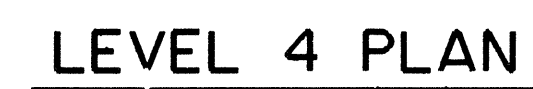

DATE	REVISION

STATE OF HAWAII
DEPARTMENT OF TRANSPORTATION
HIGHWAYS DIVISION

HAIKU PORTAL BUILDING
OB - PLANS
F & I VENTILATION FANS
INTERSTATE ROUTE H-3
F.A.I. PROJ. NO. I-H3-I(60)

SCALE: 1/8" = 1'-0"
DATE: NOV 1989

SHEET NO. 14 OF 23 SHEETS