

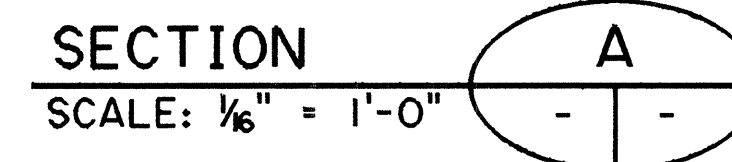


N

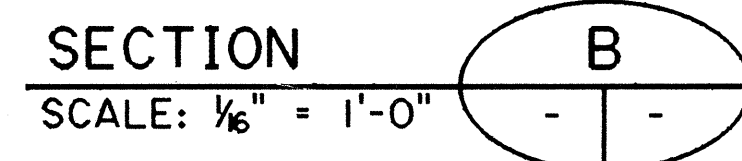

SECTION
SCALE: $\frac{1}{16}" = 1'-0"$

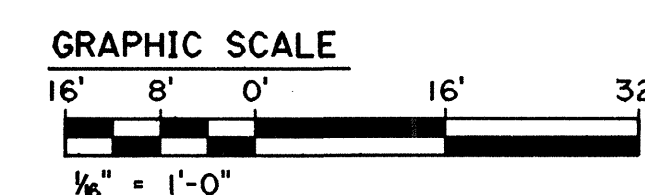

SCALE: $\frac{1}{16}" = 1'-0"$ DATE: NOV 1989
SHEET NO. 9 OF 24 SHEETS