


SECTION 

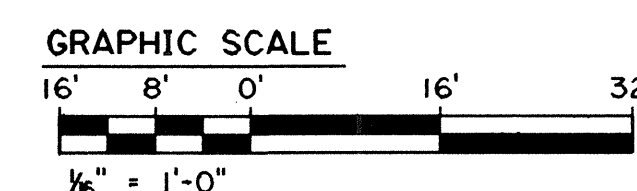

John M. ...