



FED. ROAD DIST. NO.	STATE	FED. AID PROJ. NO.	FISCAL YEAR	SHEET NO.	TOTAL SHEETS
HAWAII	HAW.	I-H3-1(60)	1990	2	24

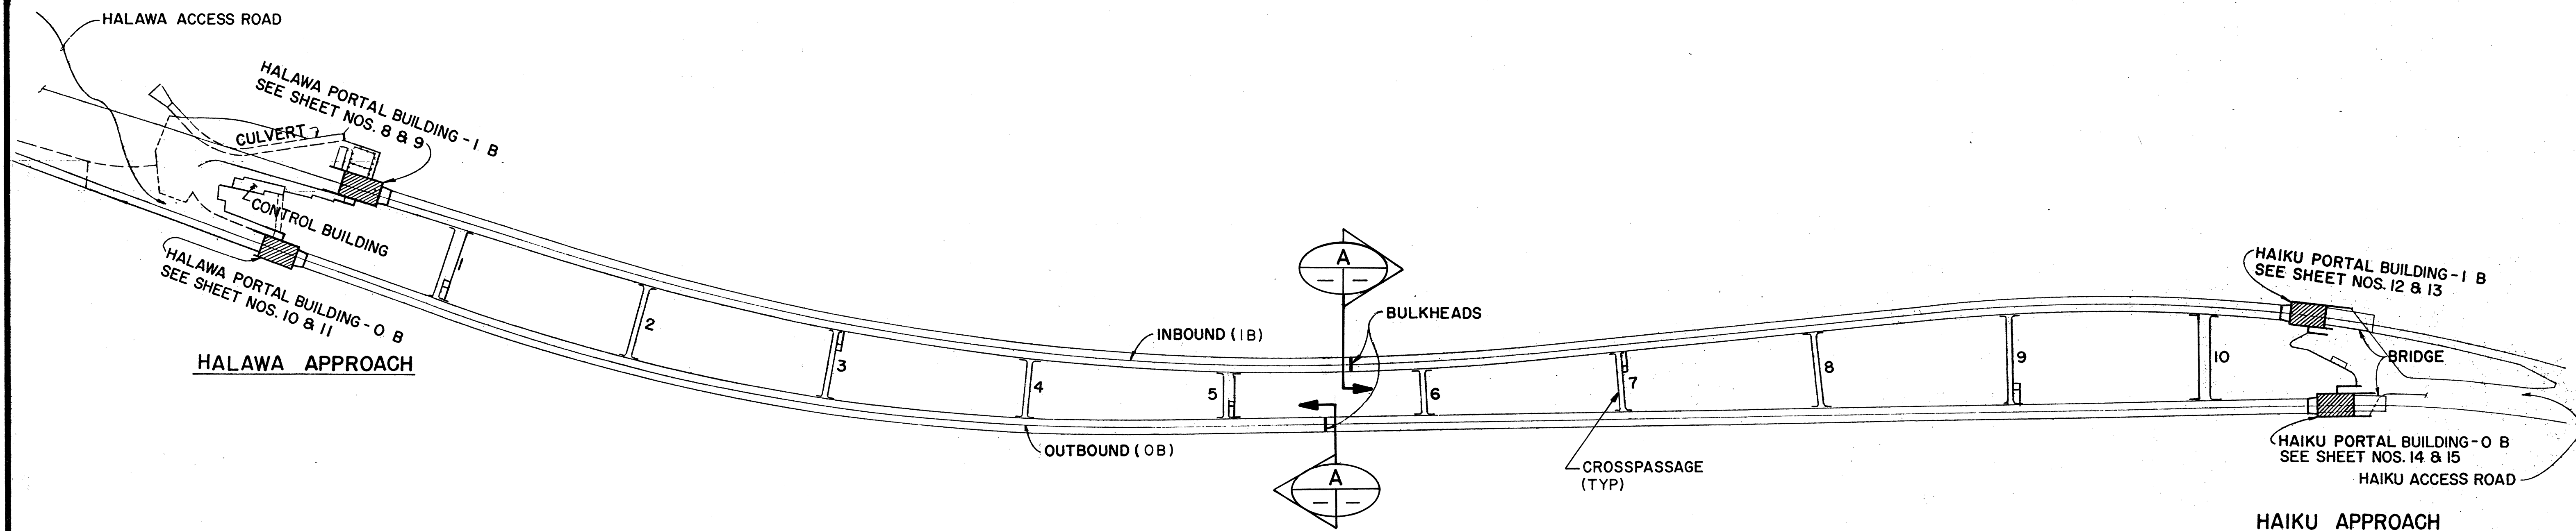


TUNNELS


KEY PLAN

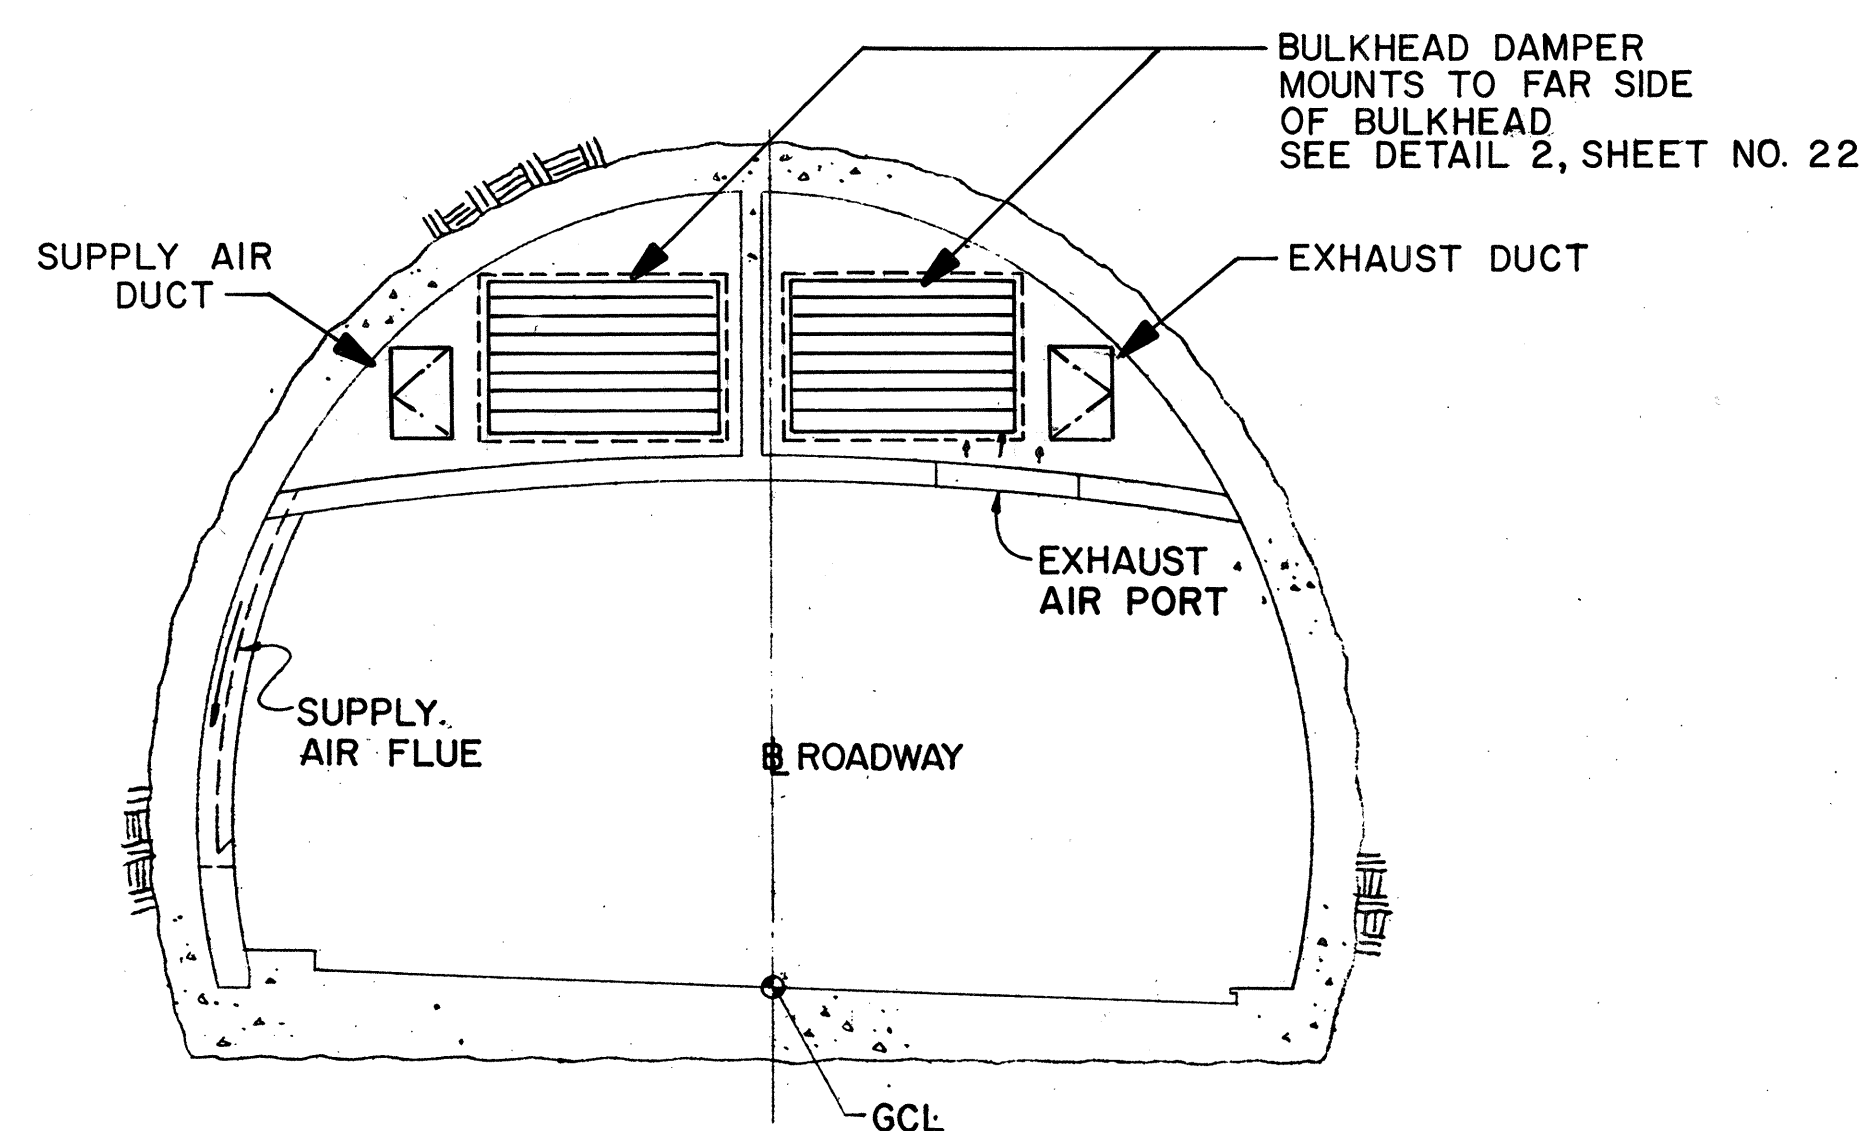

SECTION

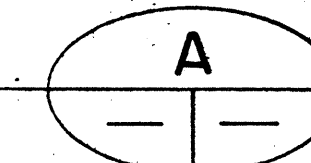

FOR DETAIL AS-BUILT INFORMATION
REFER TO CONSTRUCTION SUBMITTALS

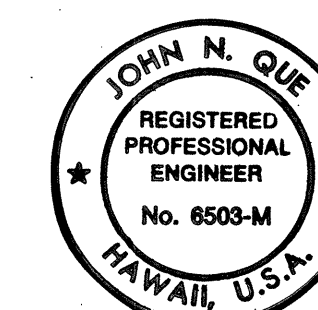

THIS WORK WAS PREPARED BY ME
OR UNDER MY SUPERVISION

STATE OF HAWAII
DEPARTMENT OF TRANSPORTATION
HIGHWAYS DIVISION

KEY PLAN
F & I VENTILATION FANS
INTERSTATE ROUTE H-3
F.A.I. PROJ. NO. I-H3-1(60)

SCALE: NO SCALE
DATE: NOV 1989

SHEET NO. 2 OF 24 SHEETS

ORIGINAL PLAN	DATE
NO. 1	12/10/88
DESIGNED BY	DATE
R. MATRISIAN	12/01/88
CHECKED BY	DATE
J.N. QUE	1/07/89