


FED. ROAD DIST. NO.	STATE	FED. AID PROJ. NO.	FISCAL YEAR	SHEET NO.	TOTAL SHEETS
HAWAII	HAW.	I-H3-1(3)	1967	2	3

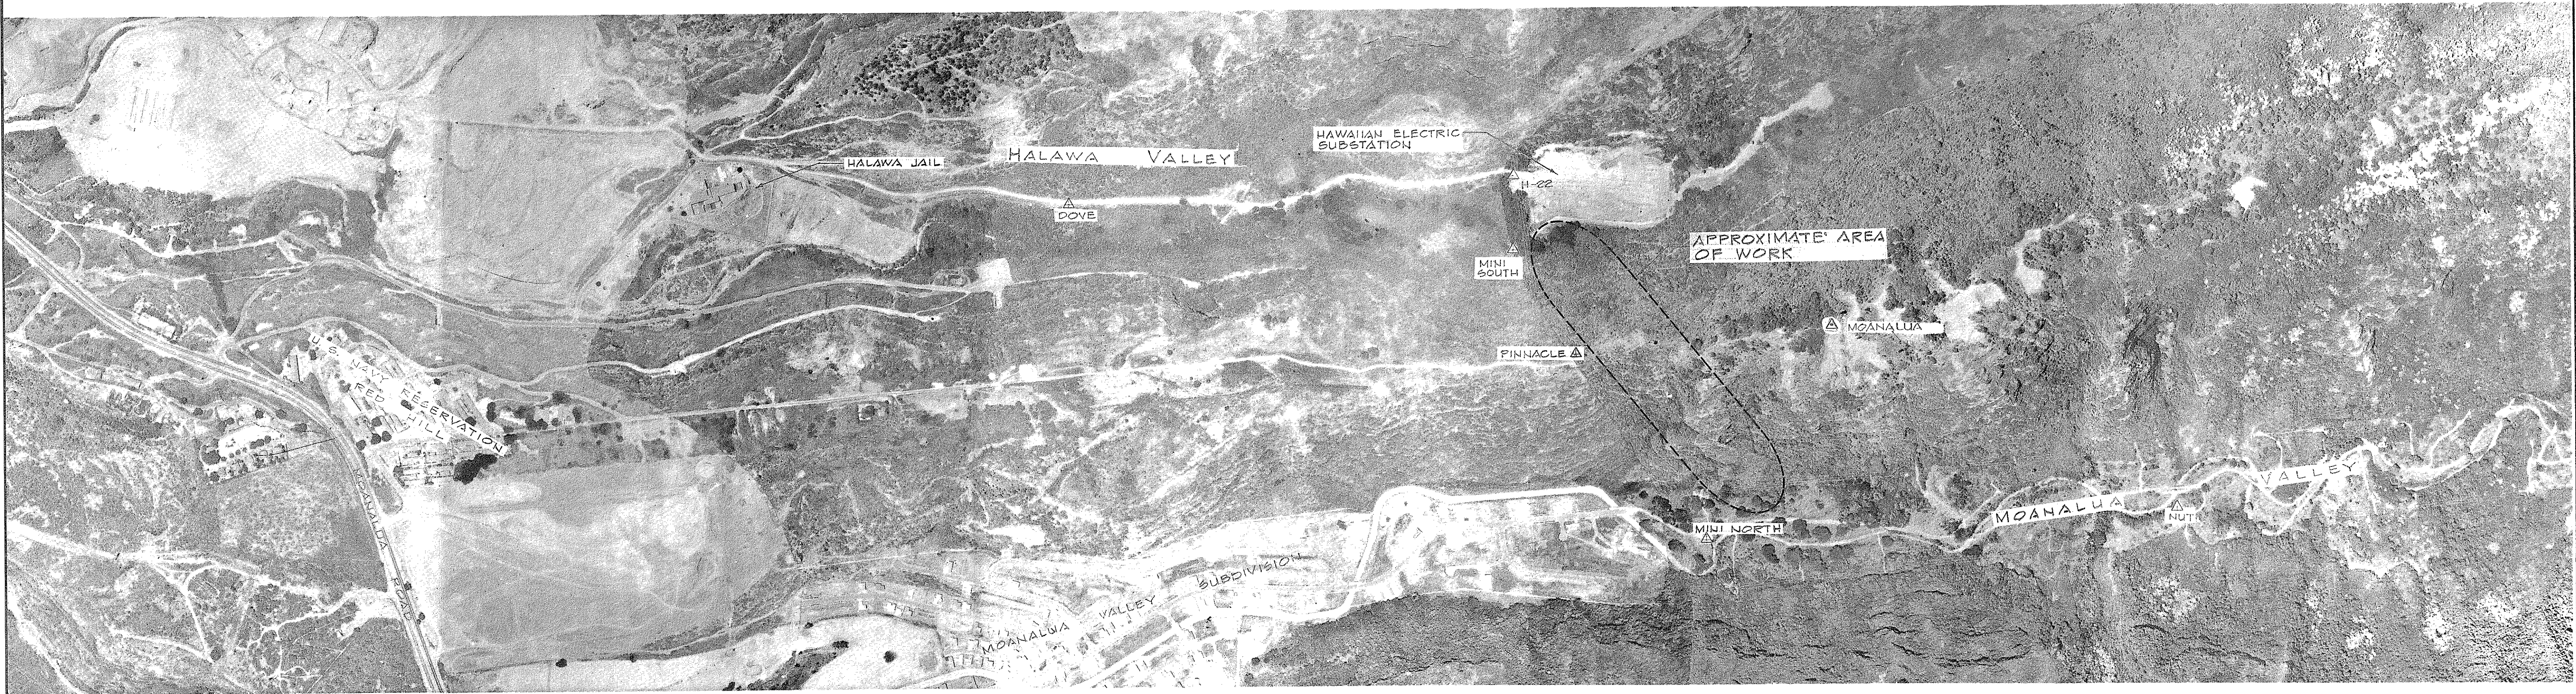

△ Primary Control Monument

STATE OF HAWAII DEPARTMENT OF TRANSPORTATION HIGHWAYS DIVISION				
INTERSTATE ROUTE H-3				
GENERAL LOCATION PLAN PROJECT NO. I-H3-1(3)				
PARSONS BRINCKERHOFF - HIROTA ASSOCIATES HONOLULU, HAWAII				
DATE 9/2/67 REVISED	SCALE 1" = 500'	SHEET NO. 2 OF 3 SHEETS	DWG. NO. 2	REV.