, .	INDEX TO PLANS
SHEET NO.	DESCRIPTION
1 - 18	GENERAL
19 - 110	CIVIL (1) (2) (3)
111 — 164	GEOTECHNICAL 456
165 -231	ARCHITECTURAL
232 - 386	STRUCTURAL 7890
387 -420	MECHANICAL
421 -491	ELECTRICAL (1) (2)
492 - 531	SYSTEMS 3 4
· +	-REFERENCE PLANS
. 1	,
•	

Plan Sht. Nos. 1005-1, 1005-2, 1005-3, 1465-1, 5 1465-2, 1465-3, 2835-1, 3025-2, 3025-2, 1465-1, 4325-1, 4325-2, 5315-1 & 5315-2 are Supplementary Sheets to this Project, added during Addendum, Change Order & "AS BUILT" postings.

TOTAL SHEET COUNT after Addendum, Change Order & "AS BUILT" postings is <u>545</u> sheets.

T (HOURLY).....2.10%

T (DAILY) 4.10% V 60 MPH STATE OF HAWAII

DEPARTMENT OF TRANSPORTATION

HIGHWAYS DIVISION

HONOLULU, HAWAII

"AS - BUILT"


PLANS FOR


CONSTRUCTION OF A PORTION OF

INTERSTATE ROUTE H-3

HALAWA APPROACH AND TUNNELS FEDERAL AID INTERSTATE PROJECT NO. I-H3-I (64)

> DISTRICT OF EWA ISLAND OF OAHU

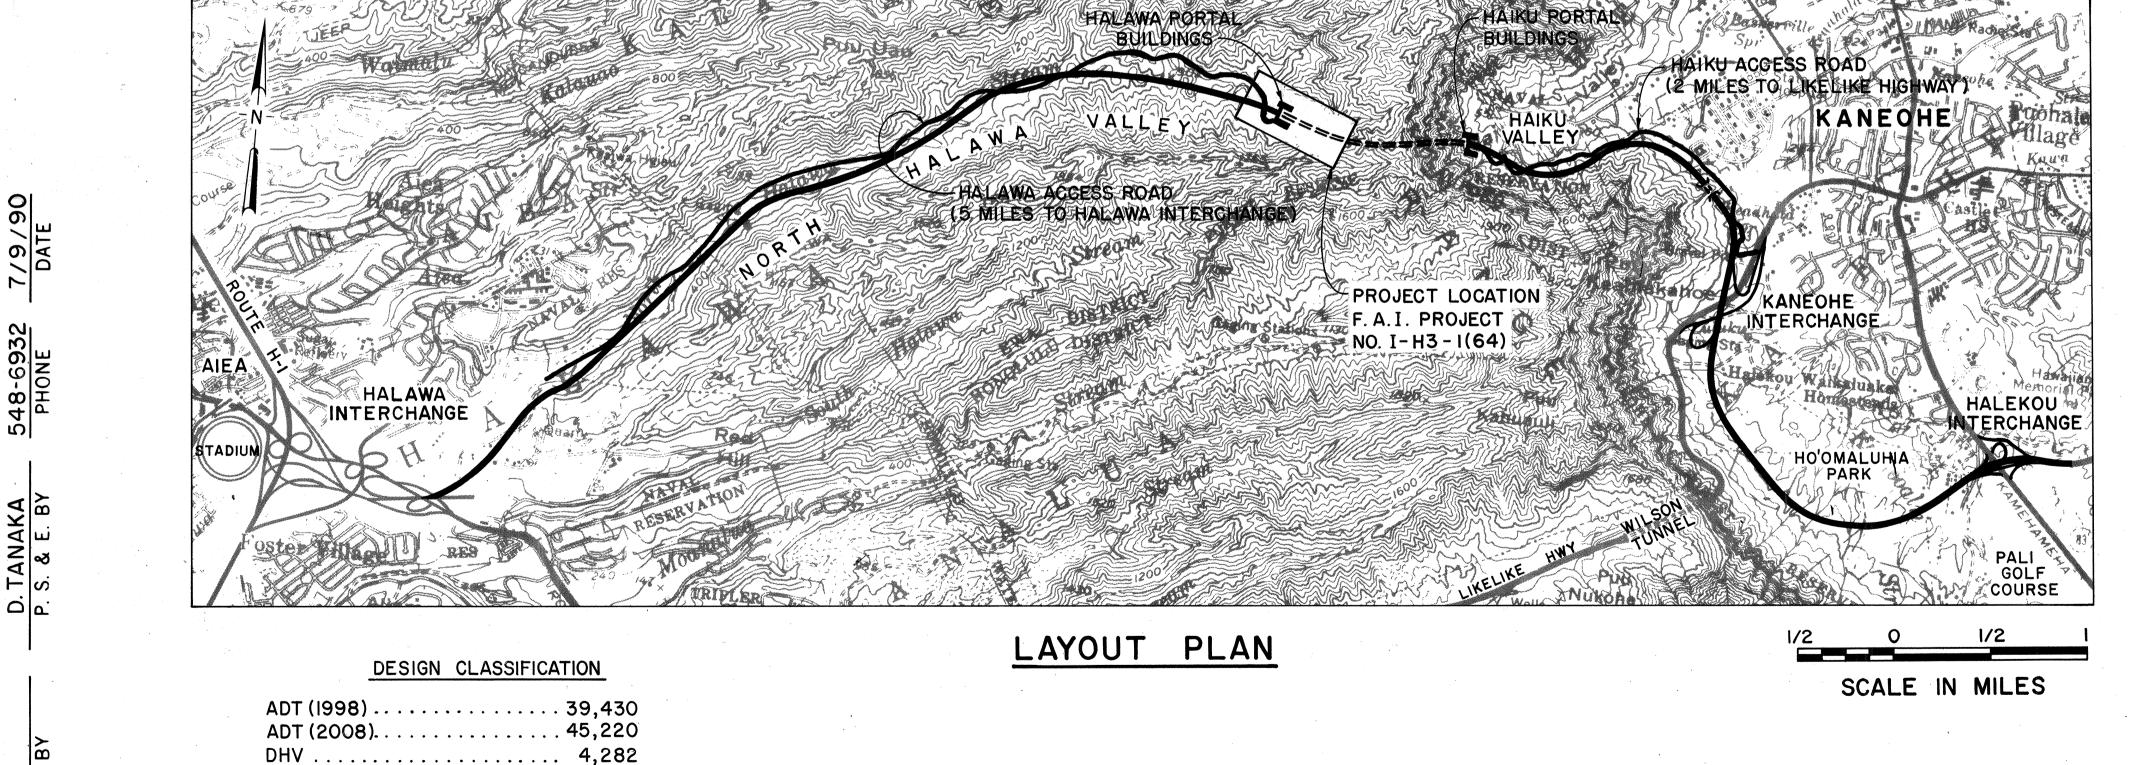

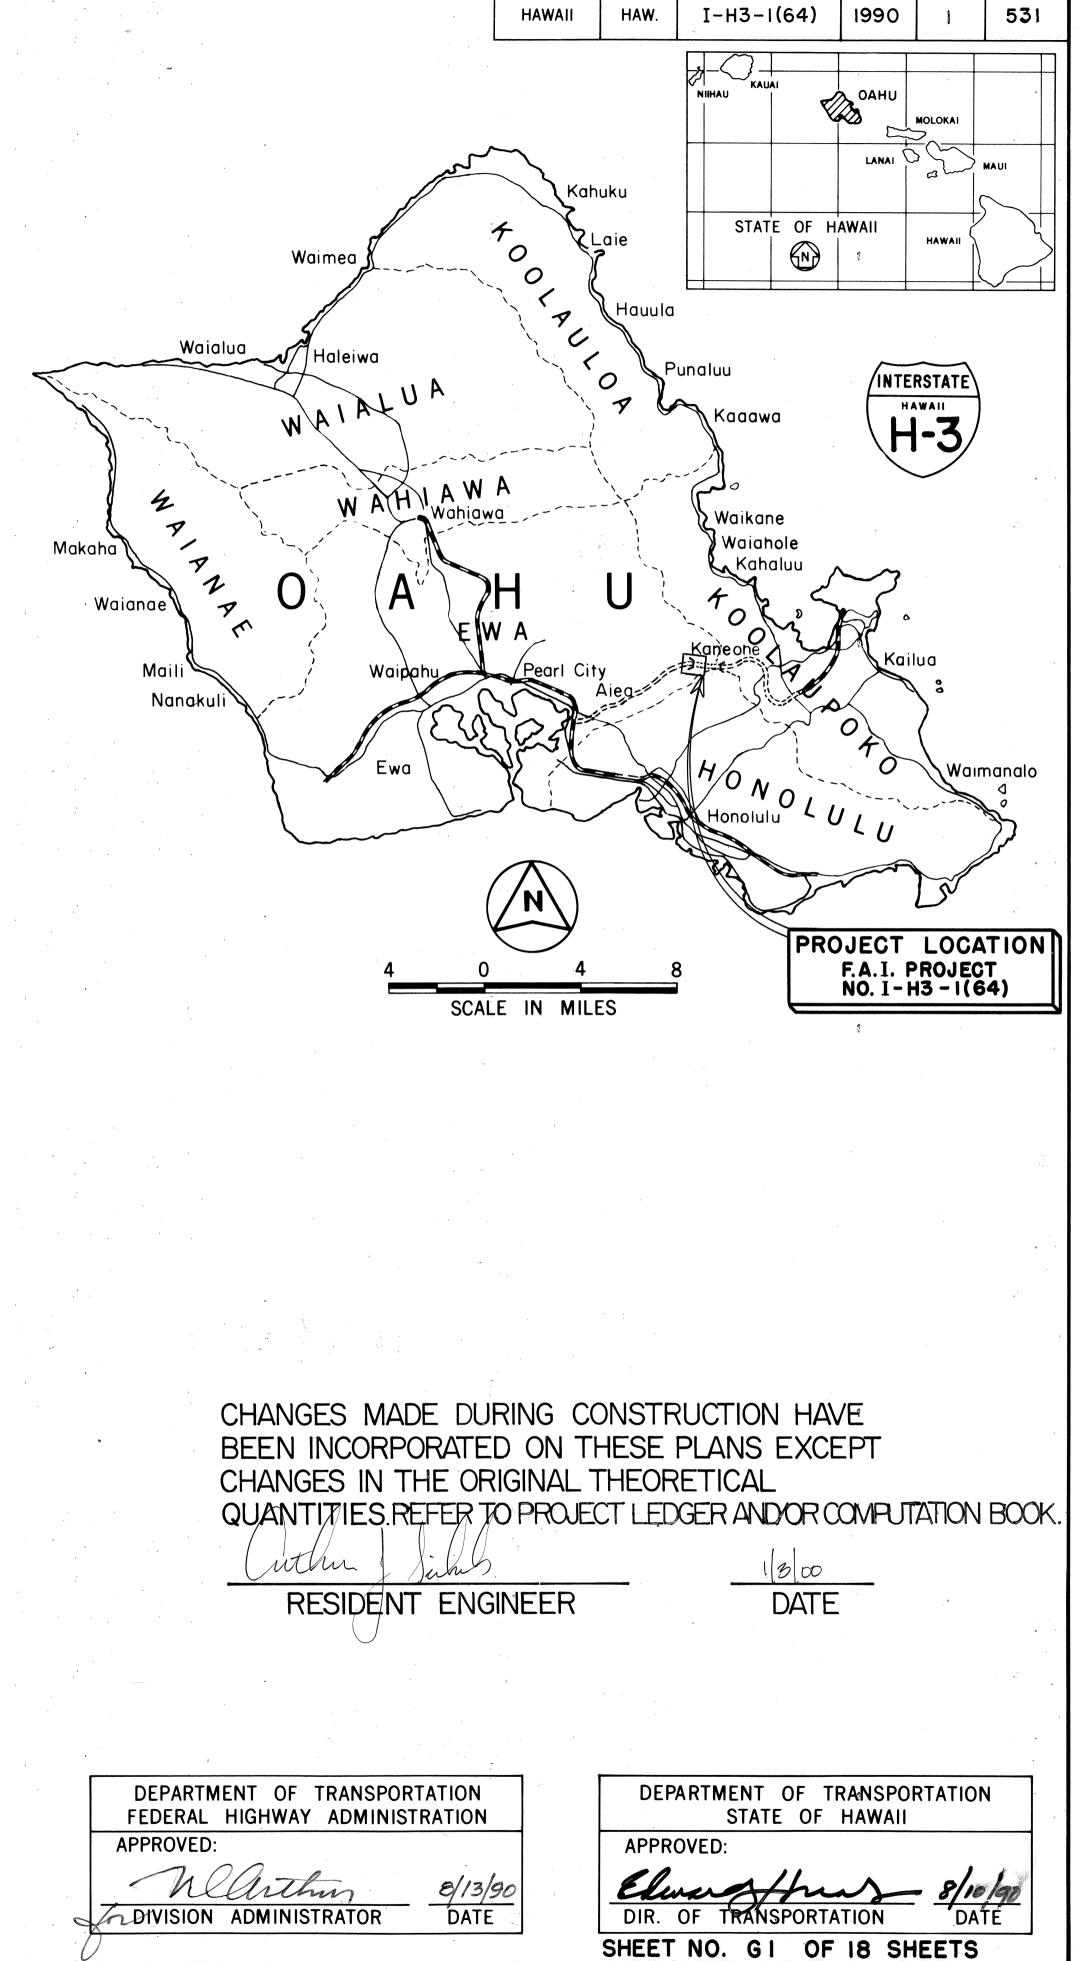

FED. ROAD DIST. NO.

STATE

FISCAL SHEET YEAR NO.

FED. AID PROJ. NO.