

SYMBOLS AND ABBREVIATIONS	
ABUT.	ABUTMENT
Ⓐ	AT
Ⓐ	AND
Ⓔ	BASELINE
BAL.	BALANCE
BET.	BETWEEN
BOT.	BOTTOM
BRG.	BEARING
Ⓒ	CENTERLINE
CONC.	CONCRETE
CONN.	CONNECTION
CONST.	CONSTRUCTION
CONT.	CONTINUOUS
C.F., CU.FT.	CUBIC FOOT
C.Y., CU.YD.	CUBIC YARD
DIA.	DIAMETER
DIAG.	DIAGONAL
DET.	DETAIL
EA.	EACH
E.F.	EACH FACE
E.W.	EACH WAY
EL., ELEV.	ELEVATION
EQ.	EQUAL
EXIST.	EXISTING
EXP.	EXPANSION
FIN.	FINISH
FTG.	FOOTING
F.A.	FORCE ACCOUNT
FT.	FOOT
GRD.	GROUND
G.R.P.	GROUTED RUBBLE PAVING
H.V.B.	HAIKU VALLEY BRIDGE
HORIZ.	HORIZONTAL
I.B.	INBOUND
IN.	INCH
JT.	JOINT
LIN. FT.	LINEAR FEET
L.S.	LUMP SUM
LB.	POUND
LG.	LONG
MAX.	MAXIMUM
MISC.	MISCELLANEOUS
N.I.C.	NOT IN CONTRACT
NO., #	NUMBER
O.B.	OUTBOUND
O.C.	ON CENTER
Ⓔ	PLATE
PCF	POUNDS PER CUBIC FEET
PSI	POUNDS PER SQUARE INCH
PT.	POINT
R=	RADIUS
REINF.	REINFORCEMENT
REQ'D.	REQUIRED
SECT.	SECTION
SIM.	SIMILAR
SP.	SPACE
STA.	STATION
STIRR.	STIRRUP
SQ.	SQUARE
SYMM.	SYMMETRICAL
TYP.	TYPICAL
T.K.T.	TRANS KOOLAU TUNNEL
VERT.	VERTICAL
W/ WWF	WITH WELDED WIRE FABRIC

-
- Diagram illustrating the loading conditions for the beam. Two point loads are applied: 54 KIPS on the left and 40 KIPS on the right. The distance between the loads is 11'-6".

8. GENERAL:
- A. THE CONTRACTOR SHALL VERIFY THE LOCATION OF EXISTING UTILITY LINES AND NOTIFY THE RESPECTIVE OWNERS BEFORE COMMENCING THE WORK OF EXCAVATING OR THE DRIVING OF PILES.

SHEET NO.	DESCRIPTION	SHEET NO.	DESCRIPTION
S-1	STRUCTURAL GENERAL NOTES	S-16	PIER 6 INBOUND - DETAILS
S-2	GENERAL PLAN	S-17	PIER SECTIONS
S-3	ELEVATION - INBOUND & OUTBOUND	S-18	DECK REINFORCEMENT DETAILS
S-4	FOUNDATION PLAN	S-19	GIRDER SECTIONS
S-5	DECK FRAMING & REINFORCEMENT PLANS	S-20	GIRDER BEARING DETAILS
S-6	FINISHED DECK ELEVATIONS	S-21	DECK EXPANSION JOINT DETAILS
S-7	INBOUND ABUTMENT	S-22	DECK DRAIN AND MISC. DETAILS
S-8	OUTBOUND ABUTMENT	S-23	FARADAY SHIELD CONNECTION DETAILS
S-9	ABUTMENT DETAILS	S-24	SIGN SUPPORT DETAILS
S-10	ABUTMENT DETAILS	S-25	PRESTRESSED CONCRETE PILE DETAILS
S-11	FOUNDATION DETAILS & SCHEDULE	S-26	MISCELLANEOUS DETAILS
S-12	PIER SCHEDULE		
S-13	PIER DETAILS	B-1 THRU B-6	BORING LOGS
S-14	TYPICAL PIER DETAILS		
S-15	PIER 1 INBOUND - SECTIONS		

ITEM NO.	ITEM DESCRIPTION	UNIT	INBOUND QUANTITY	OUTBOUND QUANTITY
206.6000	STRUCTURE EXCAVATION FOR BRIDGES	CU. YD.	4,210	1,600
206.7300	STRUCTURE BACKFILL FOR BRIDGES	CU. YD.	2,810	610
206.8500	FILTER MATERIAL FOR STRUCTURES	CU. YD.	27	40
503.1092	CONCRETE IN HAIKU VALLEY BRIDGES (EXCEPT FTGS.)	L. S.	(2,870 C.Y.)	(580 C.Y.)
503.1093	CONCRETE IN FOOTINGS FOR HAIKU VALLEY BRIDGES	L. S.	(1,110 L.F.)	(185 C.Y.)
504.6500	KEEHI TYPE IV PRESTRESSED CONCRETE GIRDERS	L. S.	(4,140 C.Y.)	(786 L.F.)
504.6510	STRAND SLIPPAGE MEASUREMENT ON GIRDERS	EACH	42	8
505.0001	PILE DRIVING EQUIPMENT EXPENSE (NOT TO EXCEED \$8,000)	L. S.	--	--
505.0010	PILE LOAD TESTS	EACH	3	1
505.0430	PRESTRESSED CONCRETE PILES, FURNISHED	LIN. FT.	10,657	279
505.4300	PRESTRESSED CONCRETE PILES, DRIVEN	LIN. FT.	9,986	212
505.6000	PREDRILLED HOLES FOR PRESTRESSED CONCRETE PILES	LIN. FT.	1,000	200
505.9000	EXTENSIONS OR "BUILD-UPS" OF PILES	F. A.	--	--
507.5100	BRIDGE CONCRETE RAILING	LIN. FT.	1,029	205
602.0090	REINFORCING STEEL IN HAIKU VALLEY BRIDGES	L. S.	(1,101,000)	(186,000 LBS.)
612.0200	GROUTED RUBBLE SLOPE PROTECTION	CU. YD.	225	112

FED. ROAD DIST. NO.	STATE	FED. AID PROJ. NO.	FISCAL YEAR	SHEET NO.	TOTAL SHEETS
HAWAII	HAW.	I-H3-1 (52)	1988	35	75

- 
- A circular professional engineer seal. The outer ring contains the text "MYRON G. OKUBO" at the top and "HAWAII, U.S.A." at the bottom, separated by two five-pointed stars. The inner circle contains the text "REGISTERED PROFESSIONAL ENGINEER" and "No. 4320-S" below it.

THIS WORK WAS PREPARED BY
ME OR UNDER MY SUPERVISION

Myron Okubo

STATE OF HAWAII
DEPARTMENT OF TRANSPORTATION
HIGHWAYS DIVISION

INTERSTATE ROUTE H-3
F.A.I. PROJECT NO. I-H3-1 (52):

SCALE: NONE DATE: JULY 1988

SHEET No. S-1 OF S-26 SHEETS

AS BUILT

C.O. ADD. 35 R

ORIGINAL PLAN	SURVEY PLOTTED BY _____	DATE _____
NOTEBOOK	DRAWN BY _____	"
	TRACED BY _____	"
	DESIGNED BY _____	"
	QUANTITIES BY _____	"
No. _____	CHECKED BY _____	"

FED. ROAD DIST. NO.	STATE	FED. AID PROJ. NO.	FISCAL YEAR	SHEET NO.	TOTAL SHEETS
HAWAII	HAW.	I-H3-1(52)	1988	36	75



1

1 I.B. Curve Data
 $\Delta = 28^\circ 43' 44''$
 $\frac{A}{2} = 14^\circ 21' 52''$
 $R = 4000.00'$
 $T = 1024.38'$
 $Ch = 1984.71'$
 $Lc = 2005.65'$
 P.C. Sta. 246+35.56
 P.T. Sta. 266+41.21

2



2 O.B. Curve Data
 $\Delta = 23^\circ 50' 09''$
 $\frac{A}{2} = 11^\circ 55' 04.5''$
 $R = 3000.00'$
 $T = 633.18'$
 $Ch = 1239.06'$
 $Lc = 1248.04'$
 P.C. Sta. 256+71.82
 P.T. Sta. 269+19.86

NOTES:

1. Stationing is along respective Baselines for Inbound Structure and outbound Structure.
2. Grade Control Lines to be Inbound and Outbound Baselines for the respective structure.
3. Faraday Shield Supports at Bridge shall be aligned parallel to the azimuths of the closest Piers unless noted otherwise. Faraday Shield Supports which are on the MSERW and ground supported shall be aligned radially to the Baseline.

I.B. = Inbound
 O.B. = Outbound
 T.K.T. = Trans-Koolau Tunnel
 H.V.B. = Haiku Valley Bridges

PLAN
 Scale: 1" = 40'

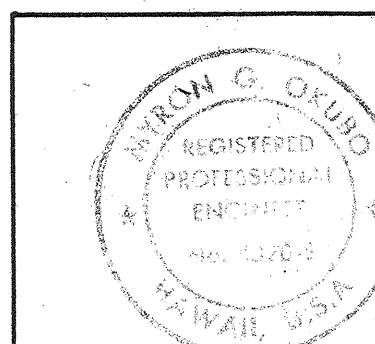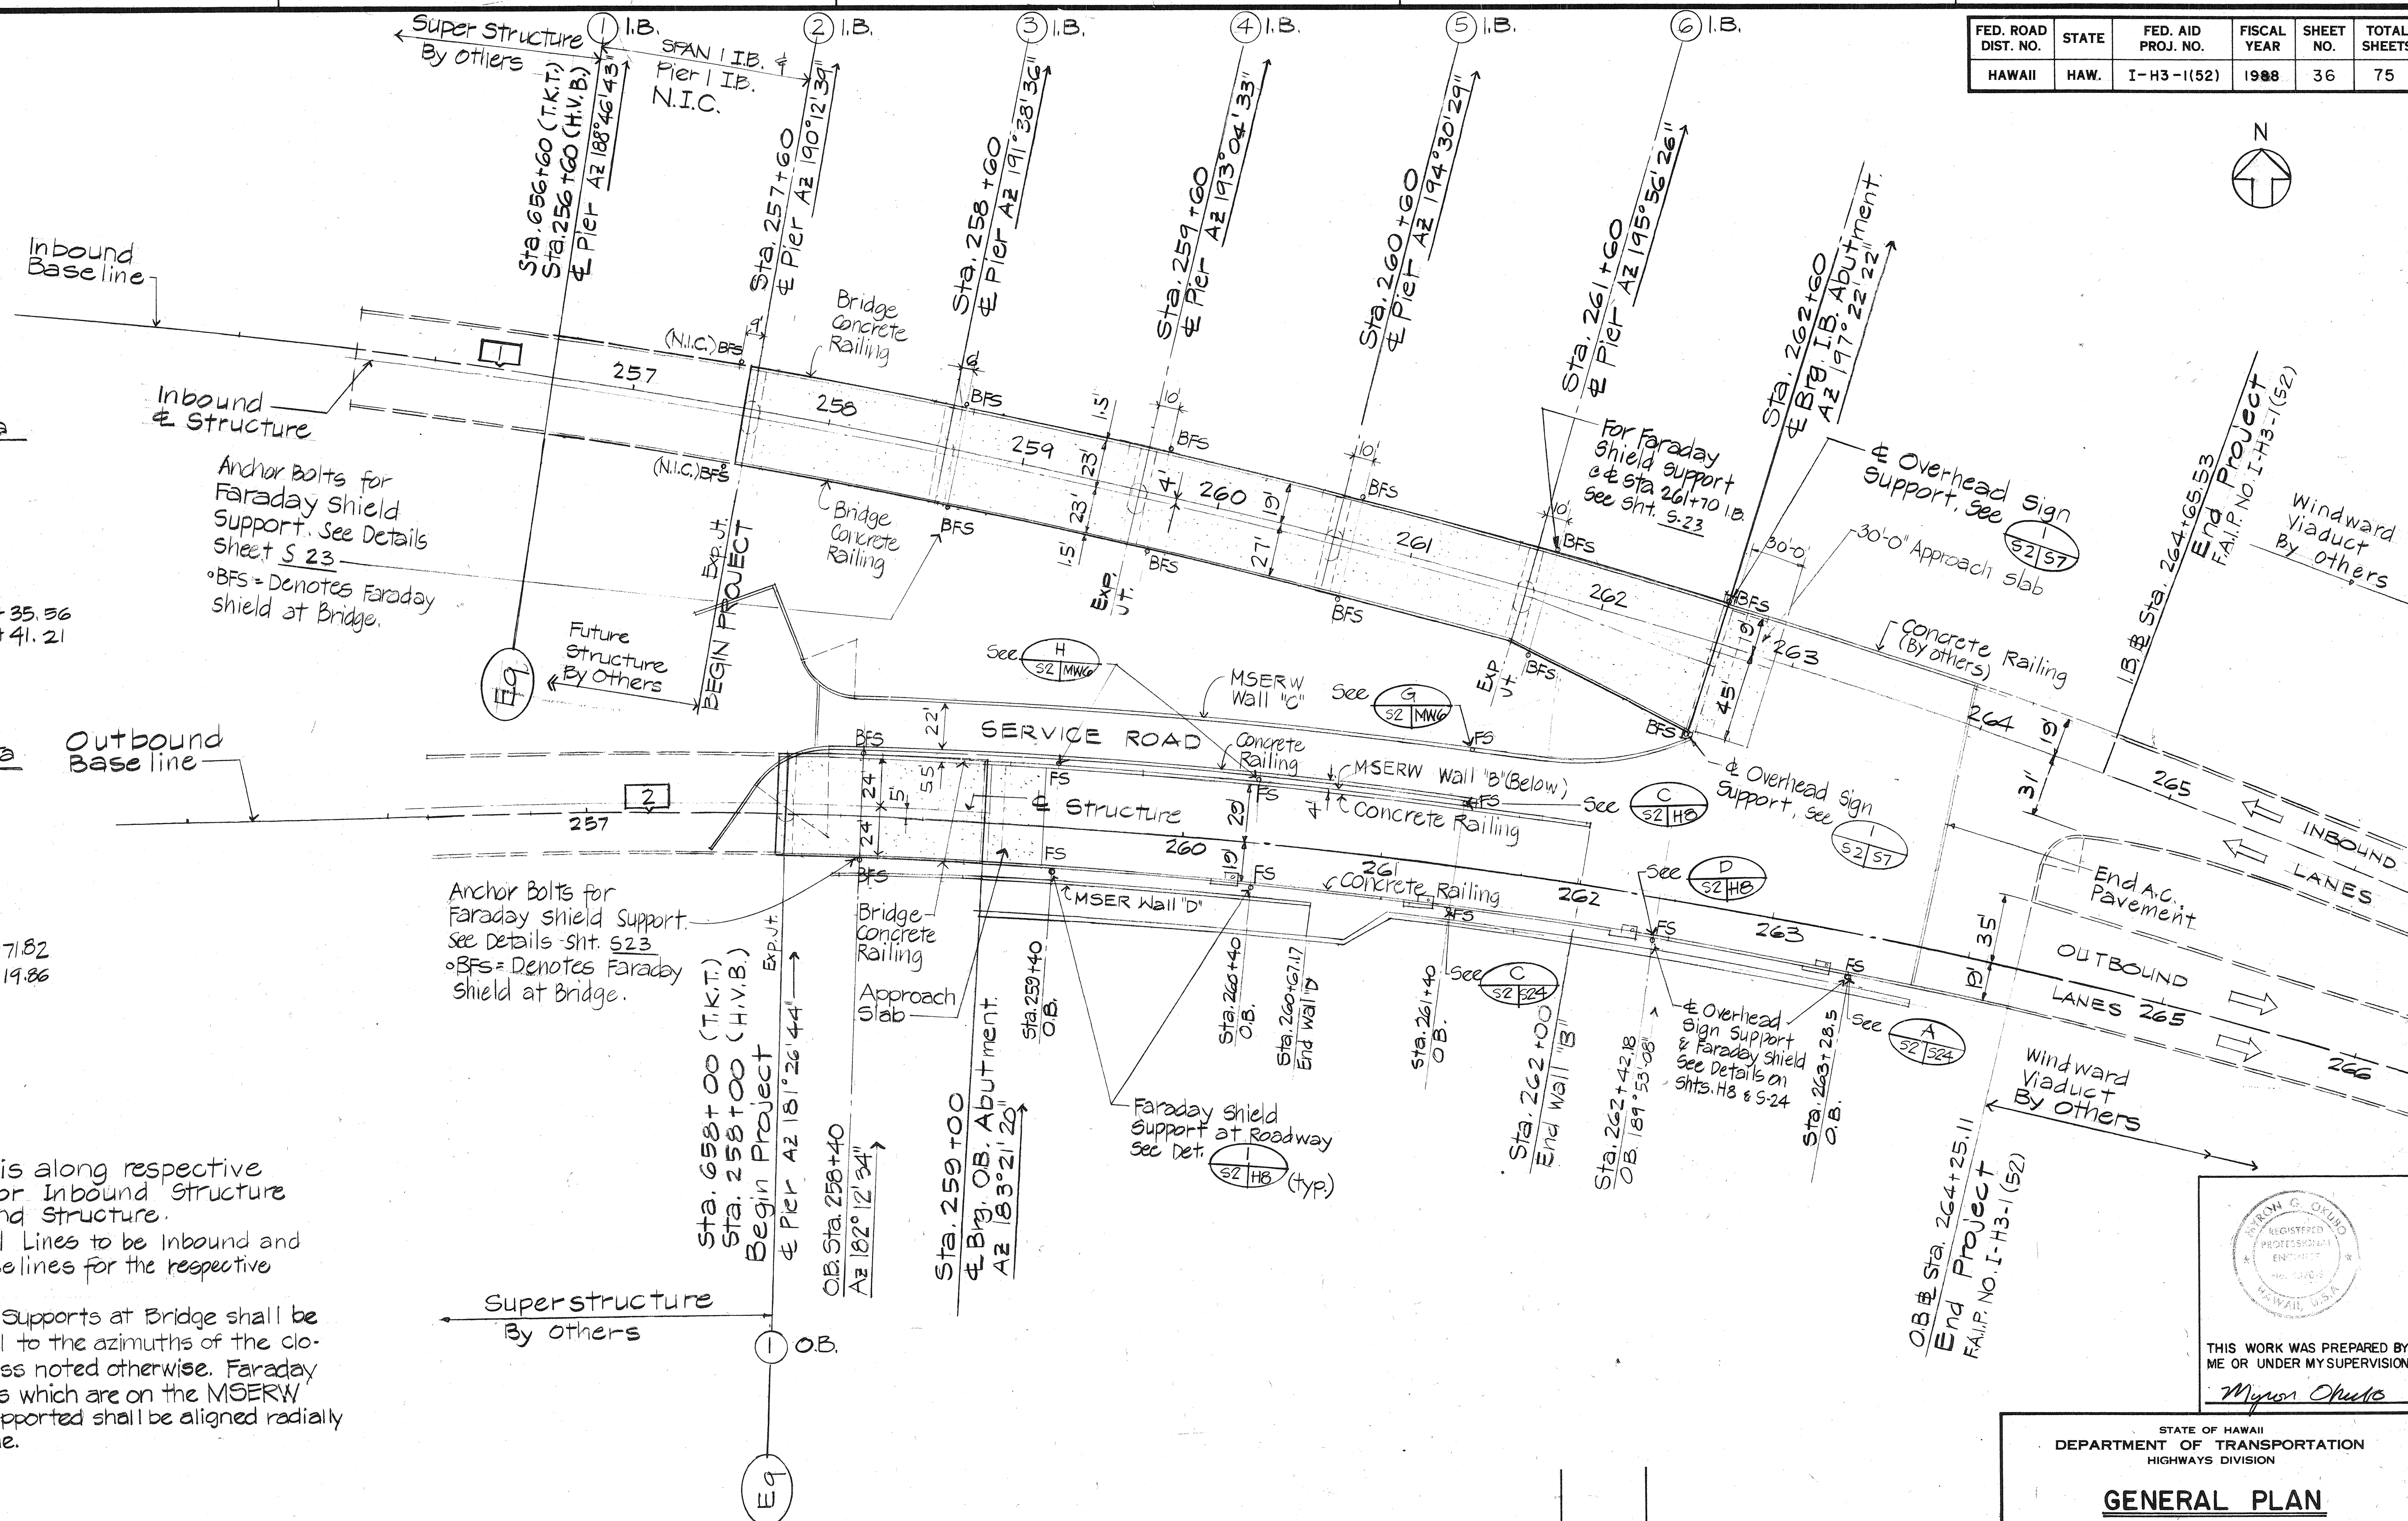

THIS WORK WAS PREPARED BY ME OR UNDER MY SUPERVISION

M. G. O'Neil

STATE OF HAWAII
 DEPARTMENT OF TRANSPORTATION
 HIGHWAYS DIVISION

GENERAL PLAN

INTERSTATE ROUTE H-3
 F.A.I. PROJECT NO. I-H3-1(52)

SCALE: AS NOTED DATE: JULY 1988
 SHEET No. 32 OF 36 SHEETS



1/10/89 Note 3 Added, Faraday Shield Support Foundations Clarified, Project Limits Revised

DATE REVISION

AS BUILT

ADD 36

FED. ROAD DIST. NO.	STATE	FED. AID PROJ. NO.	FISCAL YEAR	SHEET NO.	TOTAL SHEETS
HAWAII	HAW.	I-H3-1 (52)	1988	37	75

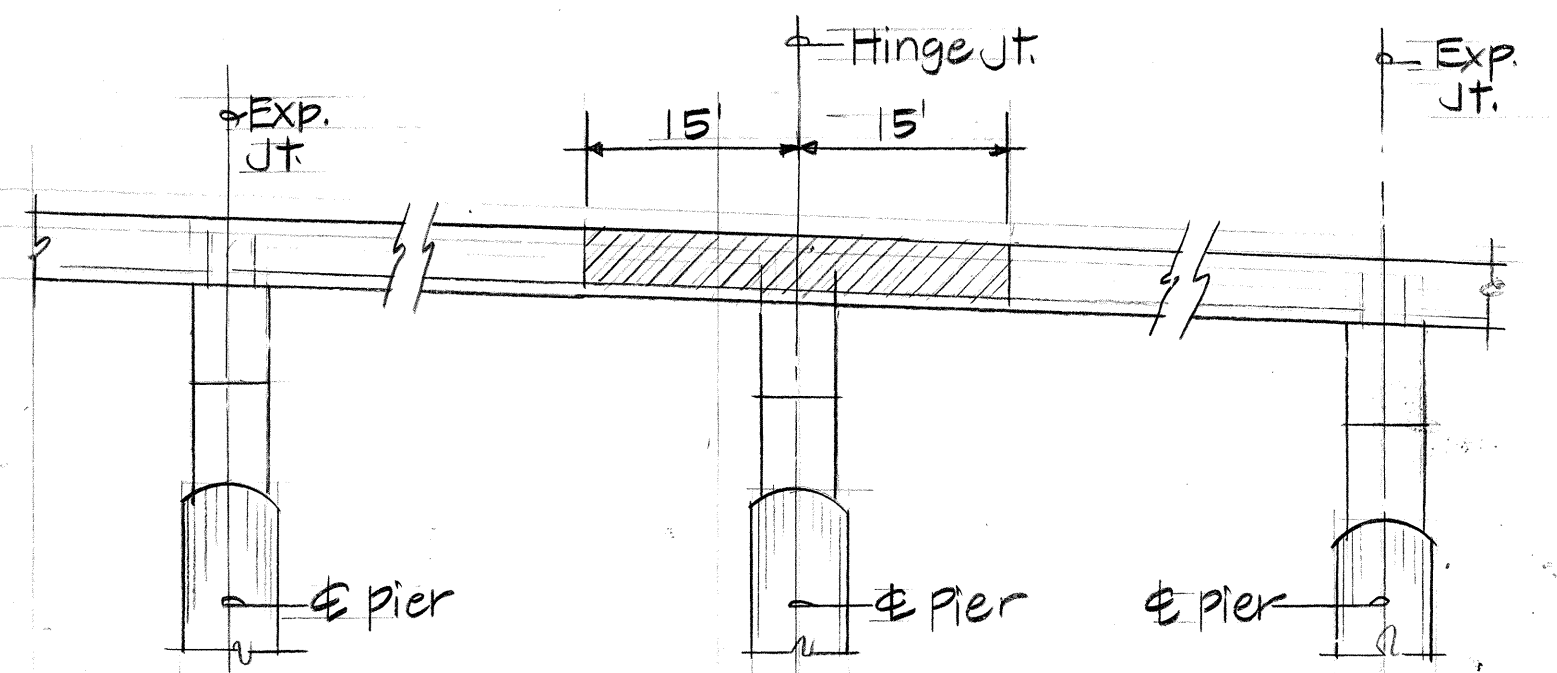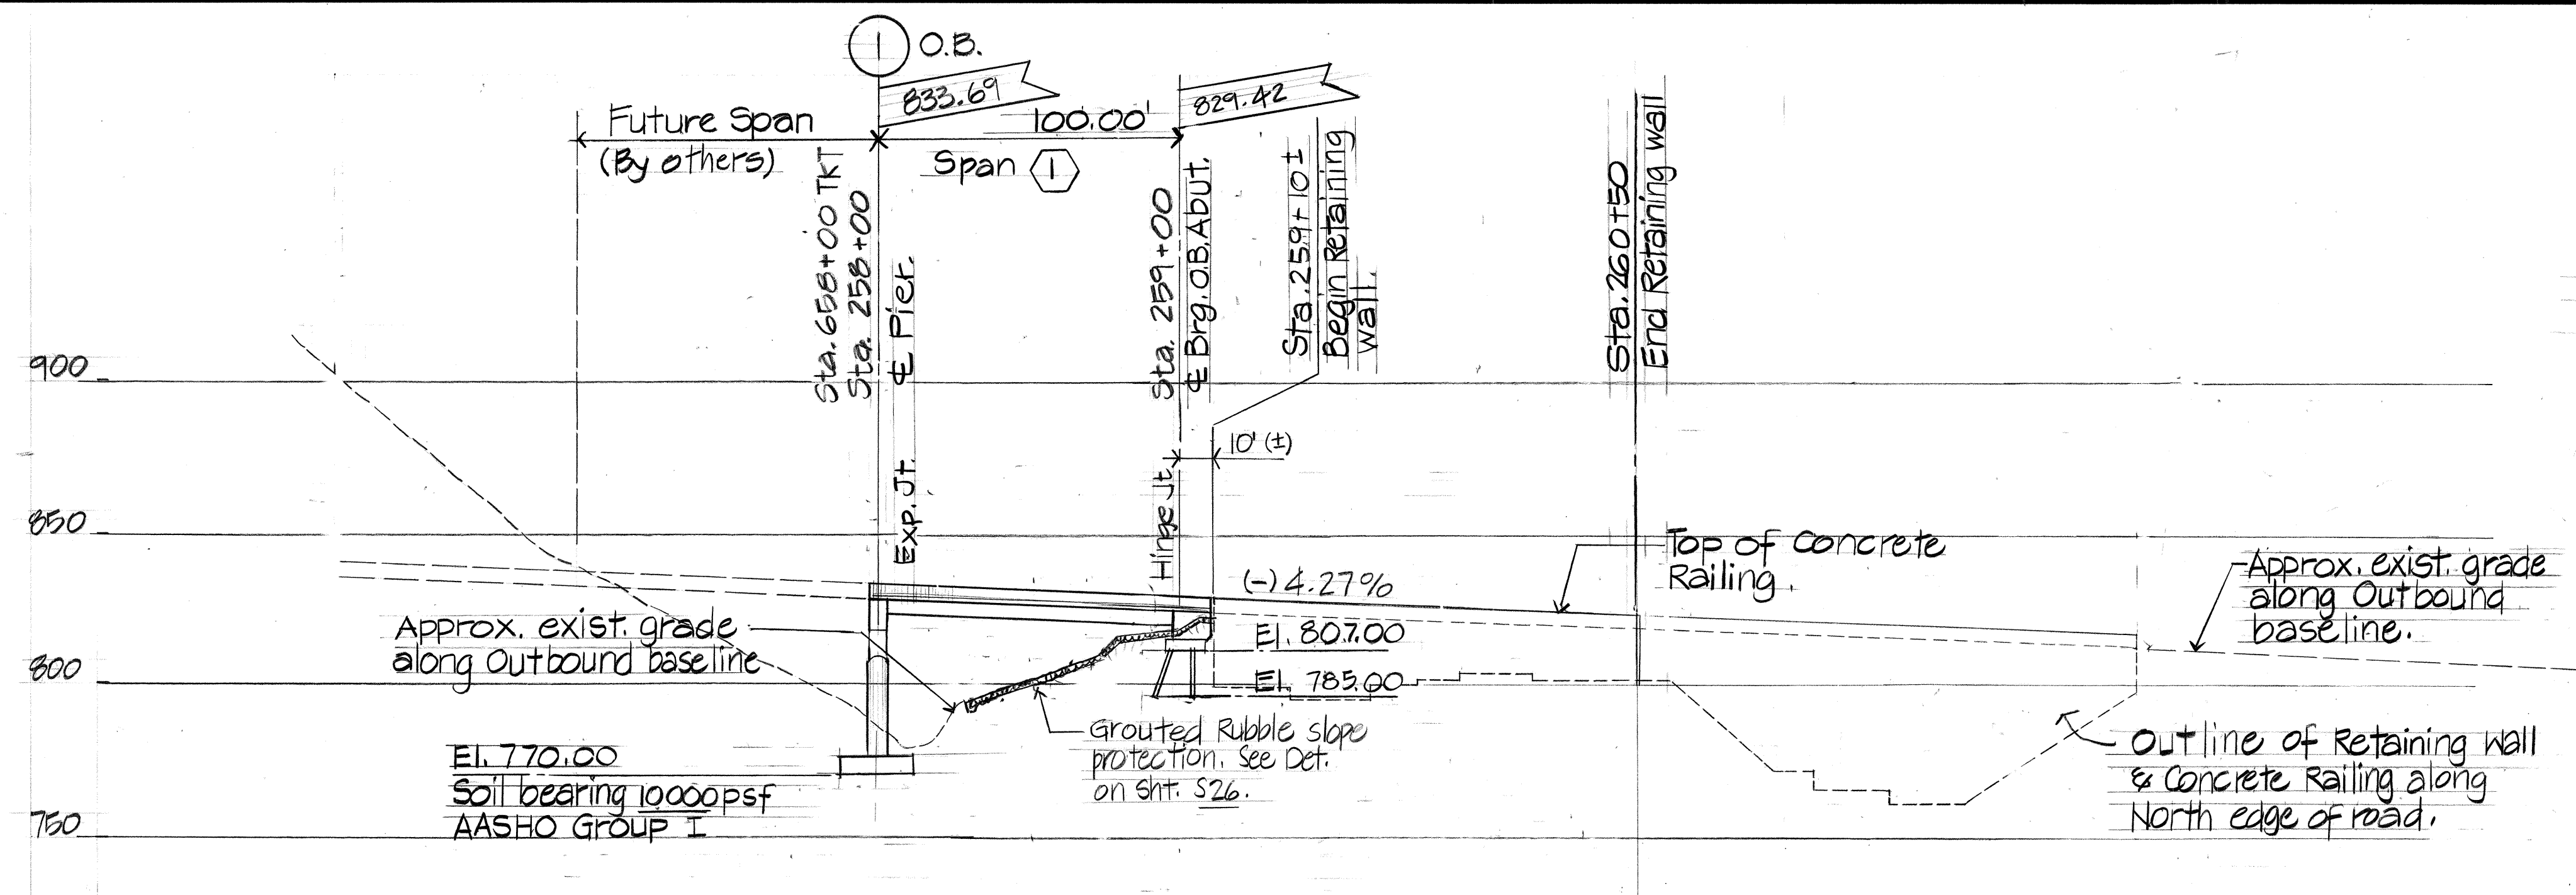


At Hinge Joint Piers where spans are continuous, Hatch portion of Deck Slab and pier Diaphragm shall be poured a minimum of 14 days after the adjacent portions of the Deck slab.

Note:
Dimensions measured along Baseline.

ELEVATION - OUTBOUND

Scale: 1" = 40'

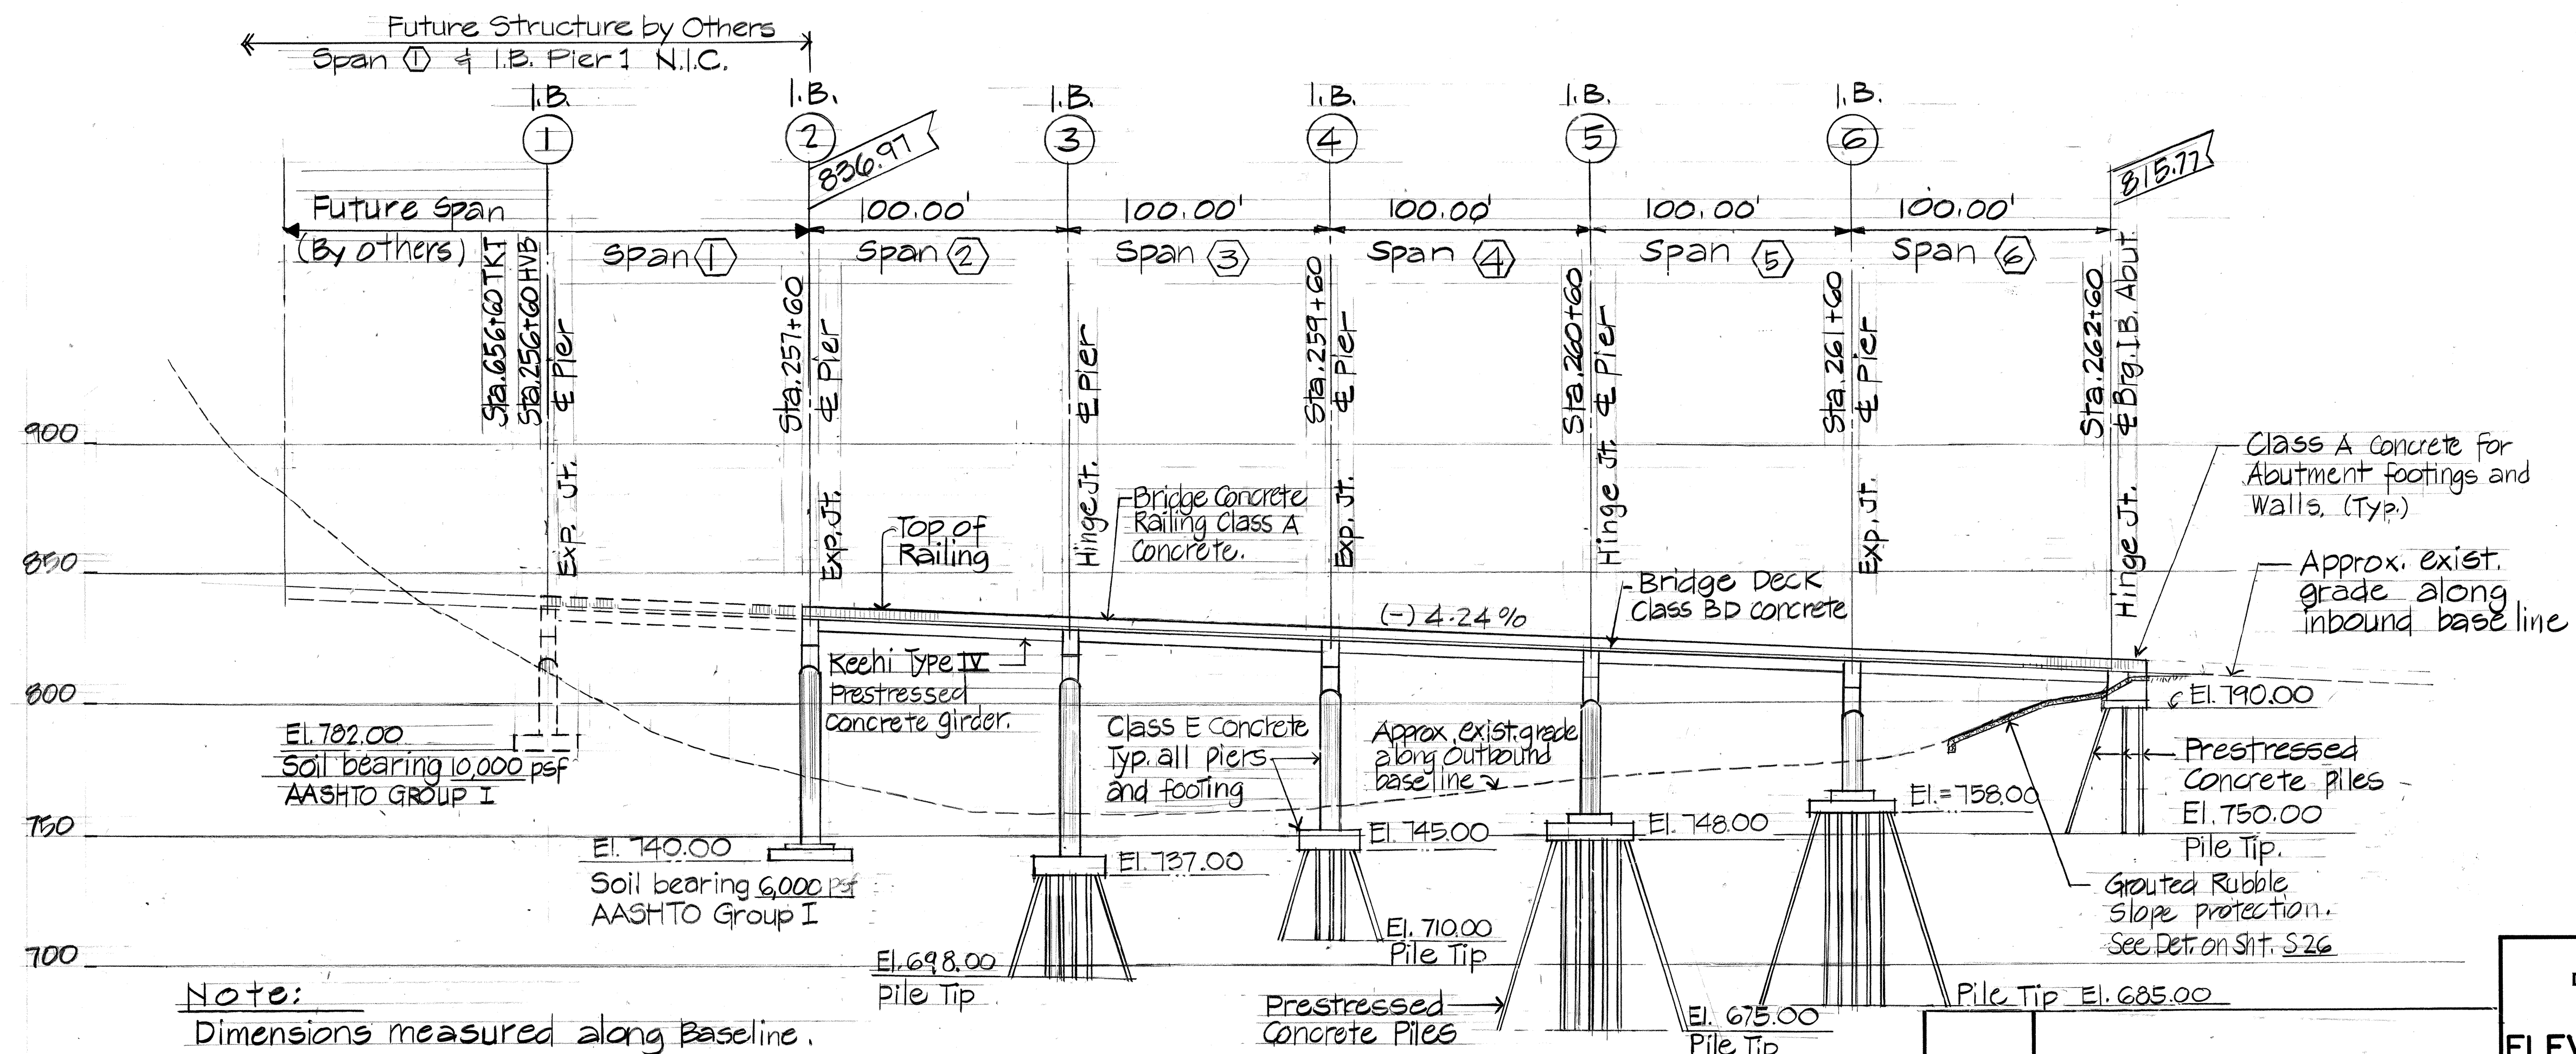

Note:
Dimensions measured along Baseline.

ELEVATION - INBOUND

Scale: 1" = 40'

MYRON G. OKINO
REGISTERED PROFESSIONAL ENGINEER
No. 4320-S
HAWAII, U.S.A.
THIS WORK WAS PREPARED BY ME OR UNDER MY SUPERVISION
Myron Okino

STATE OF HAWAII
DEPARTMENT OF TRANSPORTATION
HIGHWAYS DIVISION
ELEVATION-INBOUND & OUTBOUND

INTERSTATE ROUTE H-3
F.A.I. PROJECT NO. I-H3-1 (52)
SCALE: 1" = 40' DATE: JULY, 1988
SHEET NO. S3 OF S26 SHEETS

9/11/89	Revised Grades & Pilecap Elevation
1/10/89	Project Limits Revised
DATE	REVISION

AS BUILT

C.O. ADD. 37


24.13-49

S3


34

SURVEY PLOTTED BY	DATE
DRAWN BY	
CHECKED BY	
NOTED BY	
NO.	


FED. ROAD DIST. NO.	STATE	FED. AID PROJ. NO.	FISCAL YEAR	SHEET NO.	TOTAL SHEETS
HAWAII	HAW.	I-H3-1(52)	1988	39	75

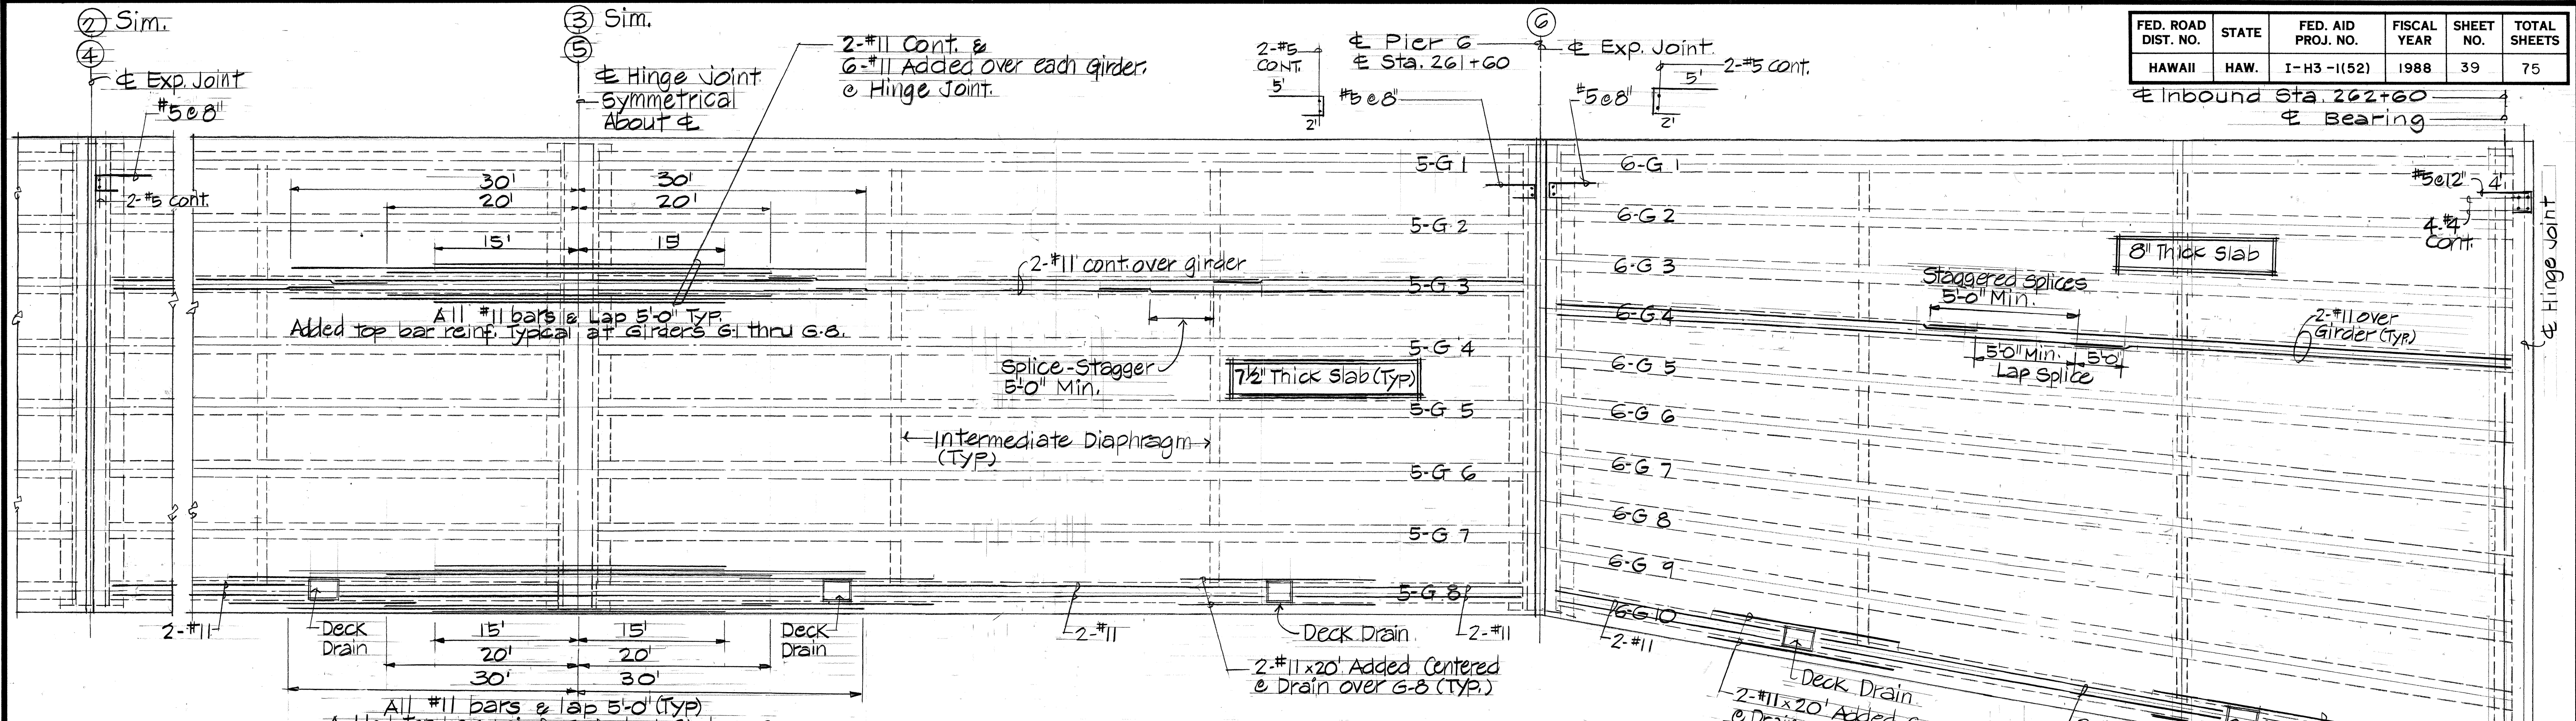

ADDED DECK REINFORCEMENT PLAN
Scale: 1/8" = 1'-0"

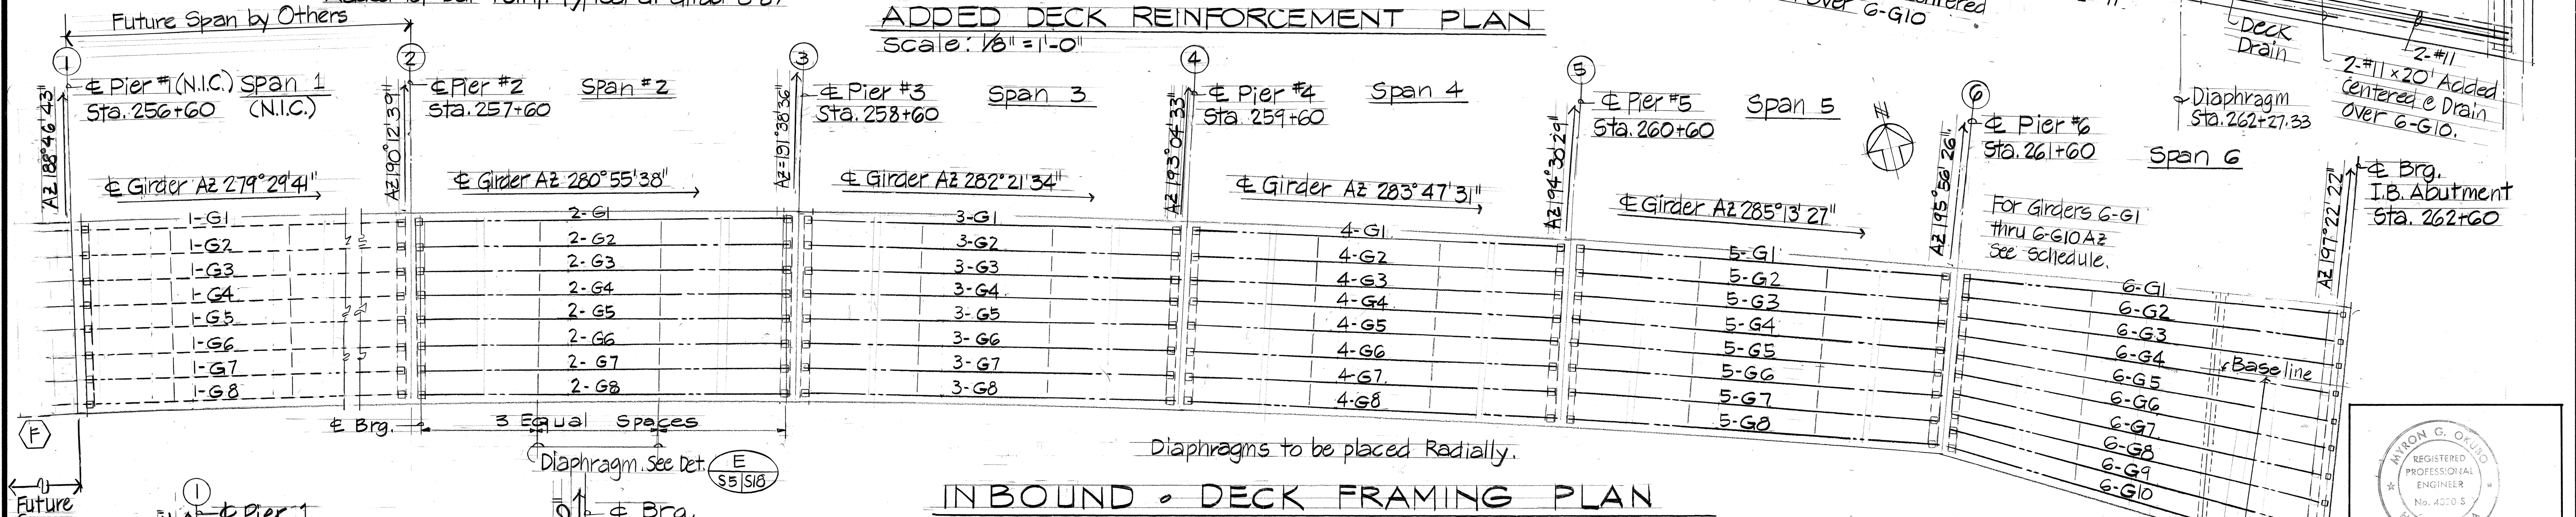

INBOUND - DECK FRAMING PLAN
Scale: 1" = 20'

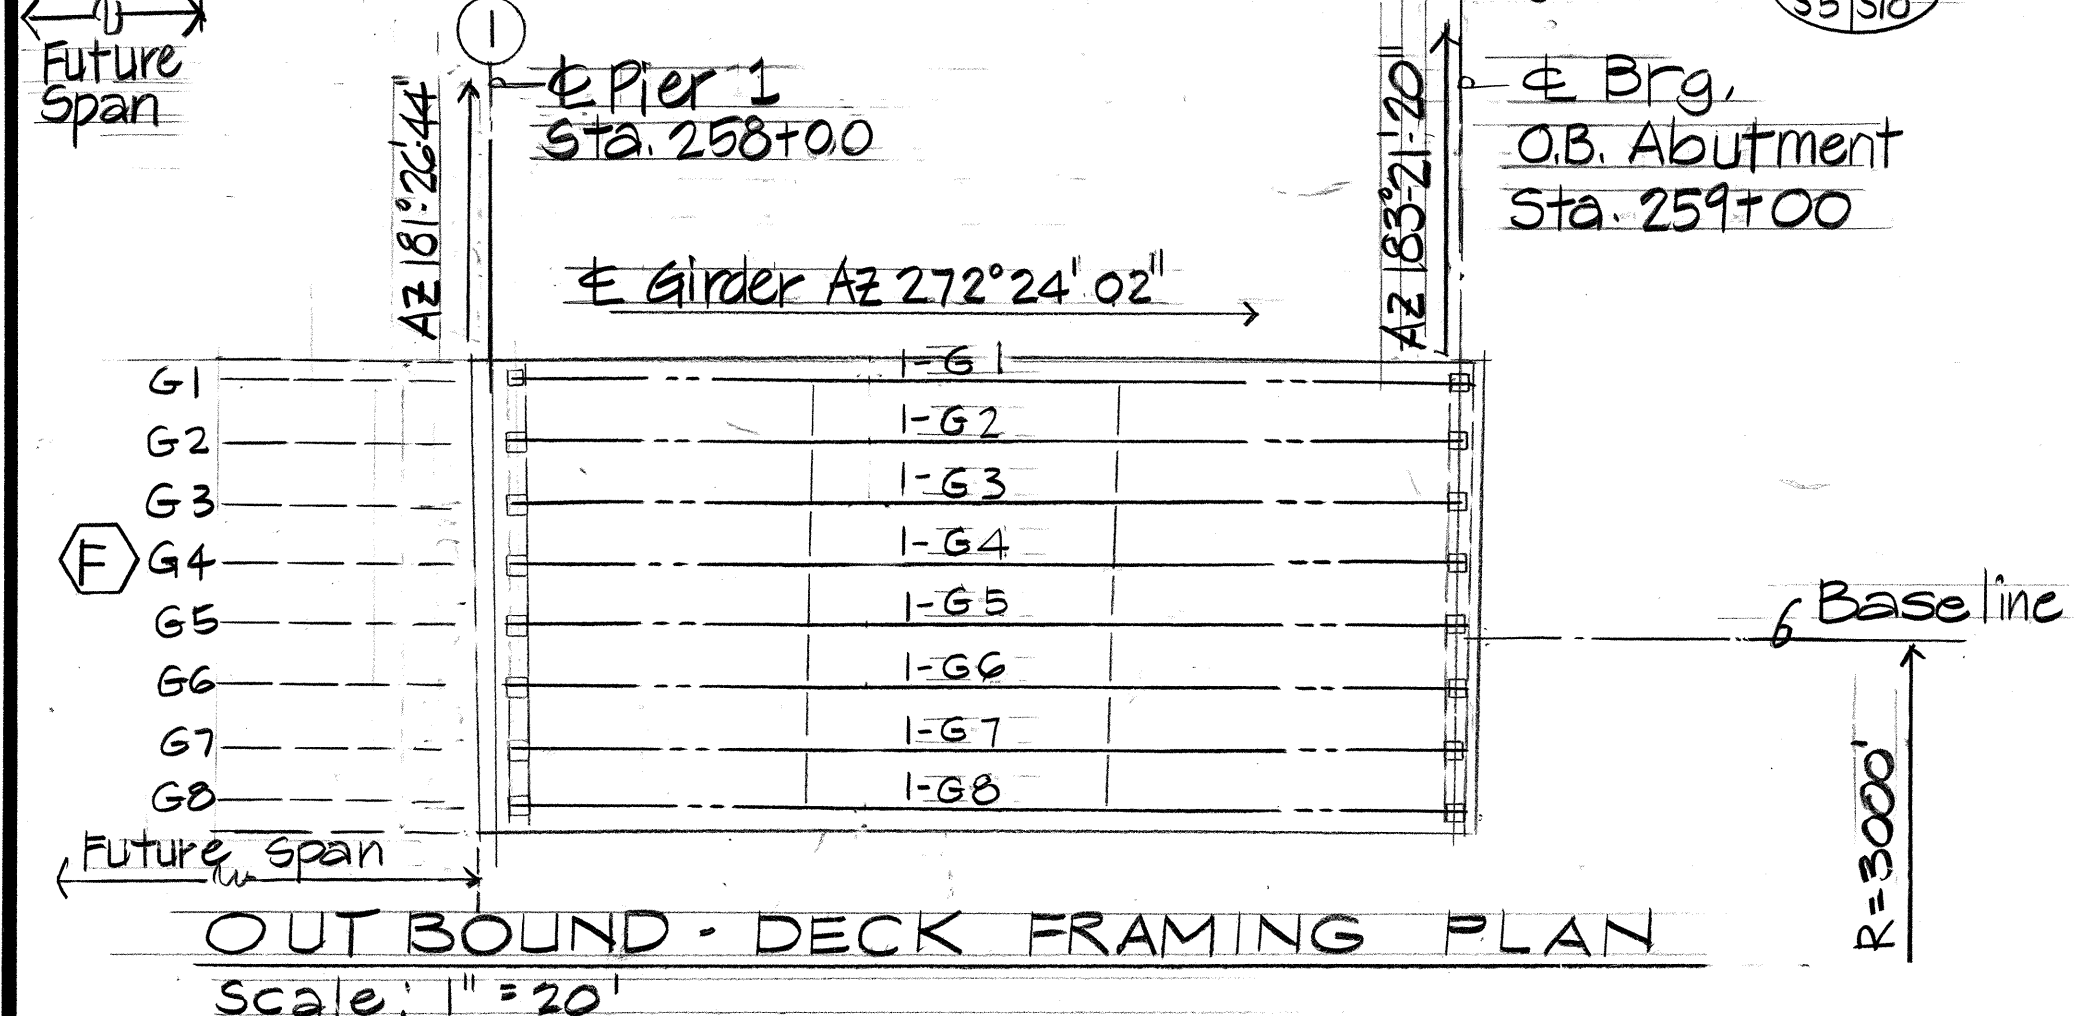

OUT BOUND - DECK FRAMING PLAN
Scale: 1" = 20'

- NOTES:
- Intermediate Diaphragms to be placed Radially. For Typical Diaphragm Detail, see E S5/S18.
 - Bridge Deck Slab thickness = 7 1/2" typ, except for Span 6 I.B. where thickness = 8".
 - Add 2-#11 over each Girder (Typ) For splices refer to Span 6 I.B.

GIRDER AZ SCHEDULE	
INBOUND SPAN 6	
GIRDER	AZIMUTH
6-G1	286°39'24"
6-G2	287°47'56"
6-G3	288°56'37"
6-G4	290°05'23"
6-G5	291°14'12"
6-G6	292°23'00"
6-G7	293°31'43"
6-G8	294°40'19"
6-G9	295°48'44"
6-G10	296°56'55"

1/10/89 Note 3 Revised, Inbound Span 1 Deleted

DATE	REVISION
	AS BUILT

MYRON G. OKUNO
REGISTERED PROFESSIONAL ENGINEER
No. 4070-S
HAWAII, U.S.A.
THIS WORK WAS PREPARED BY ME OR UNDER MY SUPERVISION
Myron Okuno



STATE OF HAWAII
DEPARTMENT OF TRANSPORTATION
HIGHWAYS DIVISION

DECK FRAMING & REINFORCEMENT PLANS


INTERSTATE ROUTE H-3
F.A.I. PROJECT NO. I-H3-1(52)

SCALE: AS NOTED DATE: JULY 1988
SHEET No. 55 OF 56 SHEETS

FED. ROAD DIST. NO.	STATE	FED. AID PROJ. NO.	FISCAL YEAR	SHEET NO.	TOTAL SHEETS
HAWAII	HAW.	I-H3-1 (52)	1988	40	75

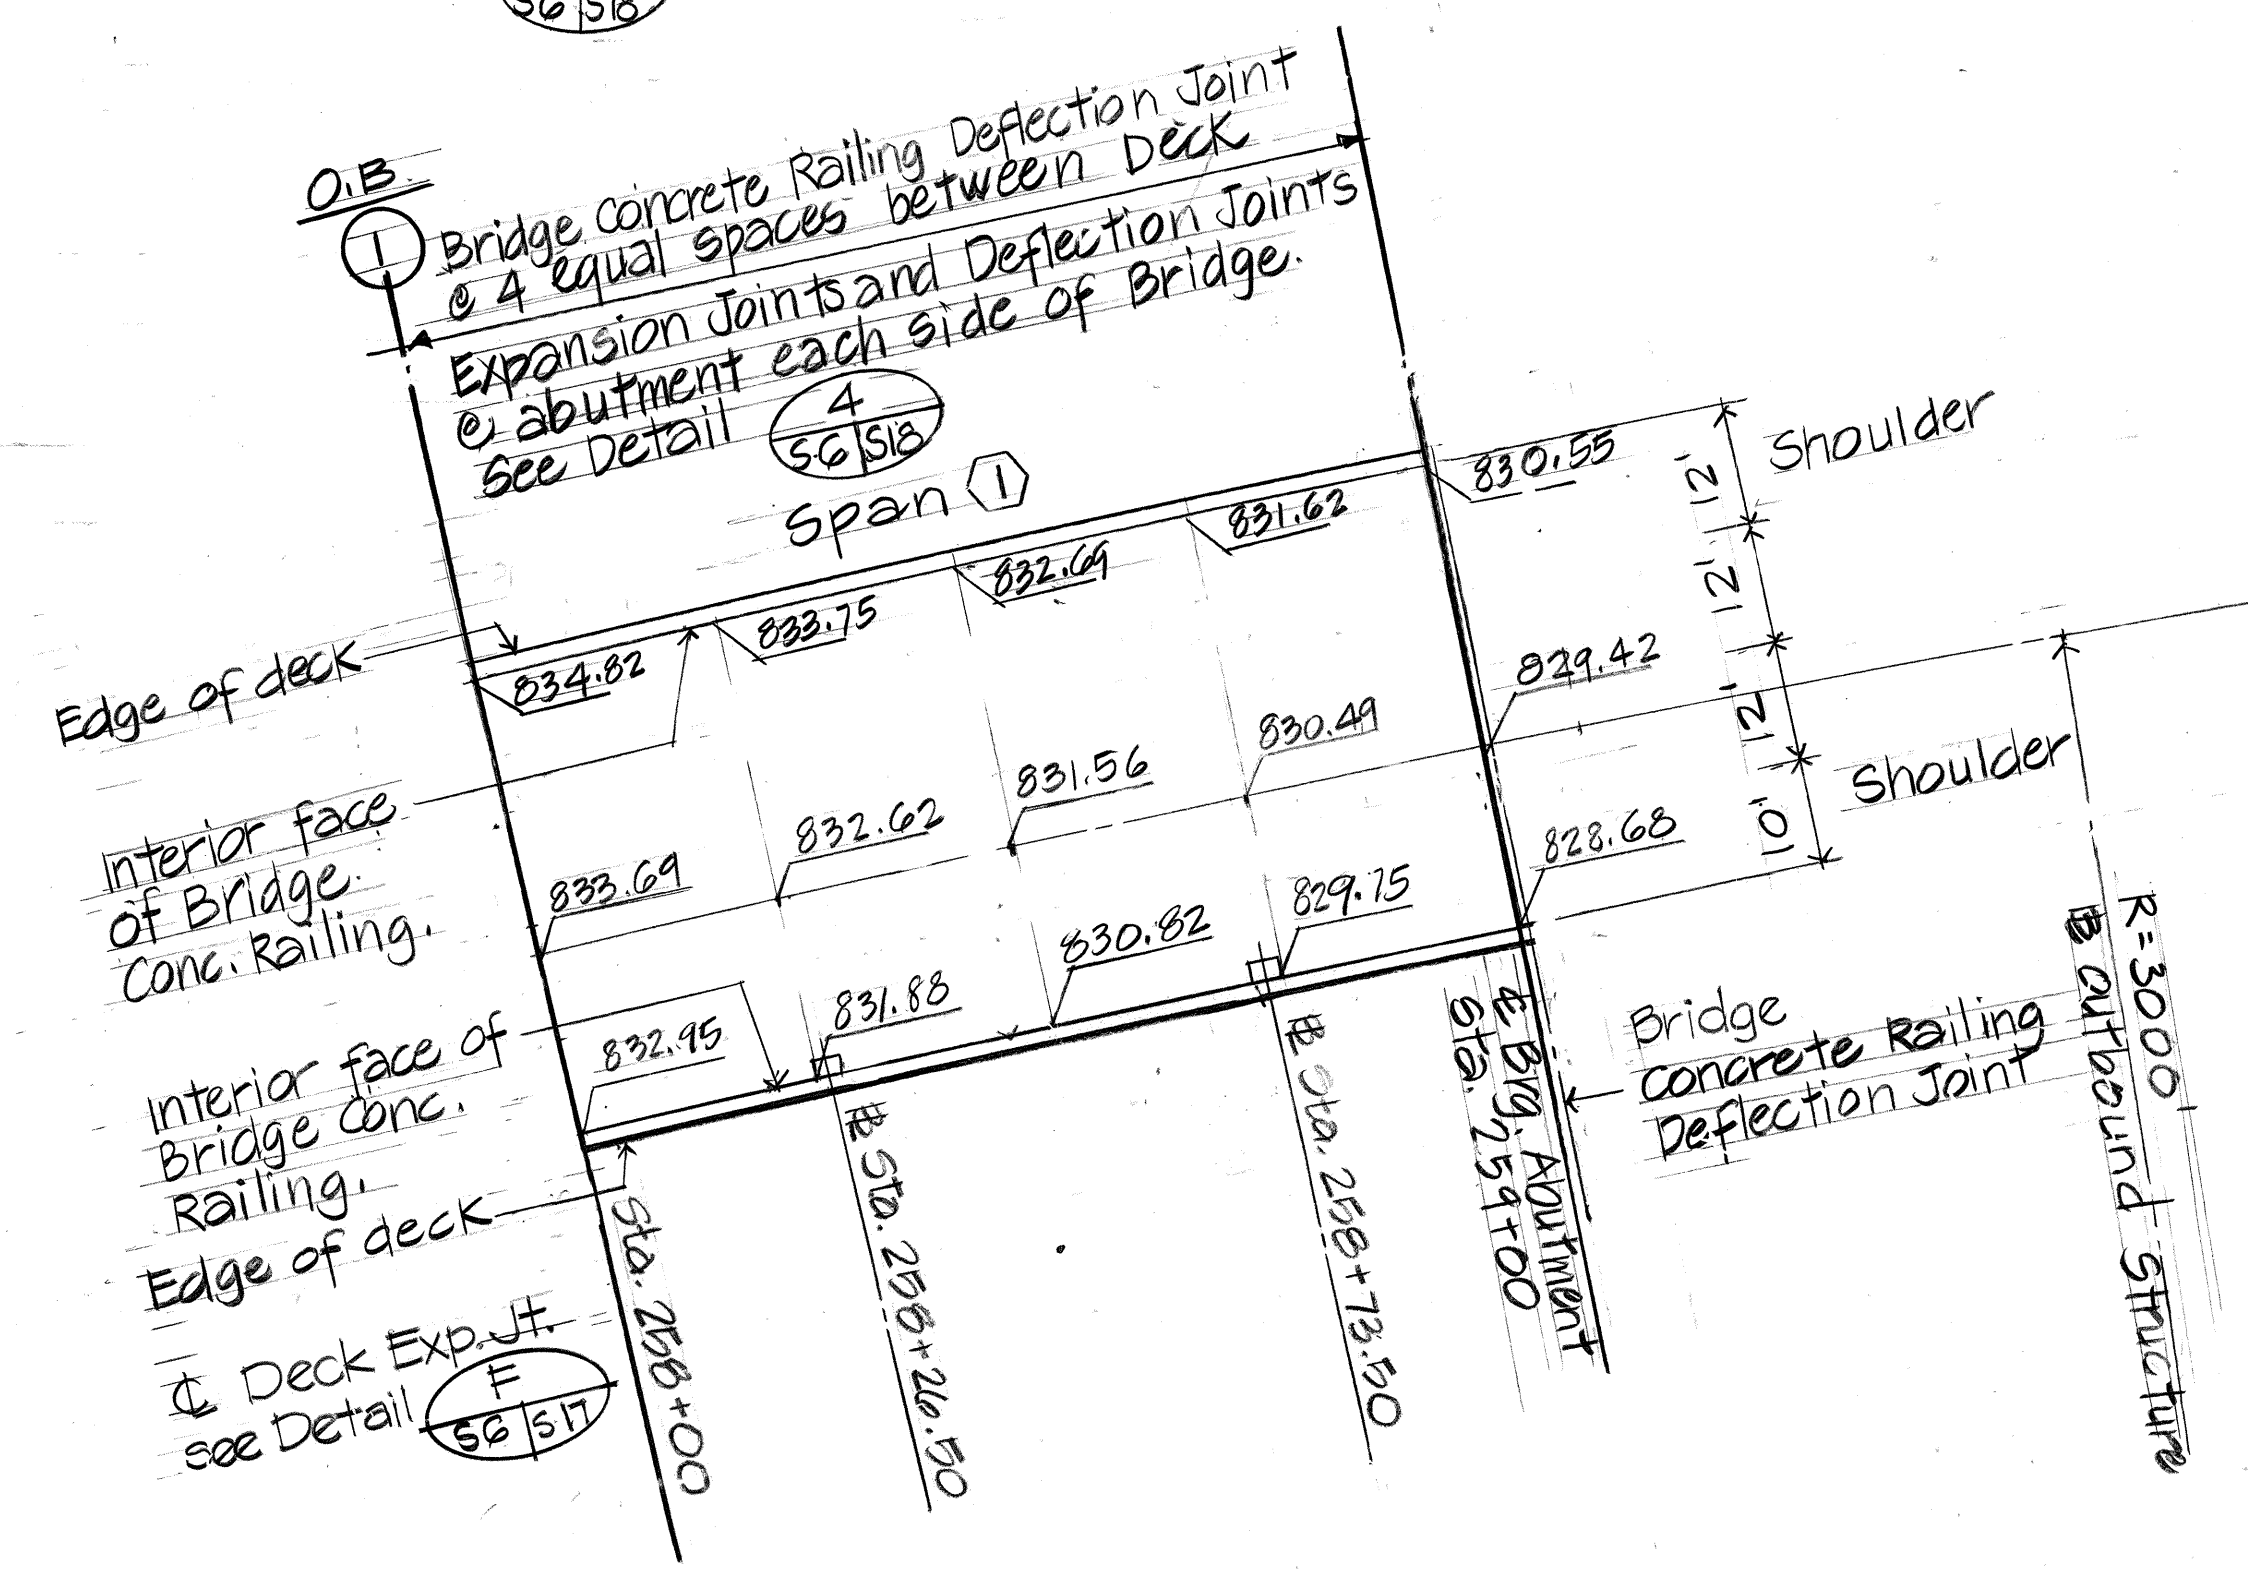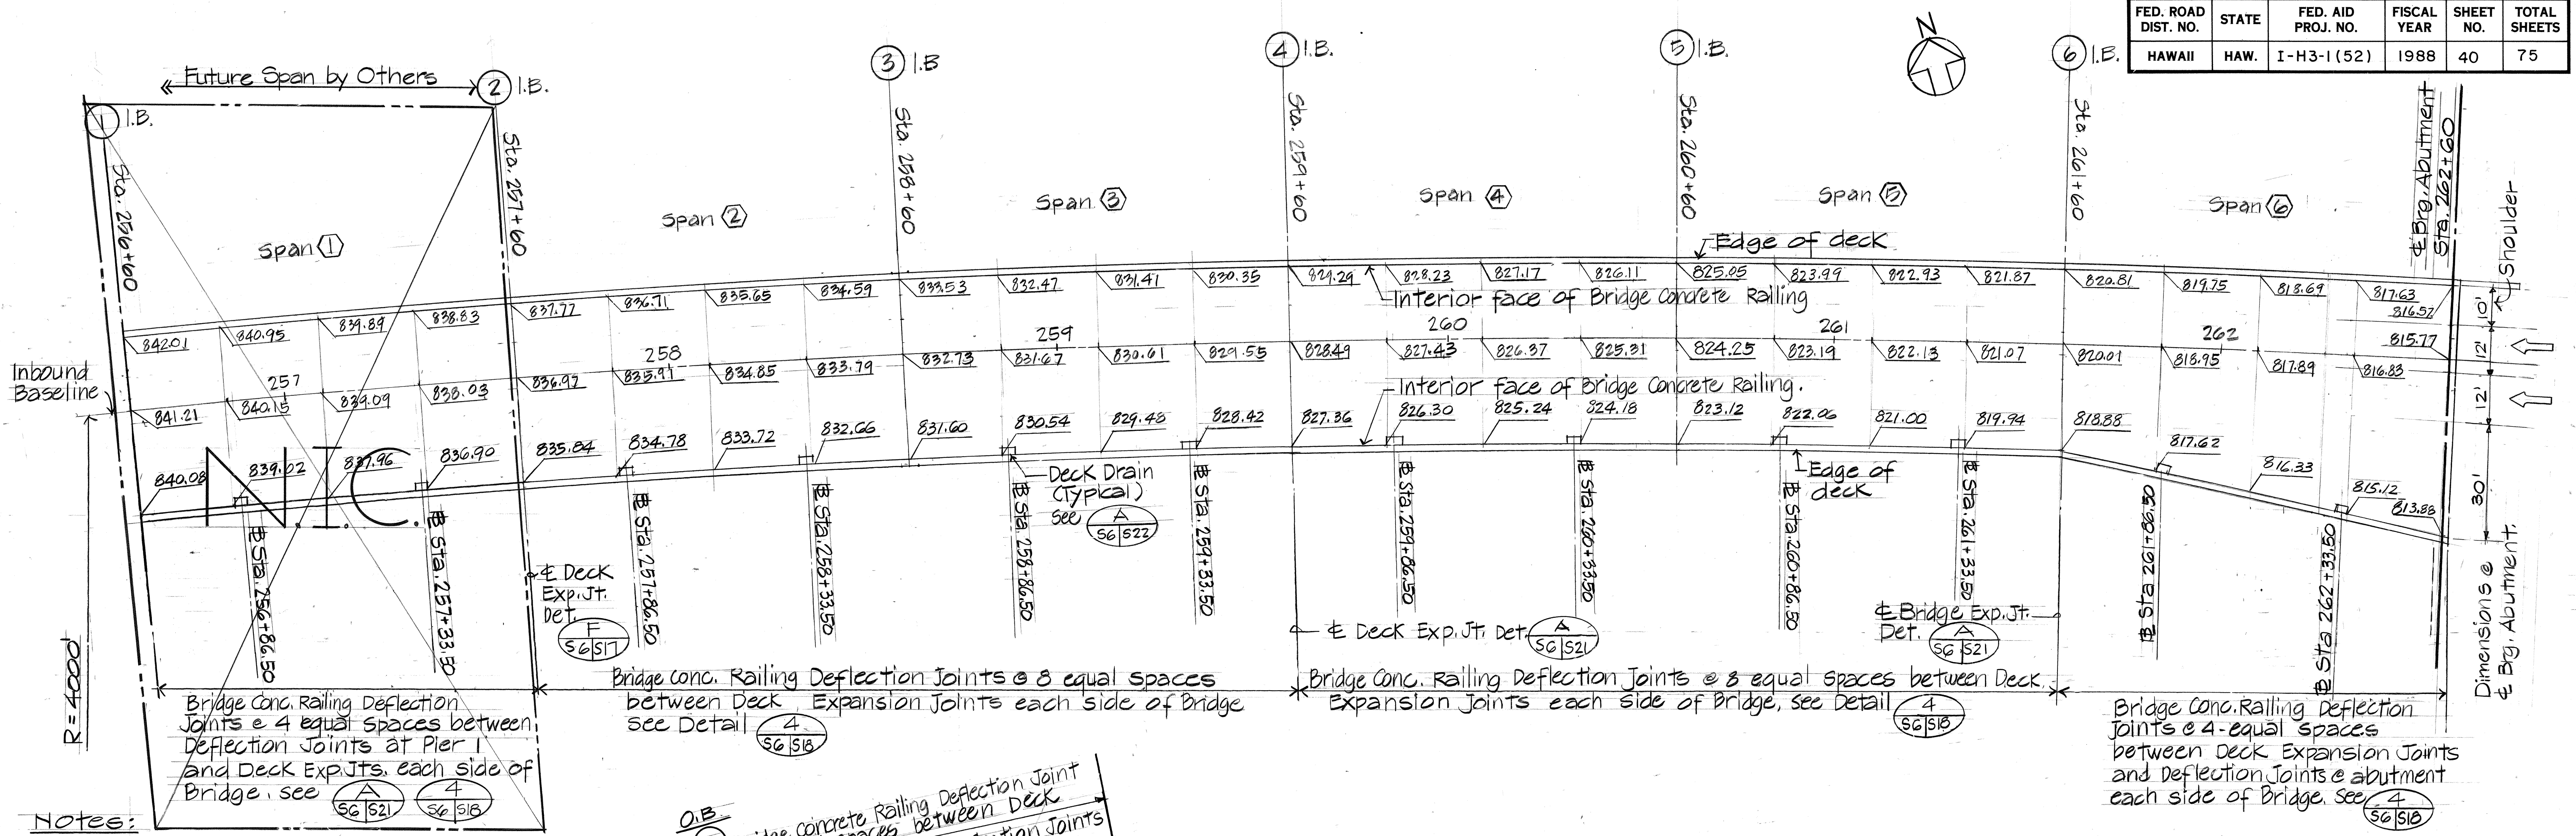

SURVEY PLOTTED BY	DATE
DRAWN BY	
CHECKED BY	
NOTED BY	
QUANTITIES BY	
CHECKED BY	
ORIGINAL PLAN	
NOTE BOOK	
NO.	

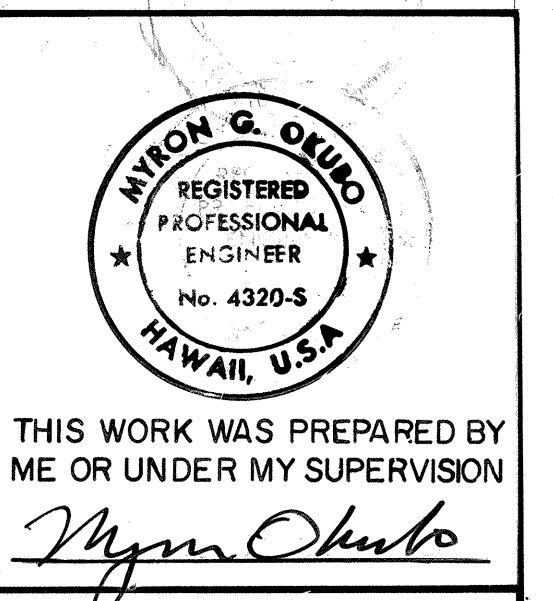




STATE OF HAWAII DEPARTMENT OF TRANSPORTATION HIGHWAYS DIVISION	
FINISHED DECK ELEVATIONS	
INTERSTATE ROUTE H-3 F.A.I. PROJECT NO. I-H3-1 (52)	
SCALE: 1" = 20'	DATE: JULY 1988
SHEET NO. 36 OF 326 SHEETS	

1/10/89	Deck Expansion Joint Detail Clarified, Inbound Span 1 Deleted
DATE	REVISION


AS BUILT

ADD. 40


FED. ROAD DIST. NO.	STATE	FED. AID PROJ. NO.	FISCAL YEAR	SHEET NO.	TOTAL SHEETS
HAWAII	HAW.	I-H3-1(52)	1988	42	75

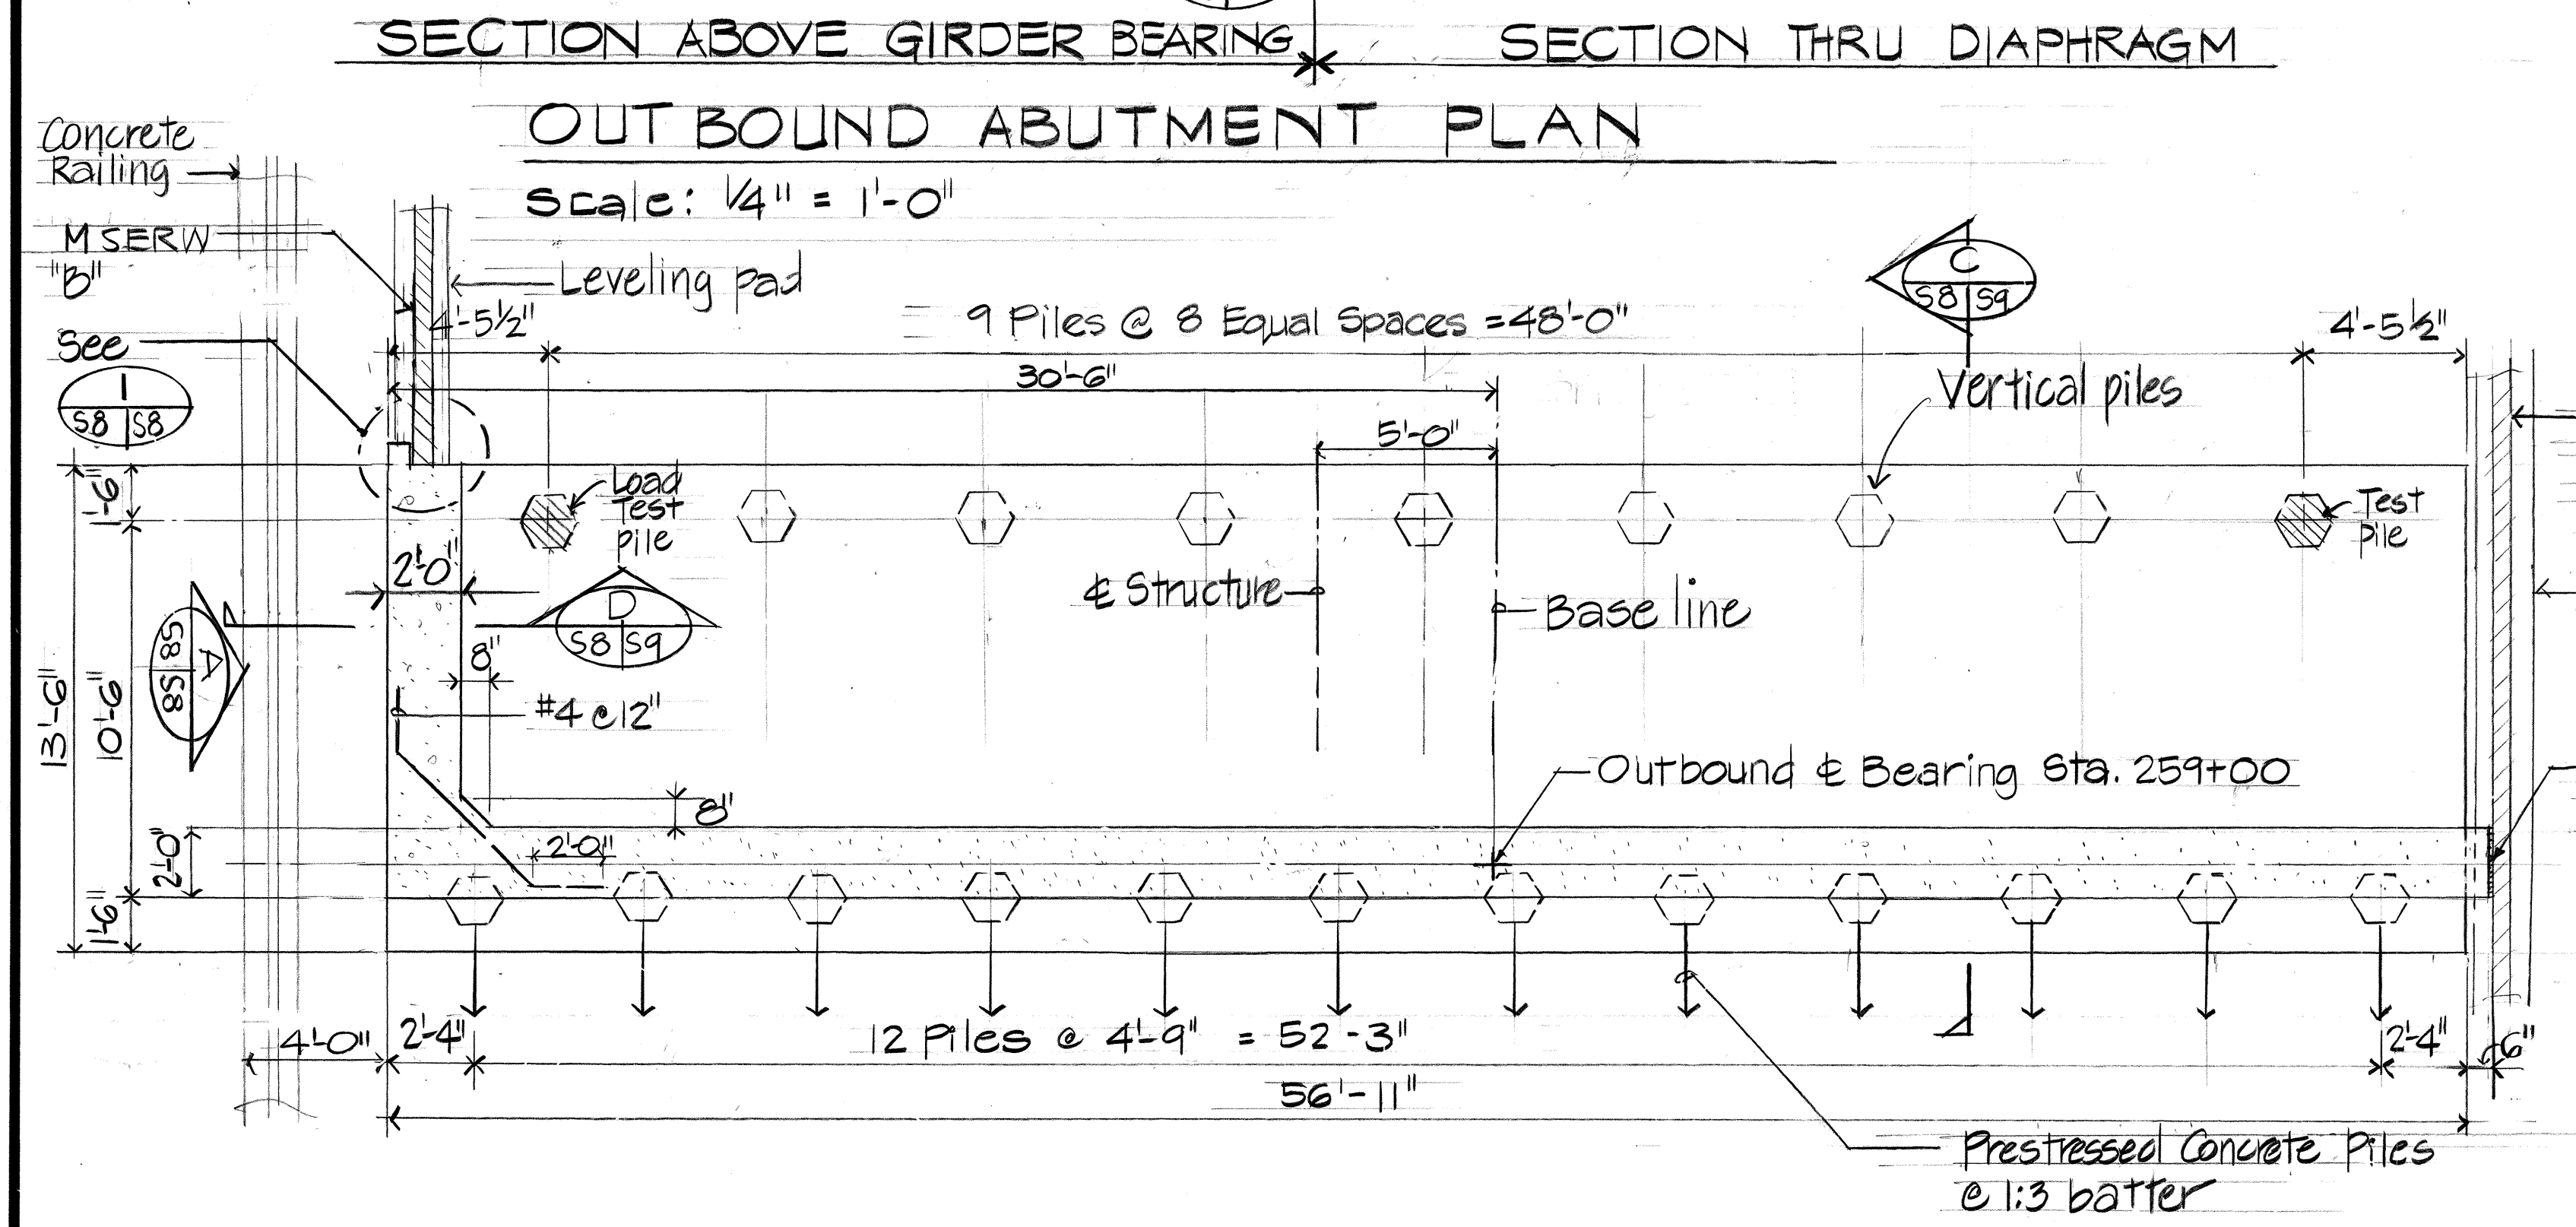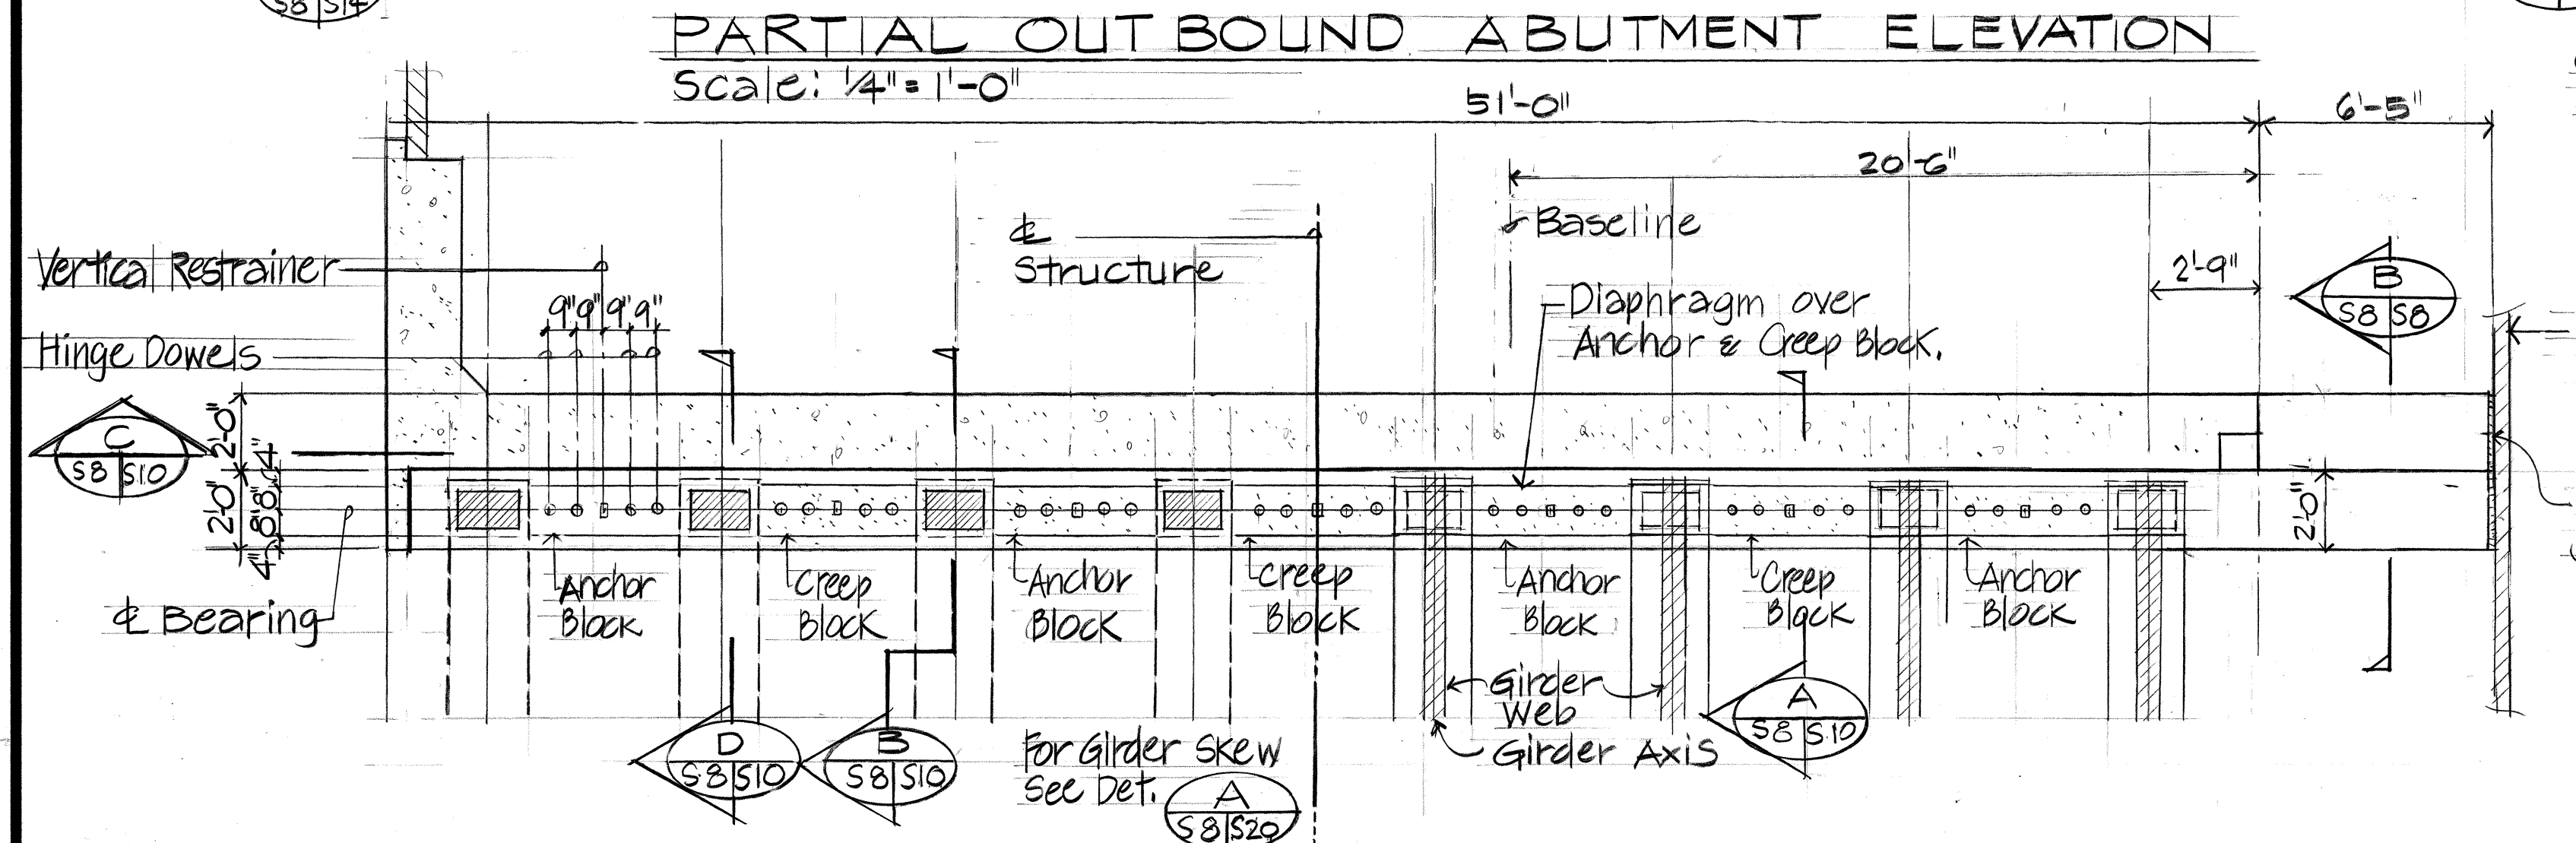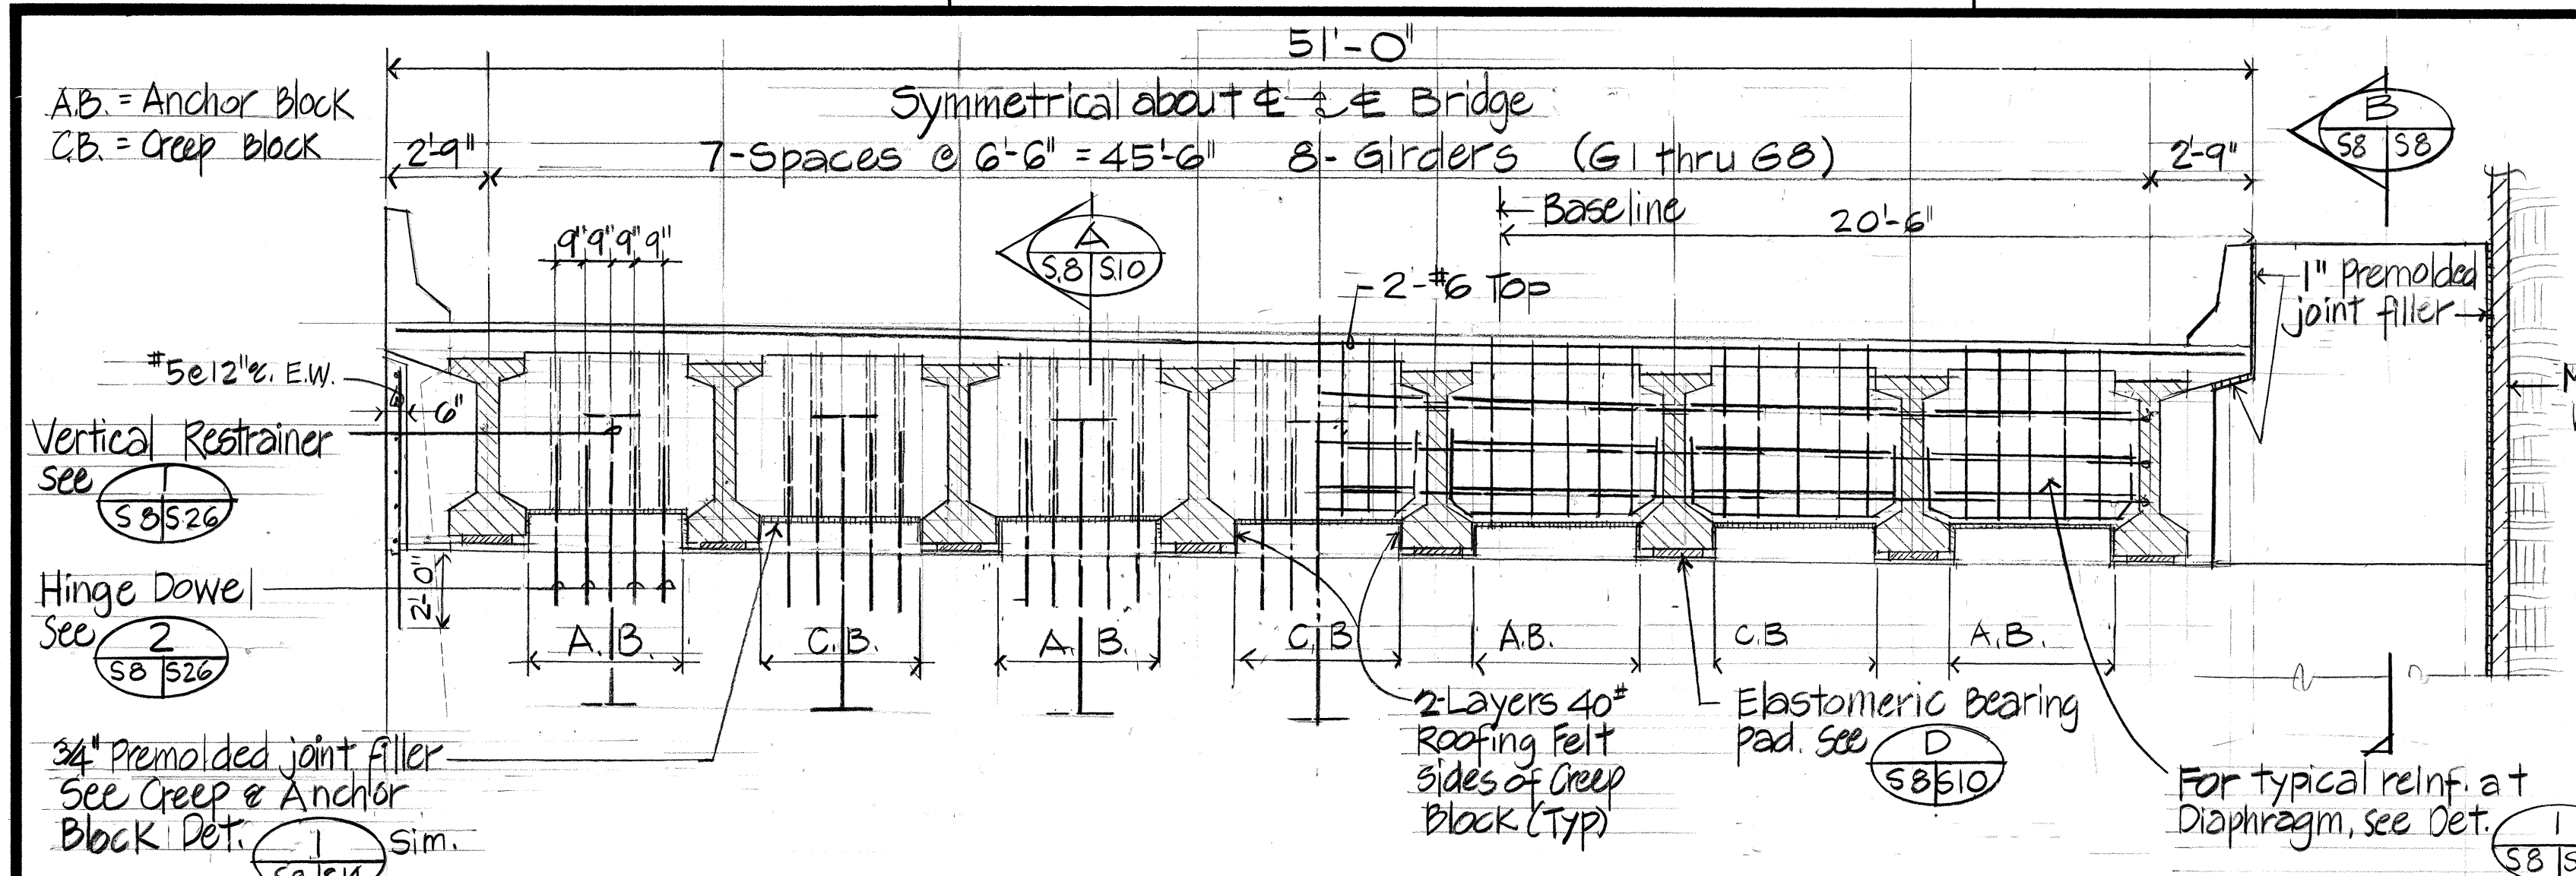

OUTBOUND ABUTMENT FOUNDATION PLAN
Scale: 1/4" = 1'-0"

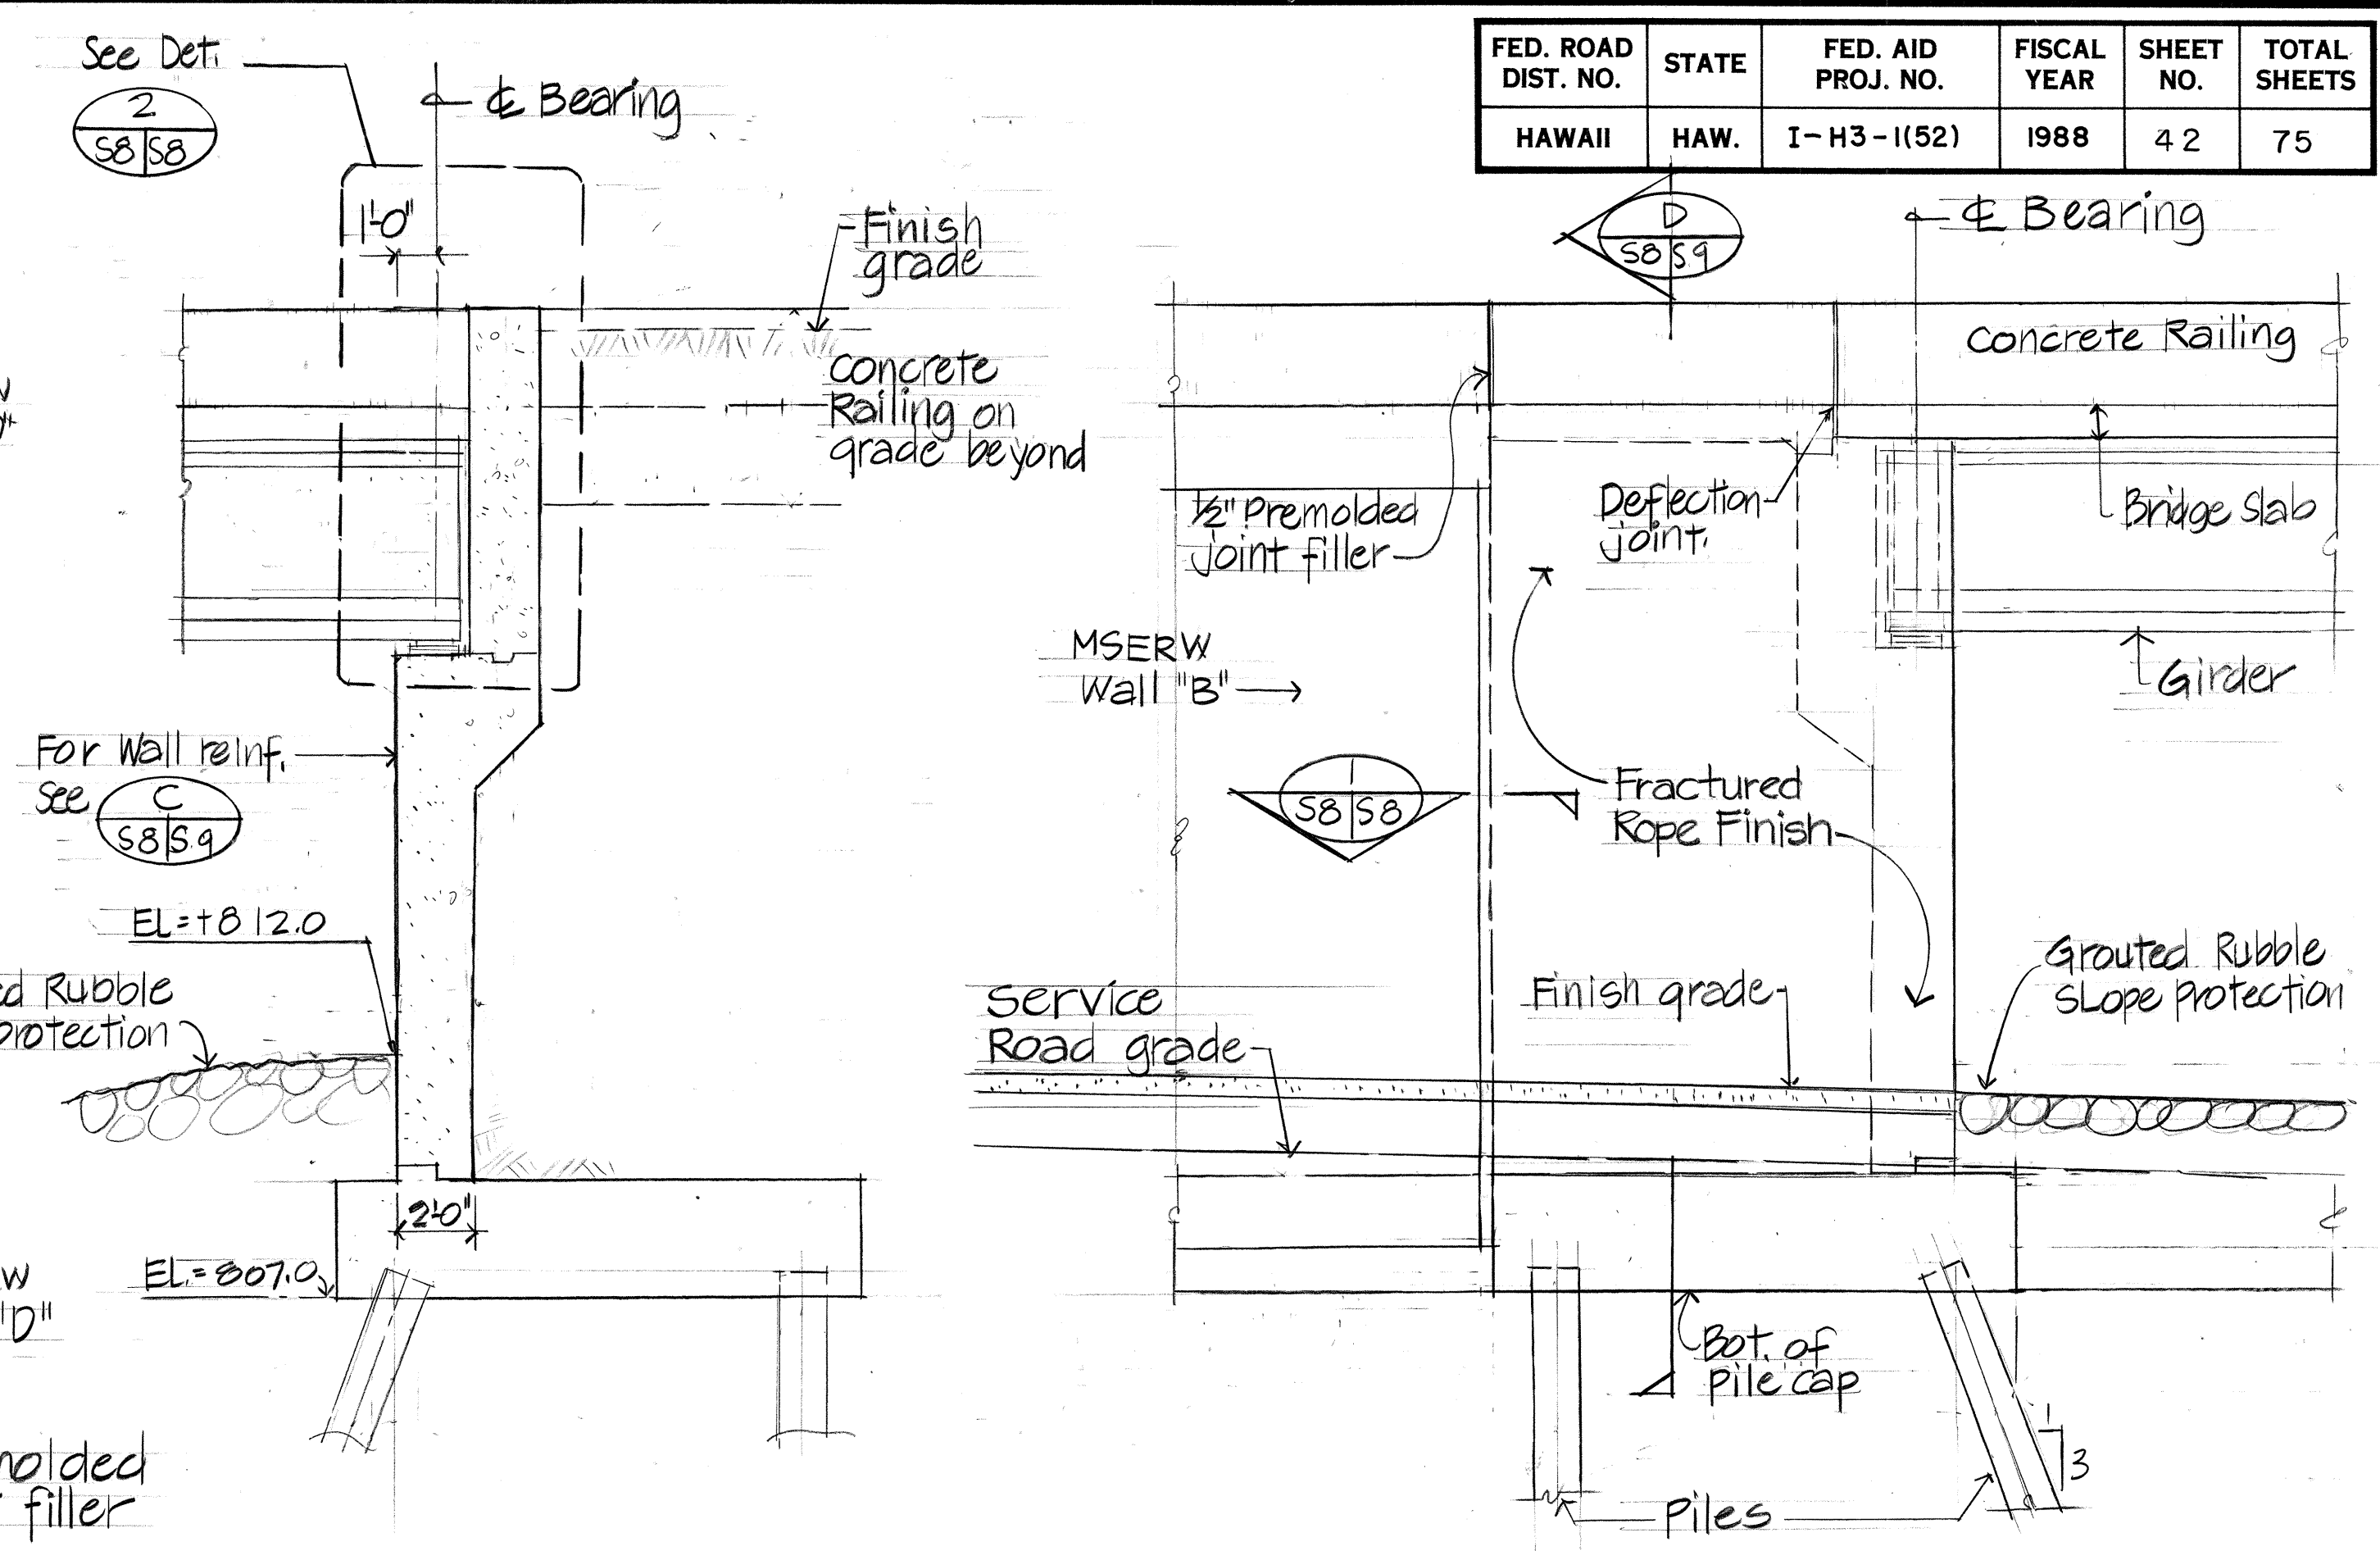

SECTION B SIDE WALL ELEVATION
Scale: 1/4" = 1'-0"

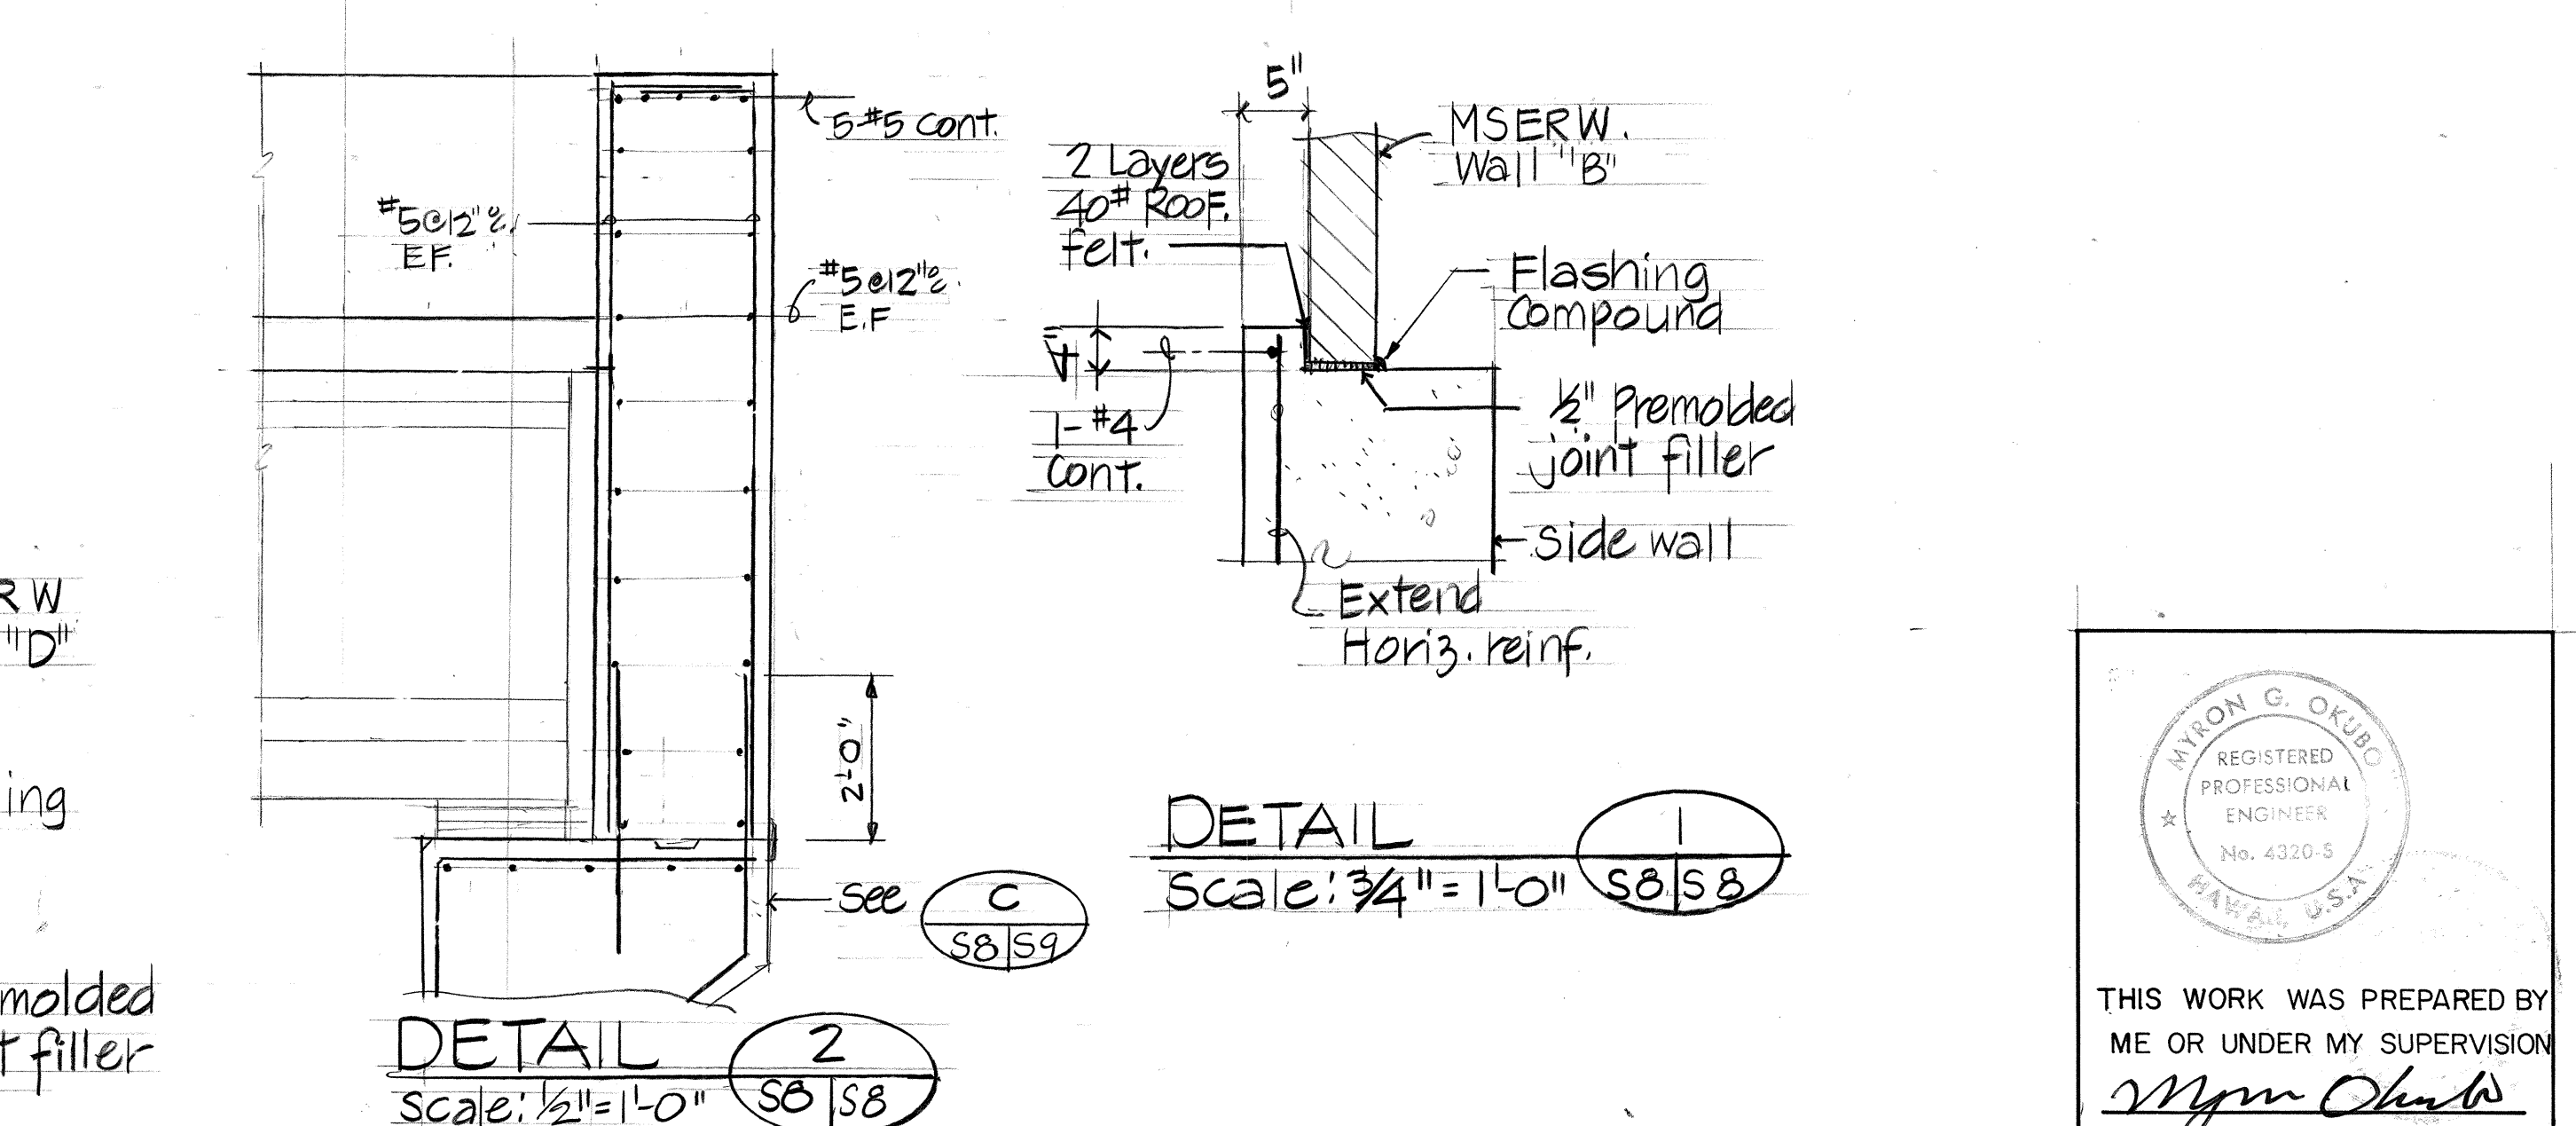

DETAIL 1
Scale: 3/4" = 1'-0"

DETAIL 2
Scale: 1/2" = 1'-0"

THIS WORK WAS PREPARED BY
ME OR UNDER MY SUPERVISION
Mym Oshida

STATE OF HAWAII
DEPARTMENT OF TRANSPORTATION
HIGHWAYS DIVISION

OUTBOUND ABUTMENT

INTERSTATE ROUTE H-3
F.A.I. PROJECT NO. I-H3-1(52):

SCALE: AS NOTED DATE: JULY 1988
SHEET NO. 38 OF 526 SHEETS





1/10/89 Pile Layout Revised, Detail A Revised
DATE REVISION

AS BUILT

ADD. 42

SURVEY PLOTTED BY
DATE
DRAWN BY
CHECKED BY
NOTE BOOK
NO.

FED. ROAD DIST. NO.	STATE	FED. AID PROJ. NO.	FISCAL YEAR	SHEET NO.	TOTAL SHEETS
HAWAII	HAW.	I-H3-1(52)	1988	43	75

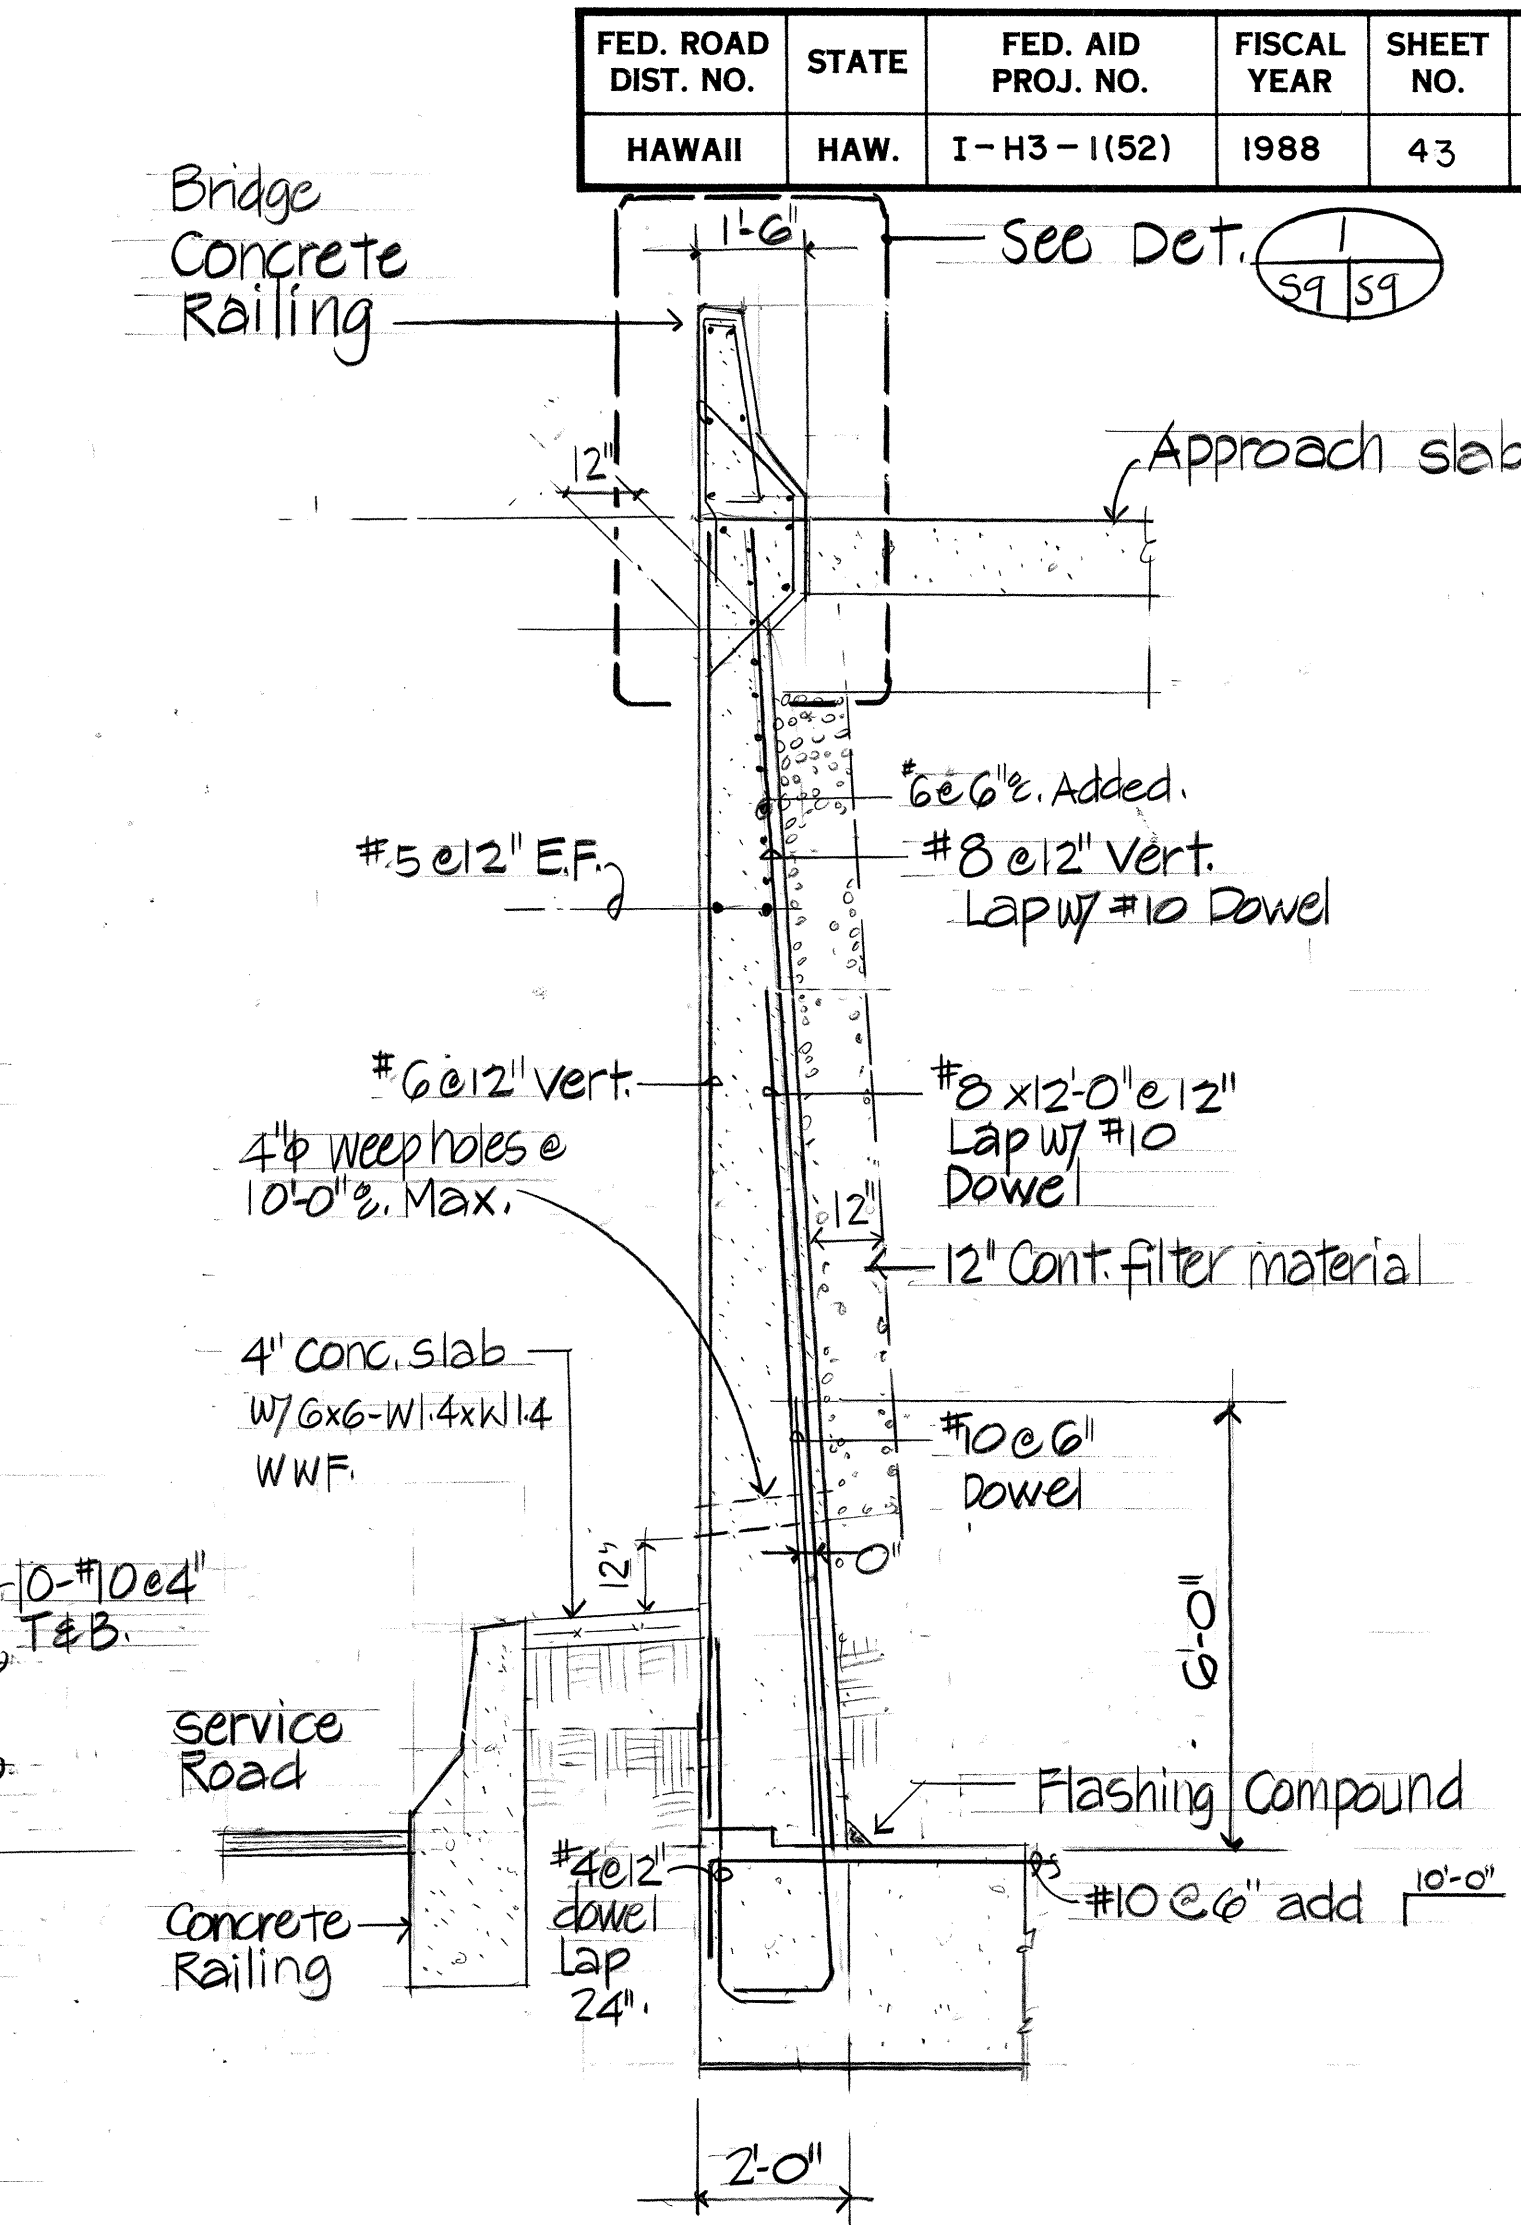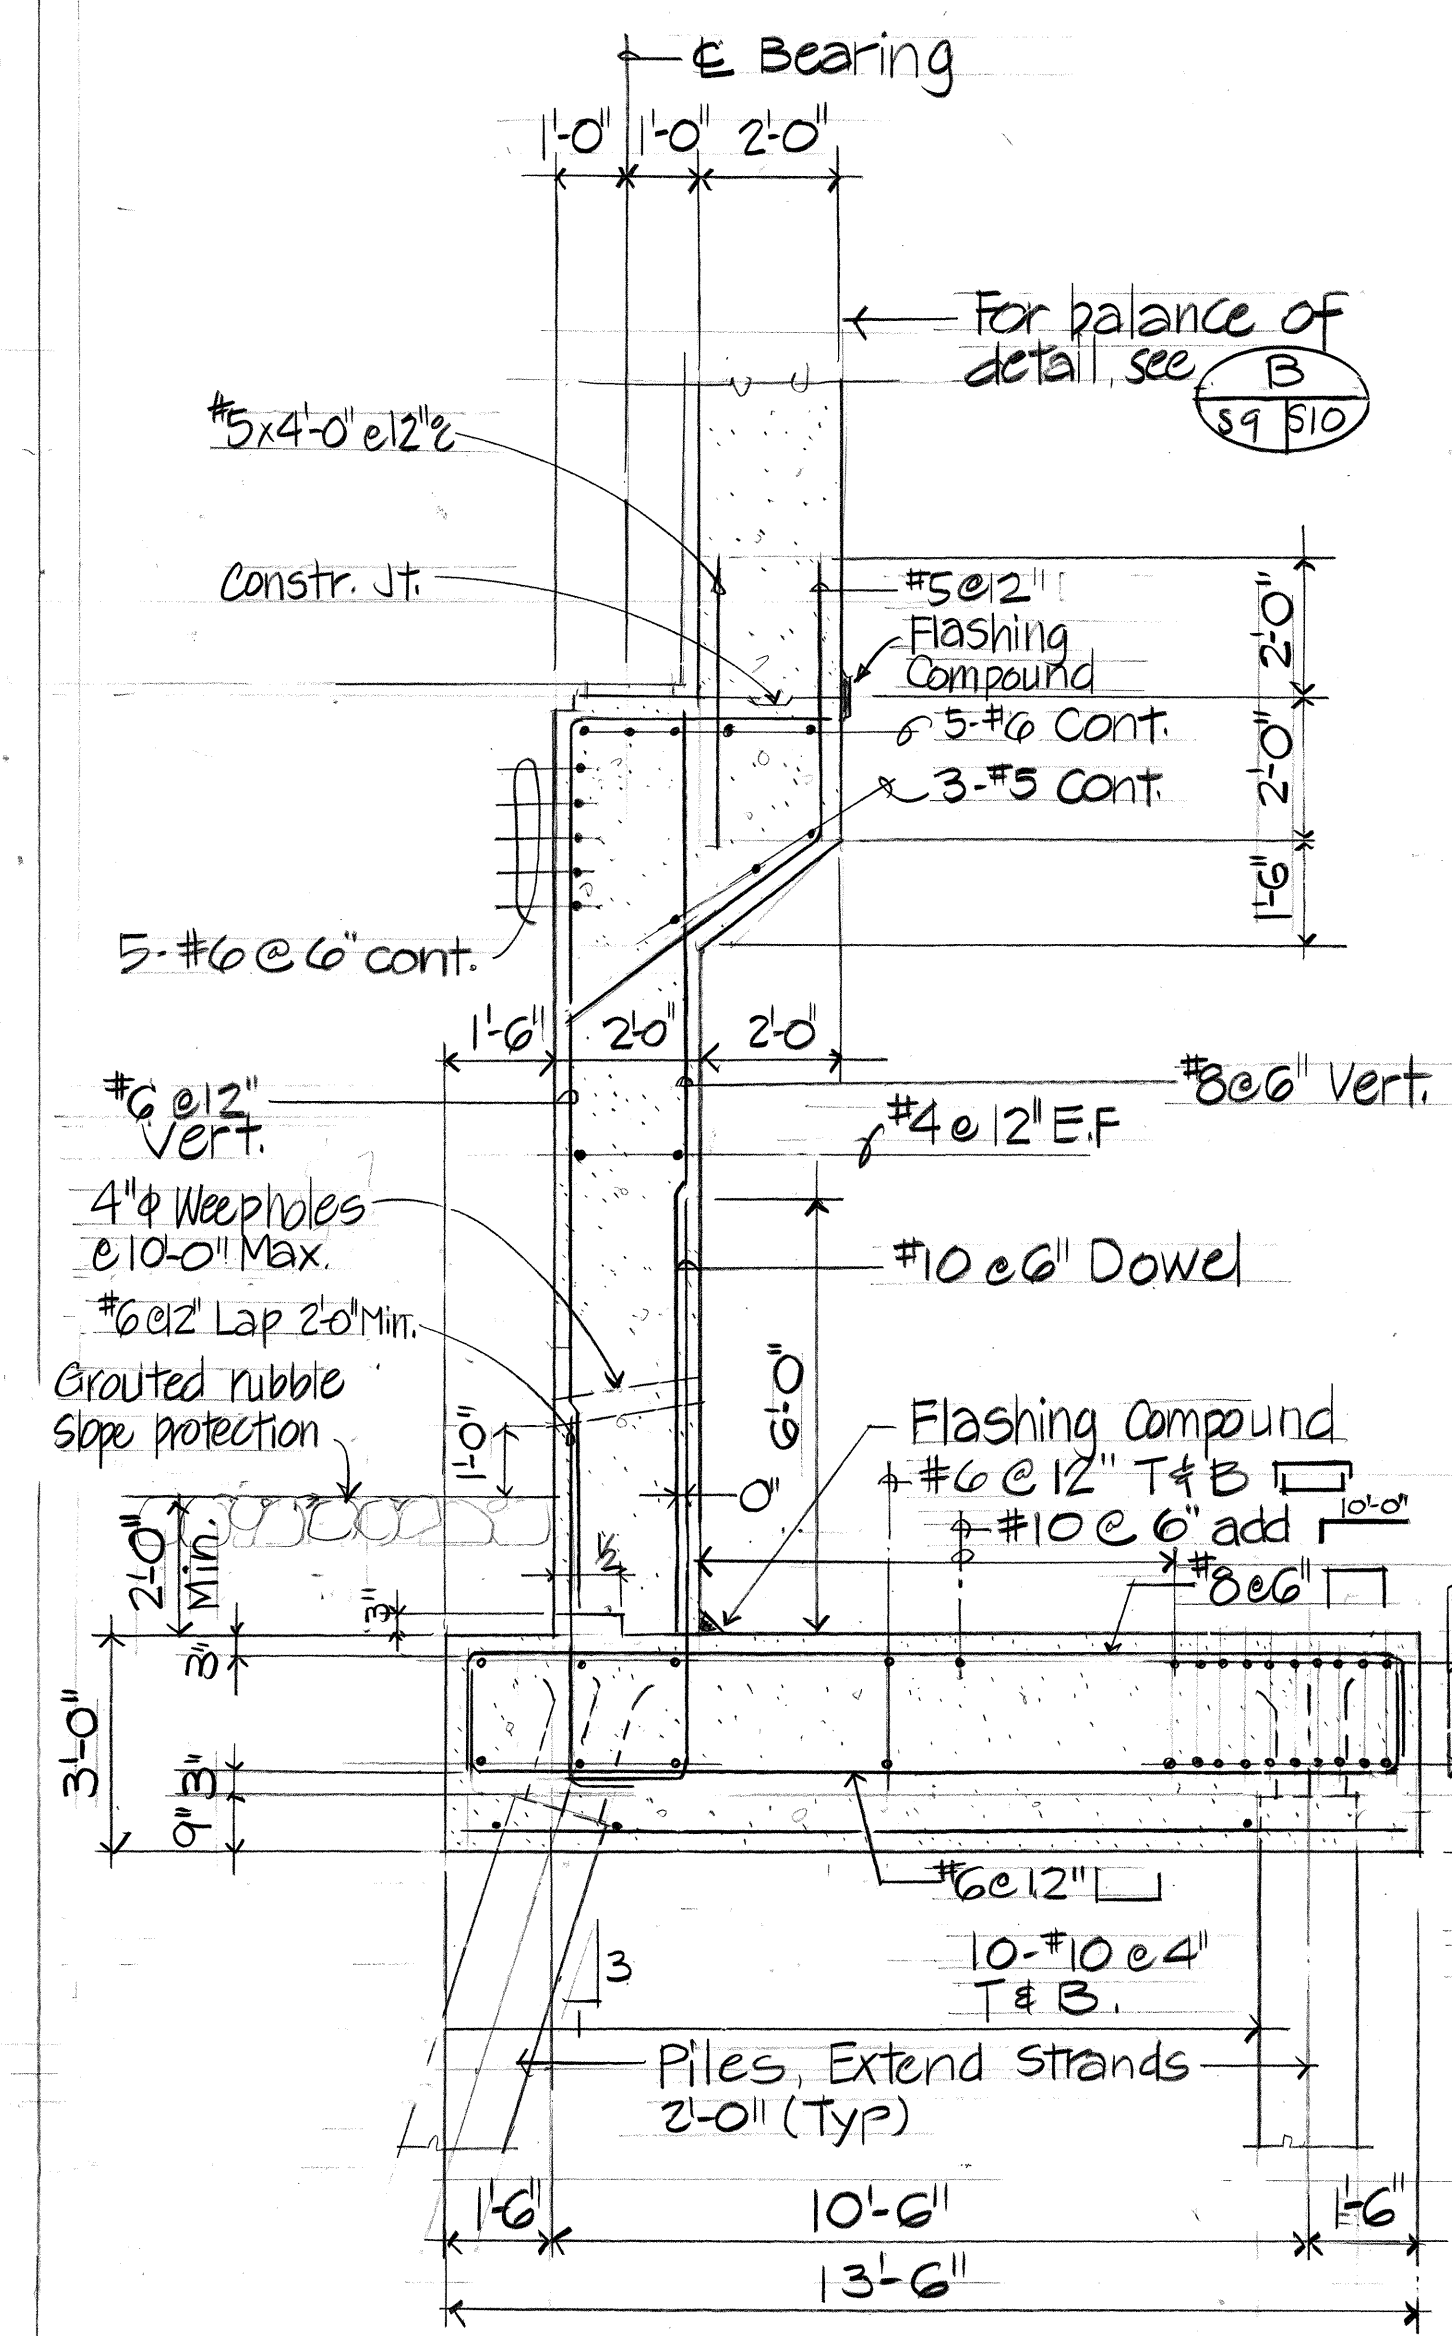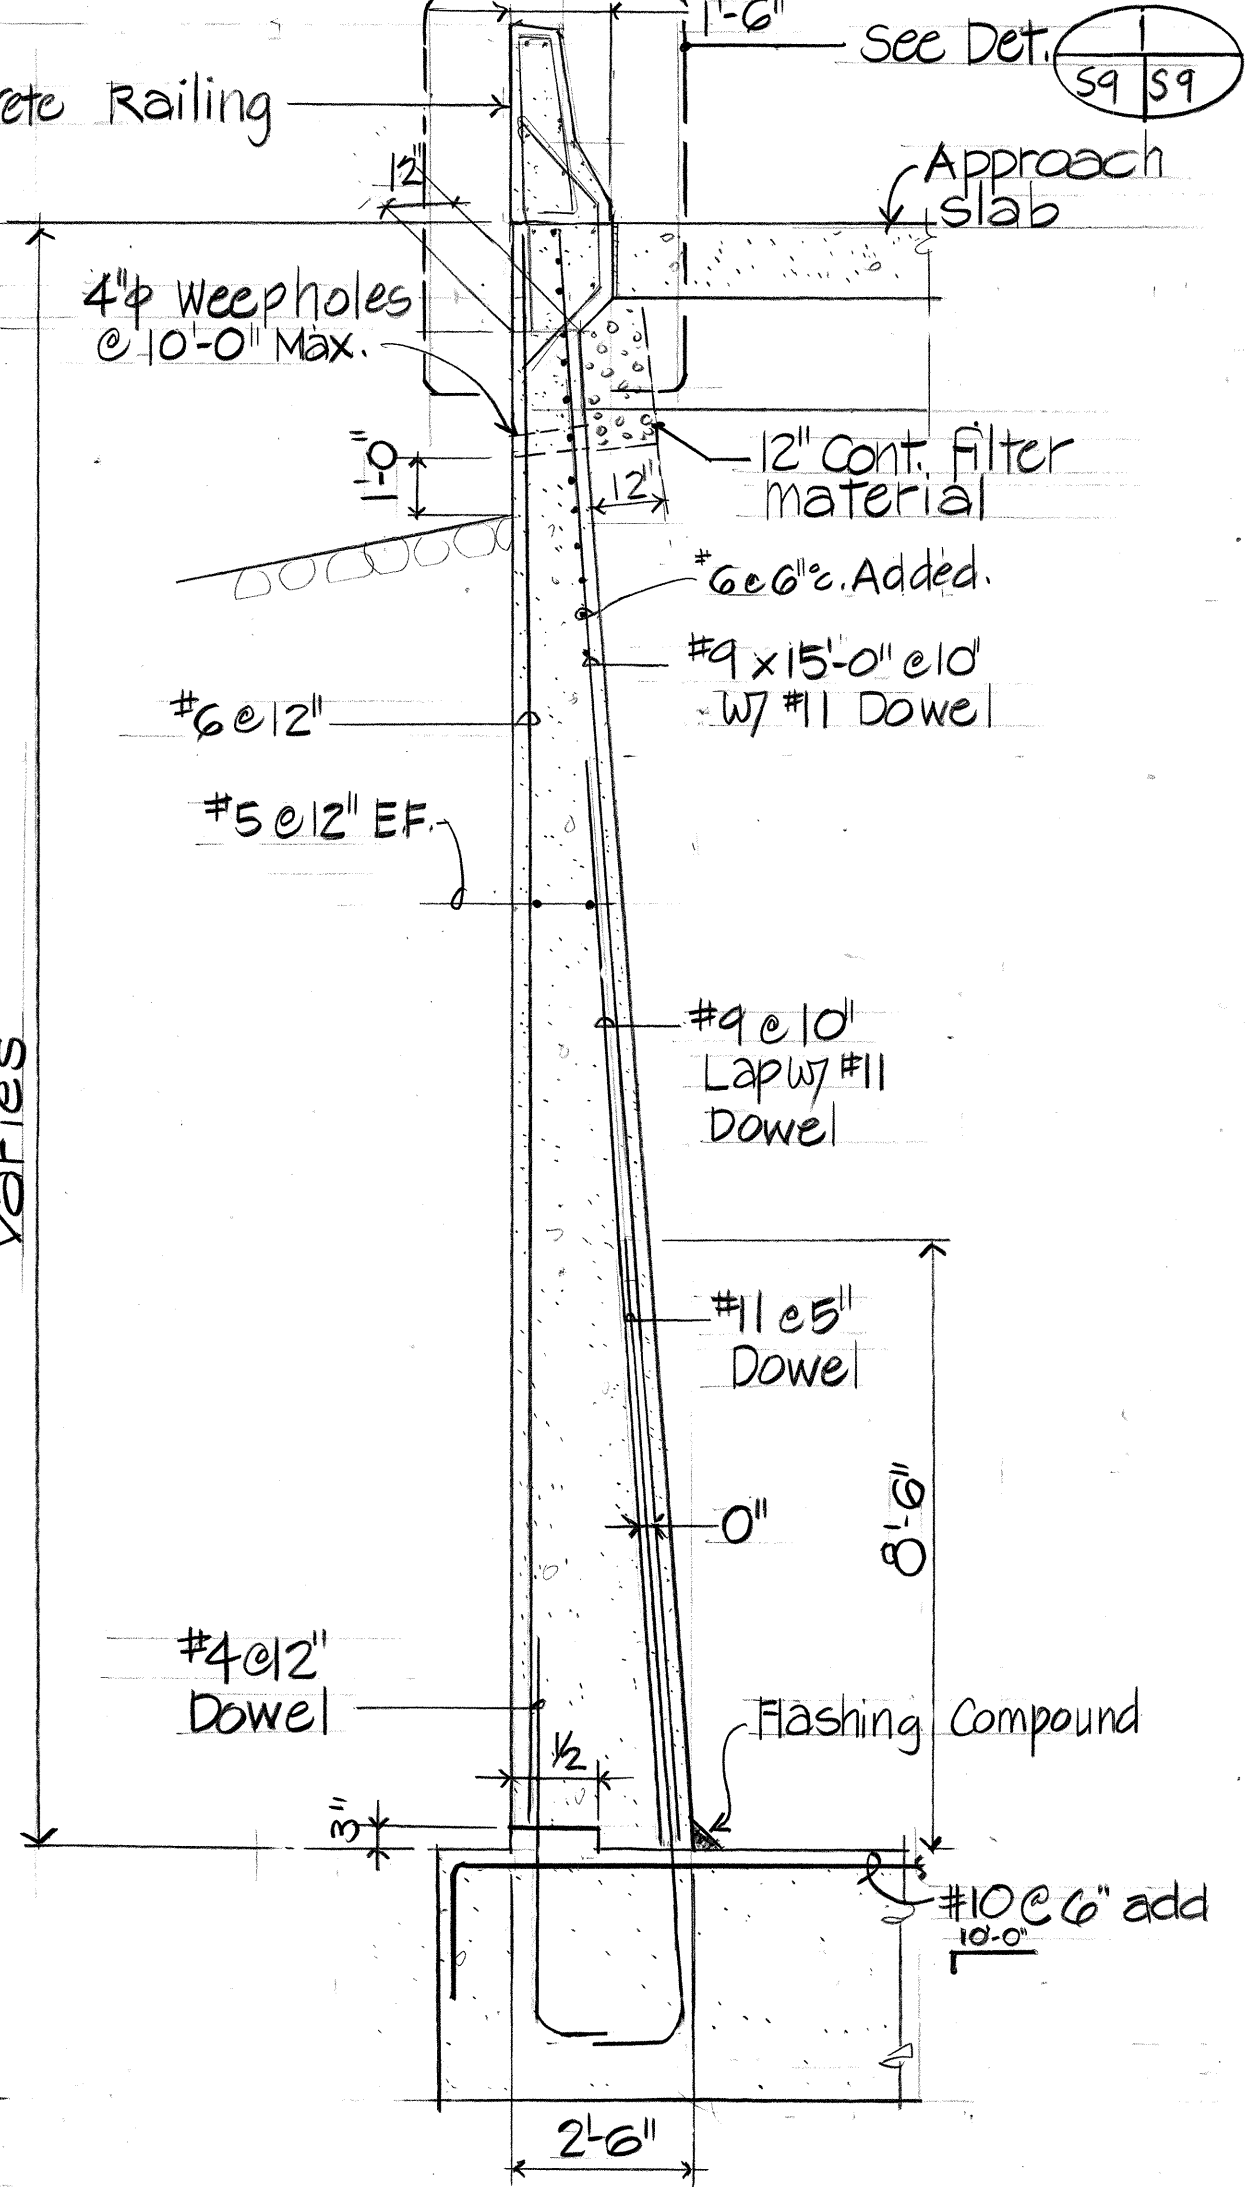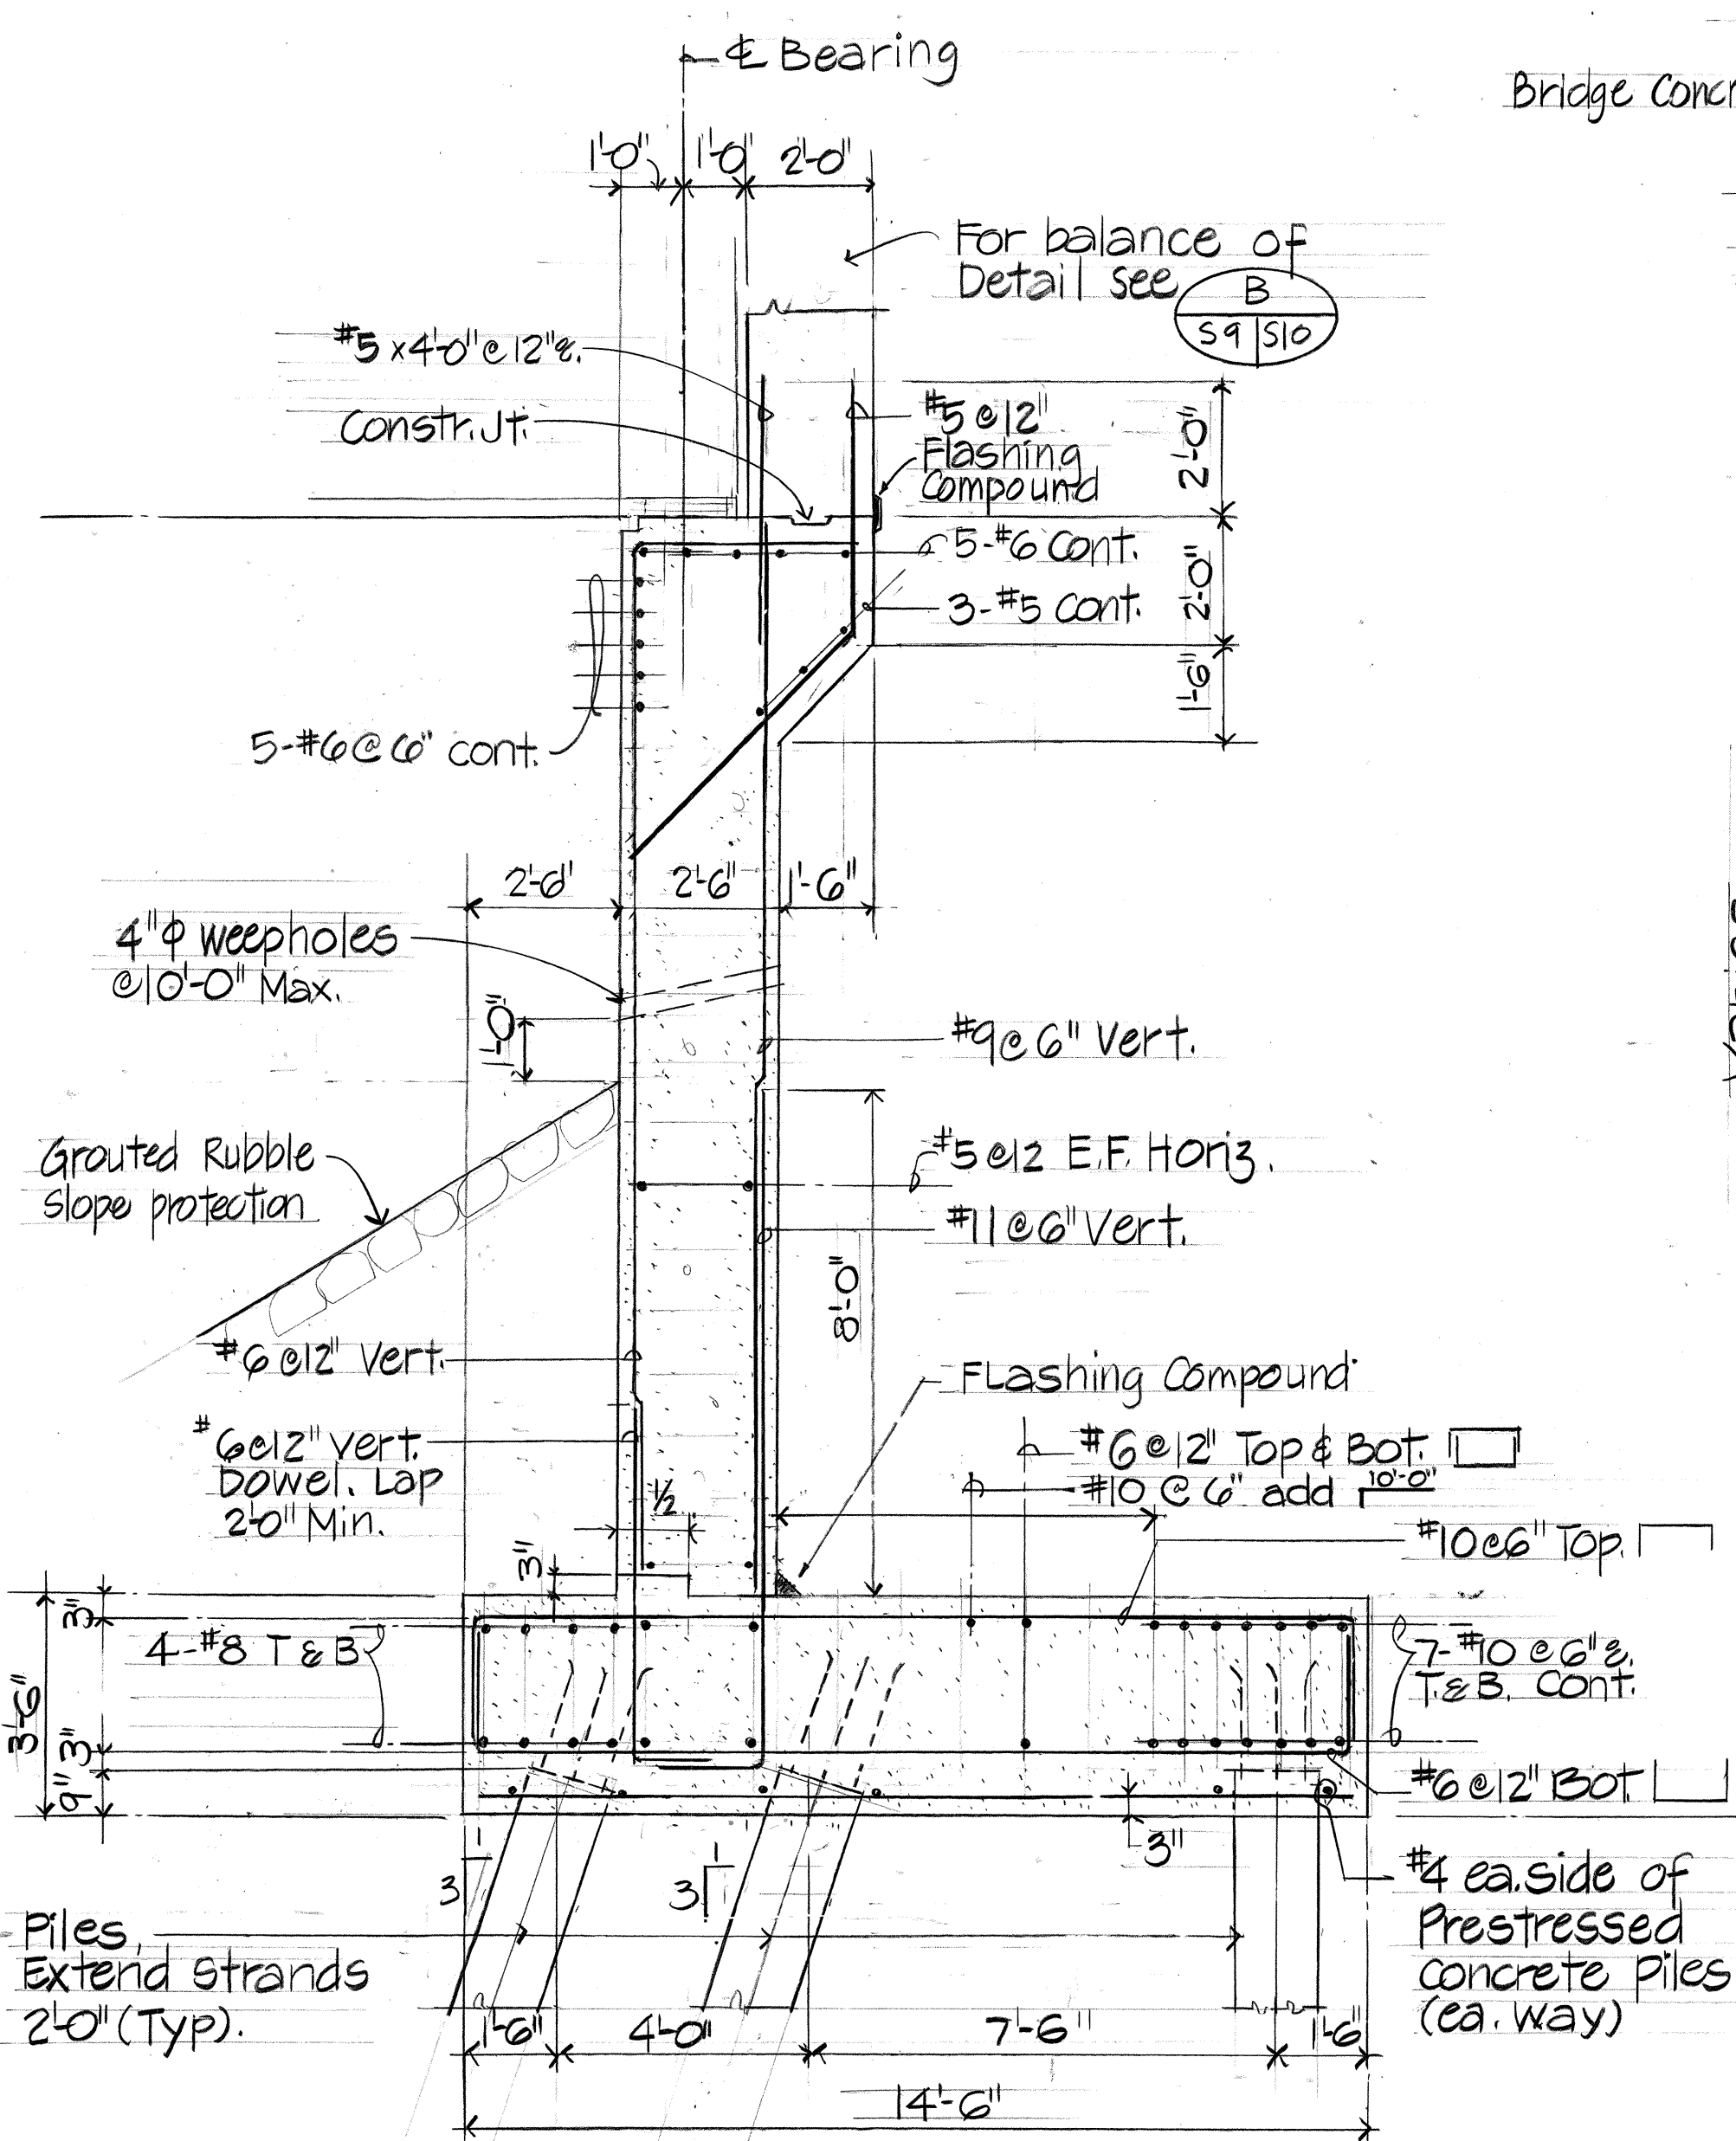


INBOUND ABUTMENT SECTION A
Scale: 3/8" = 1'-0"

INBOUND ABUTMENT NORTH SIDE WALL SECTION B
Scale: 3/8" = 1'-0"

OUTBOUND ABUTMENT SECTION C
Scale: 3/8" = 1'-0"

OUTBOUND ABUTMENT NORTH SIDE WALL SECTION D
Scale: 3/8" = 1'-0"

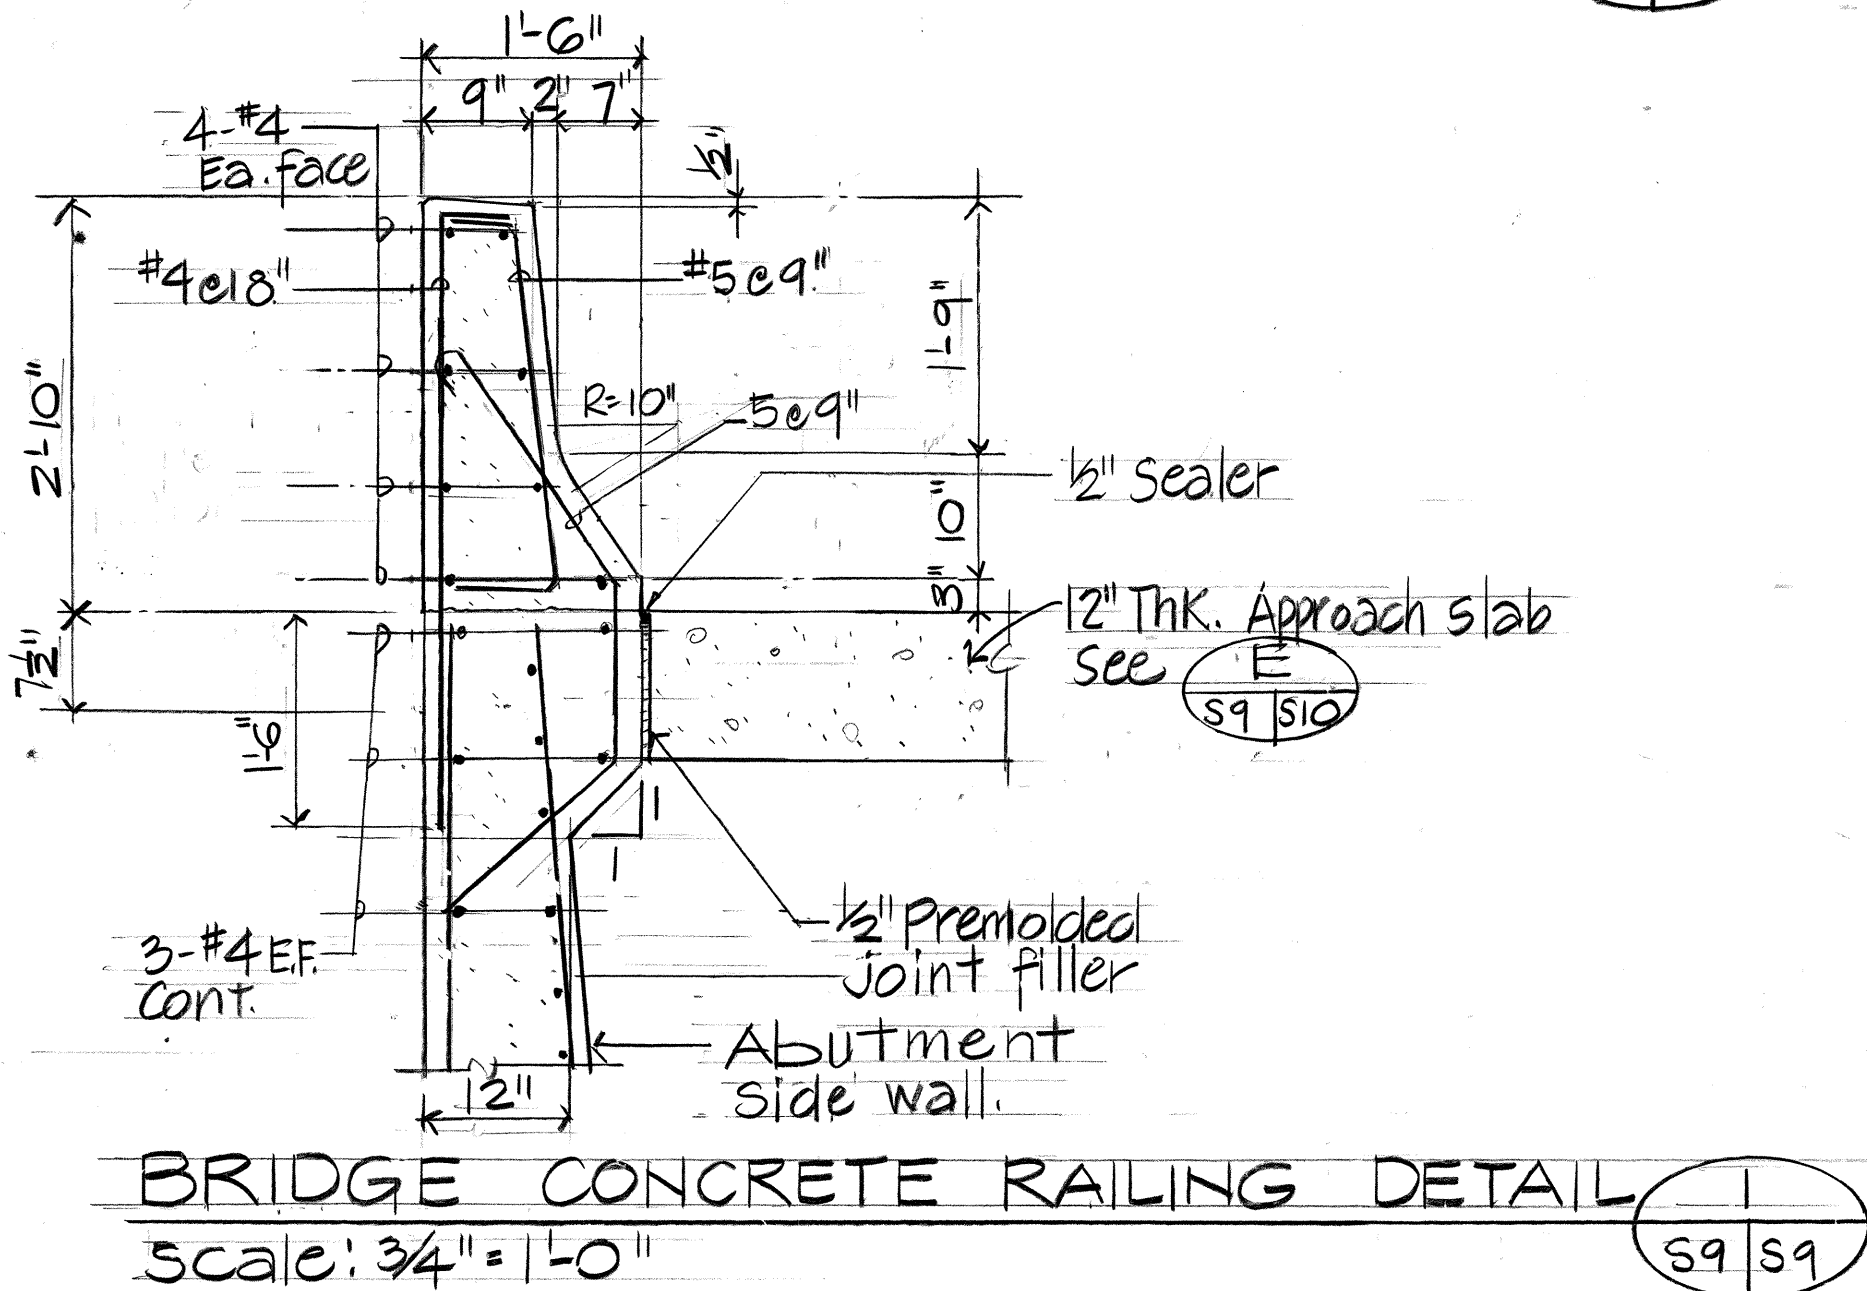

1/10/89 Footing Reinforcing Revised
DATE REVISION

STATE OF HAWAII
DEPARTMENT OF TRANSPORTATION
HIGHWAYS DIVISION










ABUTMENT DETAILS

INTERSTATE ROUTE H-3
F.A.I. PROJECT NO. I-H3-1(52)

SCALE: AS NOTED DATE: JULY 1988
SHEET No. 59 OF 26 SHEETS

THIS WORK WAS PREPARED BY
ME OR UNDER MY SUPERVISION
Myron Okubo

FED. ROAD DIST. NO.	STATE	FED. AID PROJ. NO.	FISCAL YEAR	SHEET NO.	TOTAL SHEETS
HAWAII	HAW.	I-H3-1(52)	1988	44	75

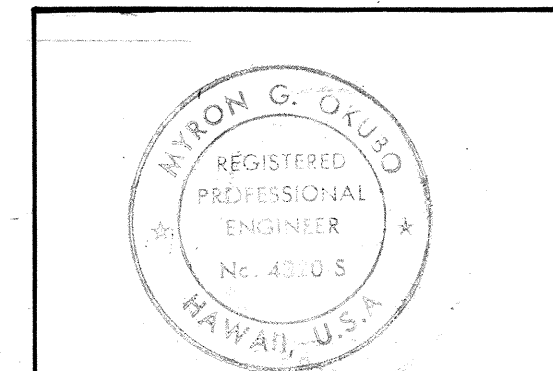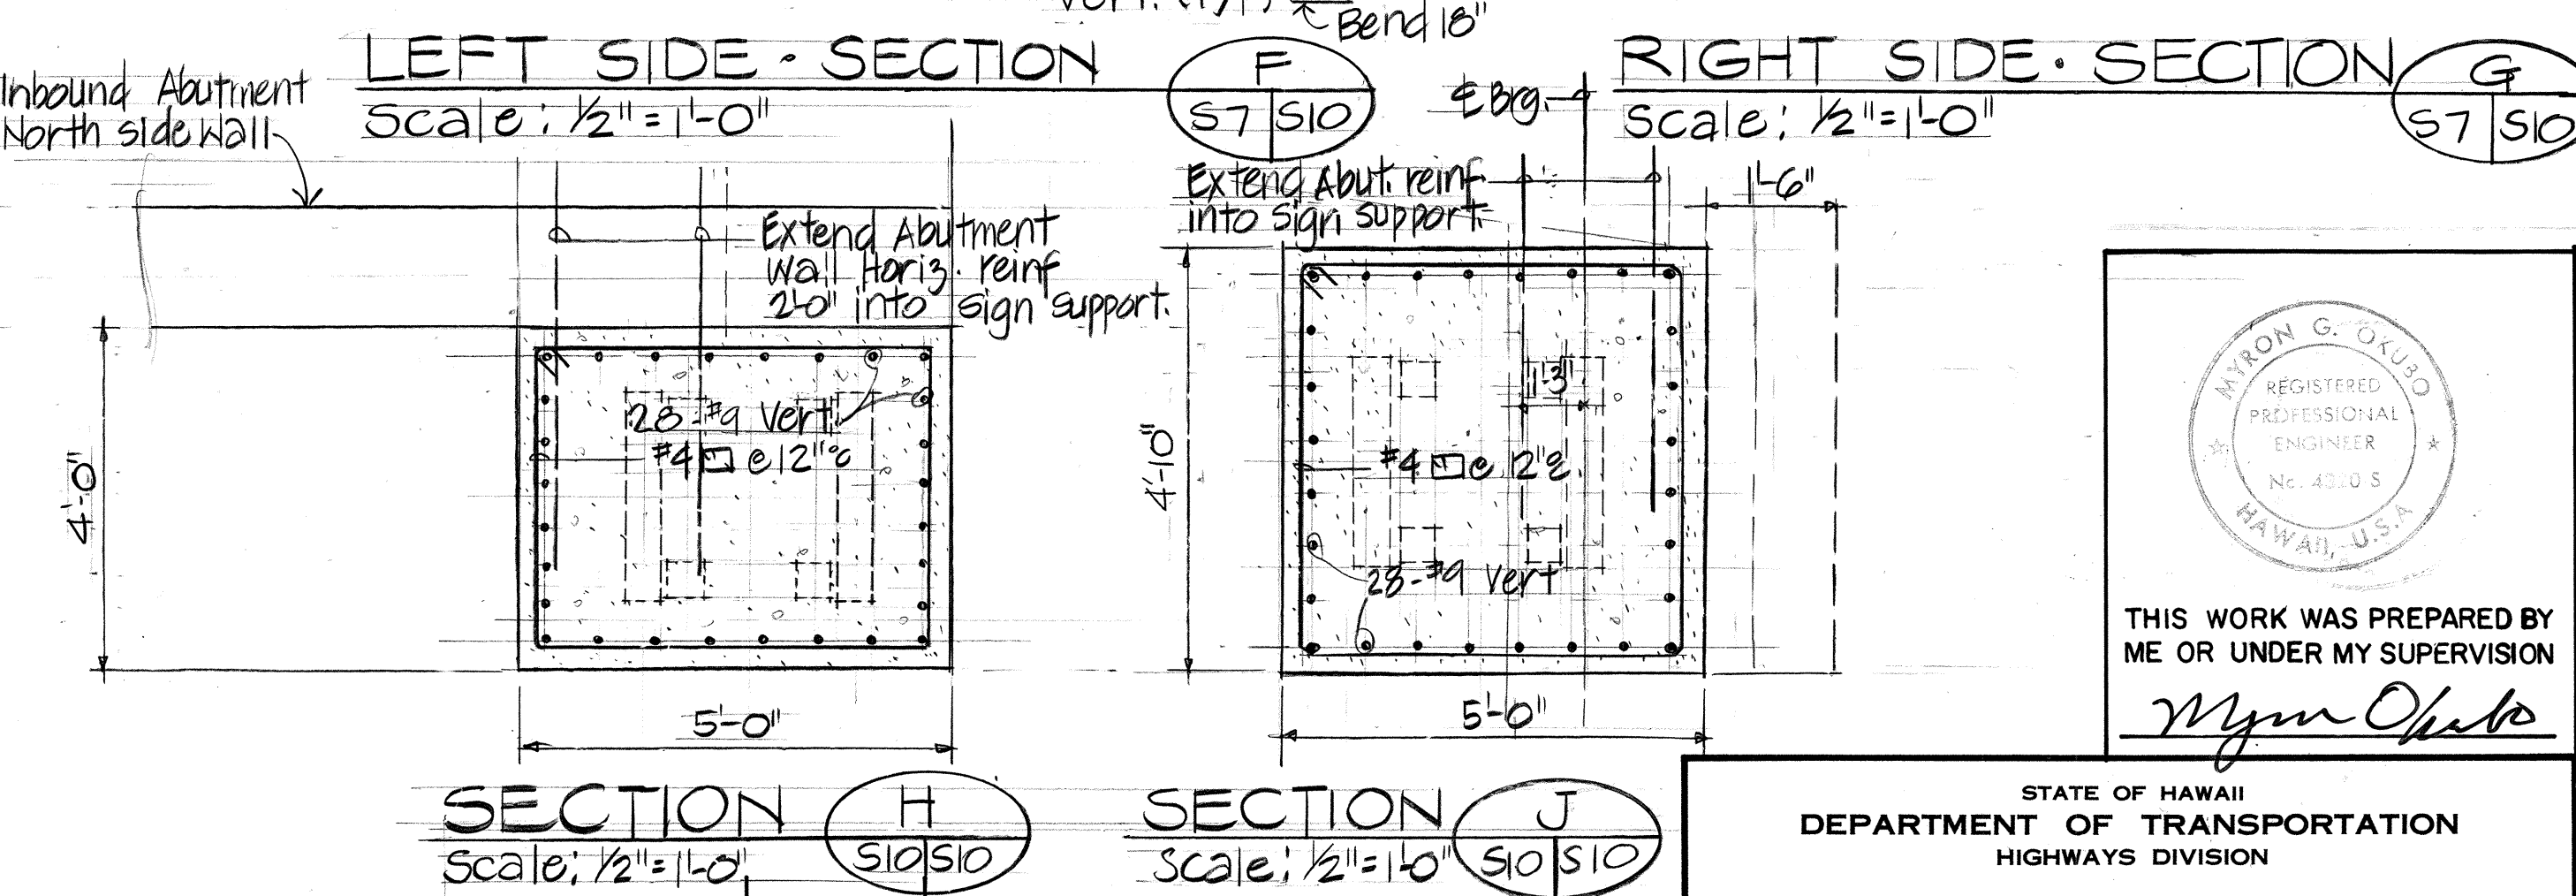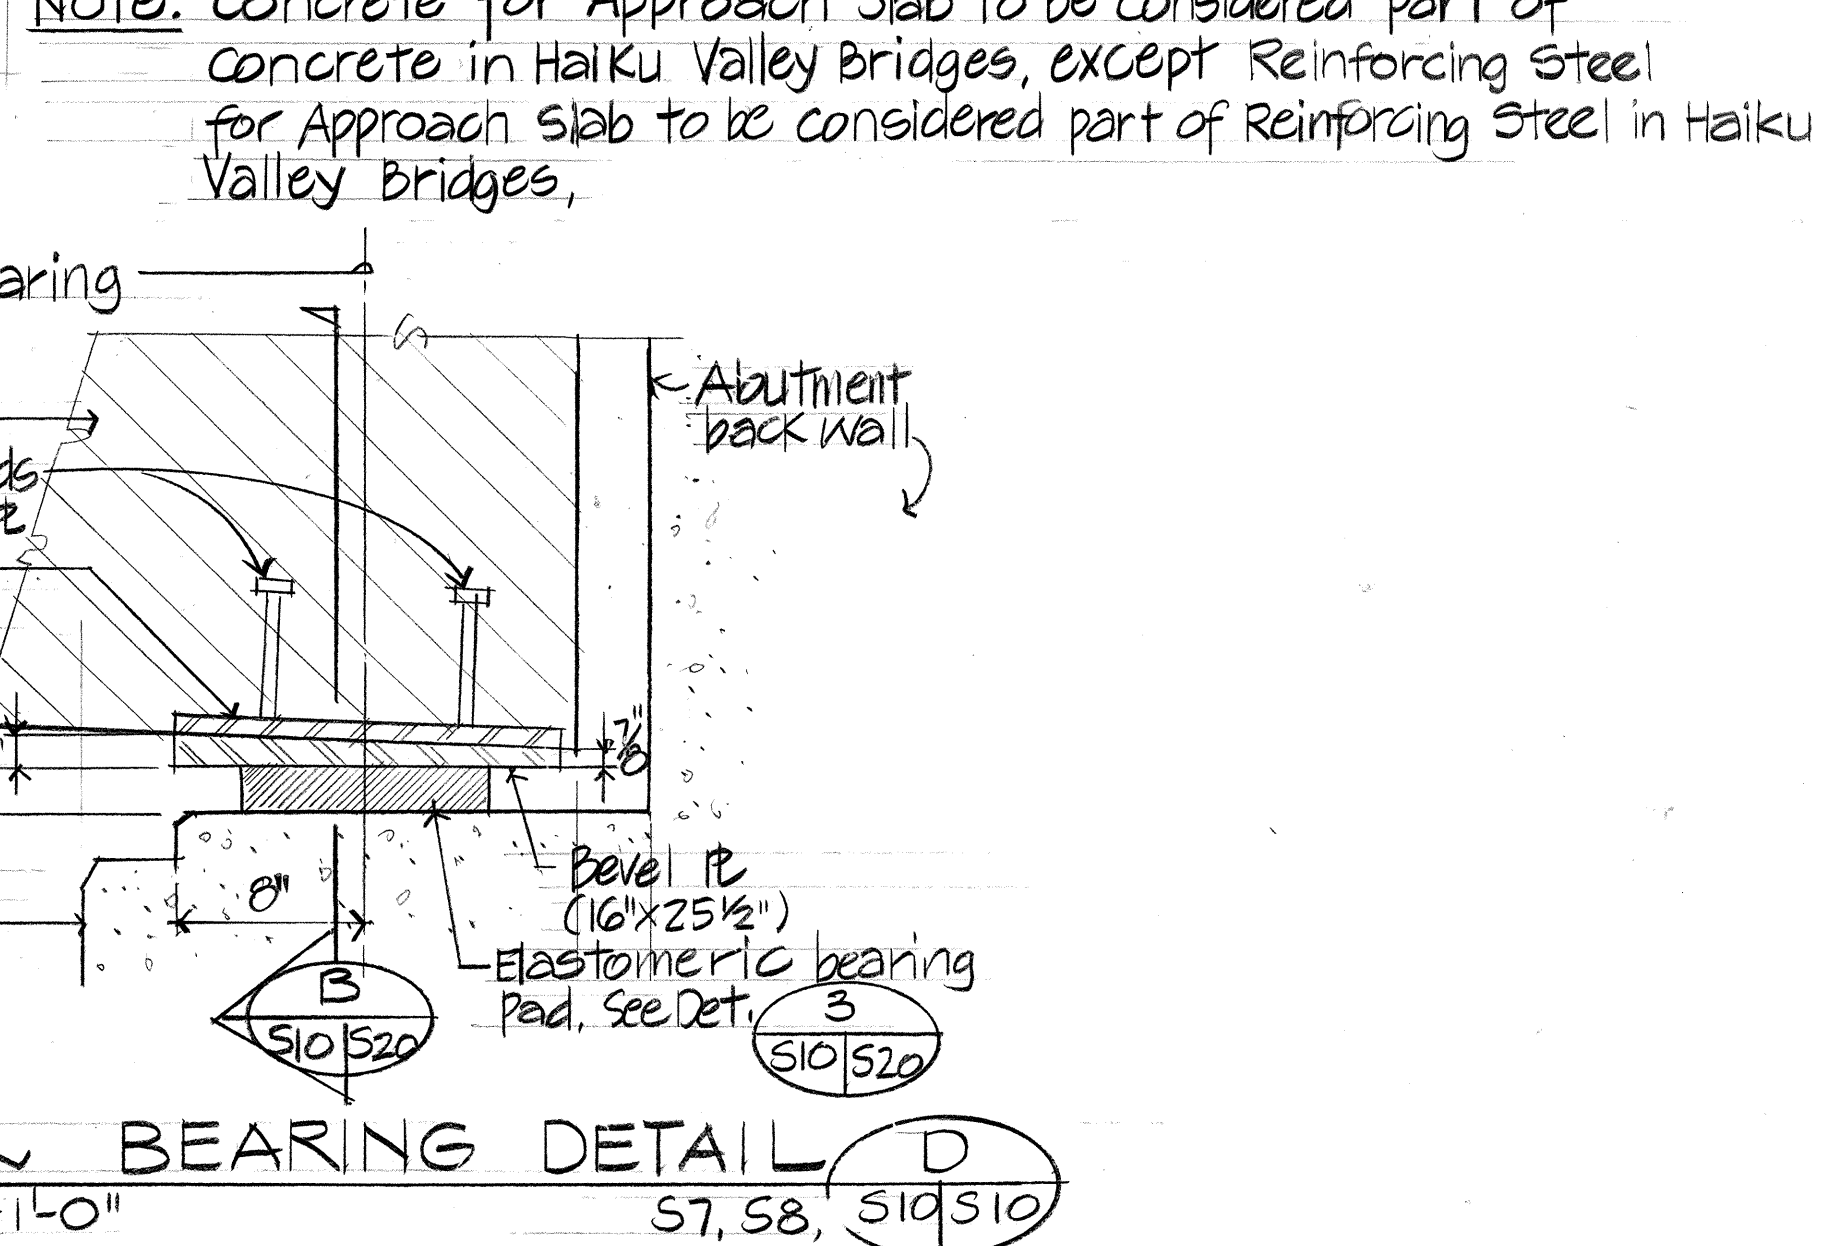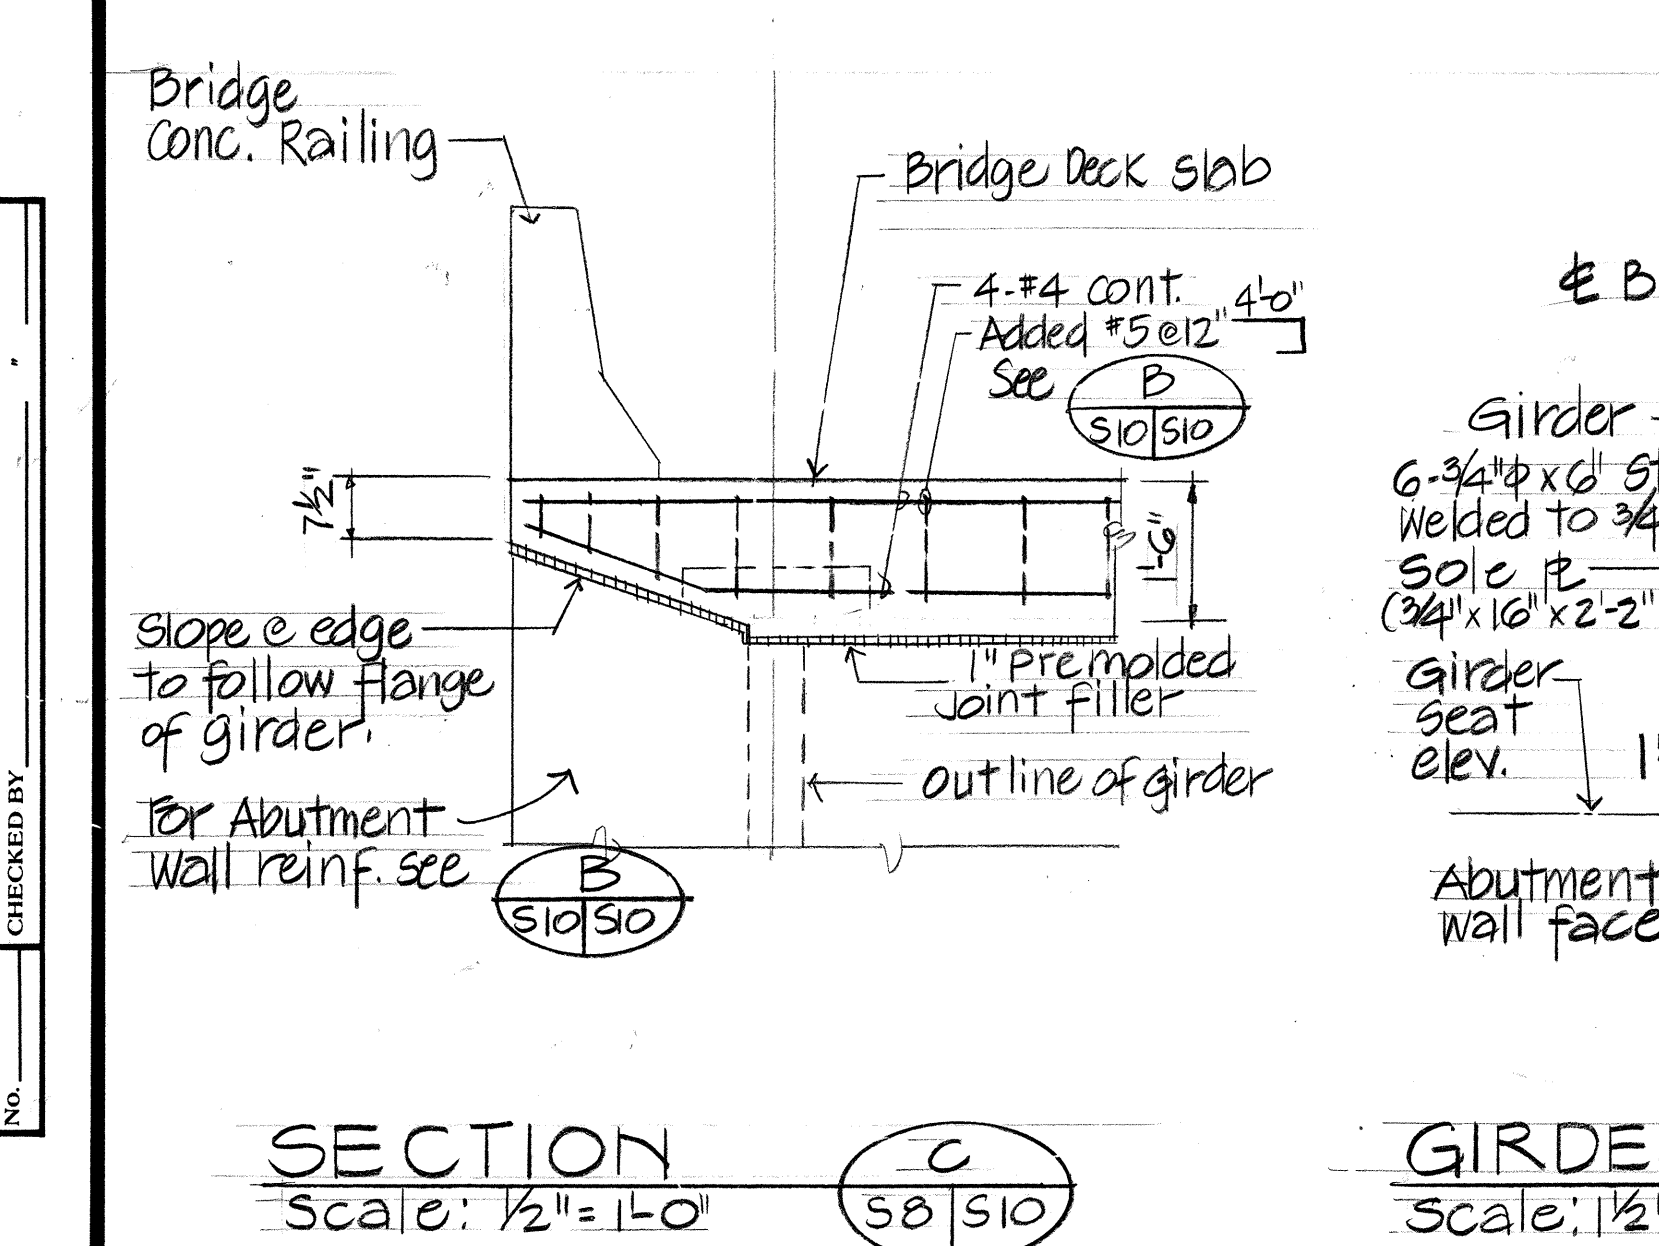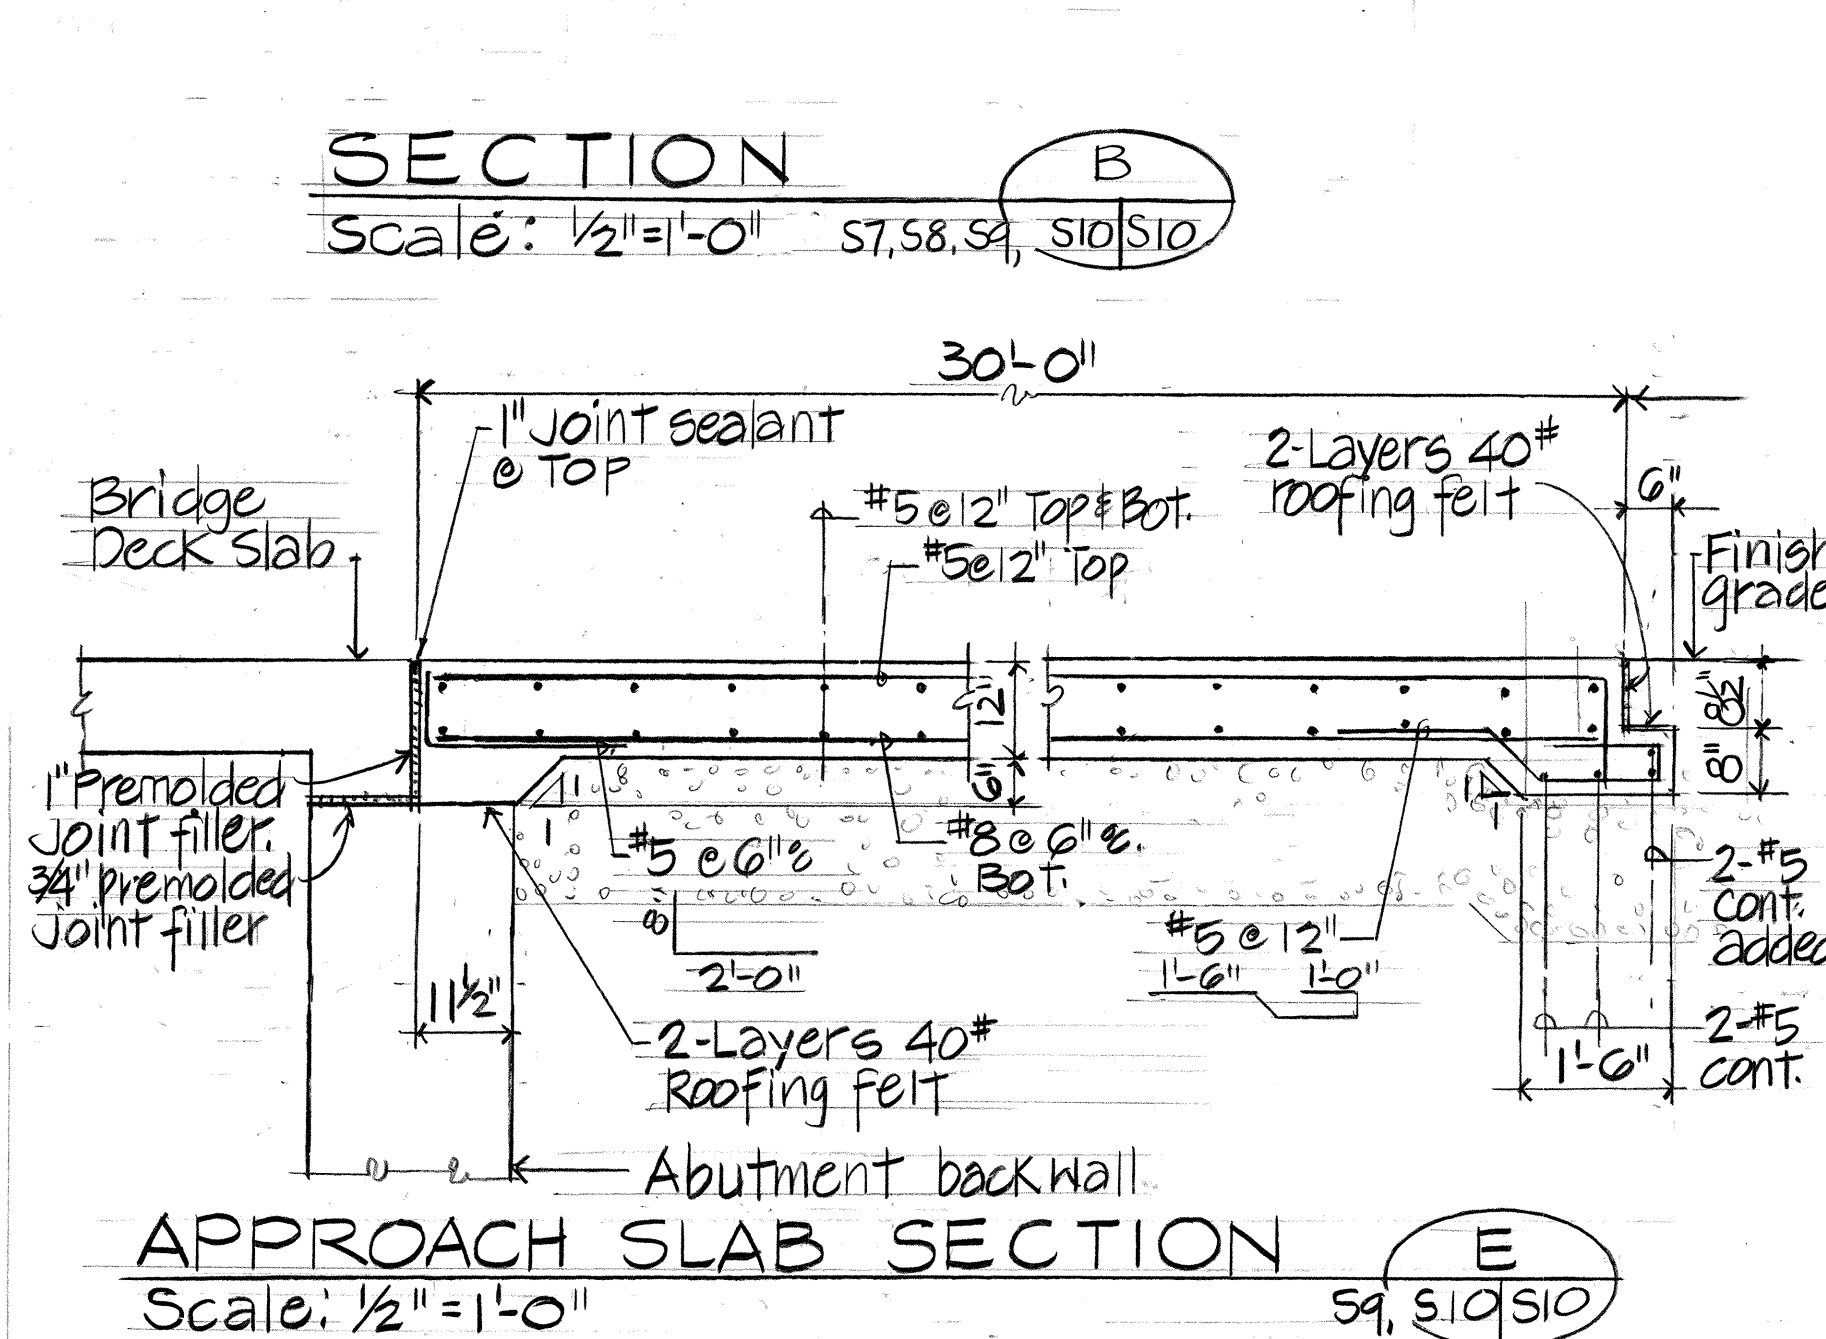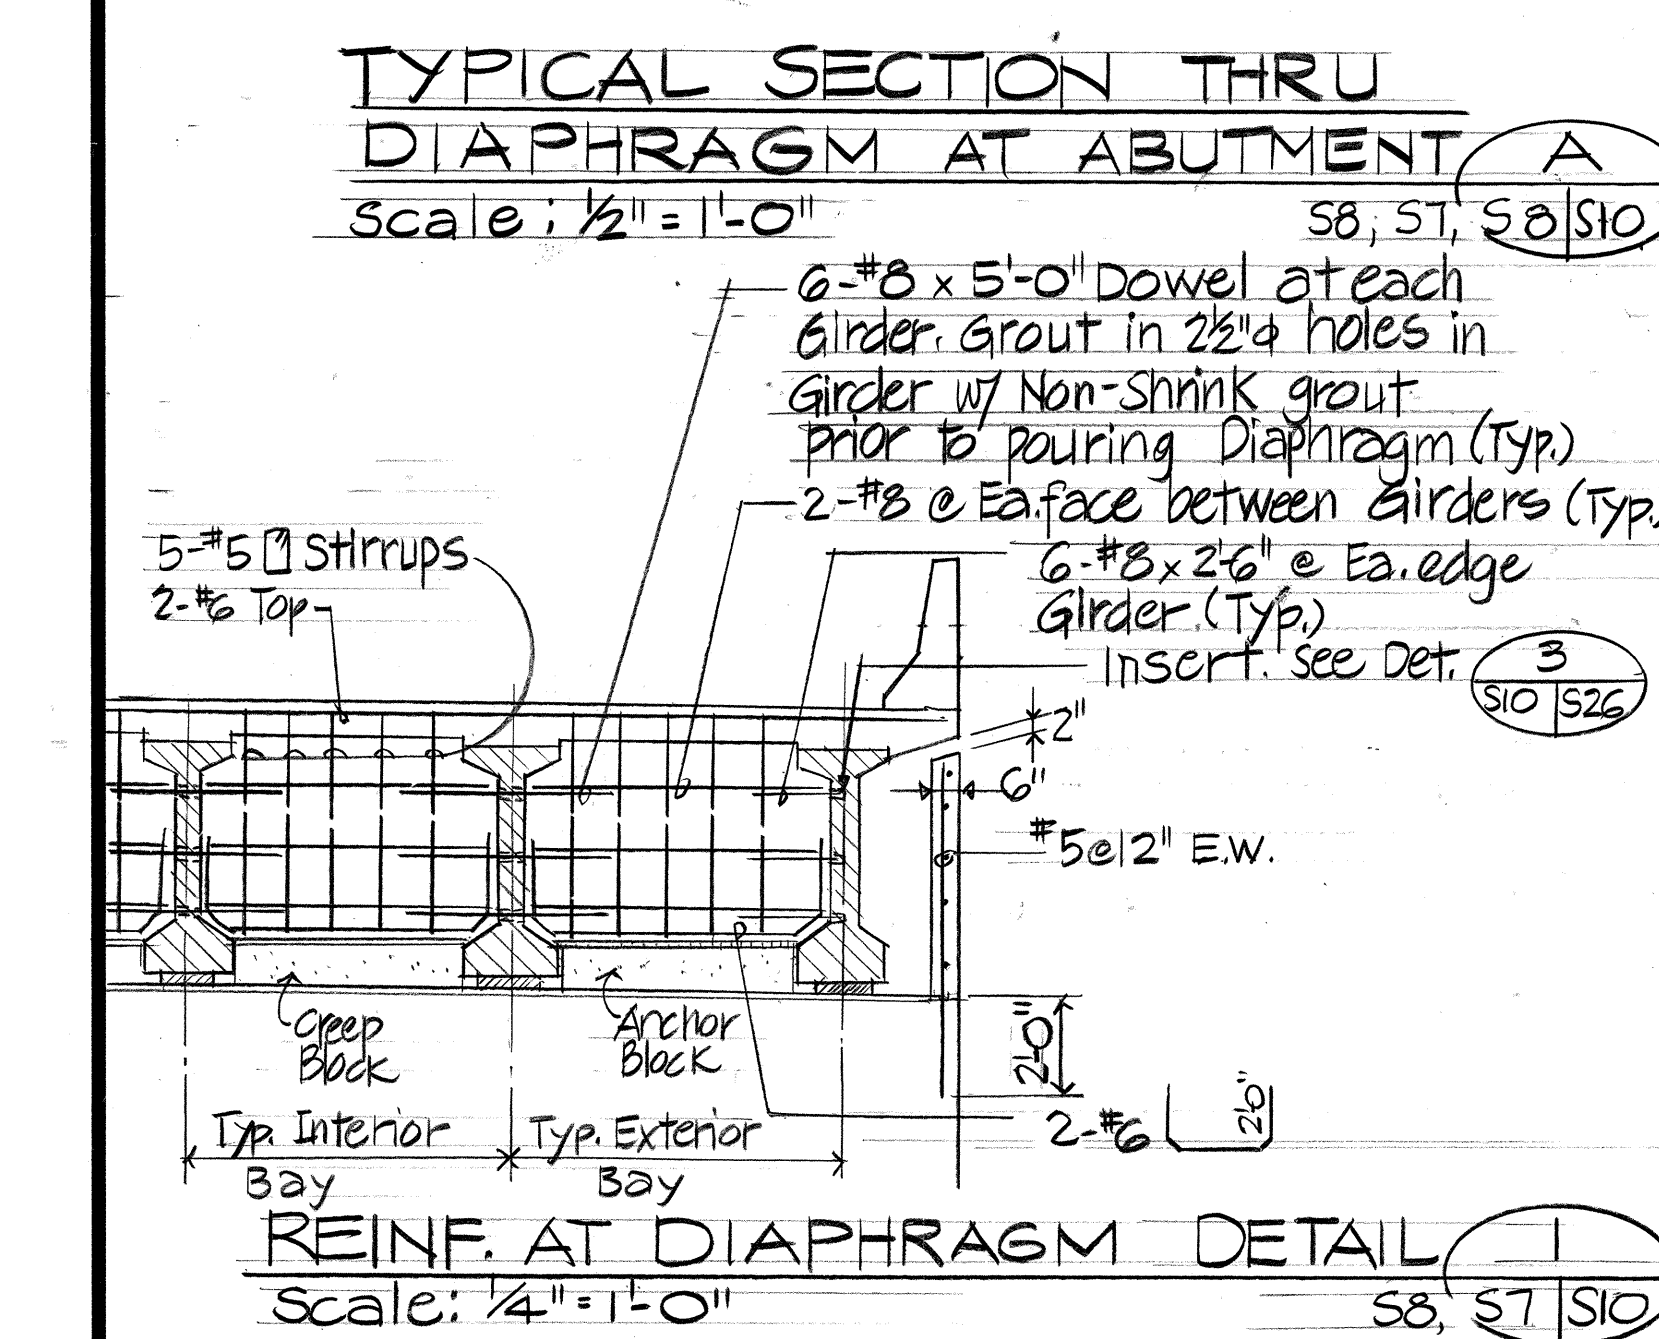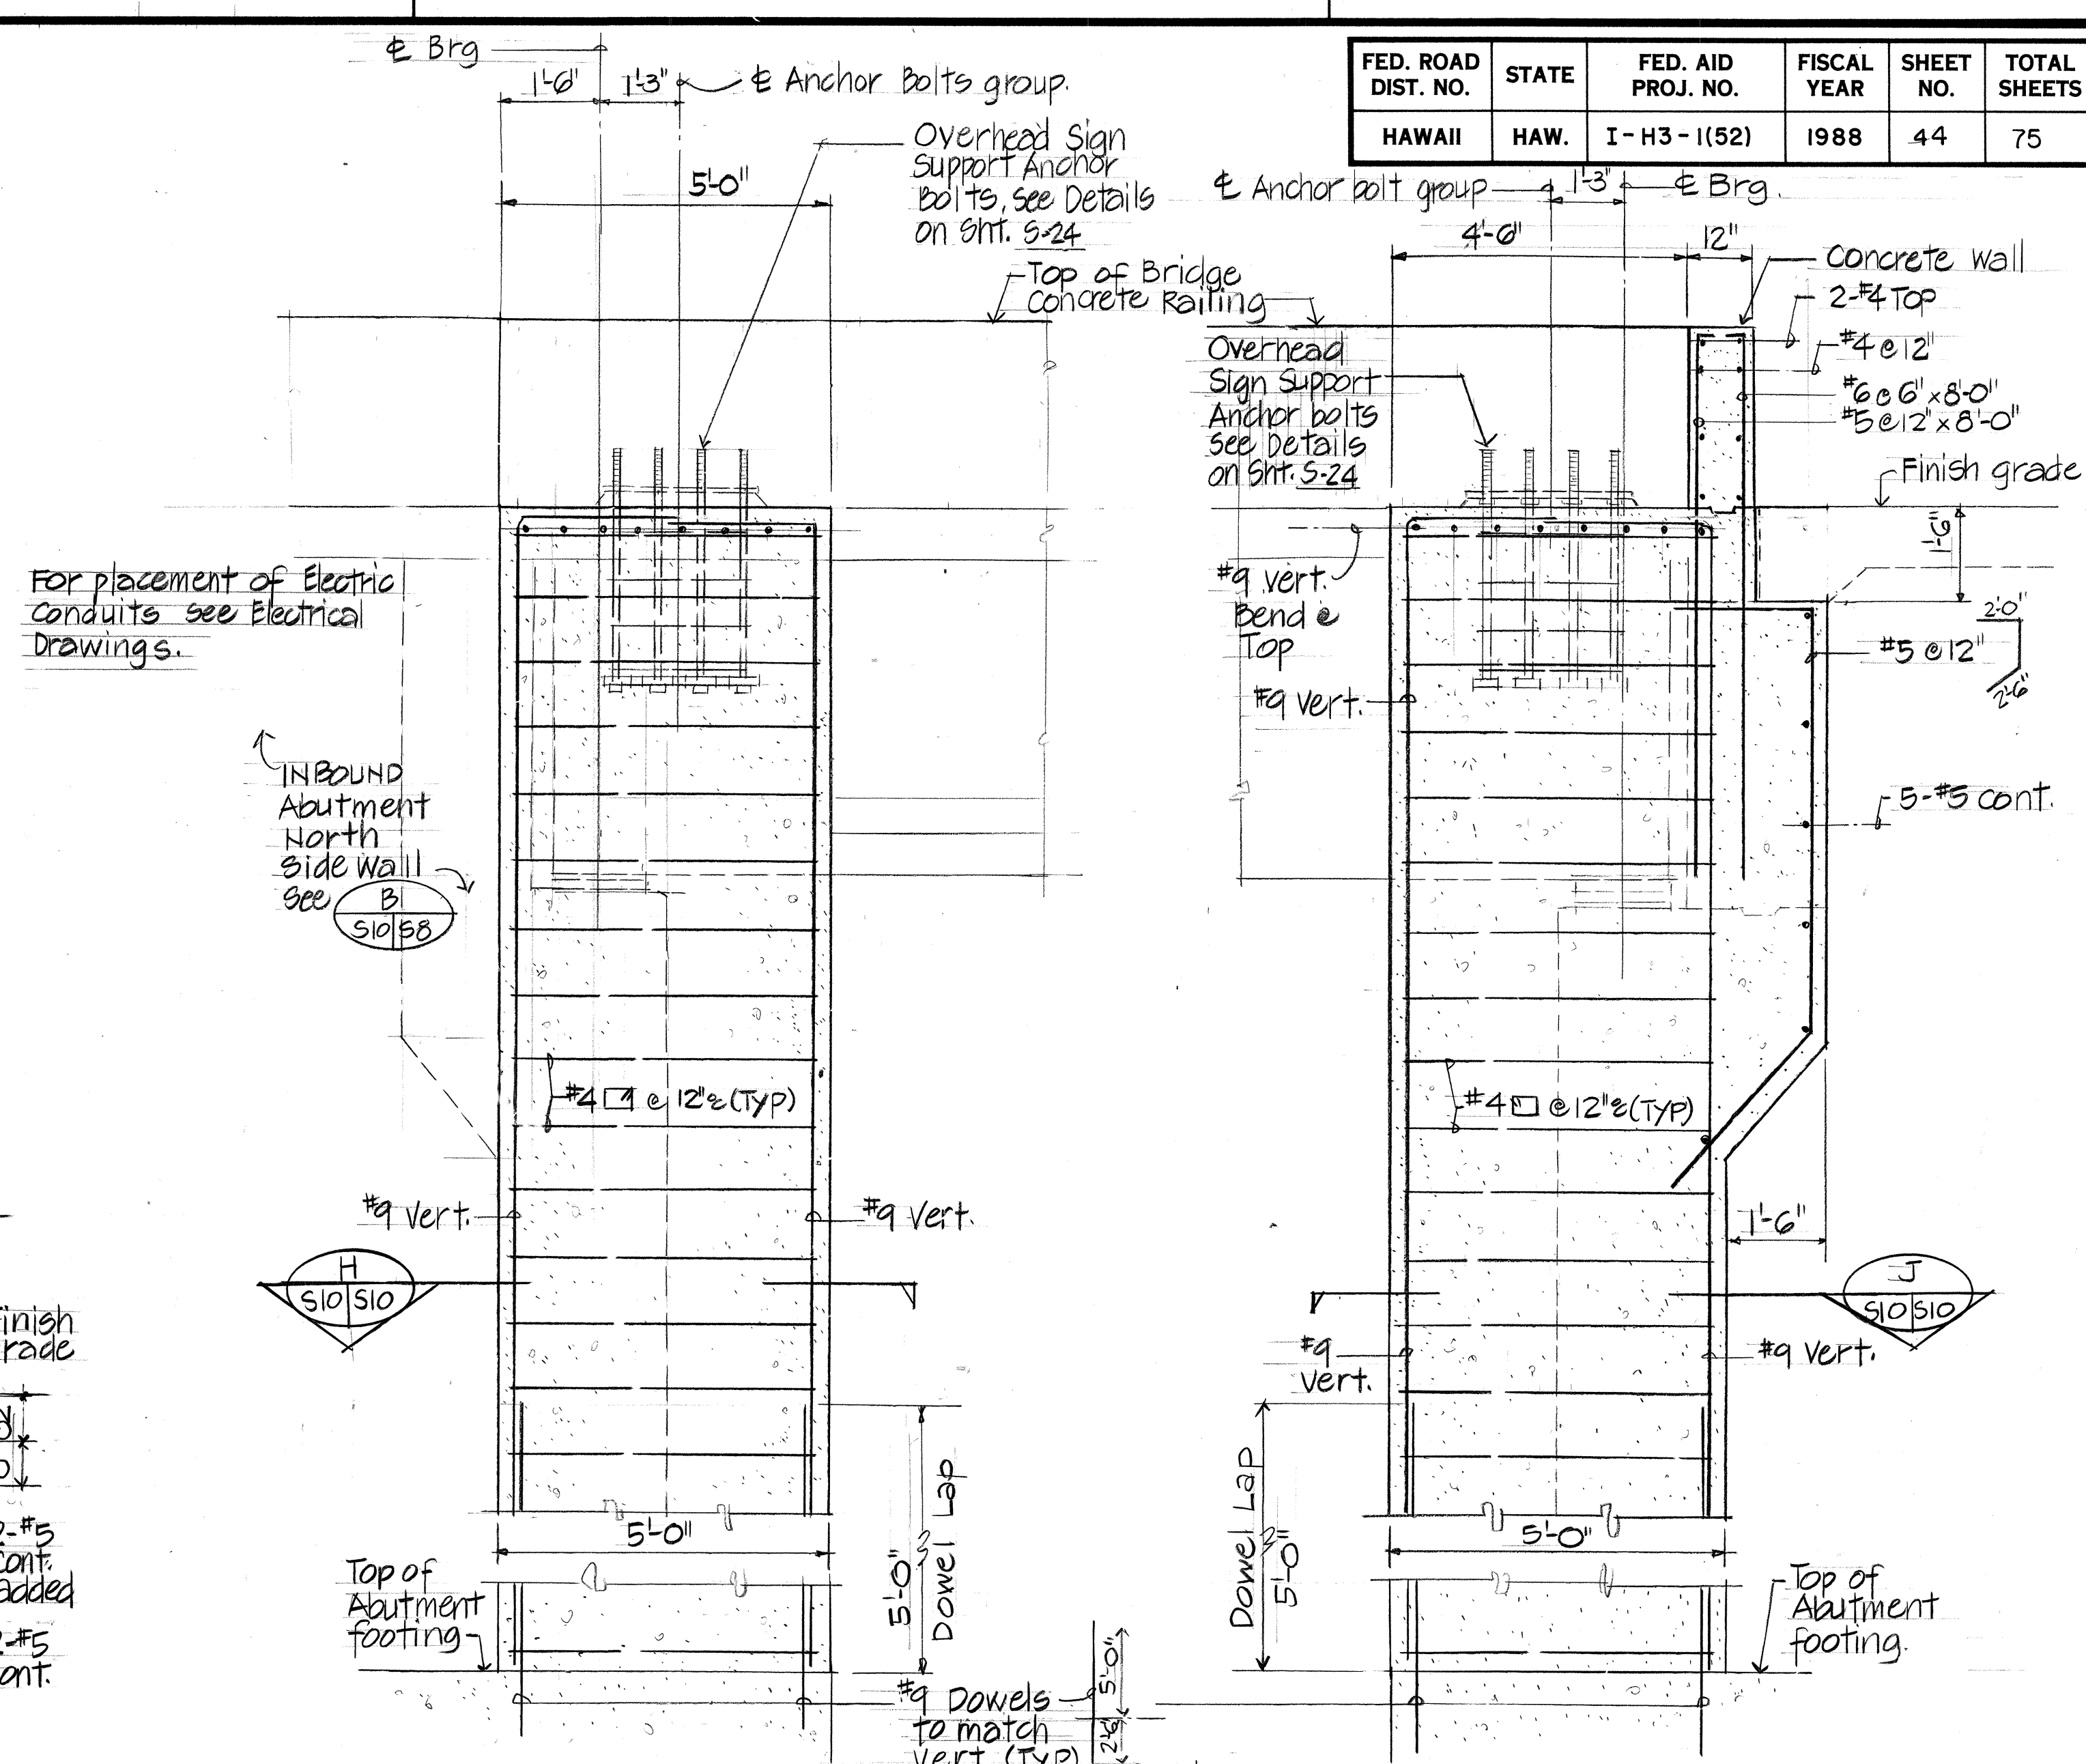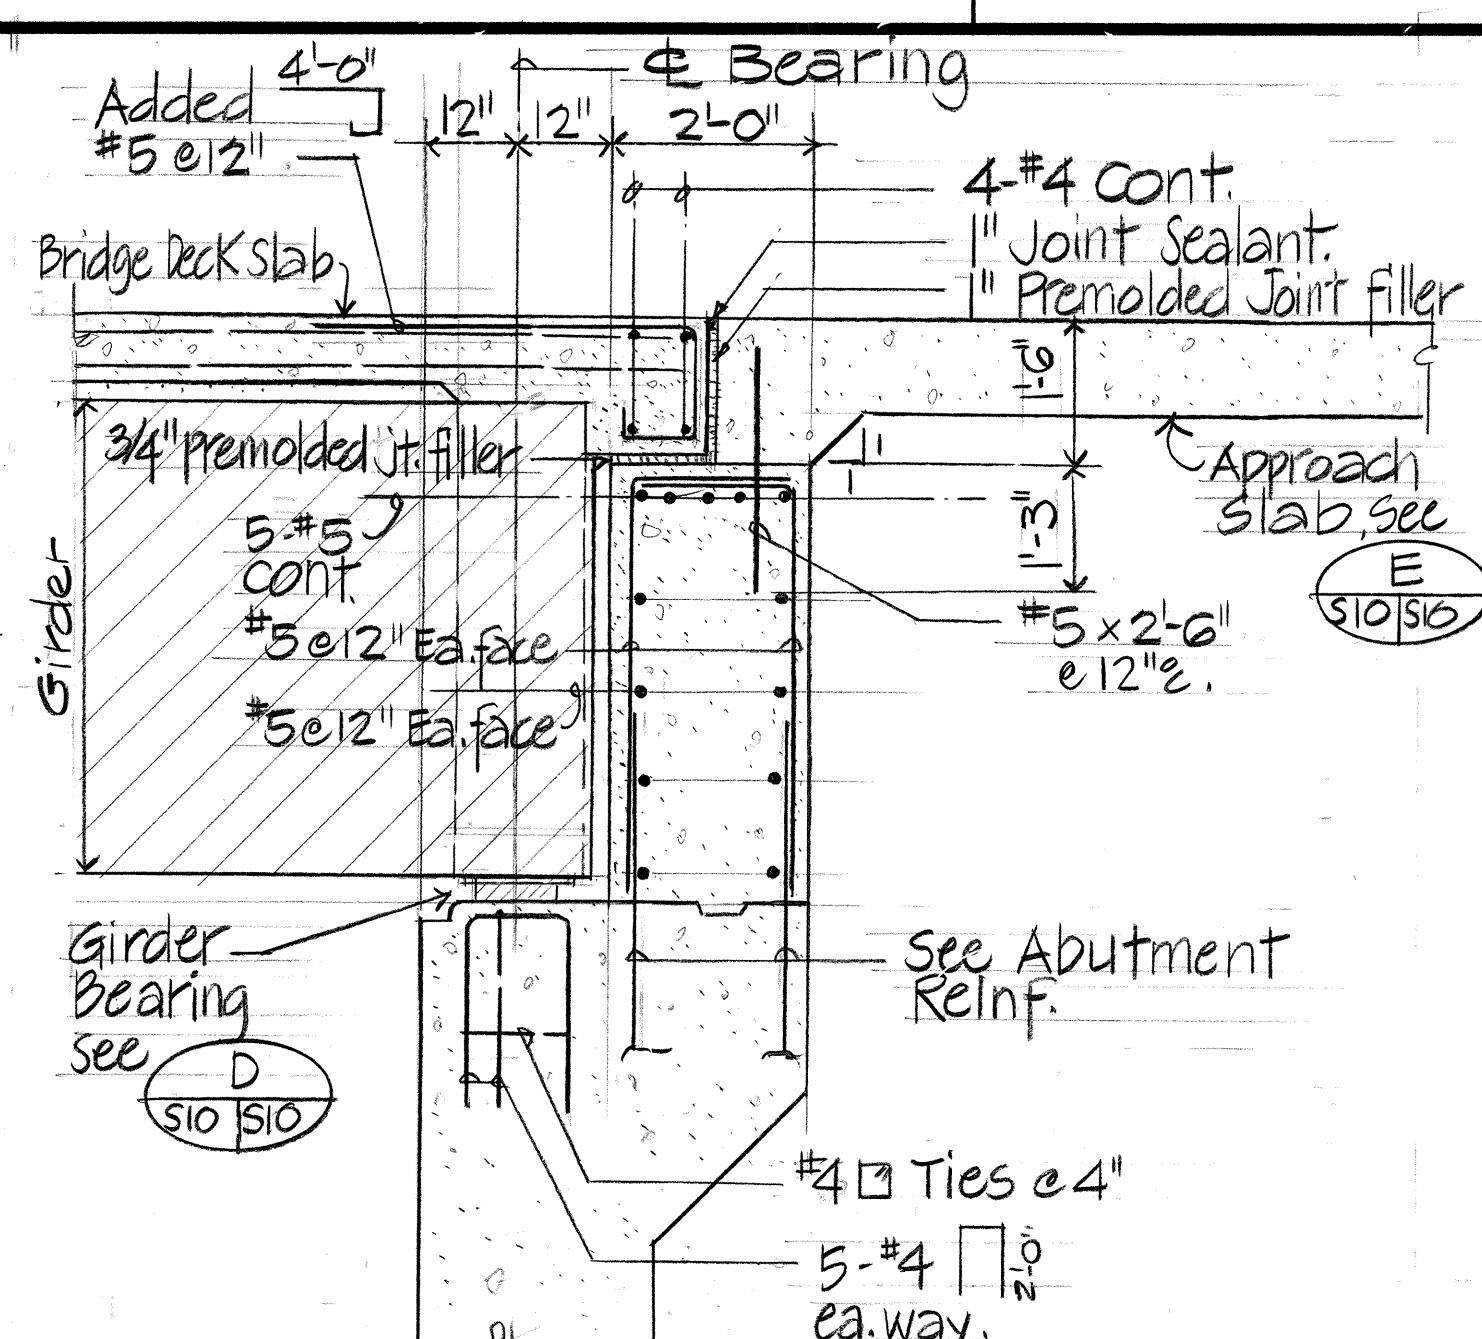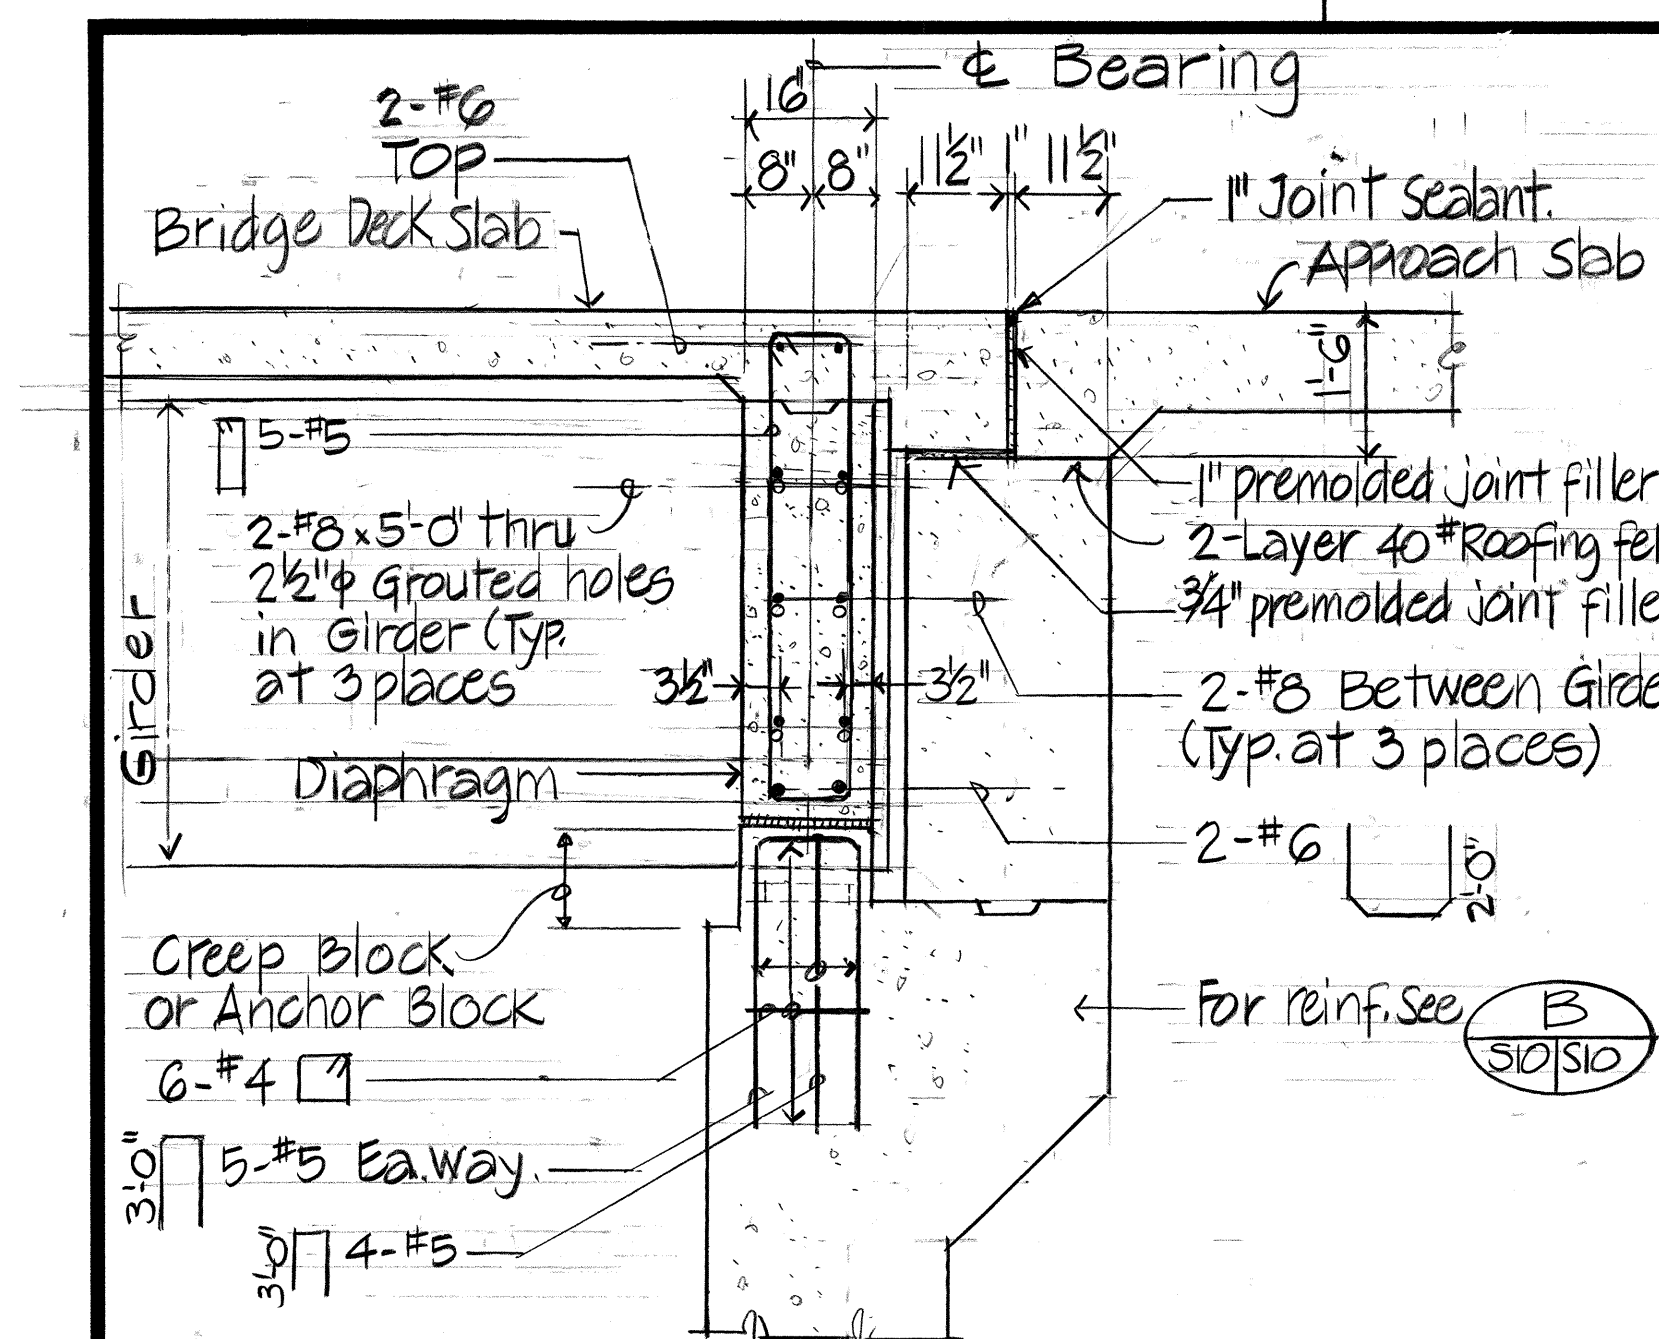

THIS WORK WAS PREPARED BY ME OR UNDER MY SUPERVISION
Myron Okada

STATE OF HAWAII
DEPARTMENT OF TRANSPORTATION
HIGHWAYS DIVISION

ABUTMENT DETAILS

INTERSTATE ROUTE H-3
F.A.I. PROJECT NO. I-H3-1(52)

SCALE: AS NOTED DATE: JULY 1988

SHEET No. 510 OF 526 SHEETS

1/10/89 Detail D Revised
DATE REVISION

AS BUILT


ADD. 44

SURVEY PLOTTED BY	DATE
DRAWN BY	
DESIGNED BY	
QUANTITIES BY	
CHECKED BY	
ORIGINAL PLAN	
NOTE BOOK	
NO.	

FED. ROAD DIST. NO.	STATE	FED. AID PROJ. NO.	FISCAL YEAR	SHEET NO.	TOTAL SHEETS
HAWAII	HAW.	I-H-3-1(52)	1988	45	75

FOOTING SCHEDULE


TYPE OF FOOTING	FOOTING			PEDESTAL			BOT. REINFORCEMENT		TOP REINFORCEMENT		REMARKS
	L1	L2	t1	D1	D2	t2	L1, reinf.	L2, reinf.	L1, reinf.	L2, reinf.	
F-1	23'-0"	23'-0"	5'-0"	—	—	—	24-#9x22'-6"	48-#11x22'-0"	#6 @ 12" E.	#6 @ 12" E.	
F-2	28'-0"	32'-0"	3'-6"	20'-0"	18'-0"	2'-6"	33-#11x27'-6"	68-#11x31'-6"	#6 @ 12" E.	#6 @ 12" E.	
PF-1	27'-0"	28'-0"	7'-0"	—	—	—	29-#11x26'-6"	54-#14	#6 @ 12" E.	#6 @ 12" E.	
PF-2	23'-0"	23'-0"	7'-0"	—	—	—	24-#11x22'-6"	48-#11x22'-6"	#6 @ 12" E.	#6 @ 12" E.	
PF-3	27'-0"	33'-0"	6'-4"	—	17'-0"	3'-6"	33-#14	55-#14	#6 @ 12" E.	#6 @ 12" E.	
PF-4	28'-0"	33'-0"	5'-0"	—	17'-0"	3'-6"	40-#14	52-#14	#6 @ 12" E.	#6 @ 12" E.	

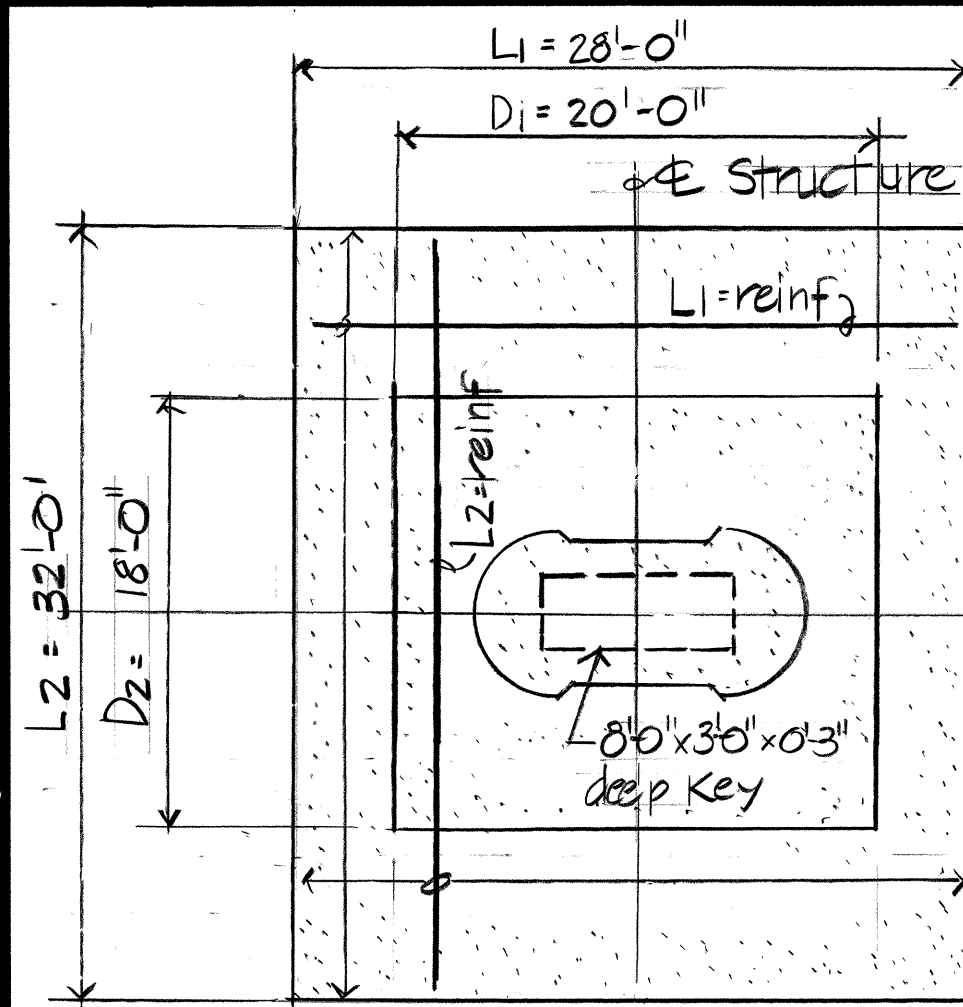


PLAN

FOOTING TYPE F-2

Not to scale

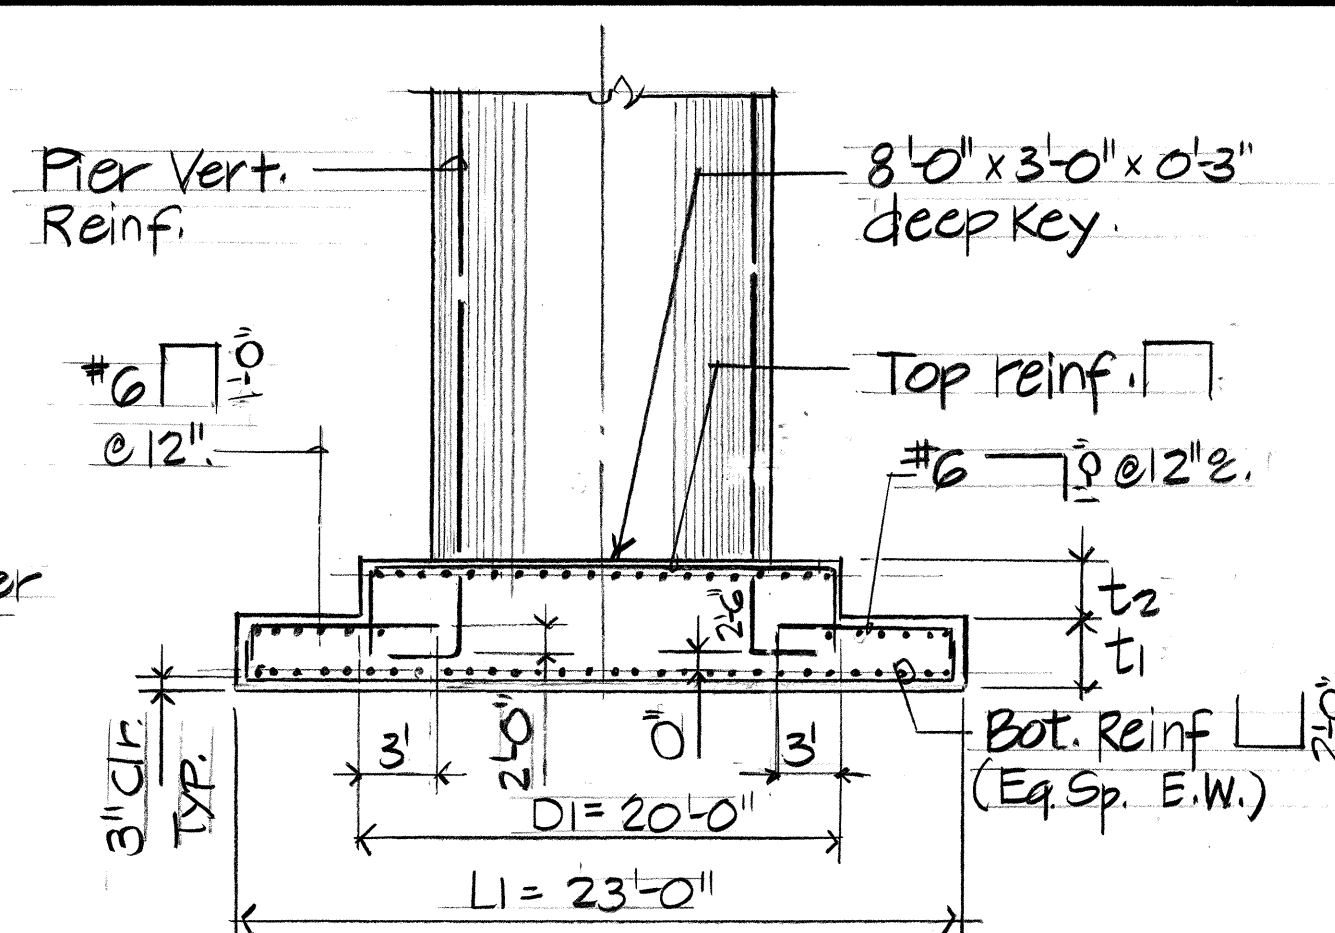


ELEVATION

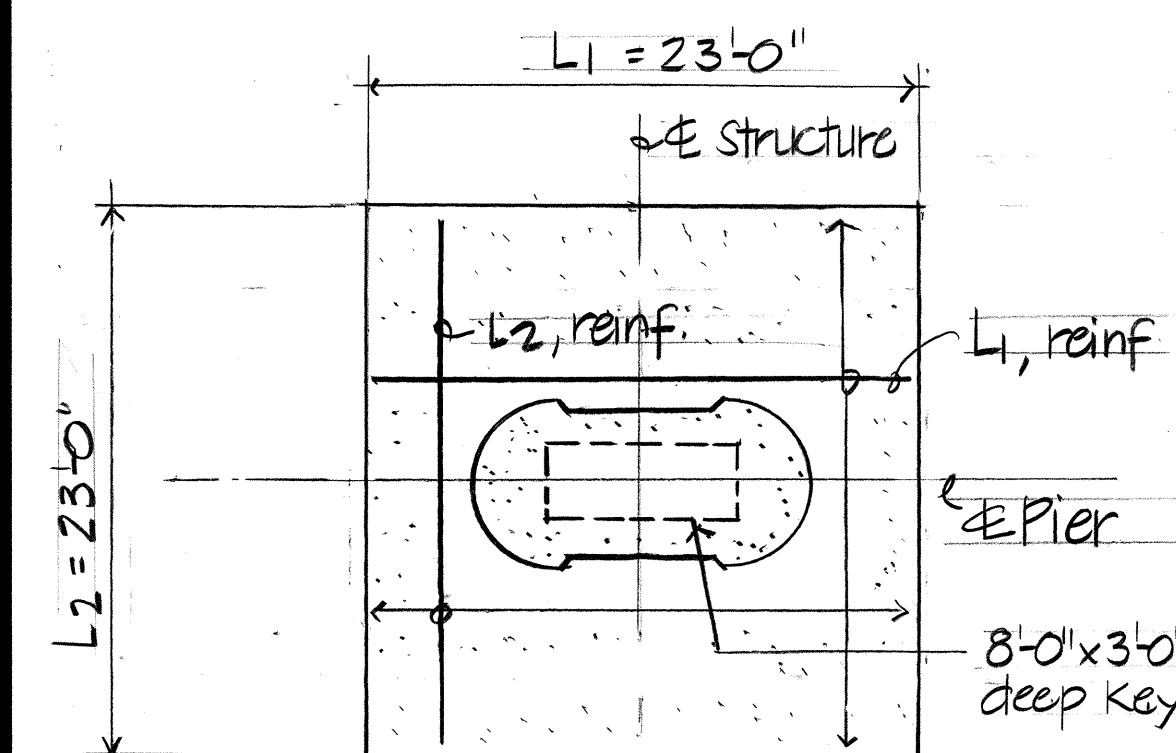


PLAN

FOOTING TYPE F-1

Not to scale

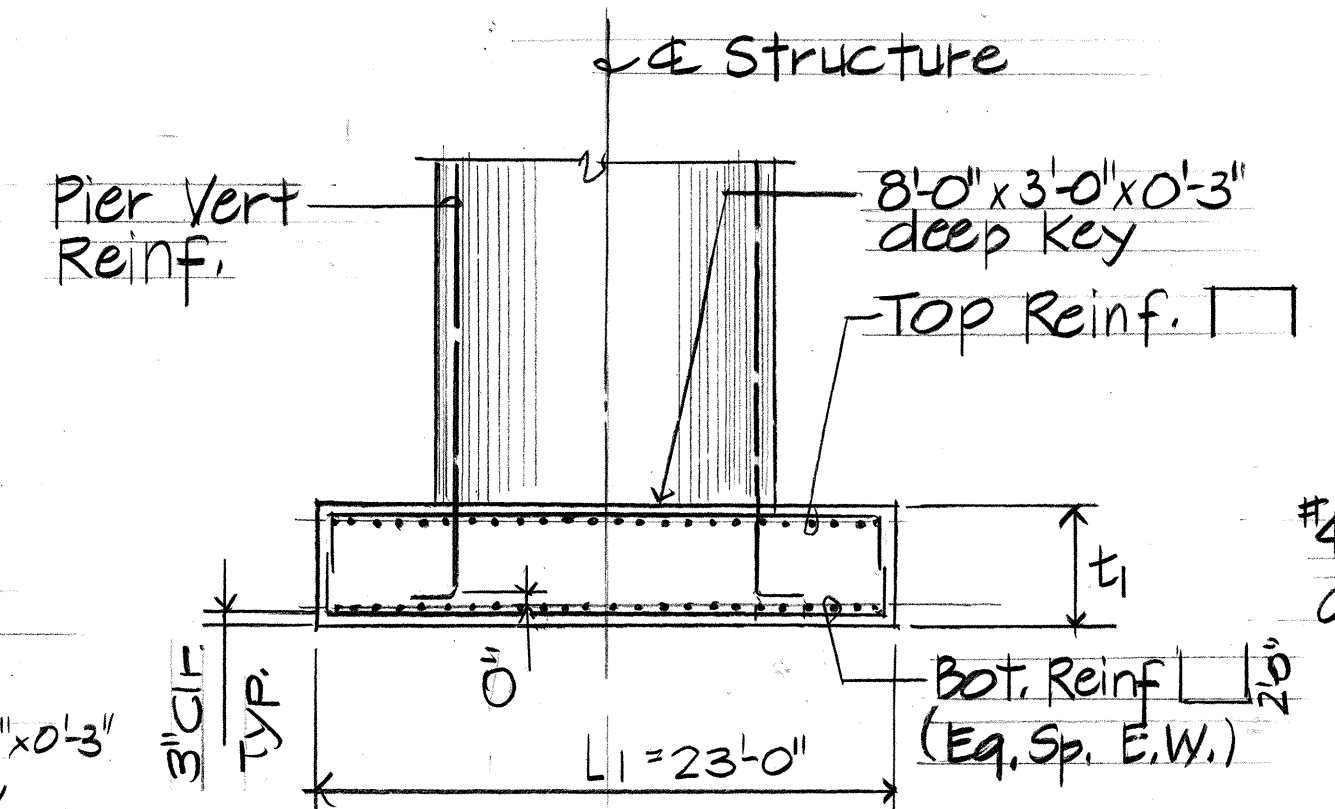


ELEVATION

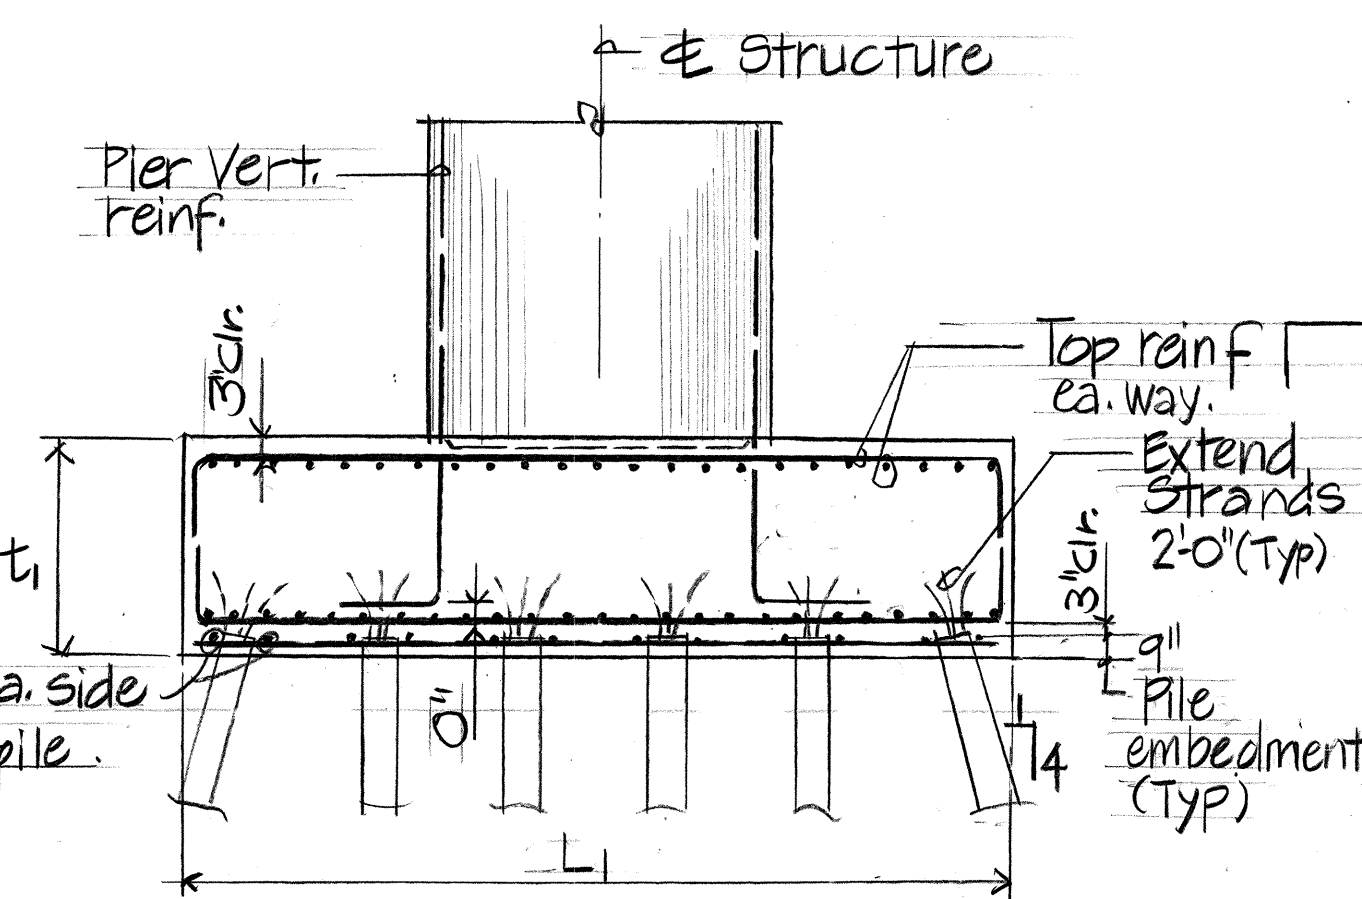

ELEVATION

FOOTING TYPE PF-1 & PF-2


Not to scale

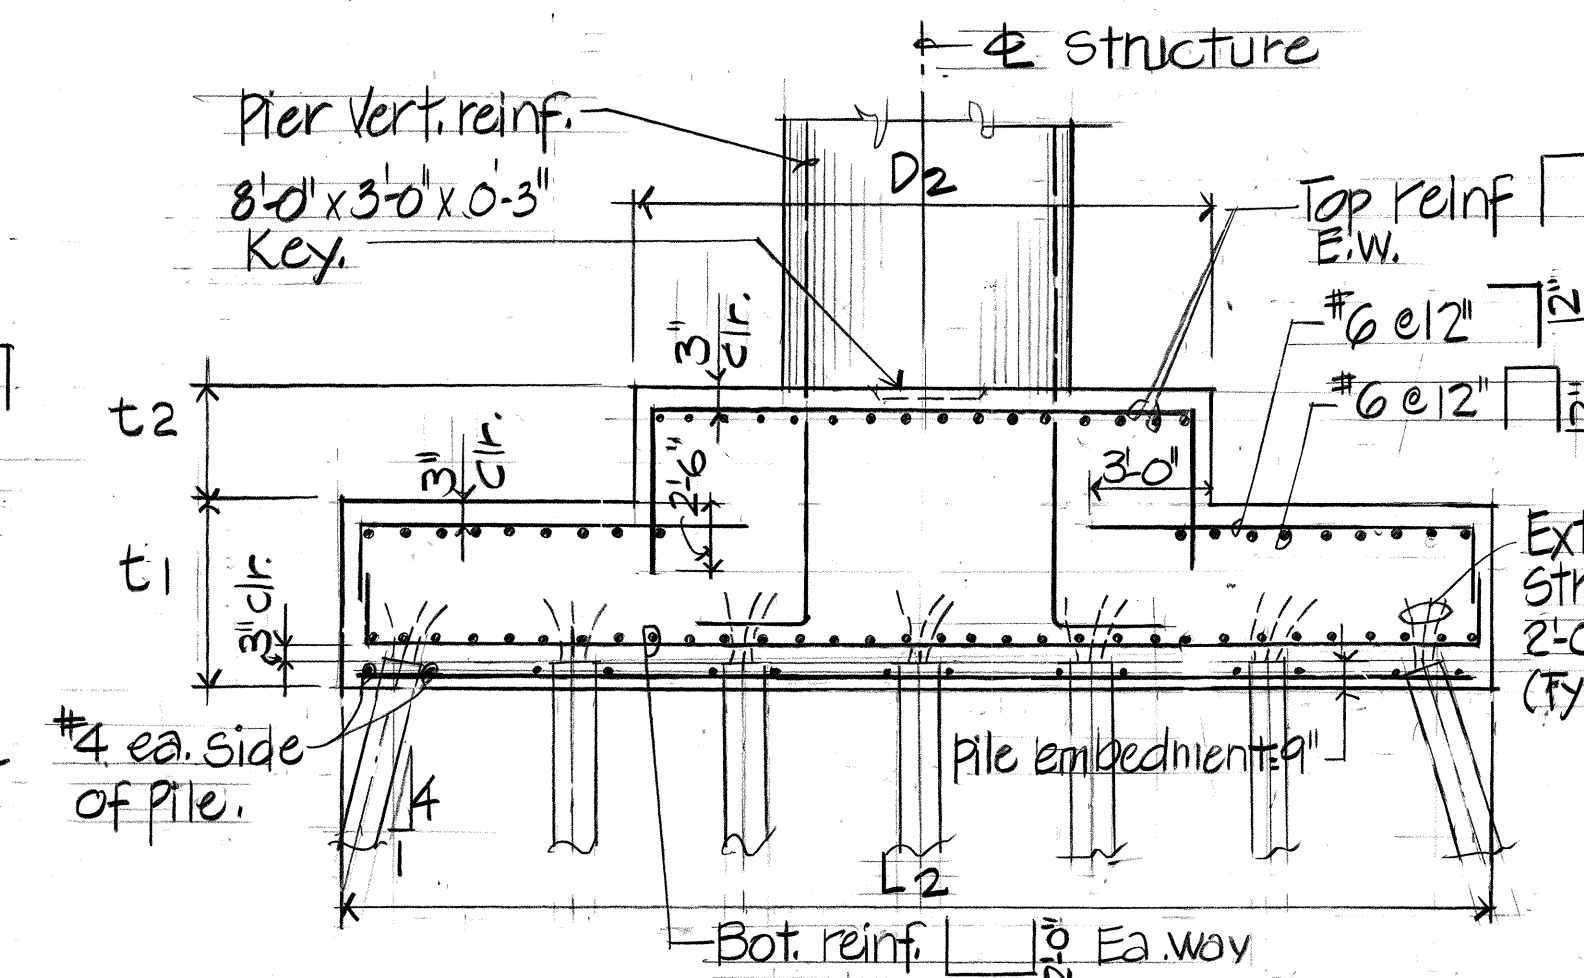

ELEVATION

FOOTING TYPE PF-3 & PF-4


Not to scale

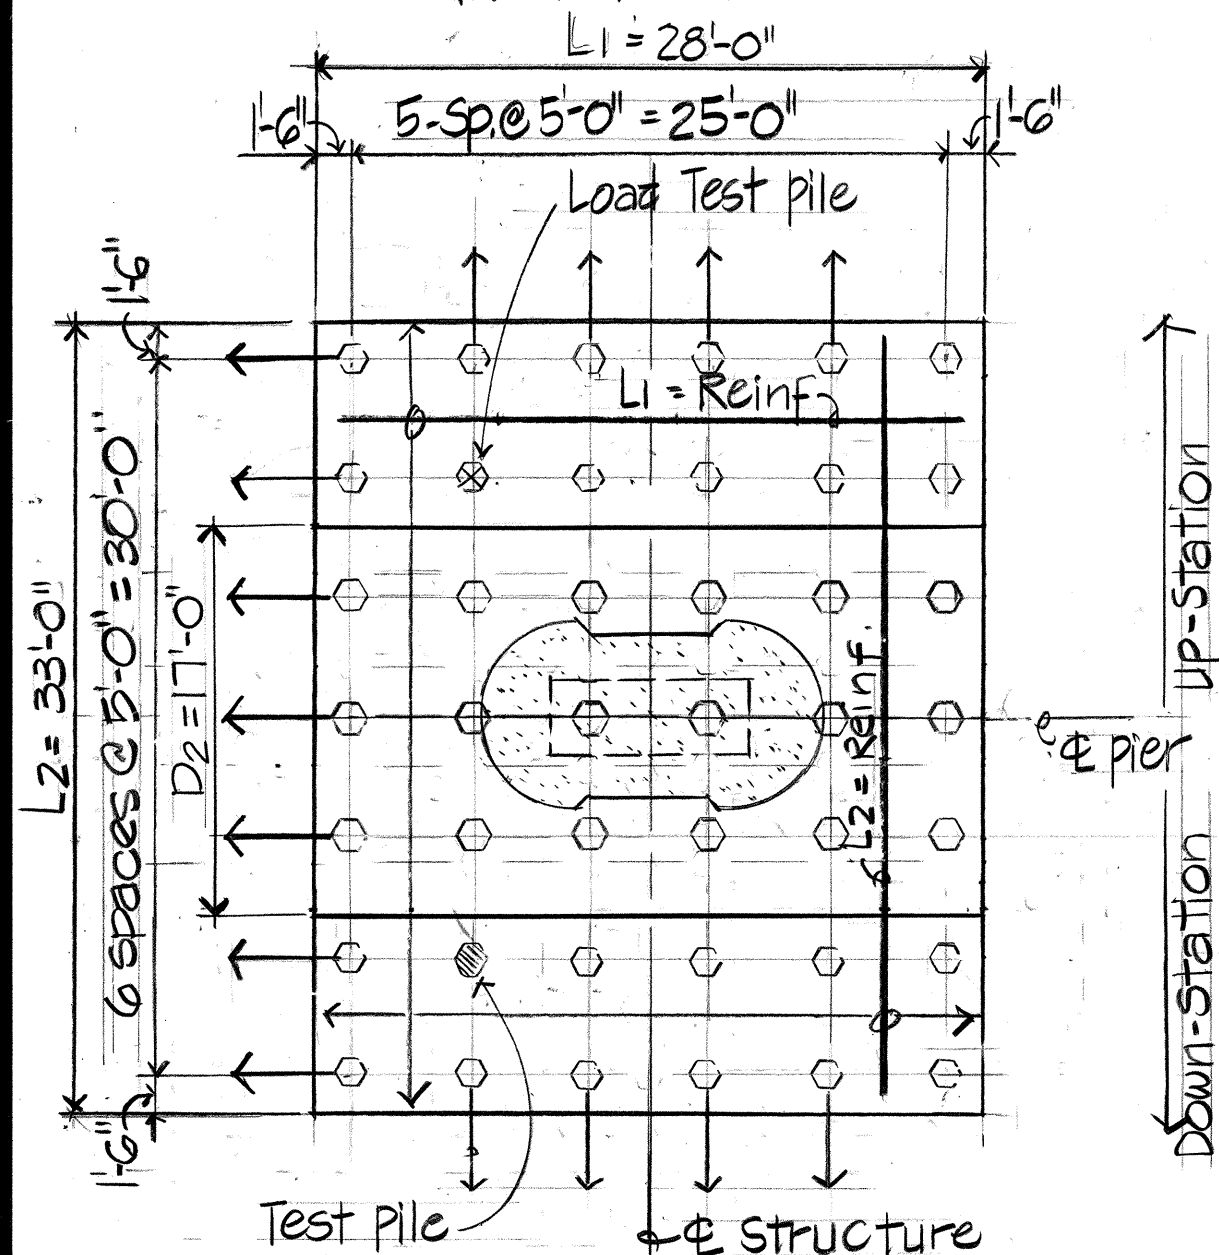

PLAN

FOOTING TYPE PF-4


Scale: 1/8" = 1'-0"

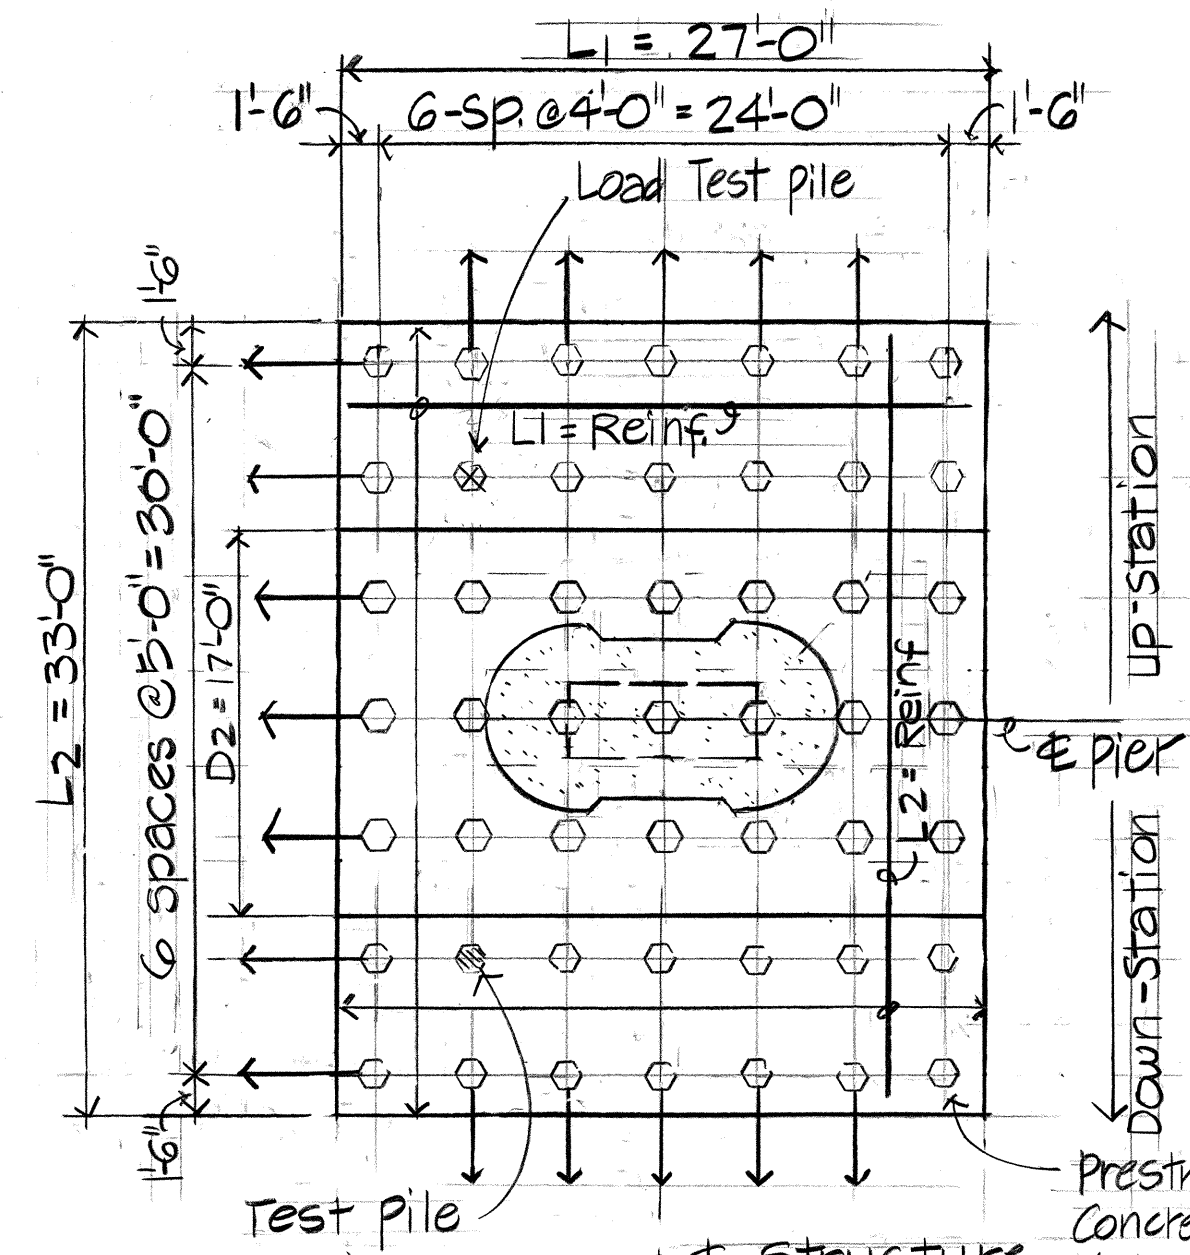

PLAN

FOOTING TYPE PF-3


Scale: 1/8" = 1'-0"

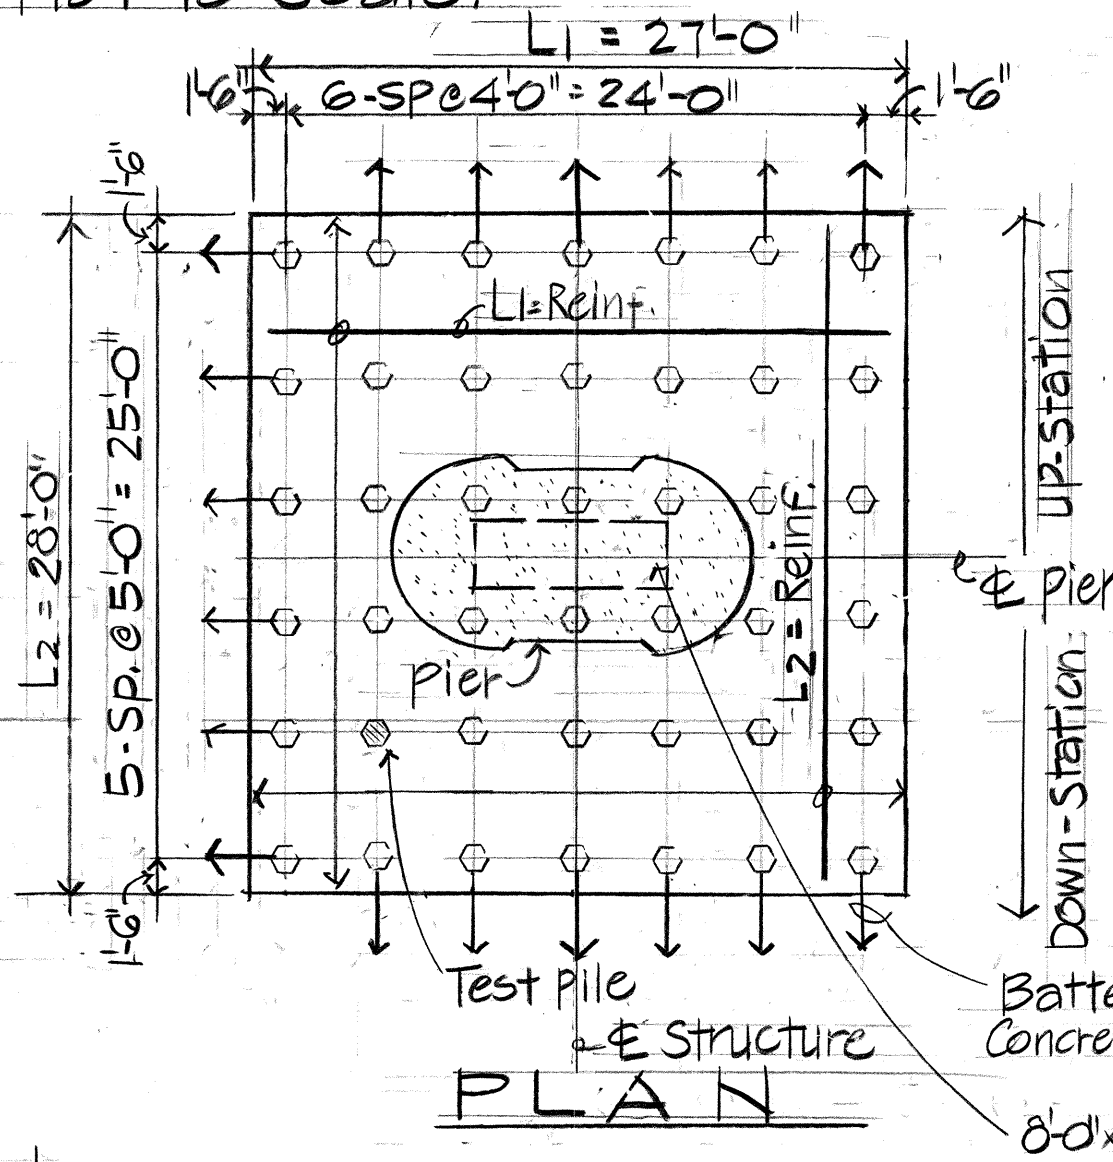

PLAN

FOOTING TYPE PF-1

Scale: 1/8" = 1'-0"

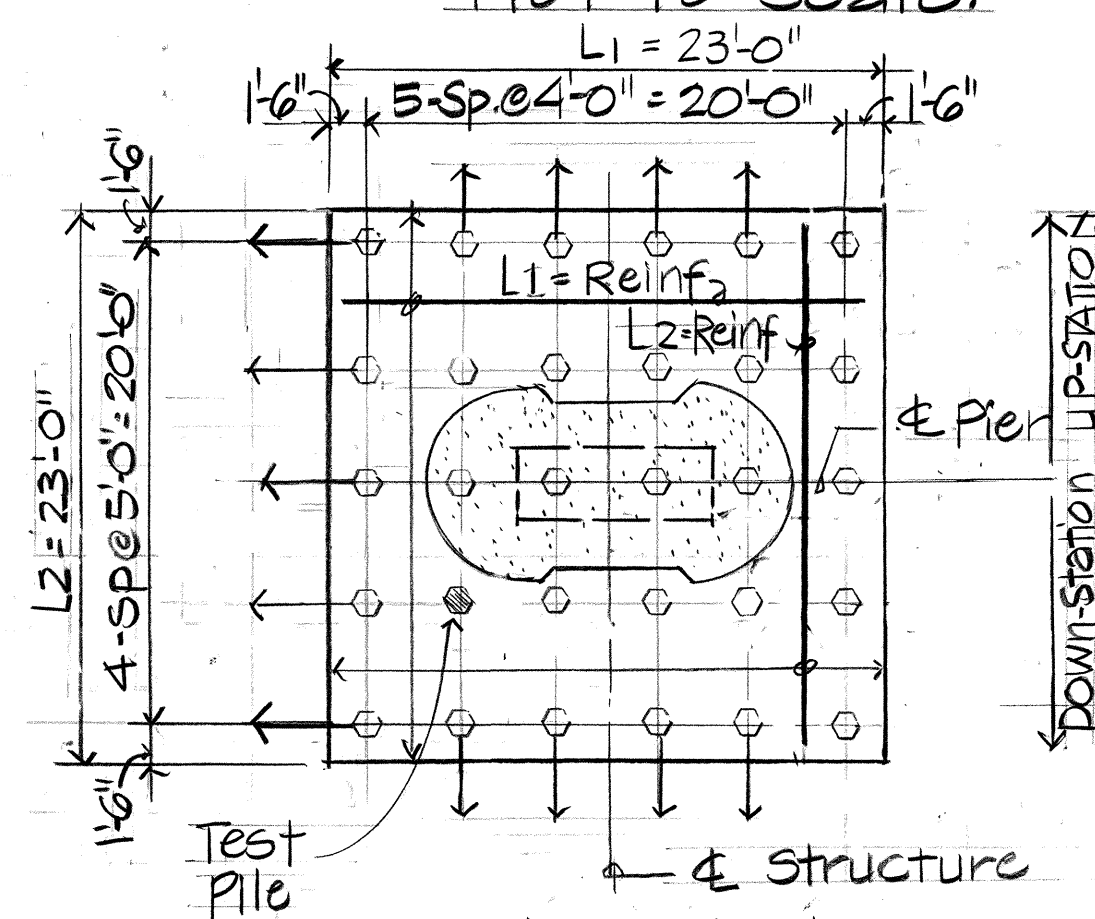

PLAN

FOOTING TYPE PF-2

Scale: 1/8" = 1'-0"

- Notes:
1. Footing and Pedestal, concrete to be placed monolithically.
 2. The 4 corners and center of each spread footing shall be probed to a depth 10' below bottom of footing elevation to detect cavities in the rock formations. The drilling of the probes shall be considered incidental to concrete in footings for Haku Valley Bridges.
 3. The Contractor shall provide the equipment that may be required to break up and/or remove obstructions so that the piles reach the required tip elevation, attain the required bearing capacity and the foundation installed in accordance with the drawings.
 4. Spread Footings shall bear on natural undisturbed material. Irregular, non-uniform surfaces at bottom of Footing may occur in excavations into Basalt Rock. All irregularities, discontinuities, loose areas and voids shall be filled with Class 'D' concrete (min).



THIS WORK WAS PREPARED BY ME OR UNDER MY SUPERVISION

Myron Oshiro

STATE OF HAWAII
DEPARTMENT OF TRANSPORTATION
HIGHWAYS DIVISION

FOUNDATION DETAILS & SCHEDULE

INTERSTATE ROUTE H-3
F.A.I. PROJECT NO. I-H3-1(52)

SCALE: AS NOTED DATE: JULY 1988

SHEET NO. 511 OF 526 SHEETS

DATE	REVISION
9/11/89	Revised Schedule, Elevations & Plans for PF3 & PF4.

AS BUILT


C.O.45

S11


42

SURVEY PLOTTED BY	DATE
DRAWN BY	
DESIGNED BY	
NOTED BY	
CHECKED BY	
ORIGINAL PLAN	
NOTE BOOK	
QUANTITIES BY	
CHECKED BY	
NO.	

FED. ROAD DIST. NO.	STATE	FED. AID PROJ. NO.	FISCAL YEAR	SHEET NO.	TOTAL SHEETS
HAWAII	HAW.	I-H3-1(52)	1988	46	75

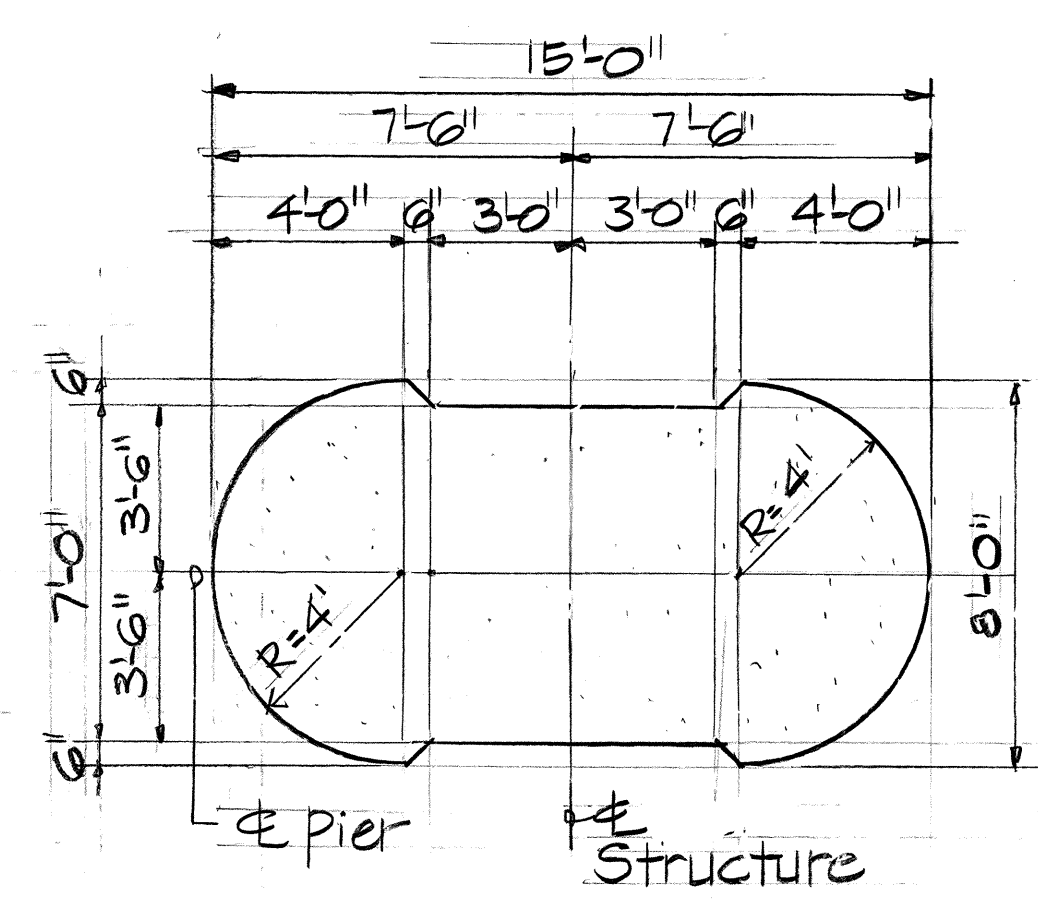


PIER - PLAN
Scale: 1/4" = 1'-0"

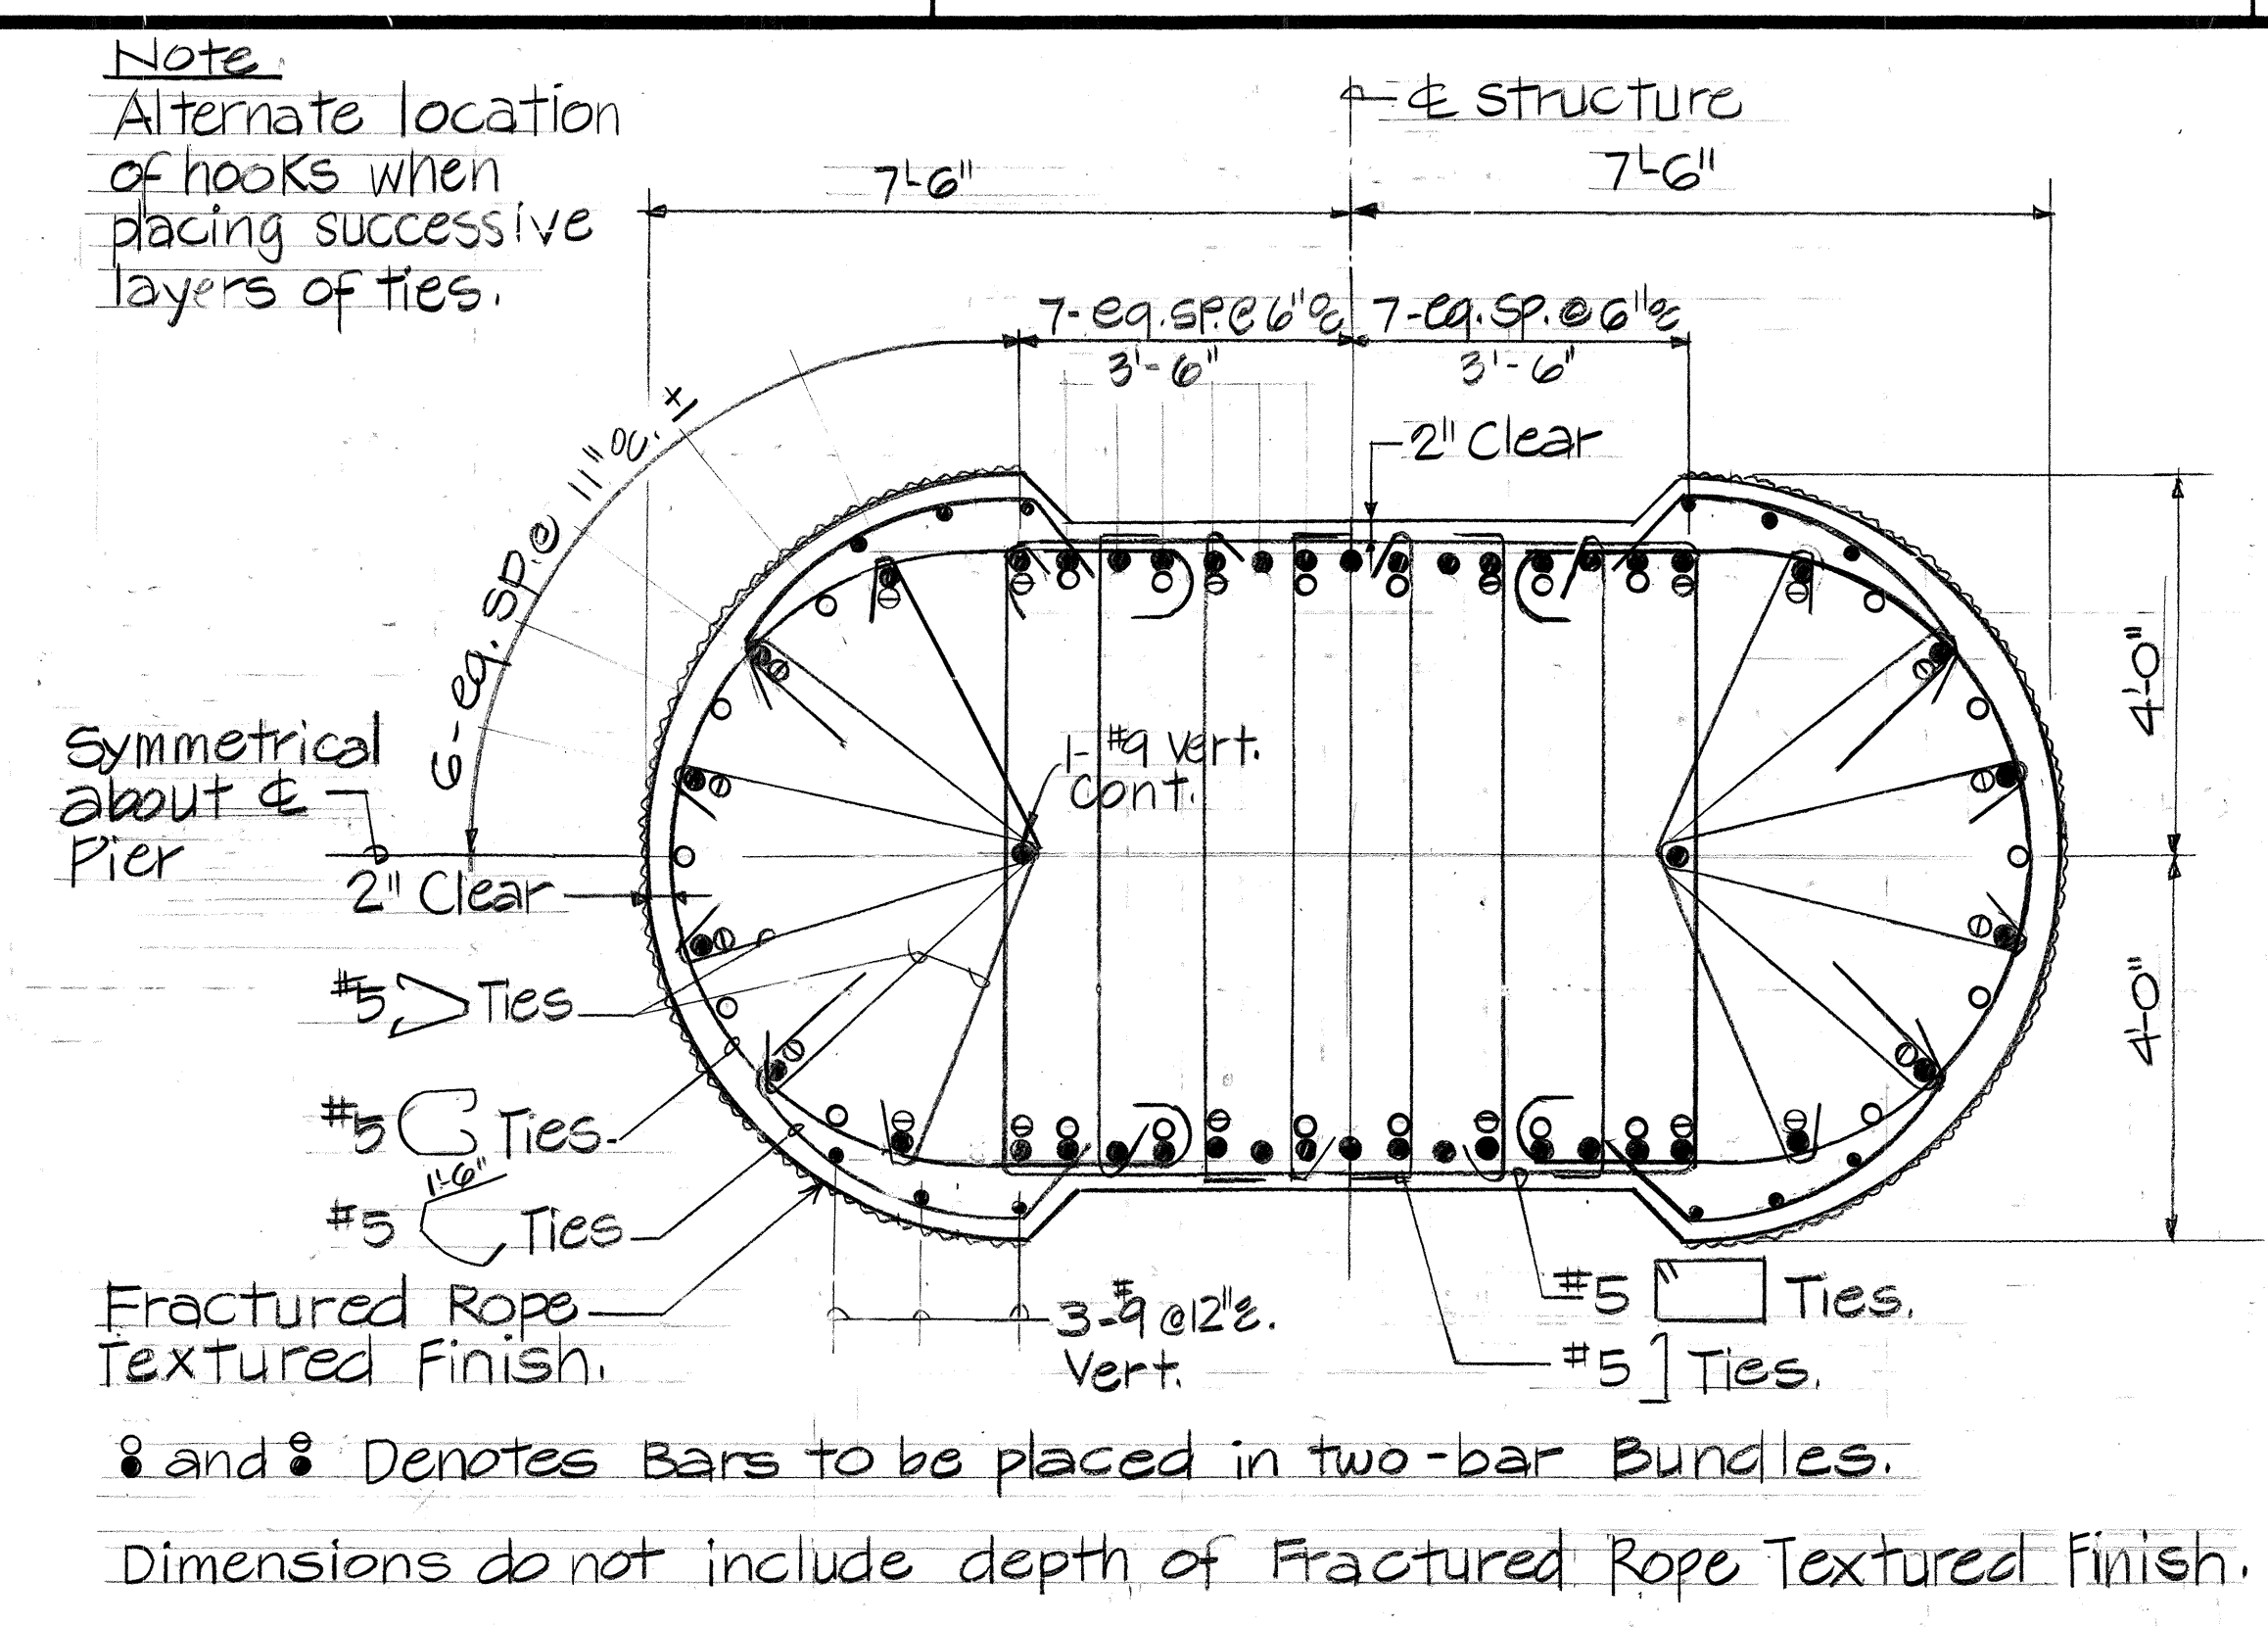

PIER - REINF. PLAN
Scale: 1/2" = 1'-0"


PIER VERTICAL REINFORCEMENT SCHEDULE				
Pier Mark	'A' bar	'B' bar	'C' bar	Remarks
N.I.C. ① I.B.	42-#18	—	—	Future Pier by Others
② I.B.	42-#18	—	—	
③ I.B.	—	20-#18x55'	22-#18x55'	
④ I.B.	—	—	—	
⑤ I.B.	—	20-#18x30'	—	
⑥ I.B.	—	—	—	
① O.B.	—	—	—	

- NOTES:
- All #18 Pier vertical reinforcement shall conform to ASTM A615, Grade 60.
 - Pier ties shall conform to ASTM A615, Grade 40.
 - Height of bars to be measured from top of footing or top of footing pedestal. 'A' bars to be continuous over the full height of Pier. 'B' and 'C' bars are extended as scheduled.
 - All #18 bars to be mechanically spliced. All other vertical bars to be class C tension lap splice.

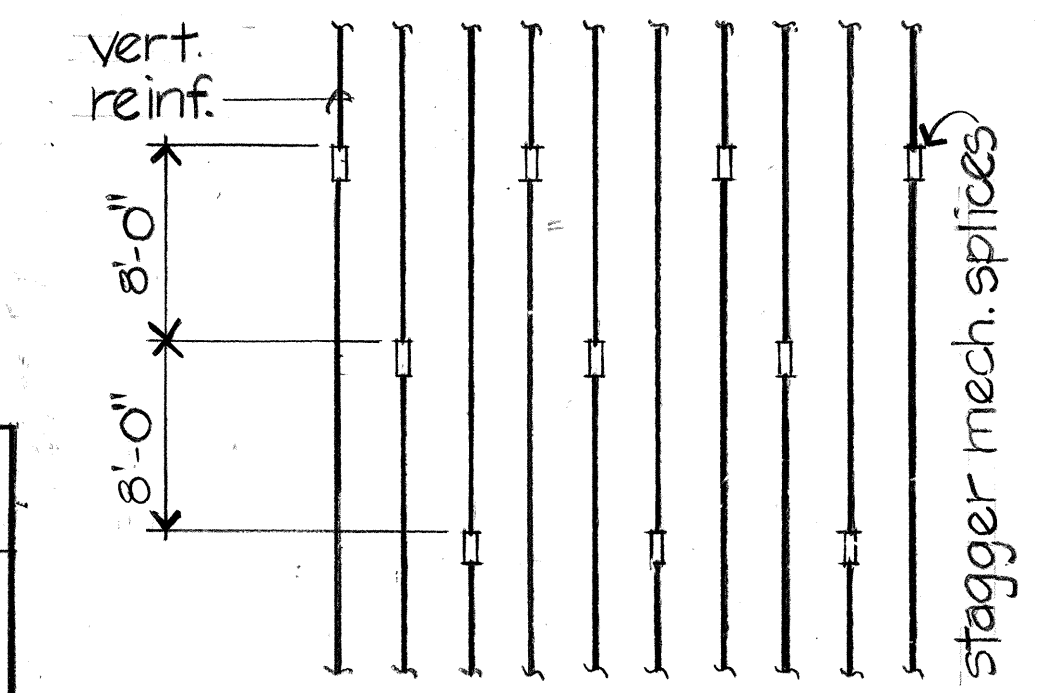

All splices to develop not less than 90% of the specified ultimate tensile strength of the reinforcing steel.

MECH. SPLICE DET.
not to scale

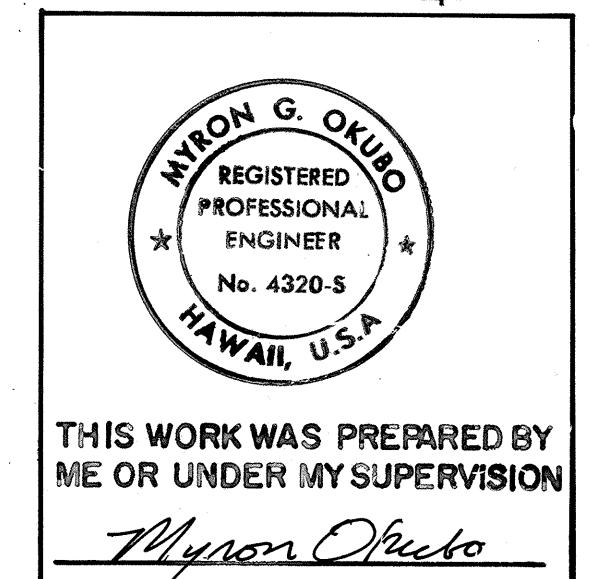


PIER SCHEDULE	
INTERSTATE ROUTE H-3 F.A.I. PROJECT NO. I-H3-1(52)	
SCALE: AS NOTED	DATE: JULY 1988
SHEET No. S12 OF S26 SHEETS	

DATE	REVISION
9/11/89	Revised Schedule and Detail A
1/10/89	IB Pier 1 Deleted

AS BUILT


C.O. ADD.46

ORIGINAL PLAN	SURVEY PLOTTED BY	DATE
NOTE BOOK	DRAWN BY	
No.	DESIGNED BY	
	CHECKED BY	

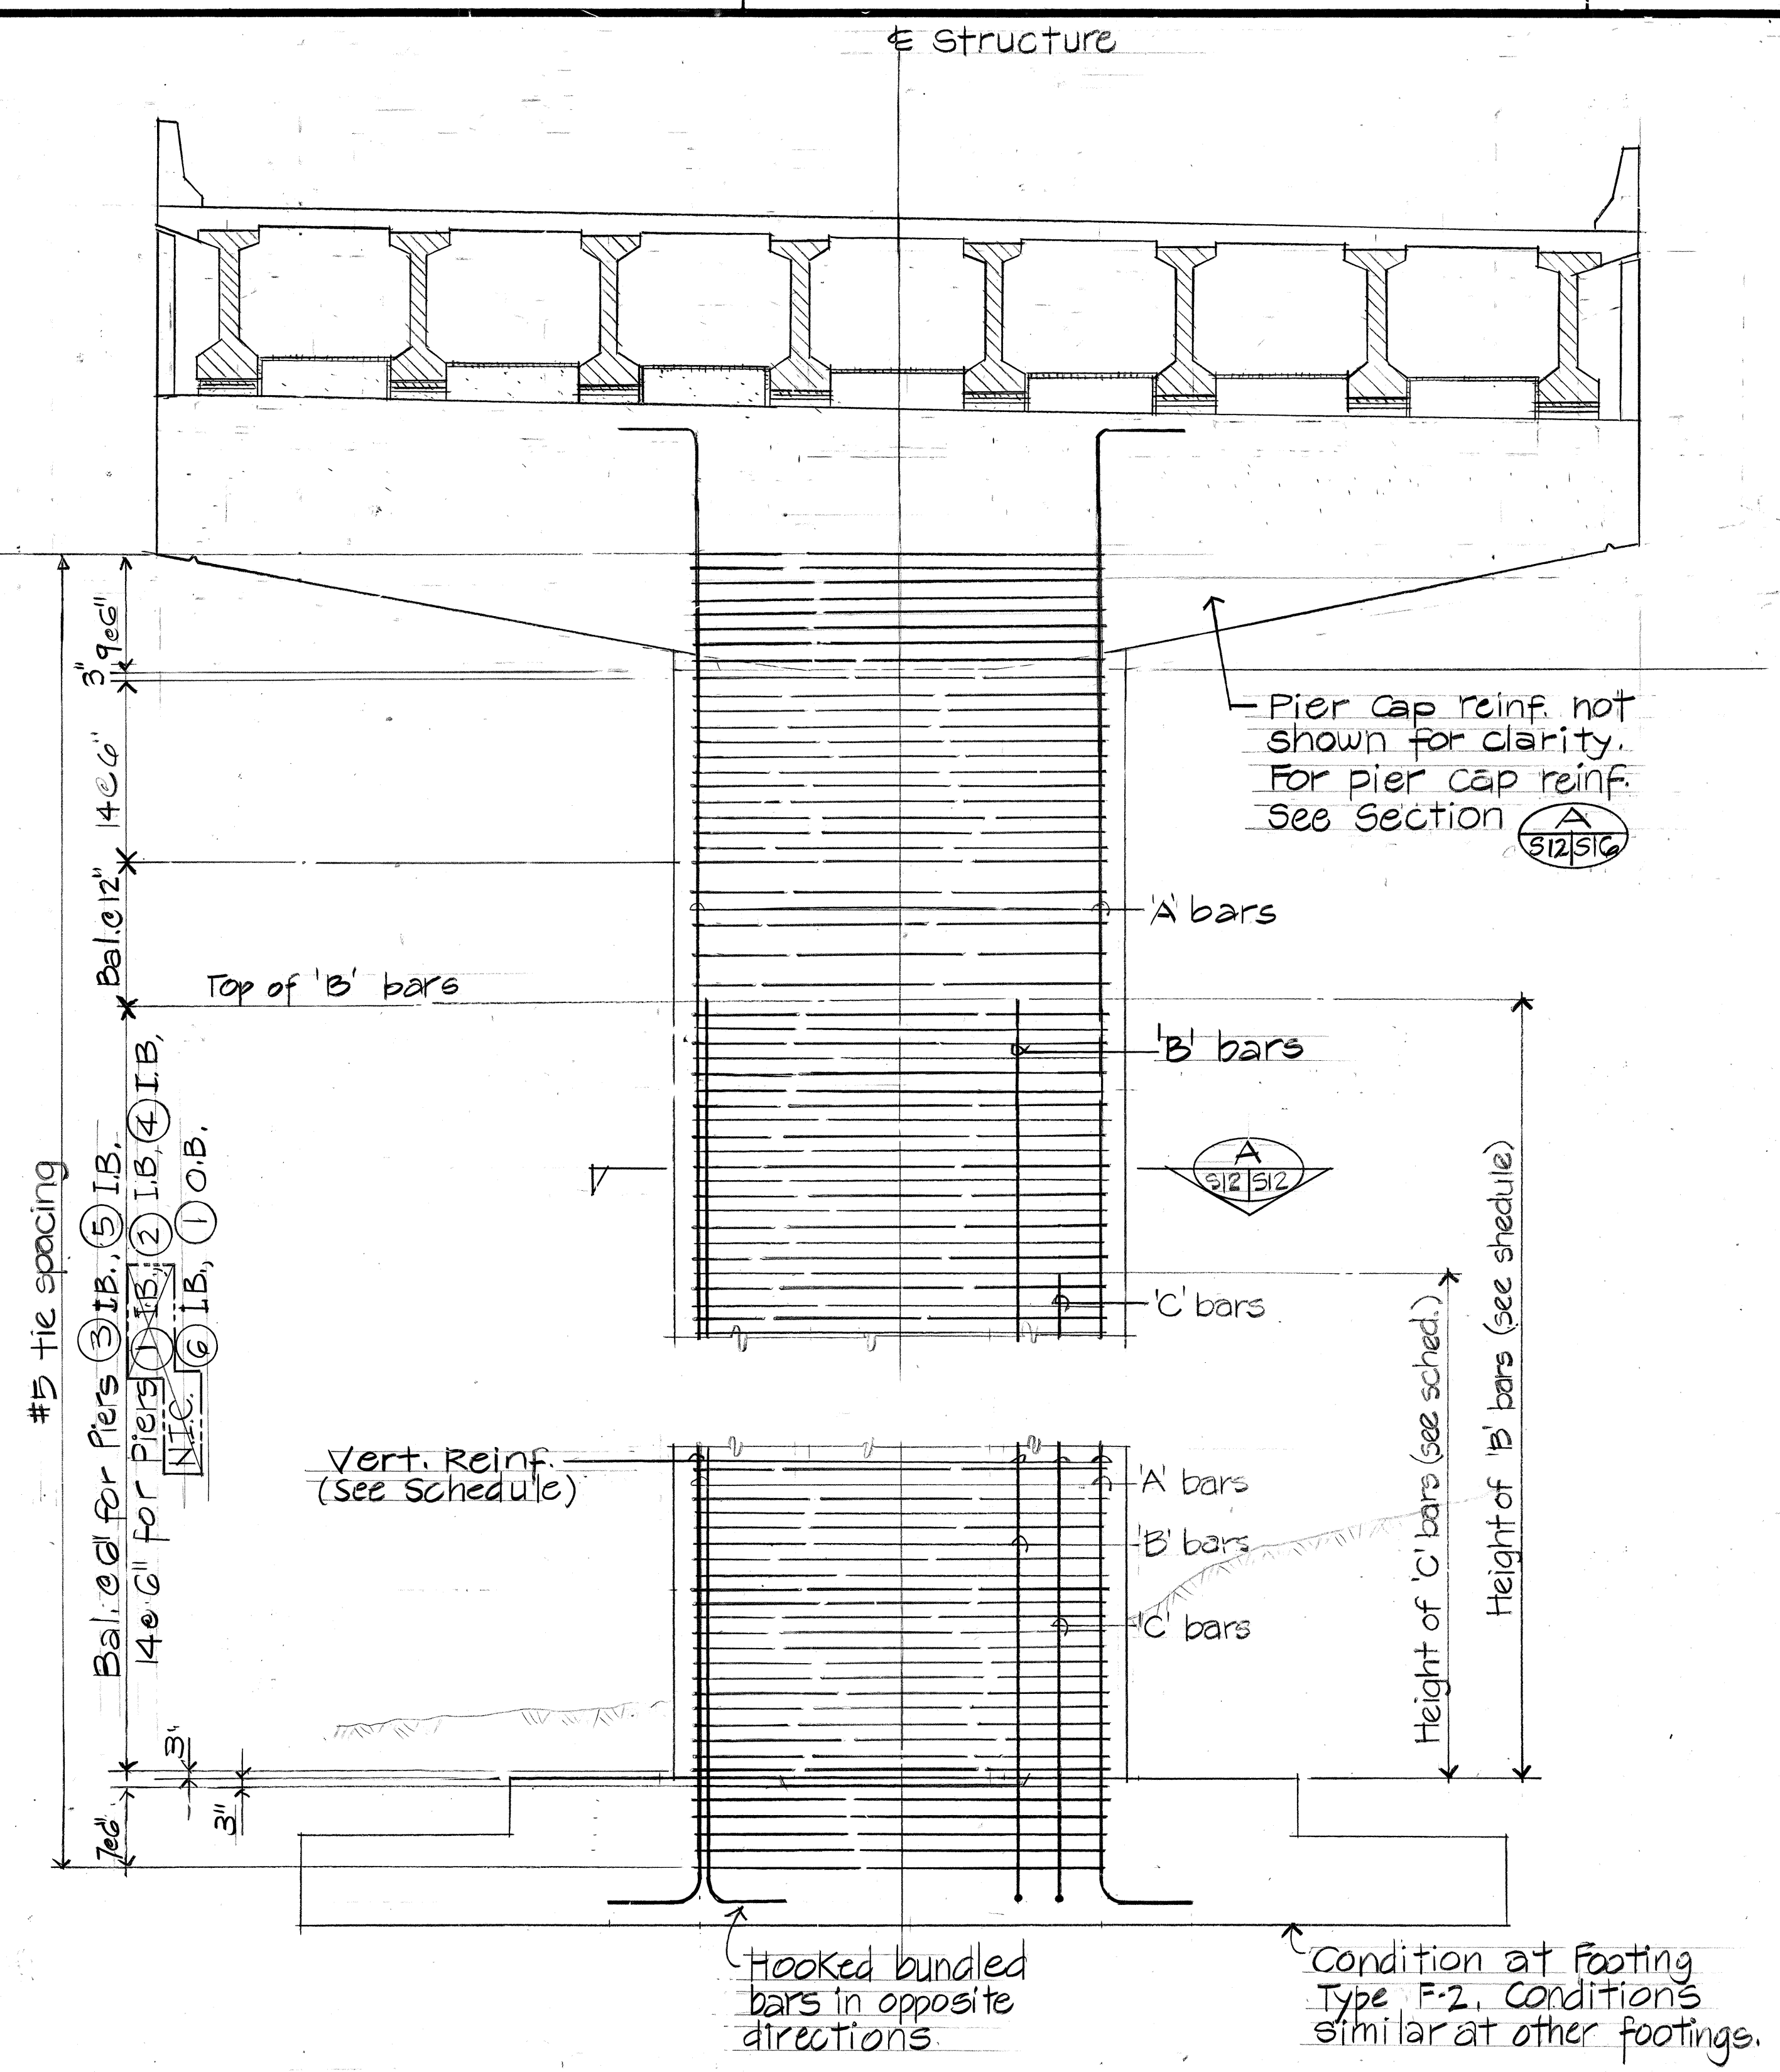

PIER ELEVATION SECTION
Scale: 1/4" = 1'-0"

FED. ROAD DIST. NO.	STATE	FED. AID PROJ. NO.	FISCAL YEAR	SHEET NO.	TOTAL SHEETS
HAWAII	HAW.	I-H3-1(52)	1988	47	75

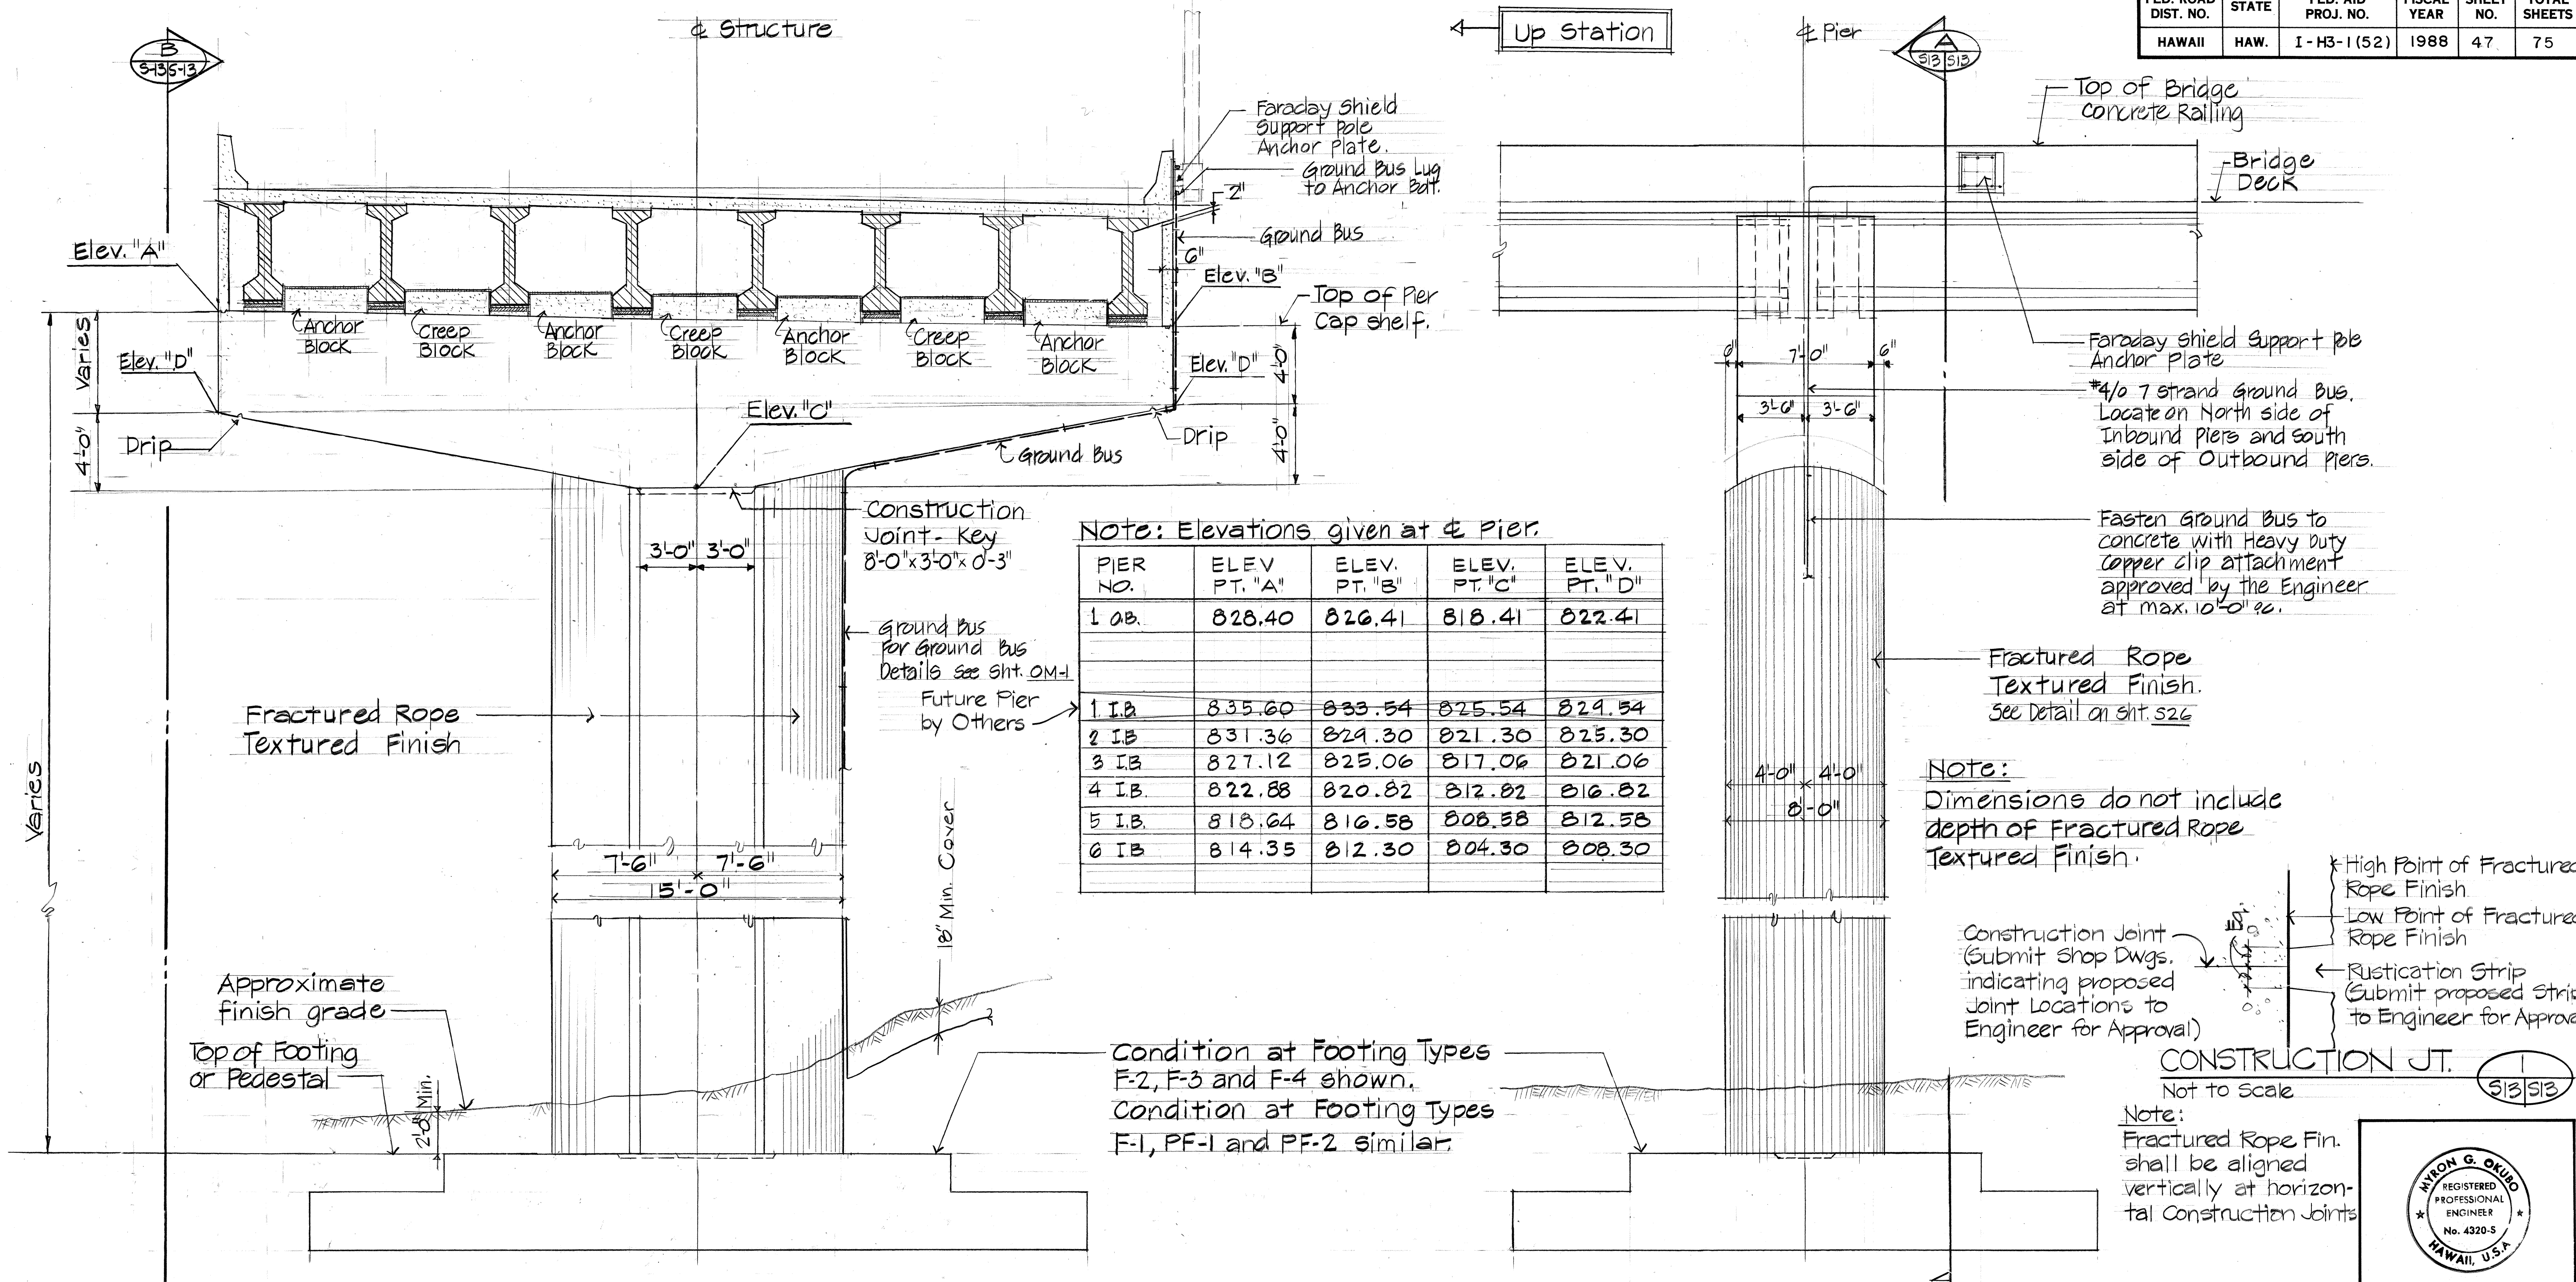

Note: Elevations given at & Pier.

PIER NO.	ELEV. PT. "A"	ELEV. PT. "B"	ELEV. PT. "C"	ELEV. PT. "D"
1 AB.	828.40	826.41	818.41	822.41
1 IB.	835.60	833.54	825.54	829.54
2 IB.	831.36	829.30	821.30	825.30
3 IB.	827.12	825.06	817.06	821.06
4 IB.	822.88	820.82	812.82	816.82
5 IB.	818.64	816.58	808.58	812.58
6 IB.	814.35	812.30	804.30	808.30

(LOOKING UPSTATION)


PIER ELEVATION

Scale: 1/4" = 1'-0"

SIDE VIEW

Scale: 1/4" = 1'-0"

SURVEY PLOTTED BY	DATE
DRAWN BY	
DESIGNED BY	
QUANTITIES BY	
CHECKED BY	
ORIGINAL PLAN	
NOTE BOOK	
NO.	

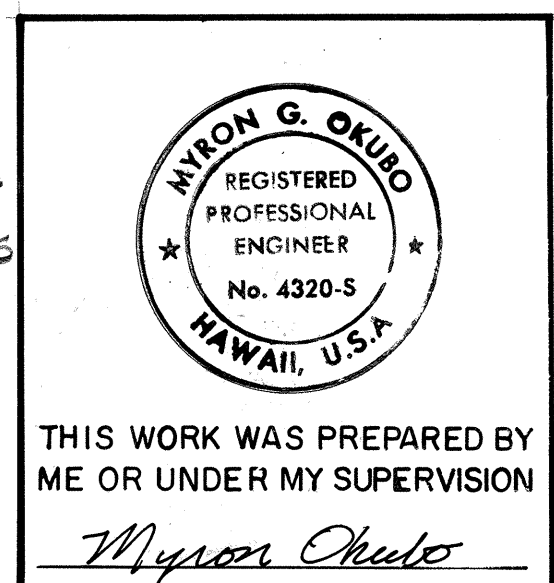

STATE OF HAWAII
DEPARTMENT OF TRANSPORTATION
HIGHWAYS DIVISION

PIER DETAILS

INTERSTATE ROUTE H-3
F.A.I. PROJECT NO. I-H3-1(52)

SCALE: 1/4" = 1'-0" DATE: JULY 1988

SHEET NO. S13 OF S26 SHEETS

1/10/89	IB. Pier 1 Deleted, IB. Pier 3 Control Elevations Revised
---------	---

DATE	REVISION
------	----------

AS BUILT

ADD. 47

FED. ROAD DIST. NO.	STATE	FED. AID PROJ. NO.	FISCAL YEAR	SHEET NO.	TOTAL SHEETS
HAWAII	HAW.	I-H3-1(52)	1988	48	75


FUTURE SPANS		
UP-STATION GIRDER SEAT ELEVATION		
GIRDER MARK SPAN/GIRDER		OUTBOUND
(F) G1		828.72
(F) G2		828.46
(F) G3		828.21
(F) G4		827.96
(F) G5		827.70
(F) G6		827.45
(F) G7		827.20
(F) G8		826.94

INBOUND		
Down-Station Girder Seat Elevation	Girder Mark Span/Girder	Up-Station girder seat Elevation
835.75	(1) G1	831.68
835.48	(1) G2	831.41
835.22	(1) G3	831.15
834.95	(1) G4	830.88
834.68	(1) G5	830.61
834.42	(1) G6	830.35
834.15	(1) G7	830.08
833.89	(1) G8	829.82
831.51	(2) G1	827.44
831.24	(2) G2	827.17
830.98	(2) G3	826.91
830.71	(2) G4	826.64
830.44	(2) G5	826.37
830.18	(2) G6	826.11
829.91	(2) G7	825.84
829.65	(2) G8	825.58
827.27	(3) G1	823.20
827.00	(3) G2	822.93
826.74	(3) G3	822.67
826.47	(3) G4	822.40
826.20	(3) G5	822.13
825.94	(3) G6	821.87
825.67	(3) G7	821.60
825.41	(3) G8	821.34
823.03	(4) G1	818.96
822.76	(4) G2	818.69
822.50	(4) G3	818.43
822.23	(4) G4	818.16
821.96	(4) G5	817.89
821.70	(4) G6	817.63
821.43	(4) G7	817.36
821.17	(4) G8	817.10
818.79	(5) G1	814.72
818.52	(5) G2	814.45
818.26	(5) G3	814.19
817.99	(5) G4	813.92
817.72	(5) G5	813.65
817.46	(5) G6	813.39
817.19	(5) G7	813.12
816.93	(5) G8	812.86

INBOUND		
Down-Station Girder Seat Elevation	Girder Mark Span/Girder	Up-Station girder seat Elevation
814.51	(6) G1	810.35
814.30	(6) G2	810.06
814.09	(6) G3	809.77
813.89	(6) G4	809.48
813.68	(6) G5	809.19
813.47	(6) G6	808.90
813.27	(6) G7	808.61
813.06	(6) G8	808.32
812.85	(6) G9	808.03
812.65	(6) G10	807.74

Notes:
 1. Refer to Bridge Framing Plan for Girder Designation. See Sheet S-5
 2. For Girder Seat, see (B) S14/S20

OUT BOUND		
Down-Station Girder Seat Elevation	Girder Mark Span/Girder	Up-Station girder seat Elevation
828.55	(1) G-1	824.36
828.29	(1) G2	824.11
828.04	(1) G3	823.86
827.79	(1) G4	823.60
827.53	(1) G5	823.35
827.28	(1) G6	823.09
827.03	(1) G7	822.84
826.77	(1) G8	822.59

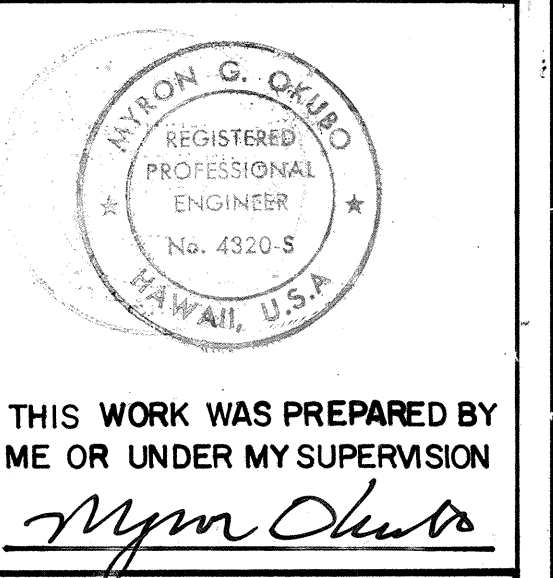

THIS WORK WAS PREPARED BY ME OR UNDER MY SUPERVISION
 Myron Okubo

STATE OF HAWAII
 DEPARTMENT OF TRANSPORTATION
 HIGHWAYS DIVISION

TYPICAL PIER DETAILS

INTERSTATE ROUTE H-3
 F.A.I. PROJECT NO. I-H3-1(52)




SCALE: AS NOTED DATE: JULY 1988

SHEET No. S14 OF S26 SHEETS

1/10/89 Girder Seat Elevations Deleted
 DATE REVISION

AS BUILT

ADD.48

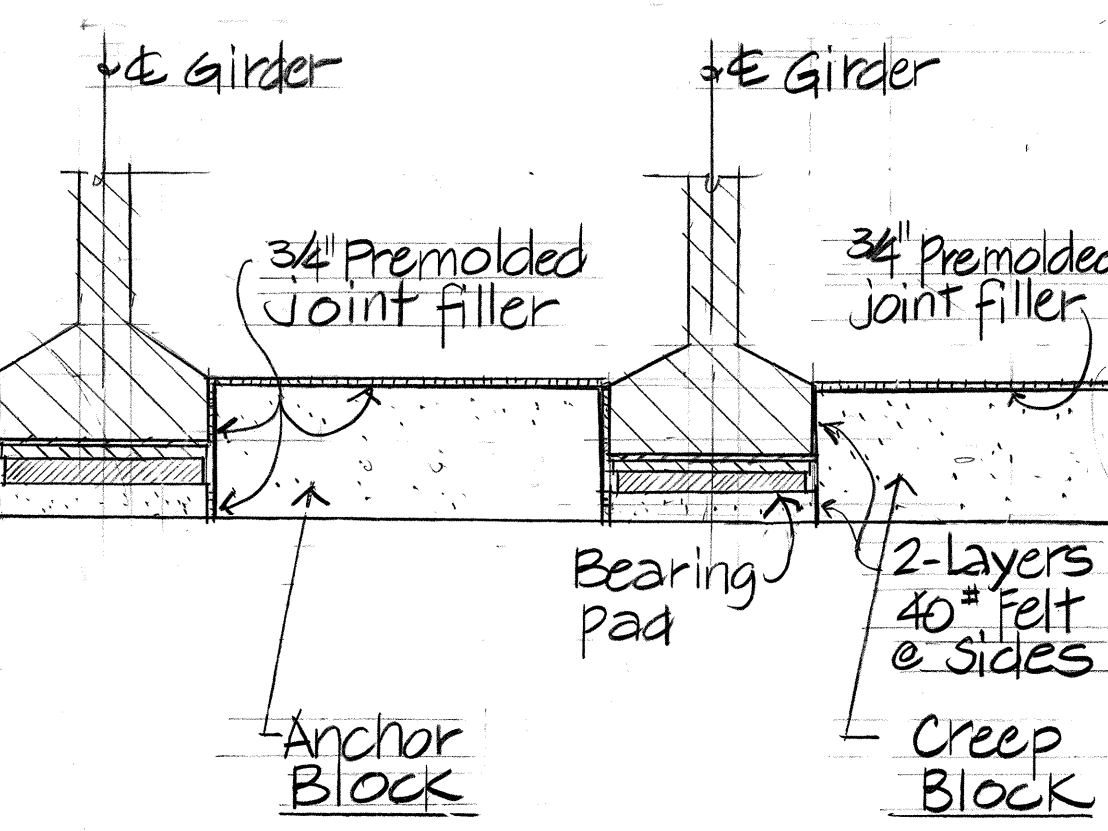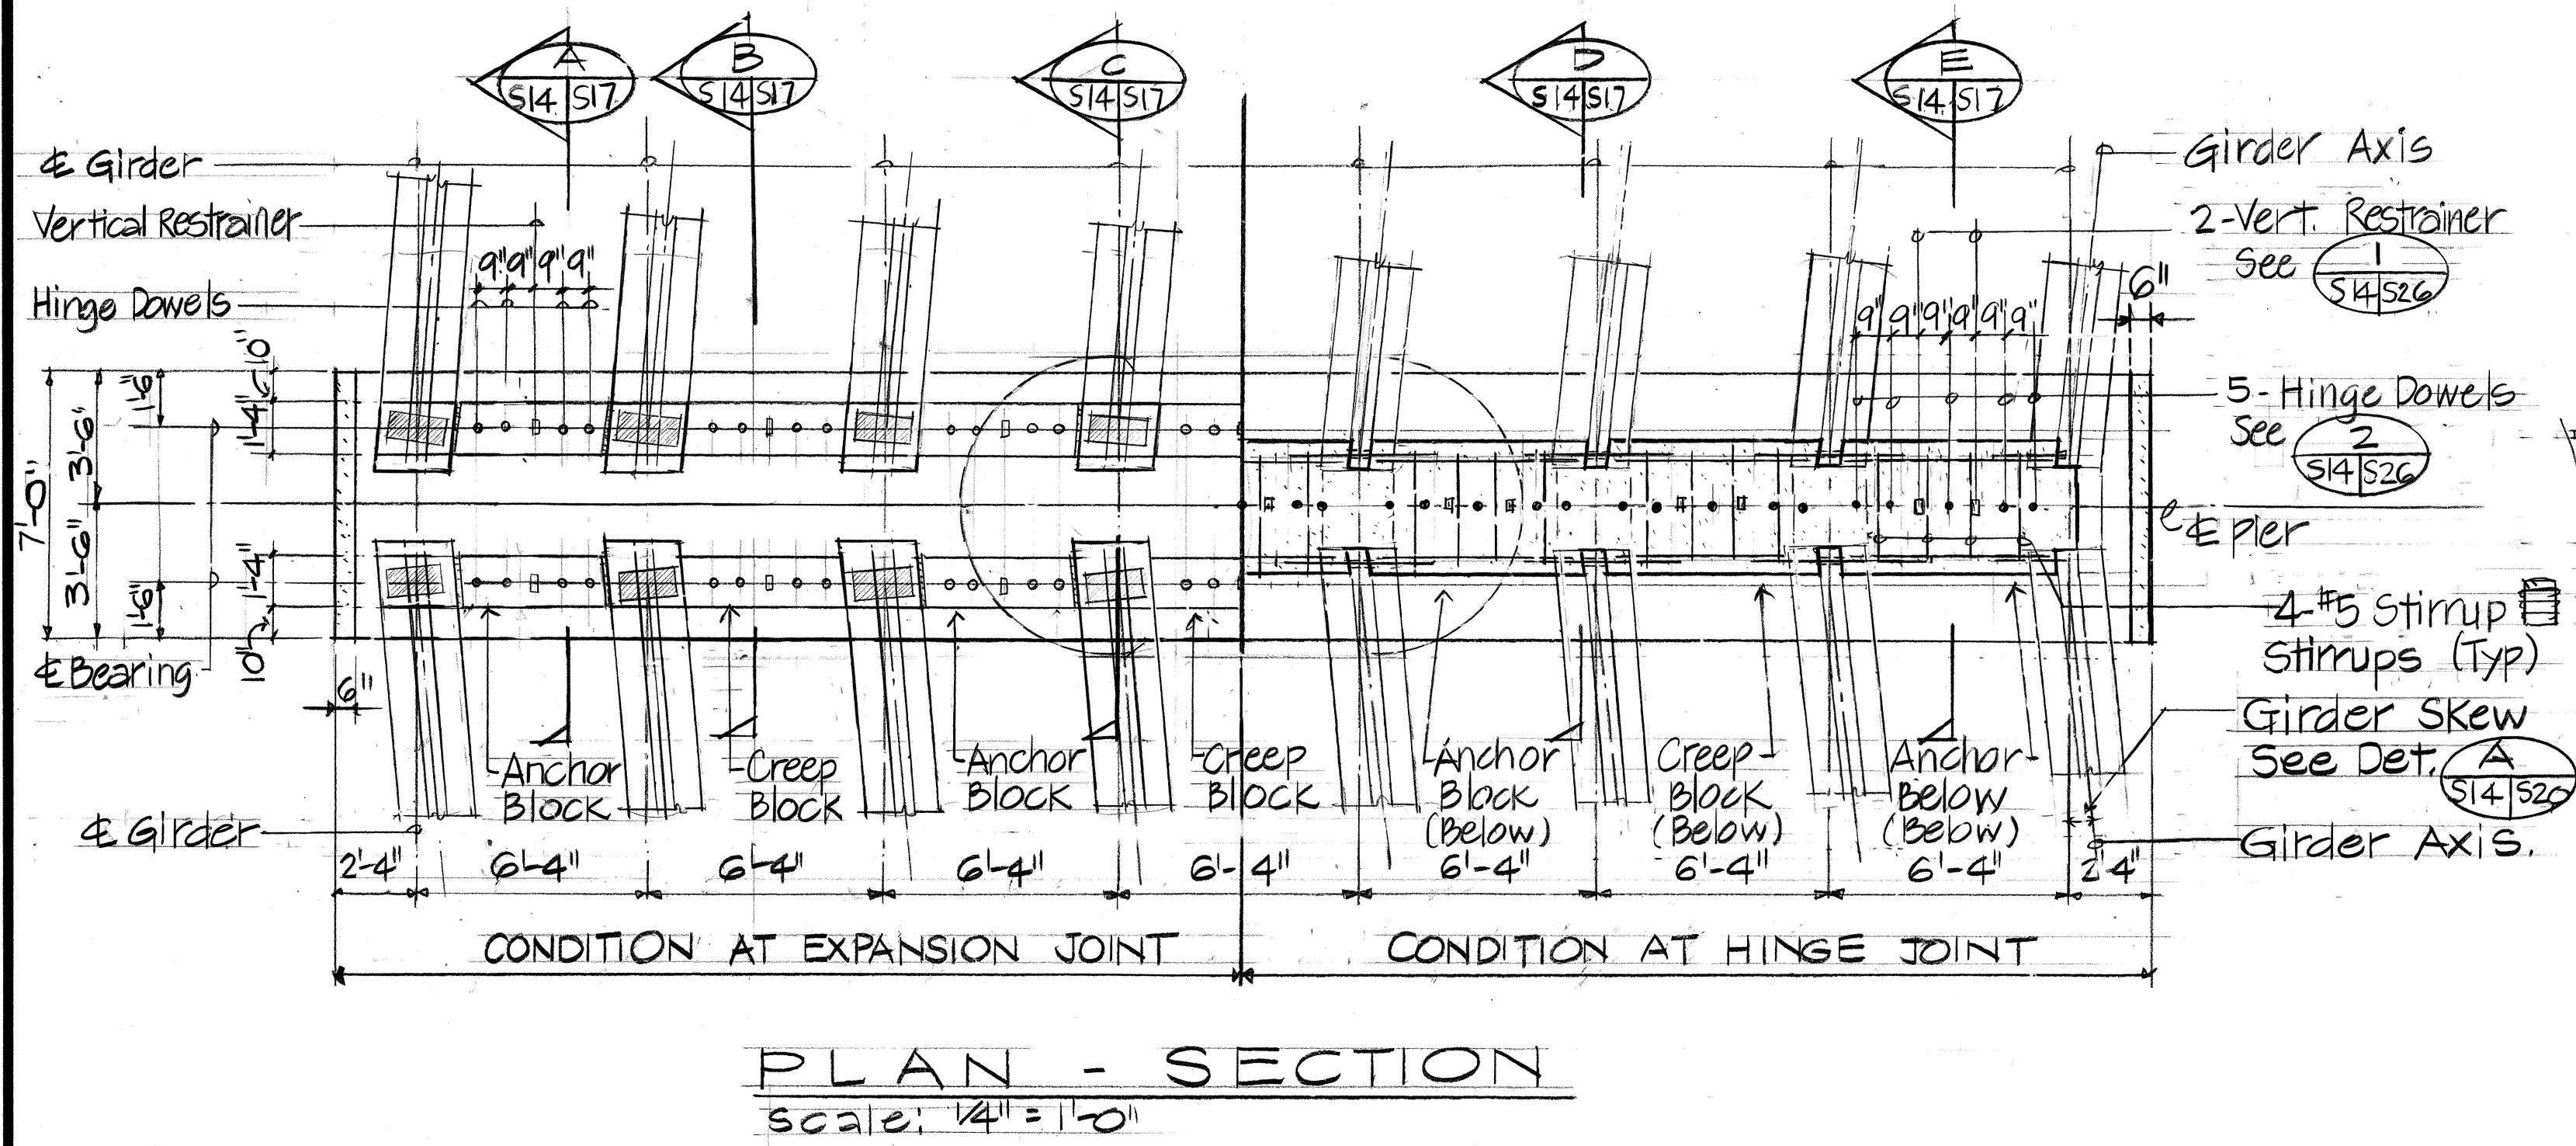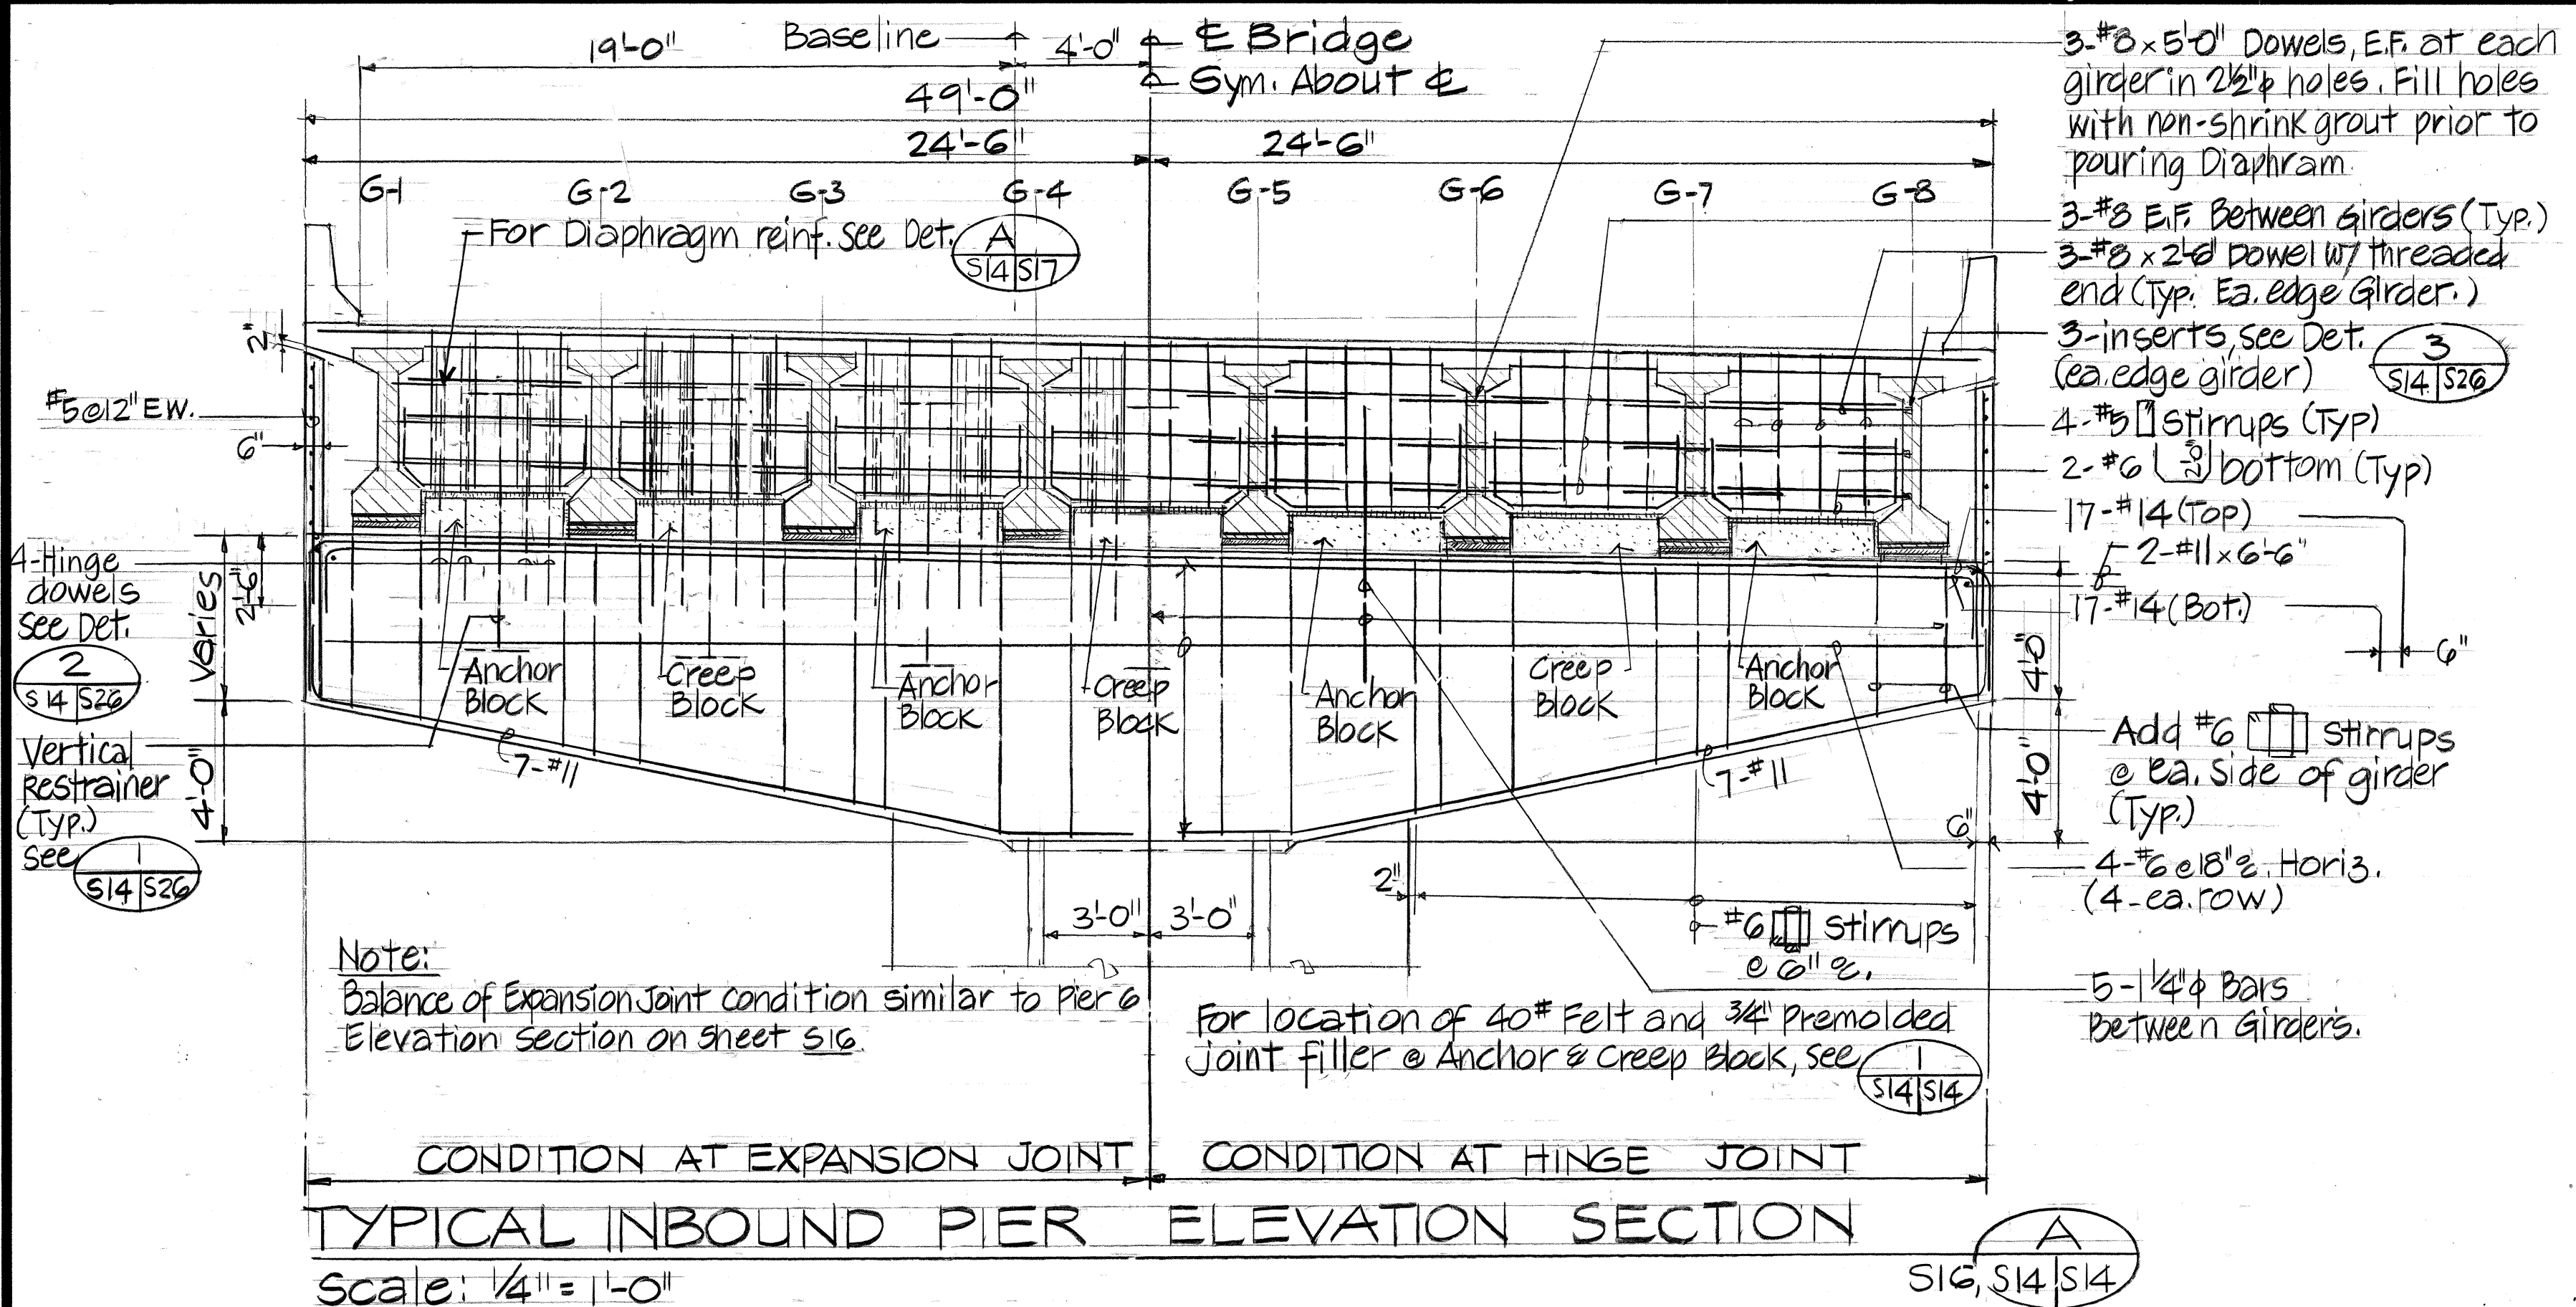


- Notes:
1. Bearing Pads, Anchor Blocks, & Creep Blocks are aligned with the Axis of the Girders. For Girder skew, see Detail (A) S14/S20
 2. Vertical Restrainers & Hinge Dowels, centered in Anchor Blocks, creep Blocks and Diaphragm. Balance of Diaphragm reinforcing similar, as shown on Pier Elevation on sheet S16
 3. Outbound pier details for expansion joint condition similar. Outbound girders spaced at 6'-6" @.

DATE	
SURVEY PLOTTED BY	
DRAWN BY	
DESIGNED BY	
QUANTITIES BY	
CHECKED BY	
ORIGINAL PLAN	
NOTE BOOK	
No.	

FED. ROAD DIST. NO.	STATE	FED. AID PROJ. NO.	FISCAL YEAR	SHEET NO.	TOTAL SHEETS
HAWAII	HAW.	I - H3 - (52)	1988	50	75

Notes:


- Bearing Pads, Anchor Blocks, & Creep Blocks are aligned with the Axis of the girders. For Girder skew see Detail A S16 S20
- Vertical Restrainers and Hinge Dowels Centered in Anchor Blocks. Creep Blocks and Diaphragms.

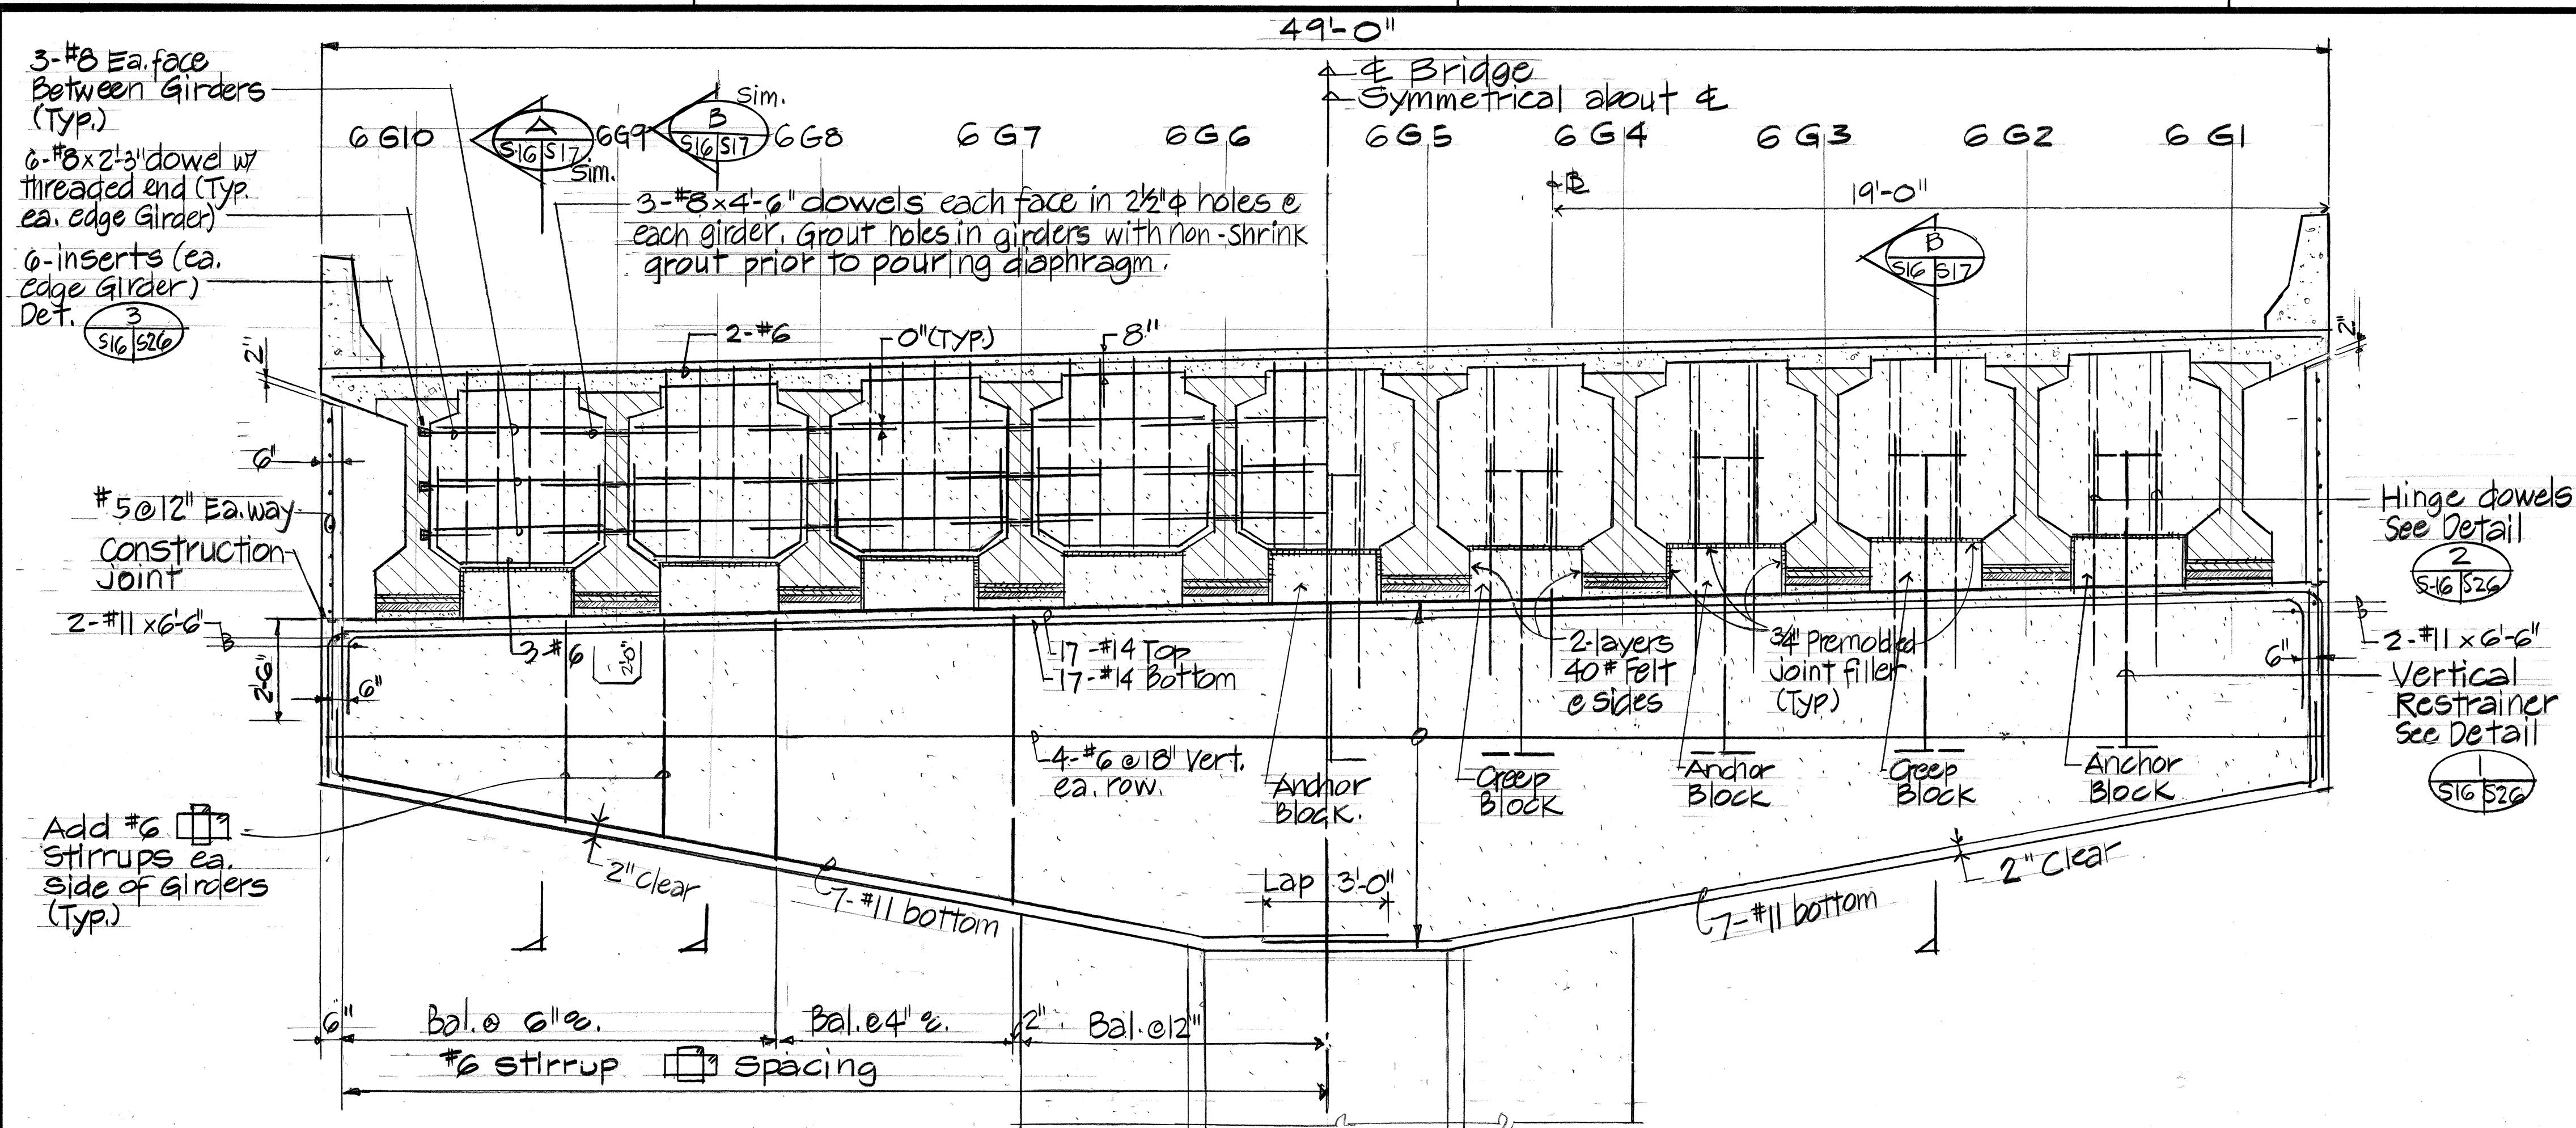

PIER 6 INBOUND ELEVATION - SECTION A

Scale: 3/8" = 1'-0"


S15, S16, S17

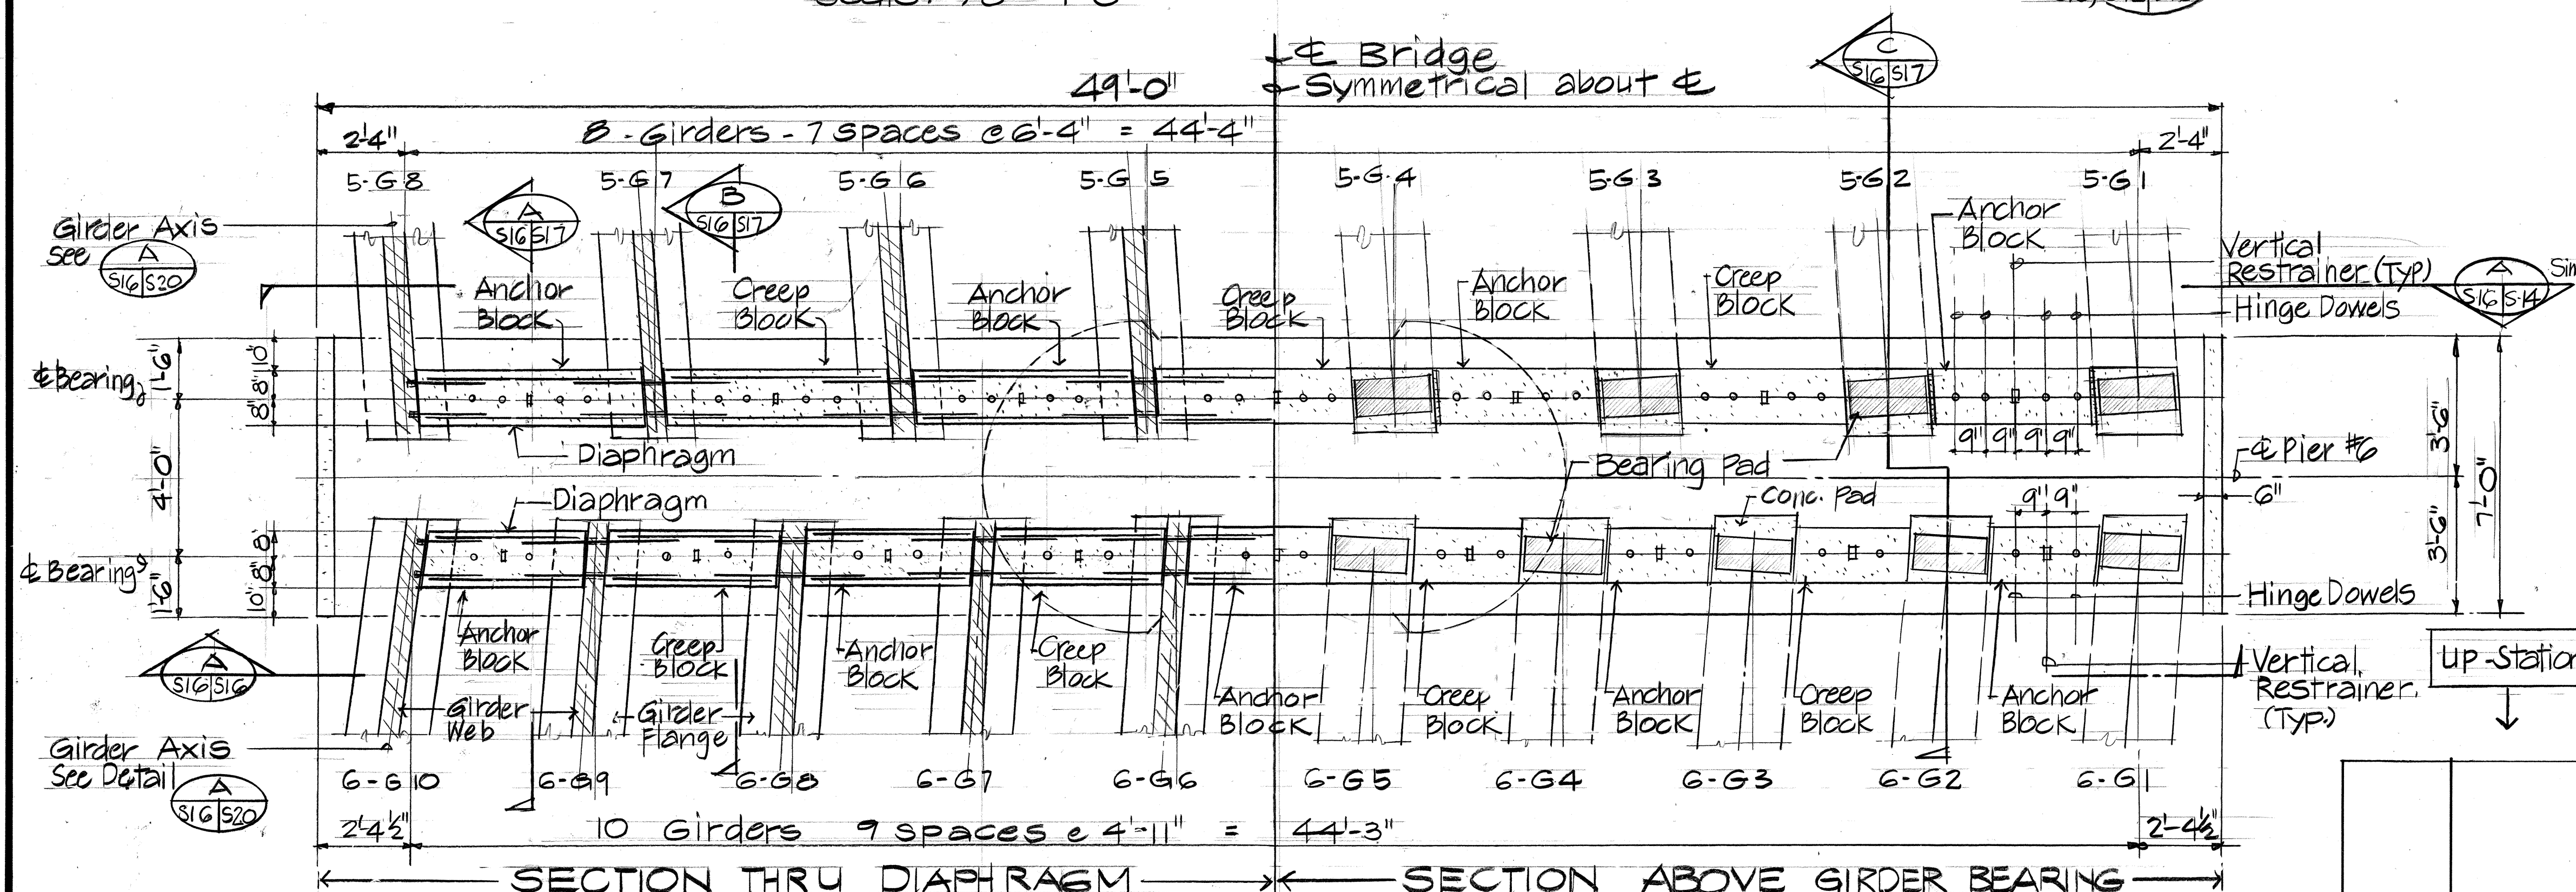

PIER 6 INBOUND PLAN - SECTION B

Scale: 3/8" = 1'-0"

S15, S16, S17

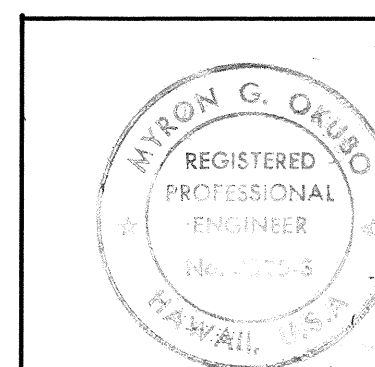

THIS WORK WAS PREPARED BY ME OR UNDER MY SUPERVISION

Myron Okada

STATE OF HAWAII
DEPARTMENT OF TRANSPORTATION
HIGHWAYS DIVISION

PIER 6 INBOUND DETAILS

INTERSTATE ROUTE H-3
F.A.I. PROJECT NO. I-H3-1(52)

SCALE: AS NOTED DATE: JULY 1988

SHEET No. S16 OF S26 SHEETS

DATE: 1/10/89 REVISION: Detail A Revised


AS BUILT

ADD.50


S16

47


FED. ROAD DIST. NO.	STATE	FED. AID PROJ. NO.	FISCAL YEAR	SHEET NO.	TOTAL SHEETS
HAWAII	HAW.	I-H3-1(52)	1988	51	75

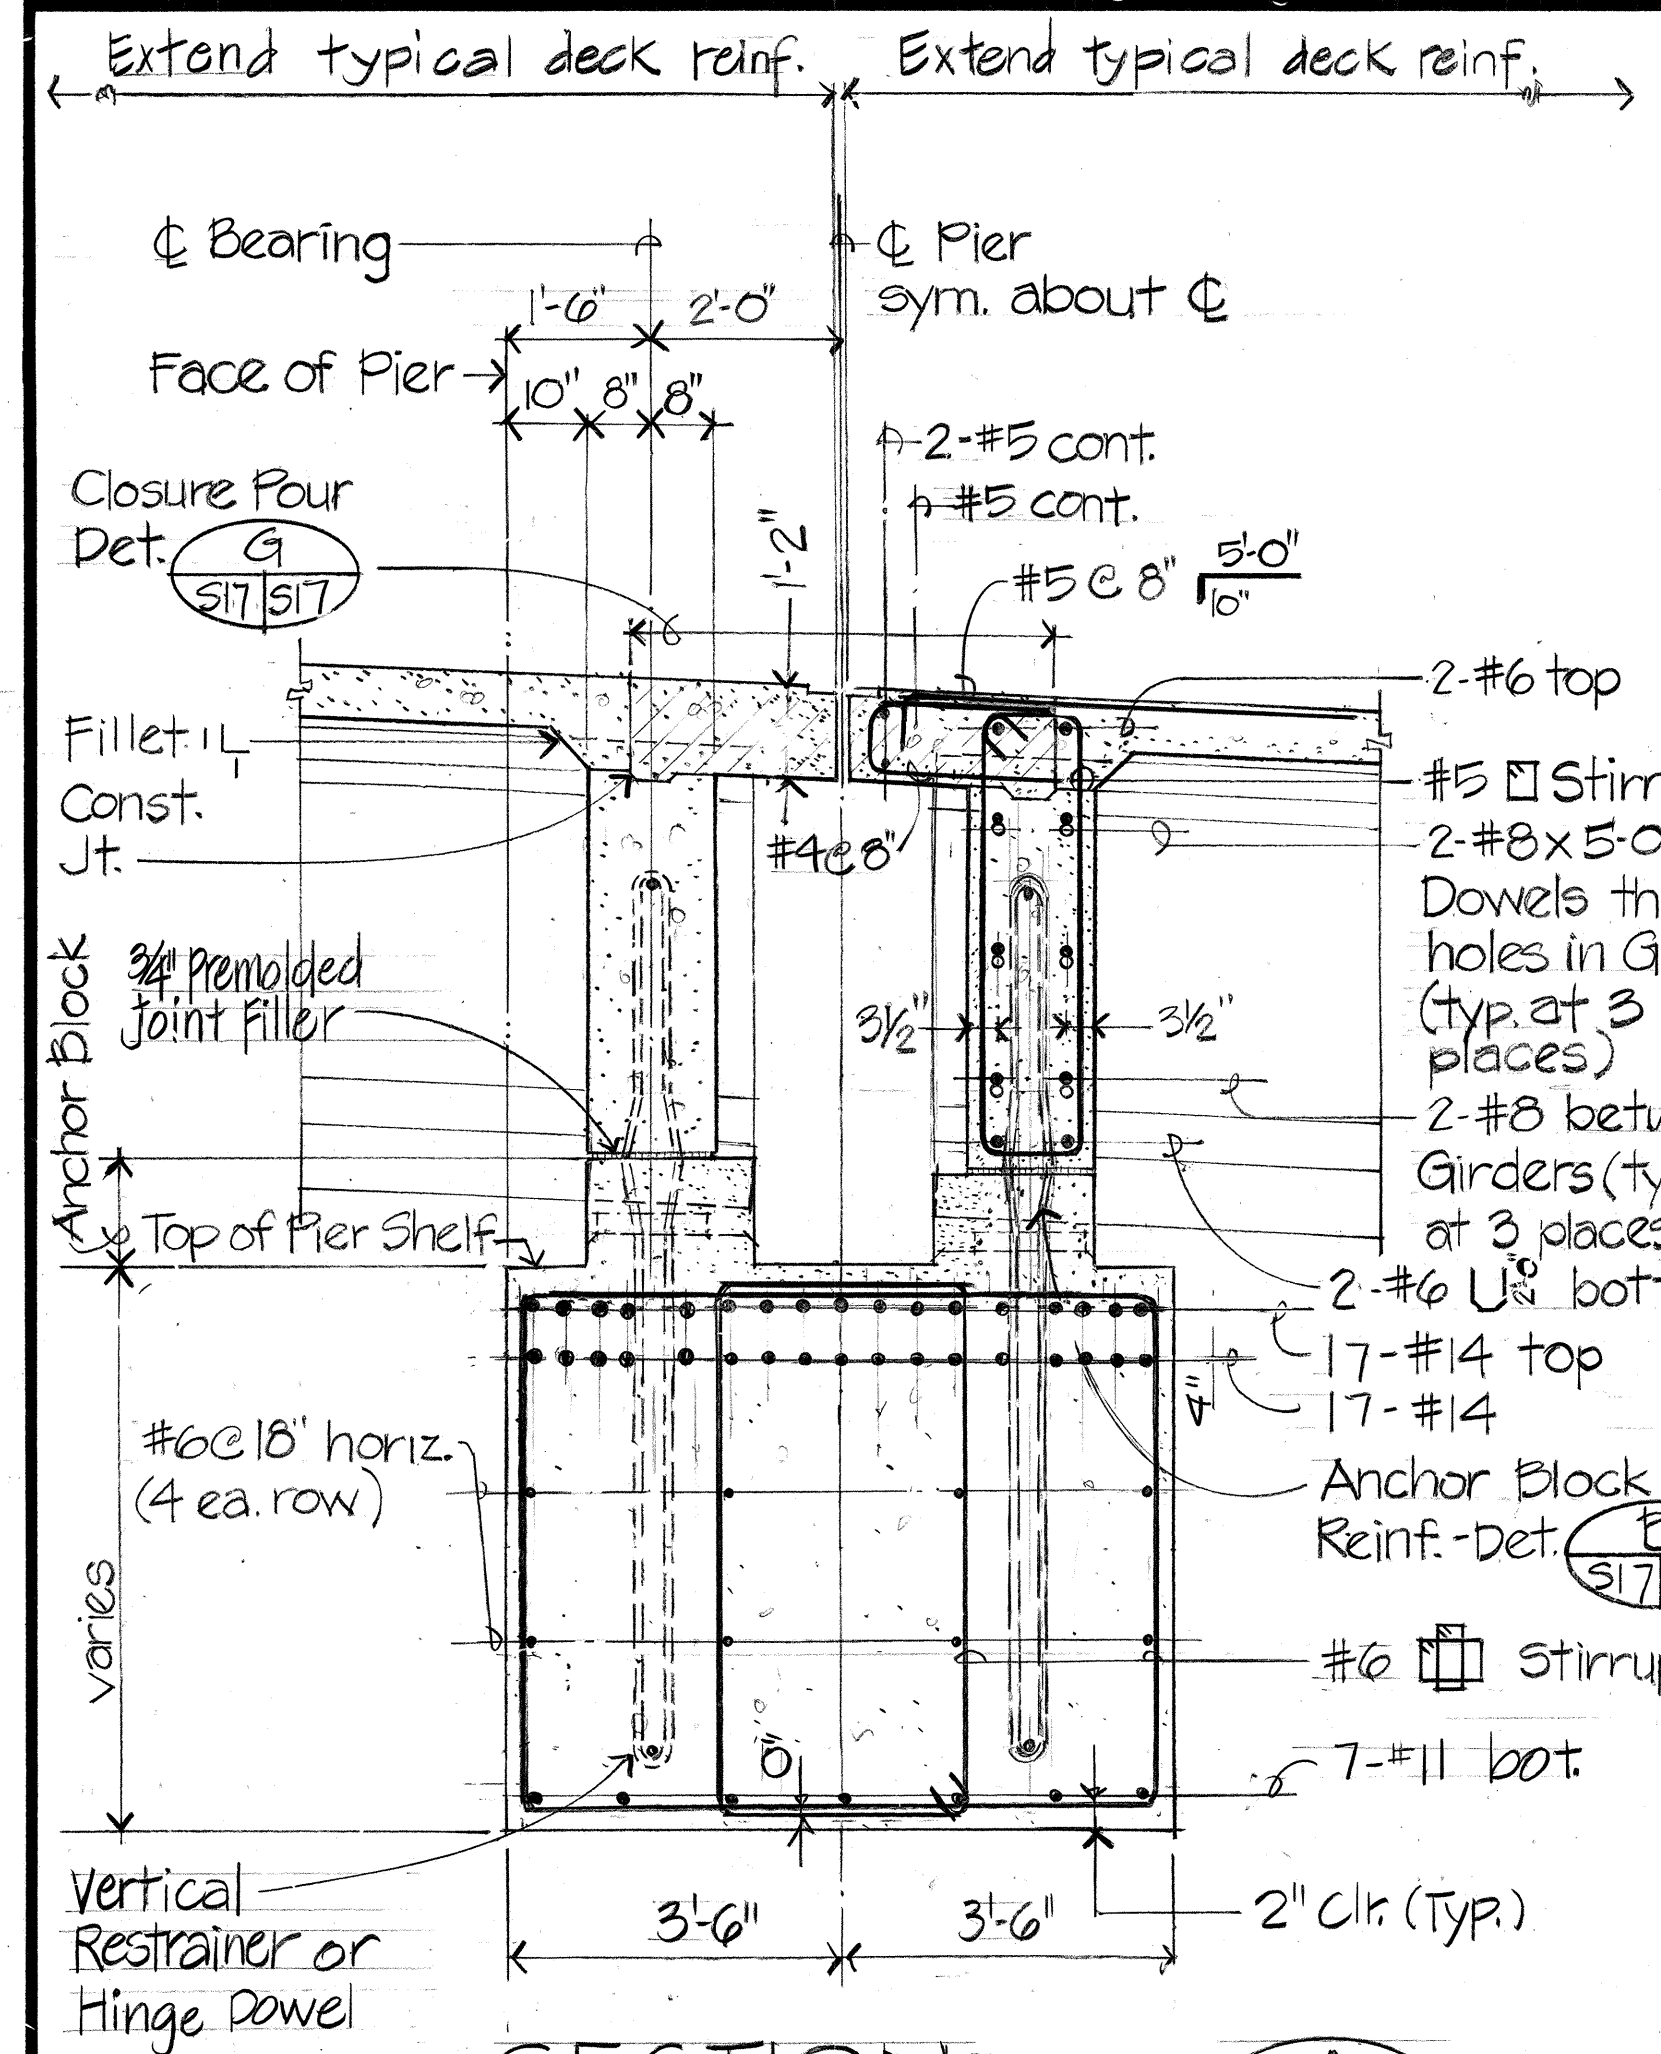


SECTION A
Scale: 1/2" = 1'-0" S16, S14, S15, S17, S17

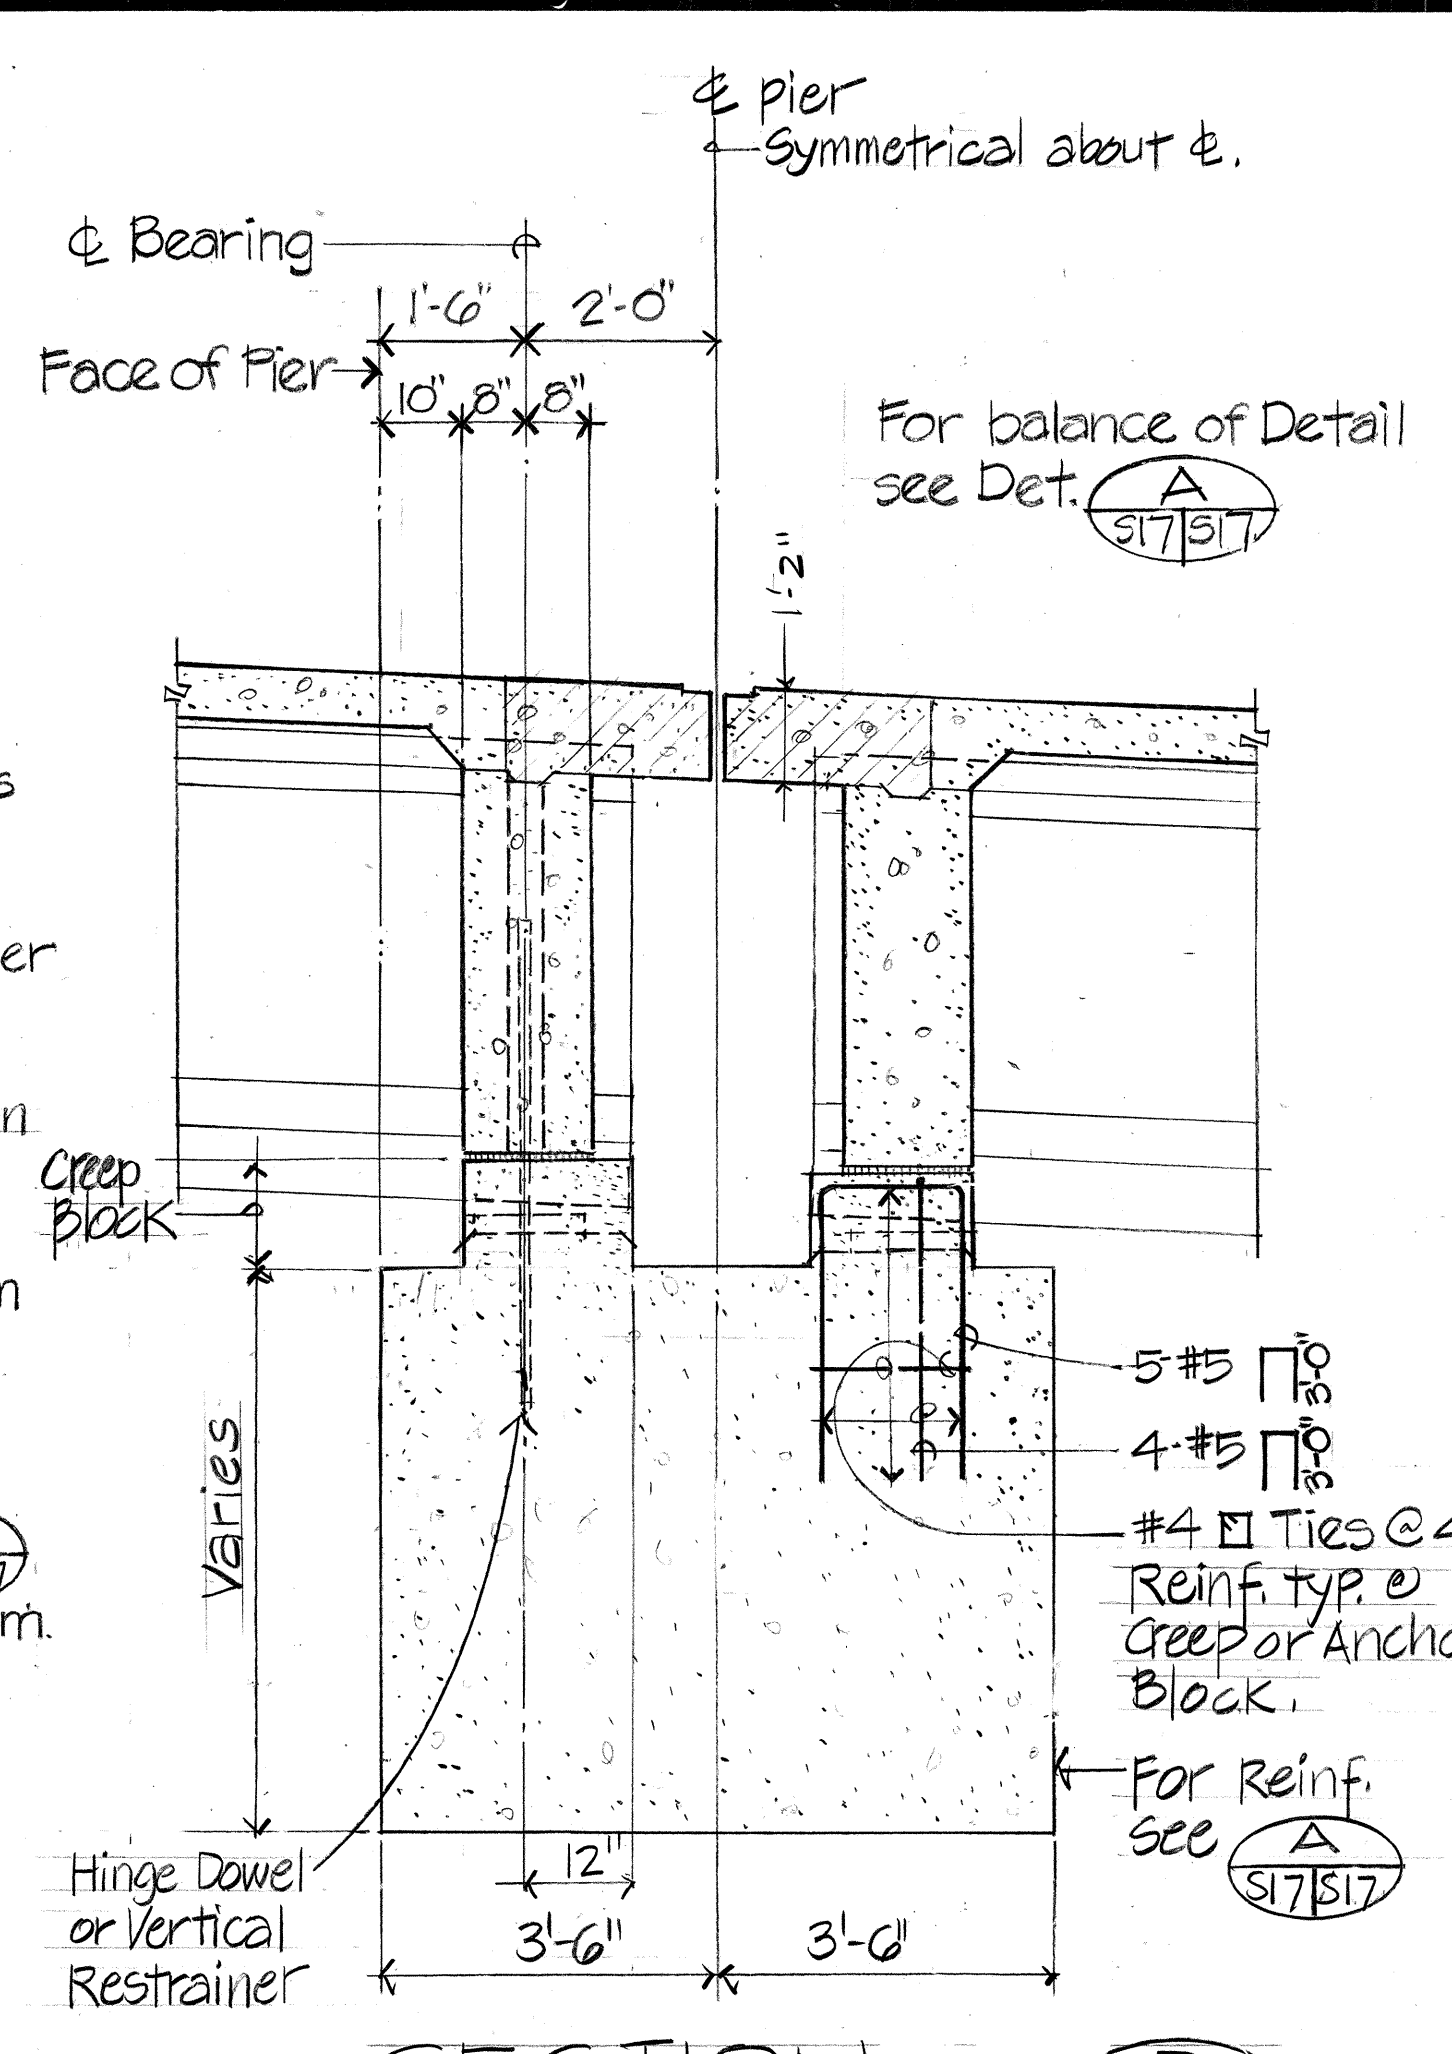


SECTION B
Scale: 1/2" = 1'-0" S16, S14, S15, S17, S17

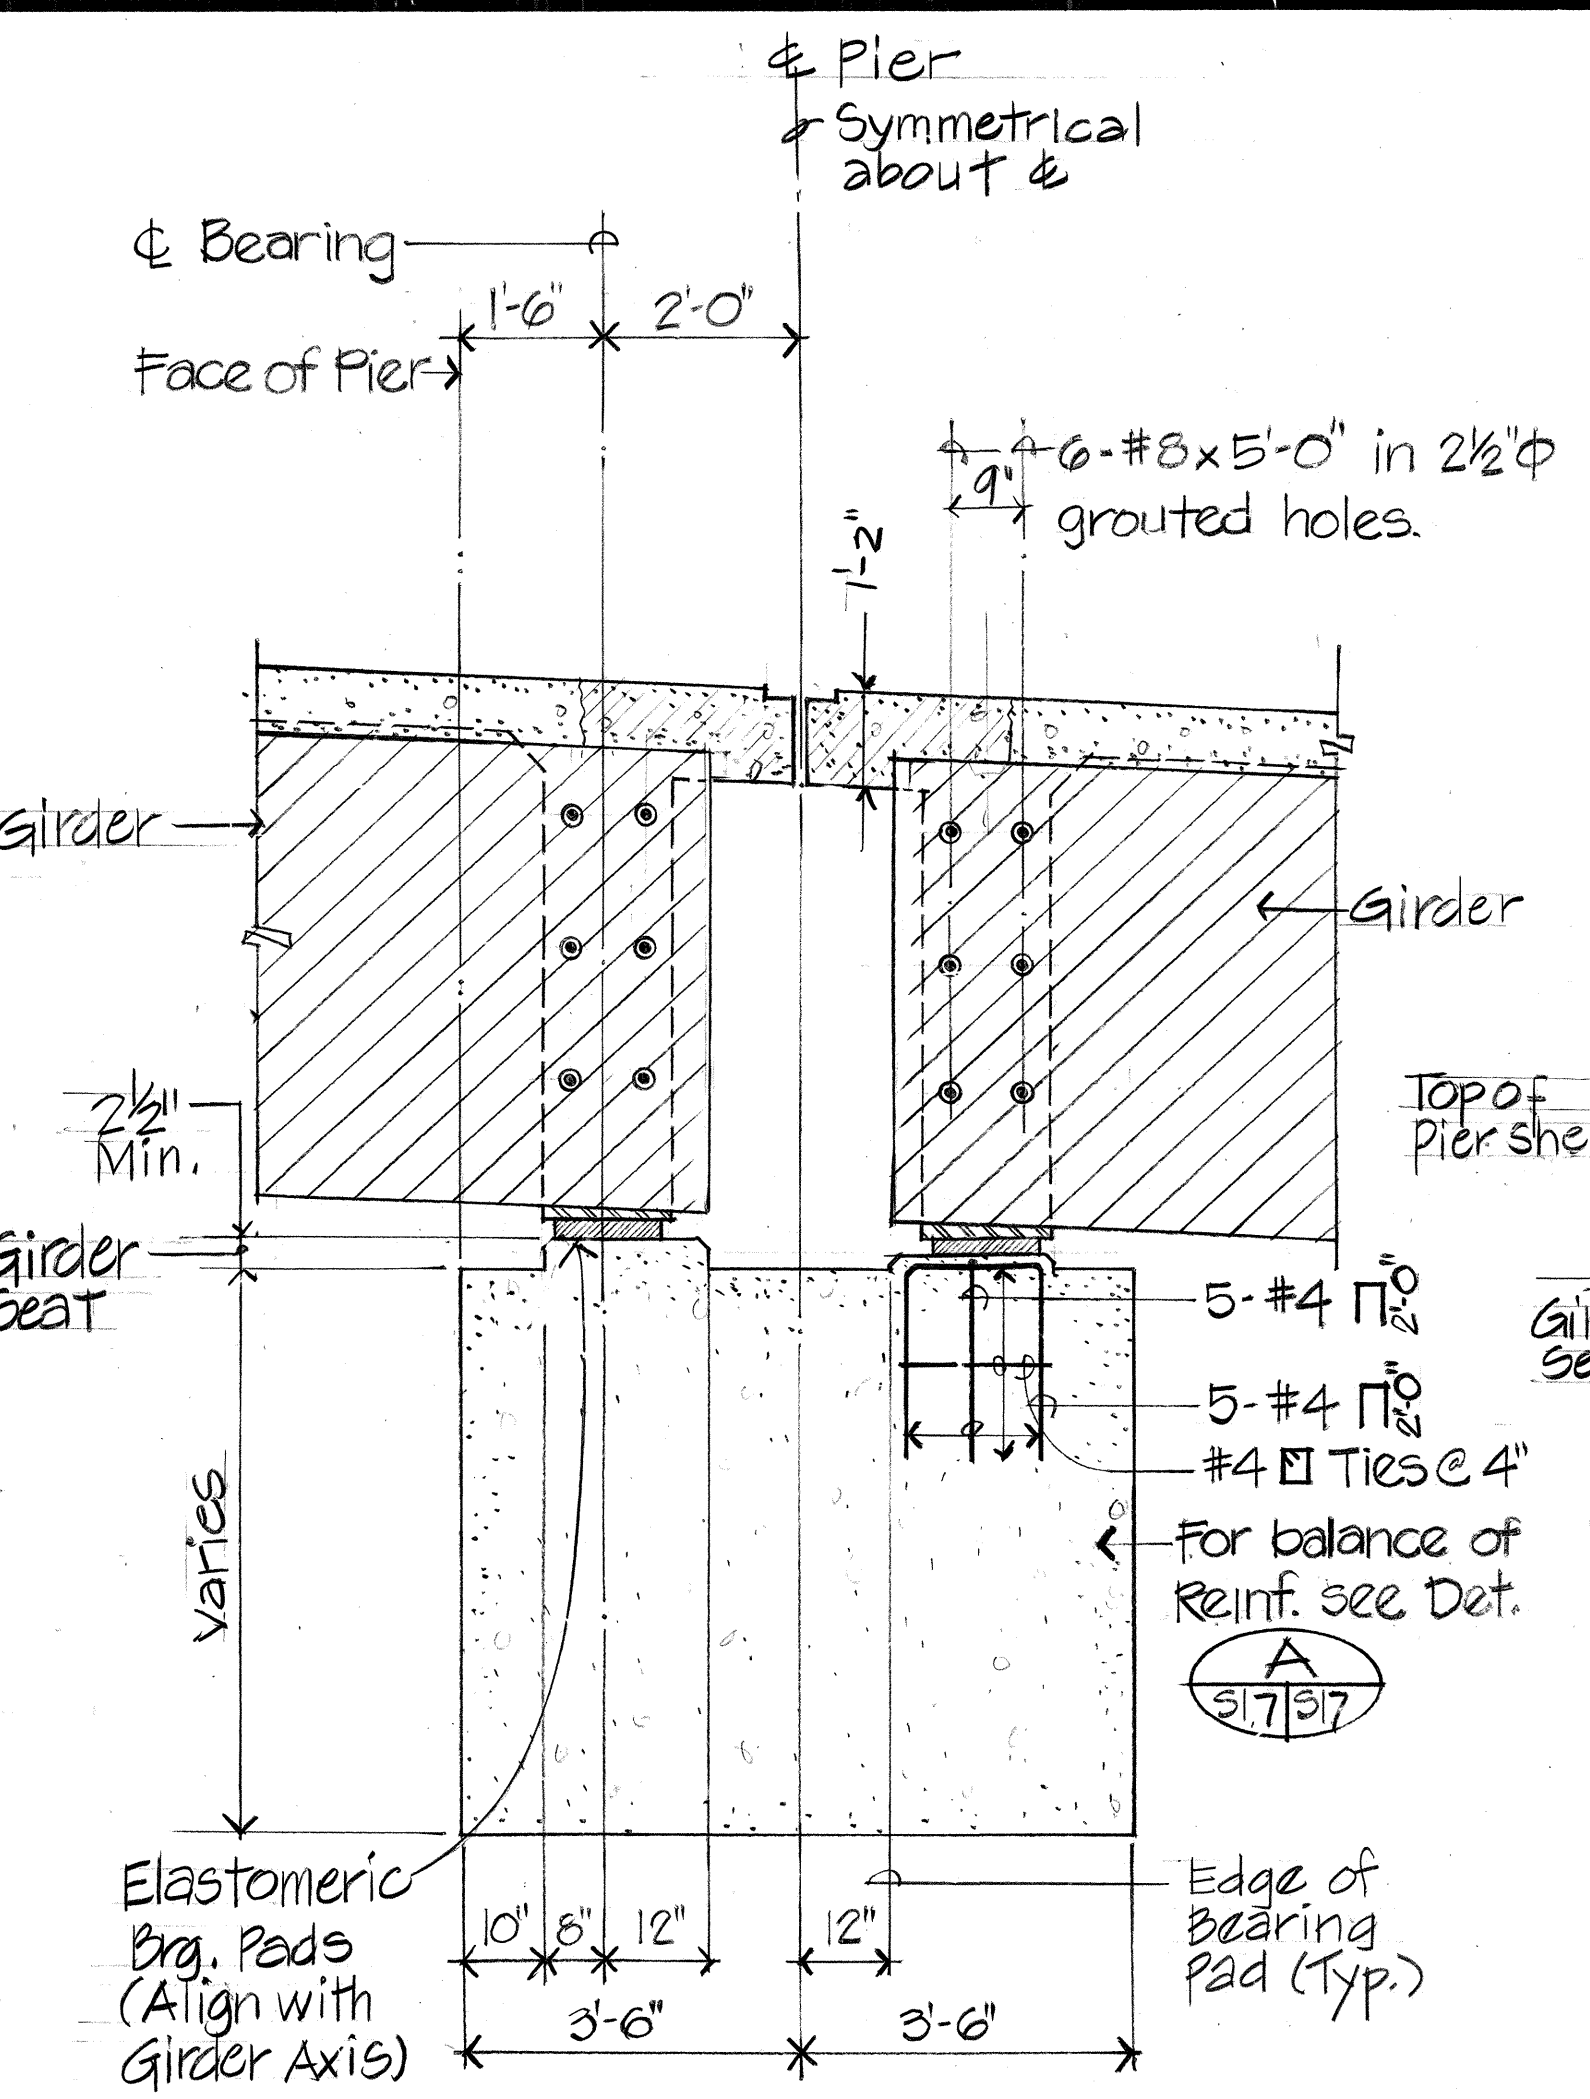


SECTION C
Scale 1/2" = 1'-0" S16, S14, S15, S17

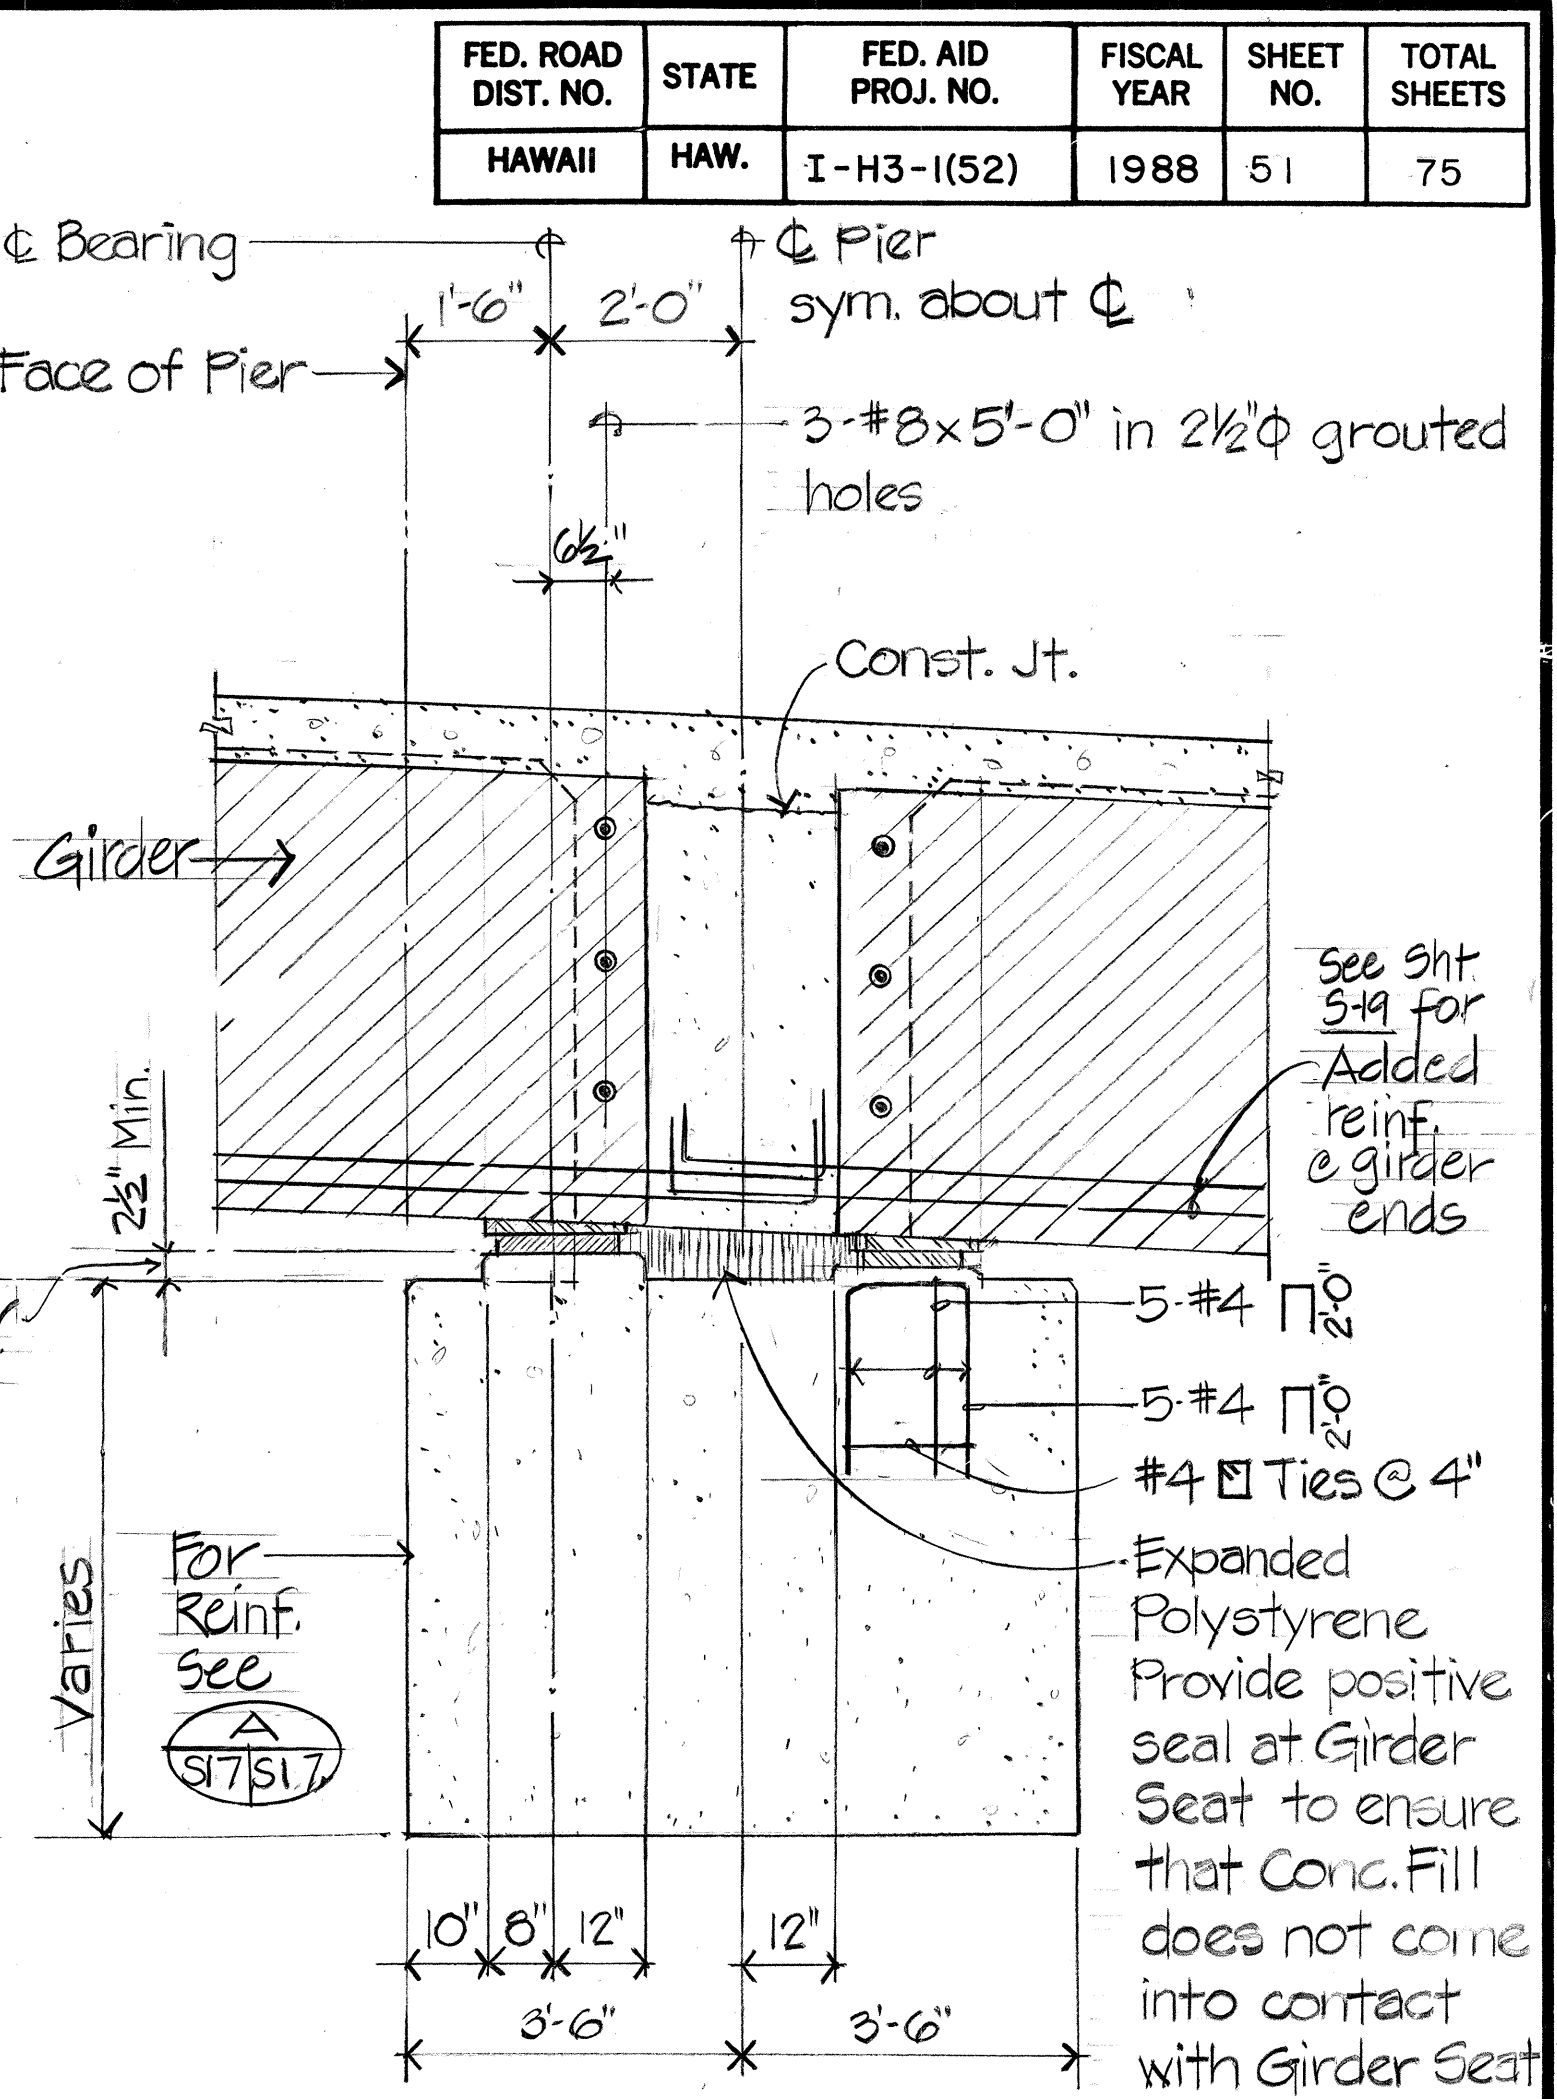


SECTION D
Scale 1/2" = 1'-0" S14, S15, S17

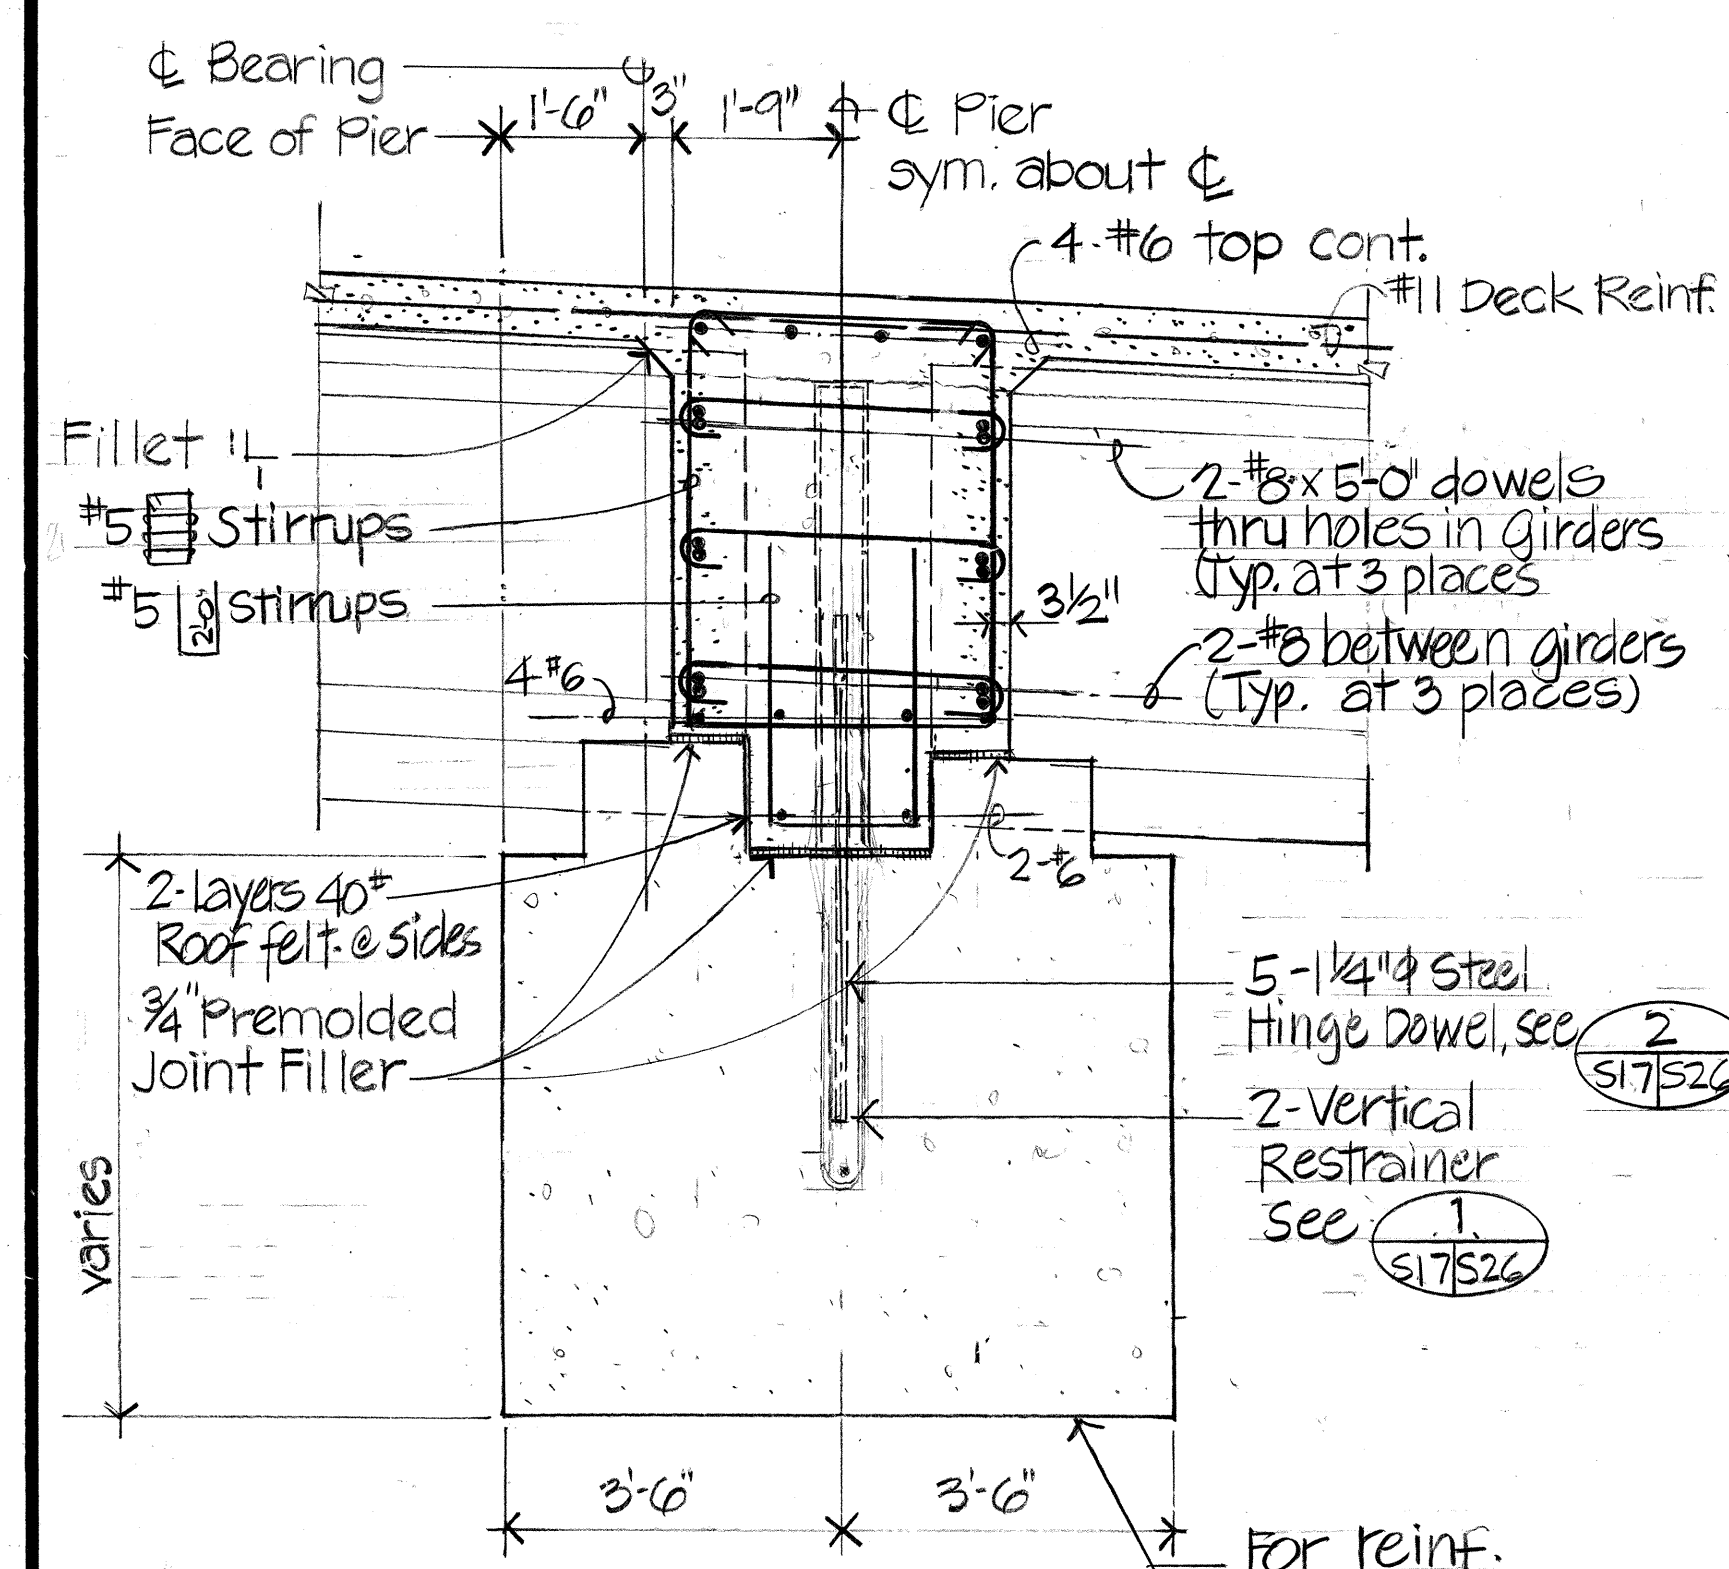

SECTION E
Scale: 1/2" = 1'-0" S14, S17

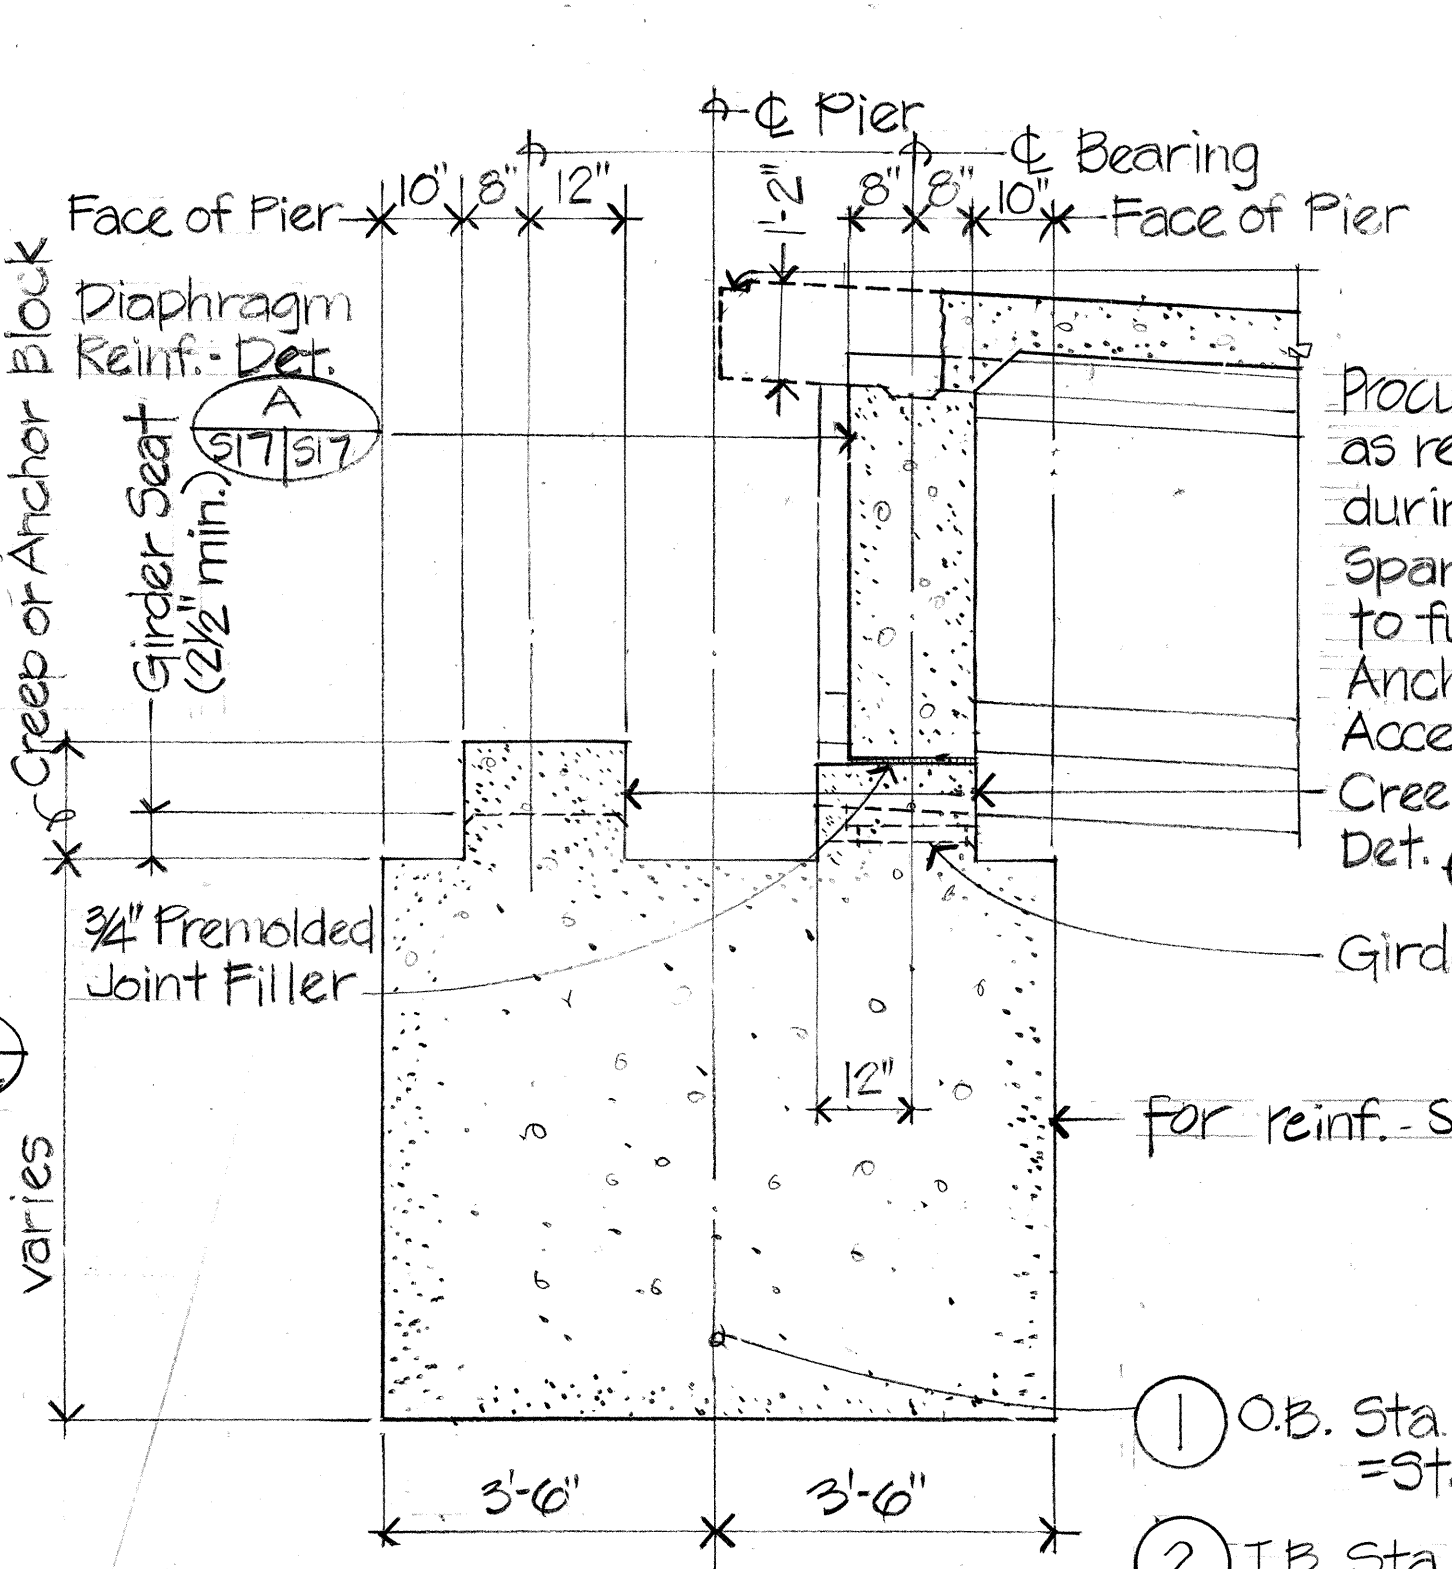

SECTION F
Scale 1/2" = 1'-0" S16, S17

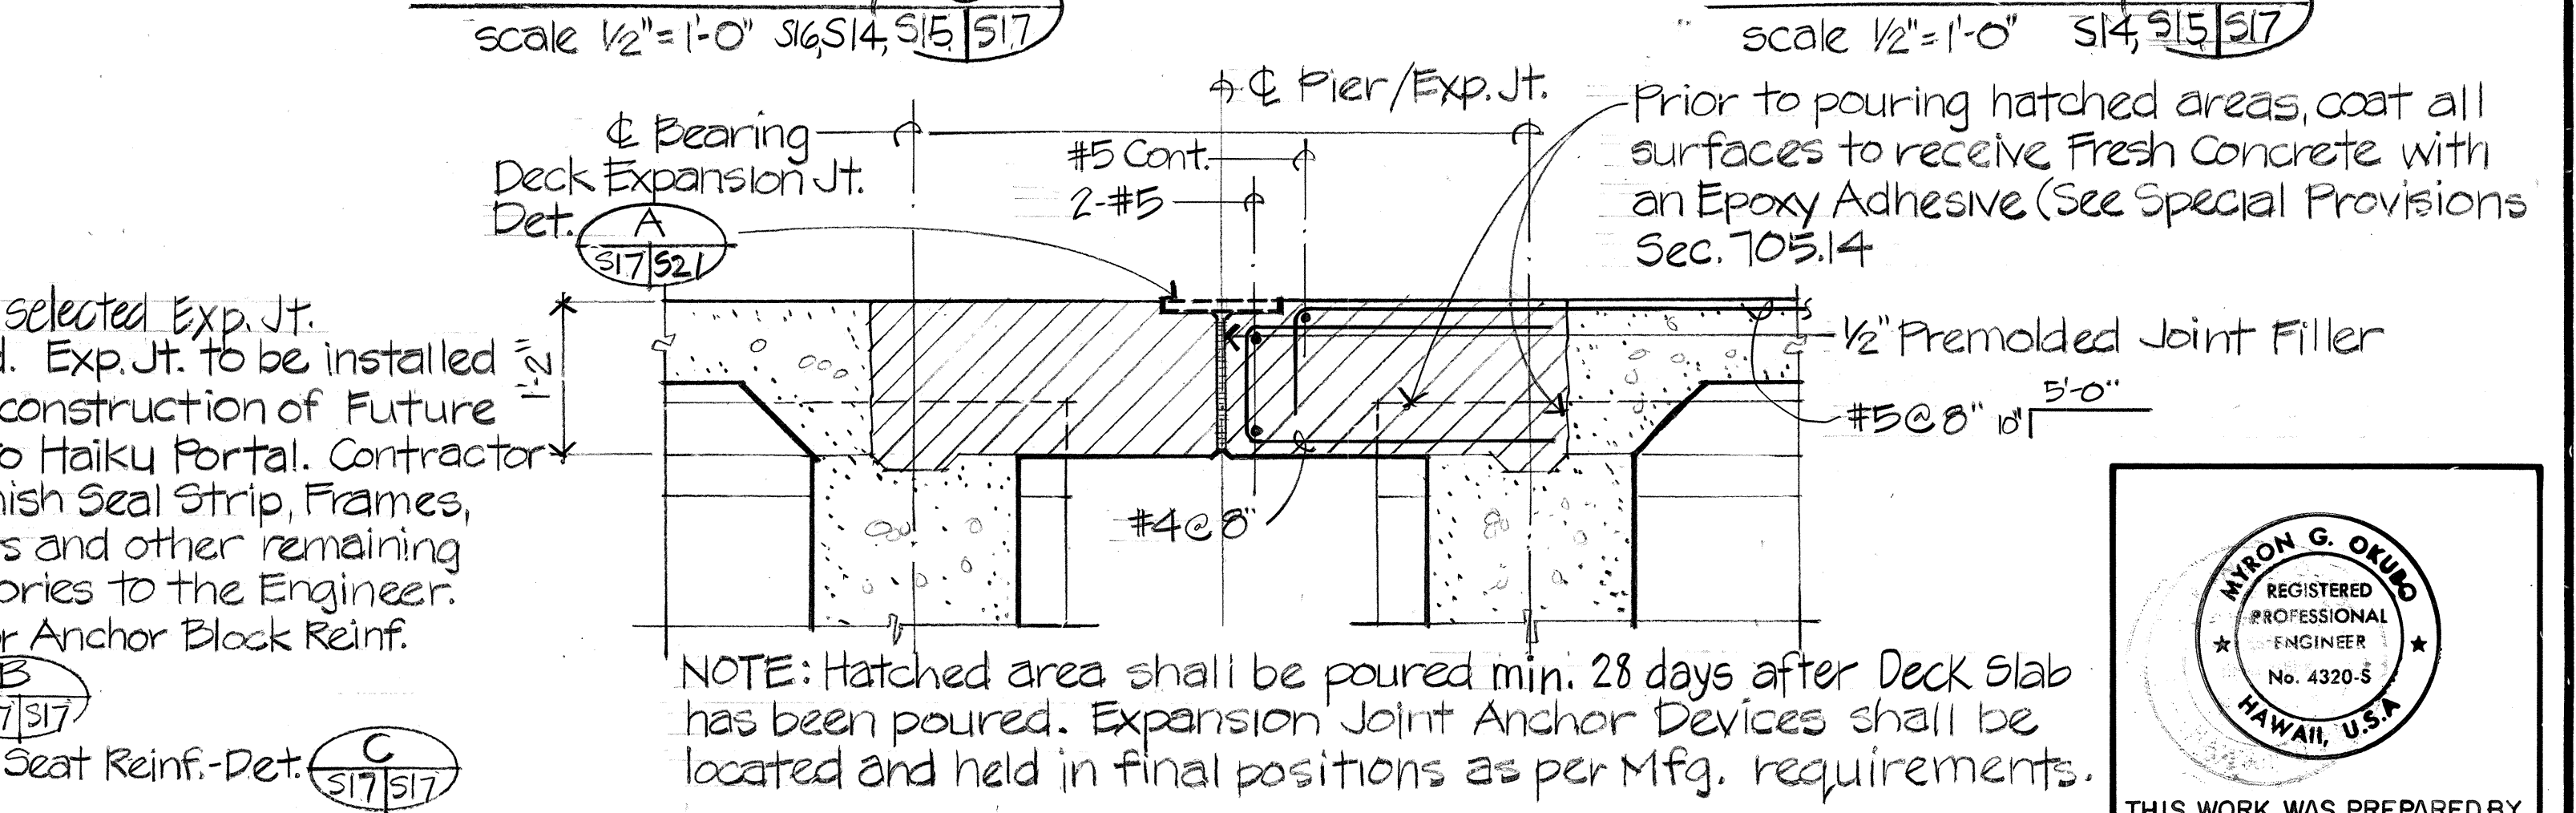

CLOSURE POUR DETAIL G
No Scale S15/S17

- 1 O.B. Sta. 658+00 (Trans-Koolau Tunnel) = Sta. 258+00 (Haiku Valley Bridge) Eq.
- 2 I.B. Sta. 257+60 (Haiku Valley Bridge) Similar



THIS WORK WAS PREPARED BY ME OR UNDER MY SUPERVISION
Myron Oshiro

STATE OF HAWAII
DEPARTMENT OF TRANSPORTATION
HIGHWAYS DIVISION

PIER SECTIONS

INTERSTATE ROUTE H-3
F.A.I. PROJECT NO. I-H3-1(52)

SCALE: AS NOTED DATE: JULY 1988
SHEET NO. S17 OF S26 SHEETS


DATE	REVISION
1/10/89	Detail E Revised, Note Added to Detail F

AS BUILT


ADD. 51

DATE	_____
DESIGNED BY	_____
CHECKED BY	_____
NOTED BY	_____
ORIGINAL PLAN	_____
TRACED BY	_____
DESIGNED BY	_____
CHECKED BY	_____
NOTED BY	_____
ORIGINAL PLAN	_____


FED. ROAD DIST. NO.	STATE	FED. AID PROJ. NO.	FISCAL YEAR	SHEET NO.	TOTAL SHEETS
HAWAII	HAW.	I-H3-1(52)	1988	52	75

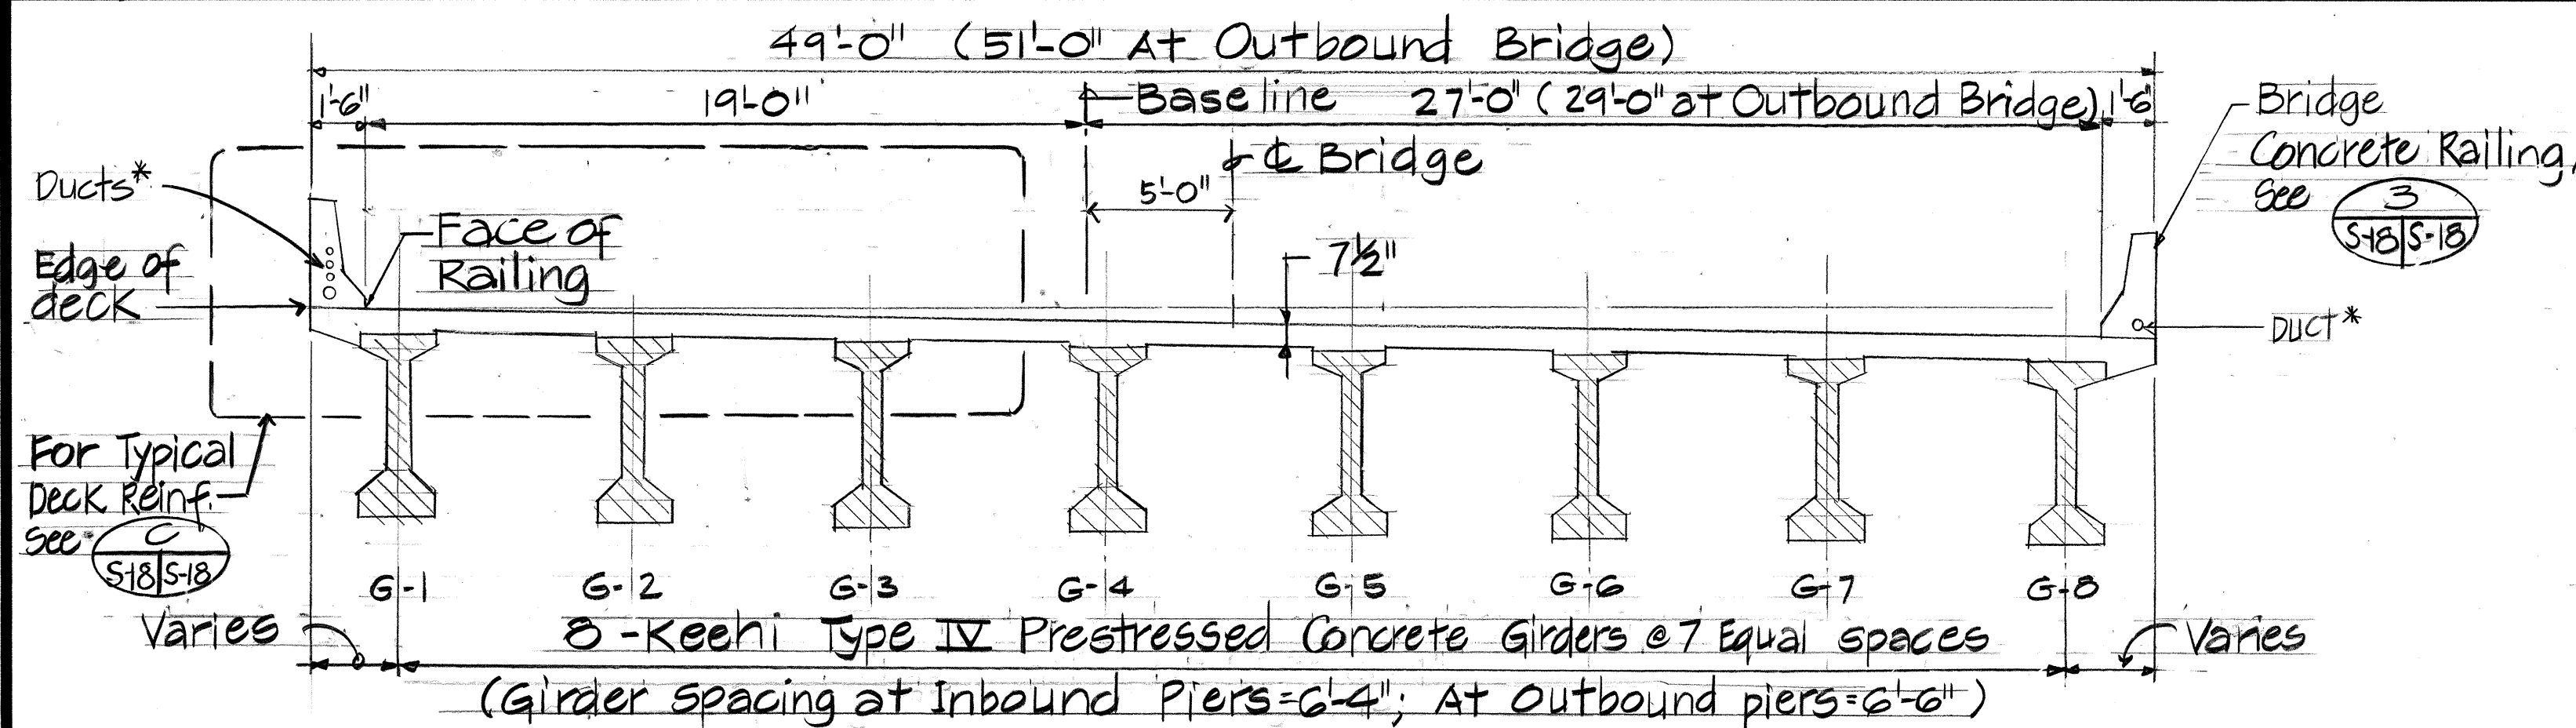

TYPICAL BRIDGE CROSS SECTION A
Scale: 1/4" = 1'-0"

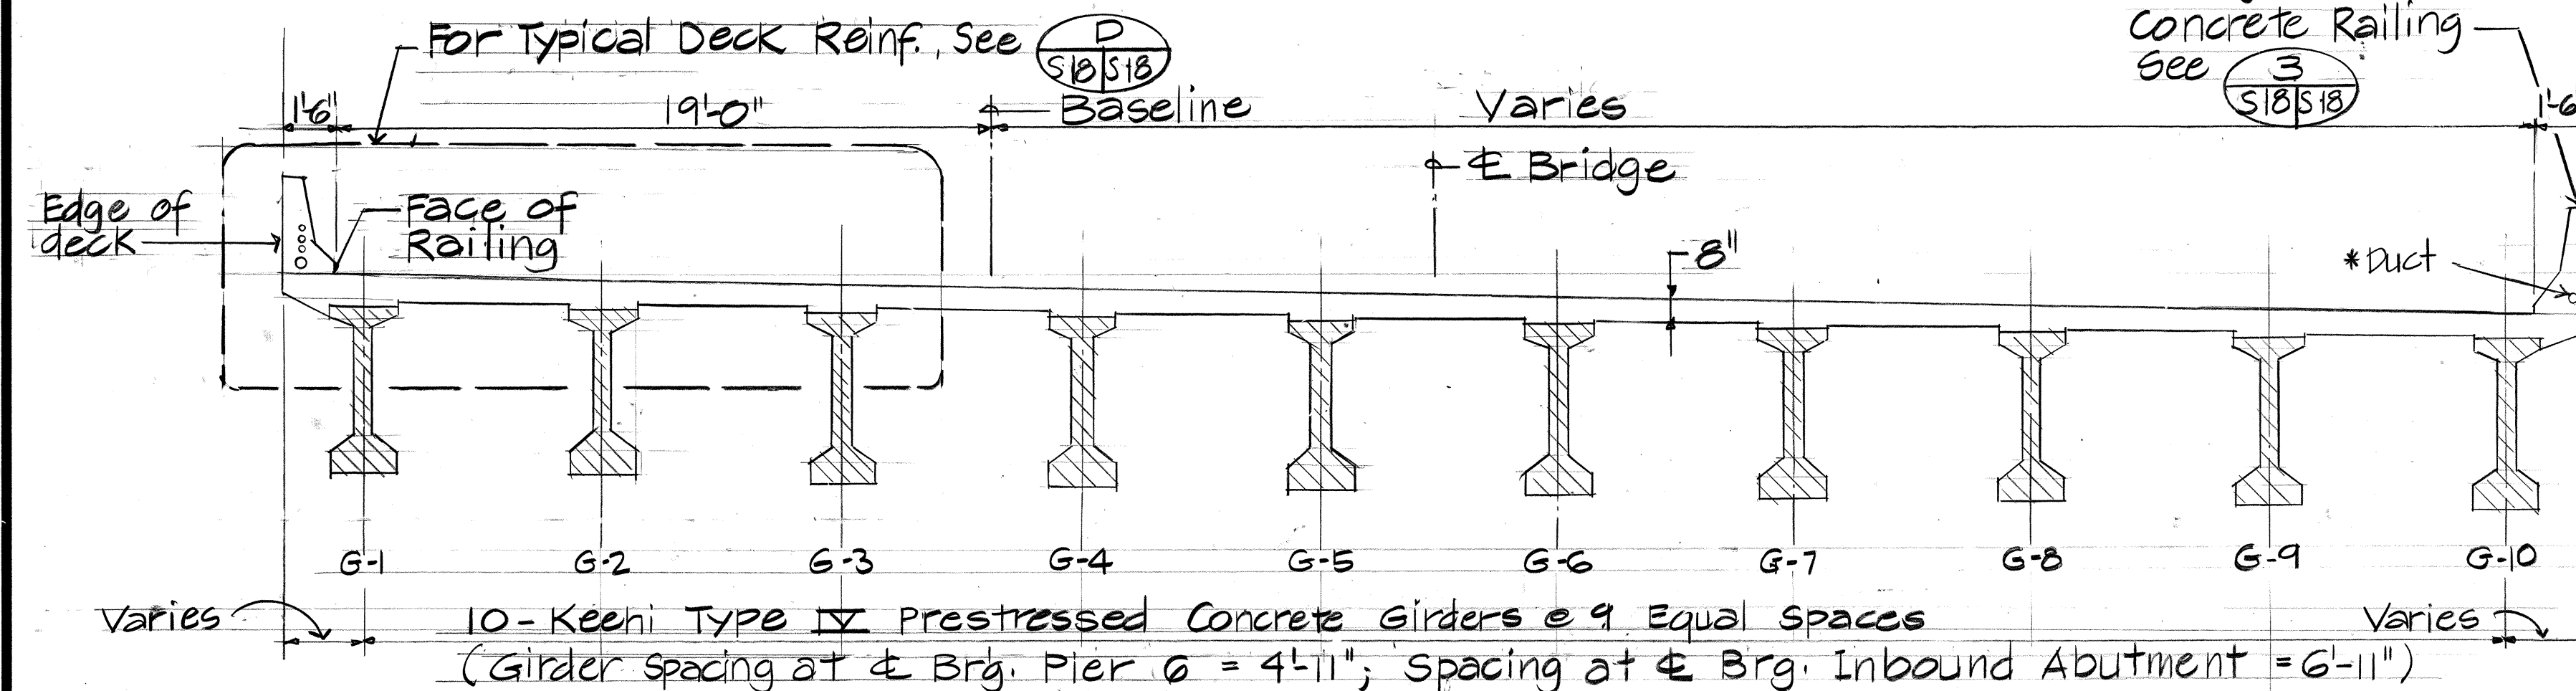


SPAN 6 INBOUND BRIDGE CROSS-SECTION B
Scale: 1/4" = 1'-0"

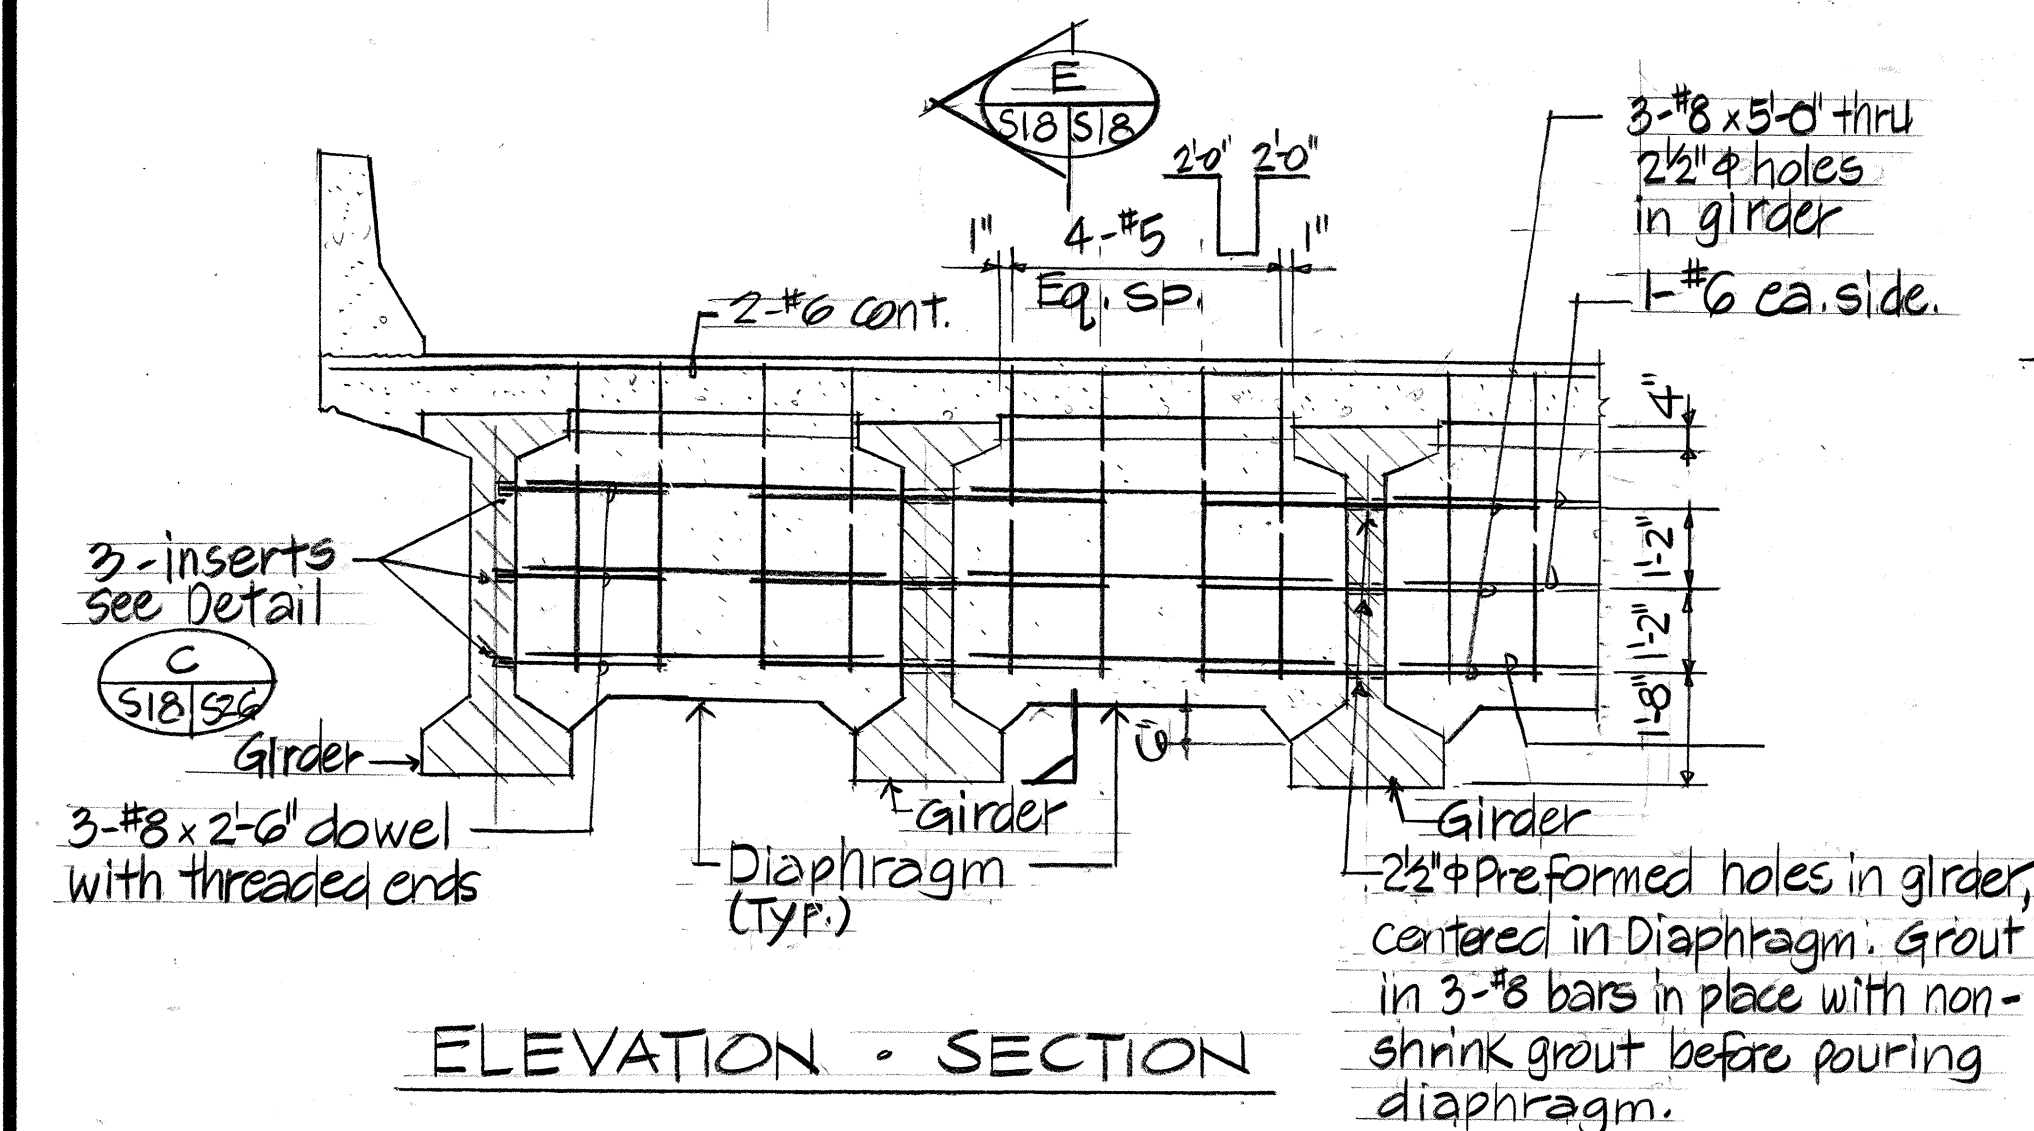

ELEVATION - SECTION


INTERMEDIATE DIAPHRAGM DETAIL
Scale: 3/8" = 1'-0"

Indicates location of MIG welds on each side of WWF Mat.

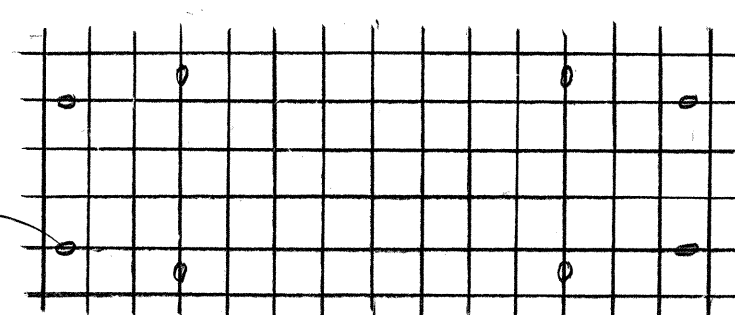


WWF 6x6-W2.9xW2.9 SPLICE DETAIL
No Scale: (2) S18/S18

SECTION E
Scale: 3/4" = 1'-0"

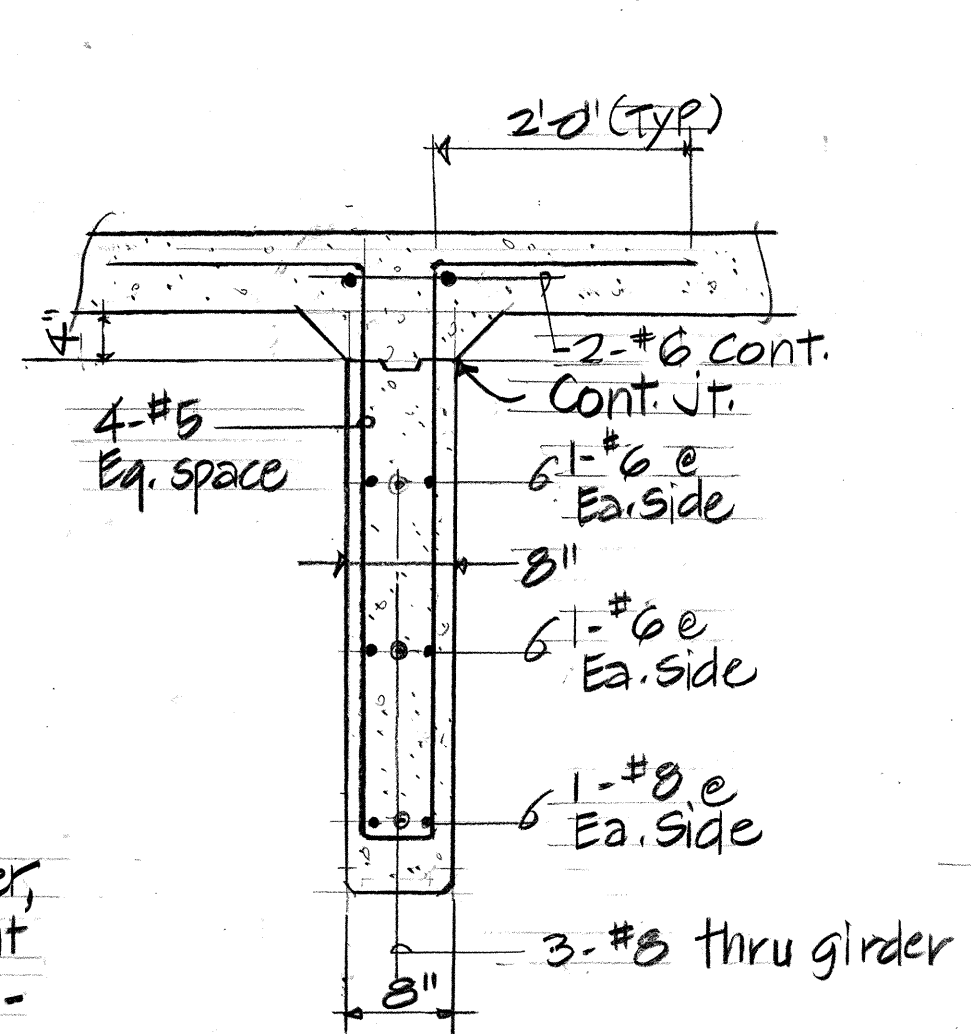


BRIDGE CONCRETE RAILING REINF. DETAIL
Scale: 1" = 1'-0"


* For Power, Communication, Lighting & Radio Ducts See Electrical Drawings.

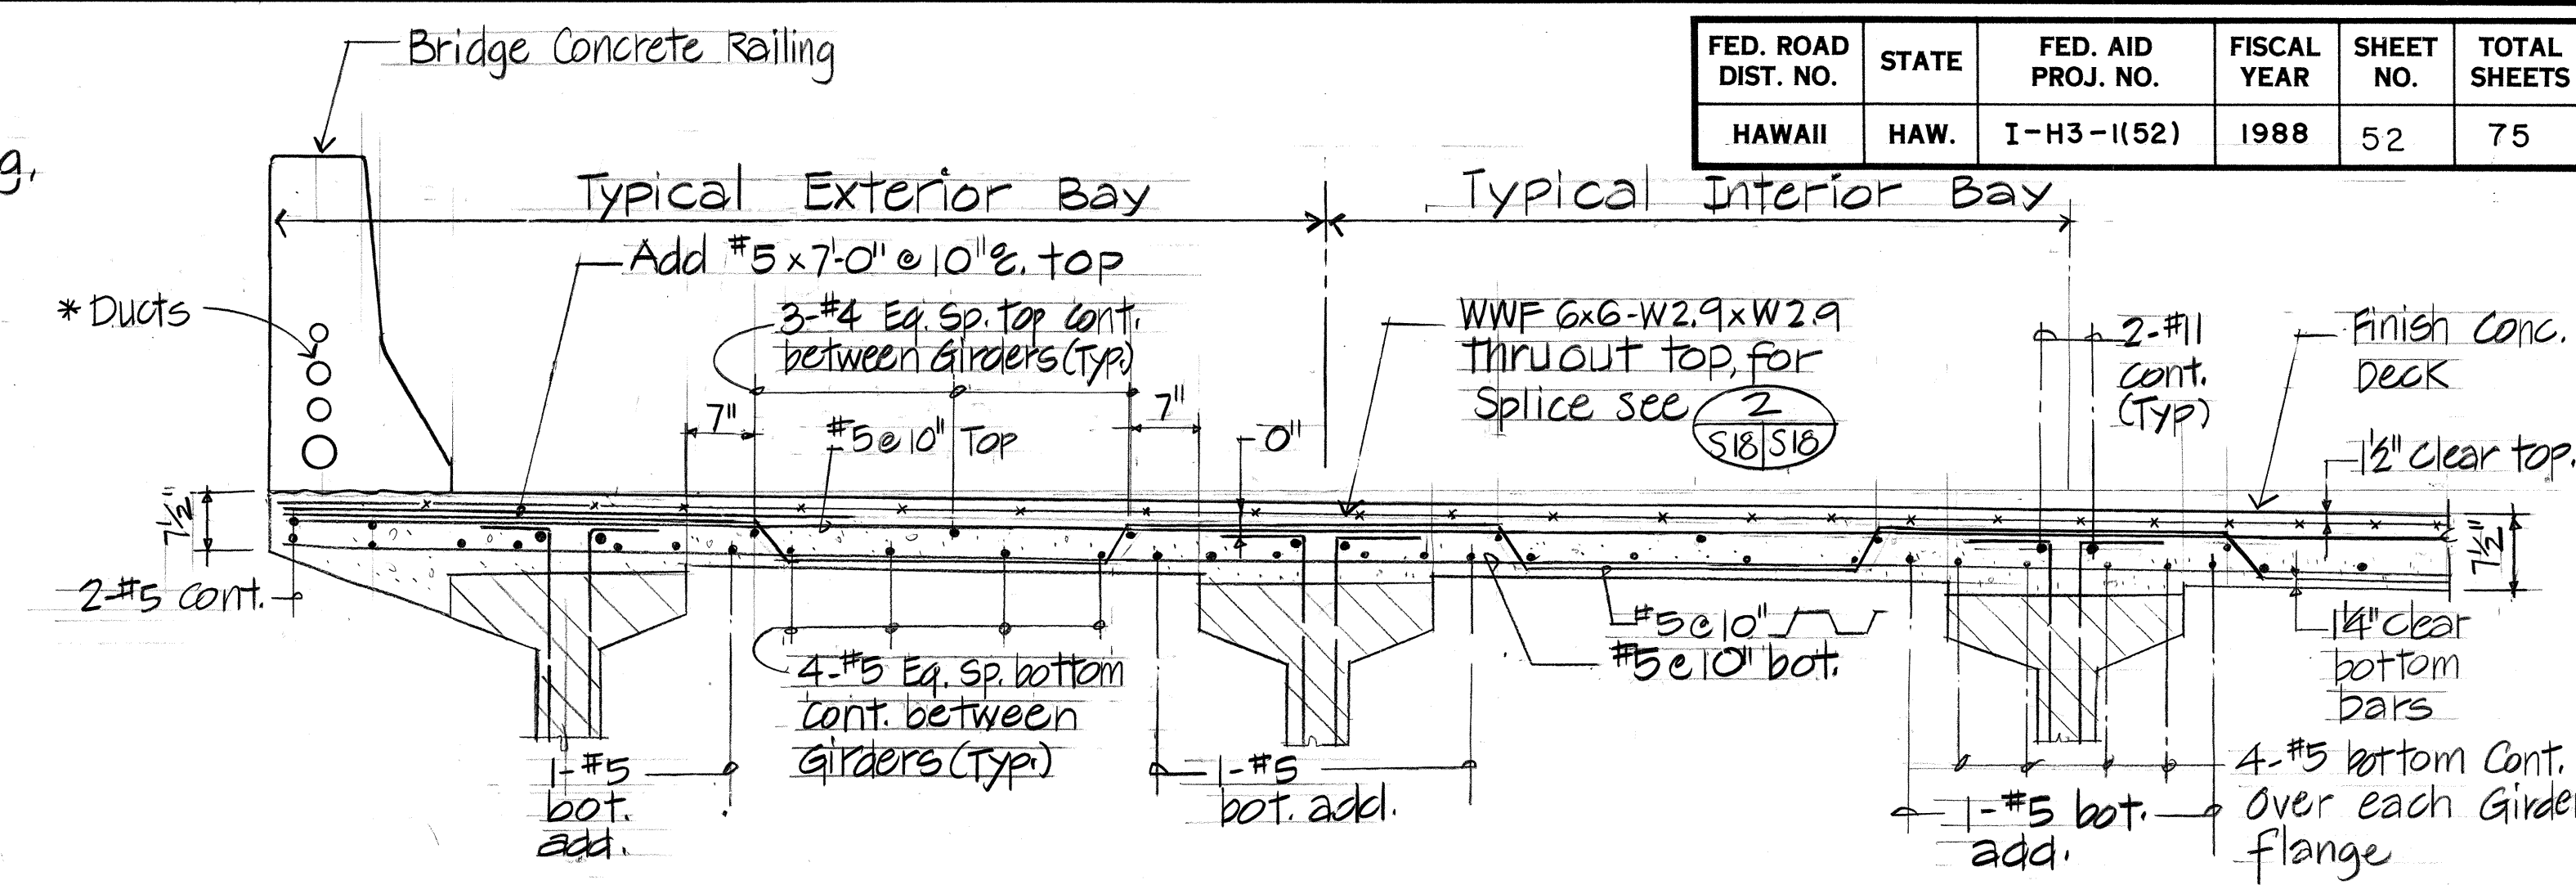

TYPICAL DECK REINFORCING C
Scale: 3/4" = 1'-0"

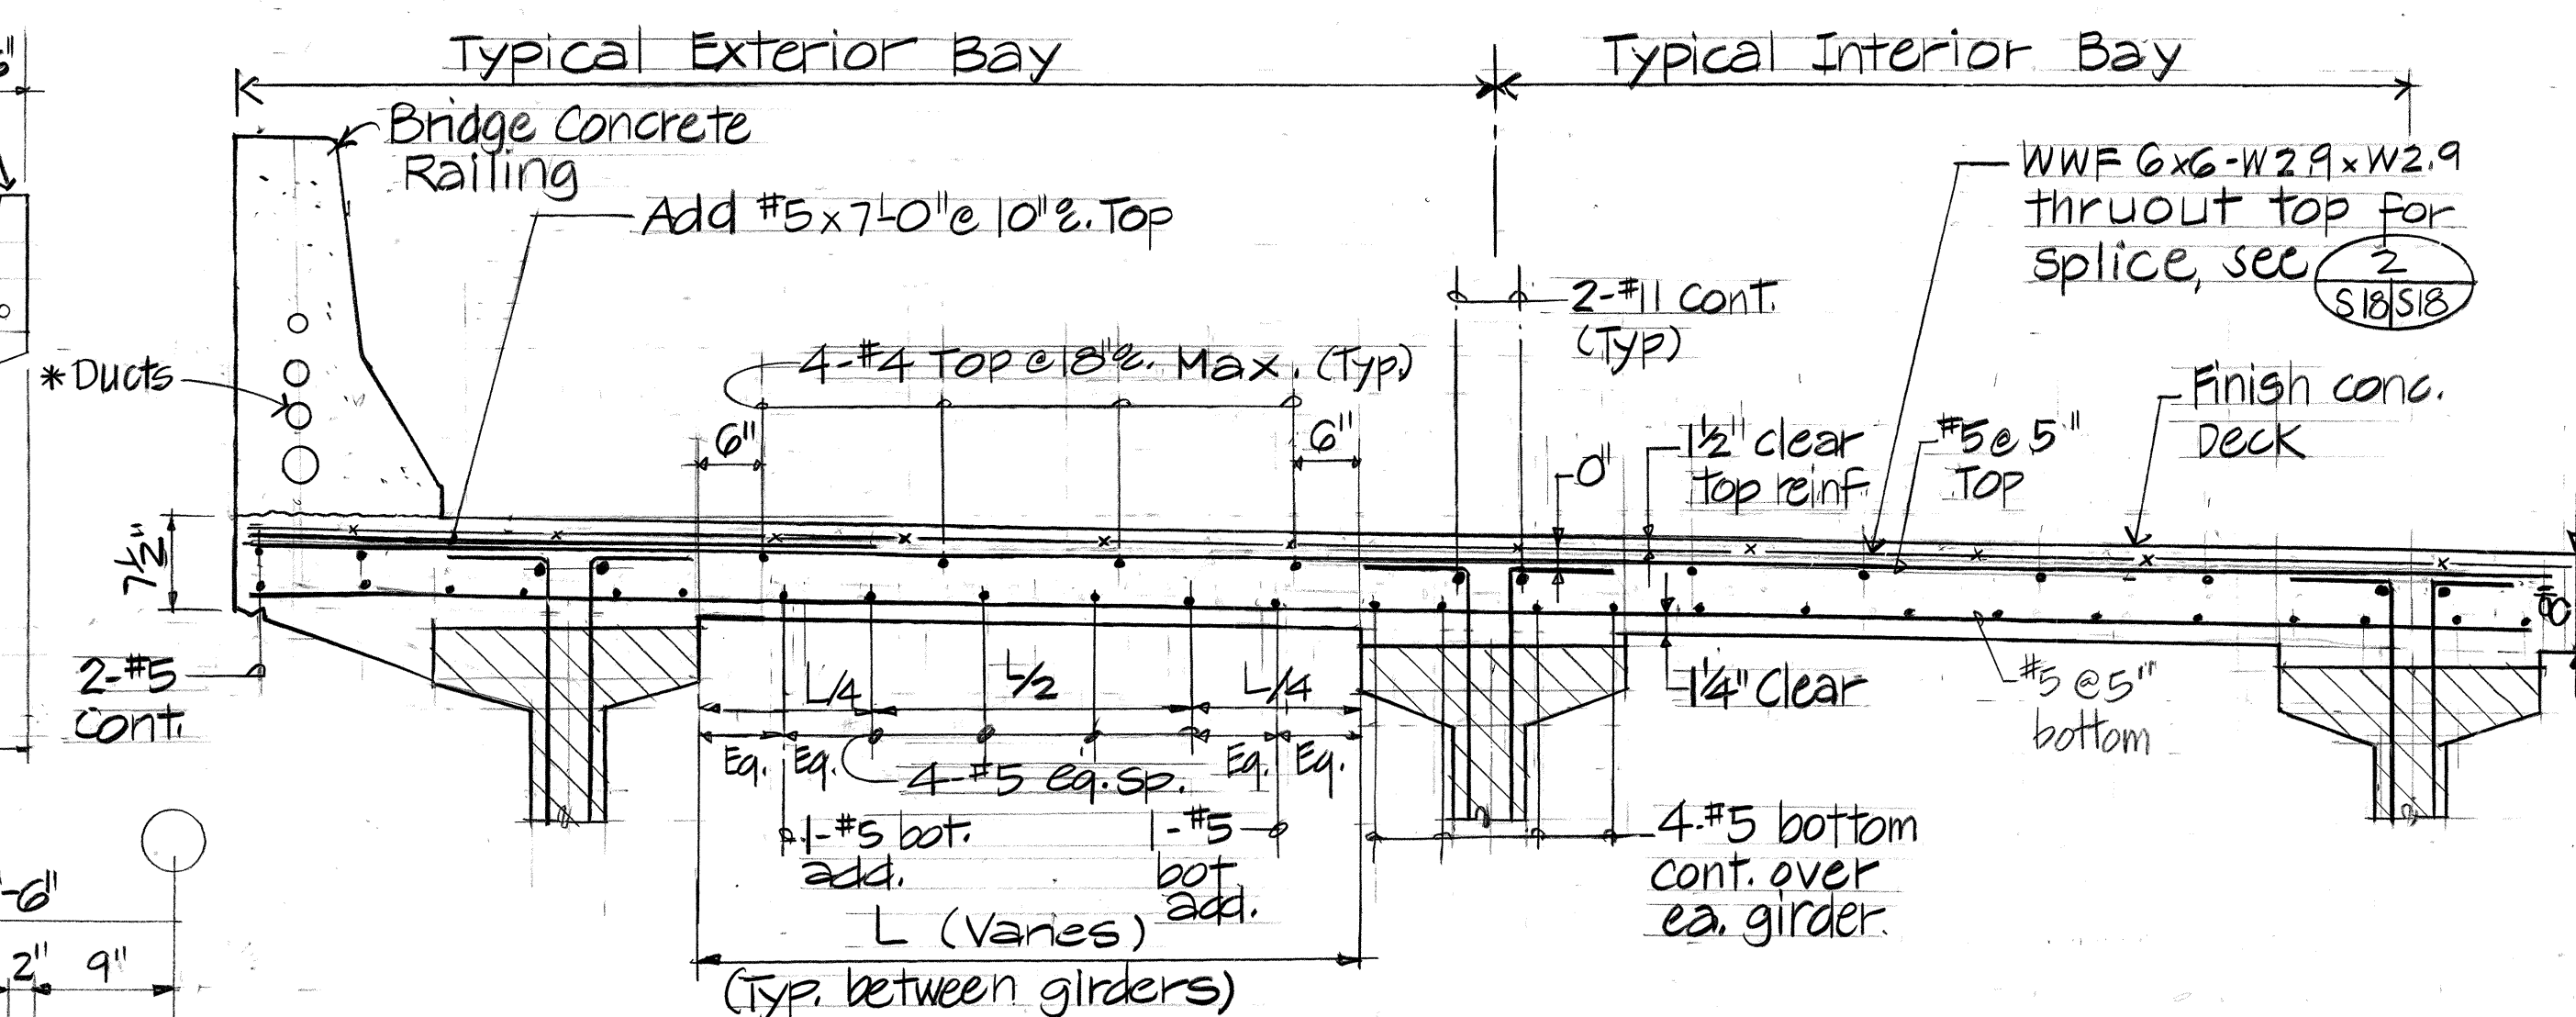

SPAN 6 INBOUND DECK REINFORCING D
Scale: 3/4" = 1'-0"

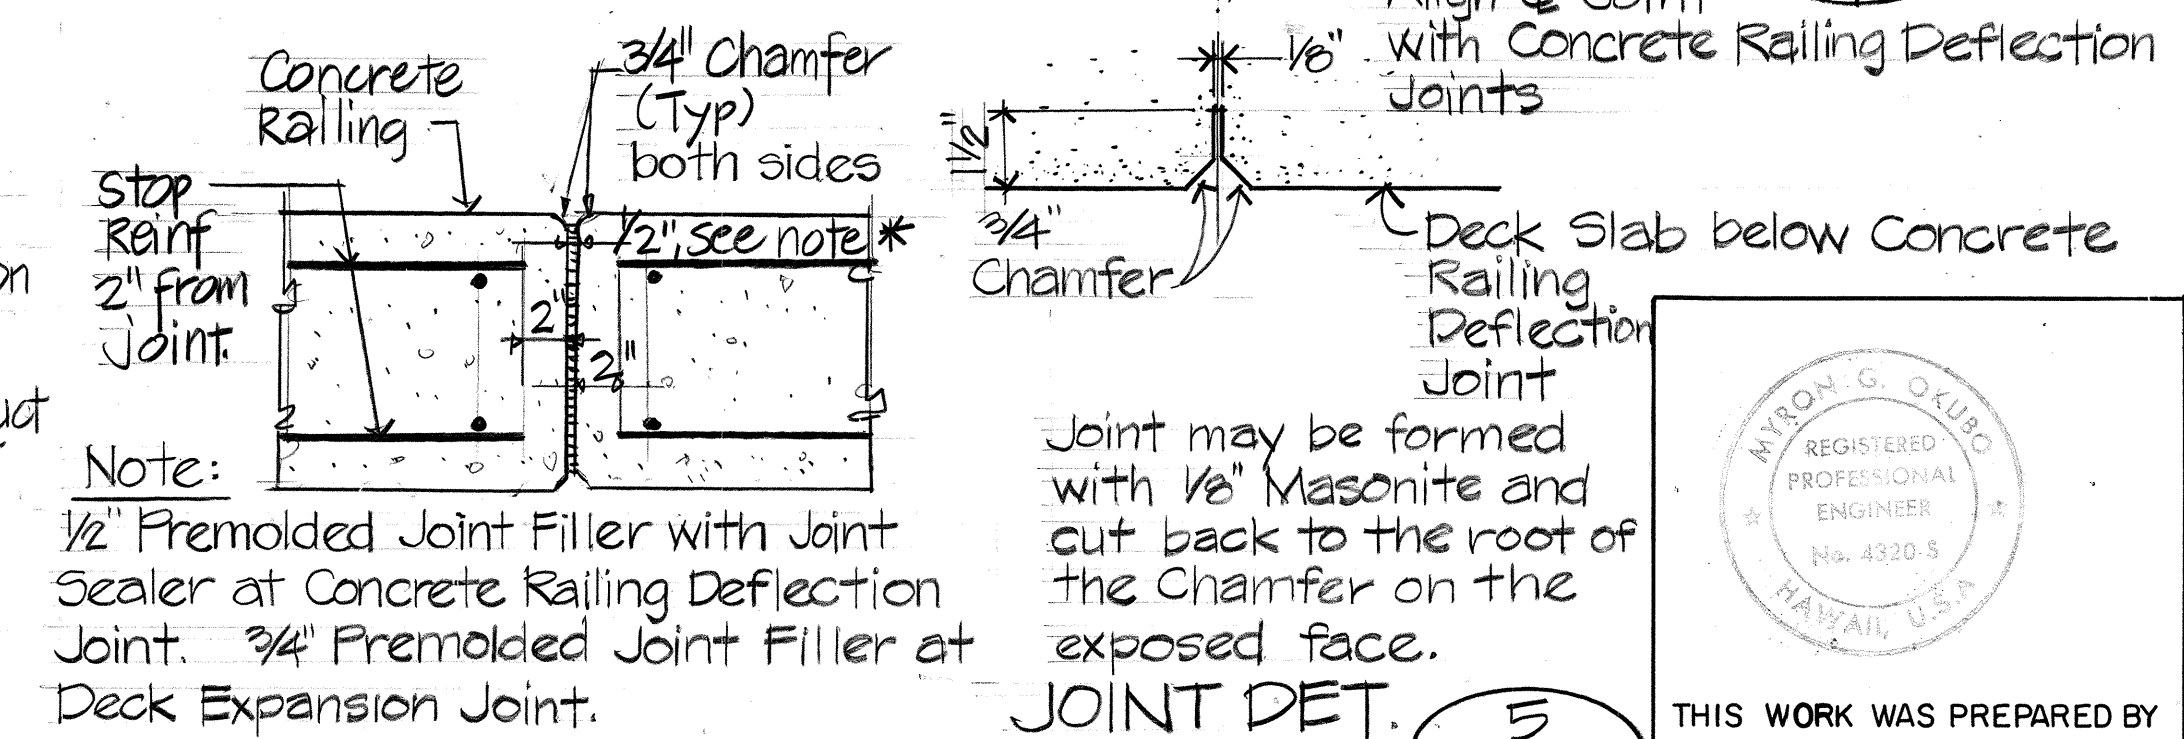

CONCRETE RAILING DEFLECTION JOINT
No Scale: (4) S18/S18

Joint may be formed with 1/2" Masonite and cut back to the root of the Chamfer on the exposed face.

JOINT DET. E
No Scale: (5) S18/S18

STATE OF HAWAII
DEPARTMENT OF TRANSPORTATION
HIGHWAYS DIVISION

DECK REINFORCEMENT DETAILS

INTERSTATE ROUTE H-3
F.A.I. PROJECT NO. I-H3-1(52)

SCALE: AS NOTED DATE: JULY 1988


SHEET No. S18 OF S26 SHEETS

DATE	REVISION
1/10/89	3" Power Ducts Revised Detail 4 Revised, Detail 5 Added

AS BUILT

ADD. 52

DATE	DESIGNED BY	CHECKED BY
1/10/89	DESIGNED BY	CHECKED BY
1/10/89	DESIGNED BY	CHECKED BY

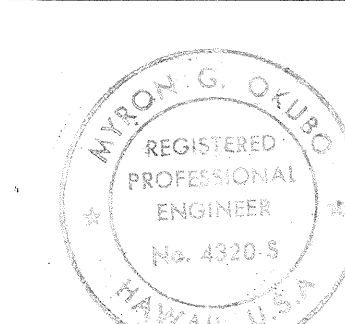

THIS WORK WAS PREPARED BY ME OR UNDER MY SUPERVISION

Myron Okada


FED. ROAD DIST. NO.	STATE	FED. AID PROJ. NO.	FISCAL YEAR	SHEET NO.	TOTAL SHEETS
HAWAII	HAW.	I-H3-1(52)	1988	53	75

PRESTRESSED GIRDER NOTES:

PRETENSIONING

- Concrete shall have a minimum ultimate 28 day compressive strength of 6000 psi. Minimum ultimate concrete compressive strength before release of strands is $f_{ci} = 5000$ psi.
- Prestensioned strands are $\frac{1}{2}$ " dia. 7 wire low-relaxation steel strands (Area = 0.531 in²) with an ultimate strength of 270 KSI, and shall conform to ASTM A416.
- Total long term losses due to creep, shrinkage, elastic shortening and relaxation of steel = 45 KSI.
- Strand pattern shall be selected to provide the effective working force, after all losses, indicated on the plans, and to induce no eccentric force about the girder longitudinal centerline.
- Strands shall be released in such a manner as to minimize lateral eccentricity. Contractor shall submit his proposed strand pattern and sequence of release to the Engineer for review.
- Care shall be taken during curing, transportation and erection to avoid any lateral deflection of the girder.
- Lifting loops or other embedded items used to lift and transport the girders shall be located as close as possible to the girder centerline of bearing. The contractor shall be responsible for the adequacy of the lifting device. The contractor shall submit details indicated the type and location of lifting devices to the Engineer for review.
- Allowable concrete stresses:
 - Temporary compressive stress at release = 3000 psi.
 - Compressive stress after losses = 2400 psi.
 - Temporary tensile stress at release = 200 psi.
 - Tensile stress after losses = 0
- Mild steel reinforcing to conform to ASTM A615 Grade 40.


Calculated Camber includes the effects of the initial prestress force and weight of girder at removal from the girder prestressing bed. Negative value shown indicates a net upward deflection. The Calculated Camber does not account for any Camber Growth of the girder. The actual camber shall not exceed the calculated camber by more than 100%.

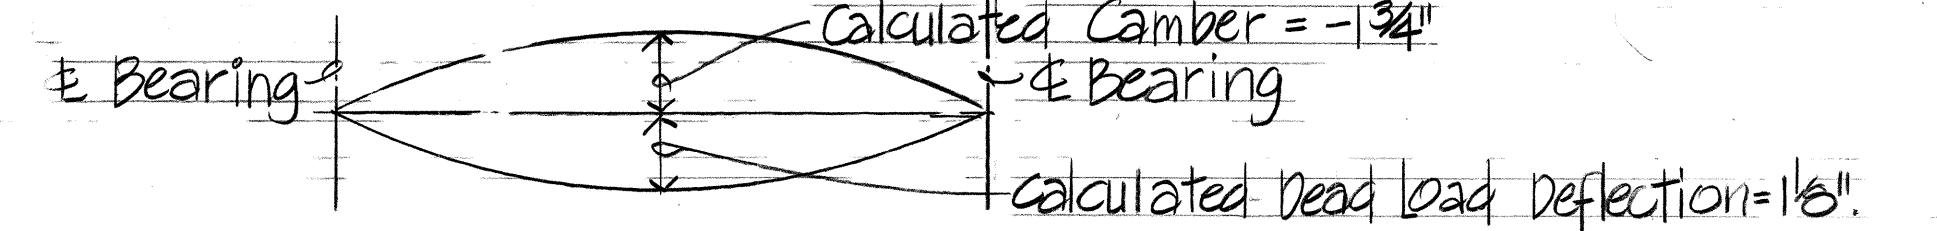

Calculated Dead Load Deflection accounts for the effects of the weight of deck slab, haunches, and diaphragms.

CAMBER DIAGRAM

No scale.

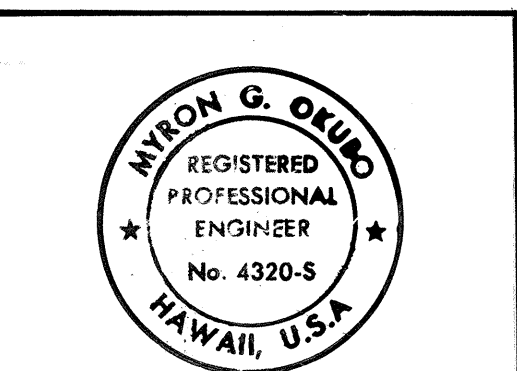

THIS WORK WAS PREPARED BY ME OR UNDER MY SUPERVISION
Myron Oshiro


STATE OF HAWAII
DEPARTMENT OF TRANSPORTATION
HIGHWAYS DIVISION

GIRDER SECTIONS

INTERSTATE ROUTE H-3
F.A.I. PROJECT NO. I-H3-1(52):


SCALE: AS NOTED DATE: JULY, 1988

SHEET No. 519 OF 526 SHEETS

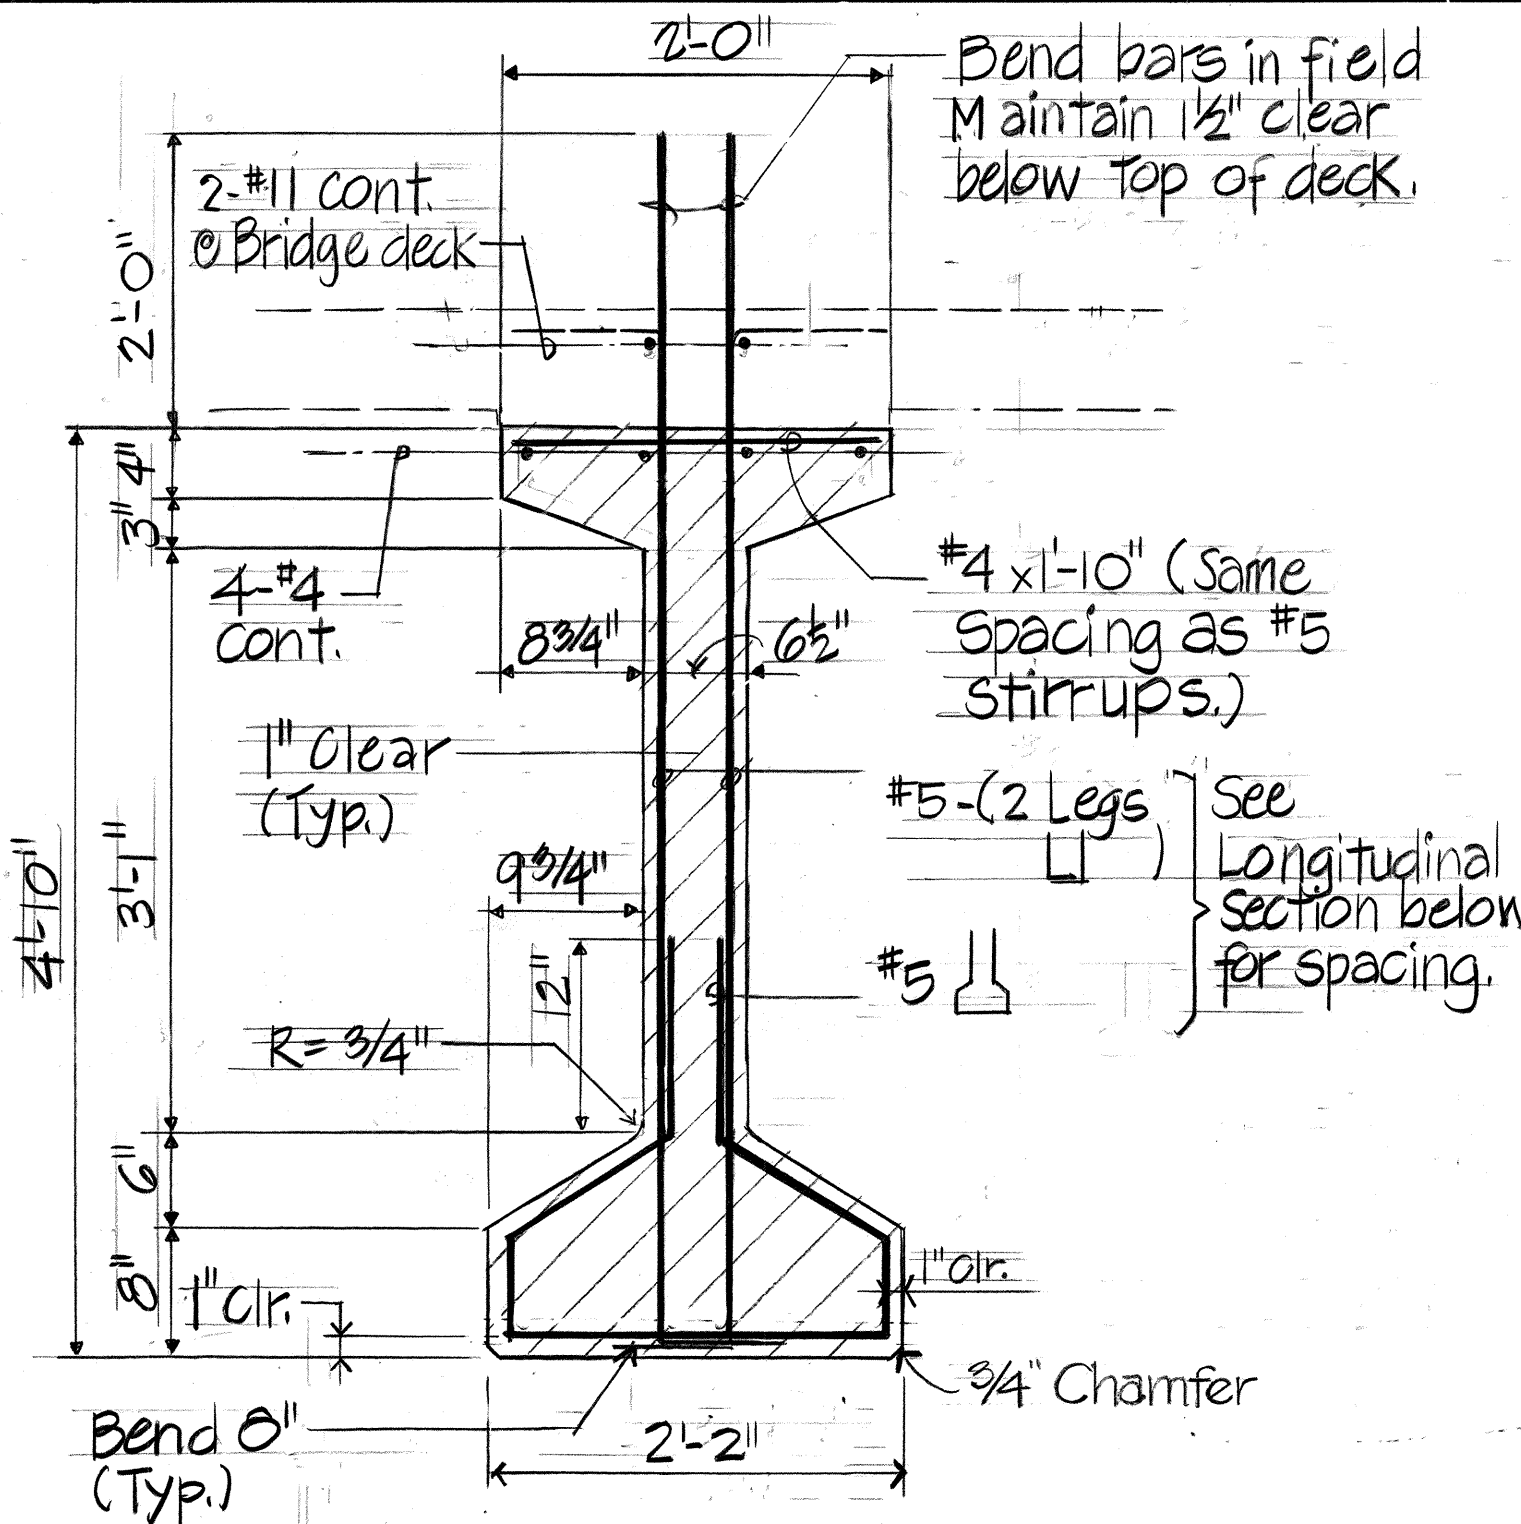


KEEHI IV GIRDER
TYPICAL GIRDER SECTION

Scale: 1" = 1'-0"

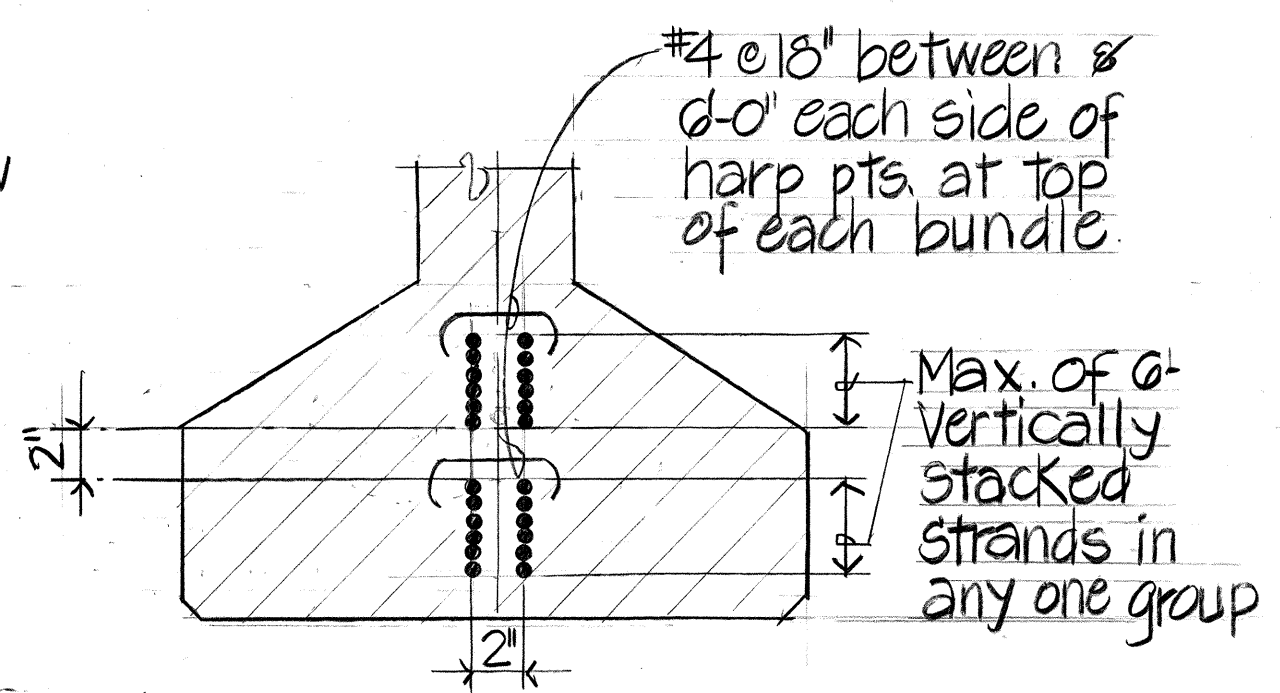


BUNDLED PRESTRESSING
REINFORCEMENT DETAIL

No scale.

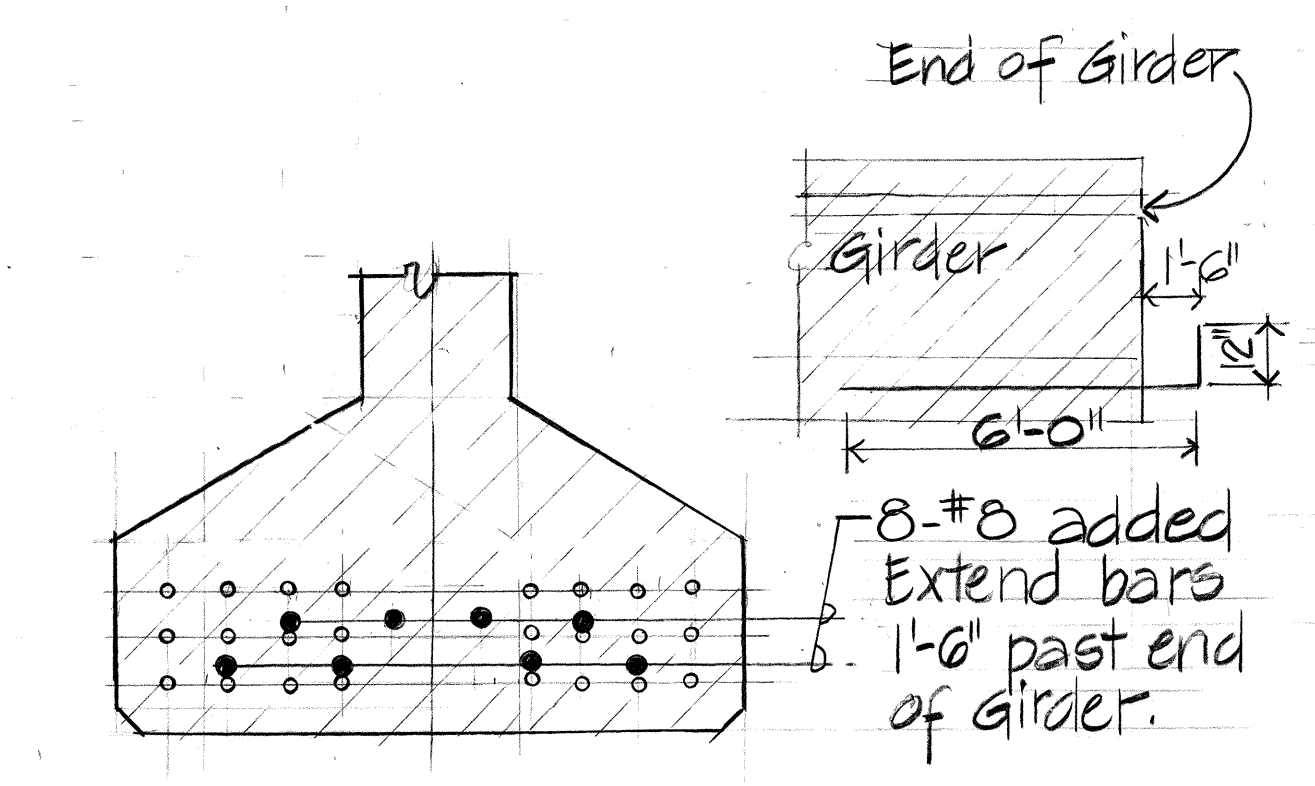

ADDED REINFORCEMENT
AT GIRDER ENDS

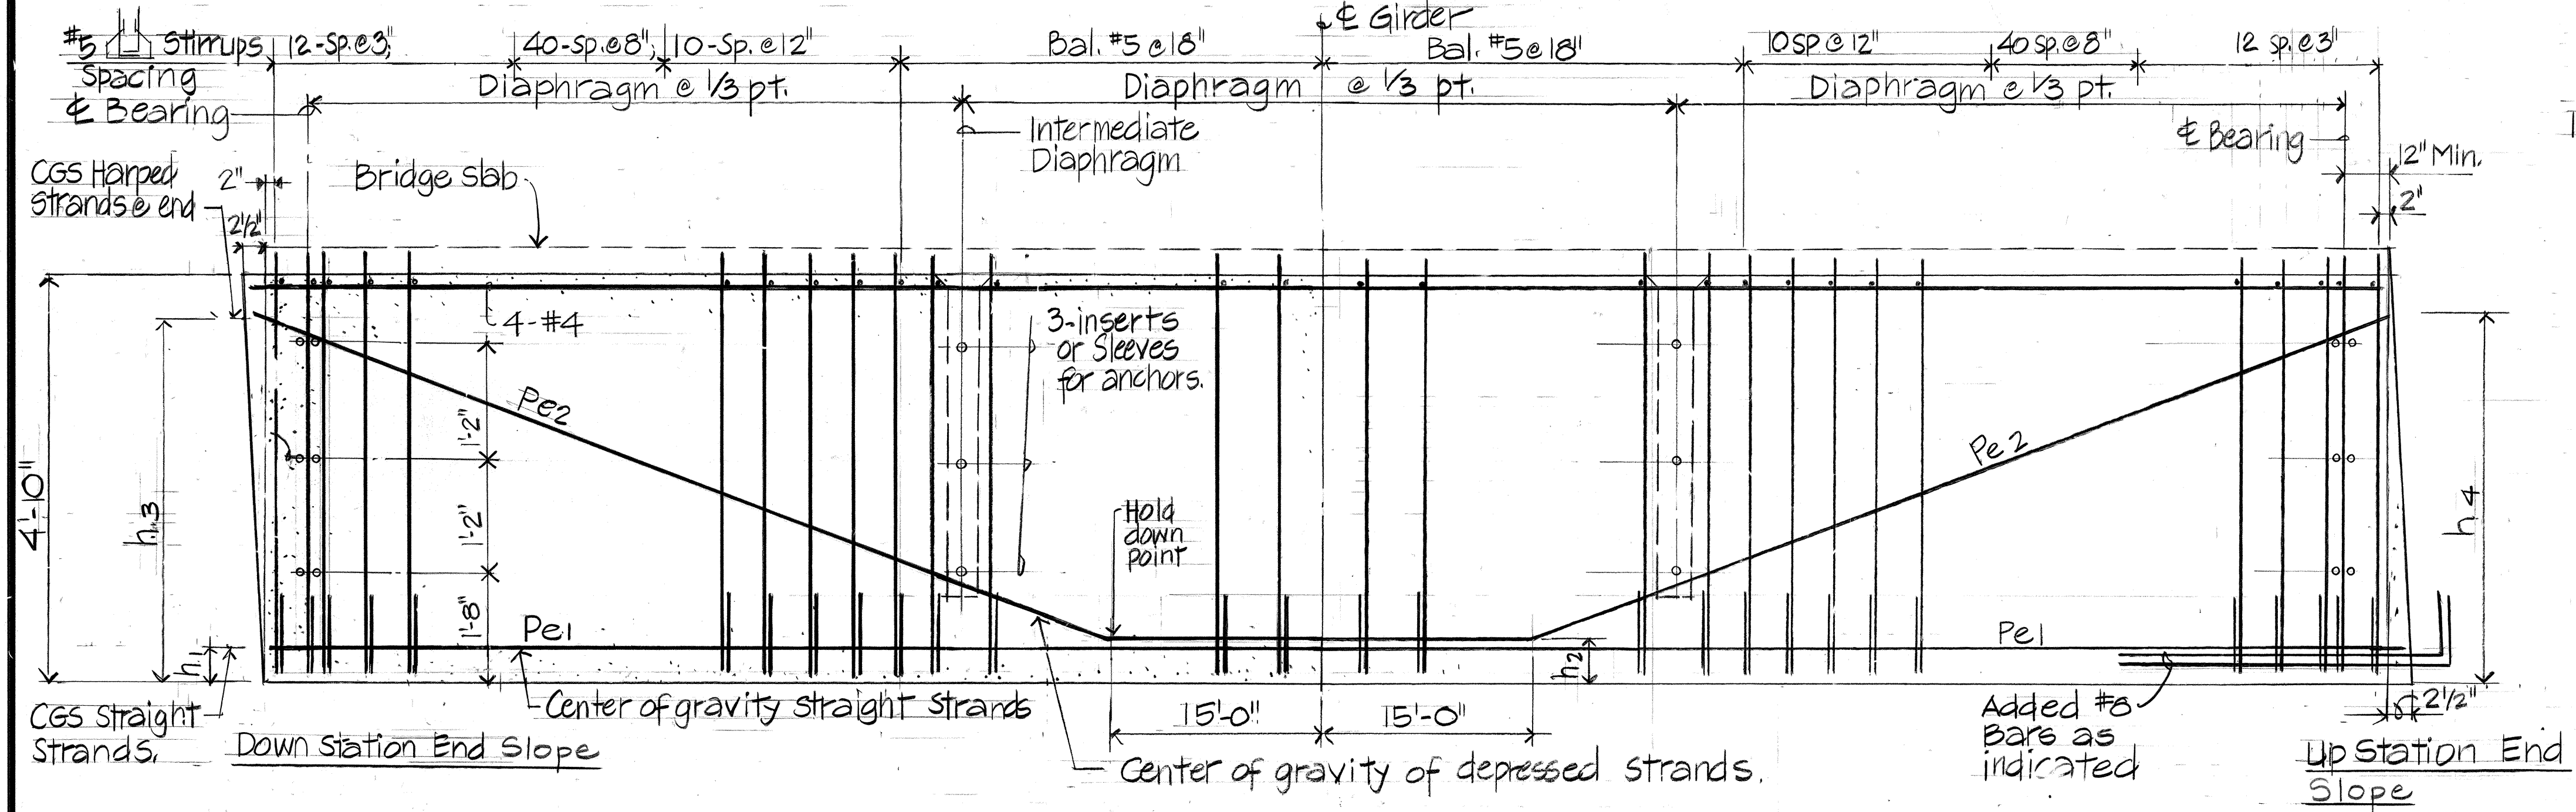

KEEHI IV GIRDER LONGITUDINAL SECTION

No scale.

P_{e1} = Effective working force after all losses
Inserts and sleeves shall be incidental to Keehi Type II
Prestressed Concrete Girders.

Girder ends to be plumb and parallel to pier when erected and Deck Slab, Haunches and Diaphragms placed.

For embedded sole ft's. @ girder ends, see B
S191520

GIRDER SPAN	P_{e1}	h_1	P_{e2}	h_2	h_3	h_4	ADDED REINF.
1 IB	627*	3.85"	386*	4.81"	44"	44"	Future Span by Others
2 IB	627*	3.85"	386*	4.81"	44"	49"	8-#8 @ up station End
3 IB	627*	3.85"	386*	4.81"	49"	44"	8-#8 @ Down Station End
4 IB	627*	3.85"	386*	4.81"	44"	49"	8-#8 @ up station End
5 IB	627*	3.85"	386*	4.81"	49"	44"	8-#8 @ Down station End
6 IB	627*	3.85"	386*	4.81"	44"	44"	
1 OB	627*	3.85"	386*	4.81"	44"	44"	


1/10/89	Revised Girder Longitudinal Sect. Span IB. 1 Deleted, Note Revised
DATE	REVISION

AS BUILT

ADD. 53

SURVEY PLOTTED BY	DATE
DRAWN BY	
CHECKED BY	
NOTED BY	
QUANTITIES BY	
CHECKED BY	


FED. ROAD DIST. NO.	STATE	FED. AID PROJ. NO.	FISCAL YEAR	SHEET NO.	TOTAL SHEETS
HAWAII	HAW.	I-H3-1(52)	1988	54	75

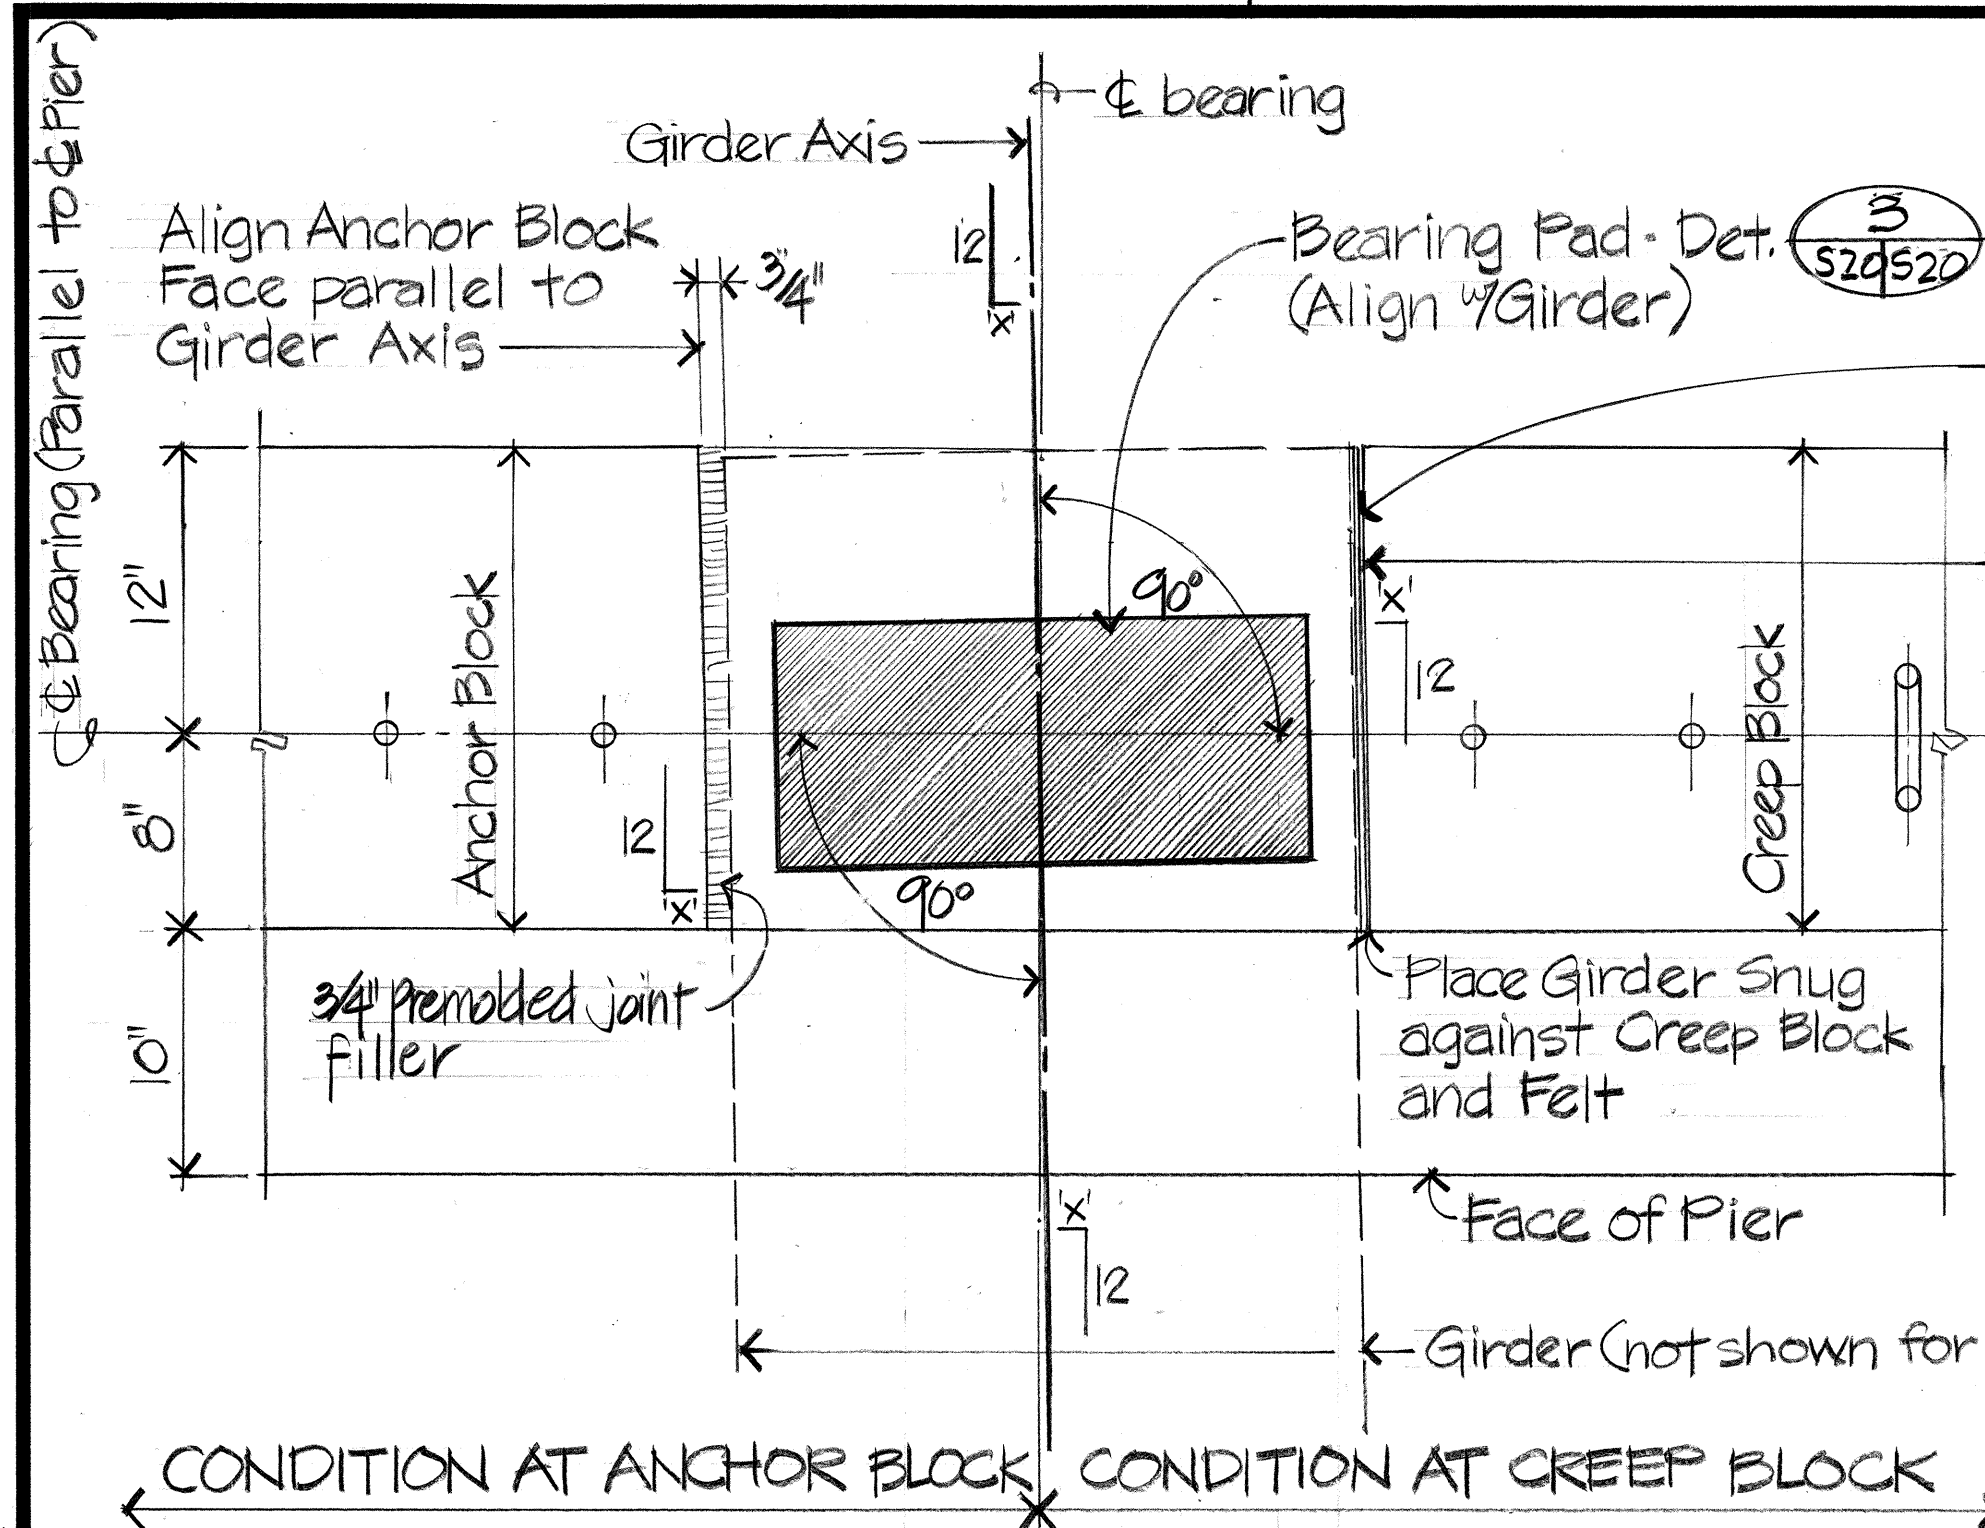

GIRDER SEAT ALIGNMENT PLAN

Scale 1 1/2" = 1'-0"


S8, S7, S14, S15, S16, S20

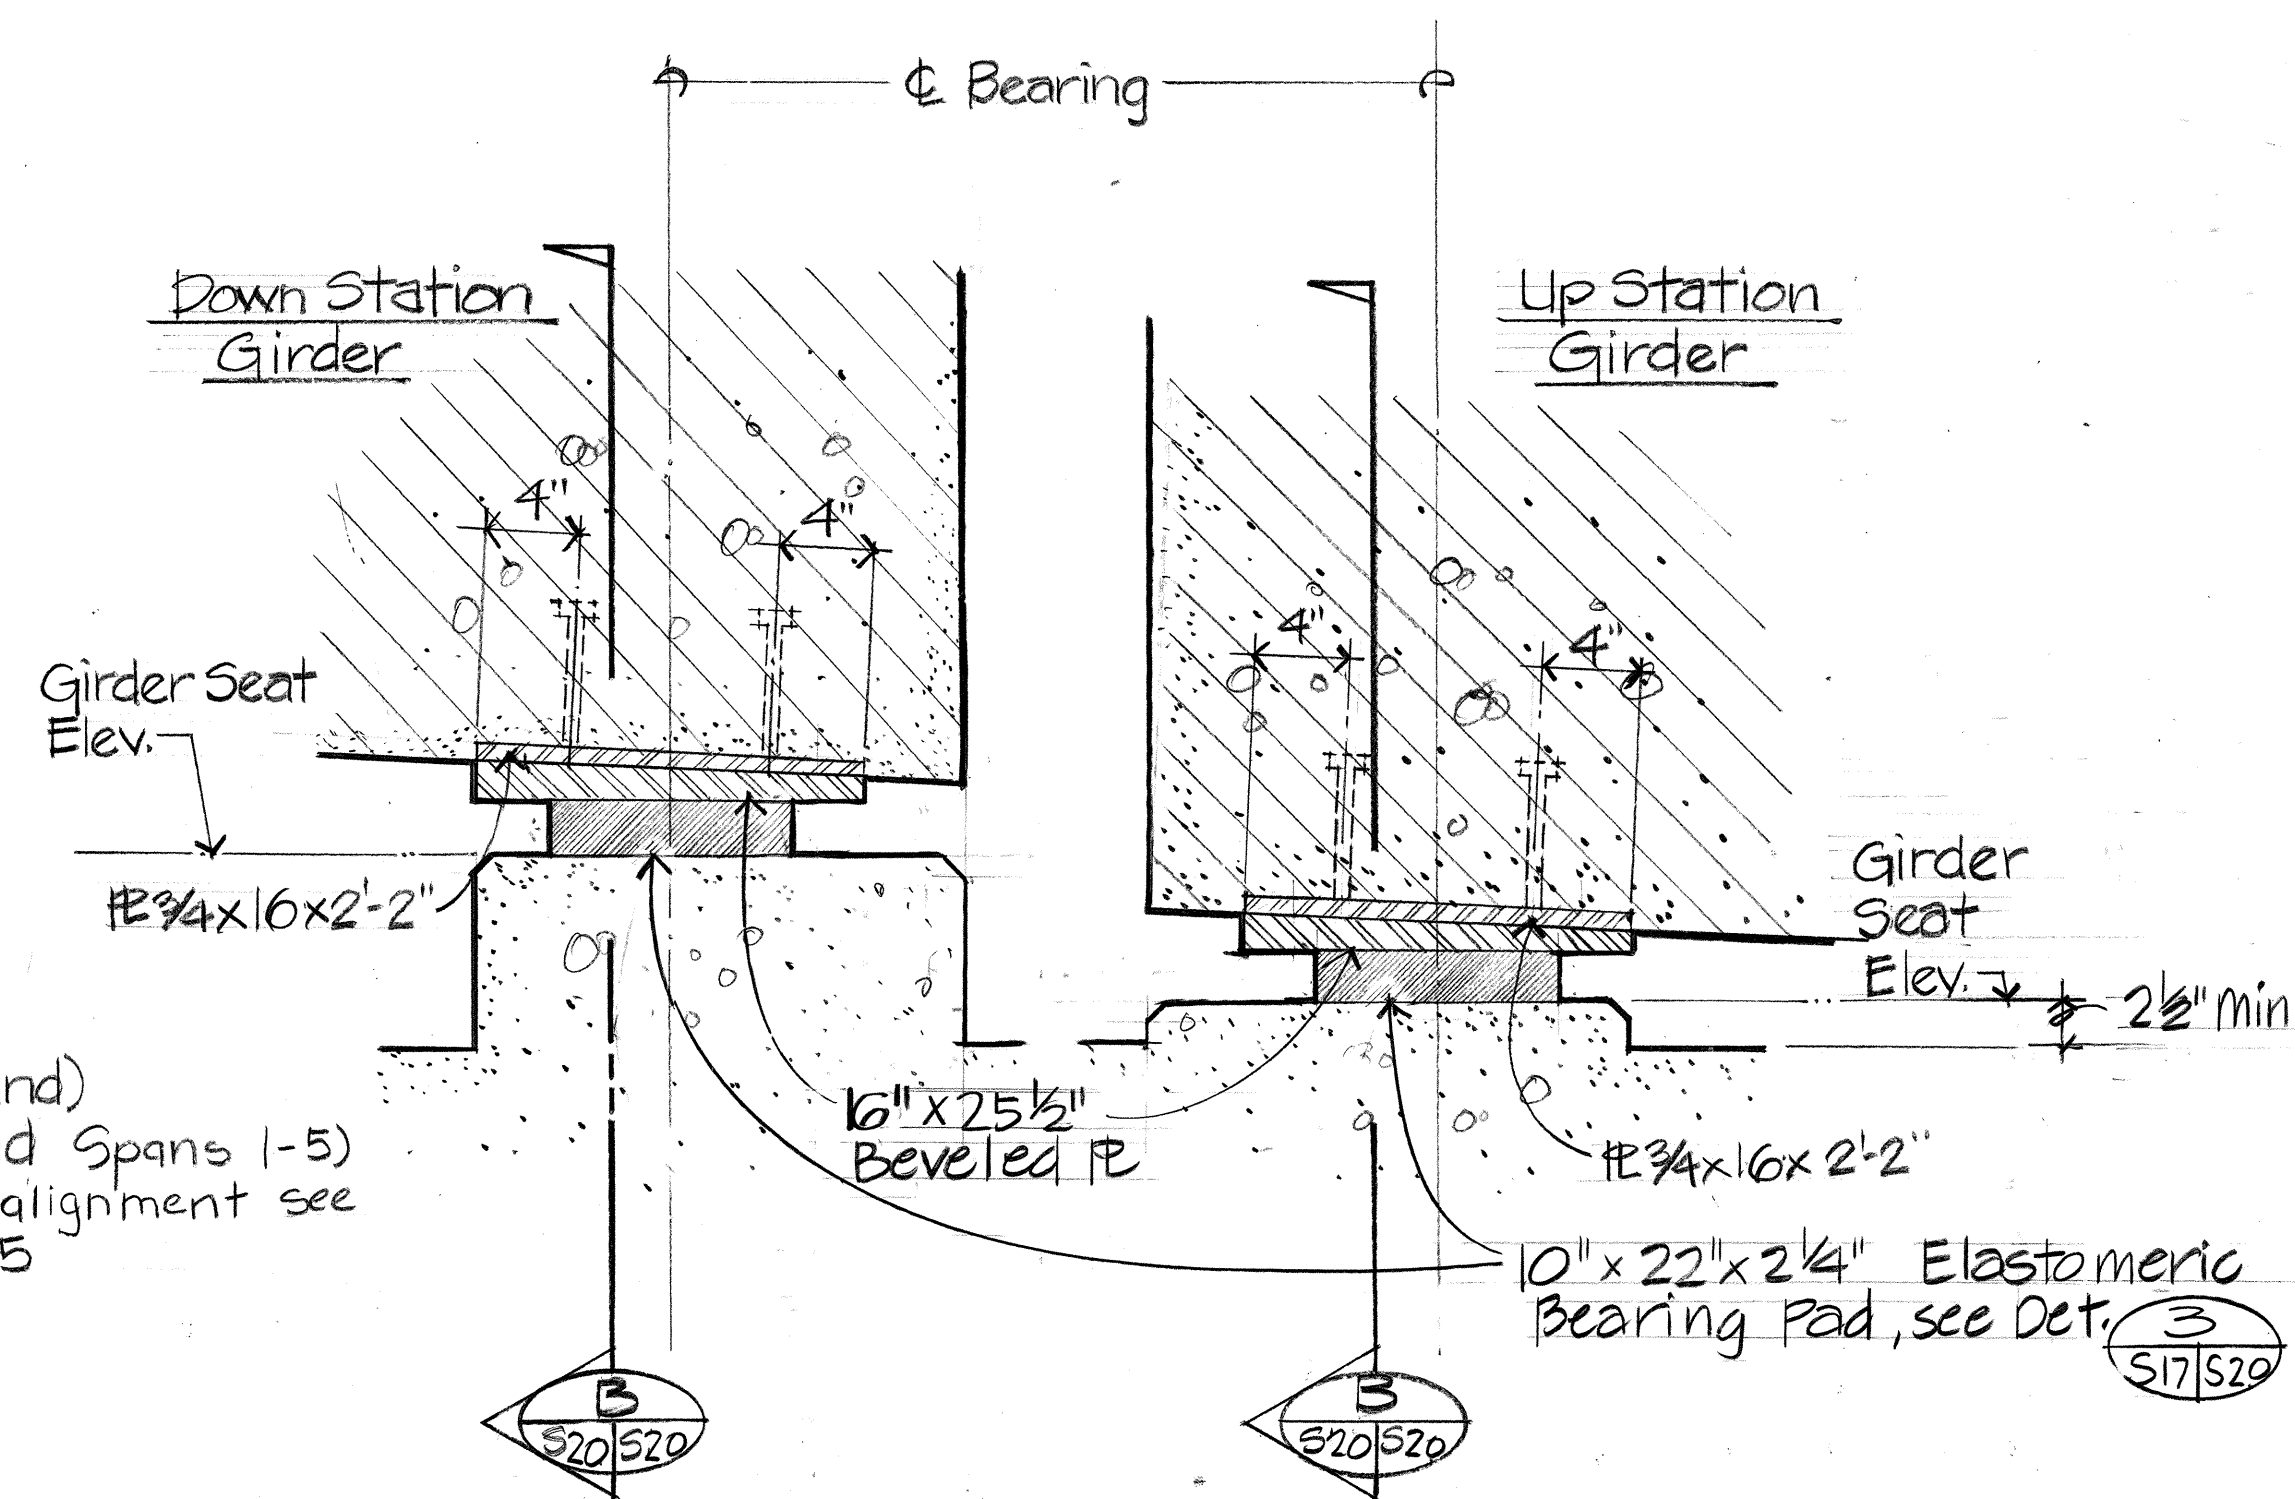

GIRDER SEAT DETAIL AT EXPANSION JOINTS

Scale: 1 1/2" = 1'-0" Condition e Hinge Joint Similar.


S14, S17, S20

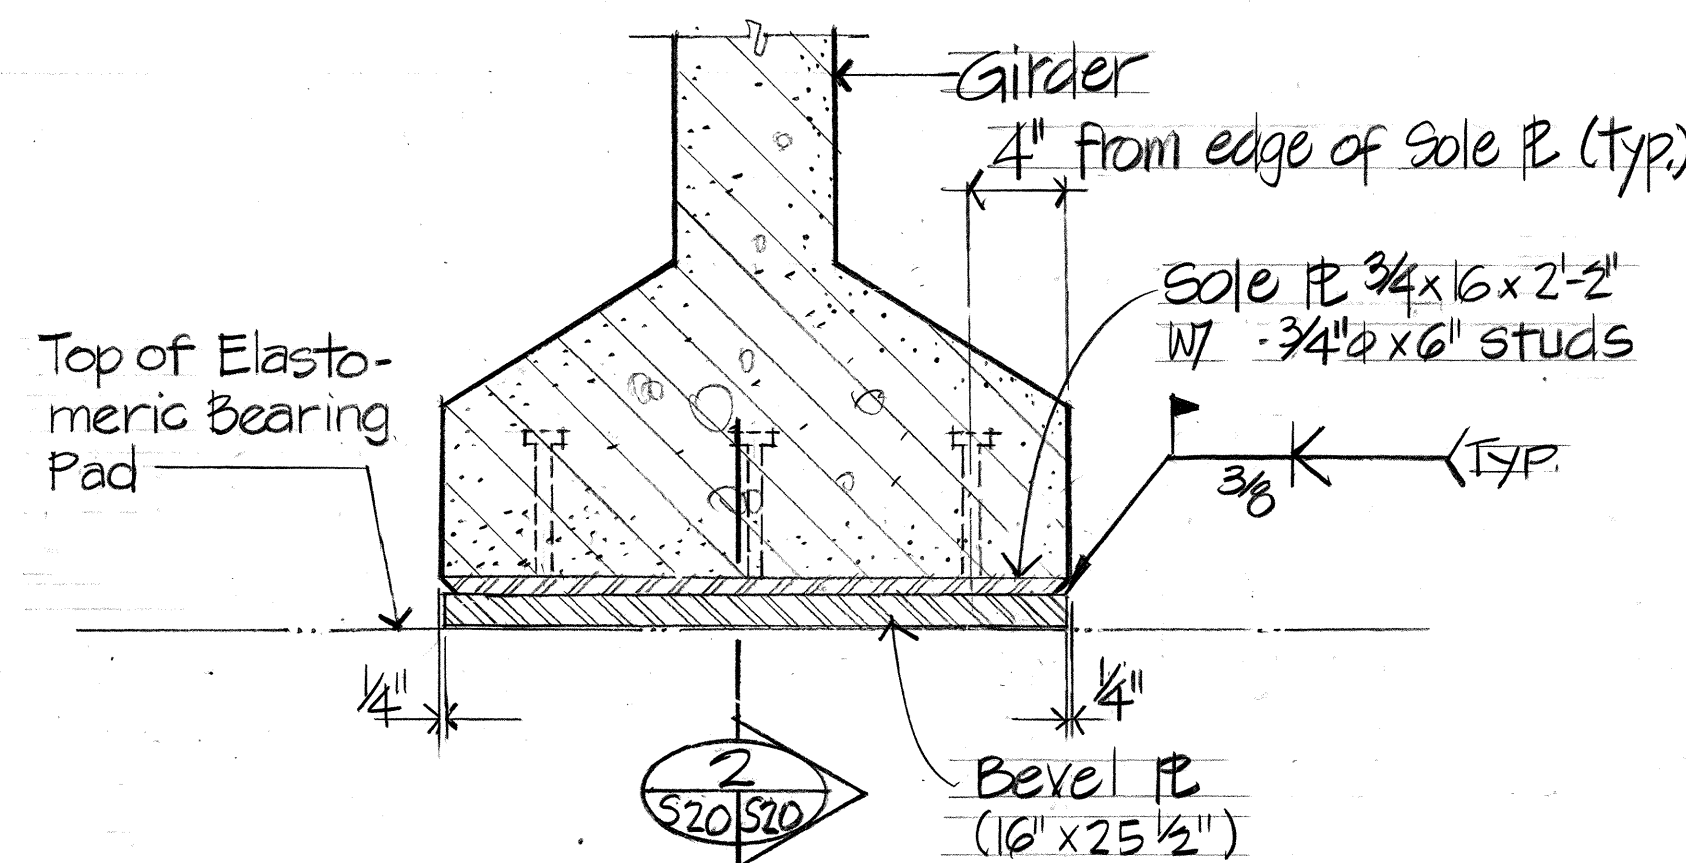

SECTION

Scale 1 1/2" = 1'-0"


S10, S19, S20, S20

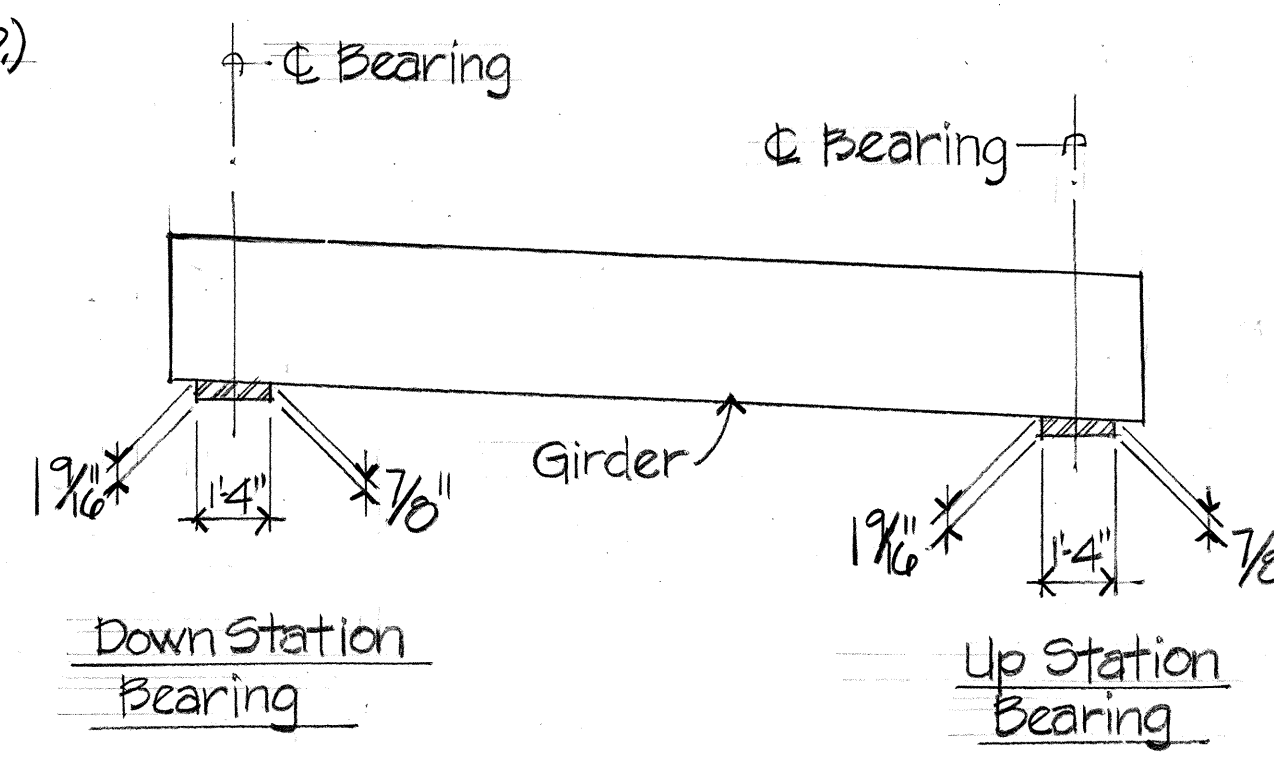

BEVELED PL (16' x 25 1/2")

N.T.S.

S20, S20

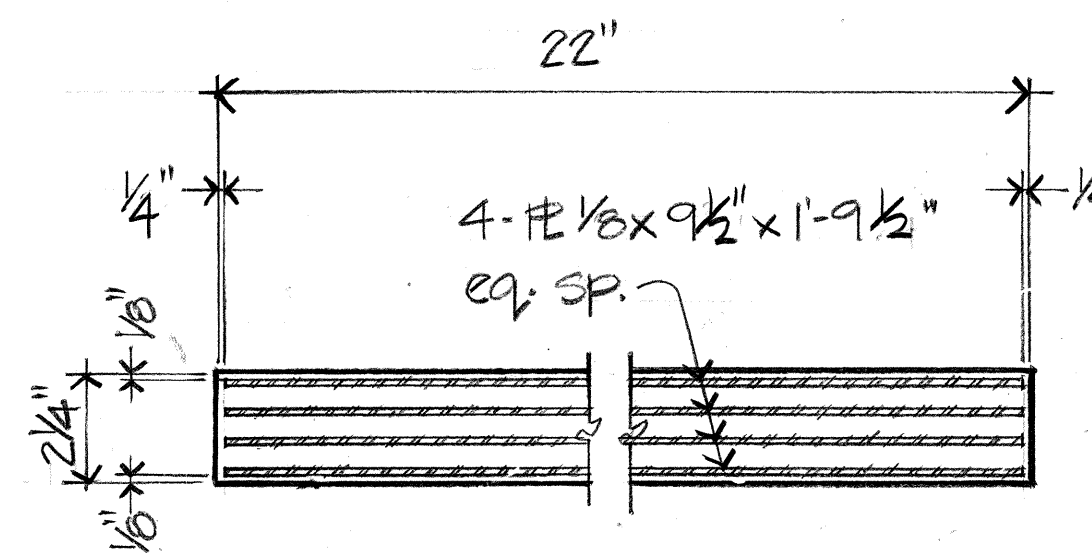

STEEL LAMINATED BEARING PAD


All bearing pads shall be 10' x 22" and are incidental to concrete in Haiku Valley Bridges.

ELASTOMERIC BEARING PAD DETAIL

Scale 1 1/2" = 1'-0"

Bearing Proof Load = 150 Kips

S10, S17, S20

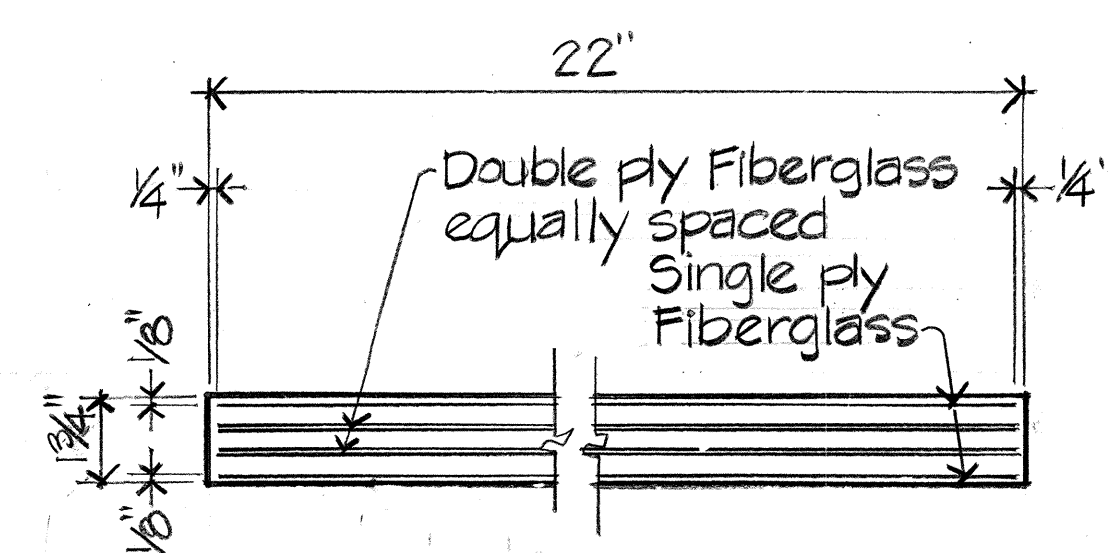

FIBERGLASS LAMINATED BEARING PAD (Alternate)

NOTE:

All Girder Seat Elevations are based on Steel Laminated Bearing Pads. Should the Contractor elect to use the Fiberglass Laminated Bearing Pads he shall insure that the Fiberglass Laminated Bearing Pads comply with the Drawings and Specification. The Contractor shall also revise the Girder Seat Elevations to reflect the thickness of the Fiberglass Laminated Bearing Pads. All Revisions shall be approved by the Engineer.

NOTES:

1. Weld Beveled PL to Sole PL Prior to delivery of Girder to Job Site.
2. Studs welded to Sole PL with Automatically Timed Welding Equipment.
3. Sole PL and Beveled PL to be hot-dipped galvanized after fabrication. Galvanized coating damaged by handling, transporting or welding shall be repaired per the specifications.
4. Sole and Beveled PLs shall be considered incidental to Keenhi type IV Prestressed concrete girders.
5. The Contractor shall minimize and dissipate the heat generated during the field welding of the 3/4" Sole plate to be bevelled bearing plate and during the field galvanizing of the weld. The contractor shall take all necessary precautions and exercise great care to avoid exposing the elastomeric bearing pad to temperatures which may damage the bearing during welding and galvanizing. Welding of the Sole PL to the Bearing PL shall be done prior to the pouring of diaphragm and deck. Temporary wooden shims (14 x 24 x 3/4" minimum thickness) shall be placed between the bevelled bearing plates and the Elastomeric Bearing pads during field welding and galvanizing. Shims shall be removed.
6. Contractor to modify thickness at edges of bevelled Plate to account for Girder End Rotation due to camber based on actual Strand Pattern used and to account for camber at time of erection.
7. Bearing Plates and Sole Plates to conform to ASTM A588.



THIS WORK WAS PREPARED BY ME OR UNDER MY SUPERVISION

Myron G. Okada

STATE OF HAWAII
DEPARTMENT OF TRANSPORTATION
HIGHWAYS DIVISION

GIRDER BEARING DETAILS

INTERSTATE ROUTE H-3
F.A.I. PROJECT NO. I-H3-1(52):

SCALE: AS NOTED DATE: JULY 1988

SHEET No. S20 OF S26 SHEETS

1/10/89 Details A, B, 2 & 3 Revised, Note 1 Deleted, Note 6 & 7 Added

DATE REVISION

AS BUILT


ADD. 54

S20

51


DATE	_____
DESIGNED BY	_____
CHECKED BY	_____
ORIGINAL PLAN	_____
NOTE BOOK	_____
NO.	_____

FED. ROAD DIST. NO.	STATE	FED. AID PROJ. NO.	FISCAL YEAR	SHEET NO.	TOTAL SHEETS
HAWAII	HAW.	I - H3-1(52)	1988	55	75

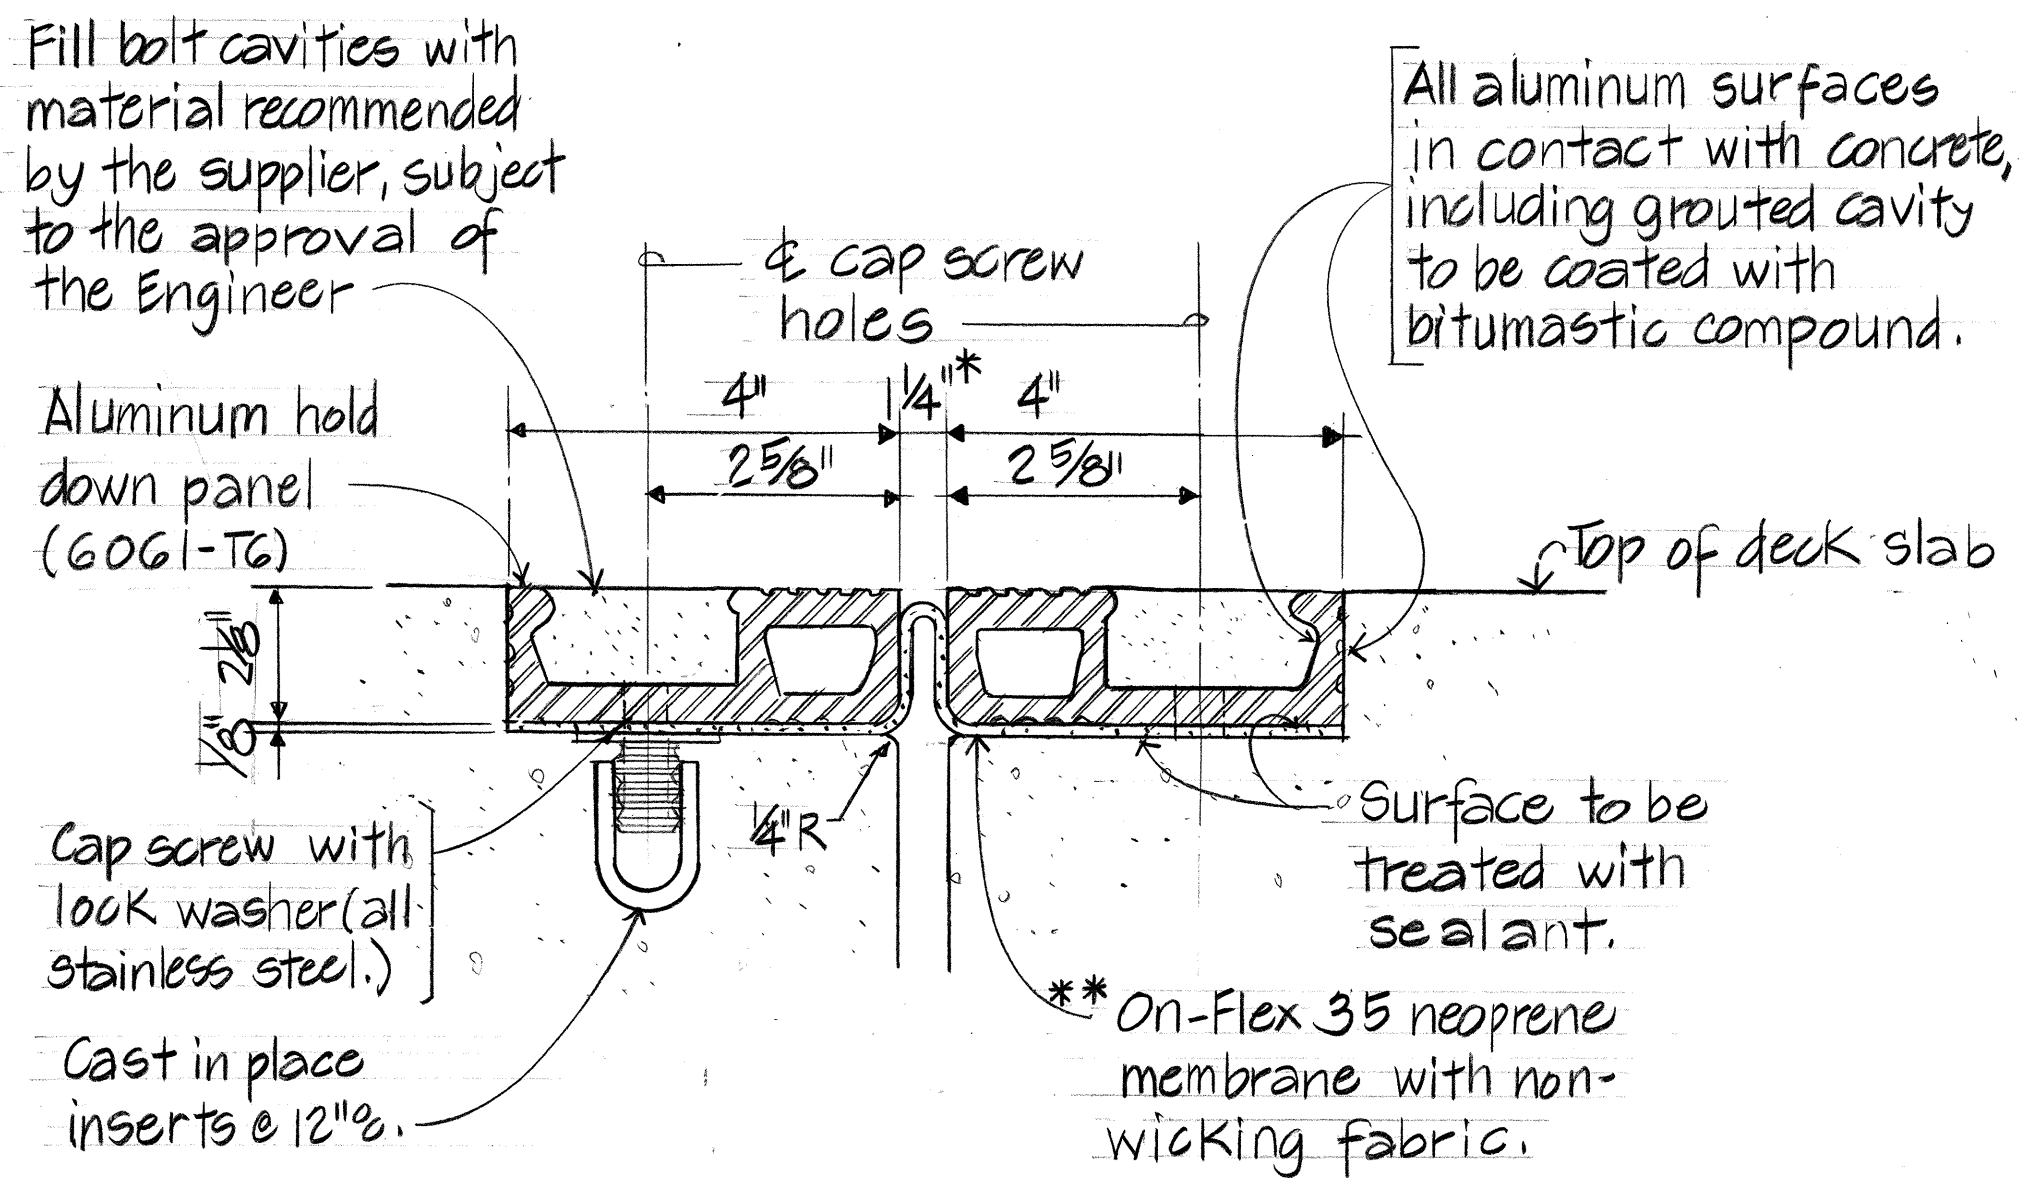

ON-FLEX 35

Not to scale:
(Manufacturer: Structural Accessories Inc.)

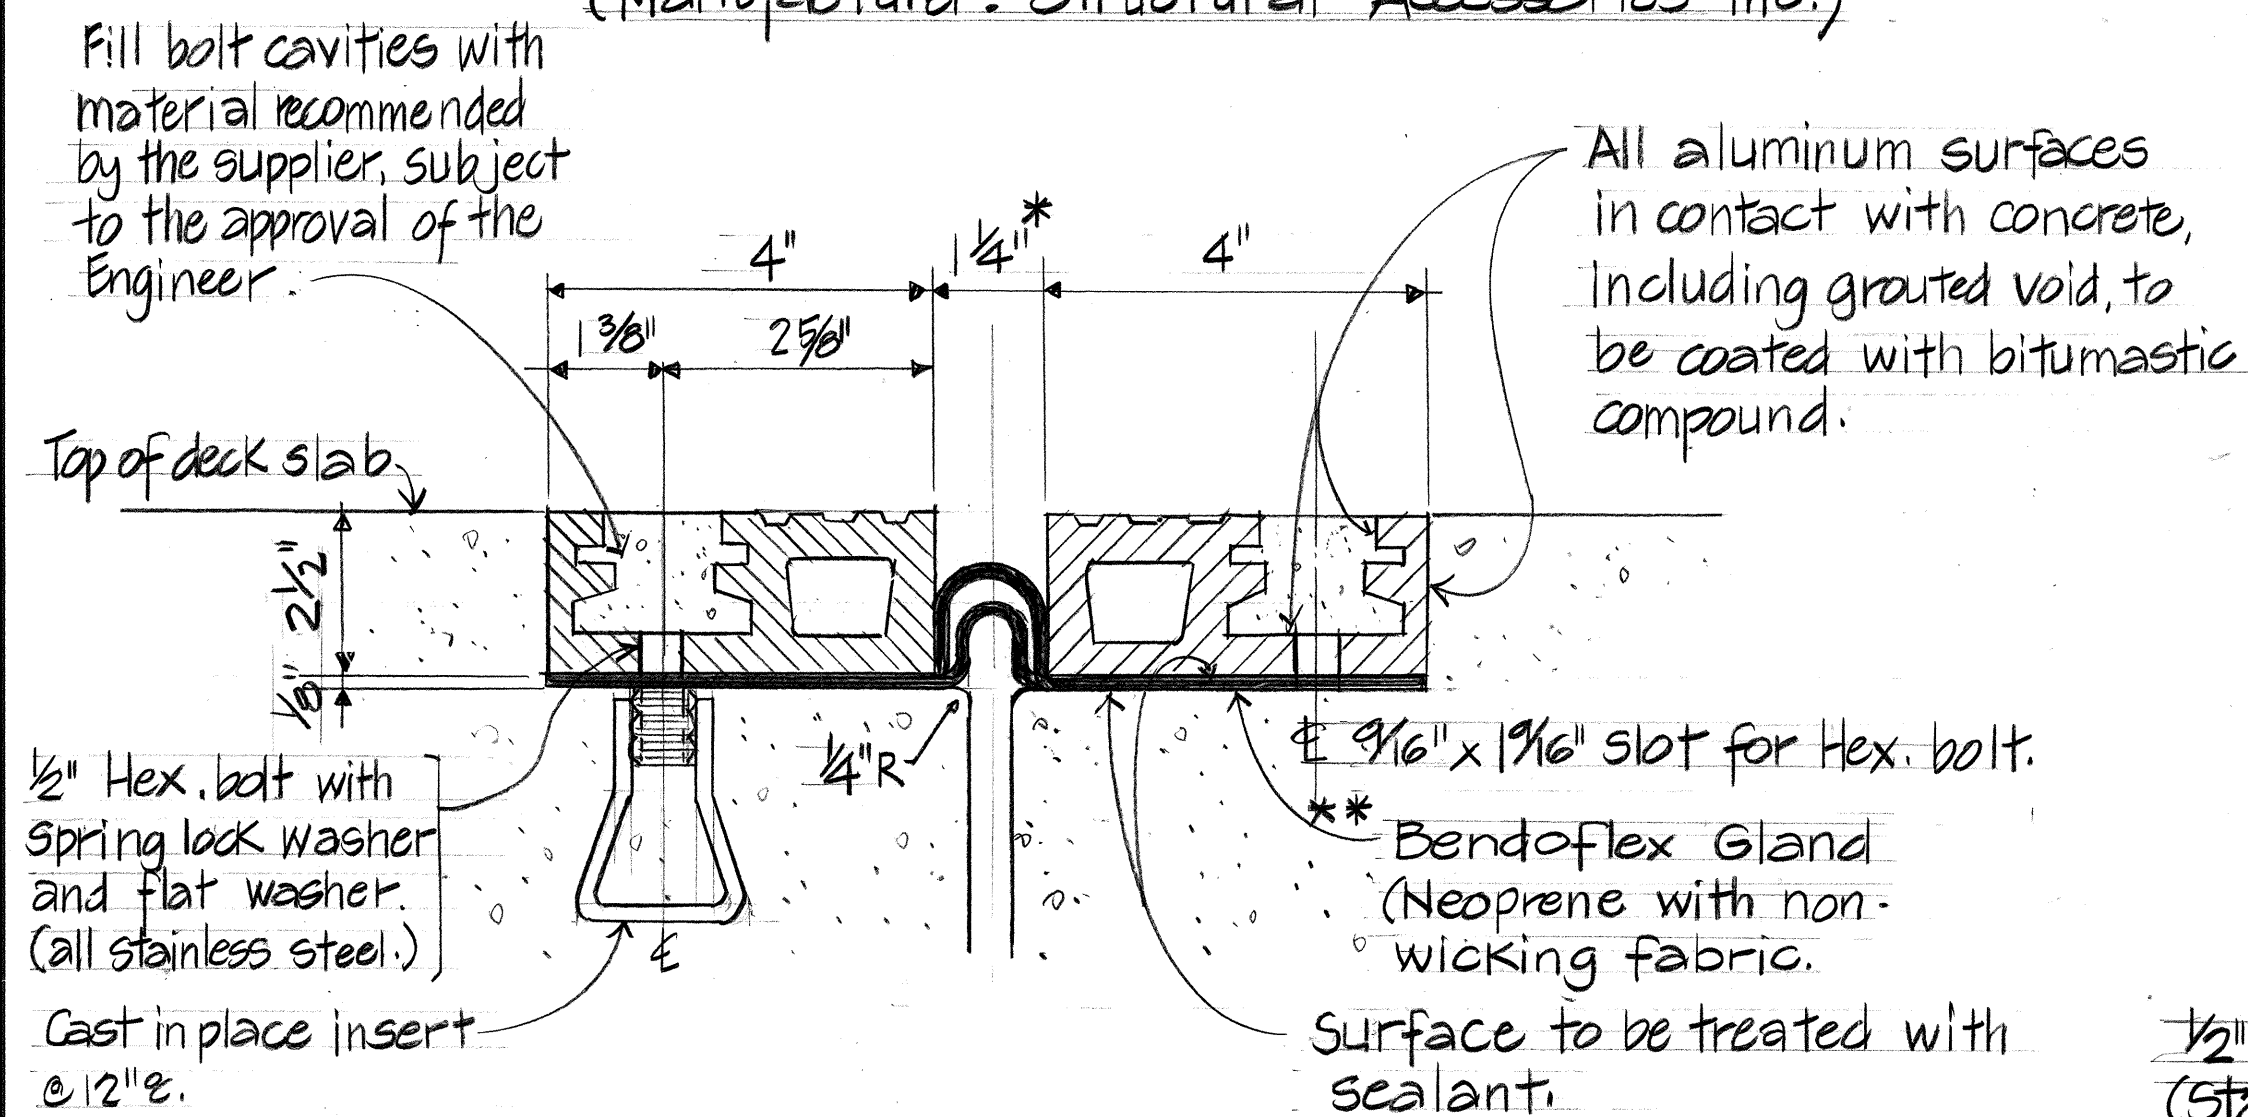

WABO BENDOFLEX 450

Not to scale:
(Manufacturer: Watson Bowman Assoc. Inc.)



DECK EXPANSION JOINT SECTIONS

DECK EXPANSION JOINT NOTES

- Two alternate Deck Expansion Joint Systems are shown. Contractor has the option of selecting any one of the systems. The contractor shall submit detailed shop drawings of the selected joint to the Engineer for approval.
 - The contractor also has the option of using an alternate Expansion Joint System provided it complies with the plans and specifications.
 - For closure pour details, see sheet S-15.
- * Installation width at 75° F
- ** Seal, Gland or membrane shall be continuous across the full width of the Structure.


DELASTIFLEX TYPE SM 400

Not to scale:
(Manufacturer: D.S. Brown Co.)

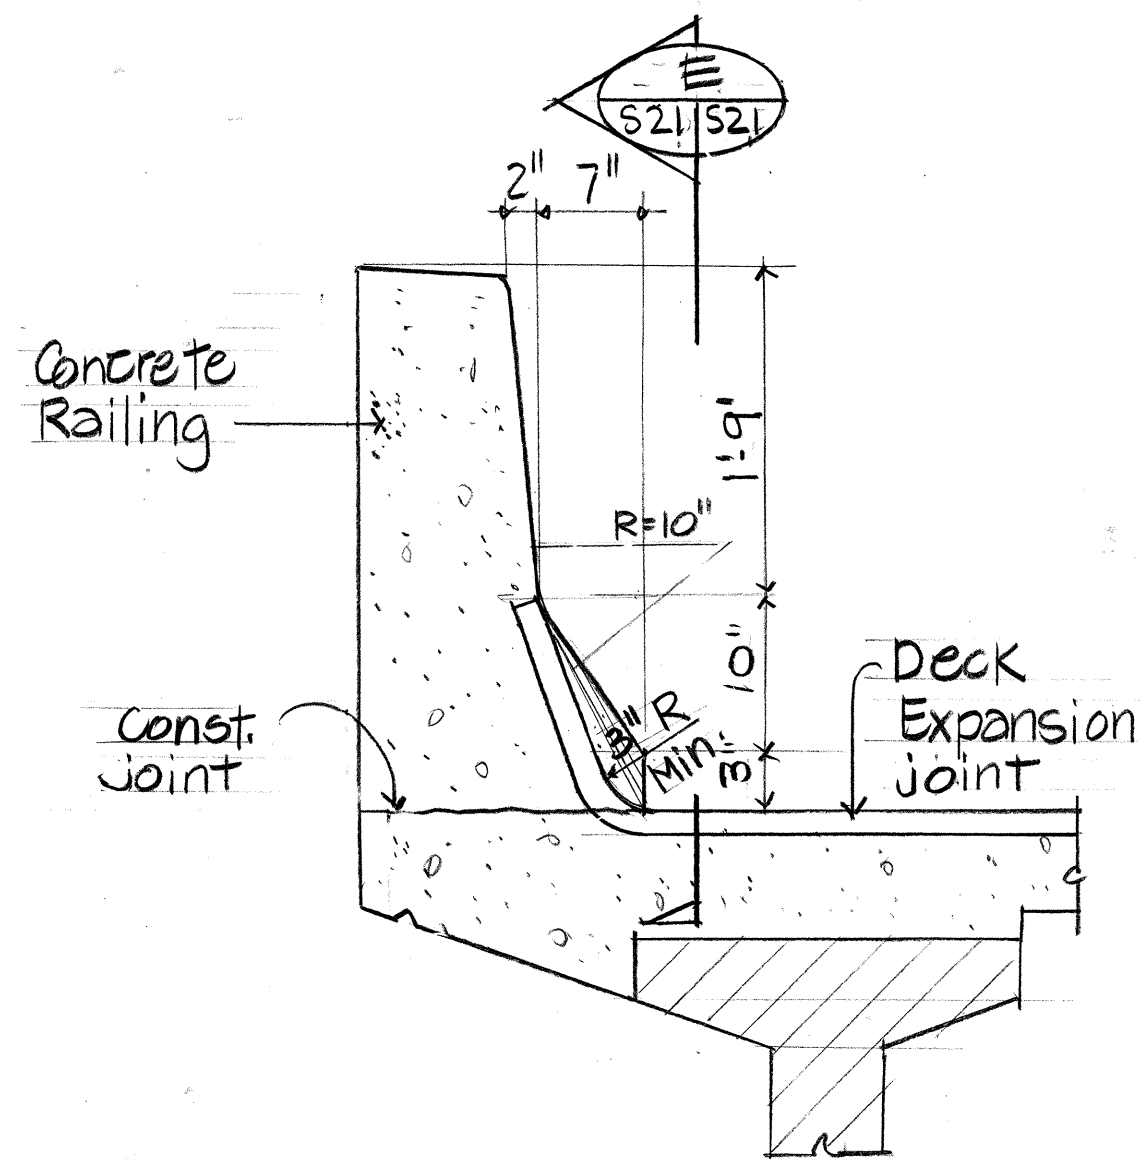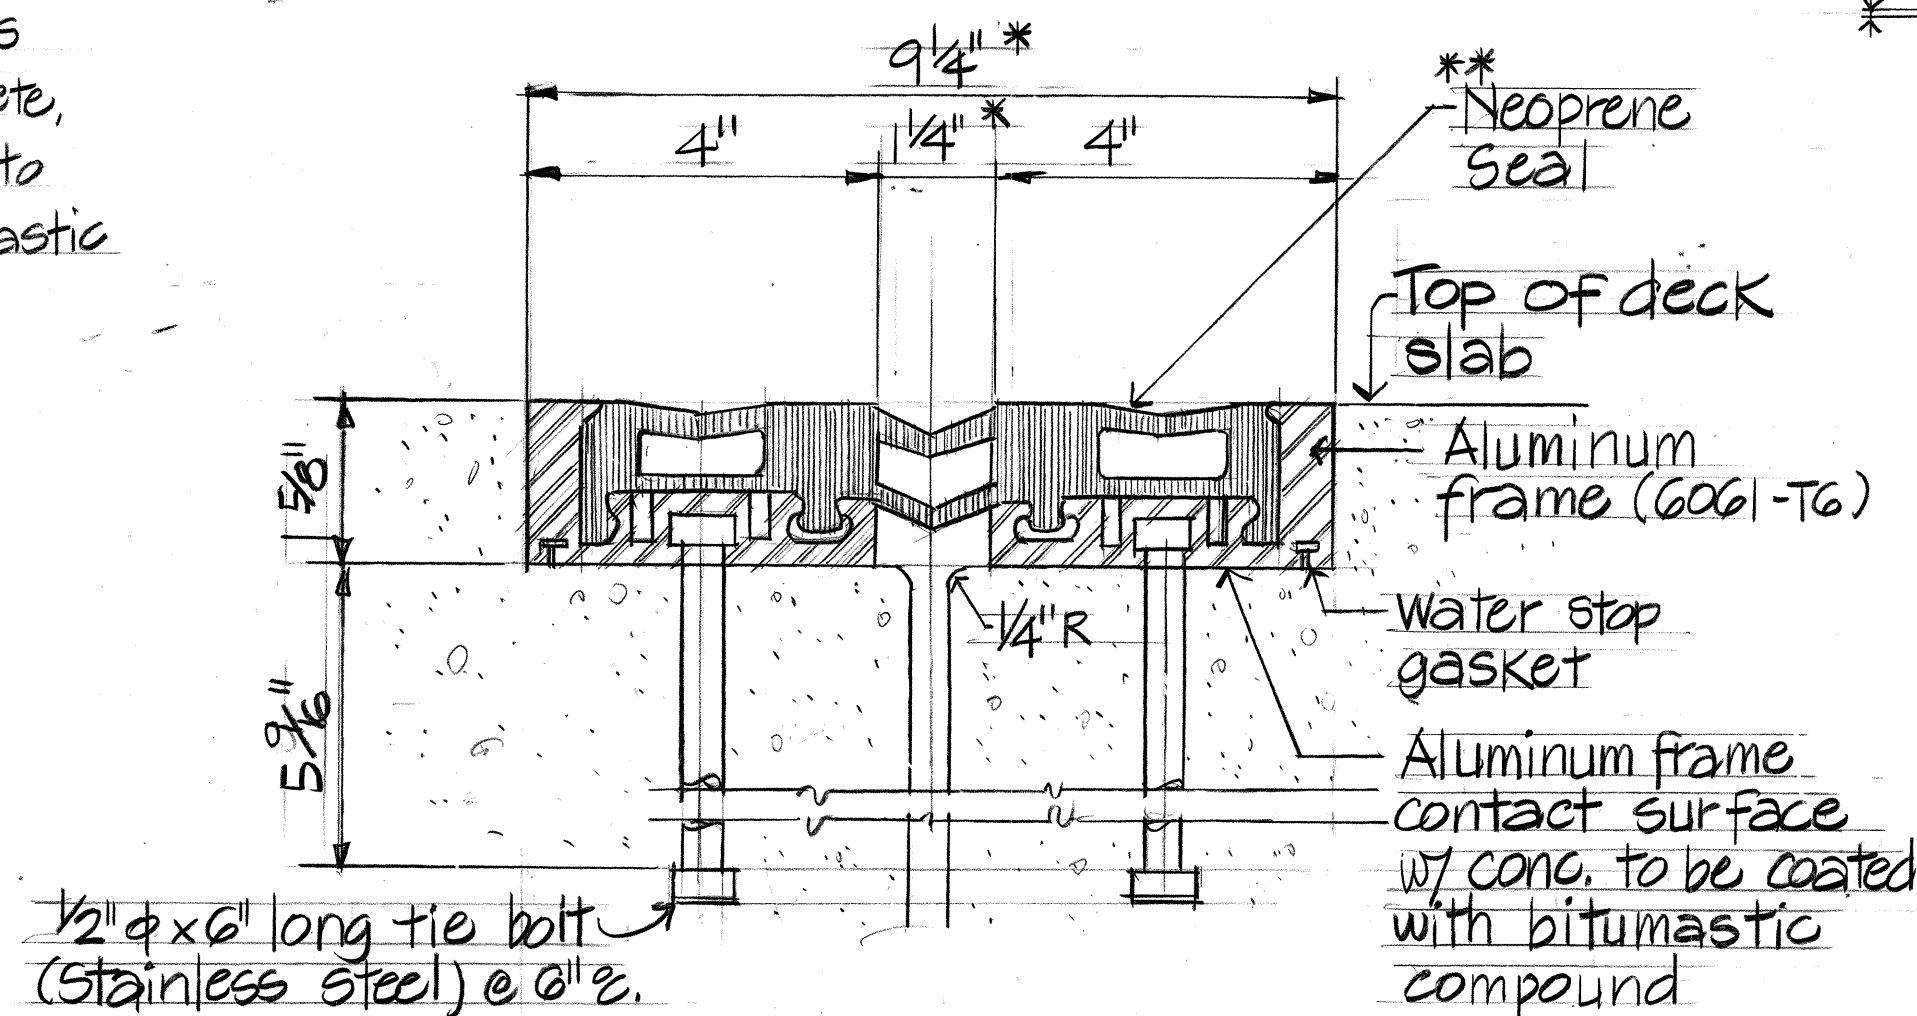


TYPICAL DETAIL B

Scale: 1" = 1'-0"

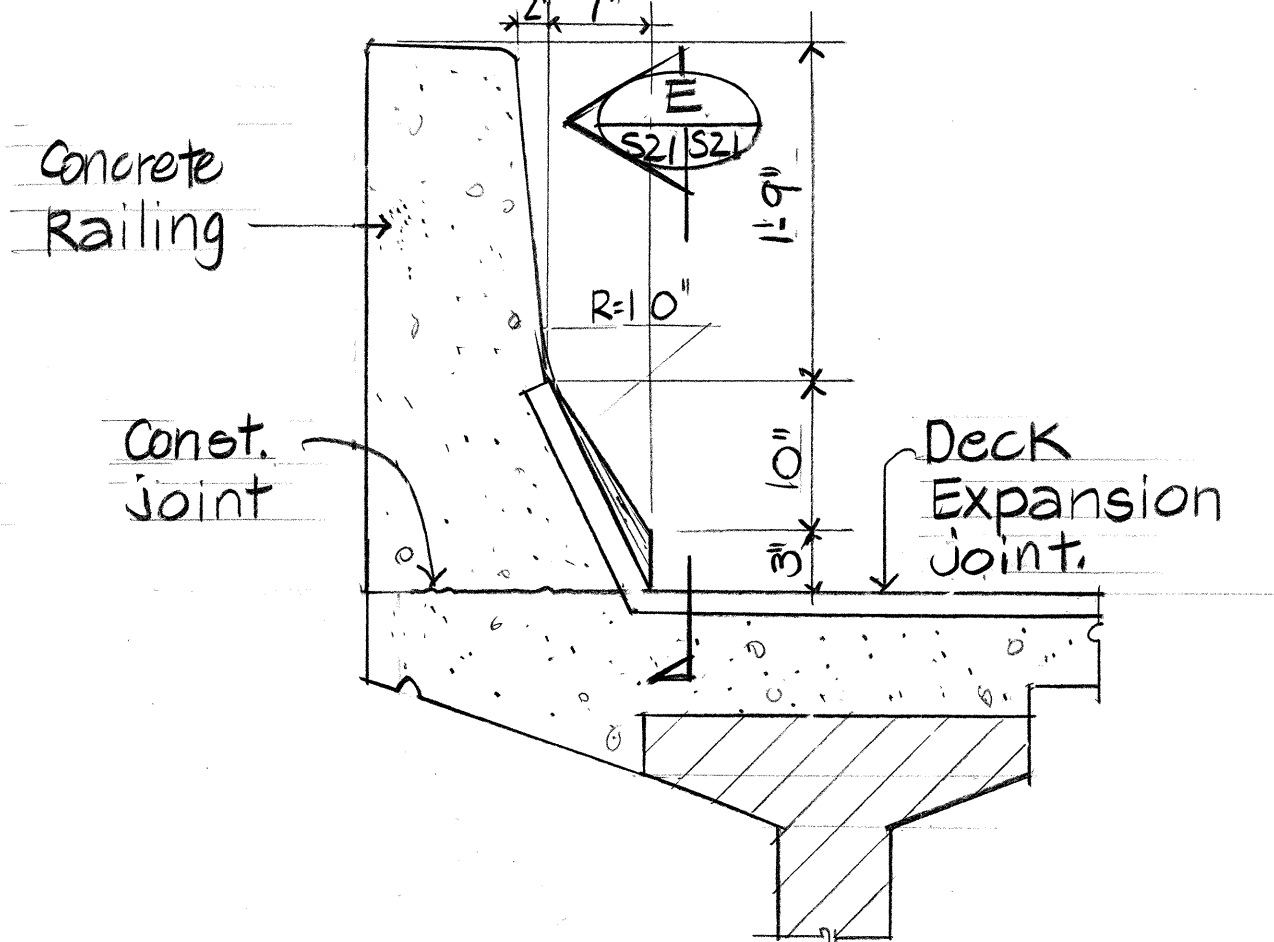


ALTERNATE DETAIL C

Scale: 1" = 1'-0"

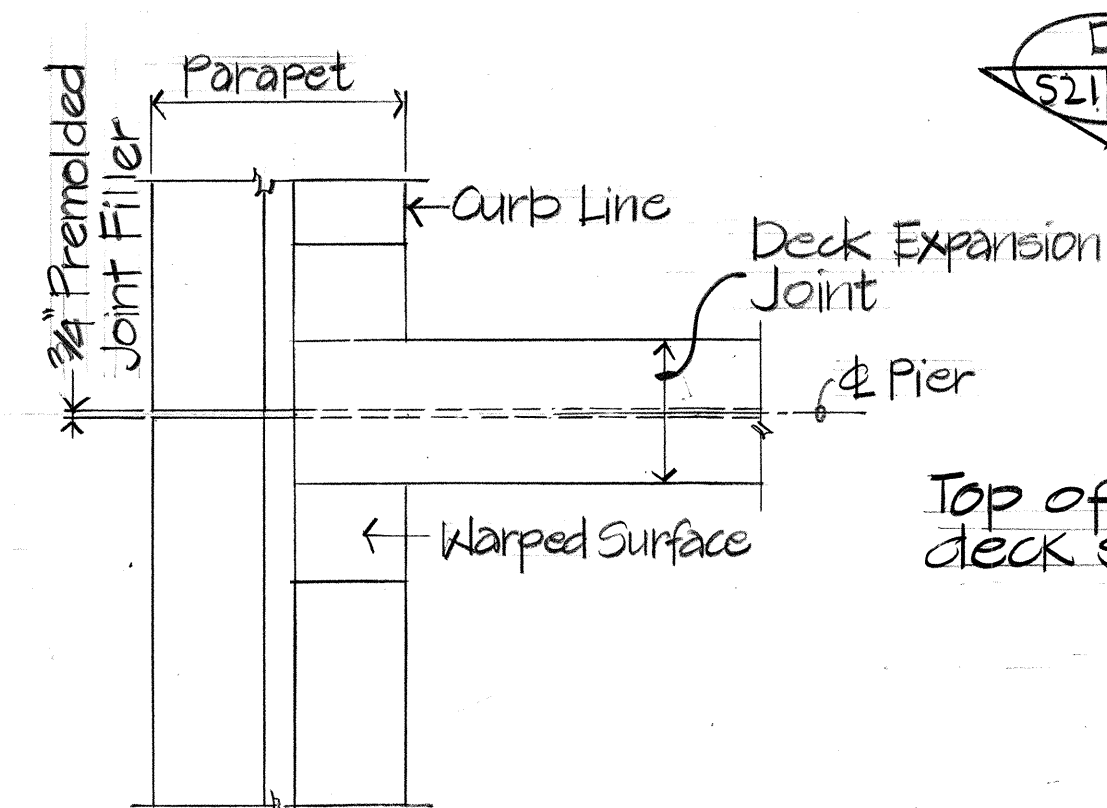


PLAN

Scale: 1" = 1'-0"

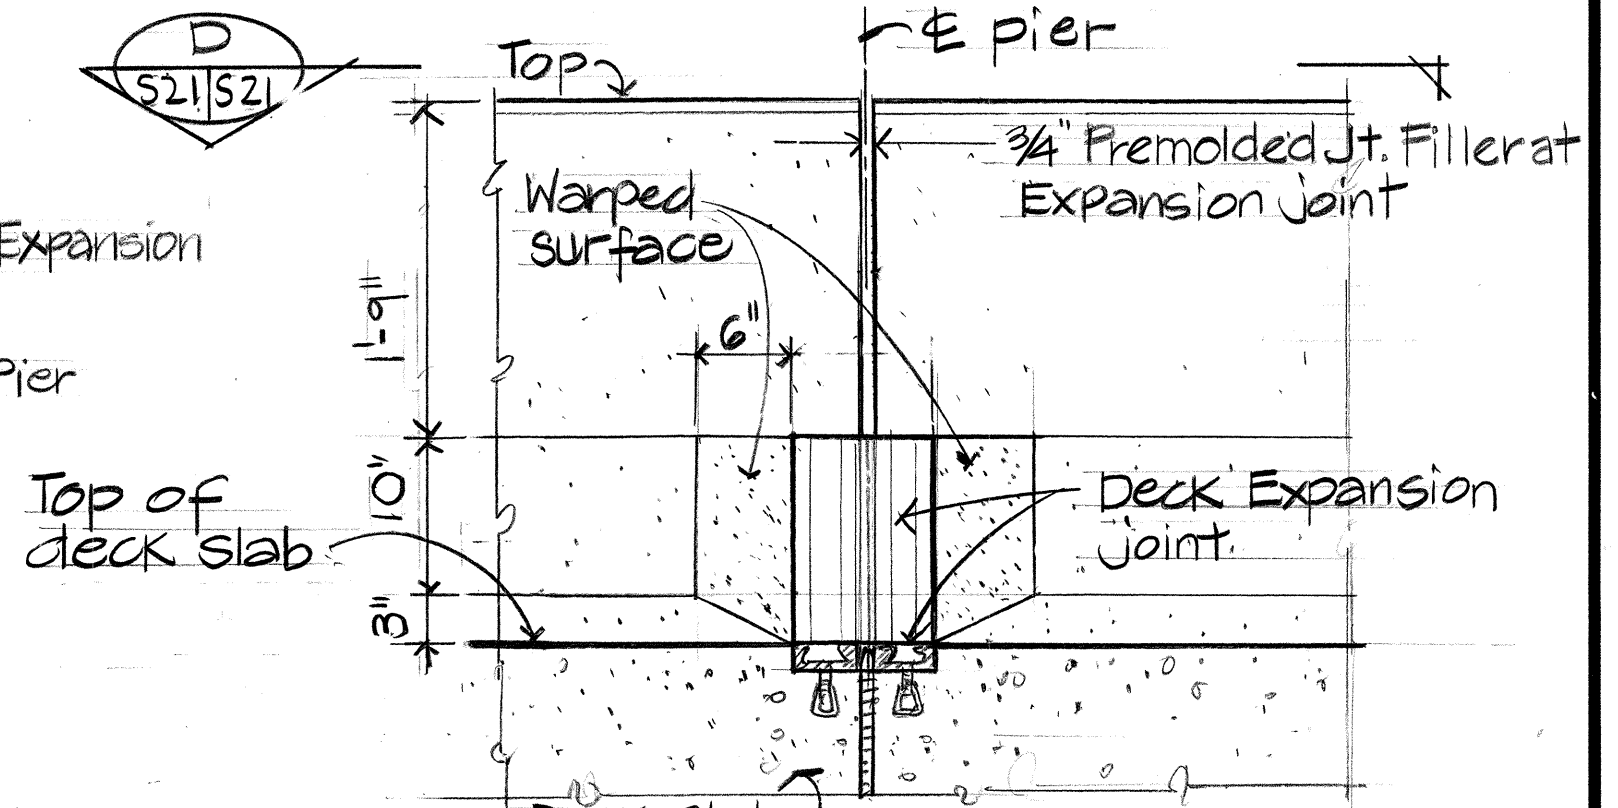

SECTION

Scale: 1" = 1'-0"

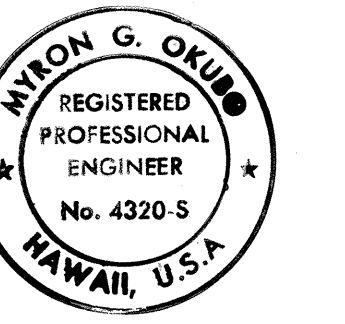

THIS WORK WAS PREPARED BY ME OR UNDER MY SUPERVISION

Myron Okubo

STATE OF HAWAII
DEPARTMENT OF TRANSPORTATION
HIGHWAYS DIVISION

DECK EXPANSION JOINT DETAILS

INTERSTATE ROUTE H-3
F.A.I. PROJECT NO. I-H3-1(52)

SCALE: AS NOTED DATE: JULY, 1988

SHEET No. S21 OF S26 SHEETS

1/10/89 Details, D & E Revised

DATE REVISION

AS BUILT





ADD. 55

S21

52

DATE	BY
DESIGNED BY	
CHECKED BY	
QUANTITIES BY	
NOTE BOOK	
ORIGINAL	

FED. ROAD DIST. NO.	STATE	FED. AID PROJ. NO.	FISCAL YEAR	SHEET NO.	TOTAL SHEETS
HAWAII	HAW.	I-H3-1(52)	1988	56	75

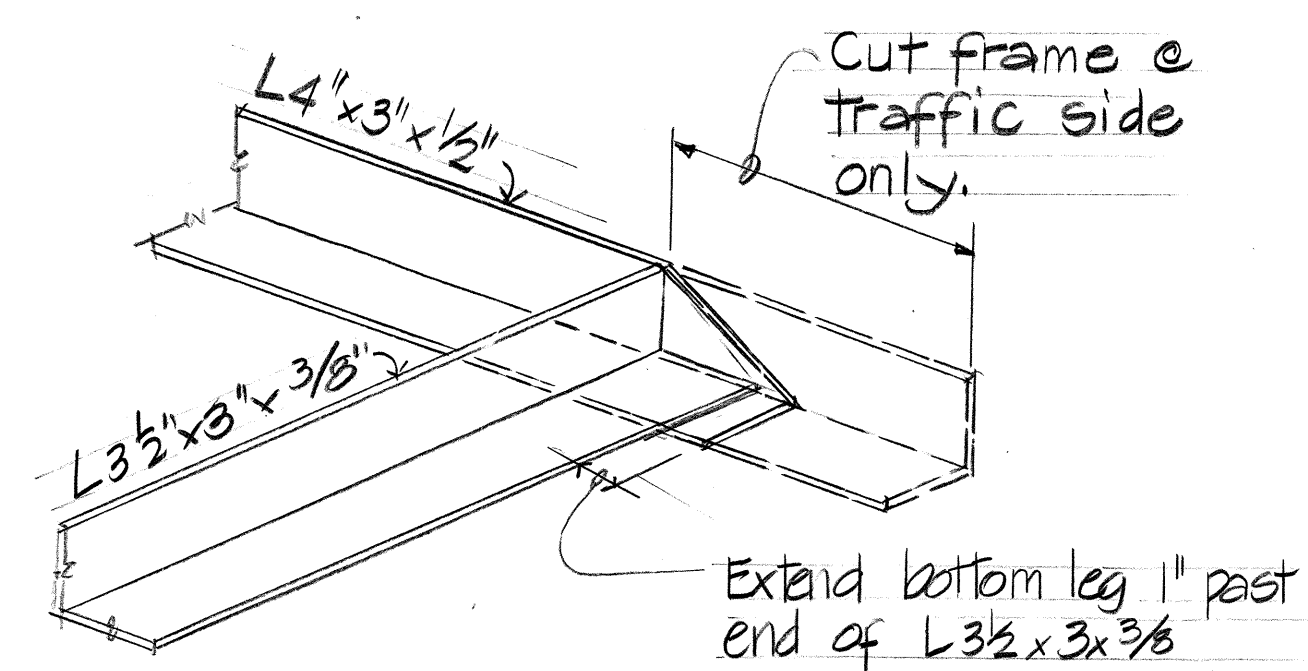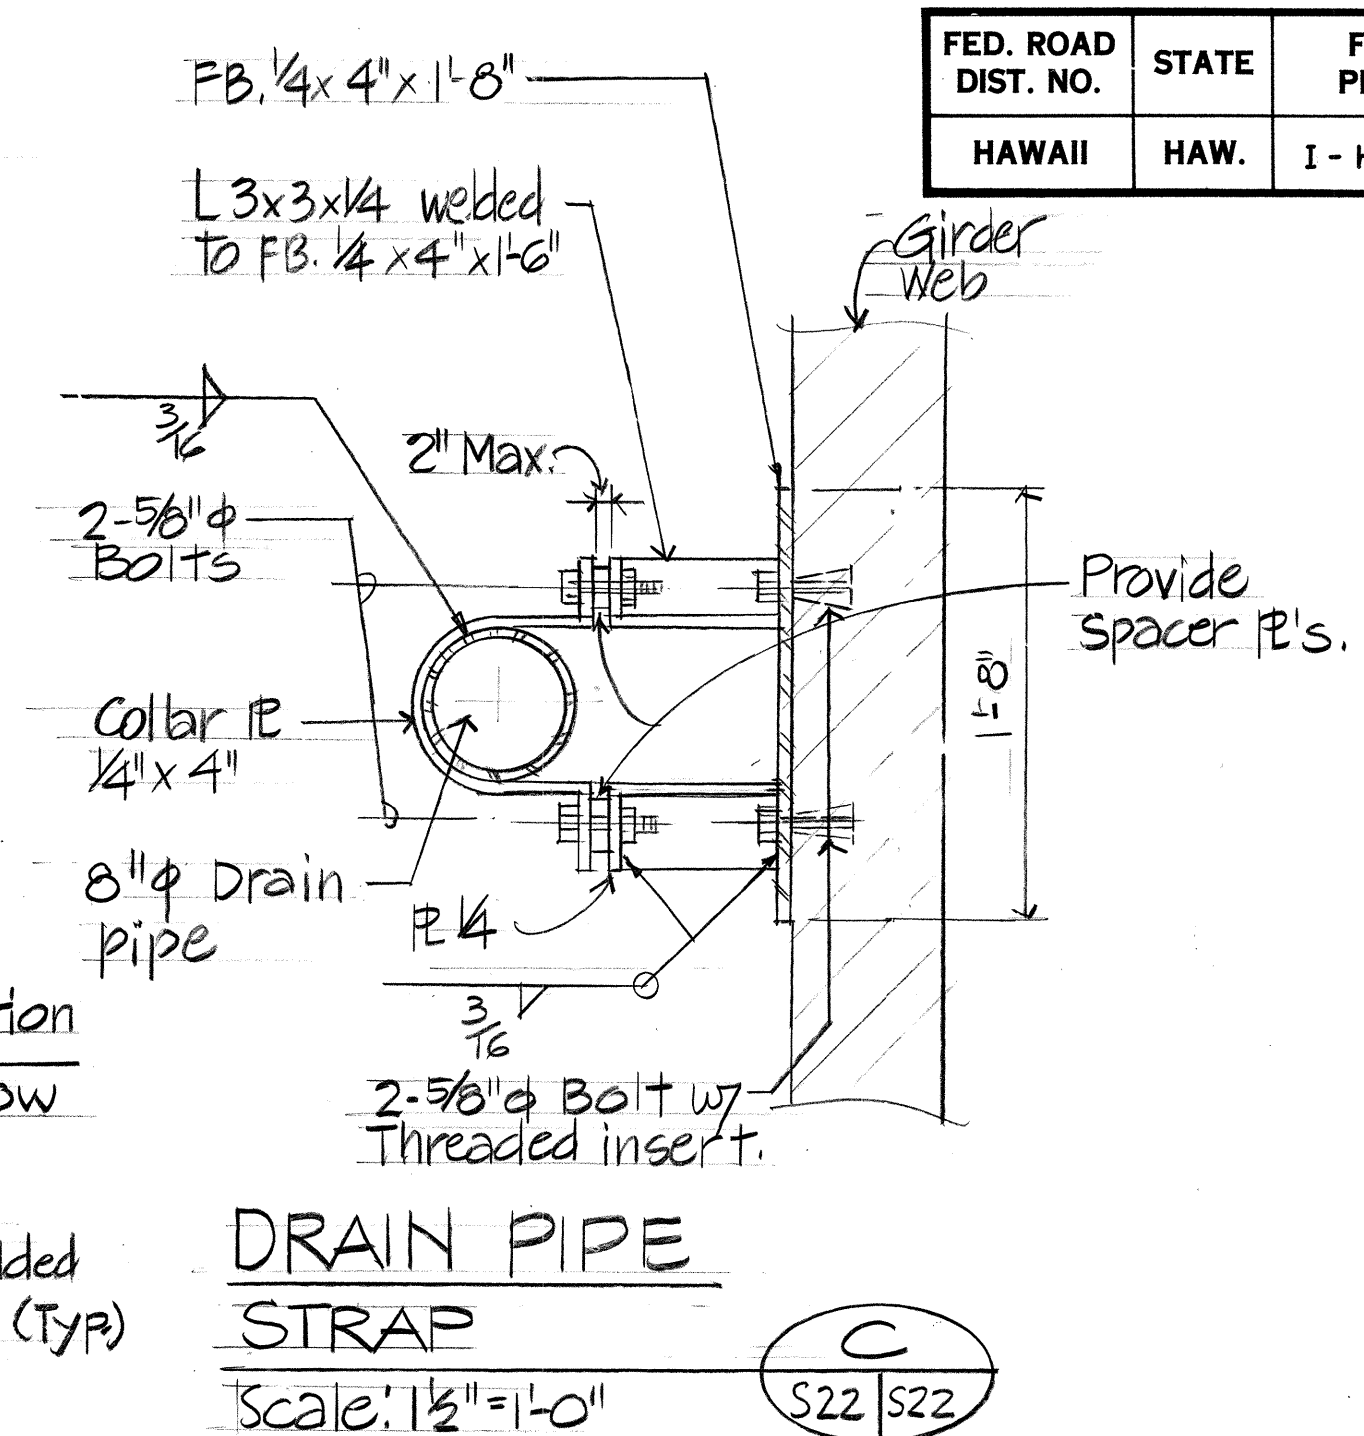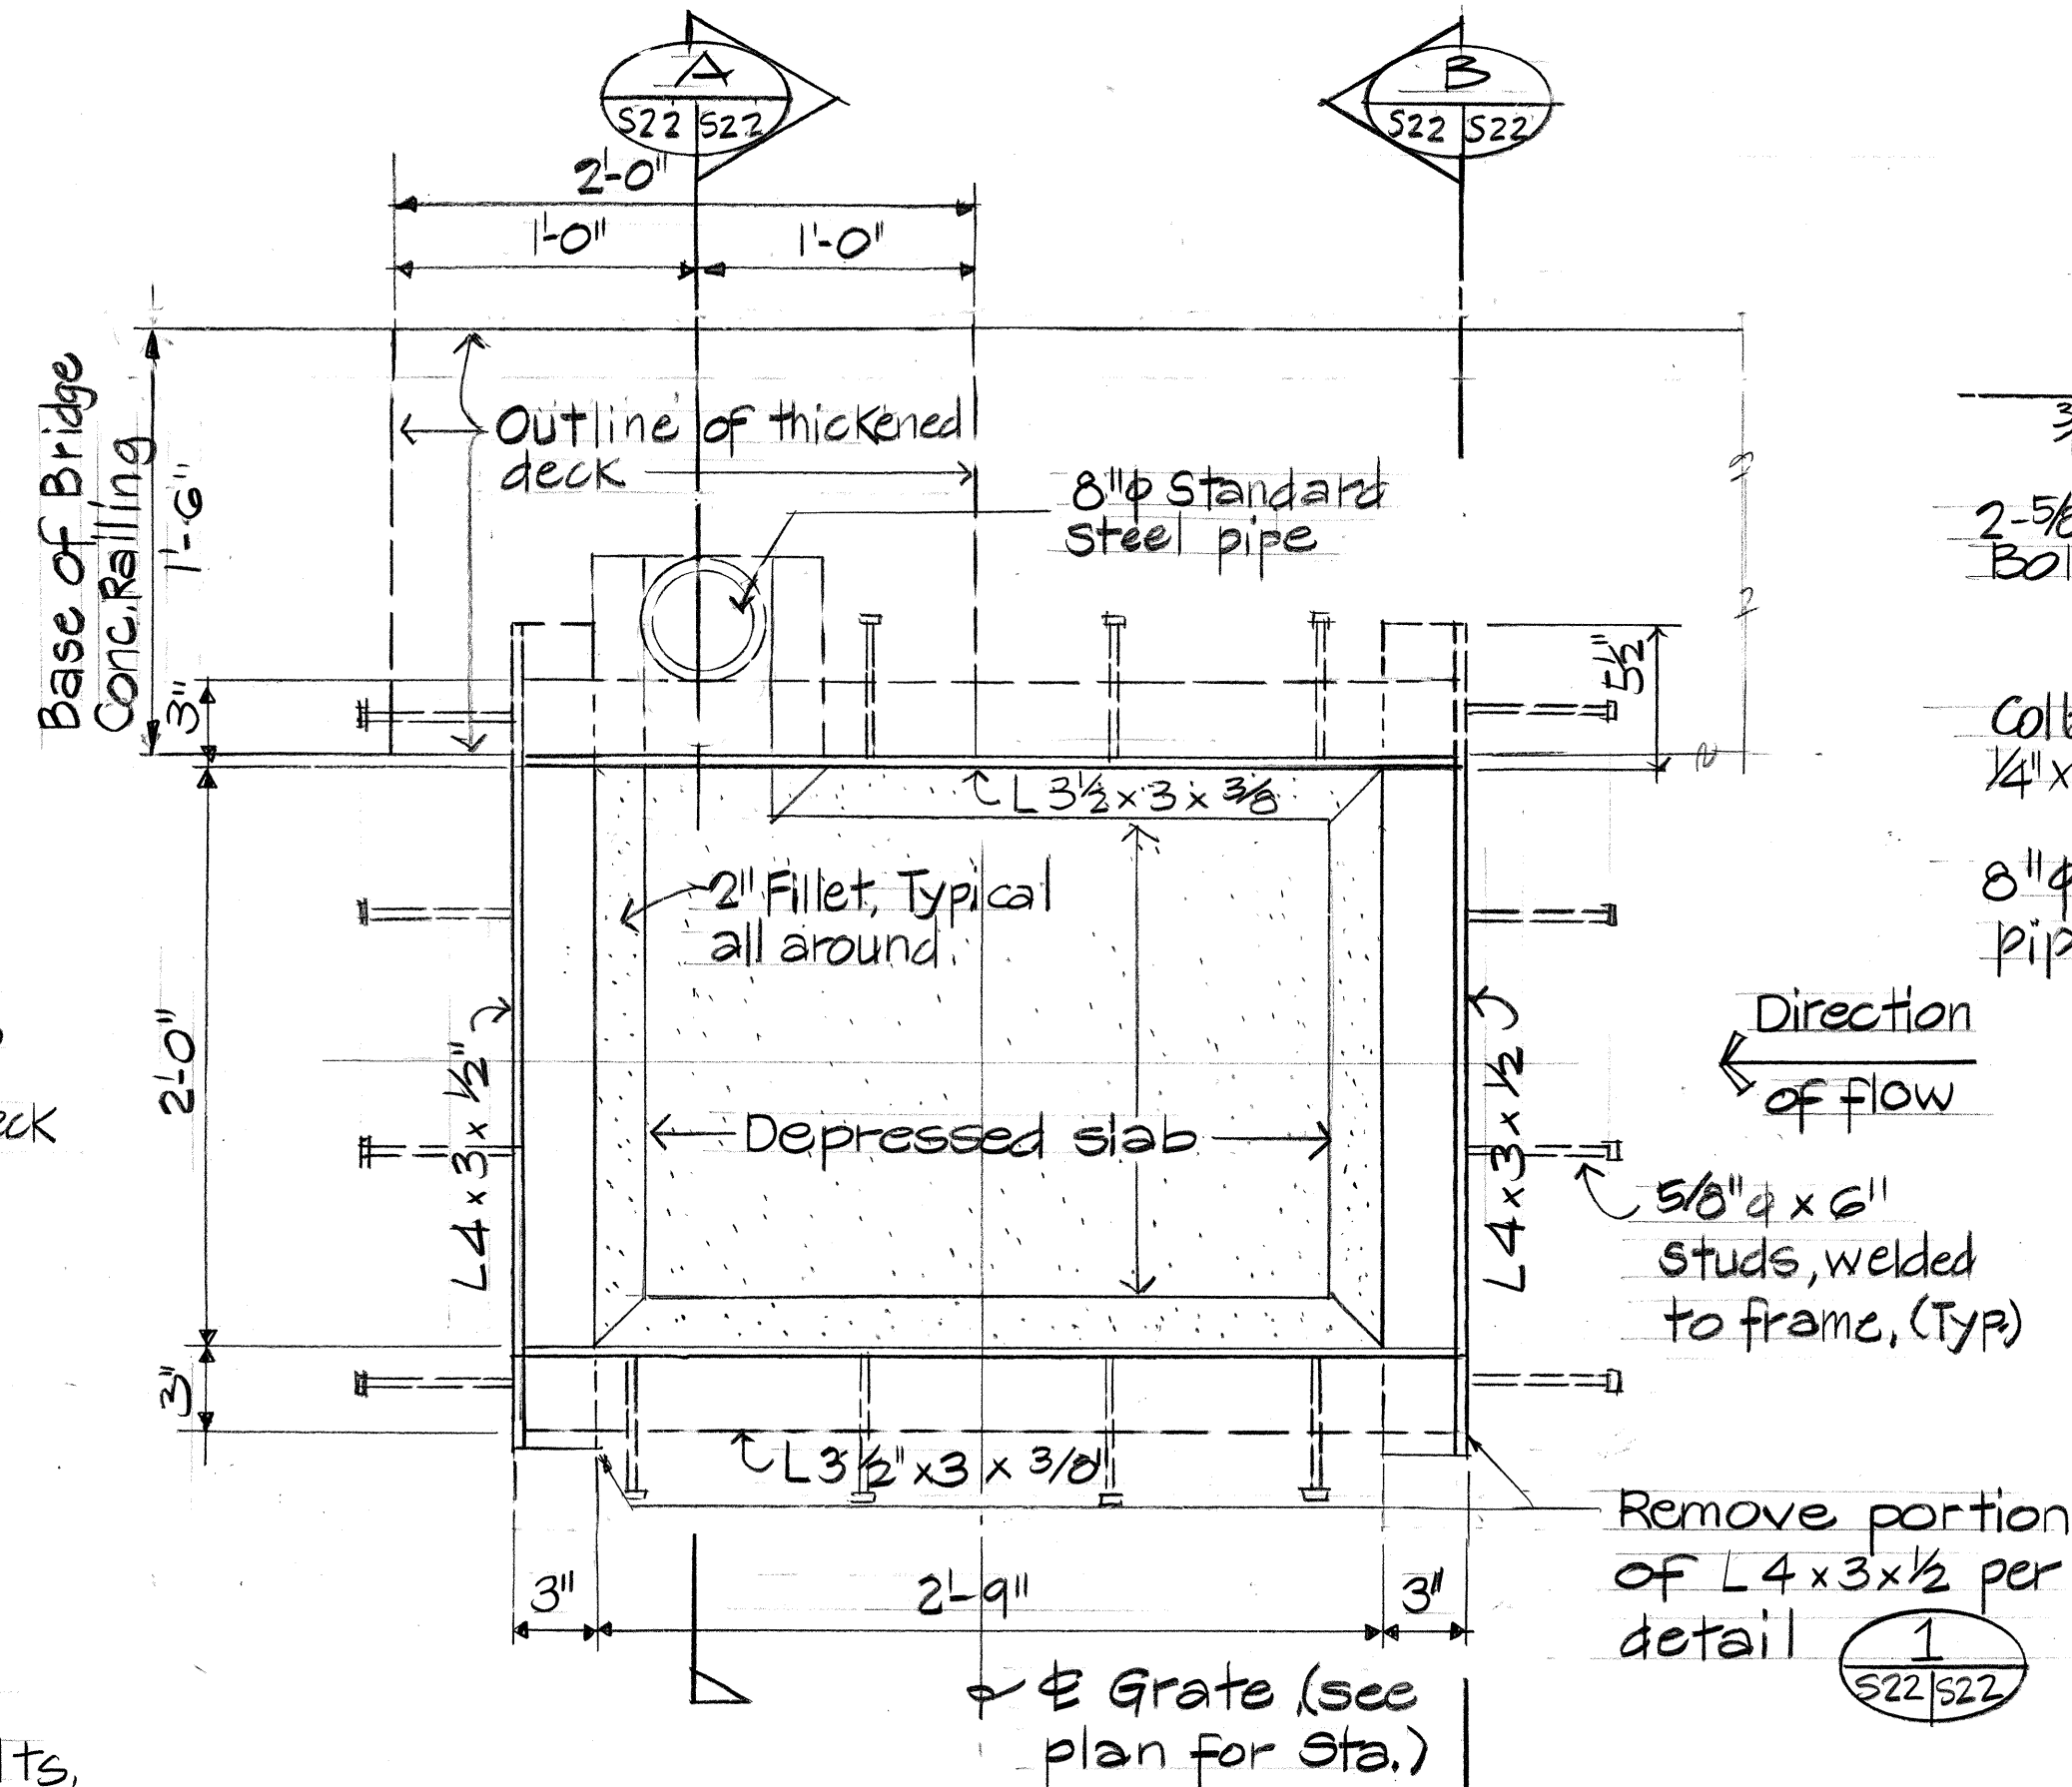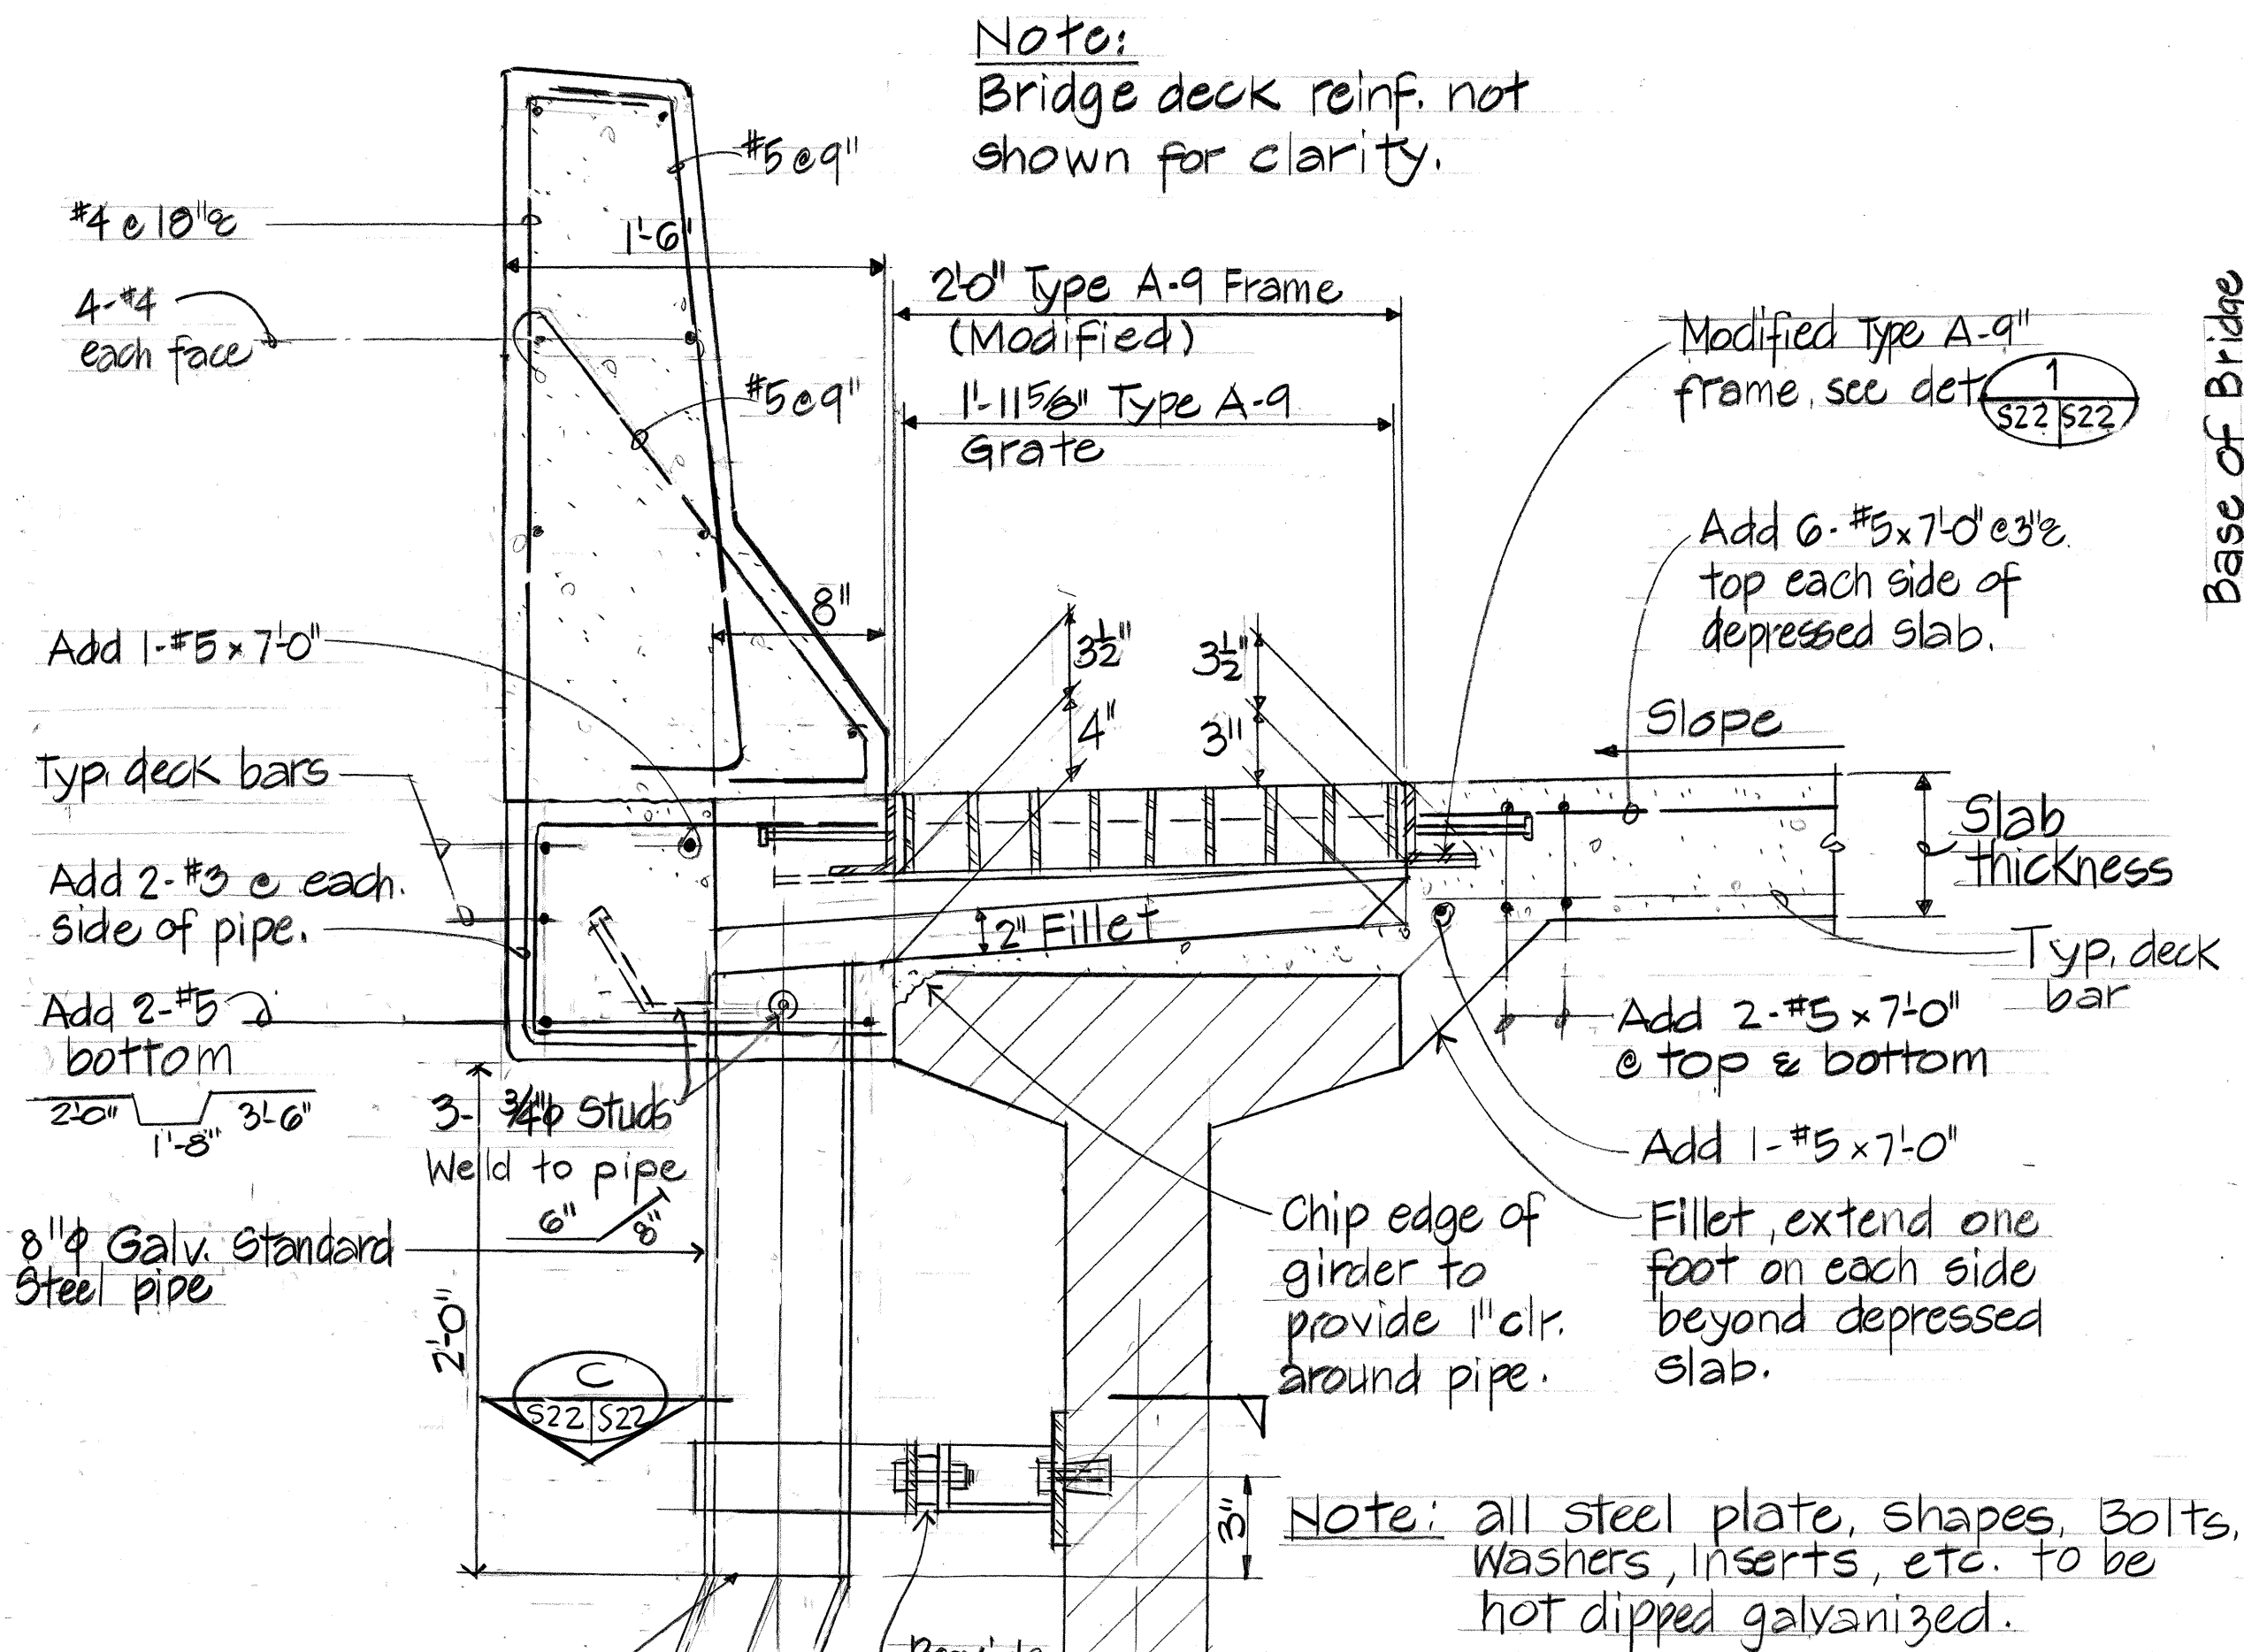

Notes:

- For other details of frame, see Standard Plan H-09.
- Type A-9 Standard Grate, see Standard Plan H-09.
- Hot dip galvanized all steel after fabrication.
- Type A-9 Grate modified Type A-9 Frame and diffuser assembly shall be incidental to concrete in Haiku Valley bridge.



THIS WORK WAS PREPARED BY ME OR UNDER MY SUPERVISION

Myron Okino

STATE OF HAWAII
DEPARTMENT OF TRANSPORTATION
HIGHWAYS DIVISION

DECK DRAIN AND MISC. DETAILS

INTERSTATE ROUTE H-3
F.A.I. PROJECT NO. I-H3-1(52)

SCALE: AS NOTED DATE: JULY 1988

SHEET NO. S22 OF S26 SHEETS

DATE REVISION

AS BUILT

56

S22

53


DATE	
SURVEY PLOTTED BY	
DRAWN BY	
DESIGNED BY	
QUANTITIES BY	
CHECKED BY	
ORIGINAL PLAN	
NOTE BOOK	
NO.	

SECTION B-B
Scale: 1/2" = 1'-0"

PLAN
DECK DRAIN REINF.
Scale: 1/2" = 1'-0"


FED. ROAD DIST. NO.	STATE	FED. AID PROJ. NO.	FISCAL YEAR	SHEET NO.	TOTAL SHEETS
HAWAII	HAW.	I-H3-1 (52)	1988	58	75

Anchor bolts to be set with Template.

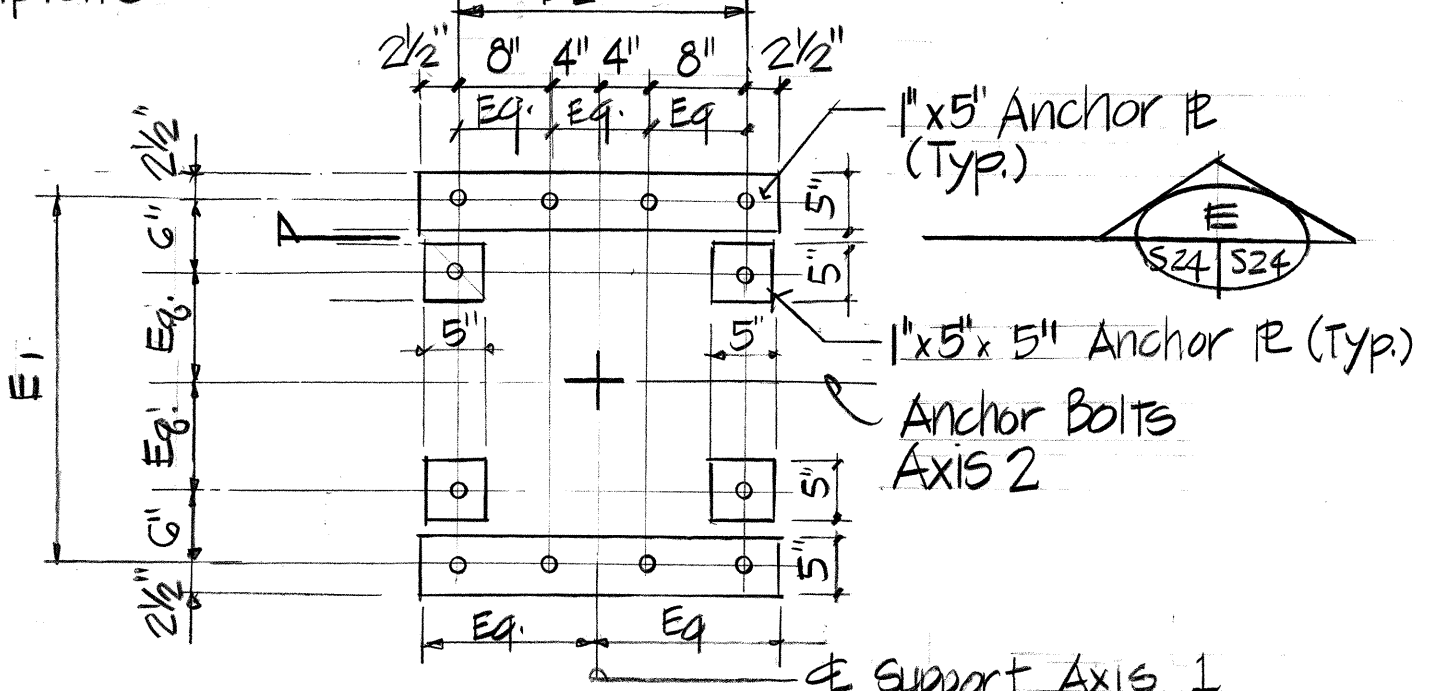

ANCHOR BOLT PLAN

Scale: 3/4" = 1'-0"

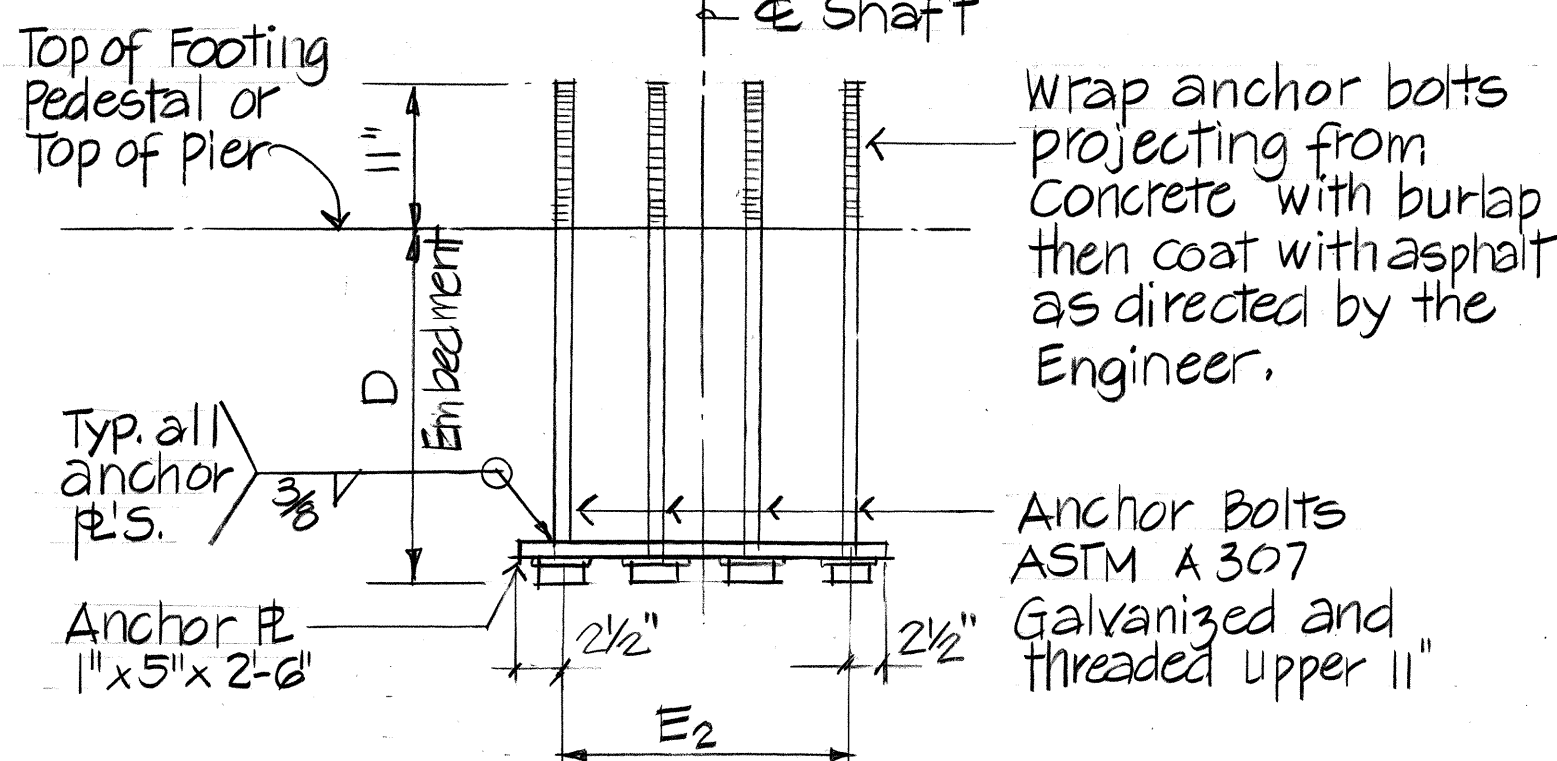

SECTION E

Scale: 3/4" = 1'-0"


ANCHOR BOLT DETAILS 3

Scale: 3/4" = 1'-0"

Anchor Bolts, Plates, Burlap and Asphalt Coating shall be considered incidental to the various Foundations.


For placement of Electric Power, Communication and Signal conduits see Electrical Drawings.

Location Station	Anchor Bolt Size	D	E1	E2
261+40 O.B. Center	2 1/2"		4	
261+40 O.B. Right	2 1/2"			
Inbound Abut. 2 locations 262+58.75 I.B.	2 1/4"	3'-3"	3'-0"	2'-0"
262+42 O.B. Right	2 1/4"	3'-3"	3'-0"	2'-0"
263+28.5 O.B. Right	2 1/4"	3'-9"	3'-6"	2'-0"

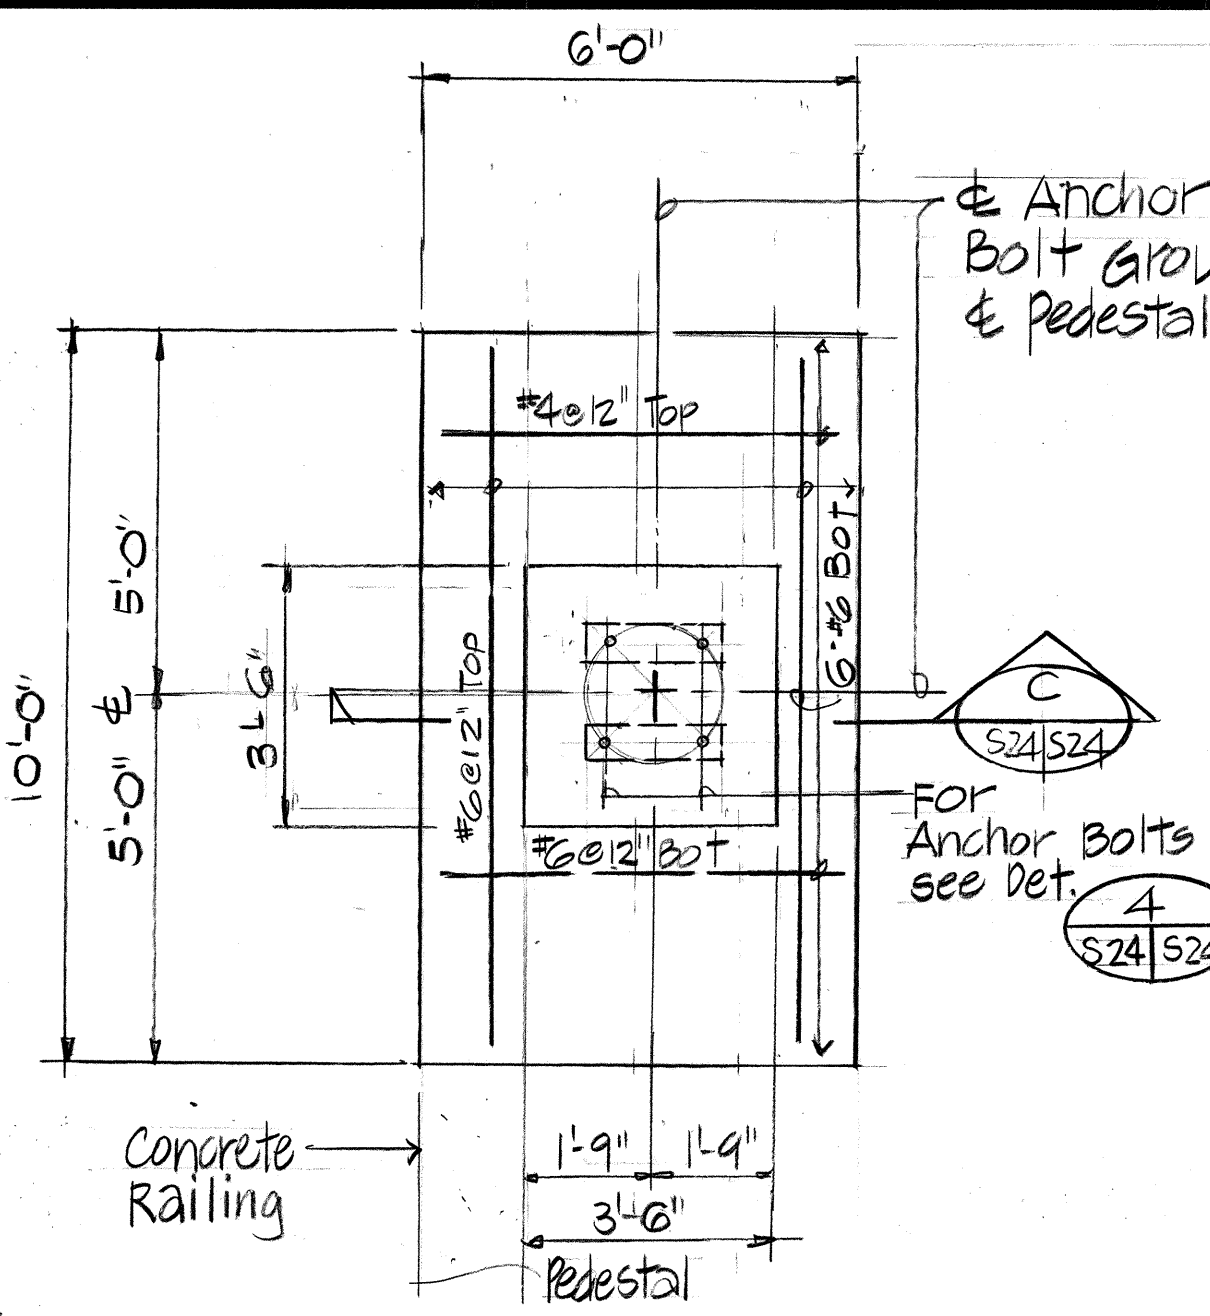

PLAN

Scale: 3/8" = 1'-0"

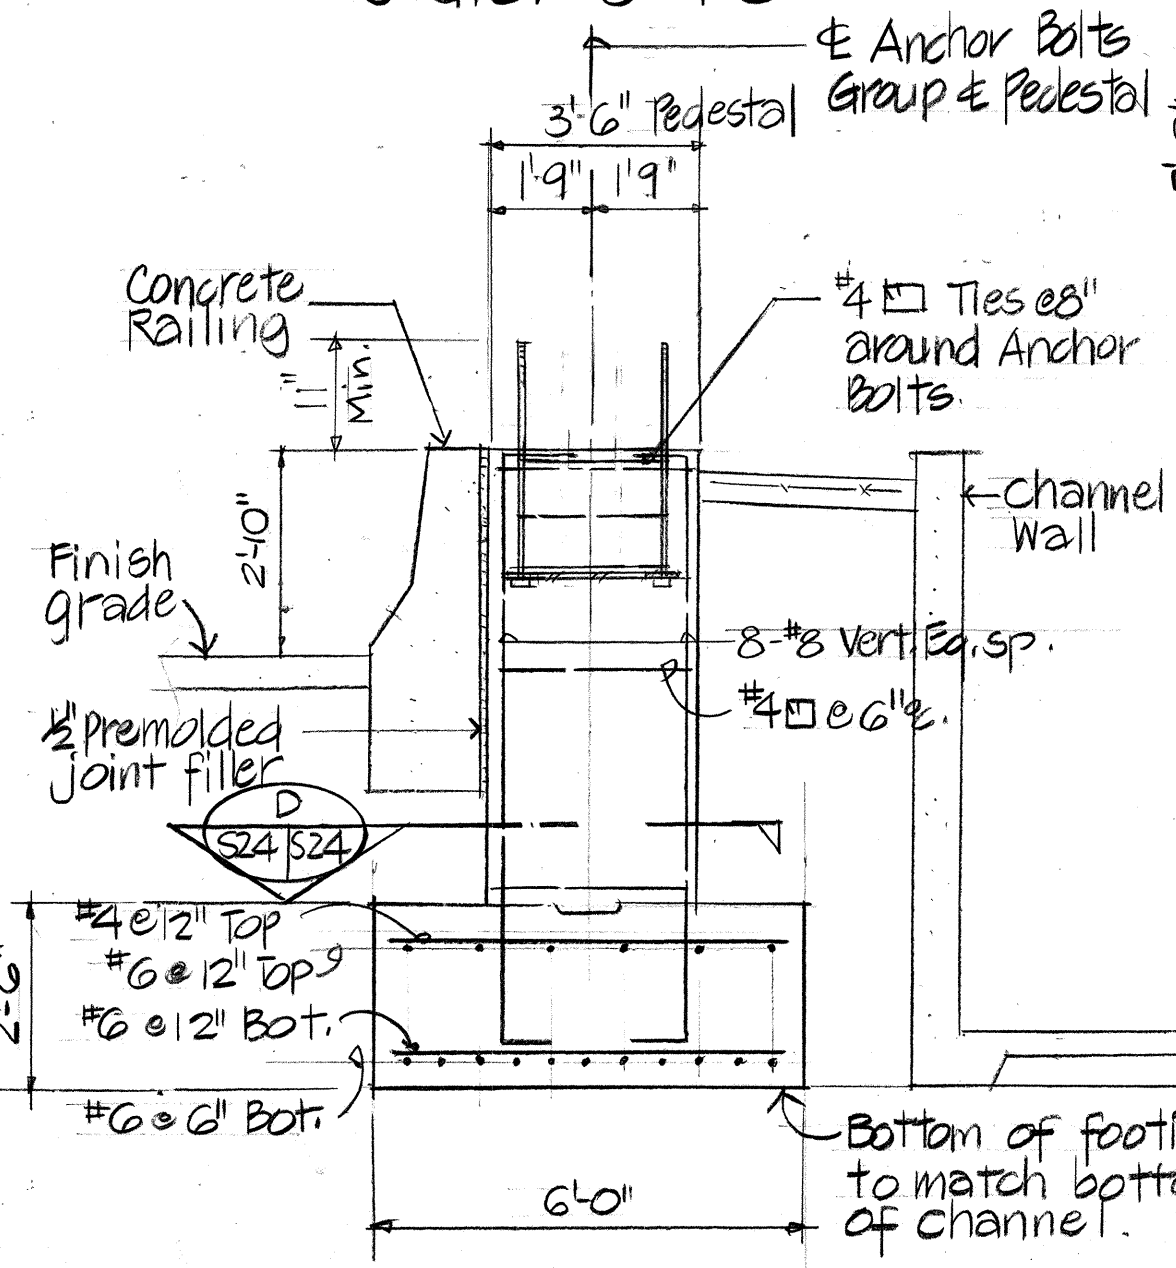

SECTION C

Scale: 3/8" = 1'-0"

FOUNDATION FOR FARADAY POST @ STA. 261+40 O.B. RIGHT


2 S24/S24

Deleted by CCO #32

ANCHOR BOLT PLAN 4

Scale: 3/4" = 1'-0"


4 S24/S24

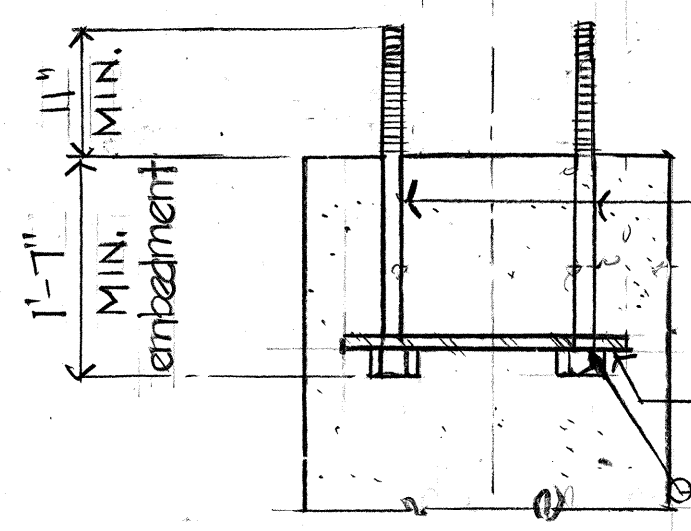

SECTION F


Scale: 3/4" = 1'-0"

4 S24/S24

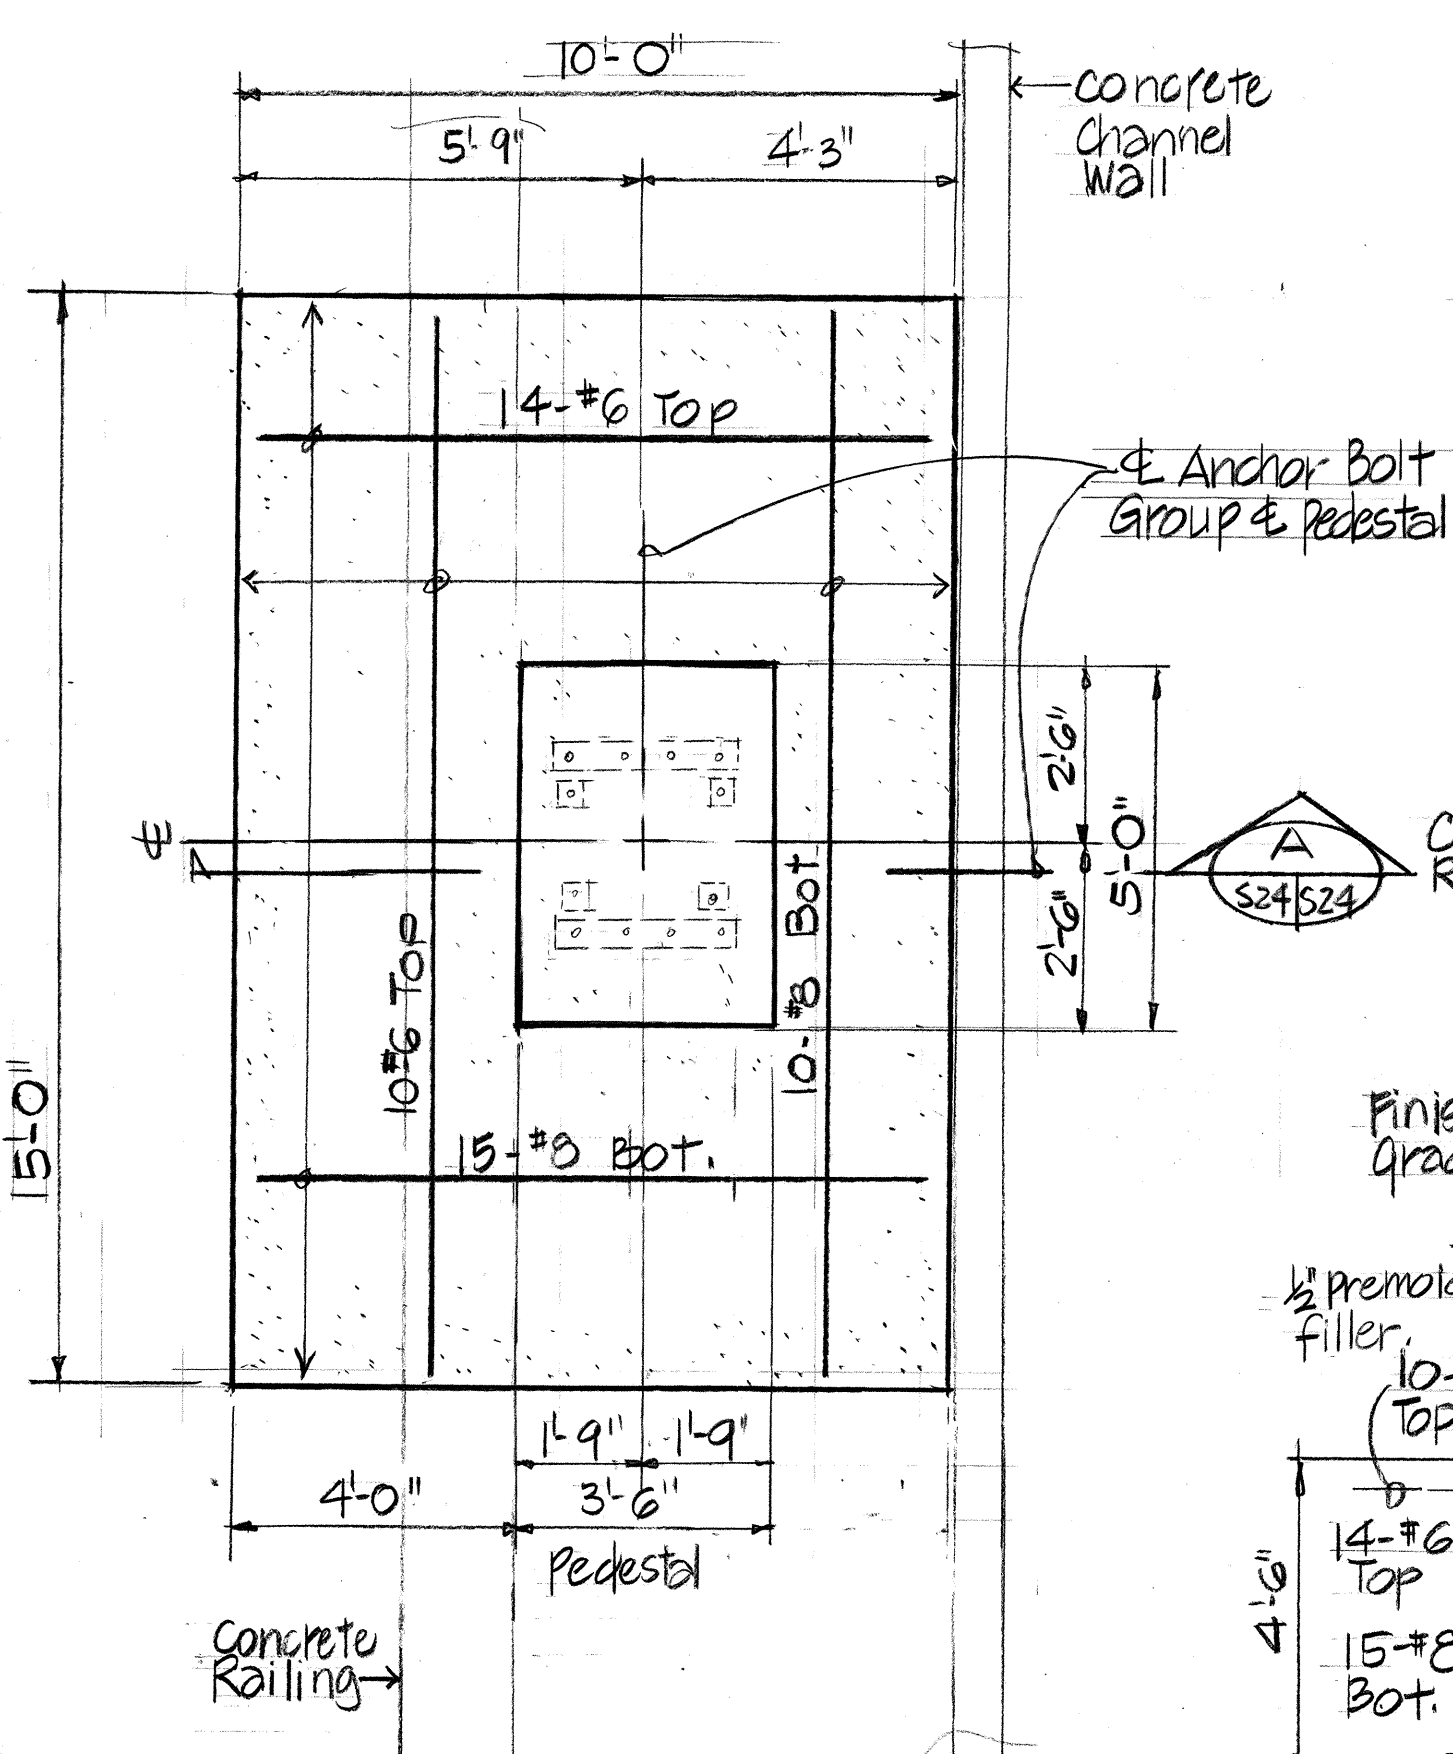

PLAN

Scale: 3/8" = 1'-0"

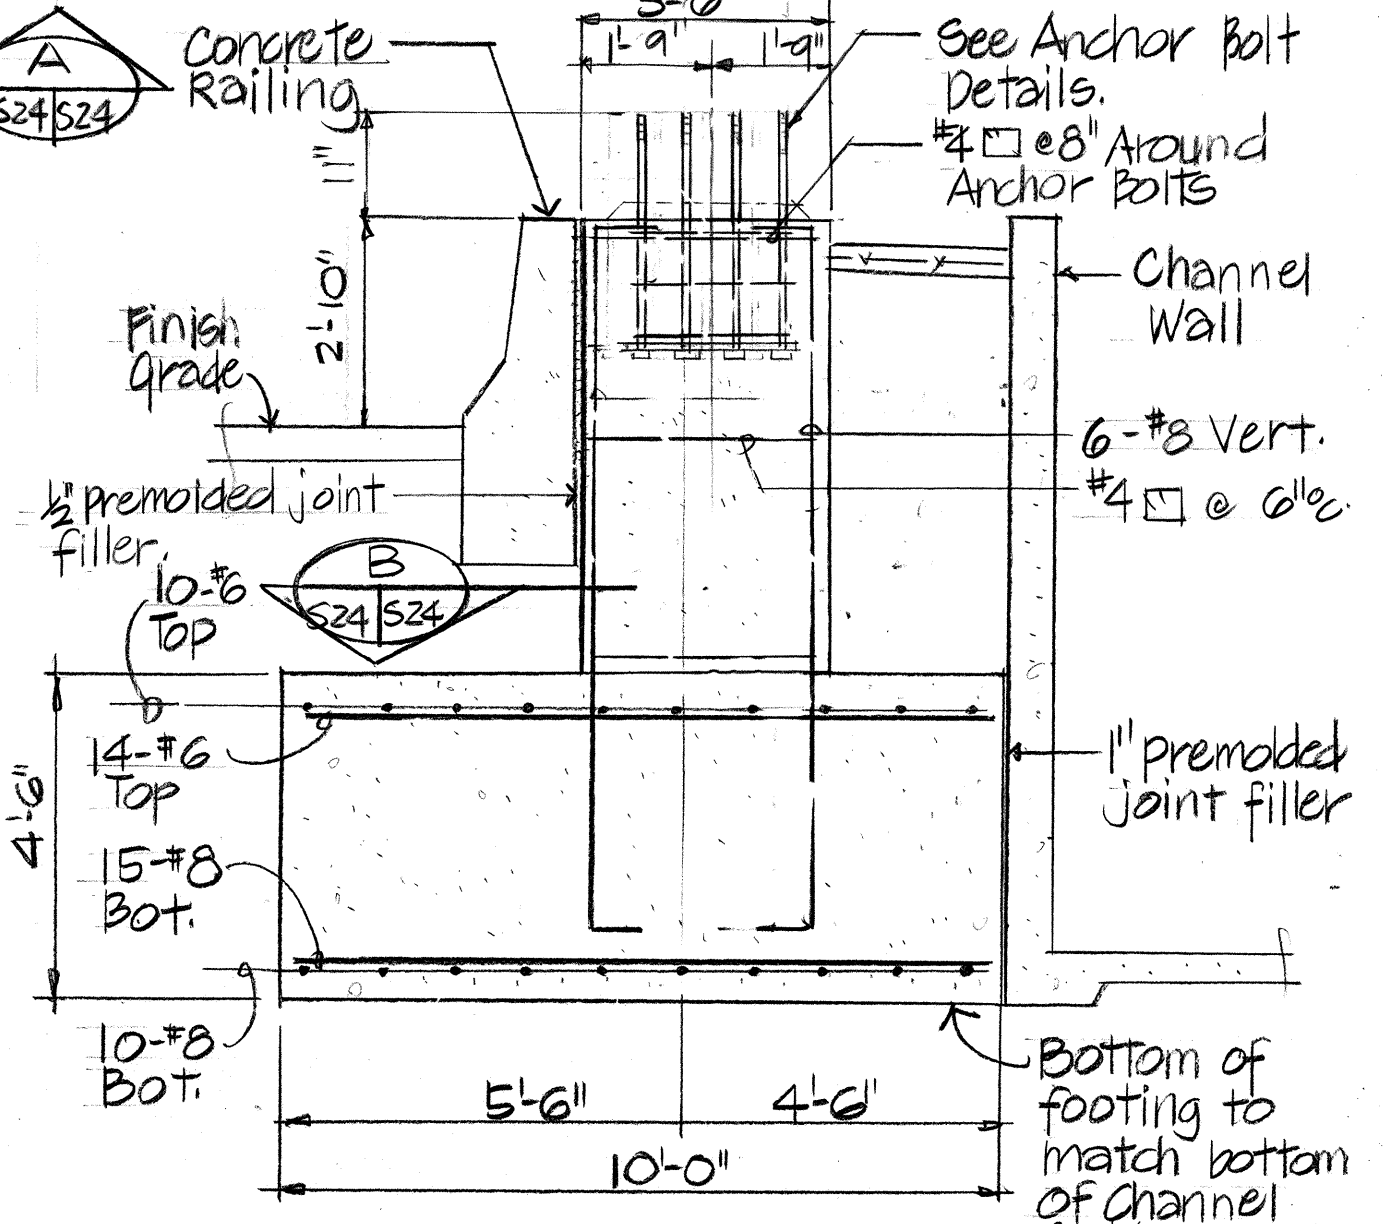

SECTION A

Scale: 3/8" = 1'-0"

1 S24/S24

FOUNDATION FOR HIGHWAY SIGN @ STA. 263+28.5 O.B. RIGHT

Deleted by CCO #32

SURVEY PLOTTED BY	DATE
DRAWN BY	
DESIGNED BY	
CHECKED BY	
ORIGINAL PLAN	
NOTE BOOK	
No.	



THIS WORK WAS PREPARED BY ME OR UNDER MY SUPERVISION

Myron G. Okuro

STATE OF HAWAII
DEPARTMENT OF TRANSPORTATION
HIGHWAYS DIVISION

SIGN SUPPORT DETAILS

INTERSTATE ROUTE H-3
F.A.I. PROJECT NO. I-H3-1 (52)

SCALE: AS NOTED DATE: JULY 1988

SHEET NO. S24 OF S26 SHEETS

1/10/89 Detail 4 Revised
Details 3A, F & Schedule Revised

DATE REVISION


AS BUILT

ADD. 58

FED. ROAD DIST. NO.	STATE	FED. AID PROJ. NO.	FISCAL YEAR	SHEET NO.	TOTAL SHEETS
HAWAII	HAW.	I-H3-1(52)	1988	59	75

FILE NOTES


- Concrete strengths:
 - Typical pile: 28 day compressive strength $f_c = 6000 \text{ psi}$.
 - Pile build-up with driving: 28 day compressive strength $f_c = 6000 \text{ psi}$.
 - Pile build-up without driving: Identical 28 days f_c as footing or pile cap.
- Reinforcing steel shall conform to the following ASTM Specifications:
 - Bar reinforcement: ASTM A615 Grade 40.
 - Spiral reinforcement: ASTM A82.
 - Prestressing strand: ASTM A416 Grade 270.
- The minimum working force in the prestressing steel shall be 190 kips.
- Piles accepted by the Engineer shall be of sound concrete. Damaged piles shall be replaced or repaired by the Contractor at his expense as directed by the Engineer.
- Work of Cutting off prestressed concrete piles or concrete pile build-ups shall be performed in such a manner as to avoid spalling or damaging the pile below cut-off. Damaged portions shall be removed and pile cut-off elevation lowered as required by the Engineer.
- Top of pile at cut-off line shall be prepared as required for construction joints in Section 503 of the Standard Specifications.
- Pile splice shall not be permitted.
 - Build-ups may be driven after the concrete attains a compressive strength of 4000 psi, but not earlier than 7 days after the concrete is poured.
- Pile with driving shoe shall be required for all piles at Outbound Abutment. Pile shoe shall be considered incidental to Prestressed Concrete Piles, furnished.
- Pile Load Tests to be performed at the locations indicated. Test Load to be a minimum of two times the Design Load.
- Pile handling procedures shall be reviewed and approved by the Engineer for Piles within the boundaries of the Omega Station.

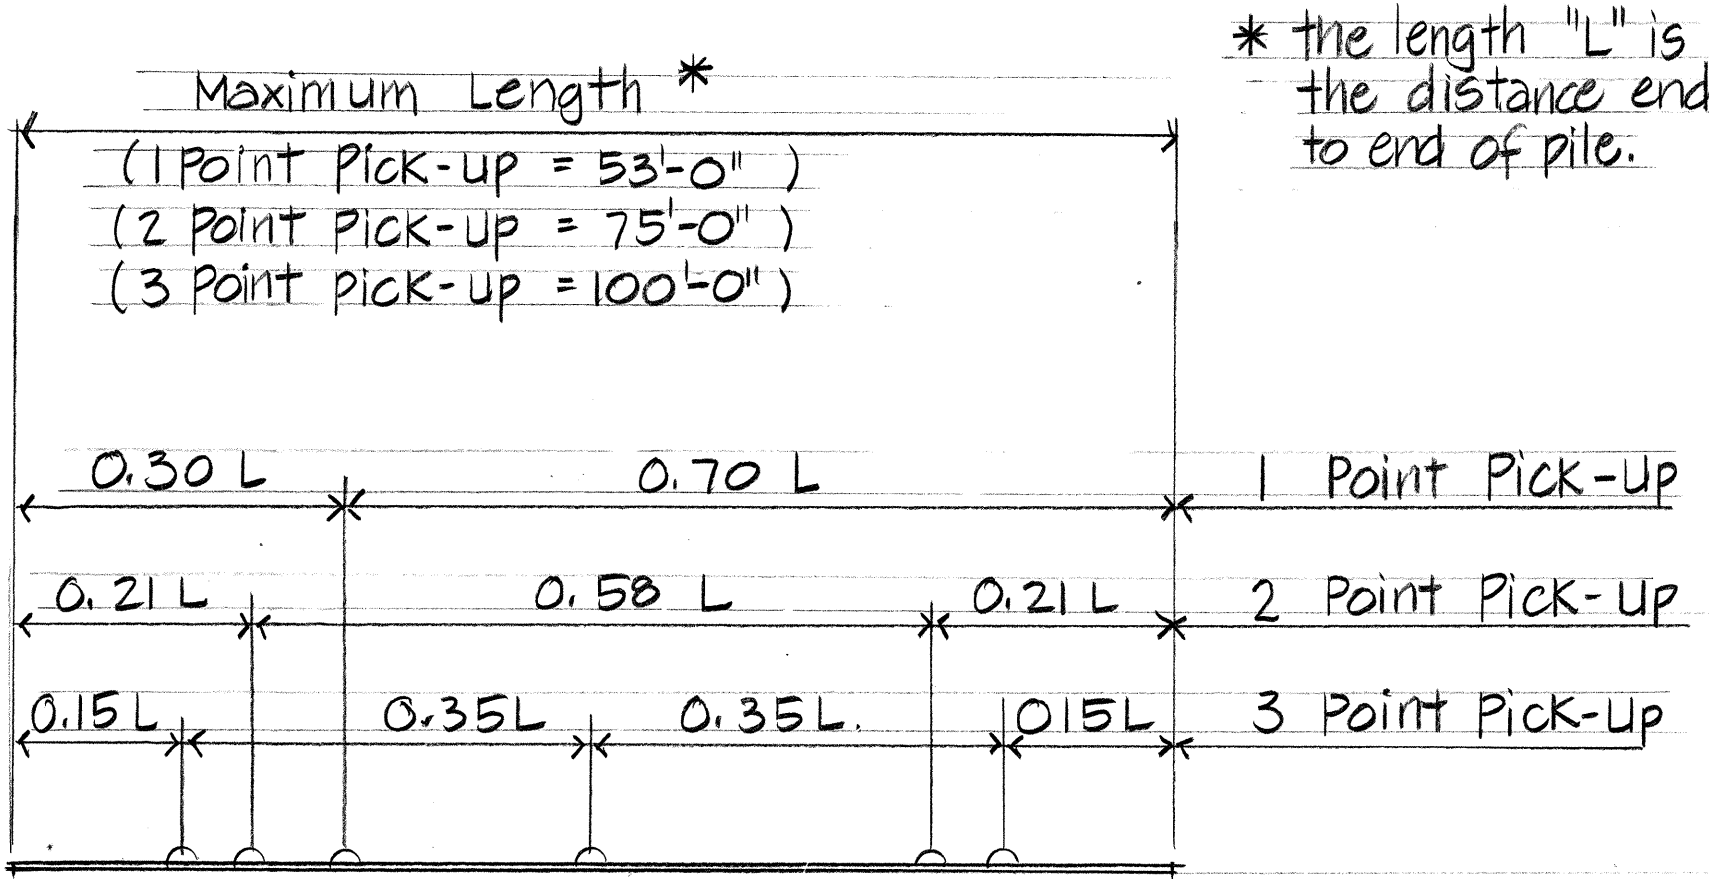


PILE PICK-UP POINTS

No scale:

Remove and Patch Pile Lifting Loops prior to delivery to Jobsite. Piles with Driving Shoes shall have a Grounding Cable attached to the Shoes during handling. Piles shall be handled at the Jobsite with Cables adequately grounded.

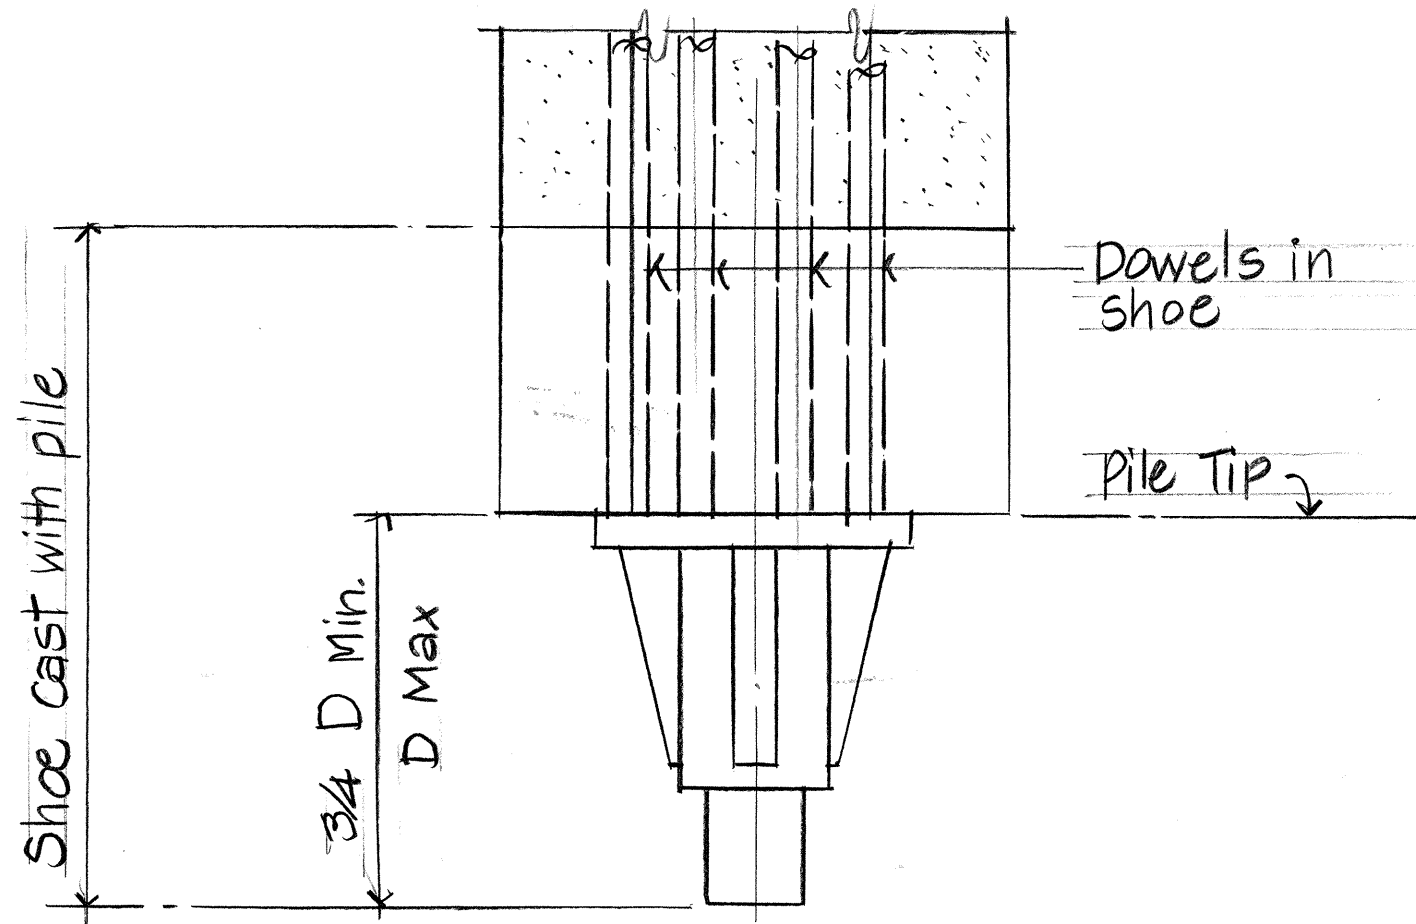

ELEVATION

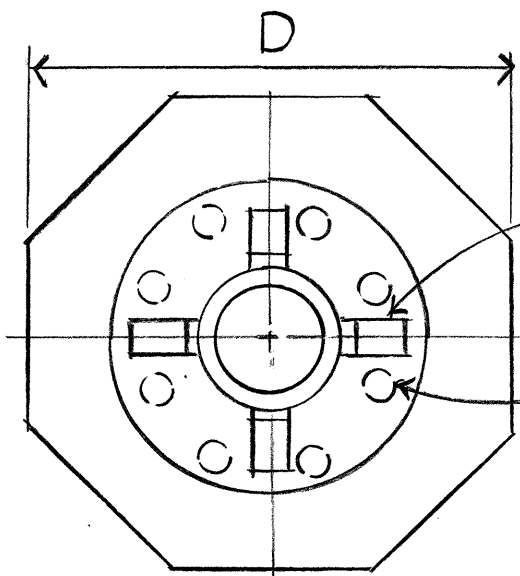



PLAN

ROCK DRIVING SHOE DETAIL


No scale:

- 4 Fins shown
 - 3 Fins also acceptable.
 - 8 dowels shown
 - 6 dowels also acceptable.
- Length of dowels shall be 8'-0" Min.

Note: Pile shoes shall be similar or equal to "Herkules" Rock shoe.

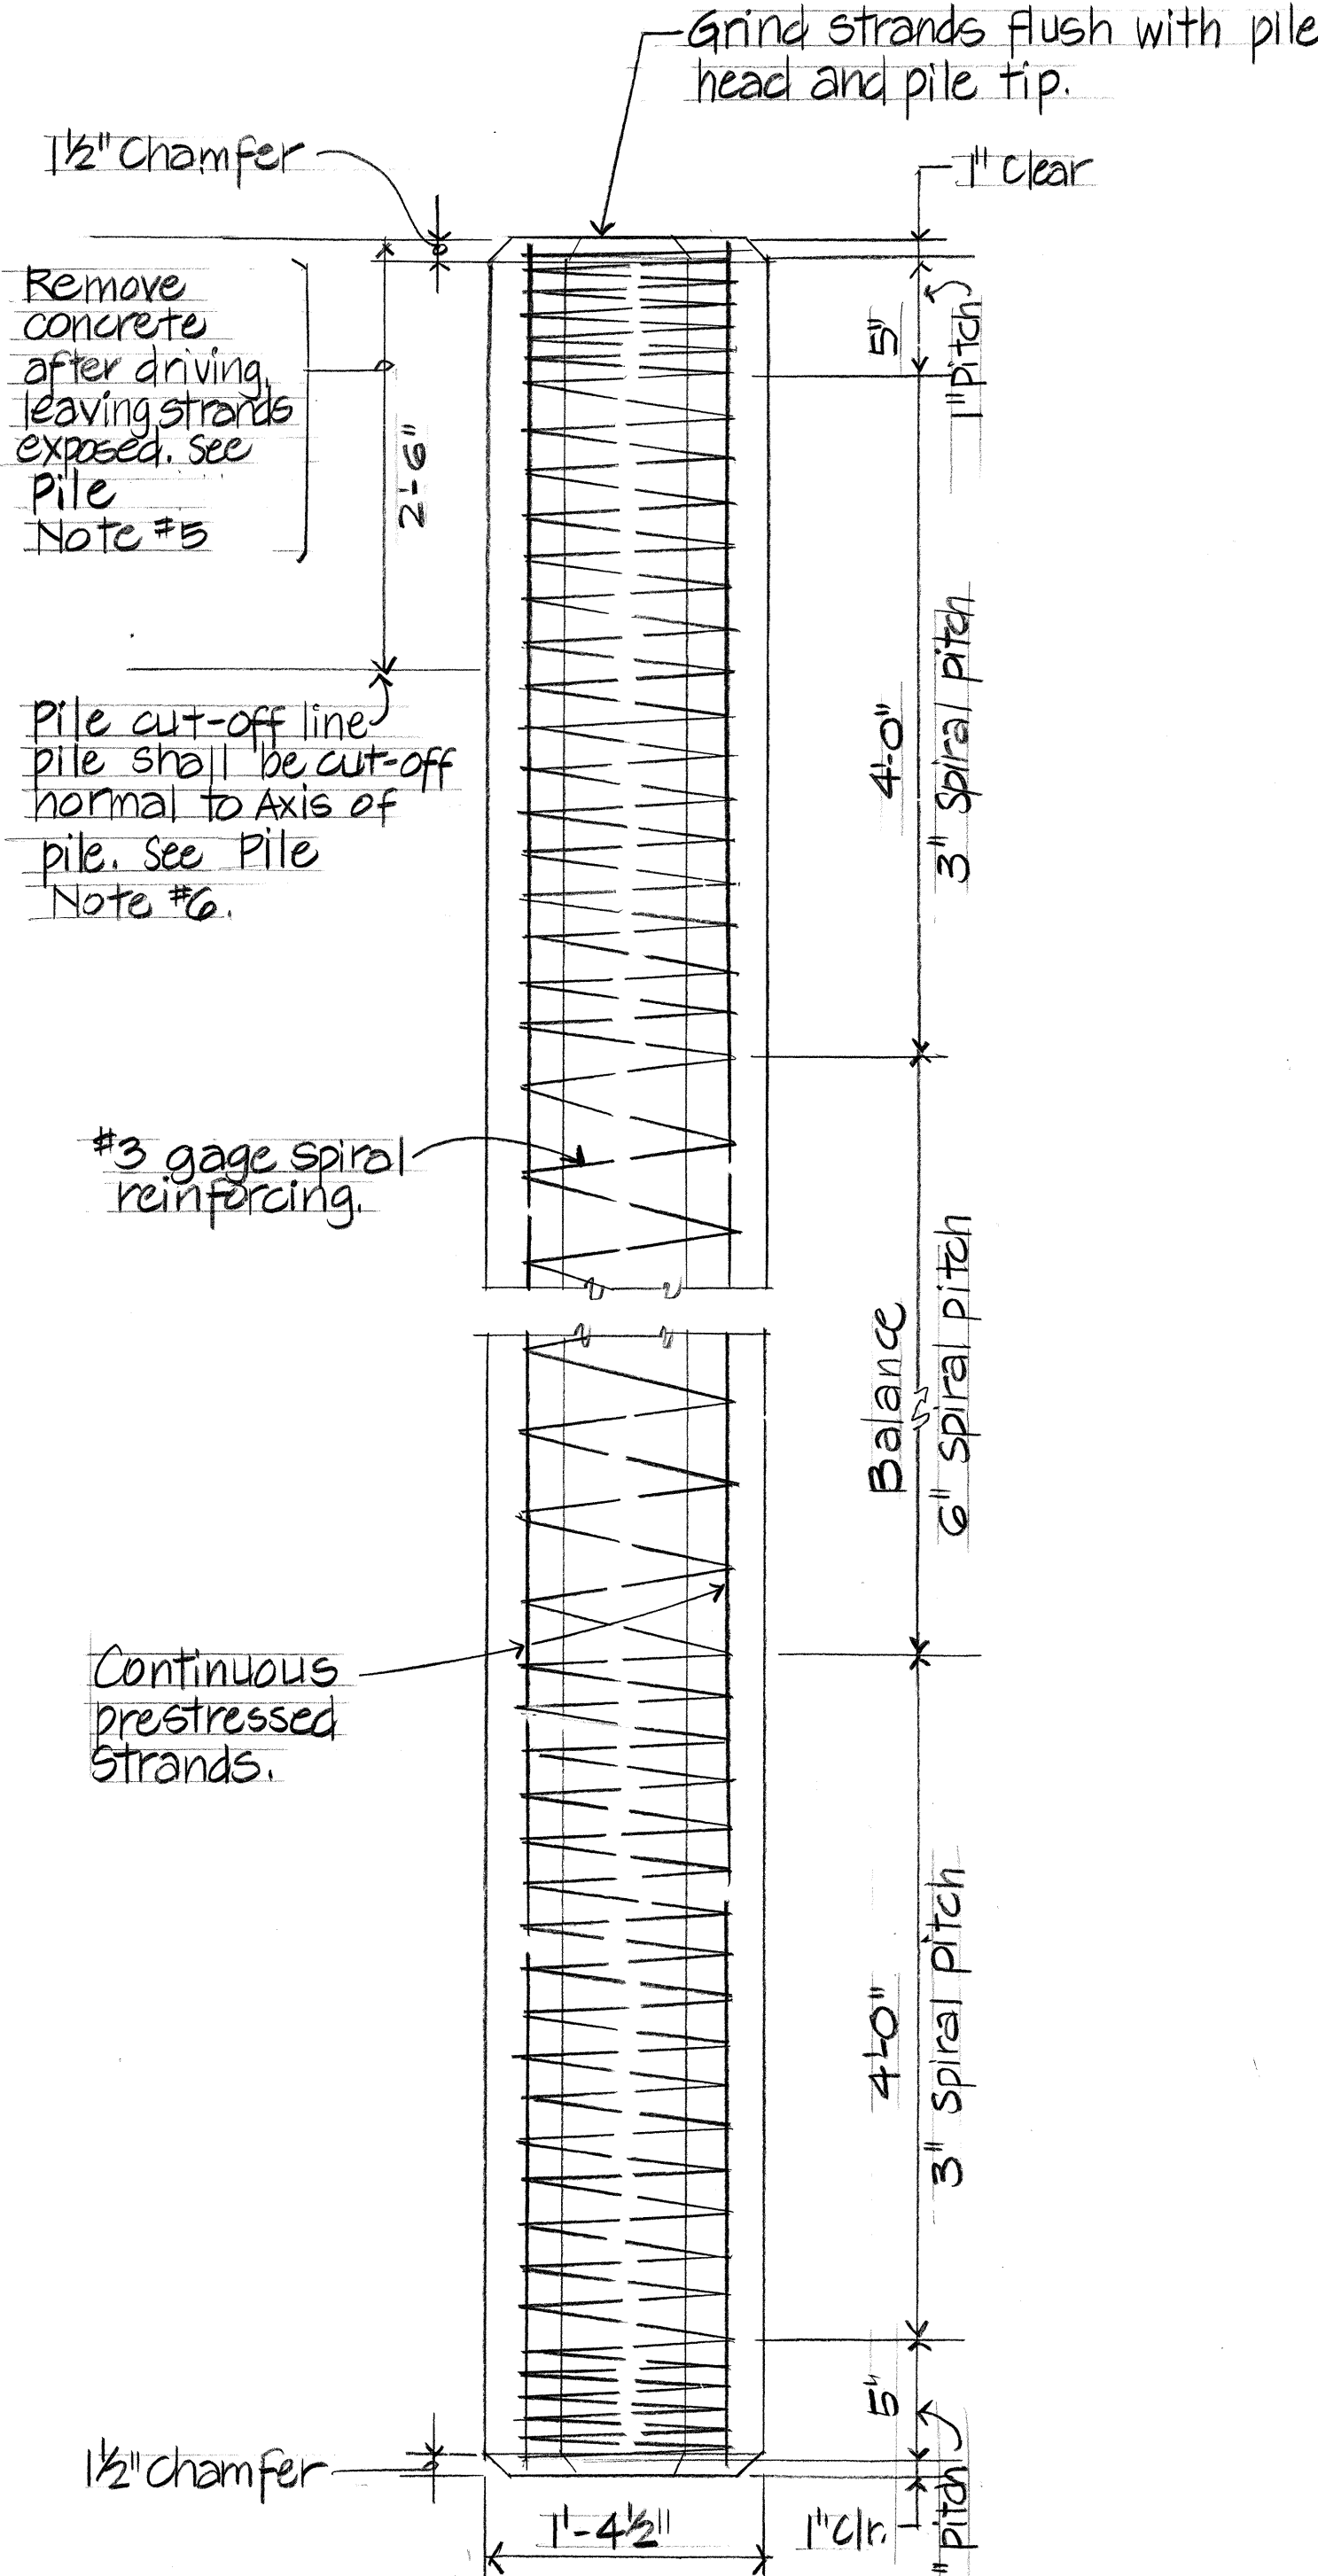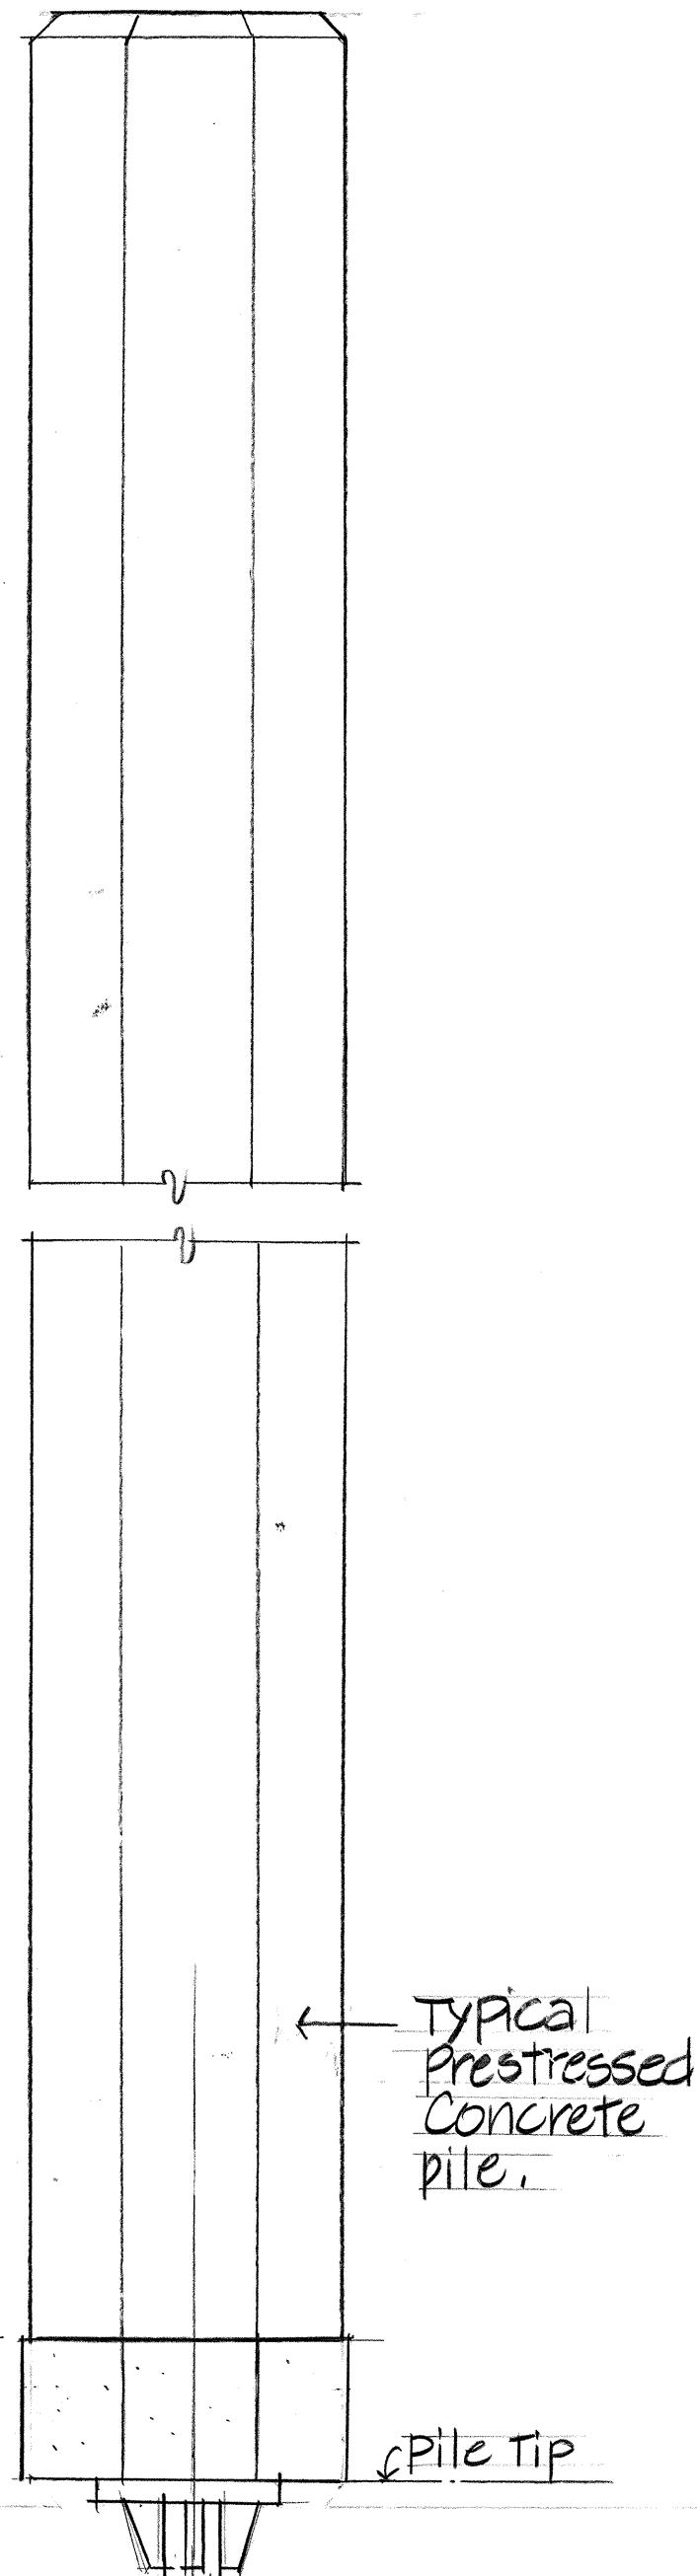

ELEVATION

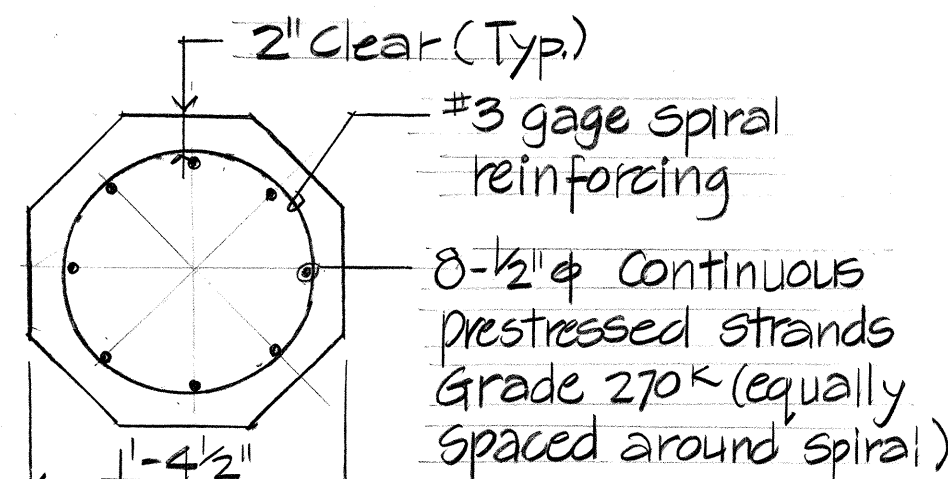

SECTION

TYPICAL PRESTRESSED CONCRETE PILE DETAIL

No scale:

DATE	REVISION	SCALE: AS NOTED	DATE: JULY 1988
1/10/89	Note 9 Revised, Note 11 Added, Pile Pickup Notes Added	SHEET NO. S25 OF S26 SHEETS	

AS BUILT

ADD.59

Top of Bridge Deck

2'-0"

U-Bolt clips total -6

4 1/2" 1/2" minimum

6" Spread

Premolded joint filler

1/8" Hard board backing (Shaped)

3/4" ϕ Cables bind with metal strap or wire

1" Expanded Polystyrene Filler

1'-3" wrap w/ duct tape

7 1/2"

3'-6"

1/8" Hard board

Restrained Hinge Dowels shall be in place to Concrete Haiku Valley Bridges

#11 x 2'-0"

Face of
Girder web

#8 Bar threaded
at one end.

Mounting
Washer

5 1/2" Min.

Inserts to develop minimum
ultimate pullout value of 24 Kips.

INSERT DETAIL 3

Not to Scale S10, S14, S16, S17, S18, S26

1 1/8" ϕ rope typ.

2" typ.

1" max.
relief

Incidental to Concrete
in Haiku Valley Bridges

S4, S3 | S26

S7	S8	S14	S17	S26
----	----	-----	-----	-----

