
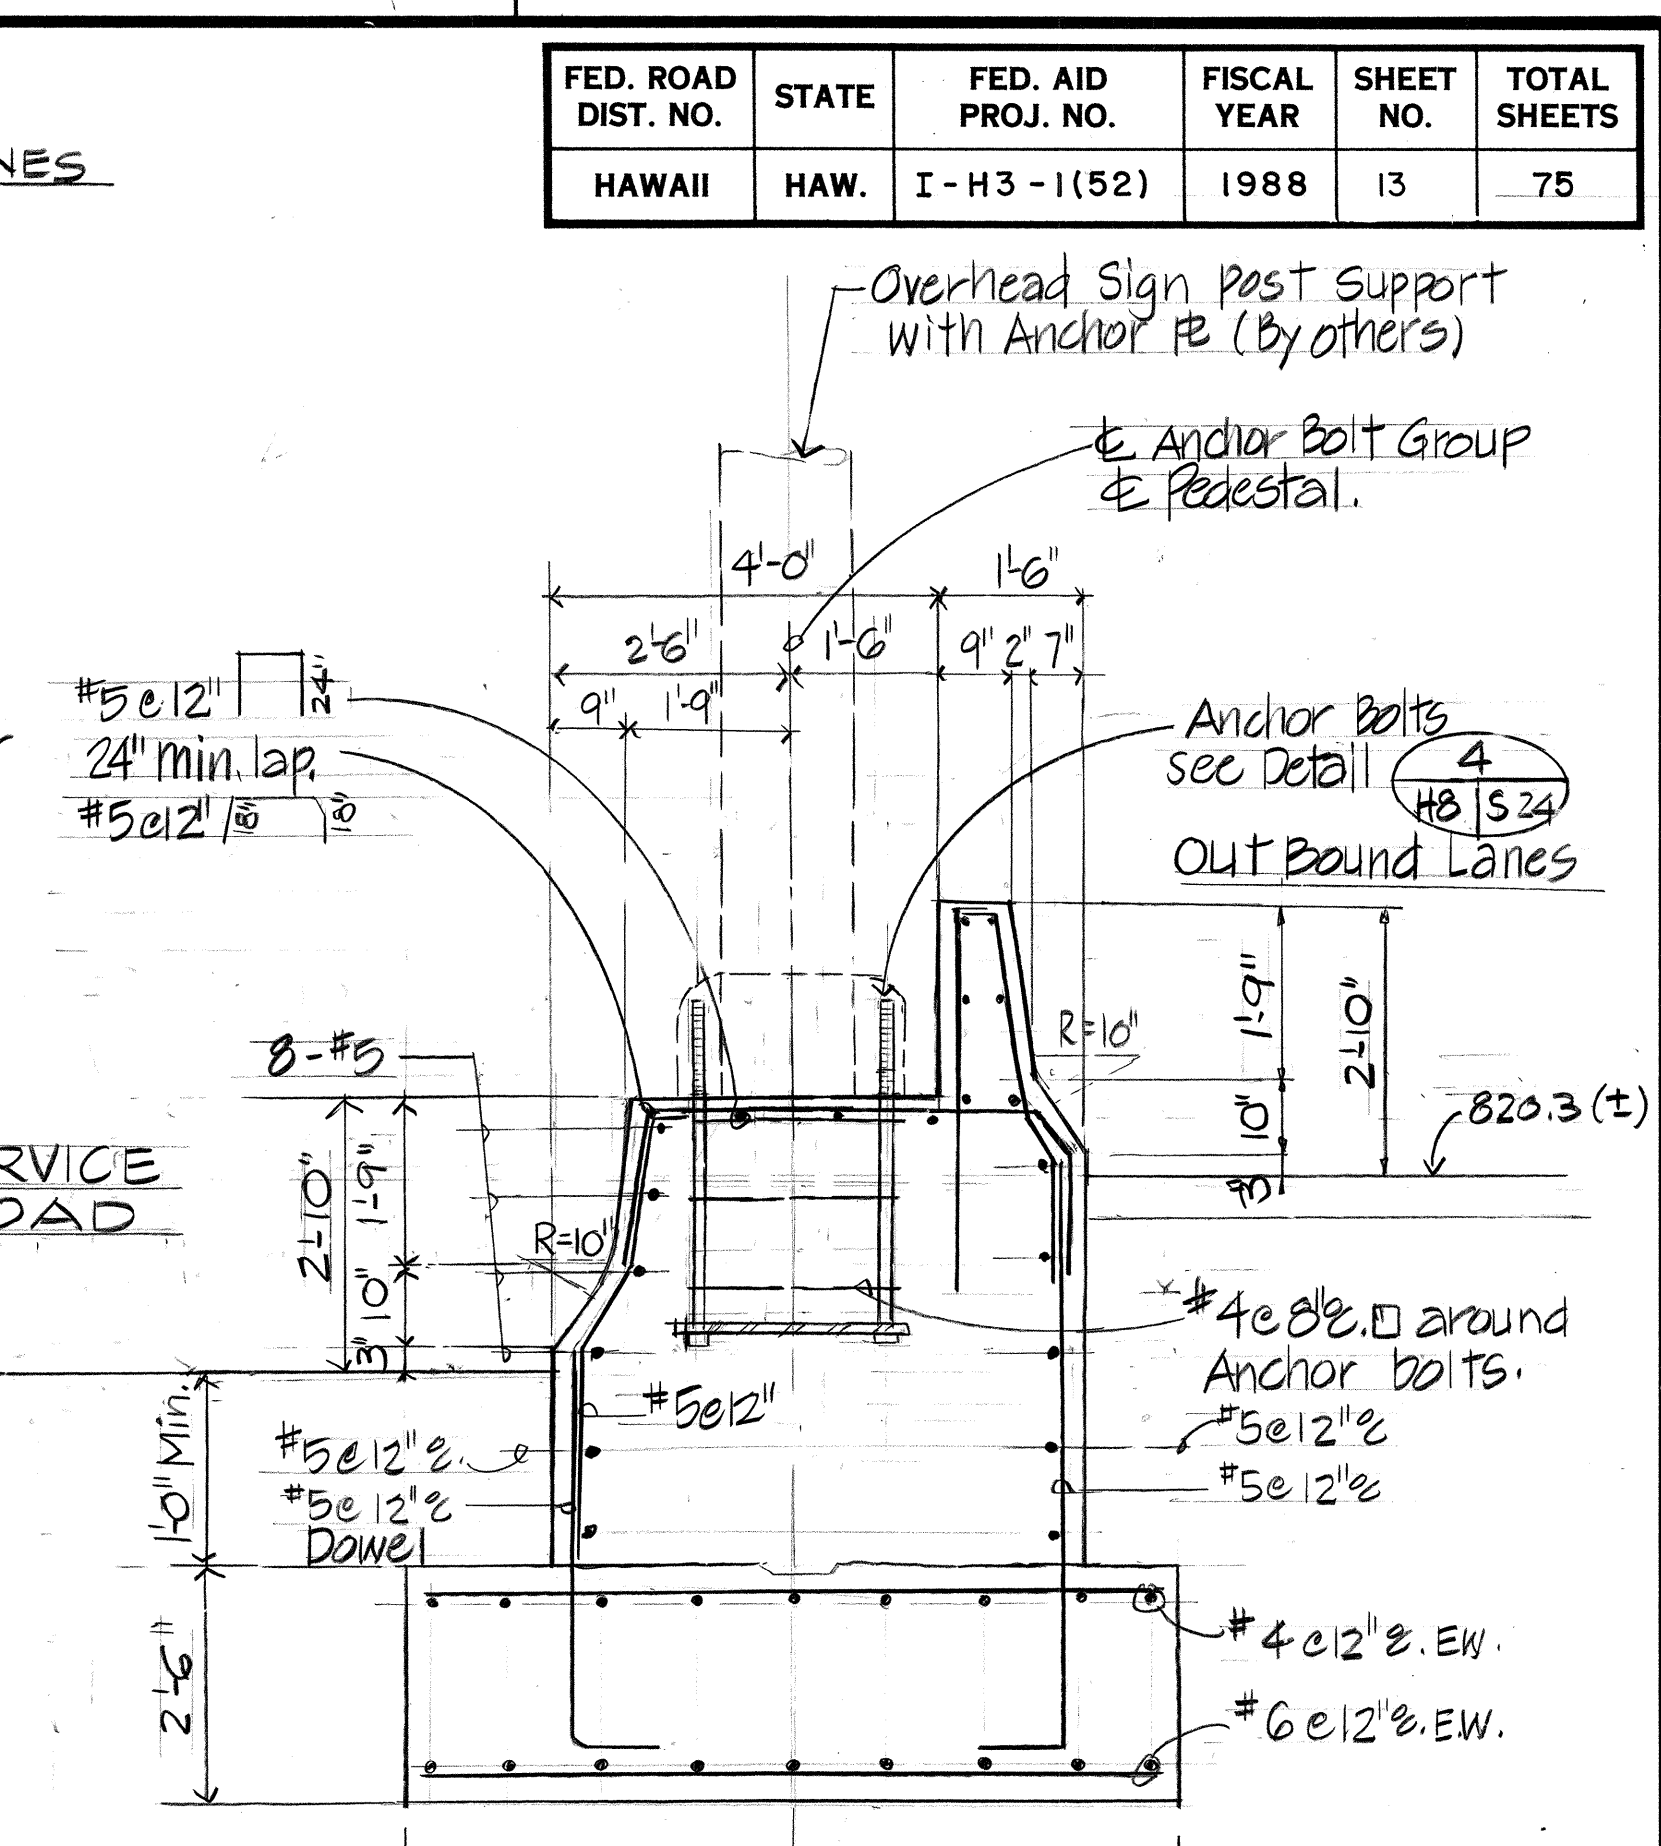
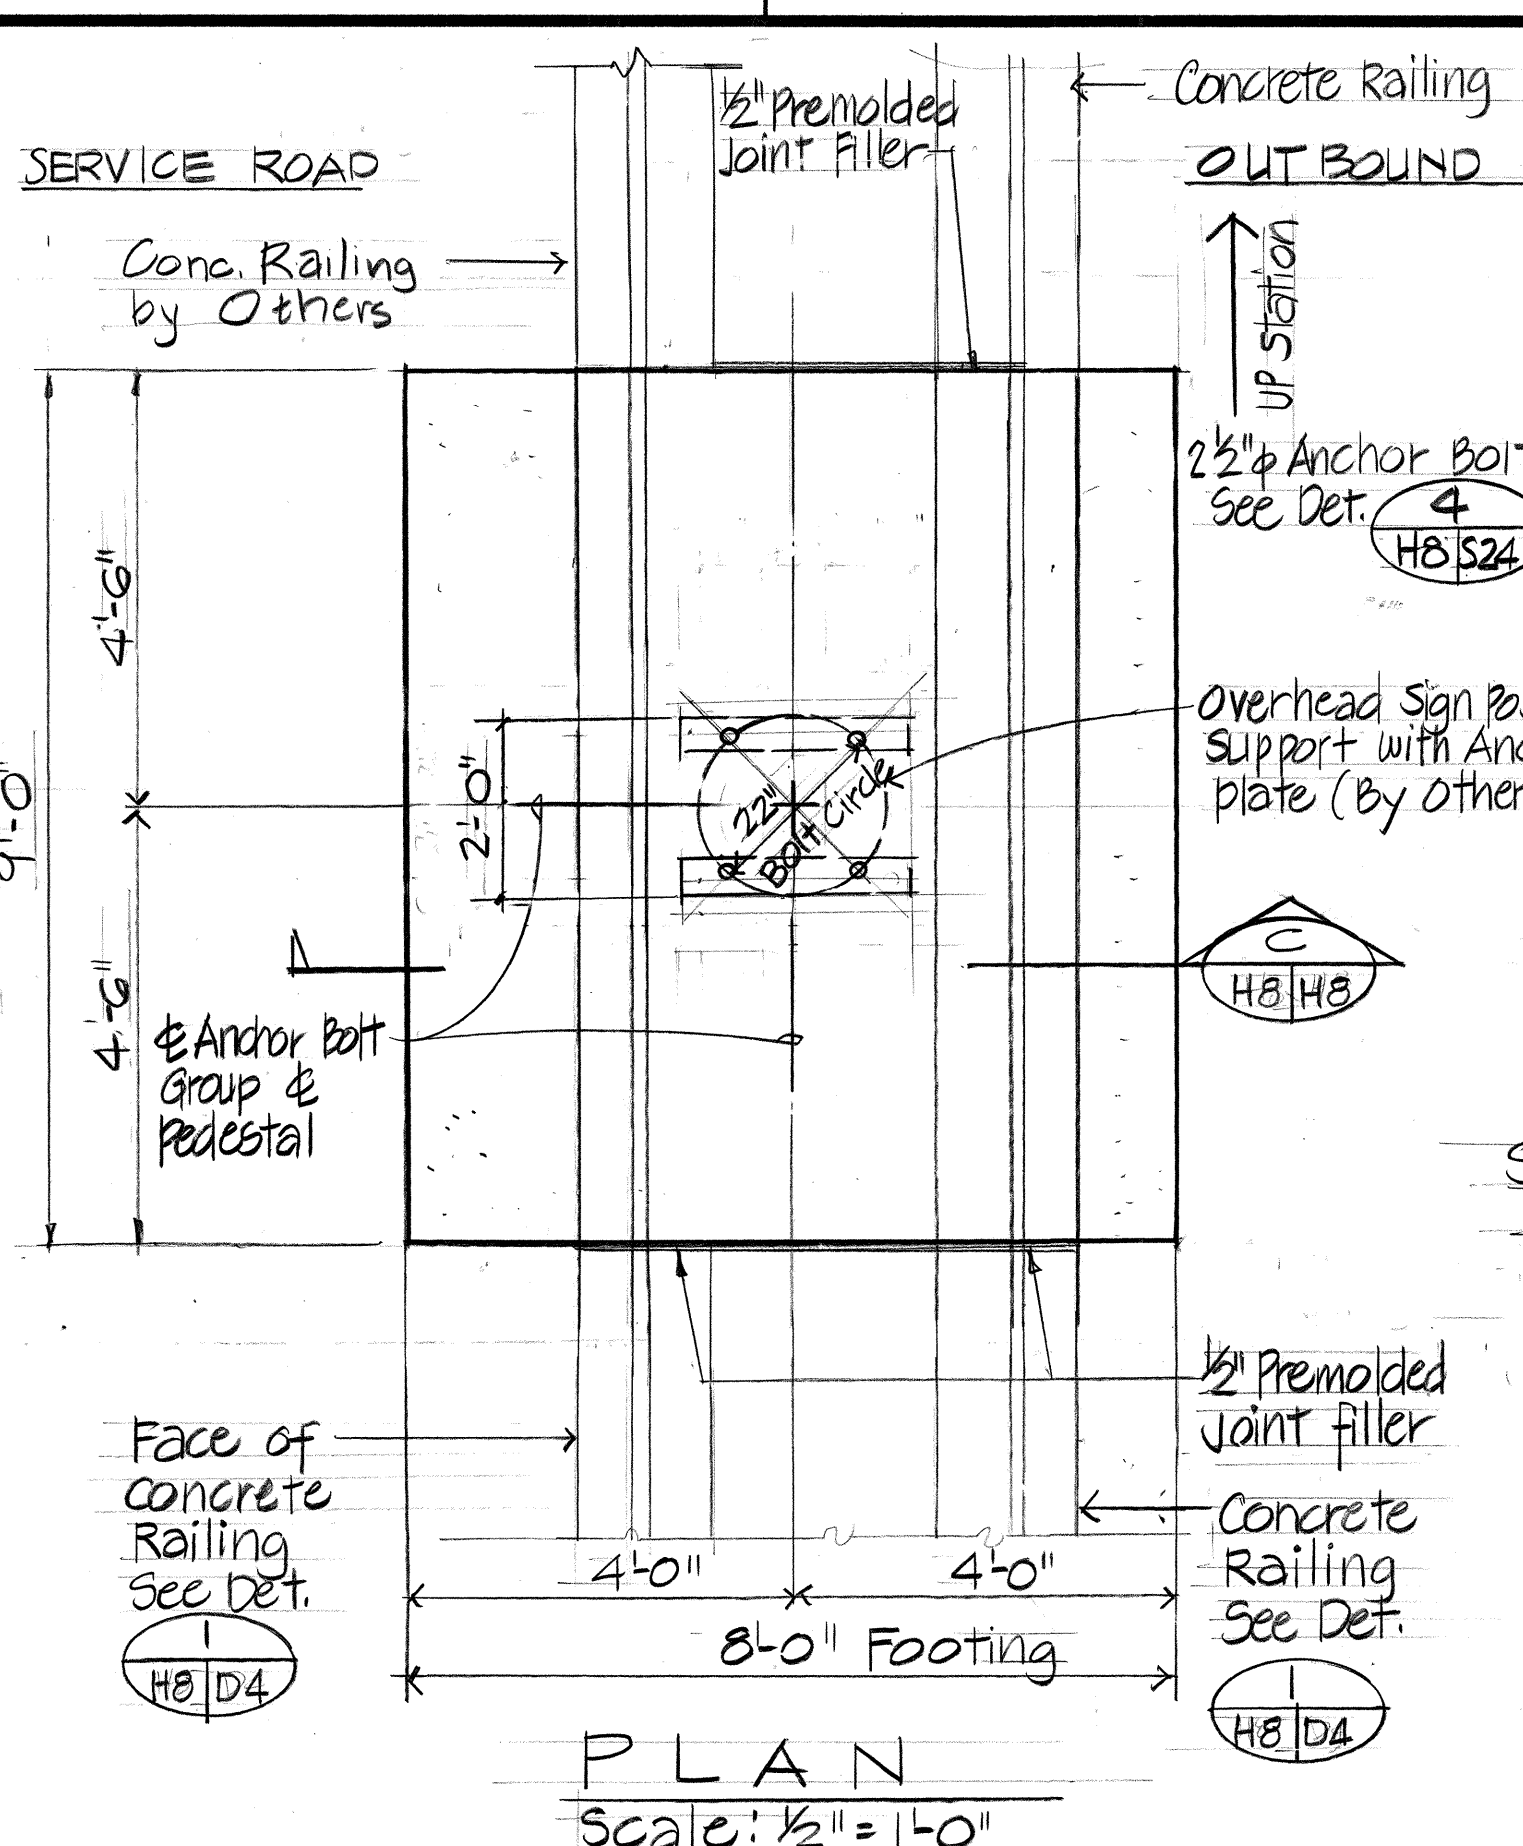
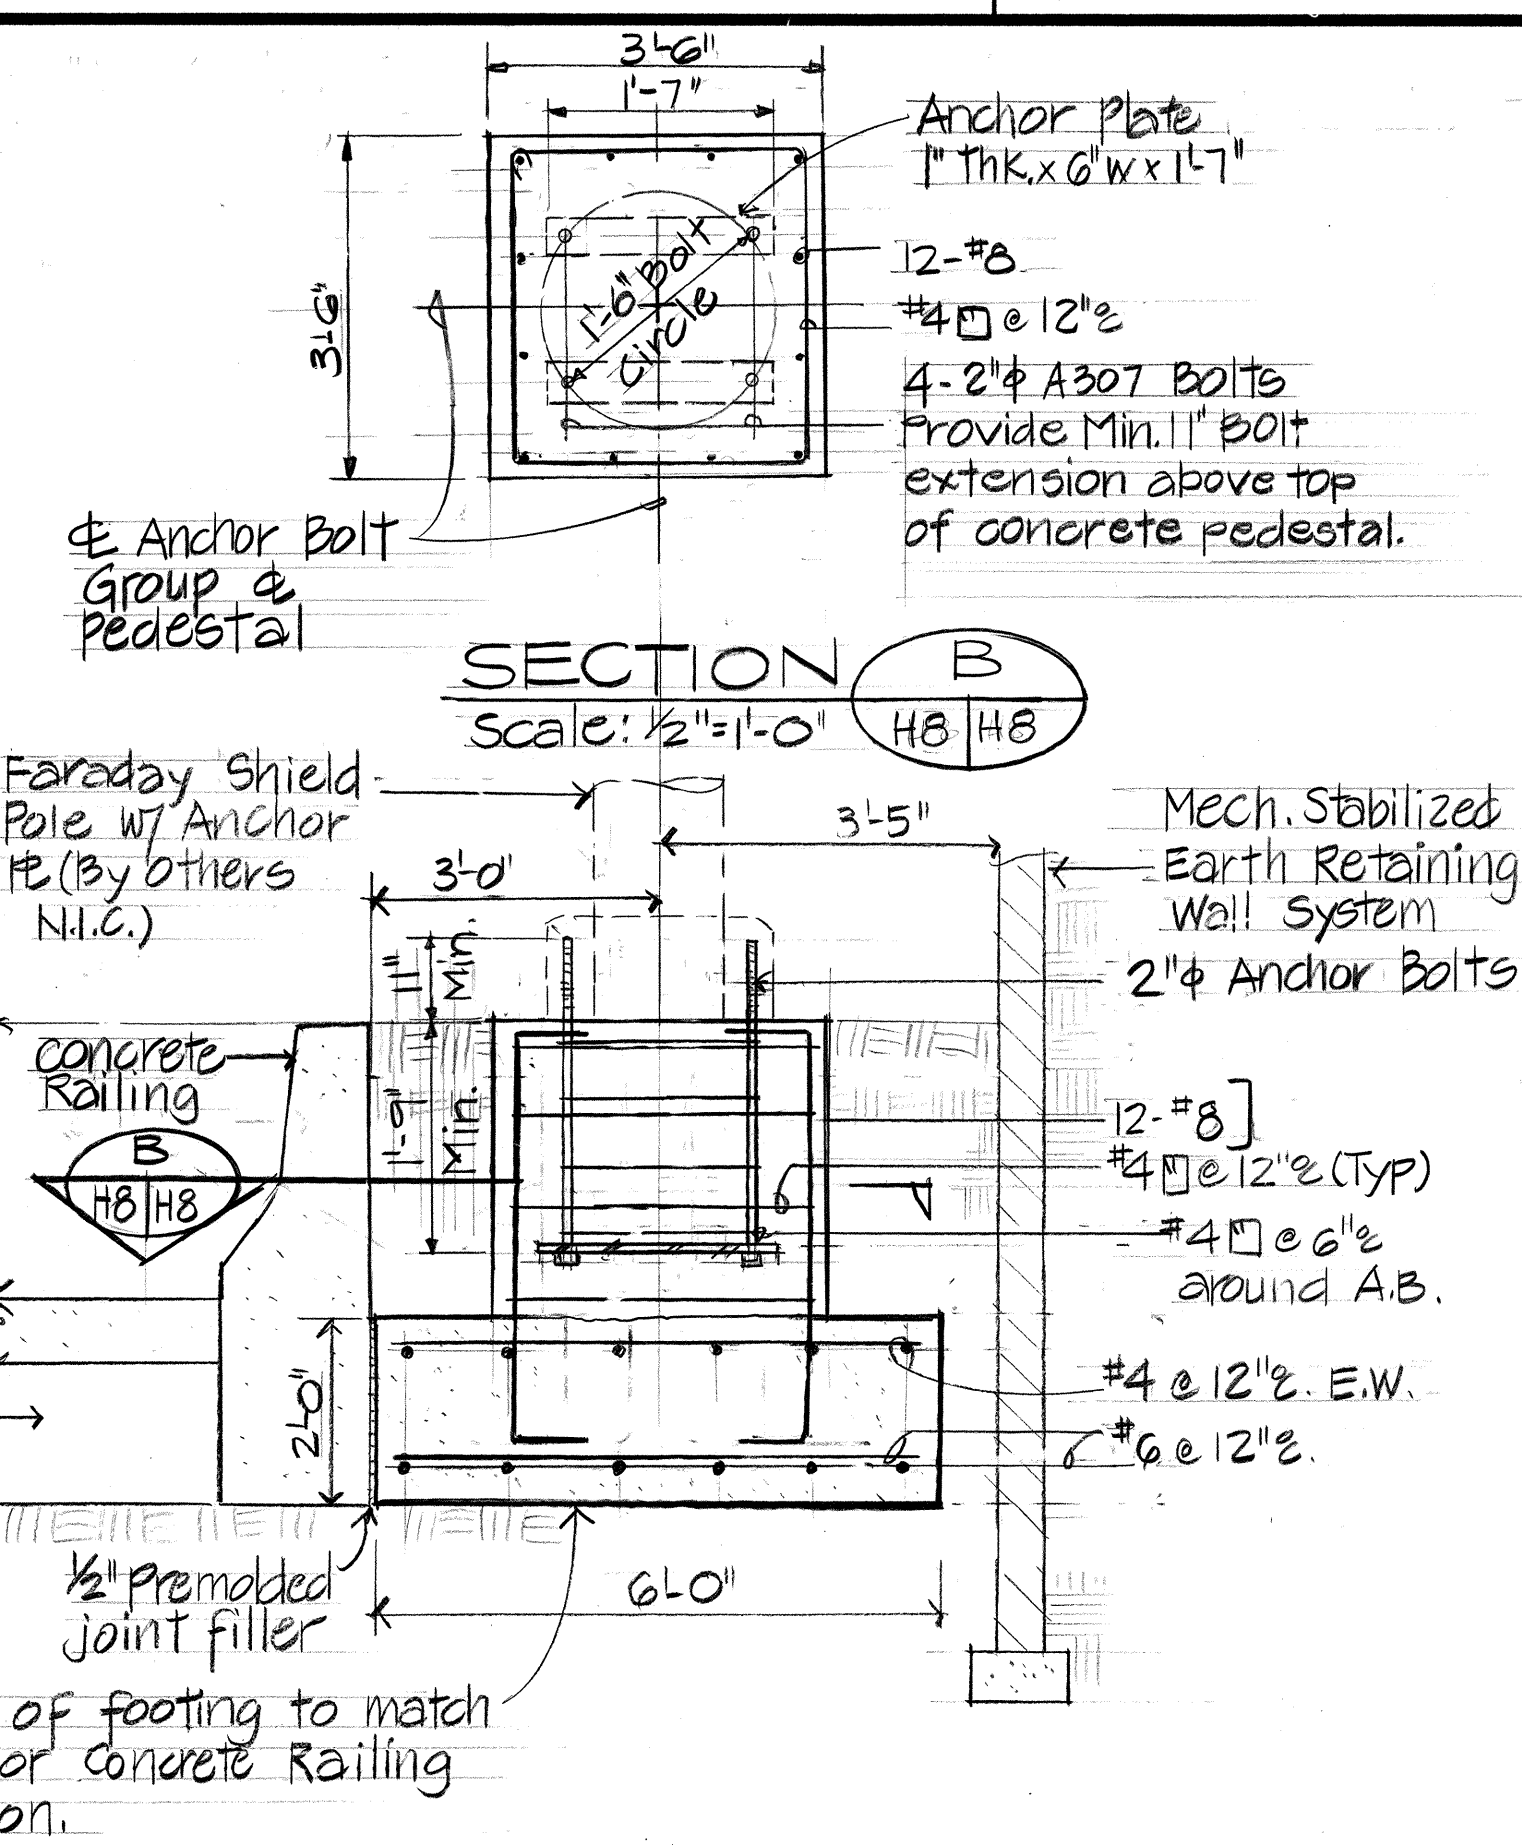


FED. ROAD DIST. NO.	STATE	FED. AID PROJ. NO.	FISCAL YEAR	SHEET NO.	TOTAL SHEETS
HAWAII	HAW.	I-H3-1(52)	1988	13	75

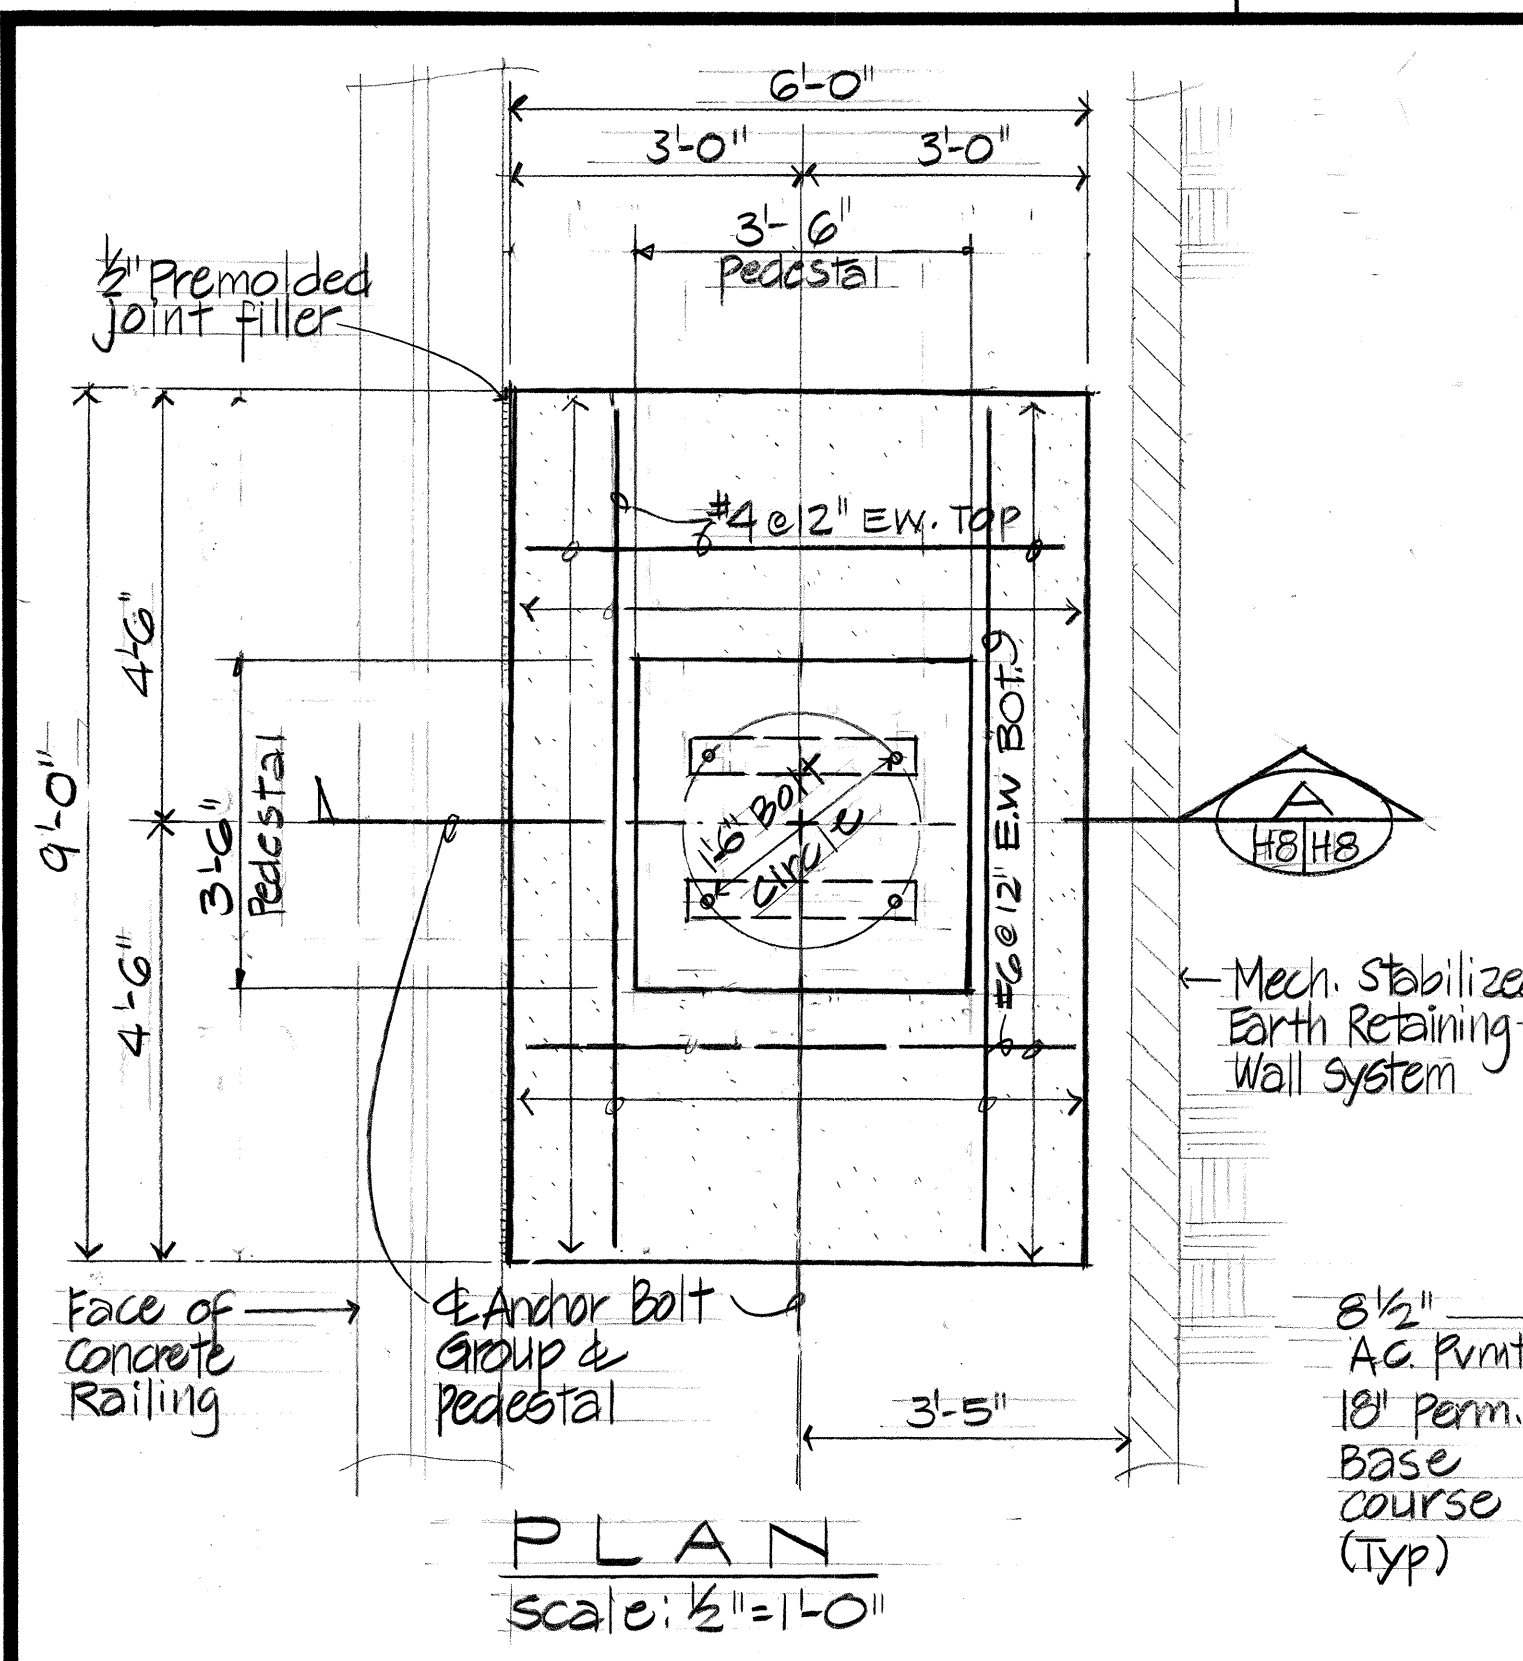

FOUNDATION FOR FARADAY SHIELD POLE
TYPICAL AT O.B. STA. 259+40
#260+40 S2,




SECTION A
Scale: 1/2" = 1'-0"

N.I.C. FOUNDATION FOR FARADAY POST
@ STA. 261+40 O.B. CENTER

SECTION C
Scale: 1/2" = 1'-0"

- Notes:**
1. Wrap all Anchor Bolts projecting from the concrete with Burlap then coat with asphalt as directed by the Engineer.
 2. For placement of Electric Power, Communication and Signal conduits see Electrical Drawings.
 3. Anchor Bolts, Plates and Asphalt Coating shall be incidental to the various foundations.


SURVEY PLOTTED BY	DATE
DRAWN BY	
DESIGNED BY	
QUANTITIES BY	
CHECKED BY	
ORIGINAL PLAN	
NOTE BOOK	
NO.	

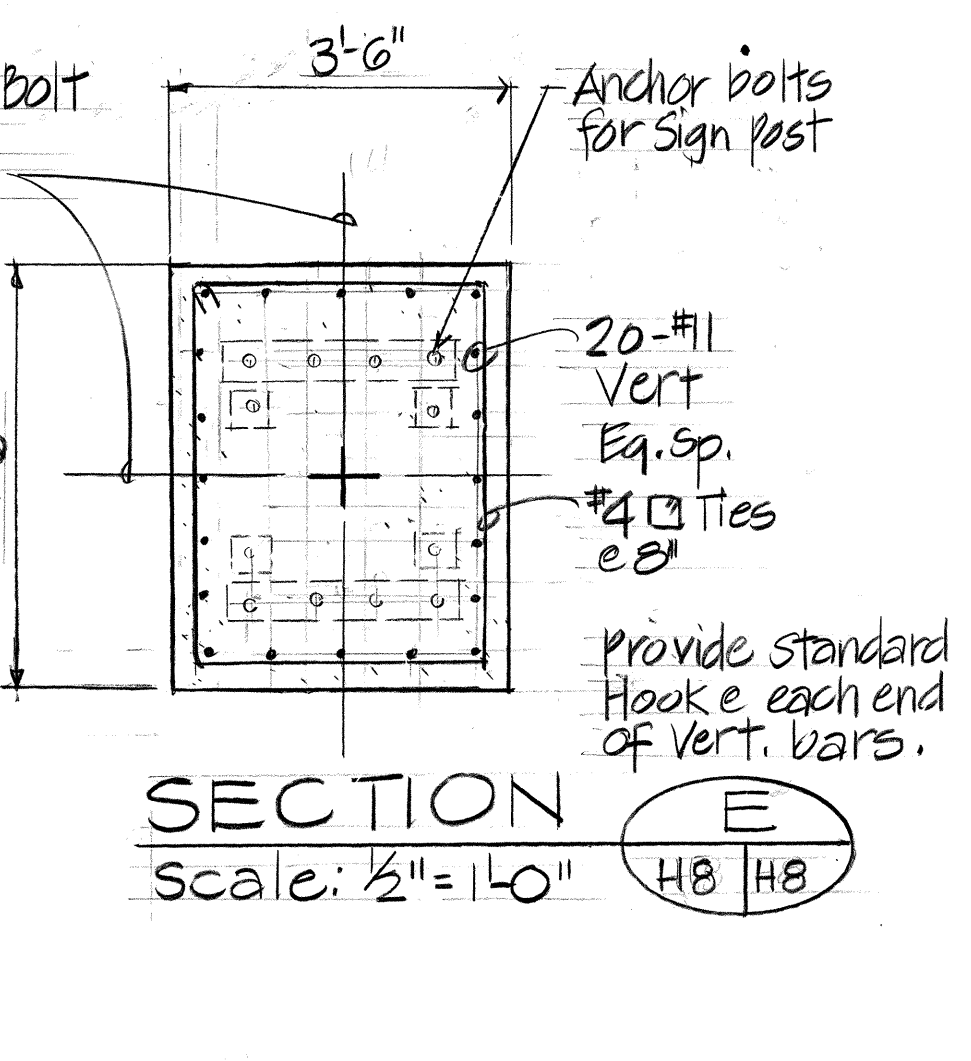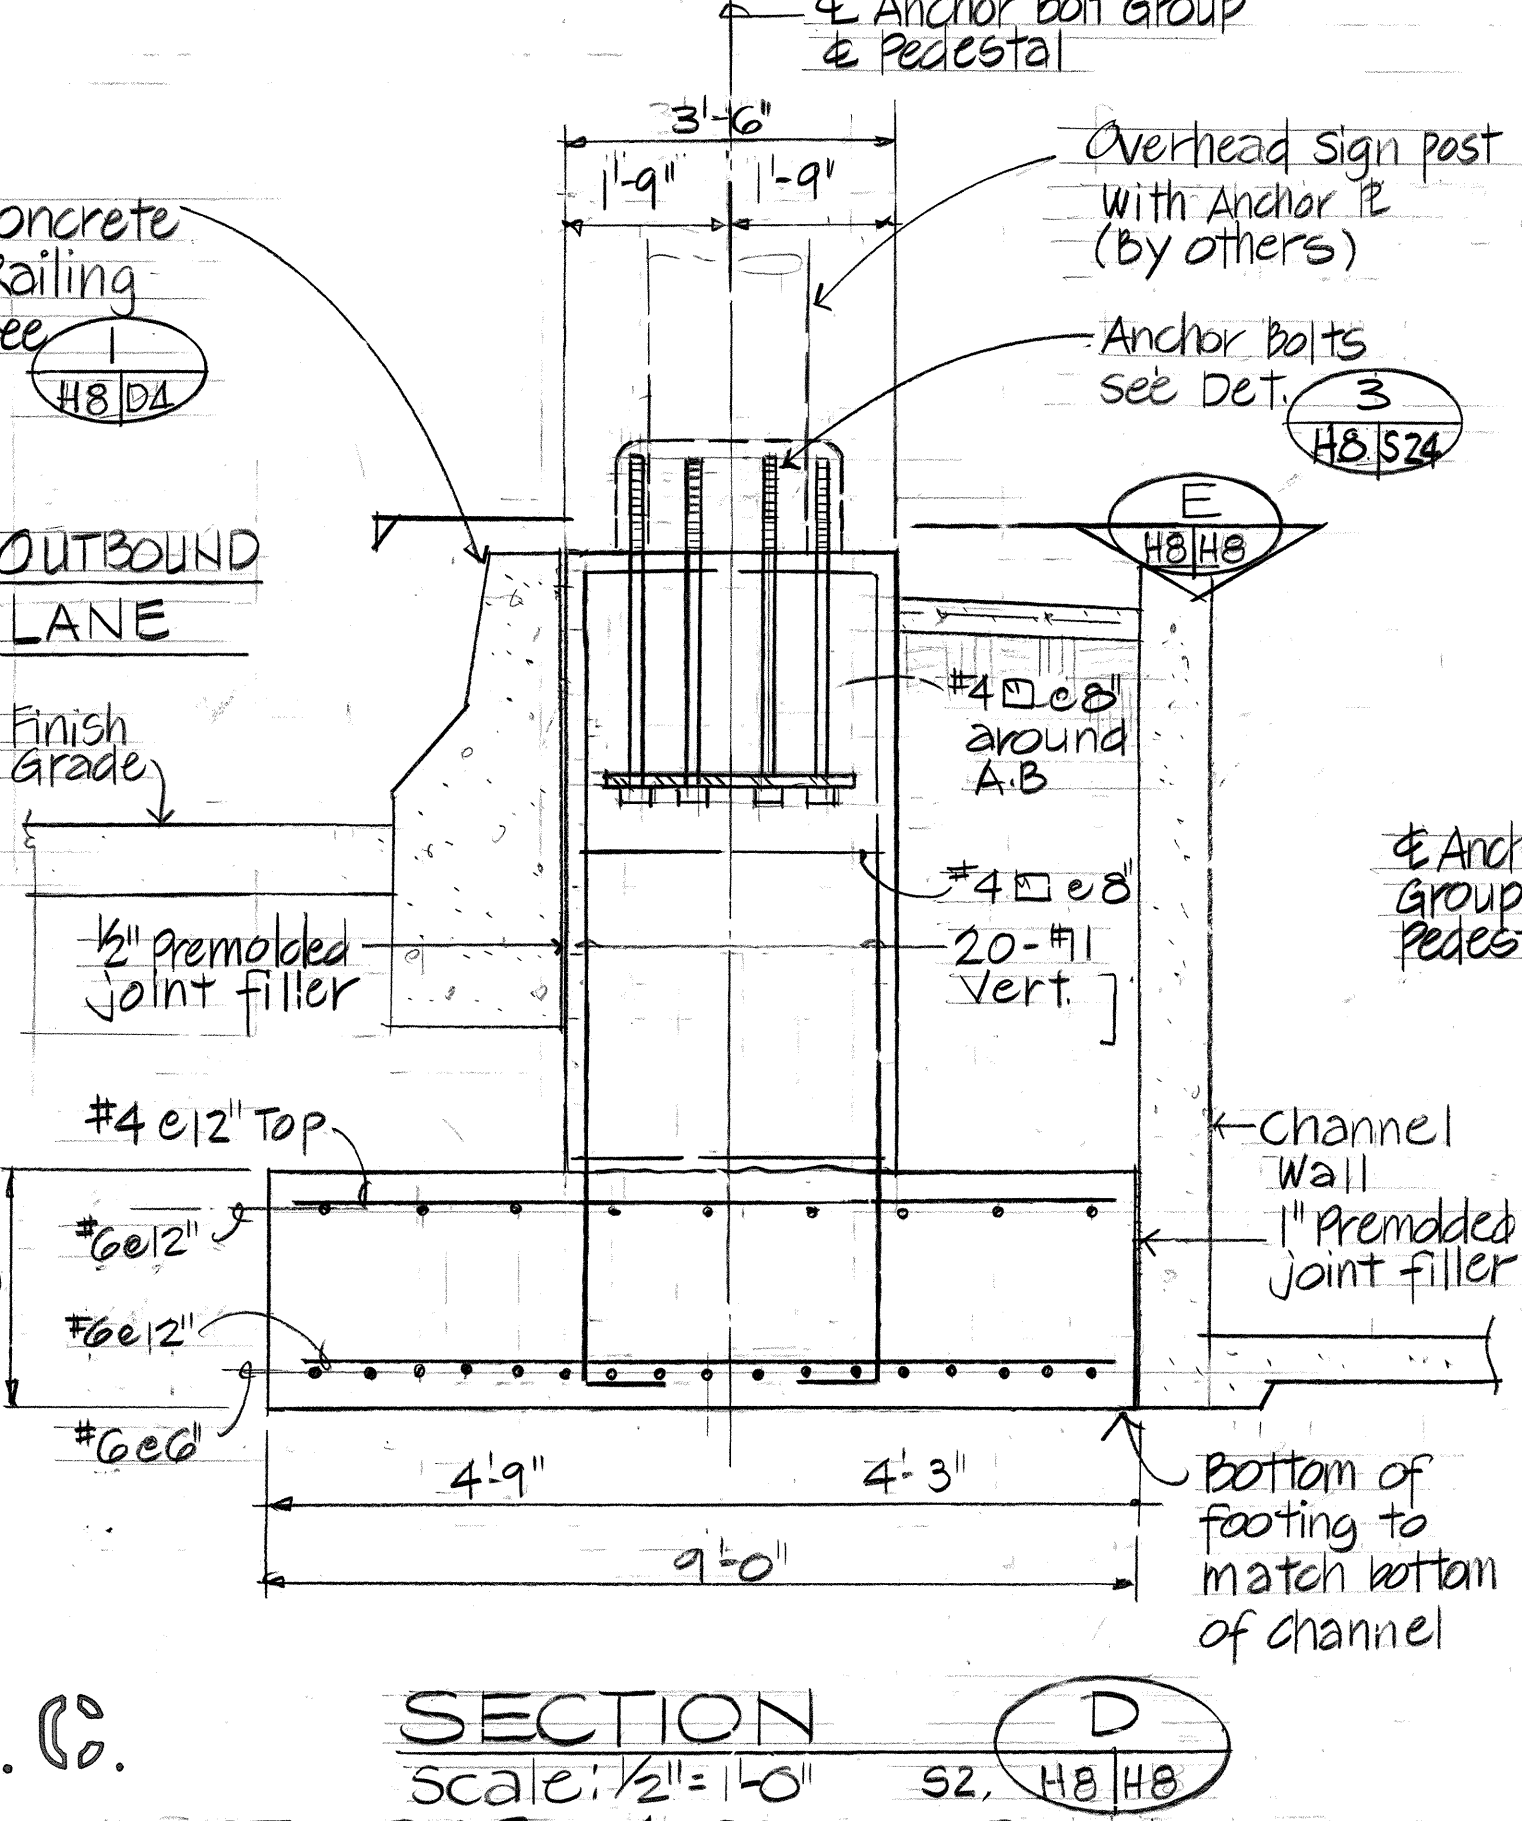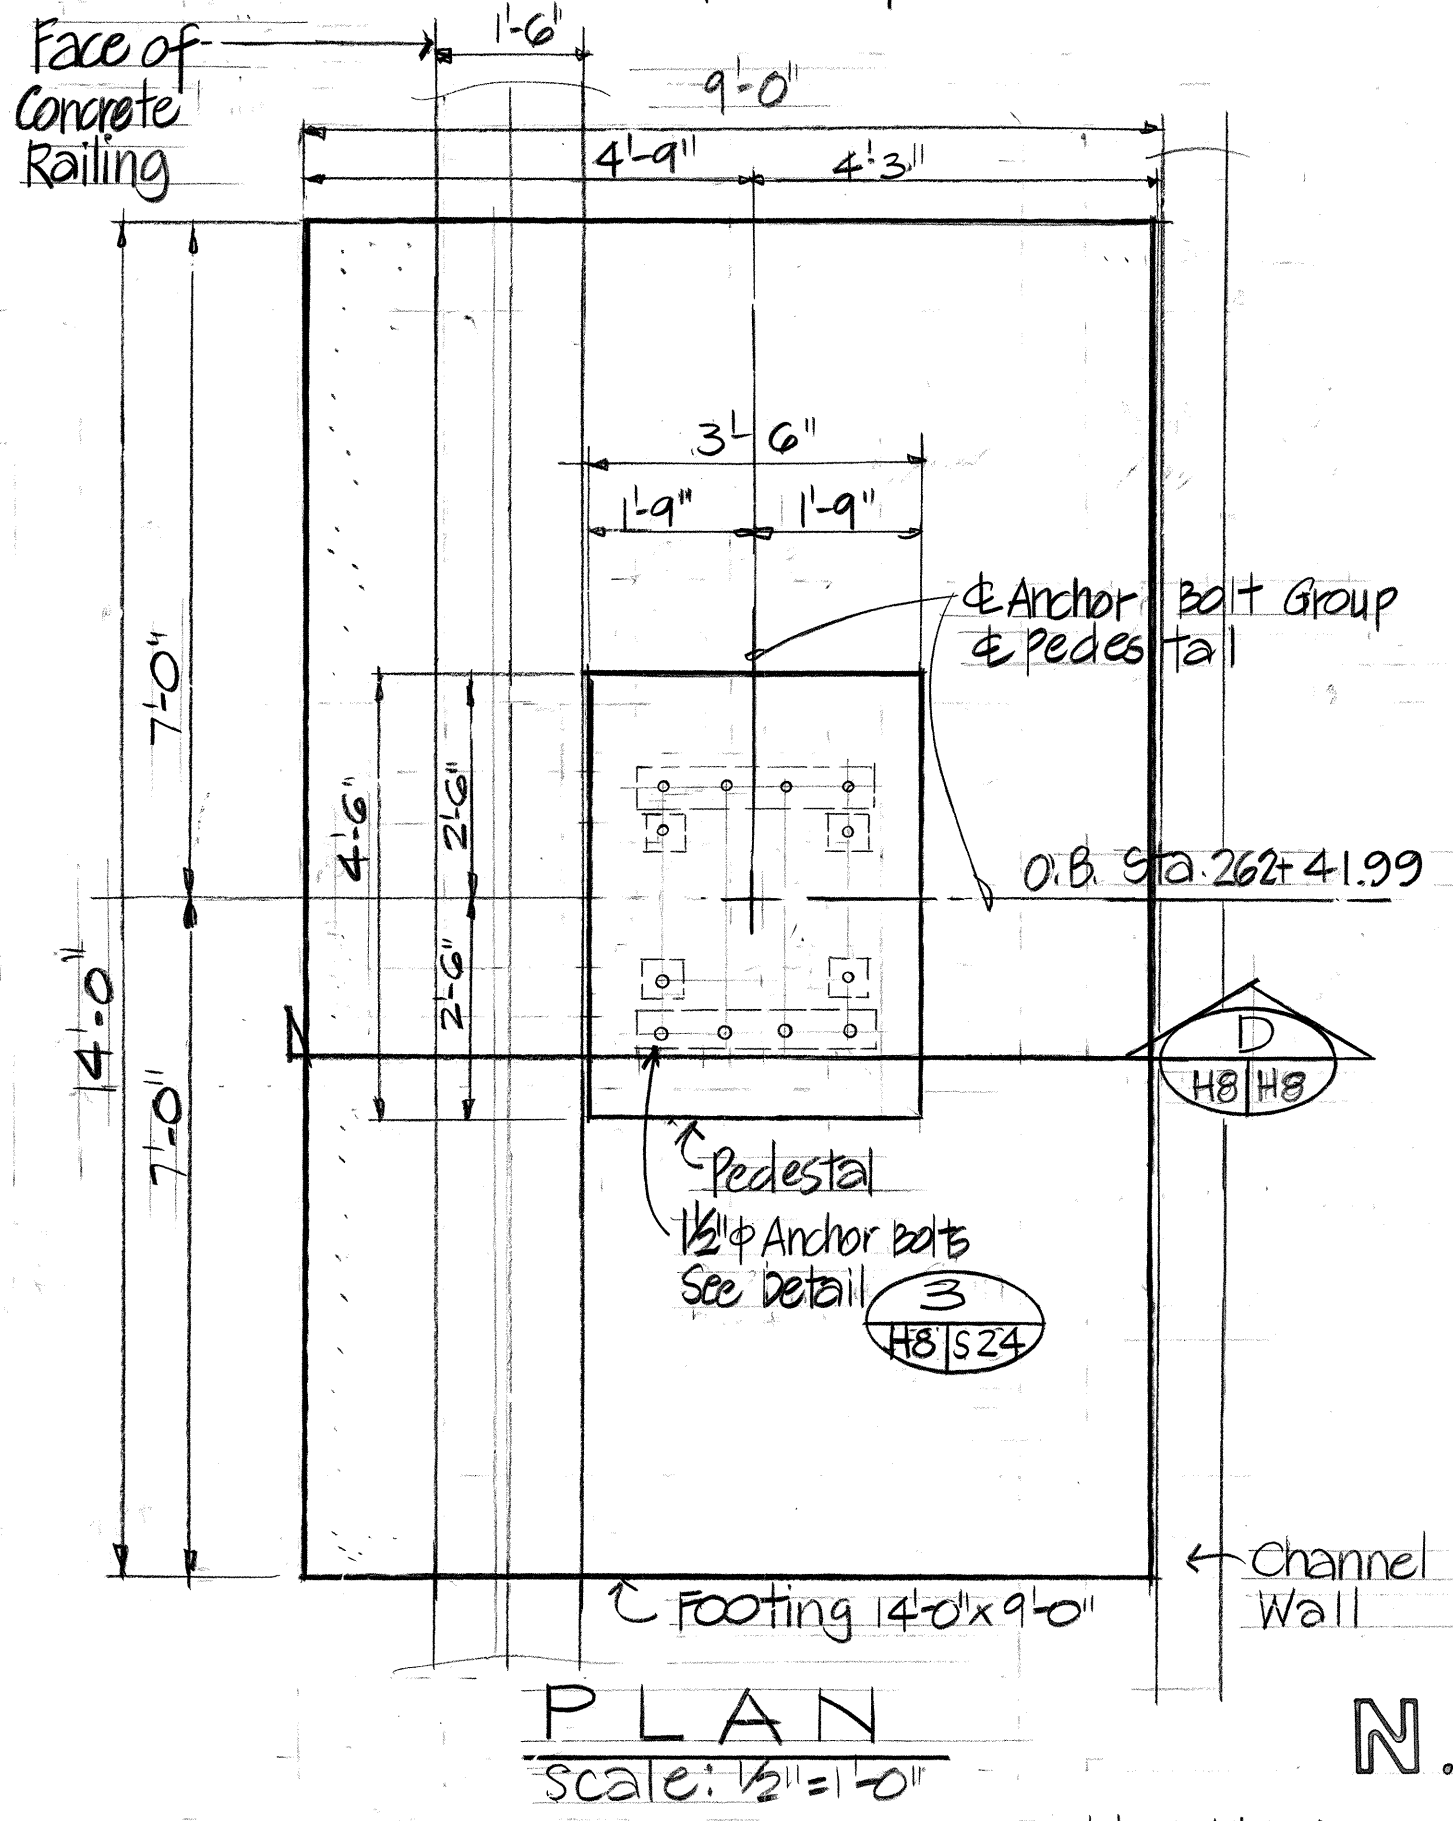

FOUNDATION FOR HIGHWAY SIGN - STA. 262+41.99 O.B. RIGHT

2/15/90	Revised Details 1 & A.
5/25/89	Revised Detail 3
	Revised B
	Clarify Locations in:
	1 2 3 4
	S2/H0 H4/H0 S2/H0 S2/H0
1/10/89	Delete Plates and Leveling Nuts
DATE	REVISION

STATE OF HAWAII DEPARTMENT OF TRANSPORTATION HIGHWAYS DIVISION
MISCELLANEOUS DETAILS
INTERSTATE ROUTE H-3 F.A.I. PROJECT NO. I-H3-1(52)
SCALE: AS NOTED DATE: JULY 1988
SHEET NO. H 8 OF 8 SHEETS

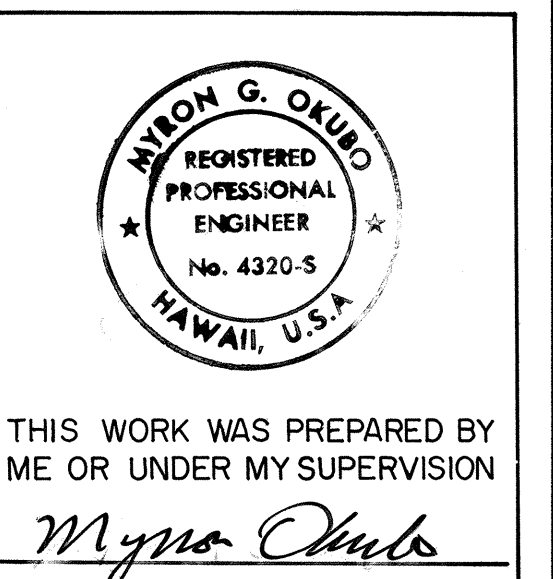

AS BUILT C.O. ADD. 13 R.