



FED. ROAD DIST. NO.	STATE	FED. AID PROJ. NO.	FISCAL YEAR	SHEET NO.	TOTAL SHEETS
HAWAII	HAW.	I-H3-1(52)	1988	12	75

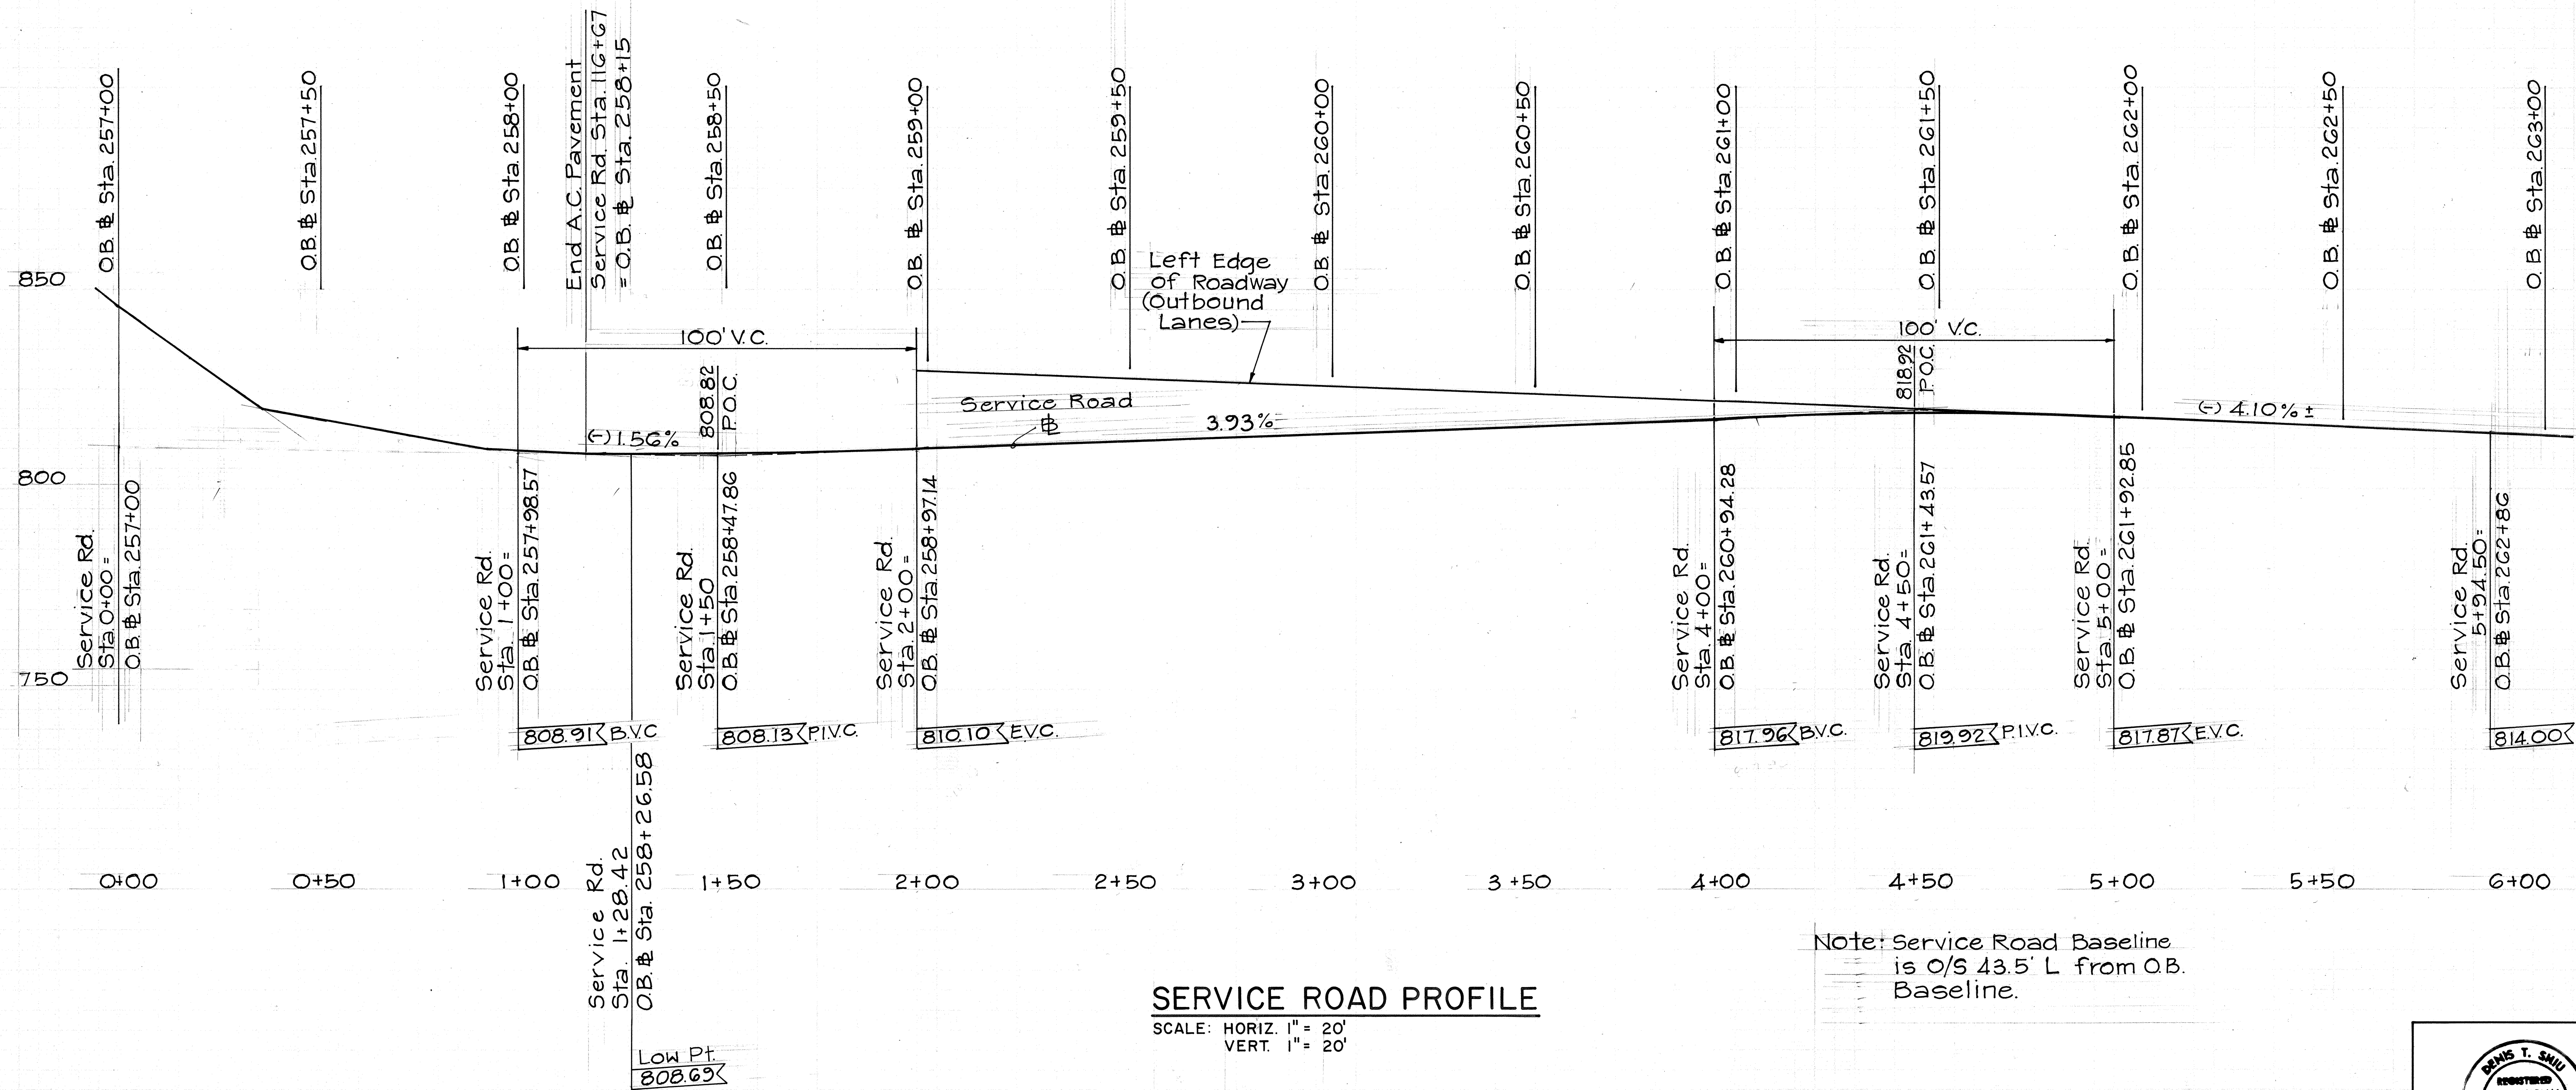

ORIGINAL PLAN	DATE
DESIGNED BY	
TRACED BY	
QUANTITIES BY	
CHECKED BY	

DATE	REVISION
9/27/89	Revised Service Road Profile
1/9/89	Revised Elevation at O.B. Sta. 261+43.57

AS BUILT

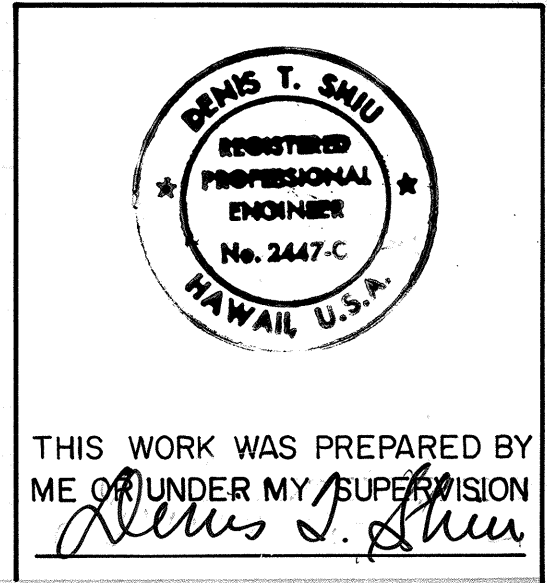

THIS WORK WAS PREPARED BY ME OR UNDER MY SUPERVISION

STATE OF HAWAII DEPARTMENT OF TRANSPORTATION HIGHWAYS DIVISION
SERVICE ROAD PROFILE
INTERSTATE ROUTE H-3 F.A.I. PROJECT NO. I-H3-1(52)
SCALE: AS NOTED DATE: JULY 1988
SHEET NO. H 7 OF 8 SHEETS

C.O. ADD. 12