



FED. ROAD DIST. NO.	STATE	FED. AID PROJ. NO.	FISCAL YEAR	SHEET NO.	TOTAL SHEETS
HAWAII	HAW.	I-H3-1(54)	1989	17	137

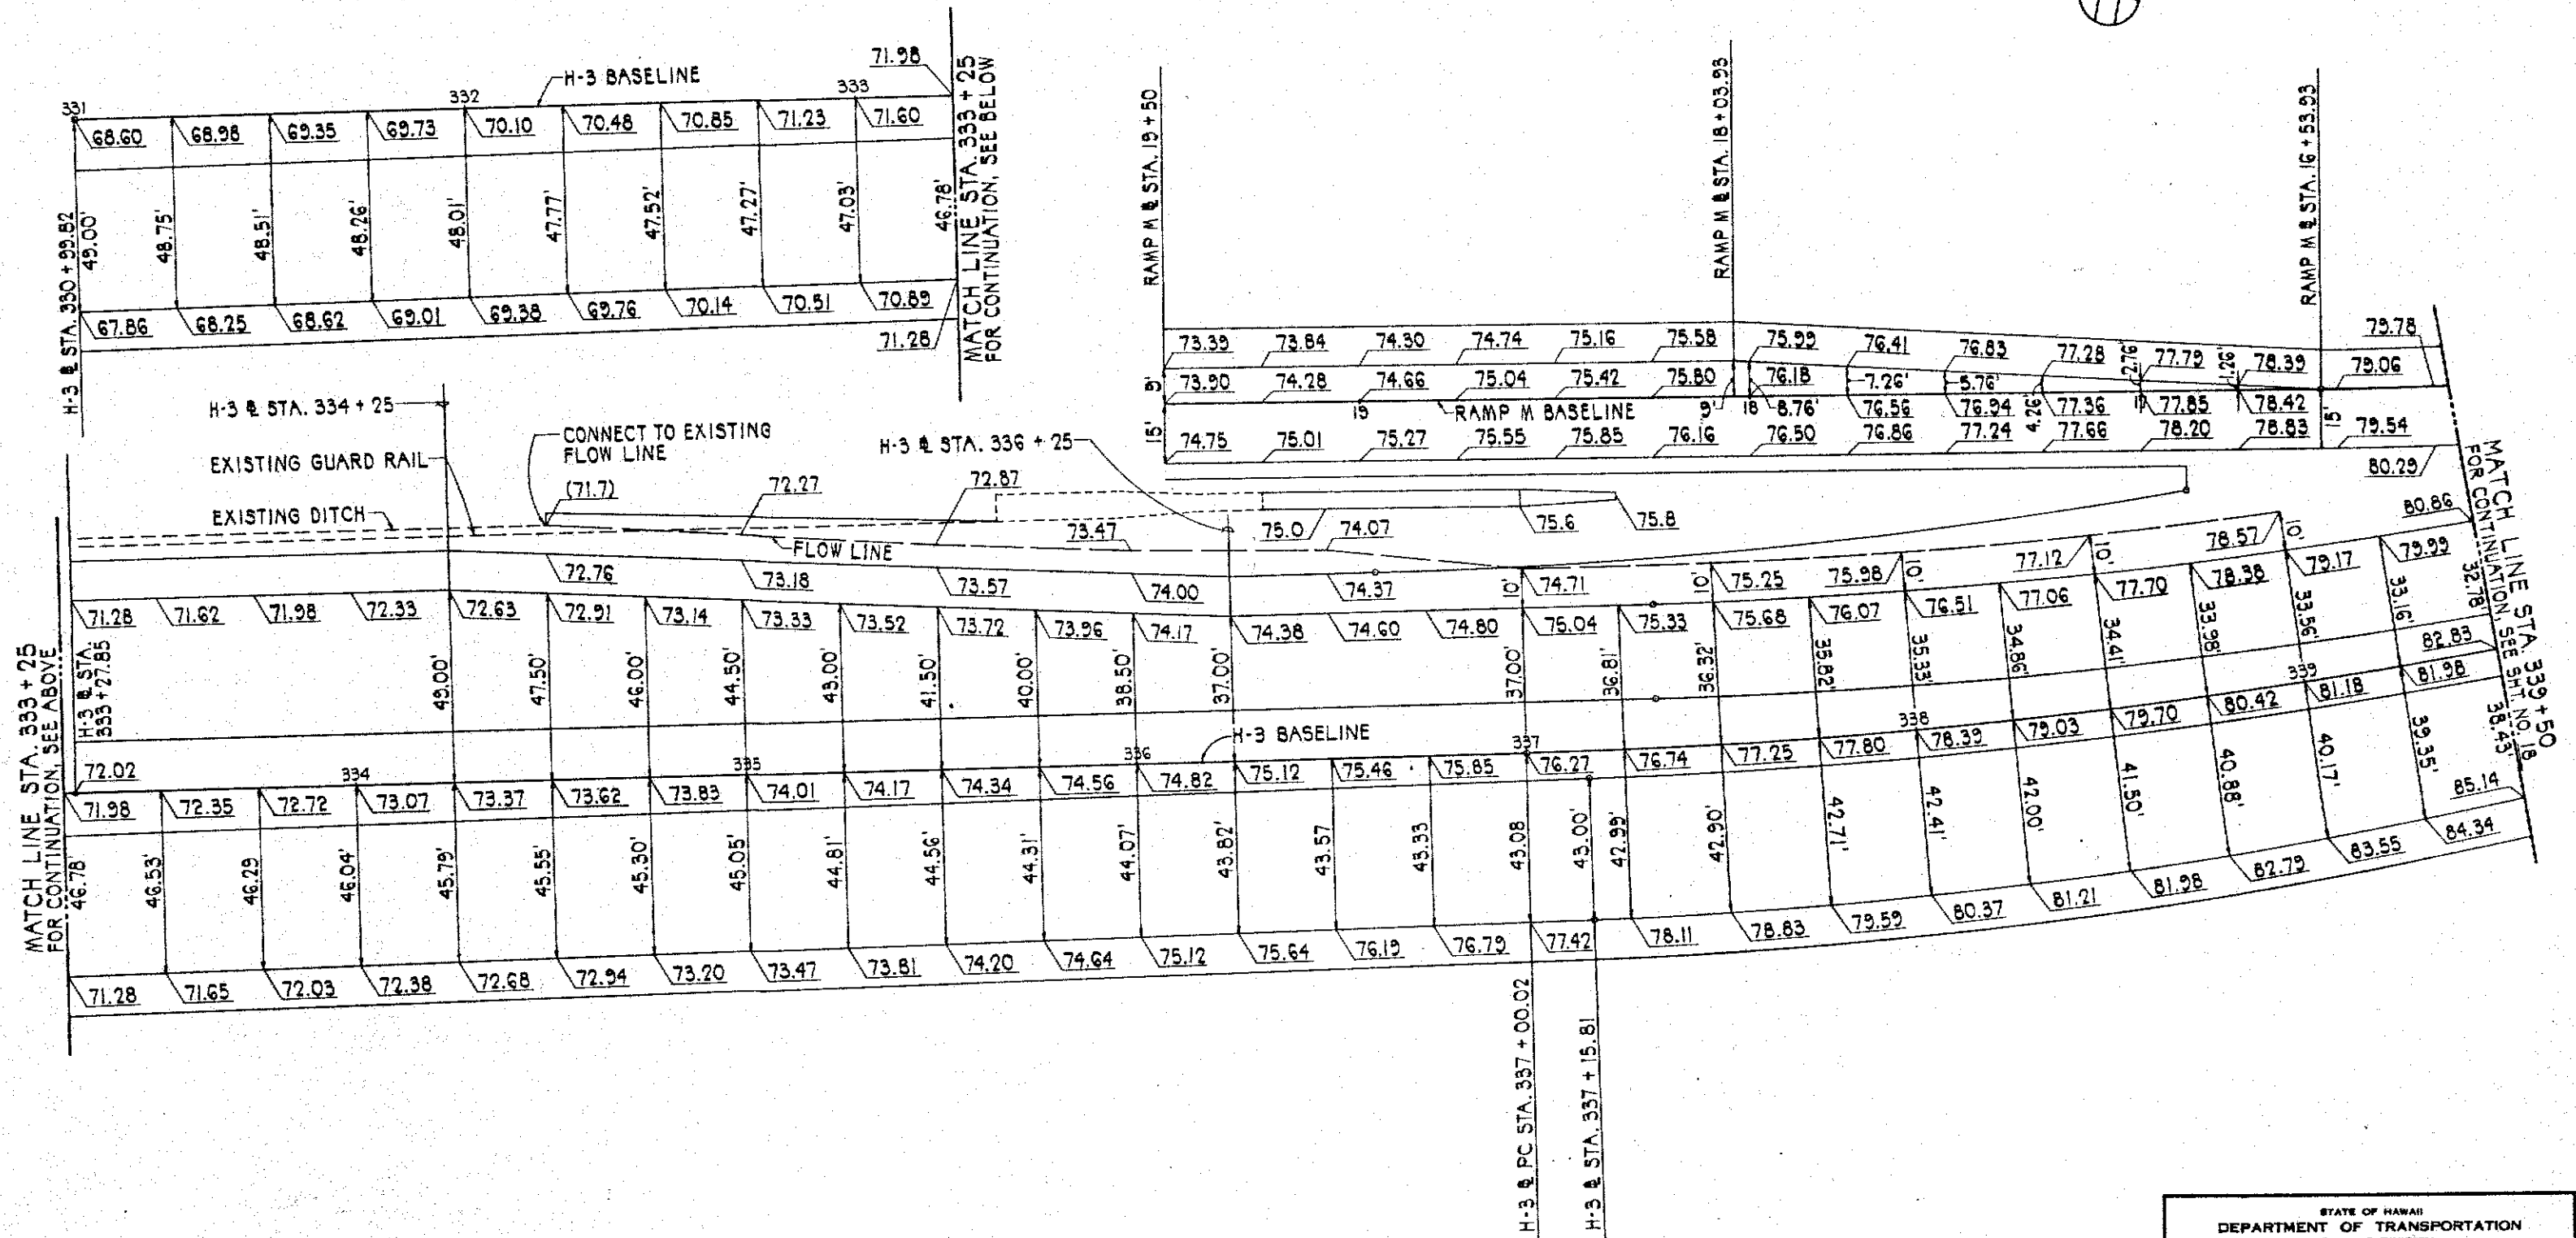

ORIGINAL PLAN	DATE
DRAWN BY	
TRACED BY	
DESIGNED BY	
CHECKED BY	
APPROVED BY	

REDUCED PLAN
HALF SIZE
3 INCHES ON ORIGINAL PLAN

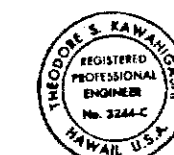

THIS WORK WAS PREPARED BY ME
OR UNDER MY SUPERVISION
Theodore S. Kawaguchi


STATE OF HAWAII
DEPARTMENT OF TRANSPORTATION
HIGHWAYS DIVISION

RAMP TERMINAL DETAILS

INTERSTATE ROUTE H-3
F.A.I. PROJECT NO. I-H3-1(54)

SCALE: 1" = 20' DATE: SEPT. 1988
SHEET NO. 1 OF 3 SHEETS

FED. ROAD DIST. NO.	STATE	FED. AID PROJ. NO.	FISCAL YEAR	SHEET NO.	TOTAL SHEETS
HAWAII	HAW.	I-H3-1(54)	1989	18	137

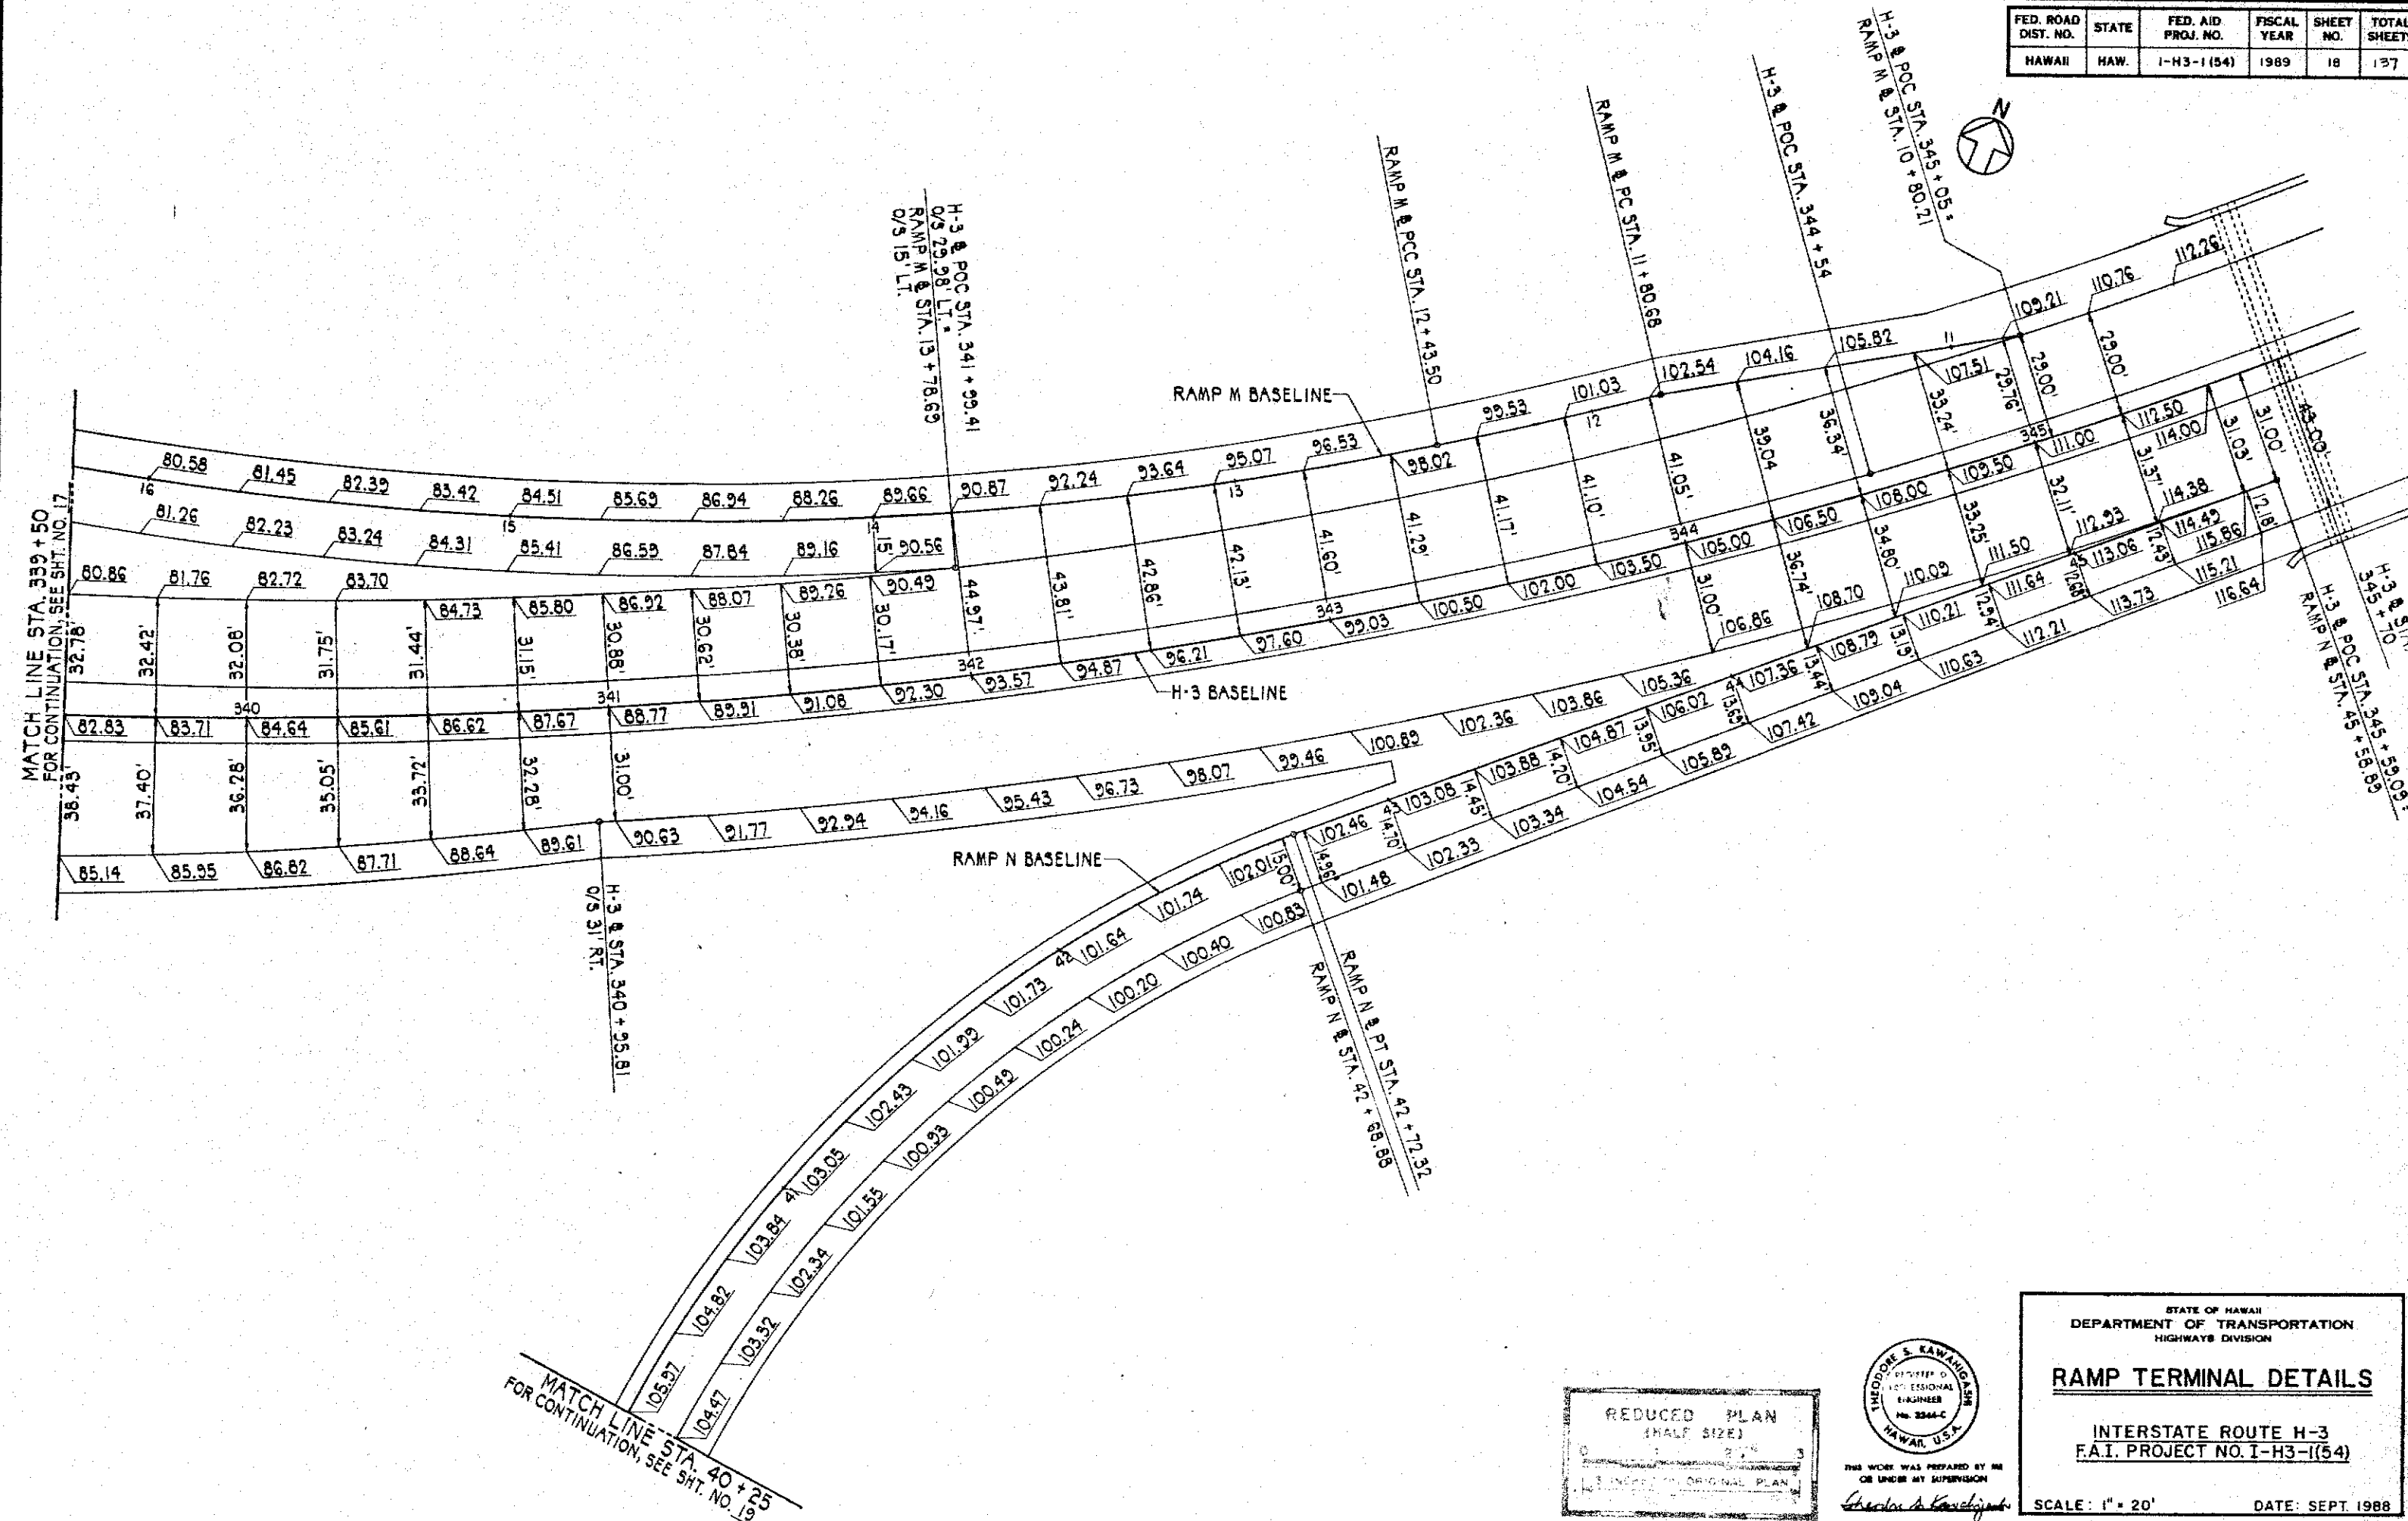

ORIGINAL PLAN	DATE
DRAWN BY	
CHECKED BY	
NOTED BY	
QUANTITIES BY	
CHECKED BY	

REDUCED PLAN
(HALF SIZE)
1" = 20'
IN REPLY TO ORIGINAL PLAN



THIS WORK WAS PREPARED BY ME
OR UNDER MY SUPERVISION
Theodore S. Kawaguchi

STATE OF HAWAII
DEPARTMENT OF TRANSPORTATION
HIGHWAYS DIVISION

RAMP TERMINAL DETAILS

INTERSTATE ROUTE H-3
F.A.I. PROJECT NO. I-H3-1(54)

SCALE: 1" = 20' DATE: SEPT. 1988
SHEET NO. 2 OF 3 SHEETS

