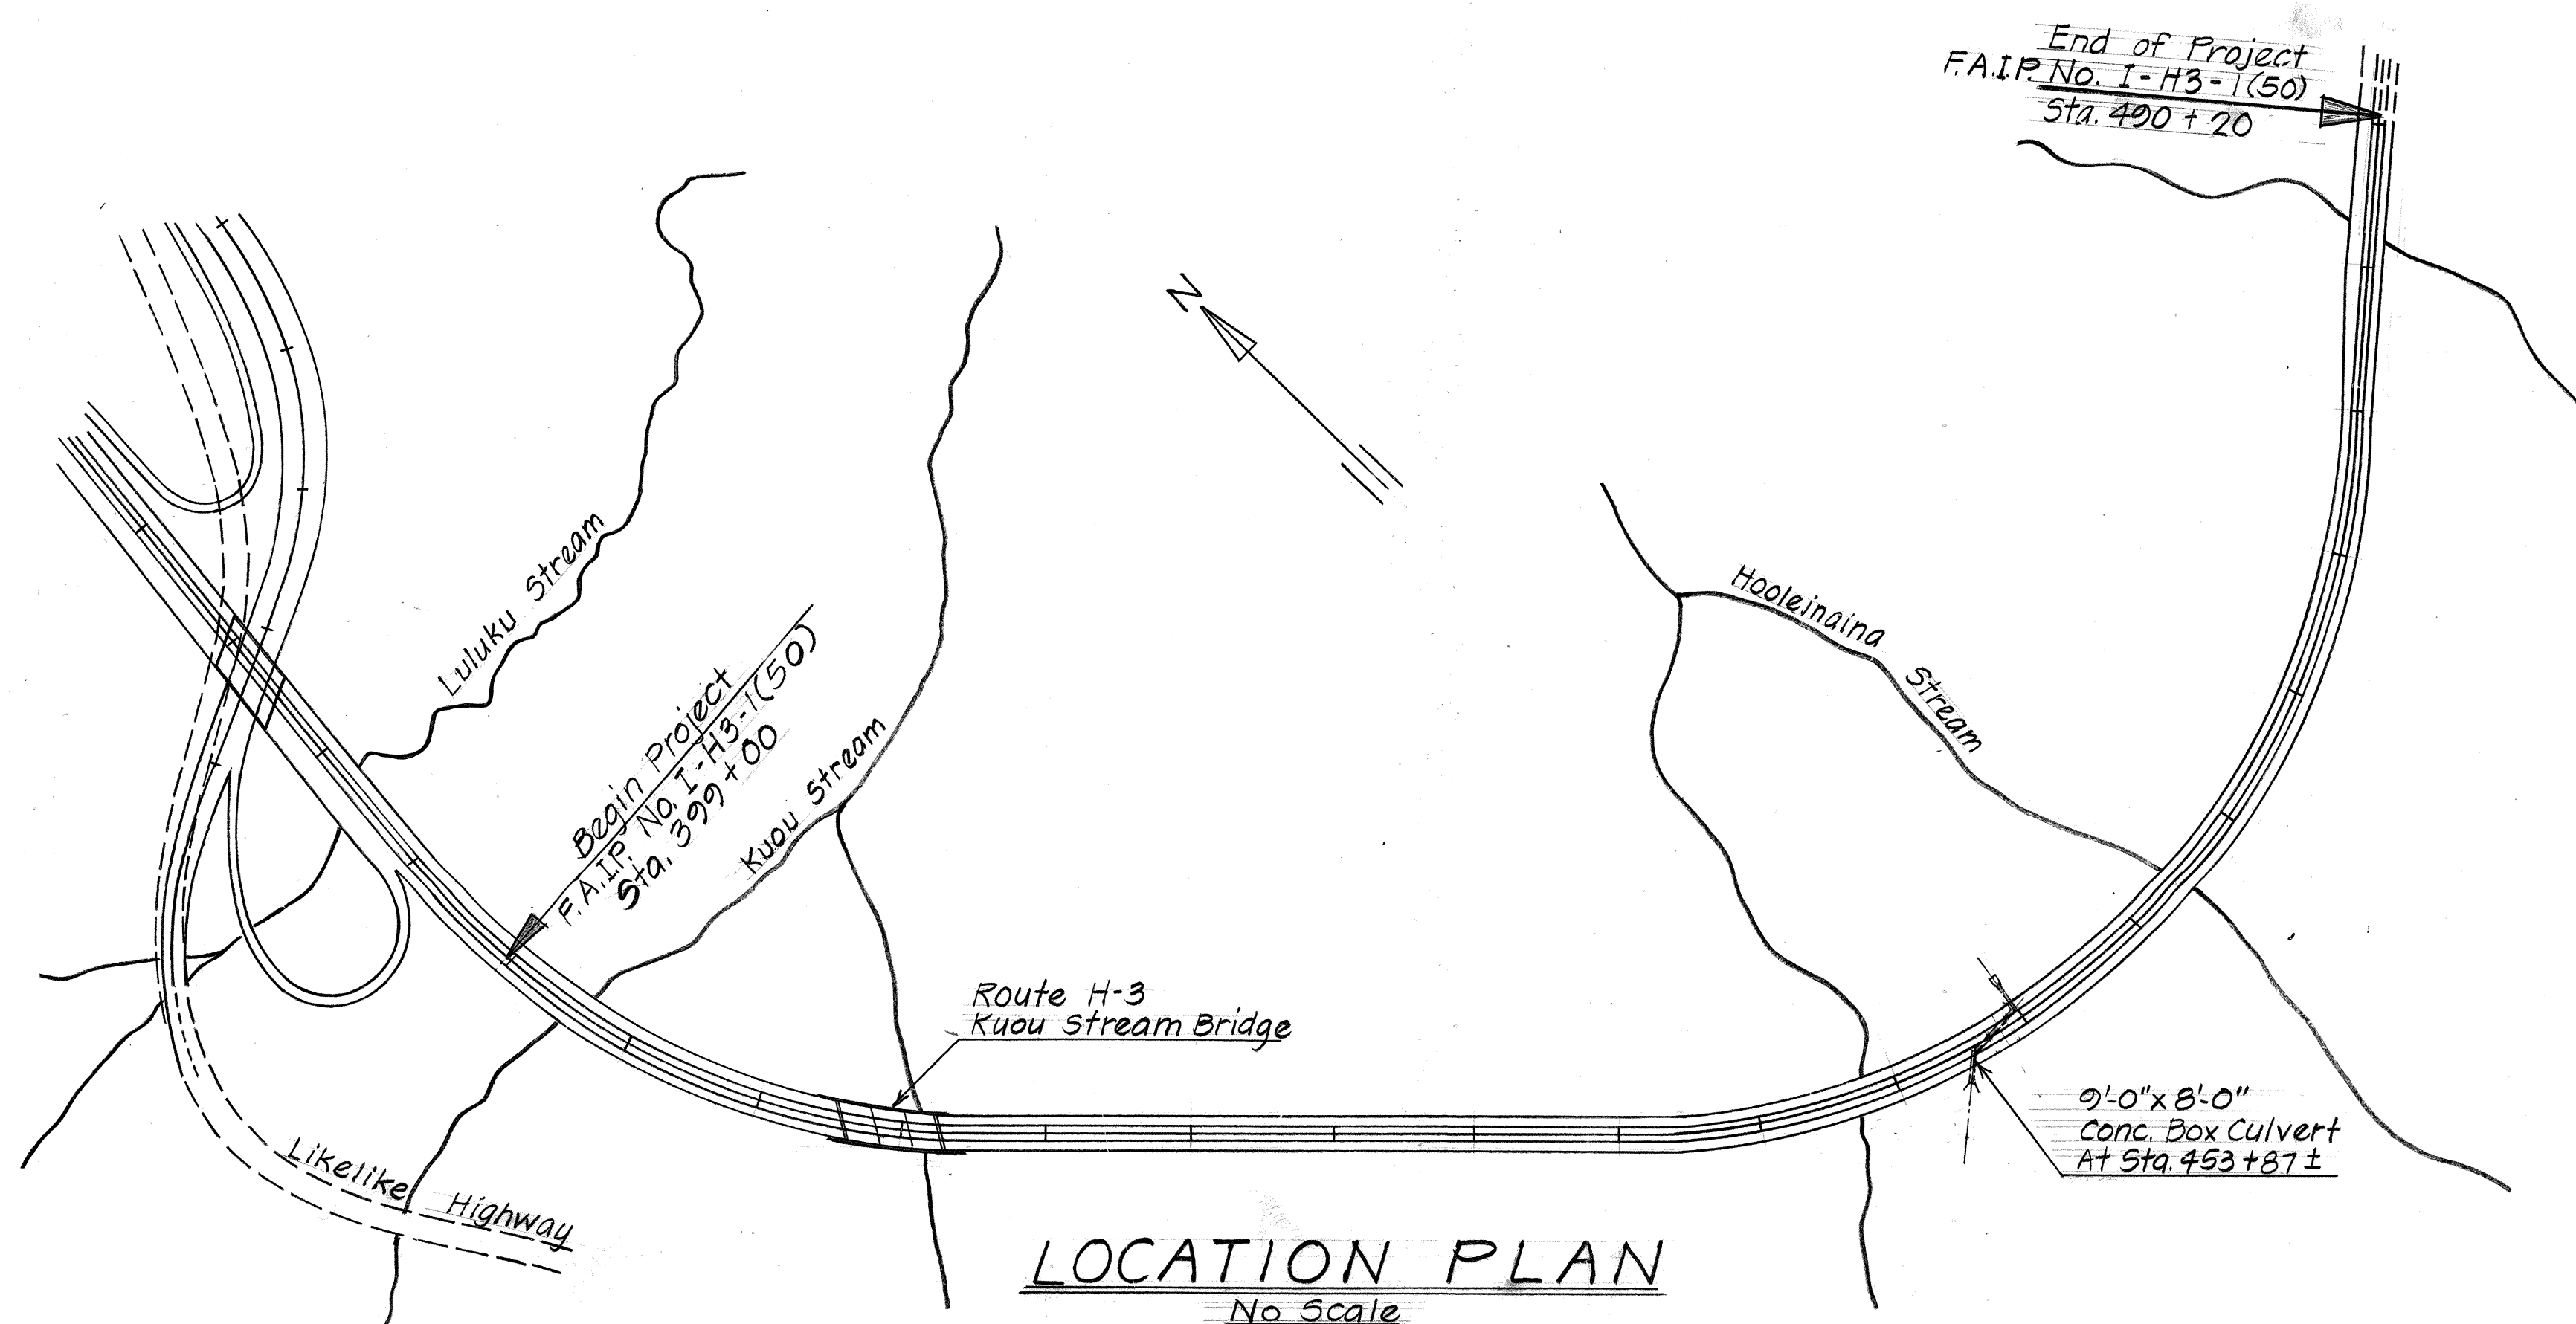


| FED. ROAD DIST. NO. | STATE | FED. AID PROJ. NO. | FISCAL YEAR | SHEET NO. | TOTAL SHEETS |
|---------------------|-------|--------------------|-------------|-----------|--------------|
| HAWAII              | HAW.  | I-43-1(50)         | 1989        | 82        | 164          |

[illegible]

STATE OF HAWAII  
DEPARTMENT OF TRANSPORTATION  
LAND TRANSPORTATION FACILITIES DIVISION

ROUTE H-3 - KUOU STREAM BRIDGE

2'-0" x 8'-0" CONC. BOX CULVERT @ STA. 459+87

INDEX & LOCATION PLAN

FAI Proj. No. I - H-3 - 1 (50)  
KANEHOE I.C. TO HALEKOU I.C.


Scale: As Noted      Date: August 1987

**SHEET No. 91 OF 35 SHEETS**




| FED. ROAD DIST. NO. | STATE | FED. AID PROJ. NO. | FISCAL YEAR | SHEET NO. | TOTAL SHEETS |
|---------------------|-------|--------------------|-------------|-----------|--------------|
| HAWAII              | HAW.  | I-H3-1(50)         | 1989        | ADD.83    | 164          |

| CURVE #2                     |
|------------------------------|
| $\Delta = 21^\circ 39' 58''$ |
| $R = 3,300 \text{ ft.}$      |
| $T = 631.48 \text{ ft.}$     |
| $L_c = 1,247.88 \text{ ft.}$ |

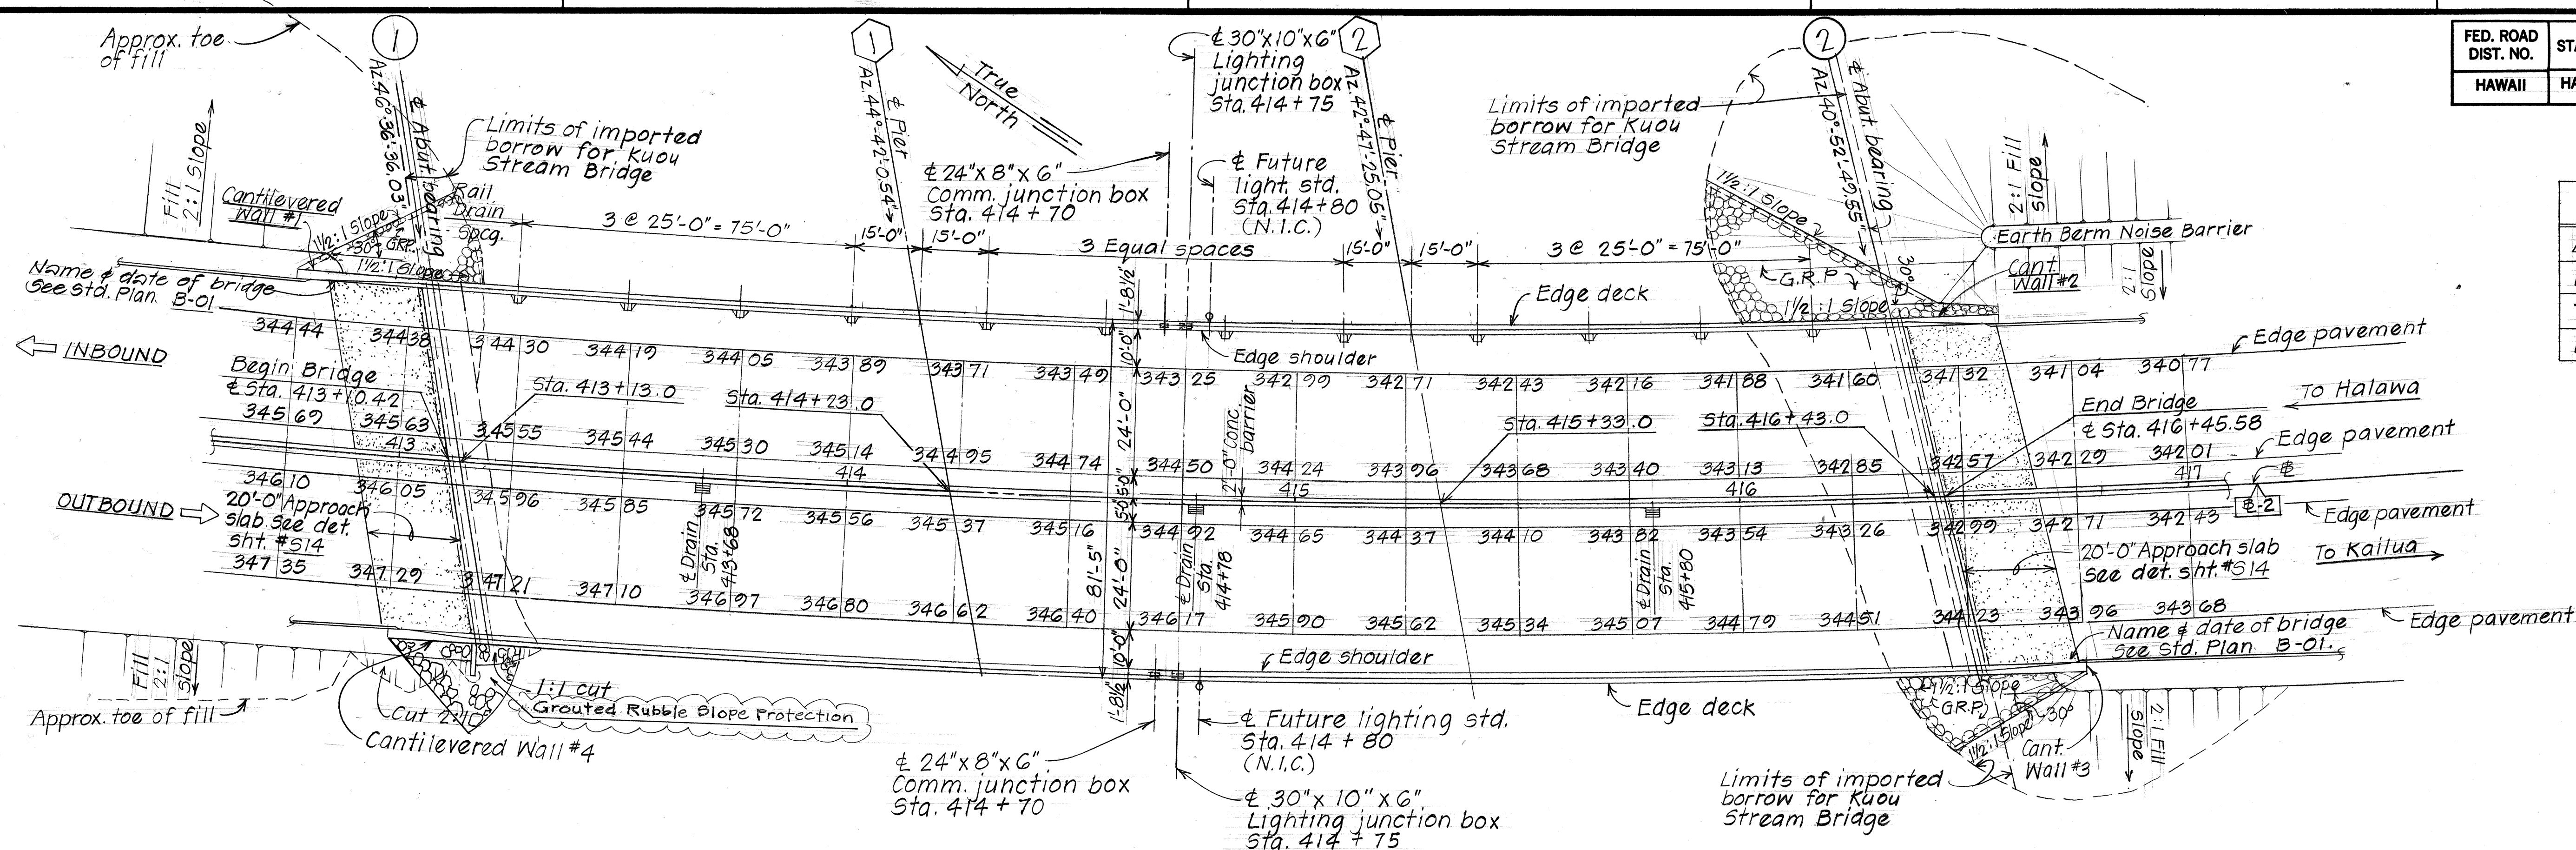

**DECK LAYOUT PLAN**  
Scale: 1" = 20'-0"

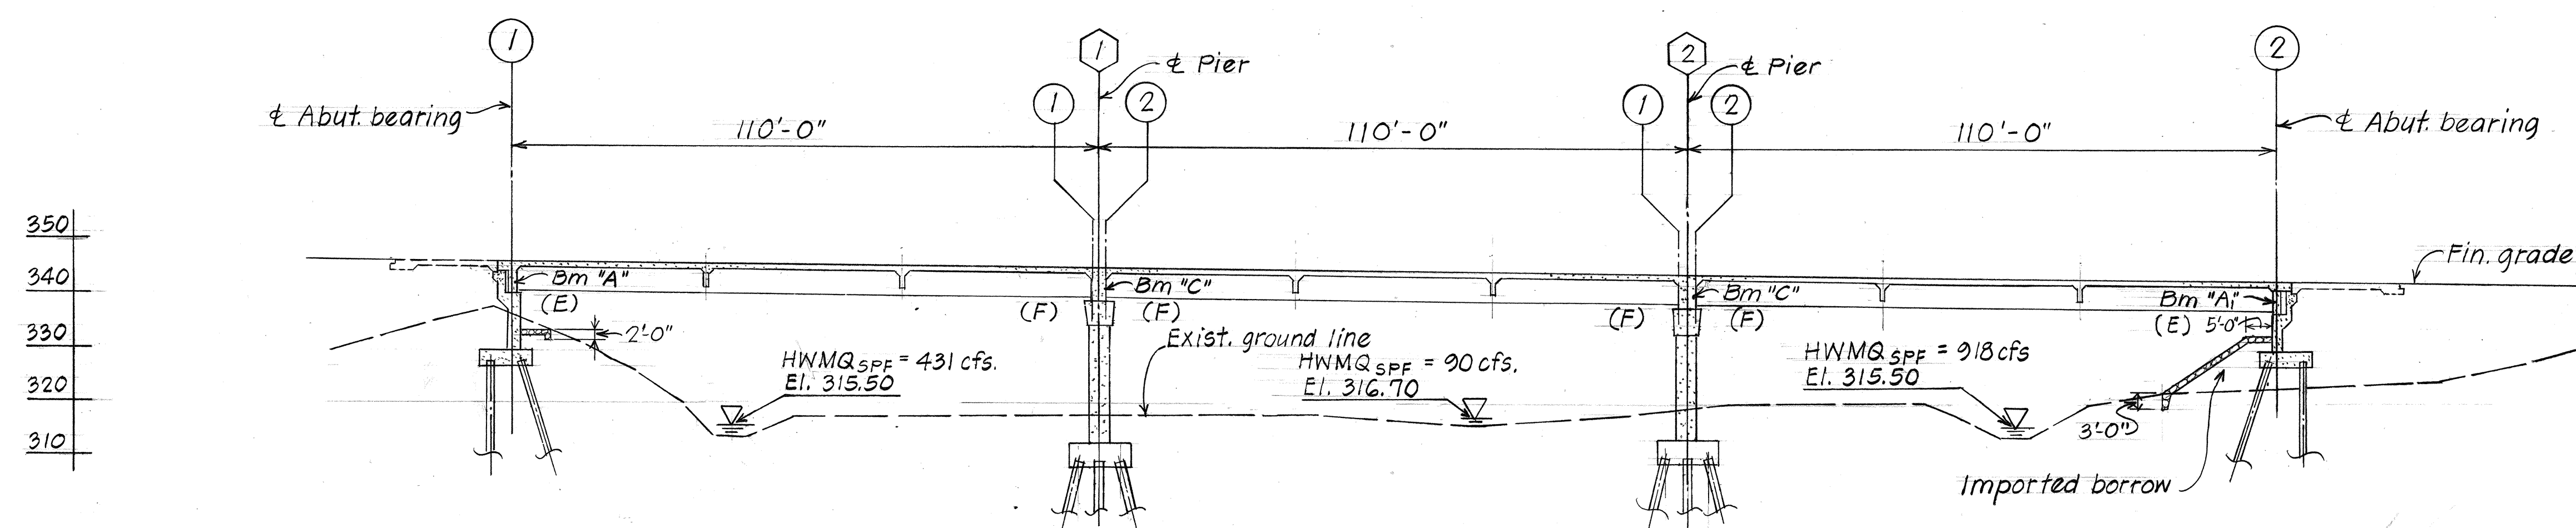

**LONGITUDINAL SECTION ALONG #2**  
Scale: 1" = 20'-0"

| DATE    | REVISION                                            |
|---------|-----------------------------------------------------|
| 4/20/91 | Construct Grouted Rubble Slope Protection (c.c.#43) |
| 3/29/90 | Addition of lighting standard & junction boxes.     |
| 3/12/89 | Revised Curve Data                                  |

STATE OF HAWAII  
DEPARTMENT OF TRANSPORTATION  
LAND TRANSPORTATION FACILITIES DIVISION

**KUOU STREAM BRIDGE**  
LAYOUT PLAN  
LONGITUDINAL DECK SECTION

F.A.I. Proj. No. I-H3-1(50)  
KANEIHE I.C. TO HALEKOU I.C.

Scale: As Noted Date: August 1987

SHEET NO. 52 OF 35 SHEETS

| DATE | BY     |
|------|--------|
| 7/83 | L.M.A. |
| 7/83 | S.A.   |
| 7/83 | T.M.   |
| 7/83 | D.C.O. |

"AS BUILT"

C.O. ADD.83



| FED. ROAD DIST. NO. | STATE | FED. AID PROJ. NO. | FISCAL YEAR | SHEET NO. | TOTAL SHEETS |
|---------------------|-------|--------------------|-------------|-----------|--------------|
| HAWAII              | HAW.  | I-H3-1(50)         | 1989        | ADD.84    | 164          |

# ESTIMATED QUANTITIES

## KUOU STREAM BRIDGE

| ITEM NO.  | ITEM                                                            | UNIT     | QUANTITIES   |
|-----------|-----------------------------------------------------------------|----------|--------------|
| 206.6000  | Structure Excavation for Bridges                                | Cu. Yd.  | 1,348 C.Y.   |
| 206.7010  | Structural Backfill for Bridges                                 | Cu. Yd.  | 448 C.Y.     |
| 206.8200  | Filter Material for Structures                                  | Cu. Yd.  | 66 C.Y.      |
| 503.1092  | Concrete in Kuou Stream Bridge (Except Footing)                 | Lump Sum | 1,215 C.Y.   |
| 503.1095  | Concrete in Footings for Kuou Stream Bridge                     | Lump Sum | 503 C.Y.     |
| 503.1910  | Concrete in Approach Slab for Kuou Stream Bridge                | Lump Sum | 138 C.Y.     |
| 504.4500  | Kaahi Type IV Prestressed Concrete Girders                      | Lump Sum | 4,950 L.F.   |
| 505.0020  | Test Piles, Driven                                              | Lin. Ft. | 1,134 L.F.   |
| 505.0310  | Precast Prestressed Concrete Piles, Furnished                   | Lin. Ft. | 9,497 L.F.   |
| 505.3100  | Precast Prestressed Concrete Piles, Driven                      | Lin. Ft. | 7,390 L.F.   |
| 505.6100  | Drilled Holes in Embankment for Piles                           | Lin. Ft. | 314 L.F.     |
| 505.9000  | Extensions or 'Build-Ups' of Piles                              | F. A.    | -            |
| 505.0001  | Pile Driving Equipment Expense (Not to Exceed \$8,000)          | Lump Sum | -            |
| 507.1001  | Metal Bridge Railing - One Rail on Parapet Kuou Stream Bridge   | Lin. Ft. | 680 L.F.     |
| 507.7001  | Concrete Bridge Parapet - Including End Post Kuou Stream Bridge | Lin. Ft. | 759 L.F.     |
| 507.7601  | Bridge Concrete Median Barrier Kuou Stream Bridge               | Lin. Ft. | 335 L.F.     |
| 602.0091  | Reinforcing Steel in Kuou Stream Bridge                         | Lump Sum | 501,000 LBS. |
| 602.00910 | Reinforcing Steel in Approach Slab for Kuou Stream Bridge       | Lump Sum | 54,275 LBS.  |
| 612.0201  | Grouted Rubble Slope Protection Kuou Stream Bridge              | Cu. Yd.  | 203 C.Y.     |
| 634.0100  | Exploratory Work at Structure Footings                          | F. A.    | -            |
| 203.0218  | Imported Borrow for Kuou Stream Bridge                          | Cu. Yd.  | 1,056 C.Y.   |
| 505.0010  | Pile Load Tests                                                 | Each     | 2 Ea.        |
| 505.9100  | Retapping of Piles                                              | F. A.    | -            |
| 505.9200  | Repair or Replacement of Engineer's Equipment                   | F. A.    | -            |
| 505.9300  | Dynamic Instrumentation and Testing for Pile Acceptance         | F. A.    | -            |

# FOUNDATION PLAN

Scale: 1" = 20'-0"

NOTE:

For Boring Logs see sht. #54.

# LEGEND:

- ◀◀ = Denotes direction of pile batter
- (00.0) = Pile cut-off elevation
- 00.0 = Bottom footing elevation
- 00.0 = Pile tip elevation
- = Test piles
- ⊙ = Boring

# ELEVATION - PIERS 1 & 2

Scale: 3/16" = 1'-0"

STATE OF HAWAII  
DEPARTMENT OF TRANSPORTATION  
LAND TRANSPORTATION FACILITIES DIVISION

**KUOU STREAM BRIDGE**  
FOUNDATION PLAN, ELEV. PIER 1 & 2  
ESTIMATED QUANTITIES

F.A.I. Proj. No. I-H3-1(50)  
KANELOHE I.C. TO HALEKOU I.C.

Scale: As Noted Date: August 1987

3/2/89 Added additional Load Test Pile

DATE REVISION

SHEET No. 93 OF 35 SHEETS

ADD.84



# GENERAL STRUCTURAL NOTES

## DESIGN SPECIFICATIONS:

AASHTO, Standard Specifications for Highway Bridges (13th edition), including Interim Specifications

## DESIGN LIVE LOAD:

H5-20-44 or Interstate Loading

## ALLOWABLE DESIGN STRESSES:

- Reinforced concrete:  $f_c = 0.40 f'_c$
- Reinforcing steel:  $f_s = 20,000$  psi for Grade 40, 24,000 psi for Grade 60
- Prestressed concrete: see Design Specifications
- Prestressed concrete piles: see Standard Plans B-12, B-13
- Pile Design Load: 75 tons - Precast (Friction Piles)

## MATERIALS:

- Reinforced concrete - 5,000 psi (pier columns)  
- Class BD (for bridge deck on girders and approach slabs)  
- Class A (all others)
- Reinforcing steel - ASTM A615, Grade 40 or Grade 60
- Prestressed concrete - see sht. #517 & #529.
- Prestressed concrete piles - see Standard Plans
- Admixture in concrete - see Special Provisions

## CONSTRUCTION METHODS:







- Refer to Standard Specifications for Road and Bridge Construction, 1985 Edition and Special Provisions.
- In general, top of concrete deck of superstructure shall be constructed to follow the finish roadway vertical and horizontal curves and grades. See Highway Plans.
- The Contractor shall verify all grades and dimensions before commencing with any work.
- For concrete finish, see Special Provisions. Girder concrete seats, hinge and creep blocks to be poured monolithically with the supporting structures. Top surfaces of concrete seats to have hard trowel finish.
- Except as noted otherwise, all vertical dimensions are measured plumb.
- Abutment footing step-ups for Trail Crossing @ Sta. 454+00 shall be excavated and poured on aggregate subbase material. In case of over-excavation, the space between the footing and the aggregate subbase material shall be filled with concrete at the Contractor's expense and as directed by the Engineer. The minimum quality of the fill concrete shall be Class D.
- Piles shorter than 100' shall not be spliced.
- Pre-drilled holes for piles shall extend 10'-0" below the bottom of Abutment No. 2 footing.

## REFERENCE:

- Refer to Standard Plans B-01 for additional details not covered by detailed and typical drawings.



## GENERAL NOTES:

- All items noted incidental will not be paid for separately.
- All preformed elastomeric bearing pads and preformed fabric bearing pads shall be secured against displacement with adhesives approved by the Engineer.
- Except as otherwise noted on plans, all exposed exterior corners 90° or less shall be chamfered 3/4" x 3/4". All exposed exterior corners greater than 90° shall not be chamfered. Round all finish corners 1/4" radius unless noted otherwise.
- Exact location of bars shall be so arranged so that no interference will occur between vertical column reinforcement and bottom pier cap horizontal reinforcement.
- All falsework and bracing schemes for all phases of construction shall be prepared by or under the supervision of an engineer who is registered as a structural engineer in the State of Hawaii.

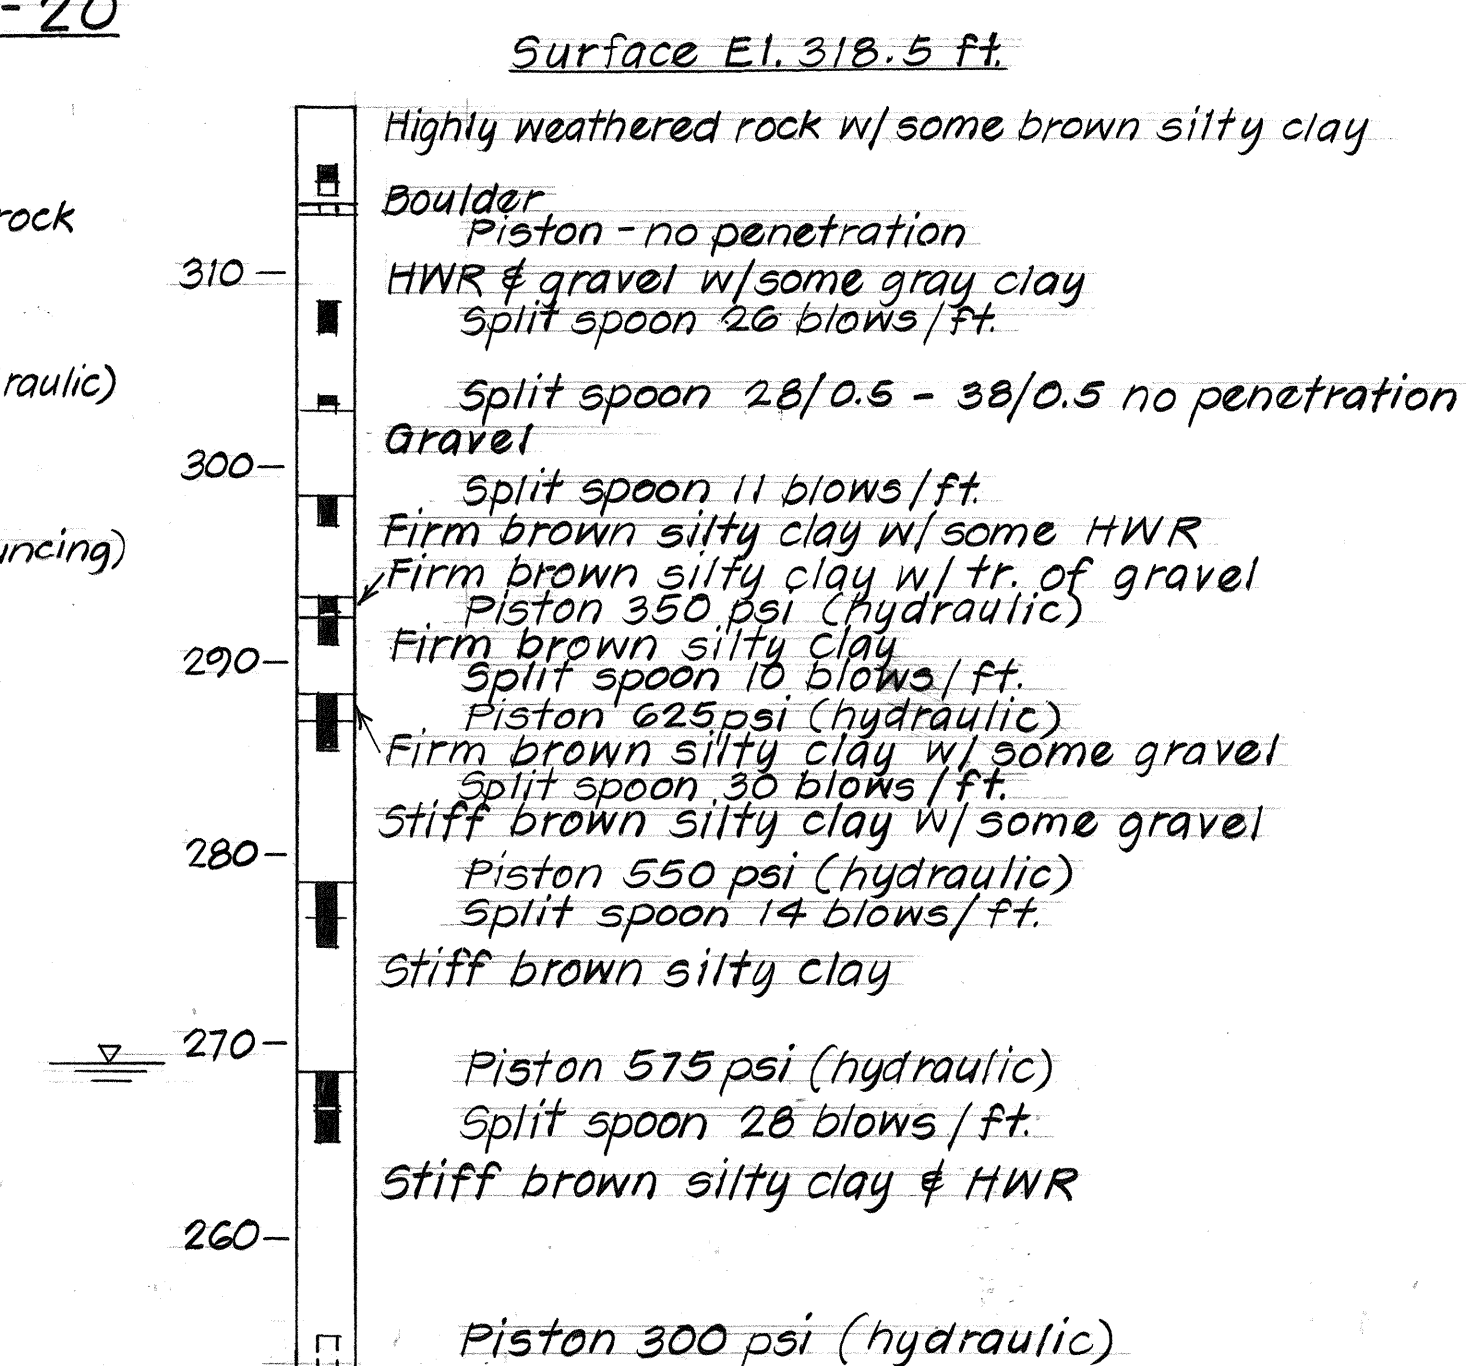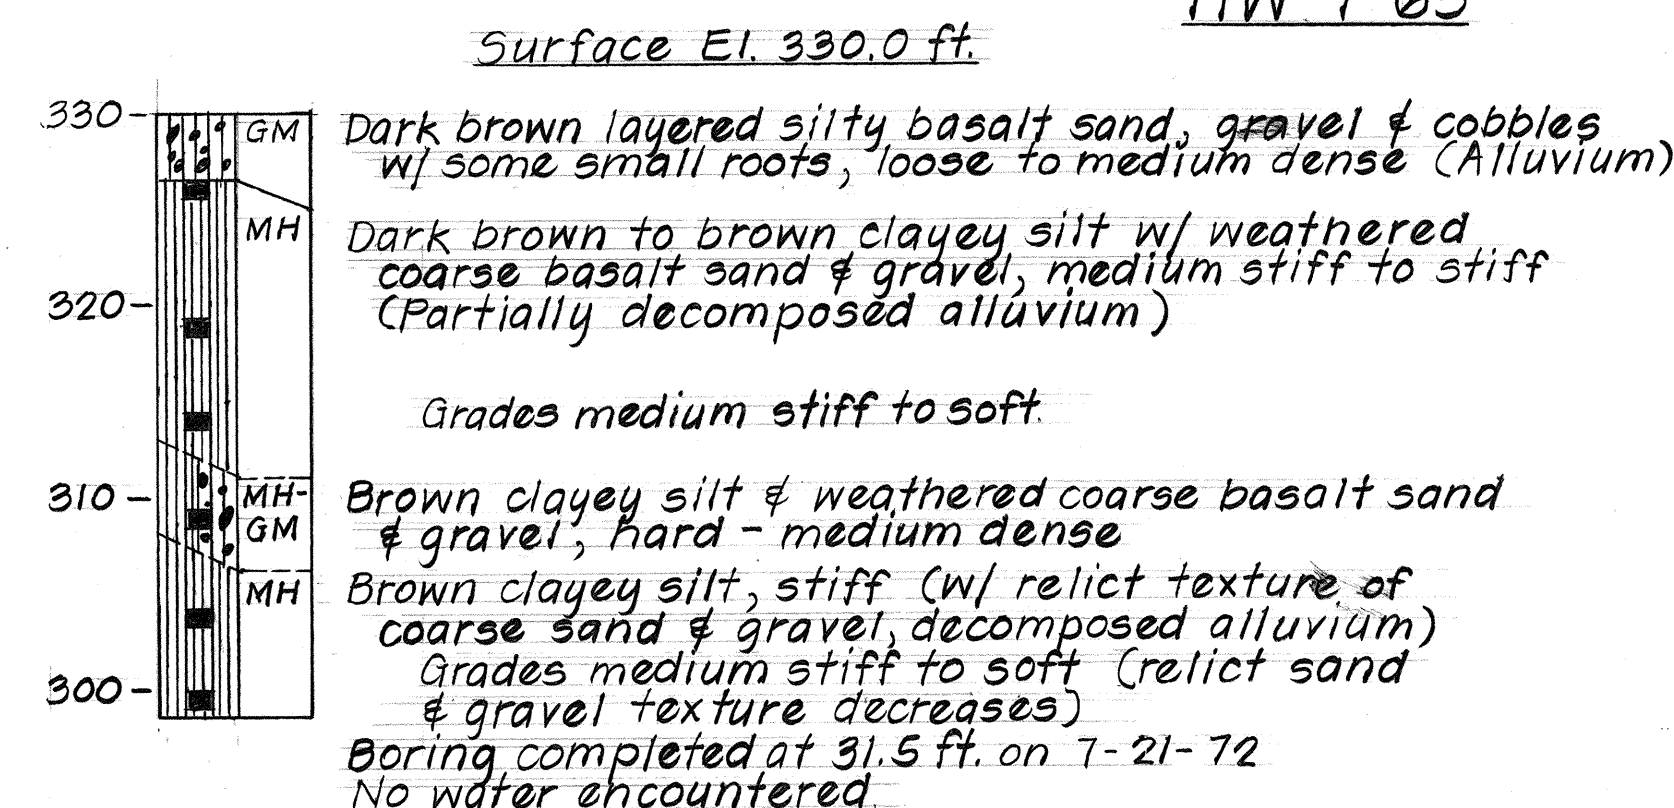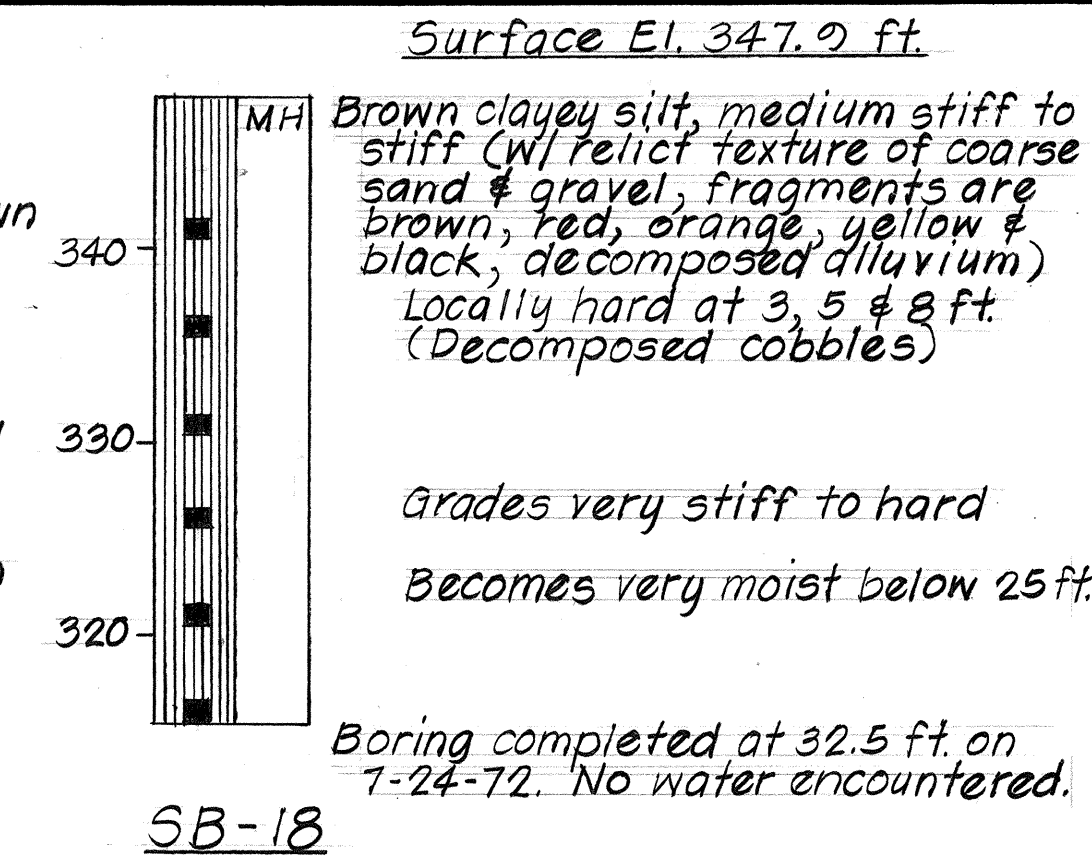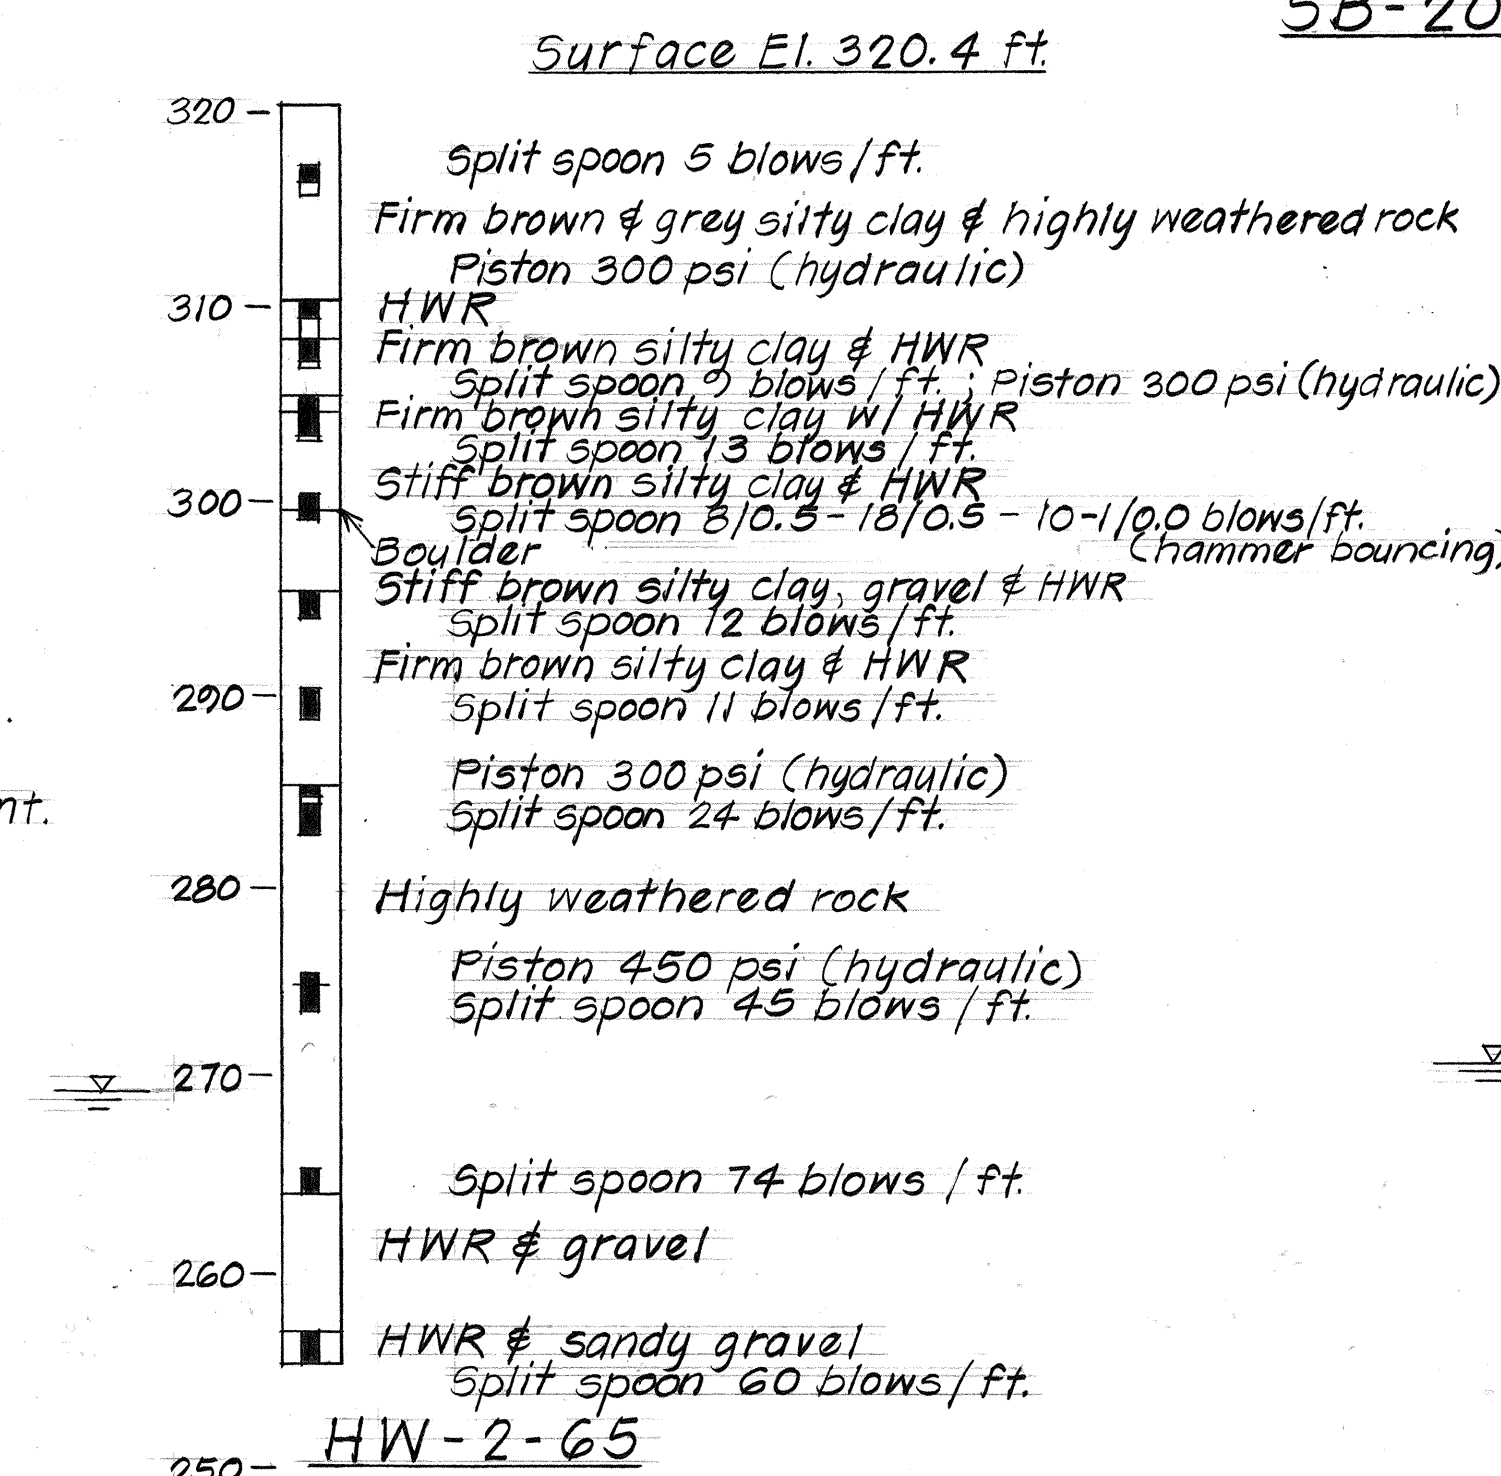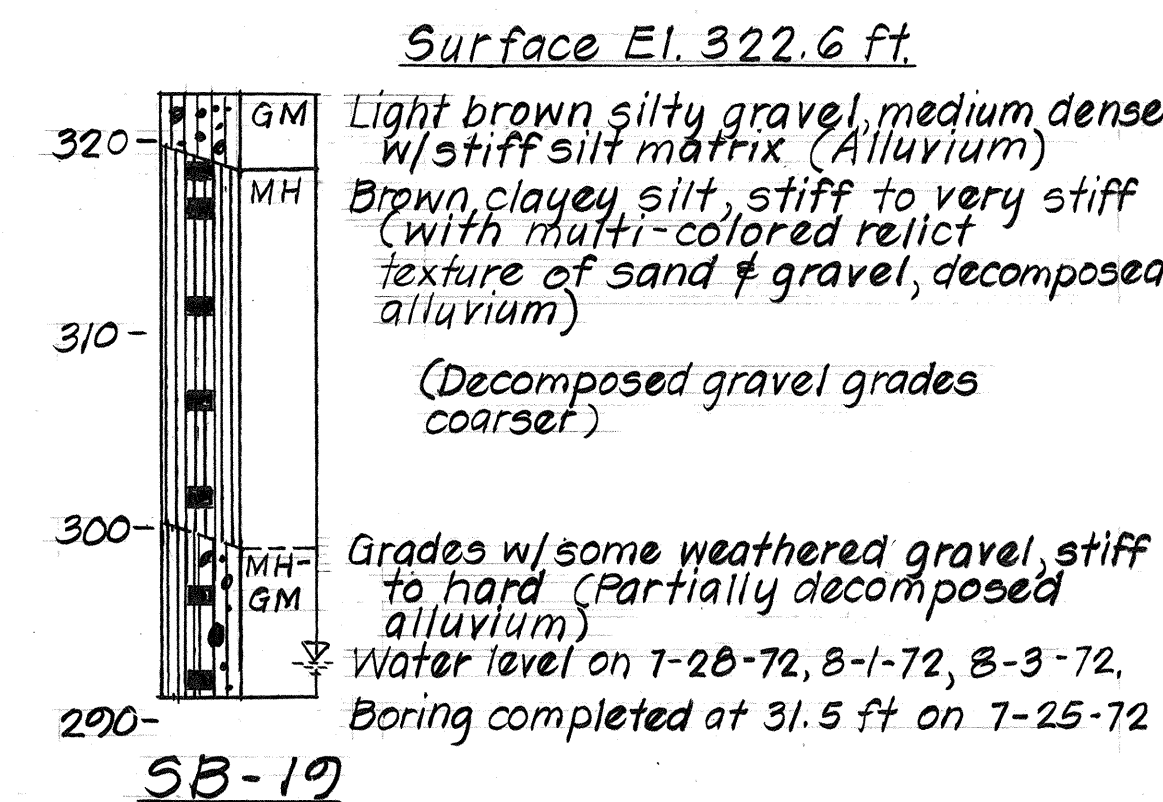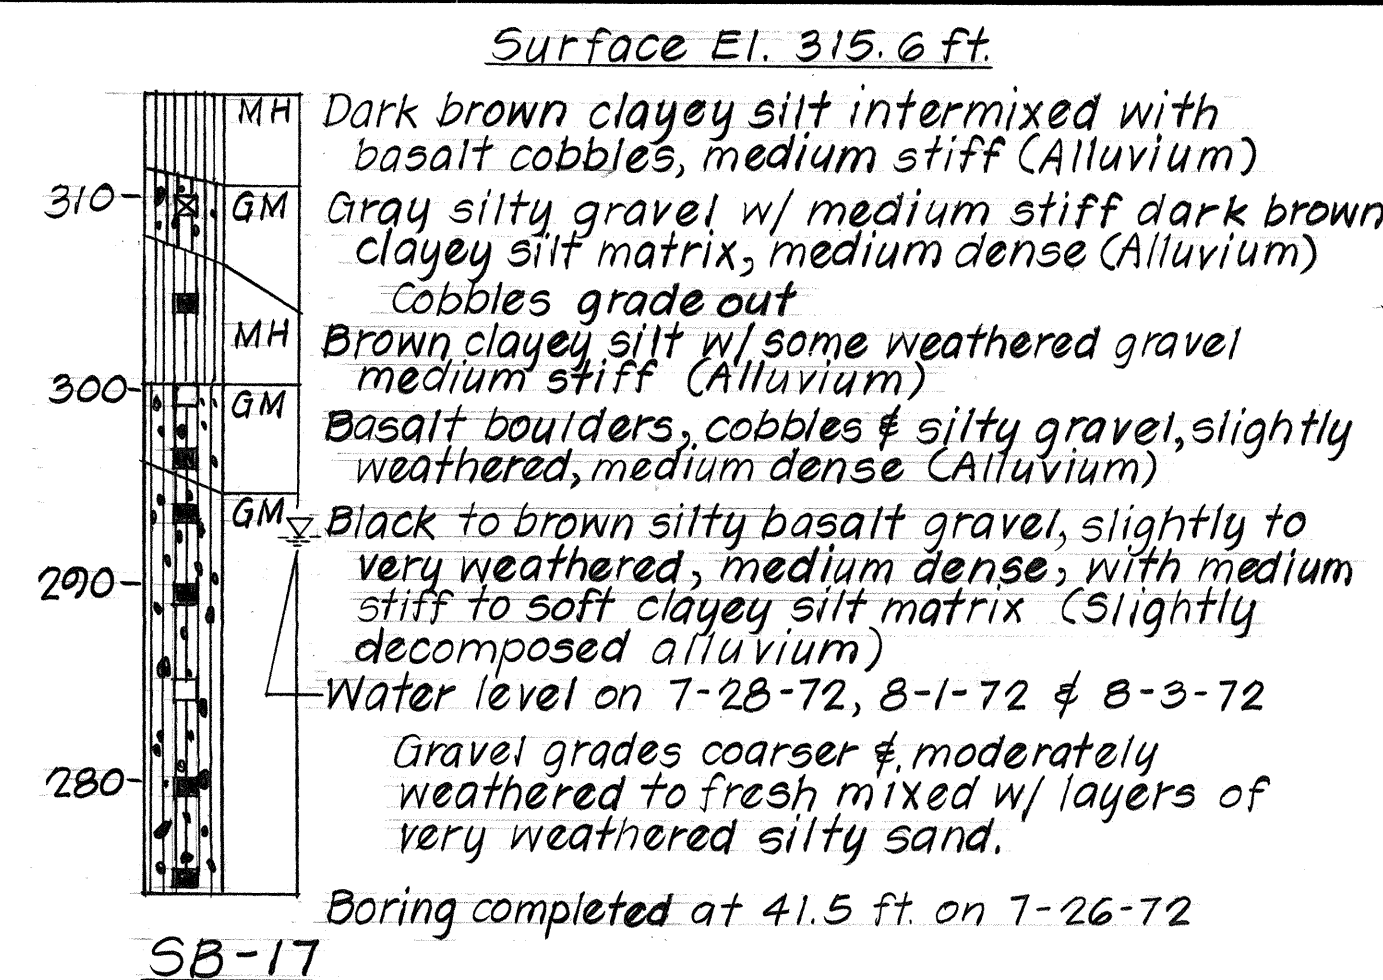

## BORING LOGS


| FED. ROAD DIST. NO. | STATE | FED. AID PROJ. NO. | FISCAL YEAR | SHEET NO. | TOTAL SHEETS |
|---------------------|-------|--------------------|-------------|-----------|--------------|
| HAWAII              | HAW.  | I-H3-1(50)         | 1987        | 85        | 164          |

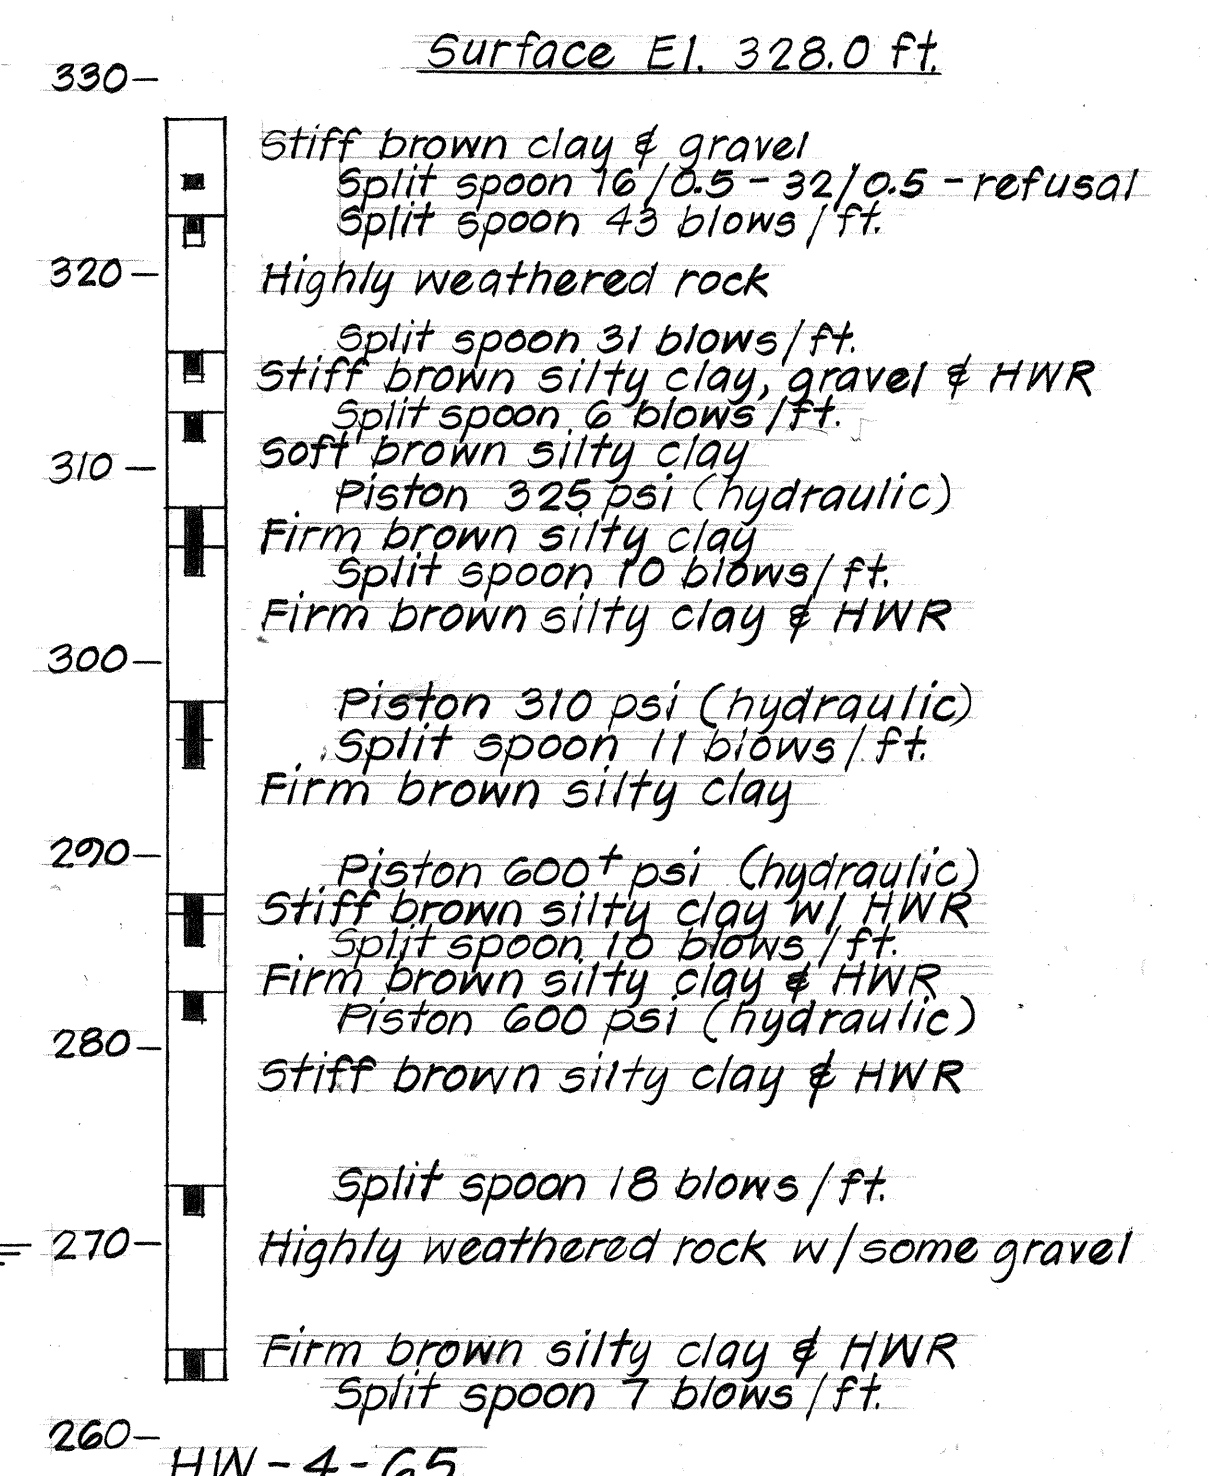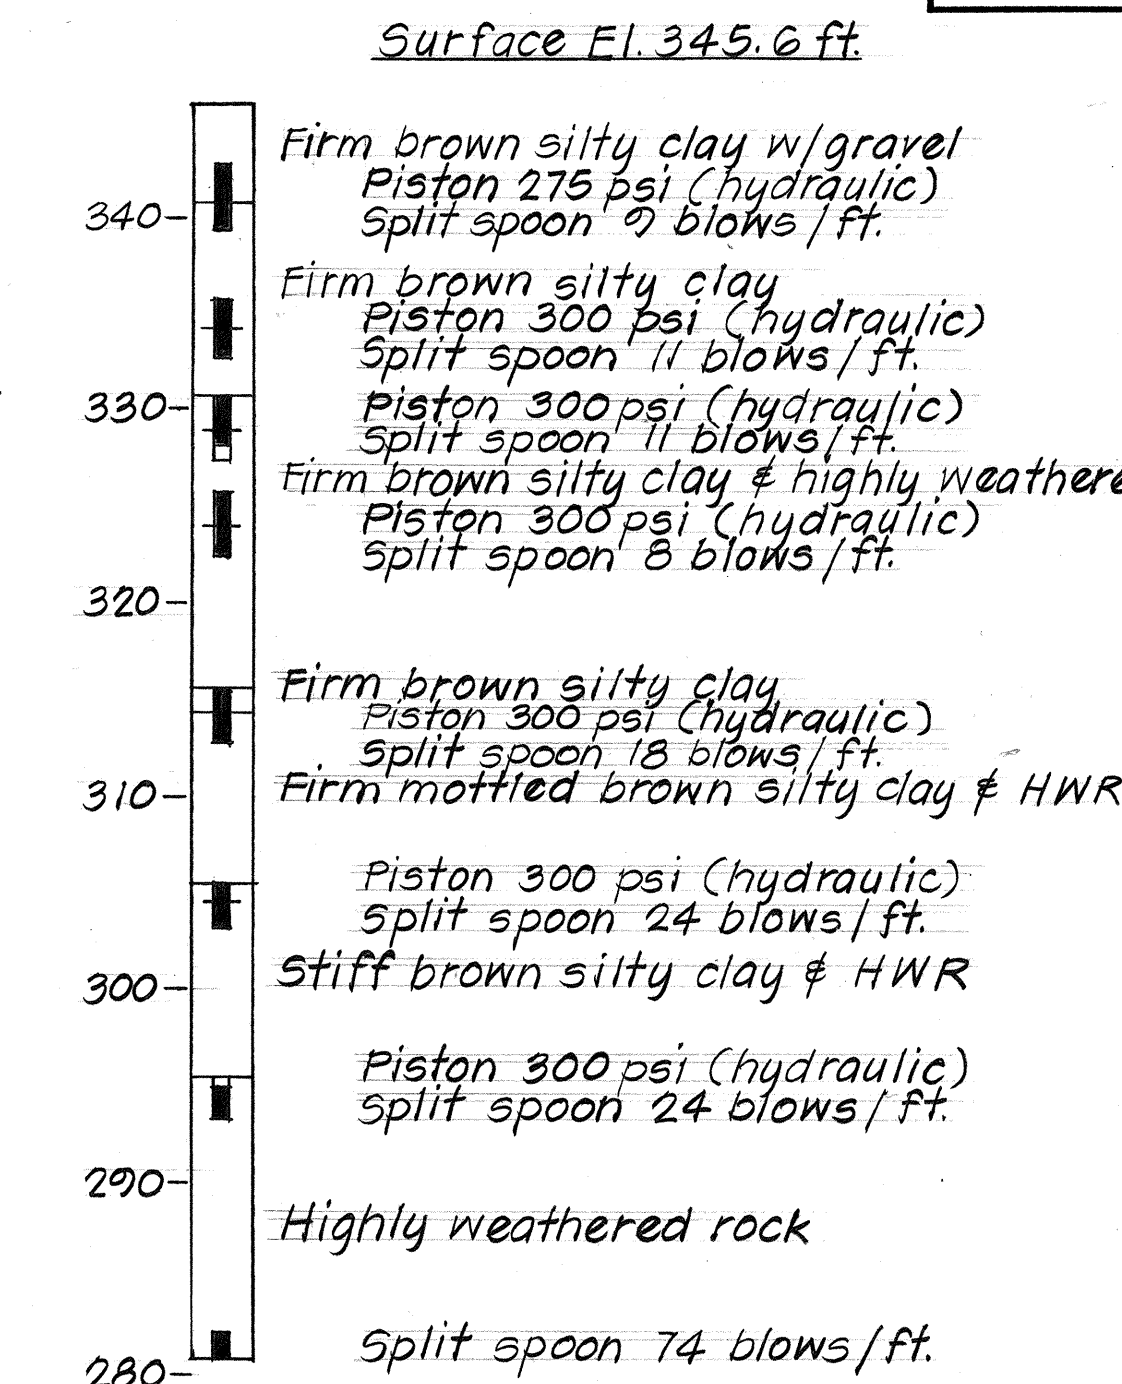

|                                                                                            |
|--------------------------------------------------------------------------------------------|
| STATE OF HAWAII<br>DEPARTMENT OF TRANSPORTATION<br>LAND TRANSPORTATION FACILITIES DIVISION |
| ROUTE H3-KUOU STREAM BRIDGE                                                                |
| GENERAL STRUCTURAL NOTES.<br>BORING LOGS                                                   |
| F.A.I. Proj. No. I-H3-1(50)<br>KANEHOHE I.C. TO HALEKOU I.C.                               |
| Scale: As Noted Date: August 1987                                                          |
| SHEET NO. 84 OF 35 SHEETS                                                                  |



| FED. ROAD<br>DIST. NO. | STATE | FED. AID<br>PROJ. NO. | FISCAL<br>YEAR | SHEET<br>NO. | TOTAL<br>SHEETS |
|------------------------|-------|-----------------------|----------------|--------------|-----------------|
| HAWAII                 | HAW.  | I-H3-1(50)            | 1989           | 86           | 164             |

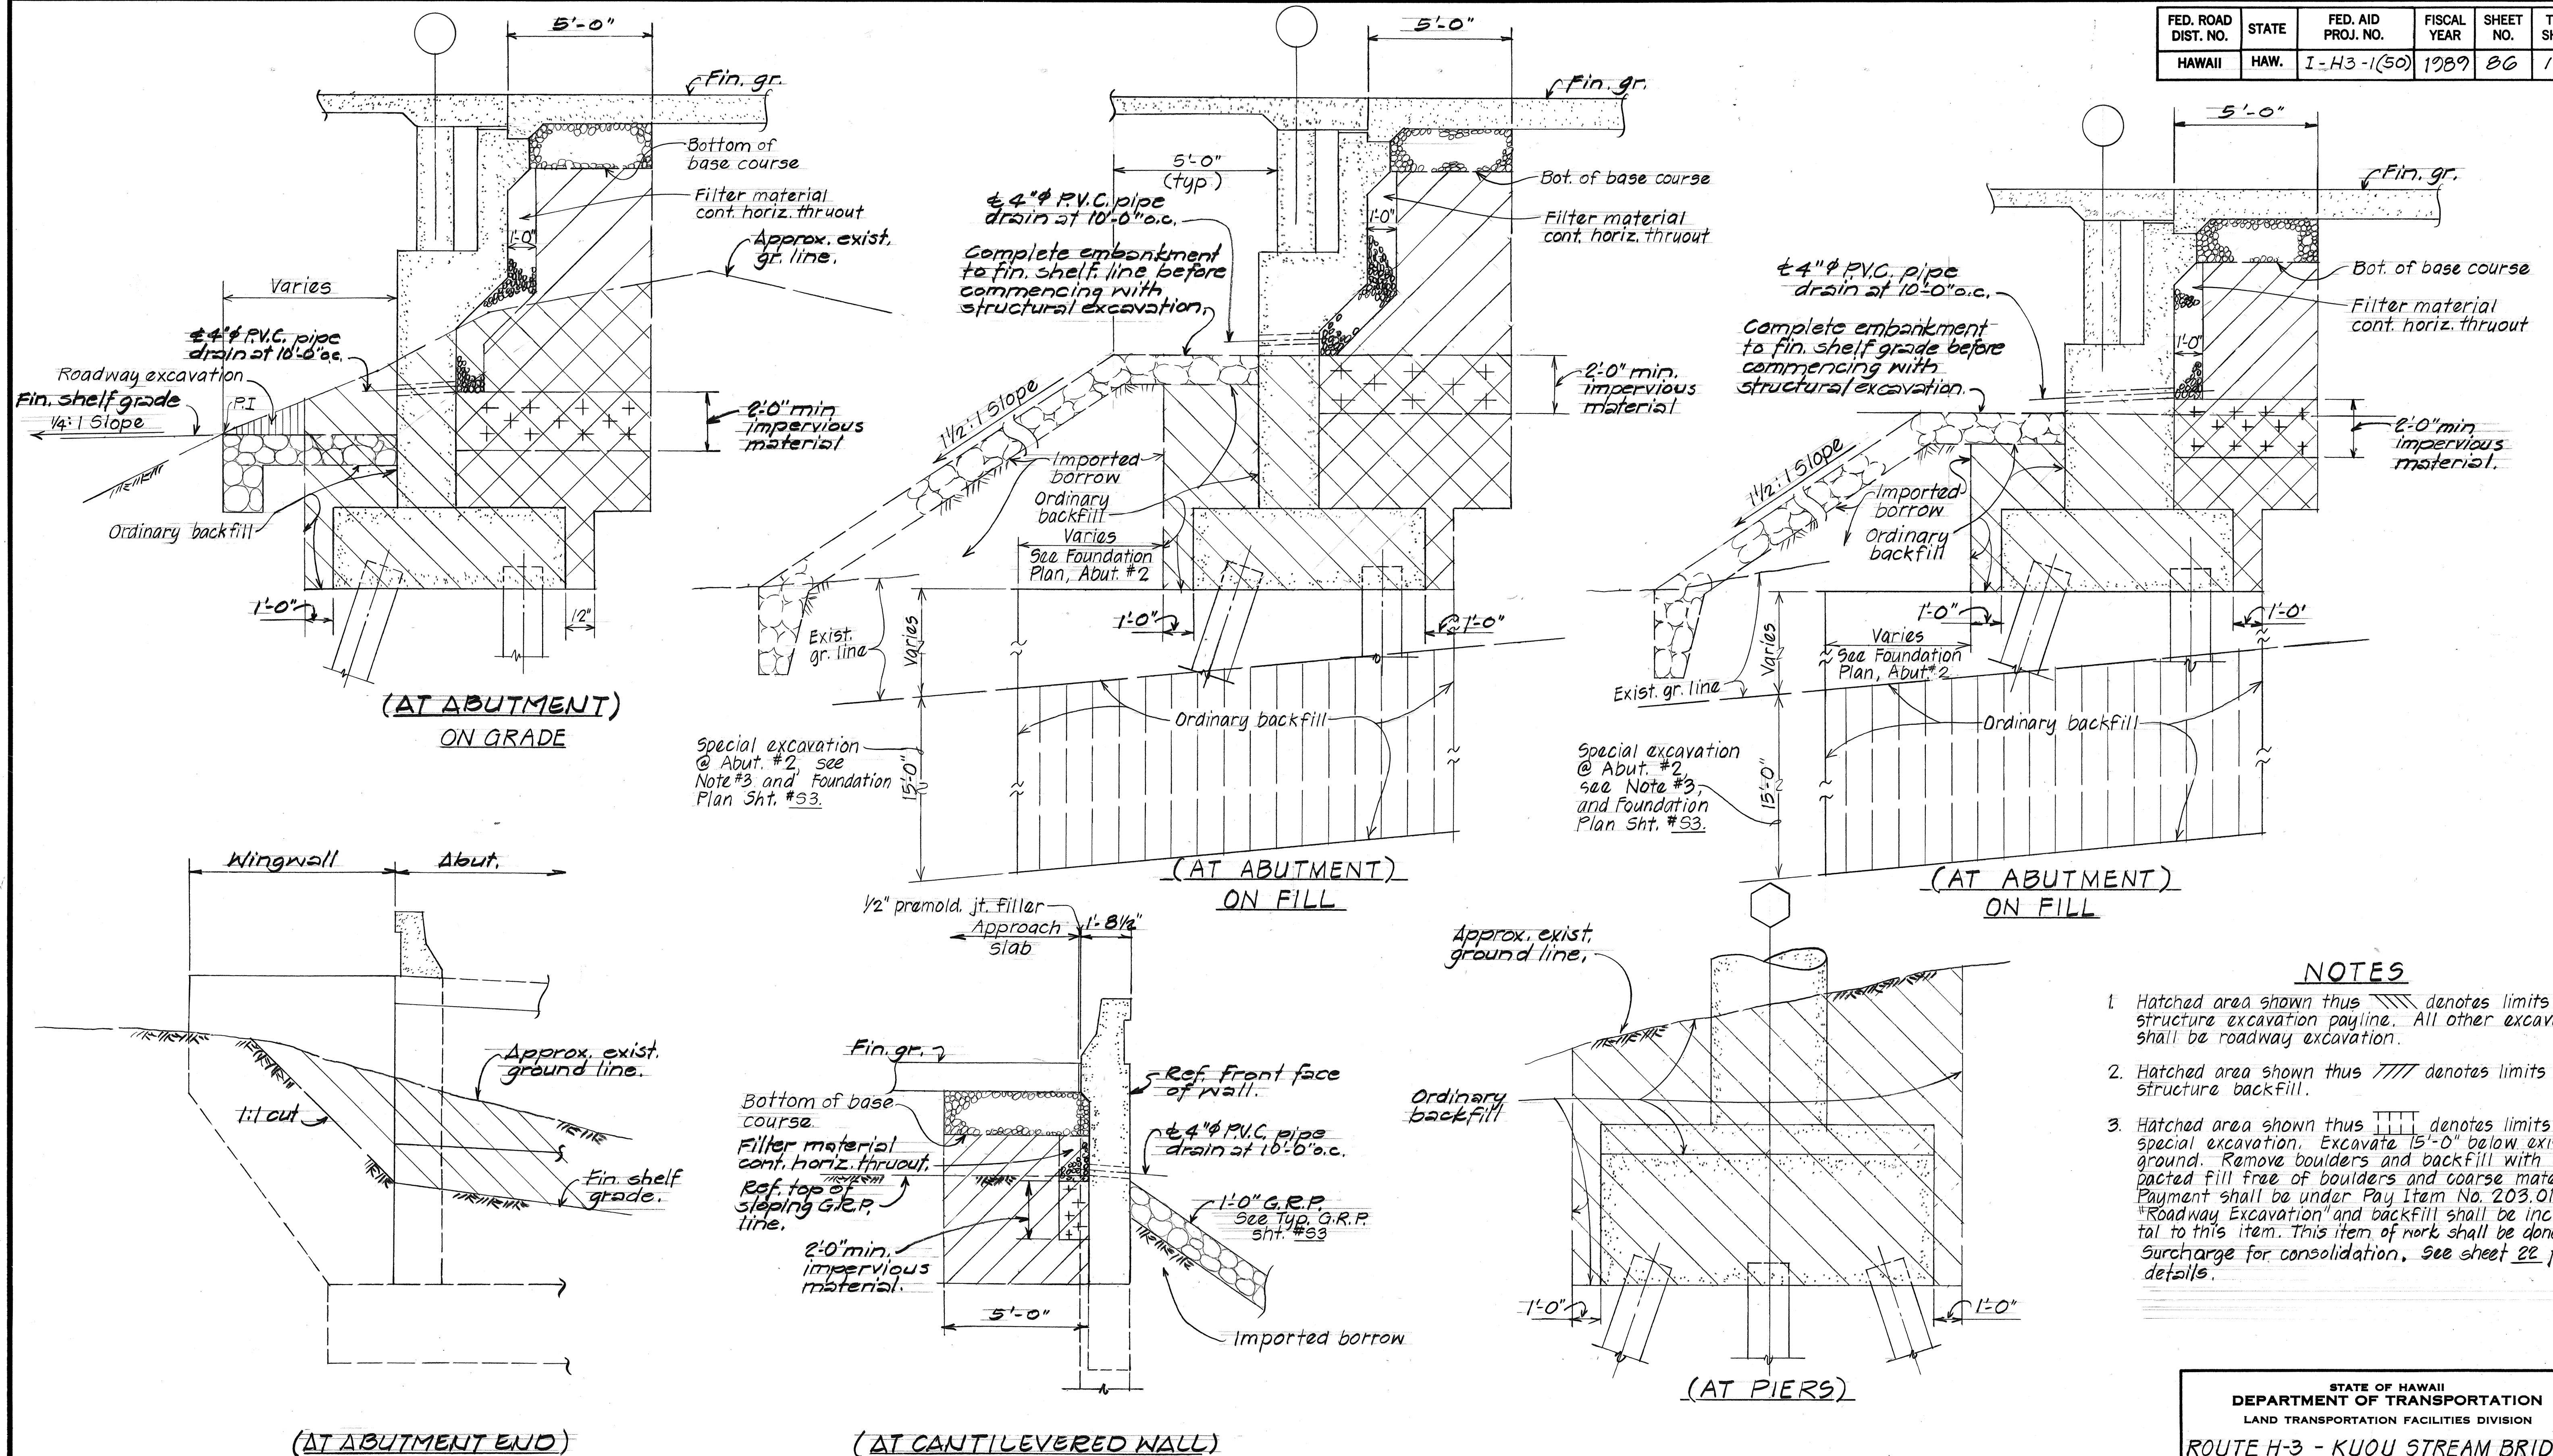

## TYPICAL STRUCTURE EXCAVATION AND BACKFILL PAY LIMITS

Not to Scale

- ## NOTES
1. Hatched area shown thus  denotes limits of structure excavation payline. All other excavation shall be roadway excavation.
  2. Hatched area shown thus  denotes limits of structure backfill.
  3. Hatched area shown thus  denotes limits of special excavation. Excavate 15'-0" below existing ground. Remove boulders and backfill with compacted fill free of boulders and coarse material. Payment shall be under Pay Item No. 203.0100 "Roadway Excavation" and backfill shall be incidental to this item. This item of work shall be done with Surcharge for consolidation. See sheet 22 for details.

STATE OF HAWAII  
DEPARTMENT OF TRANSPORTATION  
LAND TRANSPORTATION FACILITIES DIVISION

ROUTE H-3 - KUOU STREAM BRIDGE

TYPICAL ABUTMENT # PIER  
STRUCTURE EXC & BACKFILL PAY LIMITS

F.A.I. Proj. No. I-H3-1(50)  
KANEHOE I.C. TO HALEKOU I.C.

Scale: As Noted      Date: August 1987


**SHEET NO. 55 OF 35 SHEETS**




| FED. ROAD DIST. NO. | STATE | FED. AID PROJ. NO. | FISCAL YEAR | SHEET NO. | TOTAL SHEETS |
|---------------------|-------|--------------------|-------------|-----------|--------------|
| HAWAII              | HAW.  | I-H3-1(50)         | 1989        | 87        | 164          |

# REFERENCE NOTE:

1. Bridge deck & superstructure not shown
2. For conc. seat hinge blk., creep blk. & elastomeric bearing pad detls. see sht. #522, 523
3. For concrete end post detail see sht. #527
4. For pile spacings and location see Foundation Plan, sht. #33
5. Top Seat El. Schedule sht. #522.

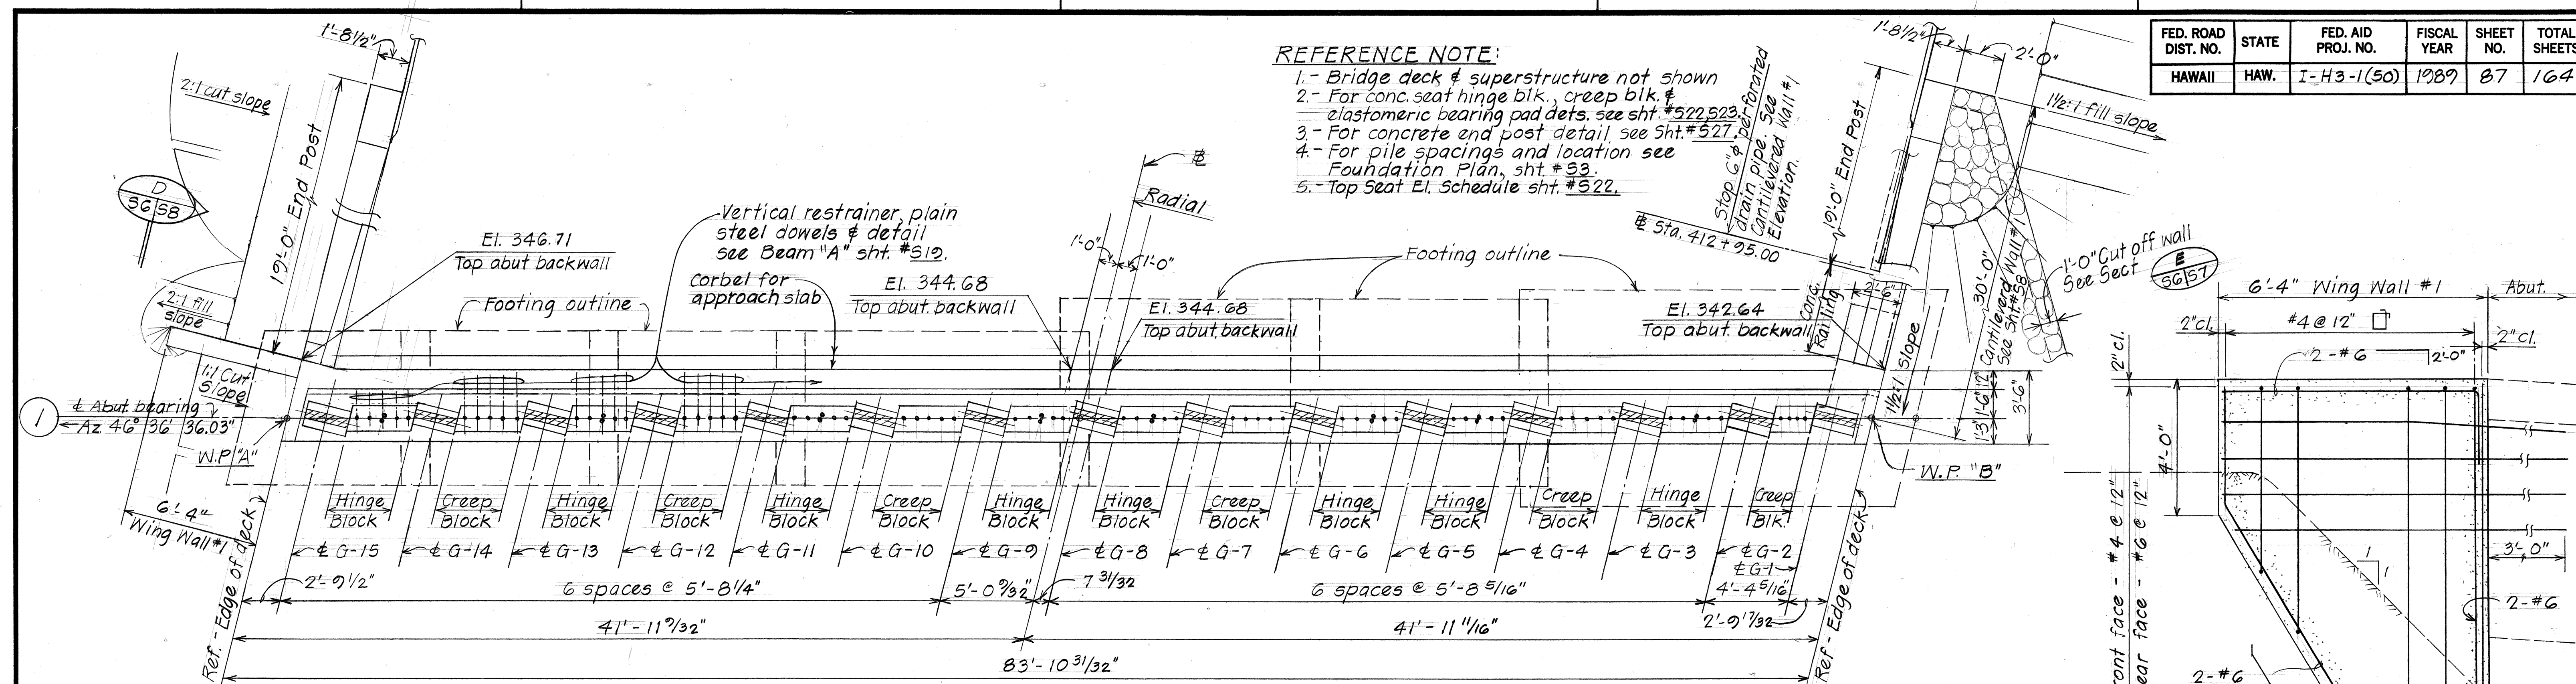

PLAN - ABUTMENT ① Scale: 1/4" = 1'-0"

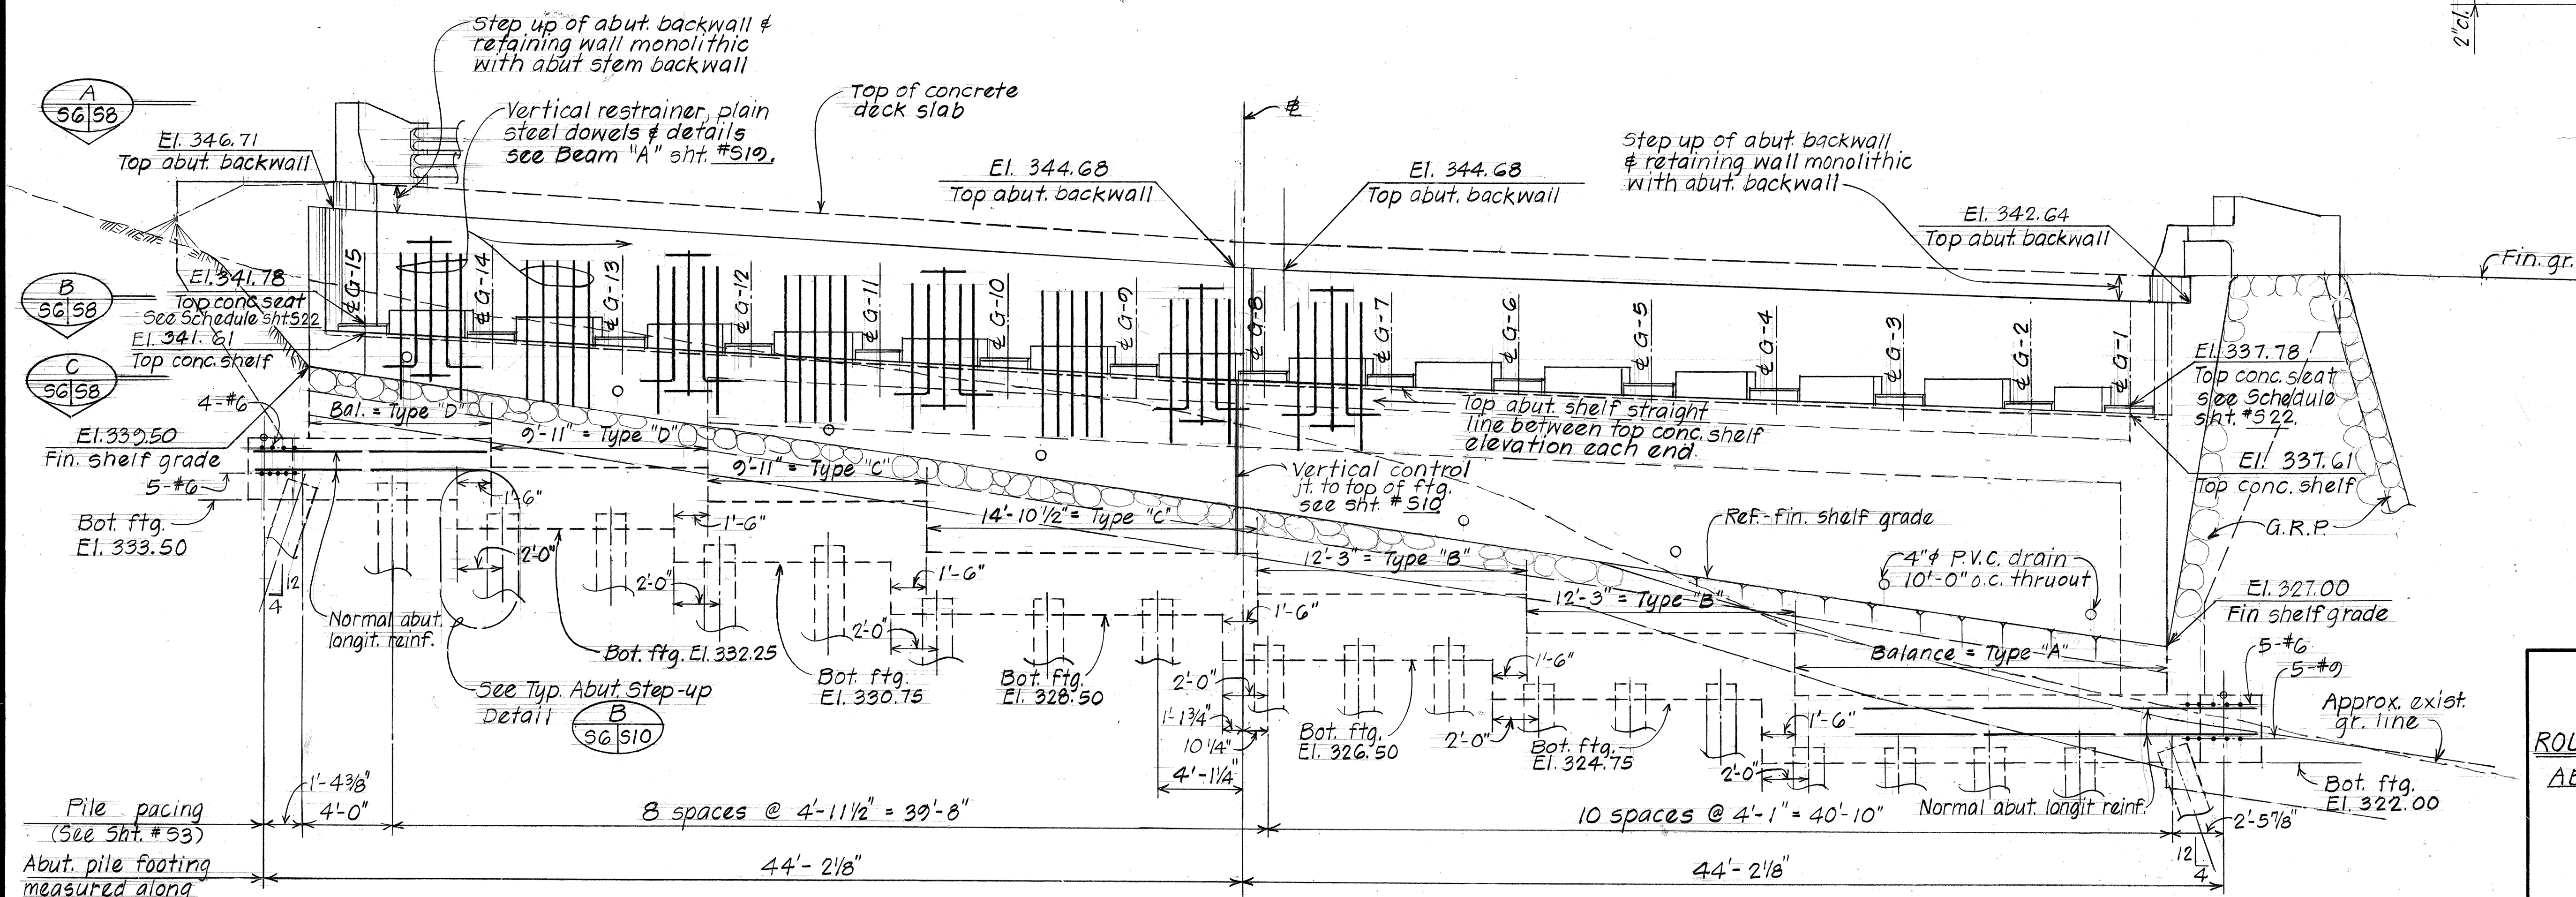

ELEVATION WING WALL #1 Scale: 1/2" = 1'-0"

ELEVATION - ABUTMENT ① Scale: 1/4" = 1'-0"

|                   |      |
|-------------------|------|
| SURVEY PLOTTED BY | DATE |
| DESIGNED BY       | 7/83 |
| NOTED BY          | 7/83 |
| CHECKED BY        | 7/83 |

STATE OF HAWAII  
DEPARTMENT OF TRANSPORTATION  
LAND TRANSPORTATION FACILITIES DIVISION

ROUTE H-3 - KUOU STREAM BRIDGE  
ABUTMENT ① - PLAN & ELEVATION  
WING WALL #1

F.A.I. Proj. No. I-H3-1(50)  
KANEHOE I.C. TO HALEKOU I.C.

Scale: As Noted Date: August 1987


SHEET NO. 56 OF 35 SHEETS




| FED. ROAD DIST. NO. | STATE | FED. AID PROJ. NO. | FISCAL YEAR | SHEET NO. | TOTAL SHEETS |
|---------------------|-------|--------------------|-------------|-----------|--------------|
| HAWAII              | HAW.  | I-H3-1(50)         | 1989        | 88        | 164          |

# REFERENCE NOTE:

1. Bridge deck & superstructure not shown.
2. For conc. seat hinge blk., creep blk. & elastomeric bearing pad details see sht. #522, 523.
3. For concrete end post detail see sht. #521.
4. For pile spacings and location see Foundation Plan, sht. #53.
5. Top Seat El. Schedule sht. #522.

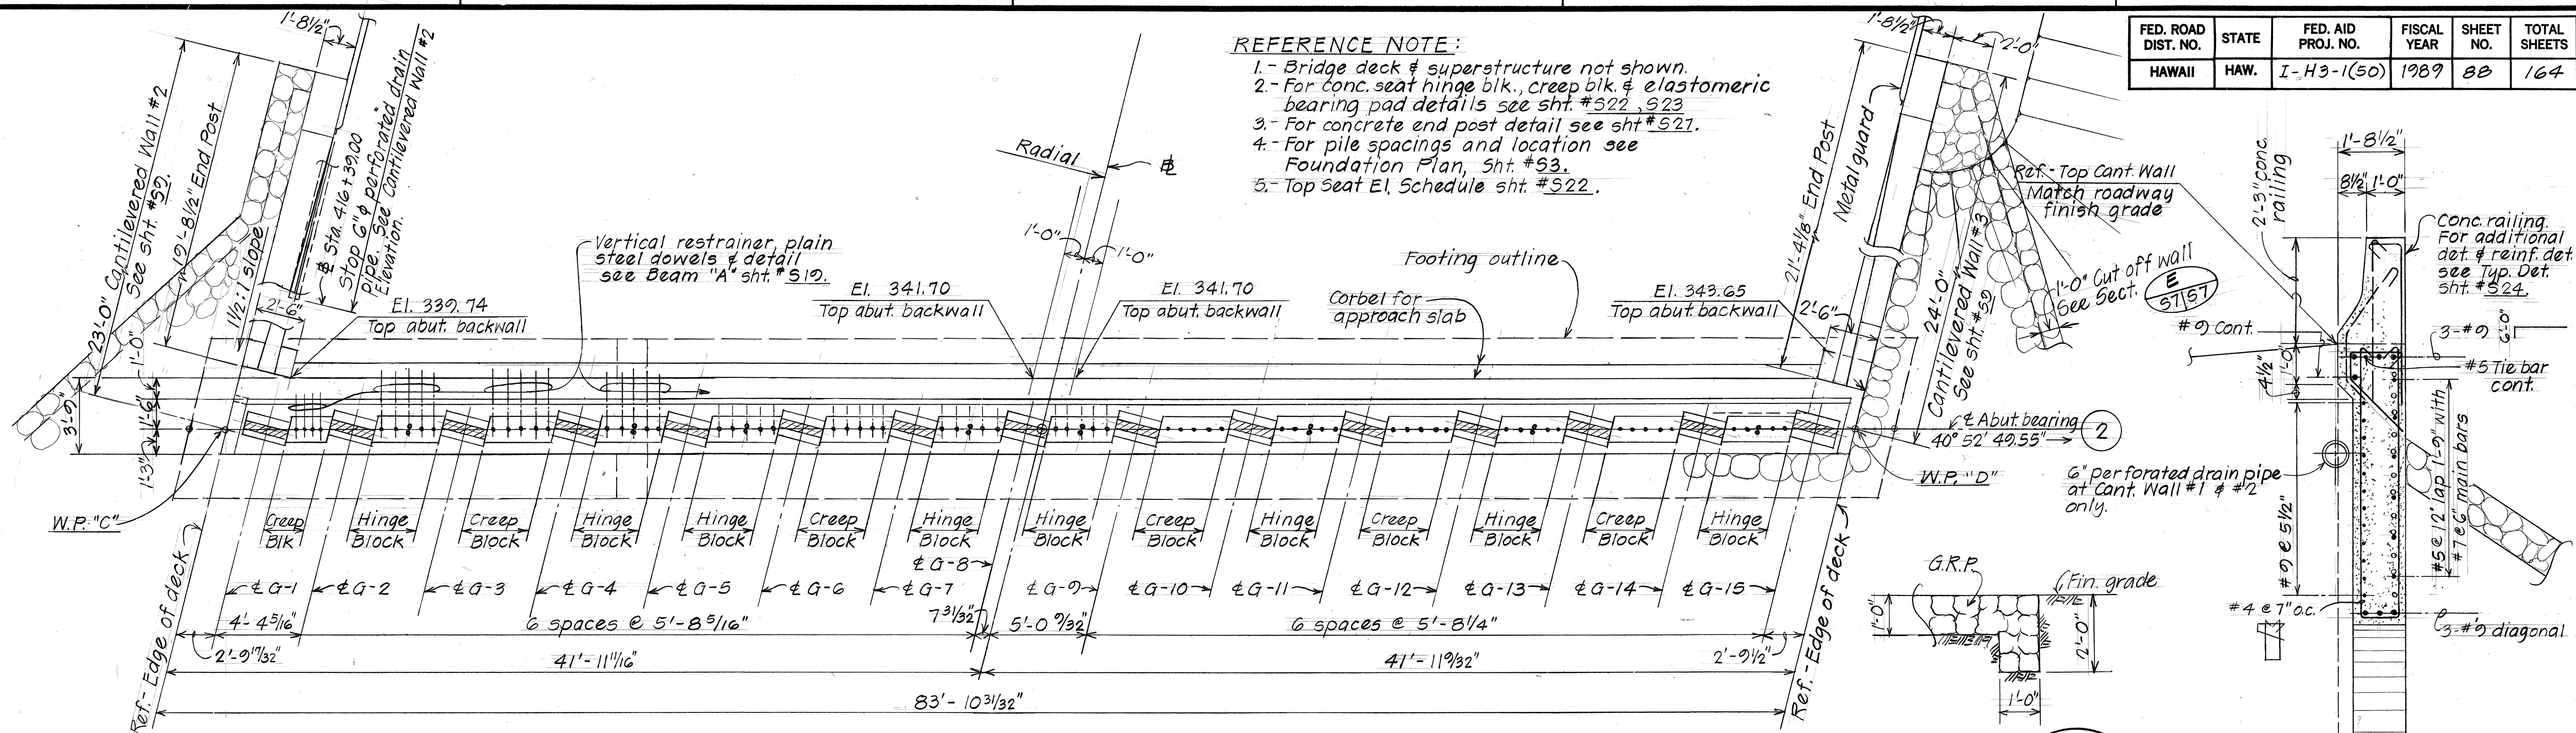


PLAN - ABUTMENT ② Scale: 1/4" = 1'-0"

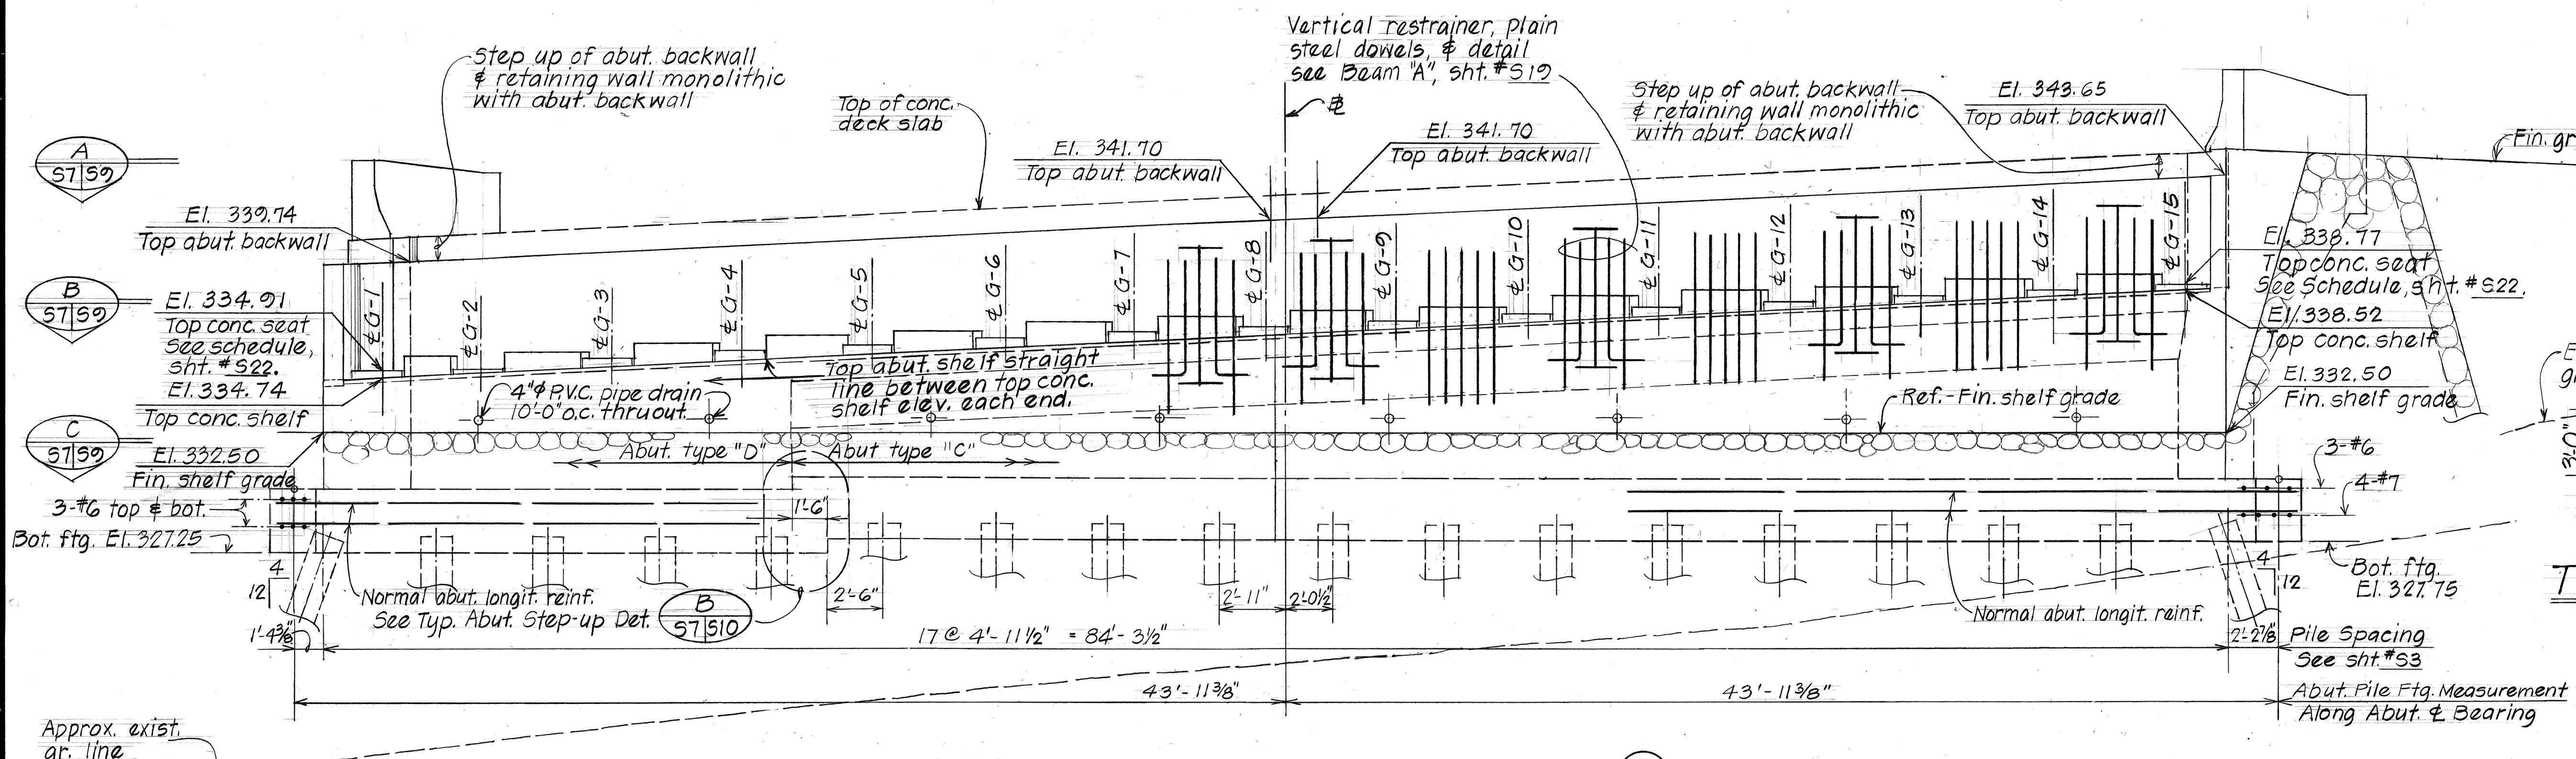

ELEVATION - ABUTMENT ② Scale: 1/4" = 1'-0"

SECTION G Scale: 1/2" = 1'-0"




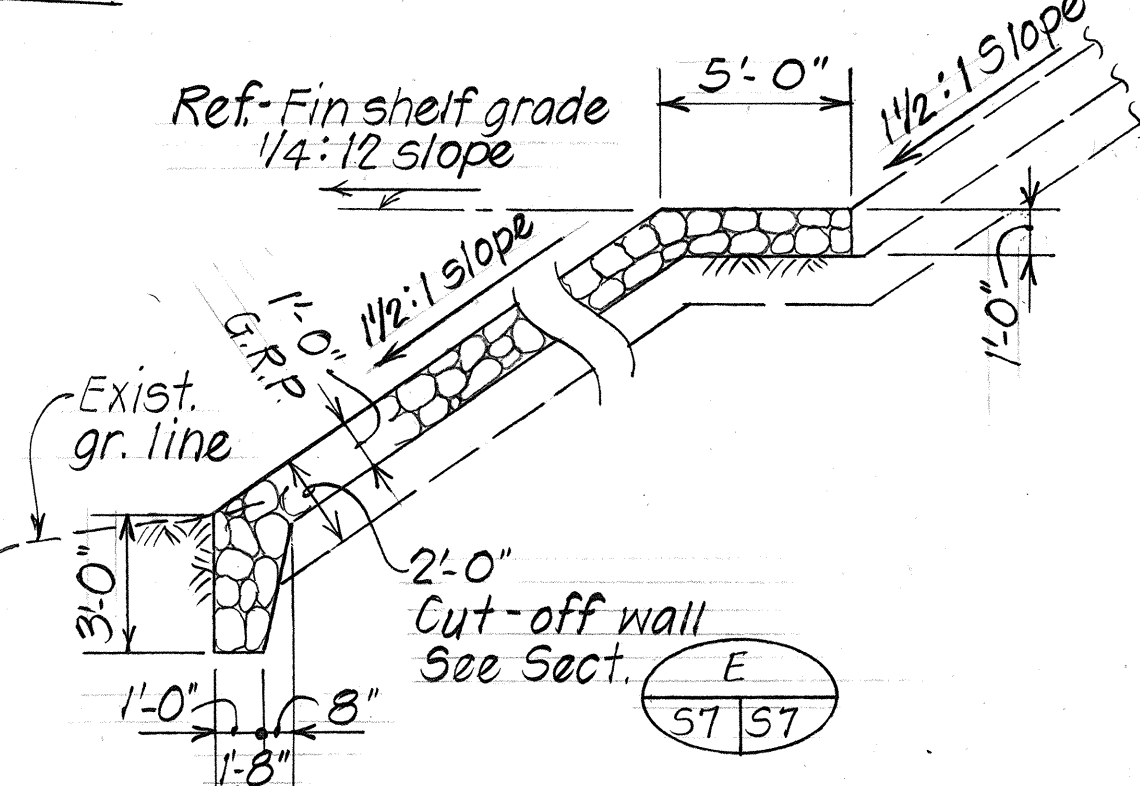


TYPICAL G.R.P. SECTION AT ABUTMENT Scale: 1/4" = 1'-0"

|                                                                                                                                                                                                                                                                                                |
|------------------------------------------------------------------------------------------------------------------------------------------------------------------------------------------------------------------------------------------------------------------------------------------------|
| STATE OF HAWAII<br>DEPARTMENT OF TRANSPORTATION<br>LAND TRANSPORTATION FACILITIES DIVISION<br>ROUTE H-3 - KUOU STREAM BRIDGE<br>ABUTMENT ② - PLAN & ELEVATION<br>E.A.I. Proj. No. I-H3-1(50)<br>KANEHOE I.C. TO HALEKOU I.C.<br>Scale: As Noted Date: August 1987<br>SHEET NO. 57 OF 35 SHEETS |
|------------------------------------------------------------------------------------------------------------------------------------------------------------------------------------------------------------------------------------------------------------------------------------------------|






| FED. ROAD DIST. NO. | STATE | FED. AID PROJ. NO. | FISCAL YEAR | SHEET NO. | TOTAL SHEETS |
|---------------------|-------|--------------------|-------------|-----------|--------------|
| HAWAII              | HAW.  | I-H3-1(50)         | 1987        | ADD.89    | 164          |

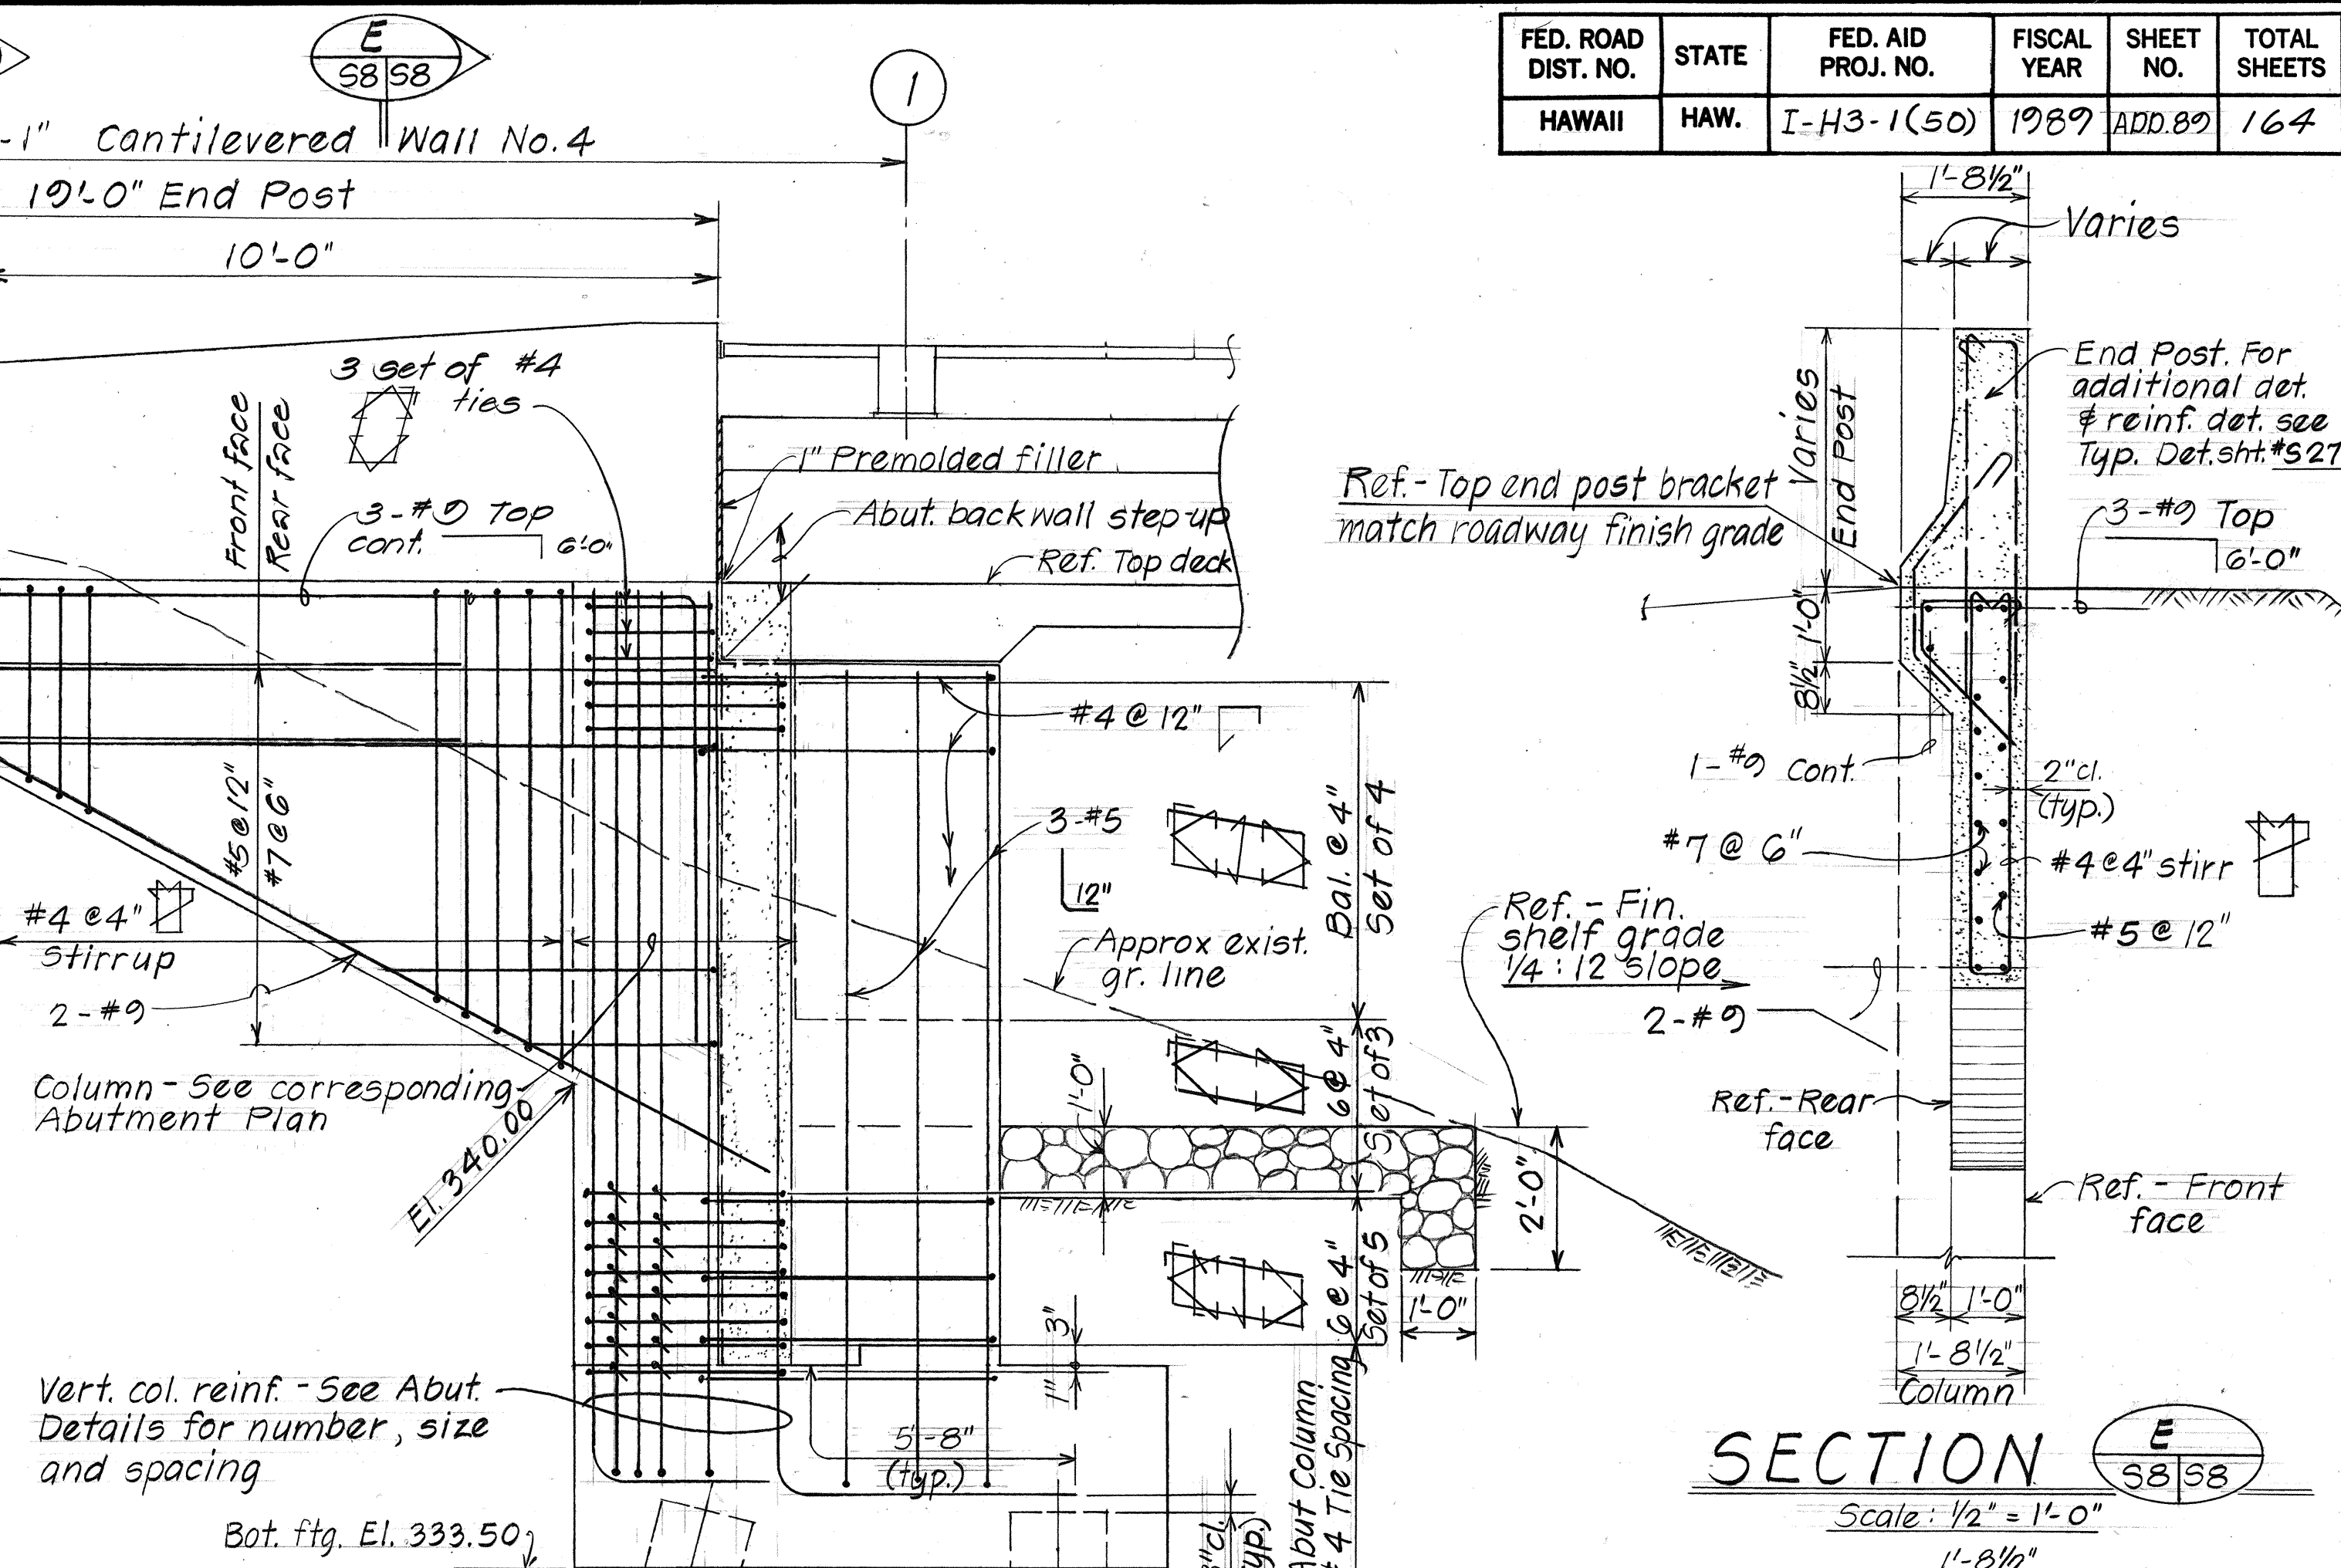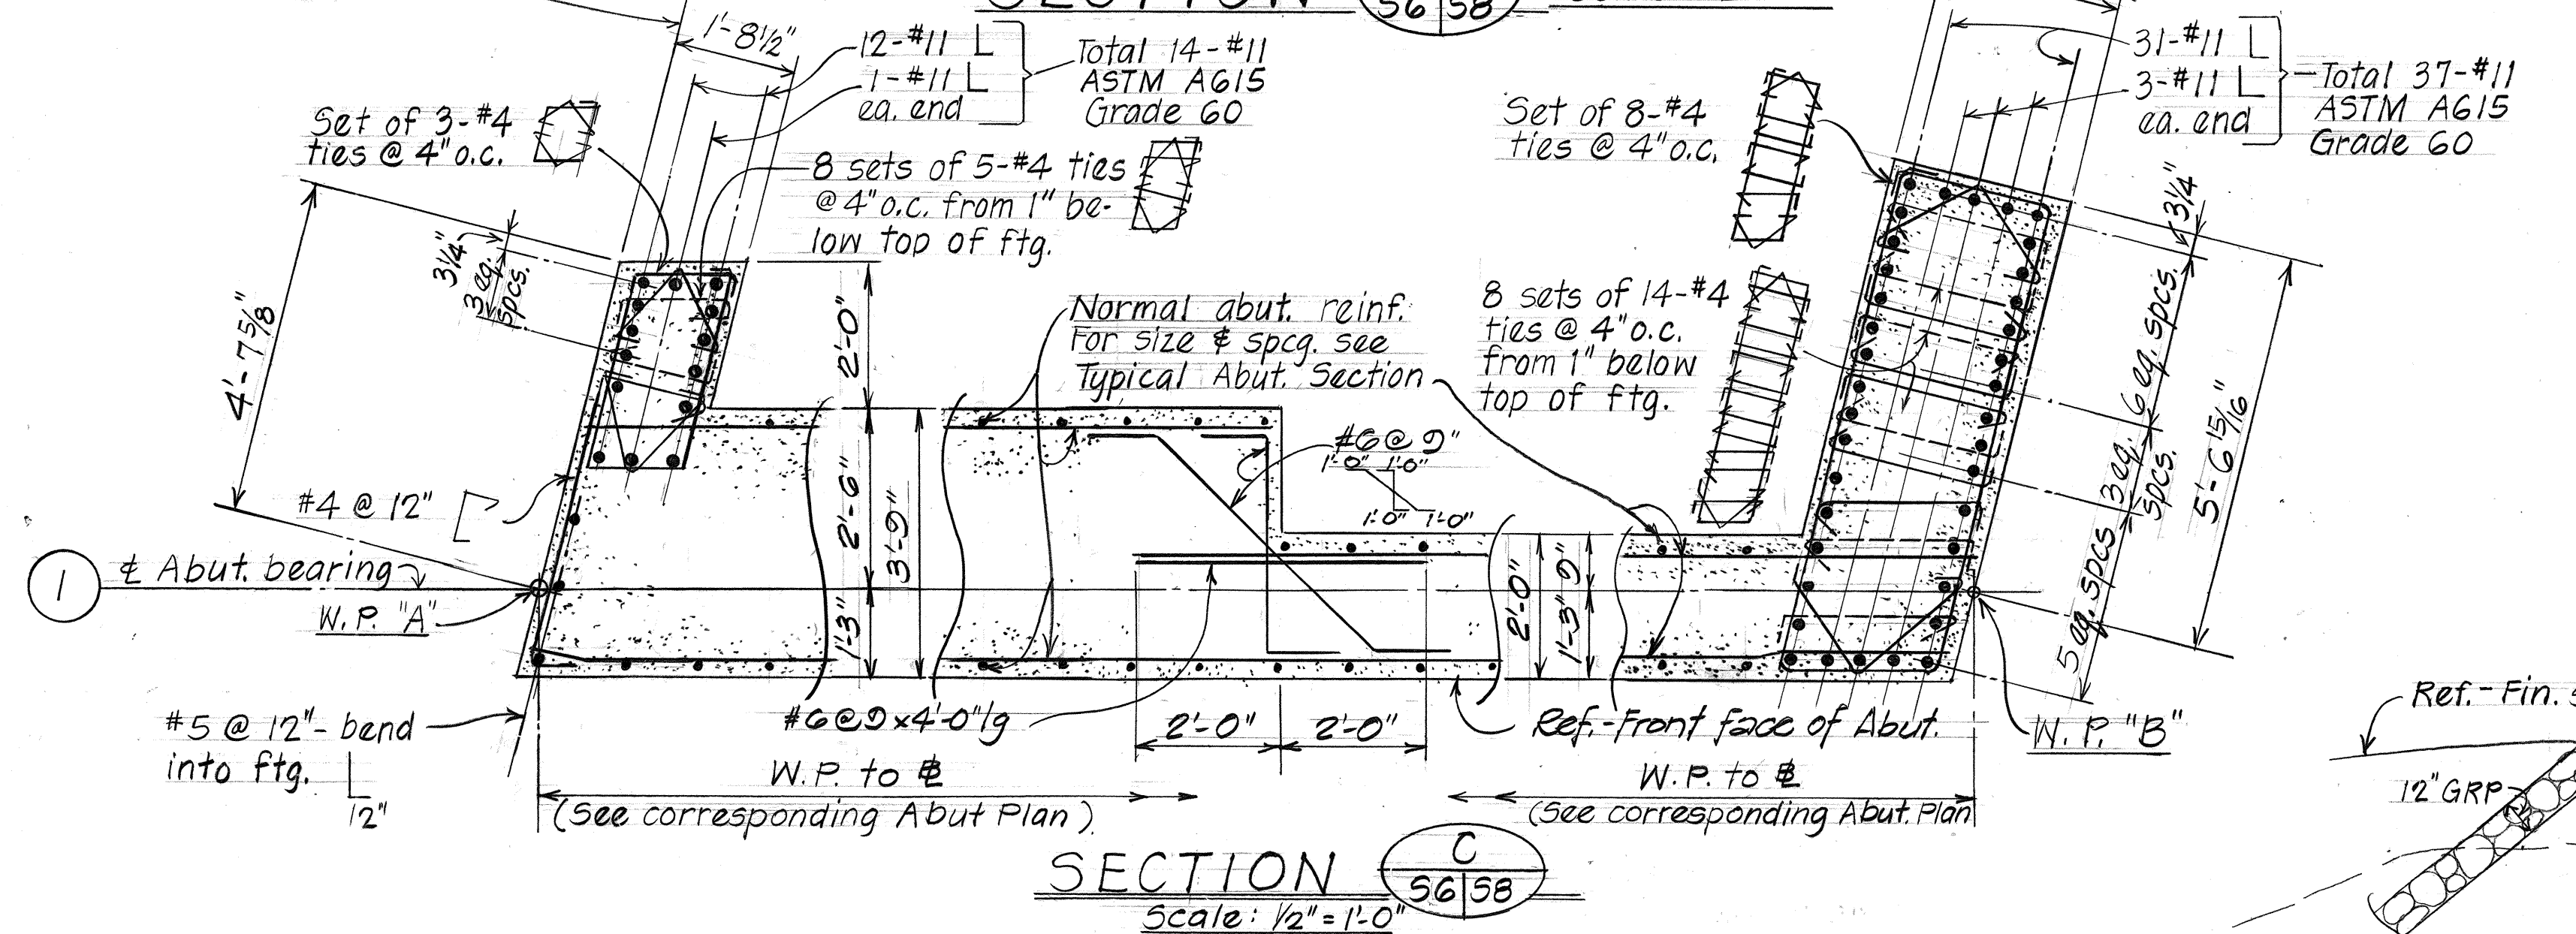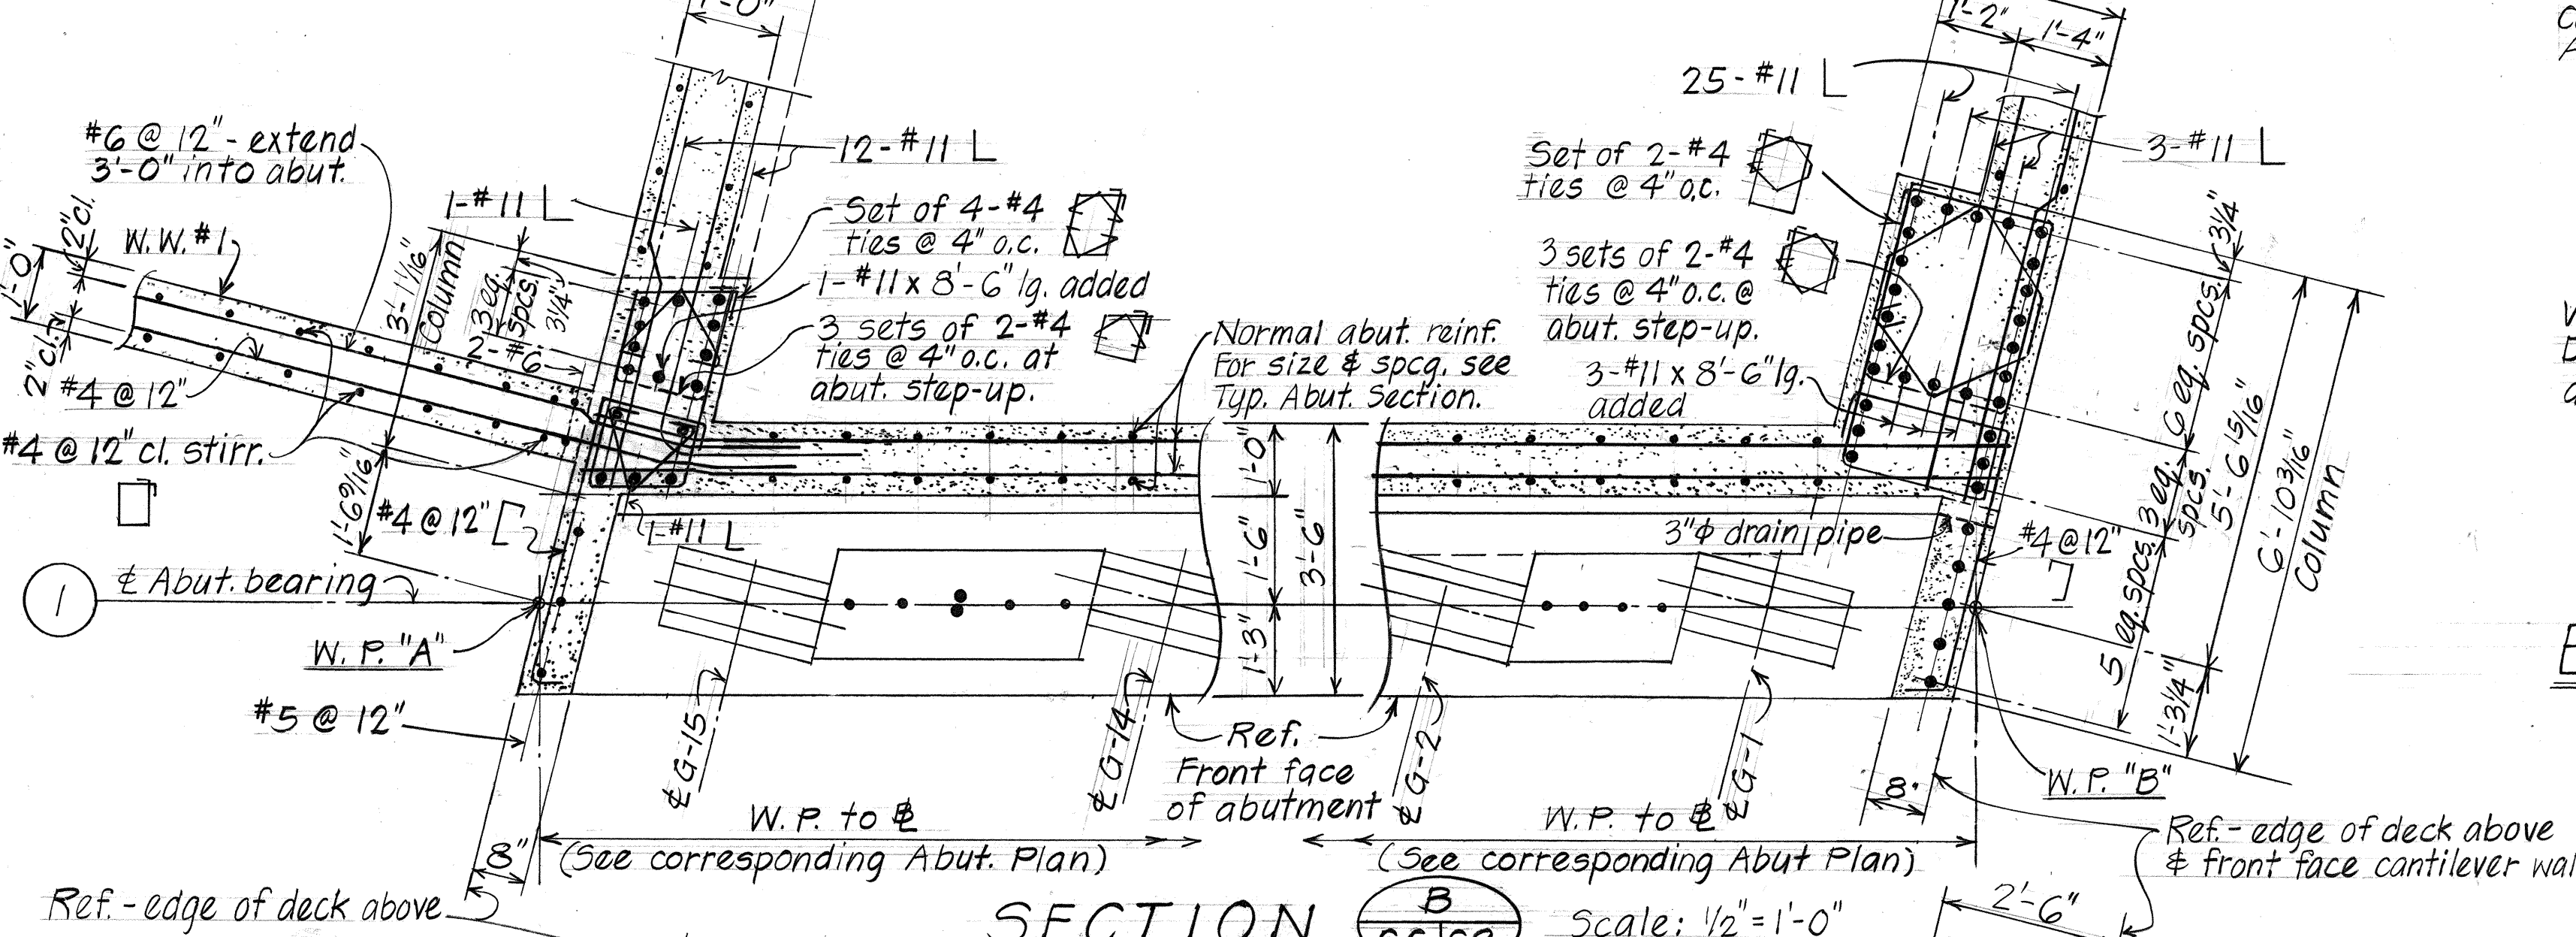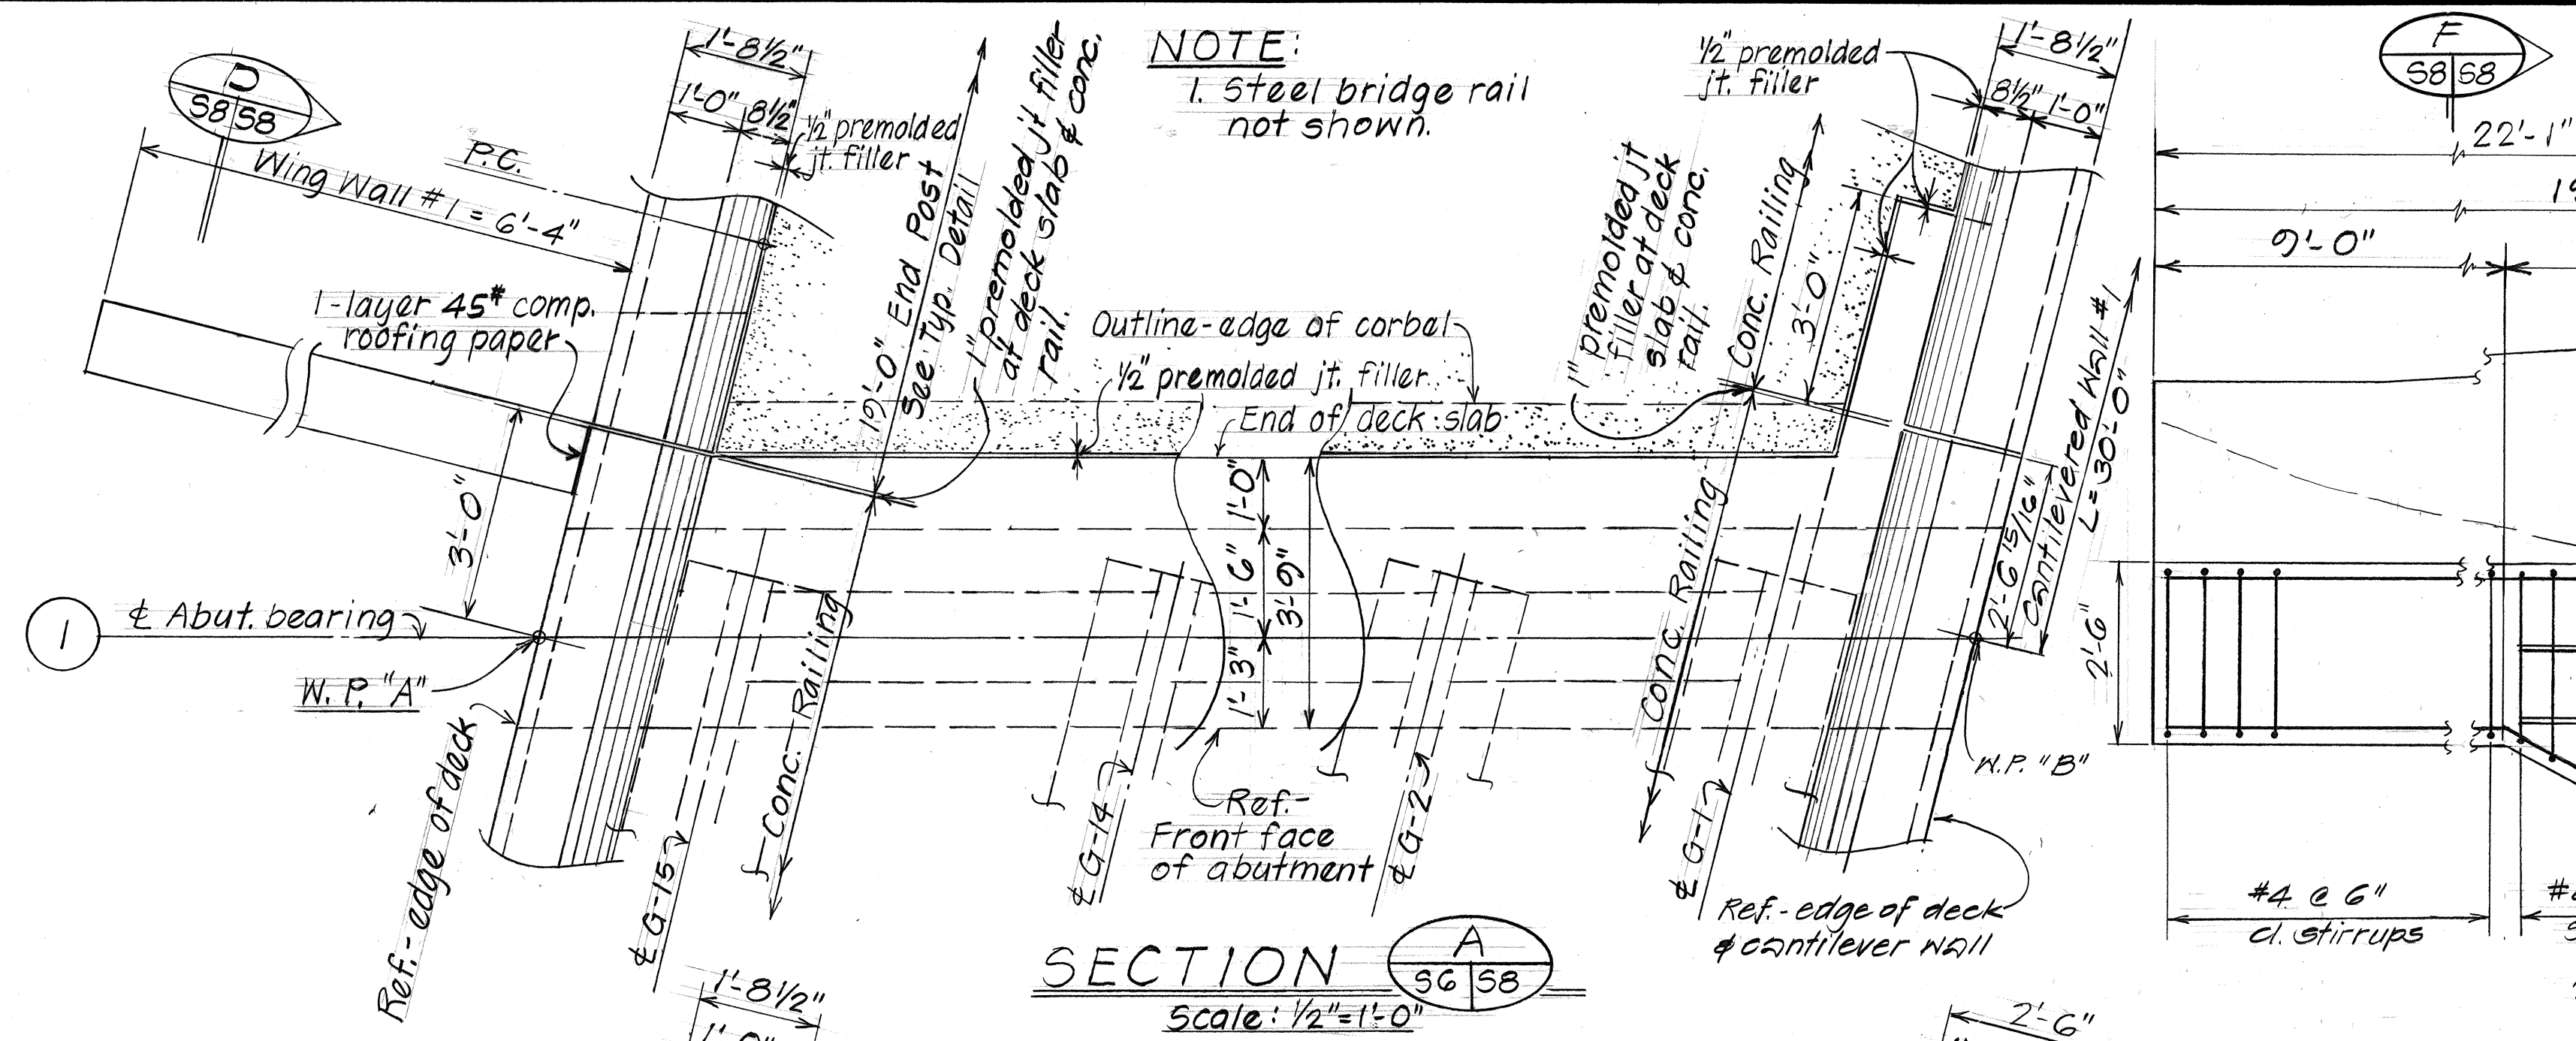

### ELEVATION - CANTILEVERED WALL NO. 4

(ABUT. COLUMN & END POST BRACKET)  
Scale: 1/2" = 1'-0"



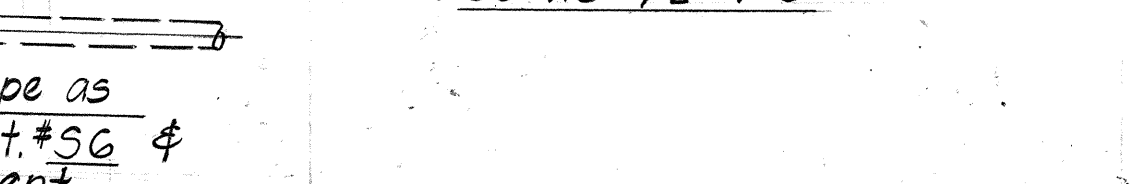
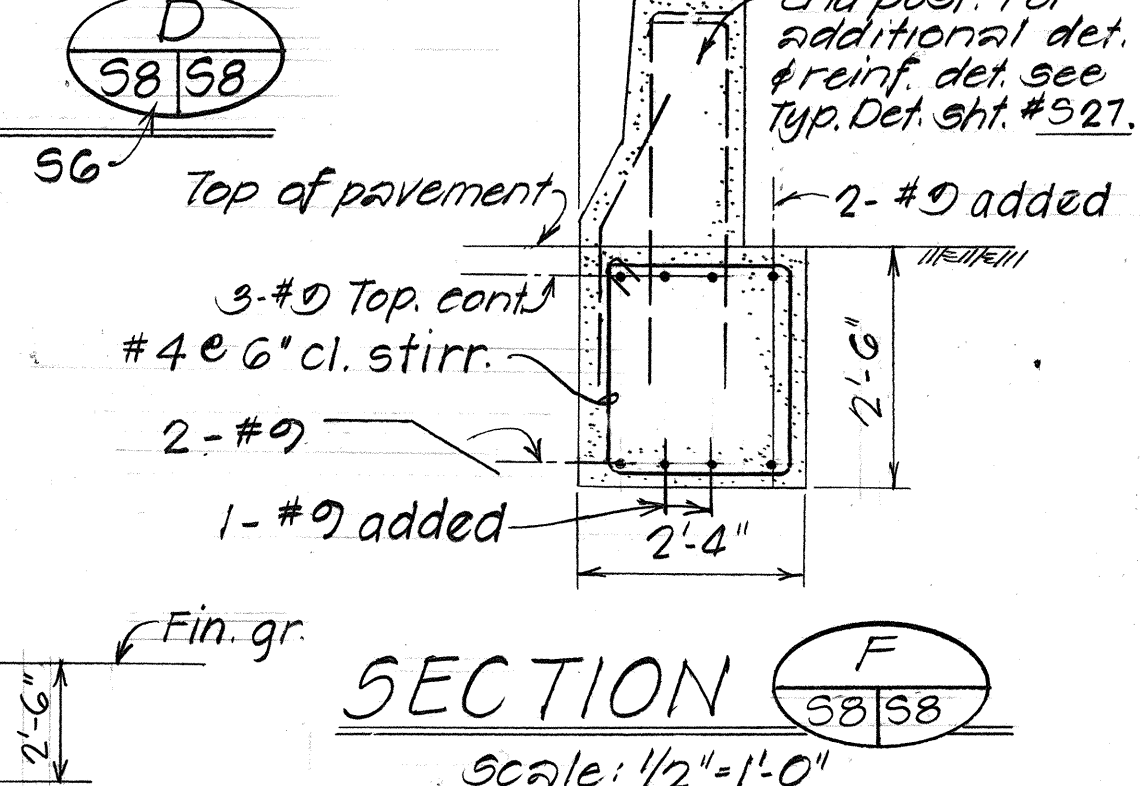
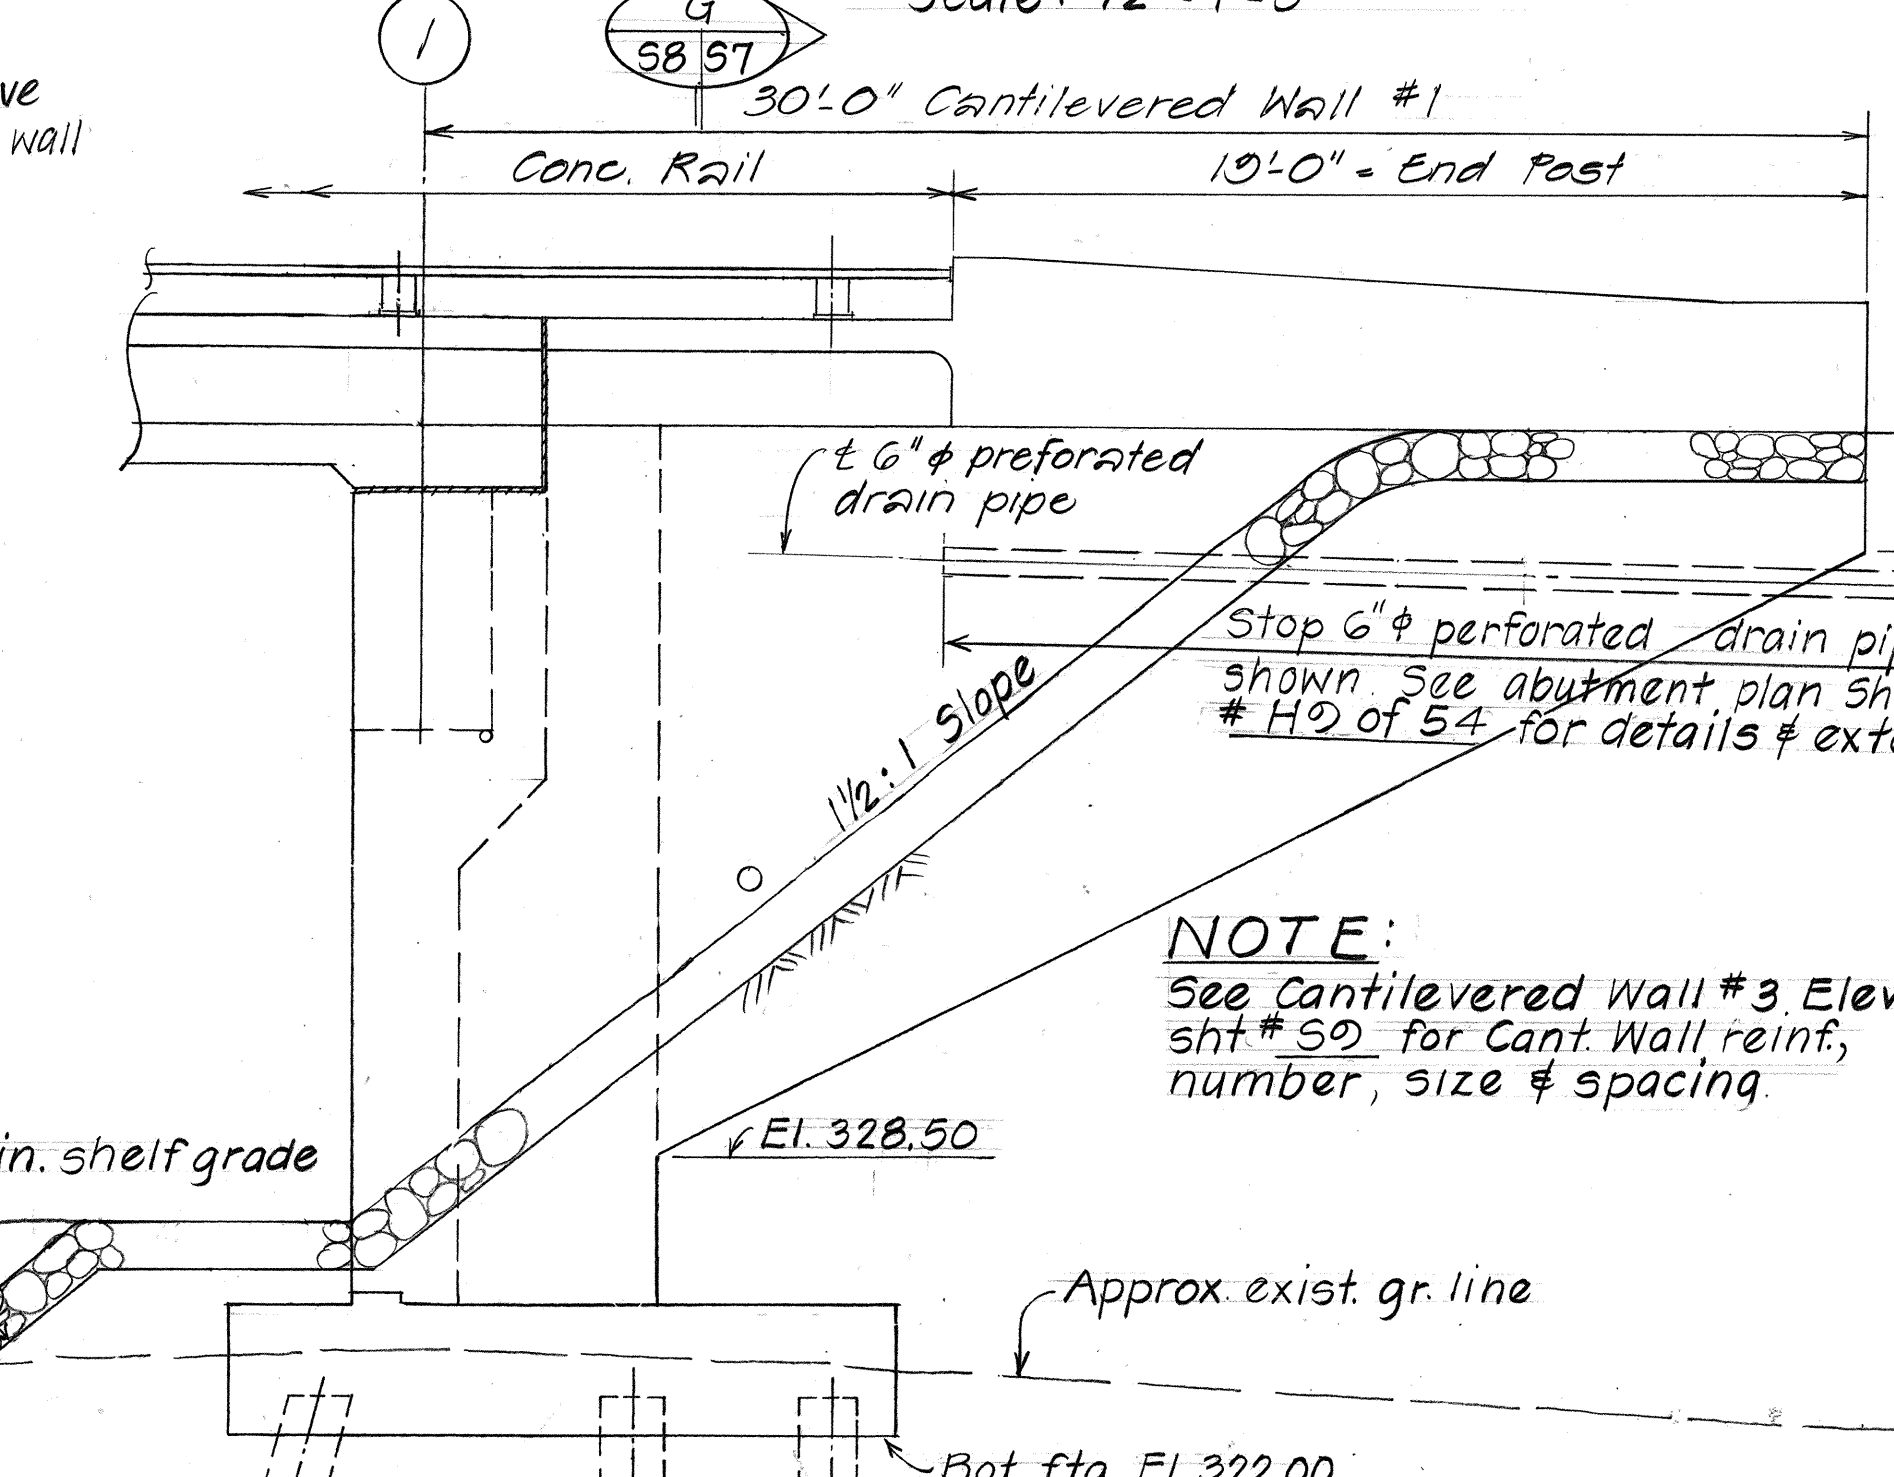


| 3/2/87                                                                                                                                                                                                                                                                                                                                                | Revised plan sheet reference number |
|-------------------------------------------------------------------------------------------------------------------------------------------------------------------------------------------------------------------------------------------------------------------------------------------------------------------------------------------------------|-------------------------------------|
| DATE                                                                                                                                                                                                                                                                                                                                                  | REVISION                            |
| STATE OF HAWAII<br>DEPARTMENT OF TRANSPORTATION<br>LAND TRANSPORTATION FACILITIES DIVISION<br><b>ROUTE H-3 - KUOU STREAM BRIDGE</b><br><b>ABUTMENT ① - SECTIONS</b><br><b>CANTILEVERED WALL #1, END POST BRACKET</b><br>E.A.I. Proj. No. I-H3-1(50)<br>KANEOHE I.C. TO HALEKOU I.C.<br>Scale: As Noted Date: August 1987<br>SHEET No. 98 OF 35 SHEETS |                                     |

ADD.89



| FED. ROAD DIST. NO. | STATE | FED. AID PROJ. NO. | FISCAL YEAR | SHEET NO. | TOTAL SHEETS |
|---------------------|-------|--------------------|-------------|-----------|--------------|
| HAWAII              | HAW.  | I-H3-1(50)         | 1987        | ADD.90    | 164          |

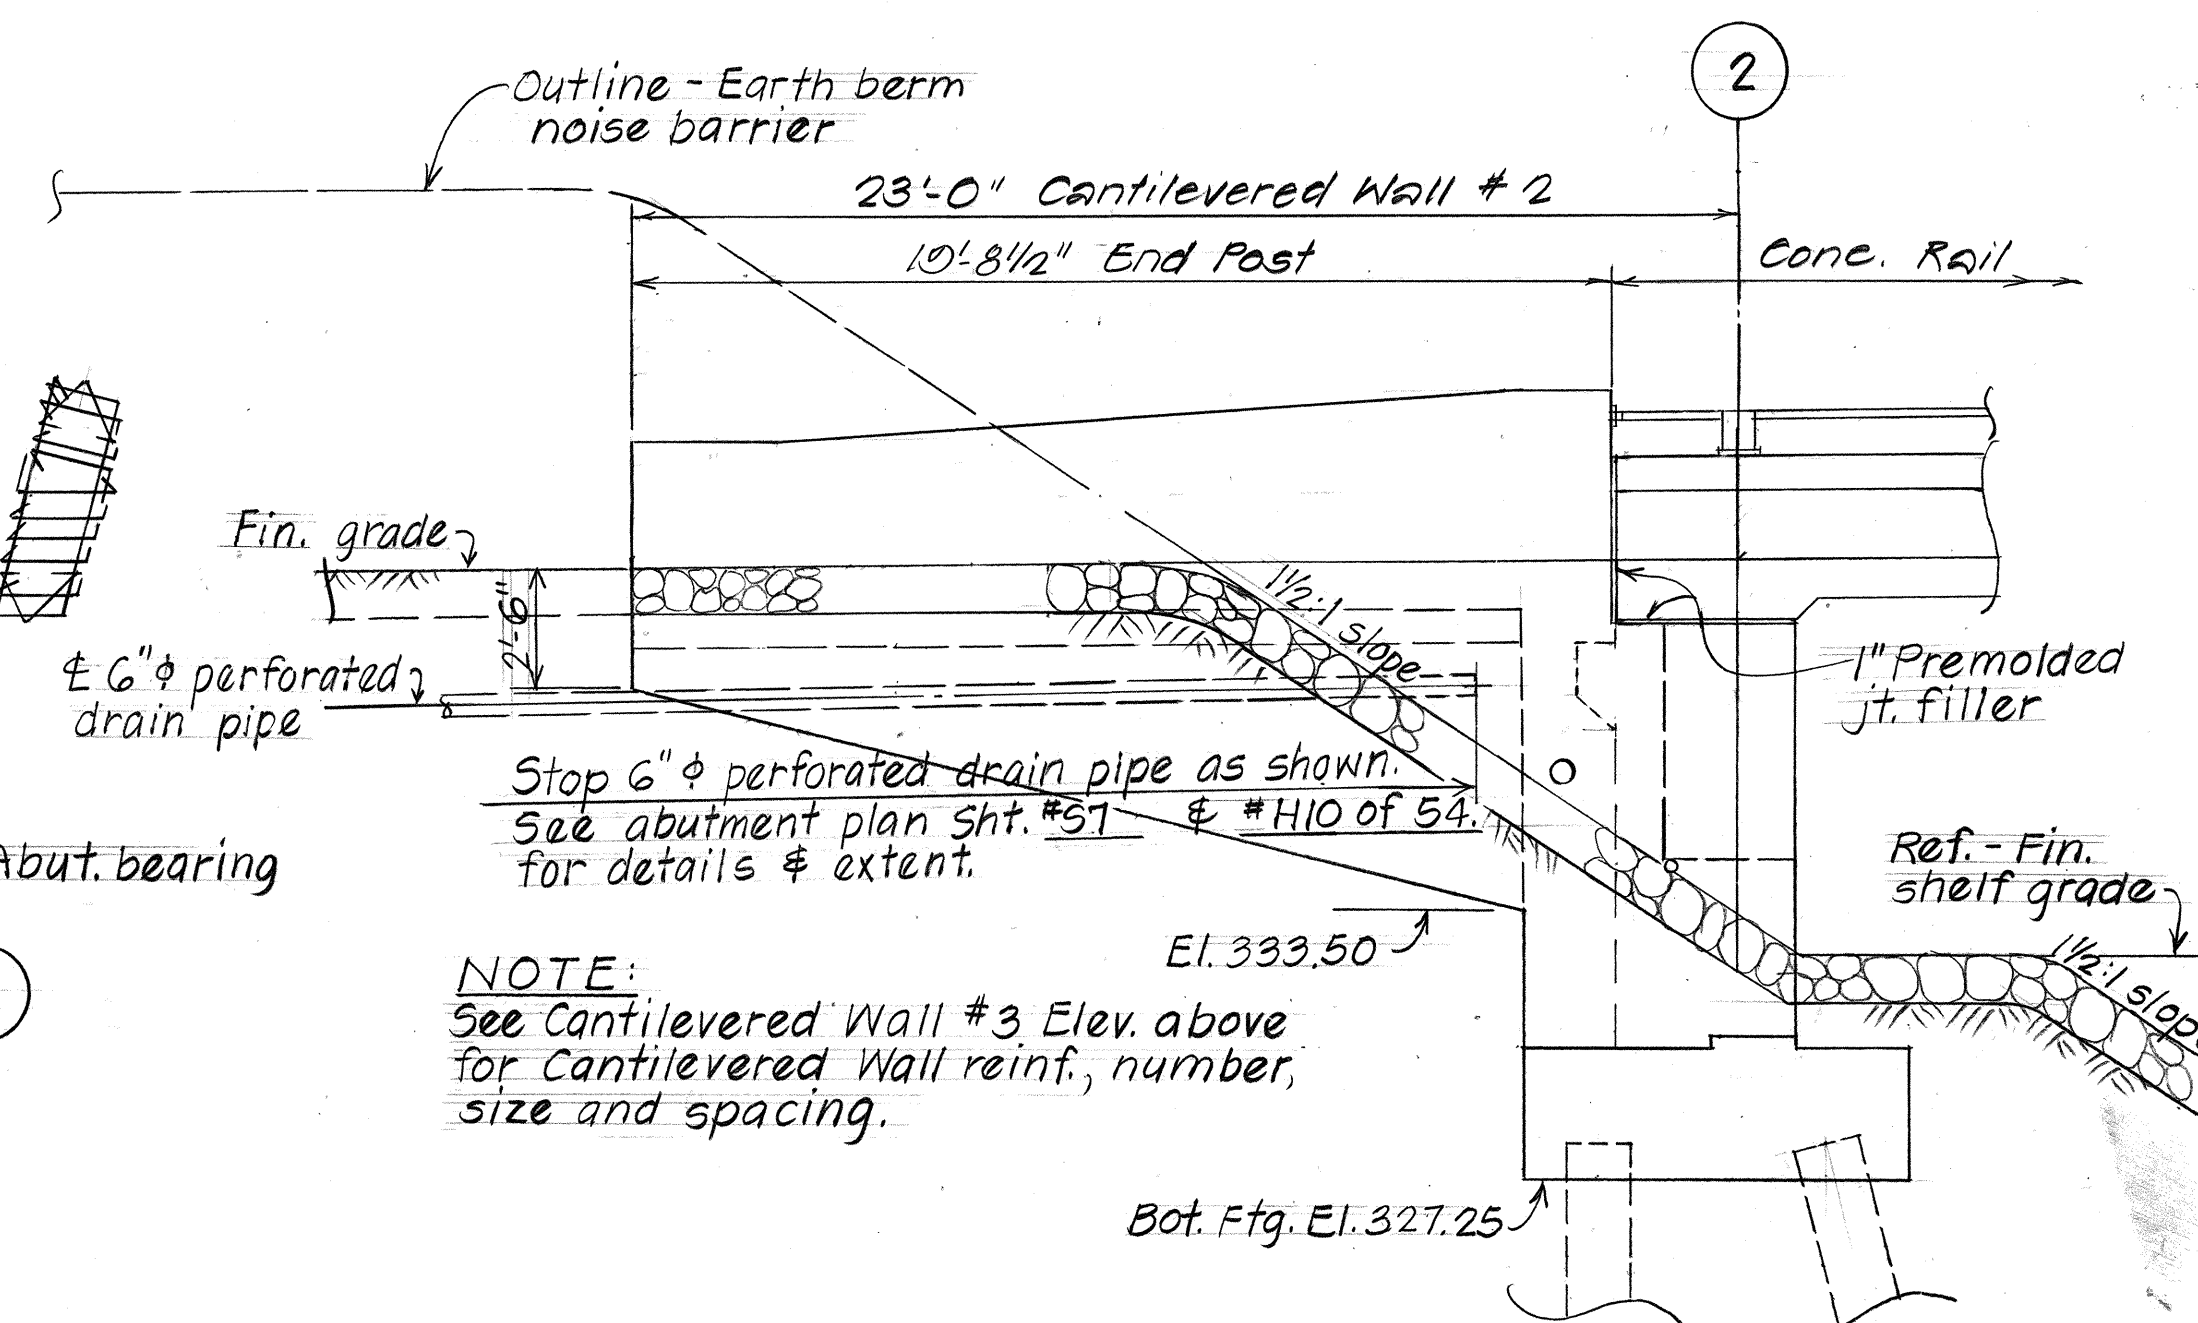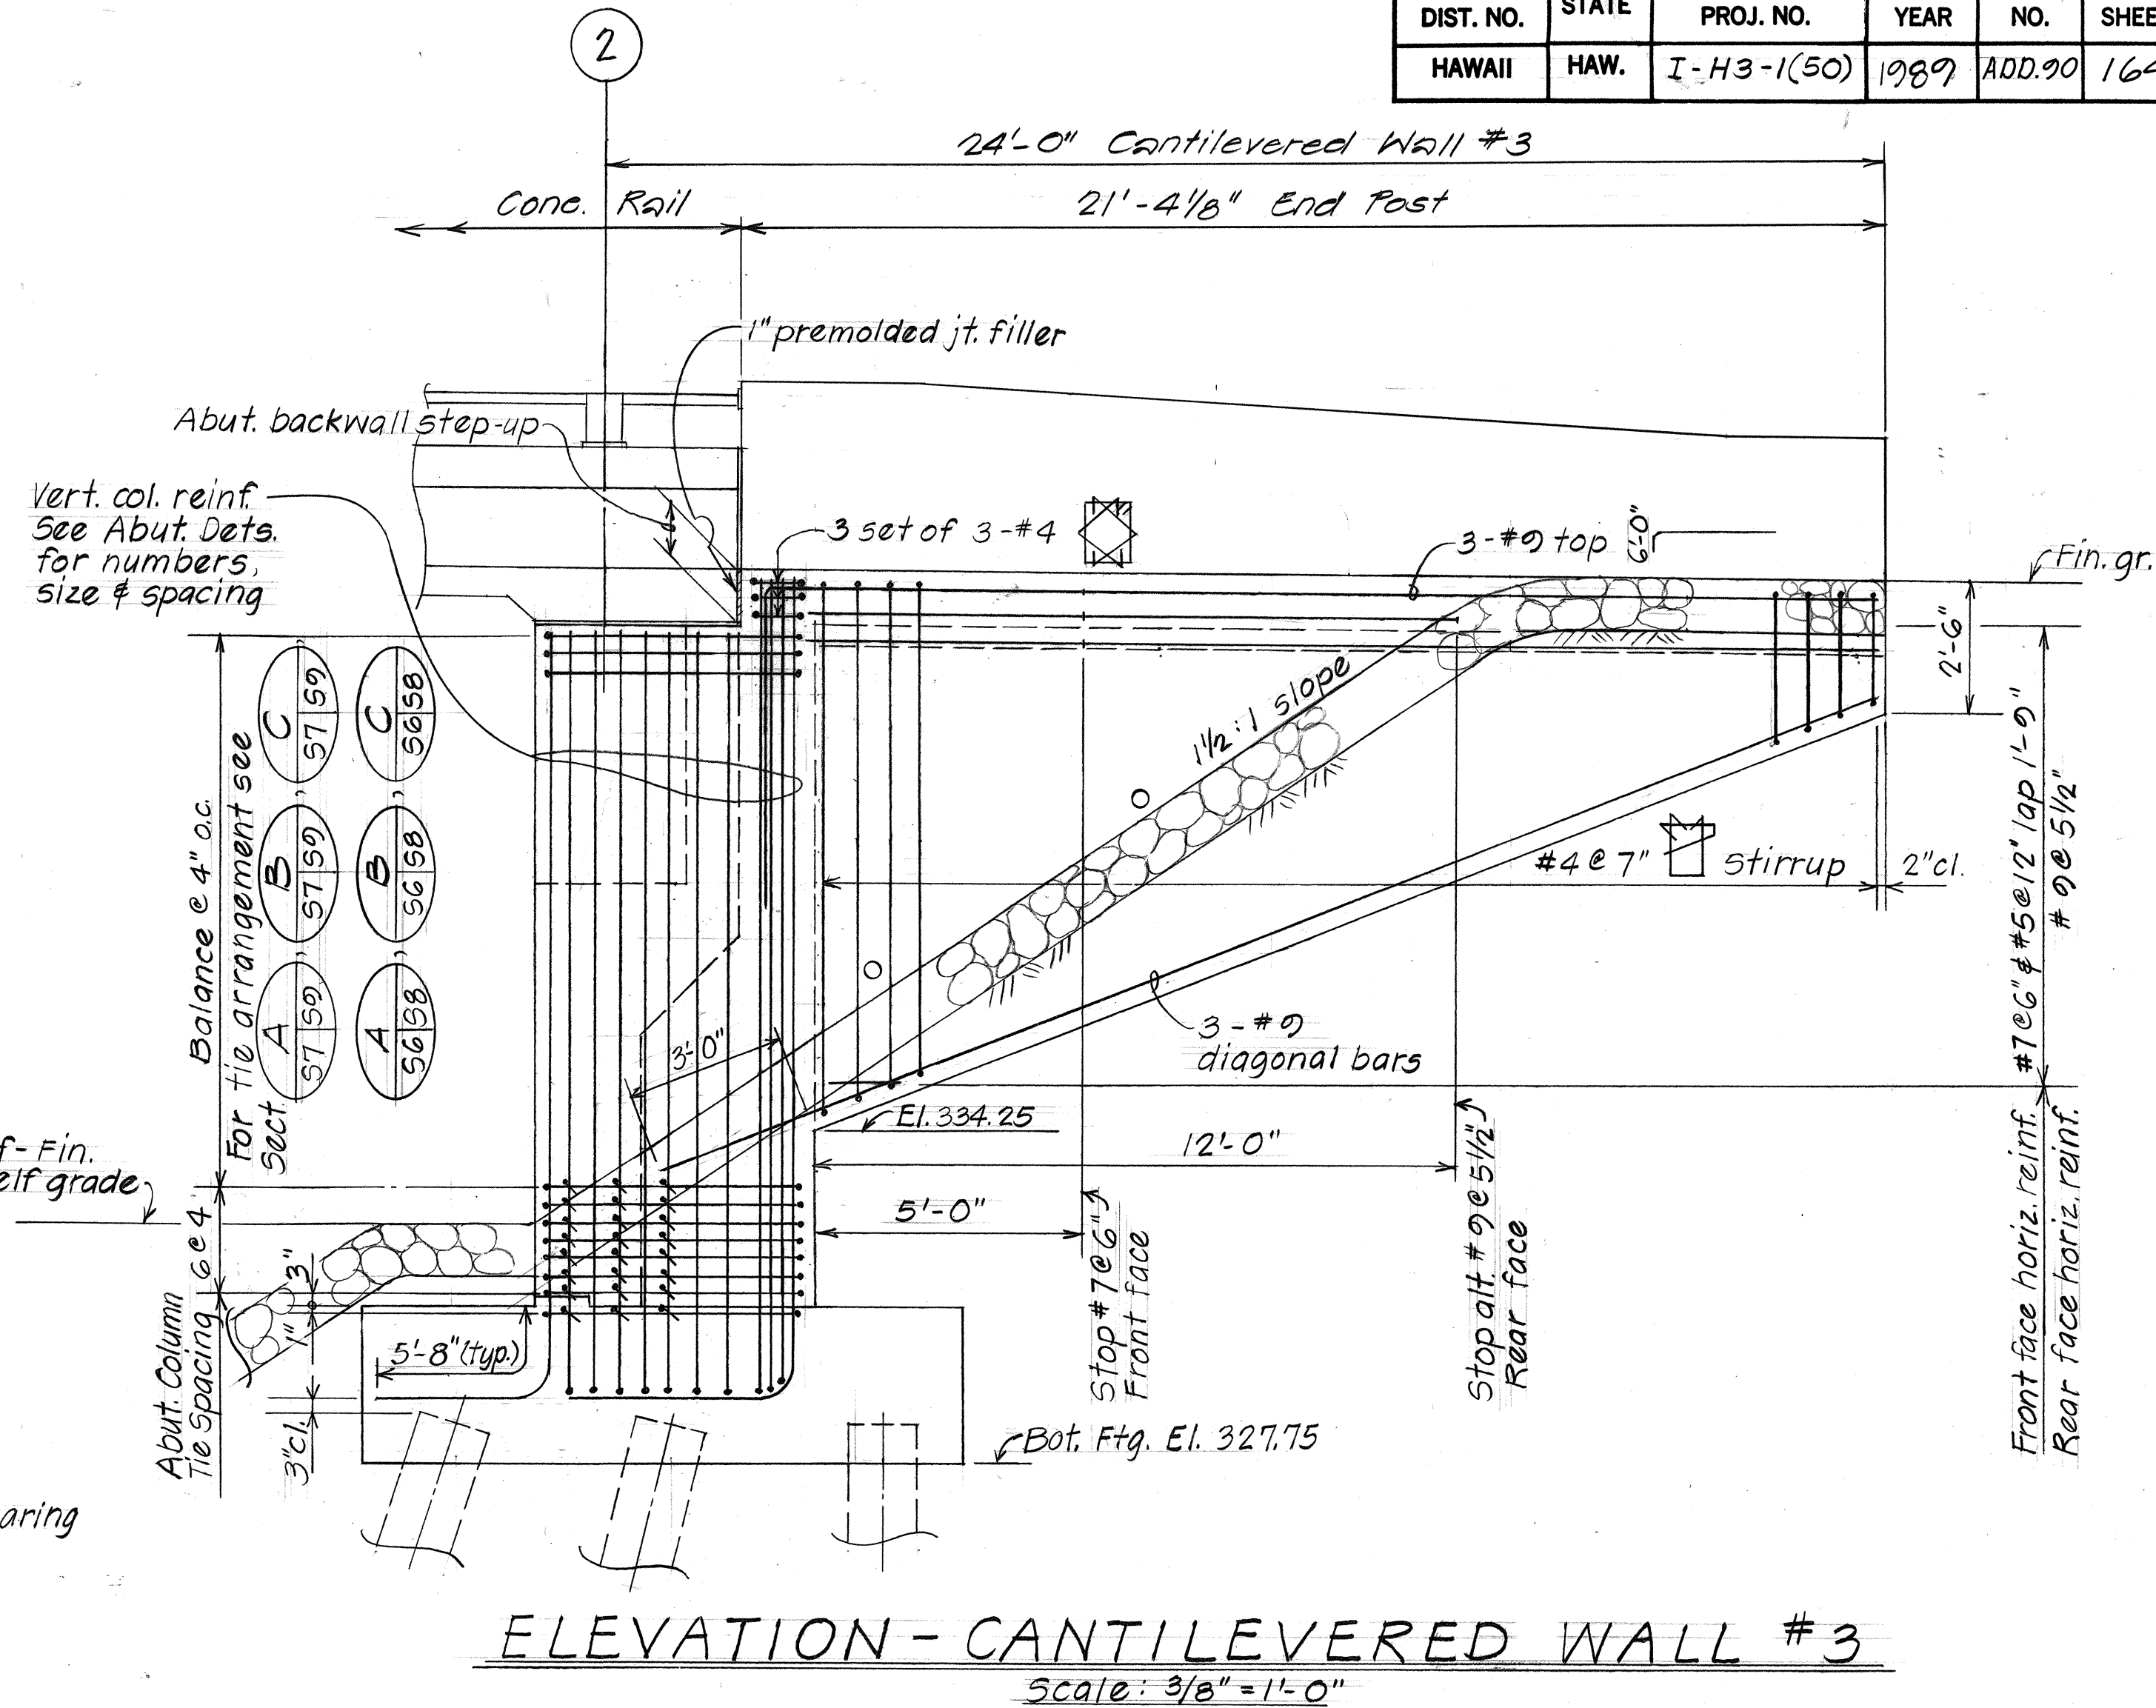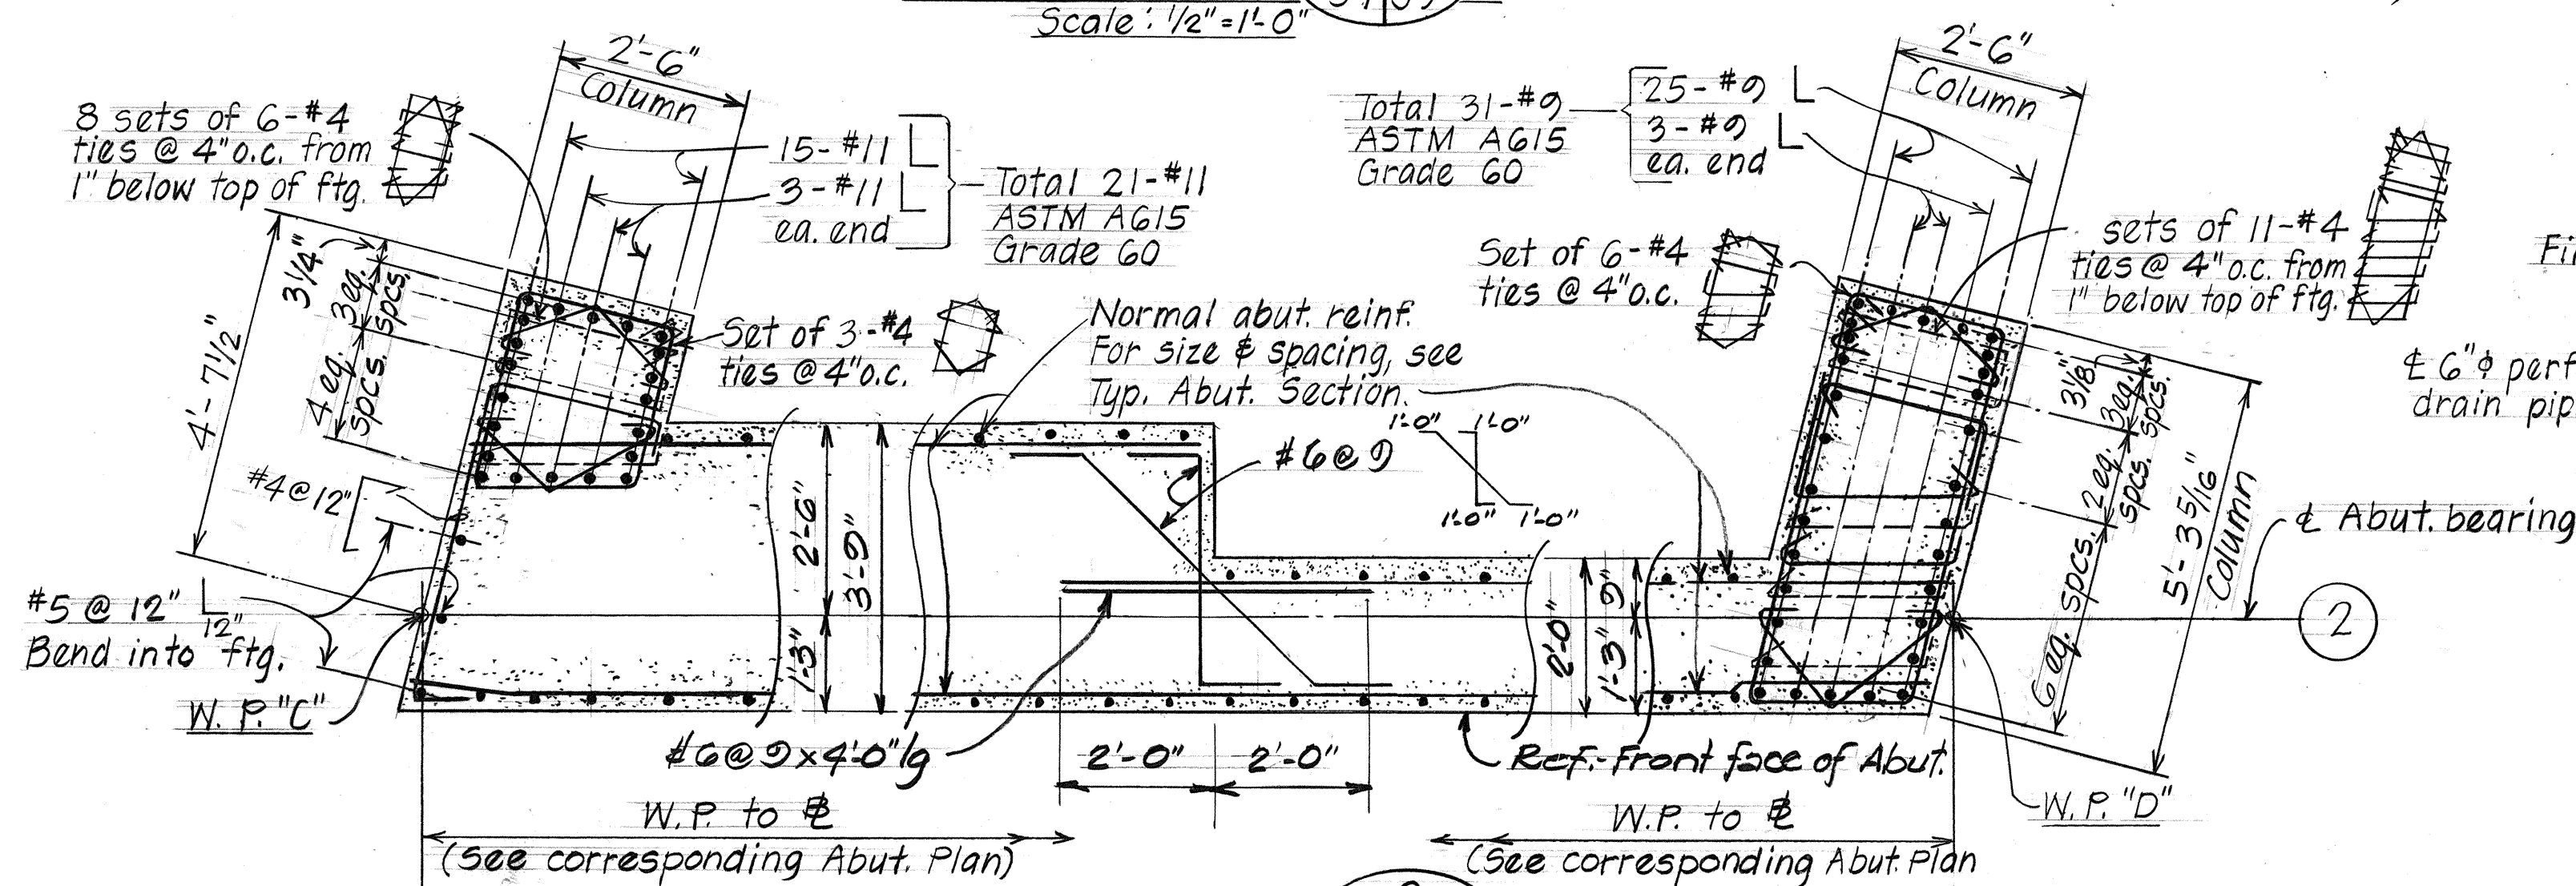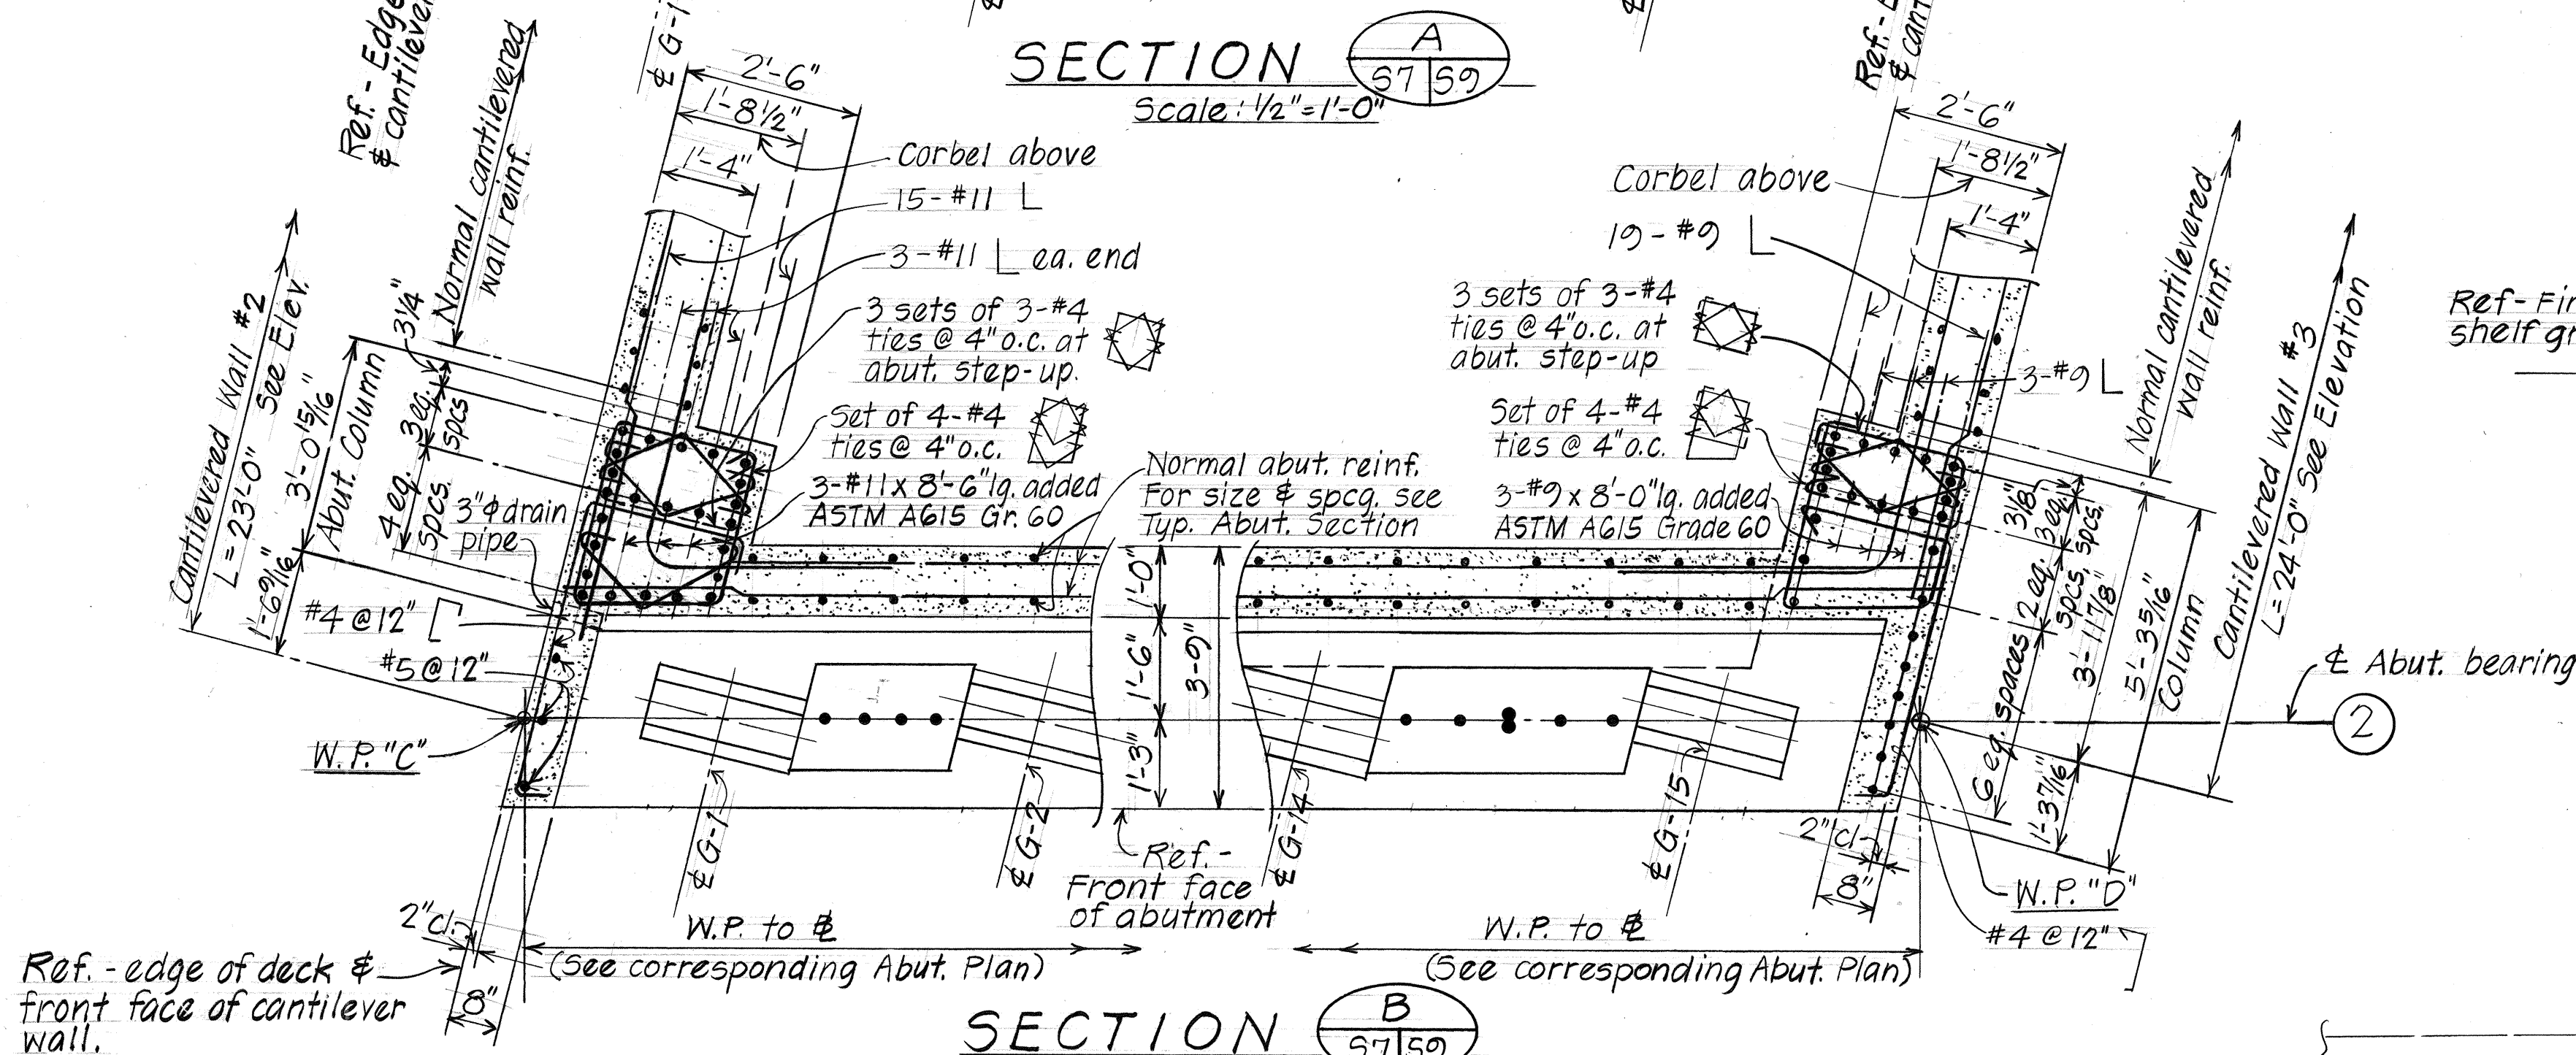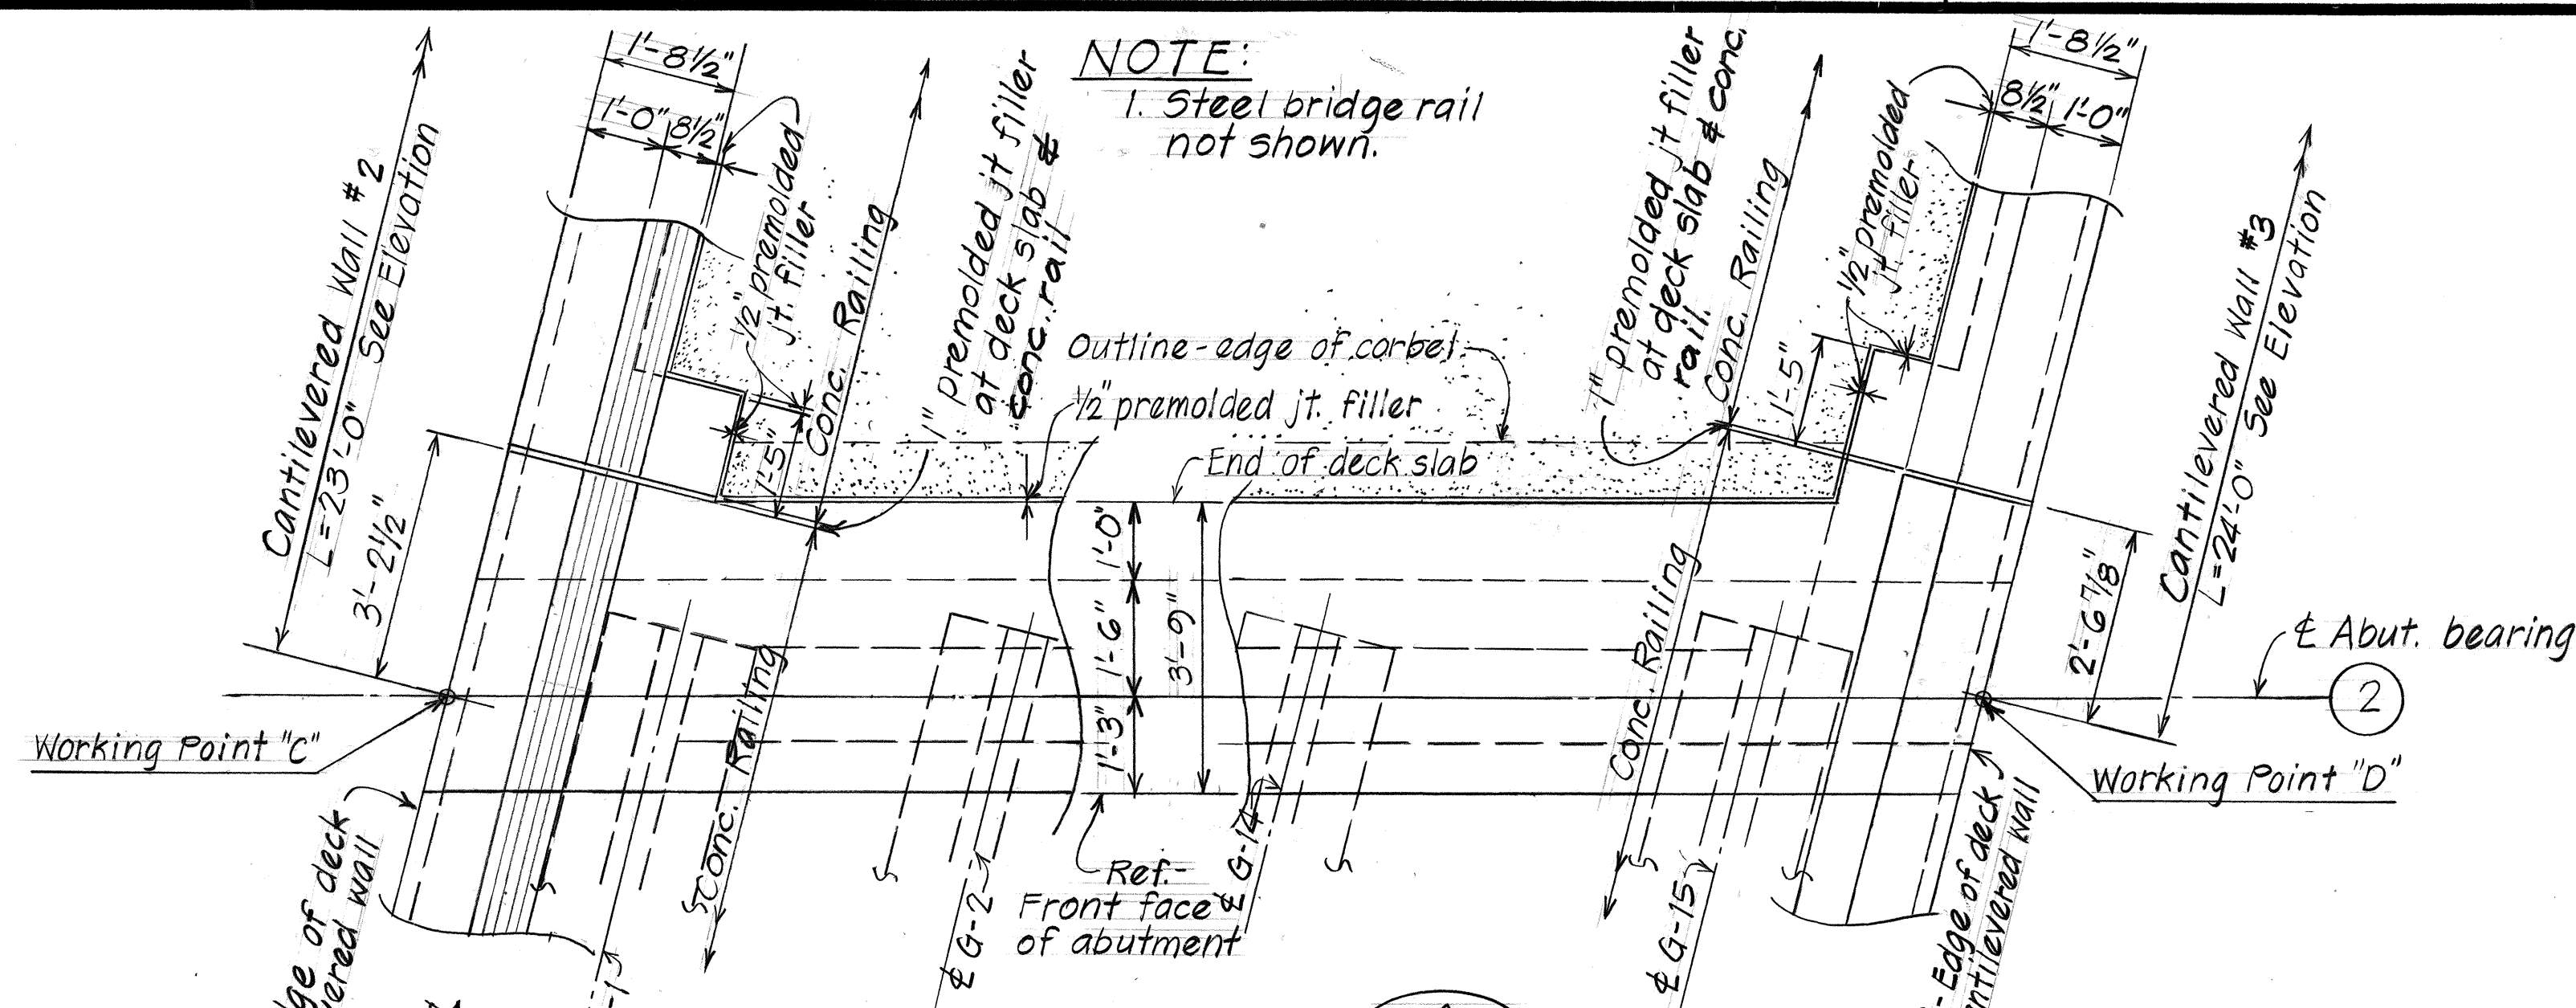


| DATE                                                                                                                                                                                                                                                                                                                | REVISION                            |
|---------------------------------------------------------------------------------------------------------------------------------------------------------------------------------------------------------------------------------------------------------------------------------------------------------------------|-------------------------------------|
| 3/2/87                                                                                                                                                                                                                                                                                                              | Revised plan sheet reference number |
| STATE OF HAWAII<br>DEPARTMENT OF TRANSPORTATION<br>LAND TRANSPORTATION FACILITIES DIVISION<br>ROUTE H-3 - KUOU STREAM BRIDGE<br>ABUTMENT ② - SECTIONS<br>CANTILEVERED WALL #2 & #3<br>F.A.I. Proj. No. I-H3-1(50)<br>KANEHOE I.C. TO HALEKOU I.C.<br>Scale: As Noted Date: August 1987<br>SHEET NO. 50 OF 35 SHEETS |                                     |




ADD.90



| FED. ROAD DIST. NO. | STATE | FED. AID PROJ. NO. | FISCAL YEAR | SHEET NO. | TOTAL SHEETS |
|---------------------|-------|--------------------|-------------|-----------|--------------|
| HAWAII              | HAW.  | I-H3-1(50)         | 1987        | 71        | 164          |

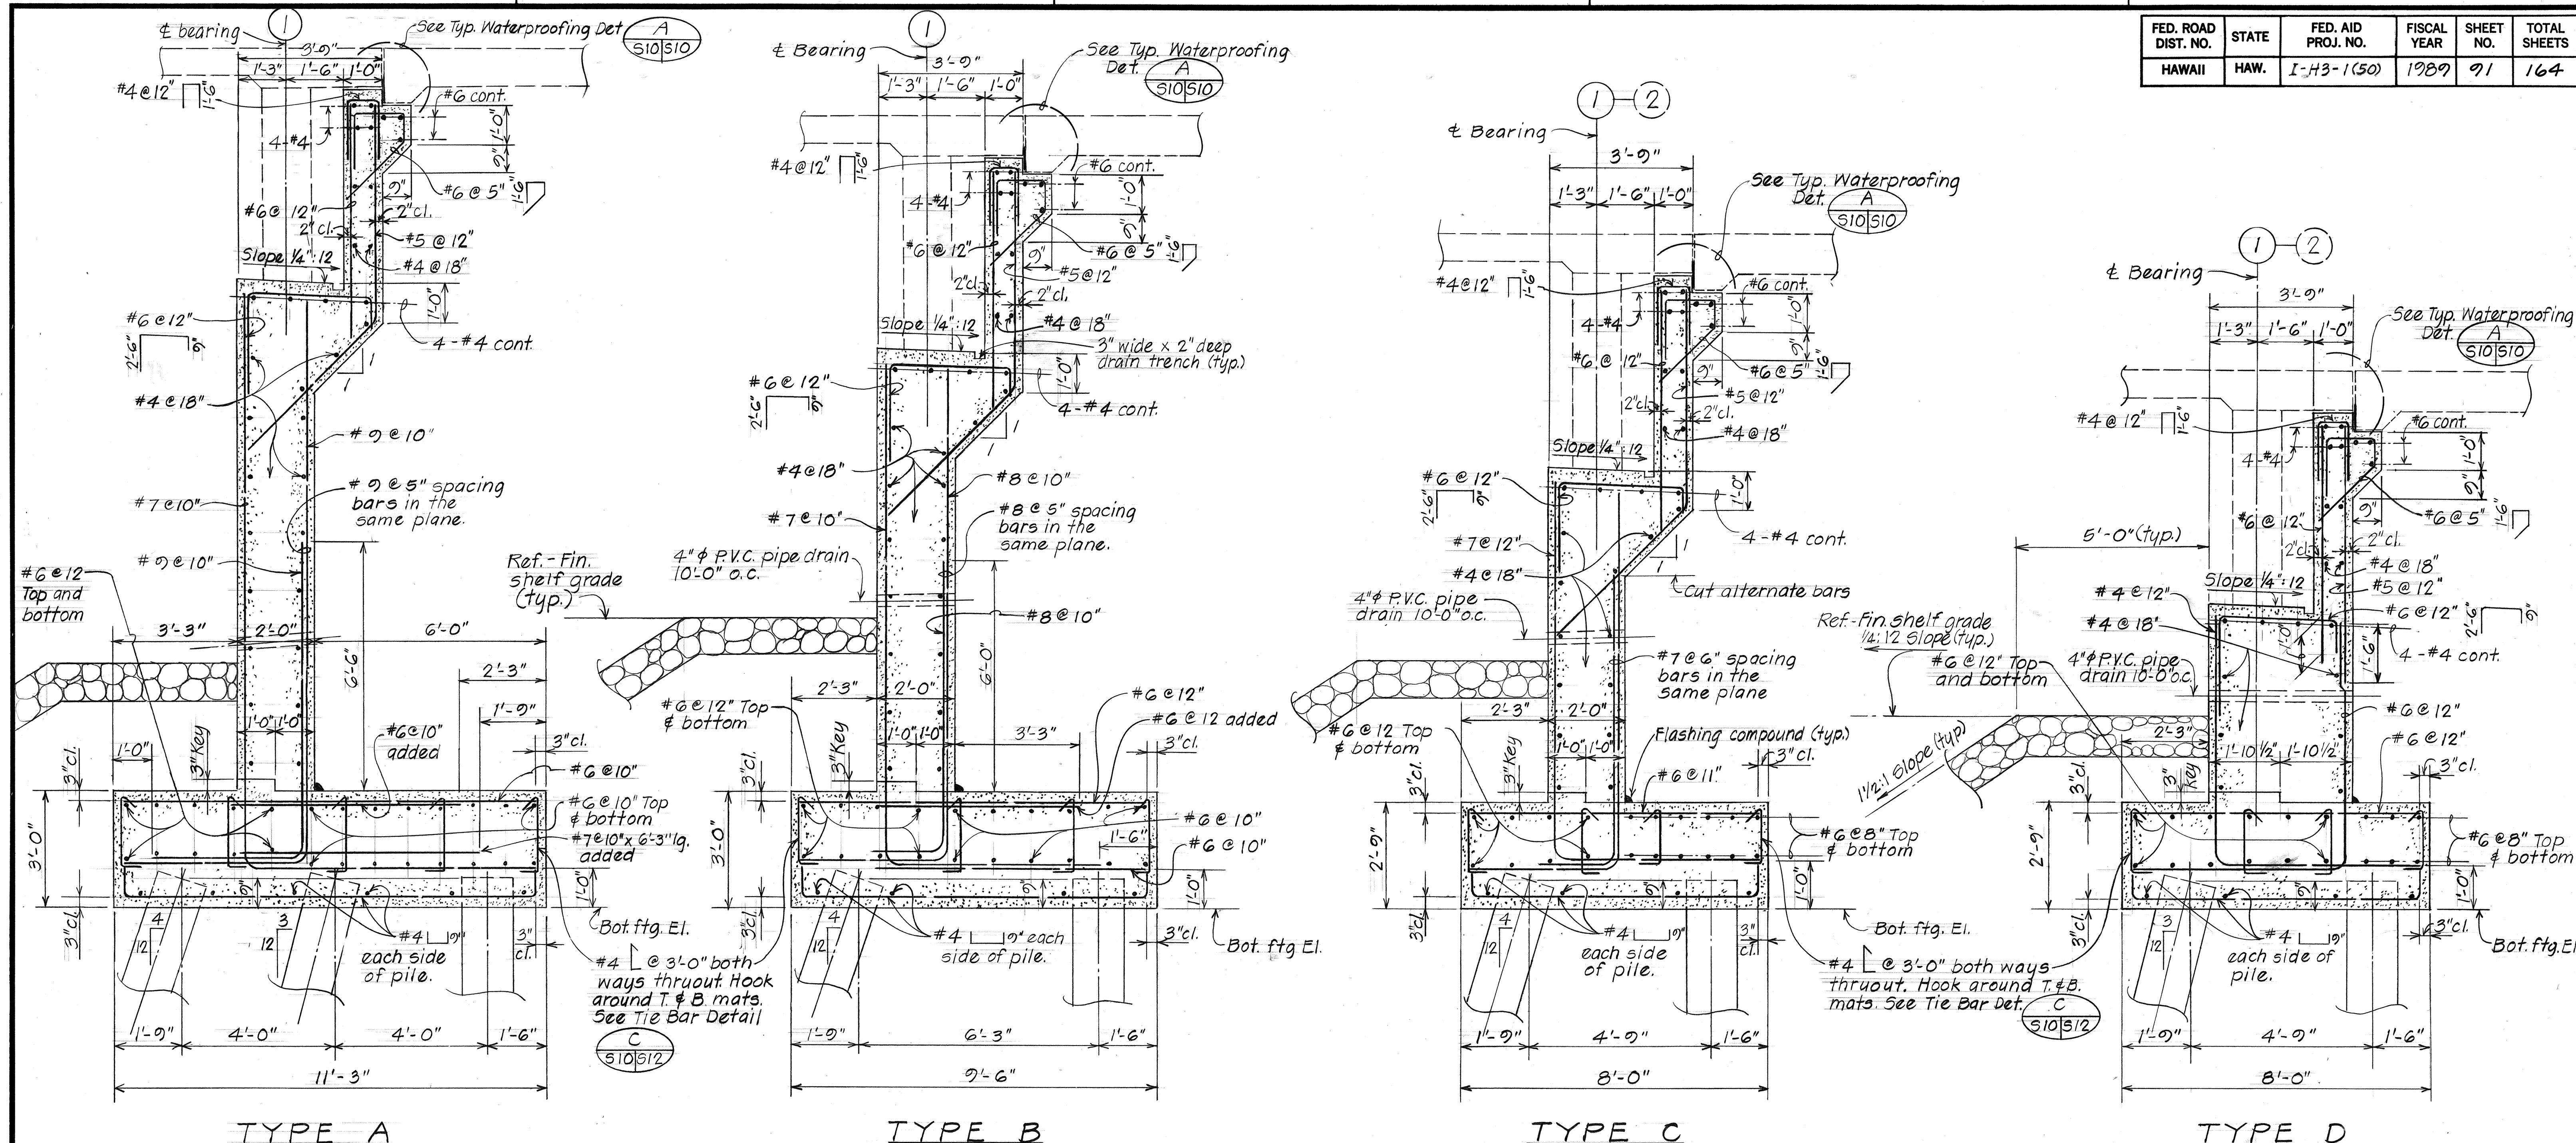

TYPE A TYPE B TYPE C TYPE D  
TYPICAL ABUTMENT SECTION  
Scale: 1/2" = 1'-0"

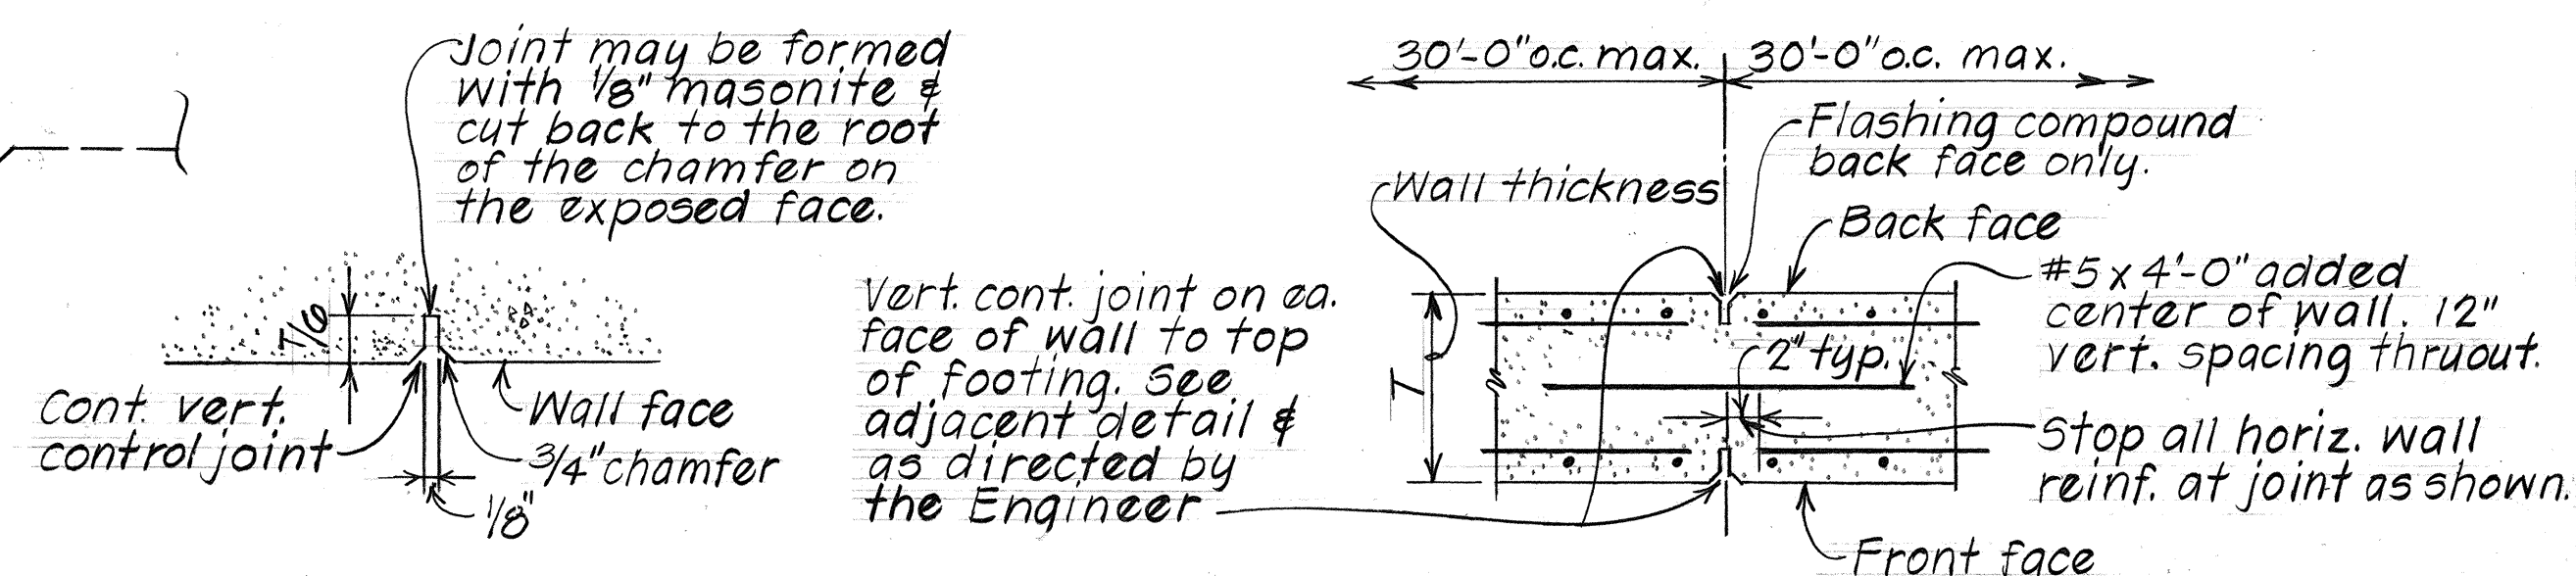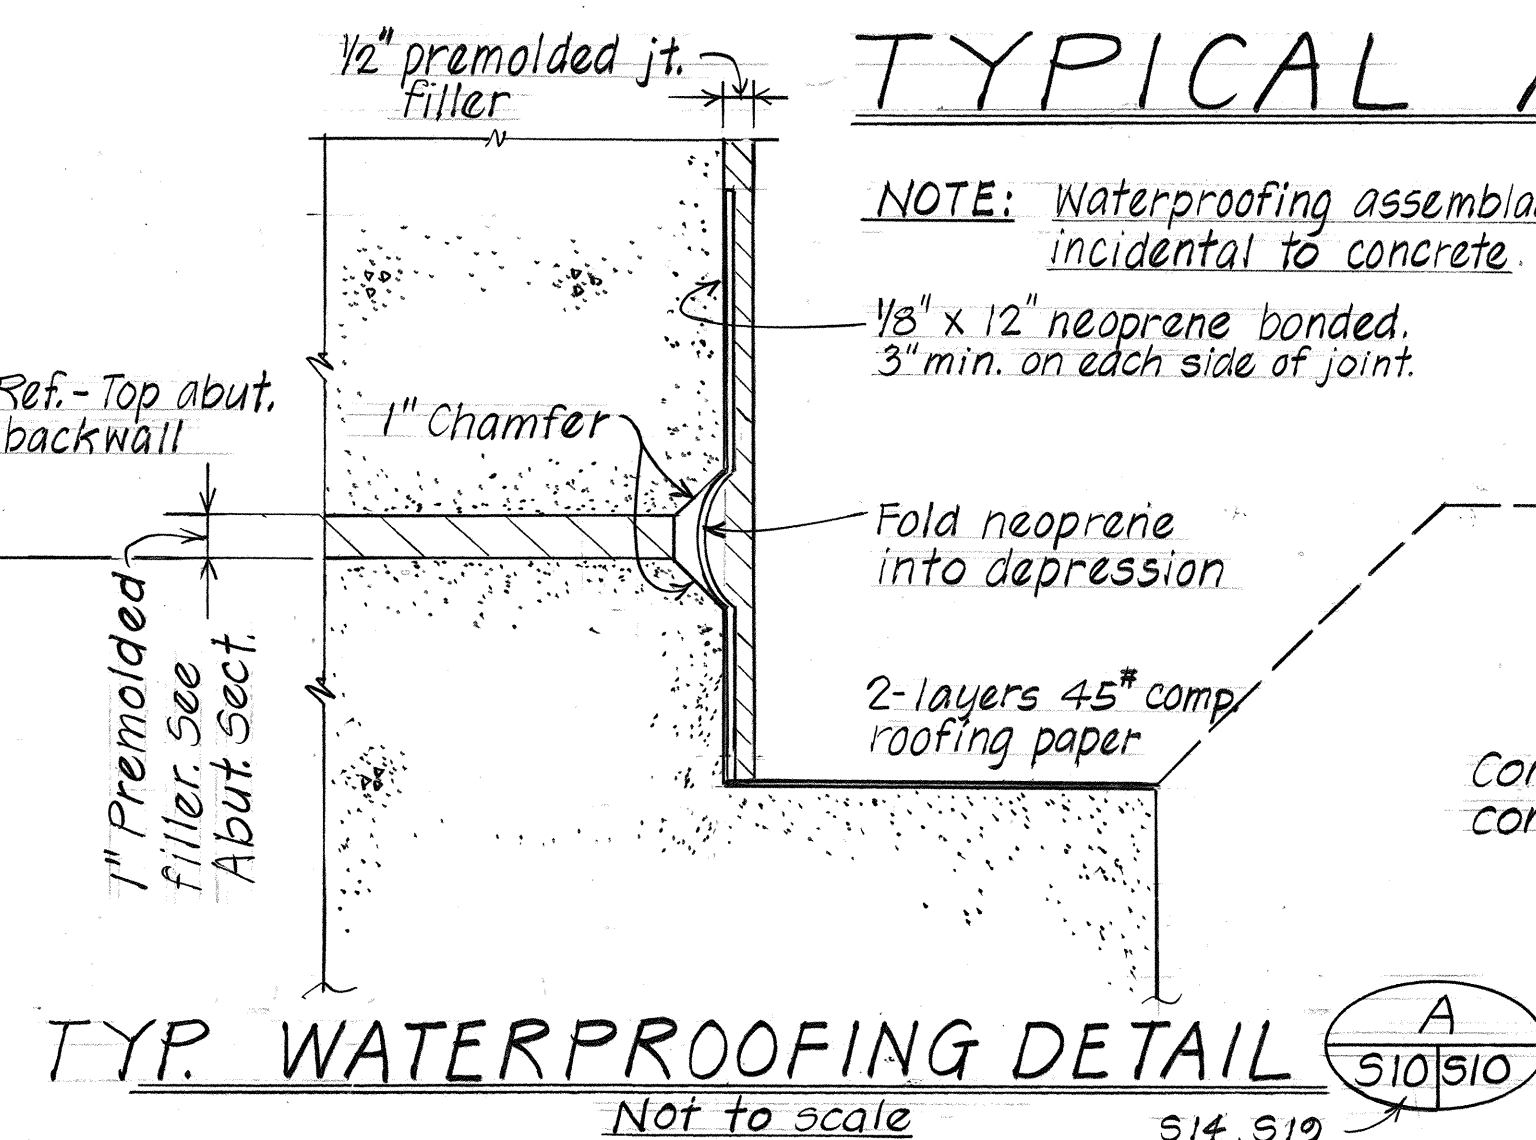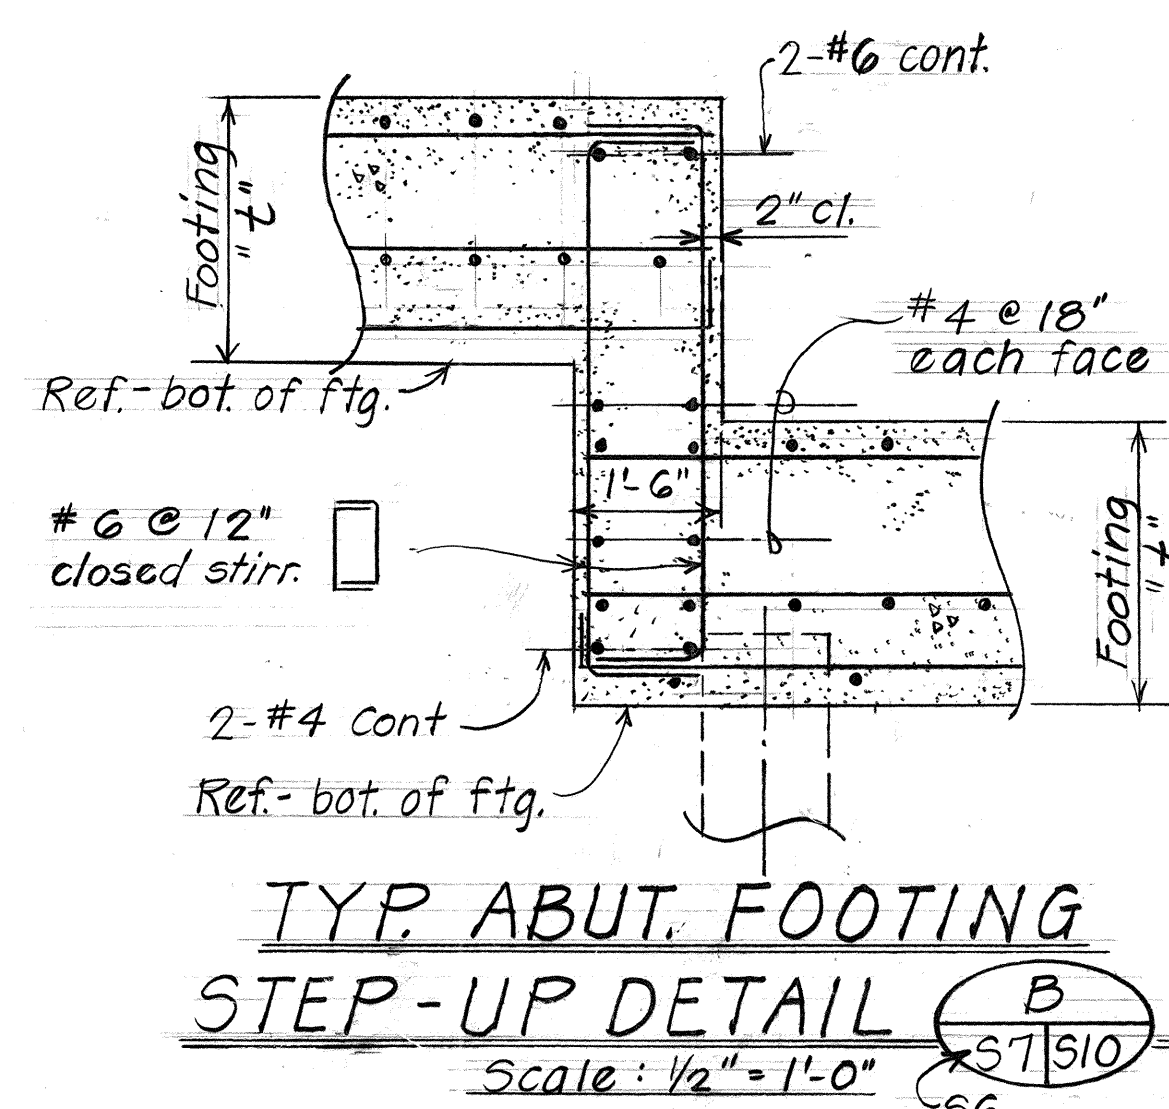

CONTROL JOINT DETAILS  
Not to scale

|                                                                                                                                                                                                                                                                                                                            |
|----------------------------------------------------------------------------------------------------------------------------------------------------------------------------------------------------------------------------------------------------------------------------------------------------------------------------|
| STATE OF HAWAII<br>DEPARTMENT OF TRANSPORTATION<br>LAND TRANSPORTATION FACILITIES DIVISION<br>ROUTE H-3 - KUOU STREAM BRIDGE<br>TYPICAL ABUTMENT SECTIONS<br>ABUTMENT FOOTING STEP-UP<br>F.A.I. Proj. No. I-H3-1(50)<br>KANELOE I.C. TO HALEKOU I.C.<br>Scale: As Noted<br>Date: August 1987<br>SHEET NO. 510 OF 35 SHEETS |
|----------------------------------------------------------------------------------------------------------------------------------------------------------------------------------------------------------------------------------------------------------------------------------------------------------------------------|



[illegible]

TYPICAL PIER COLUMN DETAIL

TYPICAL PIER COLUMN SECTION

STATE OF HAWAII  
DEPARTMENT OF TRANSPORTATION  
LAND TRANSPORTATION FACILITIES DIVISION

ROUTE H-3 - KUOU STREAM BRIDGE  
PIER COLUMN DETAIL  
PIER COLUMN PILE FOOTING PLAN


F.A.I. Proj. No. I-H3-1(SO)  
KANEHOE I.C. TO HALEKOU I.C.

Scale: As Noted Date: August 1987

**SHEET NO. 911 OF 35 SHEETS**



| FED. ROAD DIST. NO. | STATE | FED. AID PROJ. NO. | FISCAL YEAR | SHEET NO. | TOTAL SHEETS |
|---------------------|-------|--------------------|-------------|-----------|--------------|
| HAWAII              | HAW.  | I-H3-1(50)         | 1987        | 93        | 164          |

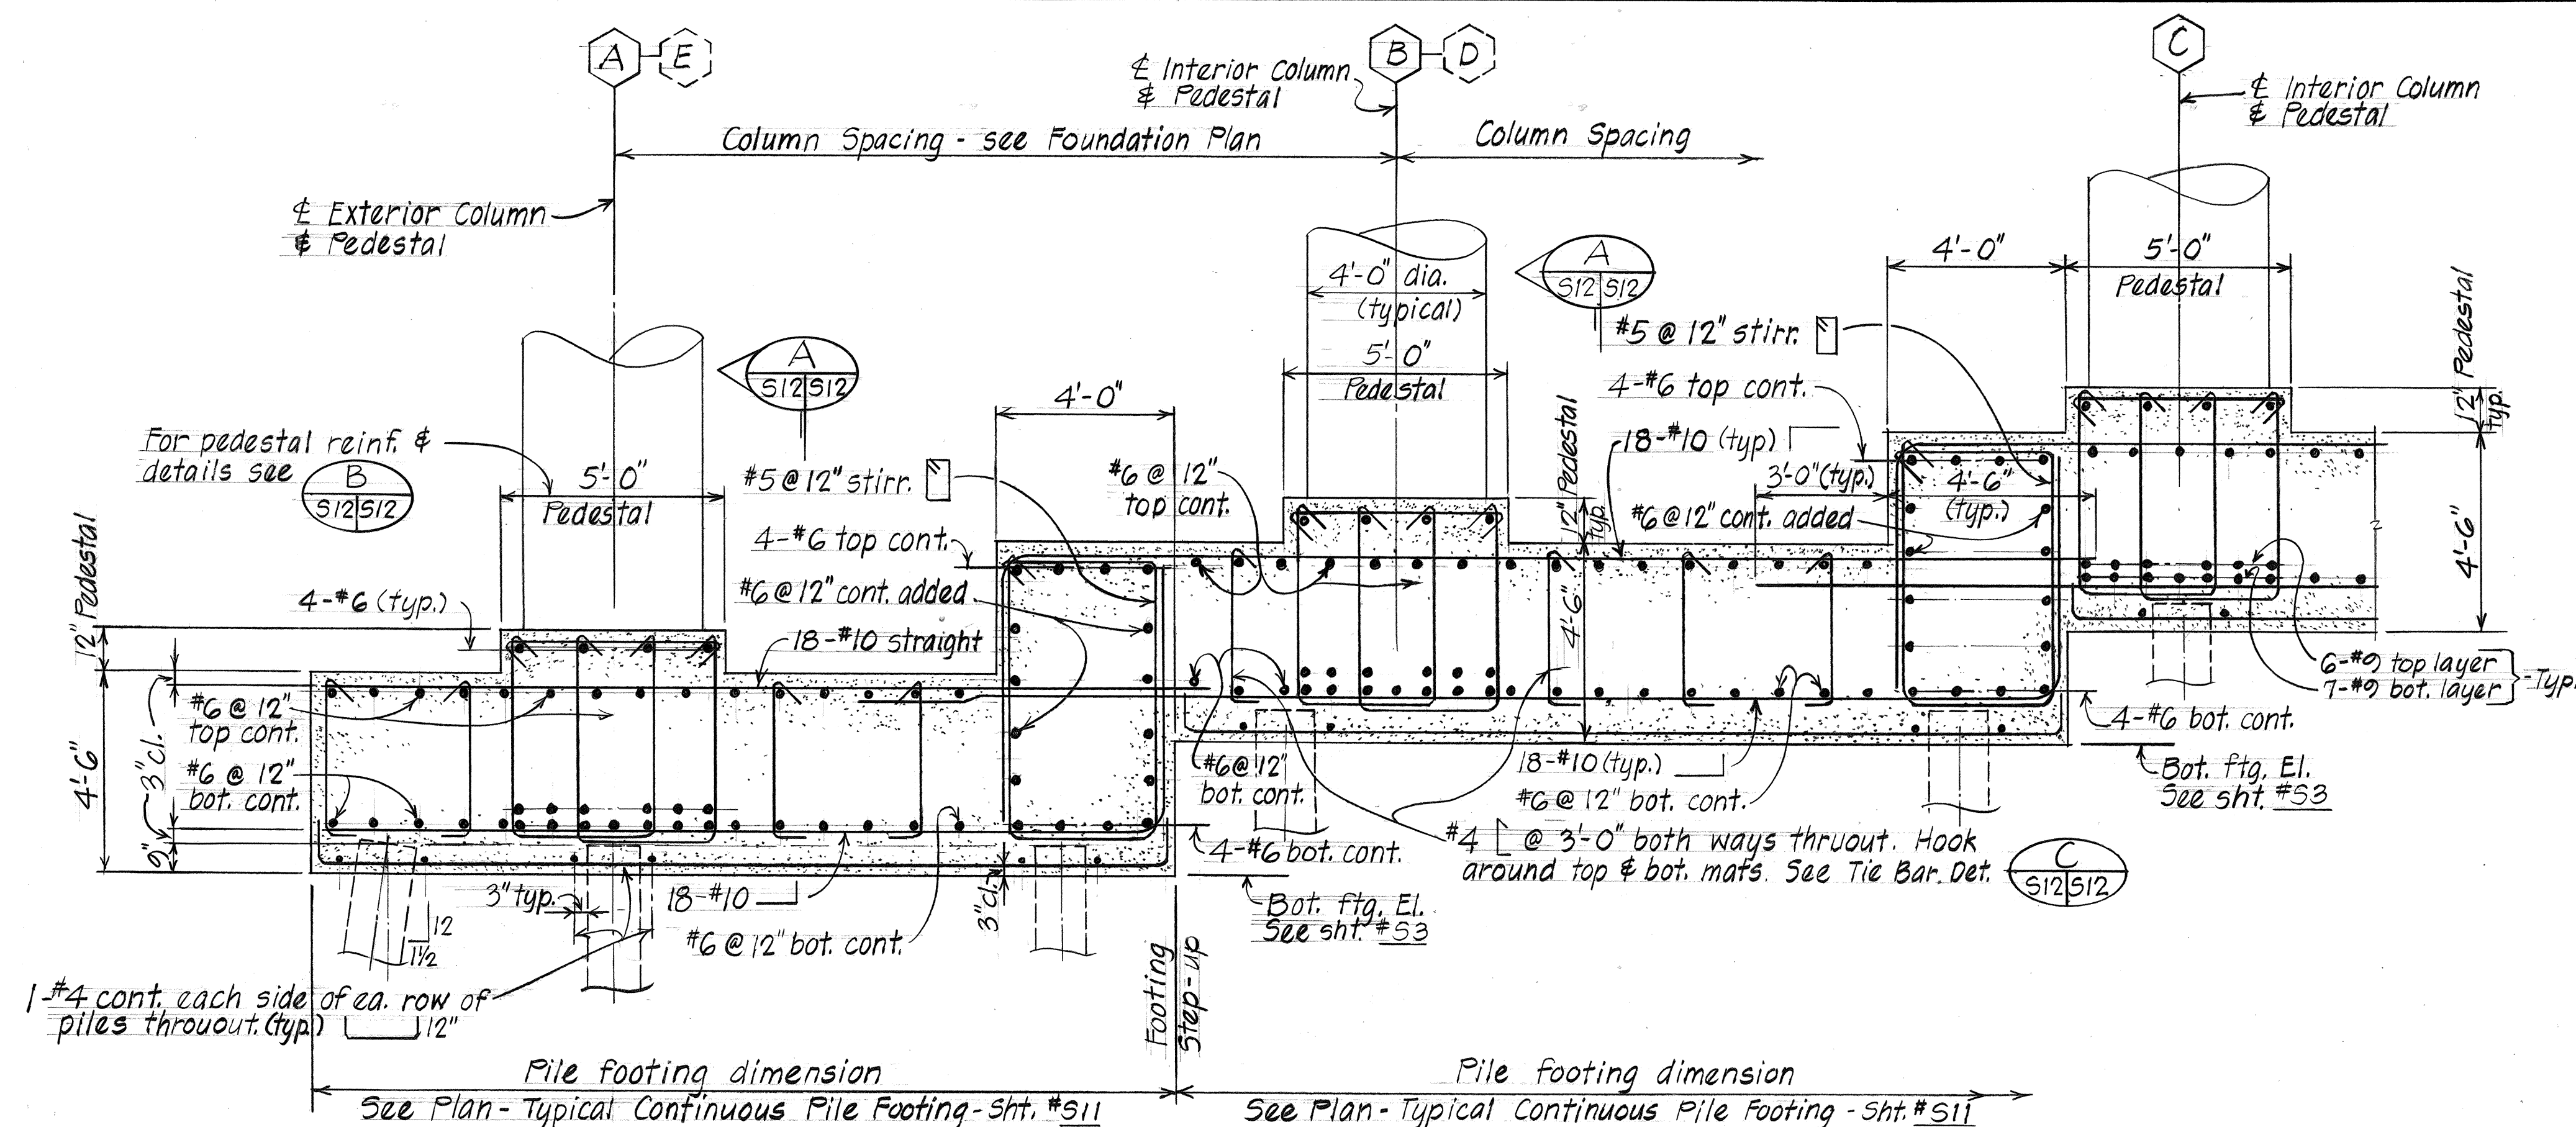


AT EXTERIOR COLUMN (A) AS SHOWN  
COLUMN (E) SIMILAR EXCEPT OPPOSITE END

AT INTERIOR COLUMN (B) AS SHOWN  
COLUMN (D) SIMILAR EXCEPT AS OTHERWISE NOTED


### TYPICAL PIER COLUMN CONTINUOUS PILE FOOTING REINFORCEMENT DETAILS

Scale: 3/8" = 1'-0"

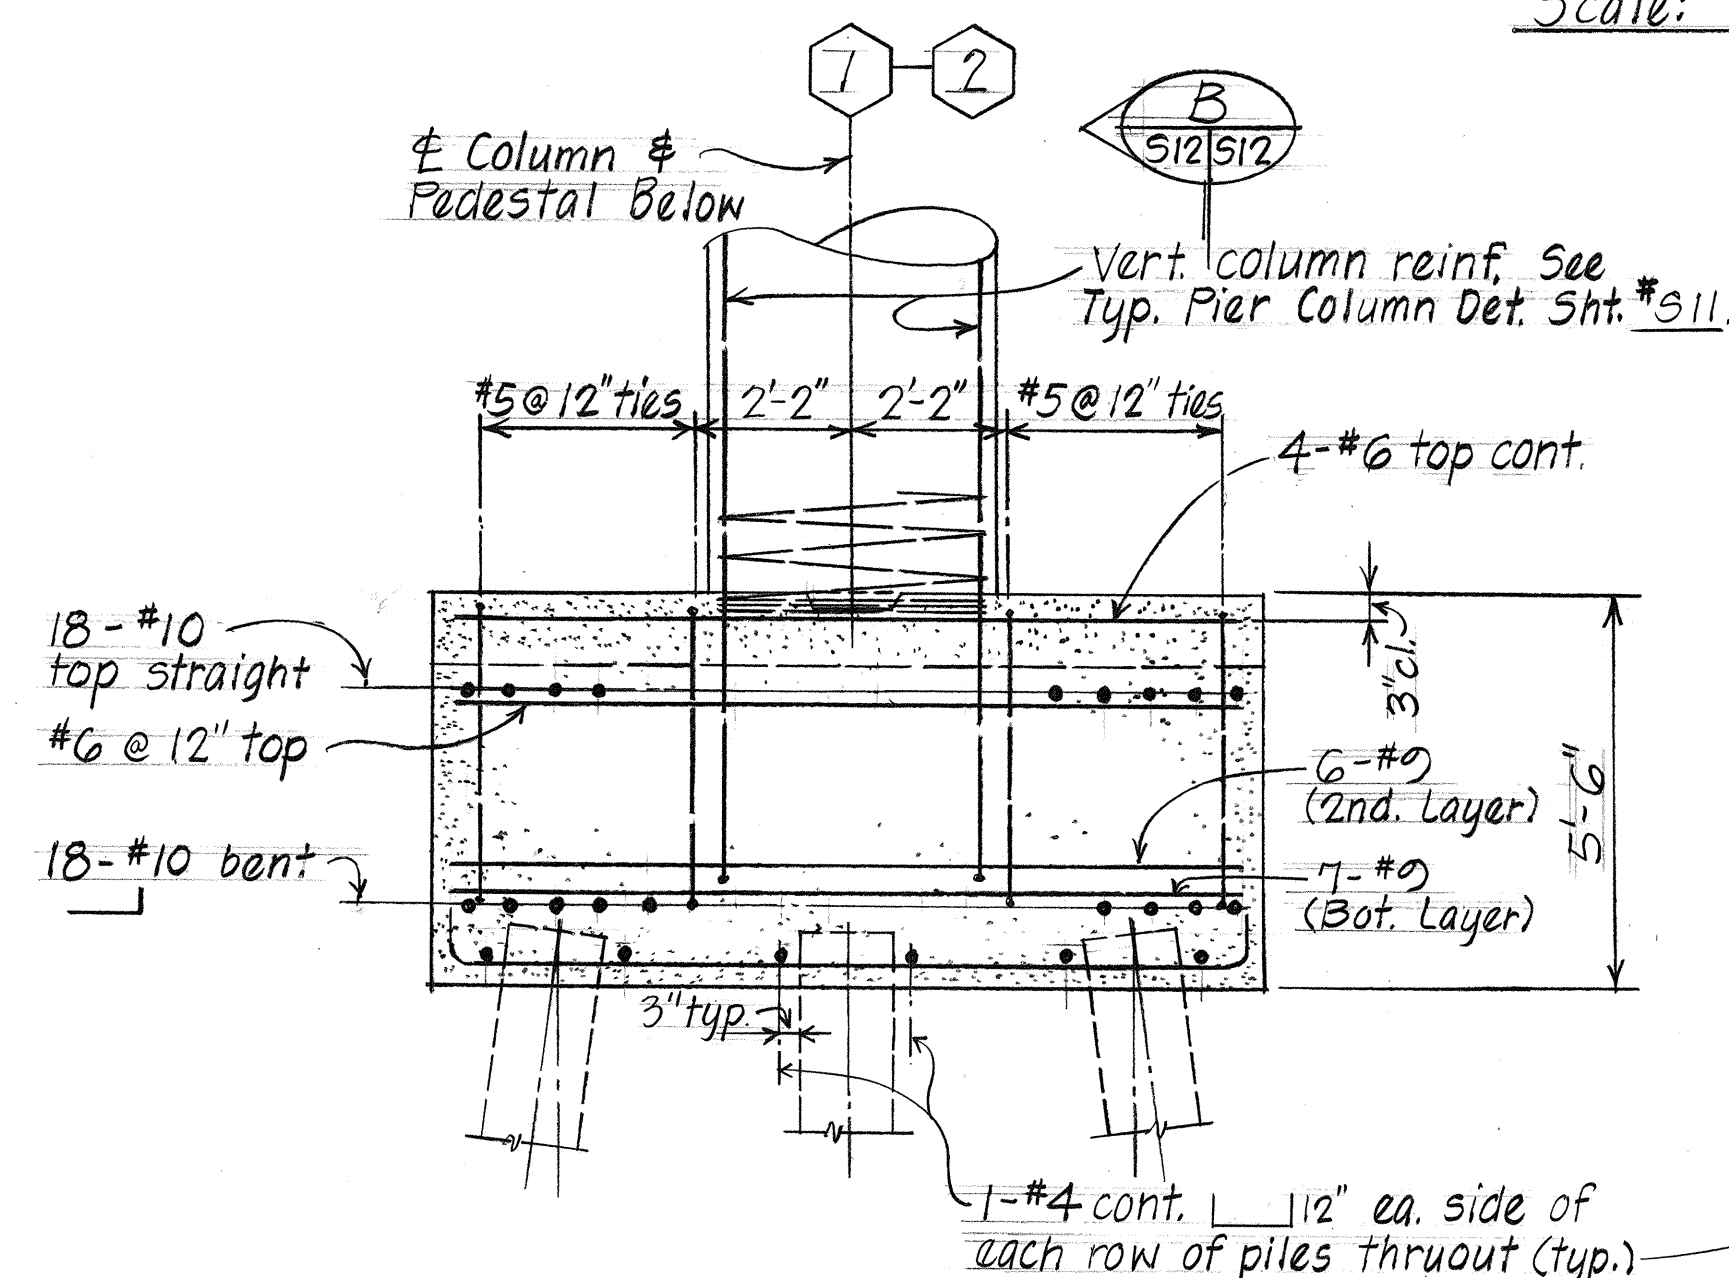


### TYPICAL PEDESTAL REINFORCEMENT DETAIL

Scale: 3/8" = 1'-0"

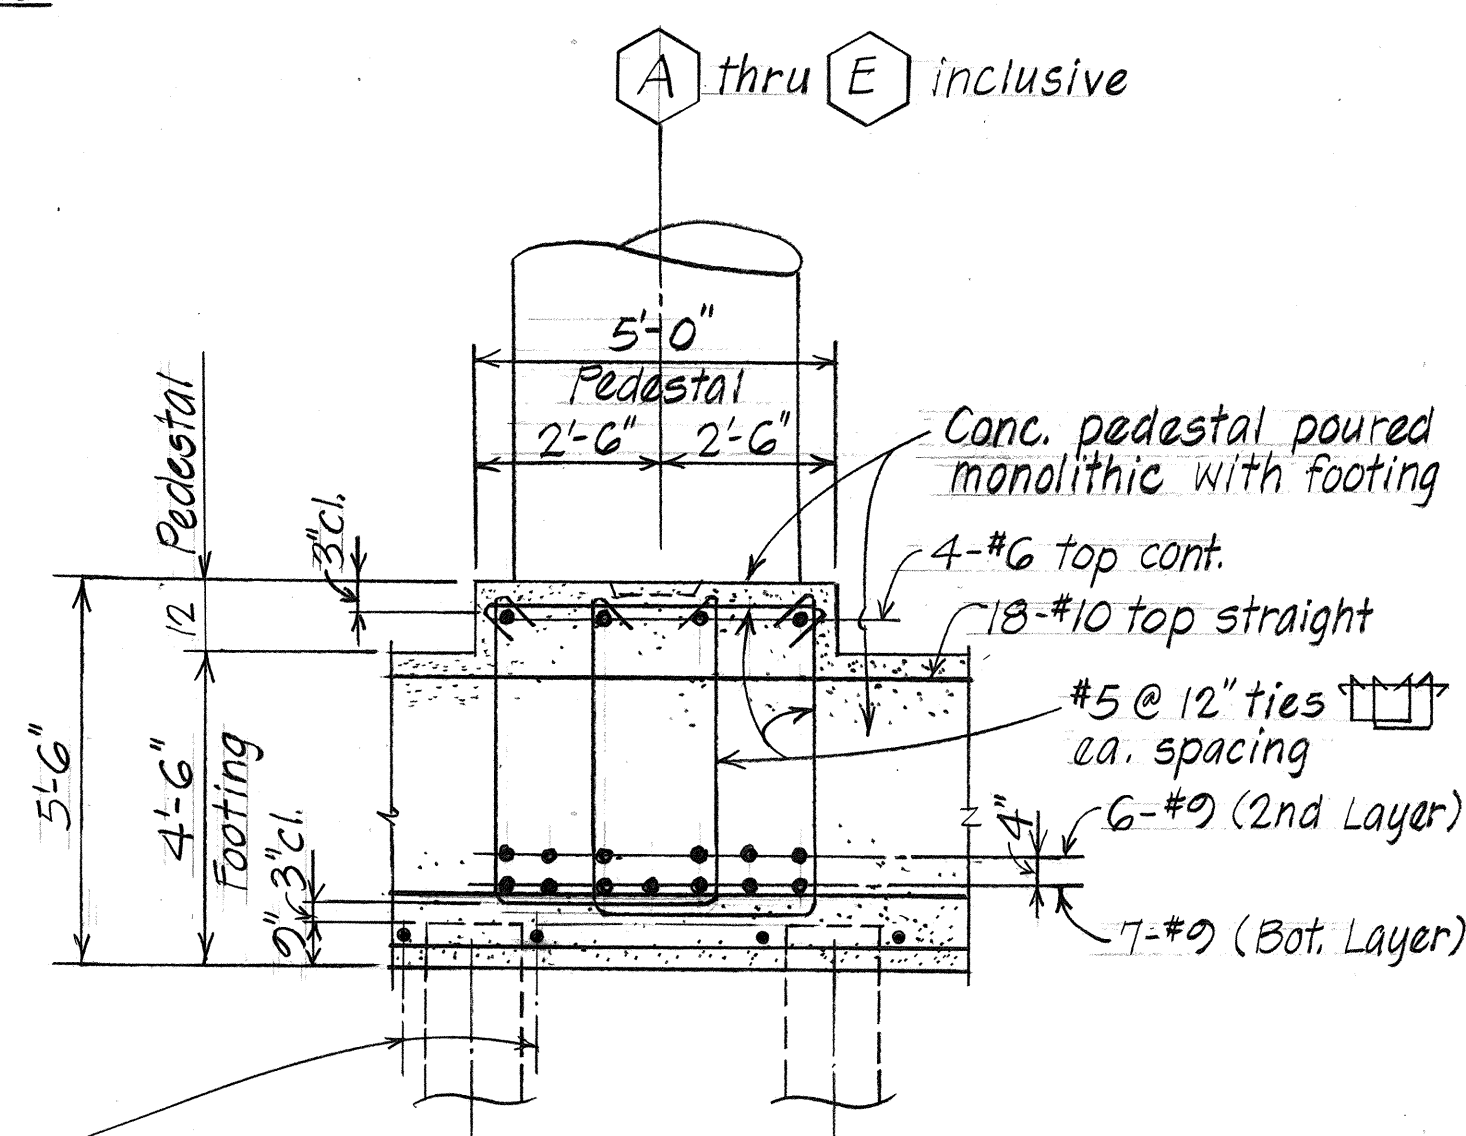


### SECTION (B)

Scale: 3/8" = 1'-0"

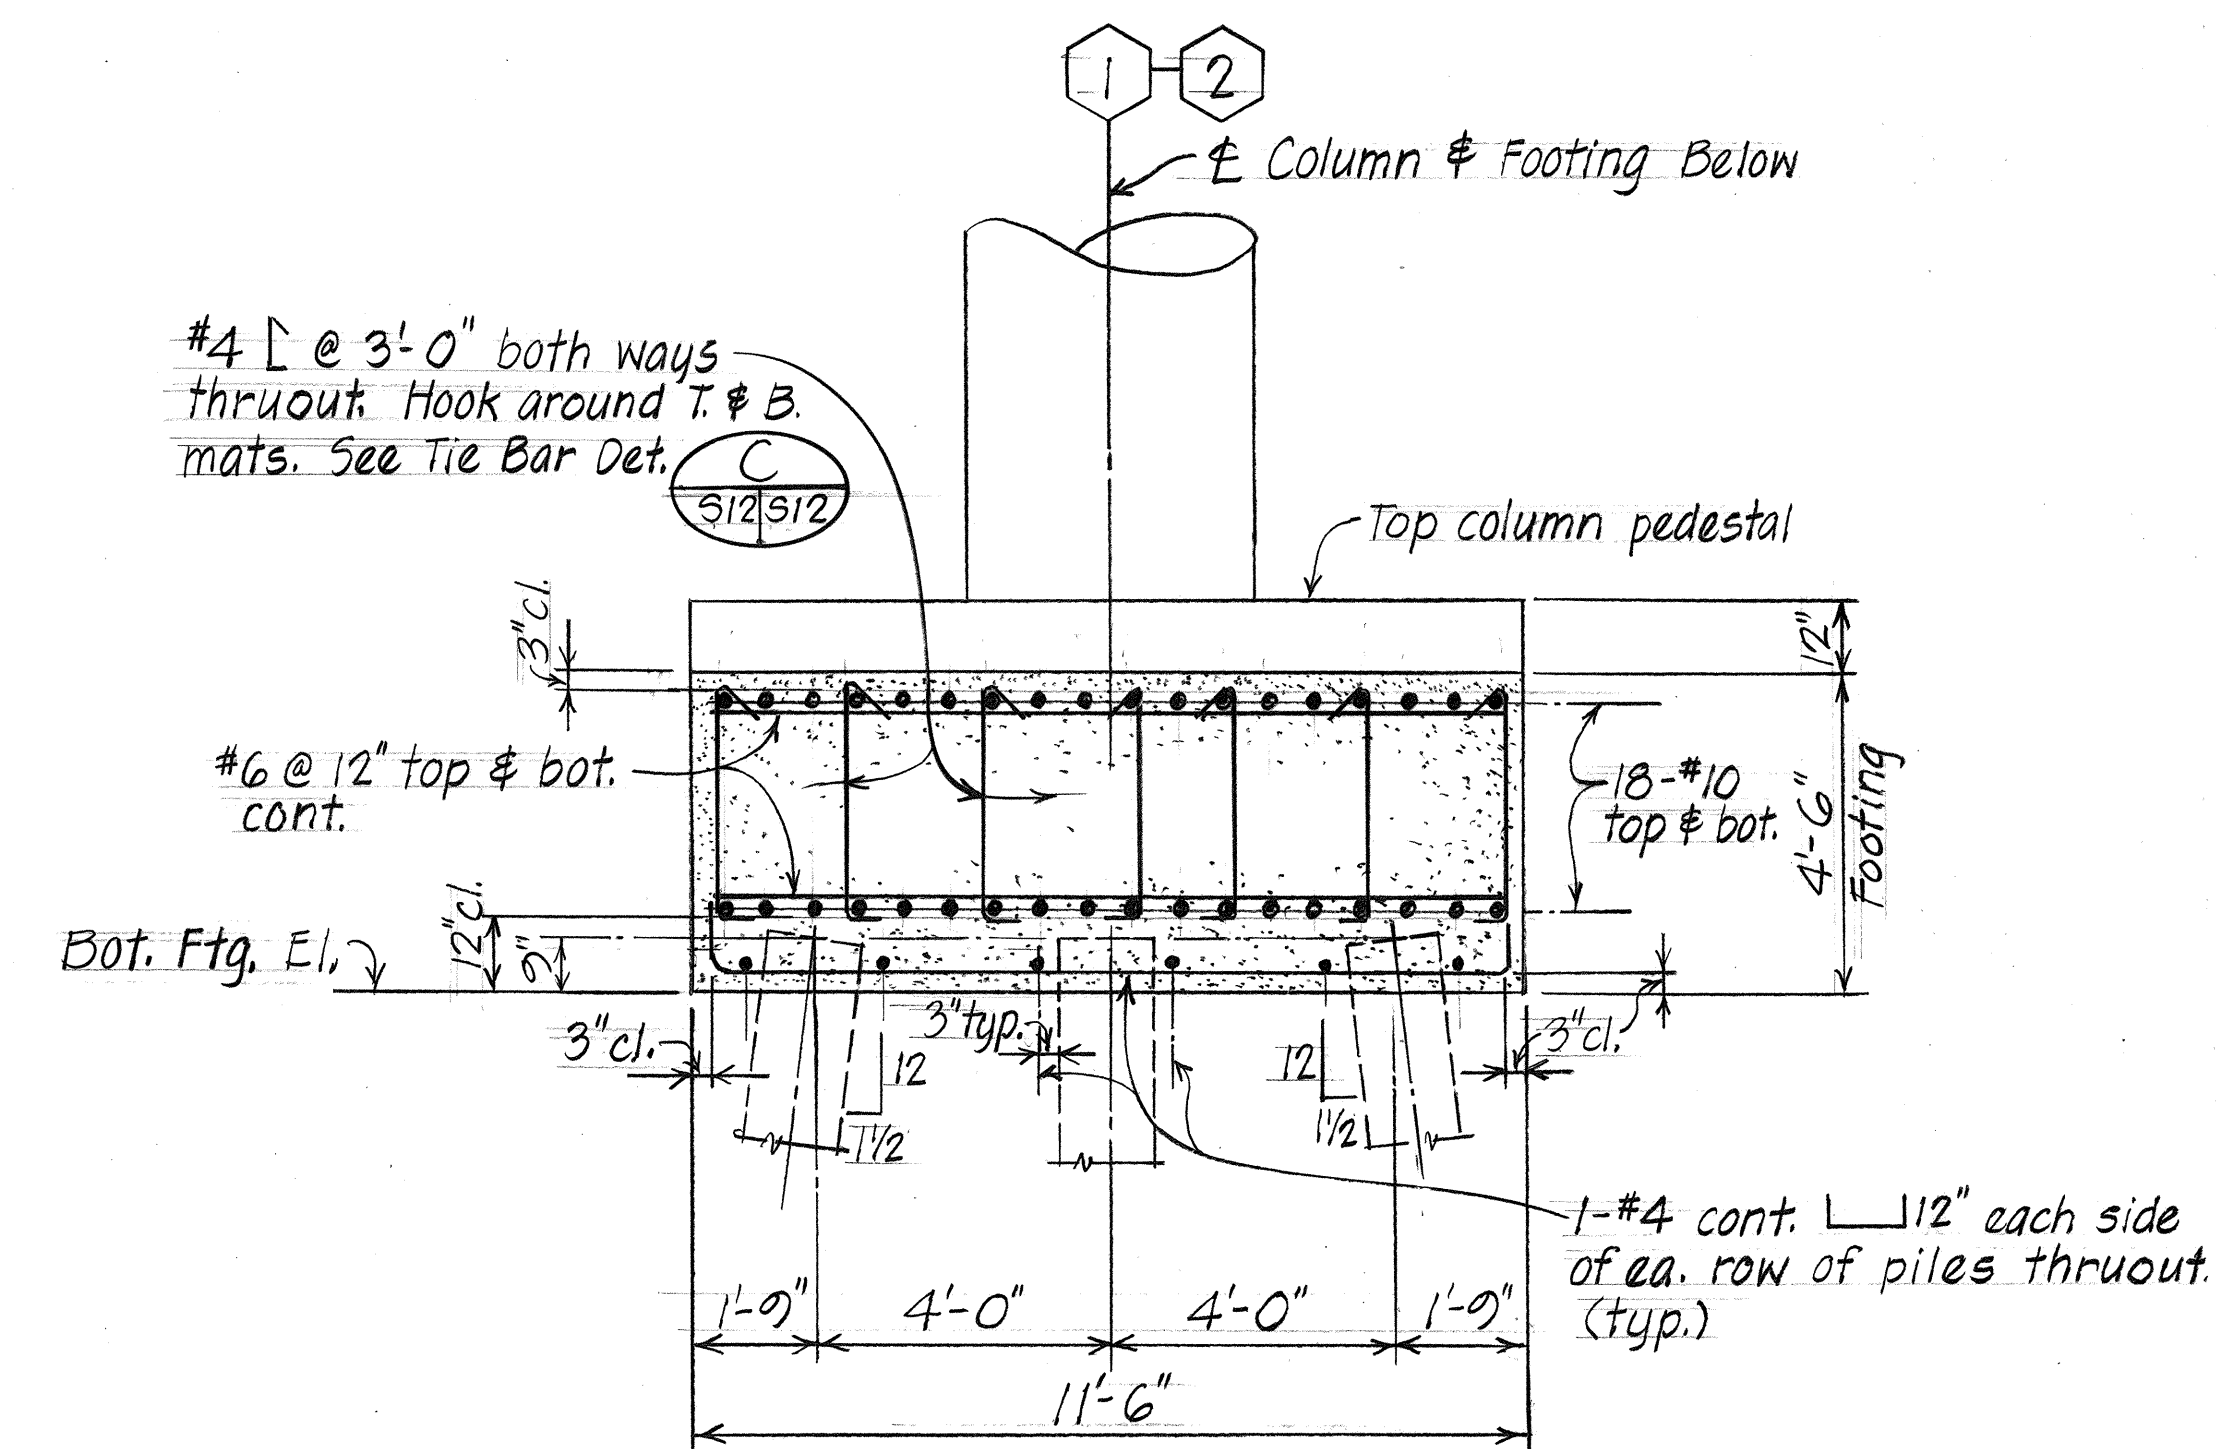

### TYPICAL SECTION (A)

Scale: 3/8" = 1'-0"

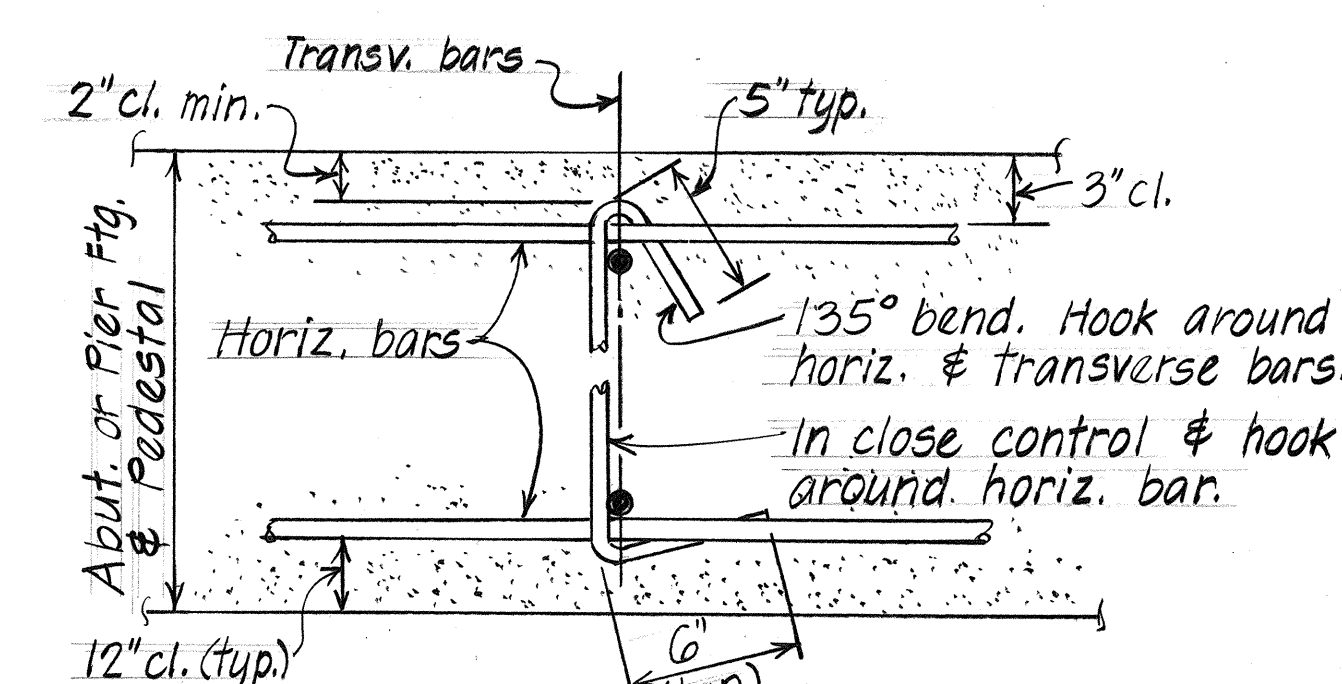



### TIE BAR DETAIL (C)

Not to Scale

|                                                                                                                                                                                                                                                                                             |
|---------------------------------------------------------------------------------------------------------------------------------------------------------------------------------------------------------------------------------------------------------------------------------------------|
| STATE OF HAWAII<br>DEPARTMENT OF TRANSPORTATION<br>LAND TRANSPORTATION FACILITIES DIVISION<br>ROUTE H-3 - KUOU STREAM BRIDGE<br>PIER FOOTING SECTIONS<br>F.A.I. Proj. No. I-H3-1(50)<br>KANELOHE I.C. TO HALELOU I.C.<br>Scale: As Noted<br>Date: August 1987<br>SHEET NO. 512 OF 35 SHEETS |
|---------------------------------------------------------------------------------------------------------------------------------------------------------------------------------------------------------------------------------------------------------------------------------------------|




| FED. ROAD DIST. NO. | STATE | FED. AID PROJ. NO. | FISCAL YEAR | SHEET NO. | TOTAL SHEETS |
|---------------------|-------|--------------------|-------------|-----------|--------------|
| HAWAII              | HAW.  | I-H3-1(50)         | 1989        | 94        | 164          |

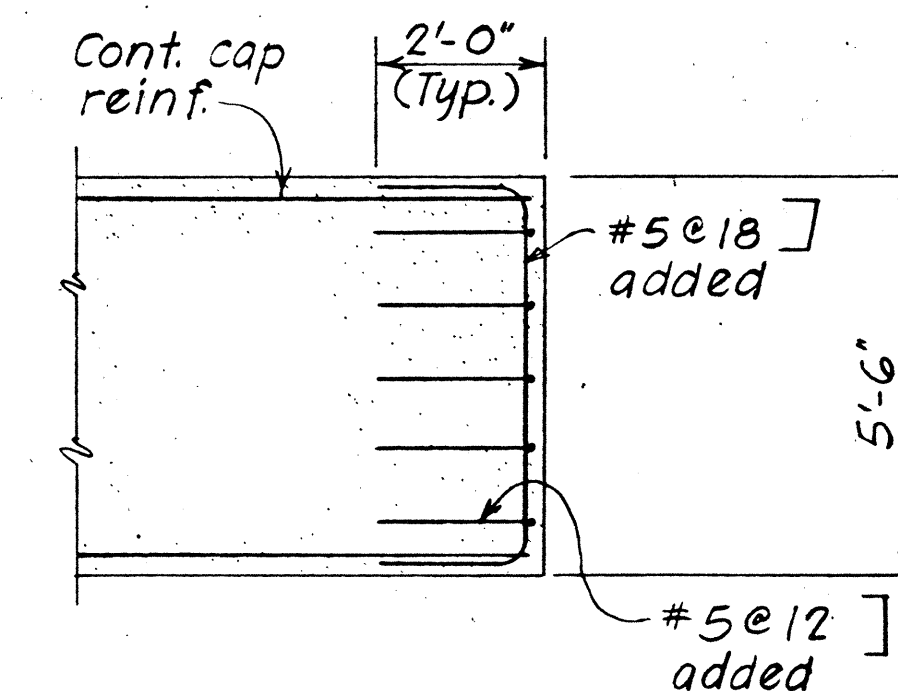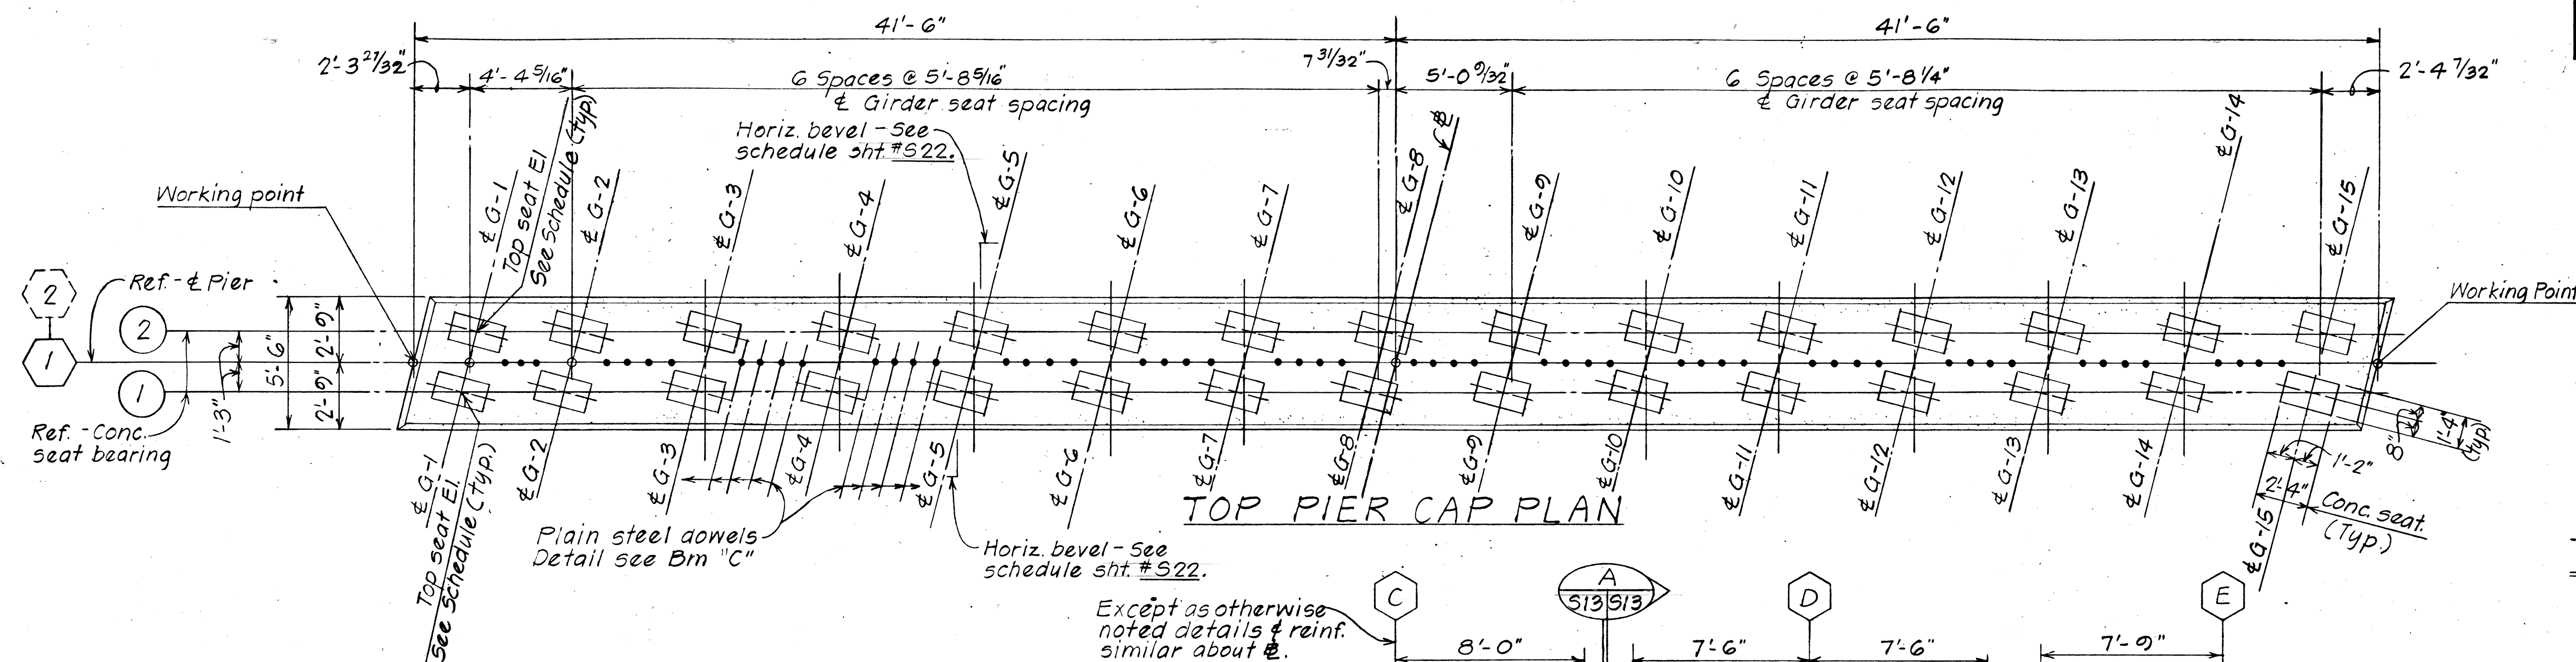

TYPICAL SECTION  
Scale: 3/8" = 1'-0"

#### REFERENCE NOTES


1. Top Seat El. Schedule sht. #522.
2. Top Column El. Schedule sht. #511.
3. Plain Steel Dowel see Beam "C" Det. sht. #520.

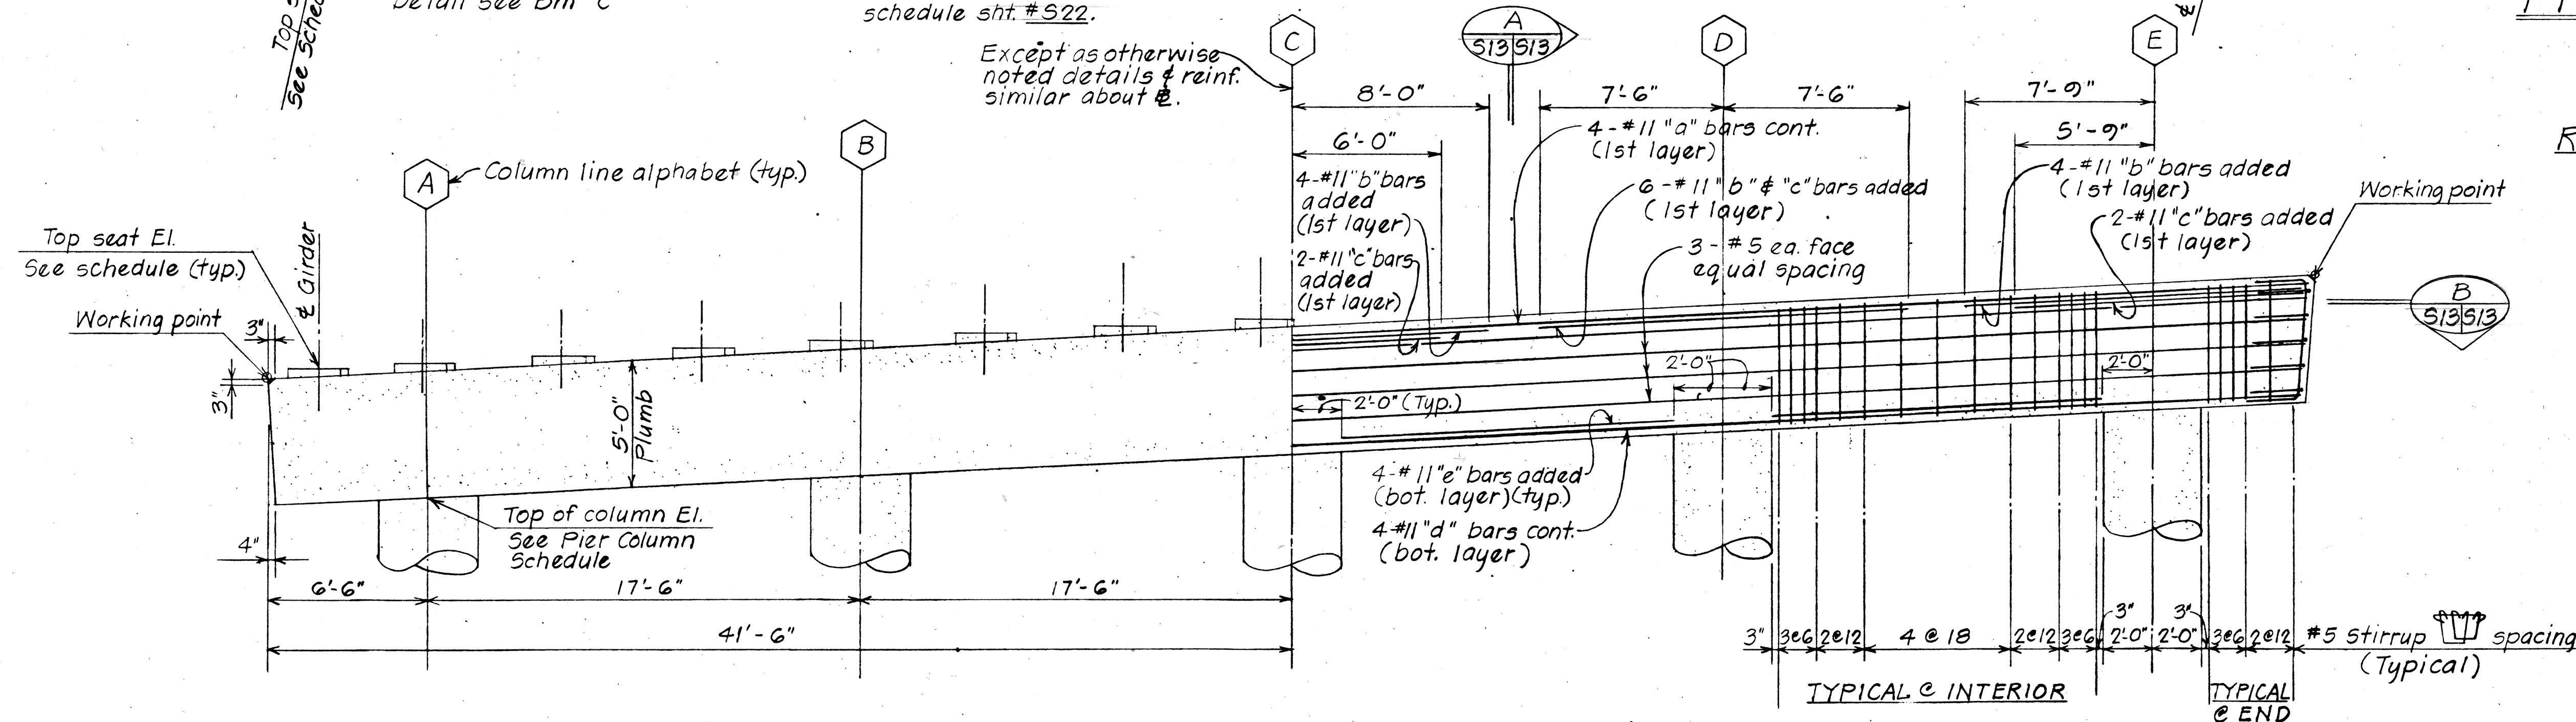

PIER DIMENSION

PIER REINFORCEMENT

PIER CAP ELEVATION  
TYPICAL PIER CAP DETAILS  
Scale: 1/4" = 1'-0"

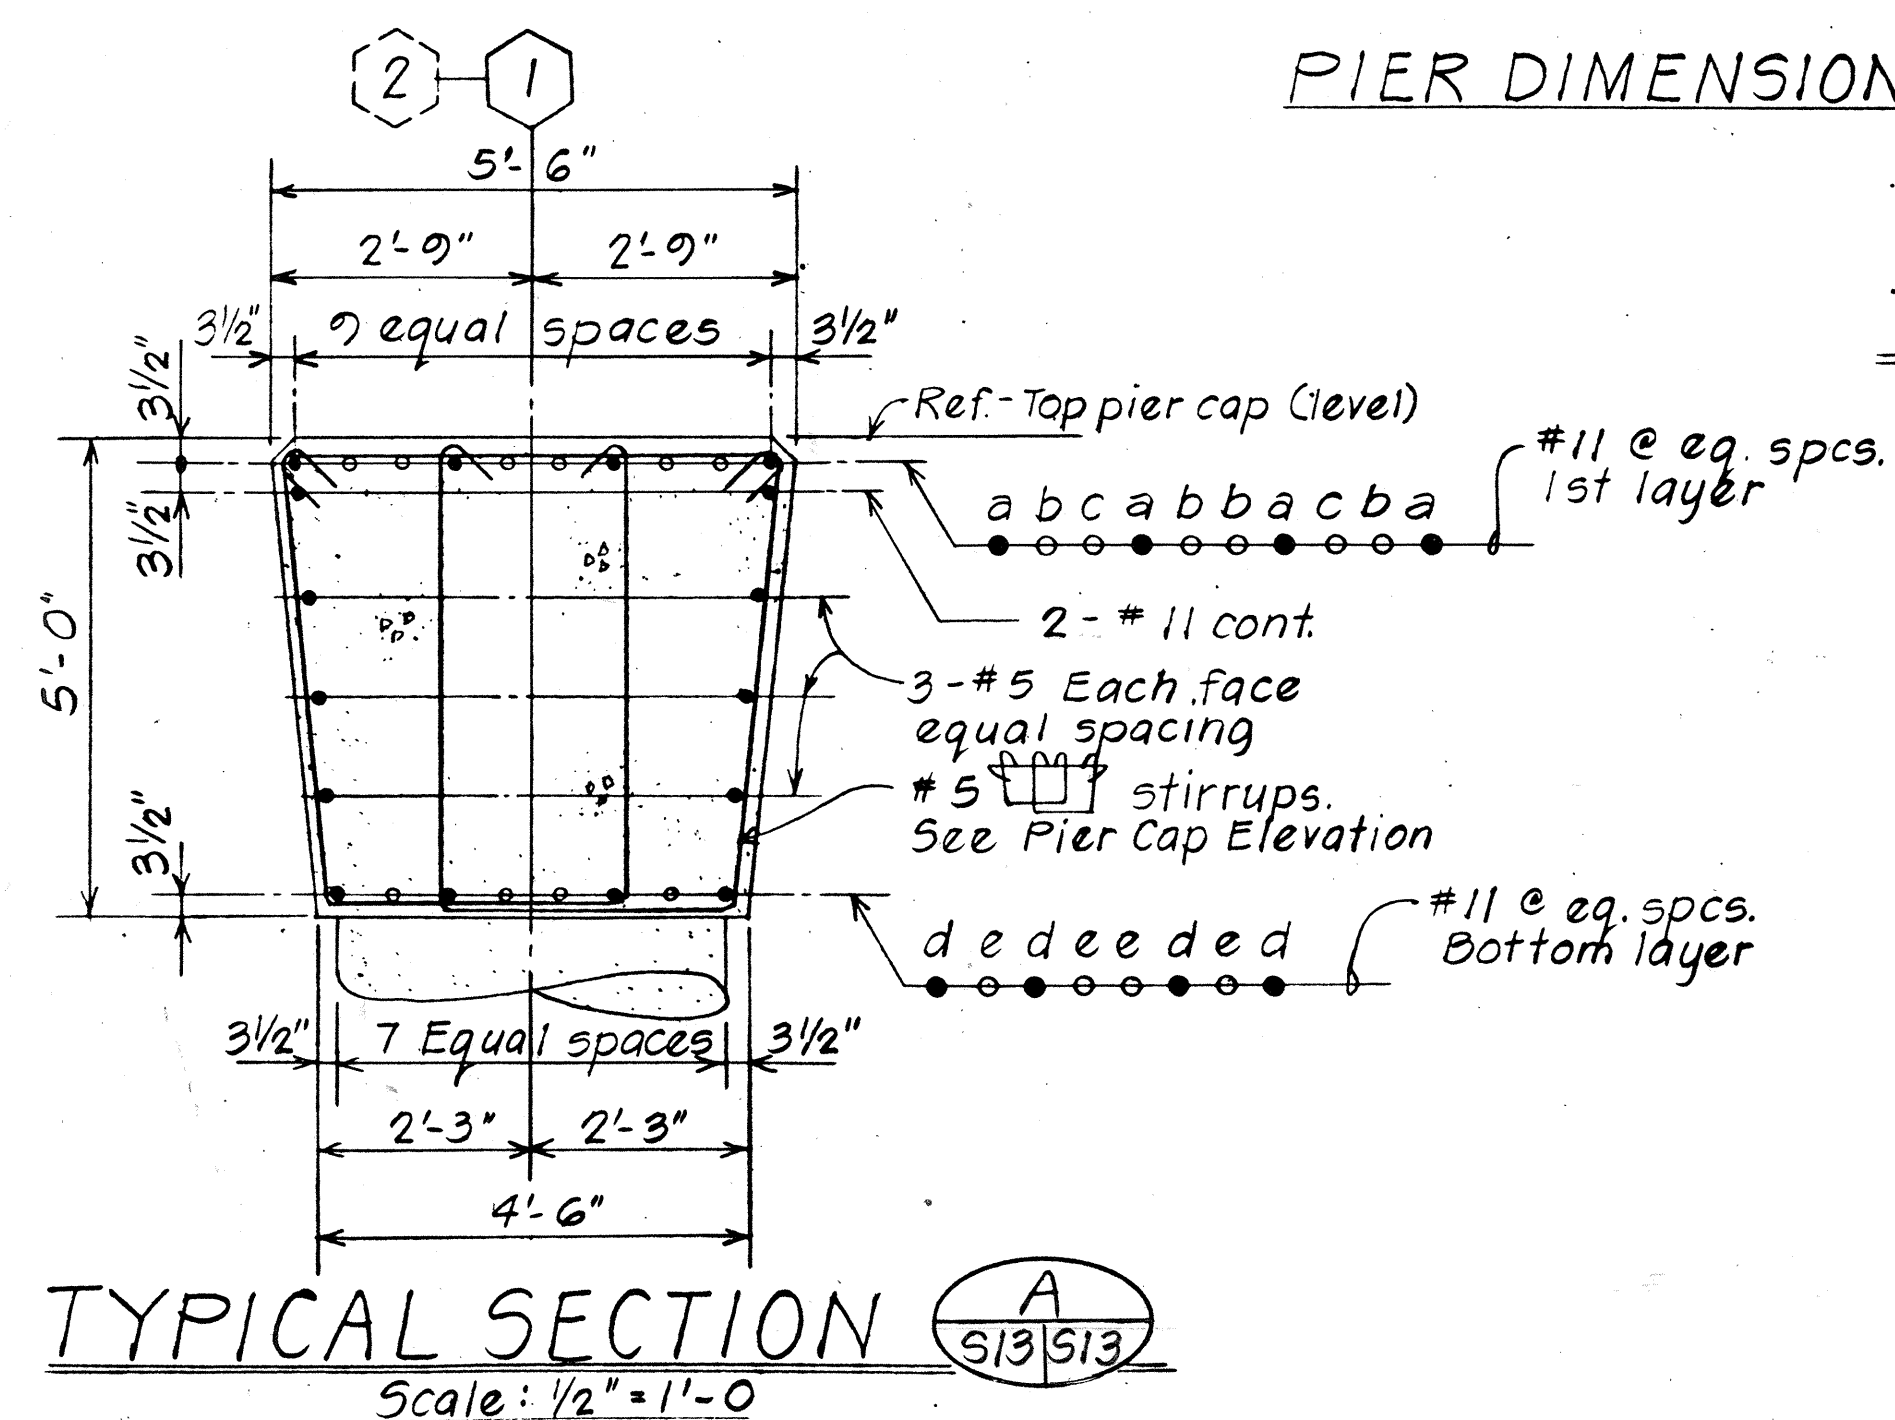


TYPICAL SECTION  
Scale: 1/2" = 1'-0"

STATE OF HAWAII  
DEPARTMENT OF TRANSPORTATION  
LAND TRANSPORTATION FACILITIES DIVISION  
ROUTE H-3 - KUOU STREAM BRIDGE  
PIER CAP DETAILS & SECTIONS  
F.A.I. Proj. No. I-H3-1(50)  
KANEHOE I.C. TO HALEKOU I.C.  
Scale: As Noted Date: August 1989  
SHEET No. S13 OF 35 SHEETS




| FED. ROAD DIST. NO. | STATE | FED. AID PROJ. NO. | FISCAL YEAR | SHEET NO. | TOTAL SHEETS |
|---------------------|-------|--------------------|-------------|-----------|--------------|
| HAWAII              | HAW.  | I-H3-1(50)         | 1989        | 95        | 164          |


- NOTES:**
1. TSS- - Denotes extent of Top Slab Strip (TSS-) between girders each bay. Refer to Typical Deck Slab Sections and corresponding Bar Placement Diagram for size and numbers, on Sht. #516.
  2. Locate Beam "B" as indicated on Plan.
  3. Girder dimension L = horizontal measurement between girder & bearing at each end of the girder. The Contractor shall determine total length of girder.

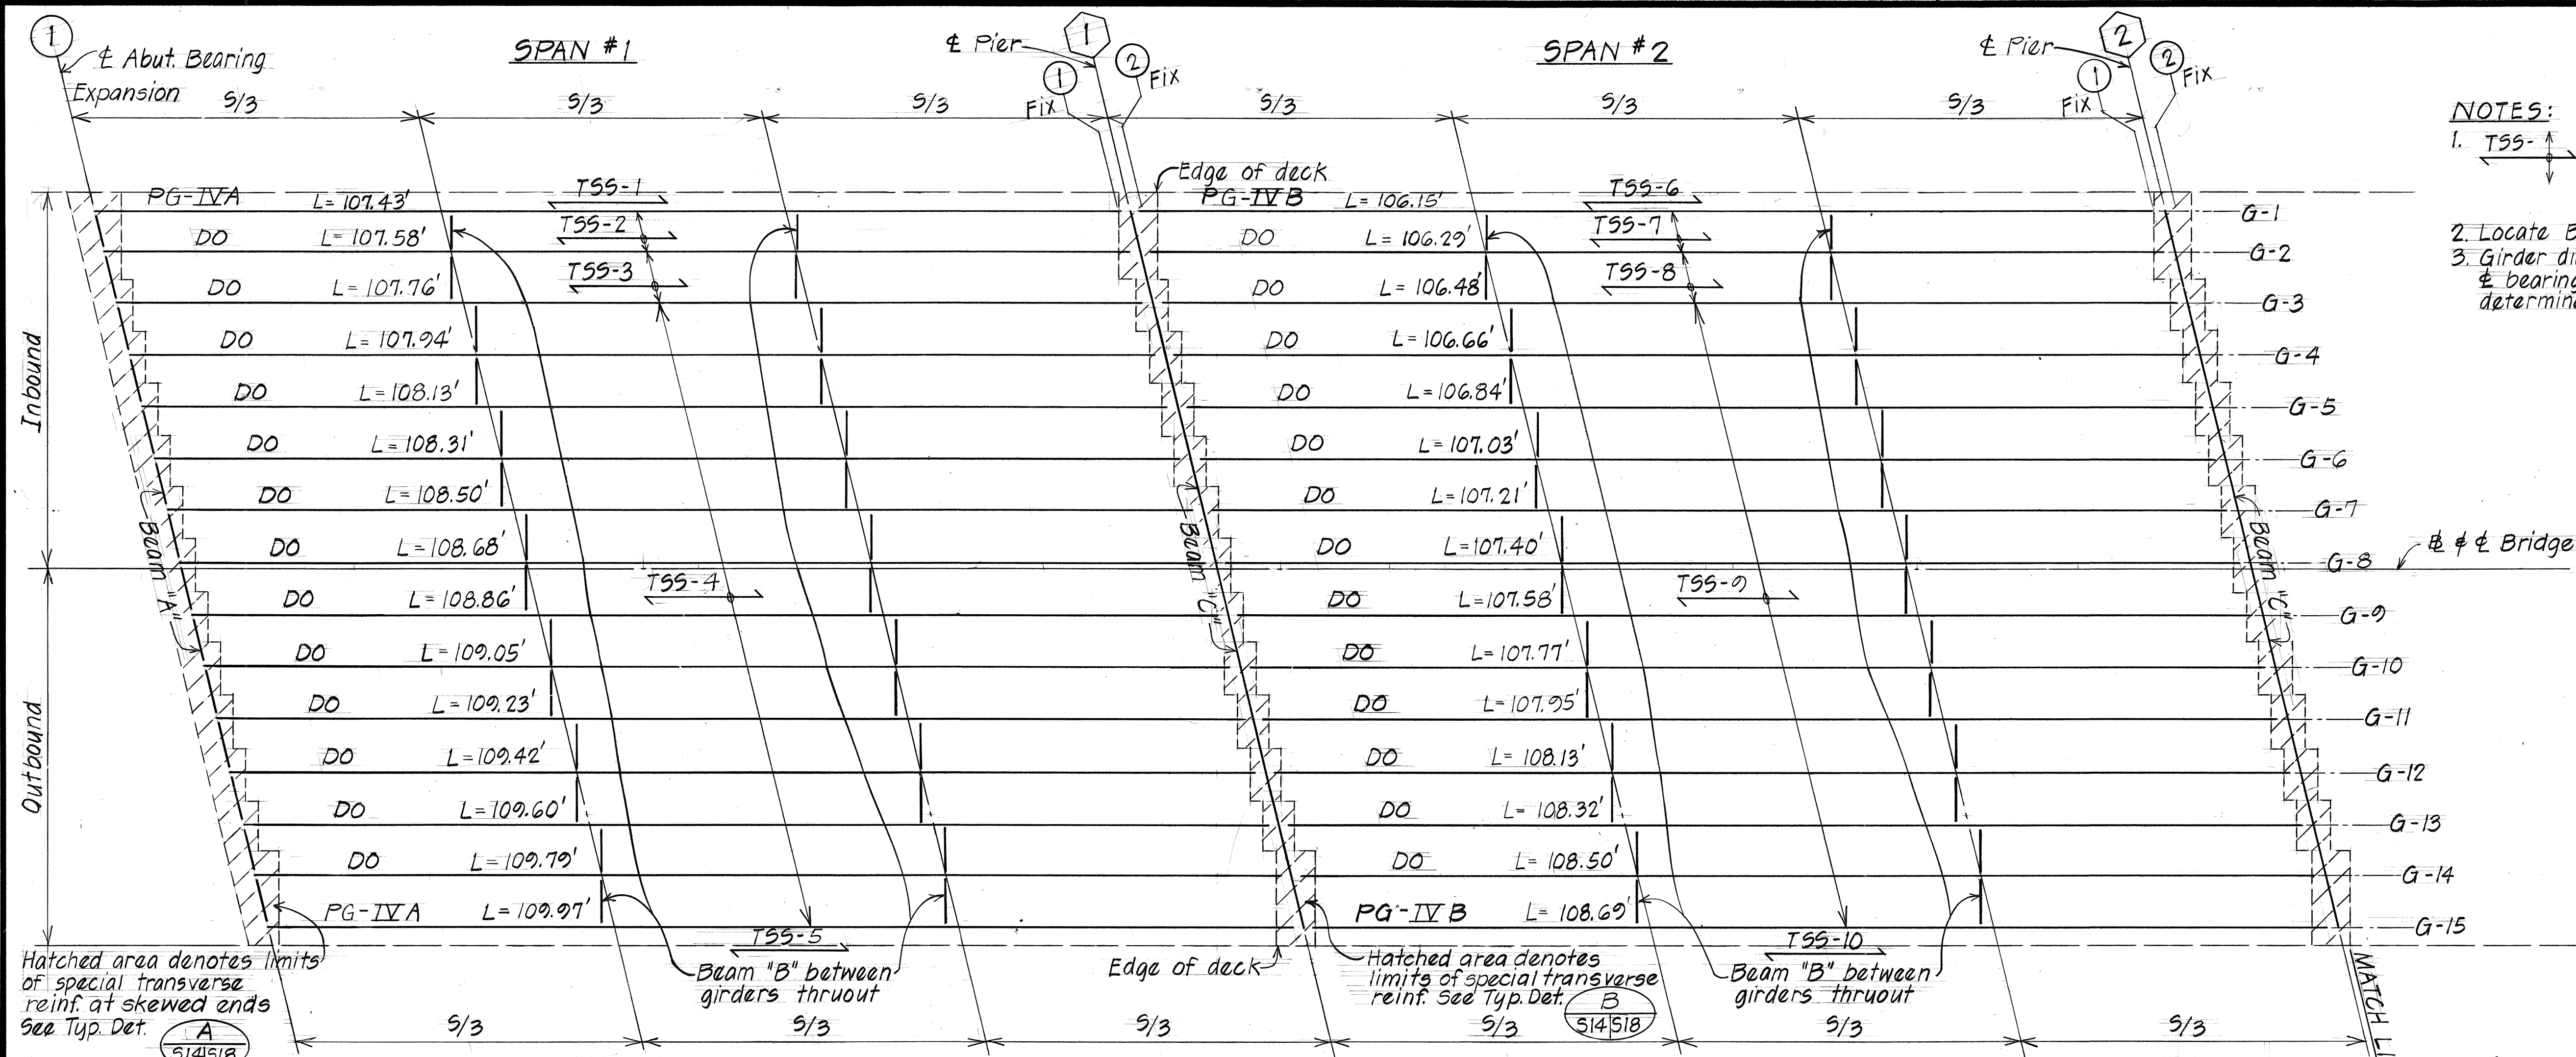


**PART DECK FRAMING PLAN**  
Scale: 1" = 10'-0"

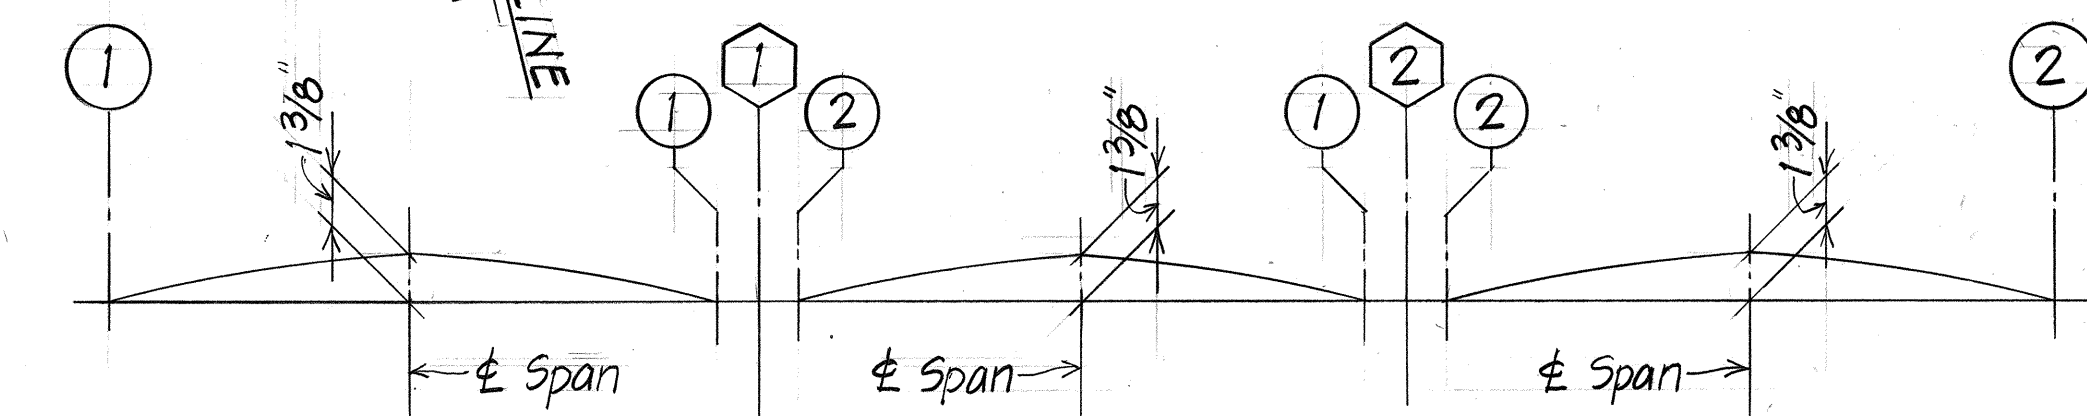

**SLAB CAMBER DIAGRAM**

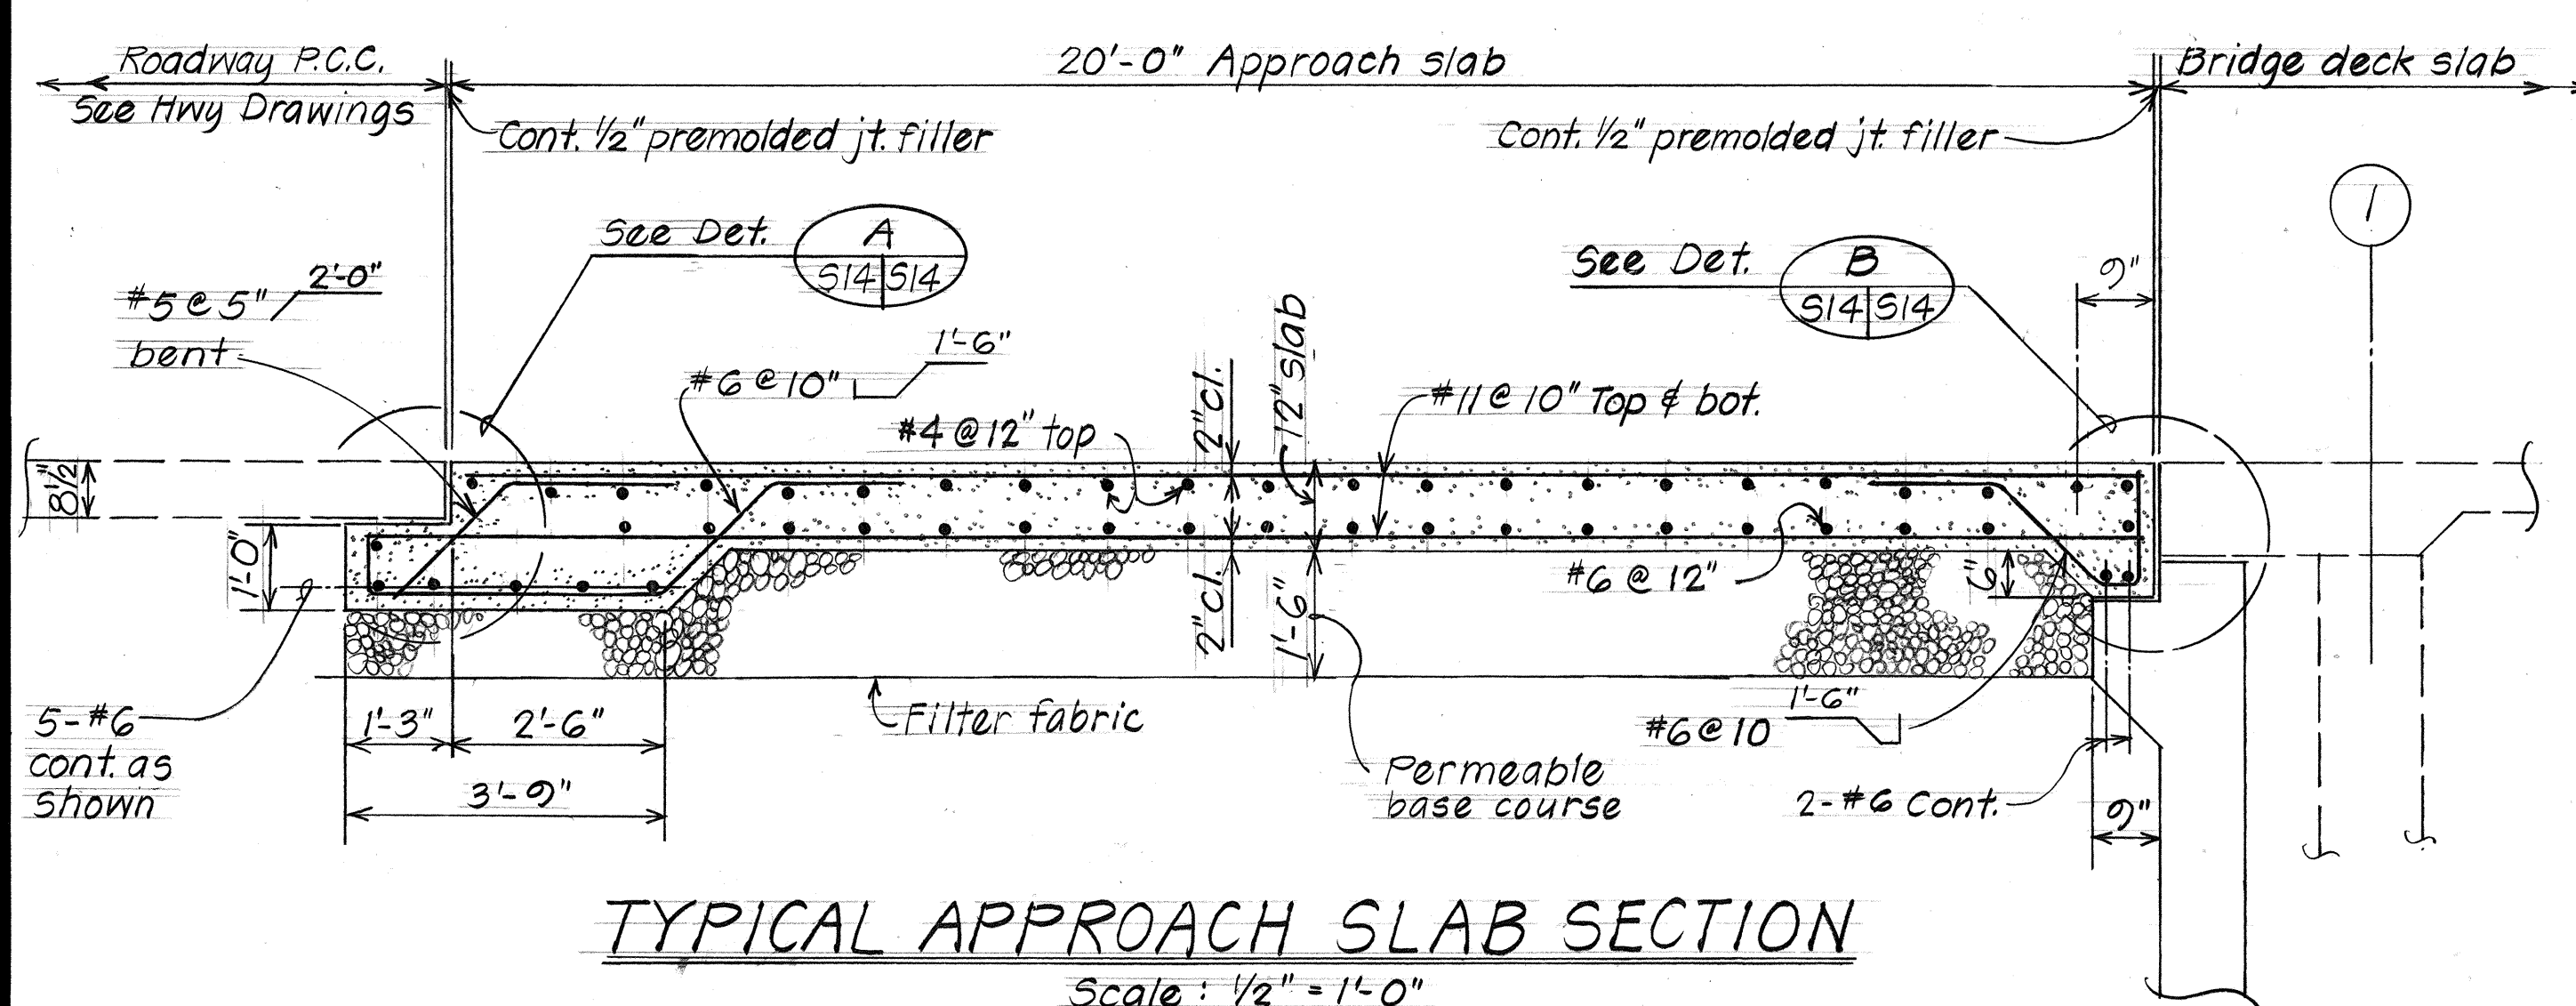

**TYPICAL APPROACH SLAB SECTION**  
Scale: 1/2" = 1'-0"

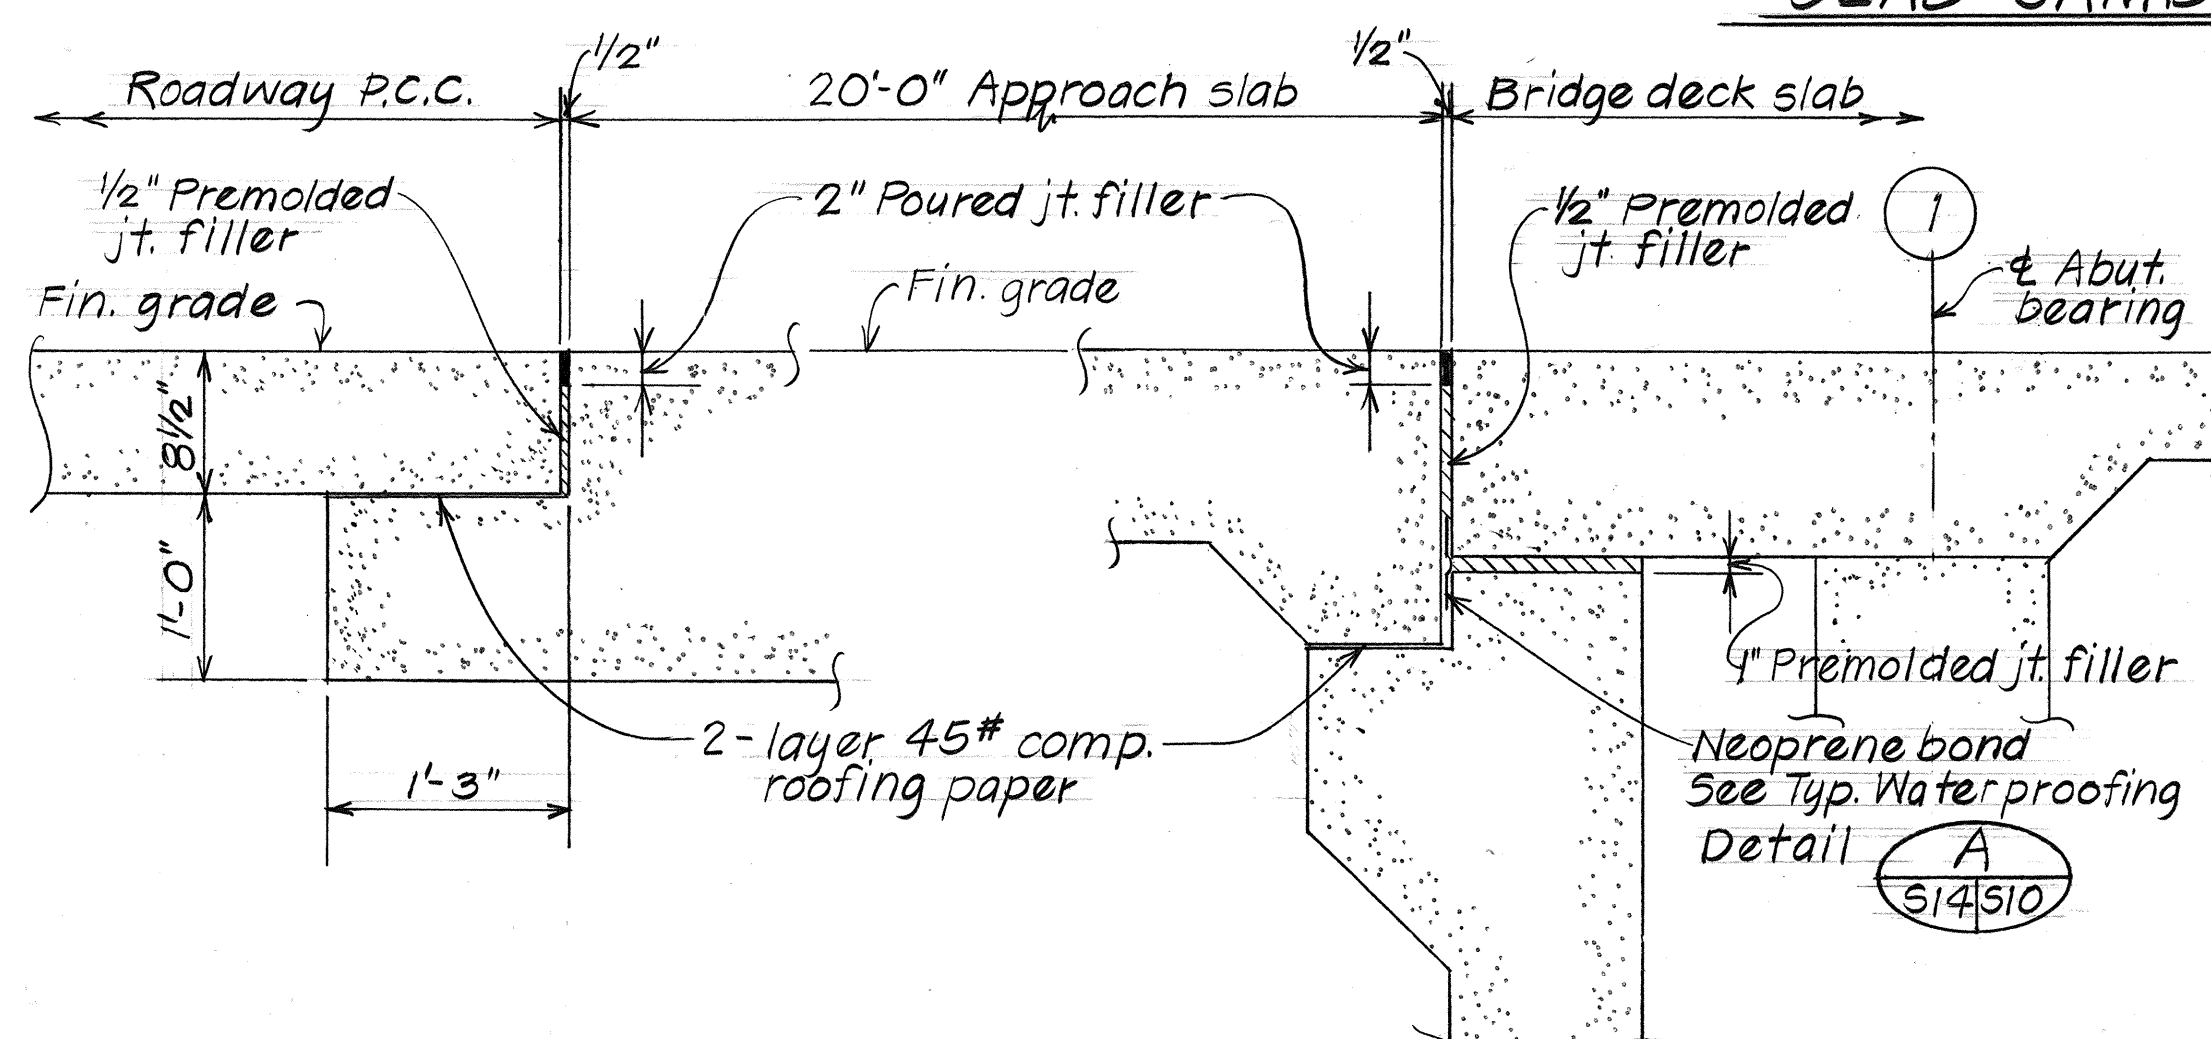



**DETAIL A**  
Scale: 1" = 1'-0"

**DETAIL B**  
Scale: 1" = 1'-0"

STATE OF HAWAII  
DEPARTMENT OF TRANSPORTATION  
LAND TRANSPORTATION FACILITIES DIVISION  
**ROUTE H-3 - KUOU STREAM BRIDGE**  
DECK FRAMING PLAN  
APPROACH SLAB DETAILS  
F.A.I. Proj. No. I-H3-1(50)  
KANEHOE I.C. TO HALEKOU I.C.  
Scale: As Noted Date: August 1987  
SHEET NO. 914 OF 35 SHEETS



|               |                                |               |
|---------------|--------------------------------|---------------|
| ORIGINAL PLAN | SURVEY PLOTTED BY              | DATE          |
|               | DRAWN BY <u>N.Y.</u>           | " <u>7/83</u> |
|               | TRACED BY _____                | " _____       |
| NOTE BOOK     | DESIGNED BY <u>D.C.O. D.W.</u> | " <u>7/83</u> |
|               | QUANTITIES BY <u>T.M.</u>      | " <u>7/83</u> |
| No. _____     | CHECKED BY <u>D.C.O.</u>       | " <u>7/83</u> |

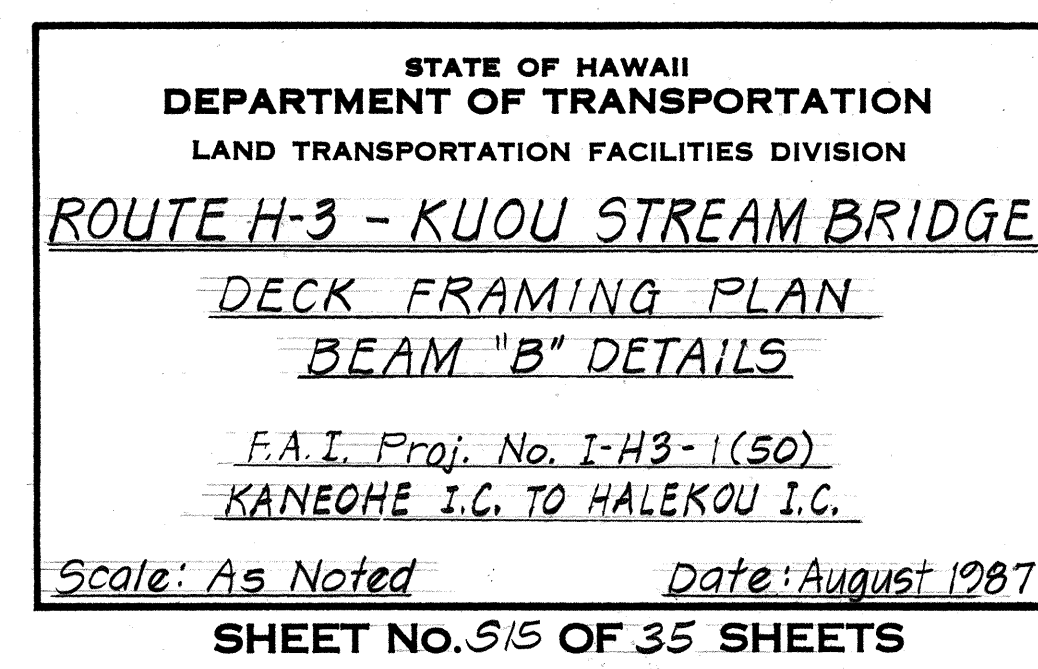
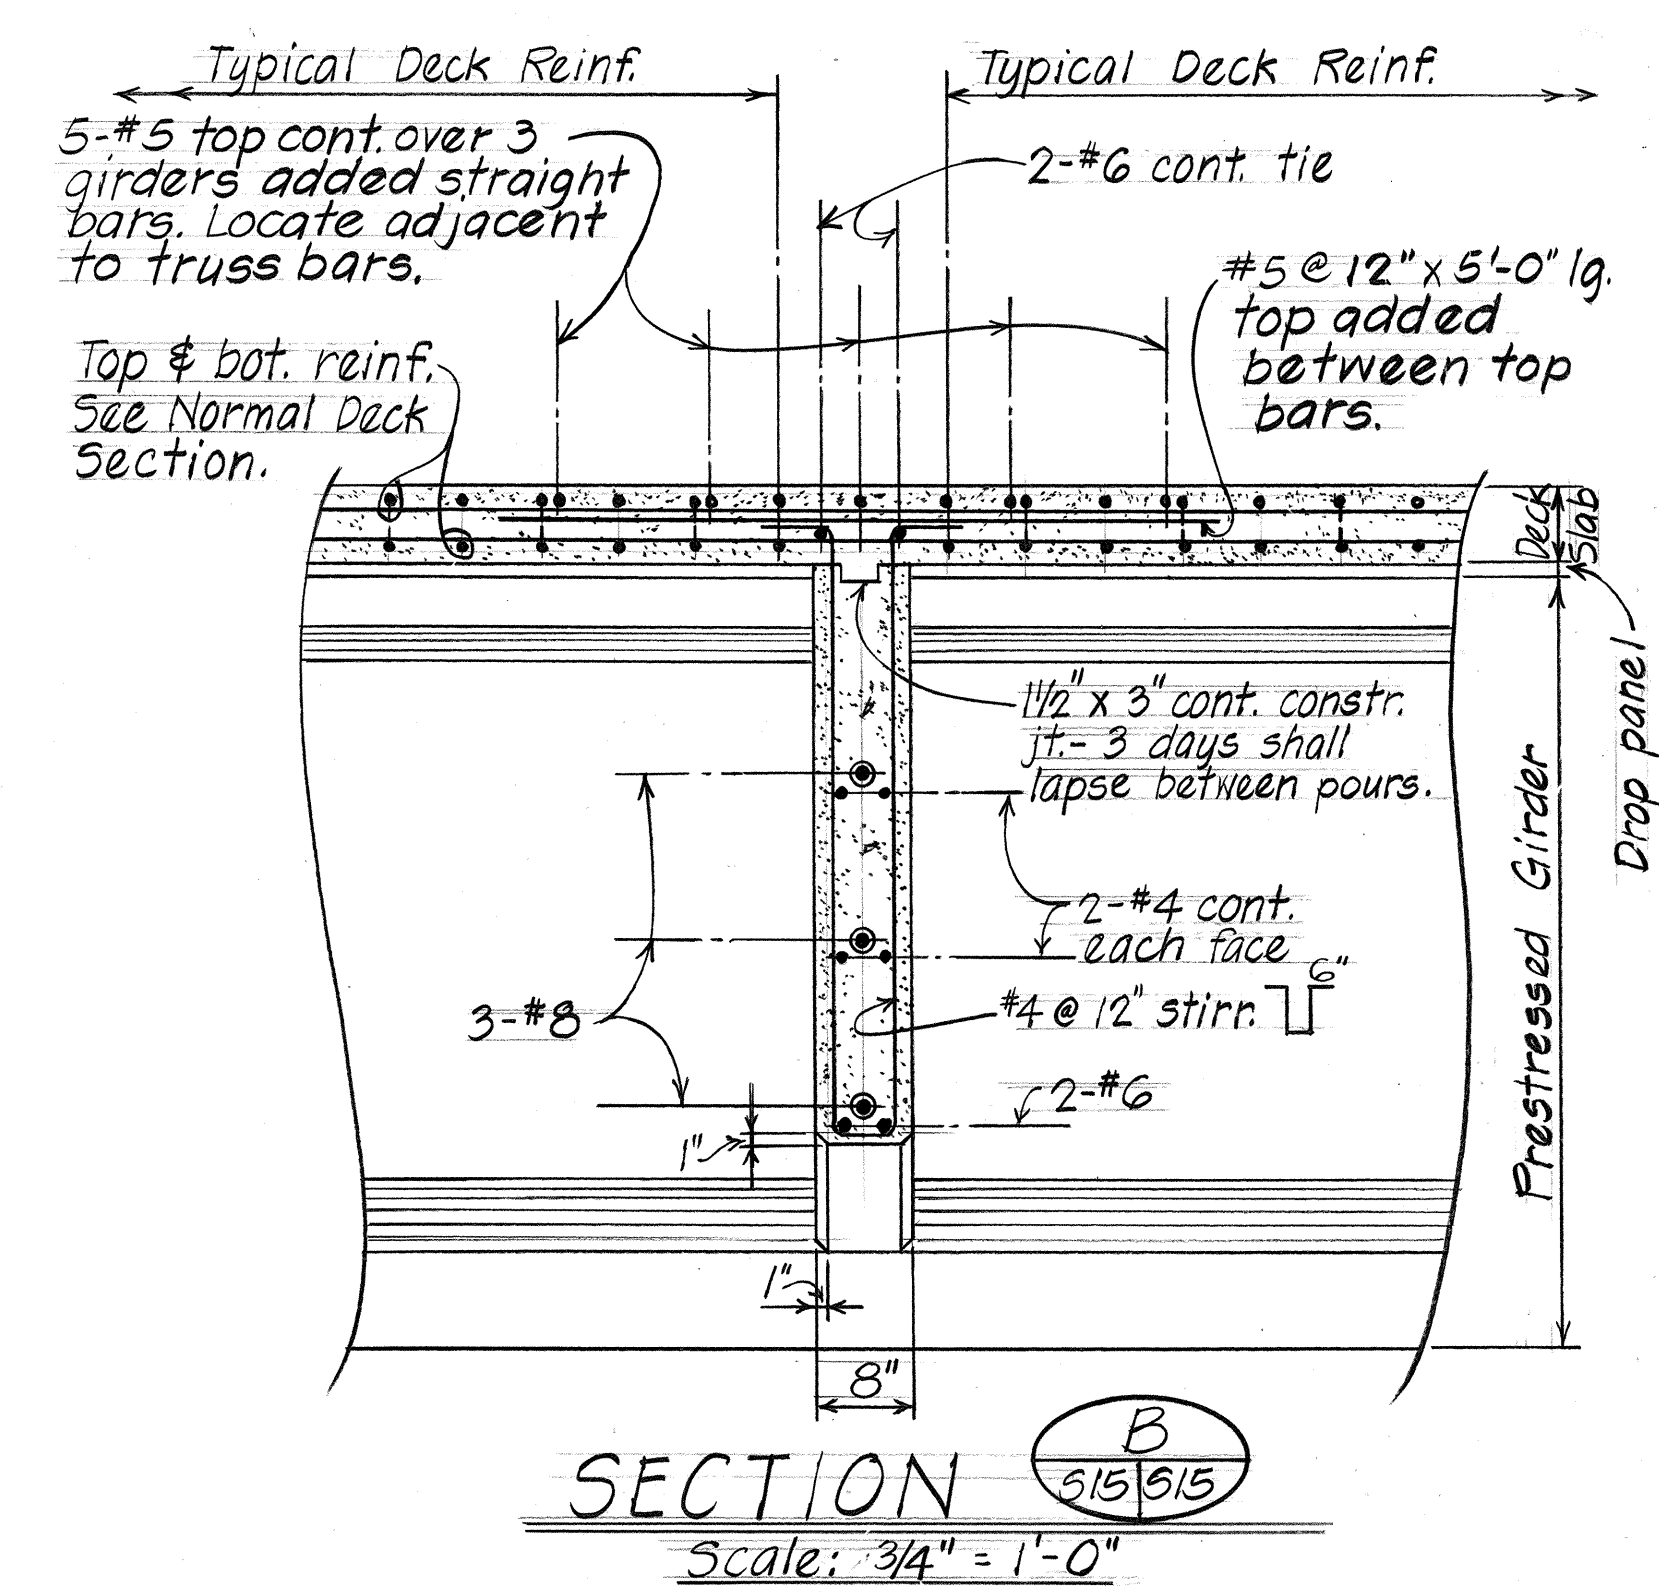








1. Strands may be bundled in groups as shown.
2. The minimum distance "S" between groups or individual strands: "2" for  $\frac{1}{2}$ " strands.
3. "S" is measured between centers of adjacent strands

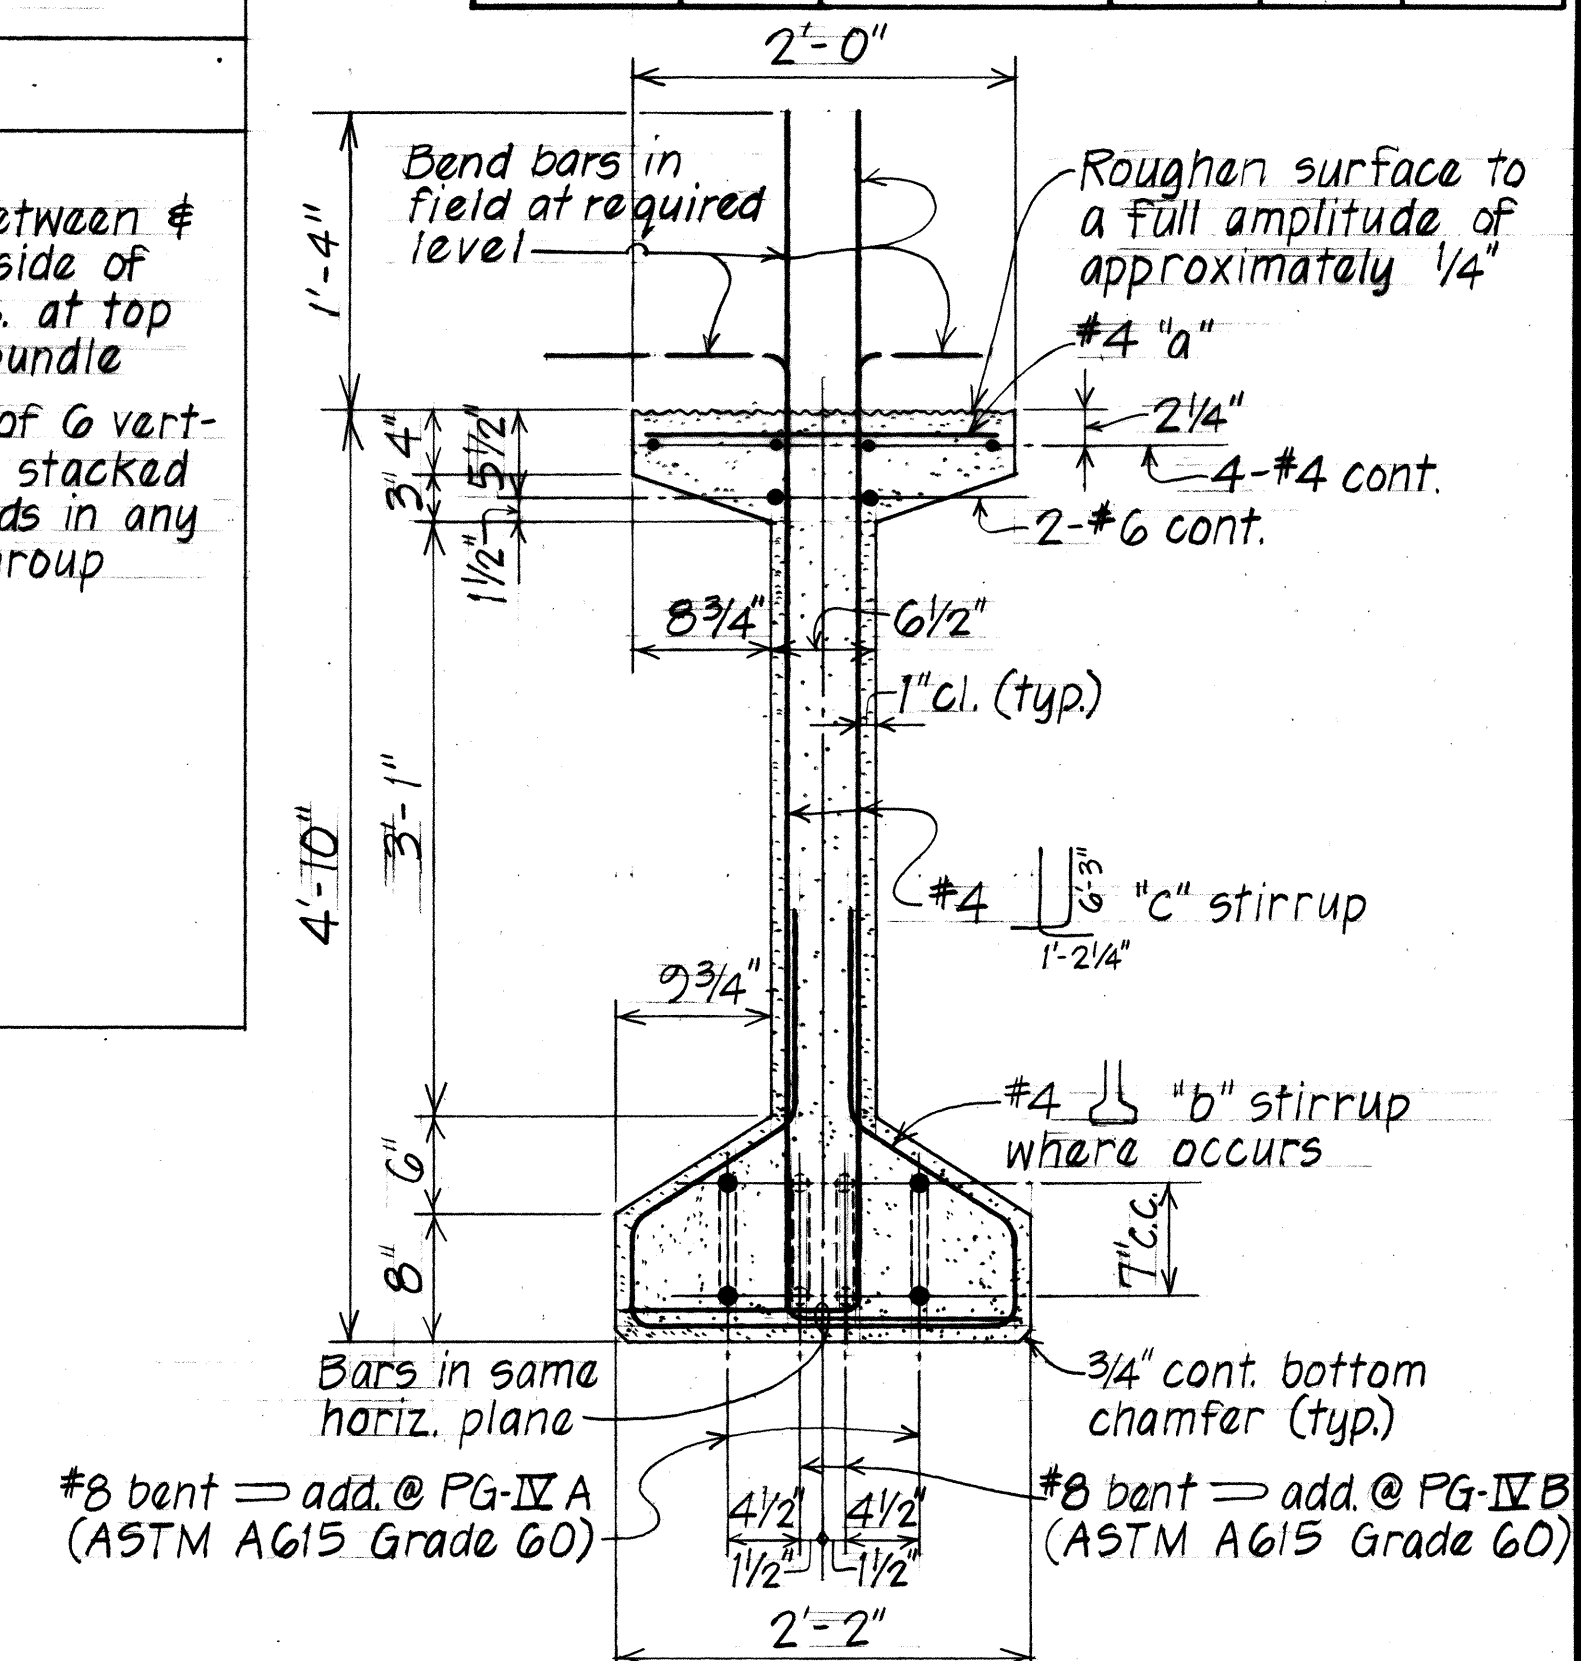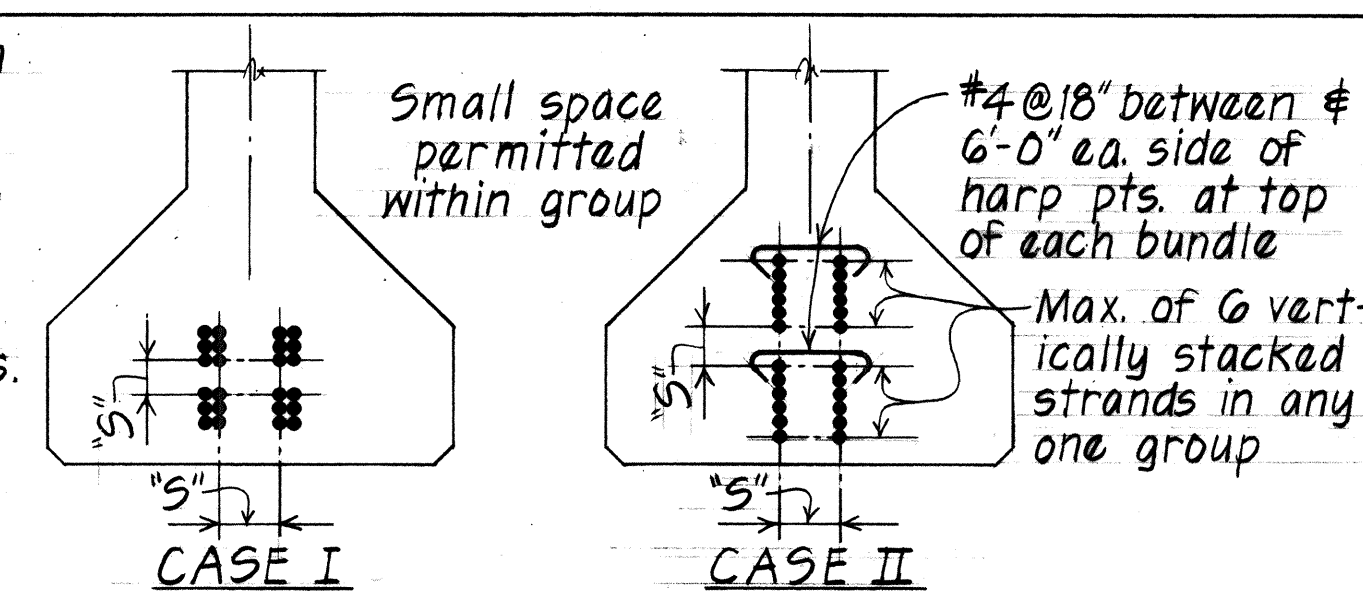

**ELEVATION ~ TYPE PG-IV GIRDER END DETAILS**

EXPANSION END (Left) | FIXED END (Right)

See typical Prestressed girder Diagram

No Scale

Final Working Force = 1012.10k

L = Length of girder - See framing plan

Ref. girder  $\pm$  bearing

$\pm$  Span #1  $\phi$  #3

1'-3"

10"

867.5k

722.9k

626.5k

Girder Depth

C.G. Prestressing Forces

Hold down point

4"

11'-0"

11'-0"

12'-8"

14"

16"

18 1/2"

20 7/8"

23 1/8"

25 1/2"

5'-6"

11'-0"

16'-6"

Span #1  $\phi$  #3

Stirr. spc'g. - See girder end detail above

#4 "a", "b"  $\phi$  "c" stirrups ea. spacing

8 @ 4 1/2", 10 @ 5", 18 @ 6", 15 @ 8", 8 @ 10"

#4 "a", "c" stirrups ea. spacing

Balance @ 12"

#4 "a", "b"  $\phi$  "c" stirrups ea. spacing

7 @ 10", 18 @ 8", 22 @ 6", 10 @ 5", 21 @ 4"

Stirrup sp. See girder detail above

EXPANSION END SUPPORT

FIXED END SUPPORT

TYPICAL TYPE PG-IVA GIRDER DETAIL  
No Scale

EXPANSION END SUPPORT

FIXED END SUPPORT

1

2

1'-3"

10"

Final Working Force = 1012.10k

L = Length of girder - See framing plan

Span #2 symm. about C

867.5k

722.9k

626.5k

1'-3"

10"

Girder Depth

C.G. Prestressing Forces

Hold down point

4"

11'-0"

12 3/8"

14"

16"

18 1/2"

20 1/8"

23 1/8"

5'-6"

11'-0"

16'-6"

75 1/2"

#4 "a", "c" stirrups ea. spacing

#4 "a", "b" # "c" stirrups ea. spacing

Balance @ 12"

6 @ 10", 16 @ 8", 22 @ 6", 9 @ 5", 15 @ 4", 8 @ 3 1/2"

Span #2

Stirrups spacing  
See girder end  
detail above

$f_c = 6000$  psi @ 28 days  
 $f_{ci} = 4750$  psi @ transfer-for girder dim.  $L = 108'-9"$  or greater  
 4850 - All others

A.  $\frac{1}{2}" \phi$  270 ksi, 7 wire stressed-relieved strands (ASTM A416)  
Total losses other than friction = 45,000 psi

B. Allowable stresses in strands shall be in accordance with Design Specifications (See General Structure Notes)

STATE OF HAWAII  
DEPARTMENT OF TRANSPORTATION  
LAND TRANSPORTATION FACILITIES DIVISION

ROUTE H-3 - KUOU STREAM BRIDGE  
TYP. PRESTRESSED CONC. GIRDER DETAILS  
TYPE PG-IV A & PG-IV B


F.A.I. Proj. No. I-H3-1(50)  
KANEHOE I.C. TO HALEKOU I.C.

Scale: As Noted Date: August 1967

**SHEET No. 317 OF 35 SHEETS**



| FED. ROAD DIST. NO. | STATE | FED. AID PROJ. NO. | FISCAL YEAR | SHEET NO. | TOTAL SHEETS |
|---------------------|-------|--------------------|-------------|-----------|--------------|
| HAWAII              | HAW.  | I-H3-1(50)         | 1987        | 77        | 164          |

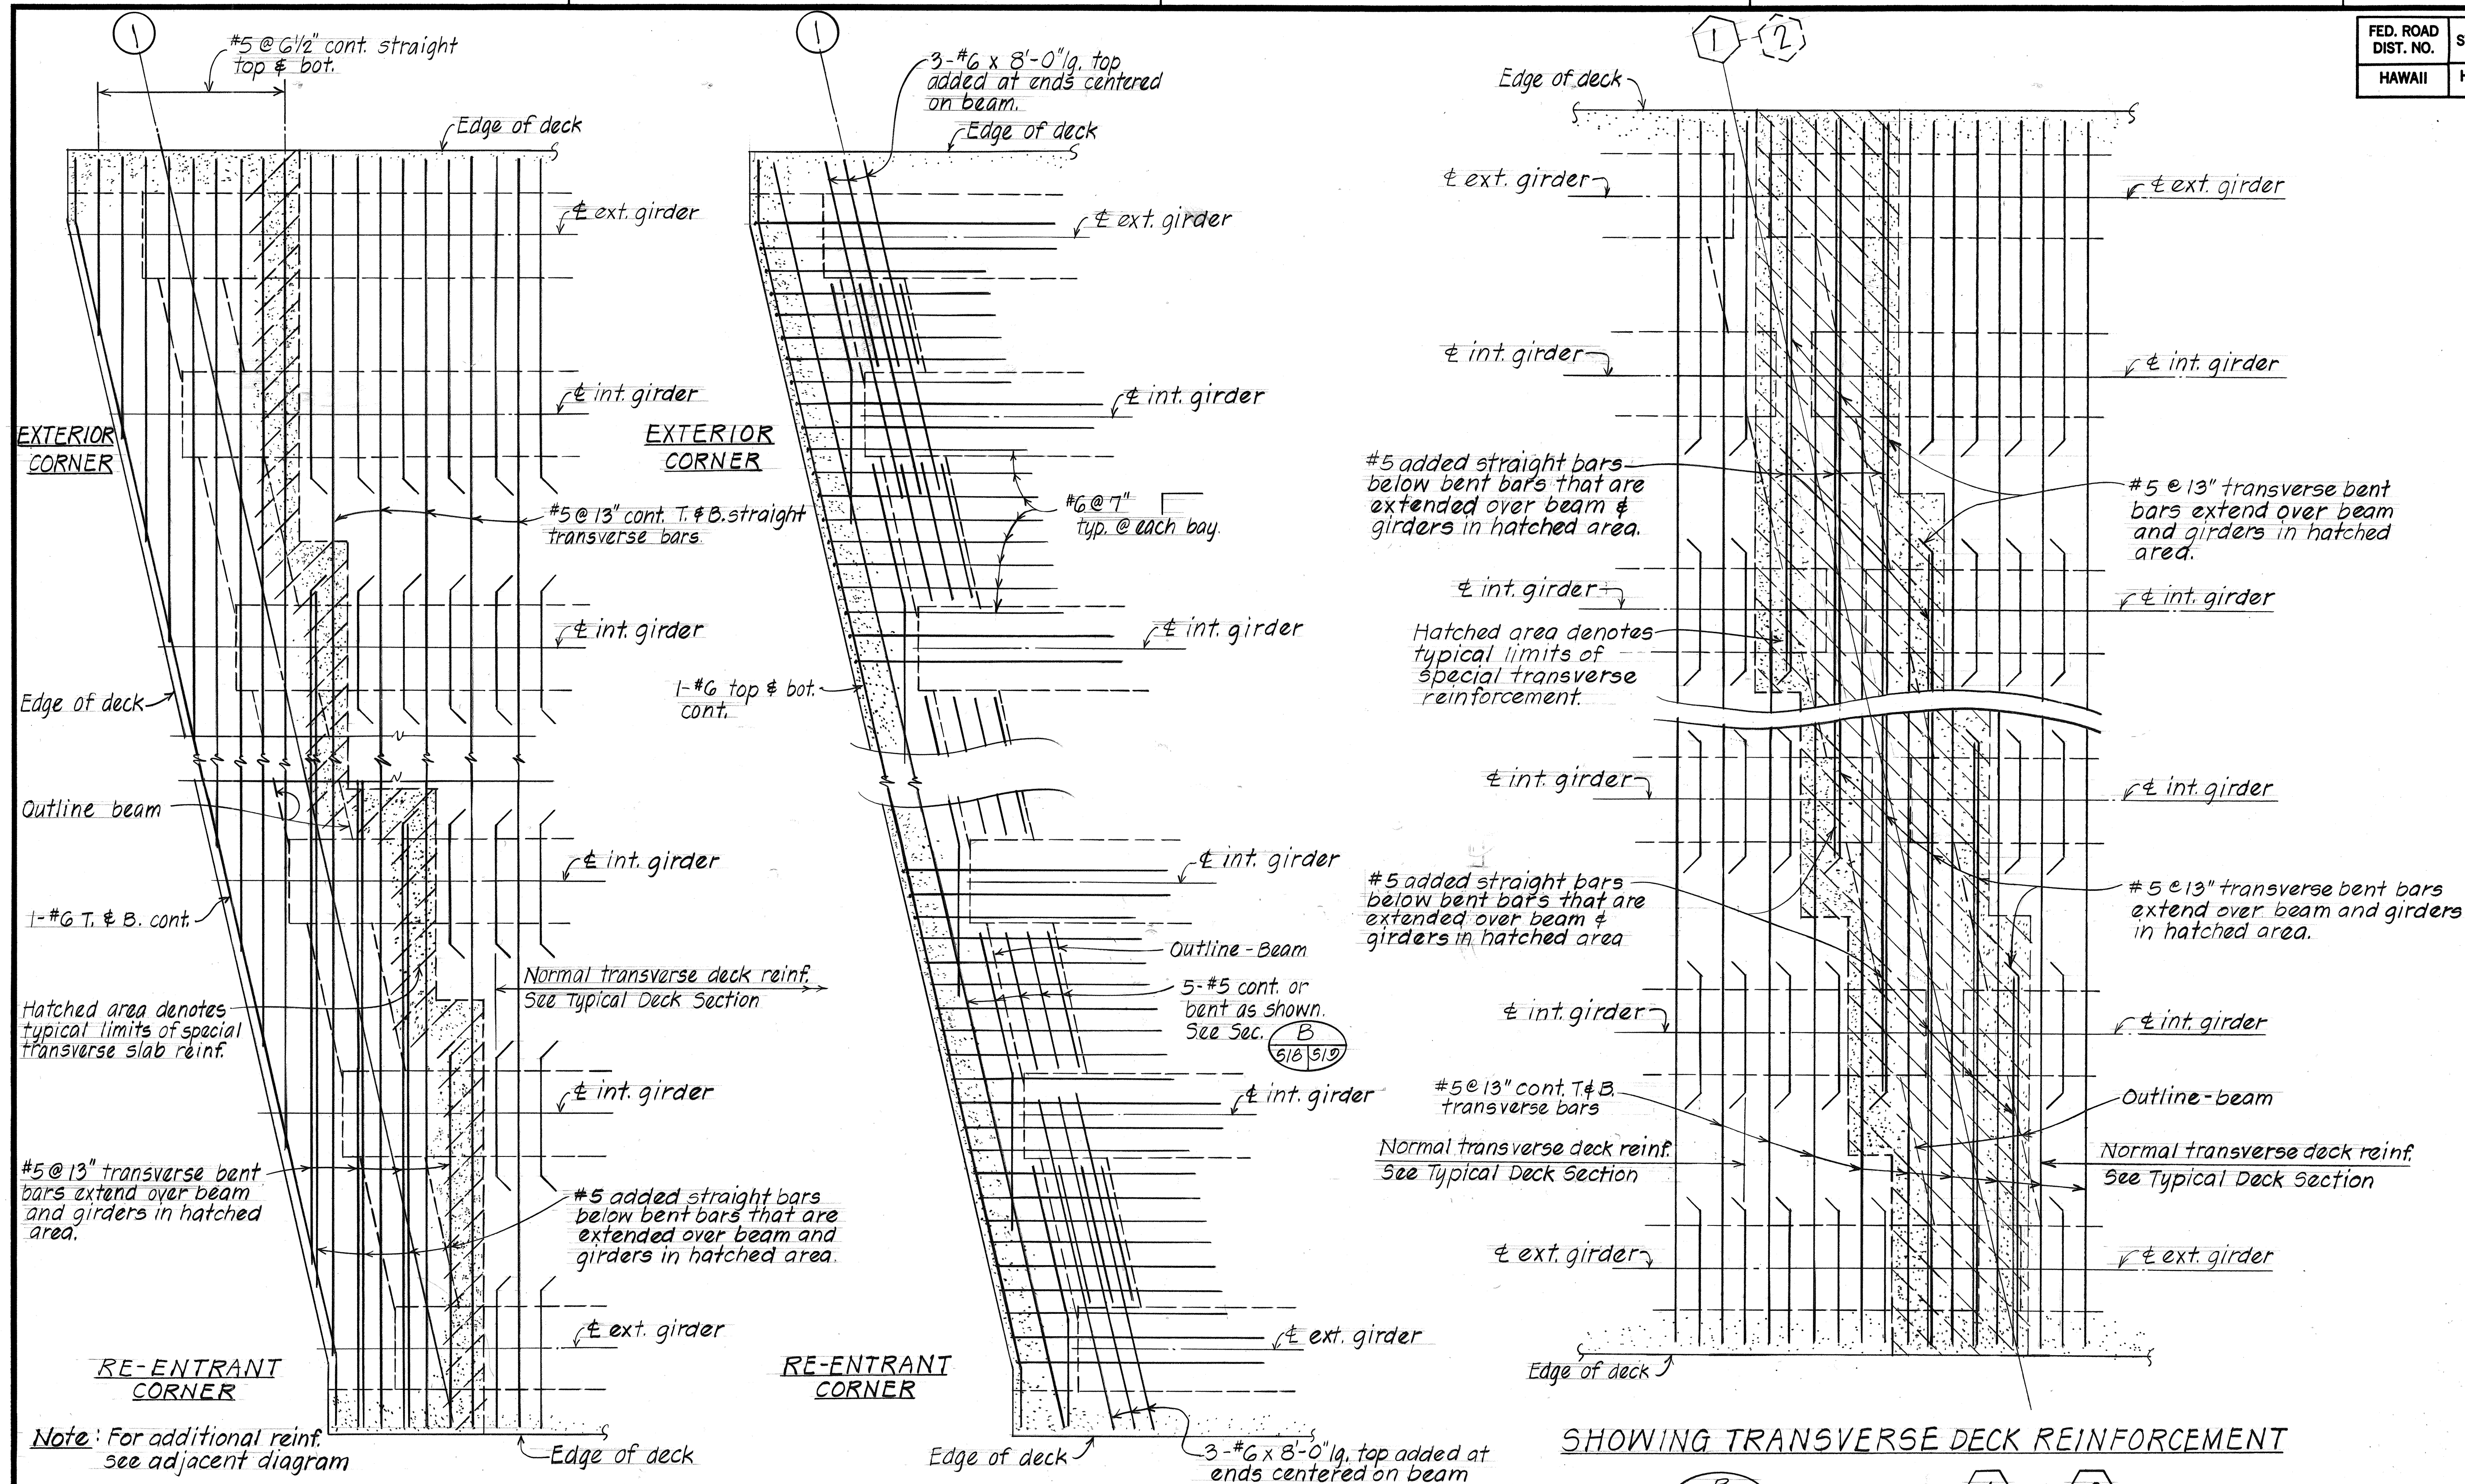

Note: For additional reinf. see adjacent diagram

SHOWING TRANSVERSE DECK REINFORCEMENT

ABUTMENT ① AS SHOWN

ABUTMENT ② SIMILAR EXCEPT AS OTHERWISE NOTED

SHOWING ADDED REINFORCEMENT

SHOWING TRANSVERSE DECK REINFORCEMENT

AT PIER ① & ②


# PART PLAN- SPECIAL DECK REINFORCEMENT AT ABUTMENTS & PIERS

Scale: 1/2" = 1'-0"


|                                         |                   |
|-----------------------------------------|-------------------|
| STATE OF HAWAII                         |                   |
| DEPARTMENT OF TRANSPORTATION            |                   |
| LAND TRANSPORTATION FACILITIES DIVISION |                   |
| ROUTE H-3 - KUOU STREAM BRIDGE          |                   |
| PART PLAN                               |                   |
| SPECIAL DECK REINF. AT ABUTS. & PIERS   |                   |
| F.A.I. Proj. No. I-H3-1(50)             |                   |
| KANEHOE I.C. TO HALEKOU I.C.            |                   |
| Scale: As Noted                         | Date: August 1987 |
| SHEET No. 518 OF 35 SHEETS              |                   |




| FED. ROAD DIST. NO. | STATE | FED. AID PROJ. NO. | FISCAL YEAR | SHEET NO. | TOTAL SHEETS |
|---------------------|-------|--------------------|-------------|-----------|--------------|
| HAWAII              | HAW.  | I-H3-1(50)         | 1989        | 100       | 164          |

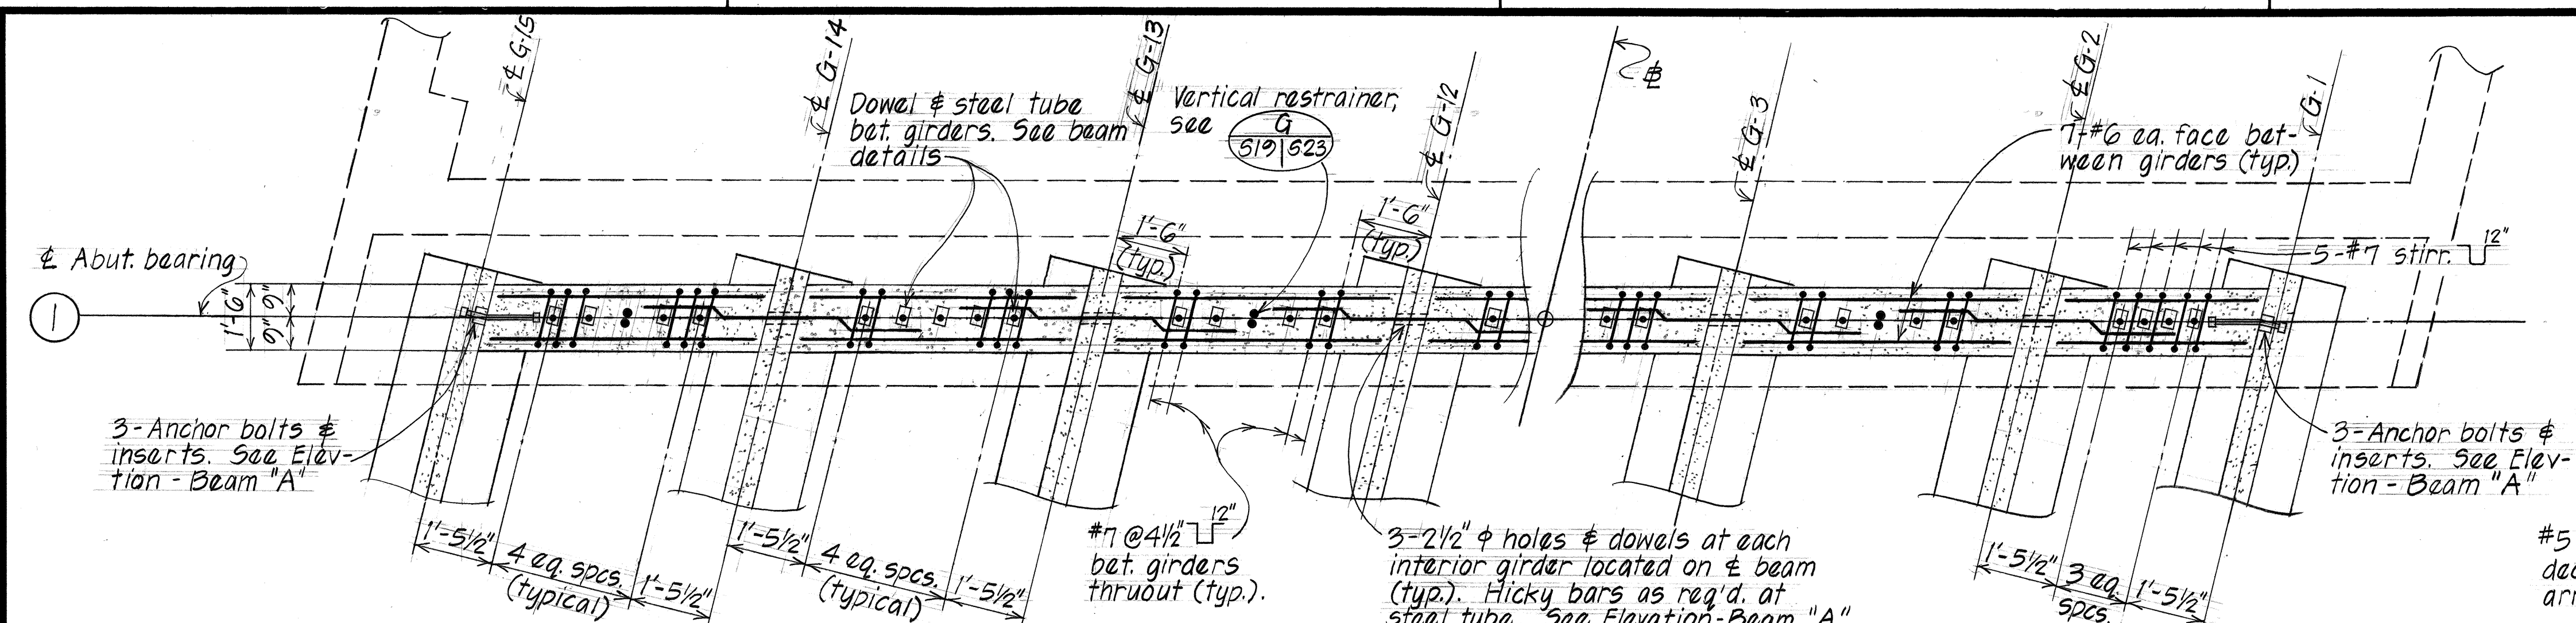


**SECTION A**  
Scale: 1/2" = 1'-0"

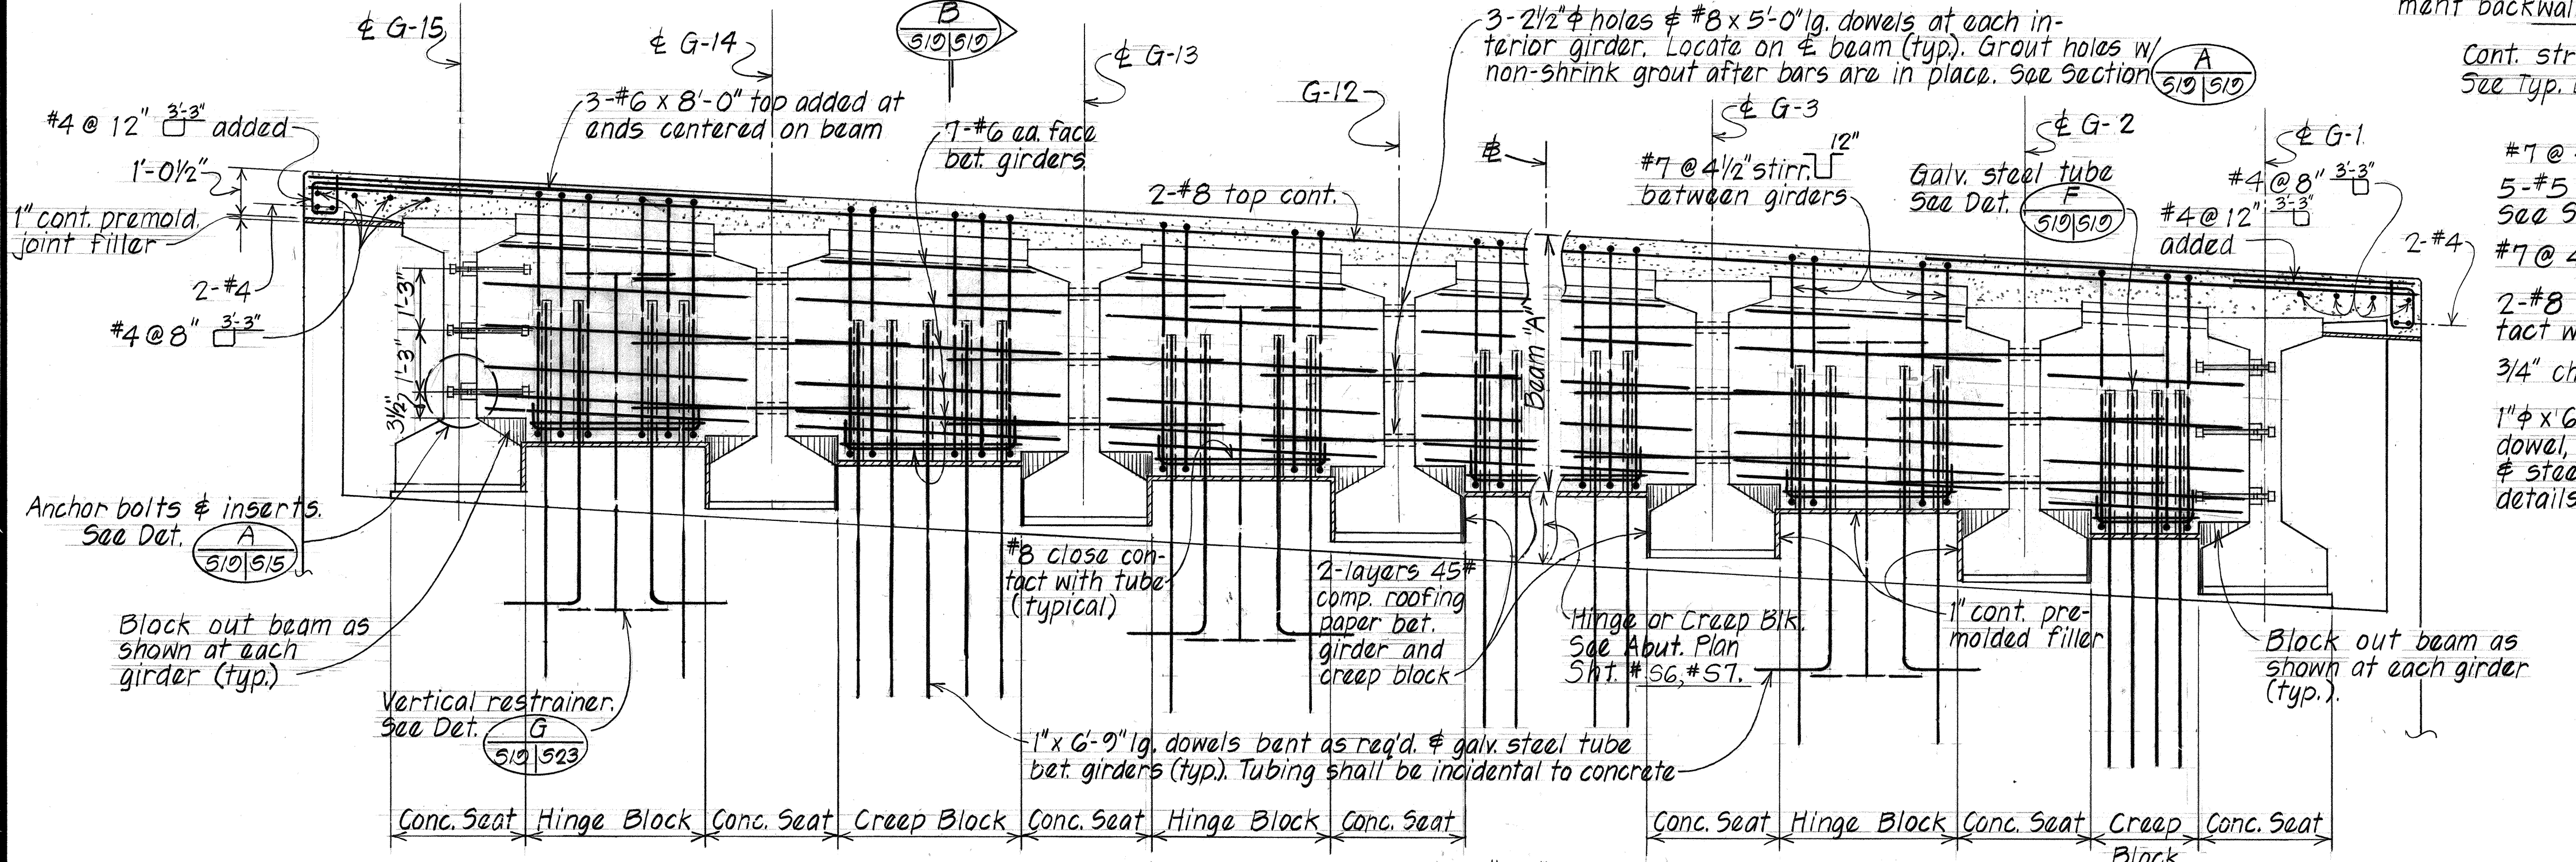


**PART ELEVATION - BEAM "A" AS SHOWN**  
Scale: 1/2" = 1'-0"  
(BEAM "A" SIMILAR EXCEPT OPPOSITE HAND AND AS NOTED OTHERWISE)

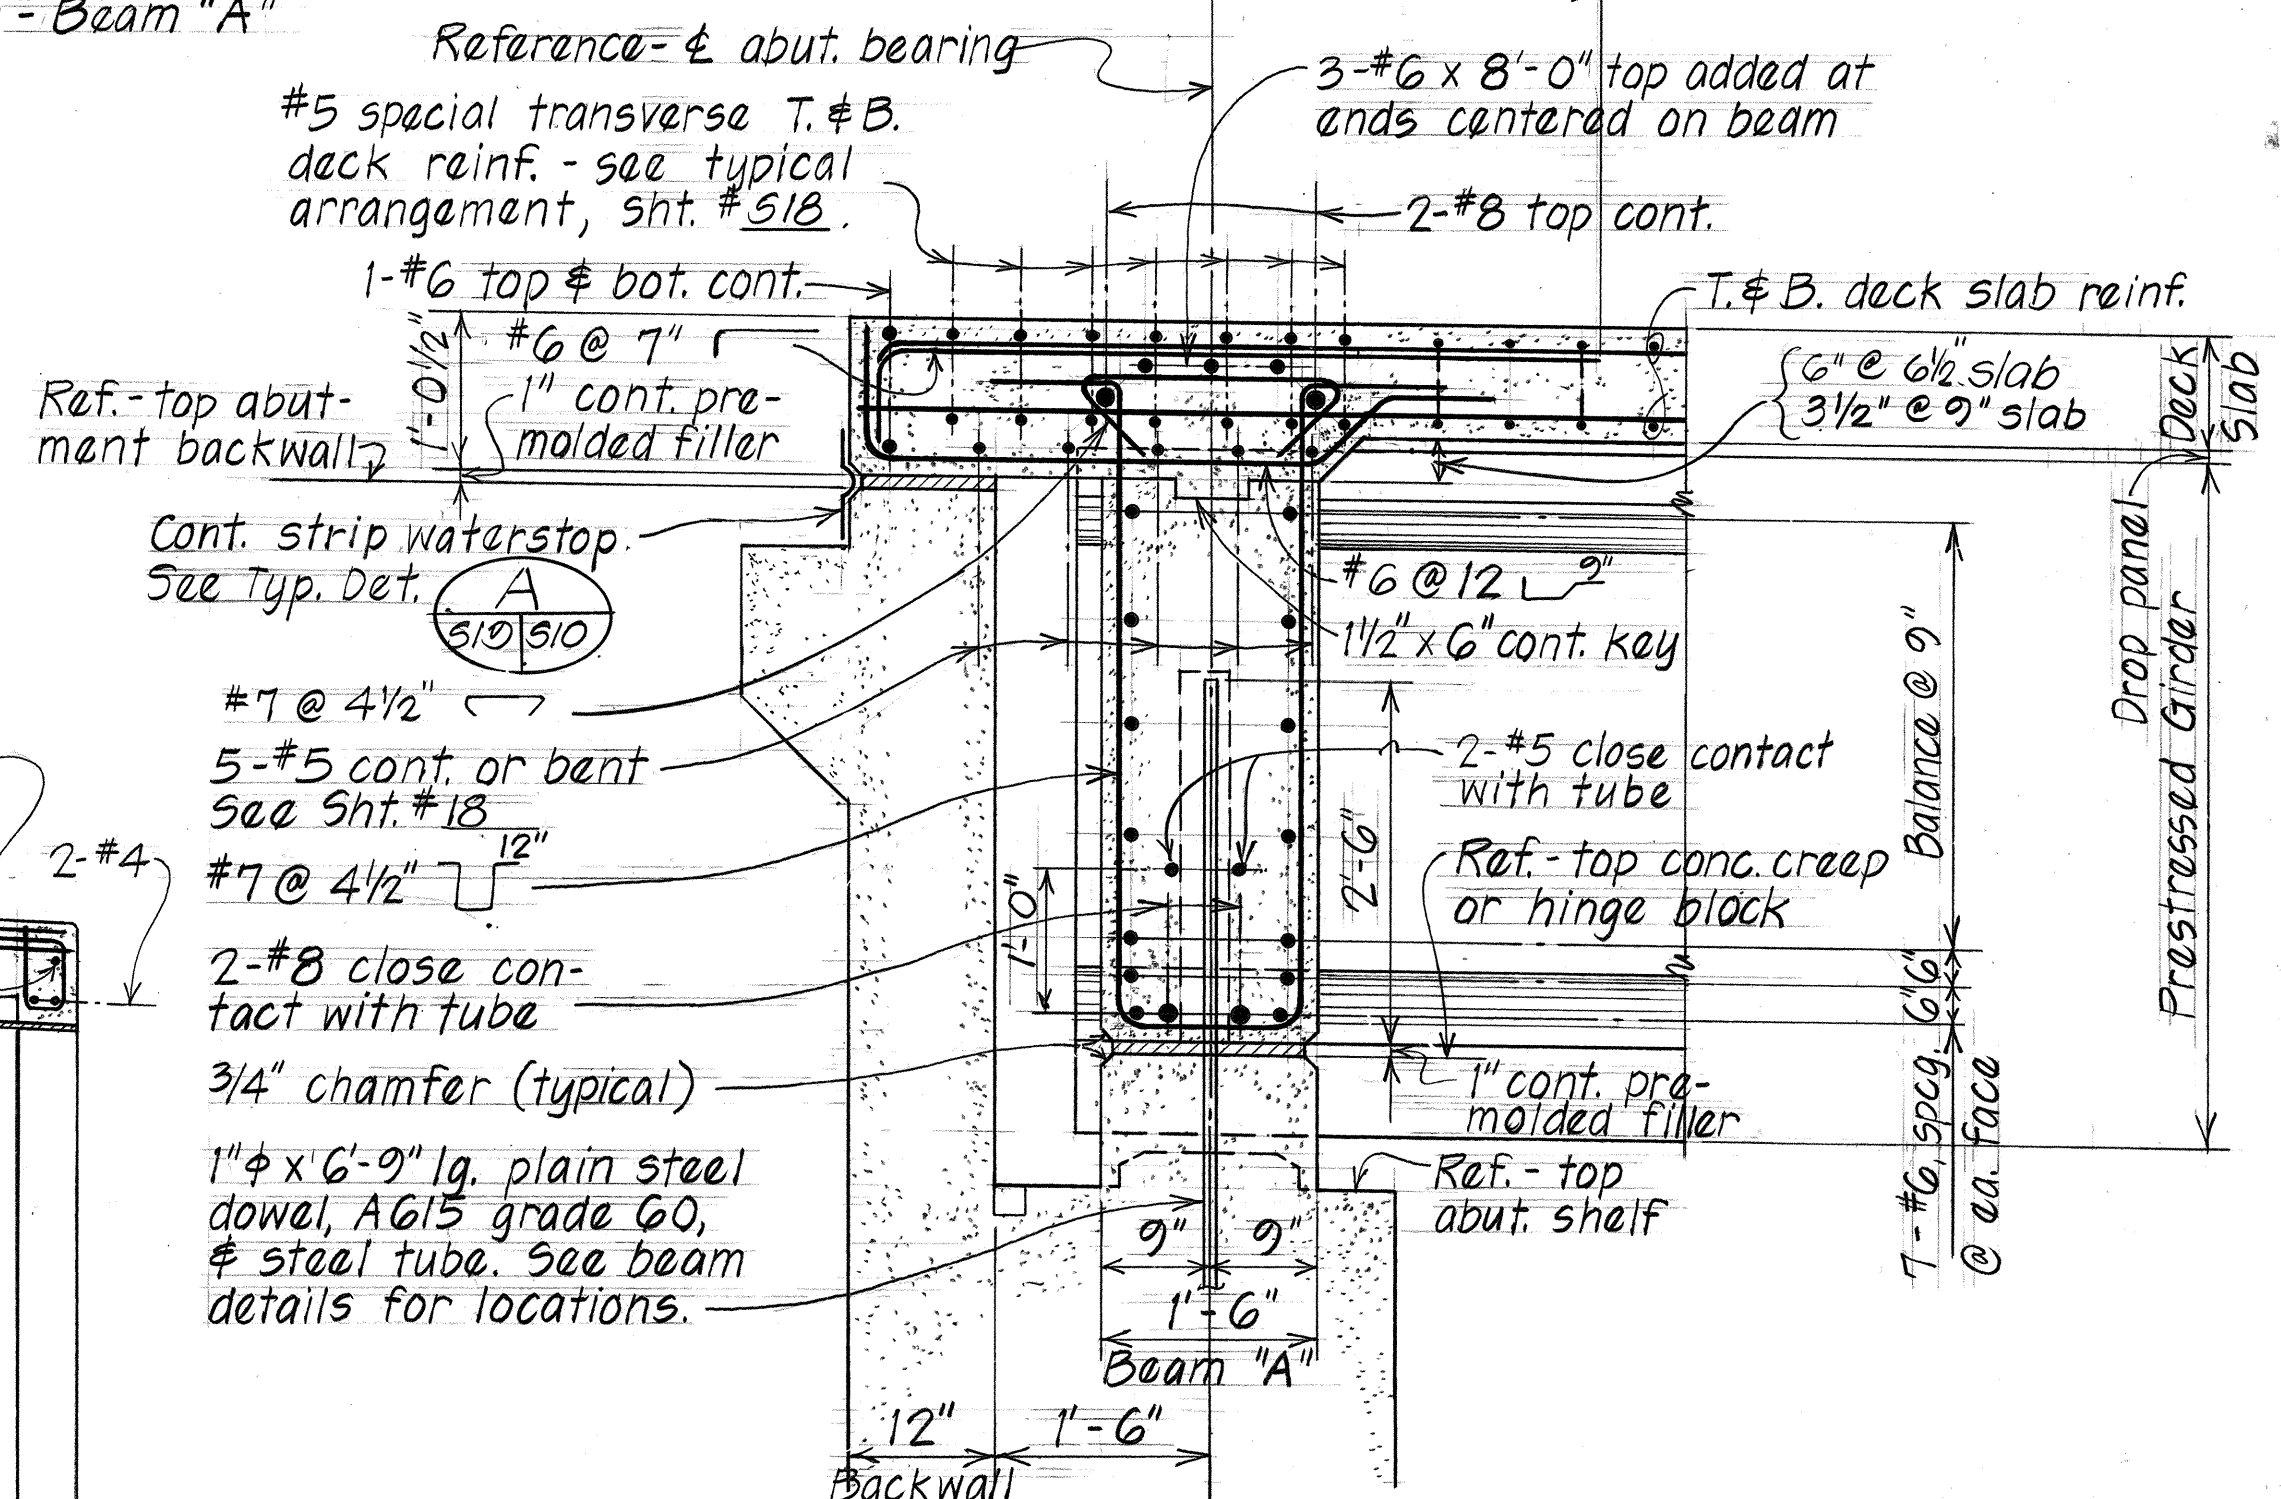

**SECTION B**  
Scale: 3/4" = 1'-0"

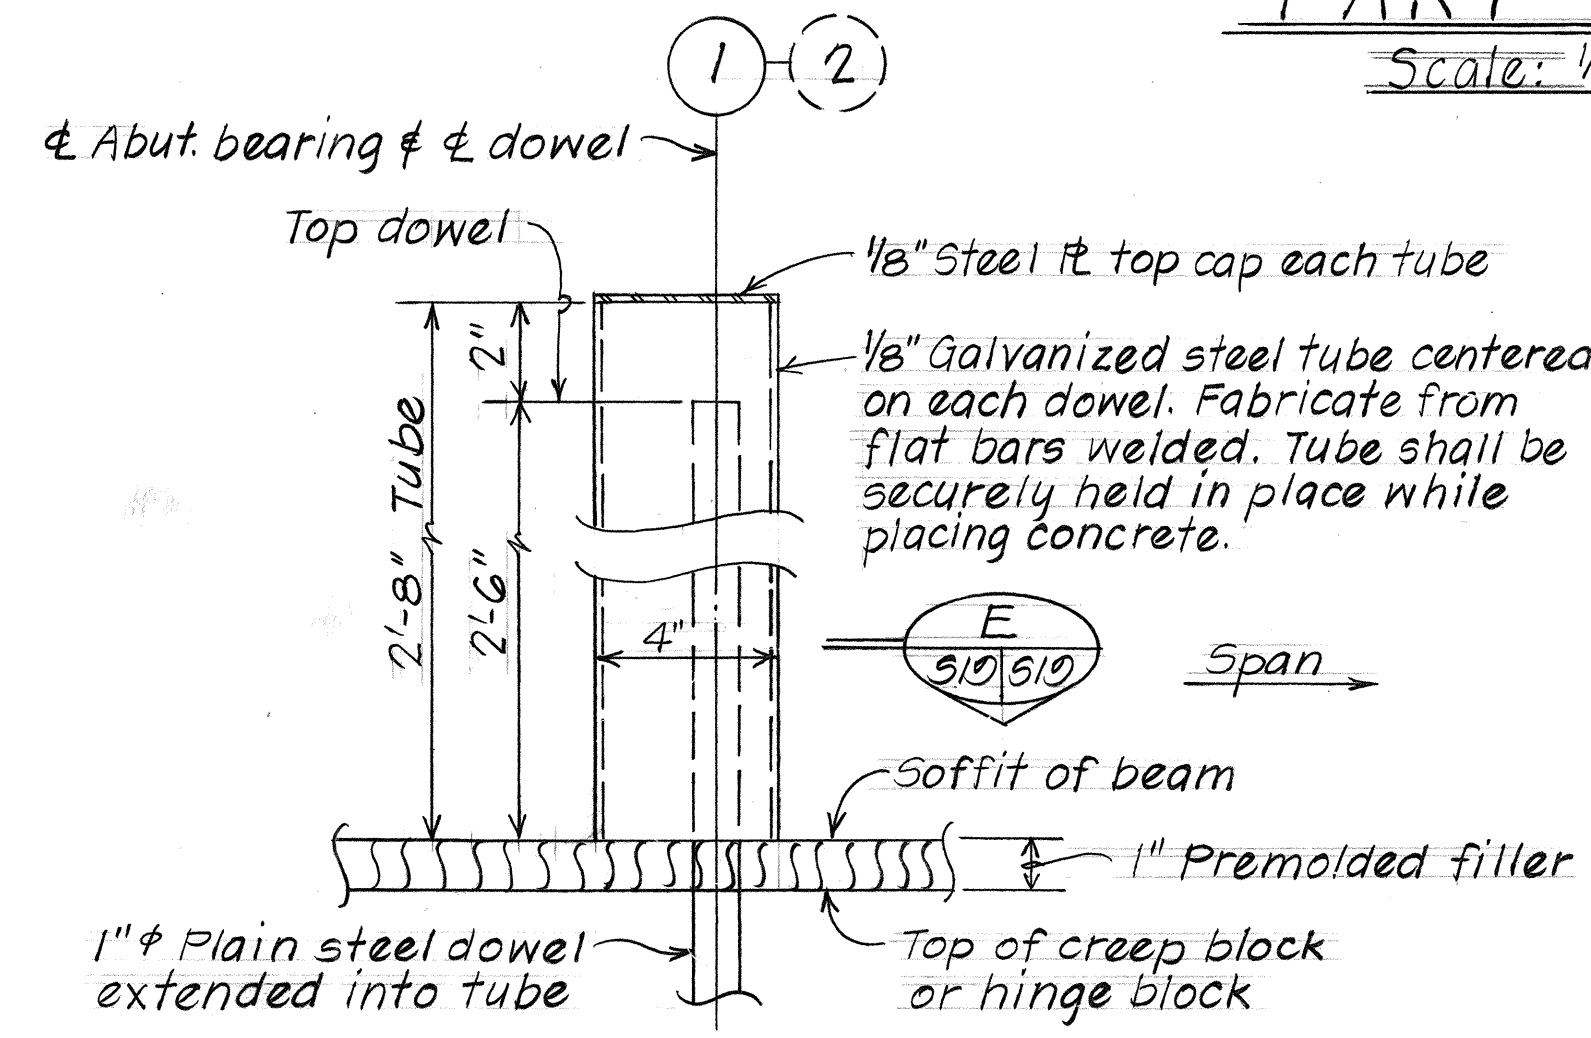

**ELEVATION**

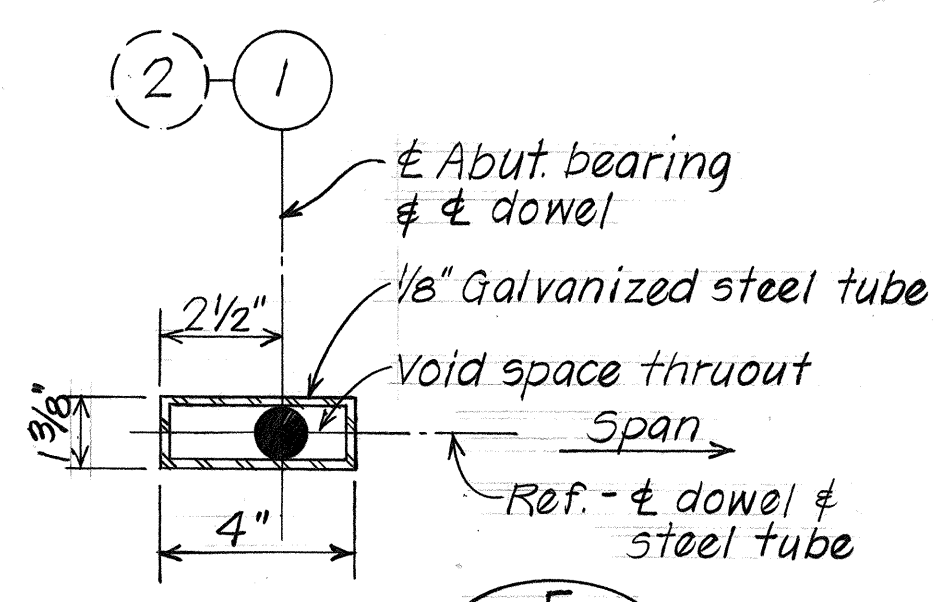






**SECTION E**

**TYP. DETAIL - EXP. END HINGE DOWEL & METAL TUBE**  
Scale: 3" = 1'-0"

STATE OF HAWAII  
DEPARTMENT OF TRANSPORTATION  
LAND TRANSPORTATION FACILITIES DIVISION  
**ROUTE H-3 - KUOU STREAM BRIDGE**  
**BEAM "A" DETAILS**  
F.A.I. Proj. No. I-H3-1(50)  
KANELOHE I.C. TO HALELOU I.C.  
Scale: As Noted Date: August 1987  
SHEET No. 510 OF 35 SHEETS



| FED. ROAD DIST. NO. | STATE | FED. AID PROJ. NO. | FISCAL YEAR | SHEET NO. | TOTAL SHEETS |
|---------------------|-------|--------------------|-------------|-----------|--------------|
| HAWAII              | HAW.  | I-H3-1(50)         | 1989        | 101       | 164          |

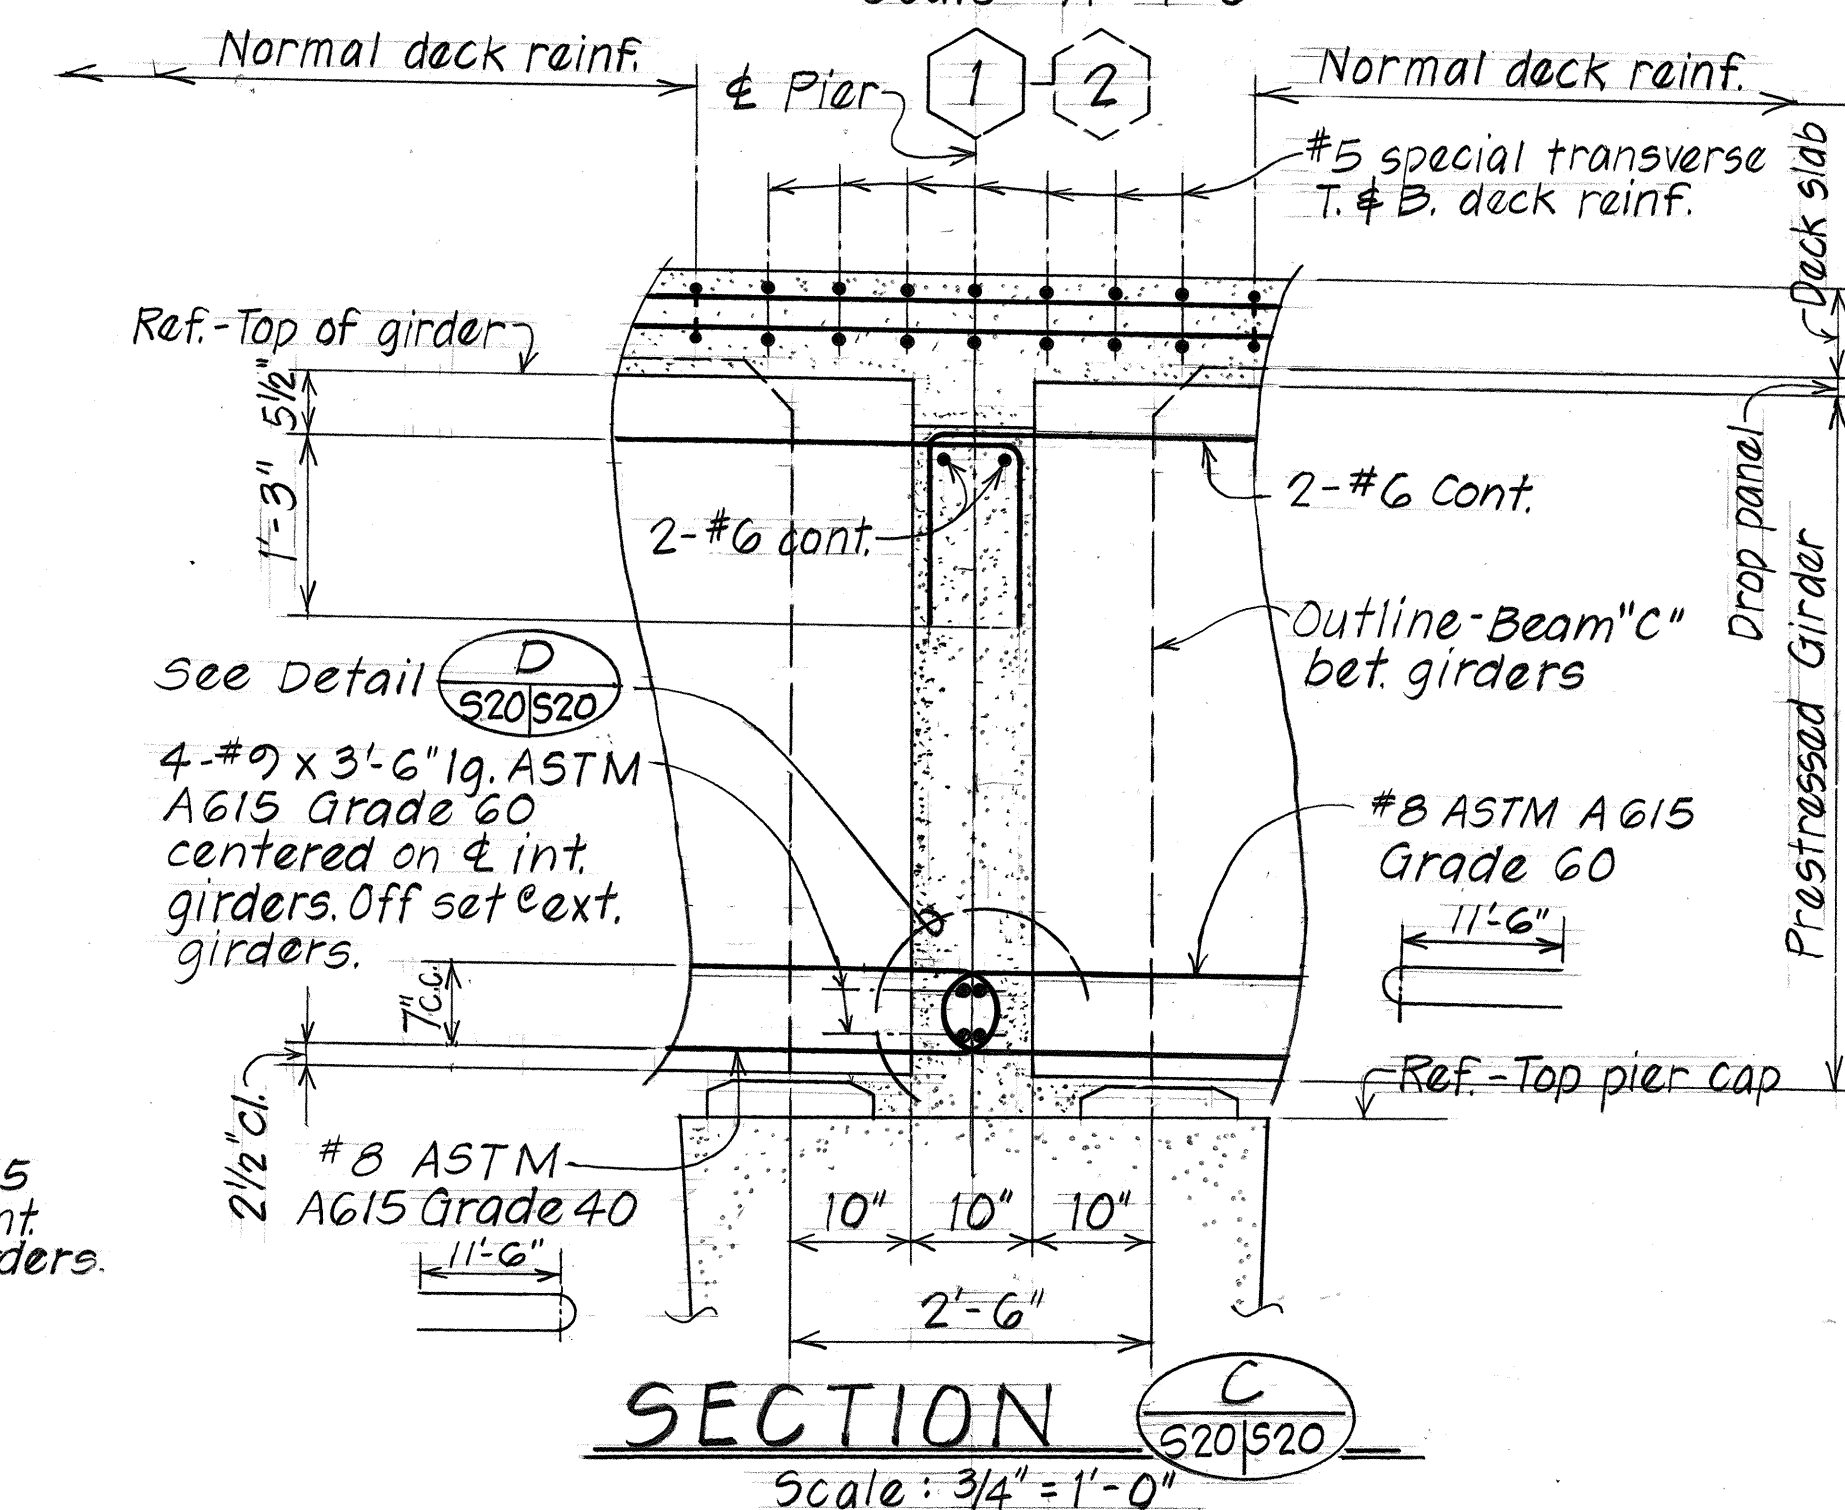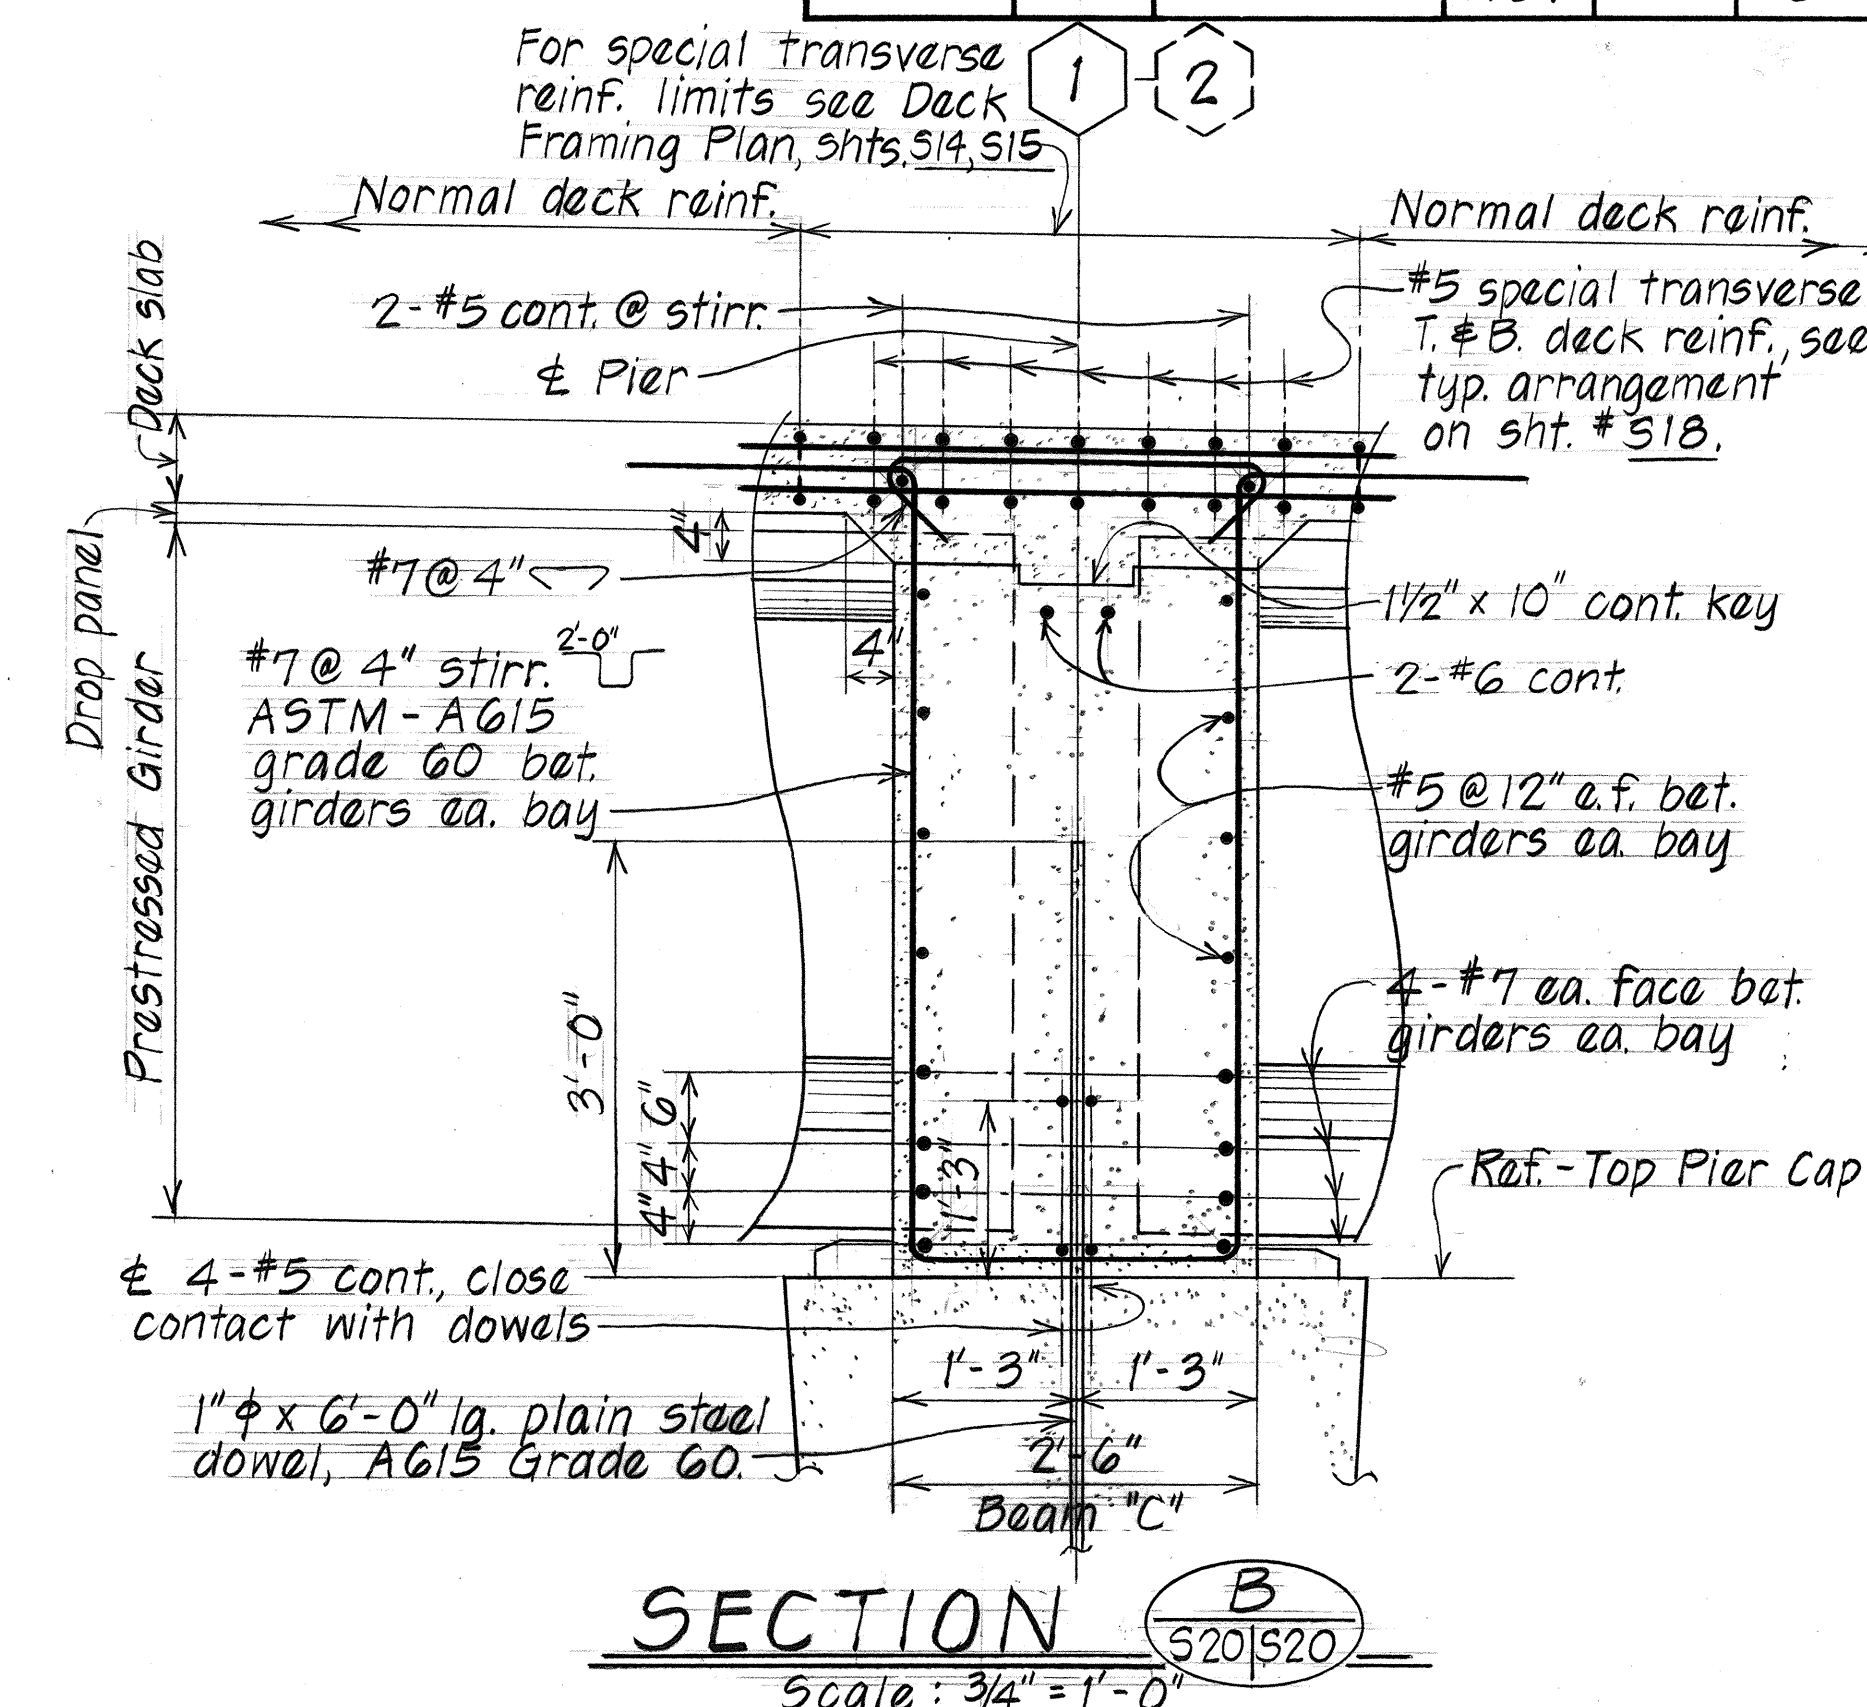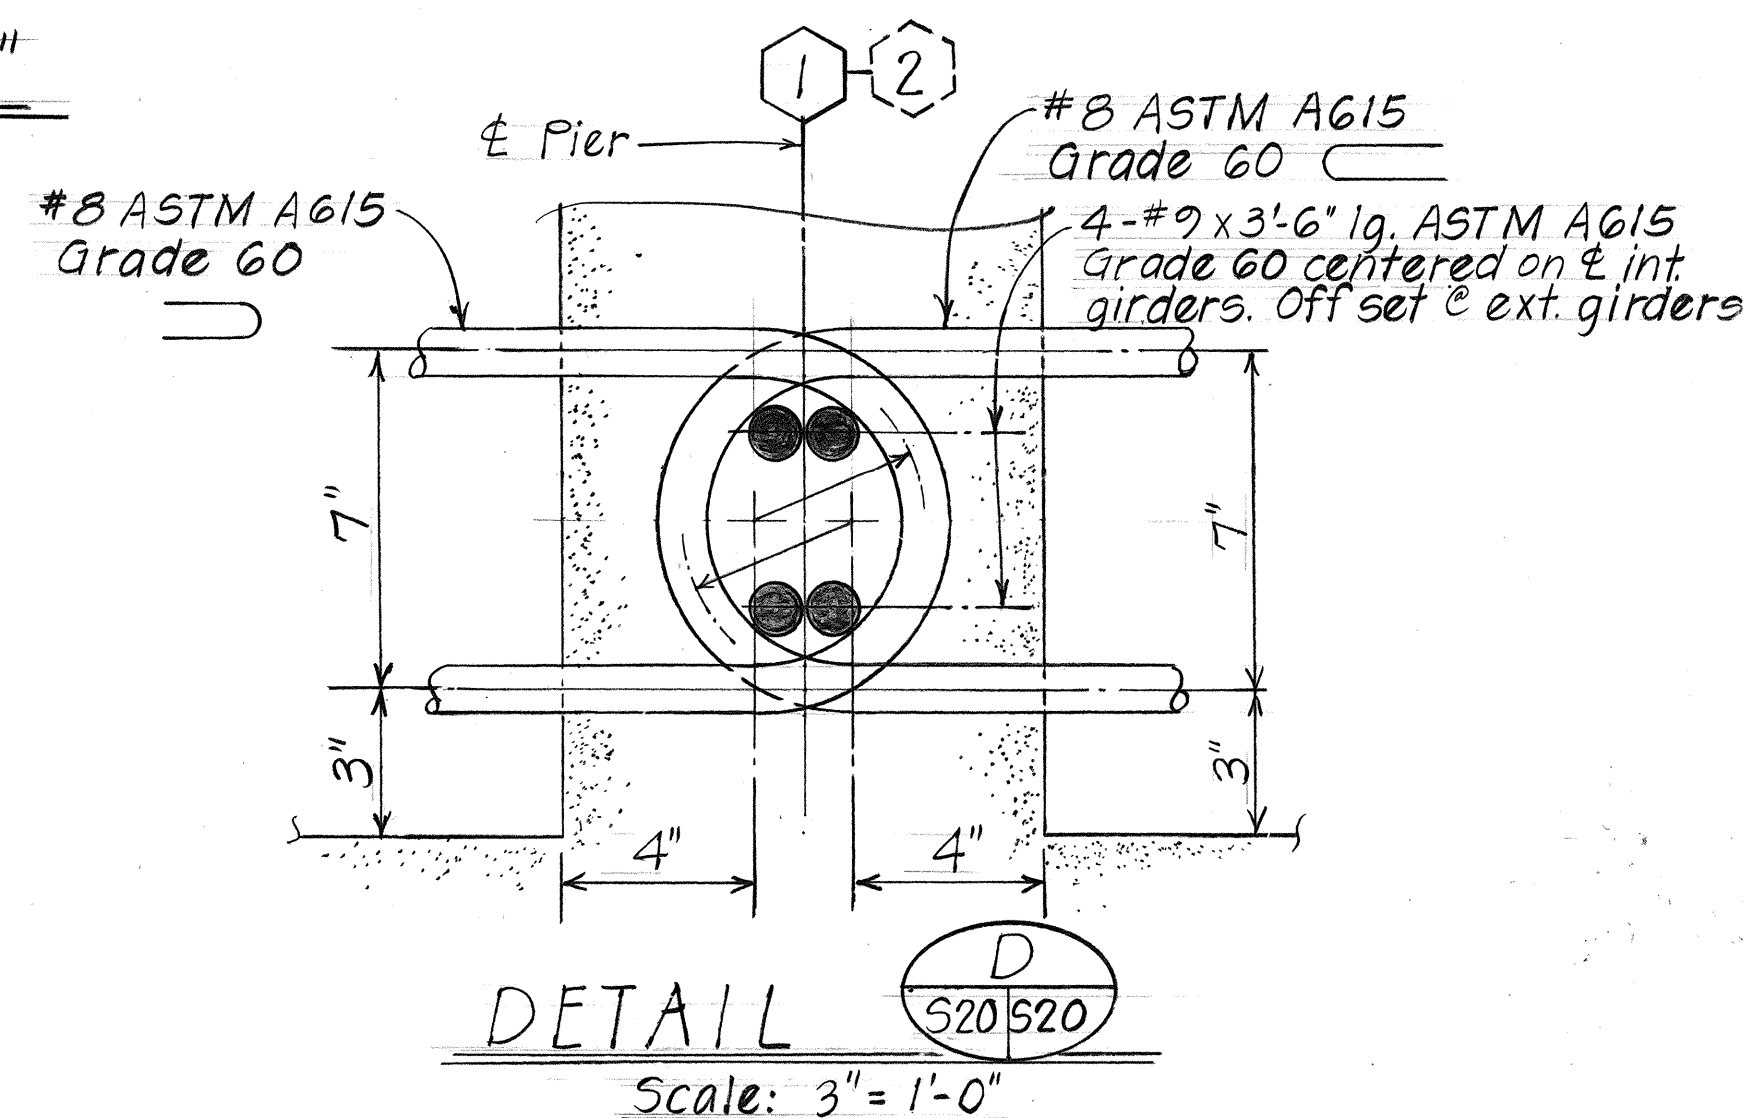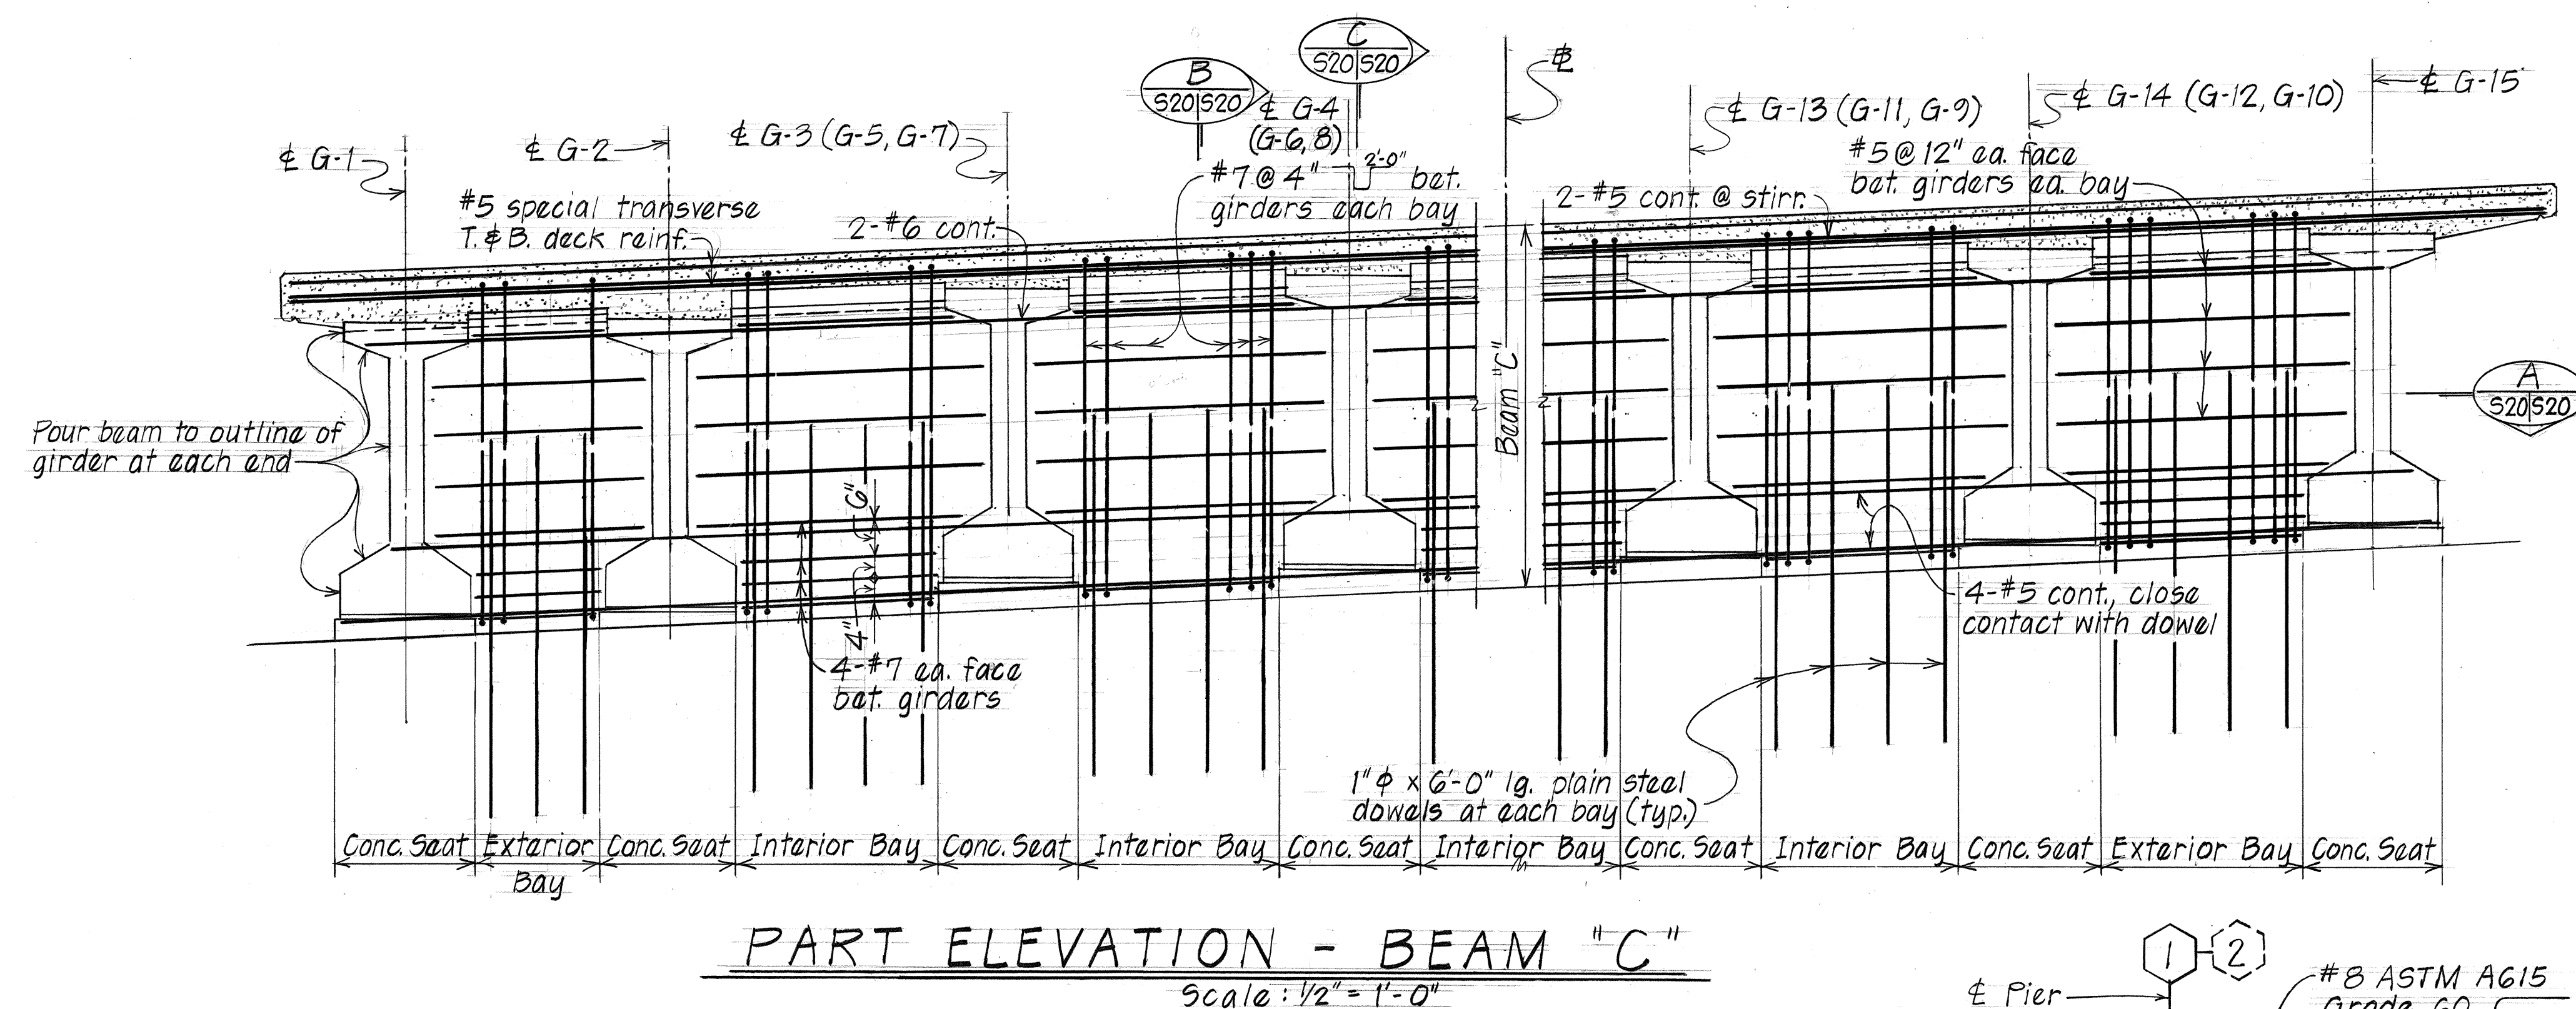
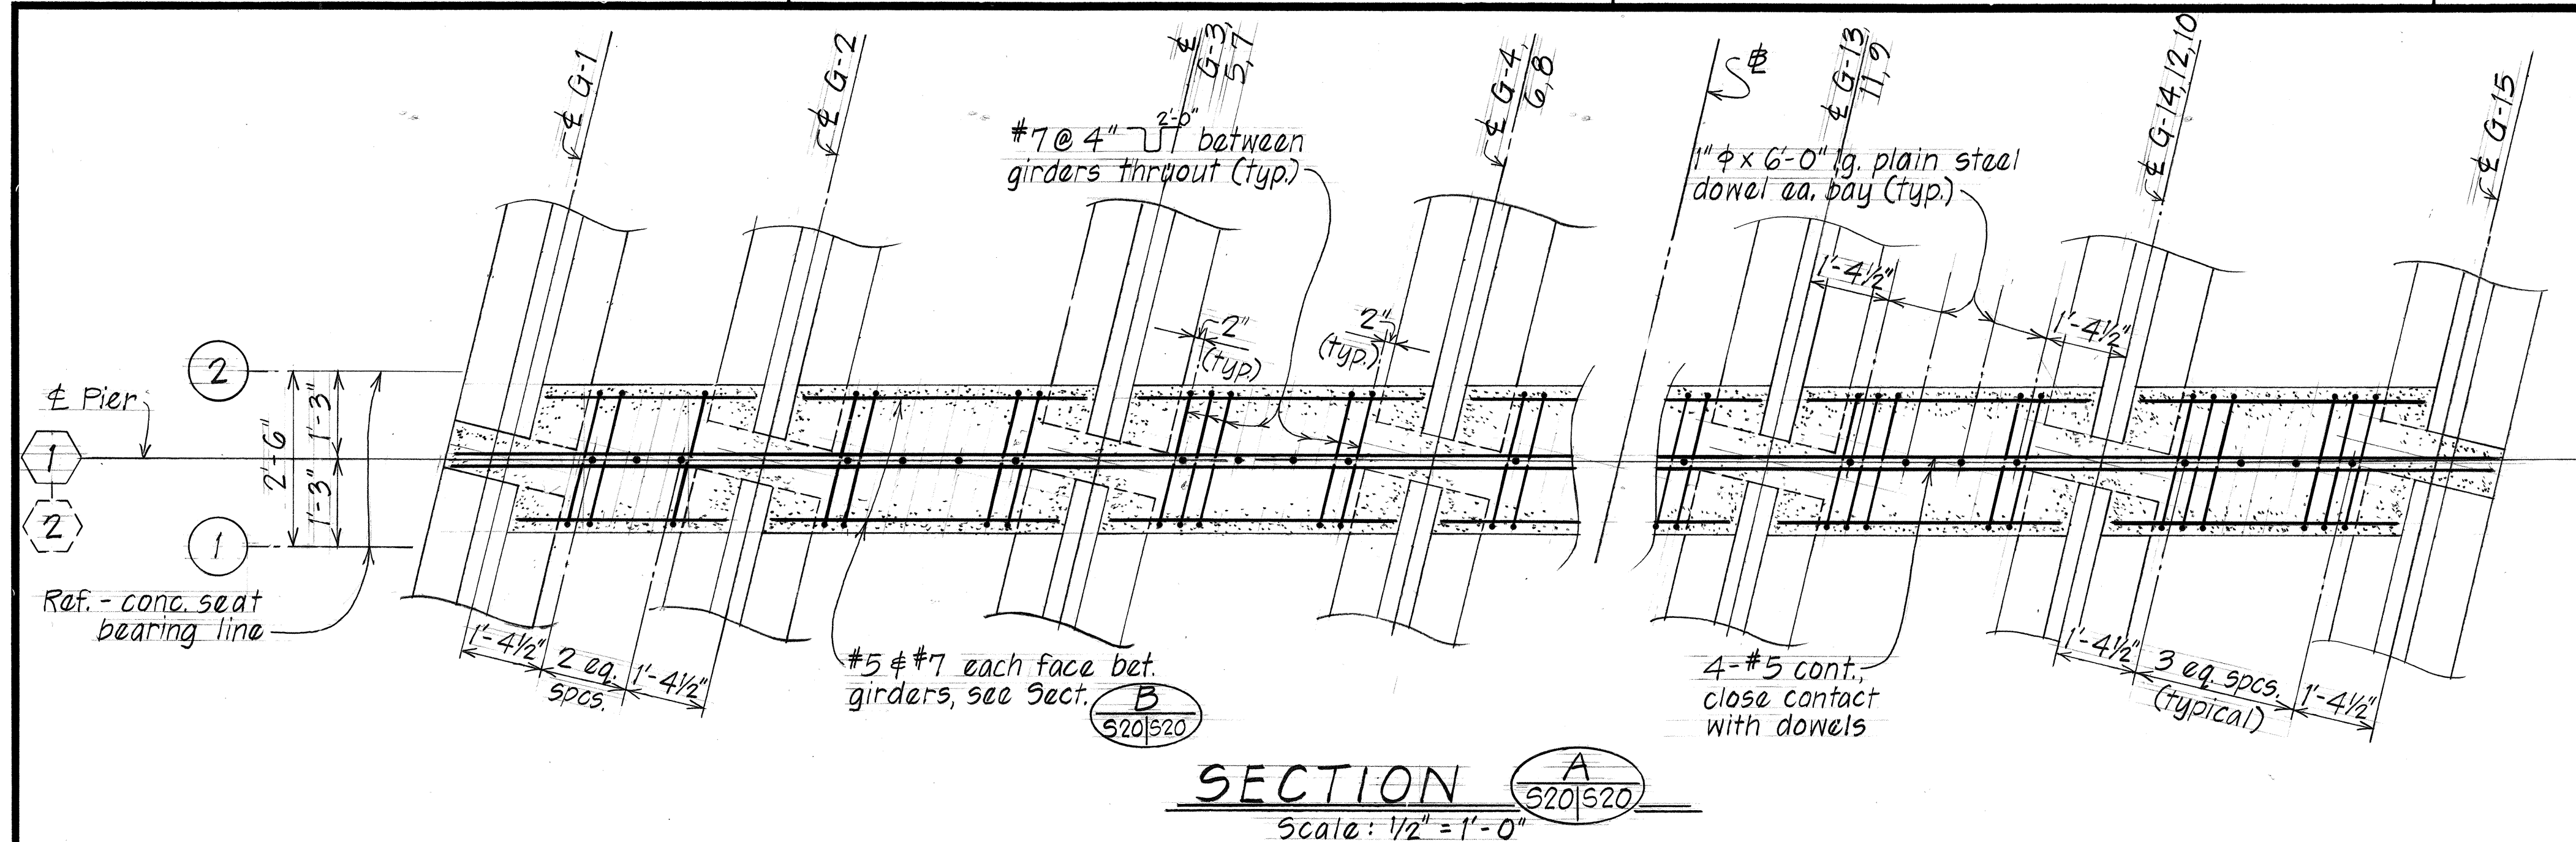


STATE OF HAWAII  
DEPARTMENT OF TRANSPORTATION  
LAND TRANSPORTATION FACILITIES DIVISION  
ROUTE H-3 - KUOU STREAM BRIDGE  
BEAM "C" DETAILS  
F.A.I. Proj. No. I-H3-1(50)  
KANELOHE I.C. TO HALELOU I.C.  
Scale: As Noted Date: August 1987  
SHEET NO. 620 OF 35 SHEETS


|               |        |
|---------------|--------|
| DATE          | 7/83   |
| DESIGNED BY   | J.C.O. |
| TRACED BY     | J.M.   |
| NOTE BOOK     |        |
| QUANTITIES BY | J.M.   |
| CHECKED BY    | J.M.   |
| No.           |        |









| FED. ROAD DIST. NO. | STATE | FED. AID PROJ. NO. | FISCAL YEAR | SHEET NO. | TOTAL SHEETS |
|---------------------|-------|--------------------|-------------|-----------|--------------|
| HAWAII              | HAW.  | I-H3-1(50)         | 1987        | 102       | 164          |

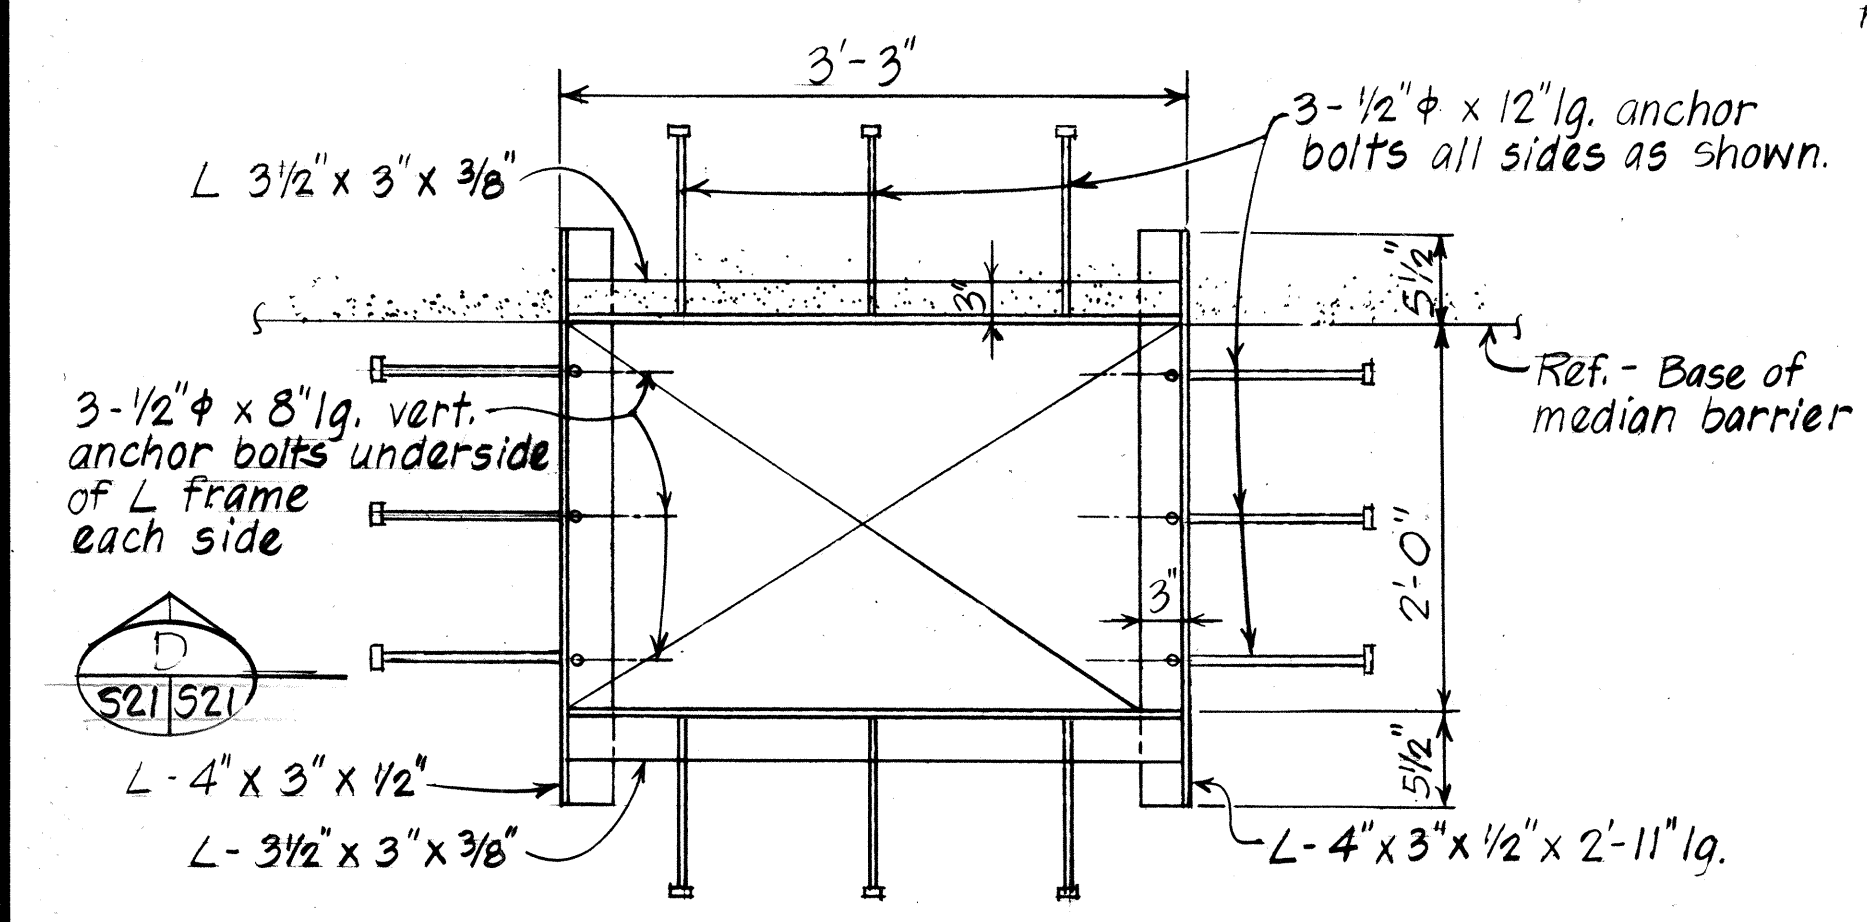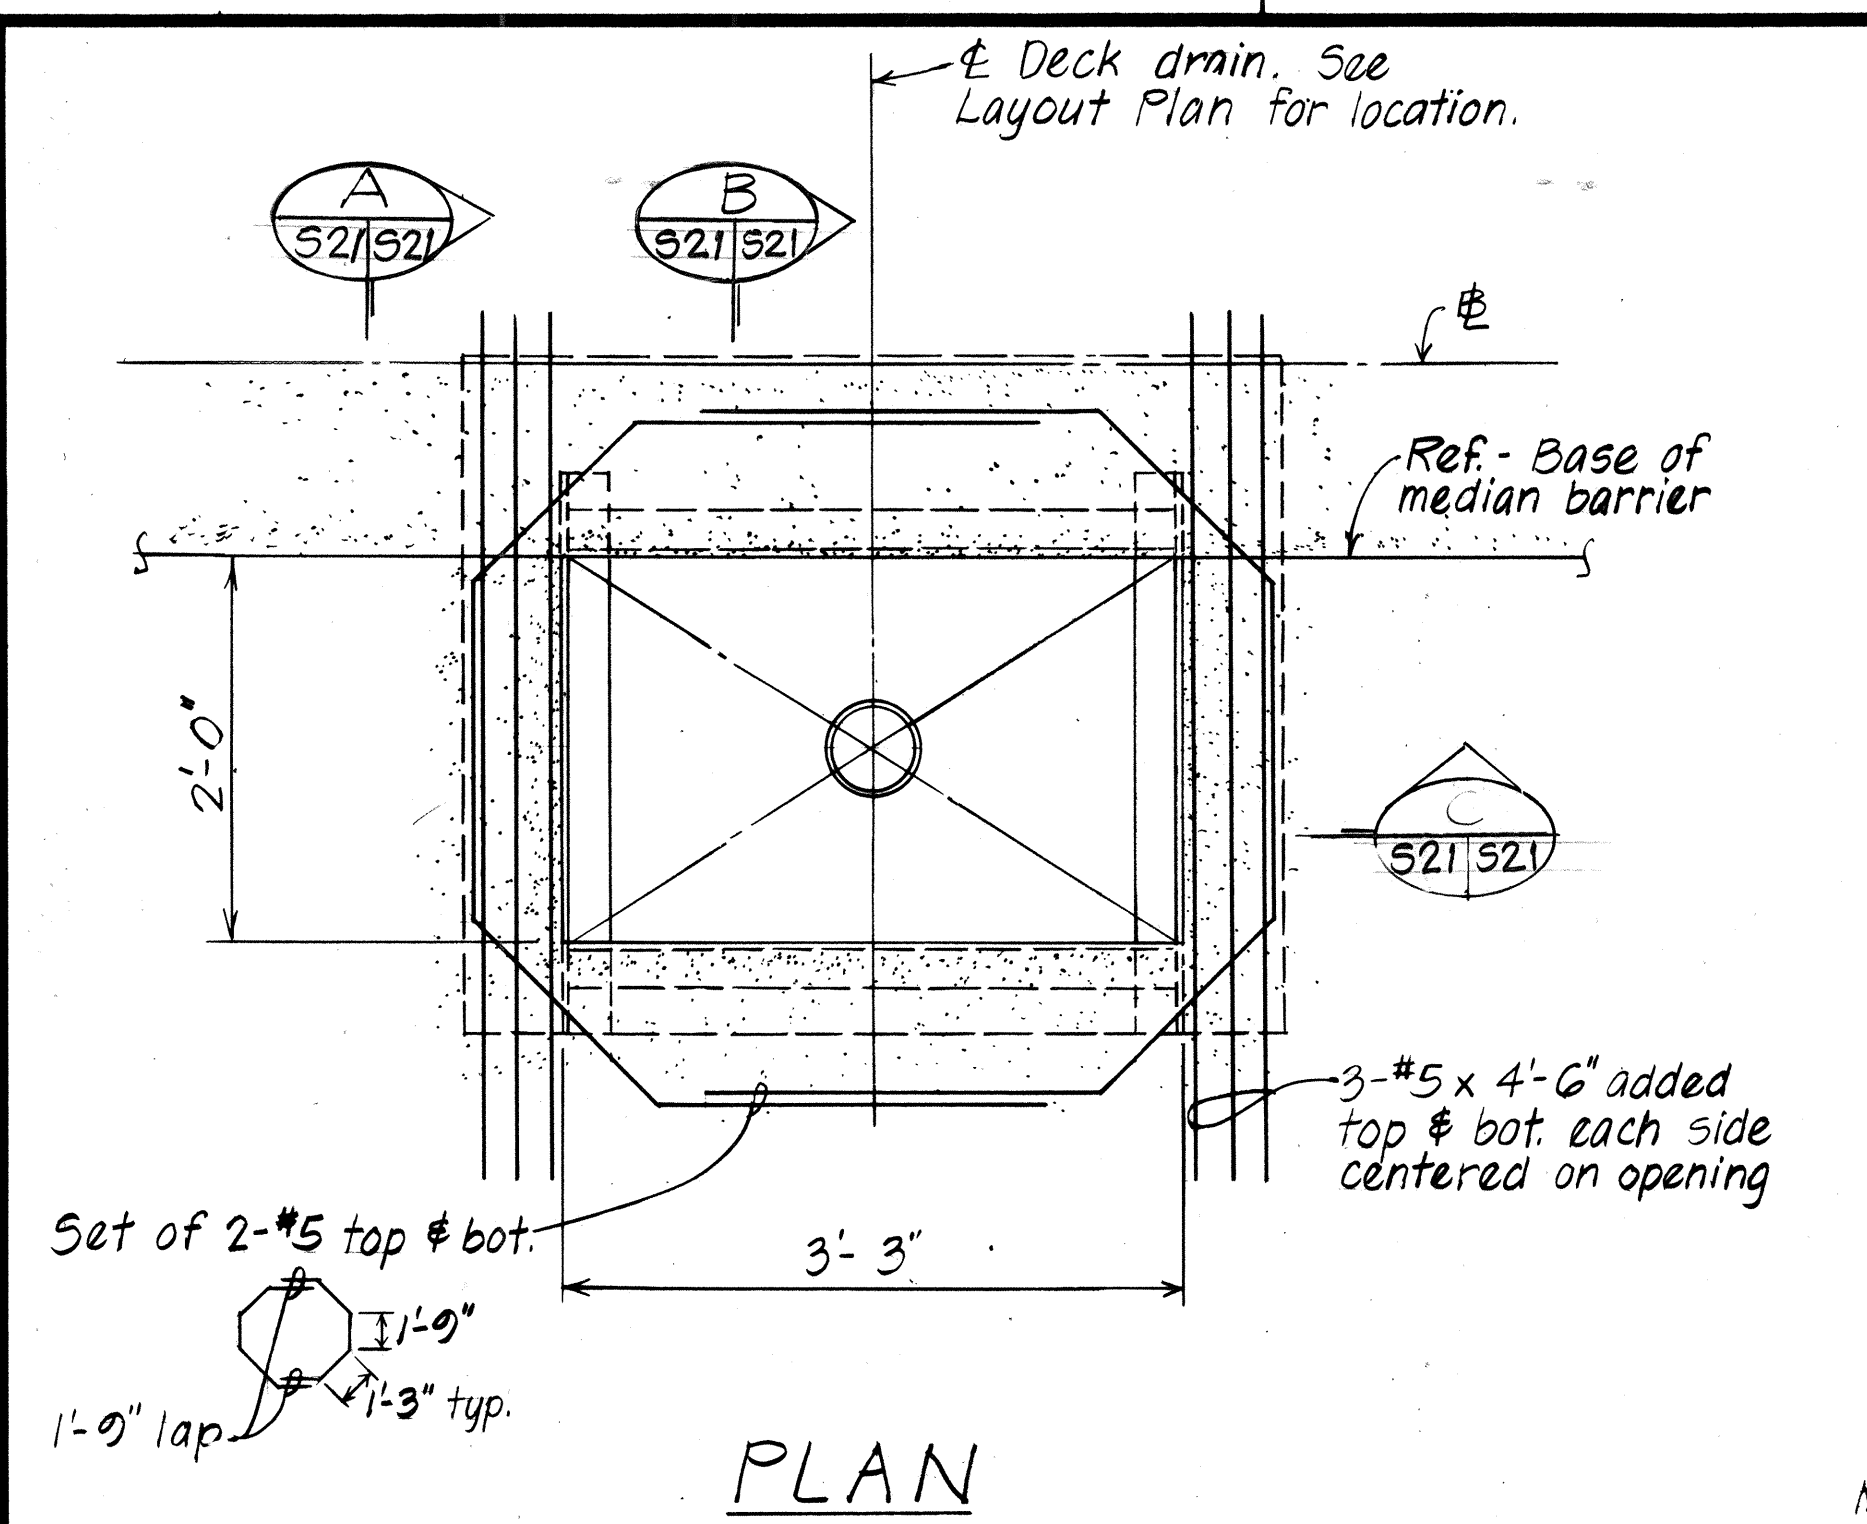

NOTE: For additional Type A-D frame & grate details, see Std Plans sht # H-09

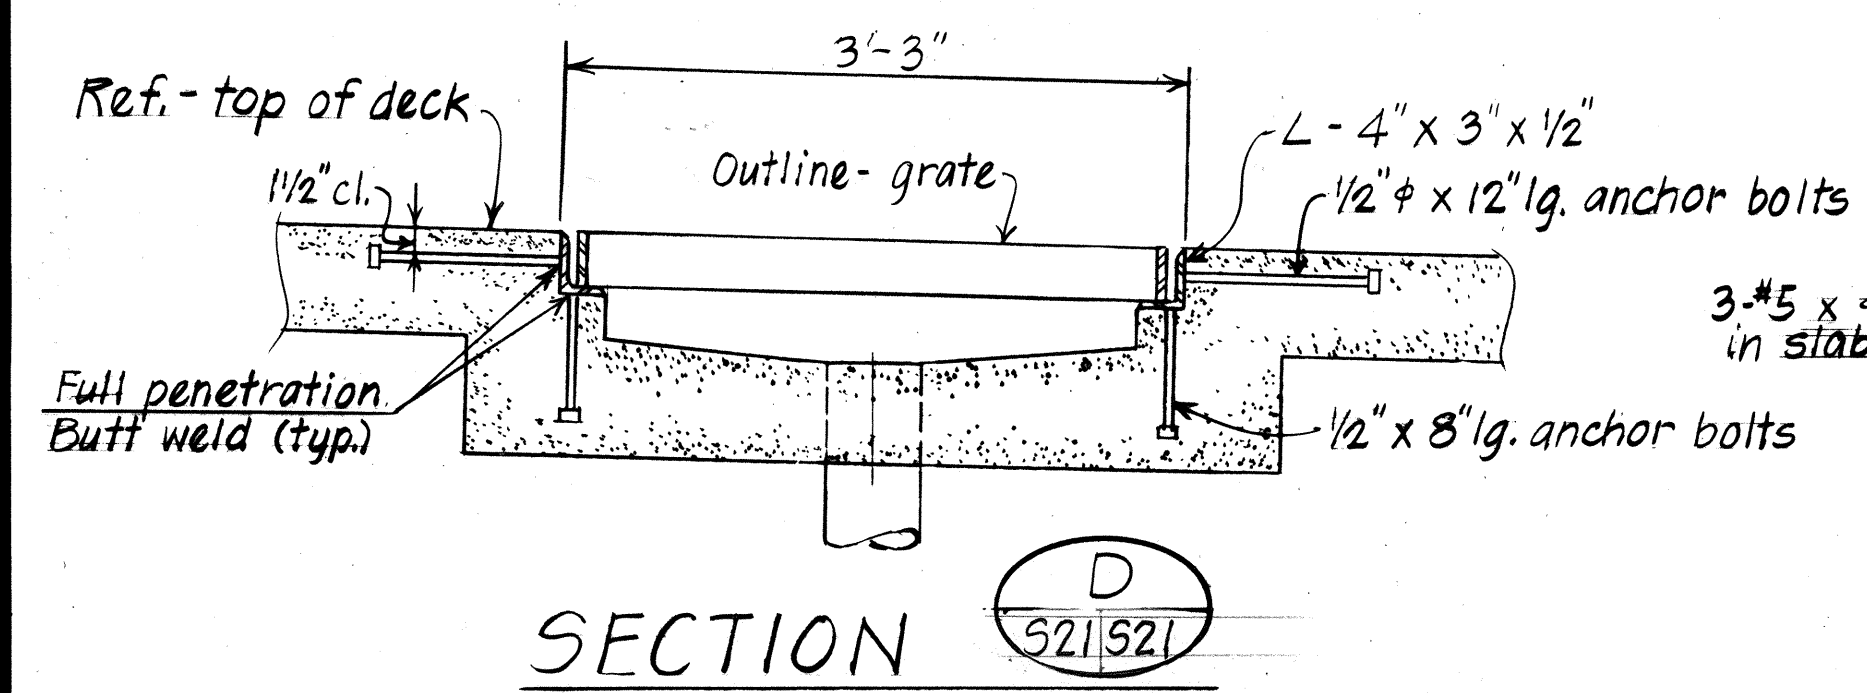


TYPICAL STORM DRAIN DETAILS AT MEDIAN BARRIER  
Scale: 1" = 1'-0"

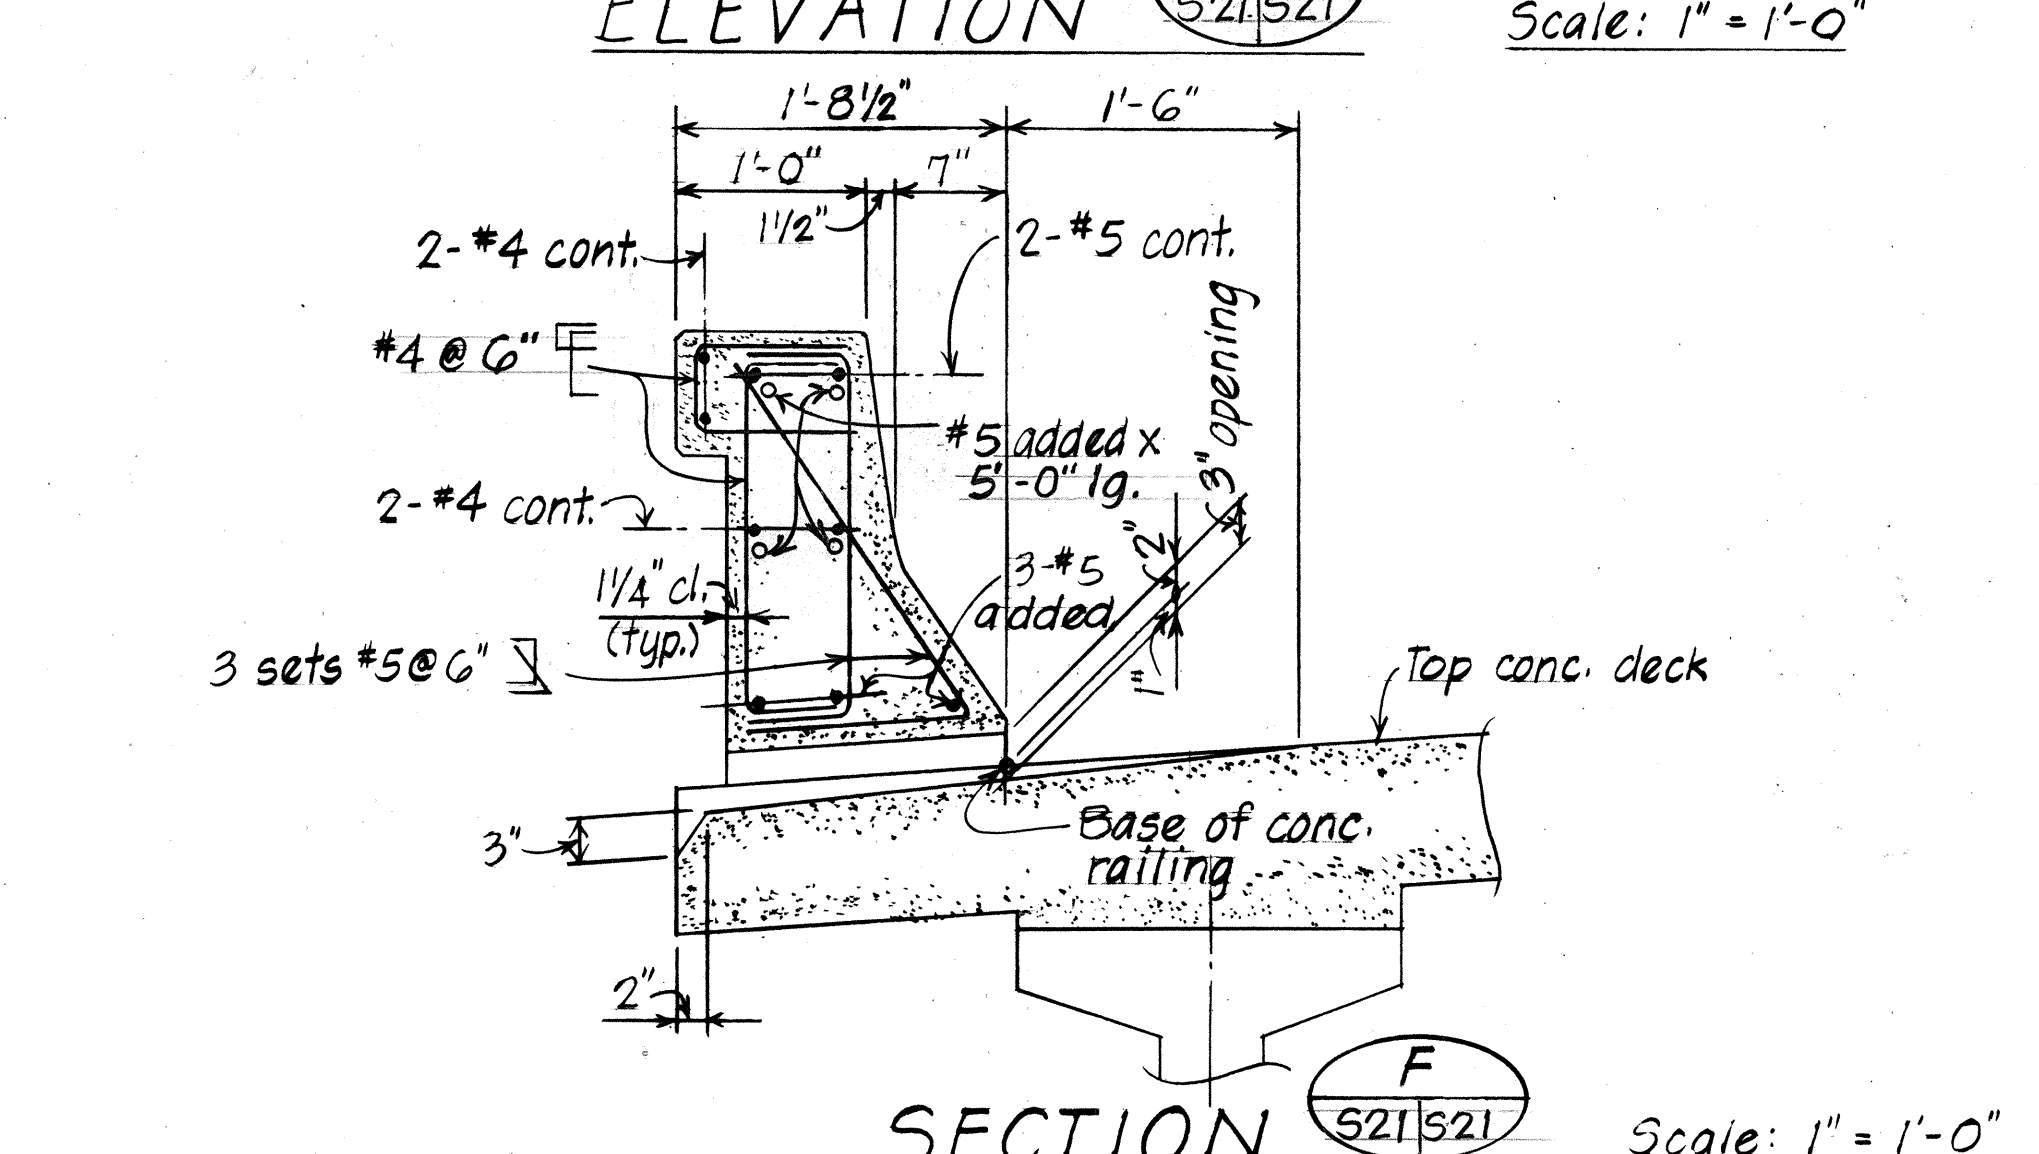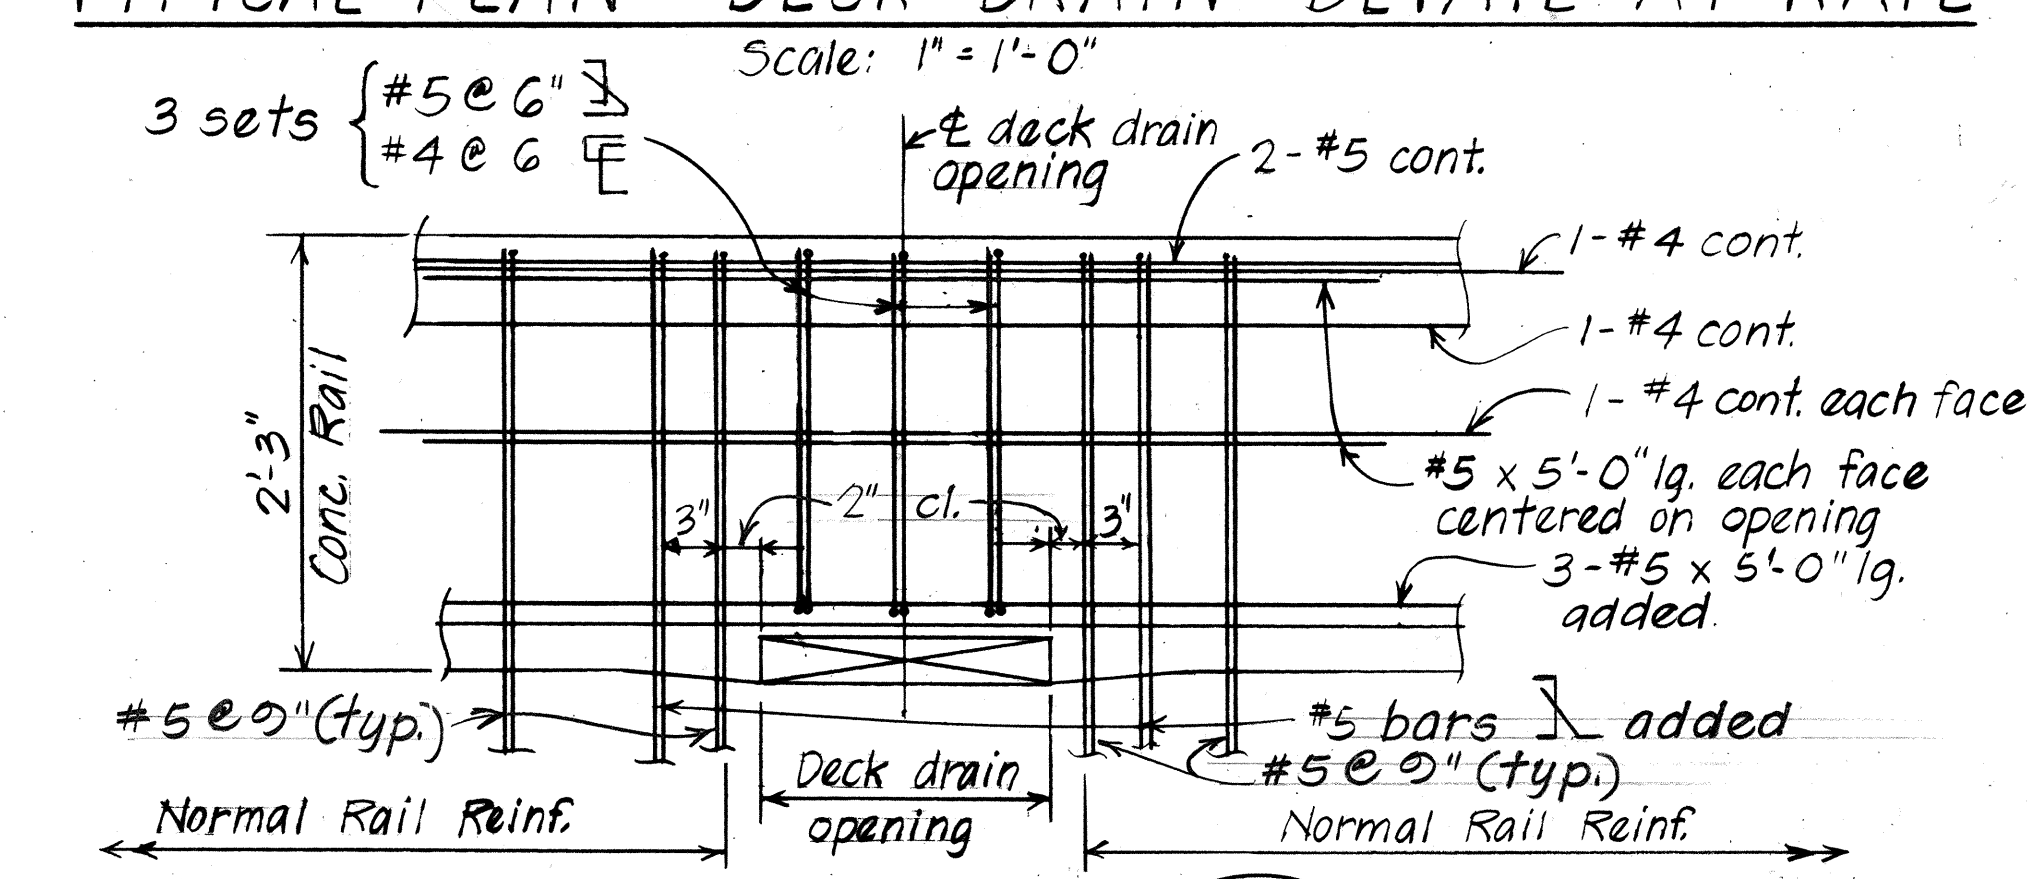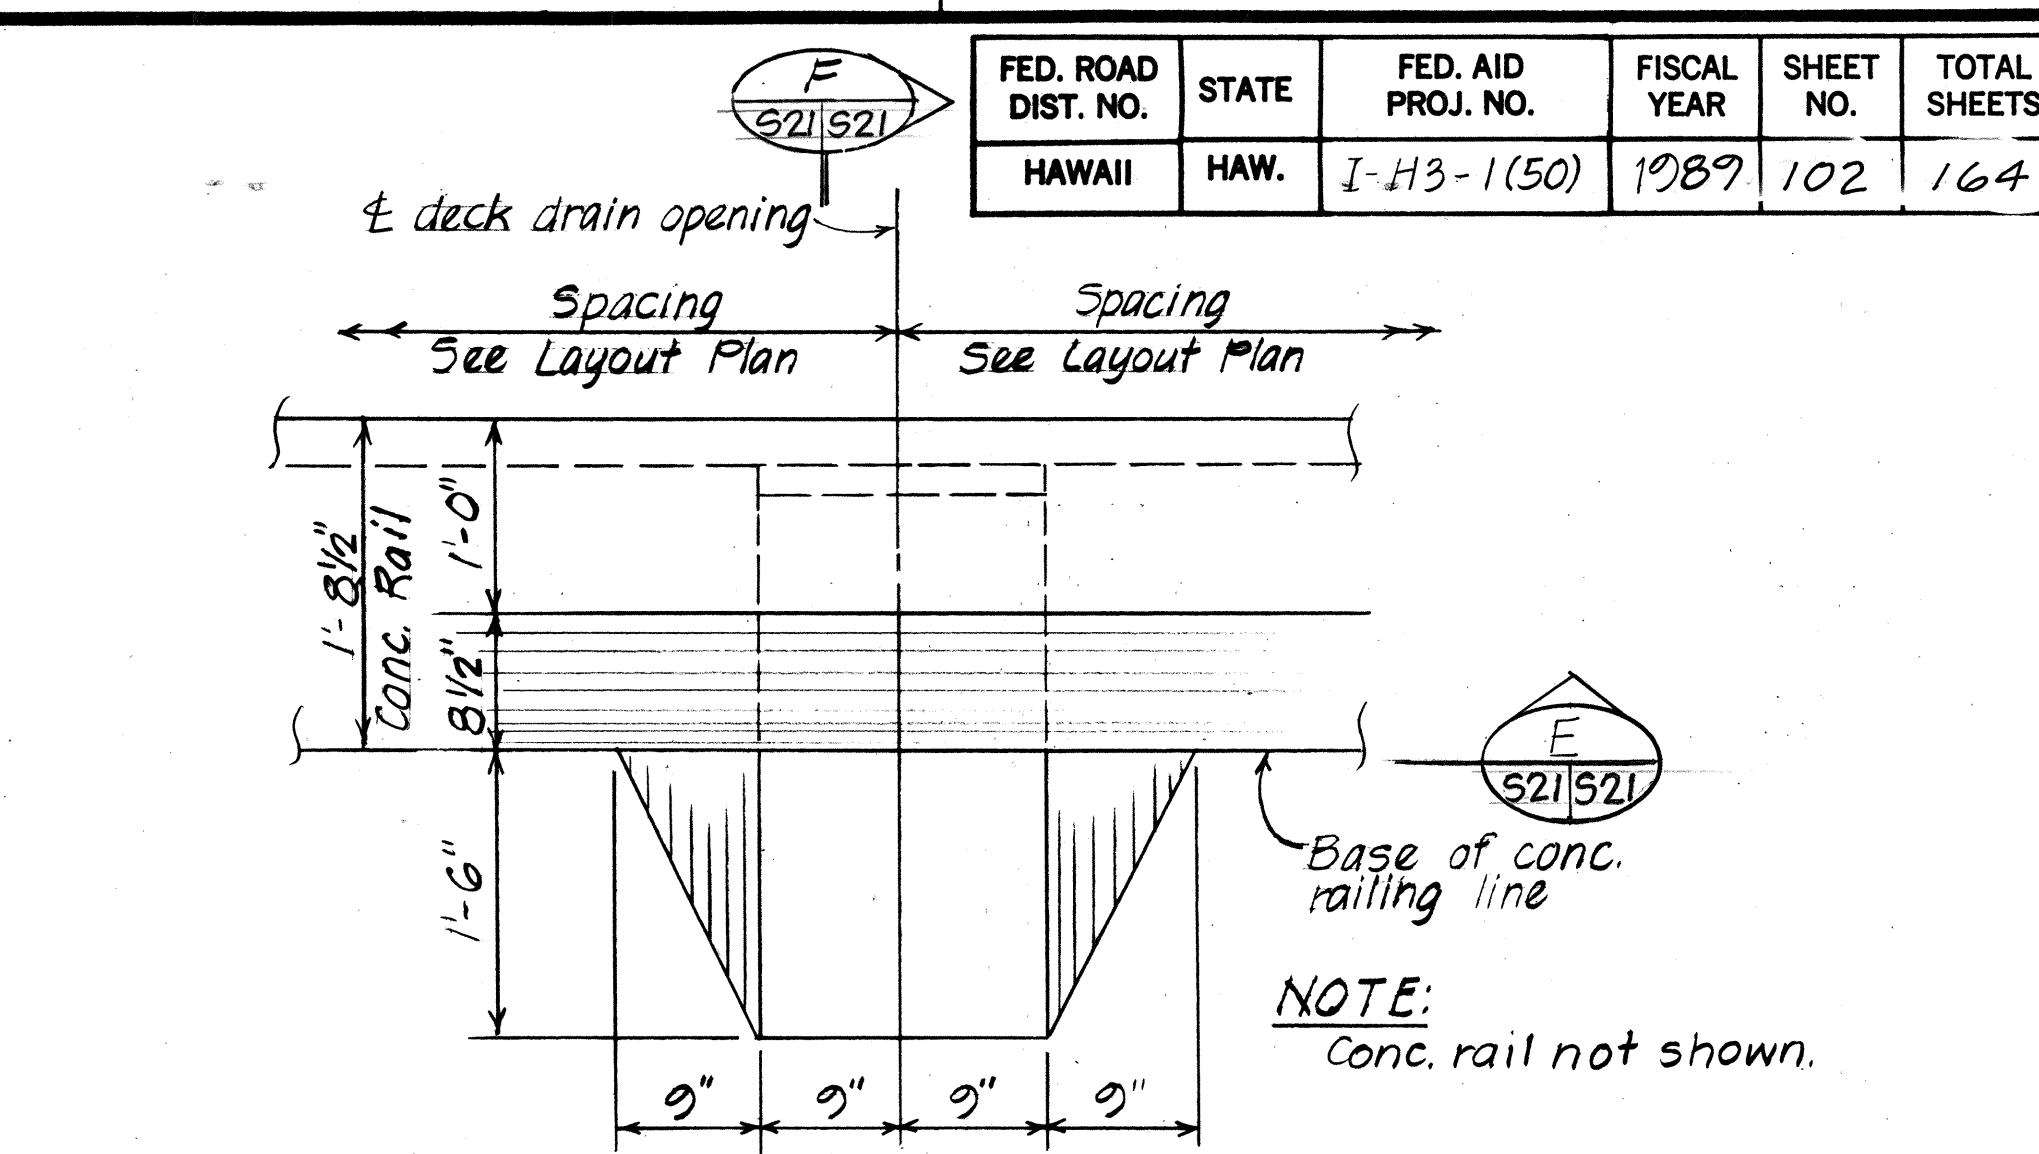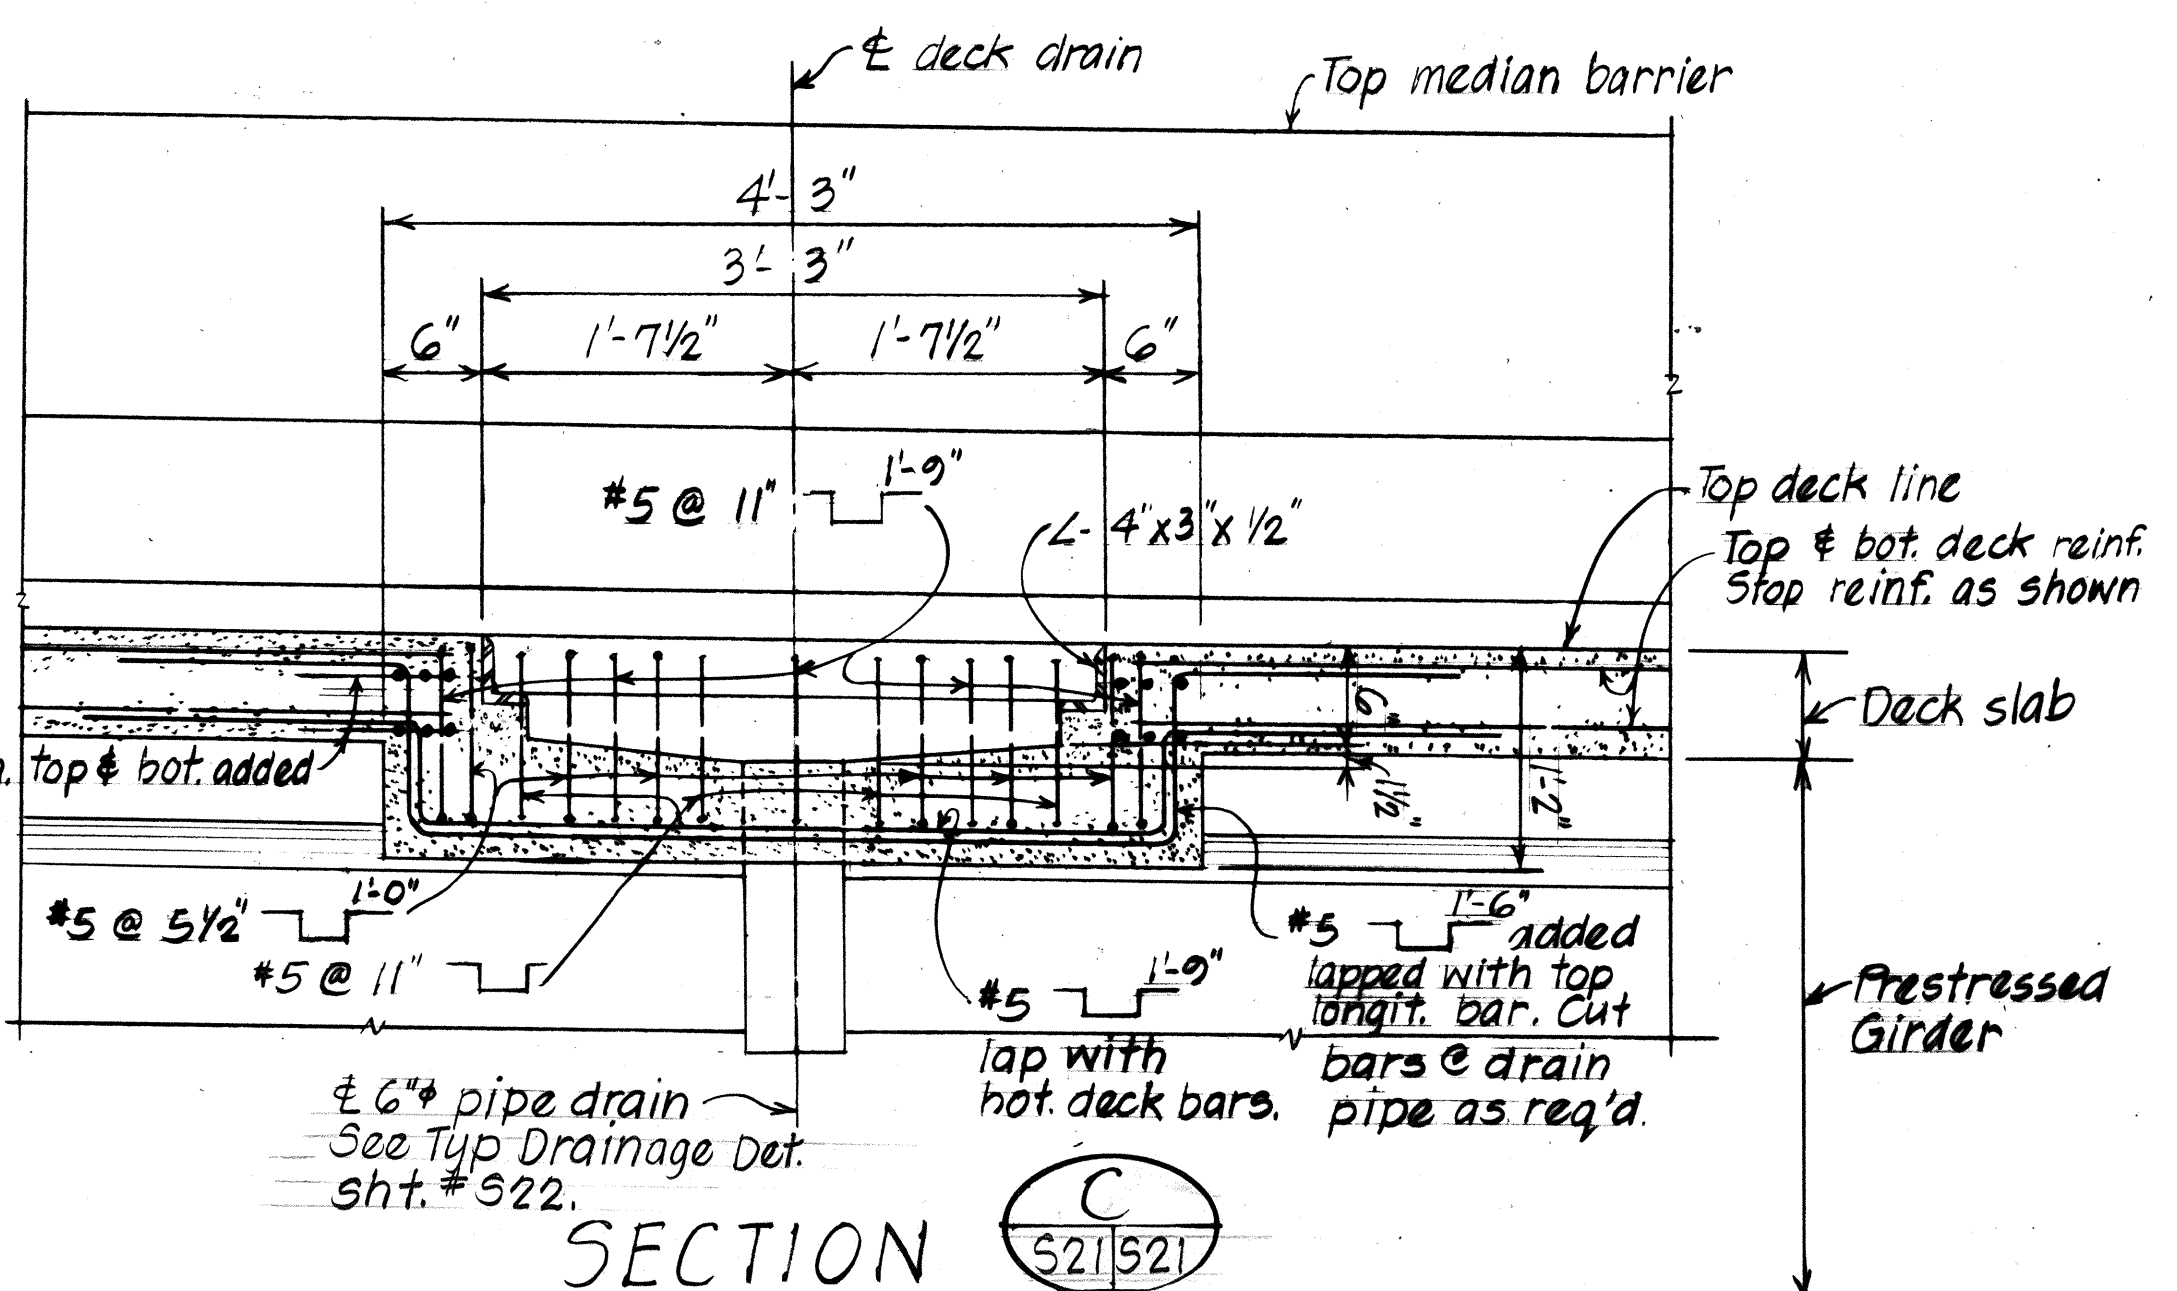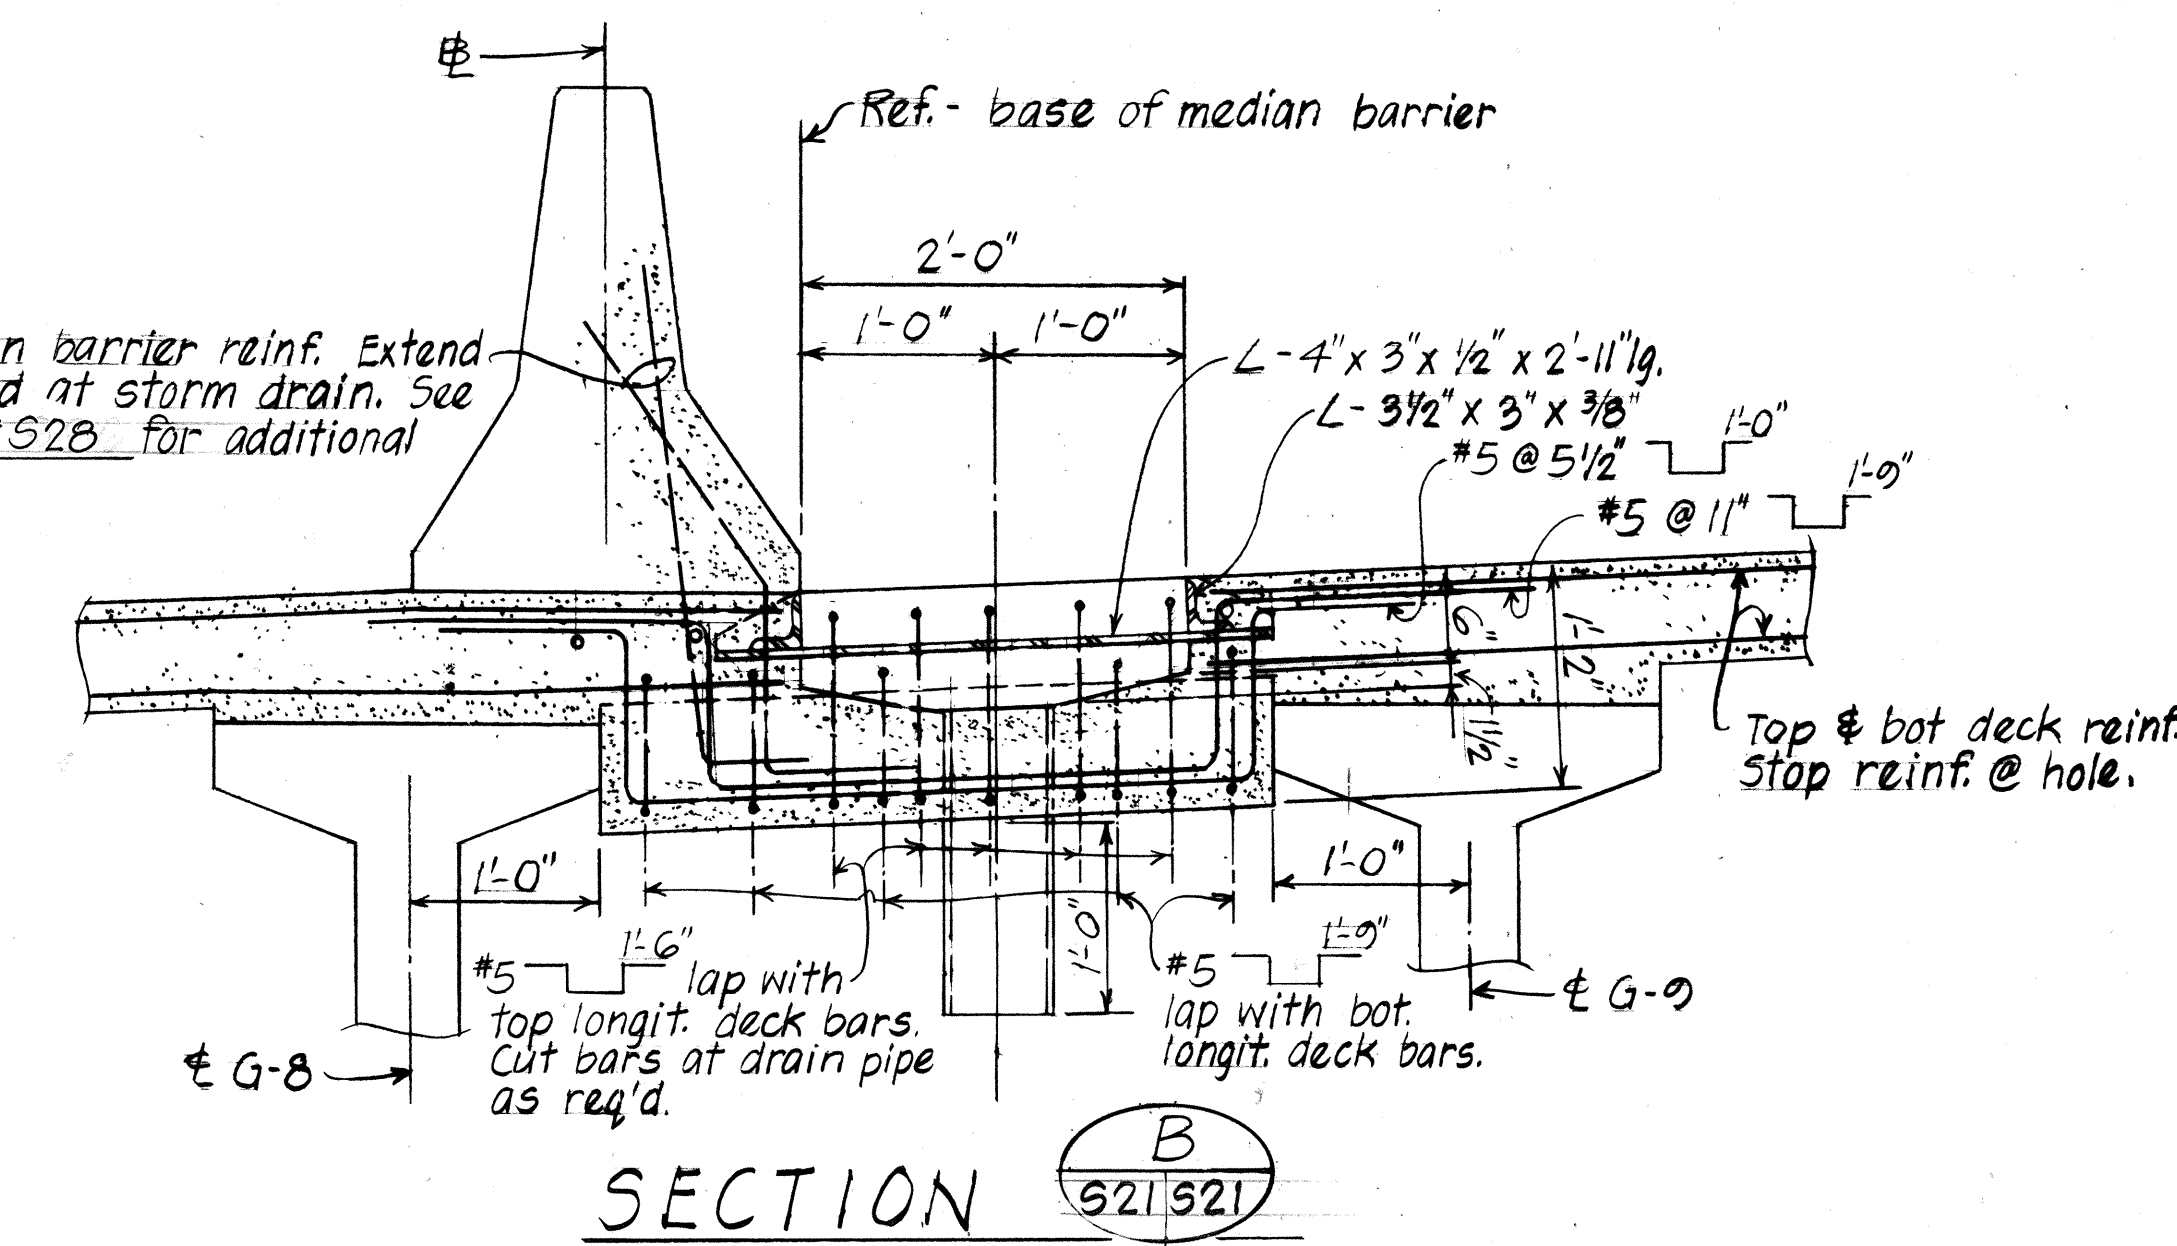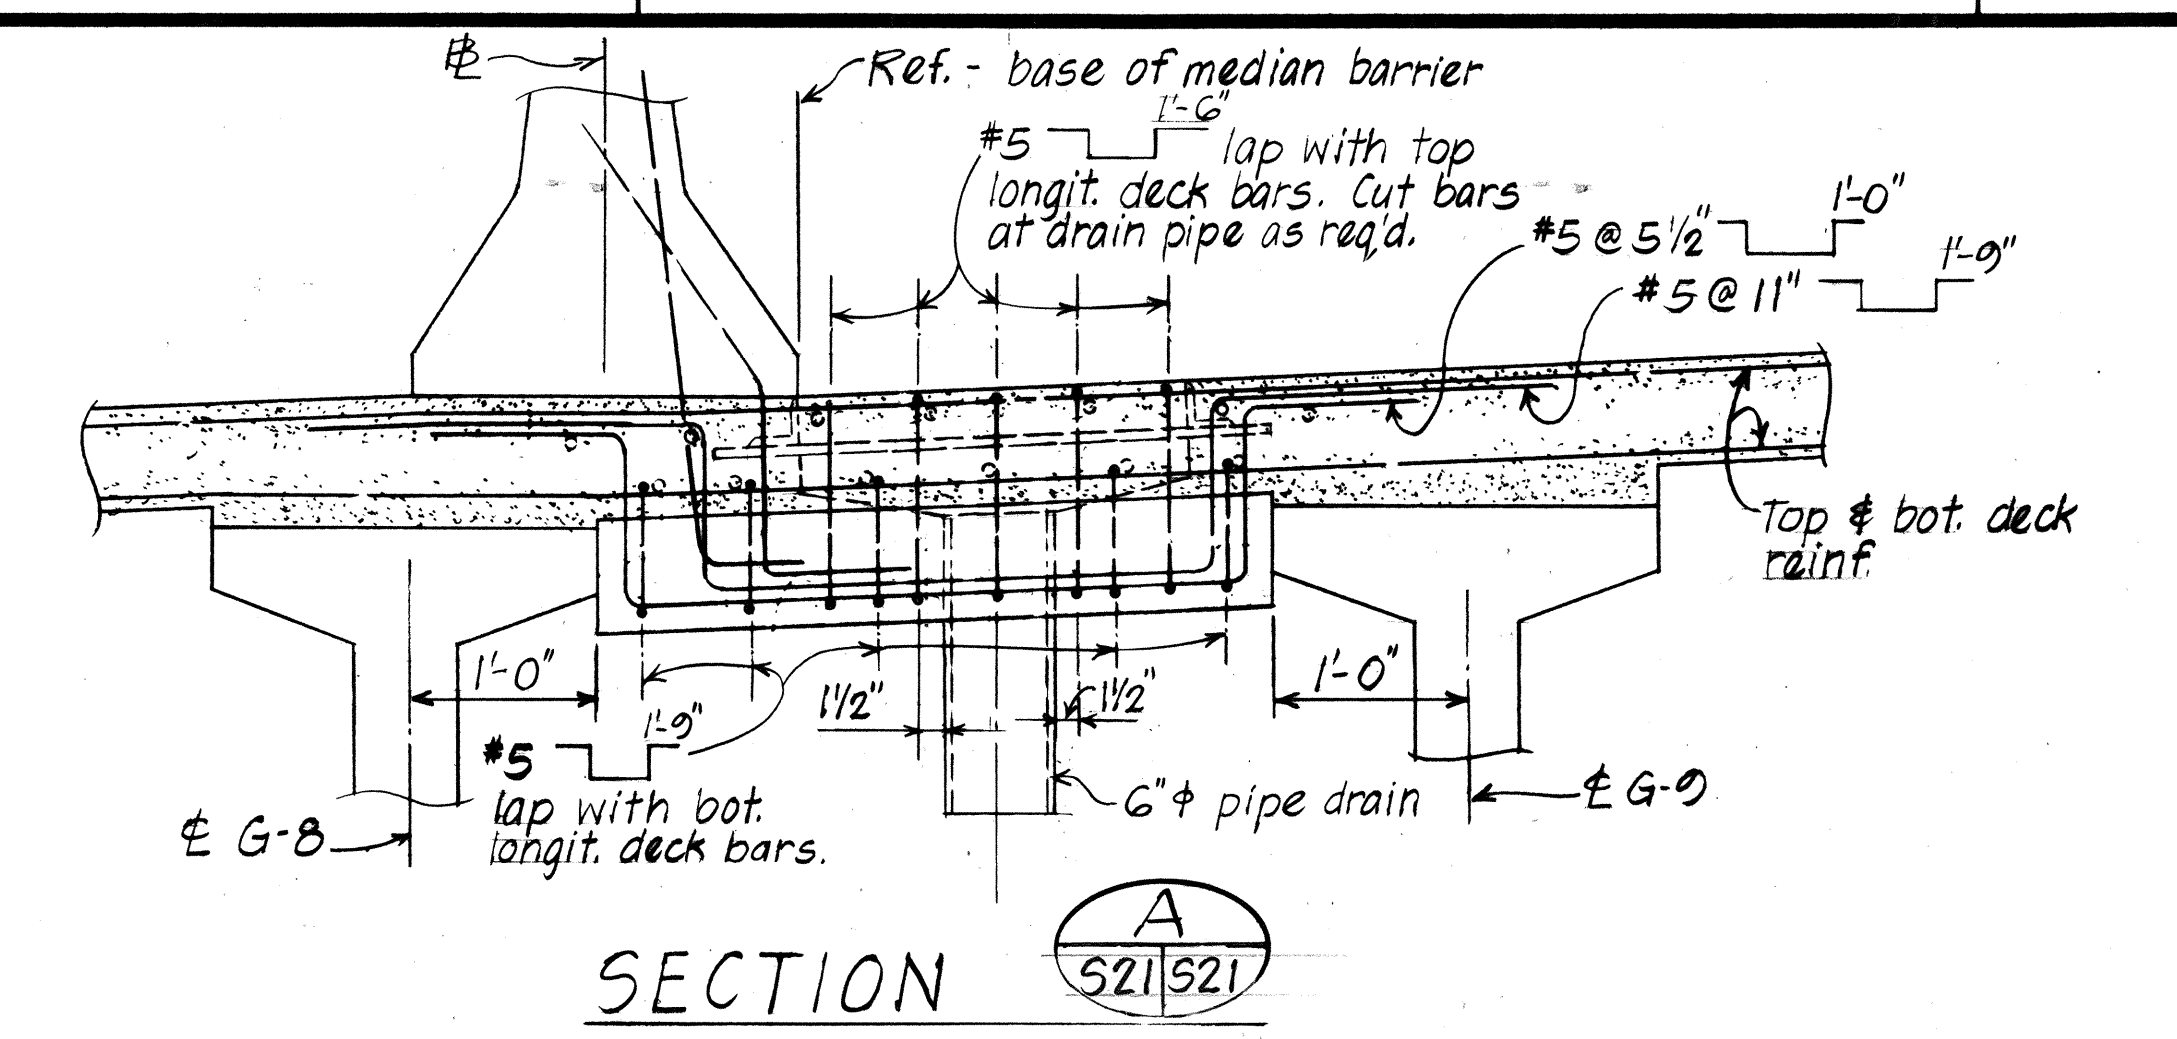

STATE OF HAWAII  
DEPARTMENT OF TRANSPORTATION  
LAND TRANSPORTATION FACILITIES DIVISION  
ROUTE H-3 - KUOU STREAM BRIDGE  
TYPICAL DECK DRAIN DETAILS  
F.A.I. Proj. No. I-H3-1(50)  
KANEHOE I.C. TO HALEKOU I.C.  
Scale: As Noted Date: August 1987  
SHEET No. 521 OF 35 SHEETS



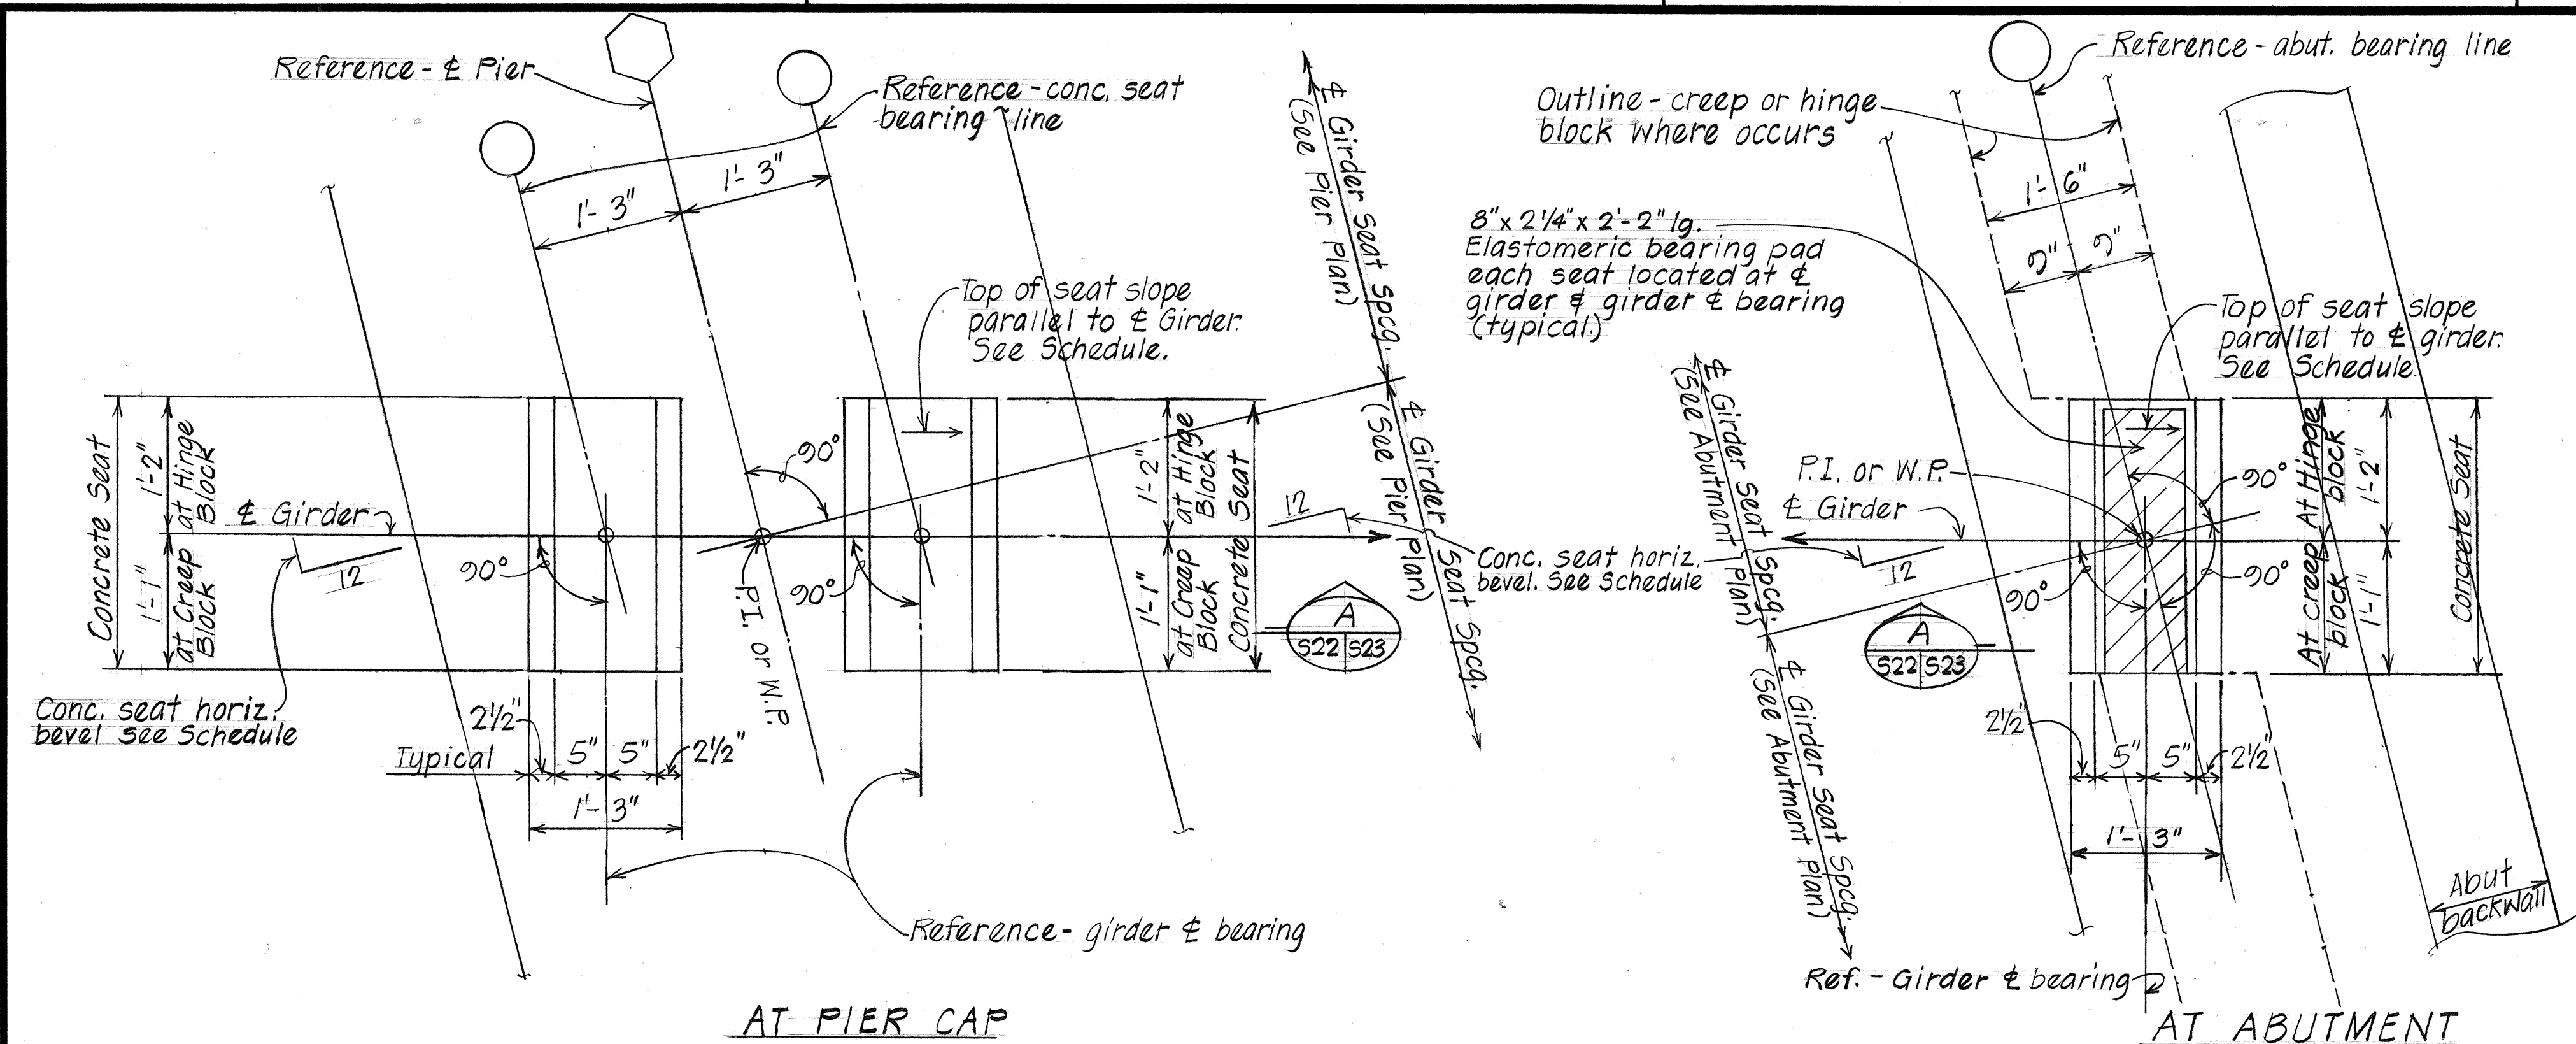


**PART PLAN - TYPICAL GIRDER CONCRETE SEAT** Scale: 1" = 1'-0"



**REFERENCE NOTE:**  
 1. Refer to sht. # 522 for conc. seat, hinge & creep block details.  
 2. Refer to sht. # 513 for pier cap details.

| GIRDER CONCRETE SEAT HORIZONTAL BEVEL SCHEDULE |             |             |             |             |             |             |                  |       |       |
|------------------------------------------------|-------------|-------------|-------------|-------------|-------------|-------------|------------------|-------|-------|
| LOCATION<br>GIRDER NO.                         | SPAN #1     |             | SPAN #2     |             | SPAN #3     |             | ABUTMENT BEARING |       |       |
|                                                | DIRECTION   |             | DIRECTION   |             | DIRECTION   |             | DIRECTION        |       |       |
|                                                | BEVEL       | BEVEL       | BEVEL       | BEVEL       | BEVEL       | BEVEL       | BEVEL            | BEVEL | BEVEL |
| G-1                                            | 2 1/16 : 12 | 3/4 : 12    | 2 1/16 : 12 | 3/4 : 12    | 2 1/16 : 12 | 3/4 : 12    | Do.              | Do.   | Do.   |
| G-2                                            | Do.         | 3/4 : 12    | Do.         | 3/4 : 12    | Do.         | 3/4 : 12    | Do.              | Do.   | Do.   |
| G-3                                            | Do.         | 3 7/32 : 12 | Do.         | 3 7/32 : 12 | Do.         | 3 7/32 : 12 | Do.              | Do.   | Do.   |
| G-4                                            | Do.         | Do.         | Do.         | Do.         | Do.         | Do.         | Do.              | Do.   | Do.   |
| G-5                                            | 2 1/16 : 12 | Do.         | 2 1/16 : 12 | Do.         | 2 1/16 : 12 | Do.         | Do.              | Do.   | Do.   |
| G-6                                            | 2 2/32 : 12 | Do.         | 2 2/32 : 12 | Do.         | 2 2/32 : 12 | Do.         | Do.              | Do.   | Do.   |
| G-7                                            | Do.         | Do.         | Do.         | Do.         | Do.         | Do.         | Do.              | Do.   | Do.   |
| G-8                                            | Do.         | 3 7/32 : 12 | Do.         | 3 7/32 : 12 | Do.         | 3 7/32 : 12 | Do.              | Do.   | Do.   |
| G-9                                            | Do.         | 3 7/16 : 12 | Do.         | 3 7/16 : 12 | Do.         | 3 7/16 : 12 | Do.              | Do.   | Do.   |
| G-10                                           | 2 2/32 : 12 | Do.         | 2 2/32 : 12 | Do.         | 2 2/32 : 12 | Do.         | Do.              | Do.   | Do.   |
| G-11                                           | 2 3/4 : 12  | Do.         | 2 3/4 : 12  | Do.         | 2 3/4 : 12  | Do.         | Do.              | Do.   | Do.   |
| G-12                                           | Do.         | Do.         | Do.         | Do.         | Do.         | Do.         | Do.              | Do.   | Do.   |
| G-13                                           | Do.         | Do.         | Do.         | Do.         | Do.         | Do.         | Do.              | Do.   | Do.   |
| G-14                                           | Do.         | 3 3/16 : 12 | Do.         | 3 3/16 : 12 | Do.         | 3 3/16 : 12 | Do.              | Do.   | Do.   |
| G-15                                           | 2 3/4 : 12  | 3 5/32 : 12 | 2 3/4 : 12  | 3 5/32 : 12 | 2 3/4 : 12  | 3 5/32 : 12 | Do.              | Do.   | Do.   |

| TOP CONCRETE SEAT ELEVATION & SLOPE SCHEDULE (AT GIRDER & BEARING) |                  |        |           |          |           |        |           |           |                  |
|--------------------------------------------------------------------|------------------|--------|-----------|----------|-----------|--------|-----------|-----------|------------------|
| LOCATION<br>GIRDER NOS.                                            | ABUTMENT BEARING |        | DIRECTION |          | DIRECTION |        | DIRECTION |           | ABUTMENT BEARING |
|                                                                    | 1                | 2      | 1         | 2        | 1         | 2      | 1         | 2         |                  |
| G-1                                                                | 337.78           | 337.40 | 1/16 : 12 | 1/8 : 12 | 336.35    | 336.30 | 1/8 : 12  | 1/16 : 12 | 334.91           |
| G-2                                                                | 337.99           | 337.61 |           |          | 336.56    | 336.51 |           |           | 335.12           |
| G-3                                                                | 338.50           | 338.10 |           |          | 337.05    | 337.00 |           |           | 335.61           |
| G-4                                                                | 338.78           | 338.38 |           |          | 337.32    | 337.27 |           |           | 335.88           |
| G-5                                                                | 339.06           | 338.65 |           |          | 337.59    | 337.54 |           |           | 336.15           |
| G-6                                                                | 339.34           | 338.93 |           |          | 337.87    | 337.82 |           |           | 336.42           |
| G-7                                                                | 339.63           | 339.21 |           |          | 338.14    | 338.09 |           |           | 336.69           |
| G-8                                                                | 339.89           | 339.47 |           |          | 338.39    | 338.34 |           |           | 336.95           |
| G-9                                                                | 340.09           | 339.66 |           |          | 338.58    | 338.53 |           |           | 337.13           |
| G-10                                                               | 340.37           | 339.93 |           |          | 338.85    | 338.80 |           |           | 337.41           |
| G-11                                                               | 340.65           | 340.21 |           |          | 339.12    | 339.07 |           |           | 337.68           |
| G-12                                                               | 340.93           | 340.48 |           |          | 339.39    | 339.34 |           |           | 337.95           |
| G-13                                                               | 341.22           | 340.76 |           |          | 339.66    | 339.62 |           |           | 338.22           |
| G-14                                                               | 341.50           | 341.04 |           |          | 339.94    | 339.89 |           |           | 338.50           |
| G-15                                                               | 341.78           | 341.31 | 1/16 : 12 | 1/8 : 12 | 340.21    | 340.16 | 1/8 : 12  | 1/16 : 12 | 338.77           |

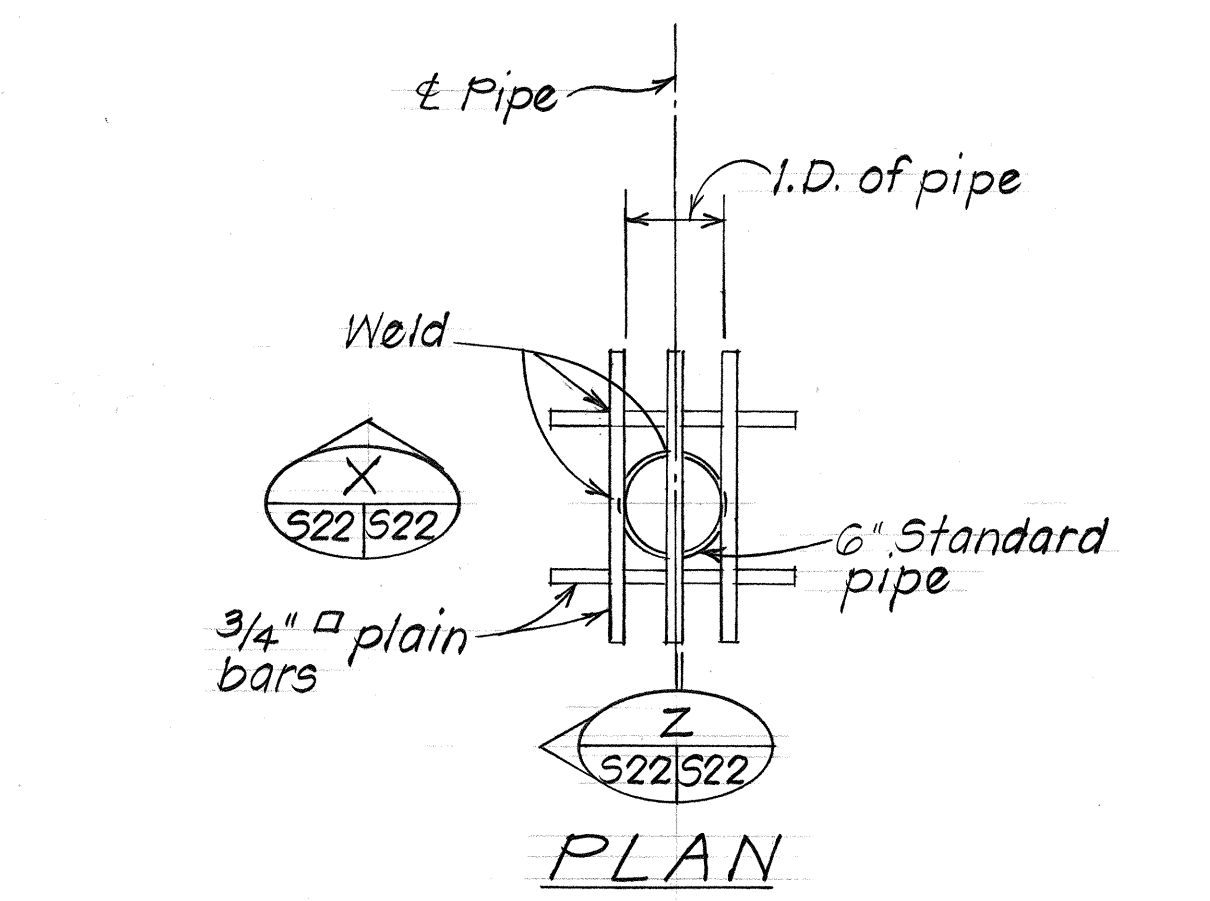

**NOTE:**  
 All abut. bearing seat elevations are based on steel laminated elastomeric bearing pads. If fabric laminations are used in lieu of the steel, appropriate revisions shall be made to the bearing seat elevations to reflect the reduction in thickness of the bearing pads. Any such revision shall be approved by the Engineer.

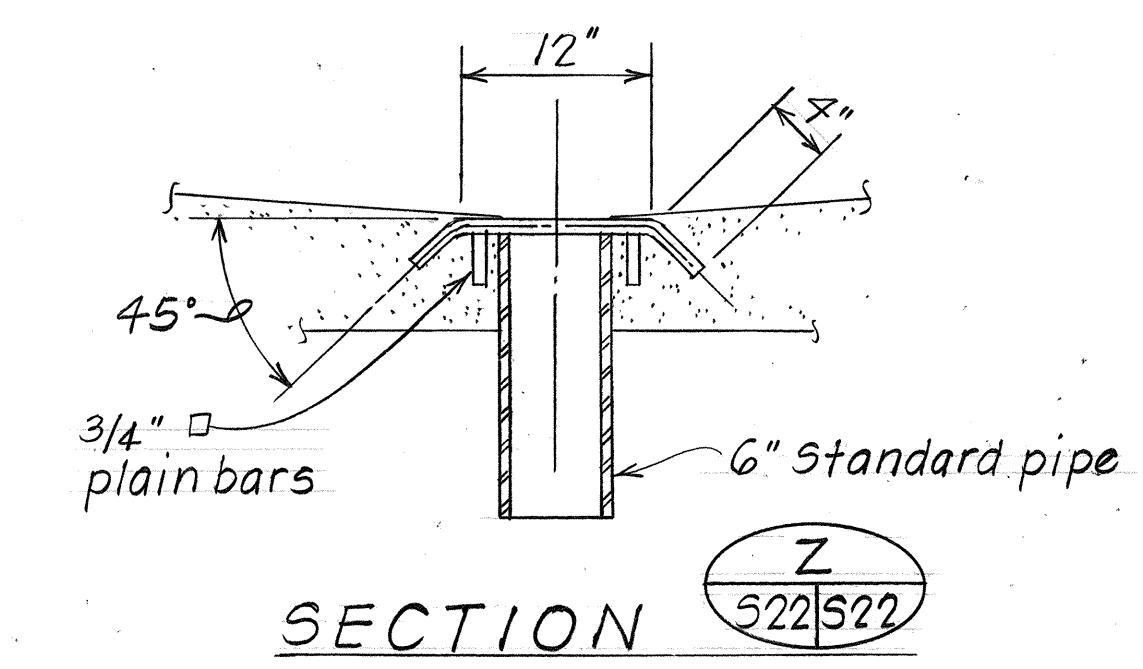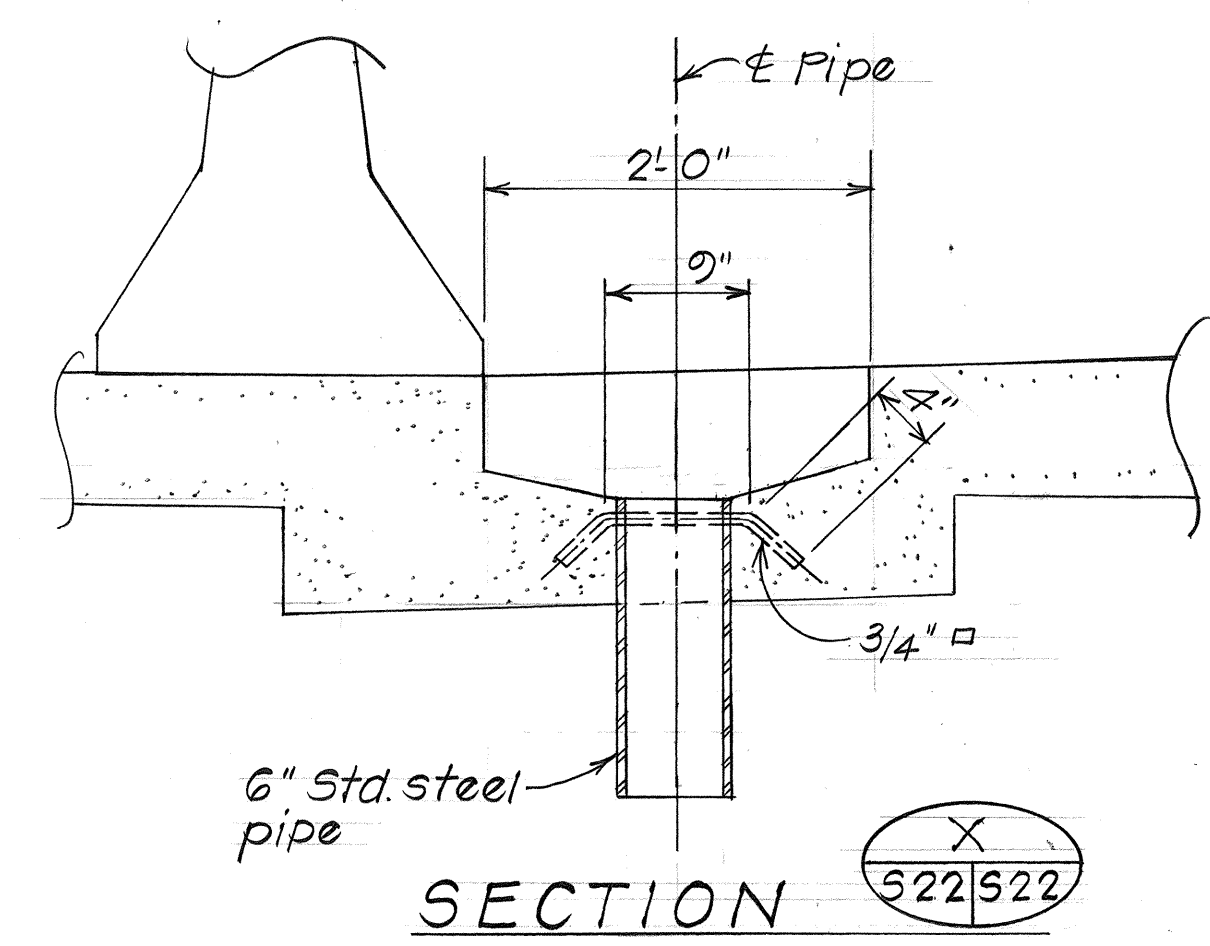

**TYPICAL DRAINAGE DETAIL** Scale: 1" = 1'-0"

DATE: 7/83  
 DESIGNED BY: S.A. D.W.  
 CHECKED BY: D.E.D.  
 SURVEY PLOTTED BY: M.A.  
 TRACED BY: M.A.  
 NOTE BOOK  
 QUANTITIES BY: T.M.  
 No.

STATE OF HAWAII  
 DEPARTMENT OF TRANSPORTATION  
 LAND TRANSPORTATION FACILITIES DIVISION  
 ROUTE H-3 - KUOU STREAM BRIDGE


**TYPICAL DETAILS**  
 PLAN - GIRDER CONG. SEAT & SCHEDULES  
 F.A.I. Proj. No. I-H3-1 (50)  
 KANEOME I.C. TO HALEKOU I.C.  
 Scale: As Noted Date: August 1987  
 SHEET NO. 522 OF 35 SHEETS



| FED. ROAD DIST. NO. | STATE | FED. AID PROJ. NO. | FISCAL YEAR | SHEET NO. | TOTAL SHEETS |
|---------------------|-------|--------------------|-------------|-----------|--------------|
| HAWAII              | HAW.  | I-H3-1(50)         | 1987        | 104       | 164          |

# **NOTE:**


1. Restrainer assemblage incidental to concrete & will not be paid for separately.
2. Restrainer assemblage shall be securely held in place while placing concrete.

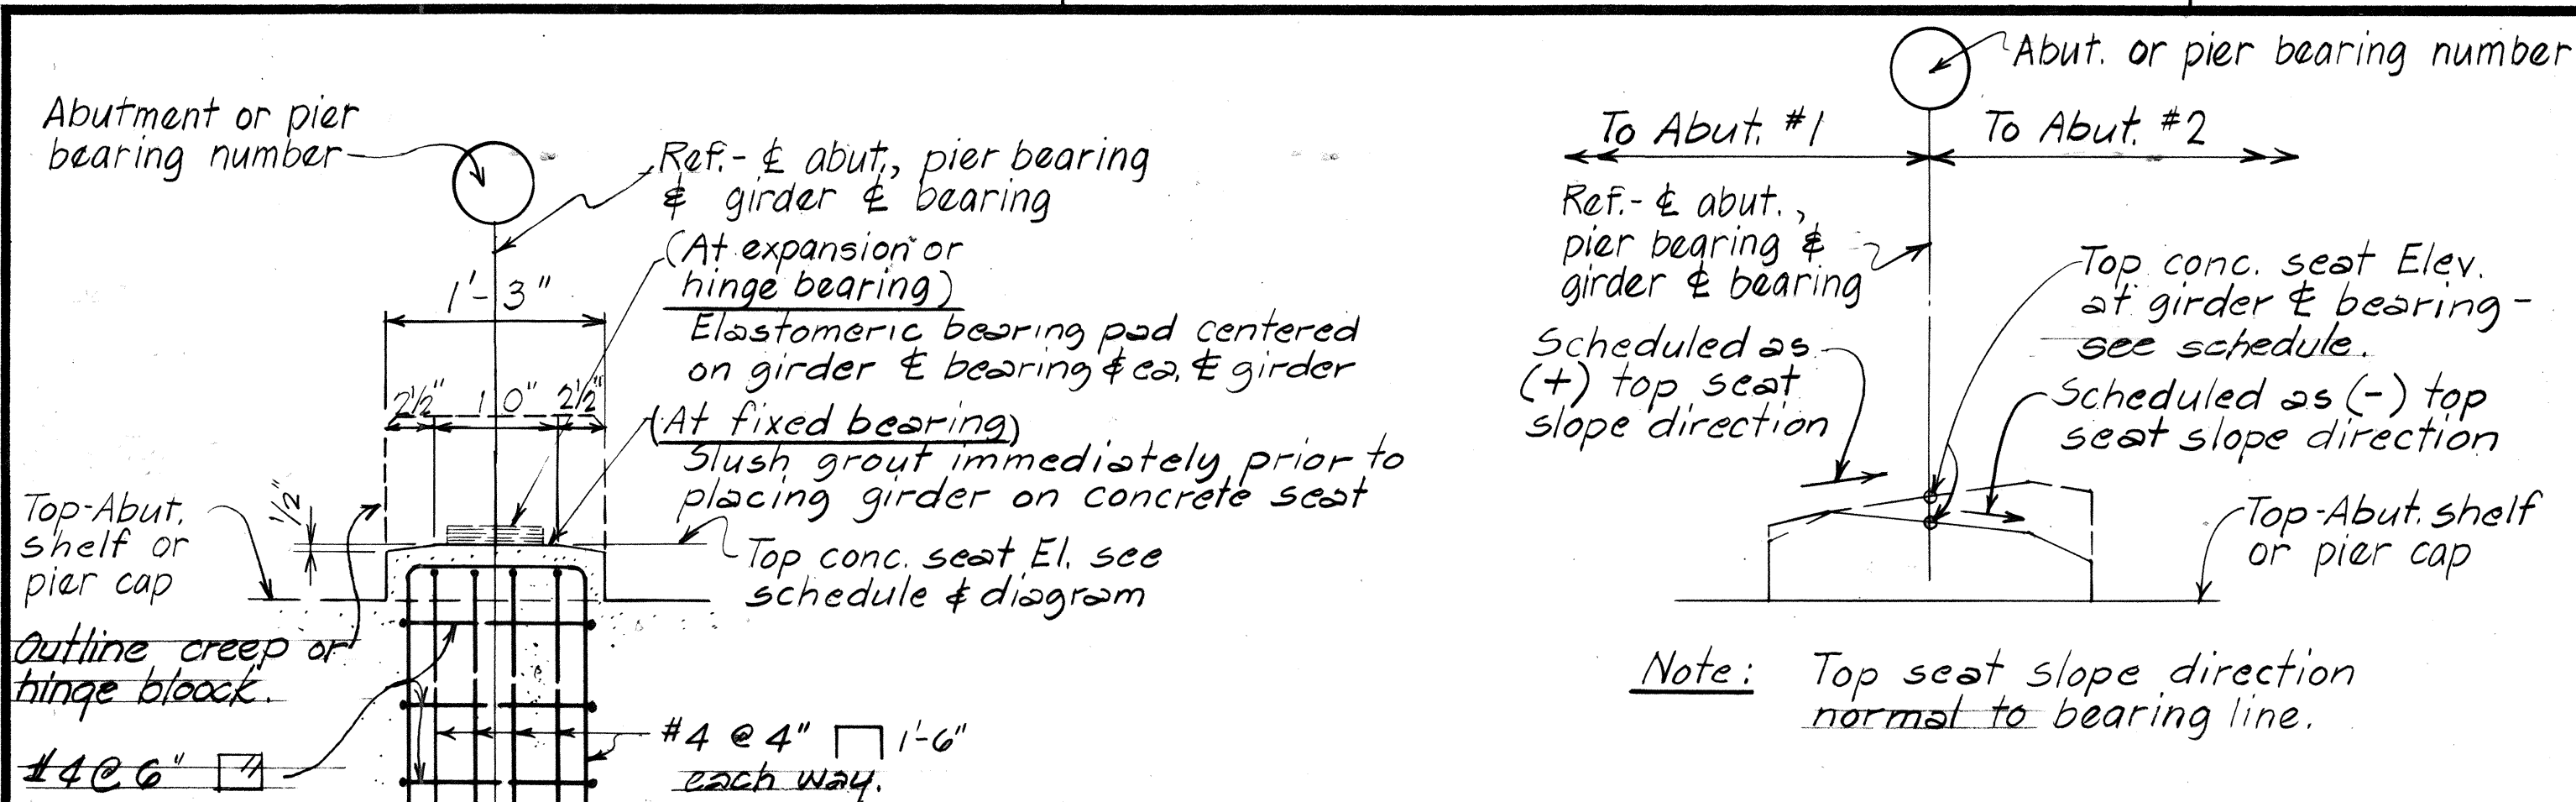


**SHOWING REINFORCEMENT AND DIMENSIONS**

**DIAGRAM - TOP OF SEAT SLOPE CONDITIONS**


**TYPICAL SEAT SECTION**

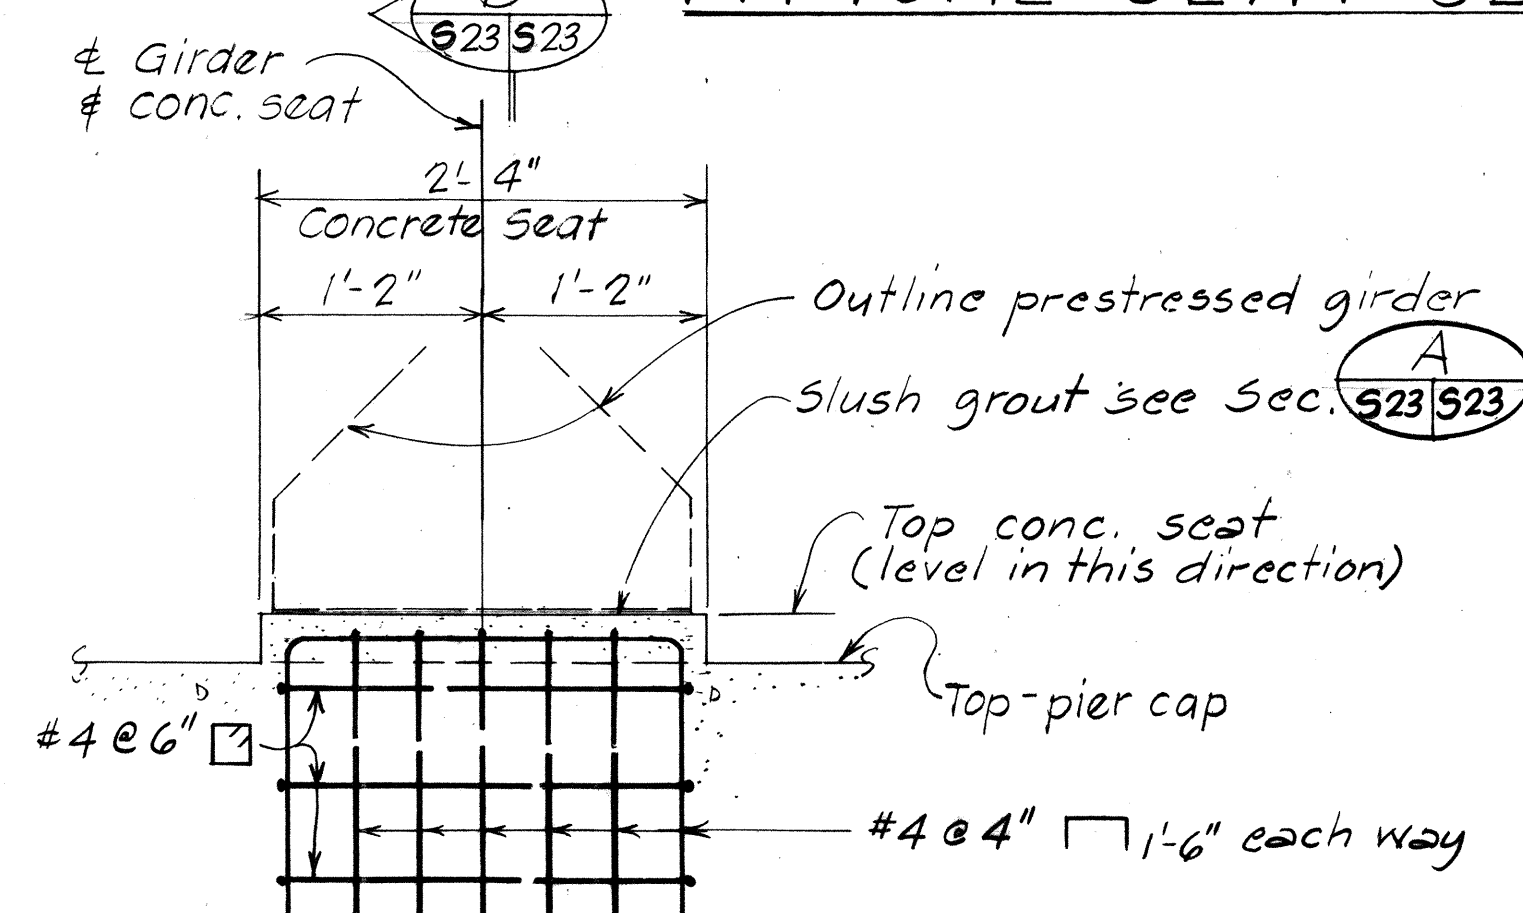

**SEAT ELEVATION (AT FIXED BEARING)**

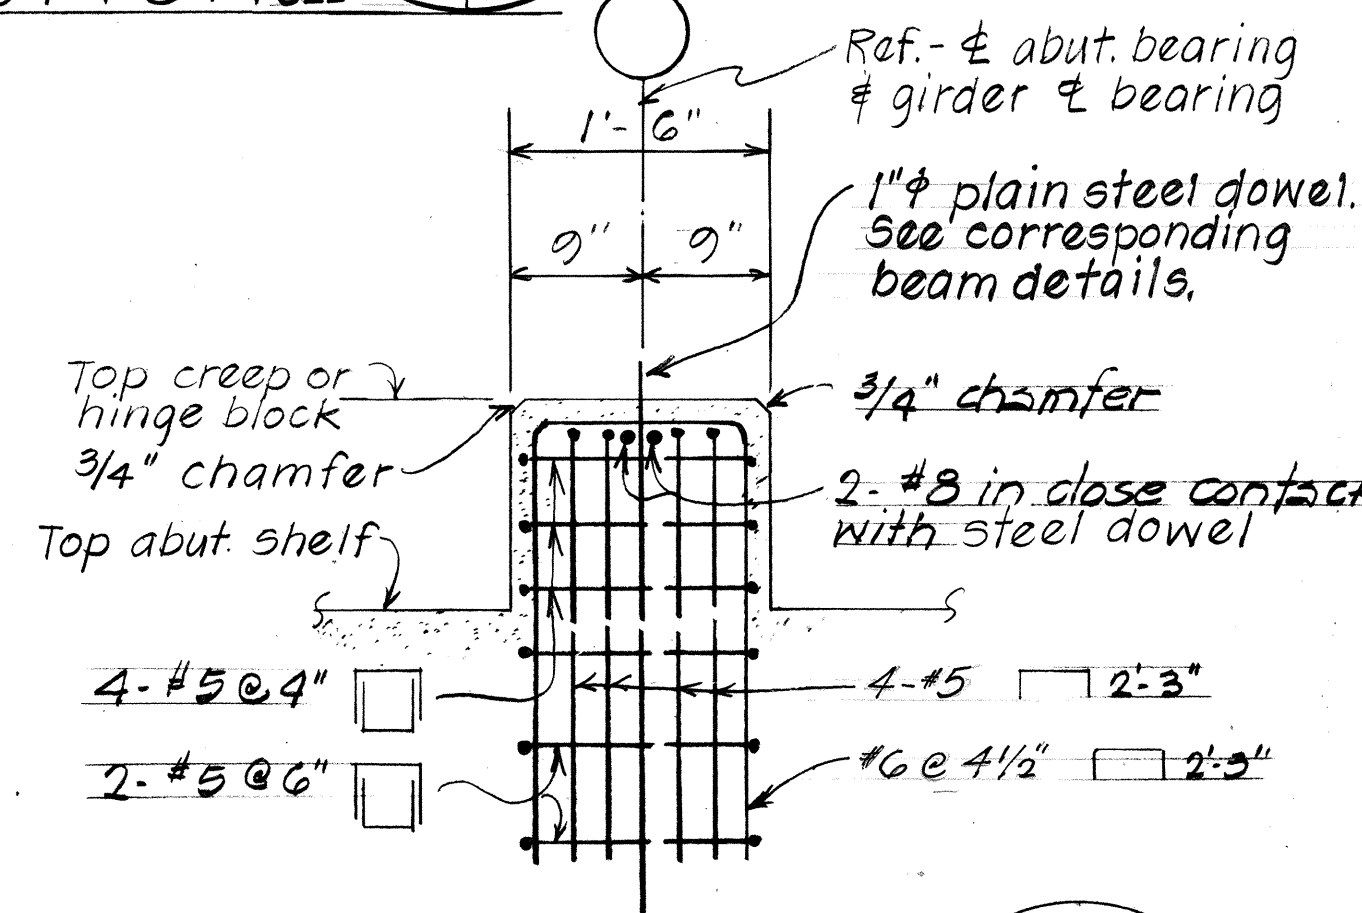

**TYPICAL SECTION (AT HINGE OR CREEP BLOCK)**

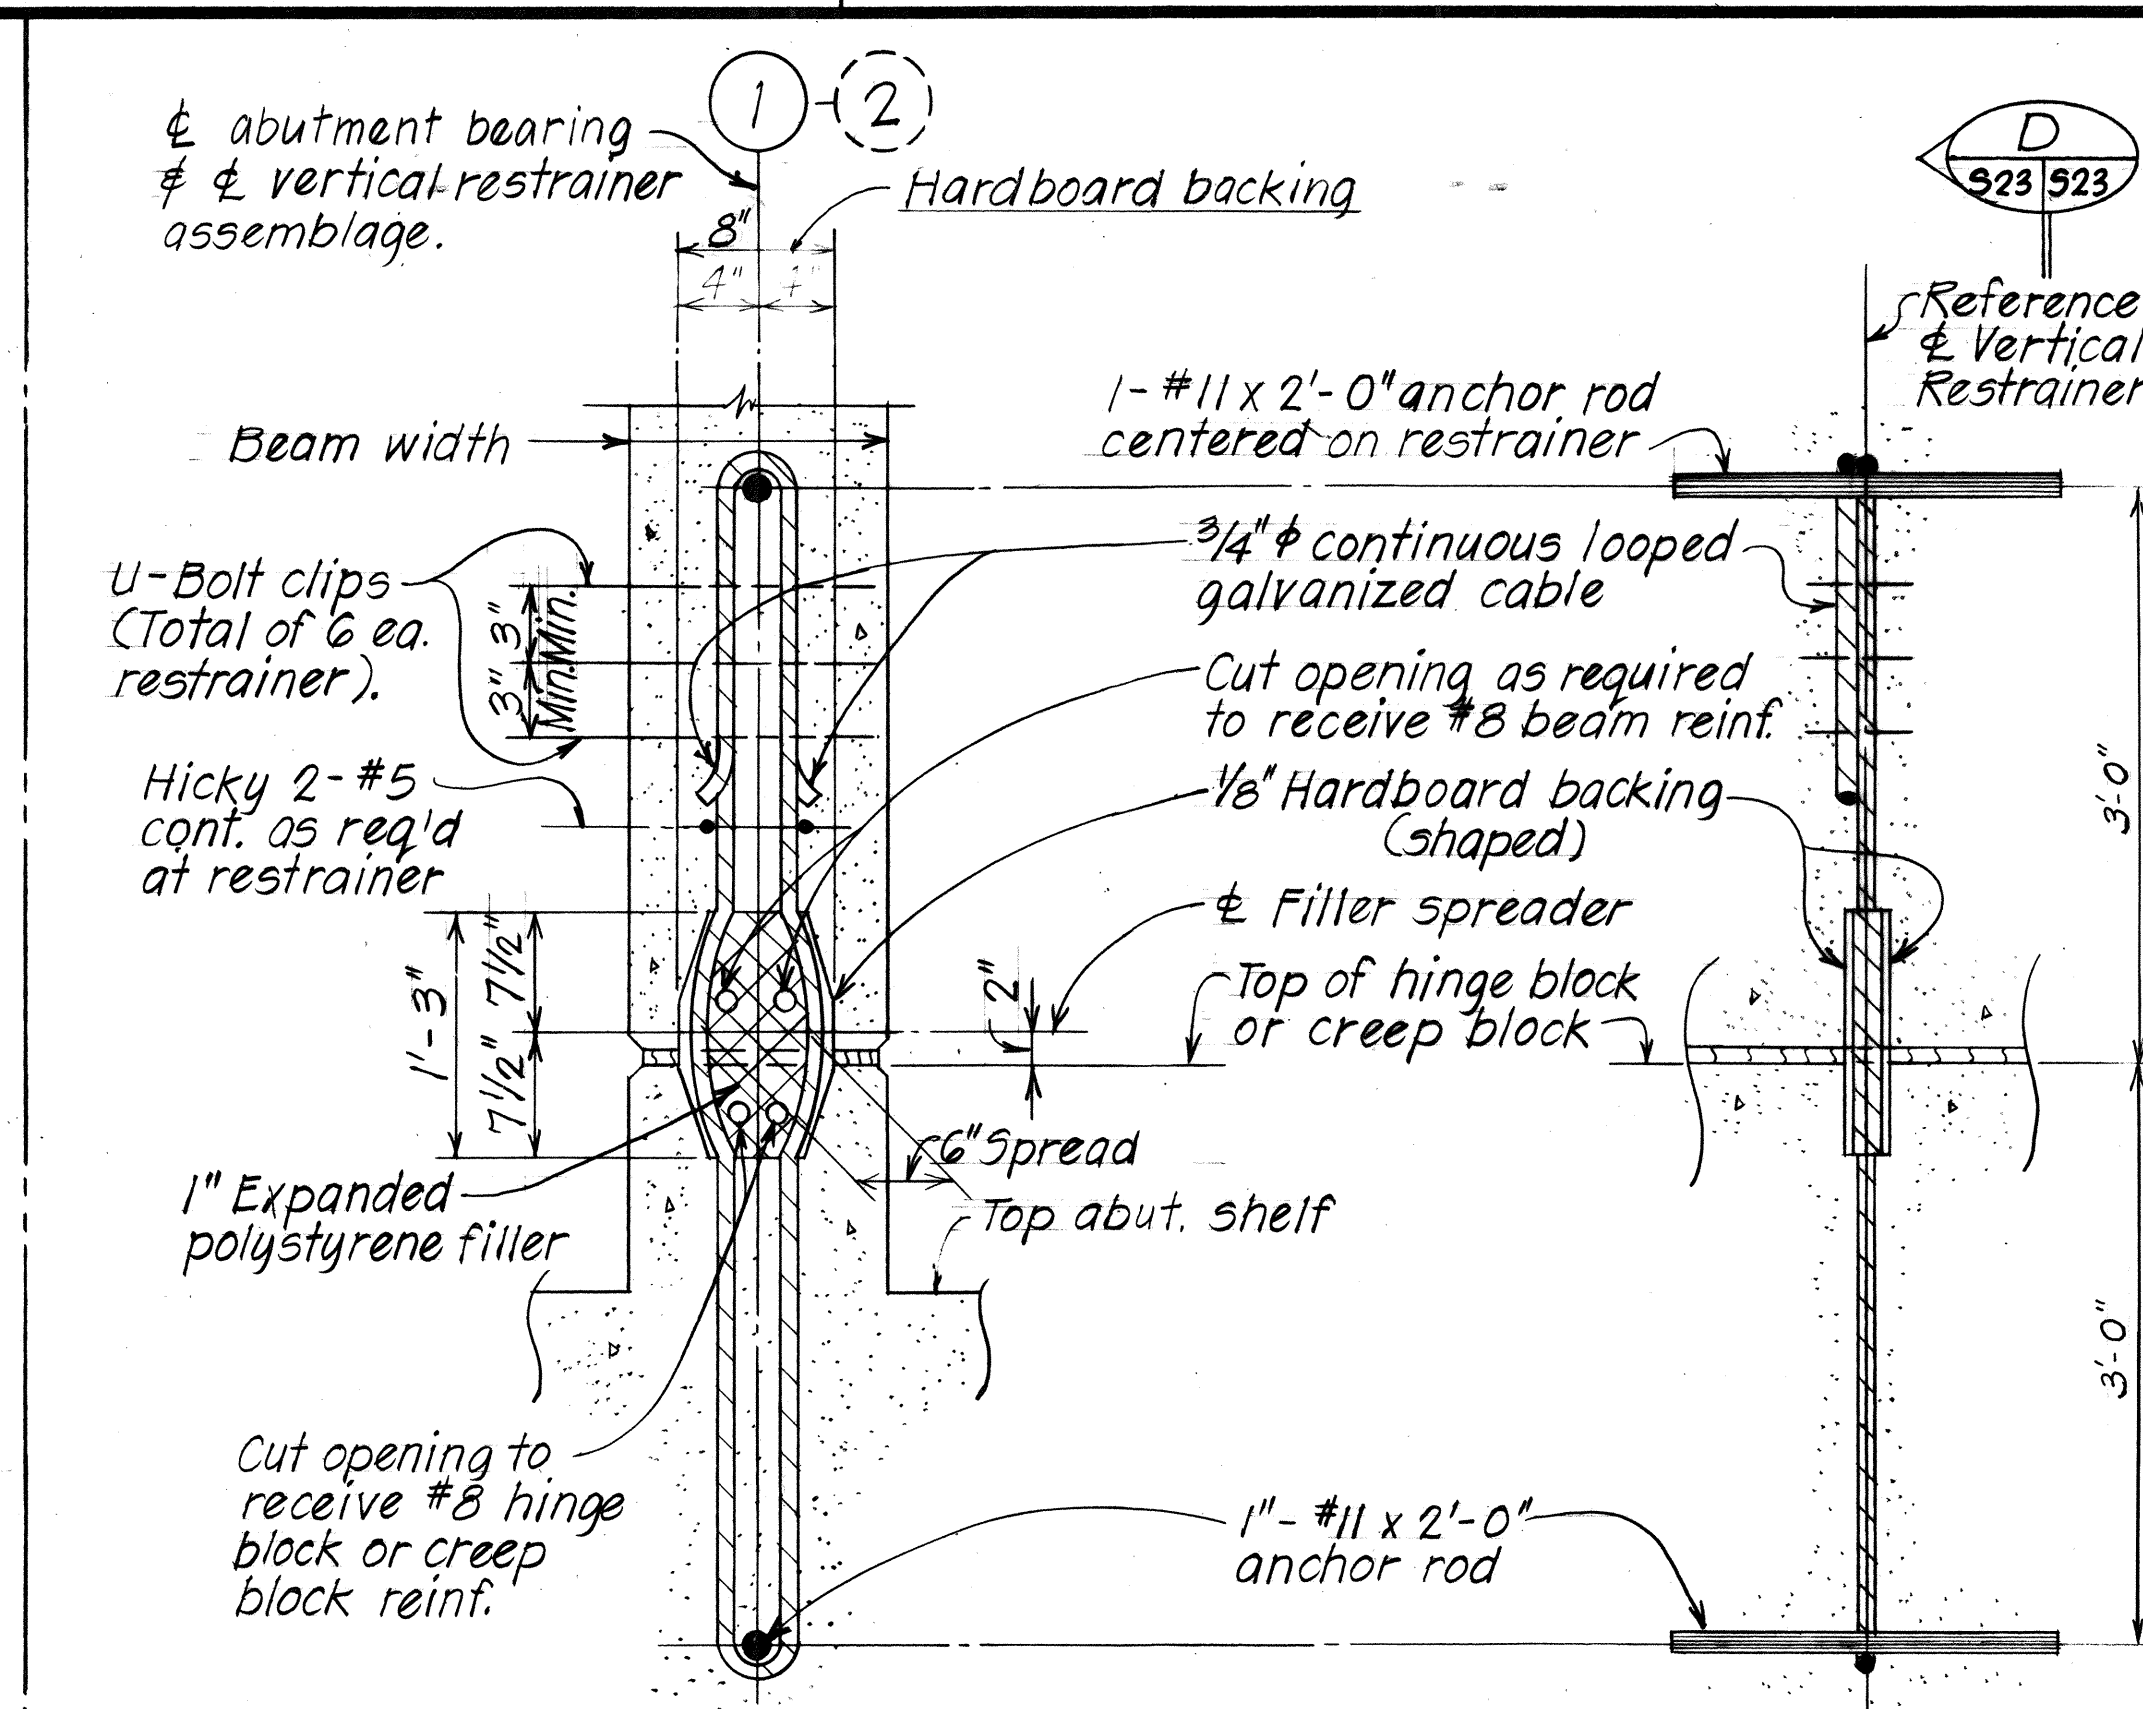


**SECTION**

**ELEVATION**

**TYPICAL VERTICAL RESTRAINER DETAILS**

Scale: 1"=1'-0"

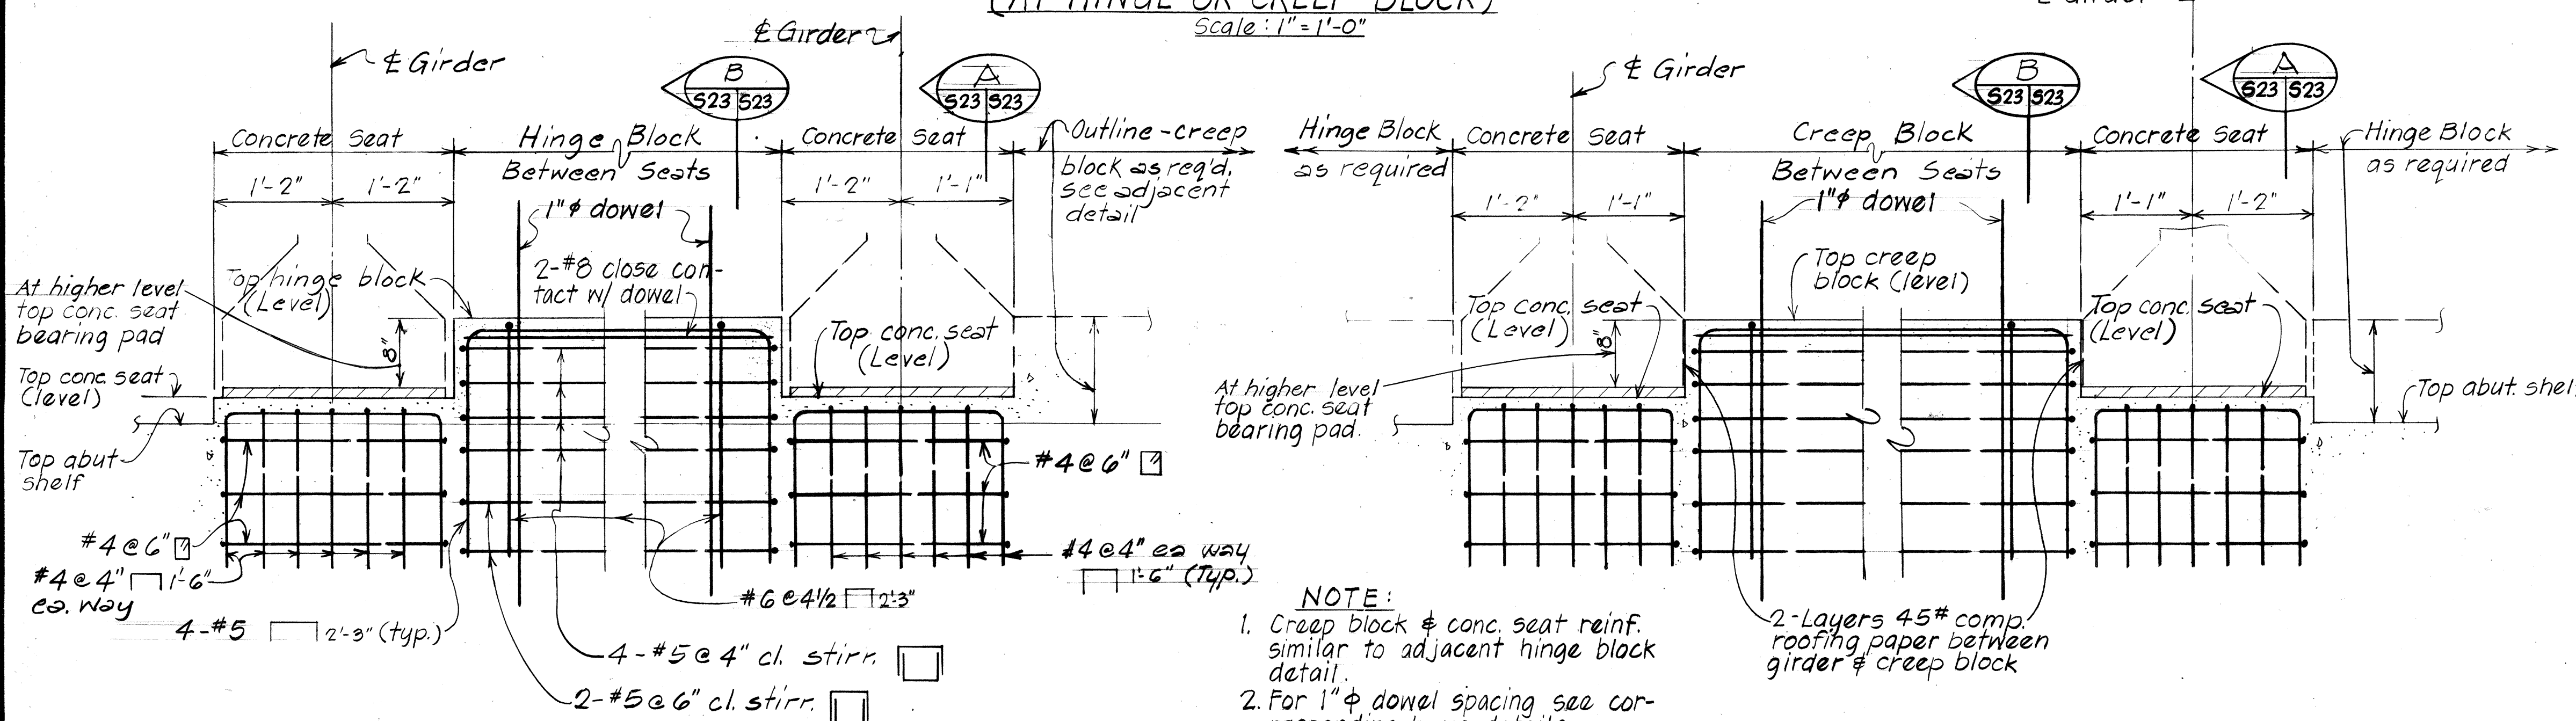

**SEAT ELEVATION (AT HINGE BLOCK)**

**SEAT ELEVATION (AT CREEP BLOCK)**

**TYPICAL-CONCRETE SEATS, HINGE & CREEP BLOCKS DETAILS**

Scale: 1"=1'-0"


- NOTE:**
1. Creep block & conc. seat reinf. similar to adjacent hinge block detail.
  2. For 1" dowel spacing see corresponding beam details.

STATE OF HAWAII  
DEPARTMENT OF TRANSPORTATION  
LAND TRANSPORTATION FACILITIES DIVISION  
**ROUTE H-3 - KUOUI STREAM BRIDGE**


**TYPICAL DETAILS**  
HINGE BLK, CREEP BLK & VERT. RESTRAINER  
F.A.I. Proj. No. I-H3-1(50)  
KANEIOHE I.C. TO HALEKOU I.C.  
Scale: As Noted Date: August 1987  
SHEET No. 523 OF 35 SHEETS



| FED. ROAD DIST. NO. | STATE | FED. AID PROJ. NO. | FISCAL YEAR | SHEET NO. | TOTAL SHEETS |
|---------------------|-------|--------------------|-------------|-----------|--------------|
| HAWAII              | HAW.  | I-H3-1(50)         | 1987        | 105       | 164          |

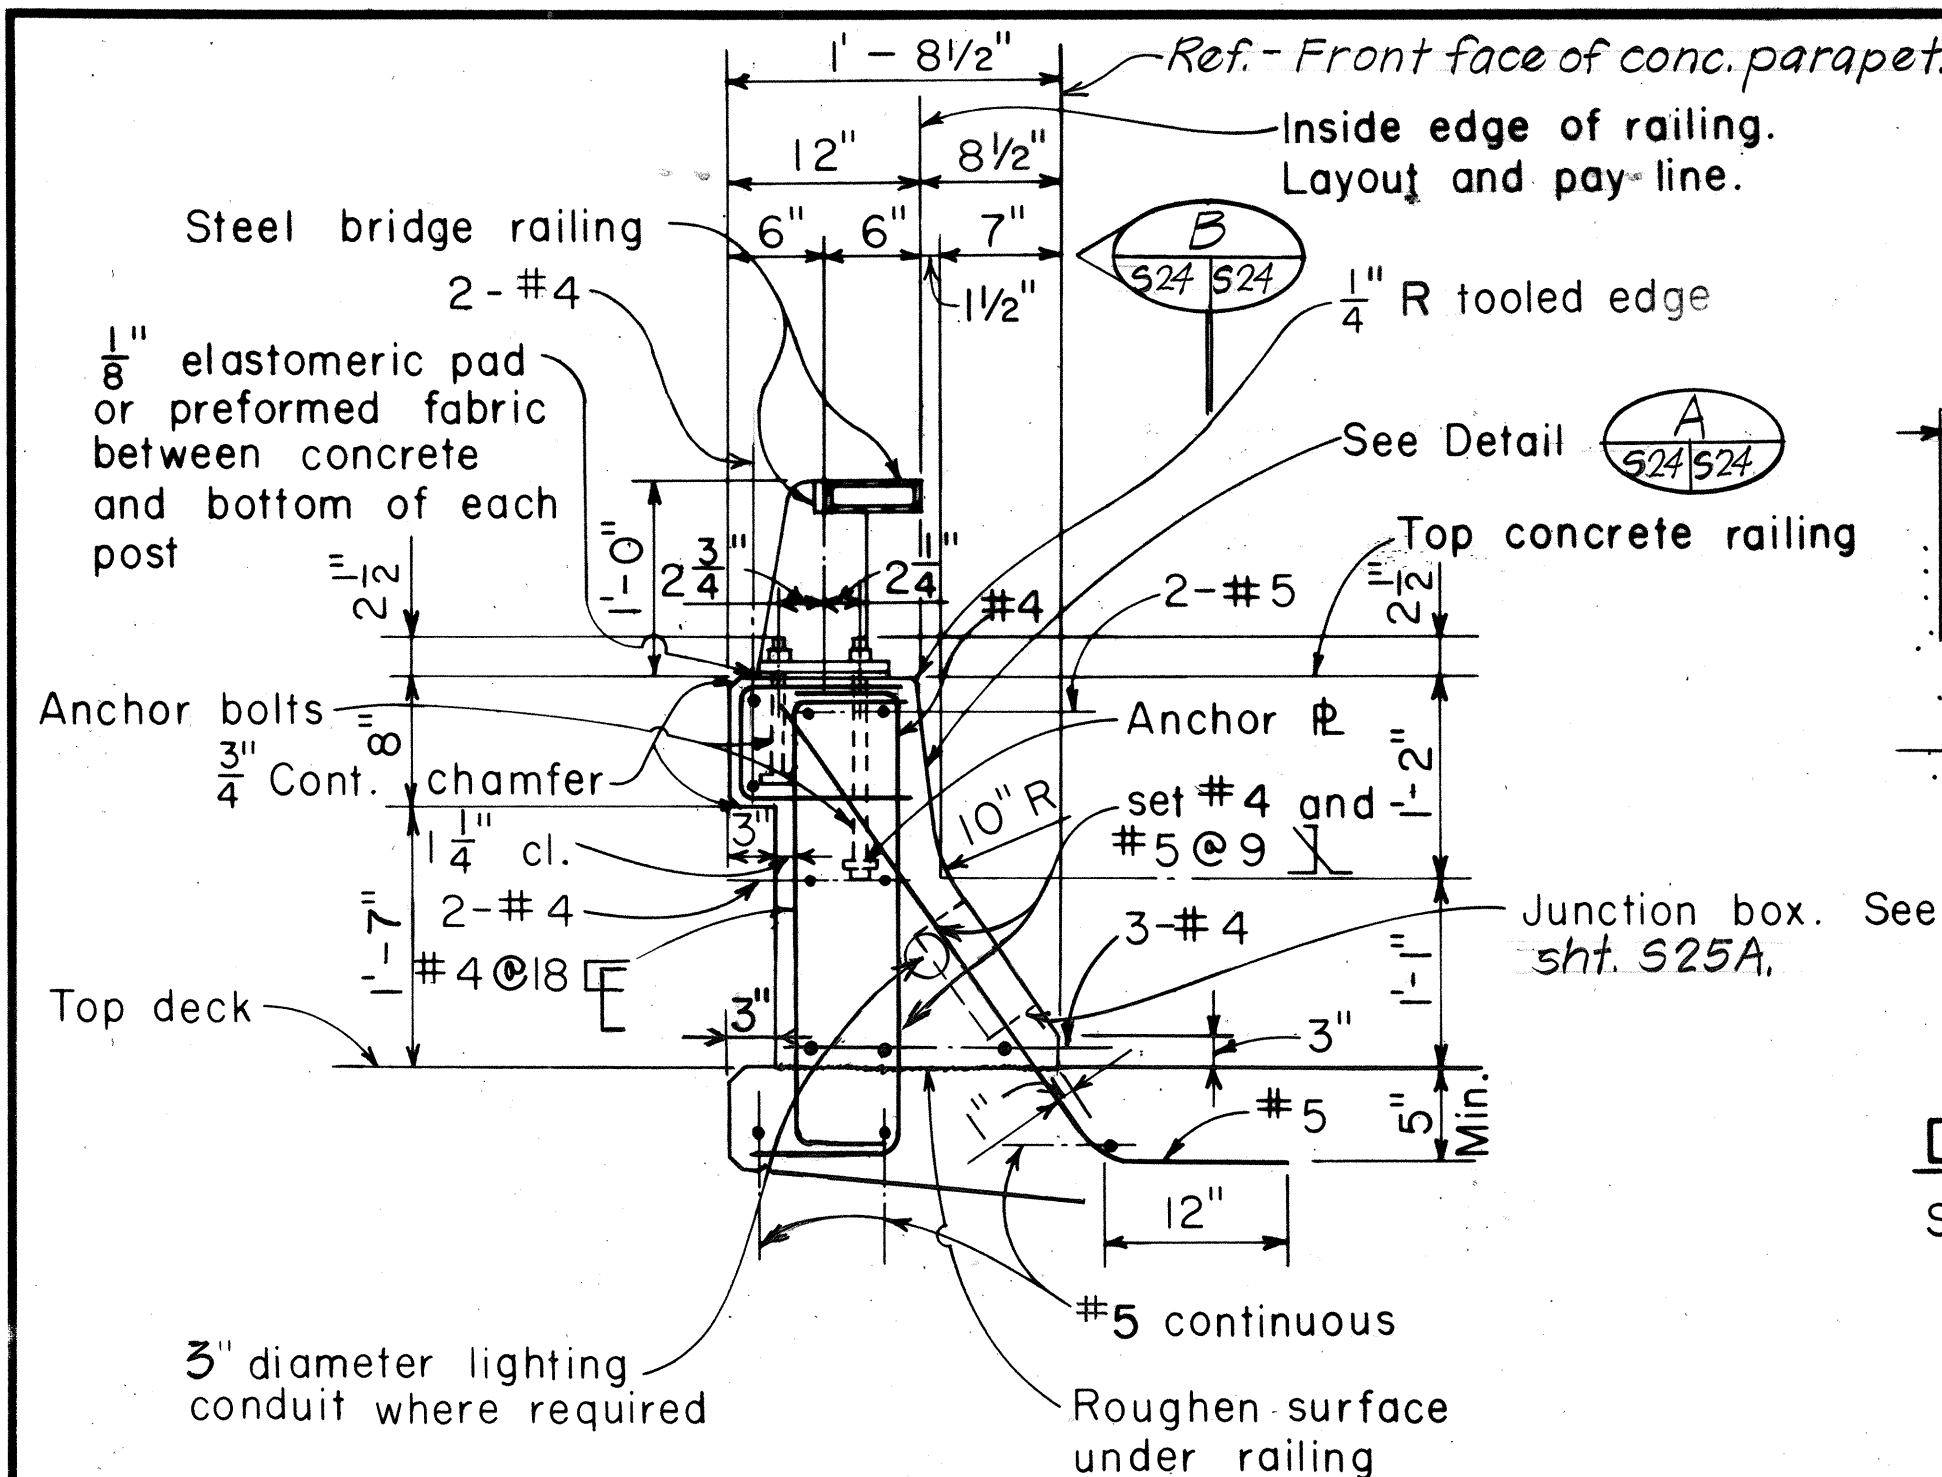


**TYPICAL SECTION** Not To Scale

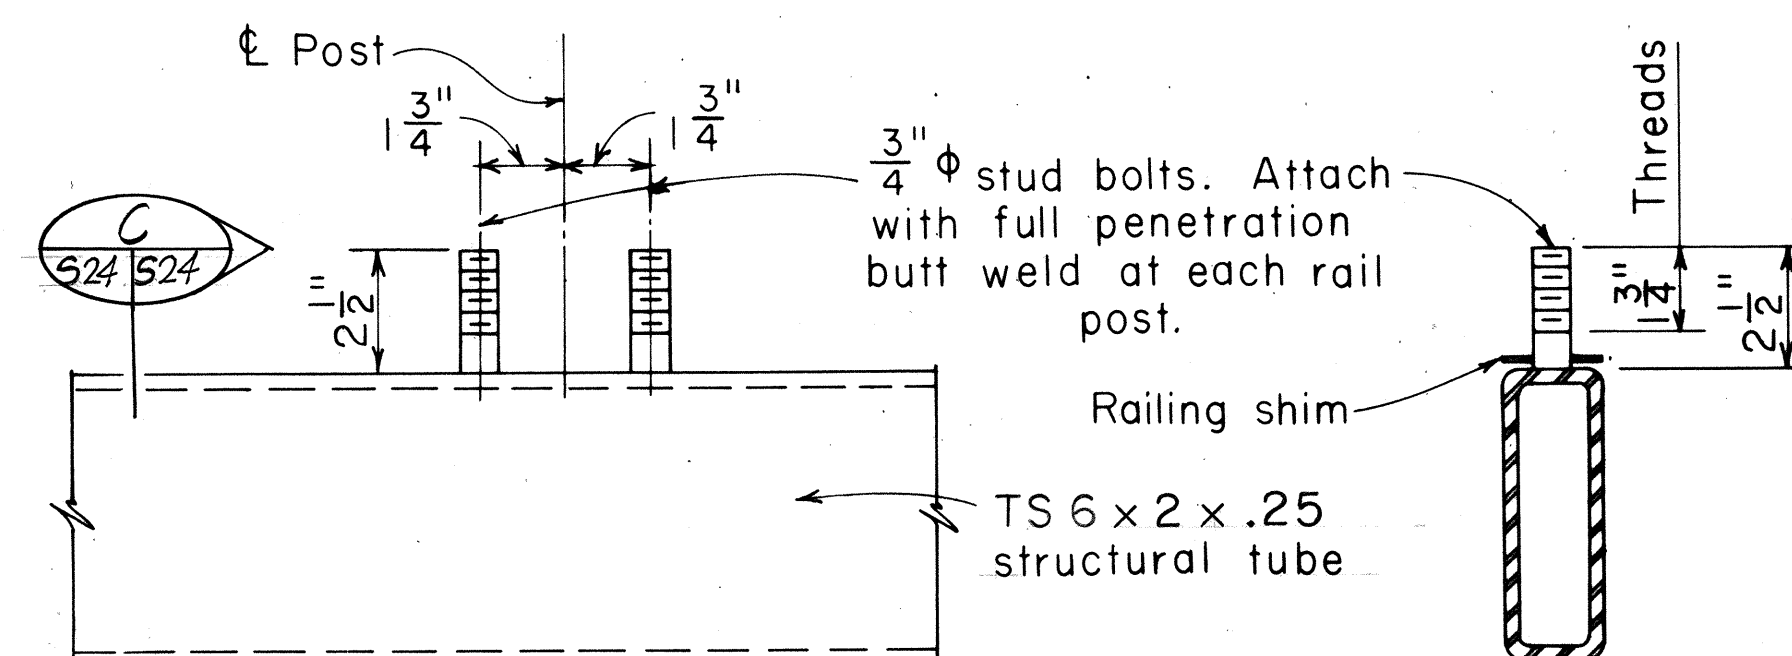


**PLAN**

**TUBE RAIL DETAILS**


Scale: 3" = 1'-0"

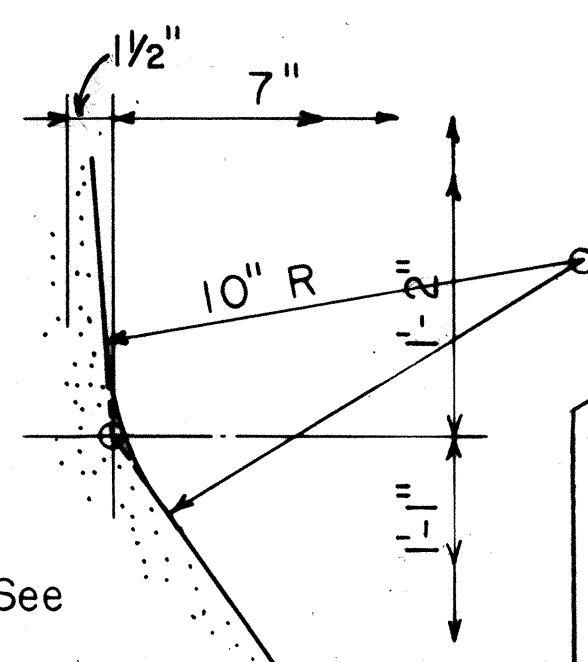

**DETAIL A**  
Scale: 3" = 1'-0"

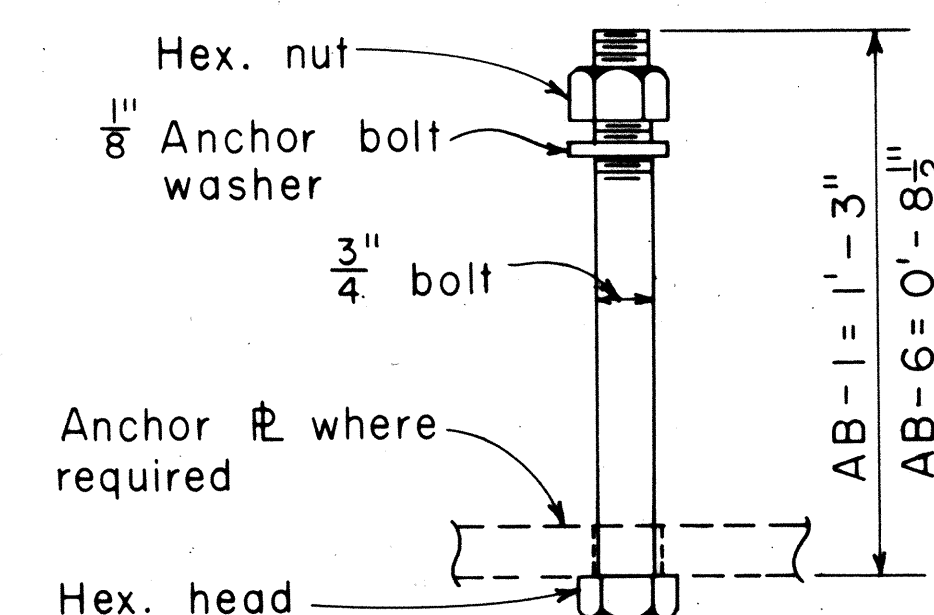

**TYPICAL ANCHOR BOLT (AB) ASSEMBLY**

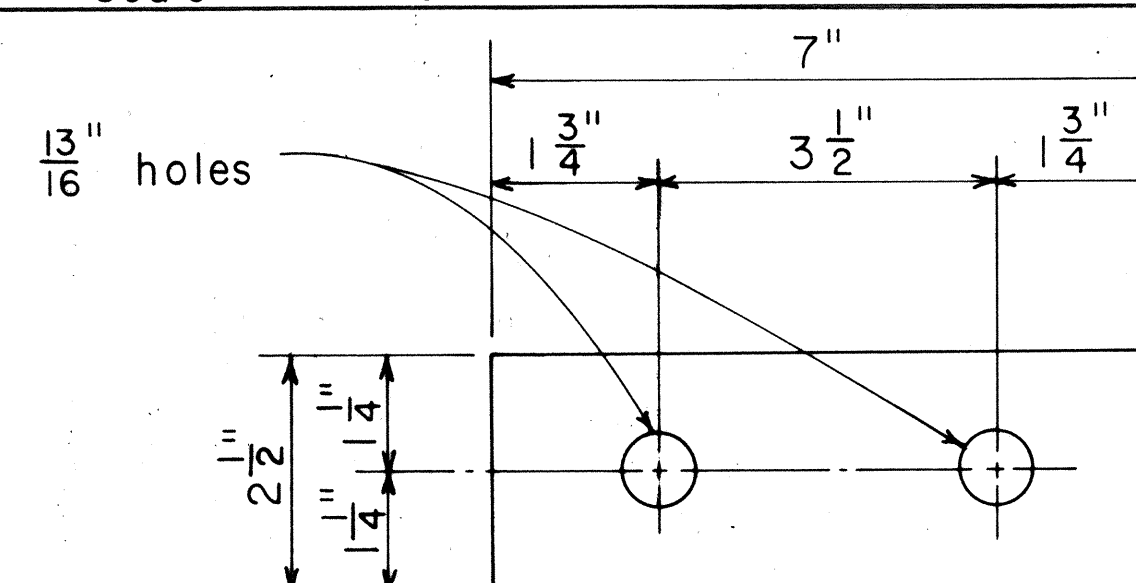


**PLAN**

**ELEVATION**


**TYPICAL ANCHOR BOLT DETAIL**

Scale: Half Size

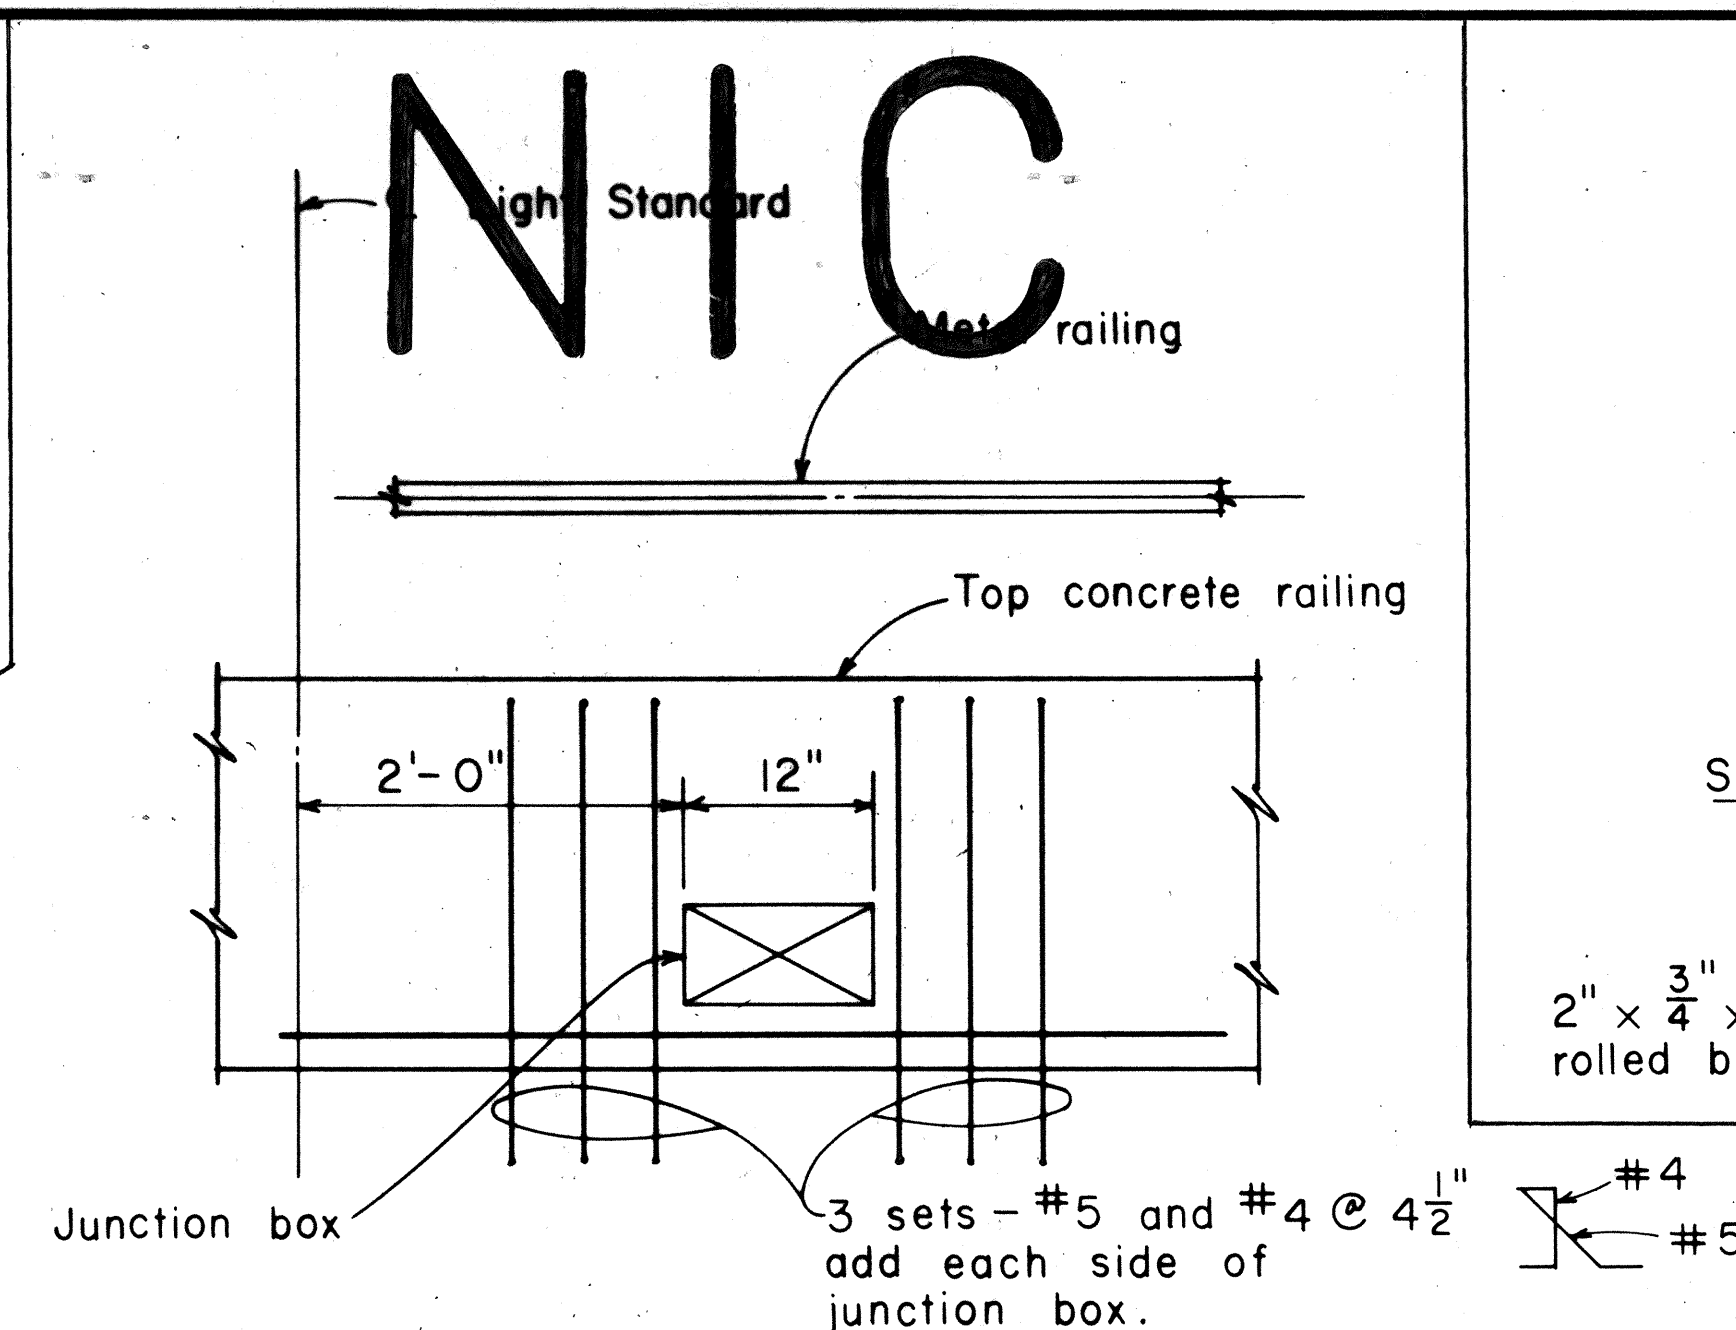


**ELEVATION B**  
**REINFORCEMENT AT JUNCTION BOX**


Scale: 1" = 1'-0"

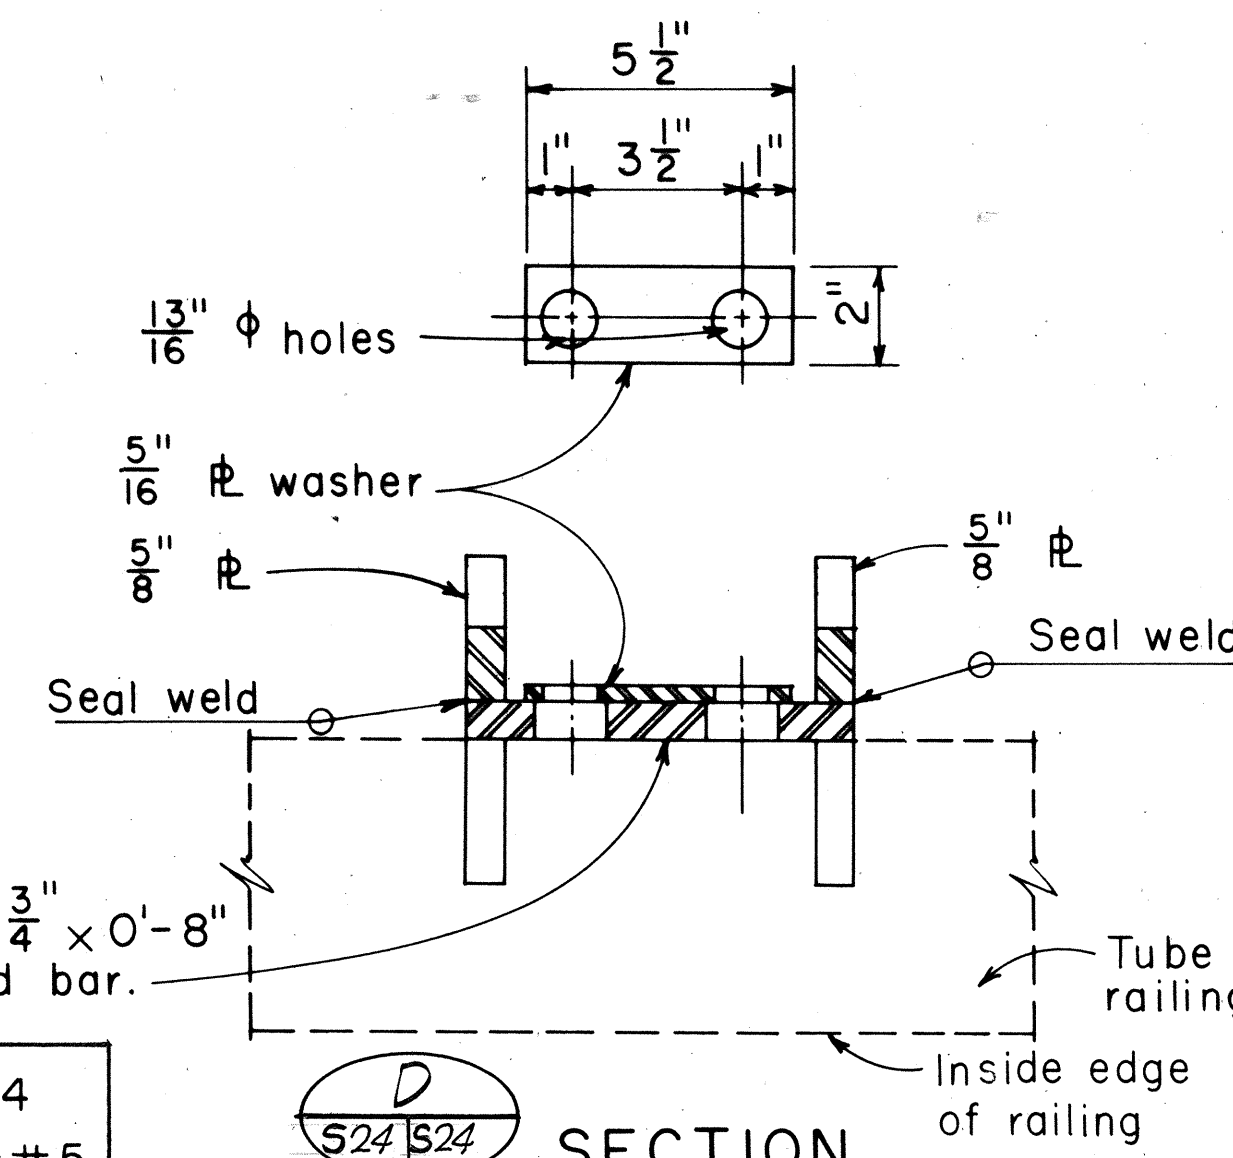


**SECTION D**

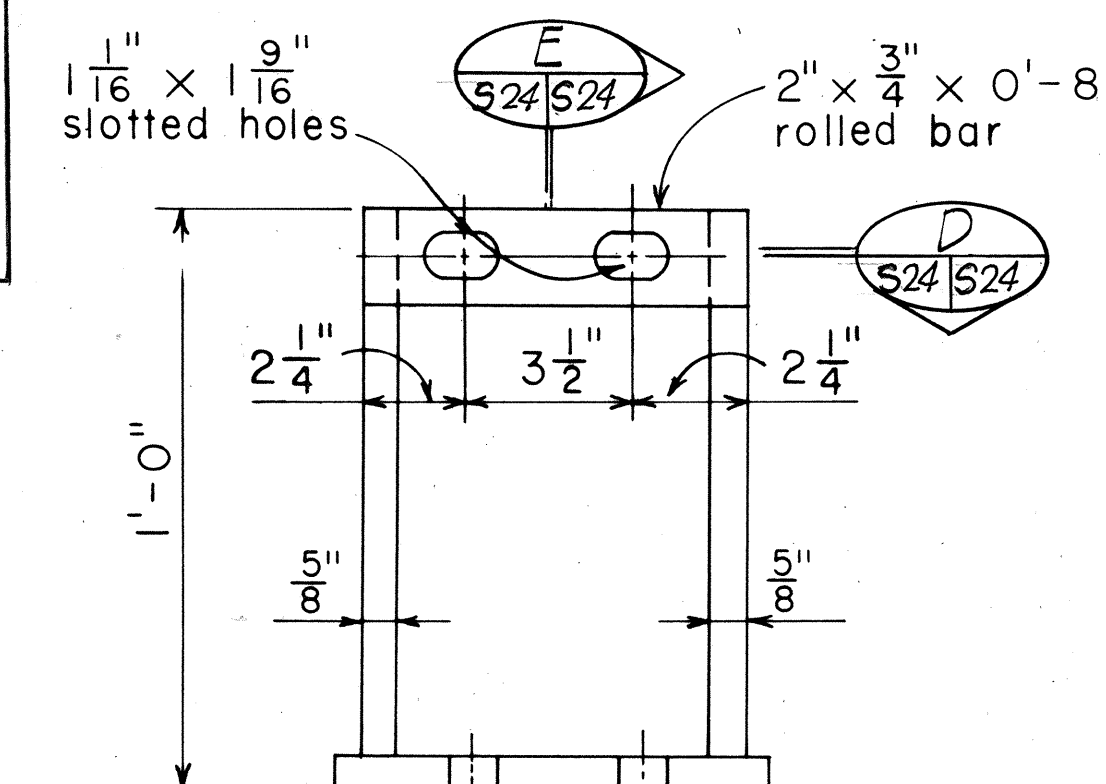

**ELEVATION E**

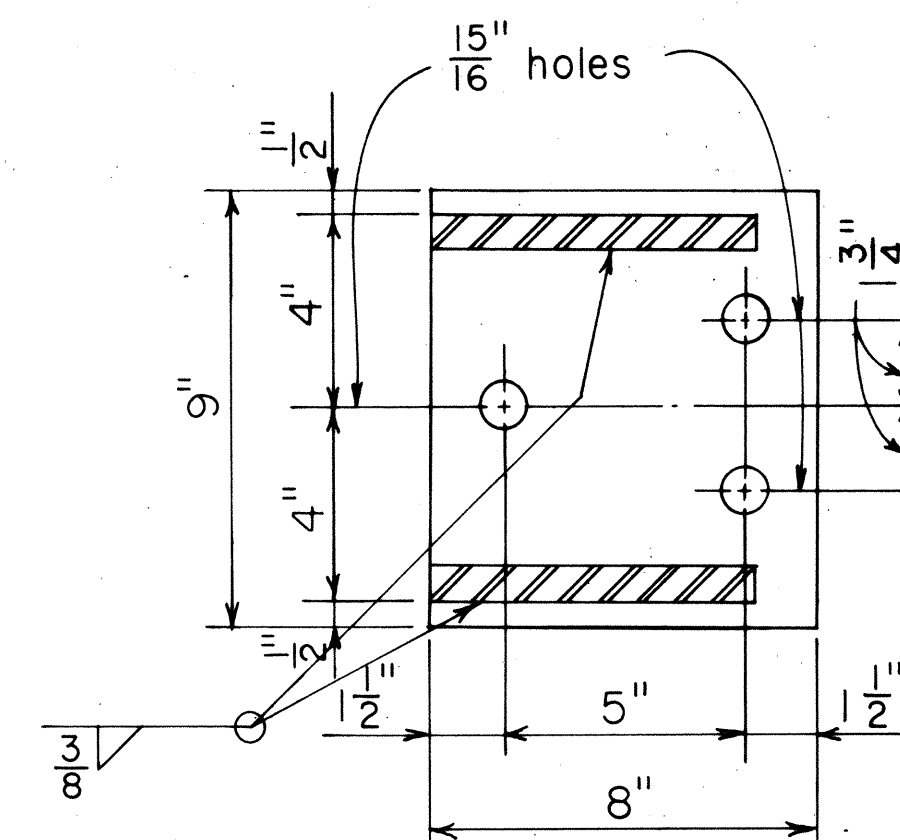


**SECTION F**

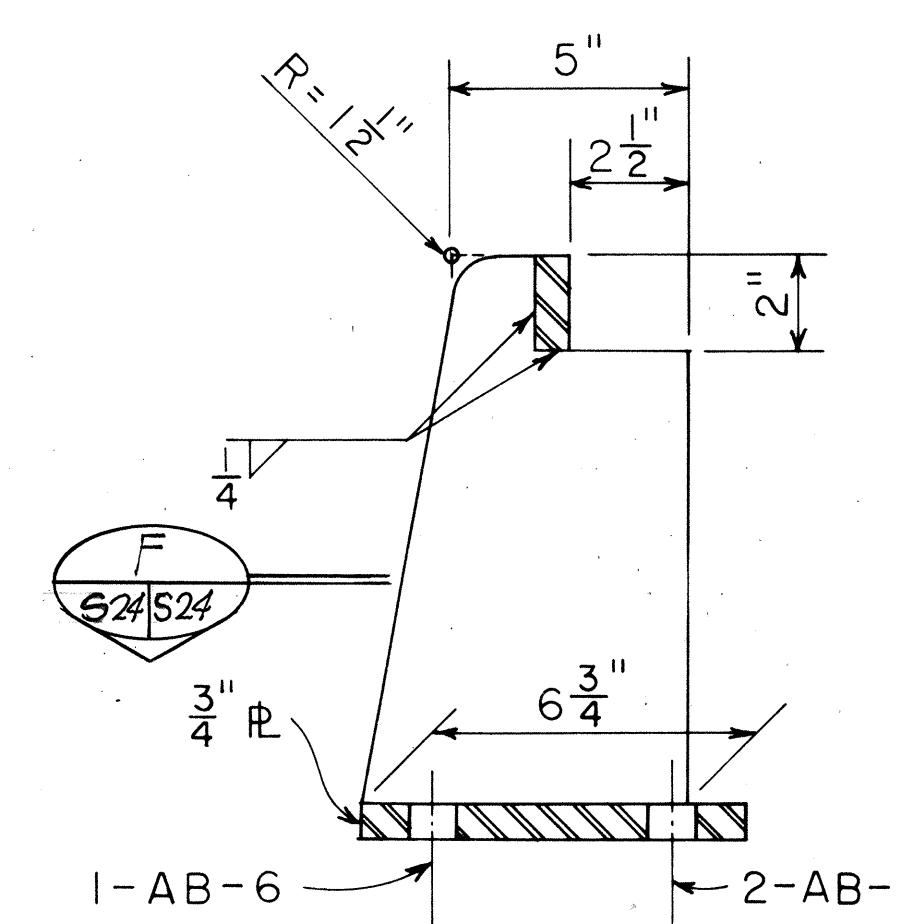

**SECTION G**


**RAIL POST DETAILS**

Scale: 3" = 1'-0"

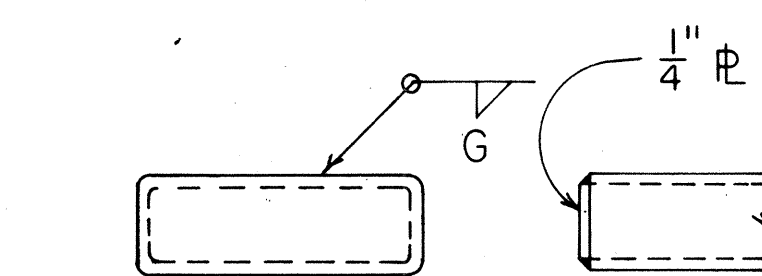


**RAIL CAP**

Scale: 3" = 1'-0"

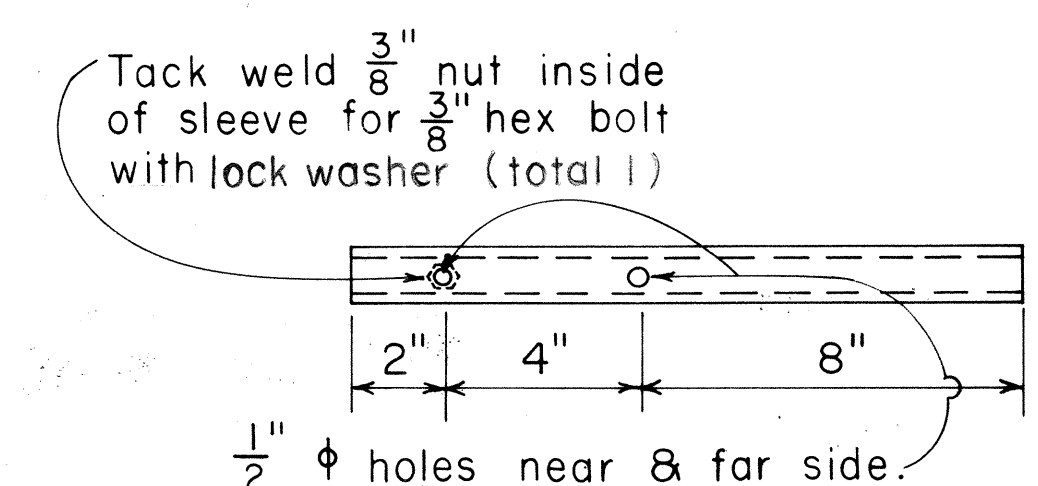

**SLEEVE**

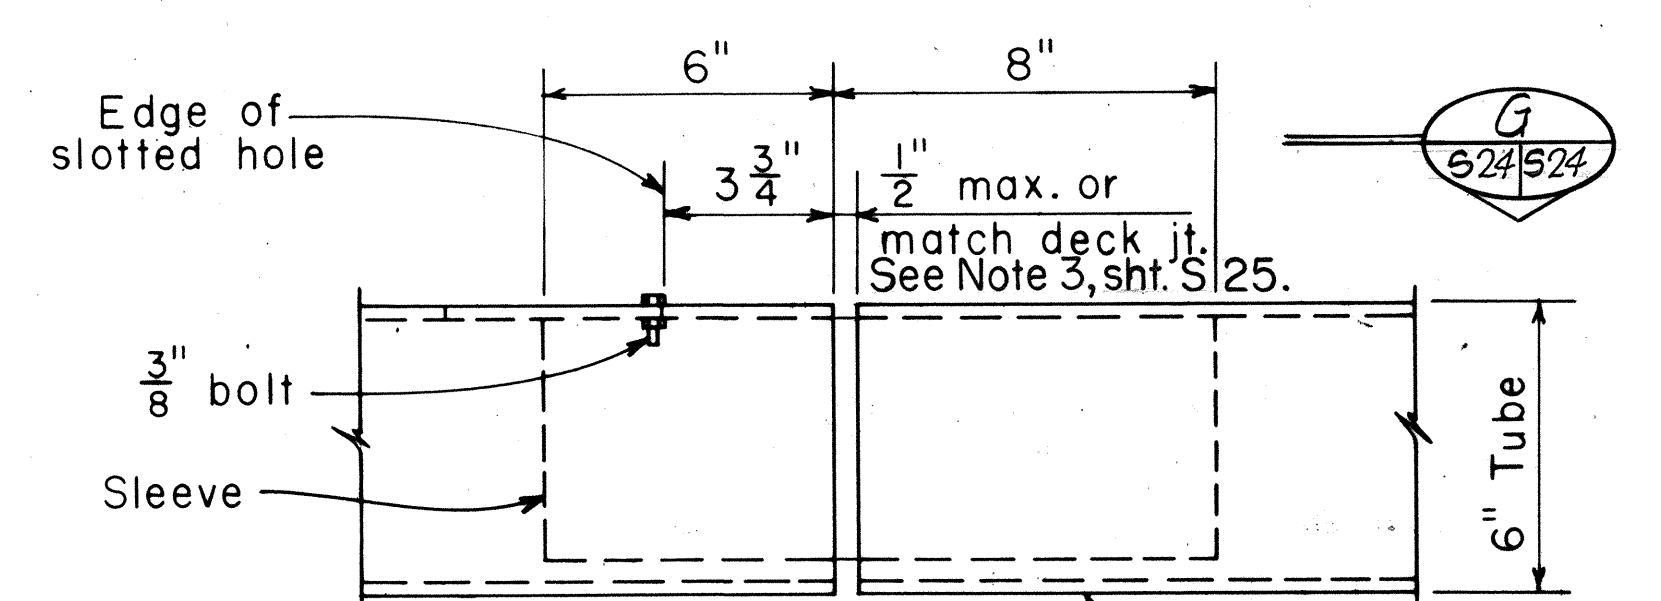


**PLAN**

**VIEW**

**TUBE SPLICE DETAIL**

Scale: 3" = 1'-0"

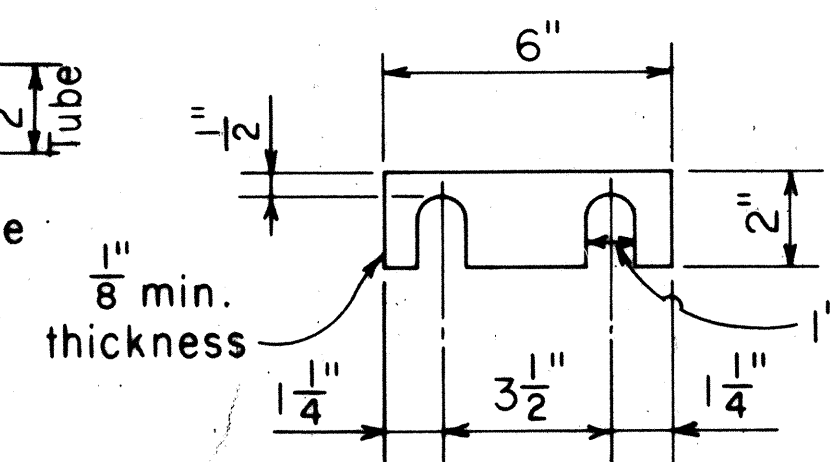

**RAILING SHIM DETAIL**

Scale: 3" = 1'-0"

3/29/90 Addition of lighting standard & junction boxes.

DATE REVISION

STATE OF HAWAII  
DEPARTMENT OF TRANSPORTATION  
HIGHWAYS DIVISION  
ROUTE H-3 - KUOUI STREAM BRIDGE

TYPICAL DETAILS  
STEEL BRIDGE RAIL ON PARAPET  
F.A.I. Proj. No. I-H3-1(50)  
KANEHOE I.C. TO HALEKOU I.C.  
Scale: As Noted. Date: August 1987


SHEET No. 524 OF 35 SHEETS

C.O. 105

105




| FED. ROAD DIST. NO. | STATE | FED. AID PROJ. NO. | FISCAL YEAR | SHEET NO. | TOTAL SHEETS |
|---------------------|-------|--------------------|-------------|-----------|--------------|
| HAWAII              | HAW.  | I-H3-1(50)         | 1989        | 106       | 164          |

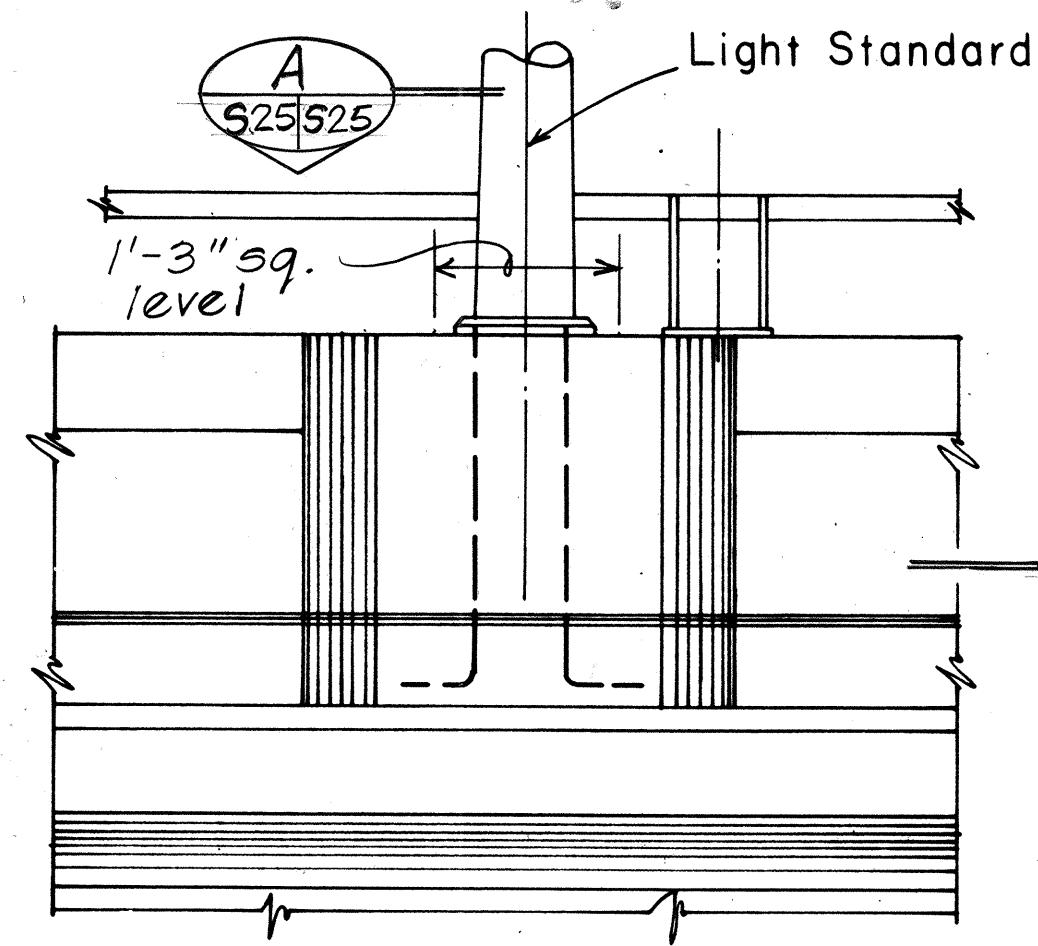


EXTERIOR ELEVATION

Scale:  $\frac{3}{4}'' = 1'-0''$

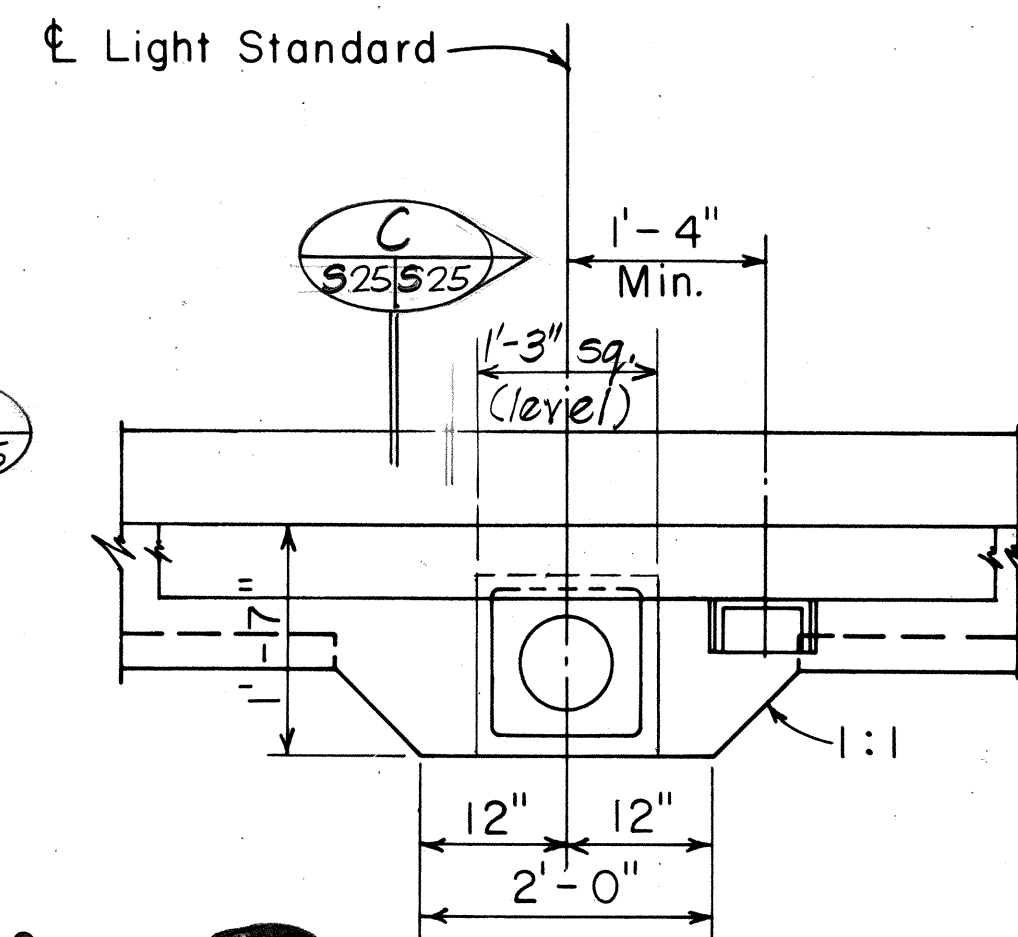


PLAN

Scale:  $\frac{3}{4}'' = 1'-0''$

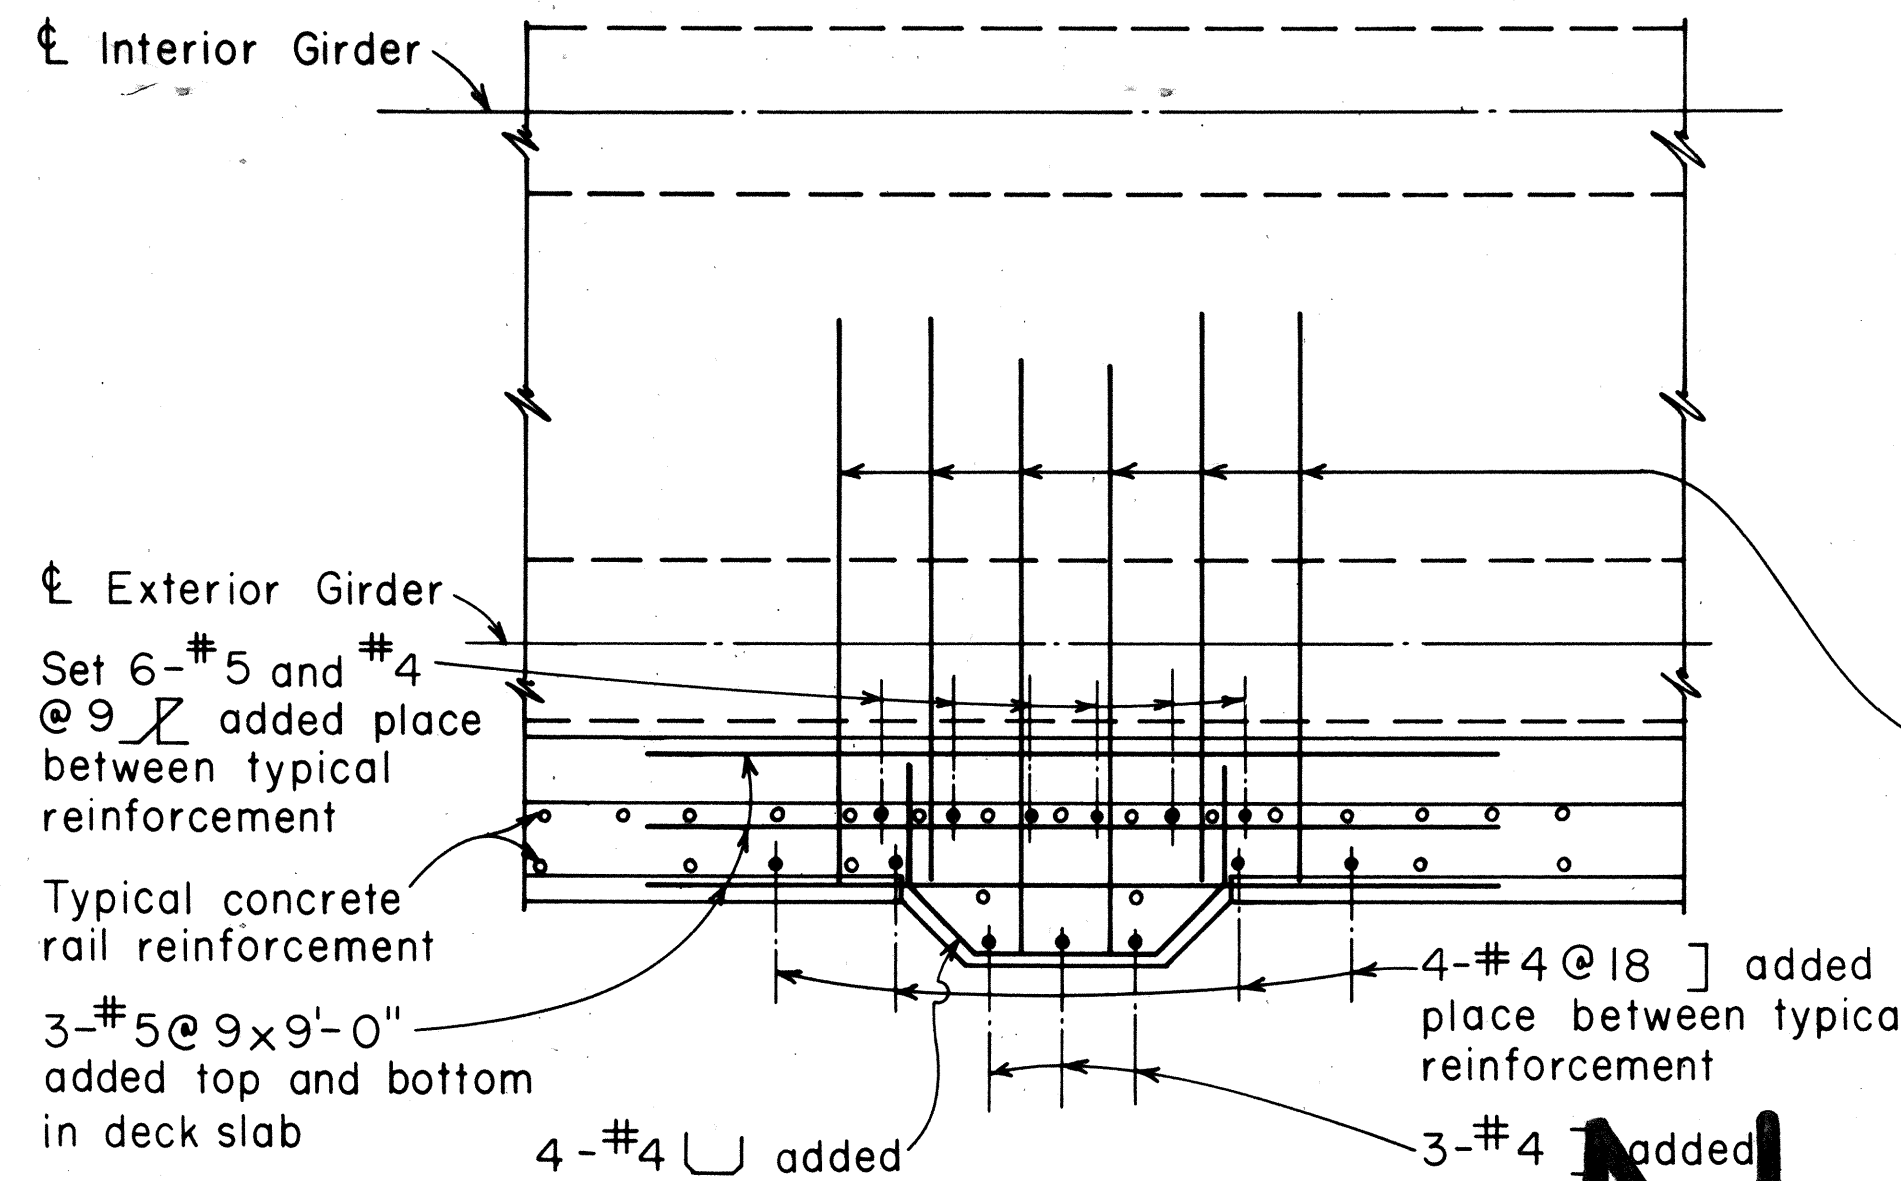

SECTION

Scale:  $\frac{1}{2}'' = 1'-0''$

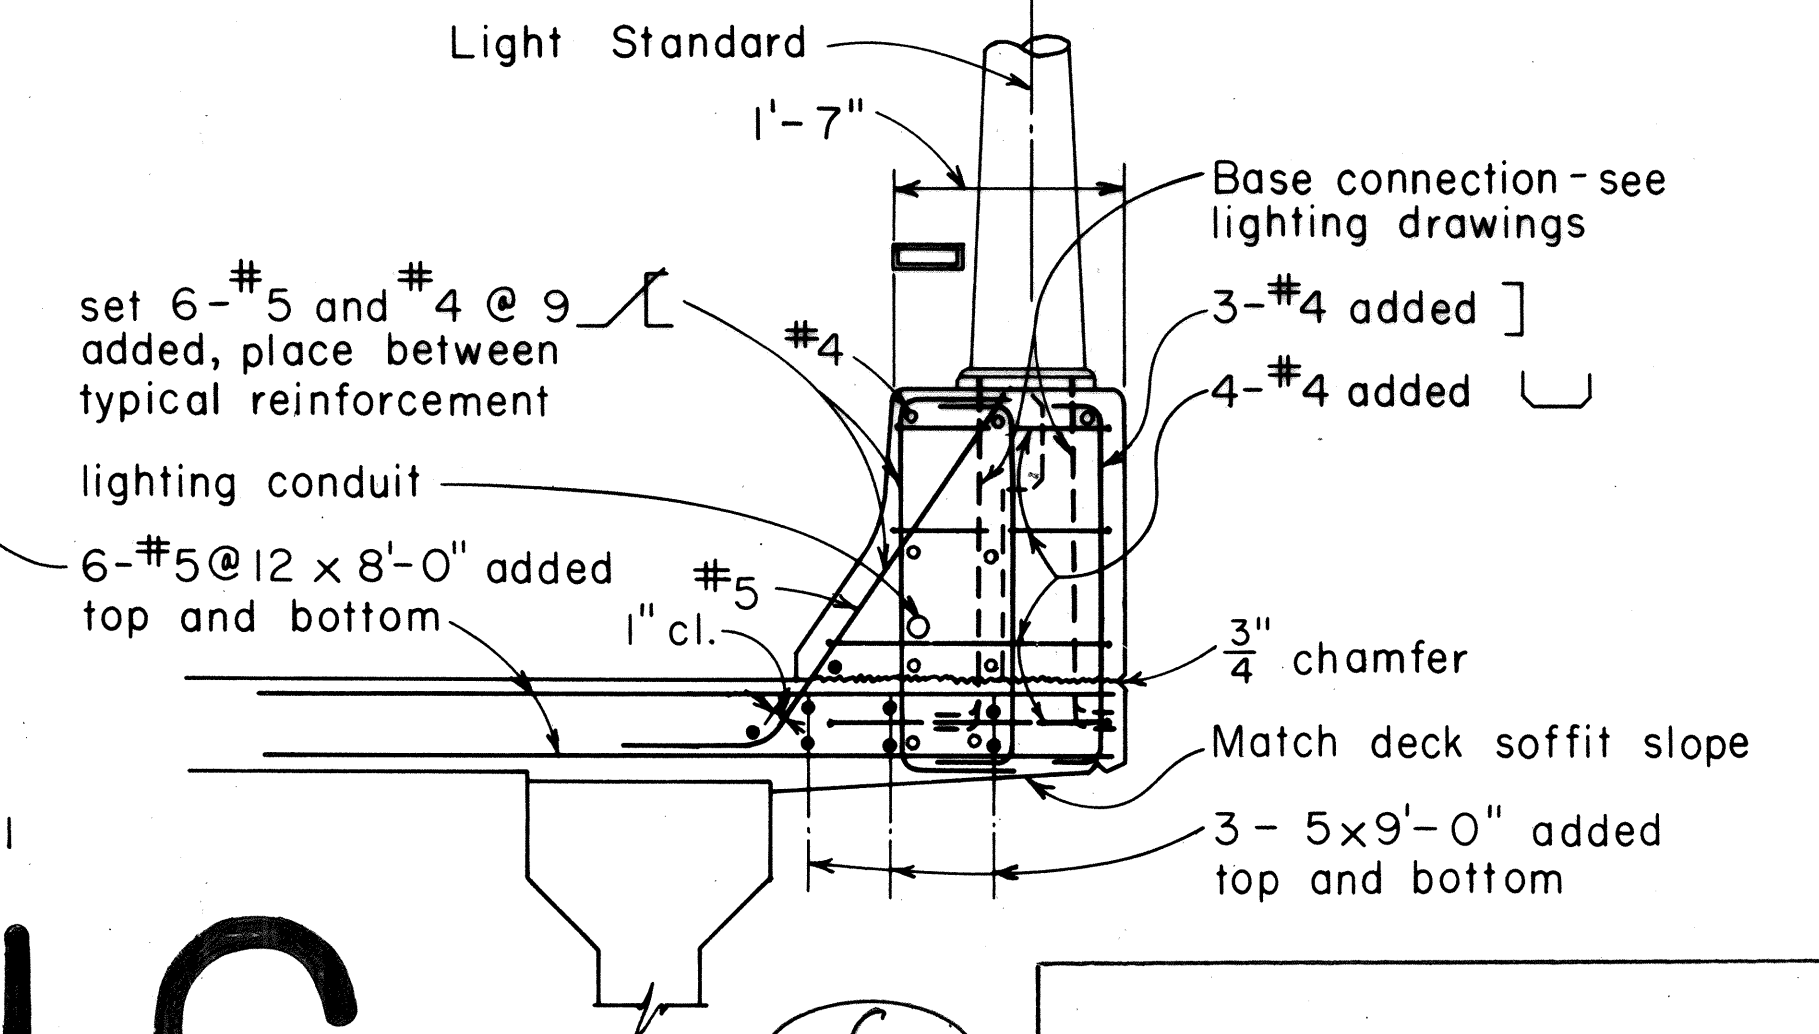

SECTION


Scale:  $\frac{3}{4}'' = 1'-0''$

# DETAILS AT LIGHT STANDARD

Scale: As Noted


## NOTES

1. Tubing shall be shop bent to fit horizontal curve when radius is less than 250 ft.
2. Post shall be normal to grade.
3. All tubes shall be spliced in the panel spanning deck expansion joints. Increase joint width between tube to  $1\frac{1}{2}''$  and increase sleeve length by 1'. (See Tube Splice Detail.)
4. Tubing shall be continuous over not less than 3 posts except as noted on plans.
5. All exposed corner of metal railing shall be ground smooth.
6. Rail assemblage shall be galvanized after fabrication.
7. All anchor bolts, bolts, nuts, plates and washers shall be galvanized.
8. Welding shall meet the requirement of Section 501 of the Standard Specifications.
9. Material shall conform to the following requirements:
  - a. Tubular steel rails ASTM A500 Grade B.
  - b. Steel posts ASTM A36.
  - c. Sleeves for tubular rails ASTM A36.
  - d. Stud bolts ASTM A108 Grades 1015 to 1020.
  - e. Anchor bolts, bolts, nuts and washers ASTM A325.
  - f. Shims commercial quality galvanized steel.
  - g. Sleeve bolts and nuts ASTM A108 Grades 1015 to 1020.
  - h. Plates ASTM A36.

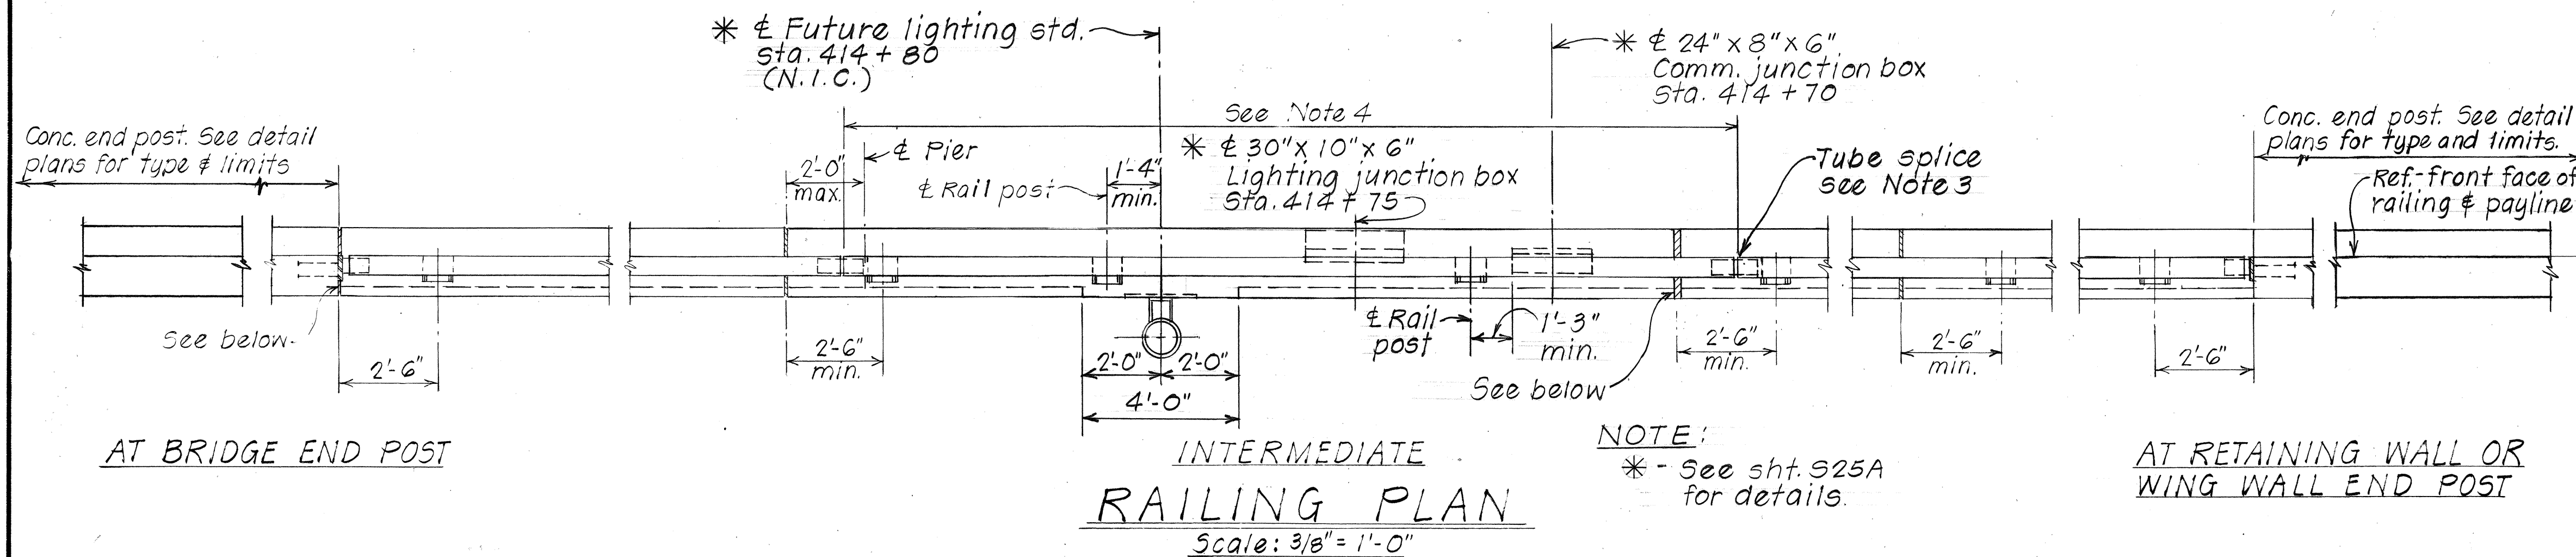

INTERMEDIATE  
RAILING PLAN

Scale:  $\frac{3}{8}'' = 1'-0''$

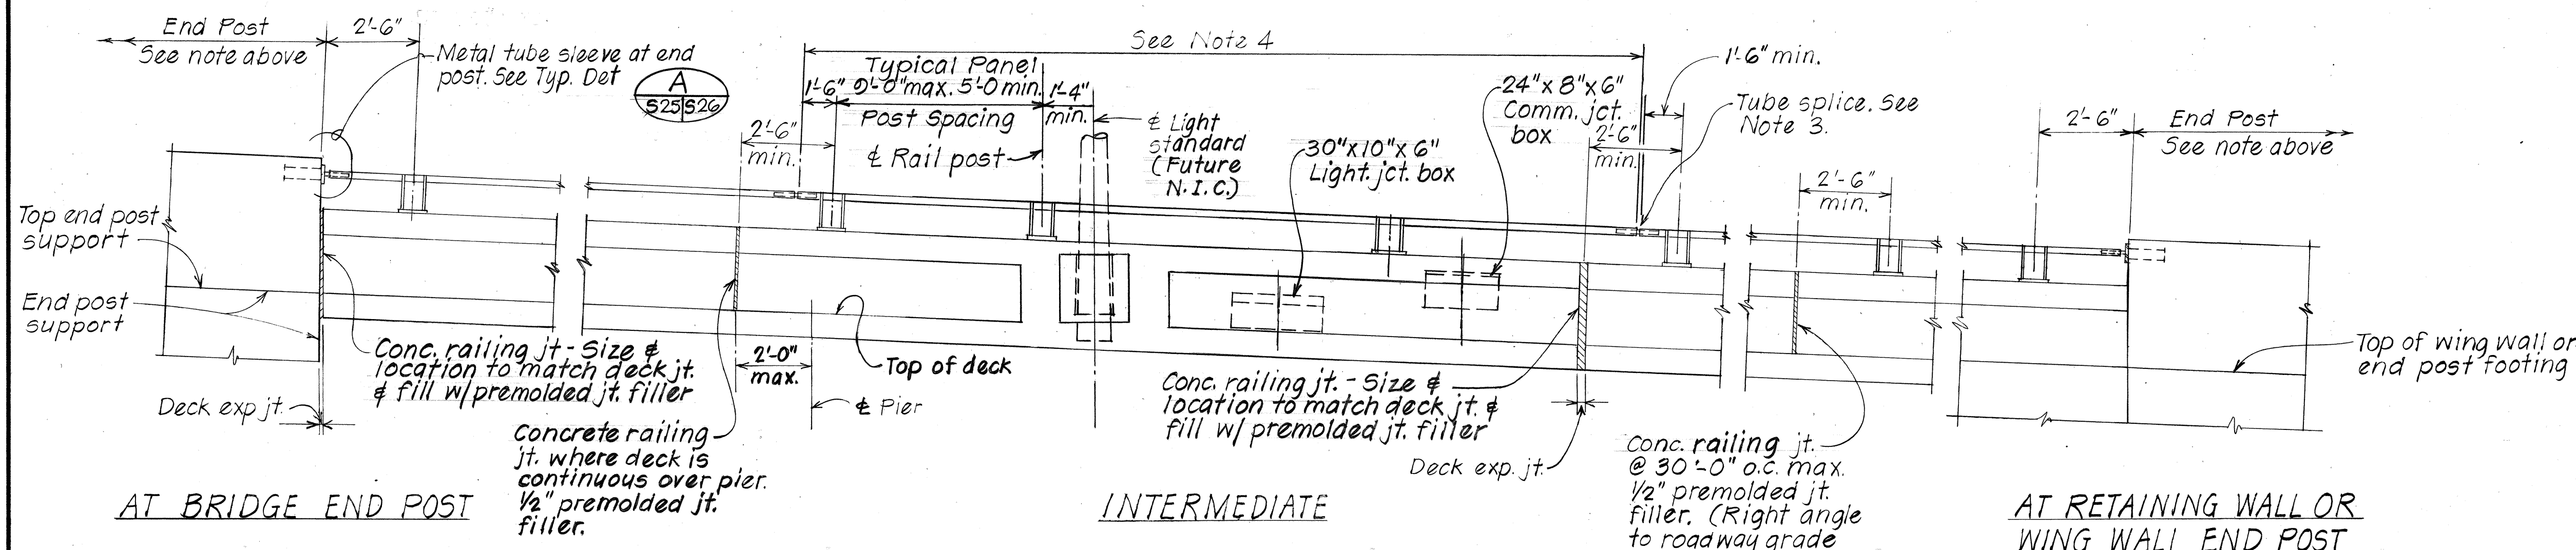

EXTERIOR RAILING ELEVATION


Scale:  $\frac{3}{8}'' = 1'-0''$

|                                                                                                                                                      |                                                 |
|------------------------------------------------------------------------------------------------------------------------------------------------------|-------------------------------------------------|
| 3/29/90                                                                                                                                              | Addition of lighting standard & junction boxes. |
| DATE                                                                                                                                                 | REVISION                                        |
| STATE OF HAWAII<br>DEPARTMENT OF TRANSPORTATION<br>HIGHWAYS DIVISION<br>ROUTE H-3 - KUOUI STREAM BRIDGE                                              |                                                 |
| TYPICAL DETAILS<br>STEEL BRIDGE RAIL ON PARAPET<br>F.A.I. Proj. No. I-H3-1(50)<br>KANELOHE I.C. TO HALEKOU I.C.<br>Scale: As Noted Date: August 1987 |                                                 |
| SHEET No. 525 OF 35 SHEETS                                                                                                                           |                                                 |

C.O. 106




| FED. ROAD DIST. NO. | STATE | FED. AID PROJ. NO. | FISCAL YEAR | SHEET NO.  | TOTAL SHEETS |
|---------------------|-------|--------------------|-------------|------------|--------------|
| HAWAII              | HAW.  | H-3-1150           | 1990        | C.O.106S-1 | 164          |

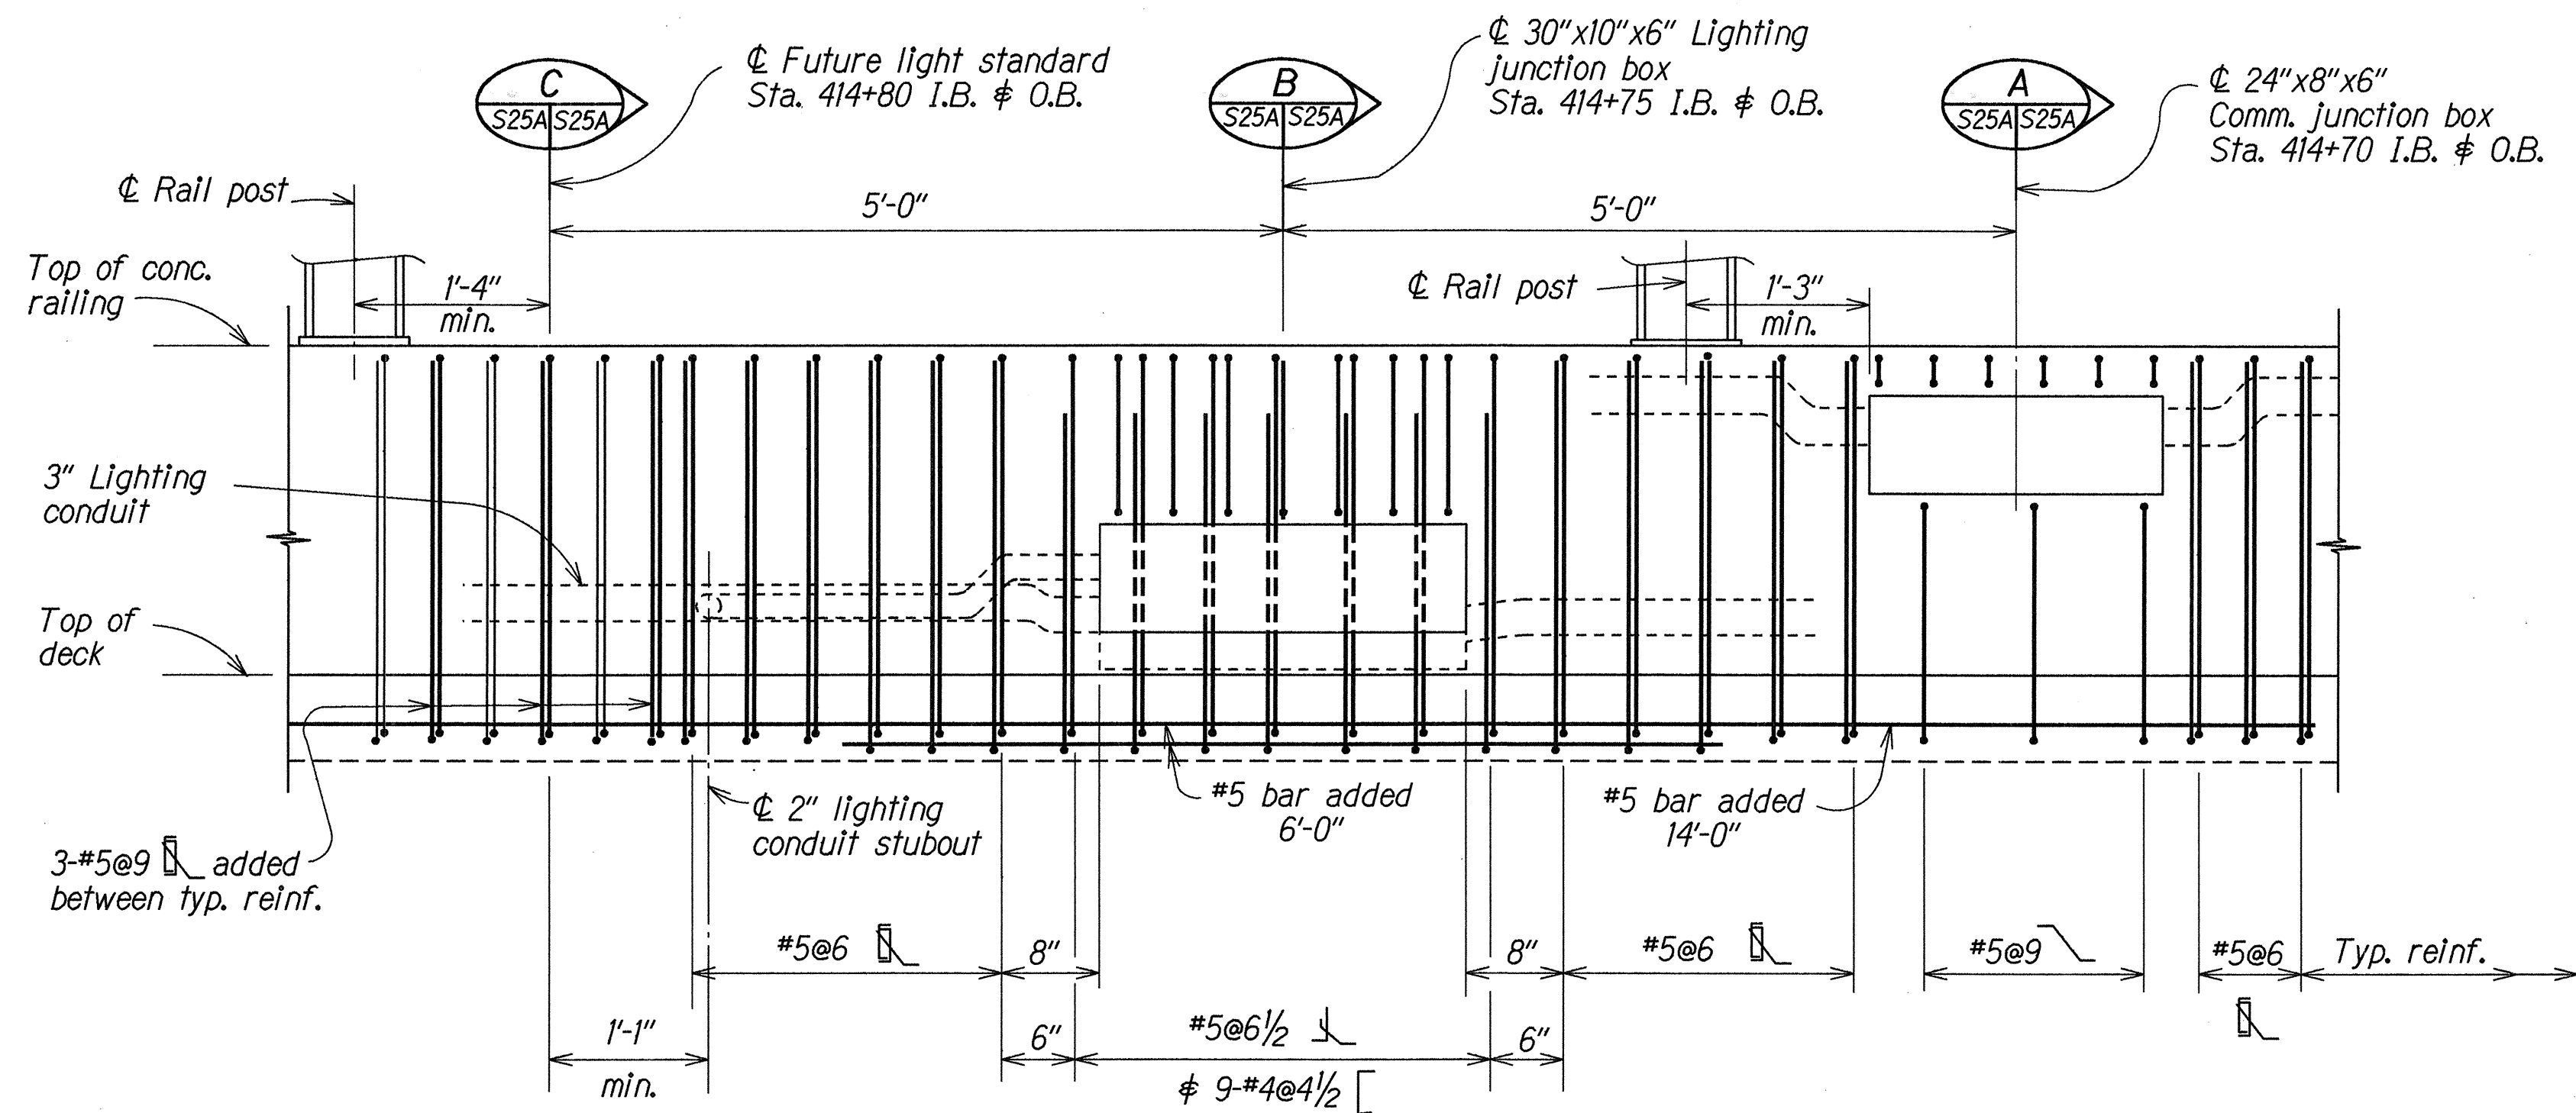


**ELEVATION**  
 Scale: 1"=1'-0"

NOTE: See sections for reinf not shown here.

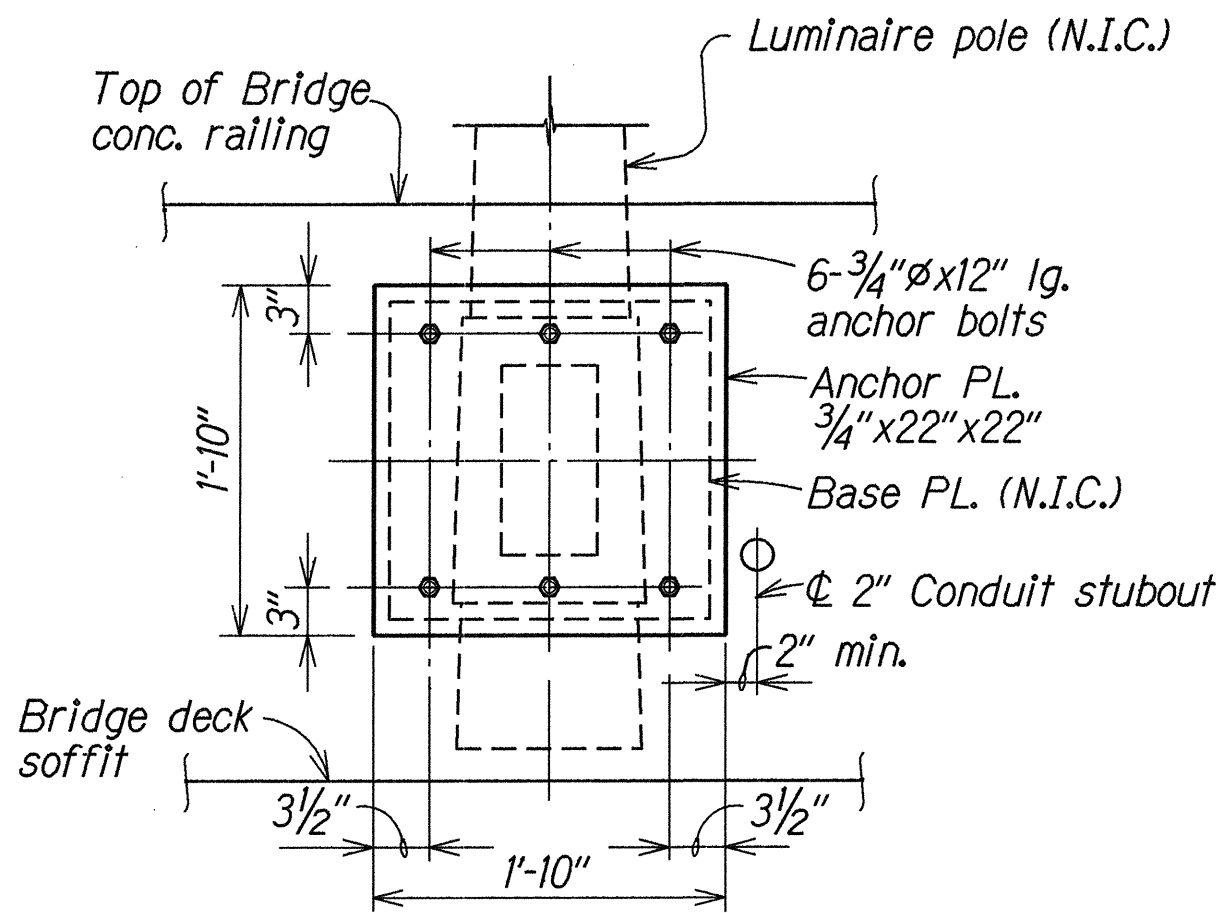


FRONT VIEW

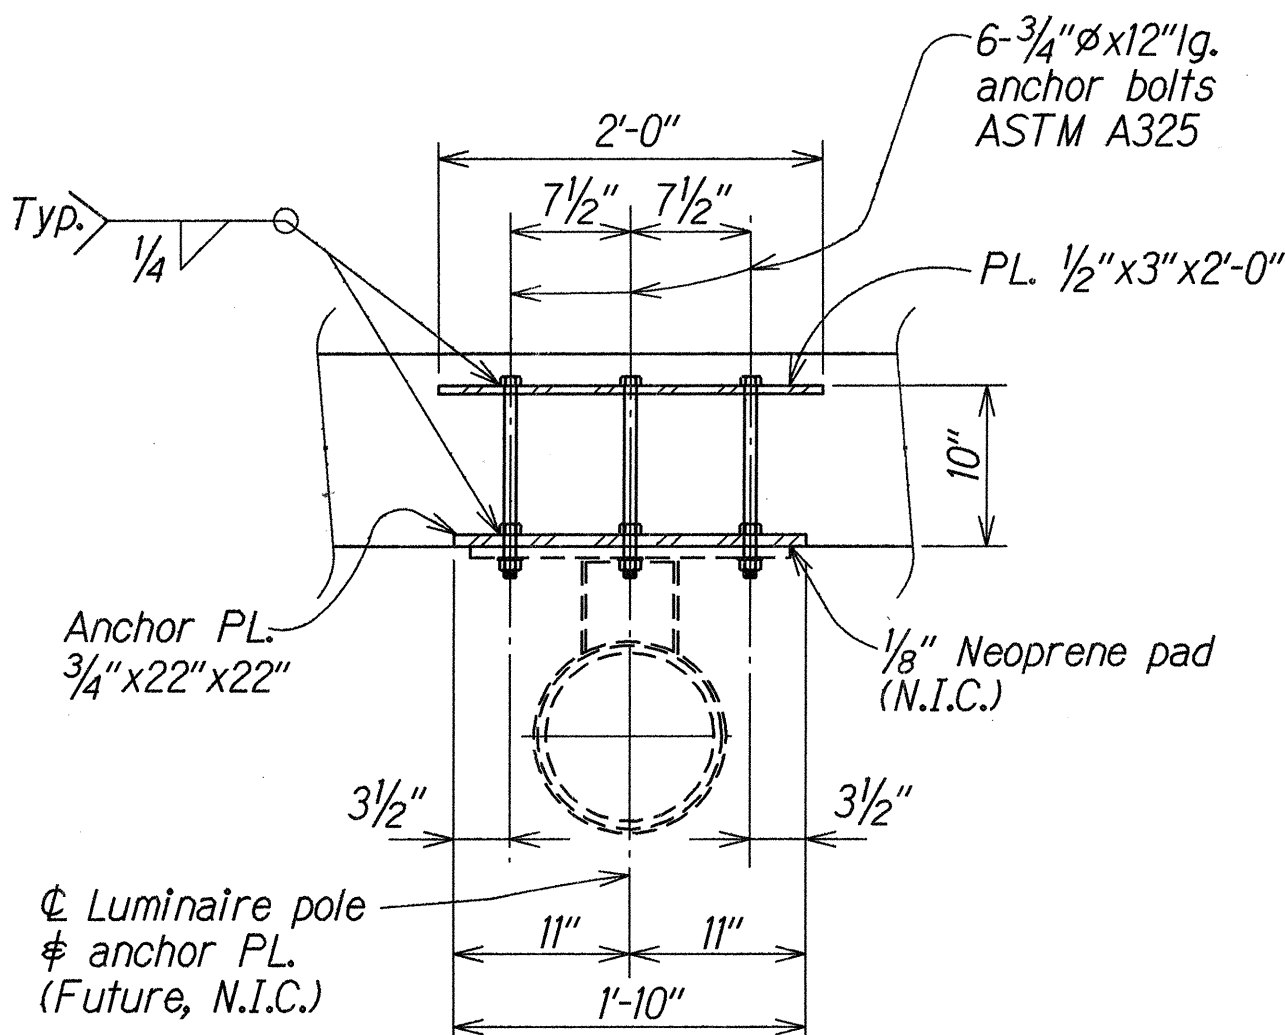

SECTION  
 D S25A S25A

SUPPORT POLE CONNECTION DETAILS


Scale: 1"=1'-0"

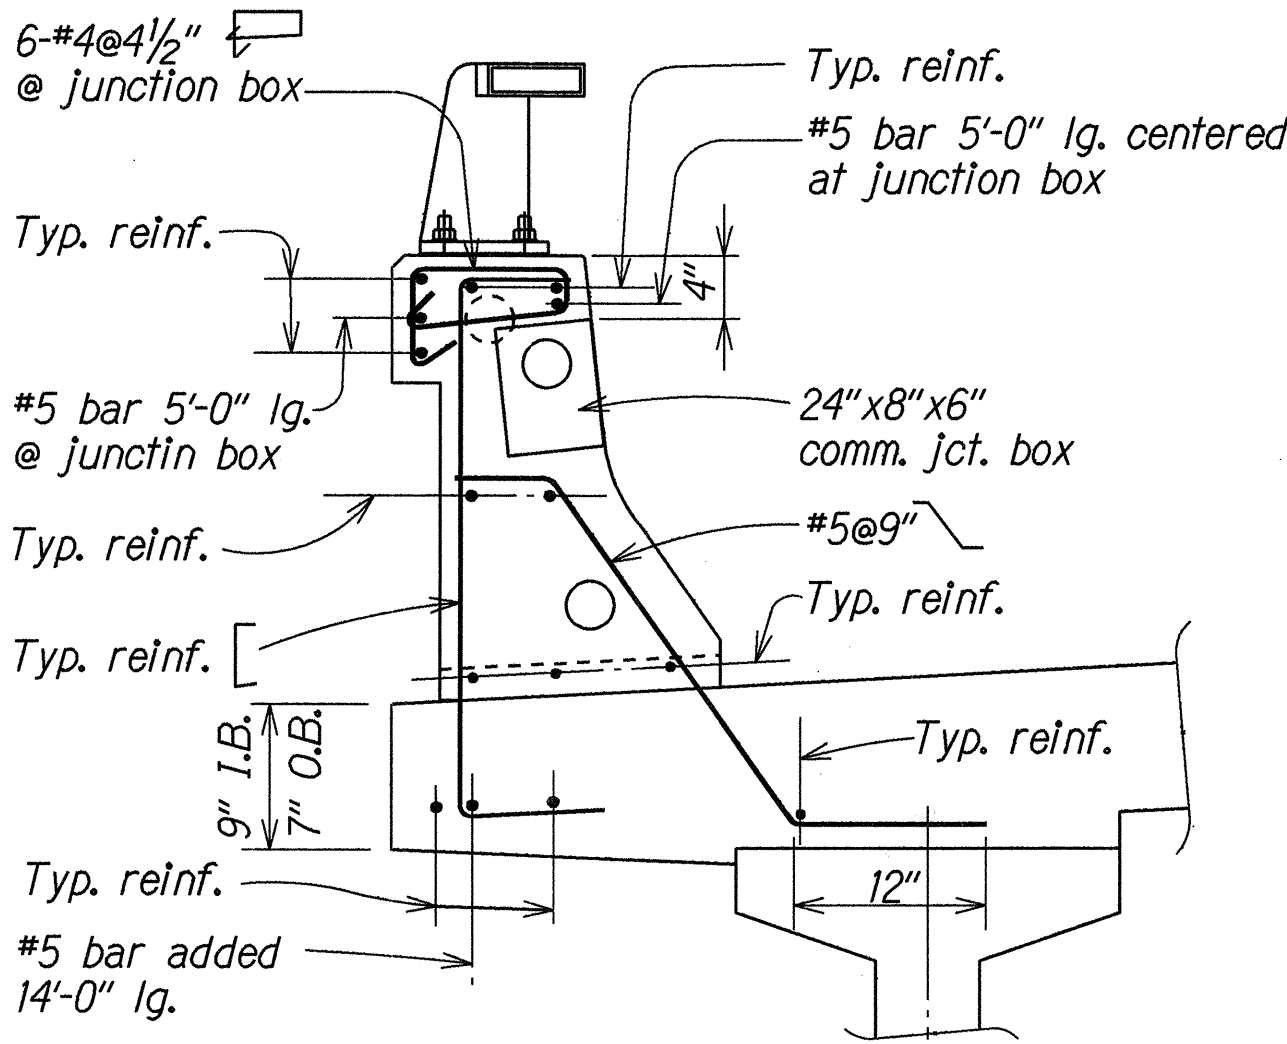

SECTION @ COMMUNICATIONS  
 JUNCTION BOX

Scale: 1"=1'-0"


A S25A S25A

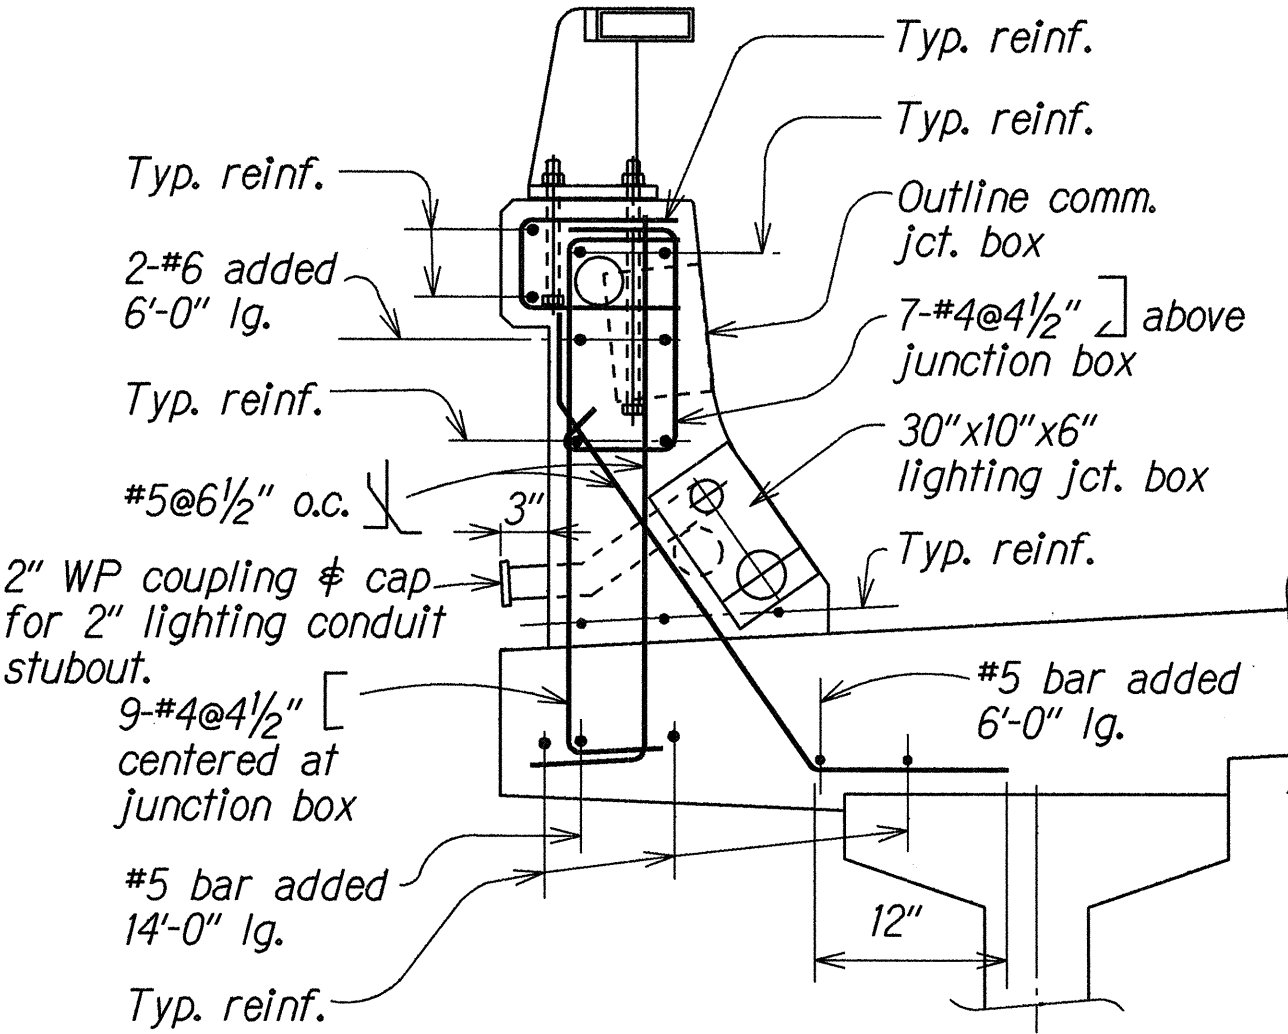

SECTION @ LIGHTING  
 JUNCTION BOX

Scale: 1"=1'-0"

B S25A S25A

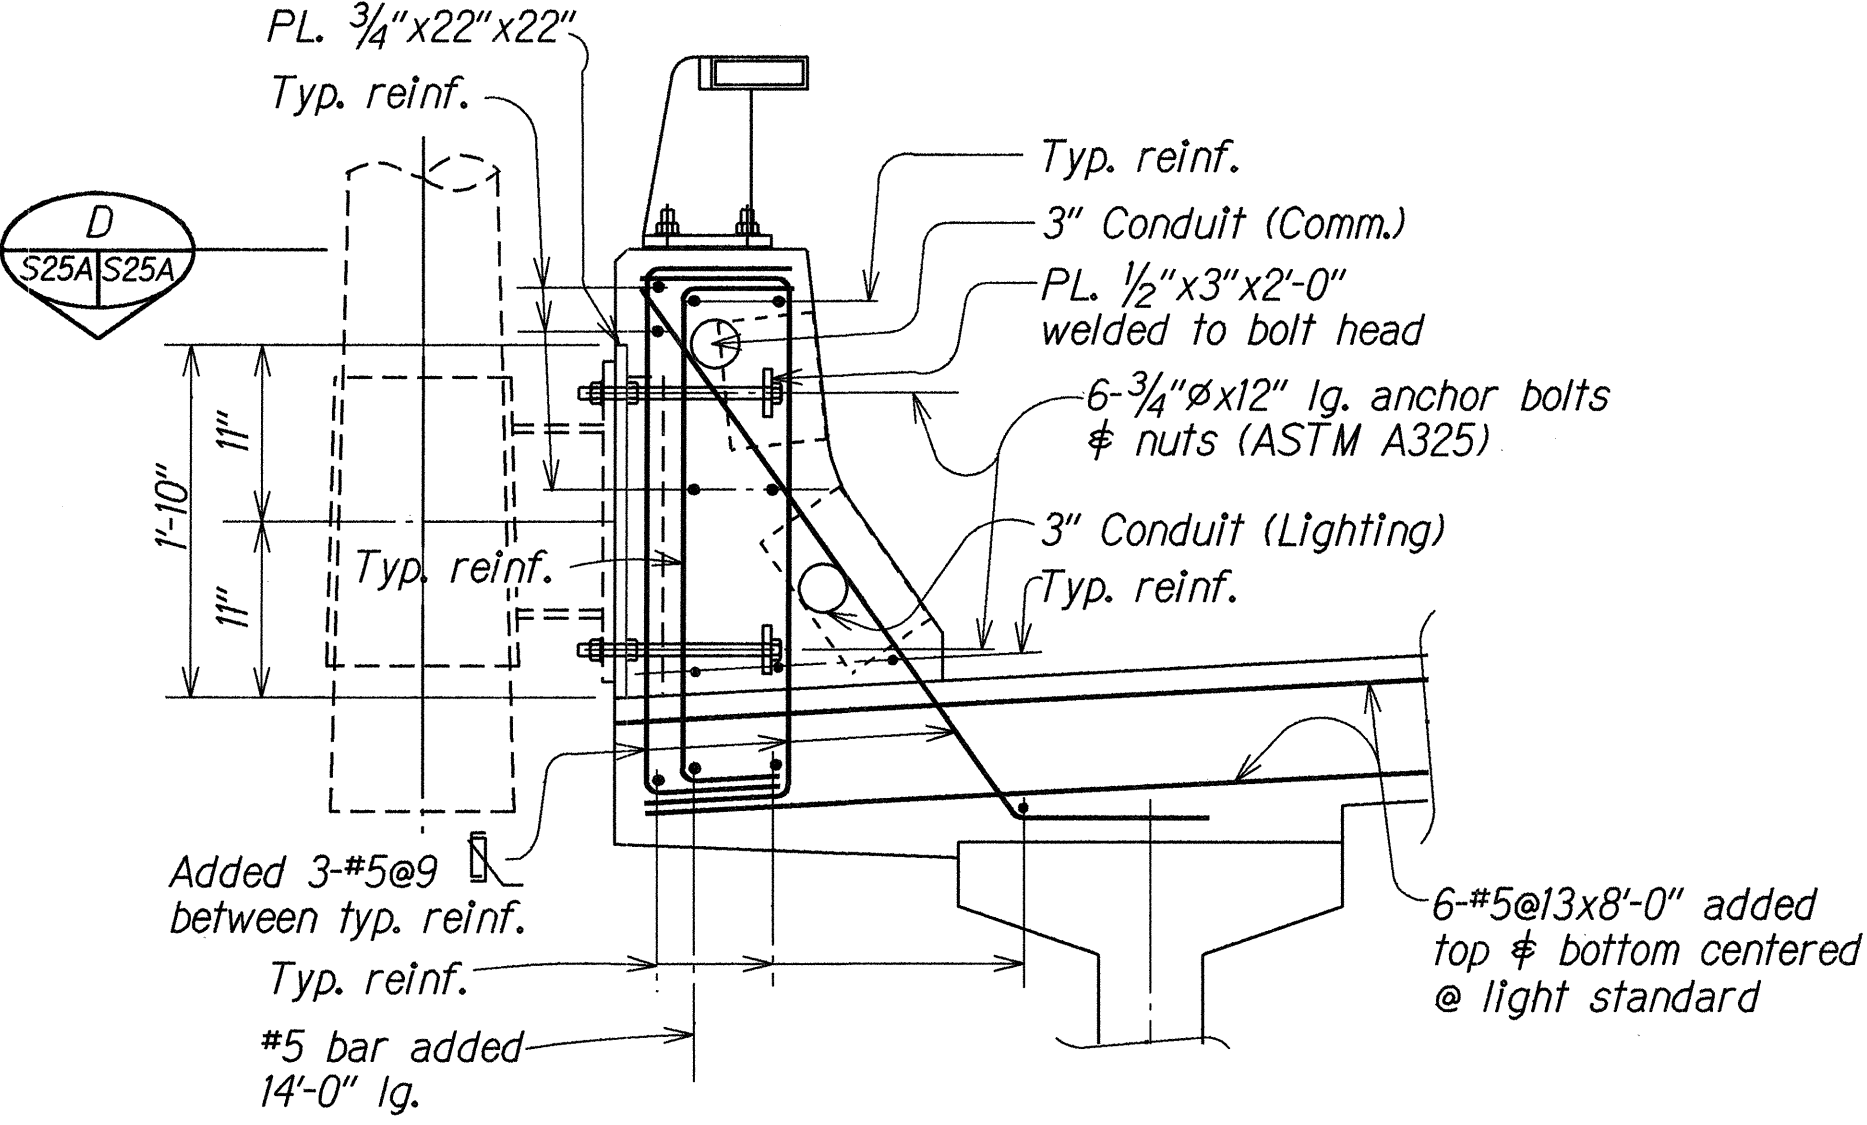

SECTION @ FUTURE  
 LIGHT STANDARD

Scale: 1"=1'-0"

C S25A S25A

6/29/90 Addition of lighting standard and junction boxes

DATE REVISION

STATE OF HAWAII  
DEPARTMENT OF TRANSPORTATION  
HIGHWAYS DIVISION

ROUTE H-3 - KUOU STREAM BRIDGE

LIGHT STANDARD & JUNCTION BOX DETAILS

F.A.P.Proj.No.H-3-1150  
KANEIHE I.C.TO HALEKOU I.C.

Scale: As Noted

June 1990


SHEET No. S25A OF 35 SHEETS


C.O. 106S-1


|               |           |             |            |
|---------------|-----------|-------------|------------|
| ORIGINAL PLAN | DATE      | DESIGNED BY | CHECKED BY |
| NOTE BOOK     | June 1990 | SA          | SA/KC      |
| QUANTITIES BY |           |             |            |
| CHECKED BY    |           |             |            |




| FED. ROAD DIST. NO. | STATE | FED. AID PROJ. NO. | FISCAL YEAR | SHEET NO. | TOTAL SHEETS |
|---------------------|-------|--------------------|-------------|-----------|--------------|
| HAWAII              | HAW.  | I-H3-1(50)         | 1987        | 107       | 164          |

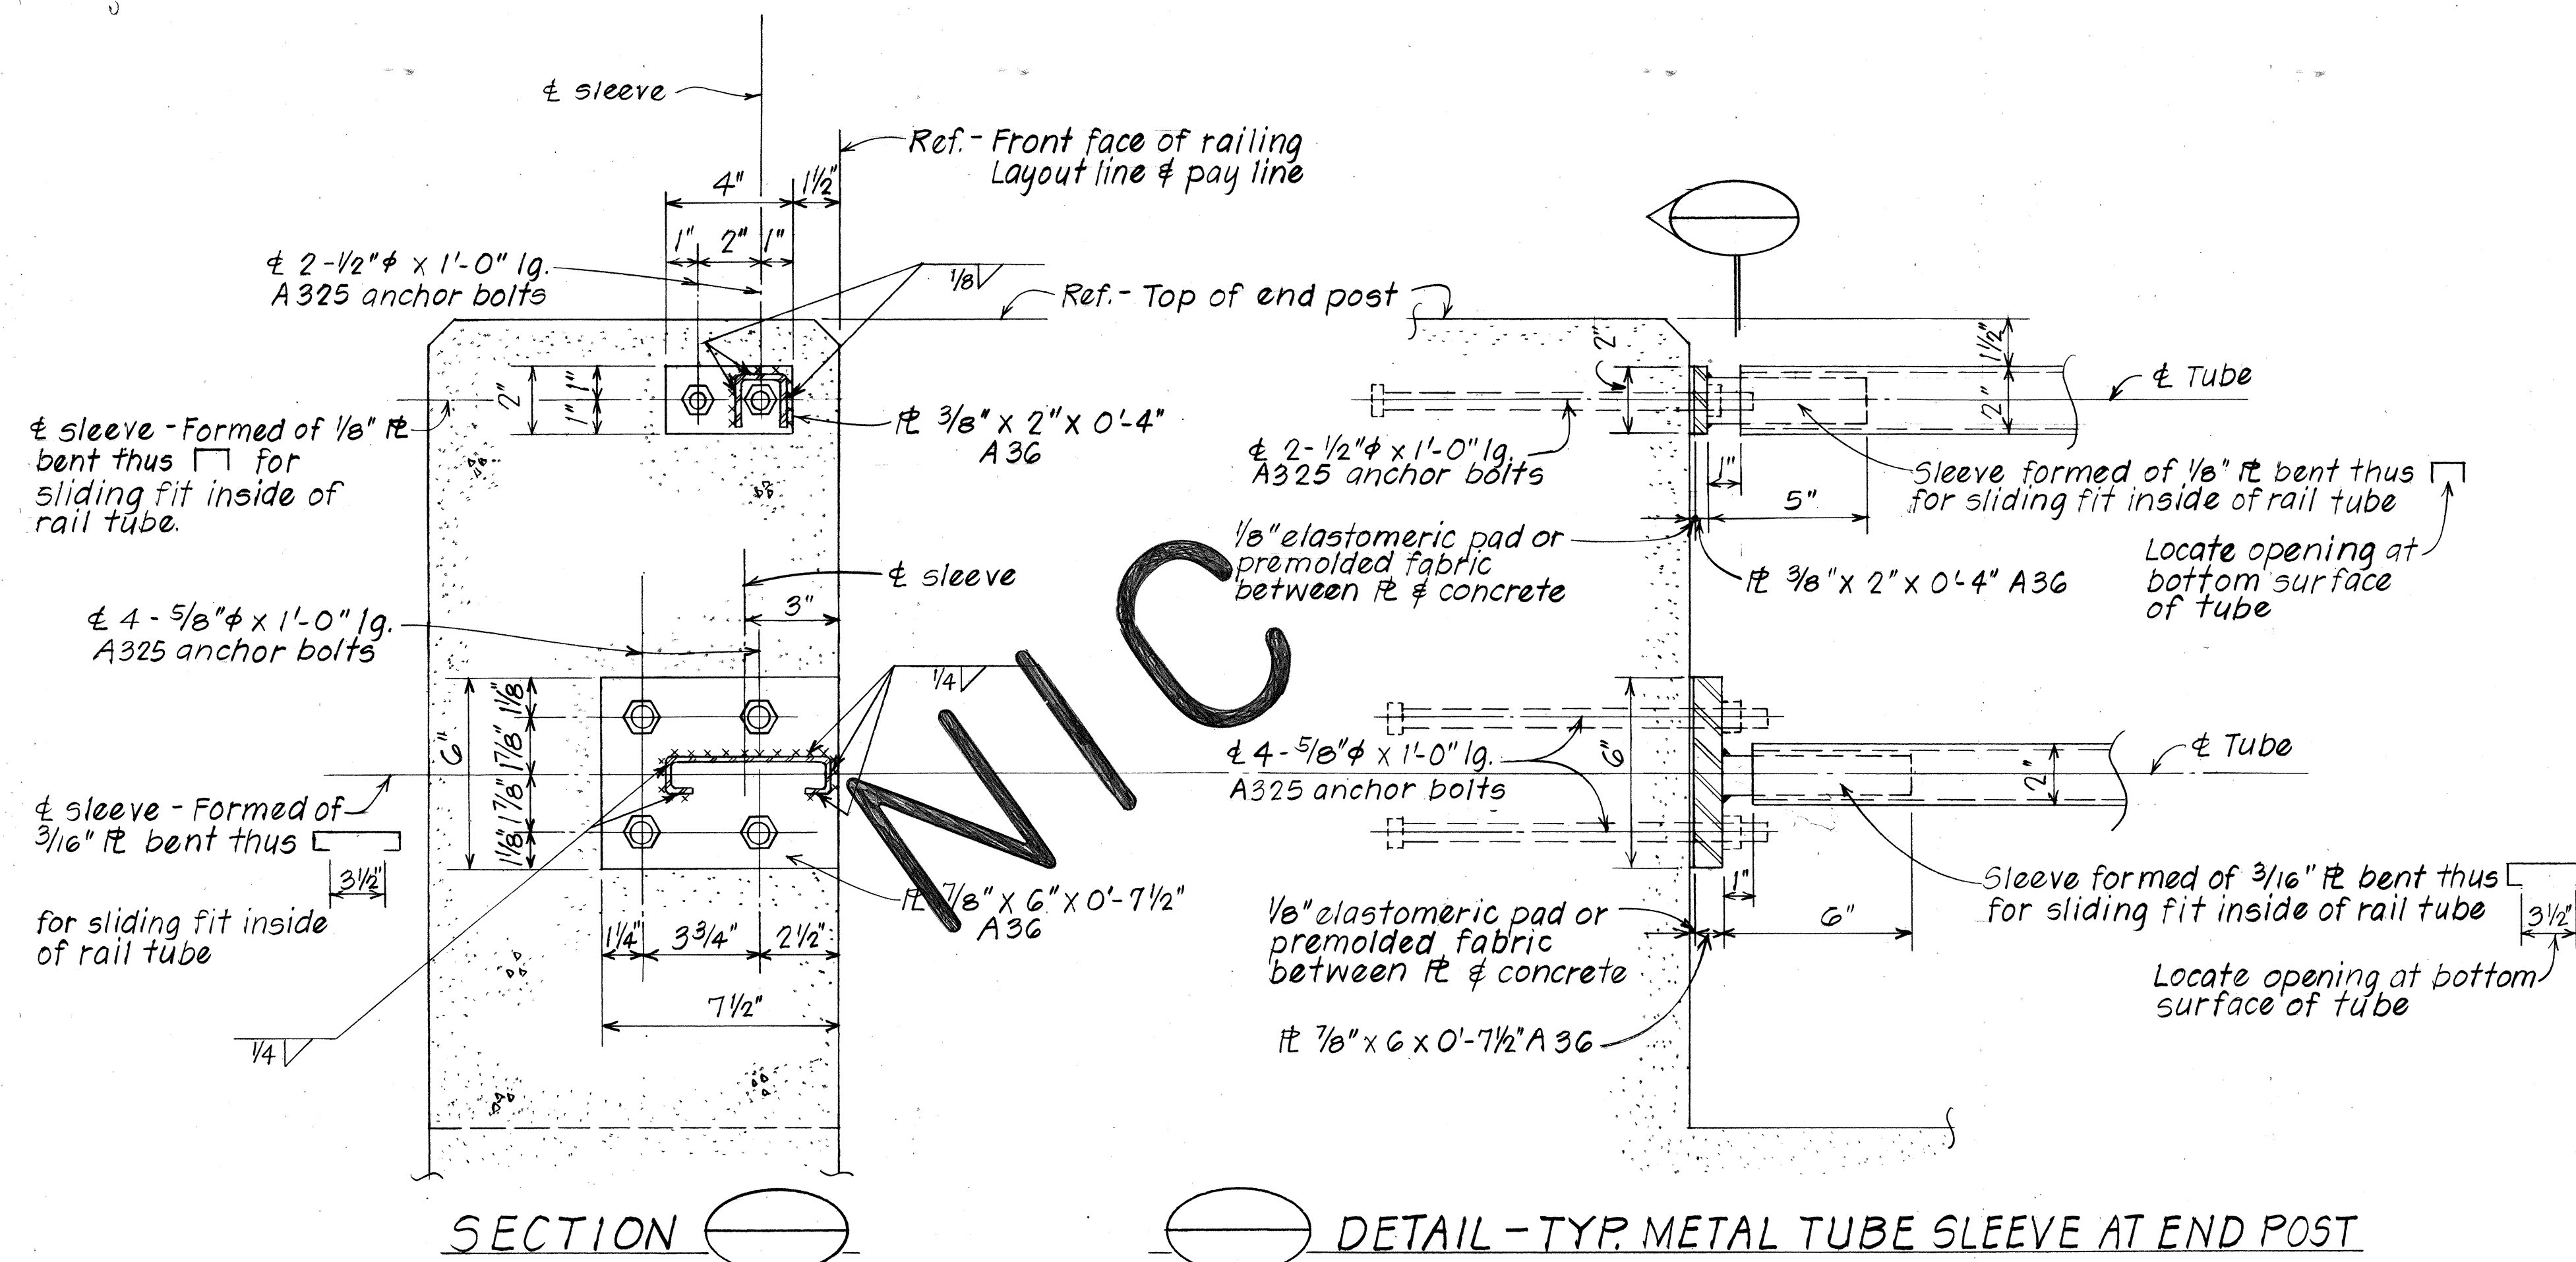

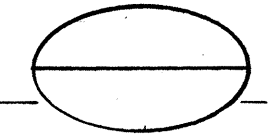SECTION  DETAIL - TYP. METAL TUBE SLEEVE AT END POST  
**END POST CONNECTION FOR STEEL BRIDGE RAILING**  
**(TUBULAR) TWO RAIL COMBINATION TYPE**  
 Scale: 3" = 1'-0"

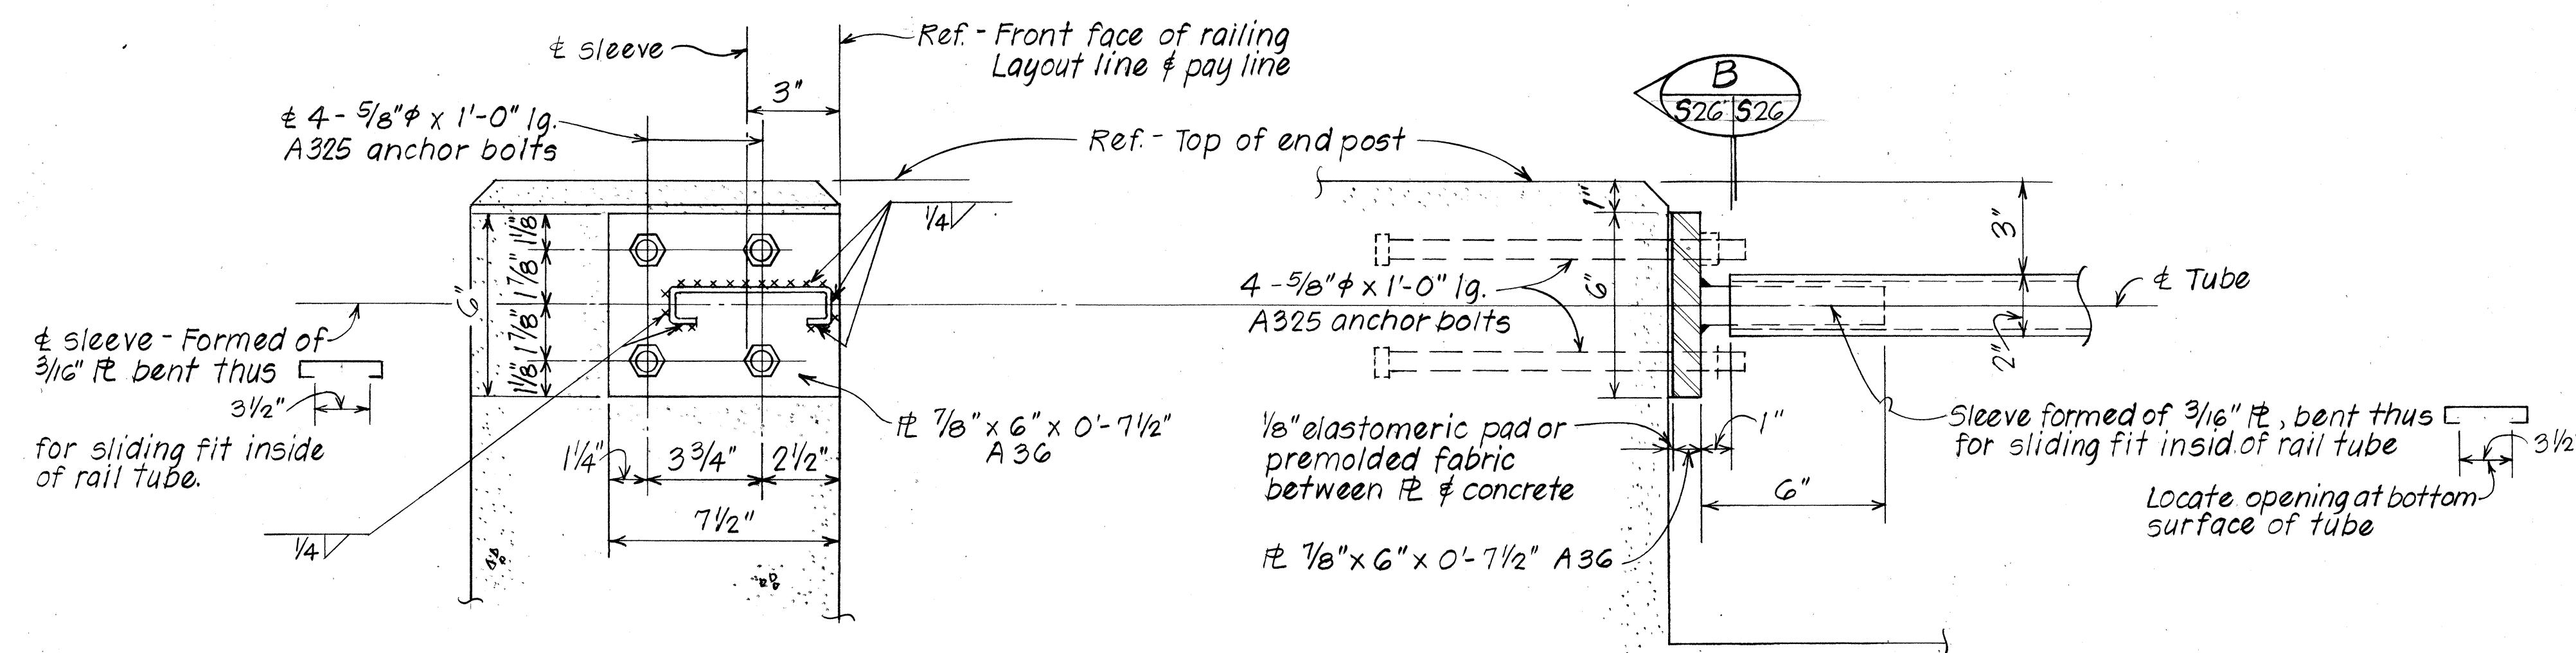

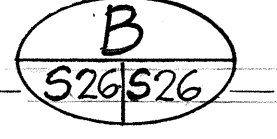SECTION  DETAIL - TYP. METAL TUBE SLEEVE AT END POST  
**END POST CONNECTION FOR STEEL BRIDGE RAILING**  
**(TUBULAR) ONE RAIL COMBINATION TYPE**  
 Scale: 3" = 1'-0"


STATE OF HAWAII  
 DEPARTMENT OF TRANSPORTATION  
 LAND TRANSPORTATION FACILITIES DIVISION  
**ROUTE H-3 - KUOUI STREAM BRIDGE**  
 TYPICAL DETAILS  
 STEEL BRIDGE RAIL ON PARAPET  
 F.A.I. Proj. No. I-H3-1(50)  
 KANELOHE I.C. TO HALELOU I.C.  
 Scale: As Noted Date: August 1987  
 SHEET NO. 526 OF 35 SHEETS




± 1-3/4" hole for 5/8" x 1'-0" lg. H.S. anchor bolt w/ cap fl. washer & nut / Rail. See "Terminal Connector" Det. for exact loc.

± 4-1" holes for 7/8" x 1'-0" lg. H.S. anchor bolt w/ cap fl. washer & nut / Rail. See "Terminal Connector" Det. for exact loc., no.s. & size.


| FED. ROAD DIST. NO. | STATE | FED. AID PROJ. NO. | FISCAL YEAR | SHEET NO. | TOTAL SHEETS |
|---------------------|-------|--------------------|-------------|-----------|--------------|
| HAWAII              | HAW.  | I-H3-1(50)         | 1968        | 108       | 164          |

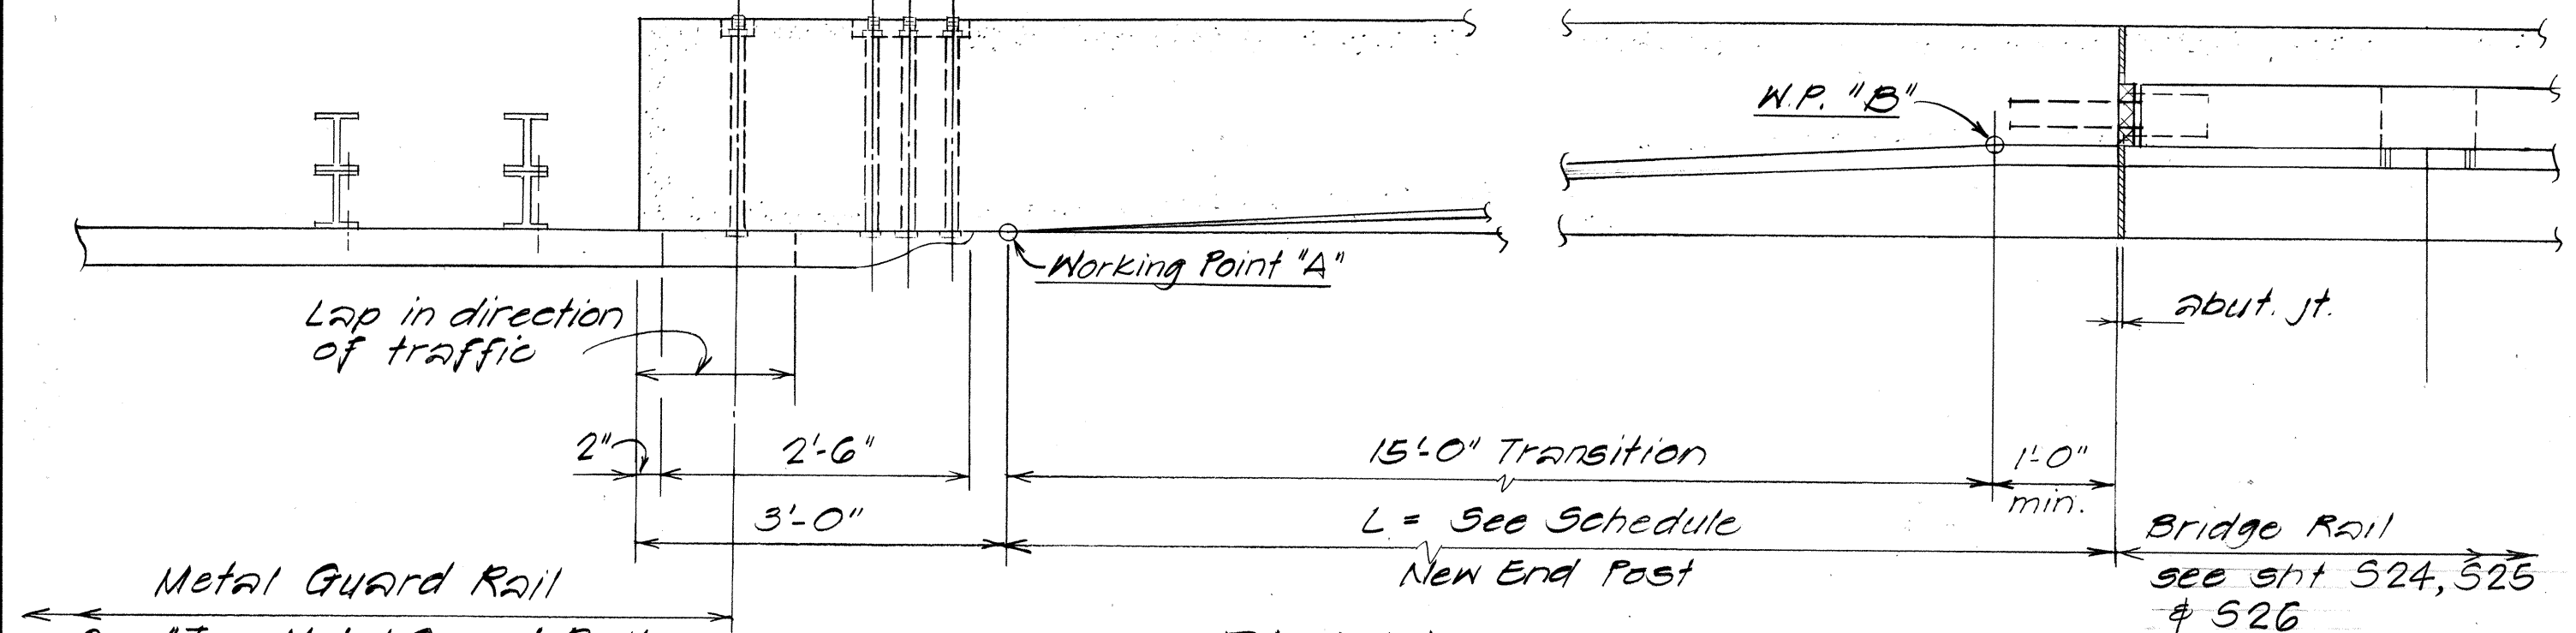

PLAN

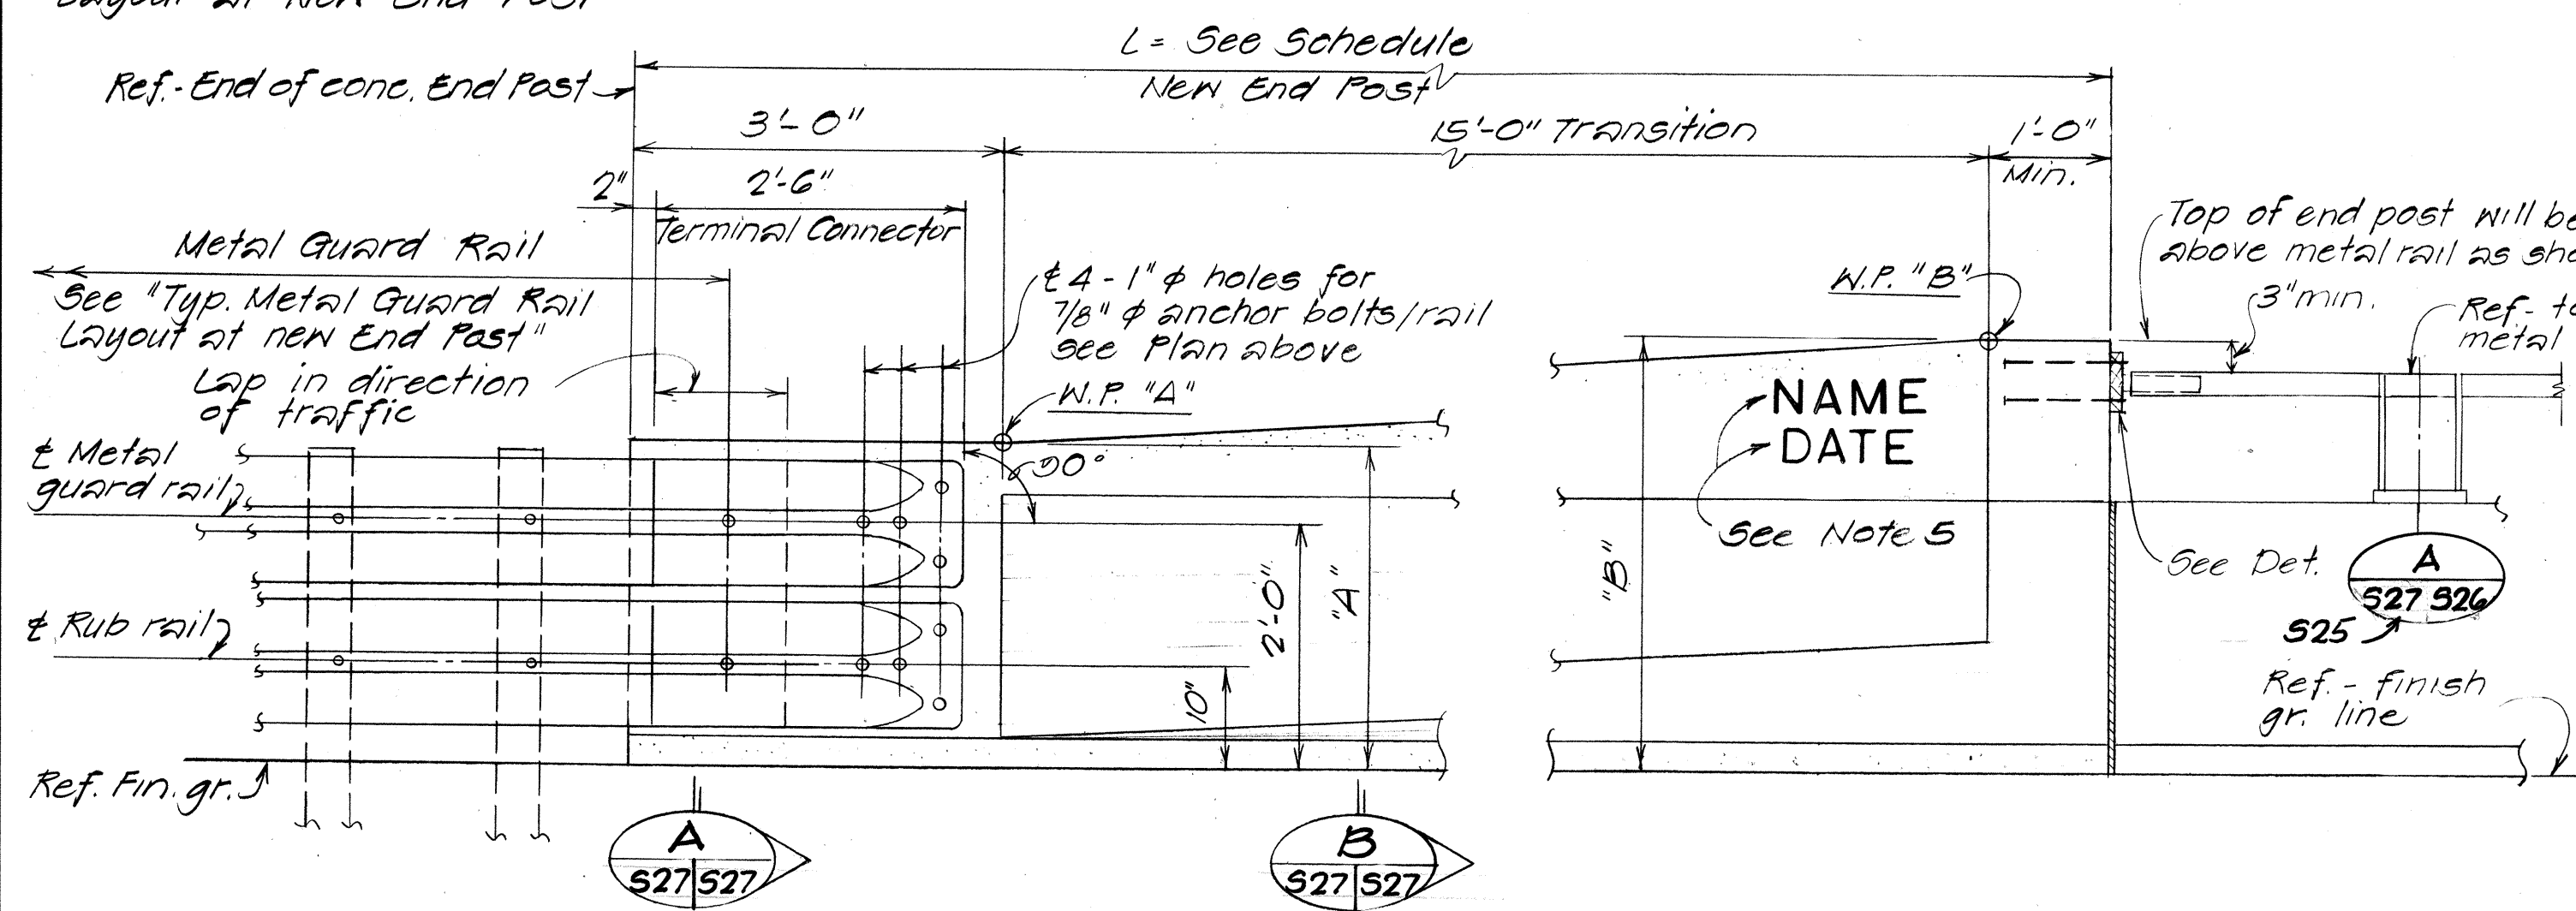

ELEVATION

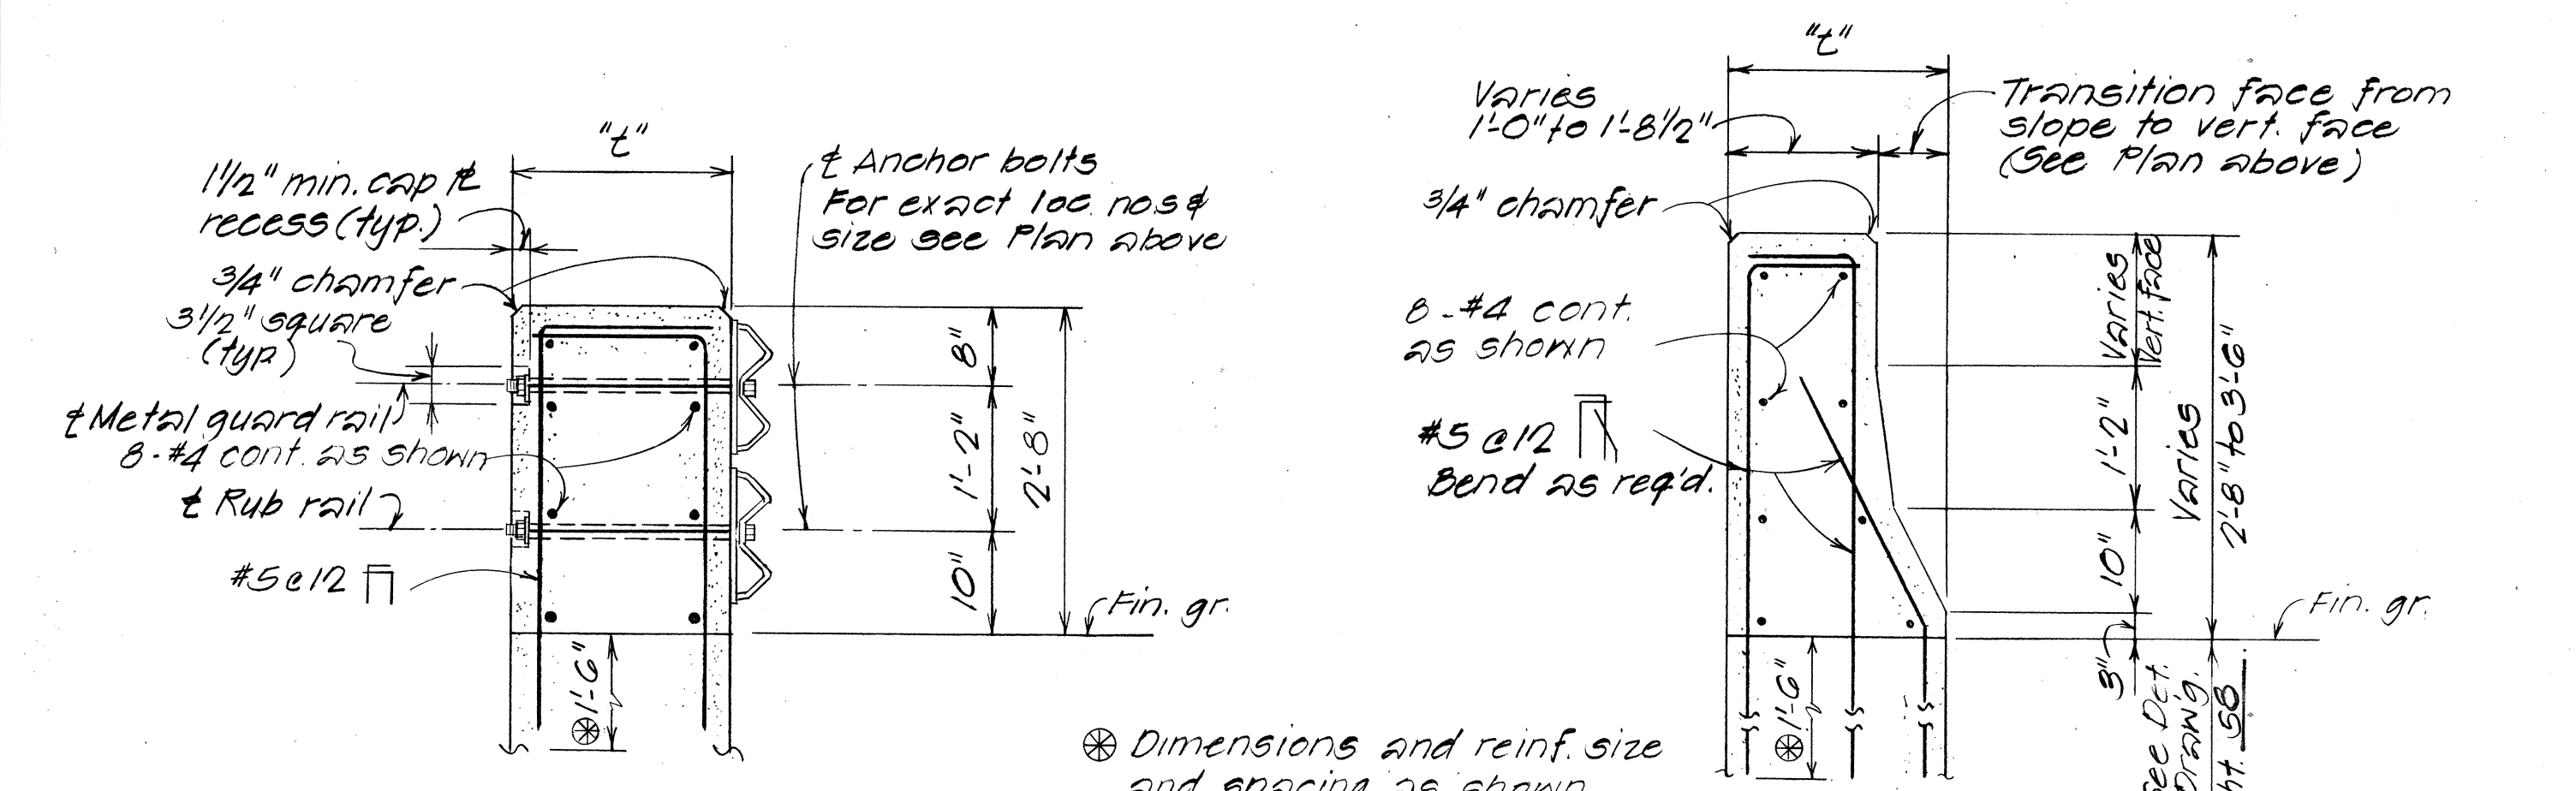


SECTION A 527/527


SECTION B 527/527

| END POST DIMENSION SCHEDULE |        |           |       |       |
|-----------------------------|--------|-----------|-------|-------|
| STRUCTURE                   | *L*    | *t*       | *A*   | *B*   |
| Kuou Stream Bridge          | 10'-0" | 1'-8 1/2" | 2'-8" | 3'-6" |

TYPICAL END POST CONNECTION DETAIL Scale: 3/4" = 1'-0"

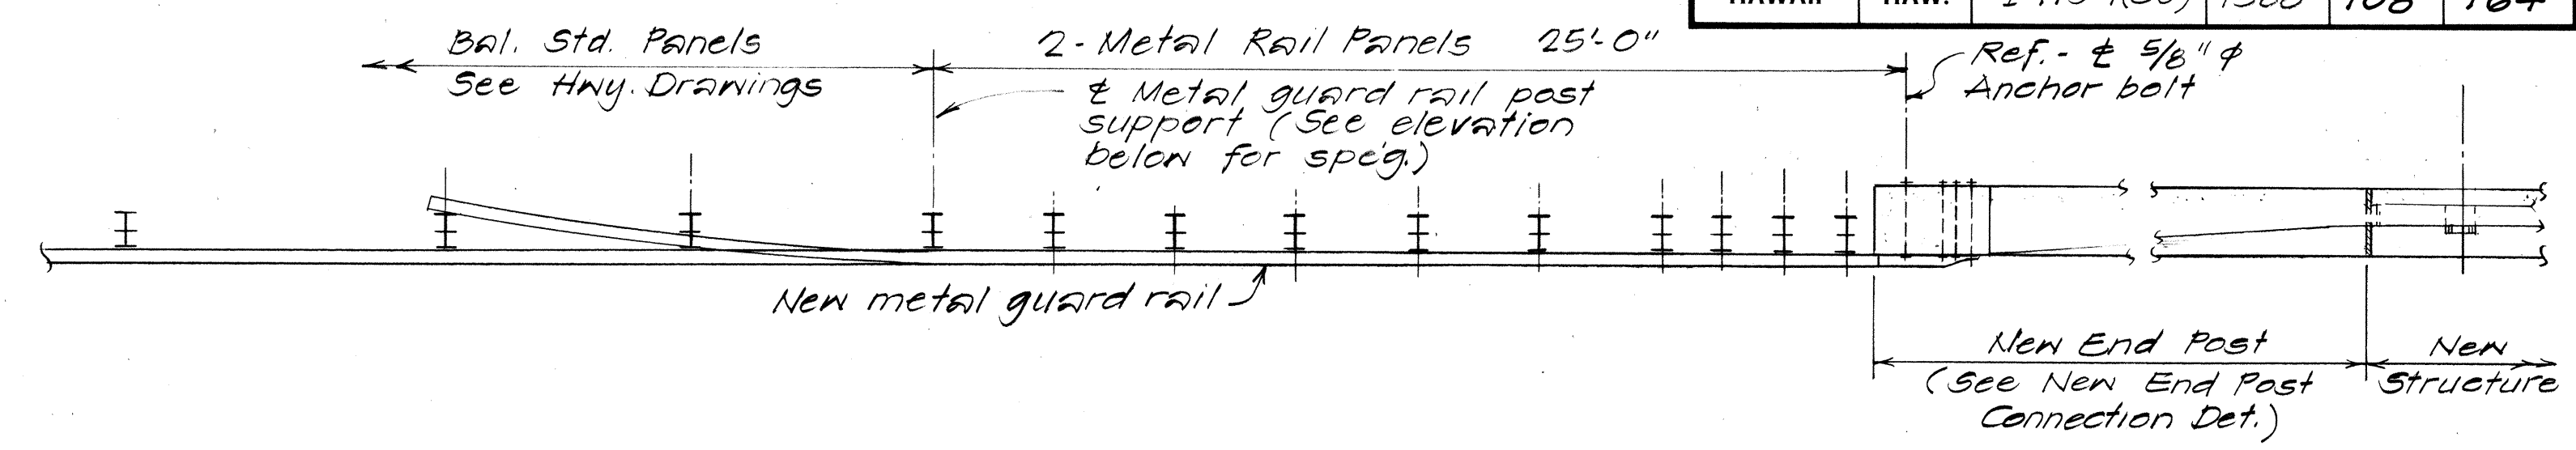

PLAN

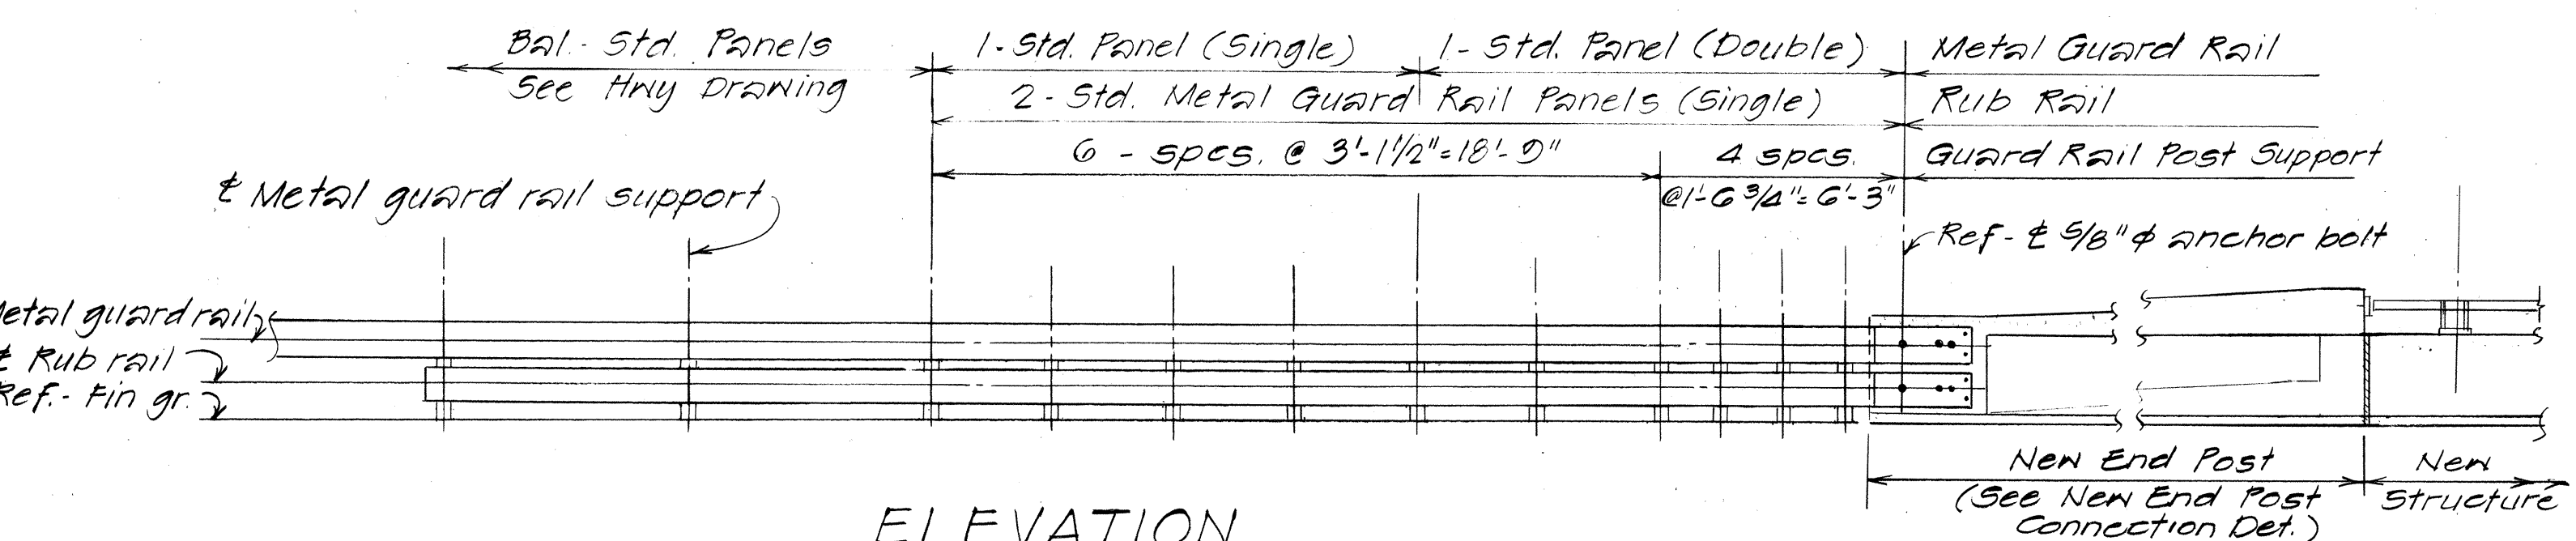

ELEVATION

TYPICAL METAL GUARD RAIL LAYOUT AT NEW END POST

Scale: 1/4" = 1'-0"


NOTES:

1. All anchor bolts shall be high strength bolts conforming to the requirements of ASTM A325 & Galv.
2. "Terminal Connector" including anchor bolts, nuts and washers, shall be galvanized.
3. "Terminal Connector" shall be fabricated from 10 gage steel conforming to the requirements of AASHTO M180.
4. First 25'-0" of guard rail and rub rail adjoining "Terminal Connector" shall be galvanized steel.
5. Place name & date of structure as shown. For location, see "Layout Plan" on contract drawing. Date will be year structure is completed. For letter size and detail see Standard Plans B-01.


± 3/4" x 2 1/2" bolt slot for 5/8" x 1'-0" lg. anchor bolts.

± 29/32" x 1 1/8" slots. See "Standard Plans" TB-51 for bolt dimensions.

1" or 3/4" hole (D + 1/8") centered in 1/2" thick steel & galvanized after fabrication.

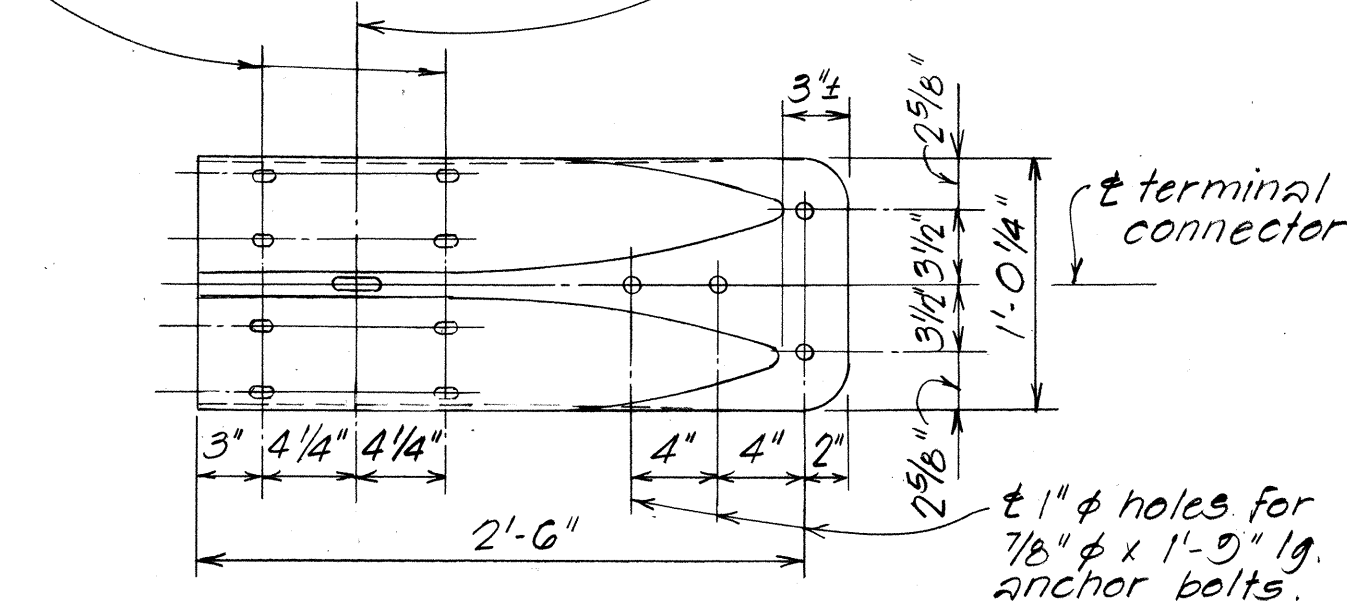

TERMINAL CONNECTOR DETAIL N.T.S.

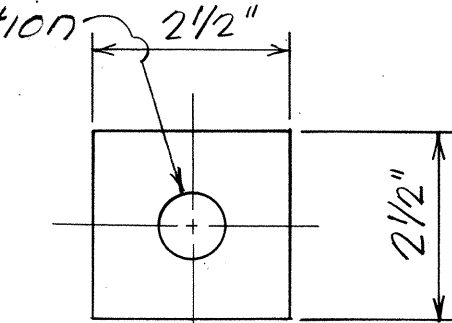

TYPICAL CAP FL DETAIL N.T.S.

STATE OF HAWAII  
DEPARTMENT OF TRANSPORTATION  
HIGHWAYS DIVISION

**TYPICAL DETAILS**  
METAL GUARD RAIL CONNECTION  
AT CONCRETE END POST

FAI. PROJ. NO. I-H3-1(50)

Scale: As Shown Date: Aug. 1967

SHEET NO. 527 OF 35 SHEETS







| FED. ROAD DIST. NO. | STATE | FED. AID PROJ. NO. | FISCAL YEAR | SHEET NO. | TOTAL SHEETS |
|---------------------|-------|--------------------|-------------|-----------|--------------|
| HAWAII              | HAW.  | I-H3-1(50)         | 1987        | ADD.110   | 164          |

# CURVE DATA

|    | Curve #1       | Curve #2    | Curve #3       |
|----|----------------|-------------|----------------|
| Δ  | 85° 44' 59.64" | 15° 40' 00" | 36° 29' 35.23" |
| R  | 2600.00'       | 36.34       | 70.00'         |
| T  | 2413.95'       | 5.00        | 23.08'         |
| Lc | 3871.21'       | 9.94        | 44.58'         |

## GENERAL STRUCTURAL NOTES

### Design Specifications:

AASHTO Standard Specifications for Highway Bridges (13th edition), including subsequent Interim Specifications.

### Design Loads:

Dead Load: Earth Load - 120 pcf  
Equivalent fluid pressure - 37 pcf  
Live Load: HS-20-44

### Allowable Design Stresses:


- Reinforced concrete:  $f_c = 1,200$  psi
- Reinforcing steel:  $f_s = 20,000$  psi

### Materials:

- Reinforced concrete - Class A
- Reinforcing steel - ASTM A615, Grade 40

### Construction Requirements:

- Refer to Standard Specifications for Road and Bridge Construction (Hawaii 1985) and Special Provisions.
- Except as noted otherwise on drawings, all exterior corners and re-entrant angles in concrete work shall be chamfered  $\frac{3}{4}" \times \frac{3}{4}"$ .

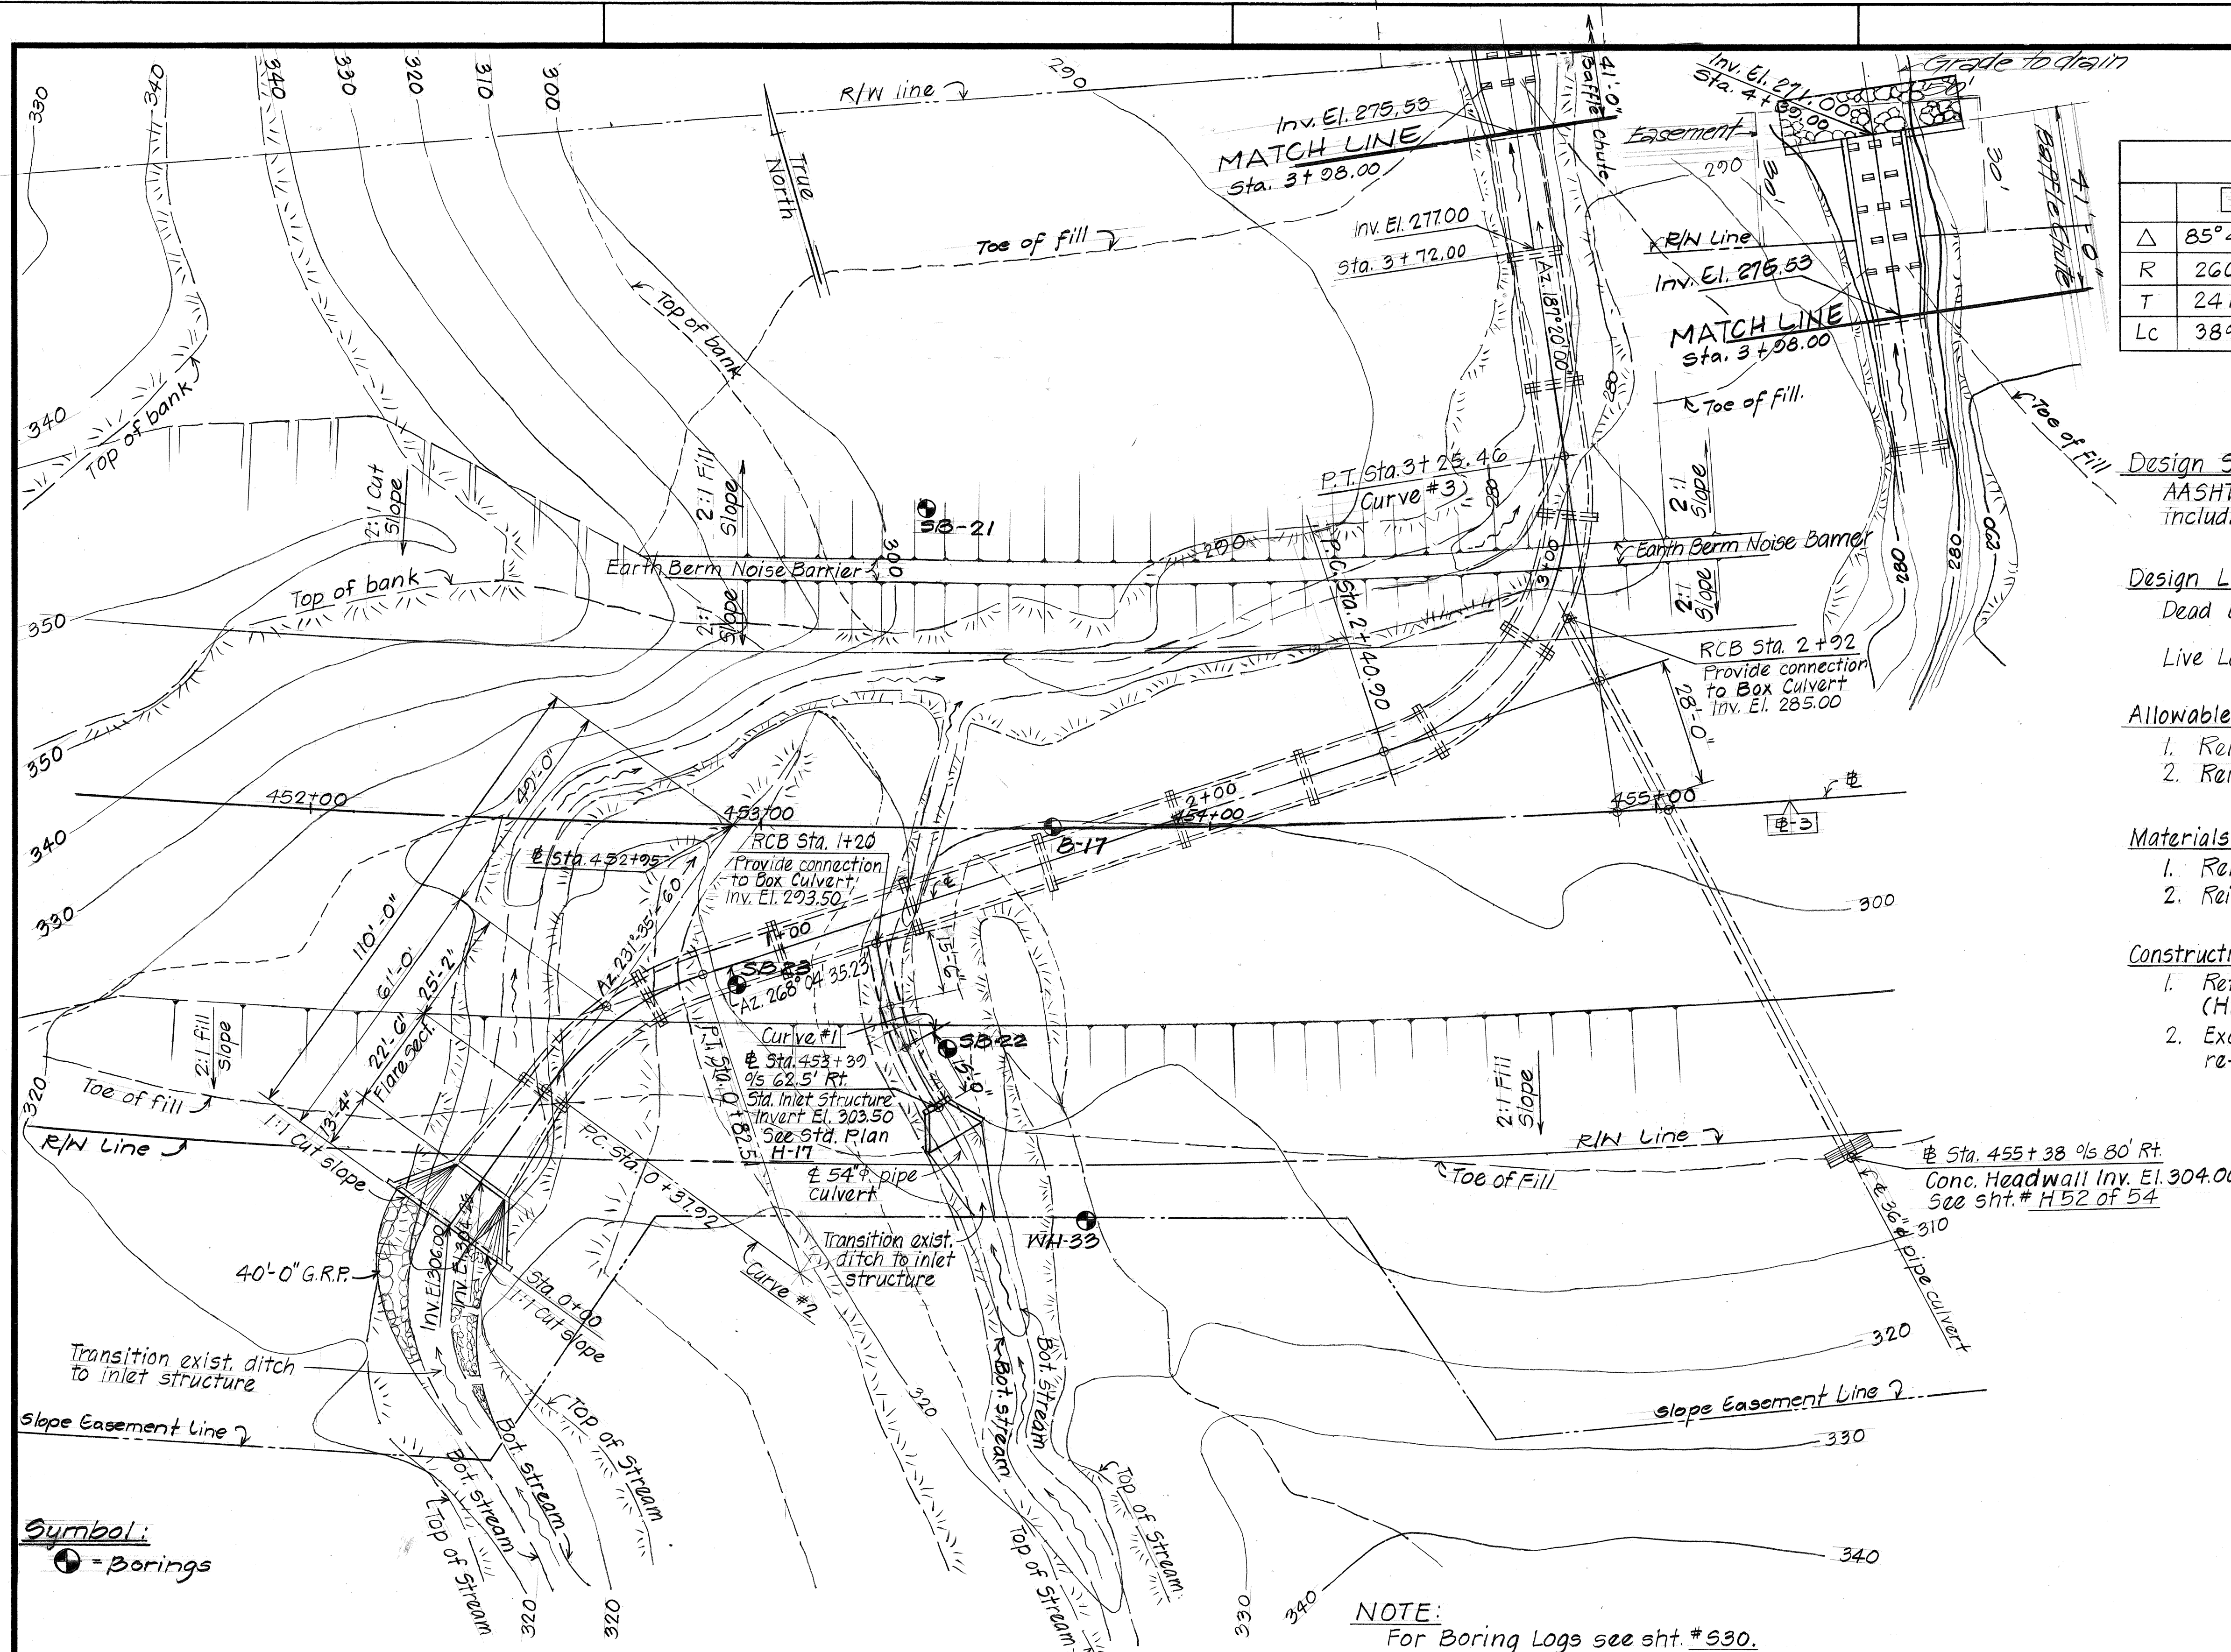

## LAYOUT PLAN - 9'-0" x 8'-0" CONC. BOX CULVERT AT STA. 453+87

Scale: 1" = 20'-0"

3/10/90 G.R.P. Lining for Outlet Structure at Sta. 453+87 Lt. C.C. (1+)  
3/12/89 Revised plan sheet reference numbers

DATE REVISION

STATE OF HAWAII  
DEPARTMENT OF TRANSPORTATION  
LAND TRANSPORTATION FACILITIES DIVISION  
9'-0" x 8'-0" CONC. BOX CULVERT  
AT STA. 453+87  
LAYOUT PLAN - CONC. BOX CULVERT

F.A.I. Proj. No. I-H3-1(50)  
KANELOHE I.C. TO HALEKOU I.C.  
Scale: As Noted Date: August 1987  
SHEET No. 529 OF 35 SHEETS

"AS BUILT"

ADD.110


110

|               |      |
|---------------|------|
| ORIGINAL PLAN | DATE |
| DESIGNED BY   | 7/83 |
| NOTED BY      | 7/83 |
| QUANTITIES BY | 7/83 |
| CHECKED BY    | 7/83 |




| FED. ROAD DIST. NO. | STATE | FED. AID PROJ. NO. | FISCAL YEAR | SHEET NO. | TOTAL SHEETS |
|---------------------|-------|--------------------|-------------|-----------|--------------|
| HAWAII              | HAW.  | I-H3-1(50)         | 1989        | 111       | 164          |

Boring B-17, surface El. 289.3'

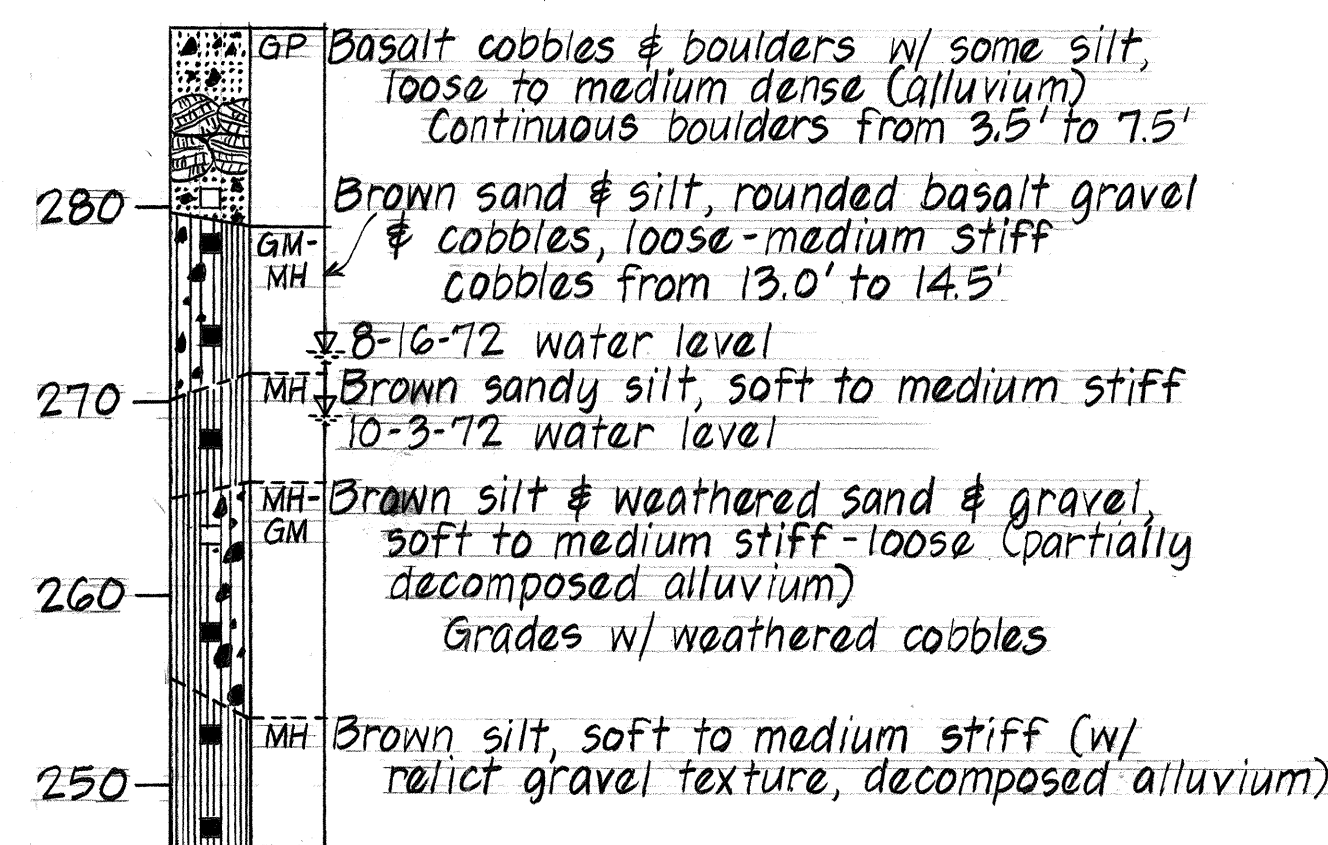


Boring completed @ 42.0' on 8-16-72

Boring SB-21, surface El. 305.9'

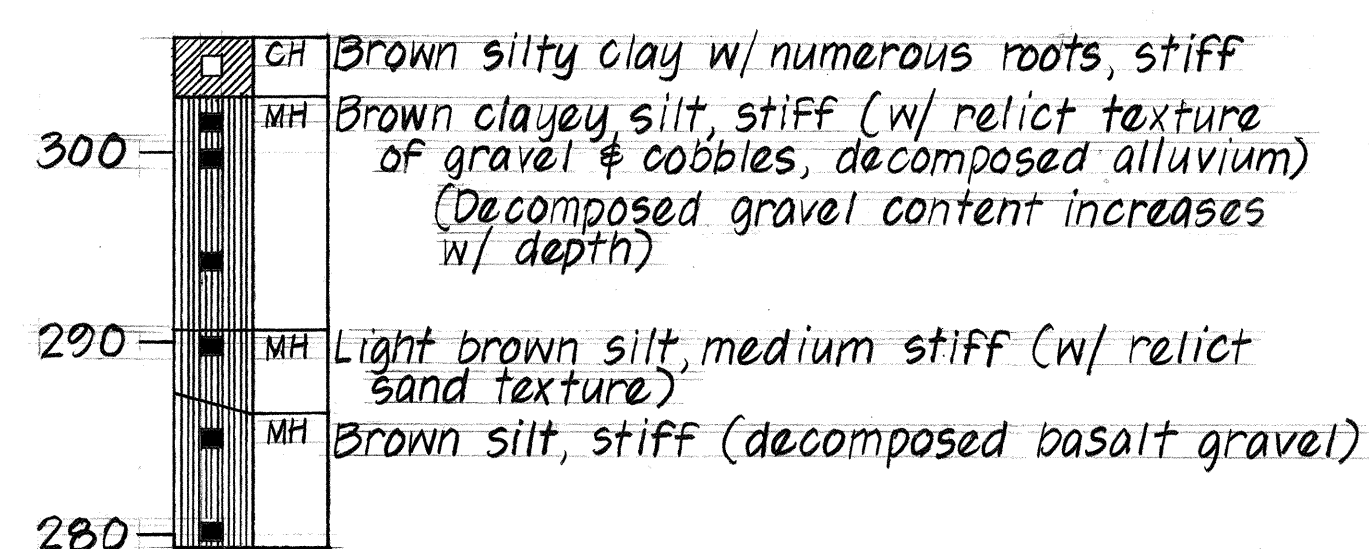


Boring completed @ 26.3' on 8-4-72  
No water encountered

Boring SB-22, surface El. 307.8'

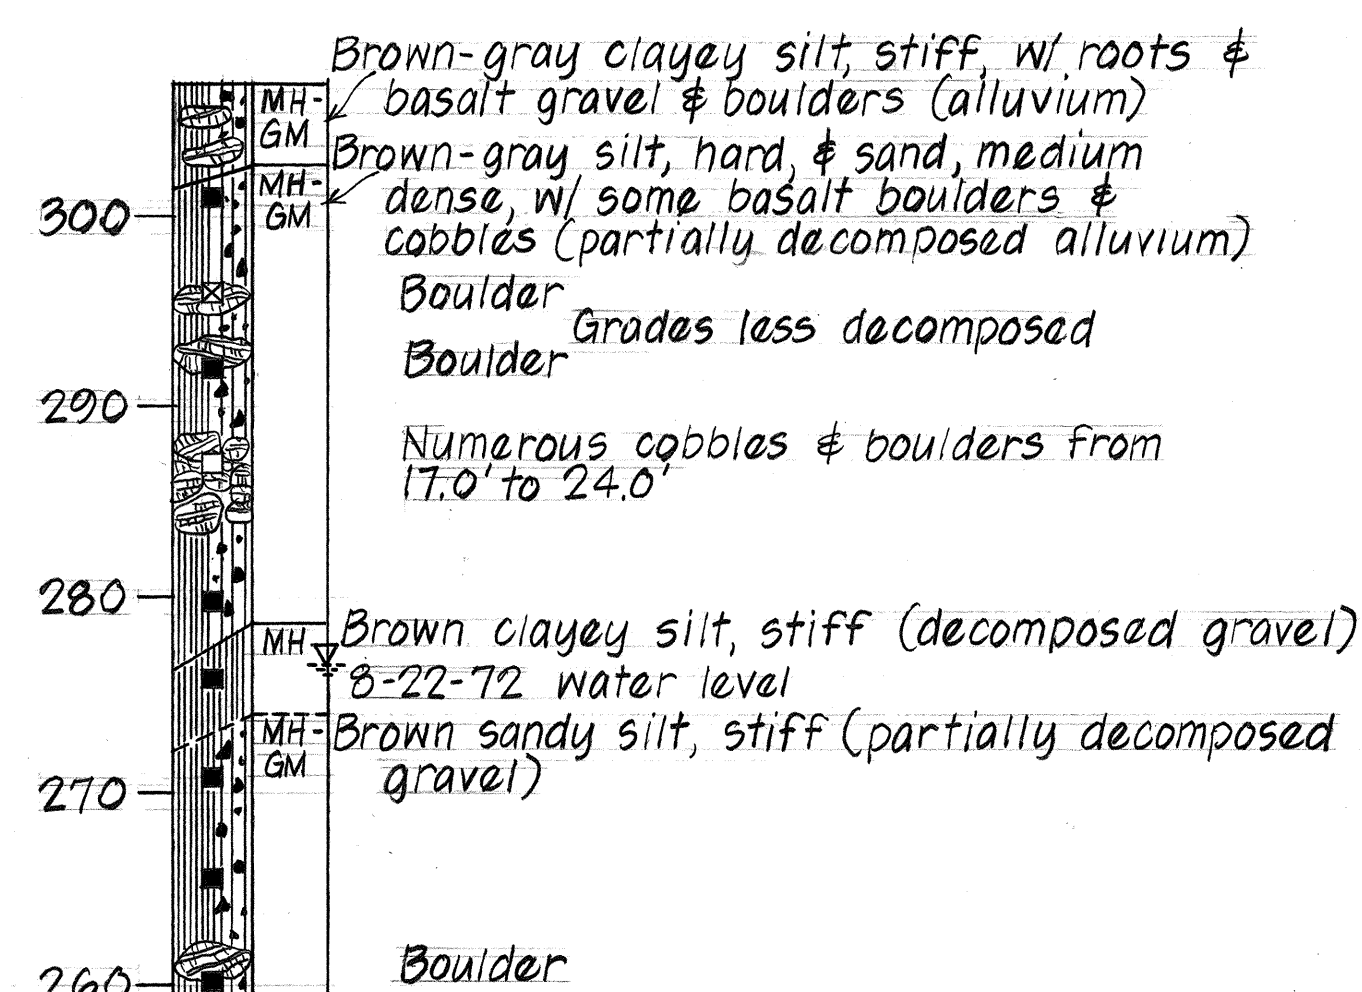


Boring completed @ 47.0' on 8-22-72  
No water encountered to 35' on 9-26-72

Boring SB-23, surface El. 308.7'

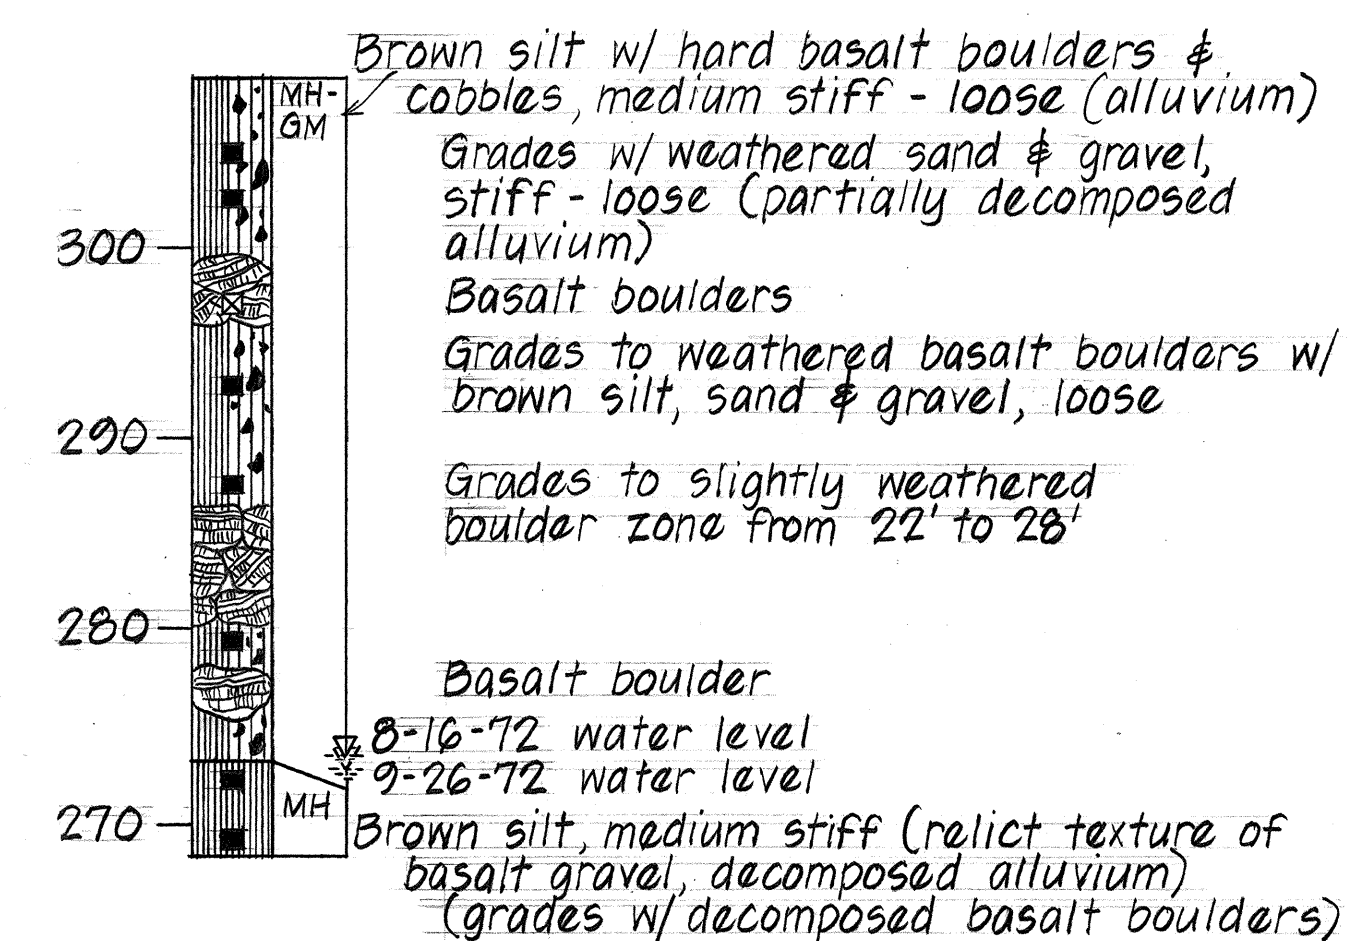

Boring completed @ 40.0' on 8-16-72

Boring WH-33, surface El. 315.0'

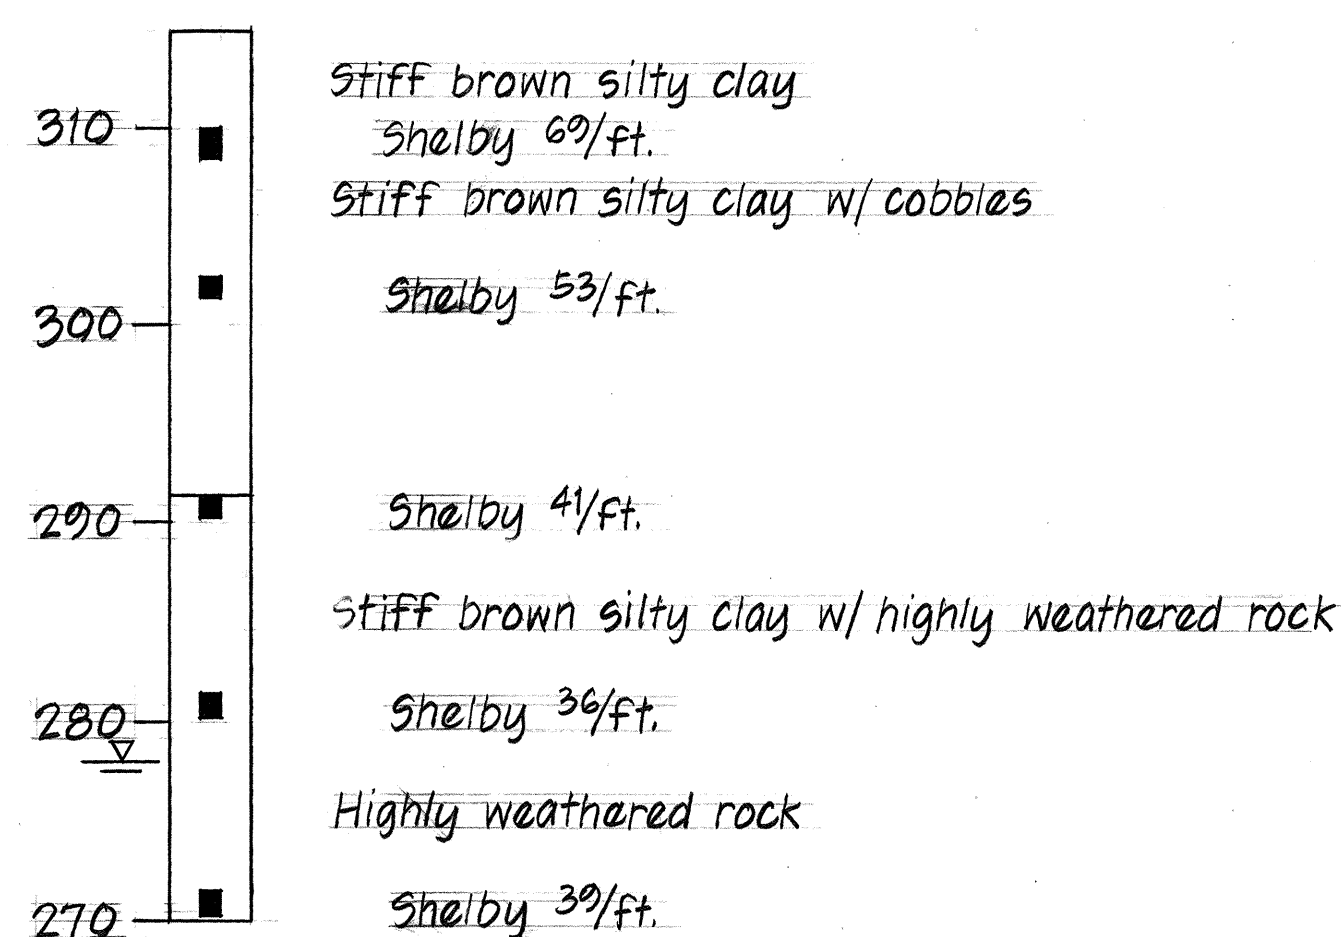


|                   |       |
|-------------------|-------|
| DATE              | 10/83 |
| SURVEY PLOTTED BY | ...   |
| DESIGNED BY       | ...   |
| NOTE BOOK         | ...   |
| QUANTITIES BY     | ...   |
| CHECKED BY        | ...   |
| No.               | ...   |

STATE OF HAWAII  
DEPARTMENT OF TRANSPORTATION  
LAND TRANSPORTATION FACILITIES DIVISION

9'-0" x 8'-0" CONC. BOX CULVERT  
AT STA. 453+87  
BORING LOGS  
F.A.I. Proj. No. I-H3-1(50)  
KANEOME I.C. TO HALEKOU I.C.  
Scale: As Noted Date: August 1987  
SHEET No. 930 OF 35 SHEETS



| FED. ROAD DIST. NO. | STATE | FED. AID PROJ. NO. | FISCAL YEAR | SHEET NO. | TOTAL SHEETS |
|---------------------|-------|--------------------|-------------|-----------|--------------|
| HAWAII              | HAW.  | I-H3-1(50)         | 1987        | 112       | 164          |

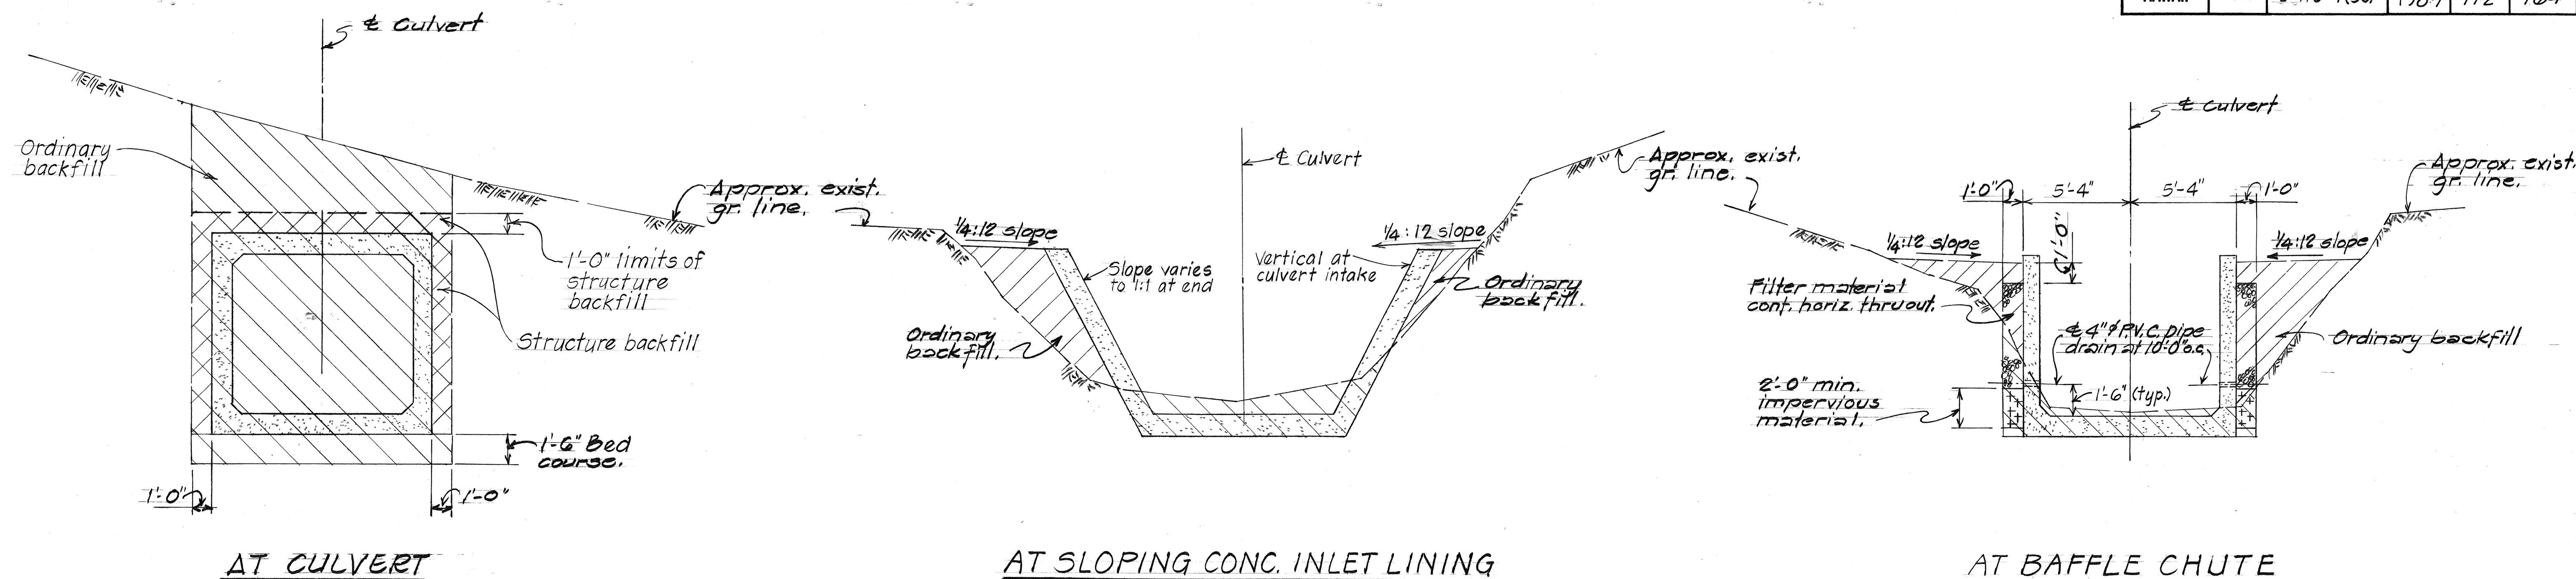

# NOTE:

1. Hatched area shown thus denotes limits of structure excavation payline. All other excavation shall be roadway excavation.
2. Hatched area shown thus denotes limits of structure backfill.

|                   |      |
|-------------------|------|
| ORIGINAL PLAN     | DATE |
| SURVEY PLOTTED BY | 7/83 |
| DESIGNED BY       | 7/83 |
| NOTED BY          | 7/83 |
| CHECKED BY        | 7/83 |


|                                                                                                                                                                                                                                                                                                                                                                      |                                                                                                    |
|----------------------------------------------------------------------------------------------------------------------------------------------------------------------------------------------------------------------------------------------------------------------------------------------------------------------------------------------------------------------|----------------------------------------------------------------------------------------------------|
| 8/13/10                                                                                                                                                                                                                                                                                                                                                              | Additional GKP for Transition into 4'x8' Box Culvert Inlet Structure at Sta. 452+50.1 Rt. (cc0*14) |
| Date                                                                                                                                                                                                                                                                                                                                                                 | Revision                                                                                           |
| STATE OF HAWAII<br>DEPARTMENT OF TRANSPORTATION<br>LAND TRANSPORTATION FACILITIES DIVISION<br><b>9'-0"x 8'-0" CONC. BOX CULVERT</b><br><b>AT STA. 453+87</b><br>TYPICAL CONC. BOX CULVERT<br>STRUCTURE EXC. & BACKFILL PAY LIMITS<br>F.A.I. Proj. No. I-H3-1(50)<br>KANELOHE I.C. TO HALEKOU I.C.<br>Scale: As Noted Date: August 1987<br>SHEET No. 531 OF 35 SHEETS |                                                                                                    |

"AS BUILT"


112




| FED. ROAD DIST. NO. | STATE | FED. AID PROJ. NO. | FISCAL YEAR | SHEET NO. | TOTAL SHEETS |
|---------------------|-------|--------------------|-------------|-----------|--------------|
| HAWAII              | HAW.  | I-H3-1(50)         | 1989        | ADD.113   | 164          |

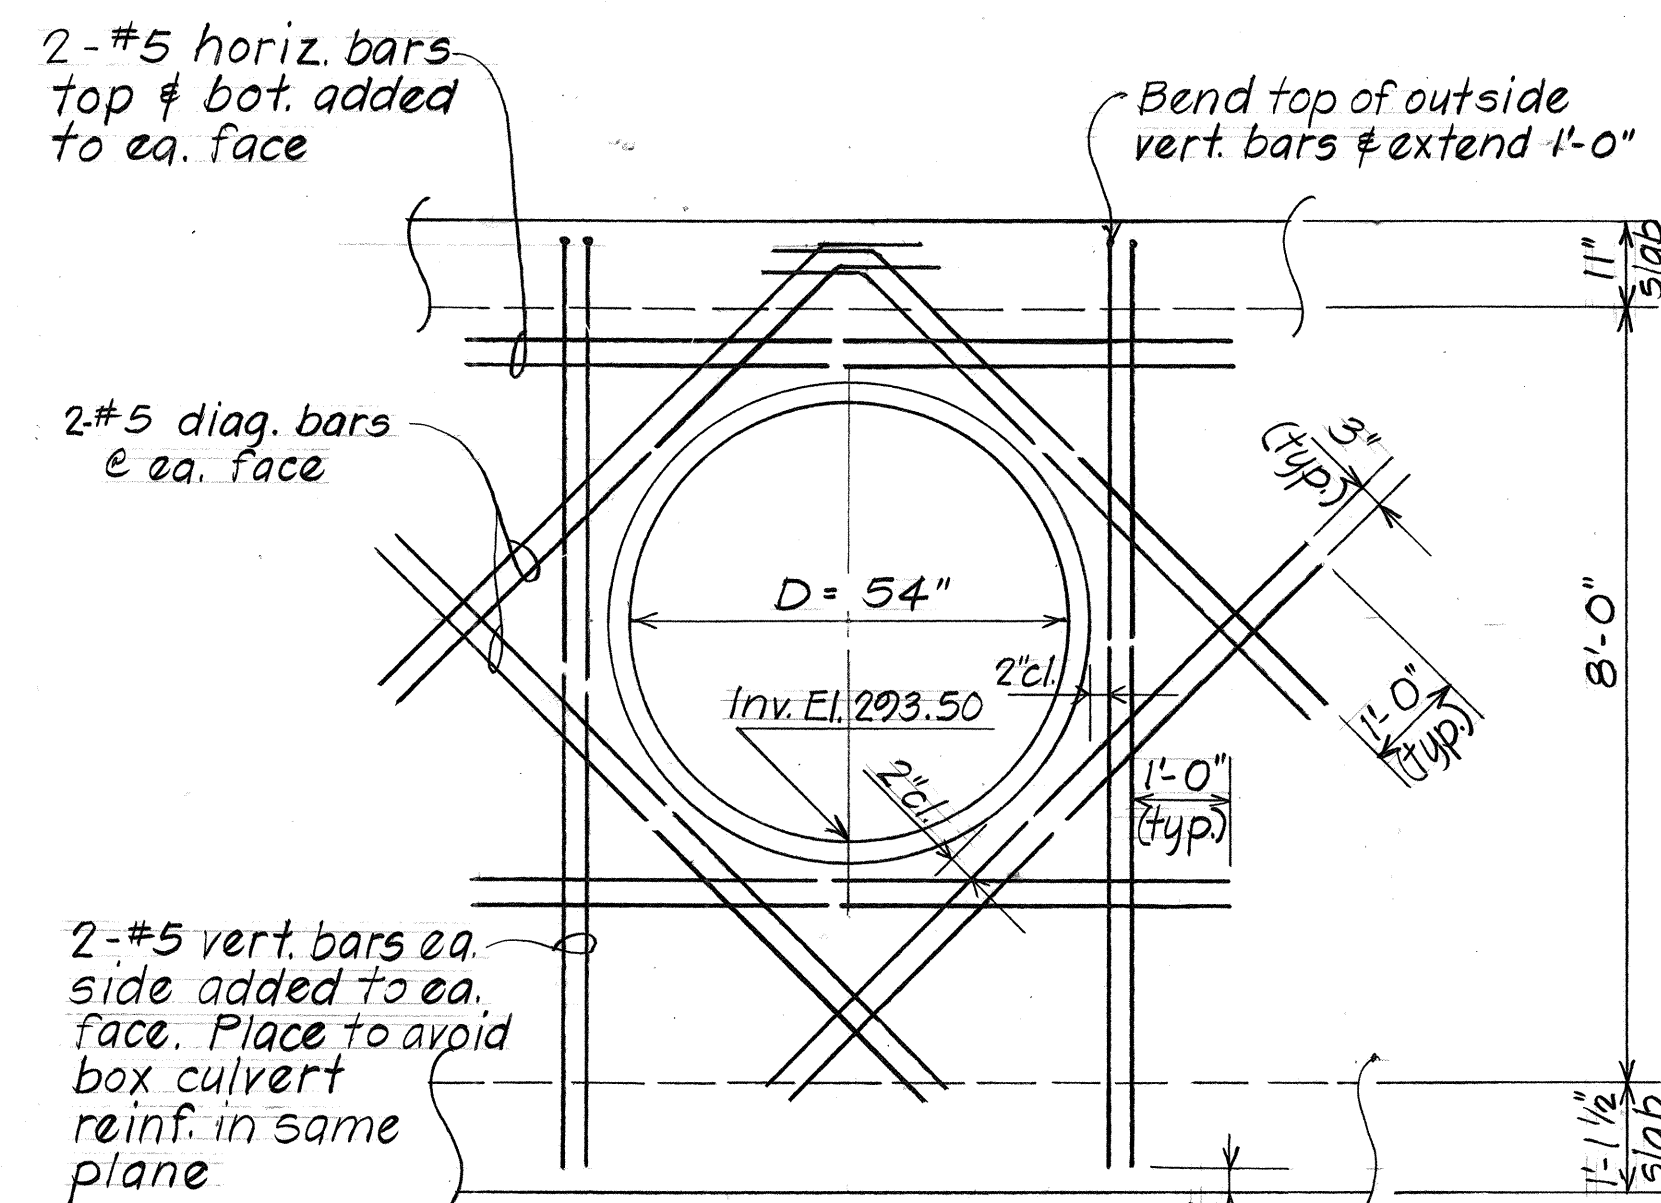


AT 54" PIPE OPENING

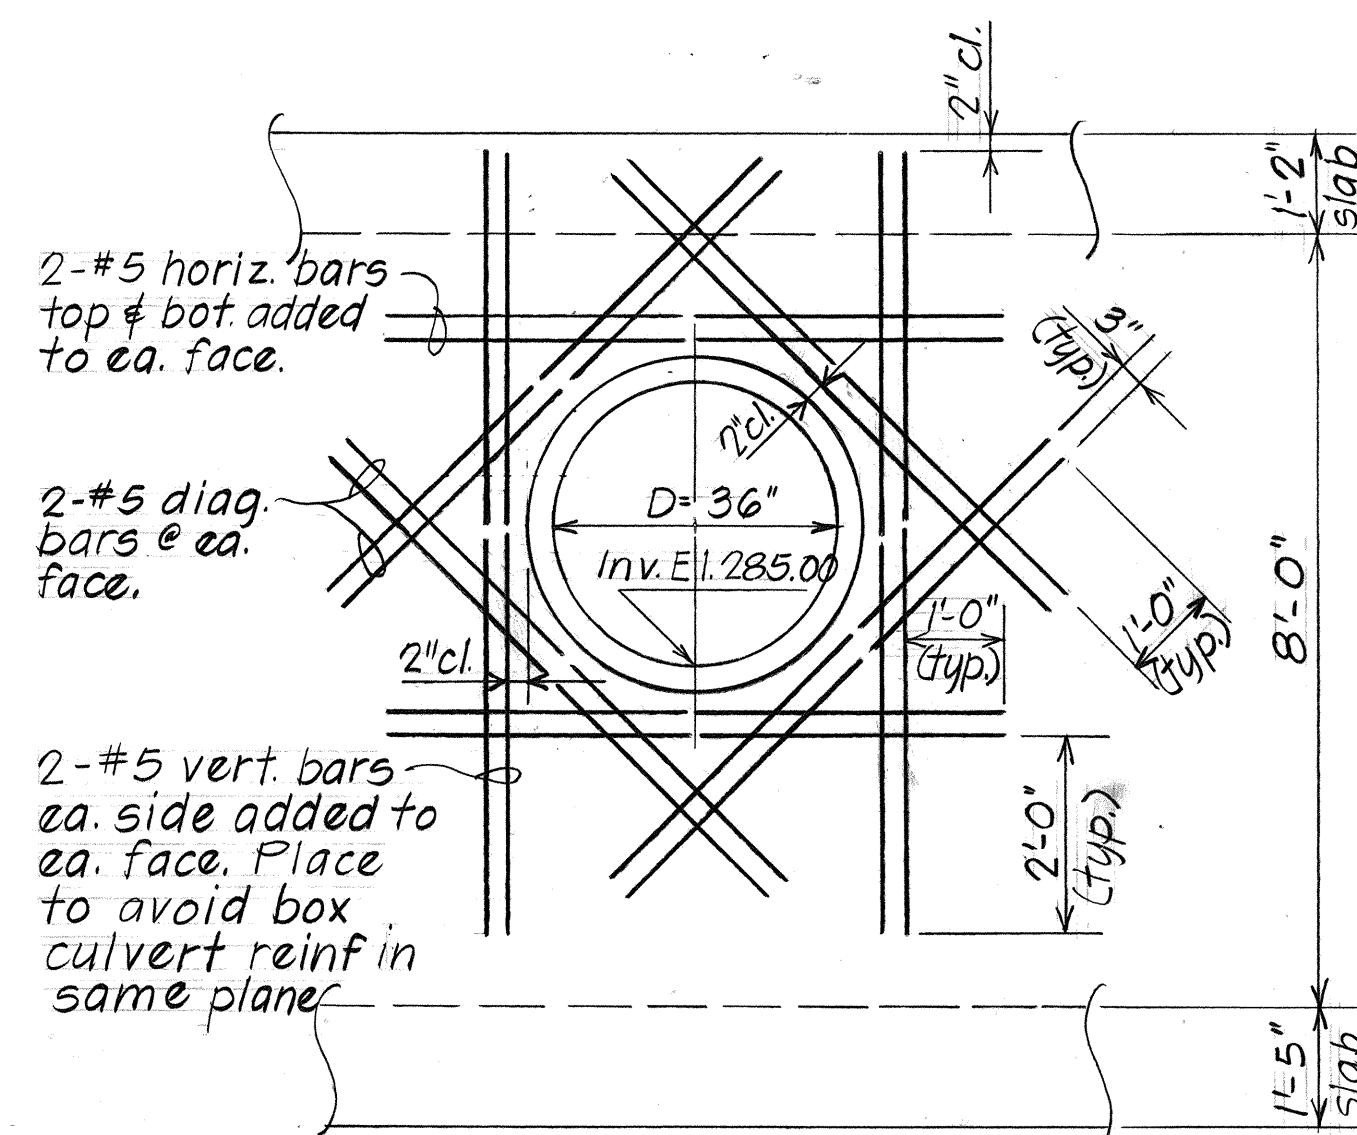

AT 36" PIPE OPENING

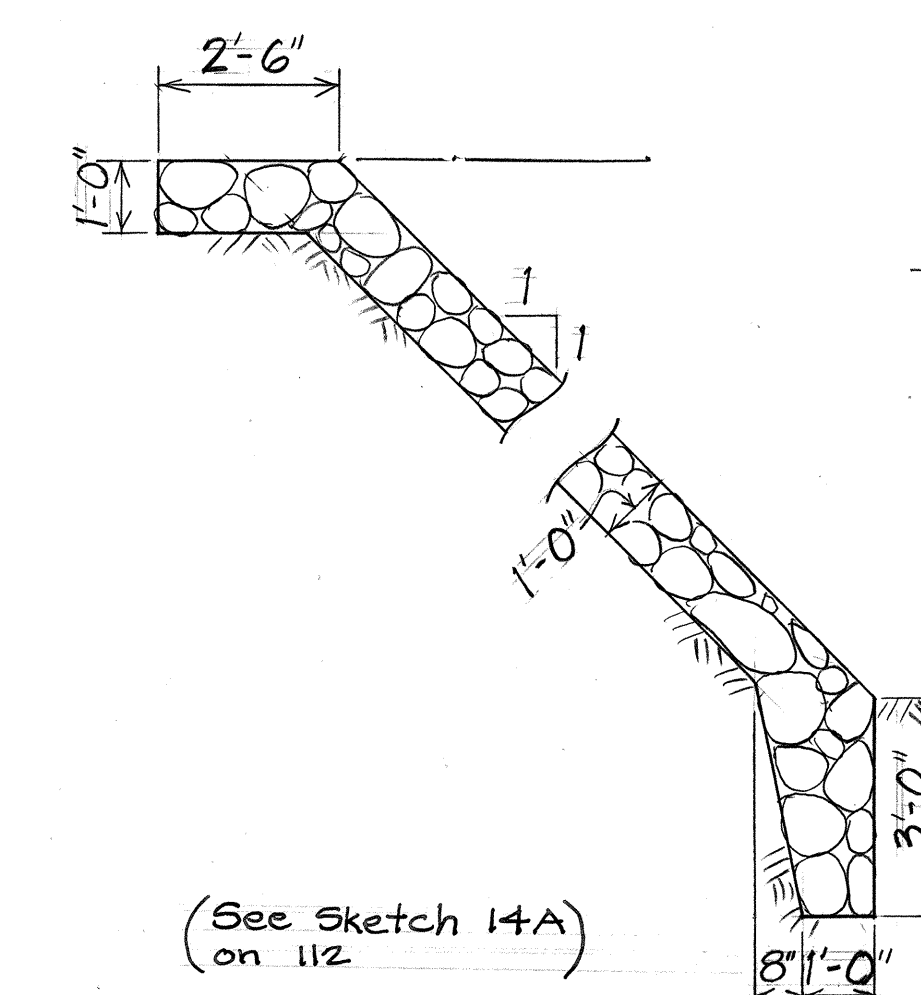

TYPICAL G.R.P. SECTION @ INLET

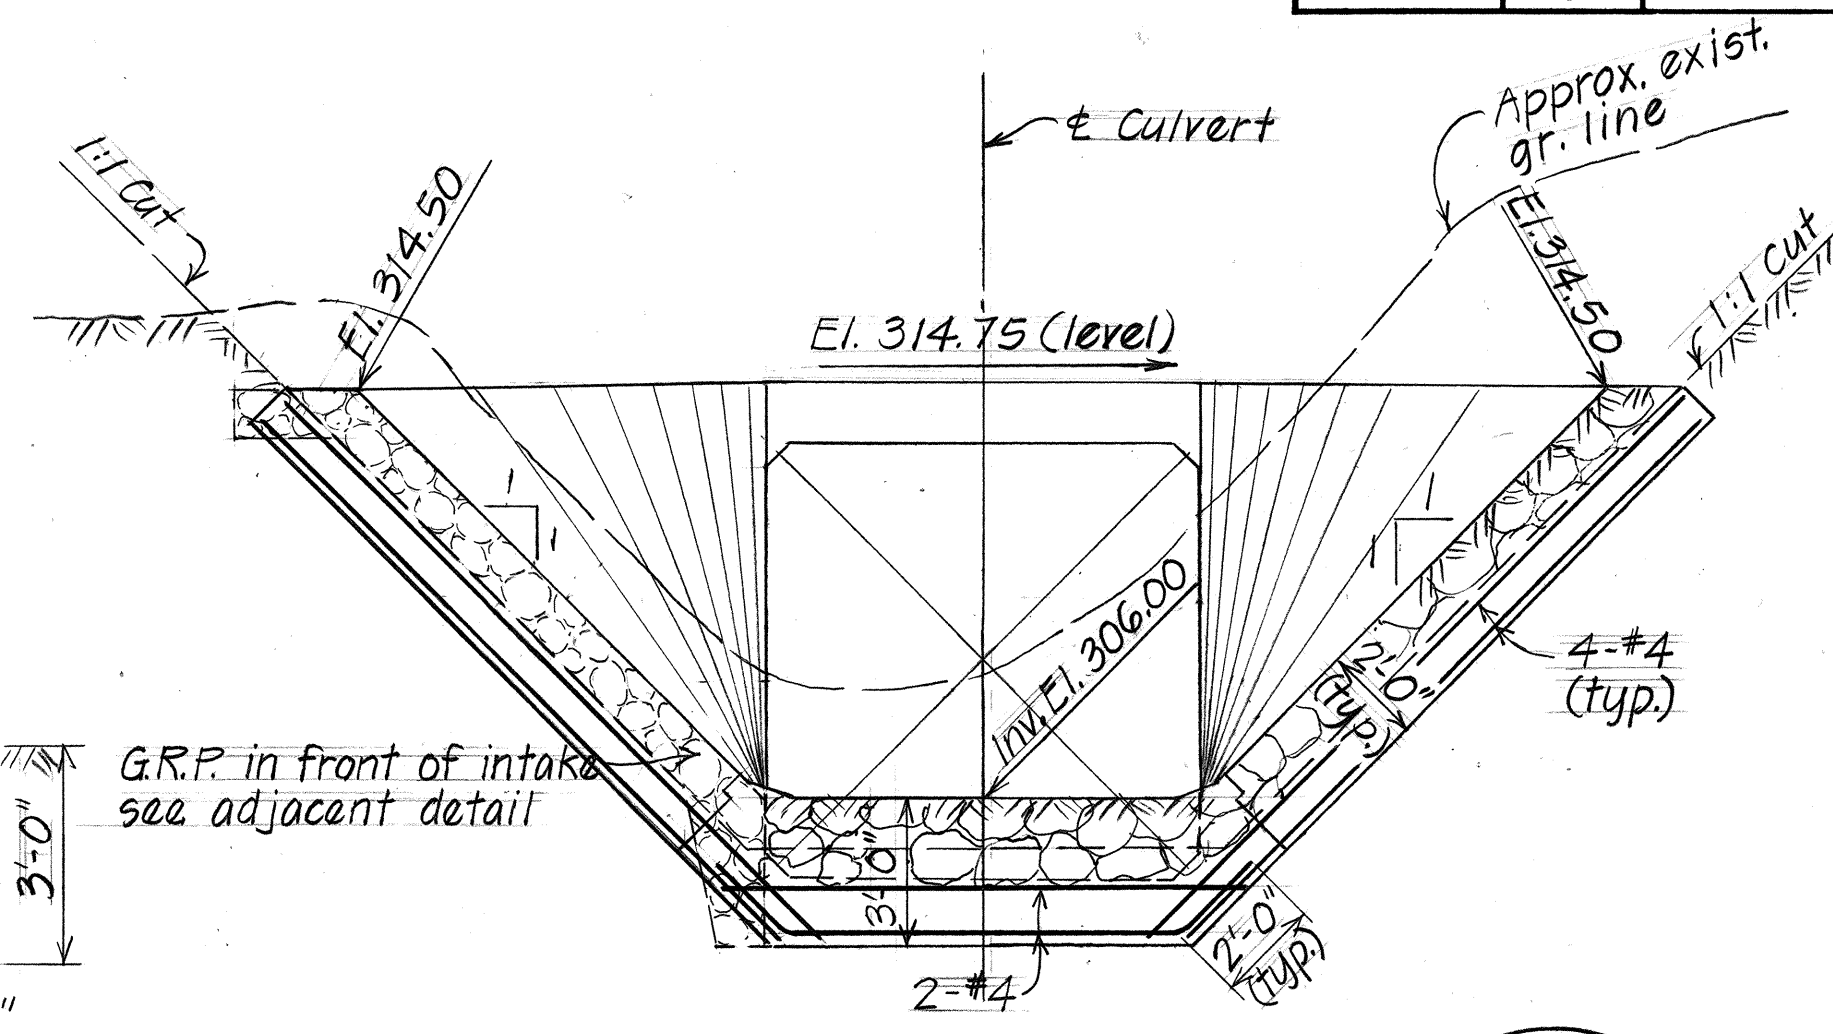


INLET ELEVATION A 532/532

TYPICAL DETAIL - SHOWING ADDED REINF. AT PIPE OPENING Scale: 1/2" = 1'-0"


ESTIMATED QUANTITIES

| ITEM NO. | ITEM                                                                                            | UNIT     | QUANTITIES  |
|----------|-------------------------------------------------------------------------------------------------|----------|-------------|
| 206.4201 | Structure Excavation for Box Culvert, Sloped Concrete Lined Inlet, Concrete Baffle Chute Outlet | Cu. Yd.  | 2,530 C.Y.  |
| 206.7001 | Structure Backfill for Box Culvert, Sloped Concrete Lined Inlet, Concrete Baffle Chute Outlet.  | Cu. Yd.  | 510 C.Y.    |
| 206.8000 | Filter Material                                                                                 | Cu. Yd.  | 26 C.Y.     |
| 207.0100 | Ditch and Channel Excavation                                                                    | Cu. Yd.  | 81 C.Y.     |
| 503.0140 | Concrete in Sloped Concrete Lined Inlet and Concrete Baffle Chute Outlet.                       | Lump Sum | 80 C.Y.     |
| 503.1030 | Concrete in Box Culvert                                                                         | Lump Sum | 640 C.Y.    |
| 602.0032 | Reinforcing Steel in Box Culvert, Sloped Concrete Lined Inlet and Concrete Baffle Chute Outlet. | Lump Sum | 103,000 LBS |
| 603.0010 | Bed Course Material for Culvert                                                                 | Cu. Yd.  | 283 C.Y.    |
| 612.0203 | Grouted Rubble Slope Protection for 9'-0" x 8'-0" Box Culvert Inlet                             | Cu. Yd.  | 15 C.Y.     |

Note: Estimated quantities for 36" & 54" pipe culverts & their inlets - see Sht. # H1 of 54

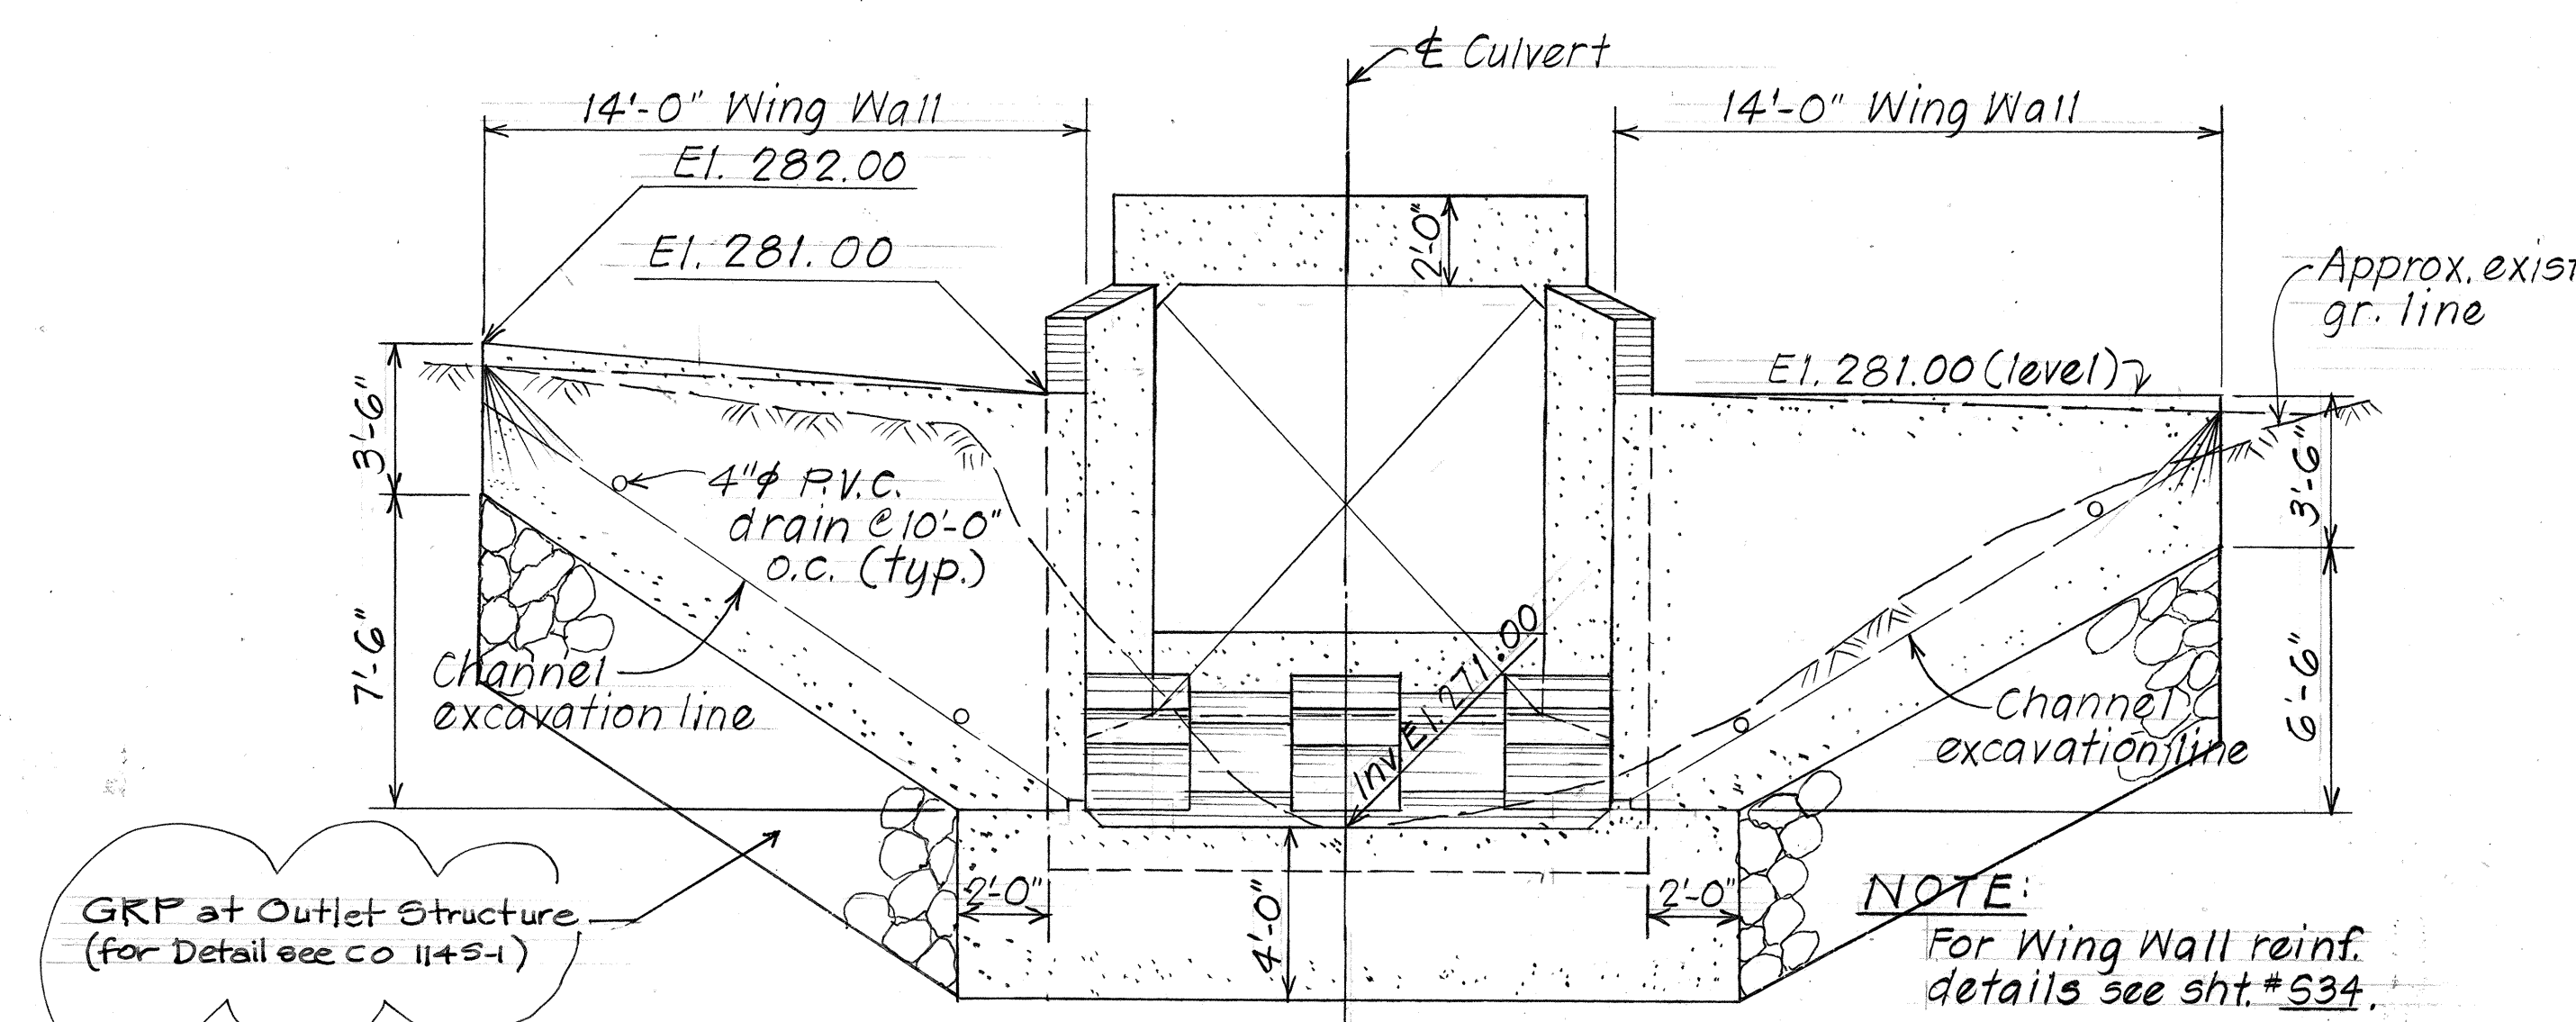

OUTLET ELEVATION B 532/532

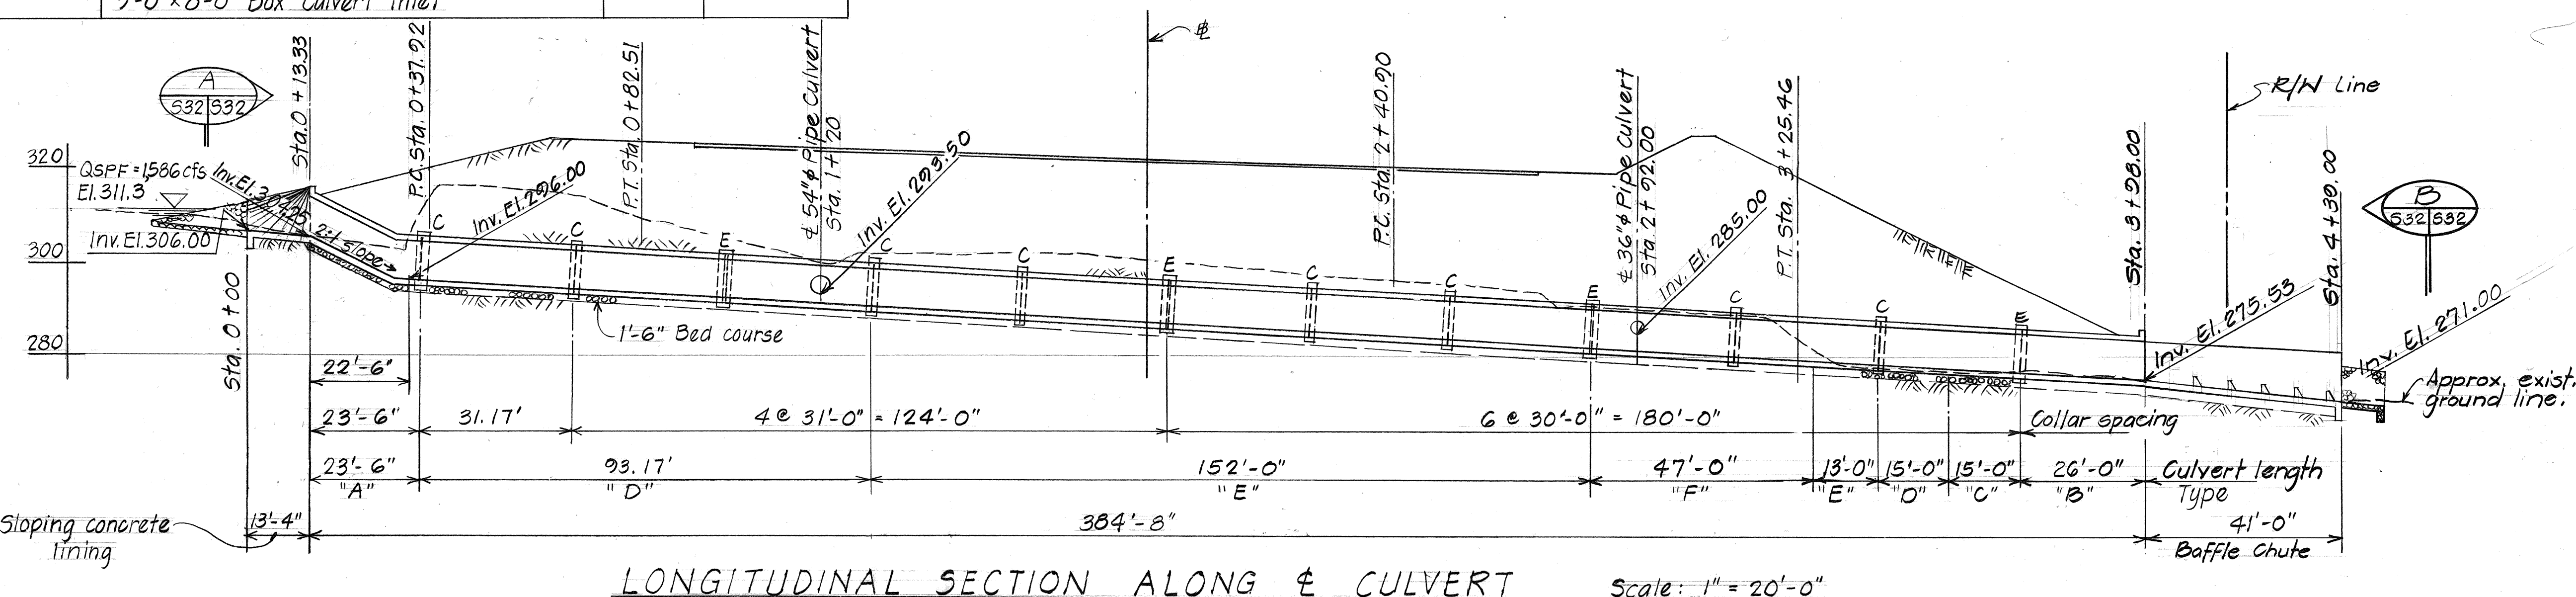


LONGITUDINAL SECTION ALONG & CULVERT Scale: 1" = 20'-0"


| 3/13/90                                                                                                                                                                                                                                                                                                                                                      | Additional G.R.P. for Transition into 9'x8' box Culvert Inlet Structure at Sta. 452+50.5 Rt. (Cco #14) |
|--------------------------------------------------------------------------------------------------------------------------------------------------------------------------------------------------------------------------------------------------------------------------------------------------------------------------------------------------------------|--------------------------------------------------------------------------------------------------------|
| 3/2/89                                                                                                                                                                                                                                                                                                                                                       | Revised plan sheet reference number                                                                    |
| DATE                                                                                                                                                                                                                                                                                                                                                         | REVISION                                                                                               |
| STATE OF HAWAII<br>DEPARTMENT OF TRANSPORTATION<br>LAND TRANSPORTATION FACILITIES DIVISION<br>9'-0" x 8'-0" CONC. BOX CULVERT<br>AT STA. 453+87<br>LONGITUDINAL CULVERT SECTION<br>INTAKE & OUTLET ELEV. - EST. QUANTITIES<br>F.A.I. Proj. No. I-H3-1(50)<br>KANEHOE I.C. TO HALEKOU I.C.<br>Scale: As Noted Date: August 1987<br>SHEET No. 532 OF 35 SHEETS |                                                                                                        |



| FED. ROAD DIST. NO. | STATE | FED. AID PROJ. NO. | FISCAL YEAR | SHEET NO. | TOTAL SHEETS |
|---------------------|-------|--------------------|-------------|-----------|--------------|
| HAWAII              | HAW.  | I-H3-1(50)         | 1987        | 114       | 164          |

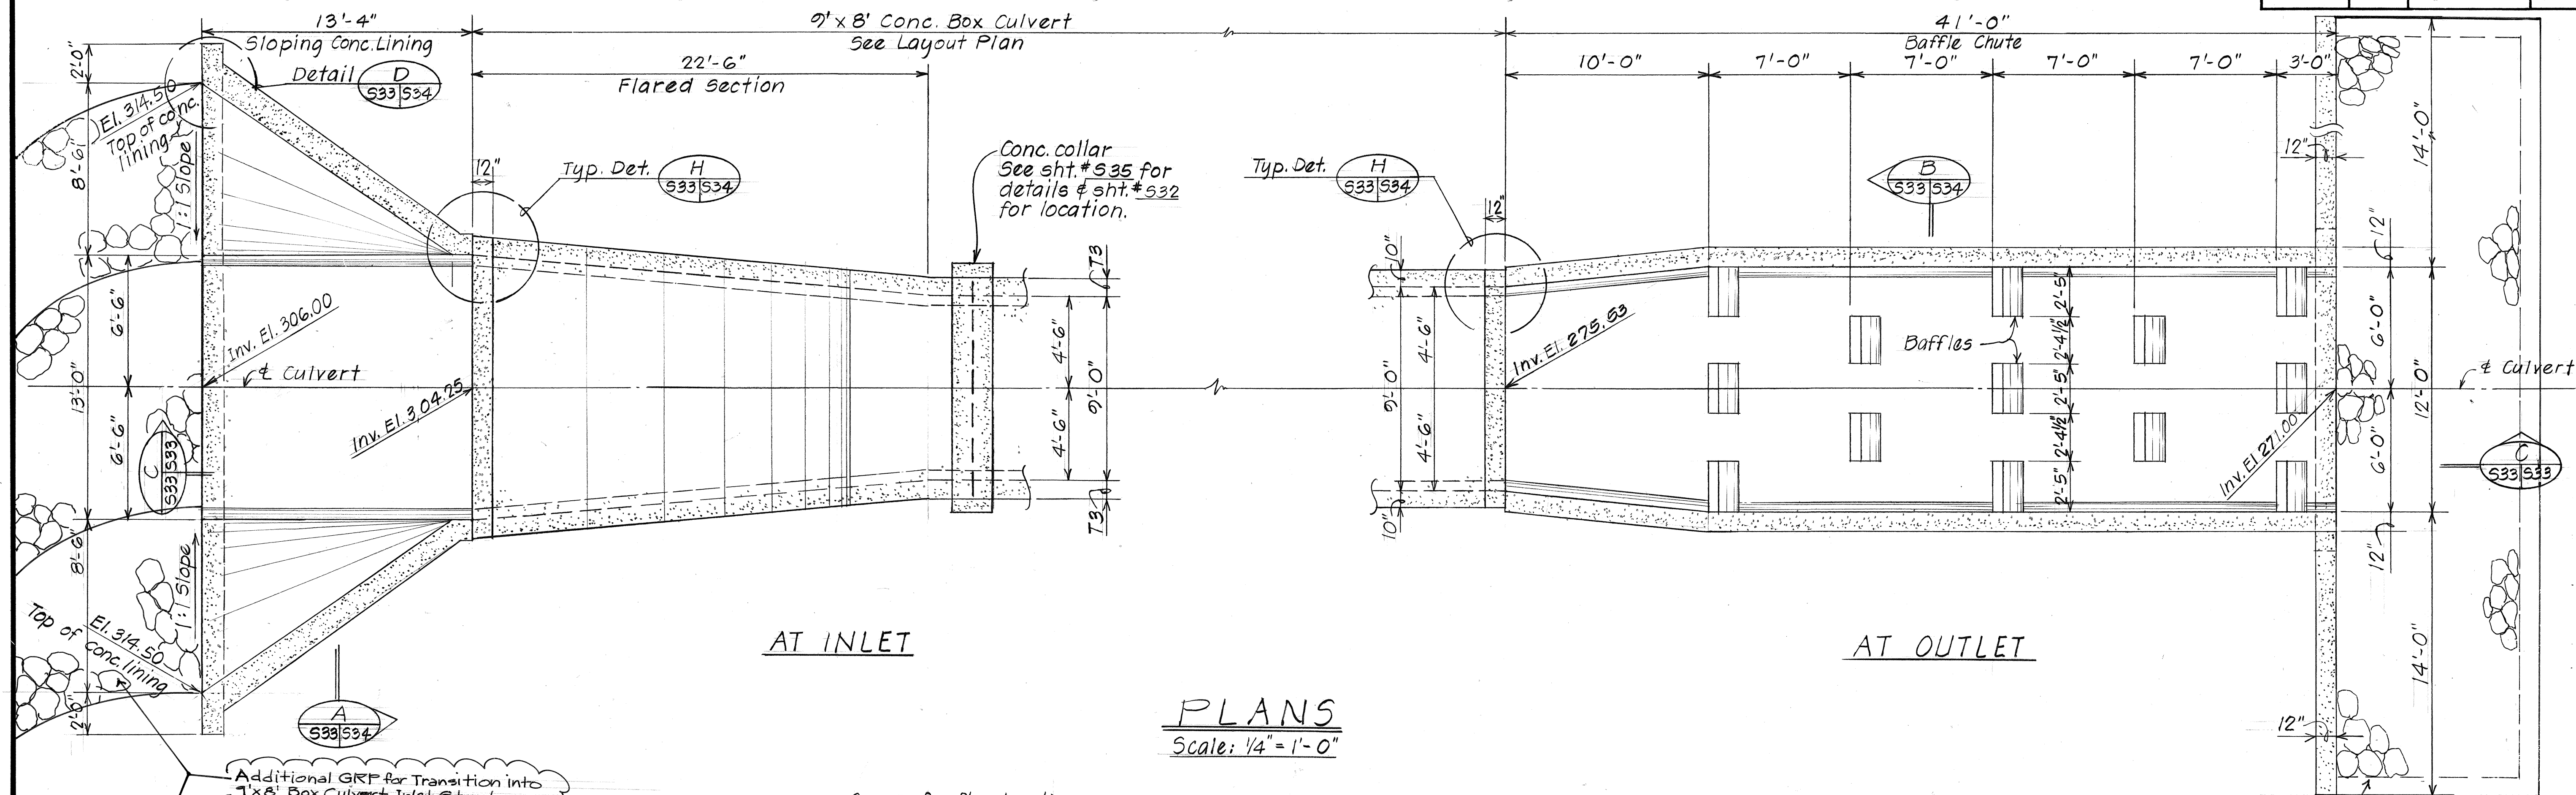

**PLANS**  
Scale: 1/4" = 1'-0"

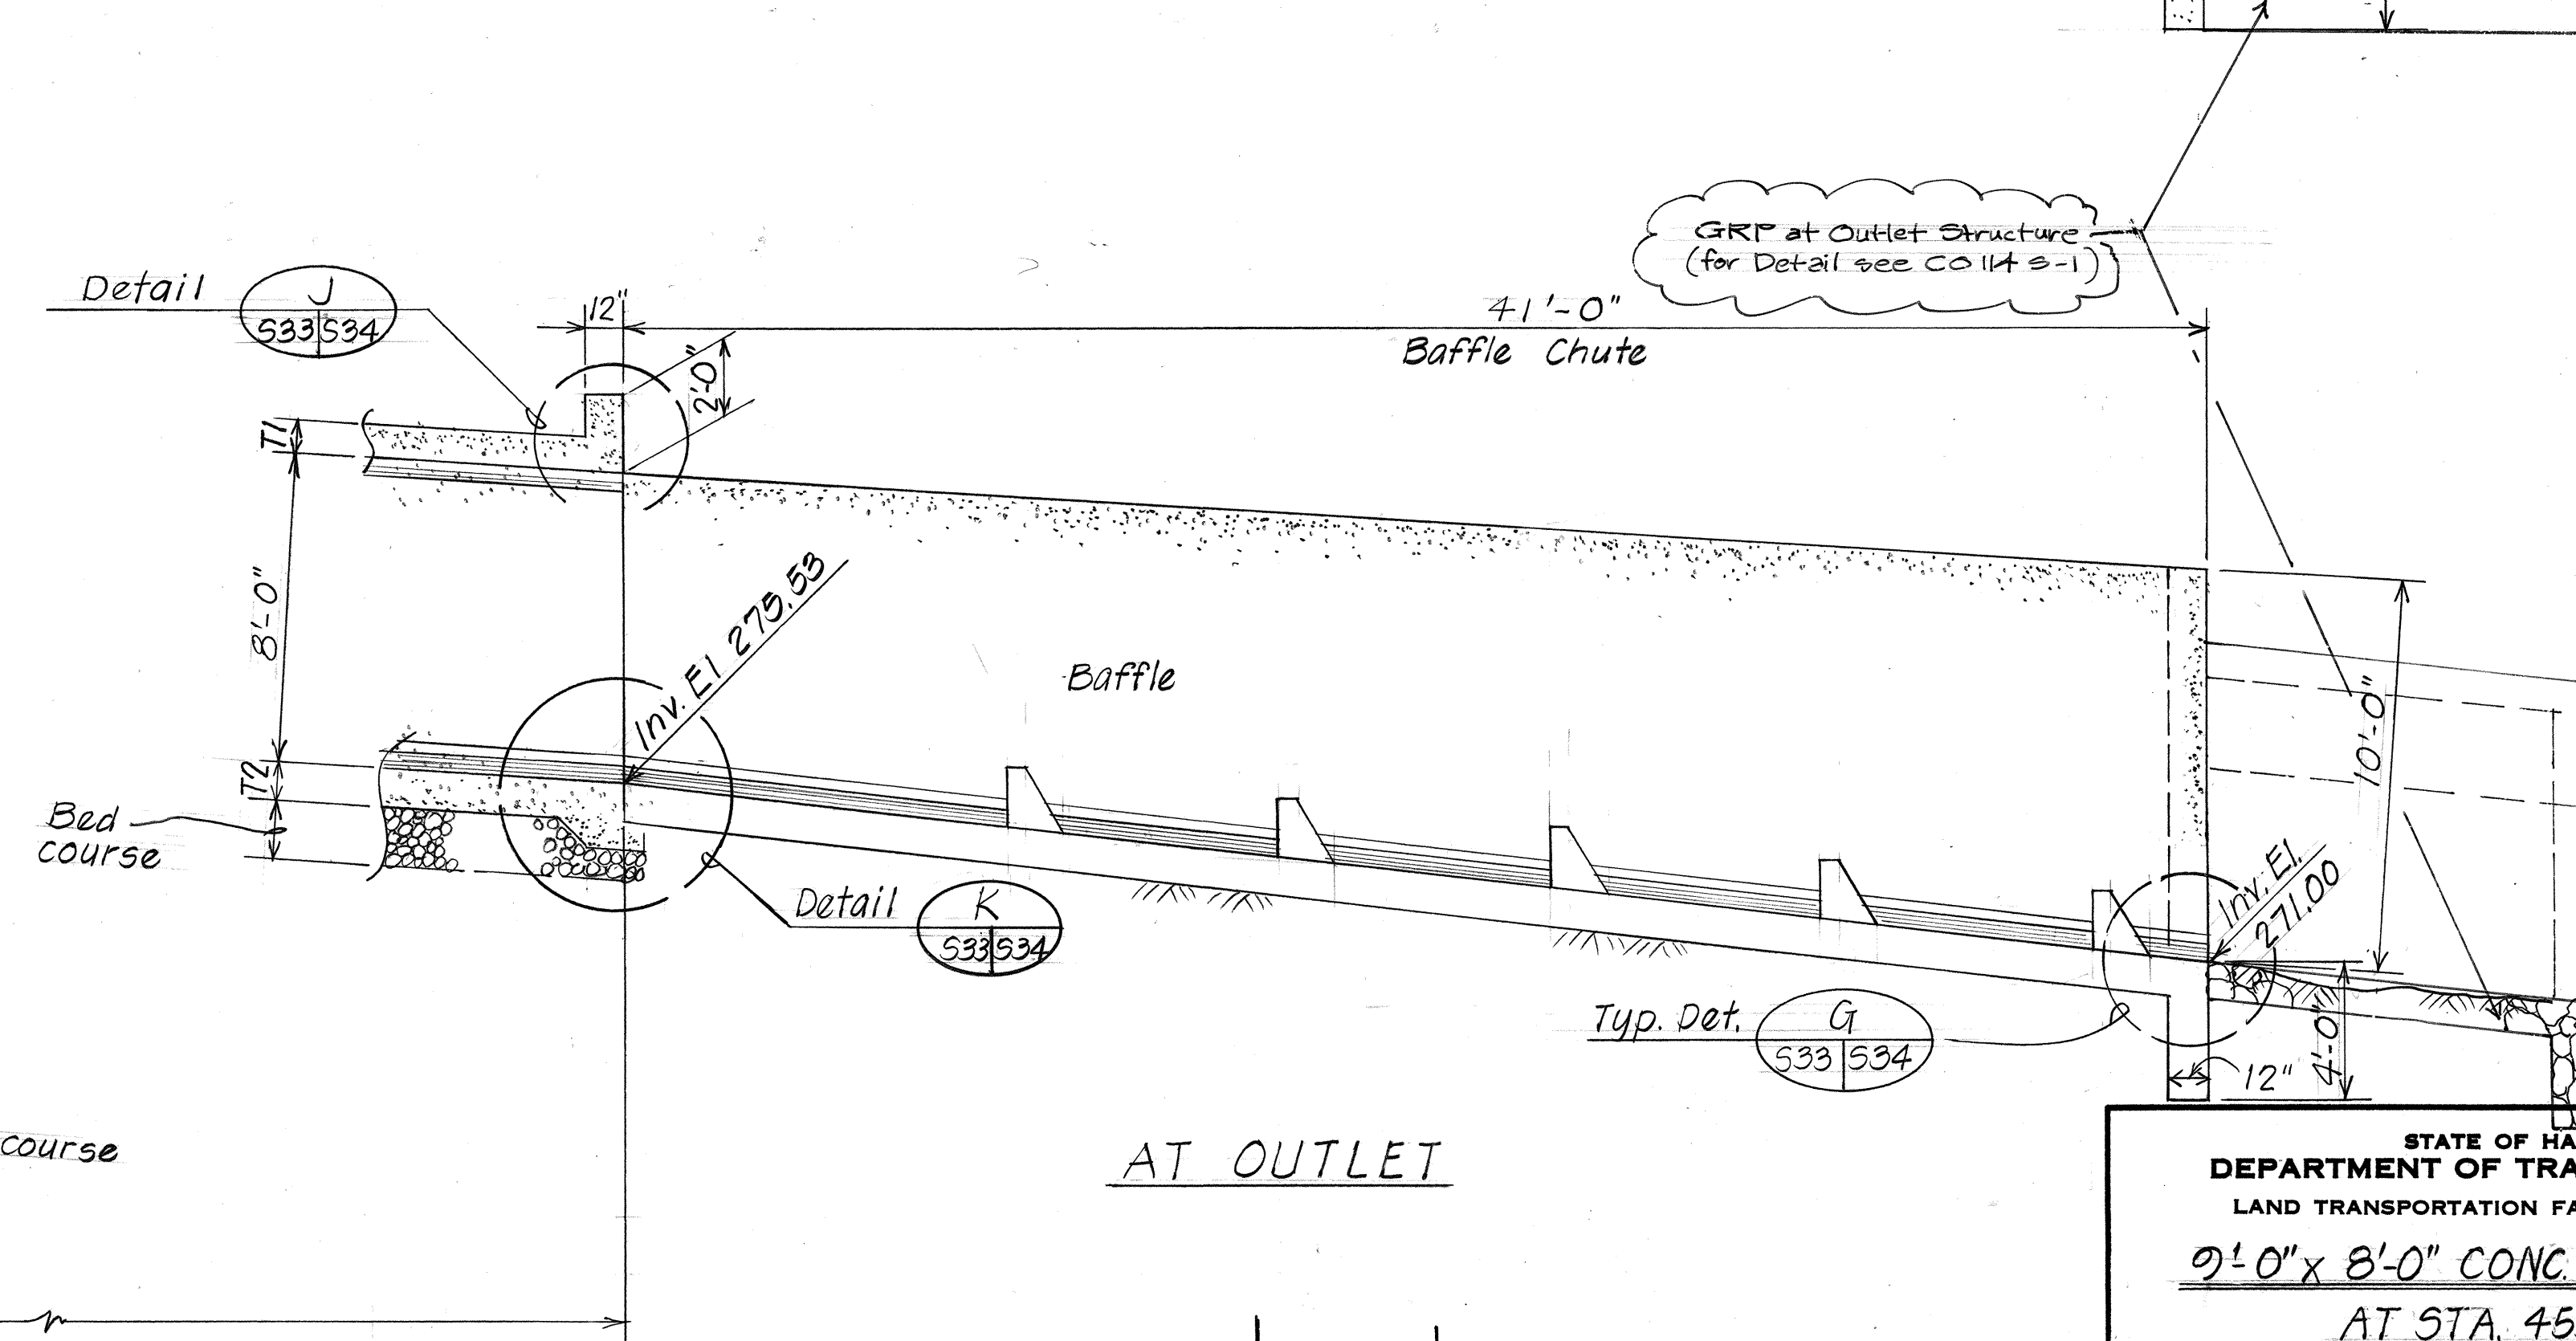

**SECTIONS**  
Scale: 1/4" = 1'-0"

|                   |      |
|-------------------|------|
| DATE              | 7/83 |
| SURVEY PLOTTED BY | ...  |
| DESIGNED BY       | ...  |
| NOTE BOOK         | ...  |
| QUANTITIES BY     | ...  |
| CHECKED BY        | ...  |

|          |  |
|----------|--|
| Date     |  |
| Revision |  |

STATE OF HAWAII  
DEPARTMENT OF TRANSPORTATION  
LAND TRANSPORTATION FACILITIES DIVISION

**9' x 8' CONC. BOX CULVERT**  
**AT STA. 453+87**

PLAN & SECTIONS - CULVERT INLET & OUTLET

F.A.I. Proj. No. I-H3-1(50)  
KANEHOE I.C. TO HALEKOU I.C.







Scale: As Noted Date: August 1987

SHEET No. 933 OF 935 SHEETS

"AS BUILT"



| FED. ROAD DIST. NO. | STATE | FED. AID PROJ. NO. | FISCAL YEAR | SHEET NO. | TOTAL SHEETS |
|---------------------|-------|--------------------|-------------|-----------|--------------|
| HAWAII              | HAW.  | I-H3-1(50)         | 1987        | C.O.11451 | 164          |

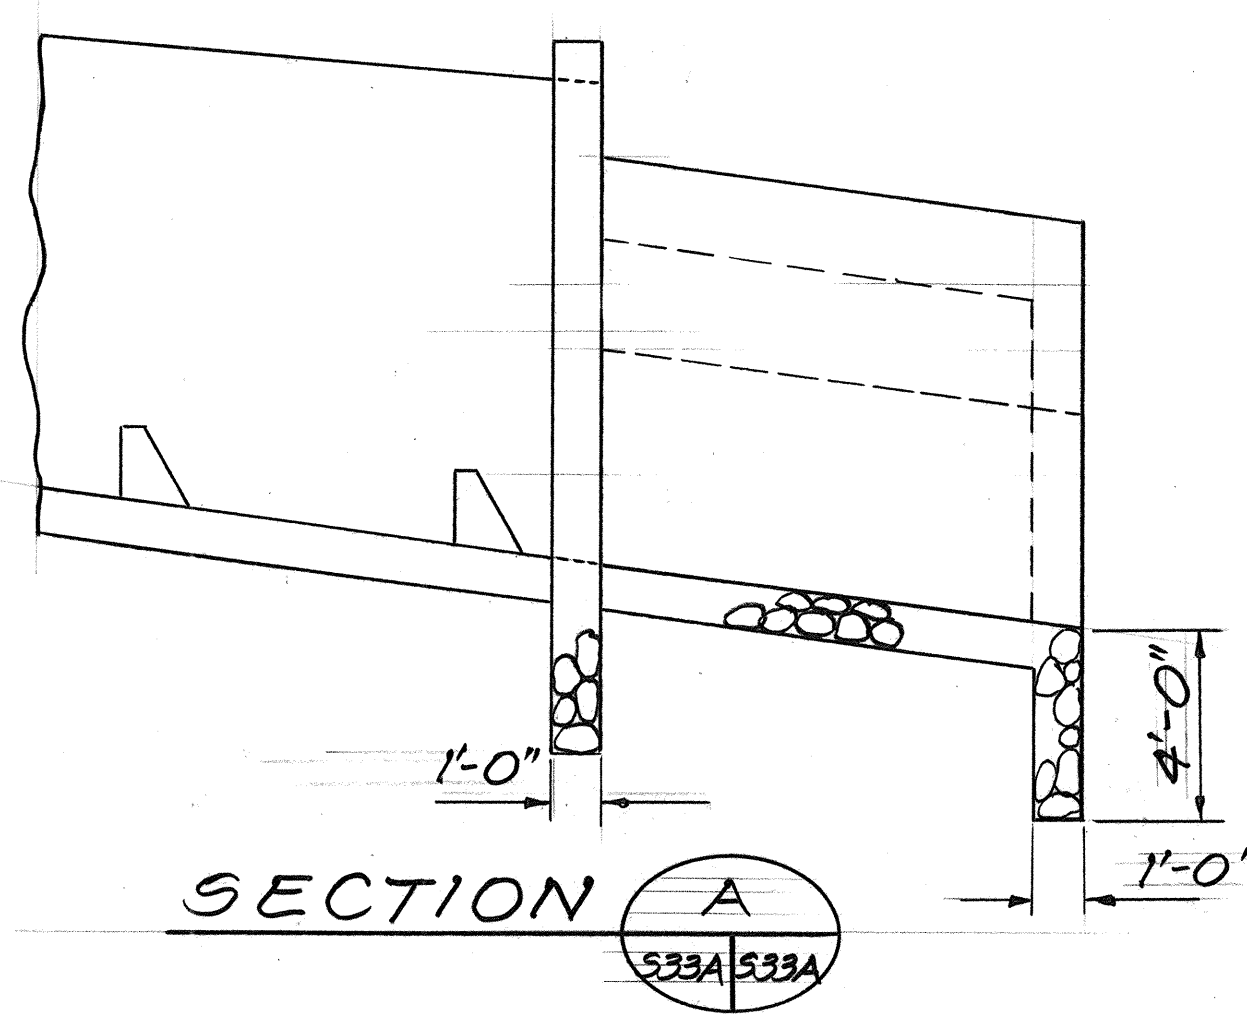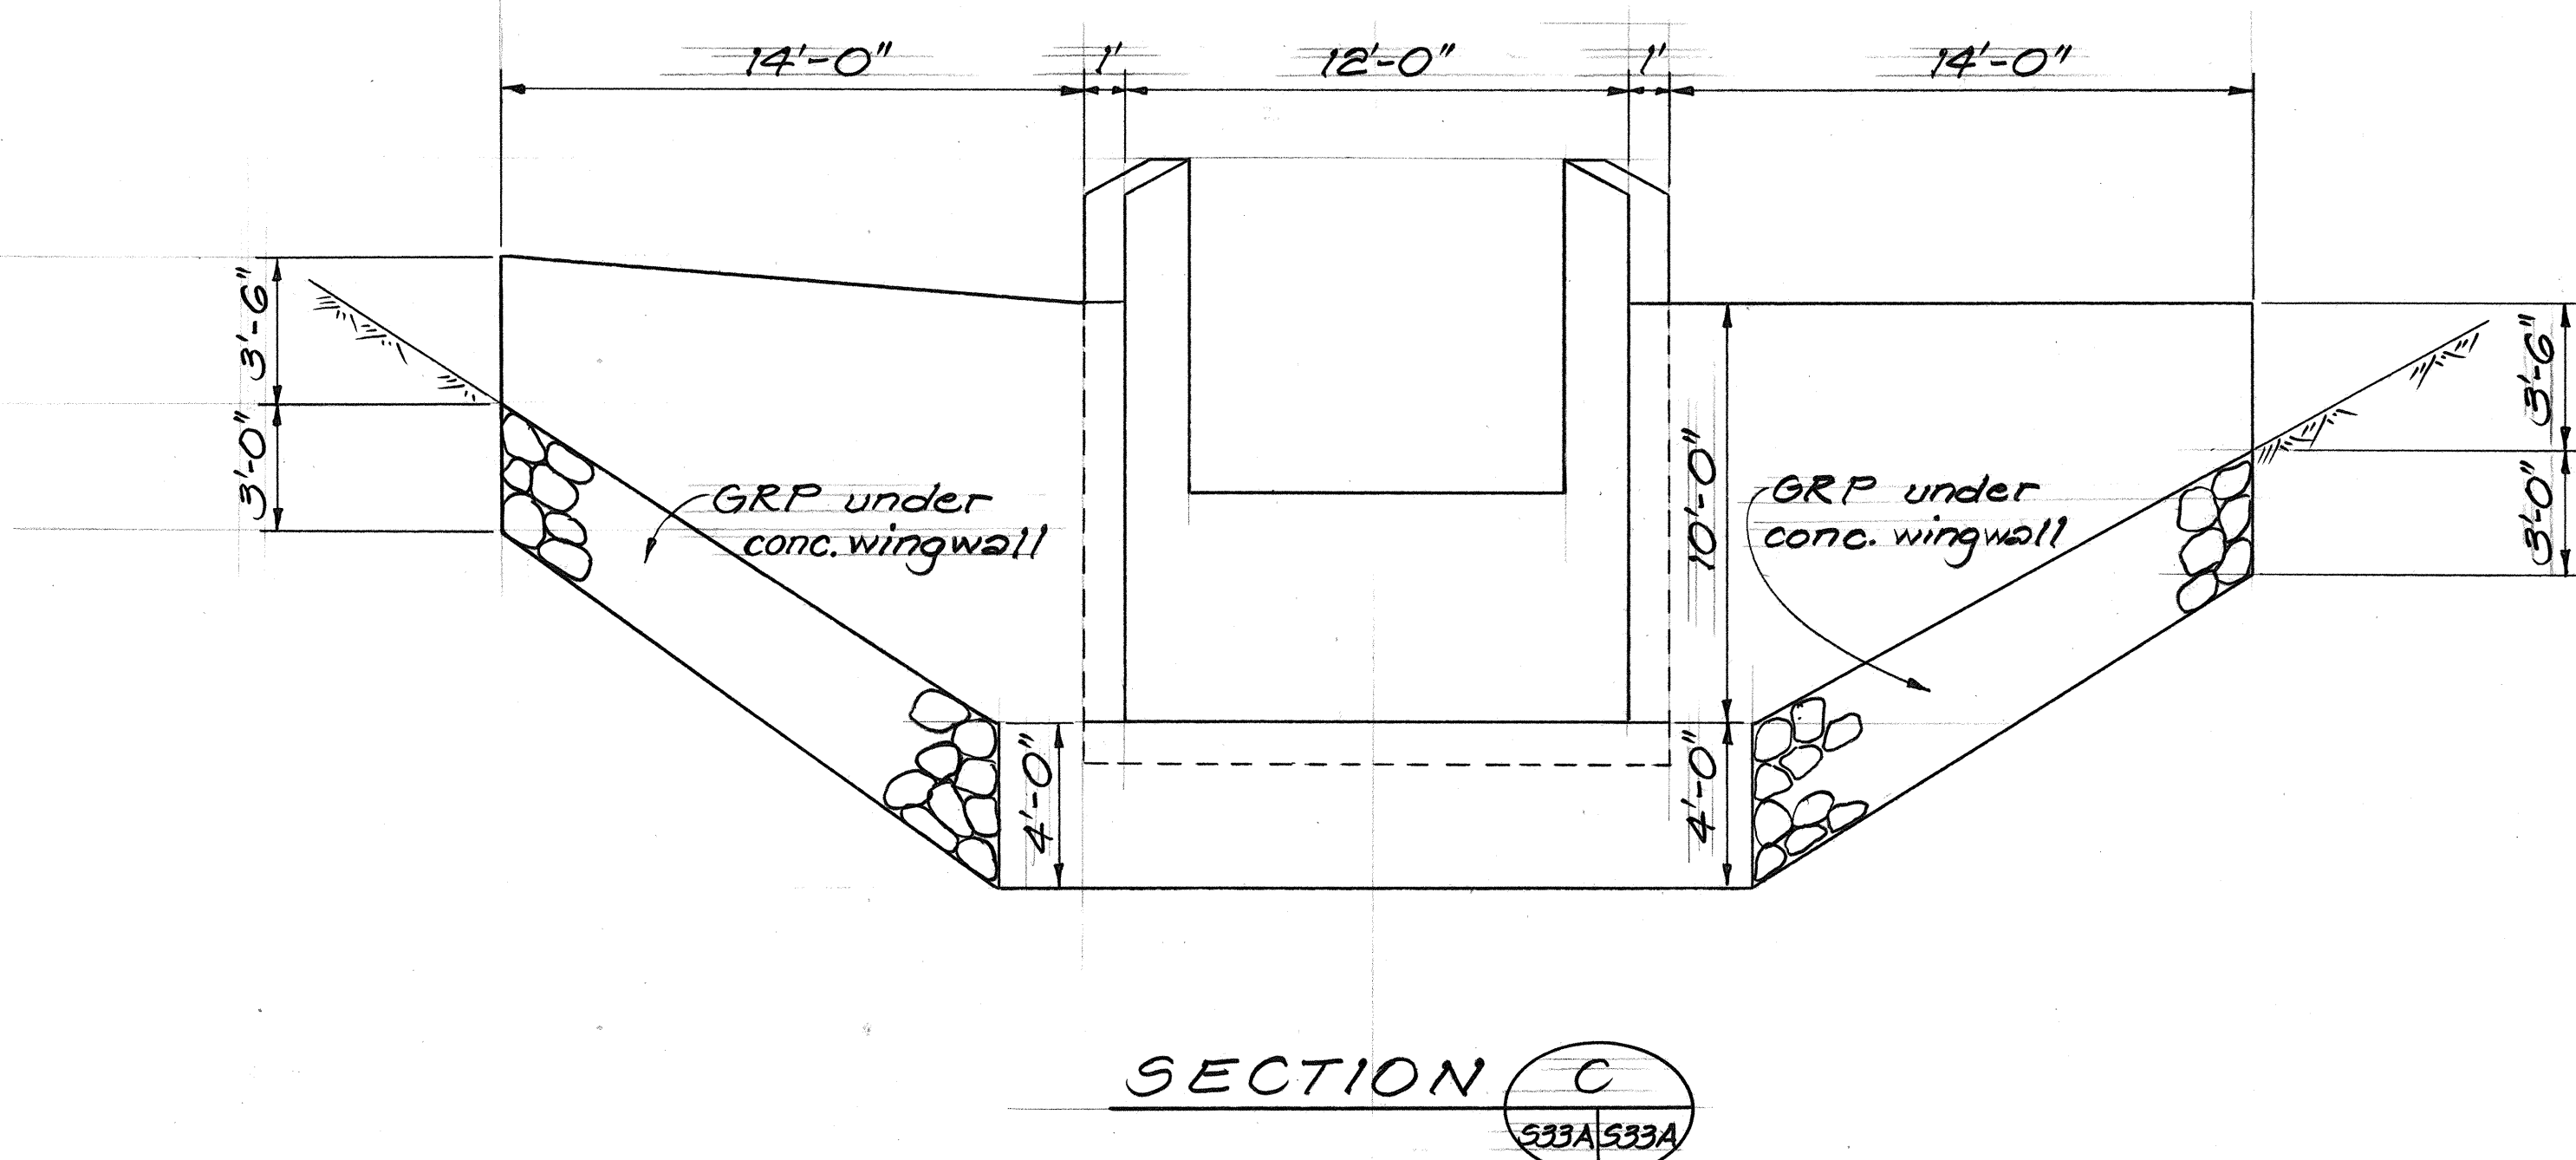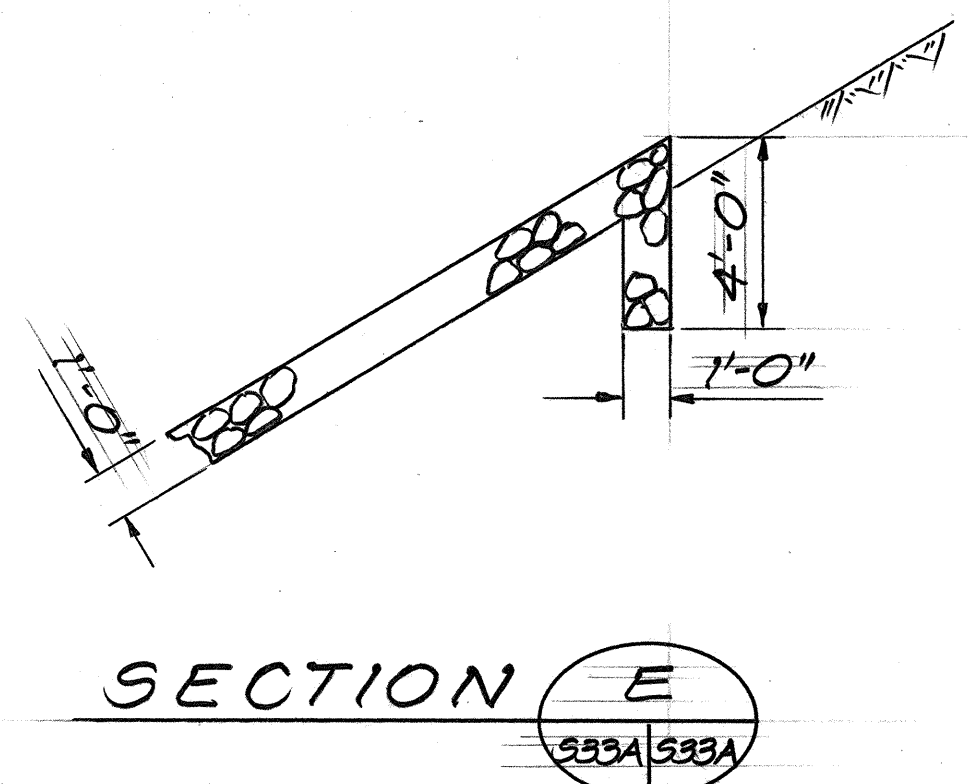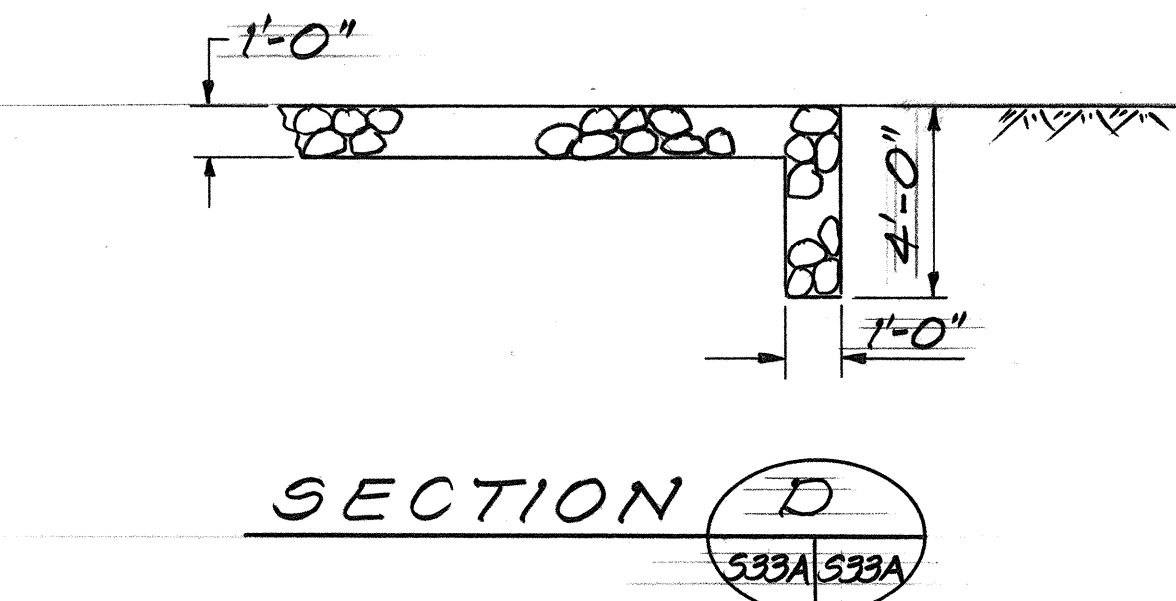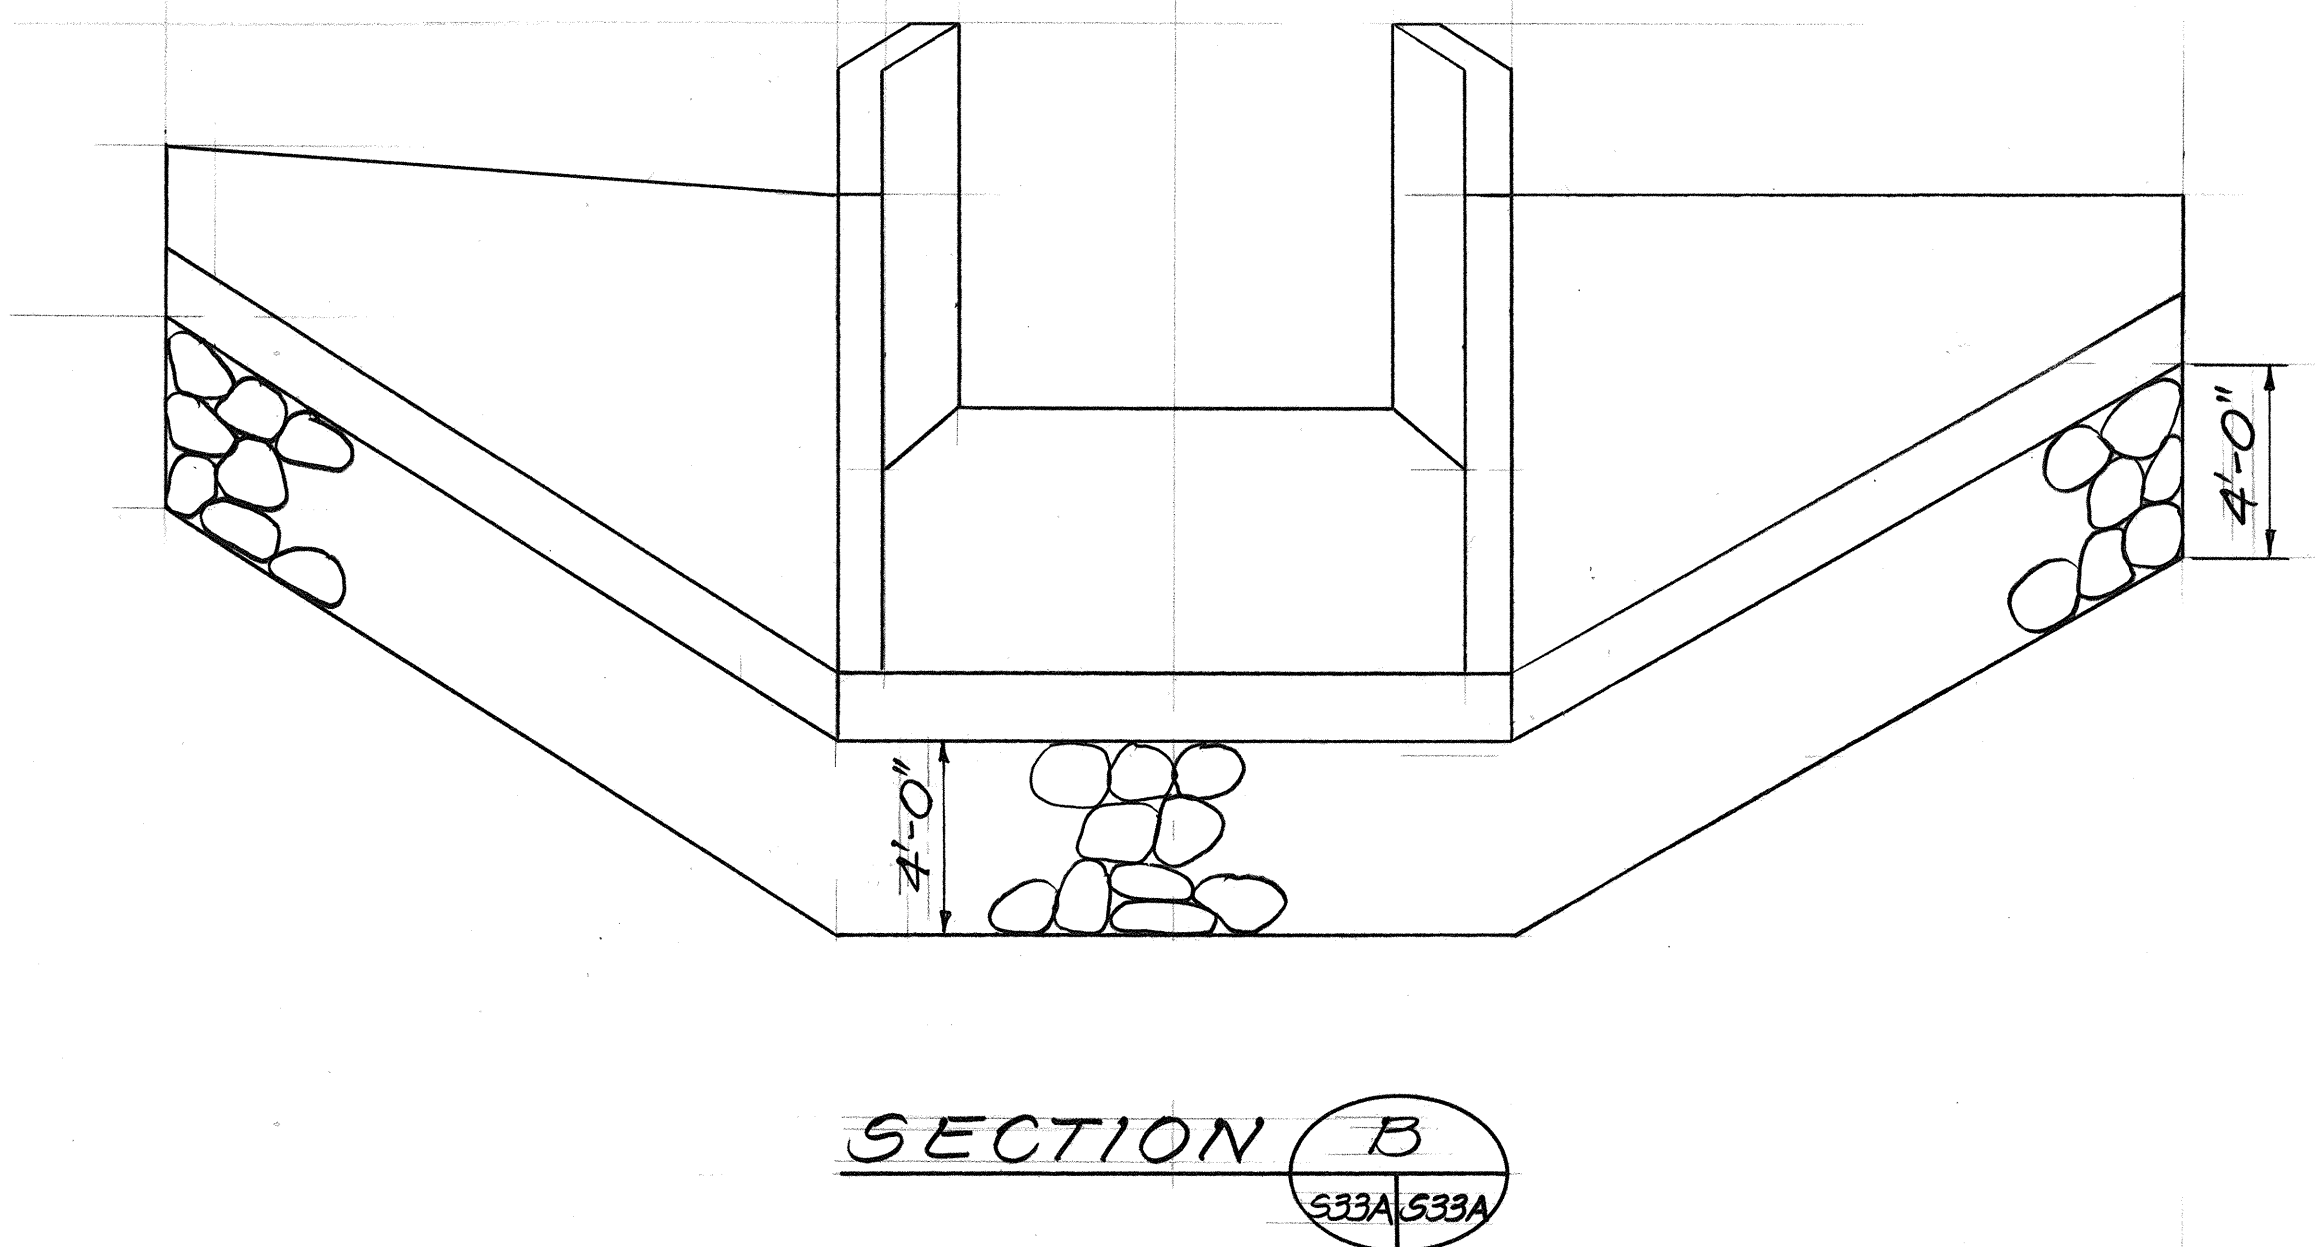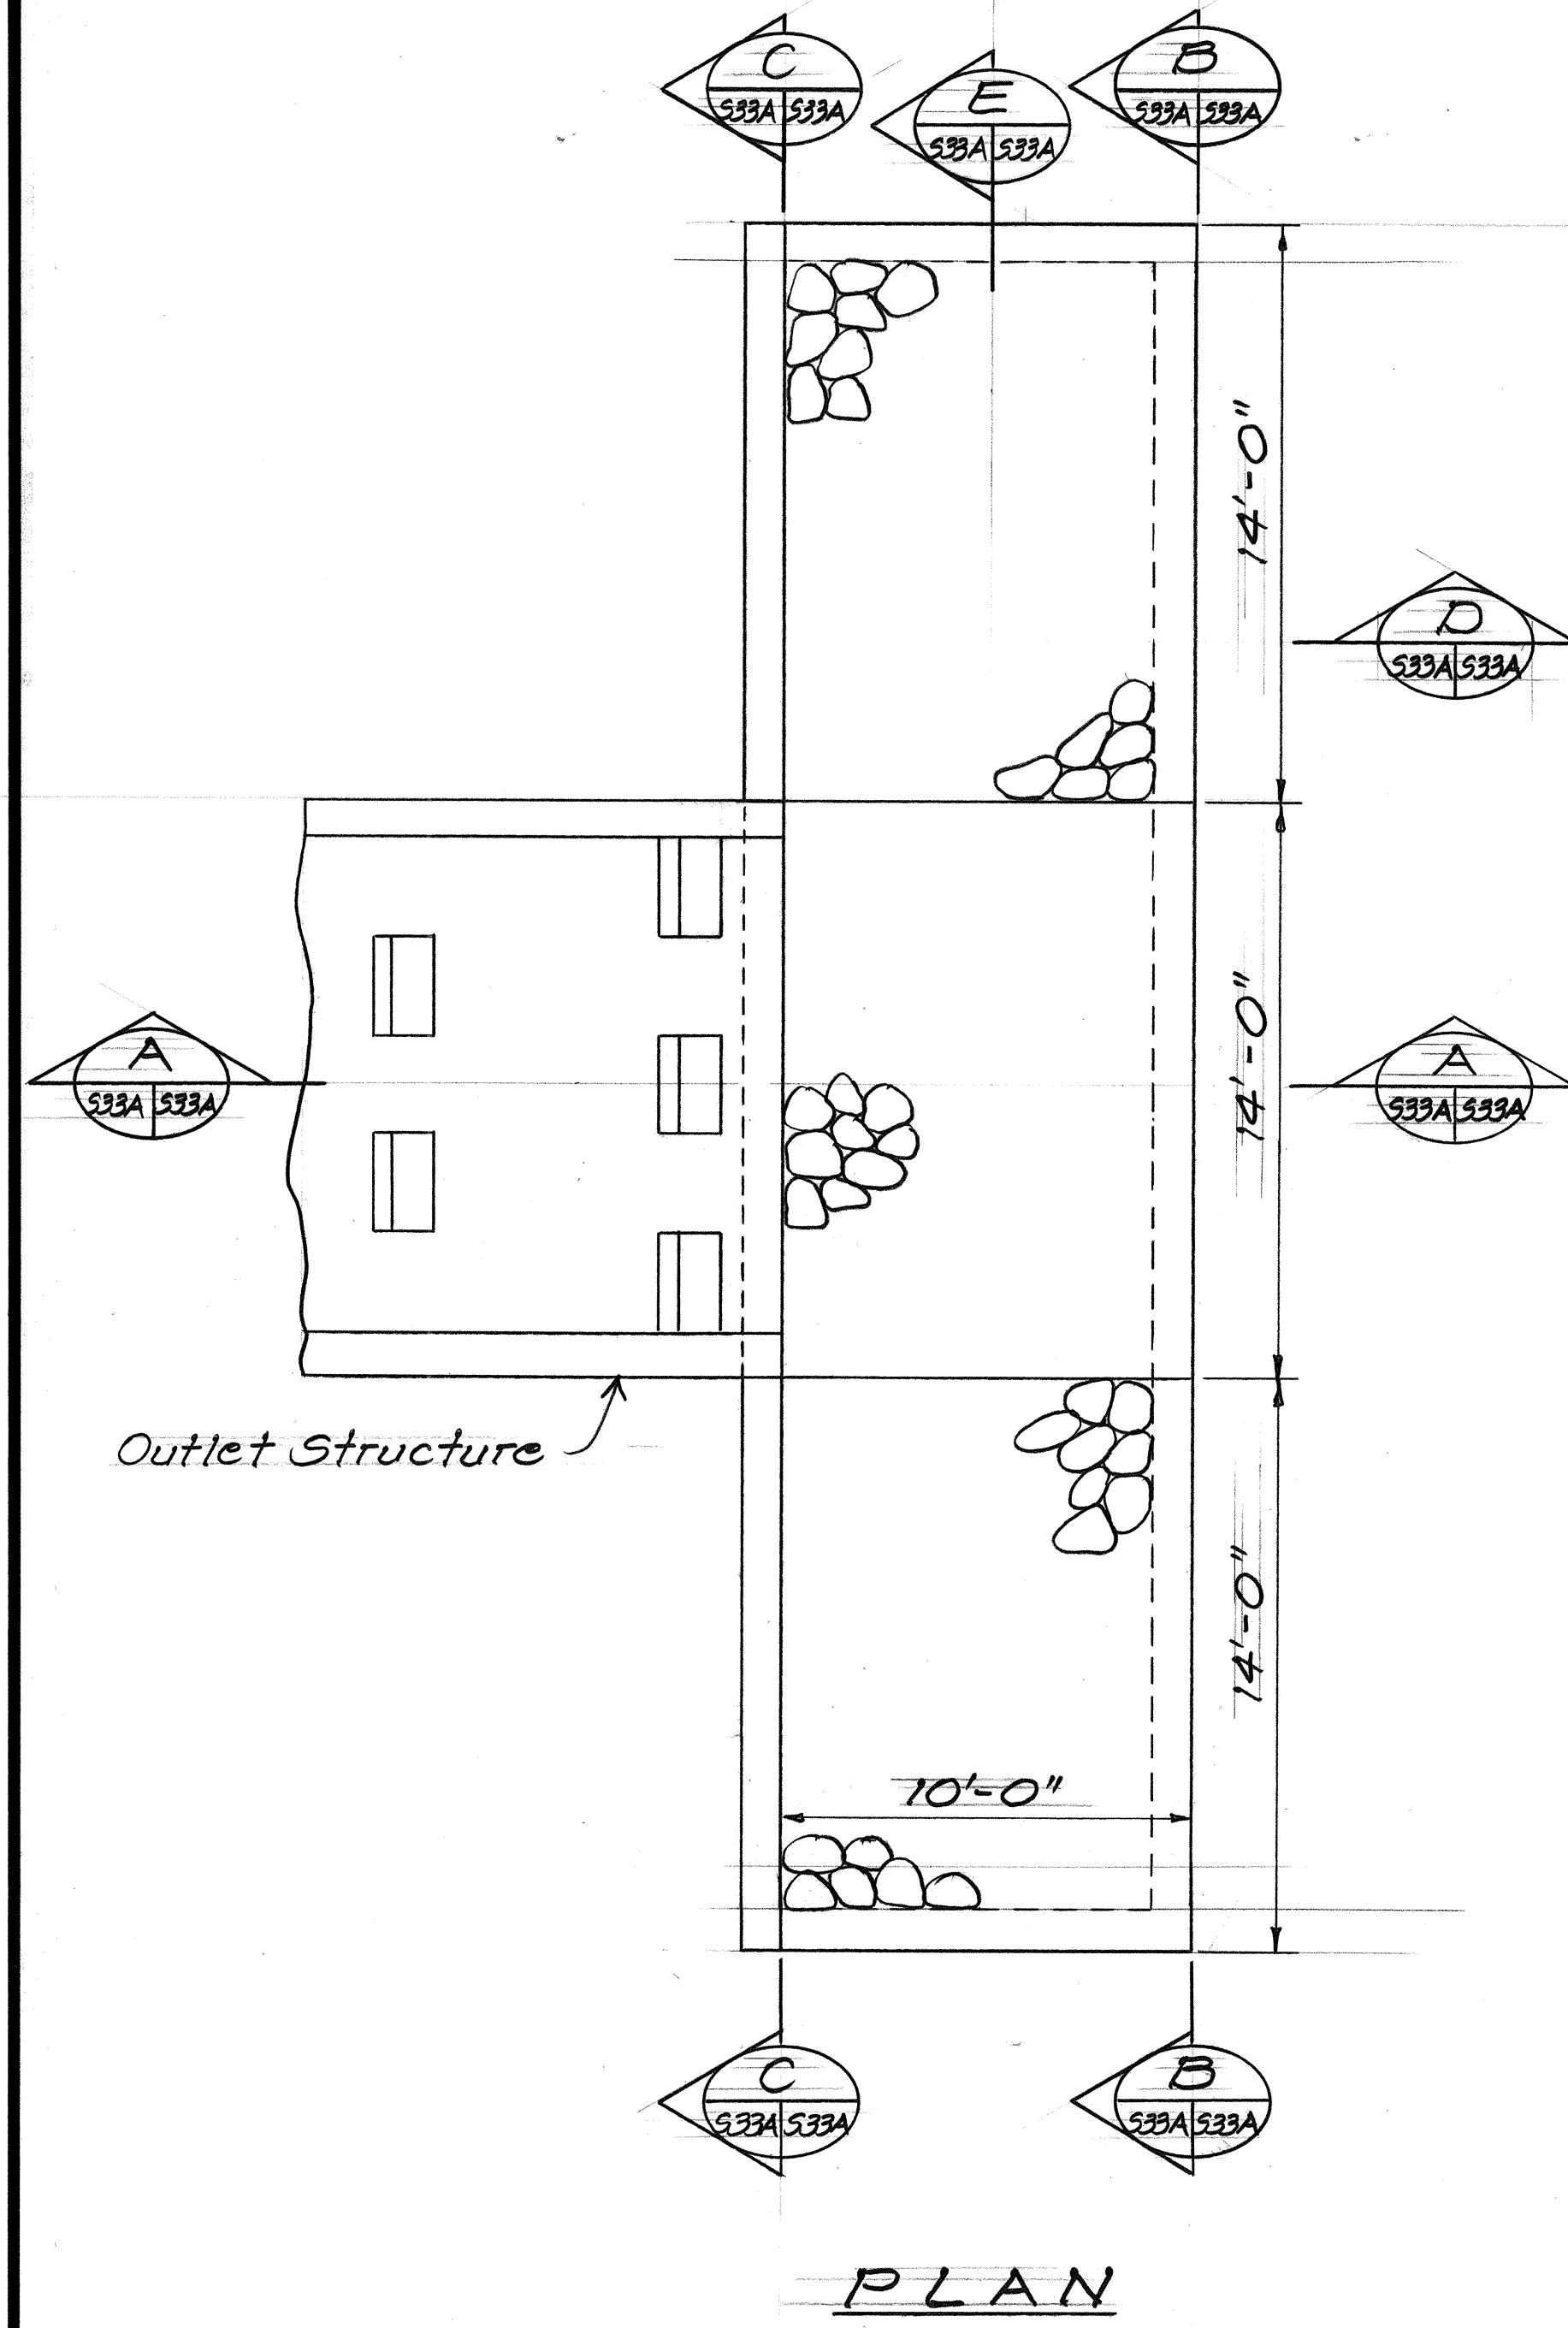

GRP DETAILS AT OUTLET STRUCTURE


|         |                                                      |
|---------|------------------------------------------------------|
| 5-30-90 | GRP Lining for Outlet Structure at Sta. 453 + 87 Lt. |
| DATE    | REVISION                                             |

|                                                                                                                                           |
|-------------------------------------------------------------------------------------------------------------------------------------------|
| STATE OF HAWAII<br>DEPARTMENT OF TRANSPORTATION<br>HIGHWAYS DIVISION                                                                      |
| 9'-0" x 8'-0" CONC. BOX CULVERT<br>AT STA. 453 + 87                                                                                       |
| PLAN & SECTS. - CULVERT INLET & OUTLET<br>F.A.I. Proj. No. I-H3-1(50)<br>KANELOHE I.C. TO HALEKOU I.C.<br>Scale: As Noted Date: Aug. 1987 |
| SHEET No. 533A OF 35 SHEETS                                                                                                               |



|                   |      |
|-------------------|------|
| SURVEY PLOTTED BY | DATE |
| DRAWN BY          |      |
| TRACED BY         |      |
| NOTED BY          |      |
| CHECKED BY        |      |
| NO.               |      |




| FED. ROAD DIST. NO. | STATE | FED. AID PROJ. NO. | FISCAL YEAR | SHEET NO. | TOTAL SHEETS |
|---------------------|-------|--------------------|-------------|-----------|--------------|
| HAWAII              | HAW.  | I-H3-1(50)         | 1989        | 115       | 164          |

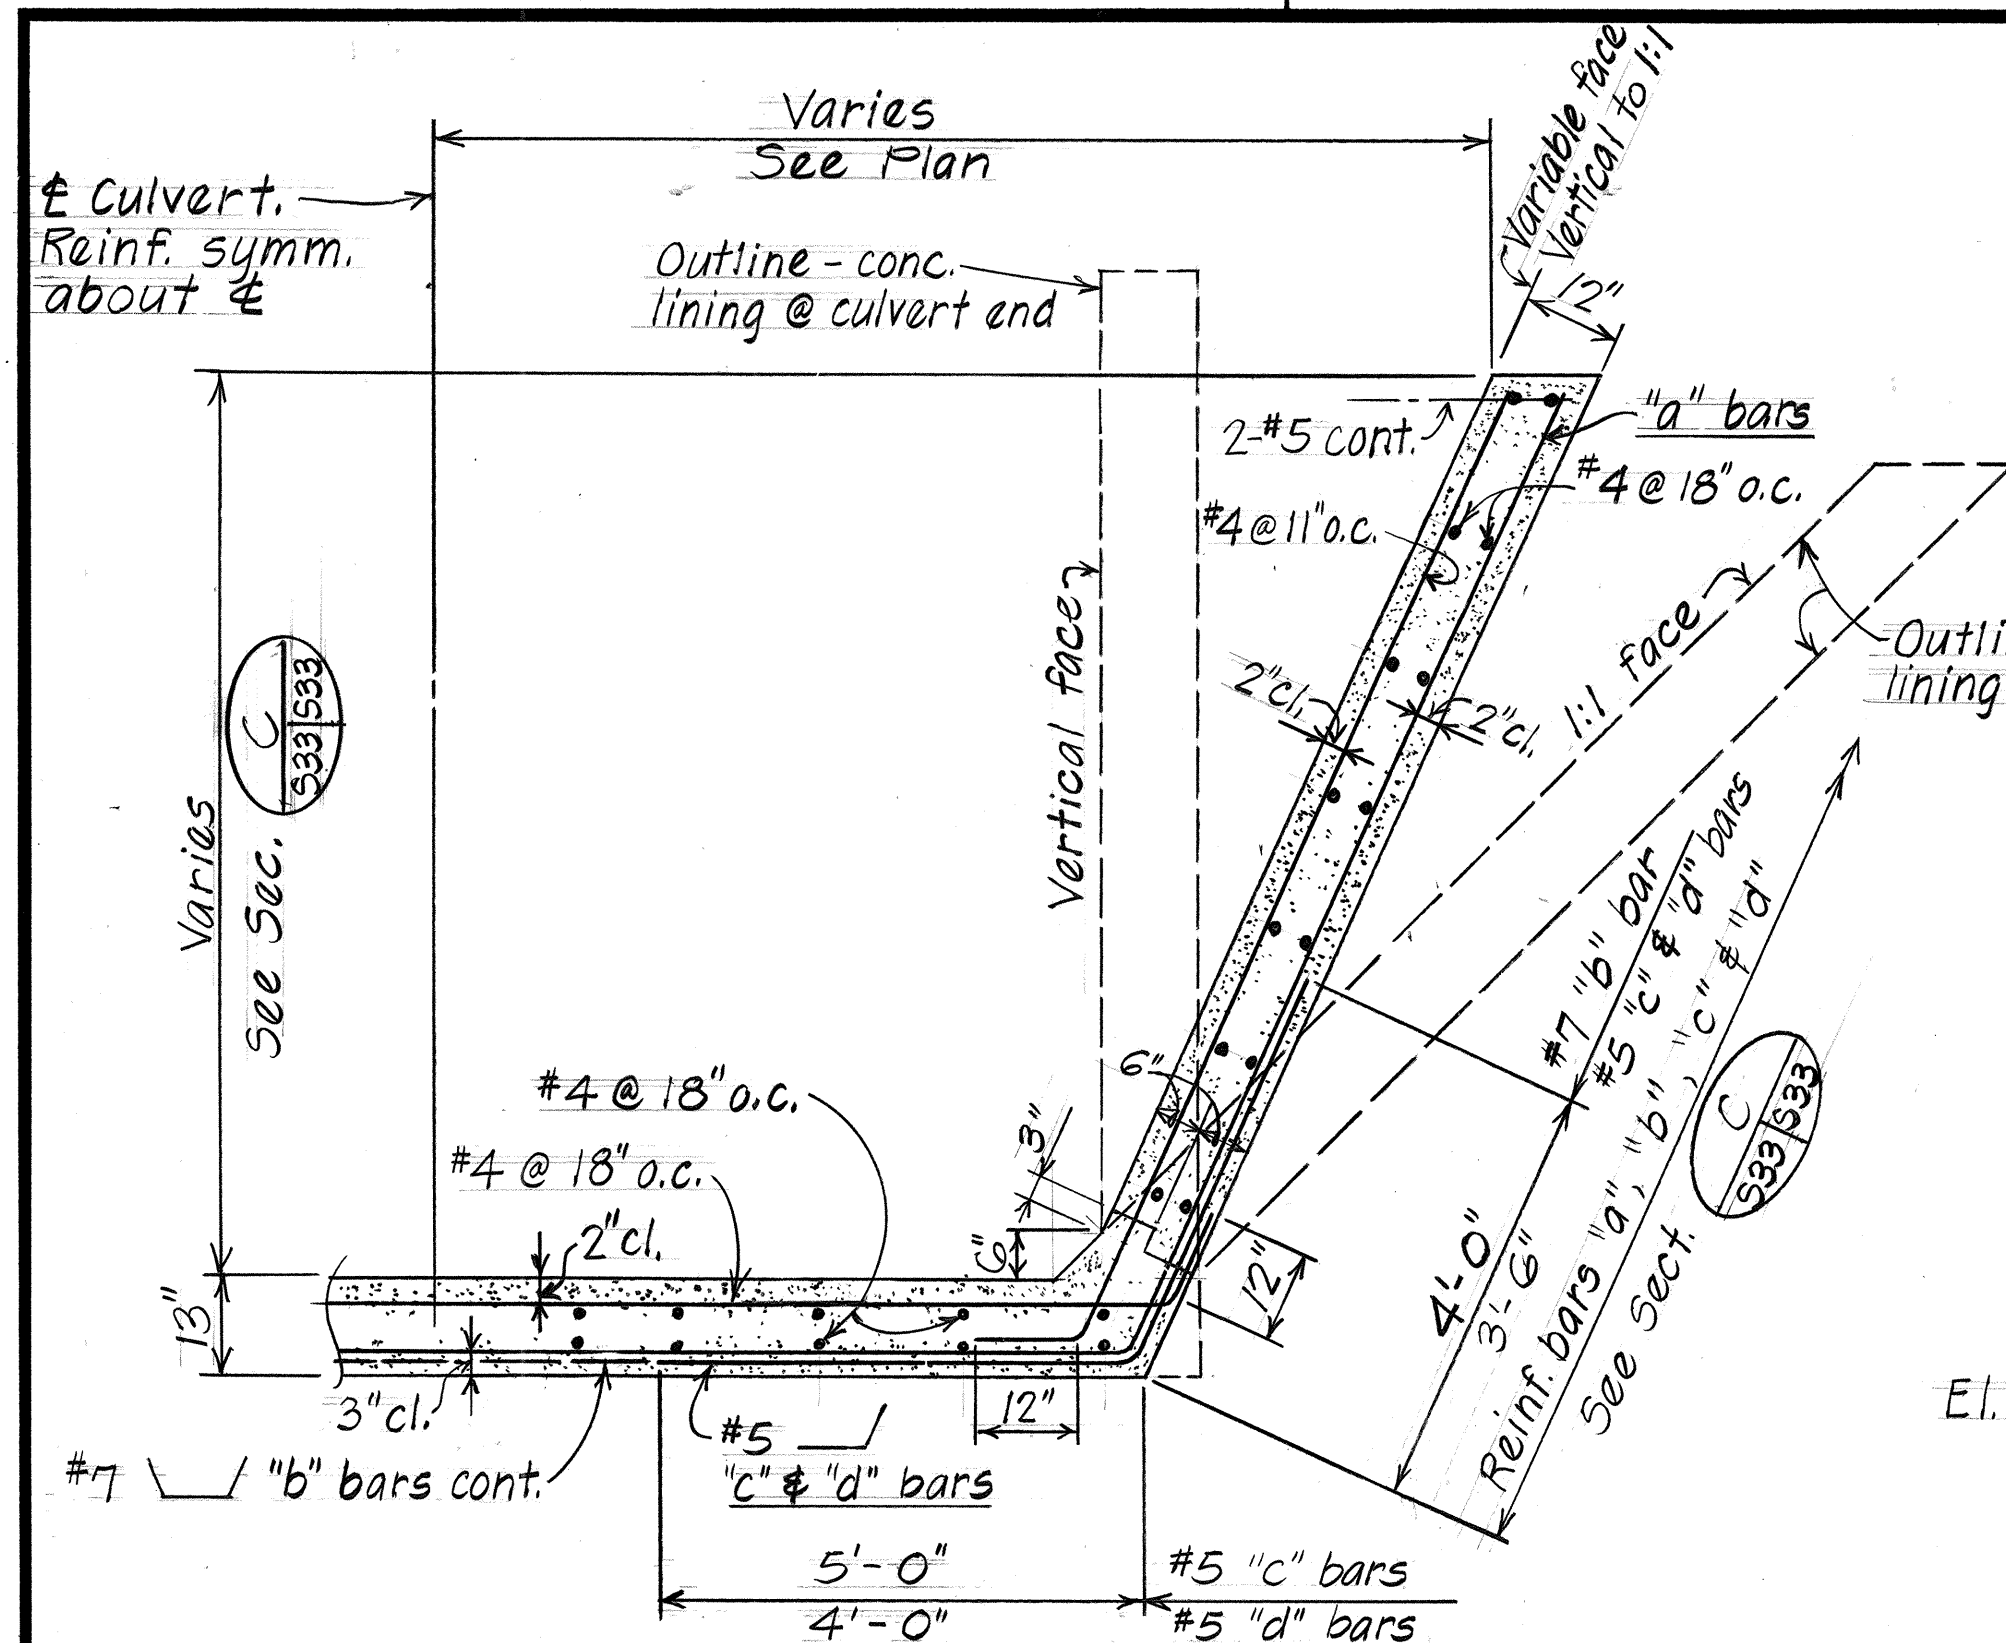


**TYPICAL INTAKE SECTION**  
SLOPING CONCRETE LINING  
Scale: 1/2" = 1'-0"

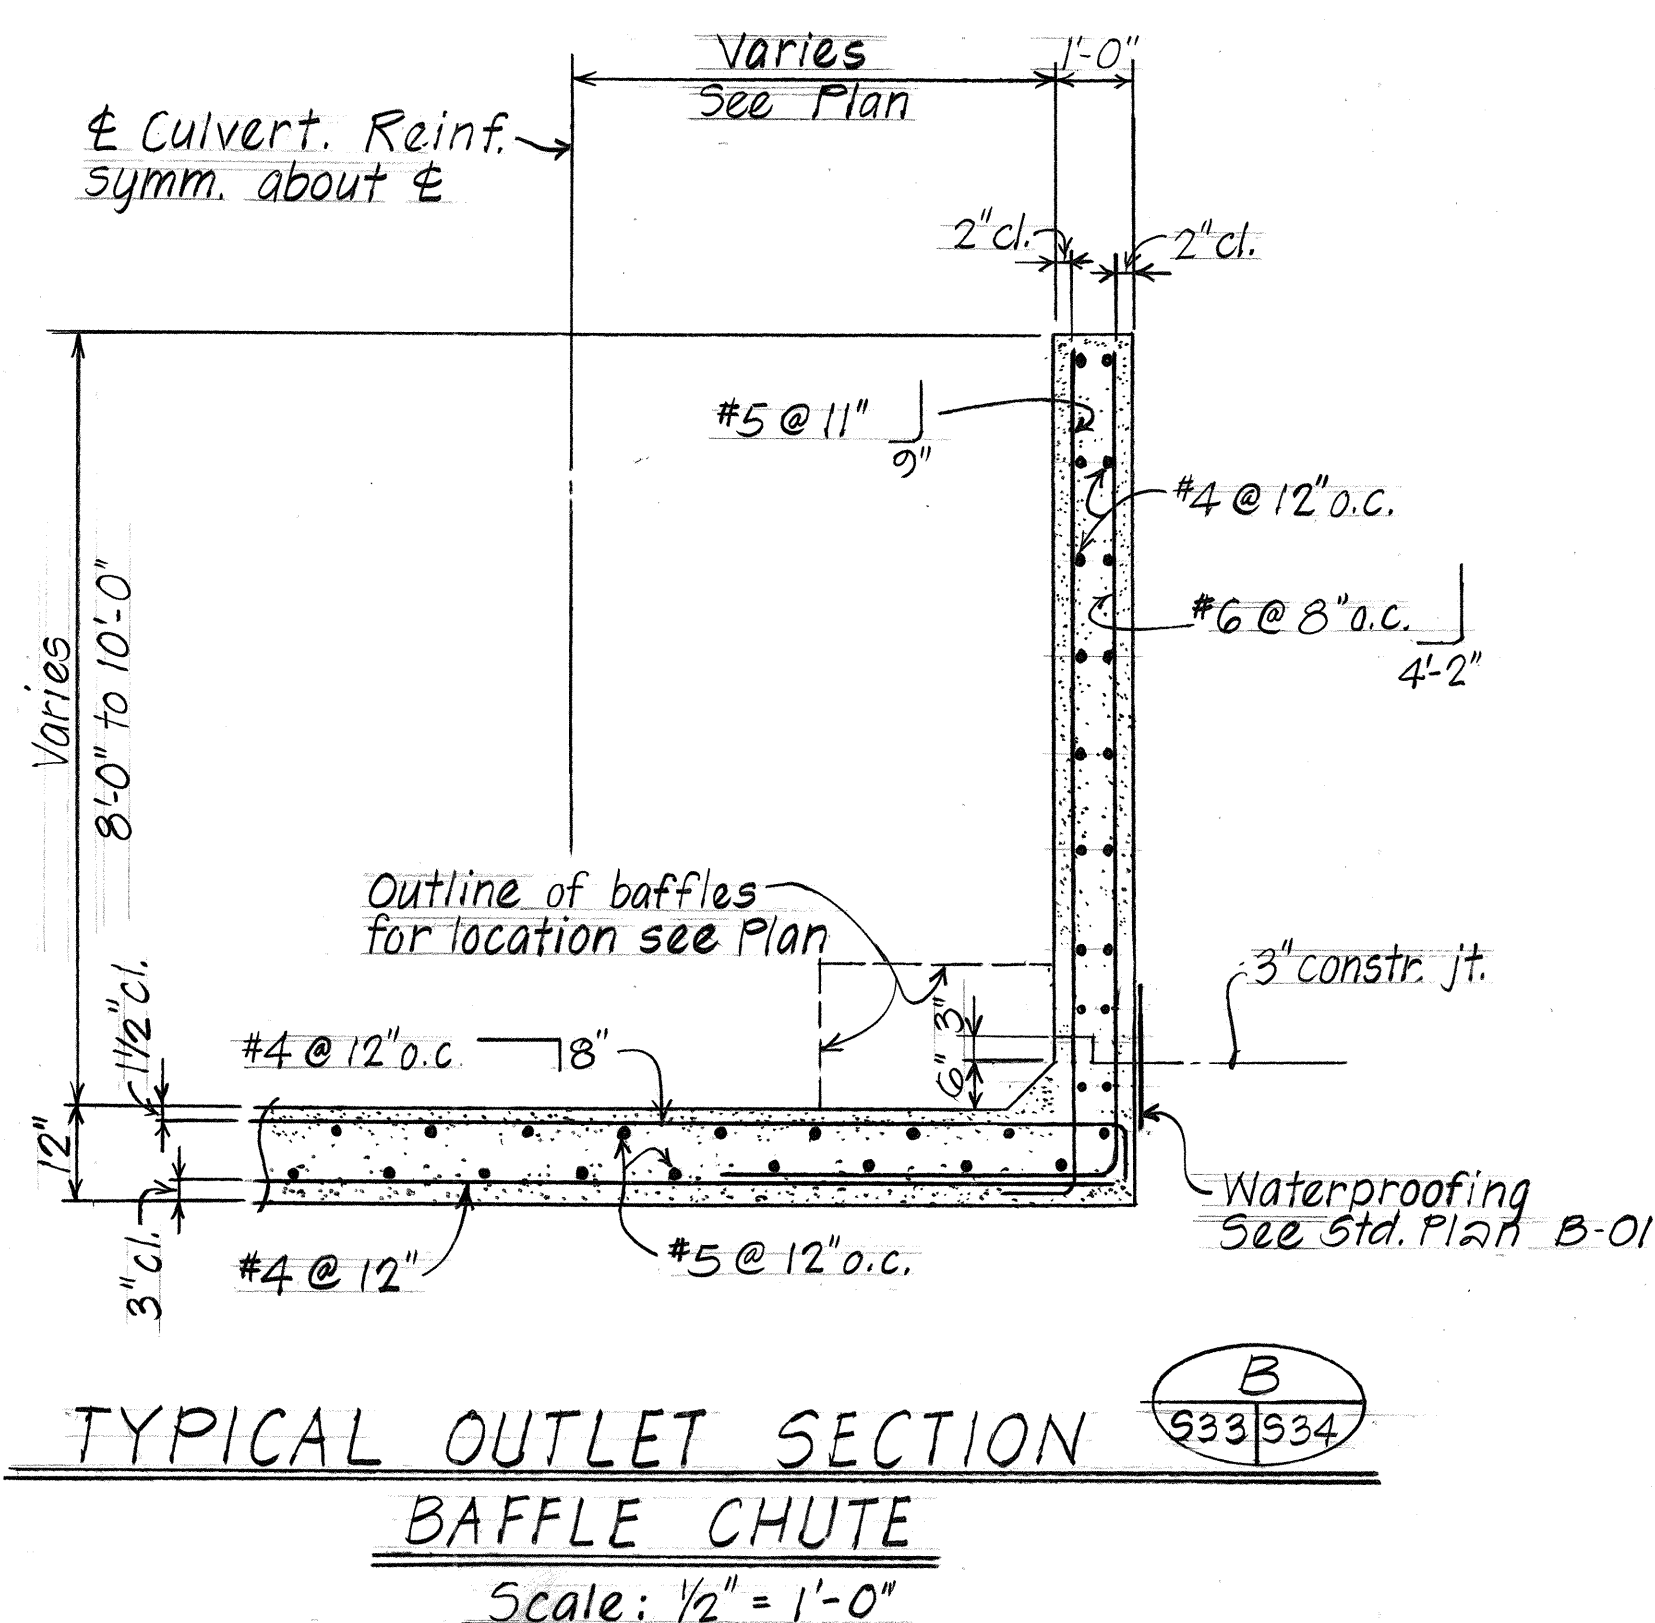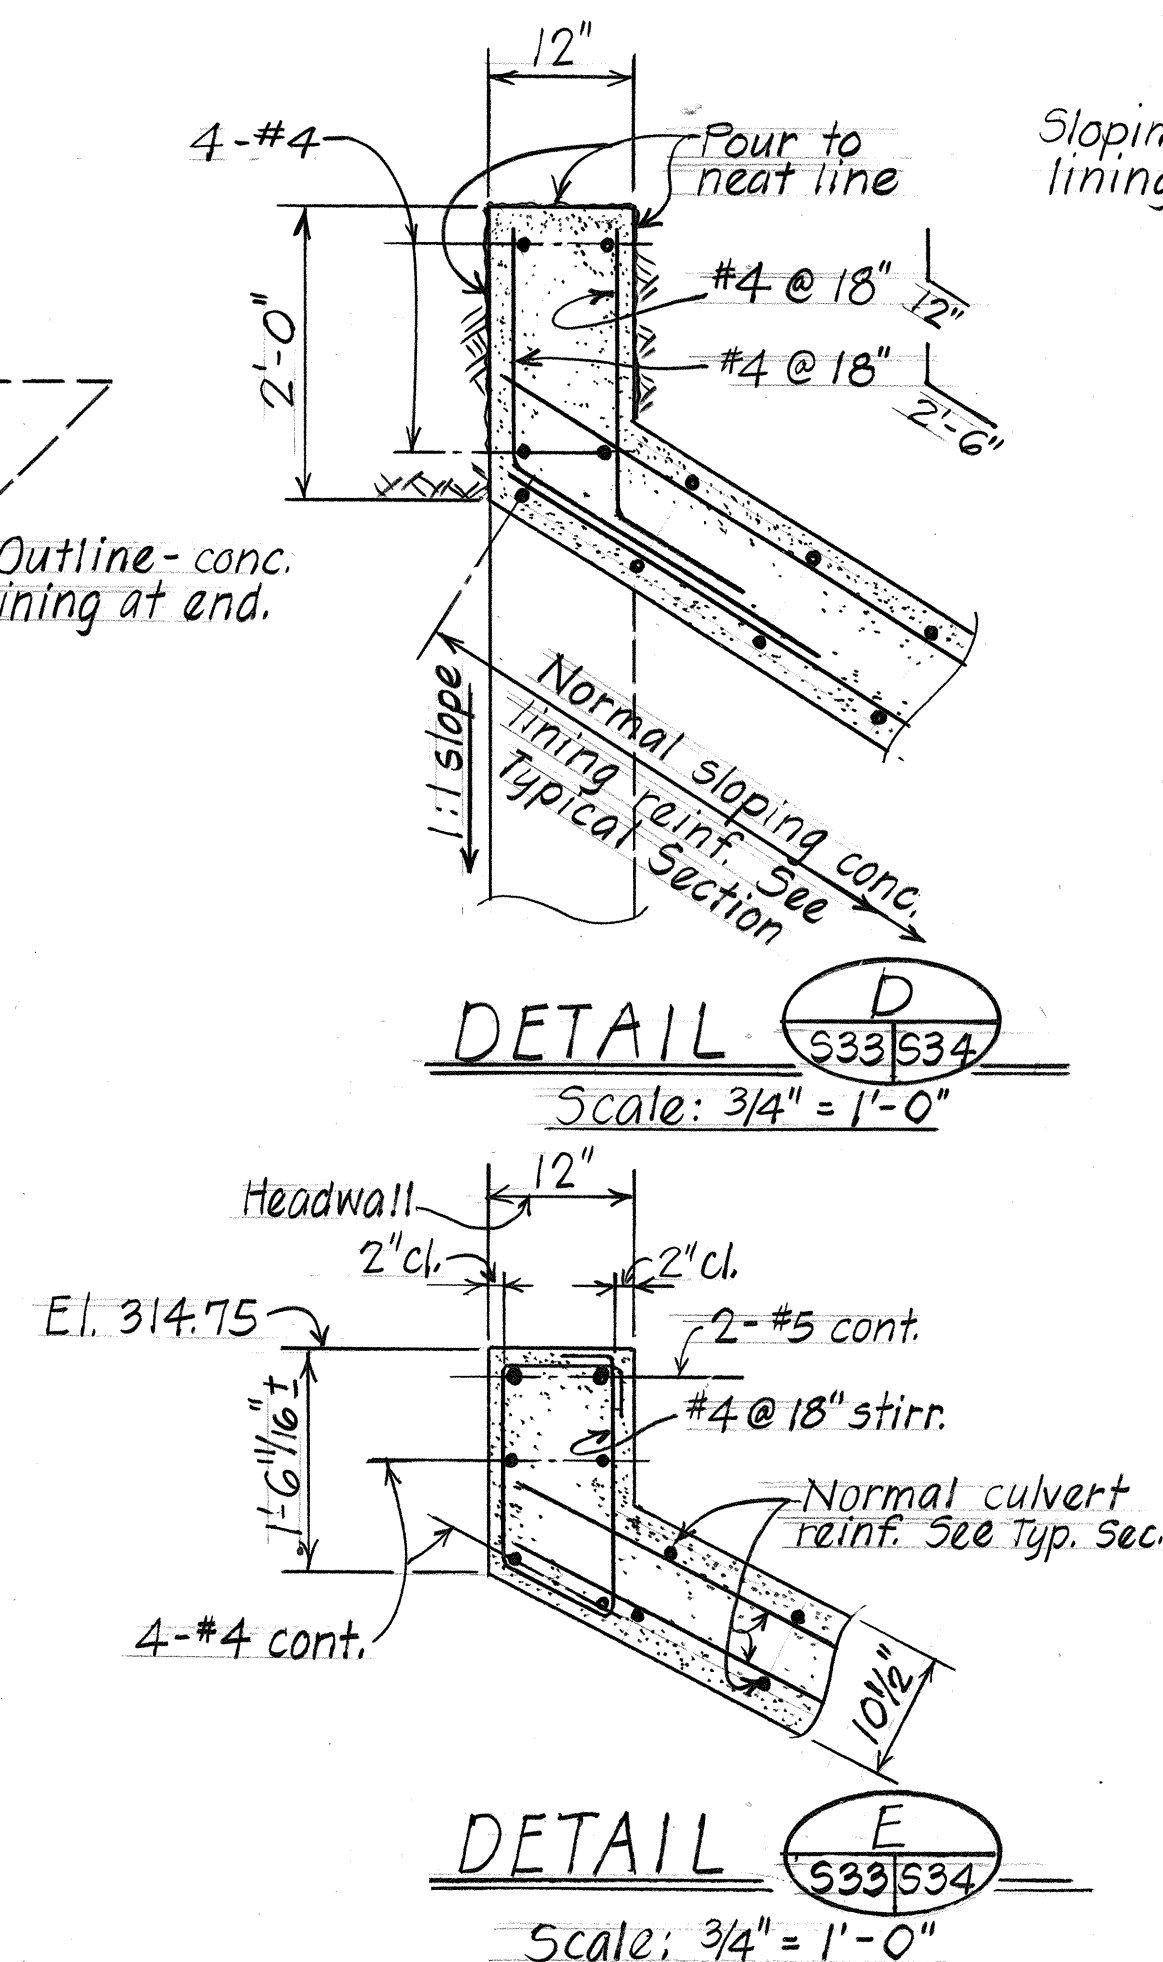


**TYPICAL OUTLET SECTION**  
BAFFLE CHUTE  
Scale: 1/2" = 1'-0"

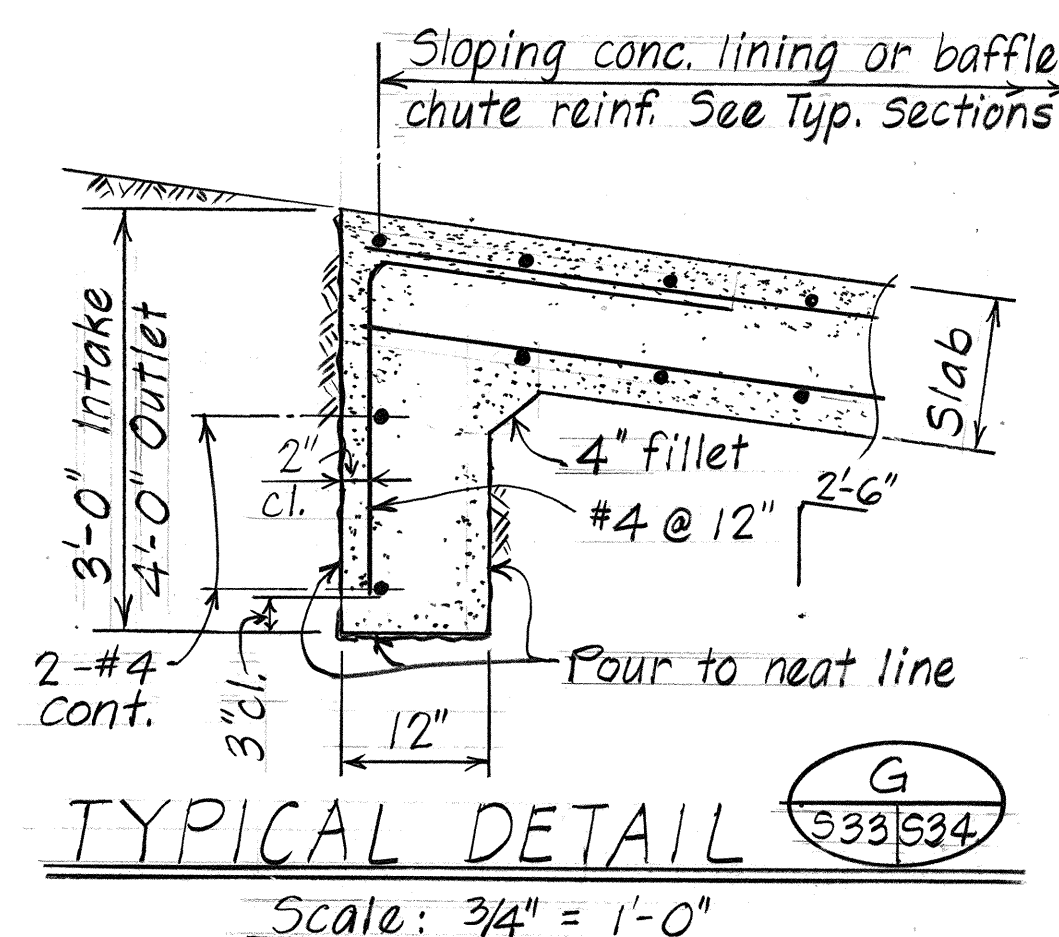


**TYPICAL DETAIL**  
Scale: 3/4" = 1'-0"

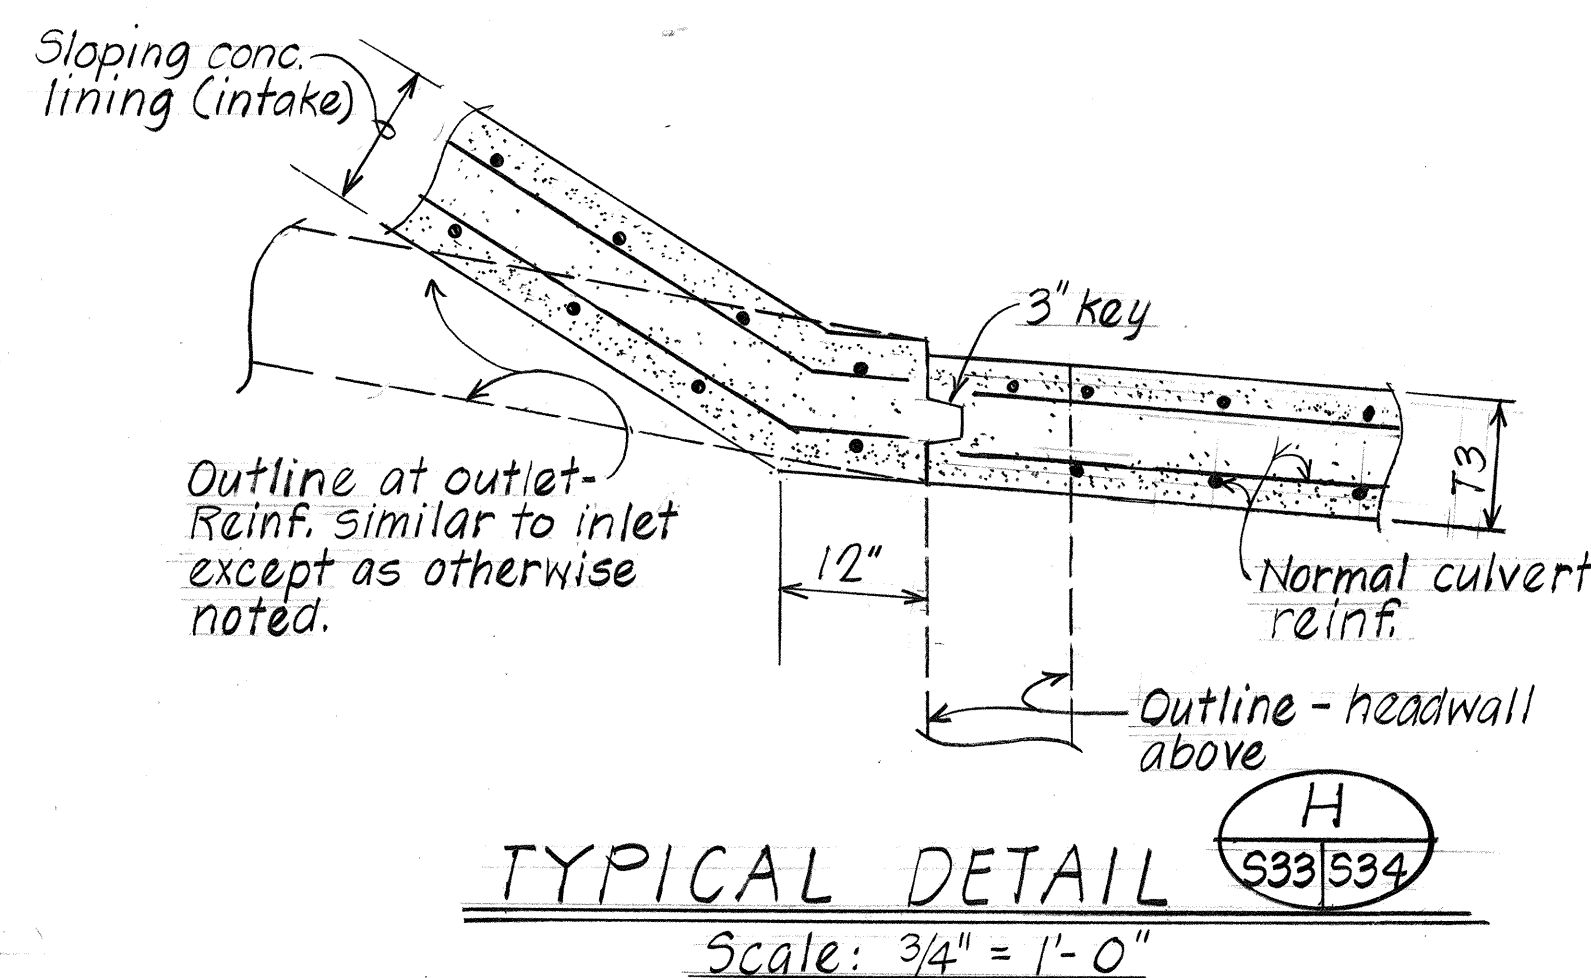


**TYPICAL DETAIL**  
Scale: 3/4" = 1'-0"

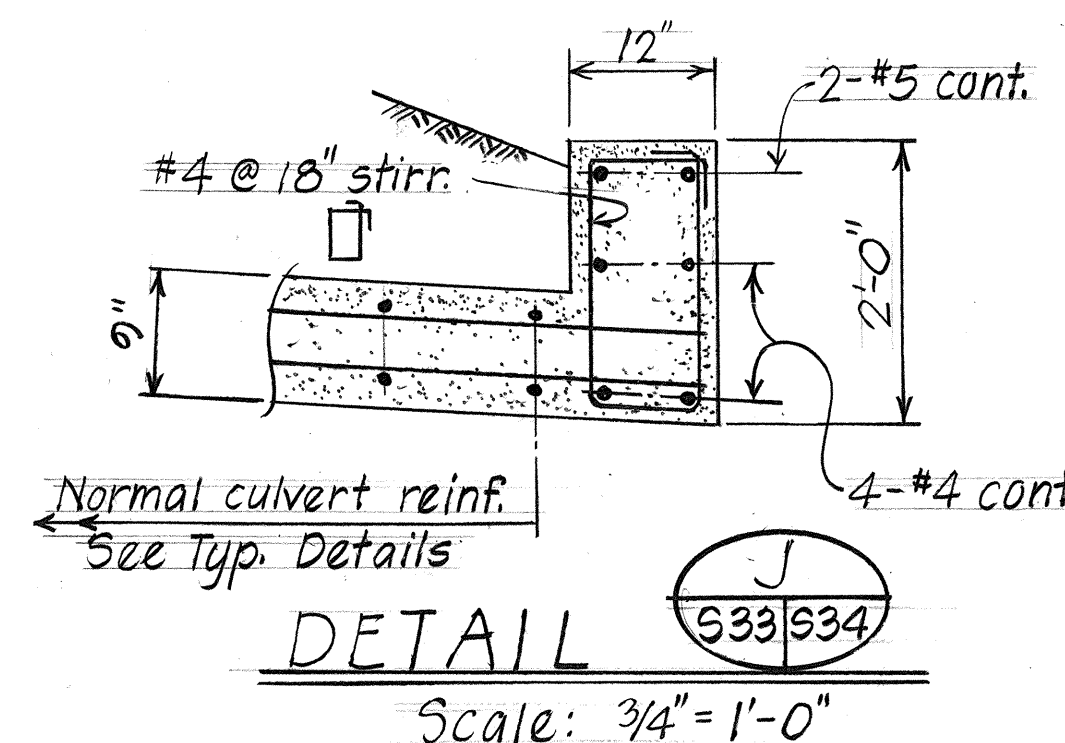


**TYPICAL DETAIL**  
Scale: 3/4" = 1'-0"

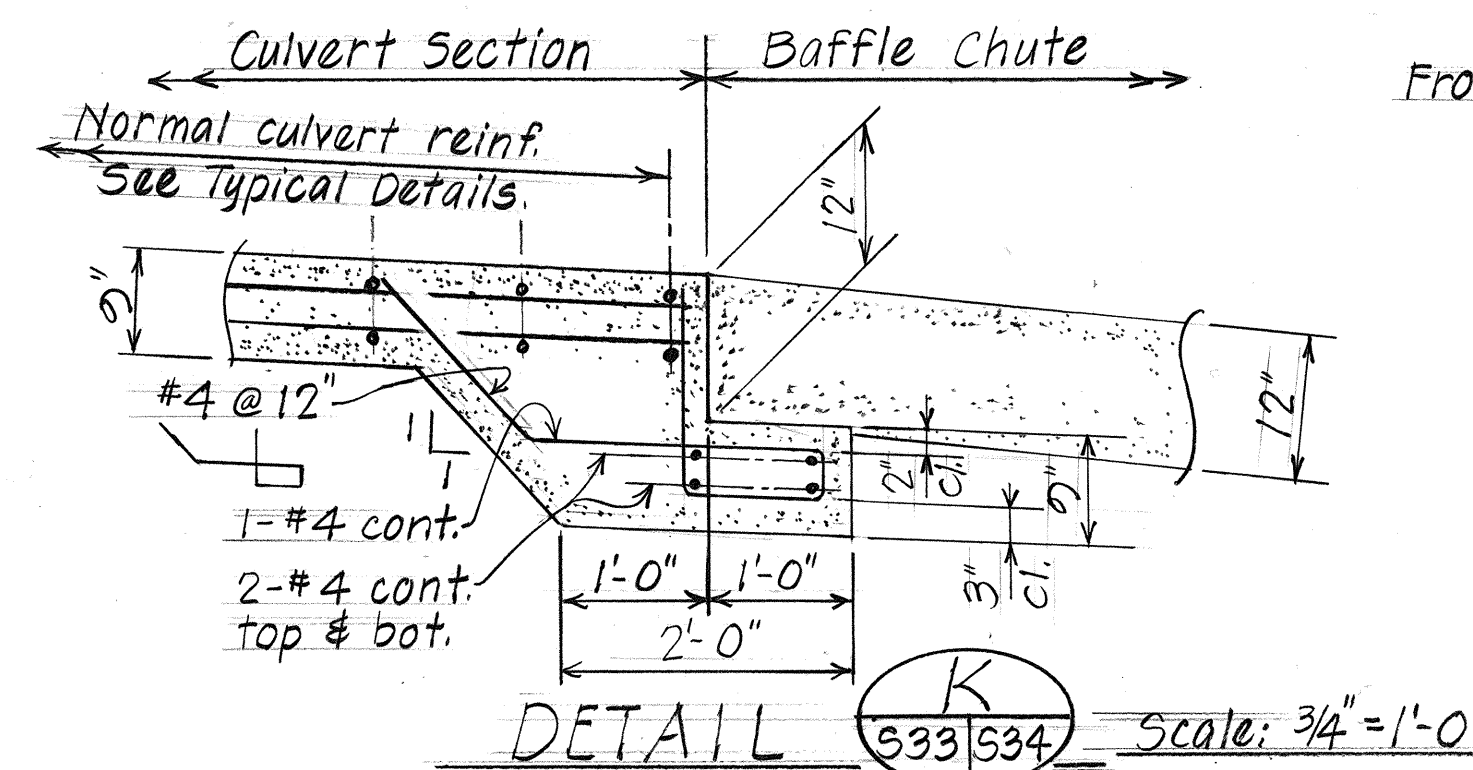


**TYPICAL DETAIL**  
Scale: 3/4" = 1'-0"

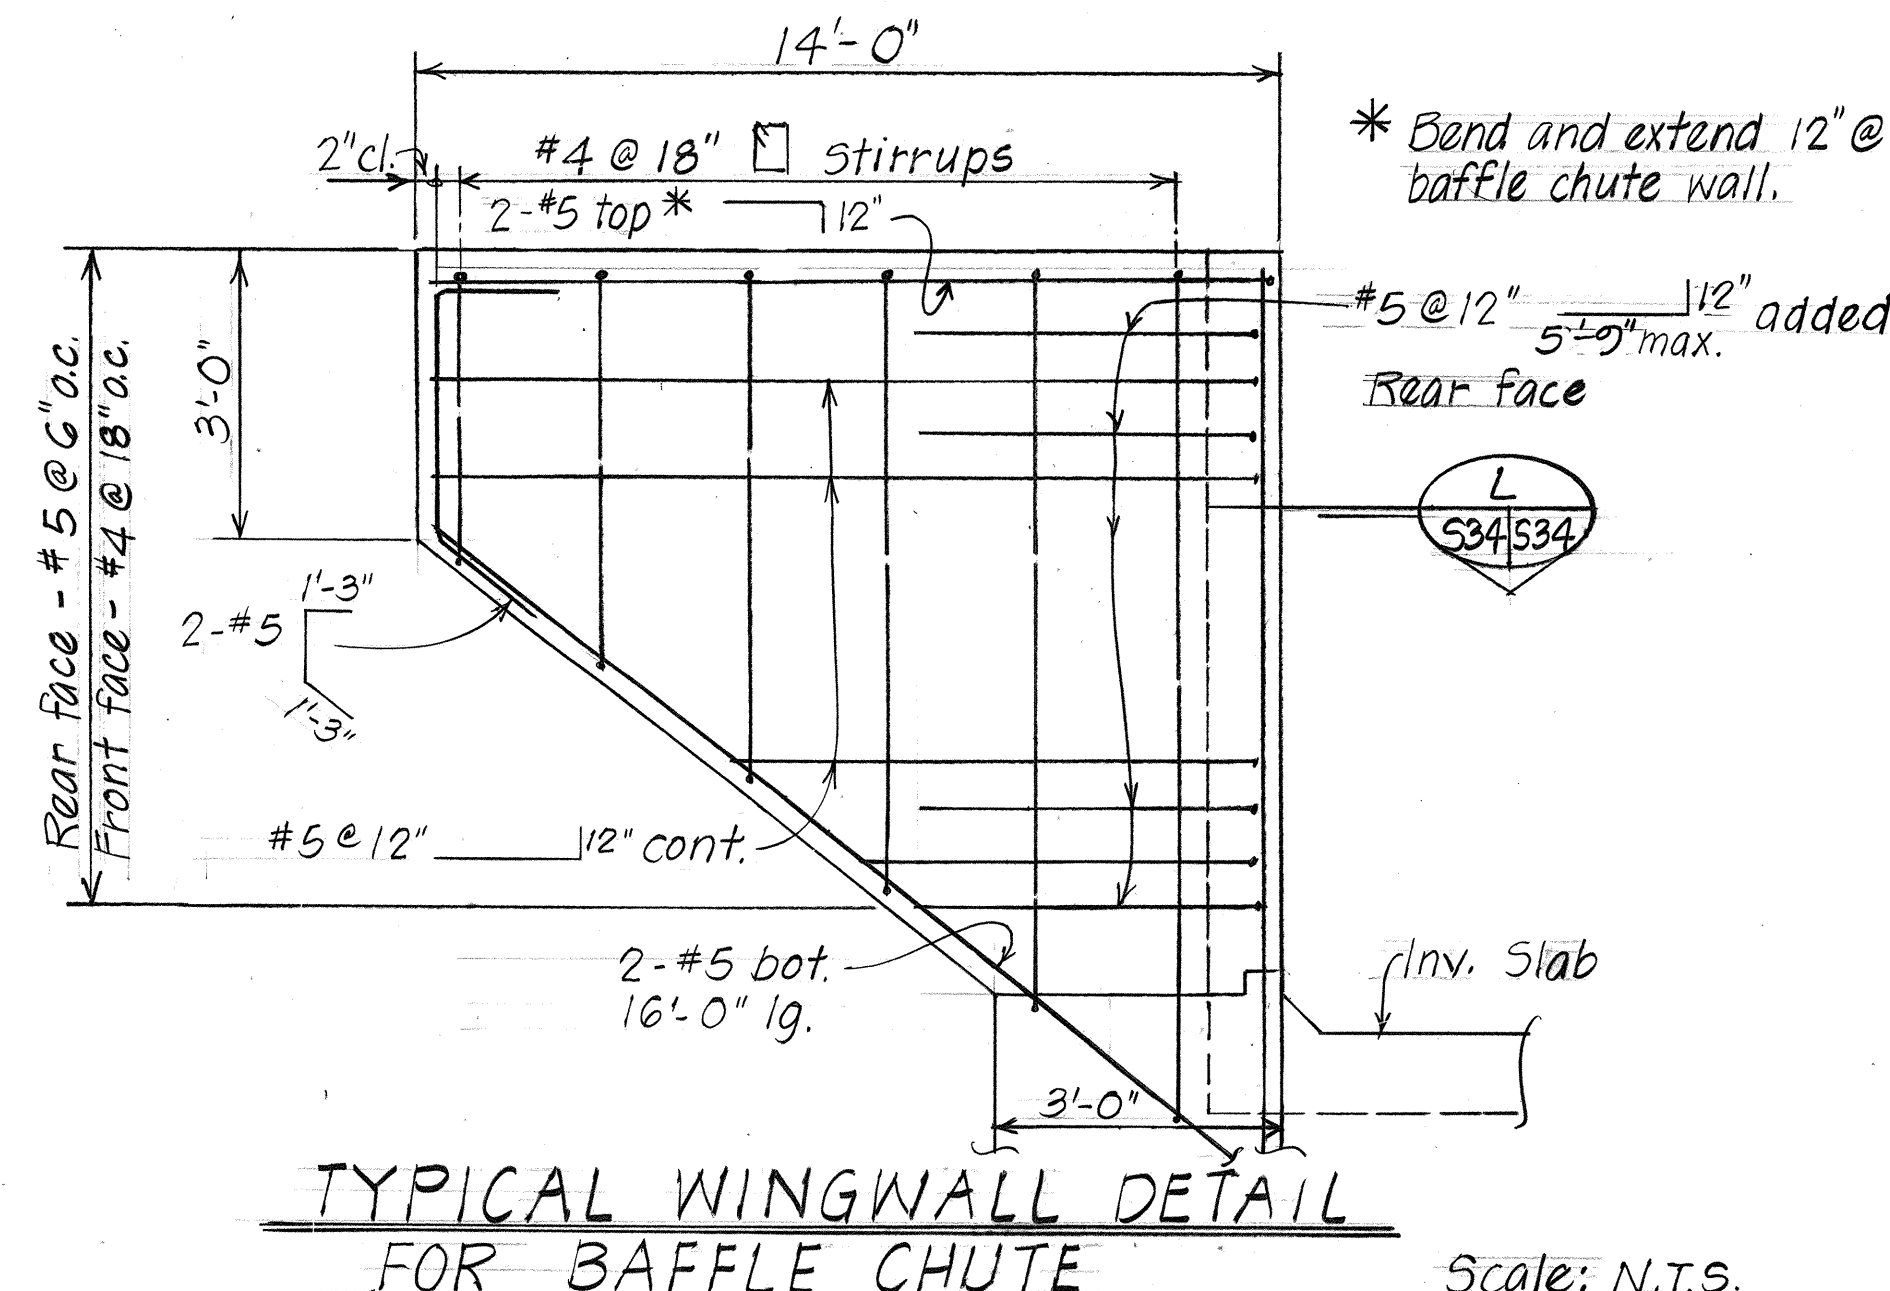

**TYPICAL WINGWALL DETAIL**  
FOR BAFFLE CHUTE  
Scale: N.T.S.

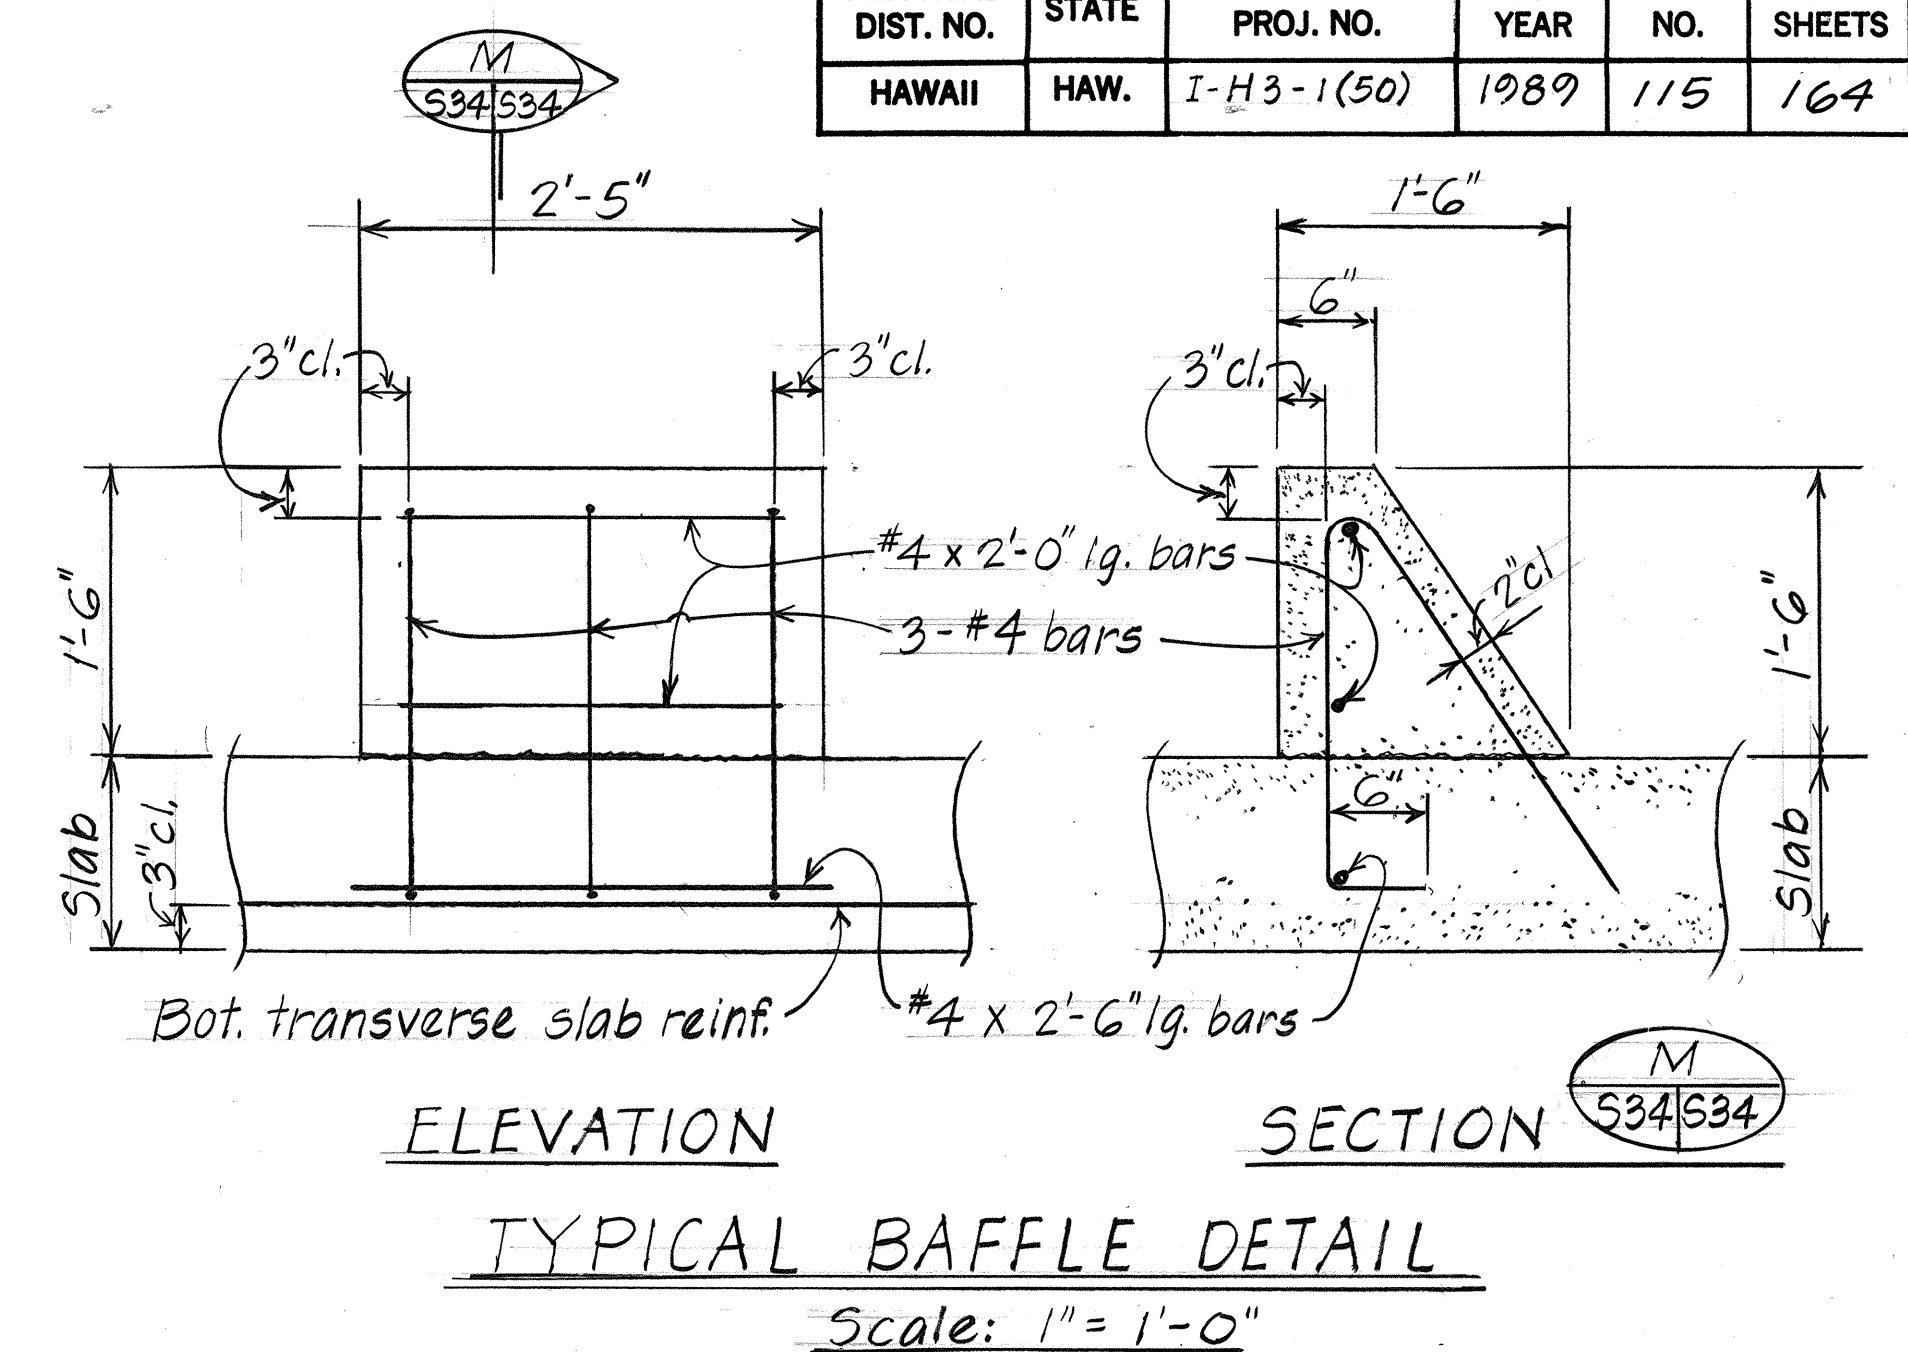

**ELEVATION**  
**SECTION**  
Scale: 1" = 1'-0"

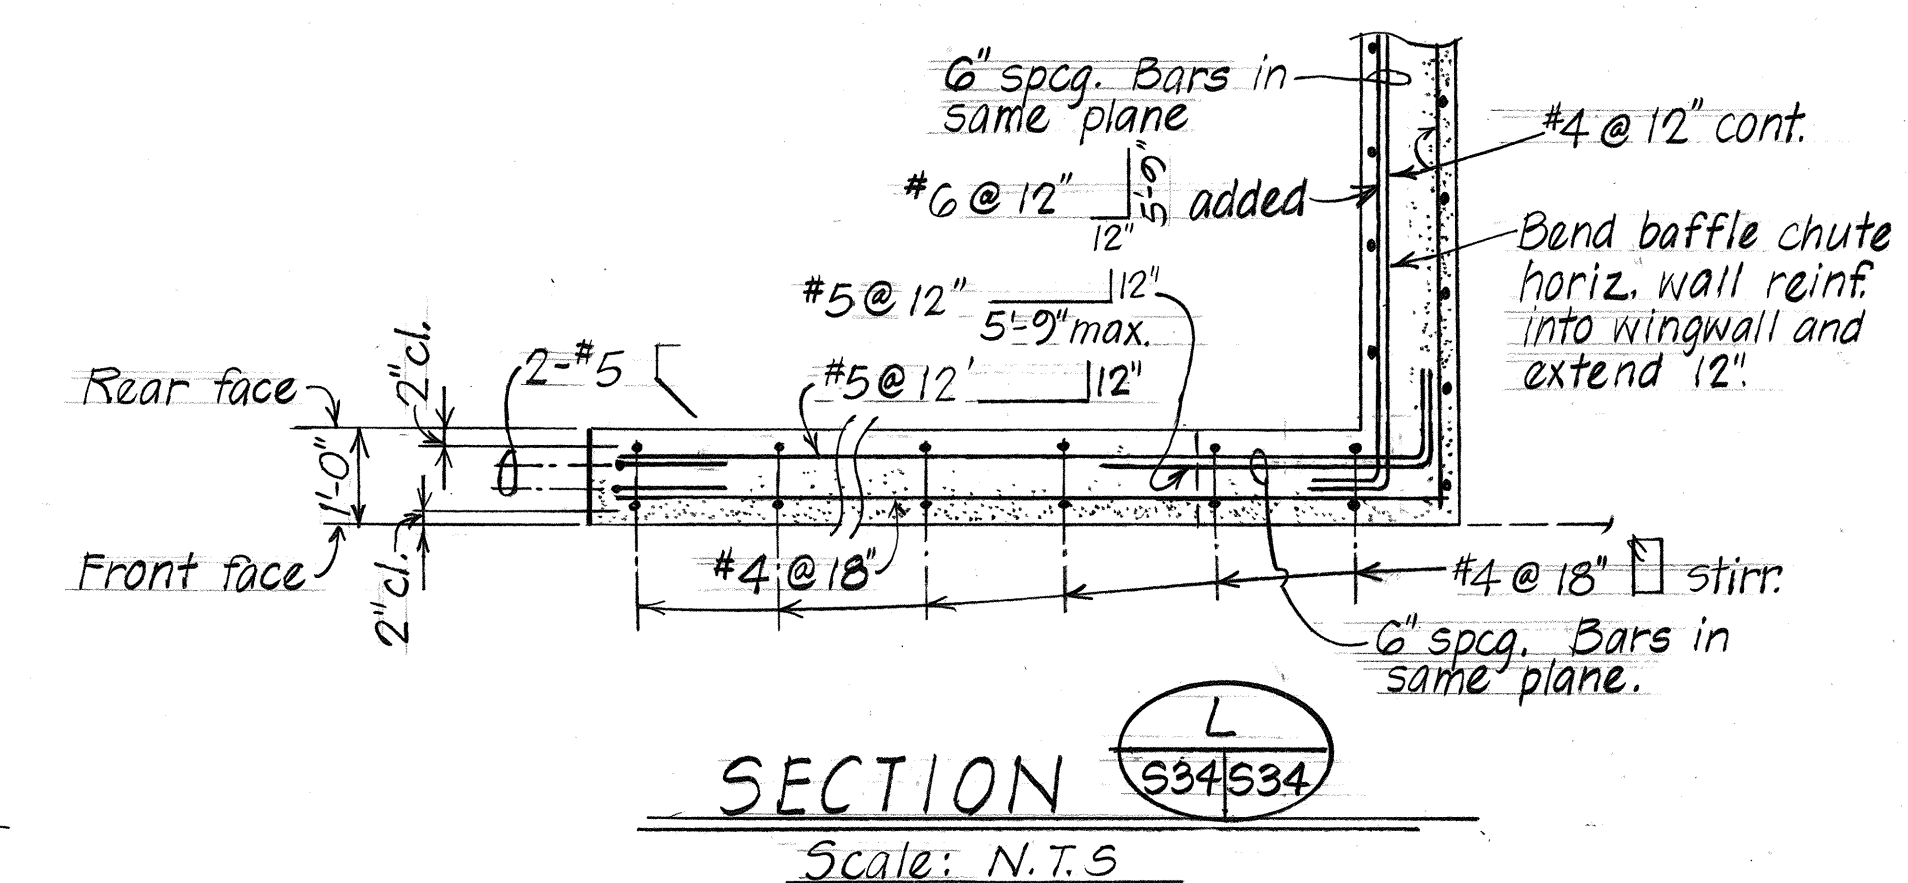

**SECTION**  
Scale: N.T.S.


STATE OF HAWAII  
DEPARTMENT OF TRANSPORTATION  
LAND TRANSPORTATION FACILITIES DIVISION  
9'-0" x 8'-0" CONC. BOX CULVERT  
AT STA. 453+87  
MISC. CULVERT DETAILS  
F.A.I. Proj. No. I-H3-1(50)  
KANEHOE I.C. TO HALEKOU I.C.  
Scale: As Noted Date: August 1987  
SHEET No. 934 OF 35 SHEETS




| FED. ROAD DIST. NO. | STATE | FED. AID PROJ. NO. | FISCAL YEAR | SHEET NO. | TOTAL SHEETS |
|---------------------|-------|--------------------|-------------|-----------|--------------|
| HAWAII              | HAW.  | I-H3-1(50)         | 1987        | 116       | 164          |

| SPAN & HEIGHT              |                                      | FLARED SECTION 9'-0" x 8'-0" |          |          |          |          |          |
|----------------------------|--------------------------------------|------------------------------|----------|----------|----------|----------|----------|
| TYPE                       |                                      | A                            | B        | C        | D        | E        | F        |
| MAX. FILL OVER TOP OF SLAB |                                      |                              |          |          |          |          |          |
| CONC.                      | TOP SLAB                             | T1                           | 10 1/2"  | 9"       | 10"      | 11"      | 12 1/2"  |
|                            | BOTTOM SLAB                          | T2                           | 12 1/2"  | 9"       | 12"      | 13 1/2"  | 15"      |
|                            | SIDE WALLS                           | T3                           | 11"      | 10"      | 11 1/2"  | 12 1/2"  | 13 1/2"  |
| * REINFORCING STEEL        | DIMENSION                            | D1                           | 7'-0"    | 6'-1"    | 6'-3"    | 6'-3"    | 6'-4"    |
|                            | DIMENSION                            | D2                           | 2'-9"    | 2'-6"    | 2'-6"    | 3'-0"    | 3'-3"    |
|                            | DIMENSION                            | D3                           | 1/3 span | 2'-9"    | 2'-9"    | 2'-9"    | 2'-9"    |
|                            | T1                                   | "a" bar                      | #7@16"oc | #4@17"oc | #7@15"oc | #5@15"oc | #6@14"oc |
|                            |                                      | "b" bar                      | #6@16"oc | #7@17"   | #6@15"   | #8@15"   | #7@14"   |
|                            |                                      | "c" bar                      | #9@16"   | #7@17"   | #8@15"   | #7@15"   | #8@14"   |
|                            |                                      | cont. "d" bar                | #4@12"   | #4@9"    | #5@18"   | #5@18"   | #5@18"   |
|                            |                                      | "a" bar                      | #4@16"   | #5@17"   | #5@15"   | #4@15"   | #5@14"   |
|                            |                                      | "b" bar                      | #7@16"   | #6@17"   | #7@15"   | #7@15"   | #8@14"   |
|                            | T2                                   | "c" bar                      | #9@16"   | #8@17"   | #9@15"   | #9@15"   | #9@14"   |
|                            |                                      | cont. "d" bar                | #6@12"   | #6@12"   | #6@12"   | #6@12"   | #6@12"   |
|                            |                                      | vert. "e" bar                | #4@12"   | #4@12"   | #4@12"   | #4@12"   | #4@12"   |
|                            | T3                                   | vert. "e" bar                | #4@12"   | #4@12"   | #4@12"   | #4@12"   | #4@12"   |
|                            |                                      | vert. "e" bar                | #4@12"   | #4@12"   | #4@12"   | #4@12"   | #4@12"   |
| QUAN.                      | CONCRETE: C.Y. PER LIN. FT.          | Varies                       | 1.09     | 1.31     | 1.46     | 1.62     | 1.84     |
|                            | REINFORCING STEEL: LBS. PER LIN. FT. |                              |          |          |          |          |          |

\* Note: Where bars are flared on a horizontal curve, the reinforcing steel spacing given in this table shall be at the widest separation of the flared bars.

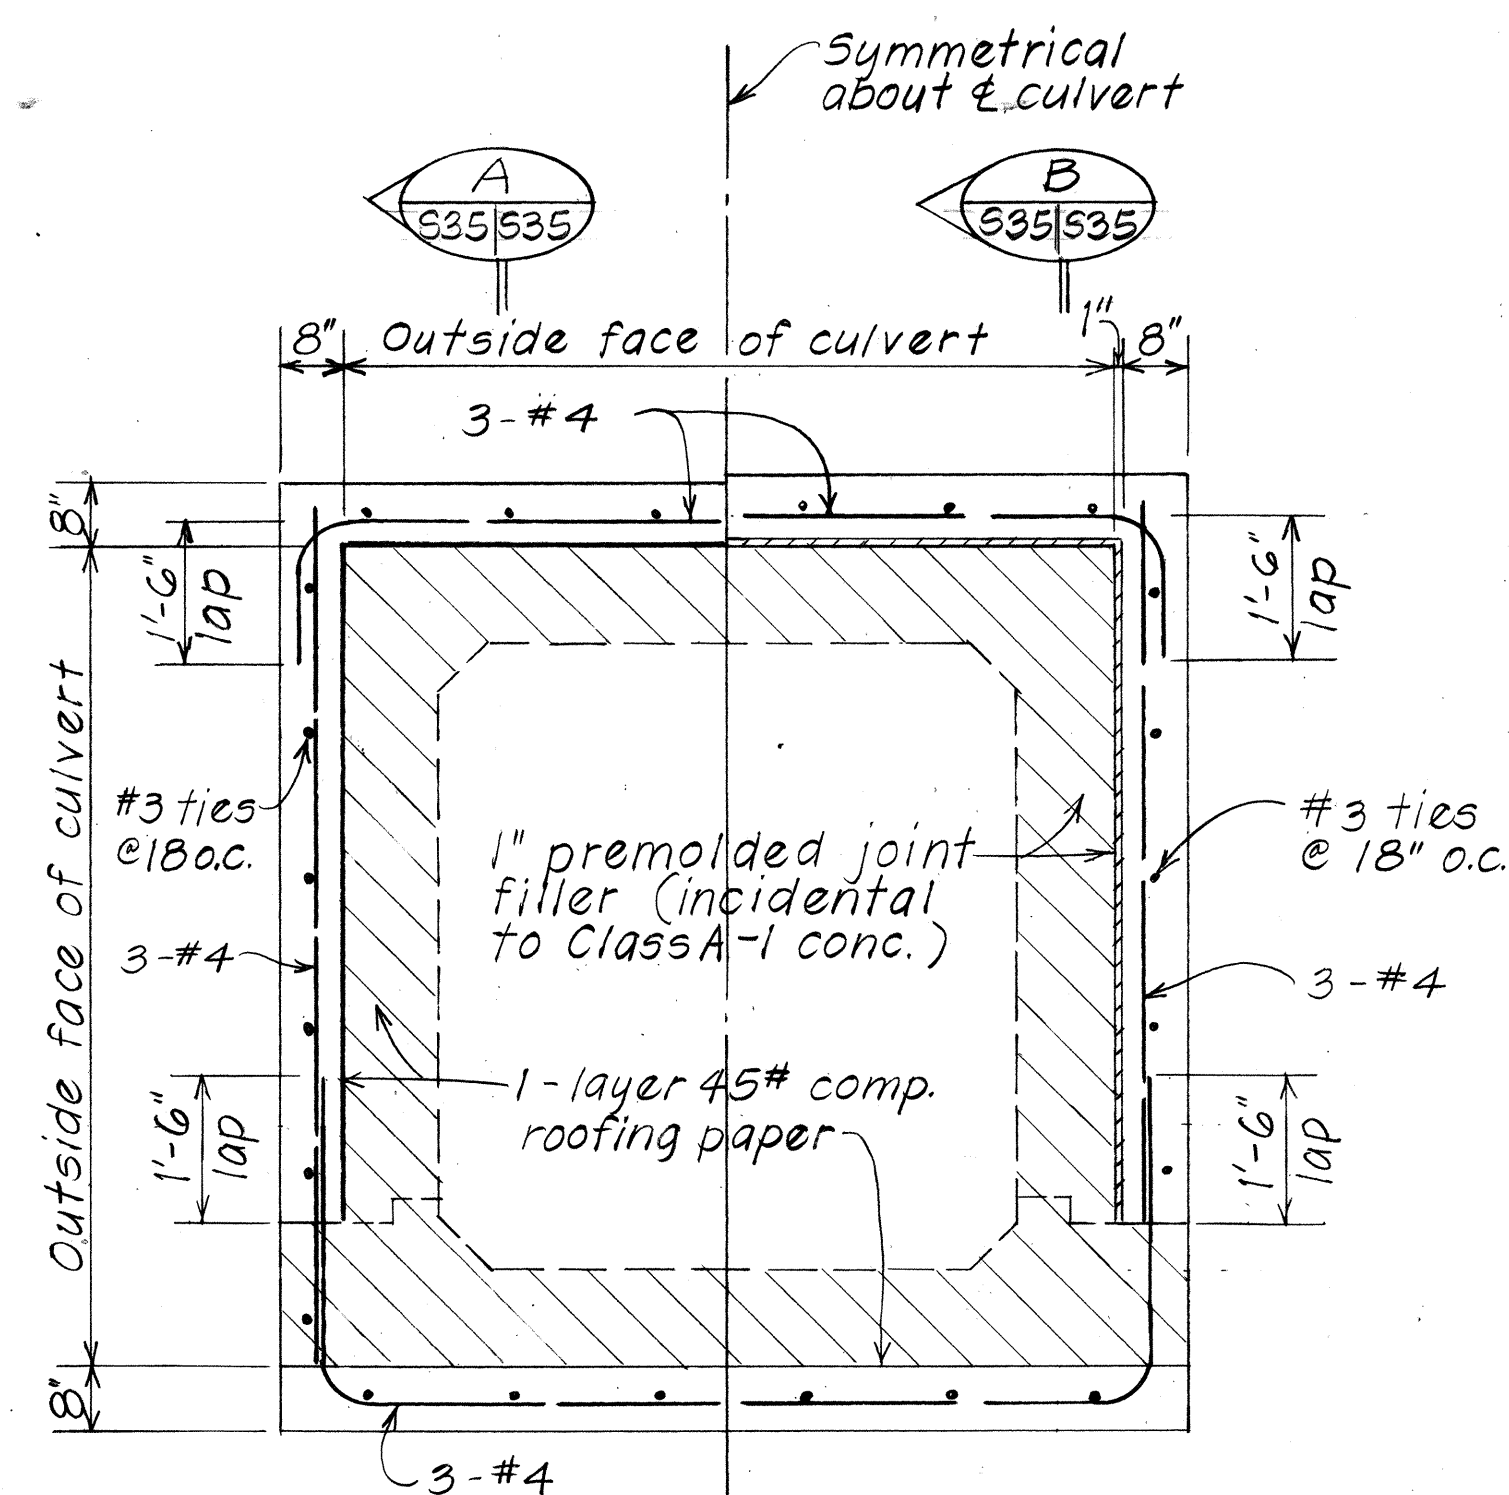


HALF SECT. AT CONTR. JT. HALF SECT. AT EXP. JT.

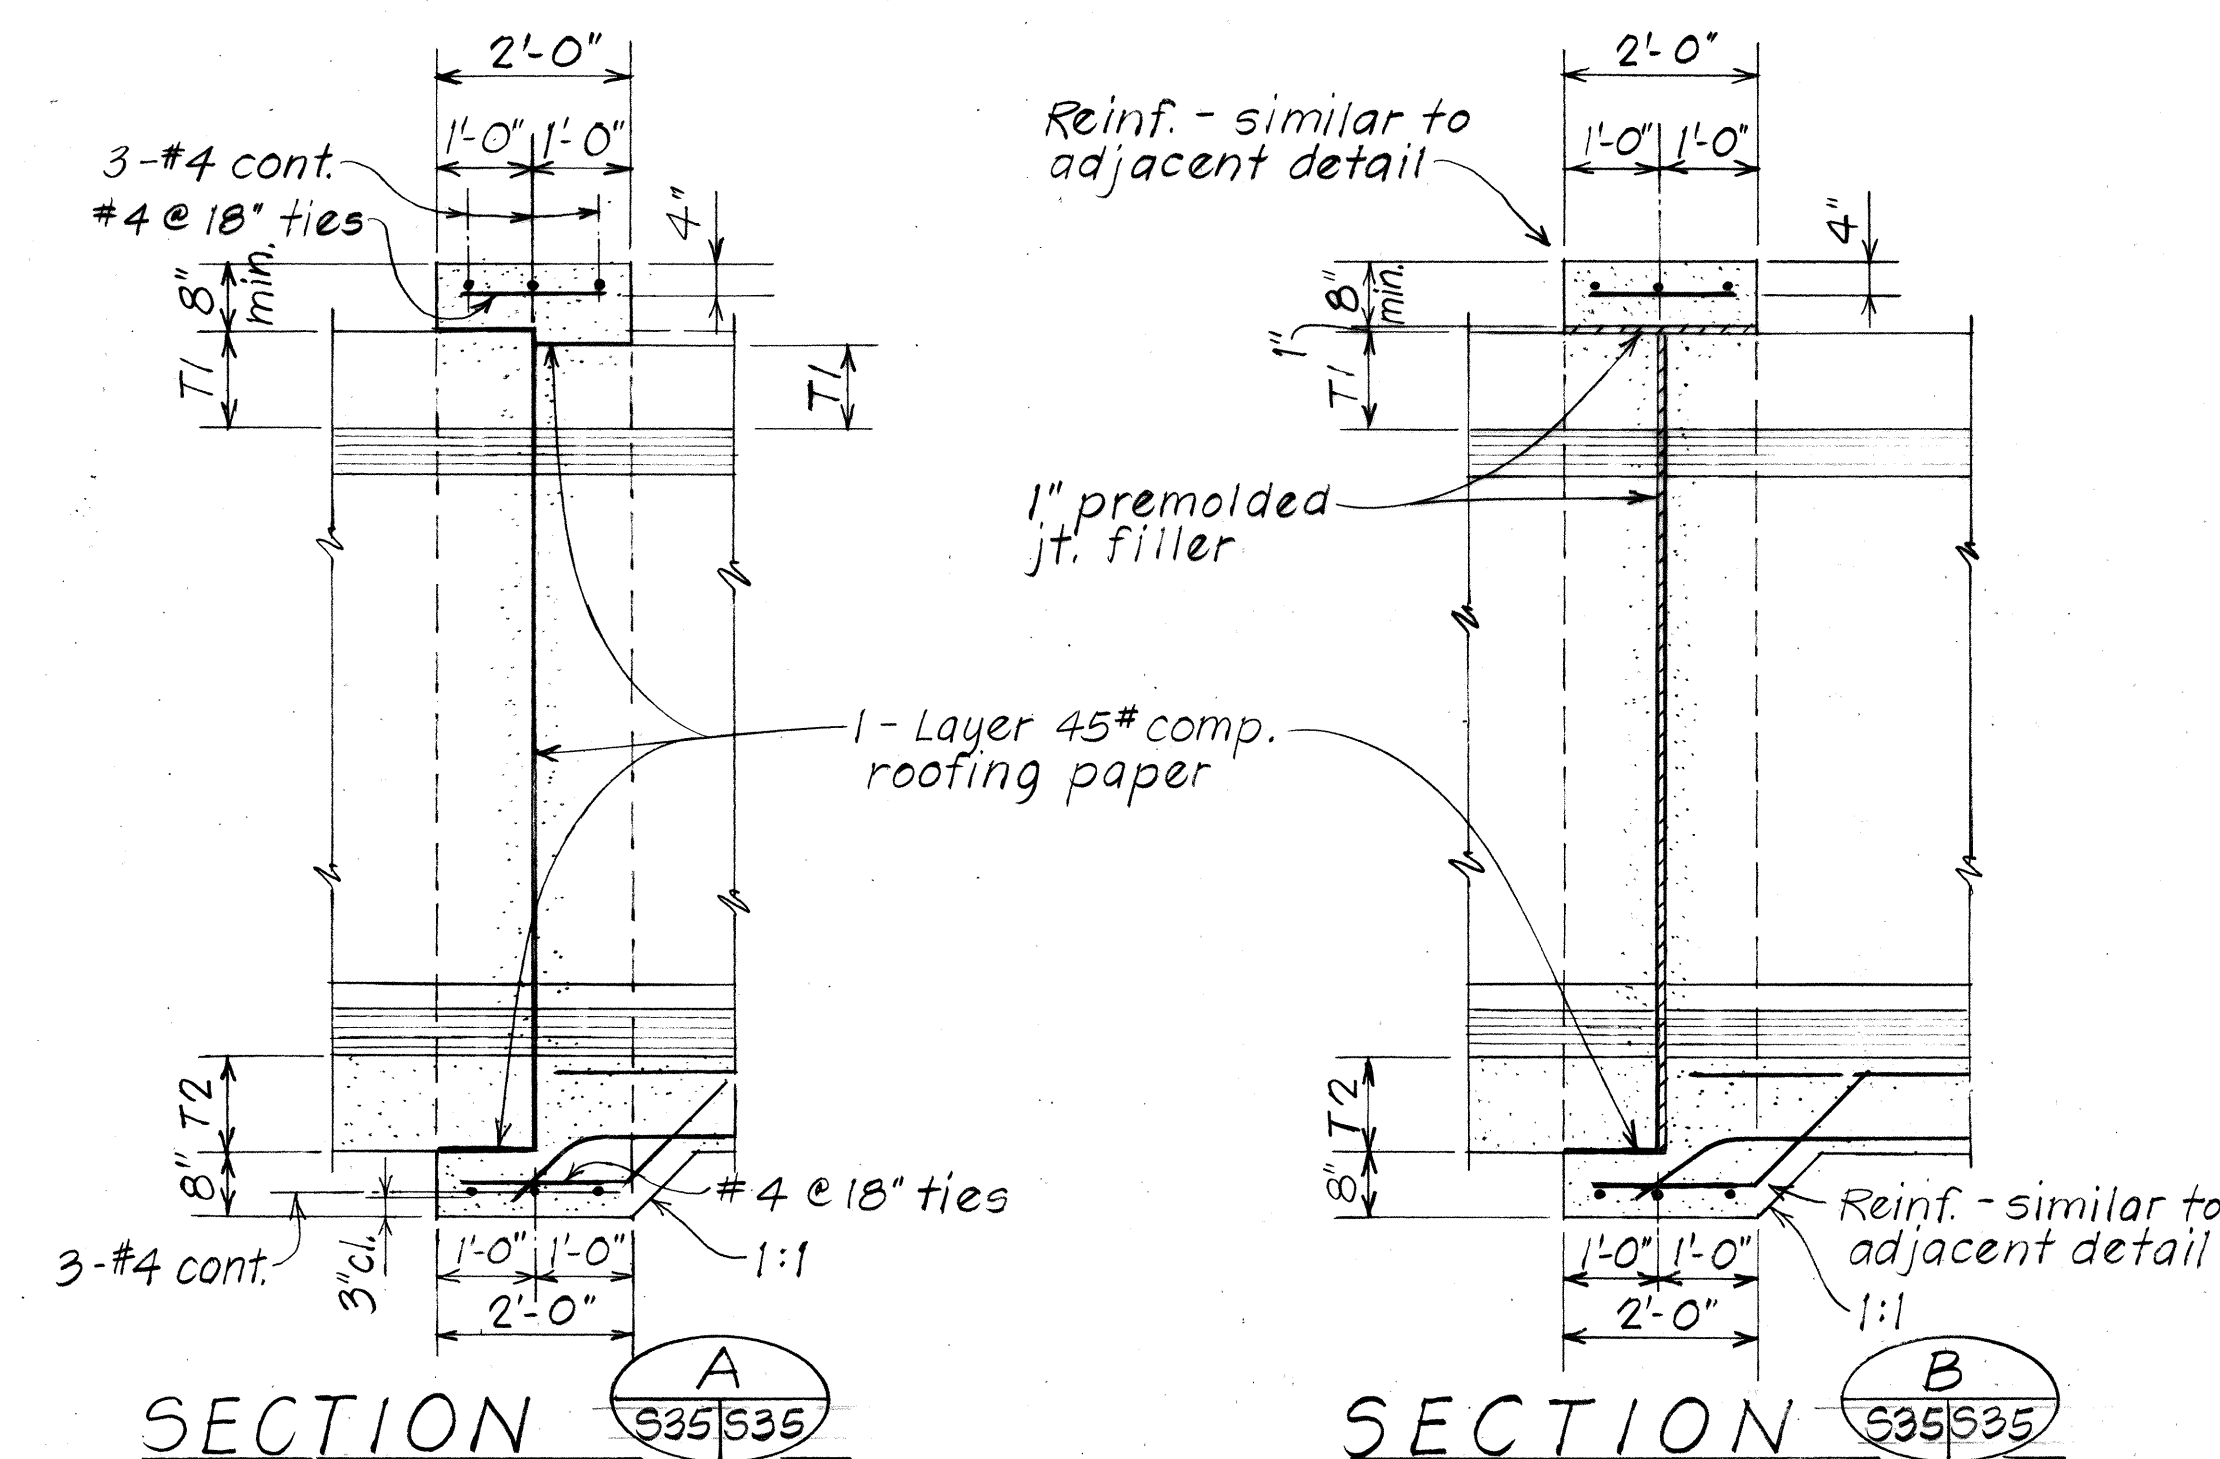

TYPICAL CONCRETE COLLAR DETAIL

Scale: 1/2" = 1'-0"

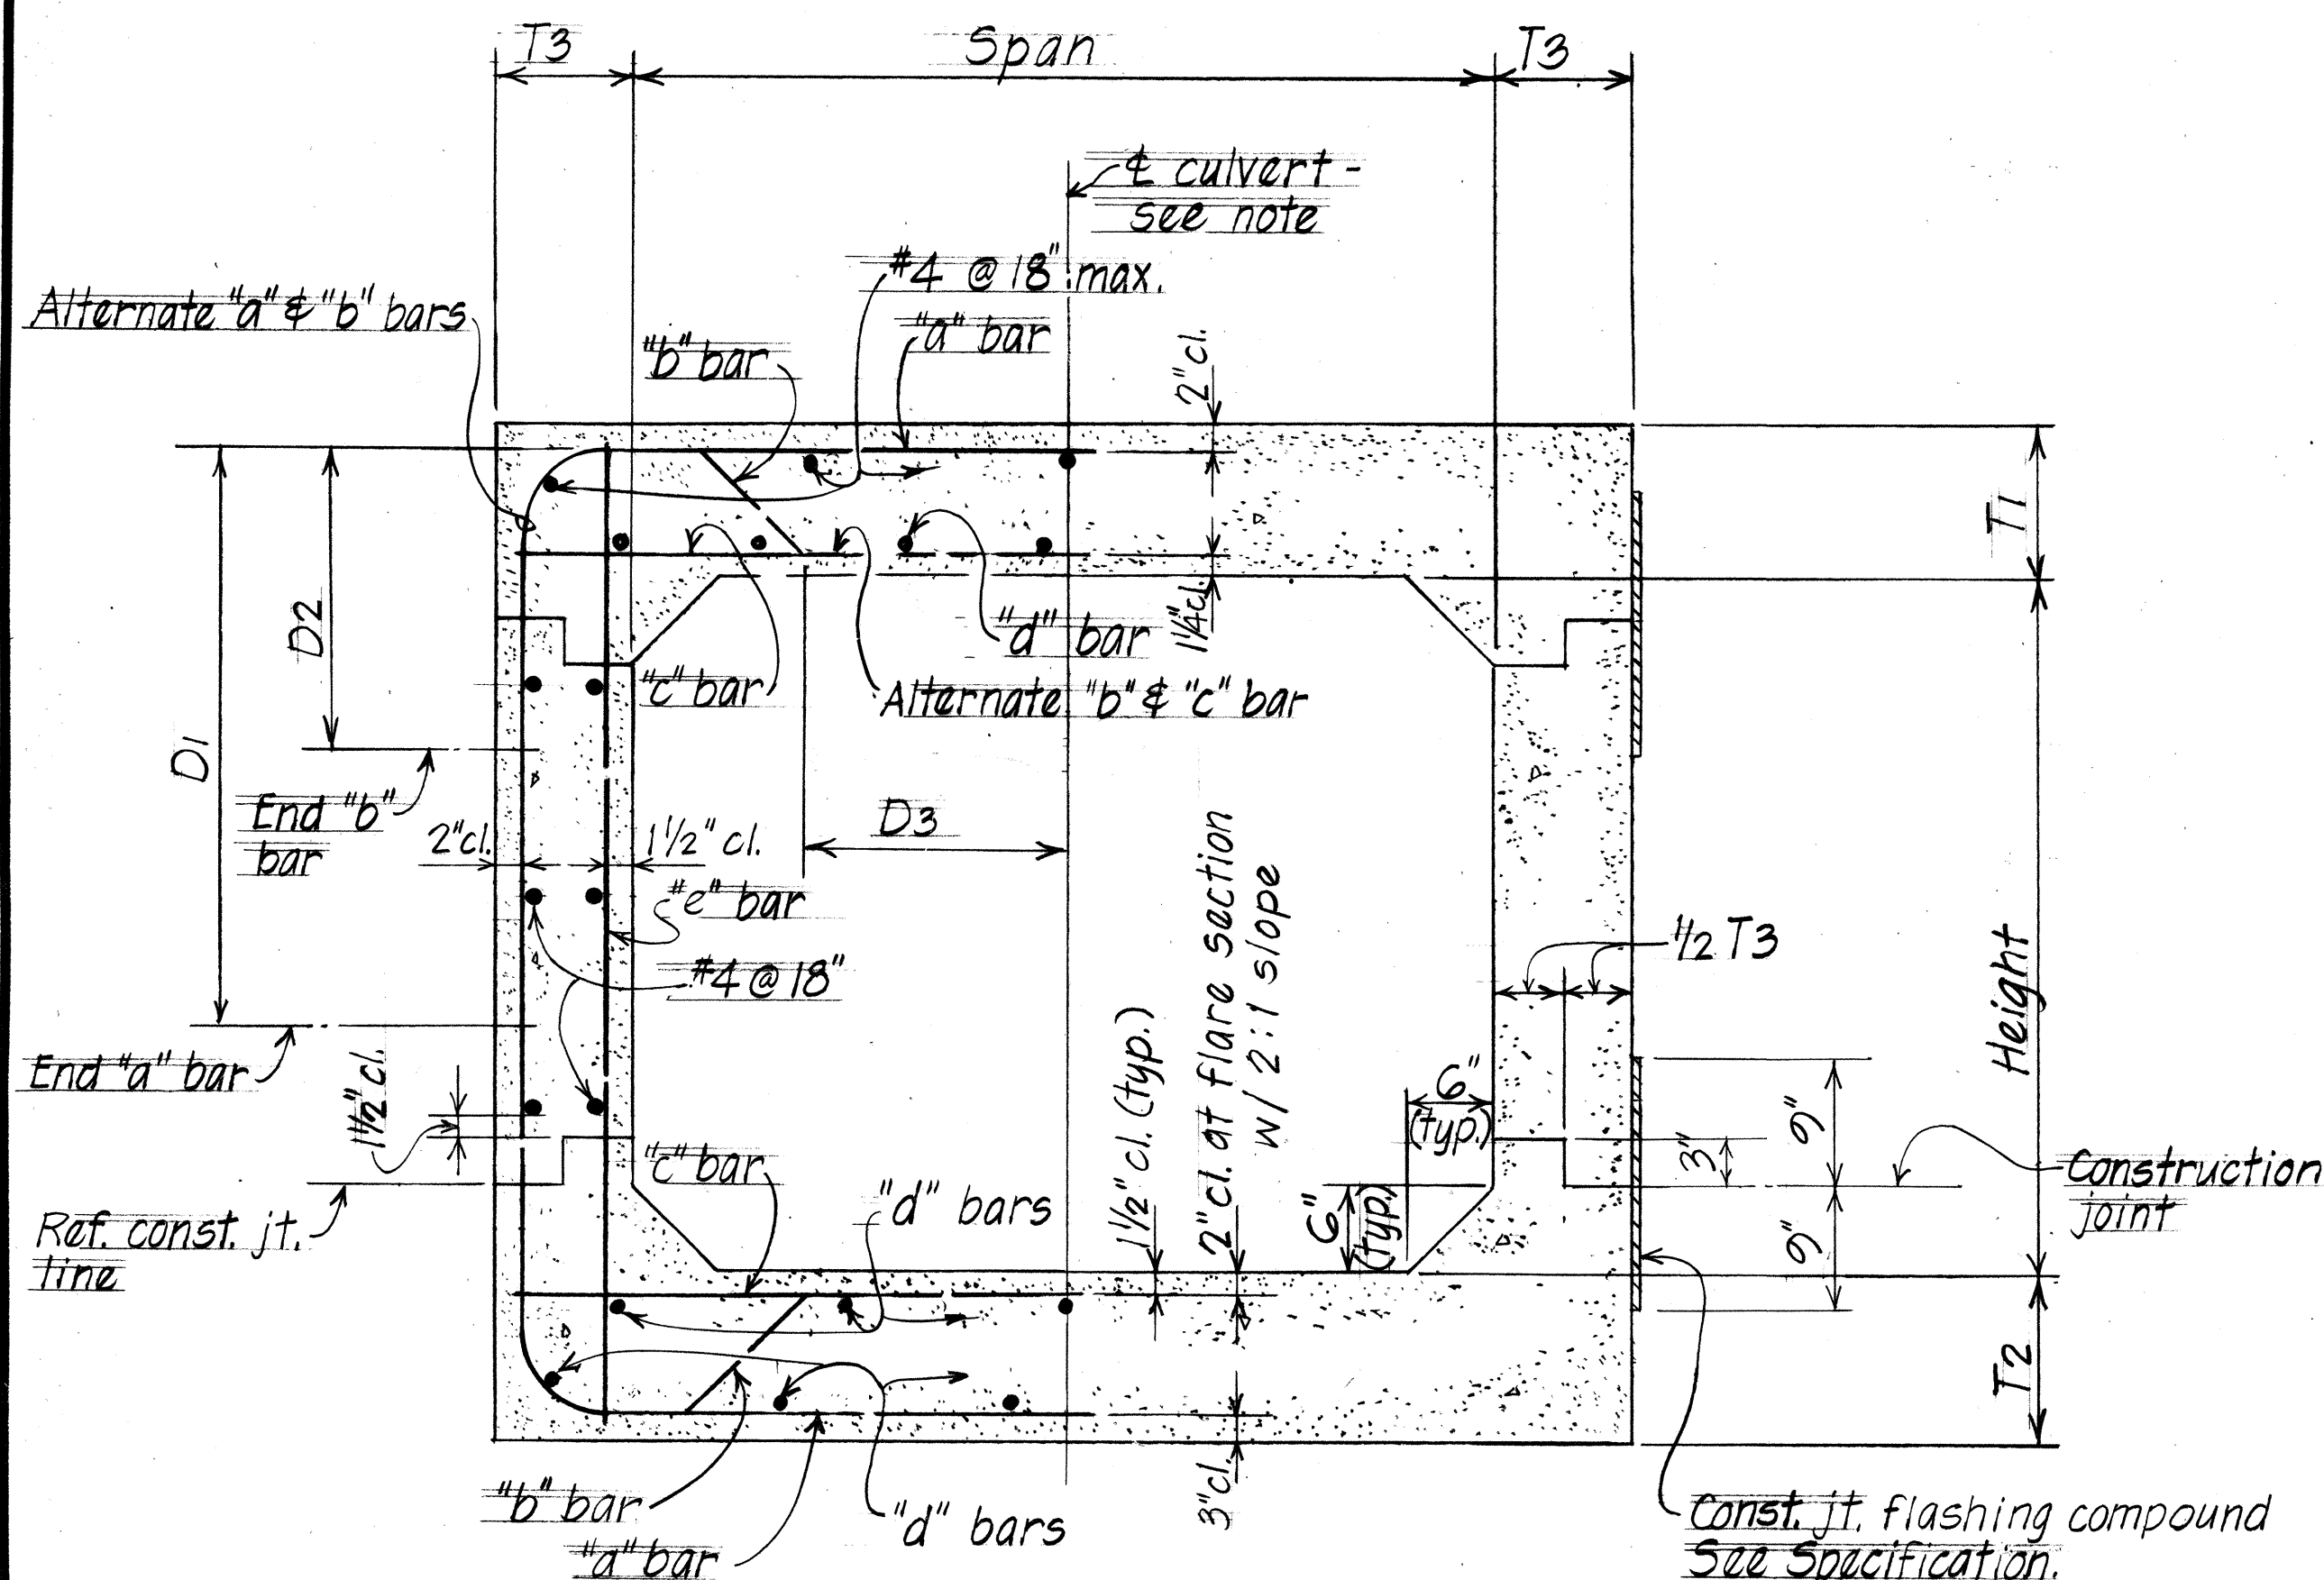


TYPICAL SECTION THRU CONCRETE BOX CULVERT

Scale: 1" = 1'-0"

NOTE:


Culvert details are symmetrical about the vertical and horizontal axis at center of culvert except where shown otherwise.

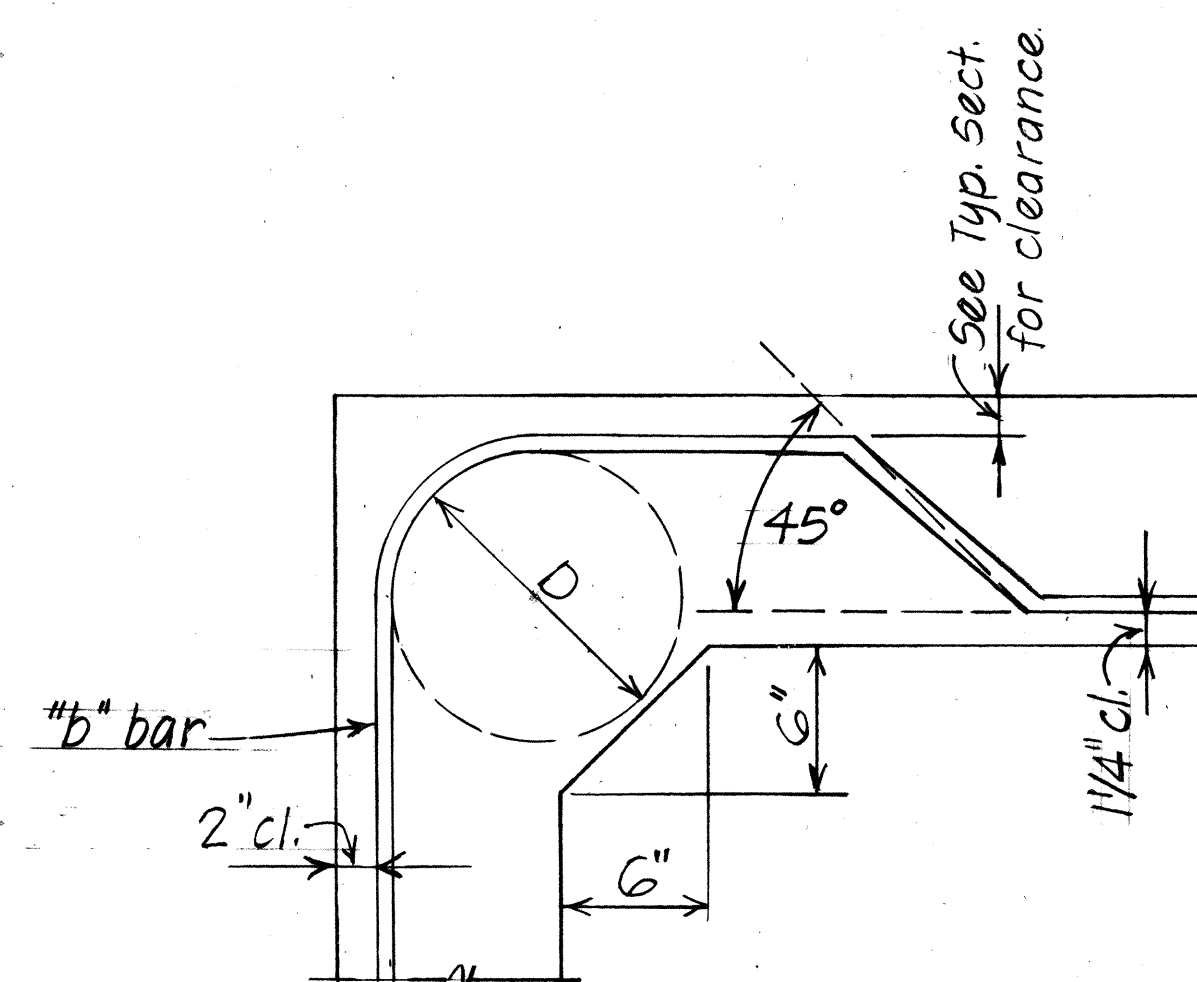

TYPICAL BEND OF MAIN BAR

Scale: 1 1/2" = 1'-0"

| SCHEDULE |        |
|----------|--------|
| BAR SIZE | D      |
| #4       | 3"     |
| #5       | 3 3/4" |
| #6       | 4 1/2" |
| #7       | 5 1/4" |
| #8       | 6"     |
| #9       | 9"     |

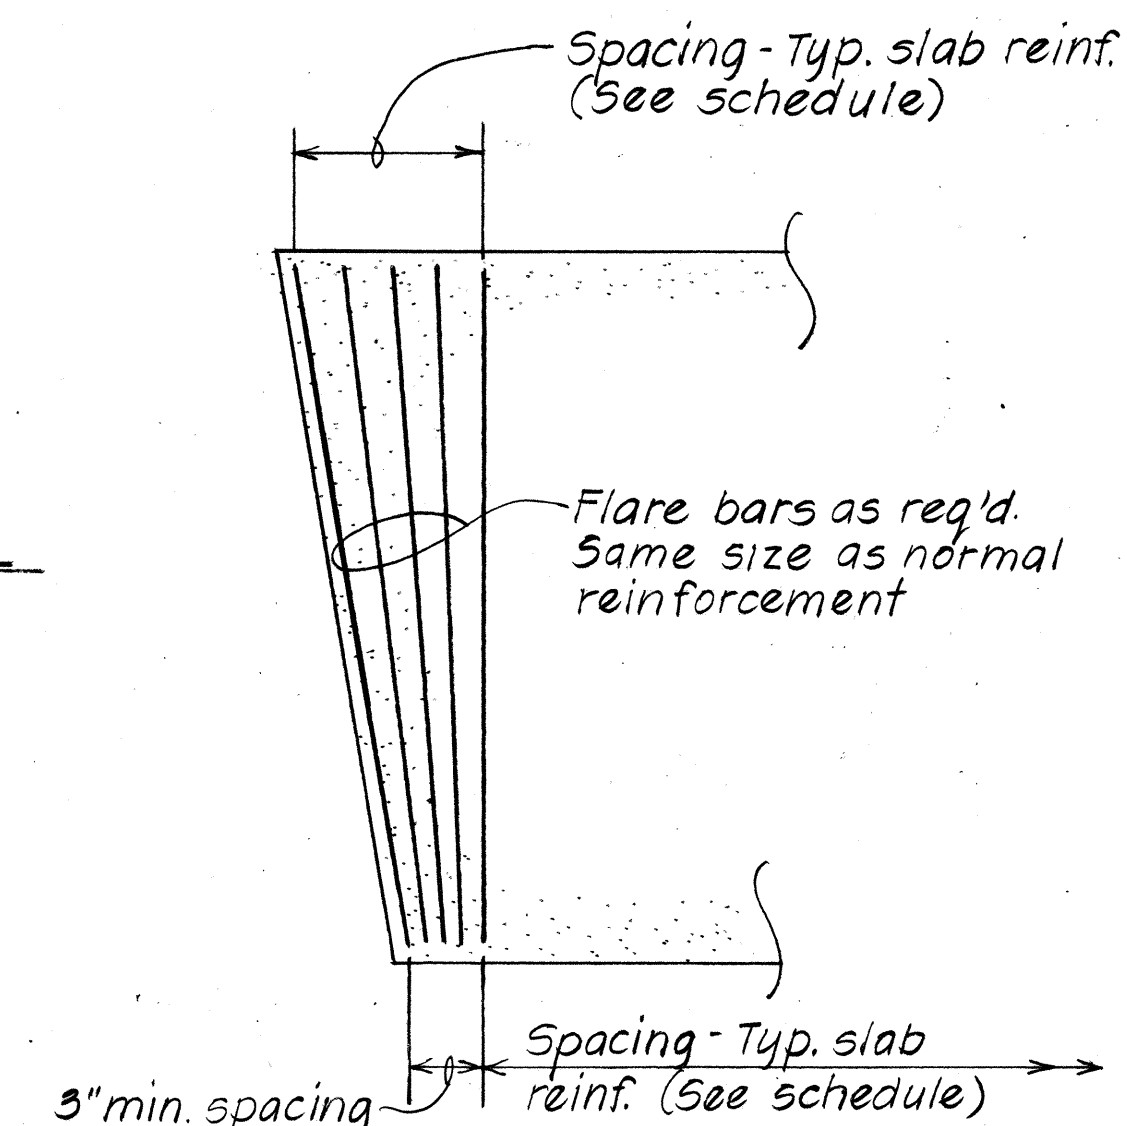

TYP. ARRANGEMENT - MAIN FLARED BARS AT CULVERT WALLS

STATE OF HAWAII  
DEPARTMENT OF TRANSPORTATION  
LAND TRANSPORTATION FACILITIES DIVISION  
9'-0" x 8'-0" CONG. BOX CULVERT  
AT STA. 453+87  
TYPICAL DETAILS  
F.A.I. Proj. No. I-H3-1(50)  
KANEHUE I.C. TO HALEKOU I.C.  
Scale: As Noted Date: August 1987  
SHEET No. 935 OF 35 SHEETS