


| INDEX TO DRAWINGS |                                                    |
|-------------------|----------------------------------------------------|
| SHEET NO.         | DESCRIPTION                                        |
| 1                 | TITLE SHEET                                        |
| 2                 | STANDARD PLAN SUMMARY                              |
| 3-5               | TYPICAL SECTION                                    |
| 6-14              | ROADWAY PLANS                                      |
| 15-16             | SUPERELEVATION DIAGRAM                             |
| 17-21             | BORING LOG                                         |
| 22-27             | MISCELLANEOUS ROADWAY DETAILS                      |
| 28-81             | DRAINAGE PLANS AND DETAILS                         |
| 82                | BRIDGE DRAWINGS-INDEX & LOCATION PLANS             |
| 83-109            | KUOU STREAM BRIDGE - PLAN & DETAILS                |
| 110-116           | CONCRETE BOX CULVERT AT STA. 453+87 PLAN & DETAILS |
| 117-124           | TRAFFIC SIGNING & MARKING - PLANS & DETAILS        |
| 125-133           | LANDSCAPING PLANS                                  |
| 134-164           | CROSS SECTIONS                                     |

SHEET NOS. ① C.O. 45-1, C.O. 55-1, ② C.O. 135-1, C.O. 145-1 THROUGH C.O. 145-9, ③ C.O. 215-1, ④ C.O. 235-1, ⑤ C.O. ADD. 435-1 THROUGH C.O. ADD. 435-3, C.O. 655-1 THROUGH C.O. 655-4, C.O. ADD. 805-1, C.O. 815-1, ⑥ C.O. 1145-1, ⑦ C.O. ADD. 1175-1, C.O. 1215-1 THROUGH C.O. 1215-8, C.O. ADD. 1245-1, C.O. ADD. 1245-2, ⑧ C.O. 1635-1, ADD. 164A, ADD. 164B AND ADD. 1645-1 THROUGH ADD. 1645-26 ARE SUPPLEMENTARY SHEETS TO THIS PROJECT. TOTAL SHEET COUNT AFTER "AS-BUILT" POSTING 230 SHTS.

STATE OF HAWAII  
DEPARTMENT OF TRANSPORTATION  
HIGHWAYS DIVISION  
HONOLULU, HAWAII

"AS-BUILT"  
PLANS FOR  
CONSTRUCTION OF A PORTION OF  
INTERSTATE ROUTE H-3  
KANEHOE INTERCHANGE TO  
HALEKOU INTERCHANGE


FEDERAL AID INTERSTATE PROJECT NO. I-H3-I(50)  
DISTRICT OF KOOLAUPOKO  
ISLAND OF OAHU

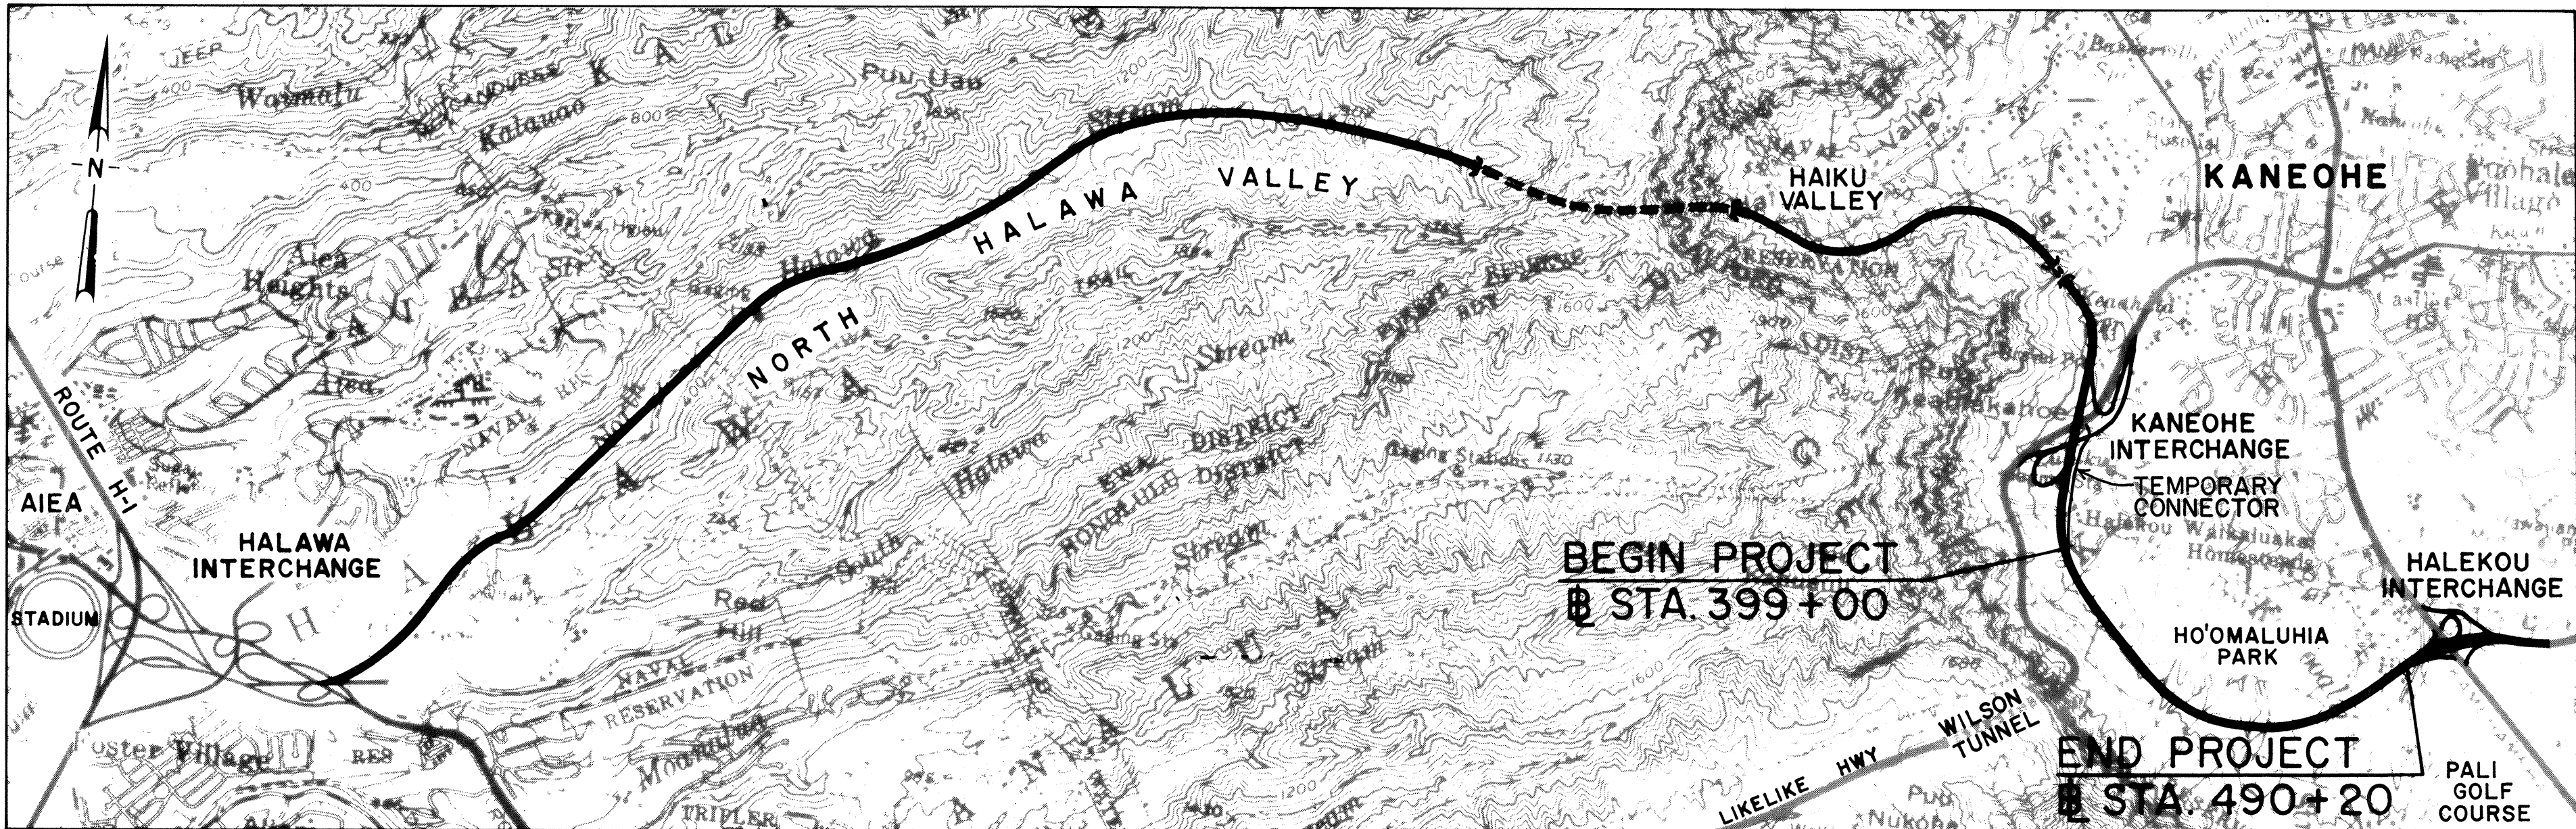

LAYOUT PLAN

GROSS LENGTH OF PROJECT ..... 1.727  
TOTAL LENGTH OF BRIDGE ..... 0.063  
NET LENGTH OF PROJECT ..... 1.664

|         |                           |
|---------|---------------------------|
| 3/10/89 | Added Temporary Connector |
| DATE    | REVISION                  |

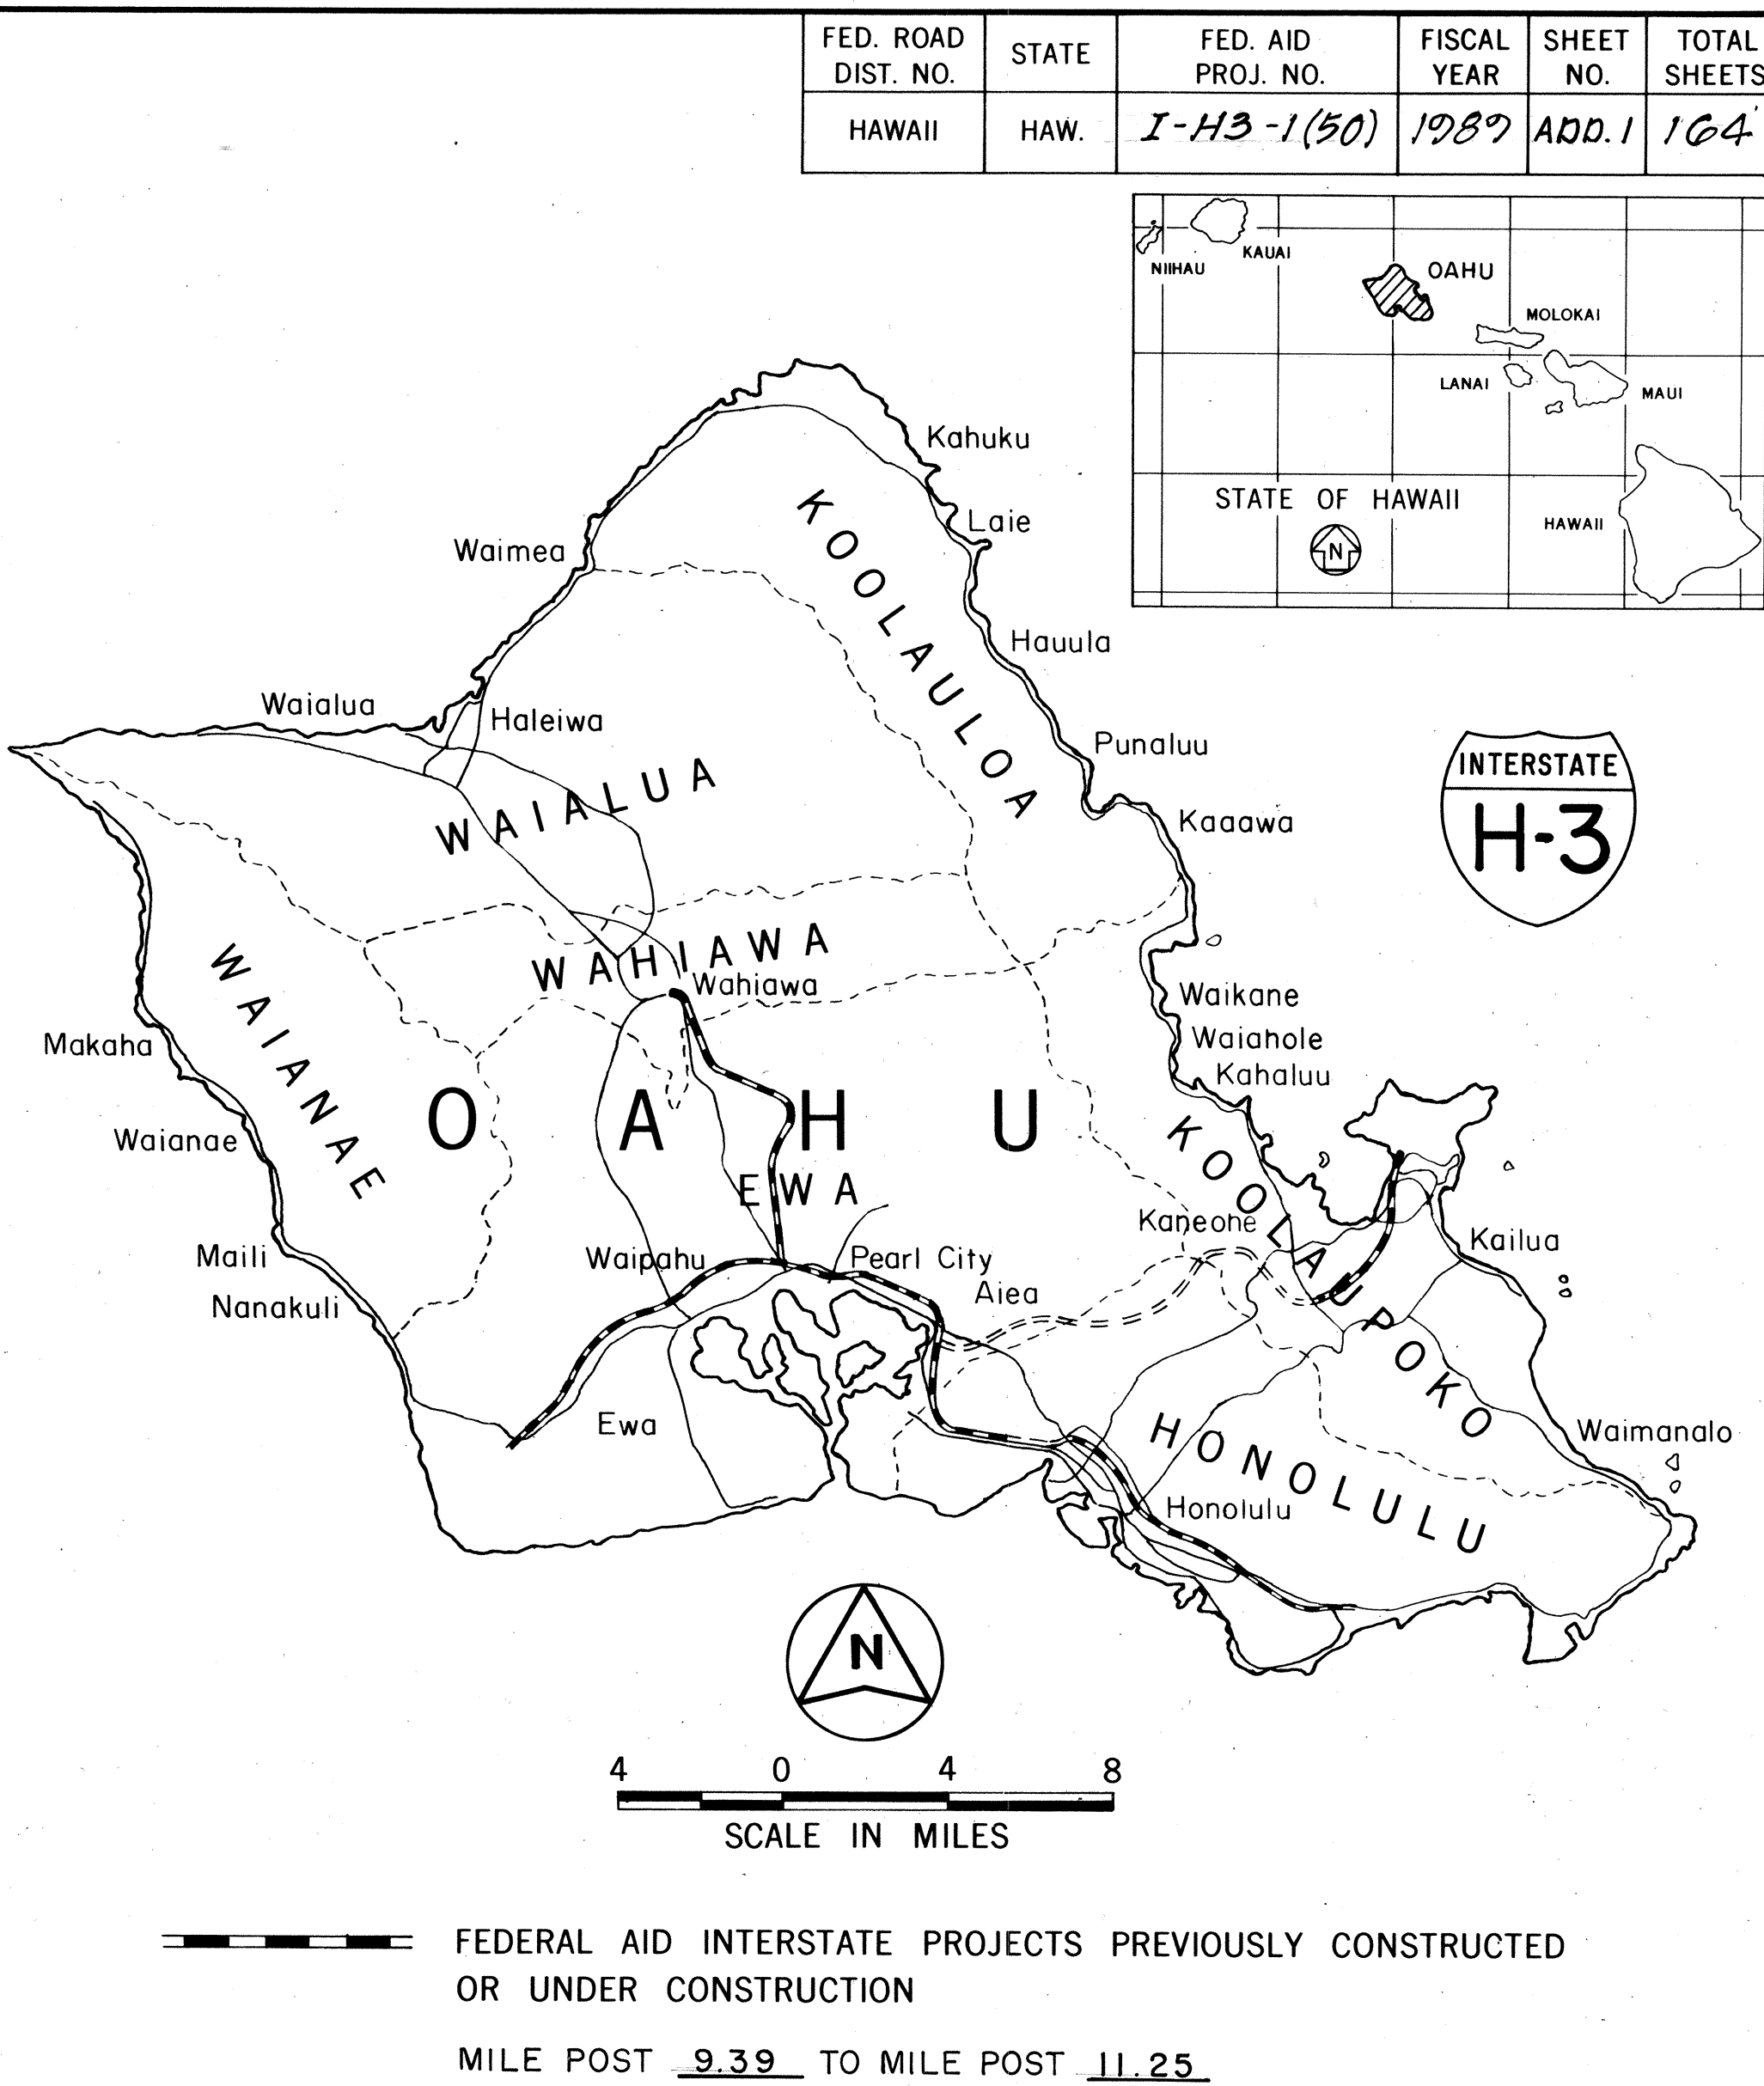

| DESIGN                      | DESIGNATION |
|-----------------------------|-------------|
| FUTURE ADT (1998) . . . . . | 24,600      |
| DESIGN ADT (2008) . . . . . | 28,600      |
| DHV . . . . .               | 2,780       |
| D . . . . .                 | 67/33       |
| T . . . . .                 | 2.1%        |
| T <sub>24</sub> . . . . .   | 4.1%        |
| V . . . . .                 | 60 M.P.H.   |

CHANGES MADE DURING CONSTRUCTION HAVE BEEN INCORPORATED ON THESE PLANS EXCEPT CHANGES IN THE ORIGINAL THEORETICAL QUANTITIES. FOR ACTUAL QUANTITIES, REFER TO PROJECT LEDGER AND/OR COMPUTATION BOOK.  
Resident Engineer: [Signature] 11/21/05 DATE

|                                                                |
|----------------------------------------------------------------|
| DEPARTMENT OF TRANSPORTATION<br>FEDERAL HIGHWAY ADMINISTRATION |
| APPROVED: [Signature] 9/8/88<br>DIVISION ADMINISTRATOR DATE    |

|                                                             |
|-------------------------------------------------------------|
| DEPARTMENT OF TRANSPORTATION<br>STATE OF HAWAII             |
| APPROVED: [Signature] 8/1/88<br>DIR. OF TRANSPORTATION DATE |

DESIGN UNIT "E"  
DESIGNED BY  
A. YAMAGUCHI 548-7534 AUG. 1988  
P. S. & E. BY PHONE DATE