
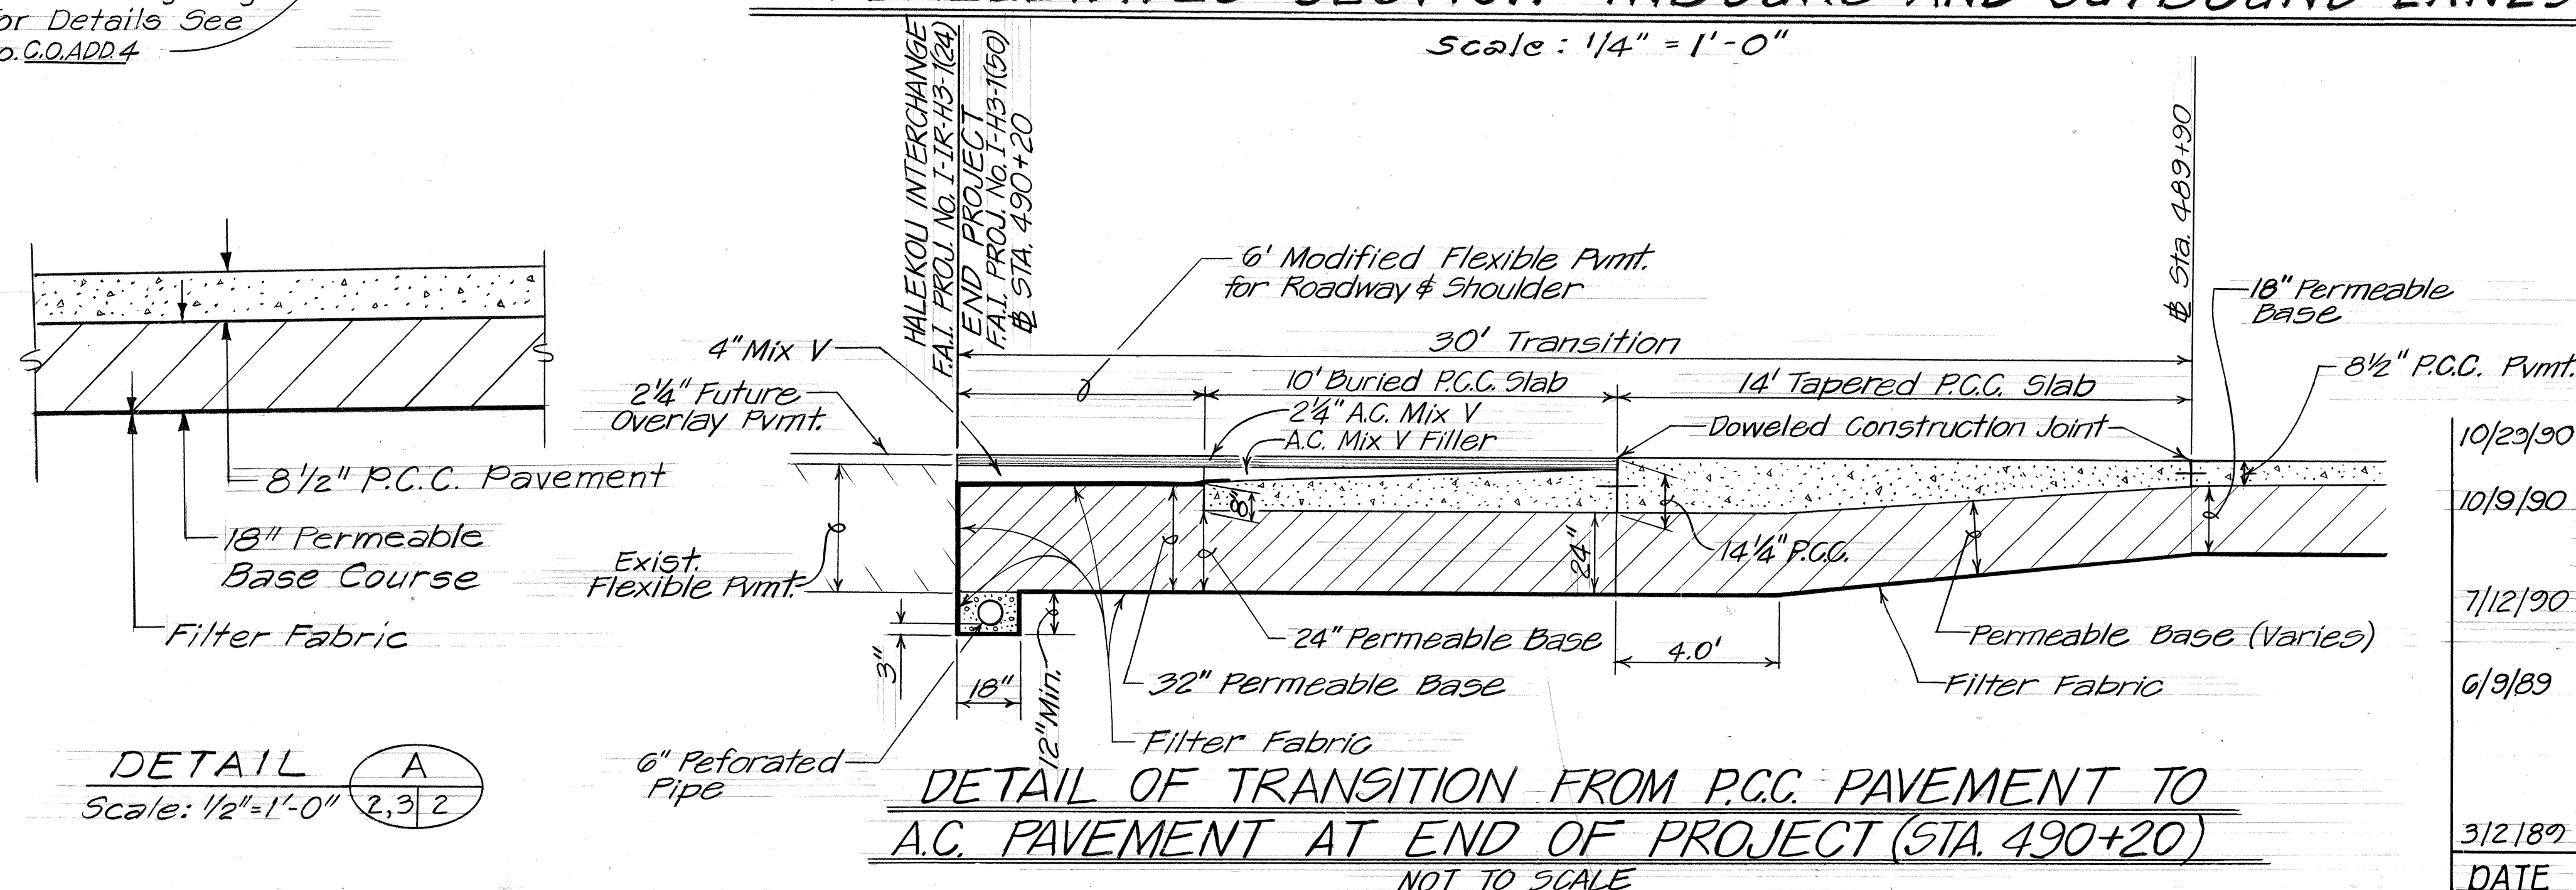
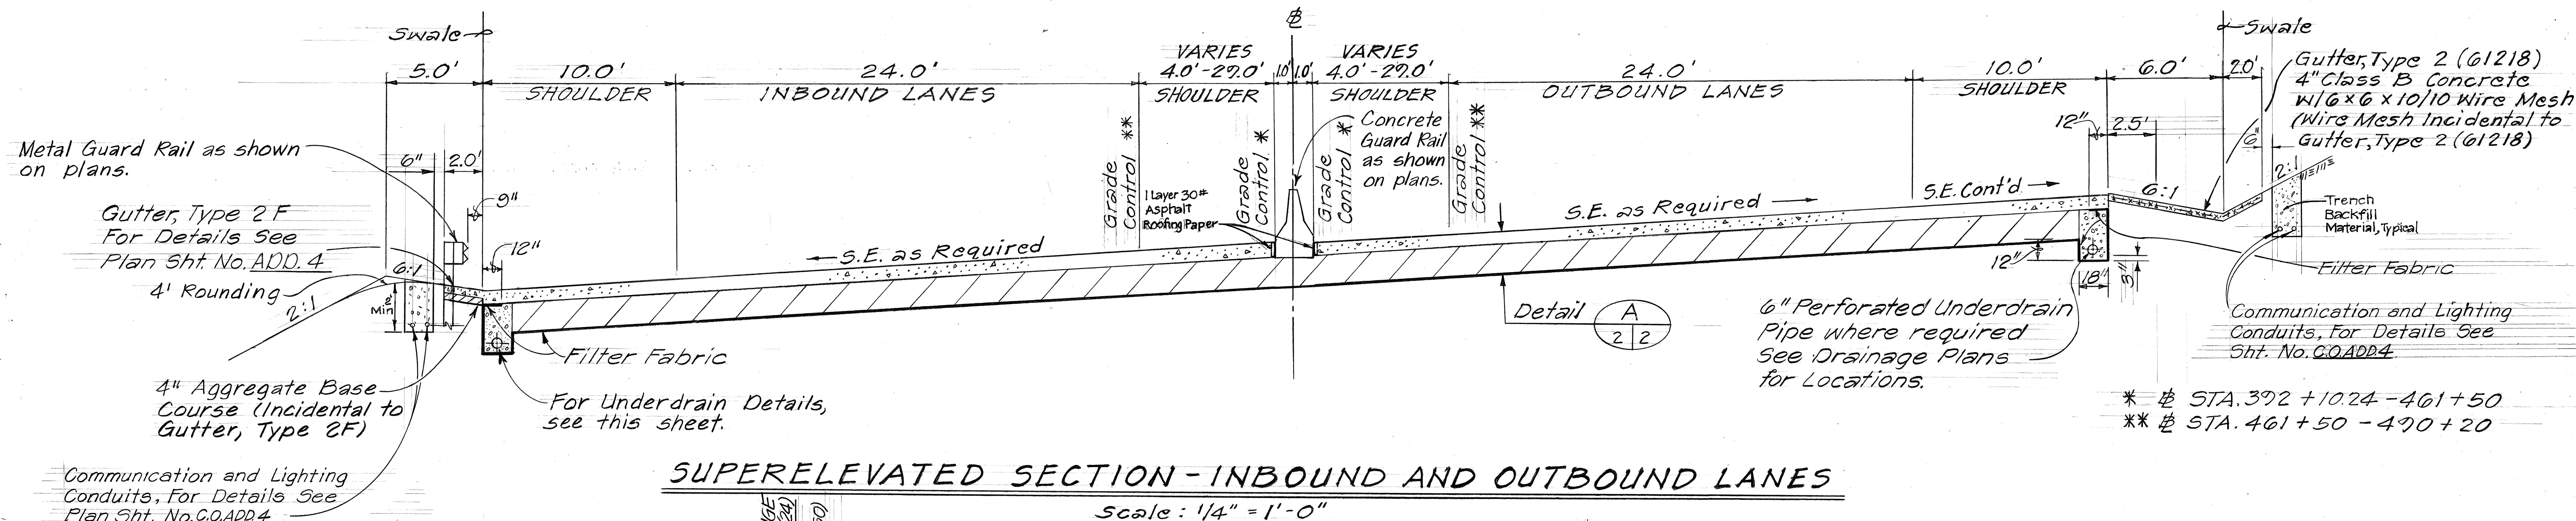


FED. ROAD DIST. NO.	STATE	FED. AID PROJ. NO.	FISCAL YEAR	SHEET NO.	TOTAL SHEETS
HAWAII	HAW.	I-H3-1(50)	1989	C.O.ADD.3	164





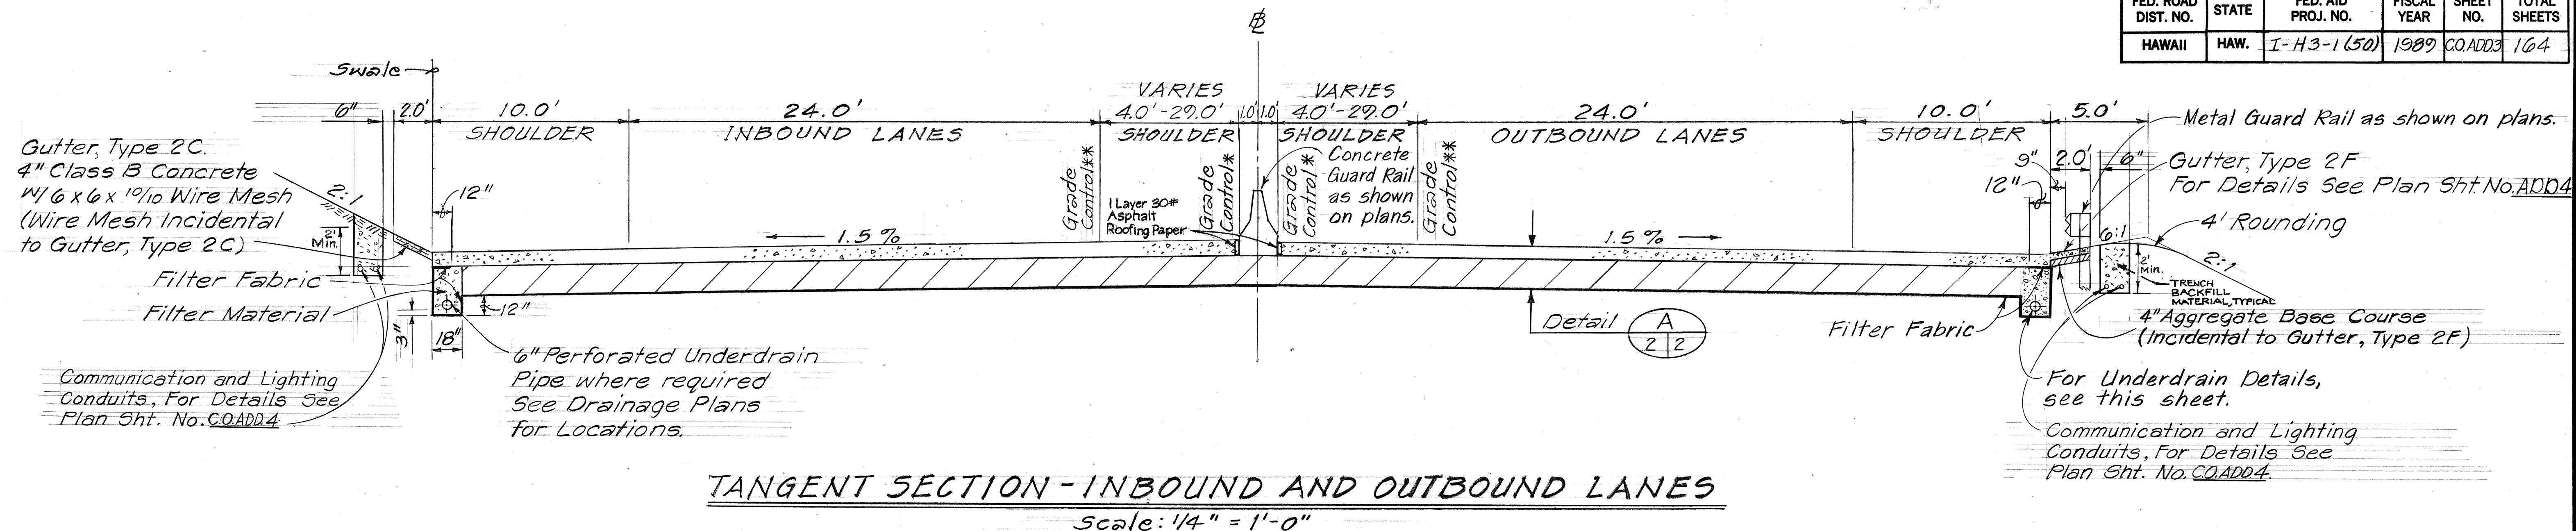


DATE	REVISION
10/23/90	Added Asphalt Roofing Paper for Bond Breaker.
10/9/90	C.O. - Revised Depth and location of Communication and Lighting Conduits.
7/12/90	Added Communication and Lighting Conduits
6/9/89	Added Pavement Transition. Detail Per C.O.
3/2/89	Revised Pavement Design from 2 1/2" A.C. Mix No. I to 8 1/2" P.C.C.P.
	Revised plan sheet reference numbers

STATE OF HAWAII DEPARTMENT OF TRANSPORTATION LAND TRANSPORTATION FACILITIES DIVISION	
TYPICAL ROADWAY SECTIONS	
INTERSTATE ROUTE H-3 F.A.I. Project No. I-H3-1(50)	
Scale: As Shown Date: Aug, 1988	
SHEET NO. 1 OF 3 SHEETS	

C.O.ADD.3

FED. ROAD DIST. NO.	STATE	FED. AID PROJ. NO.	FISCAL YEAR	SHEET NO.	TOTAL SHEETS
HAWAII	HAW.	I-H3-1 (50)	1989	ADD.4	164

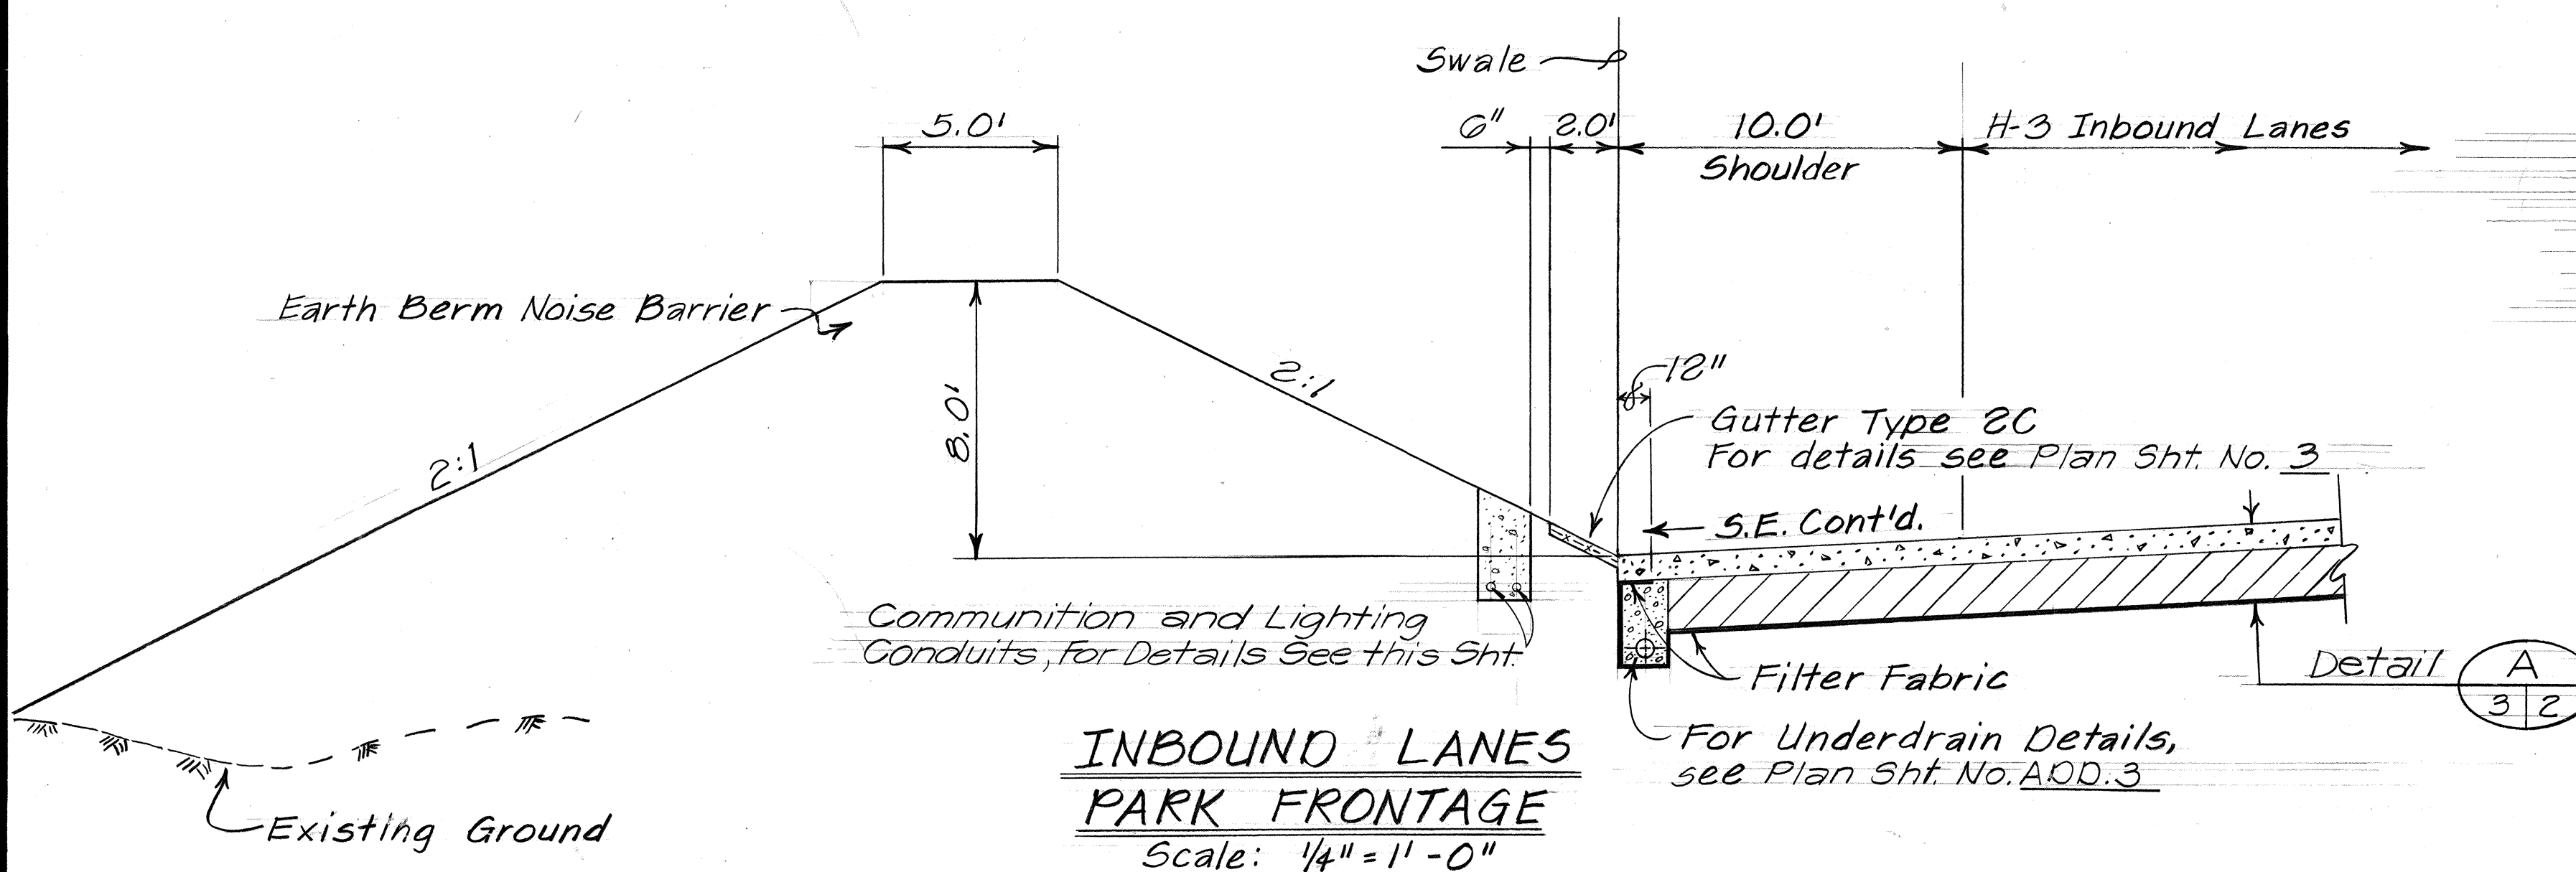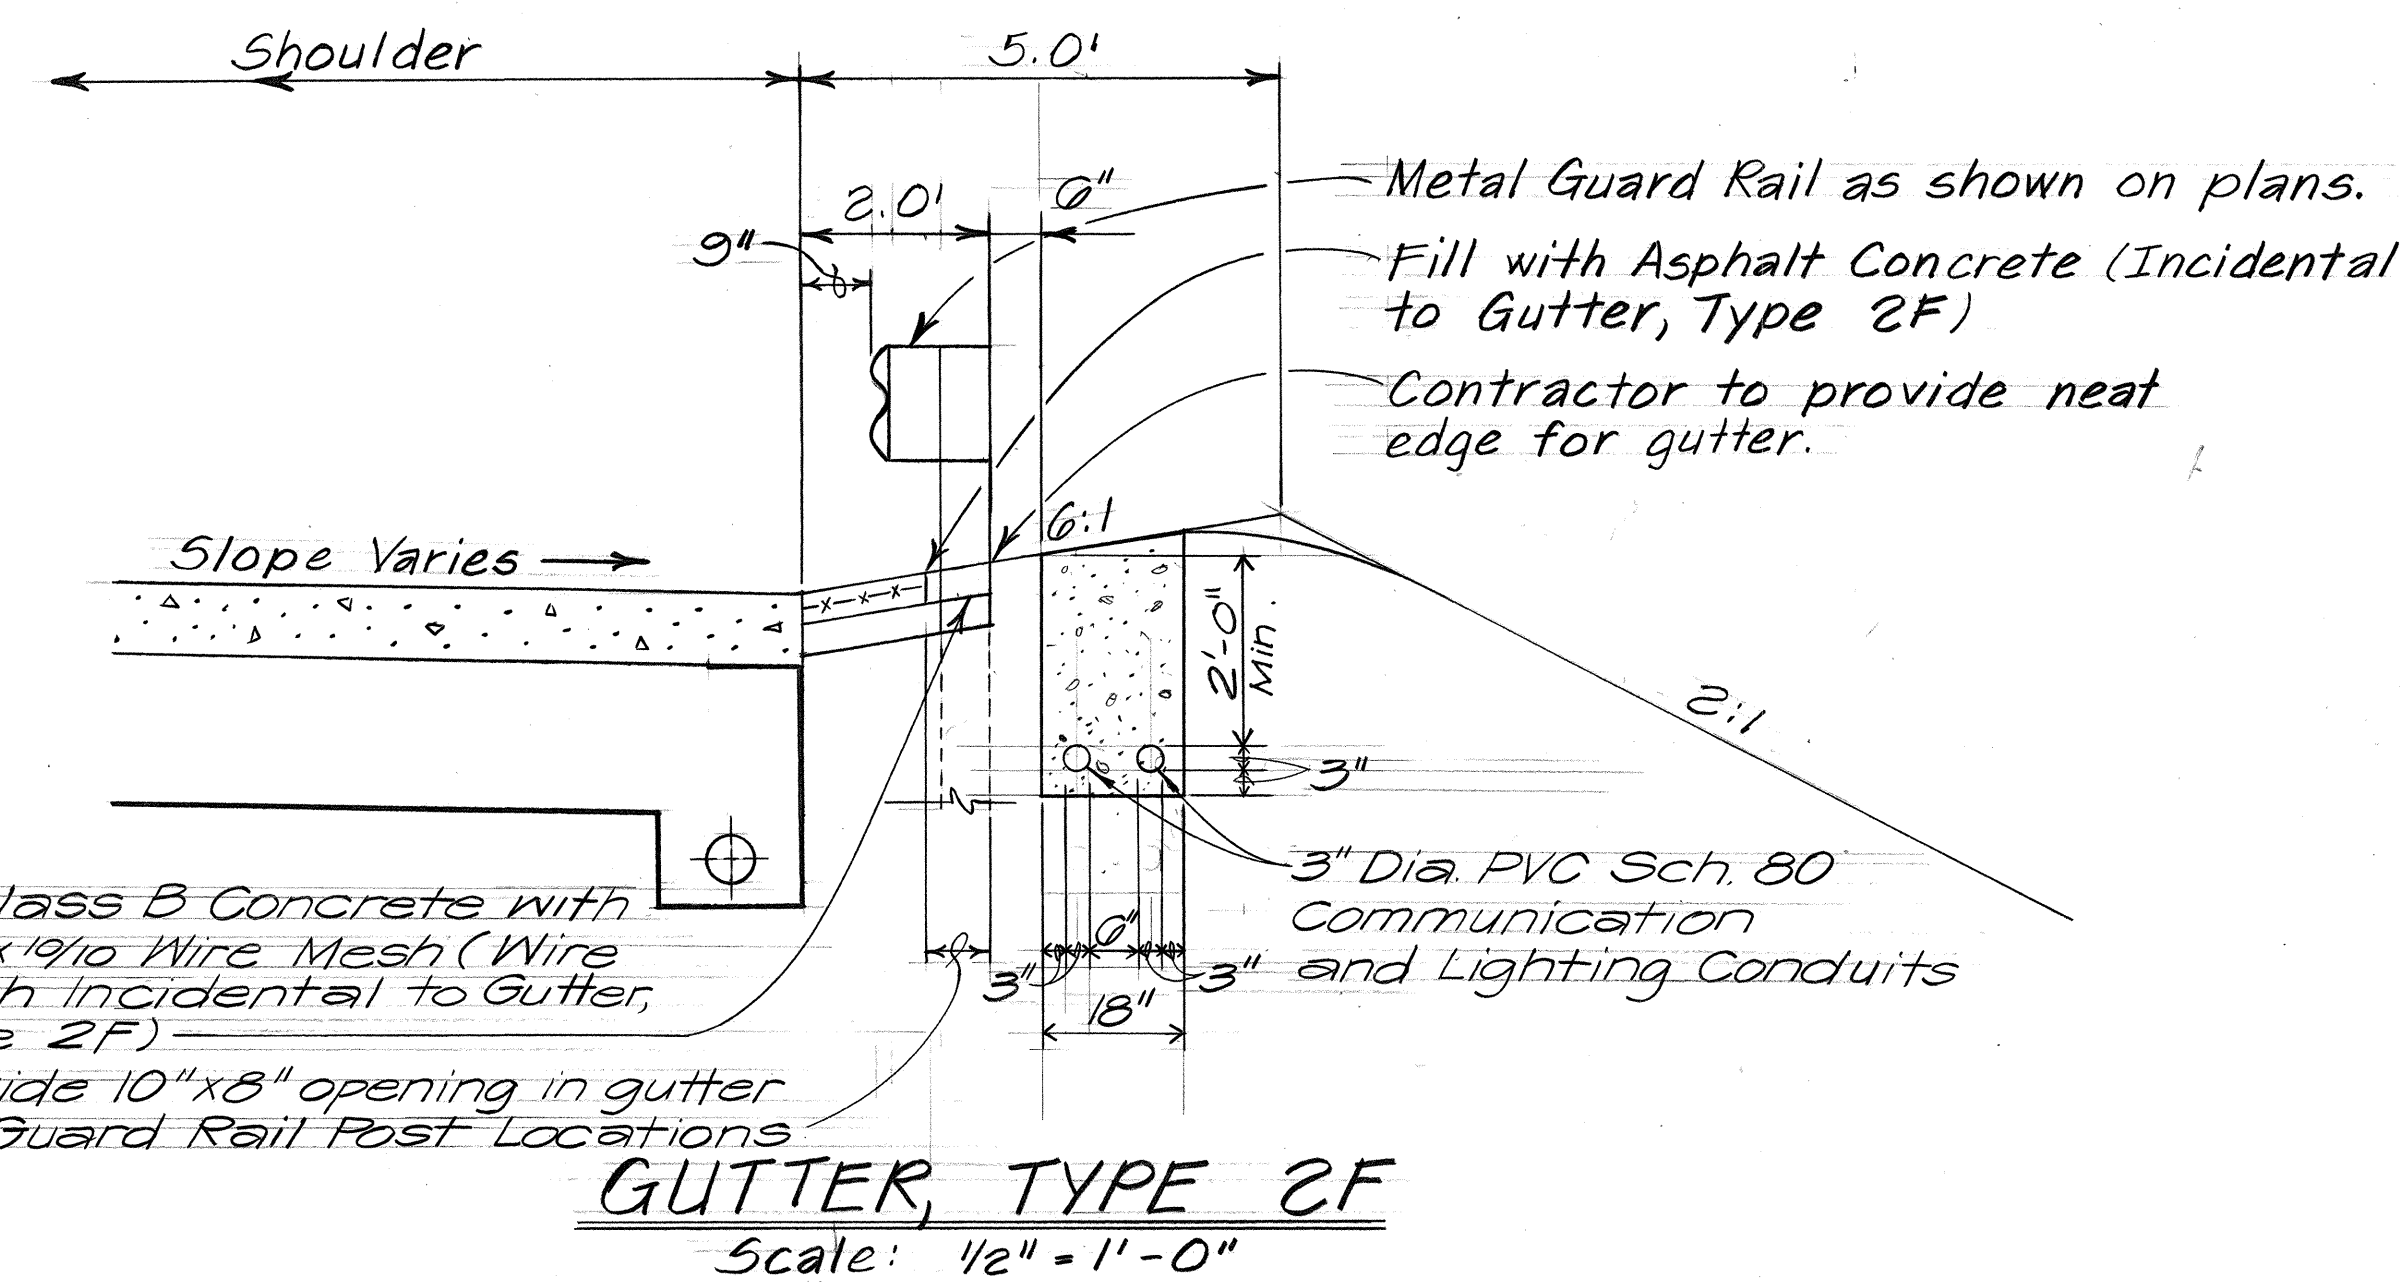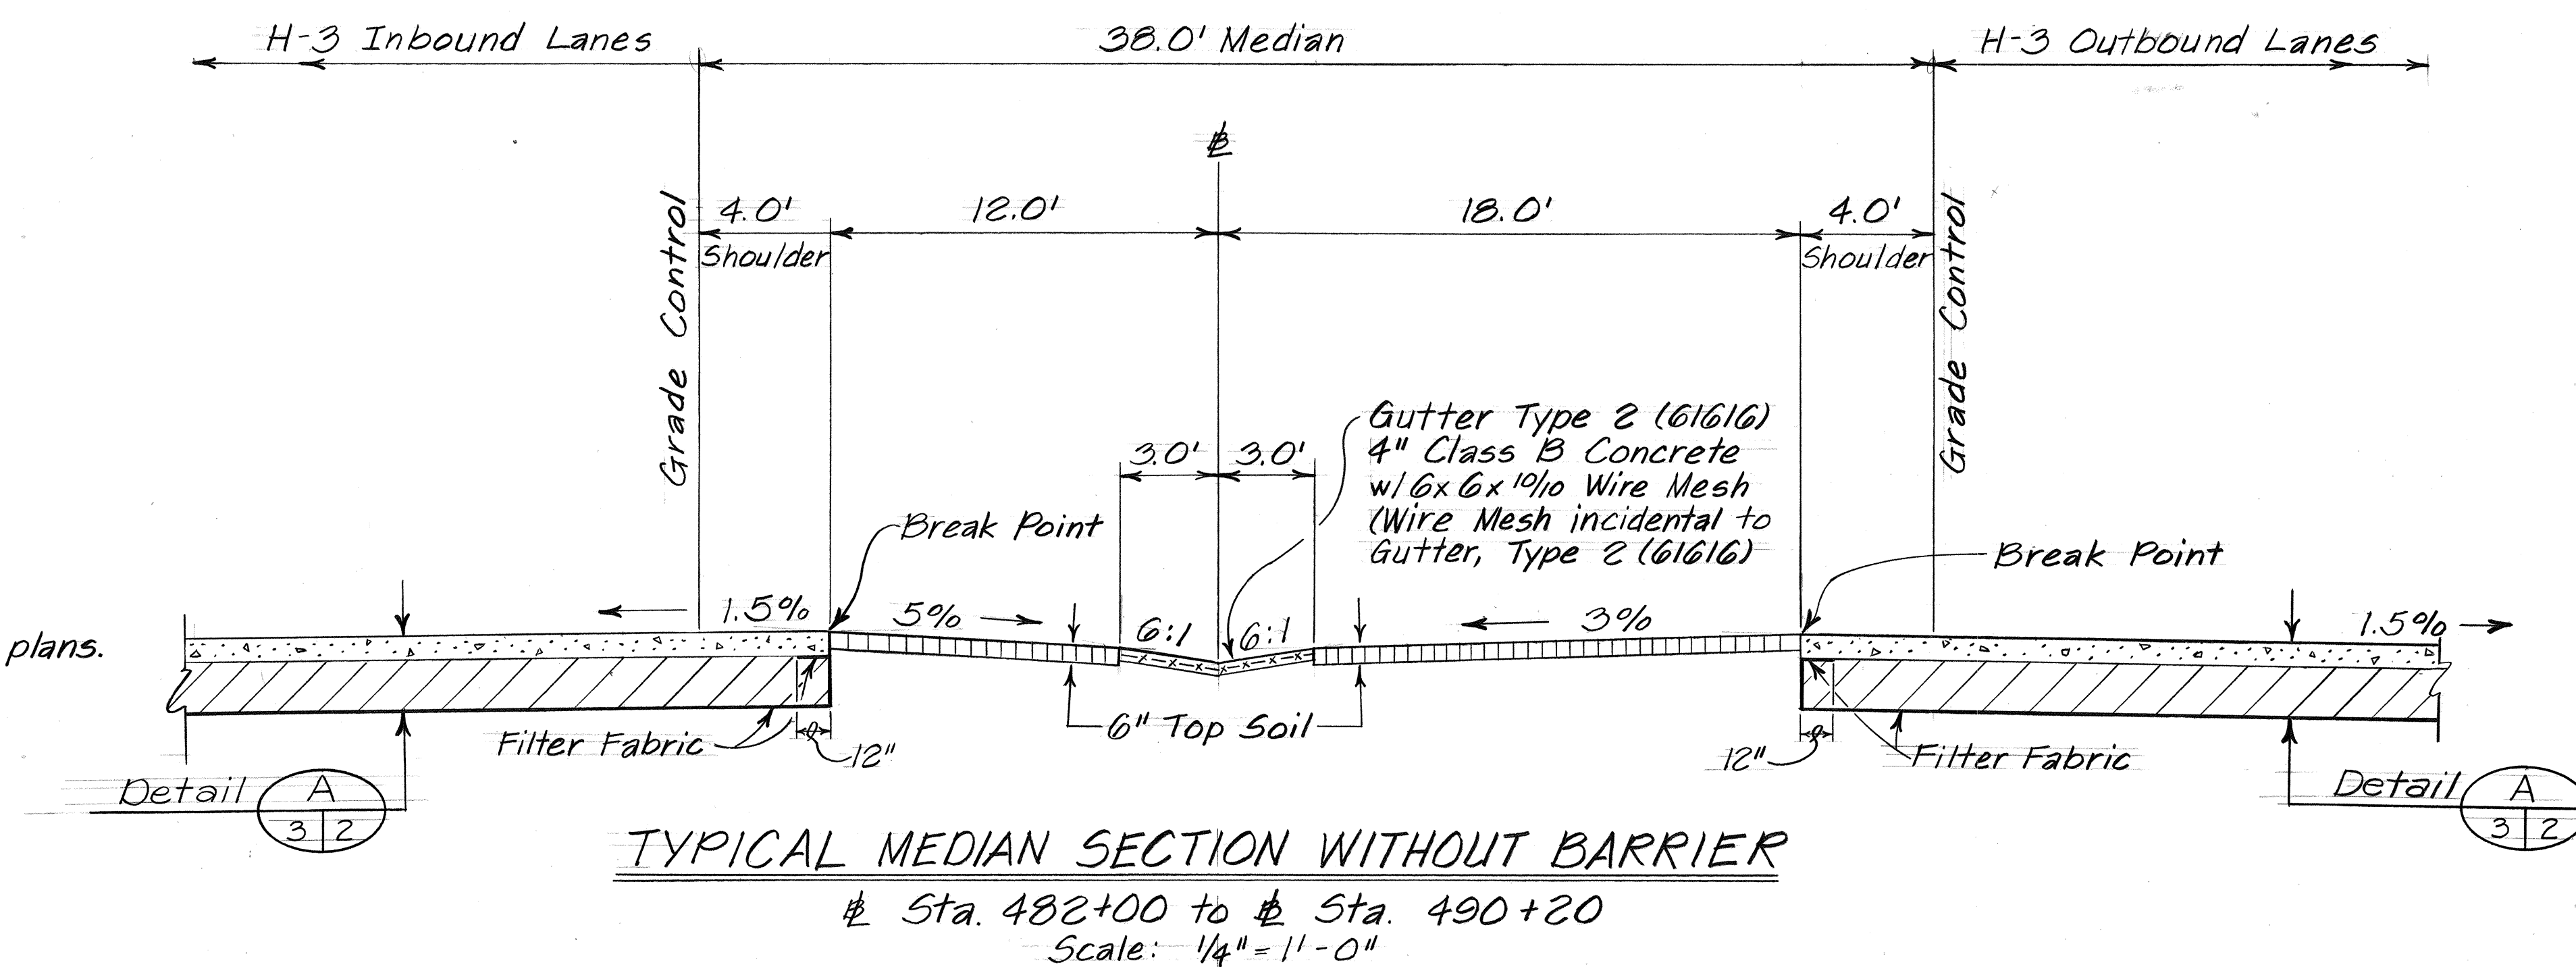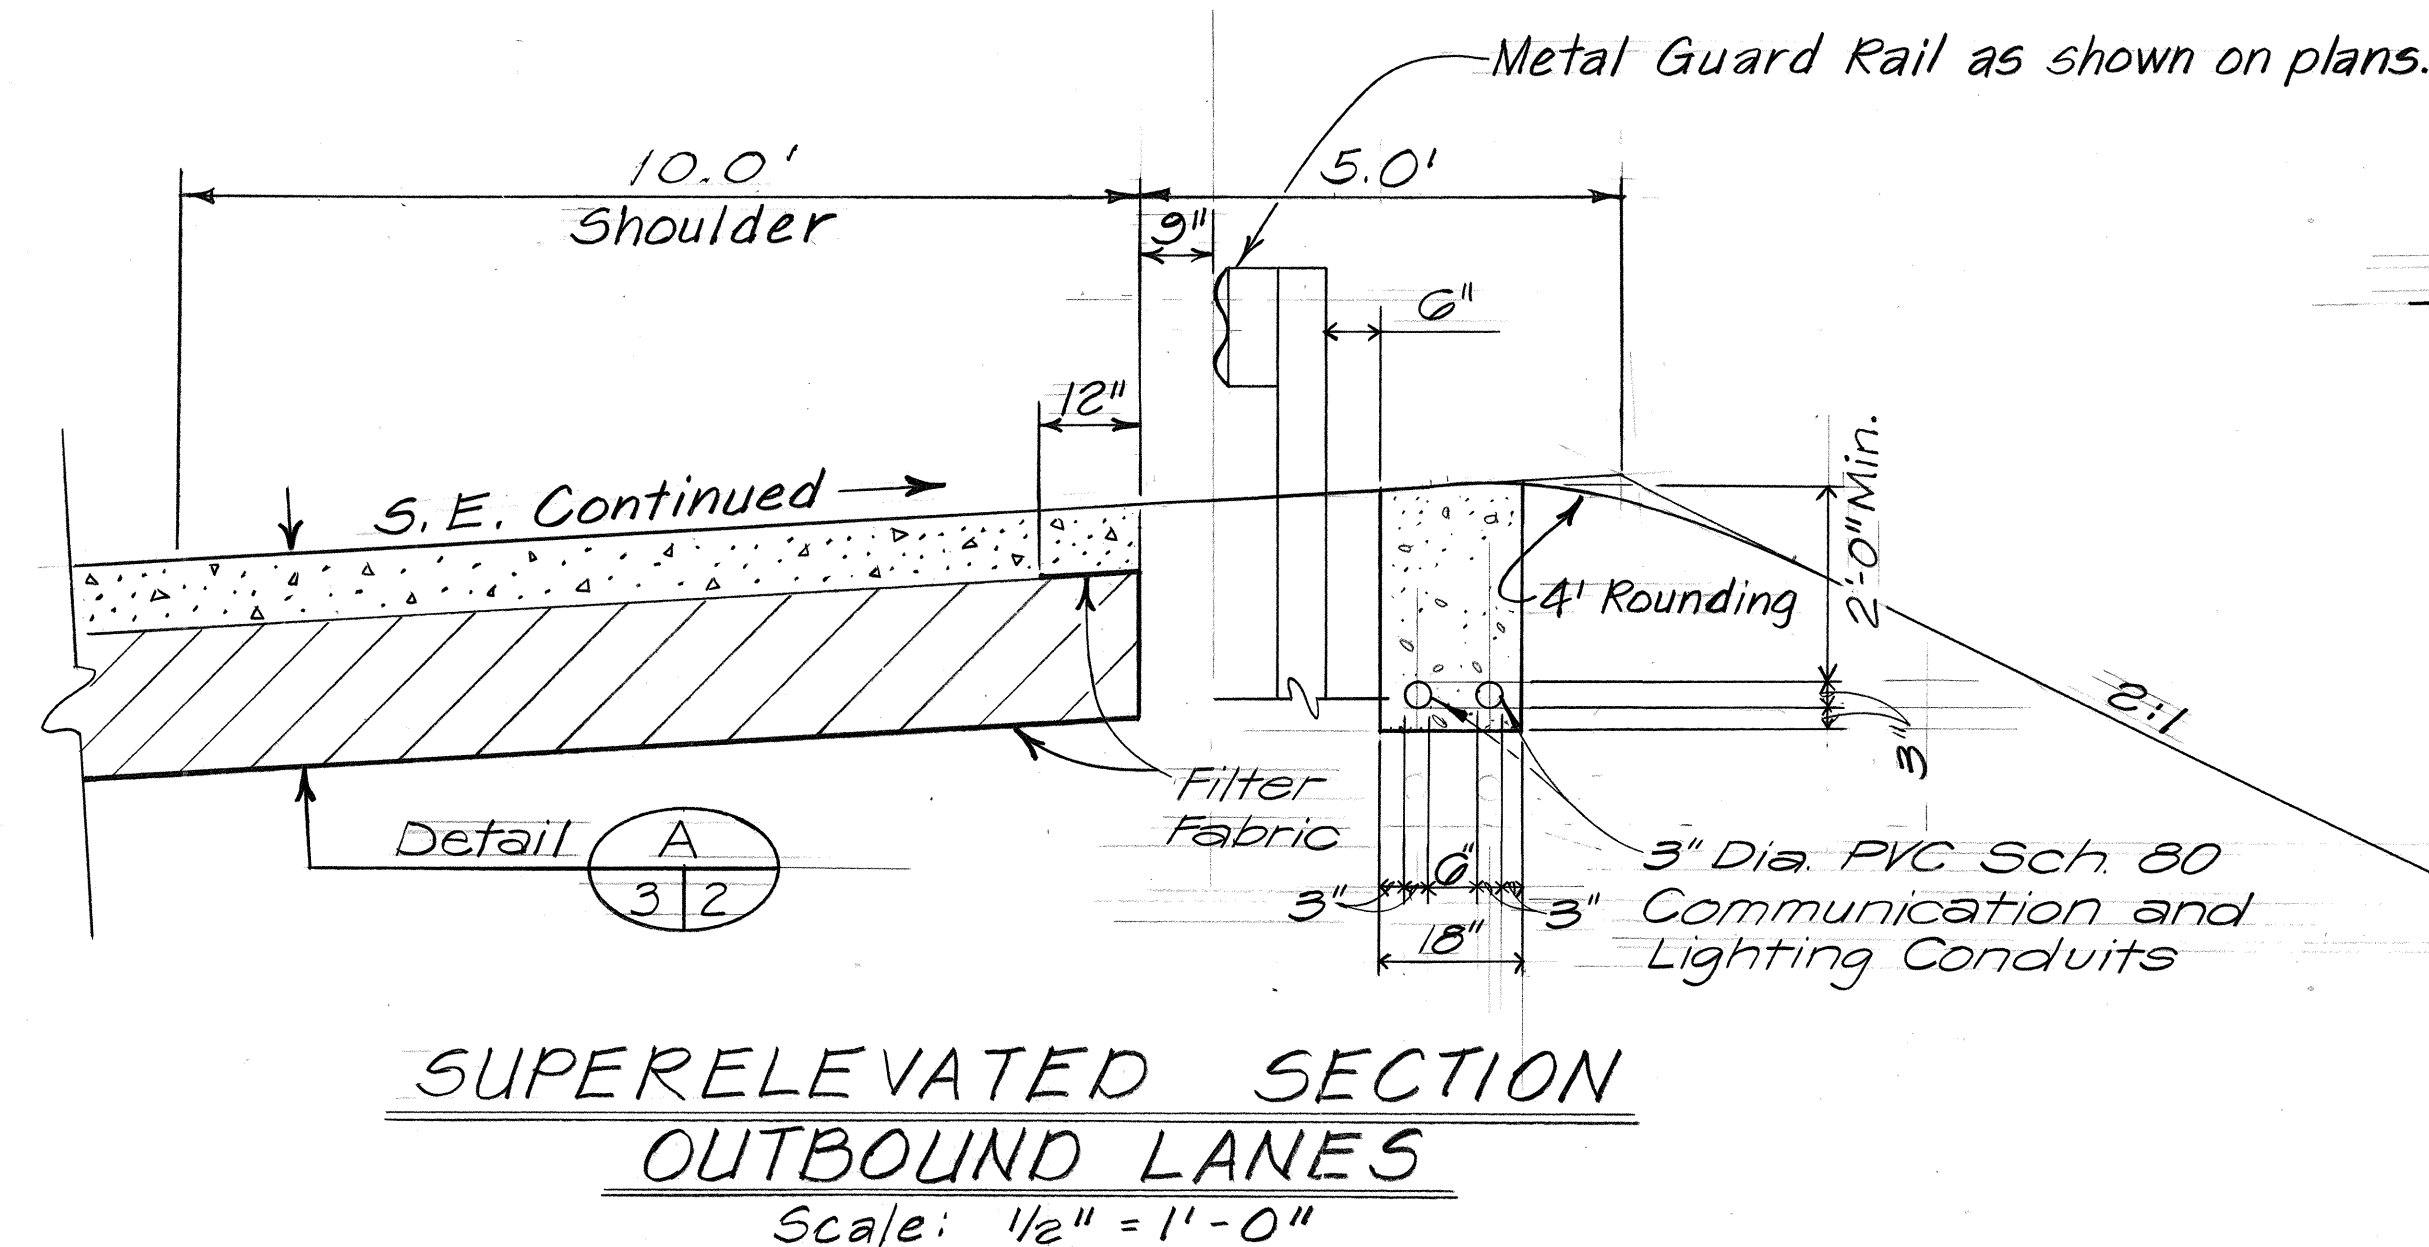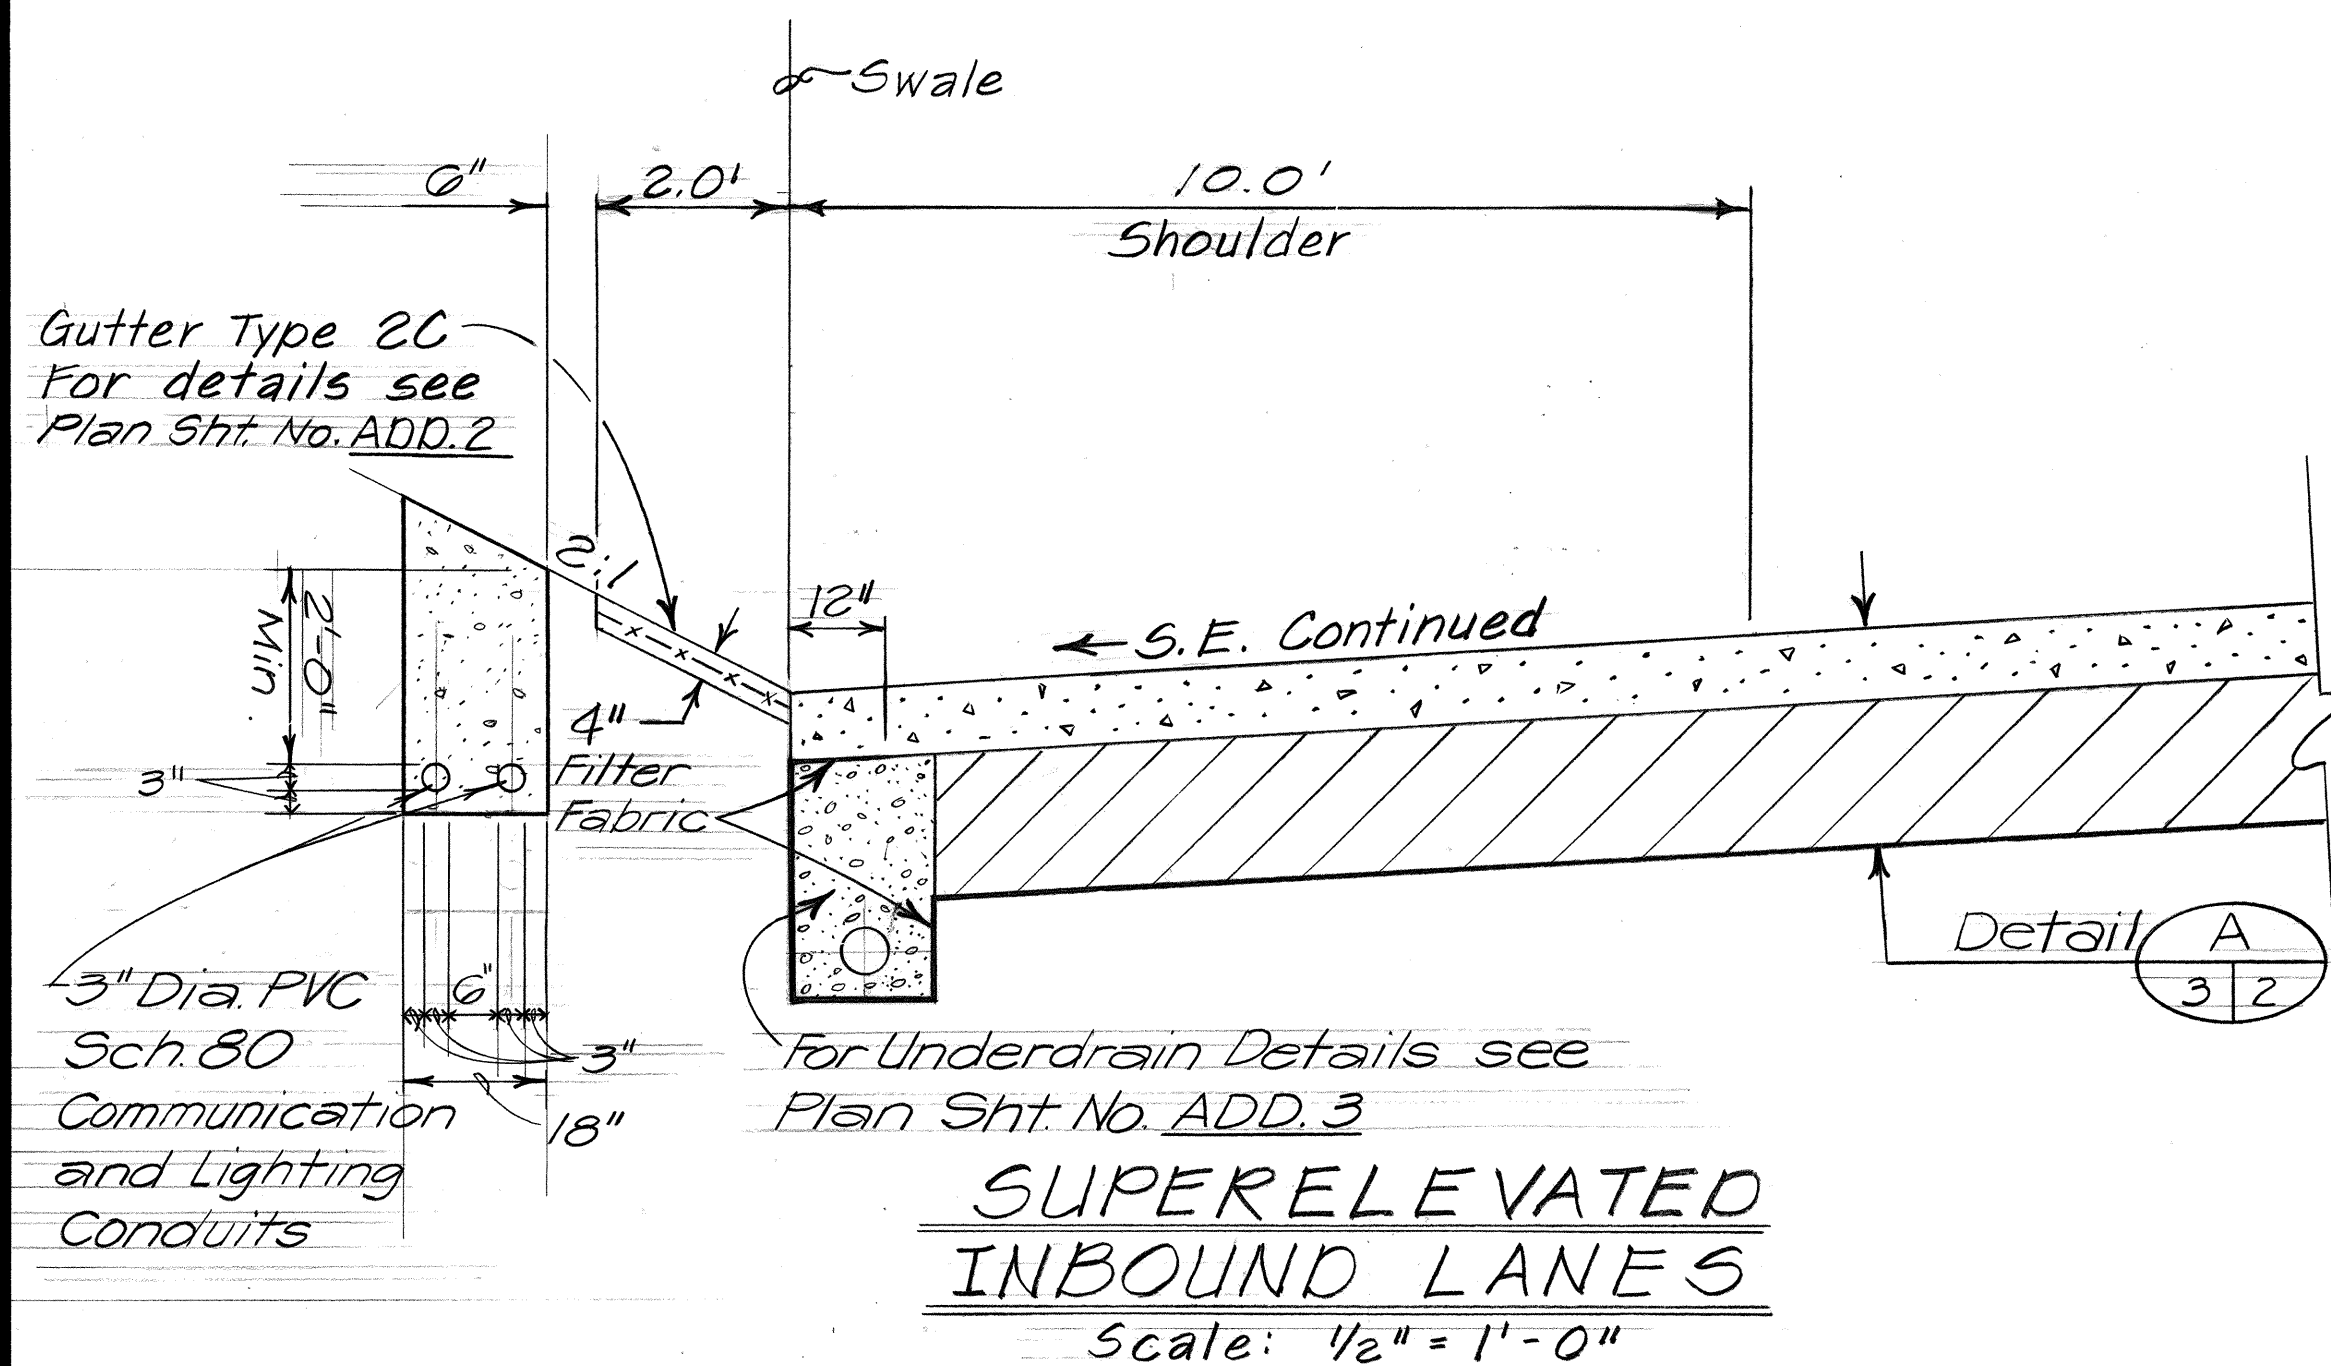


DATE	REVISION
10/9/90	C.O.-Revised Trench Depth of Communication and Lighting Conduits.
7/12/90	Added Communication and Lighting Conduits
3/2/89	Revised Pavement Design from 2 1/2" A.C. Mix No. I to 8 1/2" P.C.C.P. Revised plan sheet reference numbers

STATE OF HAWAII DEPARTMENT OF TRANSPORTATION LAND TRANSPORTATION FACILITIES DIVISION
TYPICAL ROADWAY SECTIONS DETAILS OF GUTTER, TYPE 2
INTERSTATE ROUTE H-3 F.A.I. Project No. I-H3-1 (50)
Scale: As Shown Date: Aug, 1988
SHEET NO. 2 OF 3 SHEETS


C.O.ADD.4

DATE	DESIGNED BY	CHECKED BY
PLAN	NOTED BY	QUANTITIES BY
ORIGINAL	NO.	


FED. ROAD DIST. NO.	STATE	FED. AID PROJ. NO.	FISCAL YEAR	SHEET NO.	TOTAL SHEETS
HAWAII	HAW.	I-H3-1(50)	1991	C0.4 S-1	164

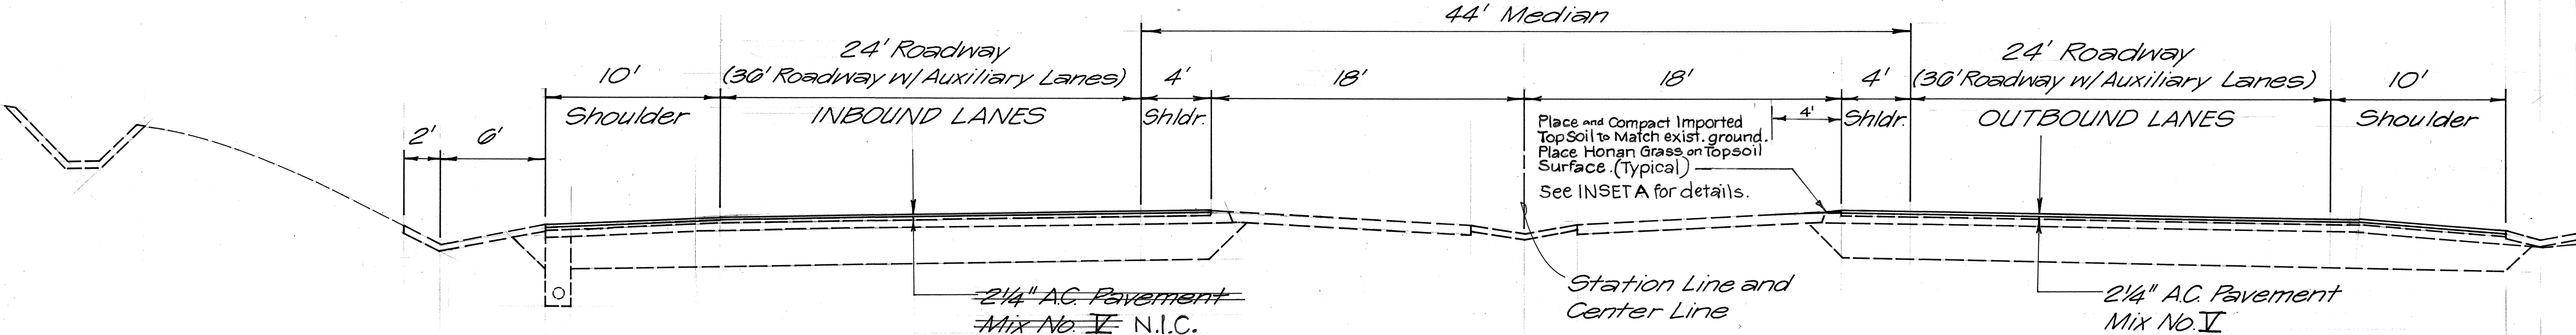


TANGENT SECTION-INBOUND AND OUTBOUND LANES
 STA. 490+20 to STA. 520+00
 Scale: 1"=5'-0"

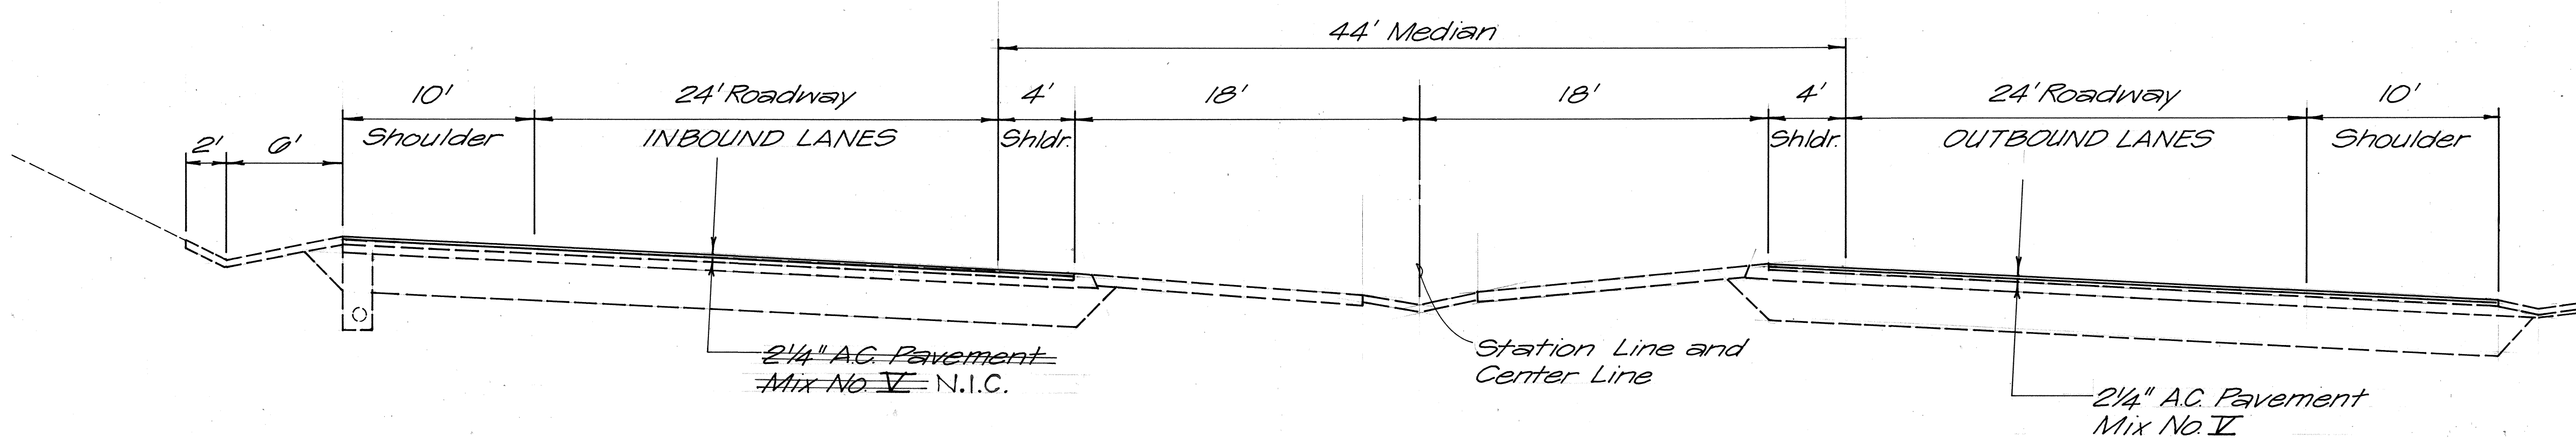


SUPERELEVATED SECTION-INBOUND AND OUTBOUND LANES
 STA. 490+20 to STA. 520+00
 Scale: 1"=5'-0"

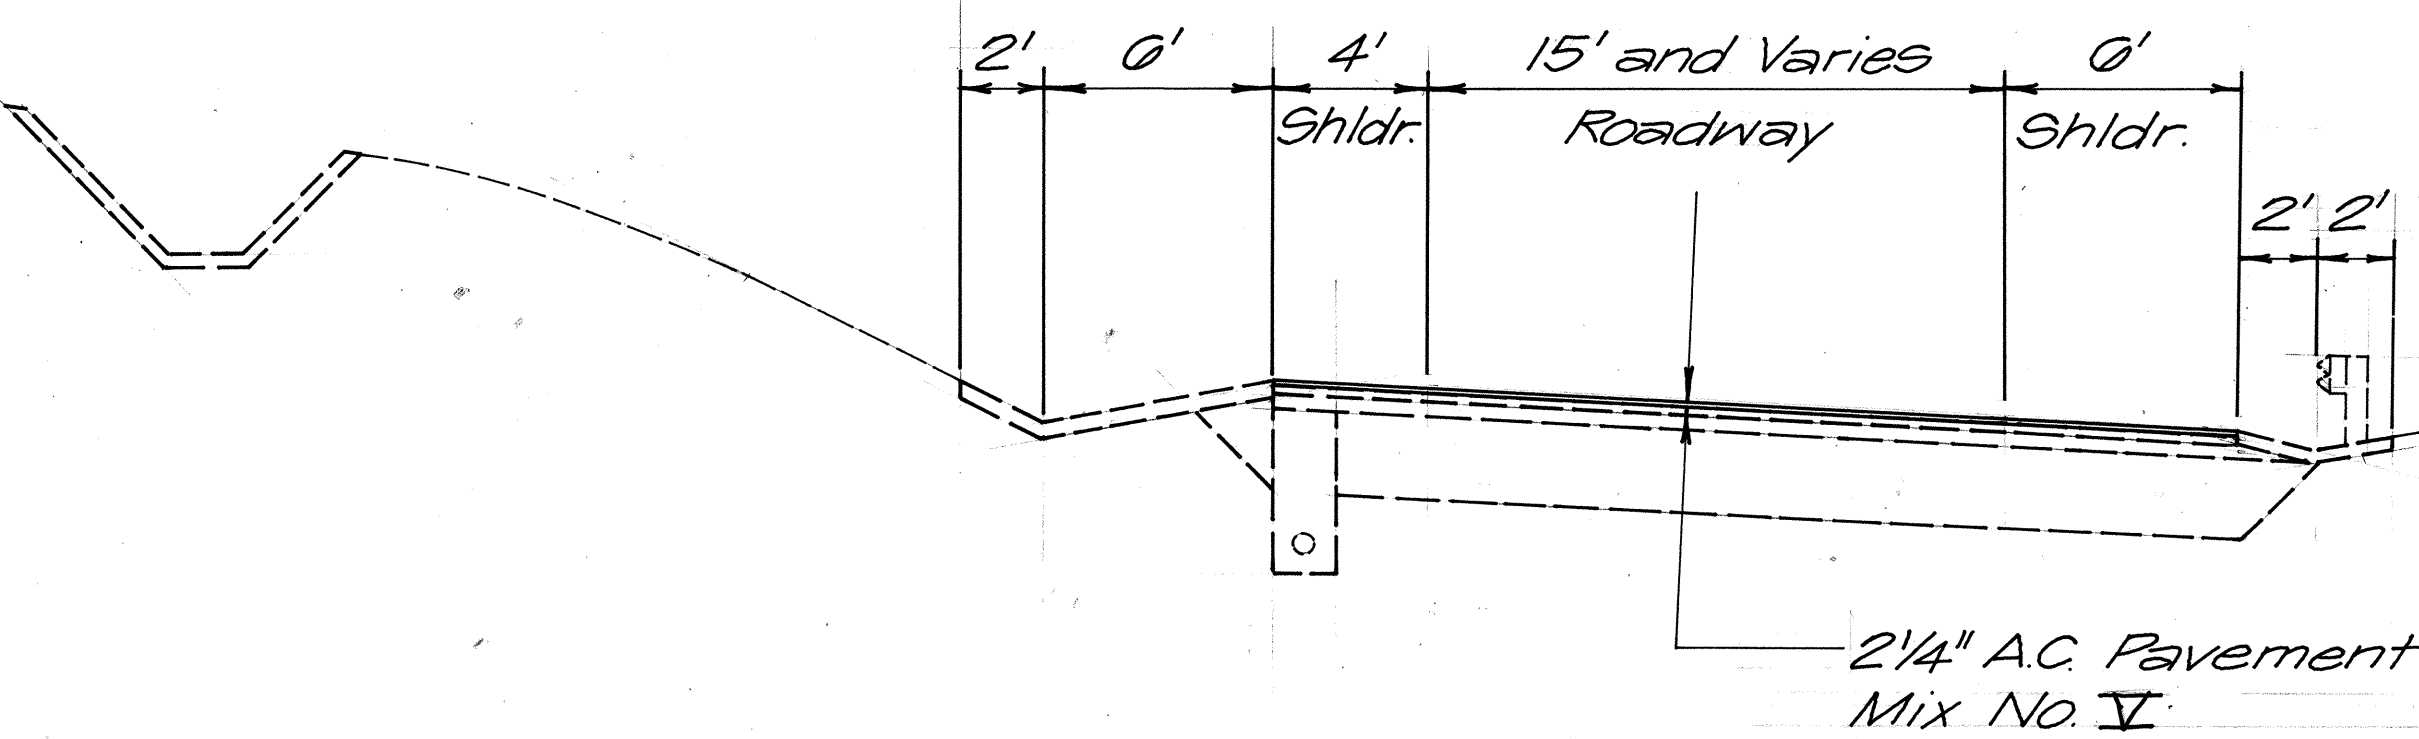


TYPICAL SECTION-RAMPS "A", "B", "C", & "F"
 Scale: 1"=5'-0"

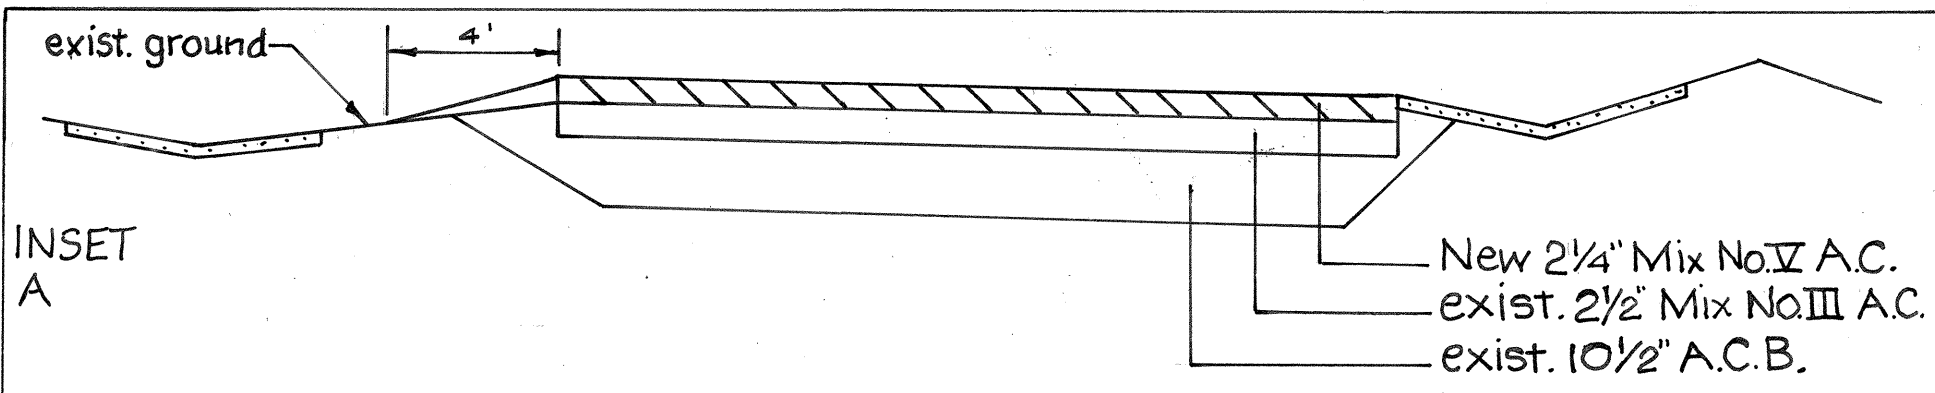

TYPICAL SECTION
 H-3 EASTBOUND LANE
 STA. 490+20 to STA. 508+80, STA. 514+40 to 517+86±
 N.T.S.

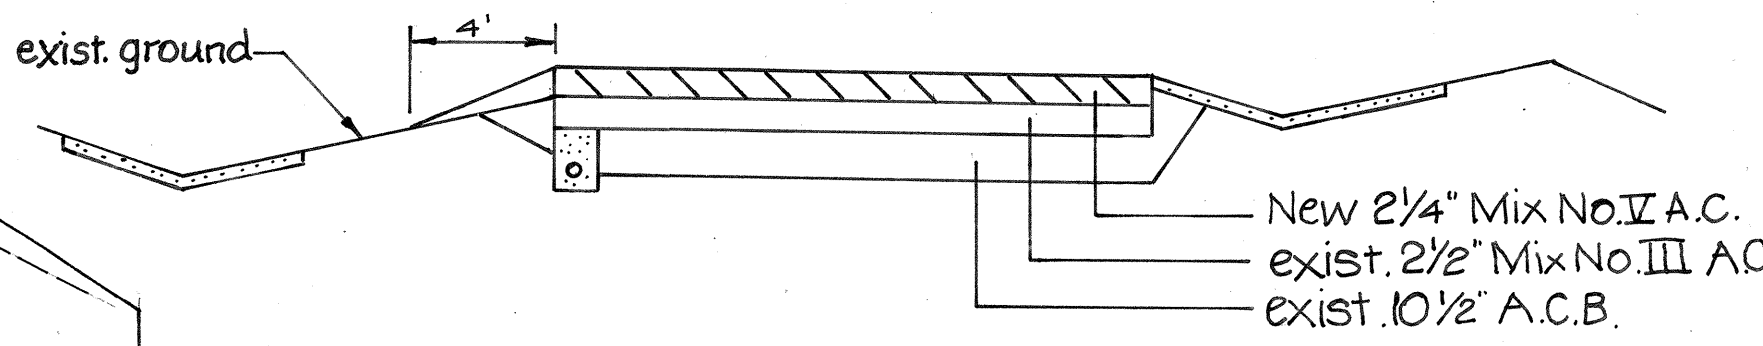

TYPICAL SECTION
 RAMPA, STA. 7+75 to STA. 16+00±
 N.T.S.

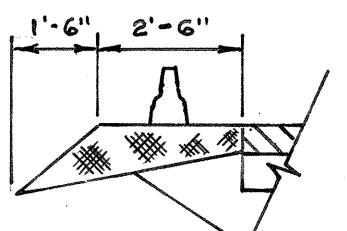


PARTIAL TYPICAL SECTION (N.T.S.)
 H-3 STA. 308+80± to STA. 514+40±

1/21/92	Added dressed shoulder along left edge of pavement at Halekou Interchange.
5/22/91	Sheet added to show typical roadway sections

DATE	REVISION
STATE OF HAWAII DEPARTMENT OF TRANSPORTATION HIGHWAYS DIVISION <u>TYPICAL ROADWAY SECTIONS</u> HALEKOU INTERCHANGE F.A.I. Project No. I-H3-1(50) Scale: As Shown Date: Oct, 1990 SHEET No. 1 OF 1 SHEETS	


SURVEY PLOTTED BY	DATE
DRAWN BY	
CHECKED BY	
NOTED BY	
QUANTITIES BY	
CHECKED BY	
ORIGINAL PLAN	
NOTE BOOK	
NO.	

FED. ROAD DIST. NO.	STATE	FED. AID PROJ. NO.	FISCAL YEAR	SHEET NO.	TOTAL SHEETS
HAWAII	HAW.	I-H3-1(50)	1989	5	104

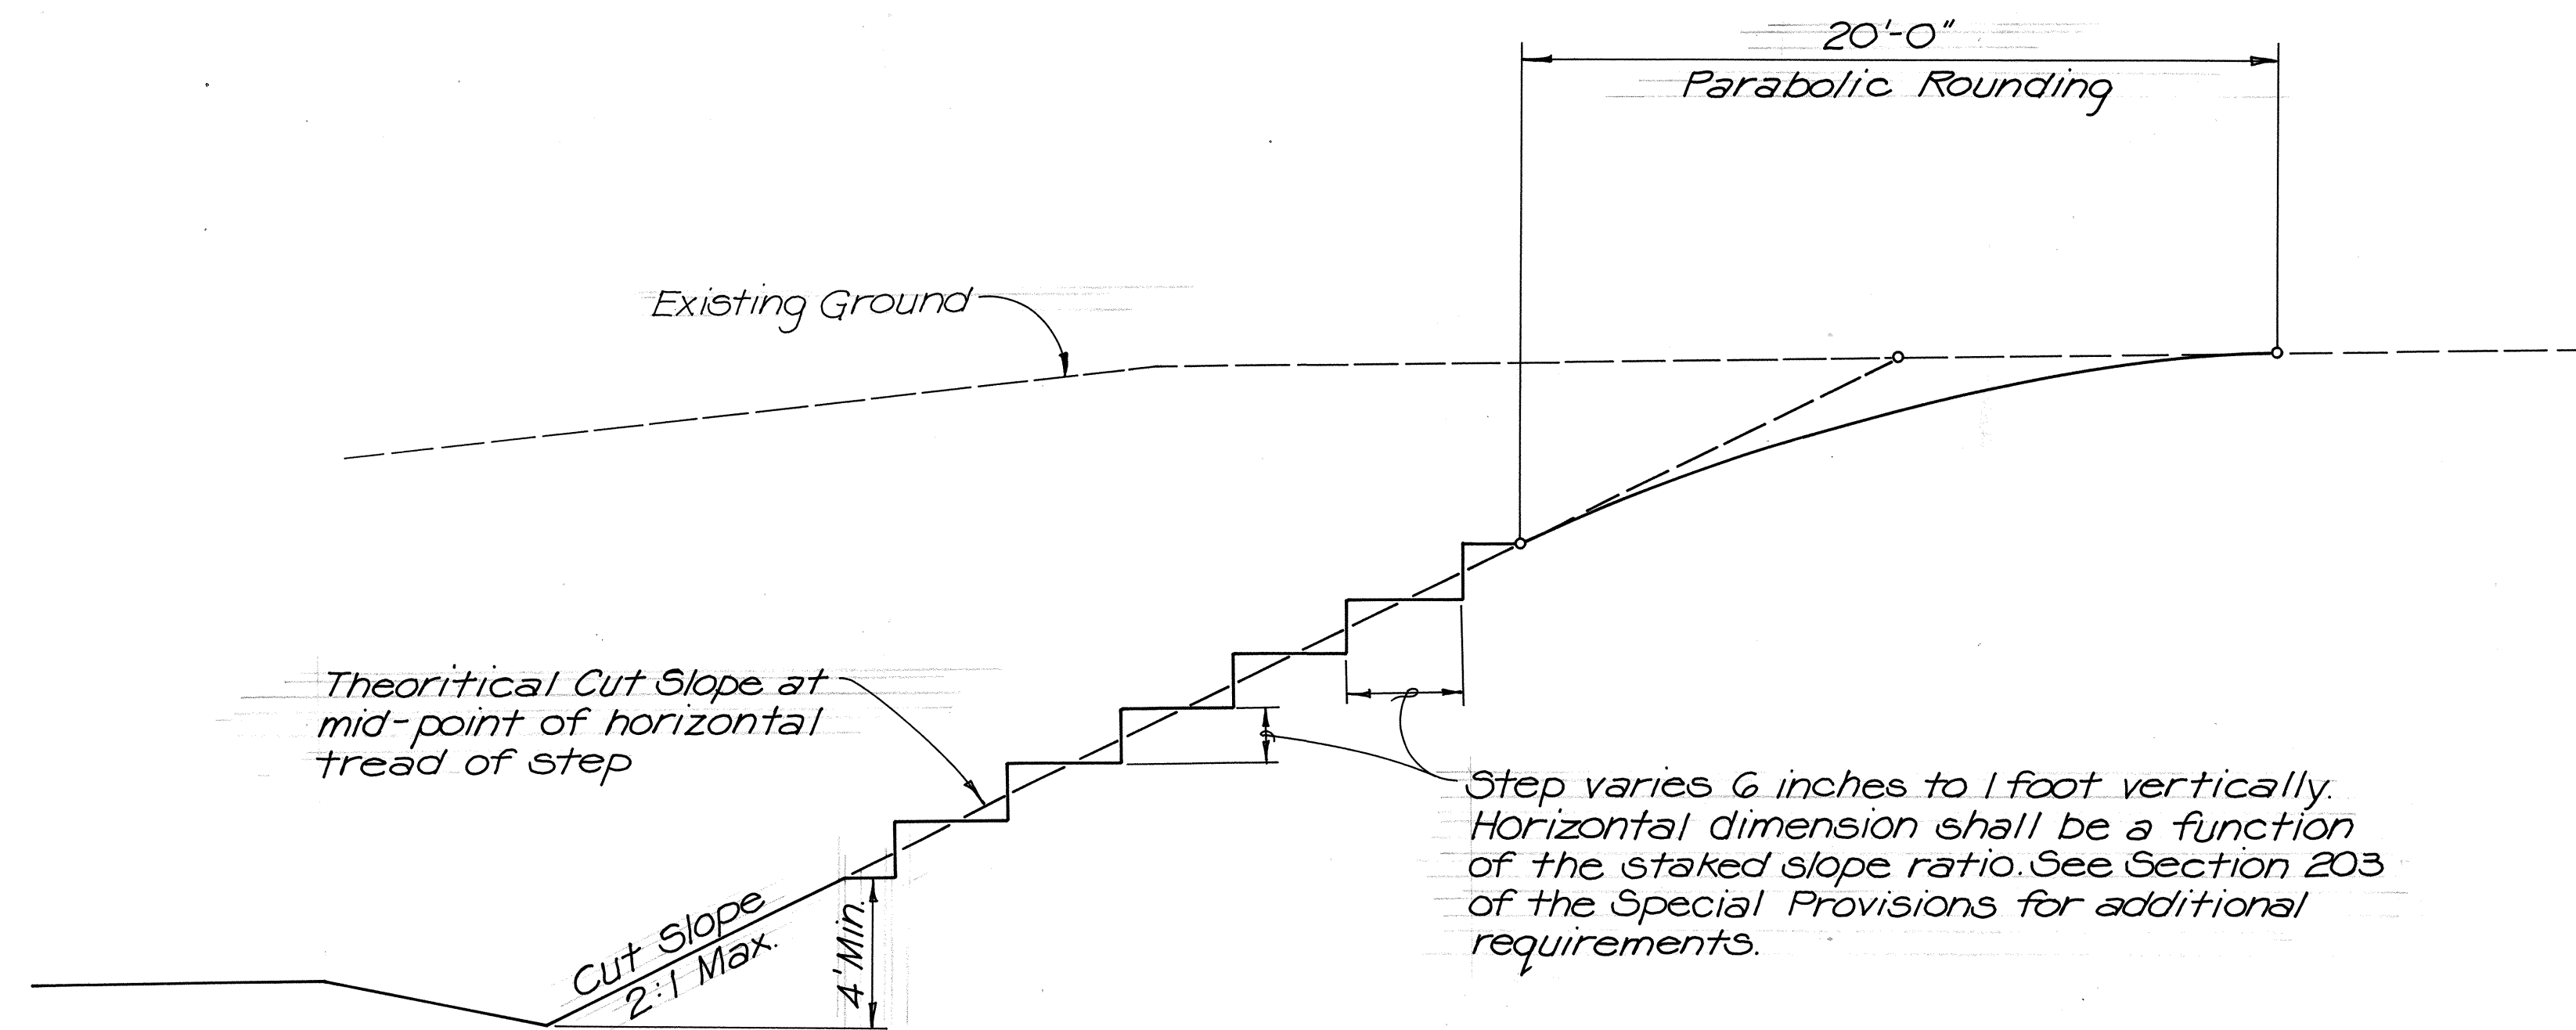

SERRATED CUT SLOPE DETAIL

Not to Scale

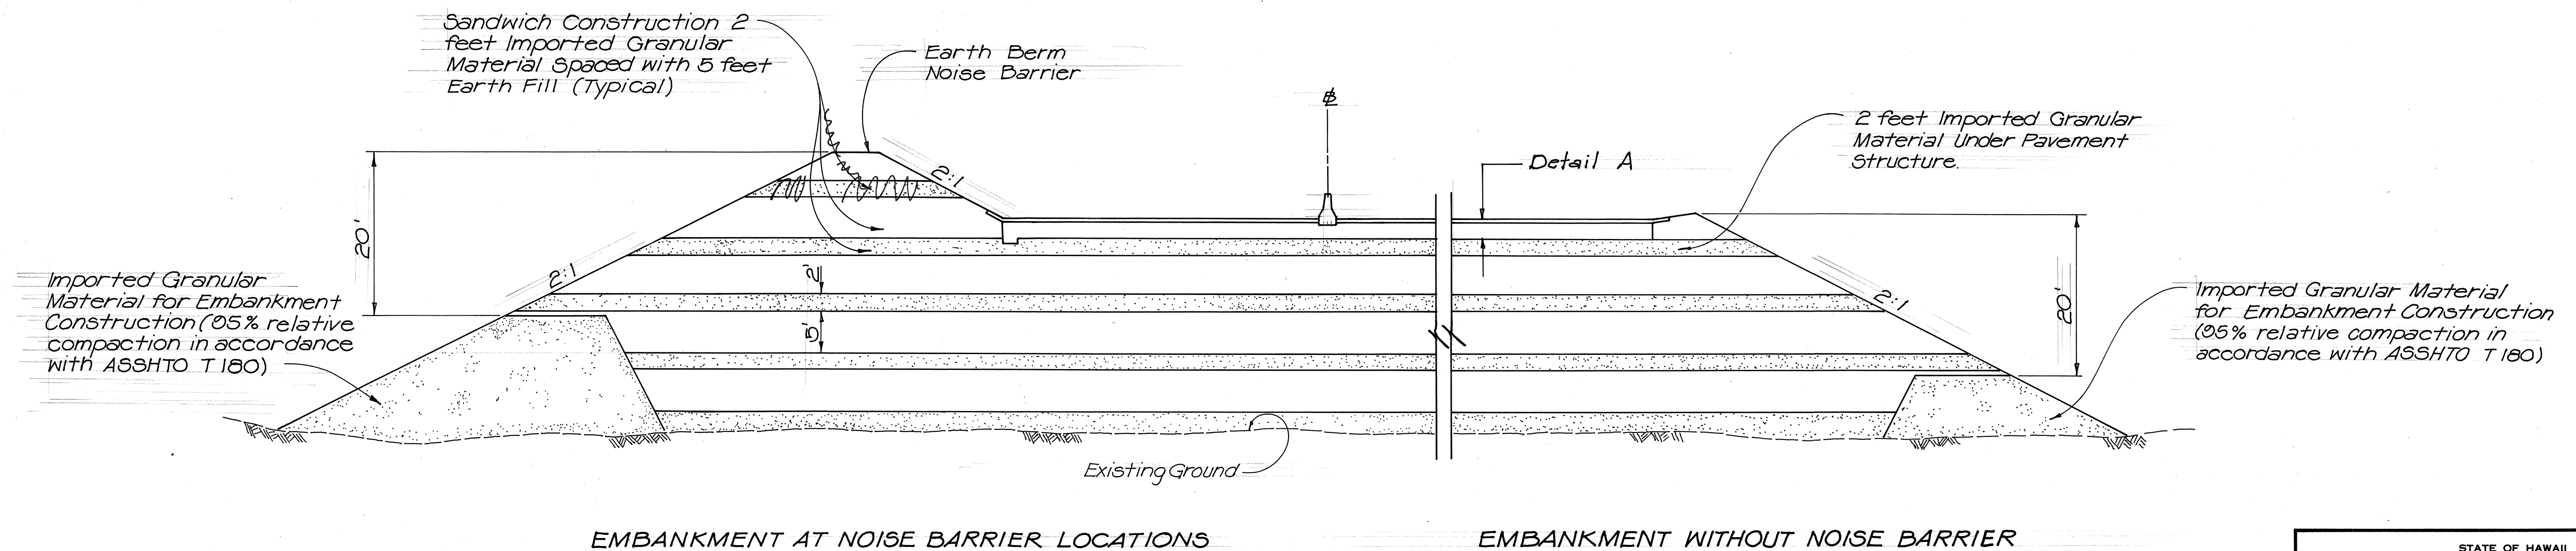

TYPICAL SECTION SANDWICH CONSTRUCTION AT EMBANKMENT SECTION

Scale: 1" = 10'

STATE OF HAWAII
DEPARTMENT OF TRANSPORTATION
HIGHWAYS DIVISION

TYPICAL SECTIONS



INTERSTATE ROUTE H-3
F.A.I. PROJECT NO. I-H3-1(50)

Scale: As Shown Date: August, 1988

SHEET NO. 3 OF 3 SHEETS

SURVEY PLOTTED BY	DATE
DRAWN BY	
CHECKED BY	
QUANTITIES BY	
CHECKED BY	
ORIGINAL PLAN	
NOTE BOOK	
NO.	

FED. ROAD DIST. NO.	STATE	FED. AID PROJ. NO.	FISCAL YEAR	SHEET NO.	TOTAL SHEETS
HAWAII	HAW.	I-H3-1(50)	1989	C.O.5 S-1	

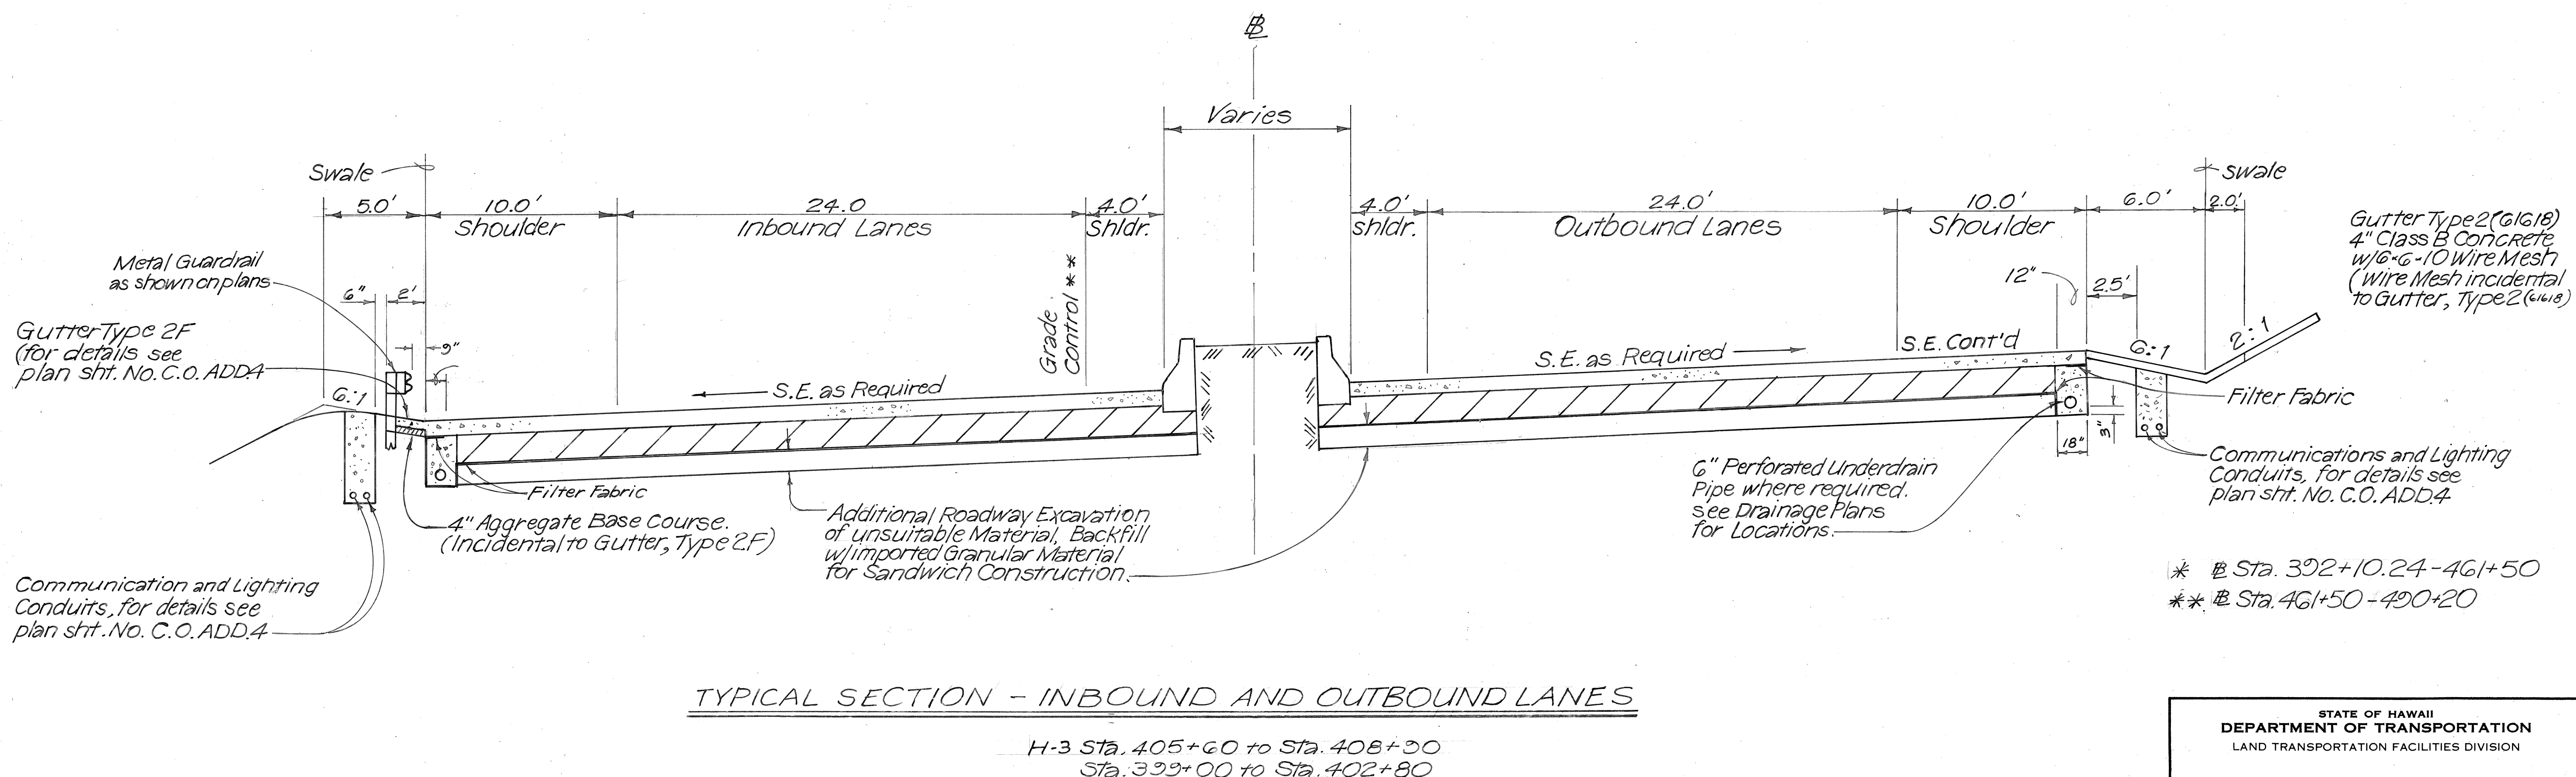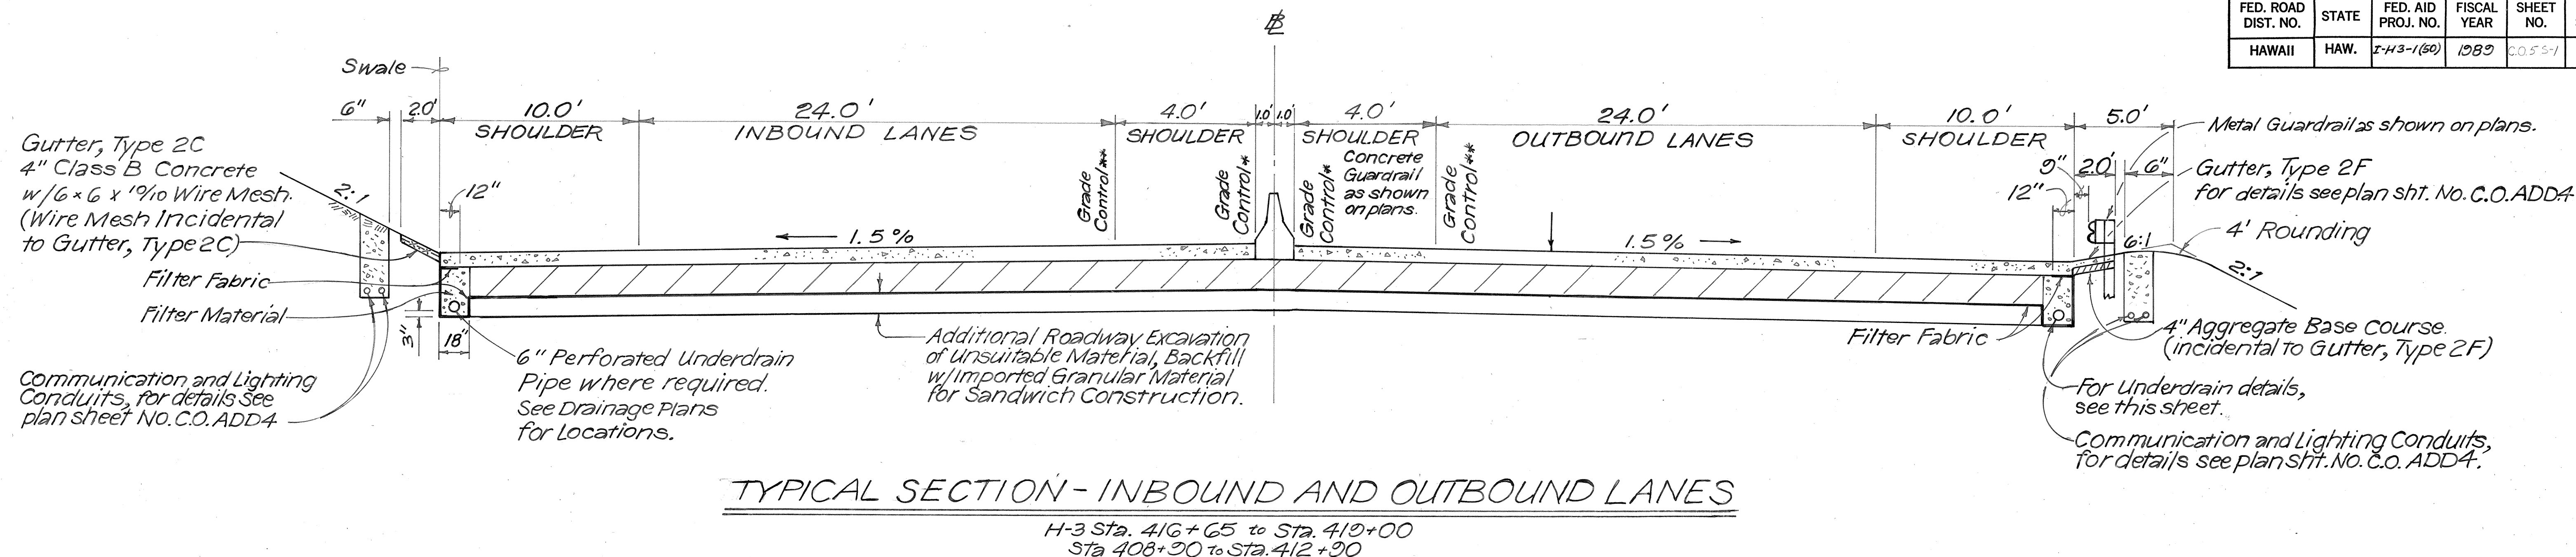

* Sta. 392+10.24-461+50
** Sta. 461+50-490+20

STATE OF HAWAII	
DEPARTMENT OF TRANSPORTATION	
LAND TRANSPORTATION FACILITIES DIVISION	
TYPICAL SECTIONS	
INTERSTATE ROUTE H-3	
F.A.I. PROJECT NO. I-H3-1(50)	
Scale: 1/4"=1'-0"	Date:
SHEET NO.	OF SHEETS

C.O.5 S-1