



ORIGINAL PLAN	SURVEY PLOTTED BY	DATE
	DRAWN BY <u>R. MALALUAN</u>	<u>3/6/90</u>
	TRACED BY	
	DESIGNED BY <u>K. WADA</u>	<u>3/5/90</u>
	QUANTITIES BY	
NO.	CHECKED BY <u>H. P. CHEN</u>	<u>3/3/90</u>



DETAIL FOR TYPE I SHAFT
AND METHOD TEST SHAFT
SCALE $\frac{3}{4}'' = 1'-0''$

1. PROVIDE SIZING HOOPS AS A GUIDE FOR THE FABRICATION OF THE REBAR CAGE.
2. PROVIDE CENTERING DEVICES AS A GUIDE FOR THE PLACEMENT OF THE REBAR CAGE IN THE DRILLED HOLE.
3. PROVIDE TEMPORARY STIFFENERS TO STRENGTHEN THE REBAR CAGE DURING LIFTING. STIFFENERS ARE TO BE REMOVED PRIOR TO POURING OF CONCRETE.
4. SPLICES IN THE LONGITUDINAL STEEL, IF REQUIRED, SHOULD BE STAGGERED SO AS NOT TO OCCUR AT THE SAME HORIZONTAL PLANE ALONG THE REBAR CAGE.
5. #4 CIRCULAR SPIRAL IN REBAR CAGE SHALL BE USED. NO CIRCULAR TIES ARE ALLOWED TO USE IN DRILLED SHAFTS EXCEPT OTHERWISE AS NOTED.
6. THE REBAR CAGE SHALL BE FABRICATED AND STORED SO AS TO AVOID DISTORTION DURING TRANSPORTATION TO THE JOB SITE AND TO AVOID CONTAMINATION WITH MUD OR OTHER DELETERIOUS MATERIAL.
7. FOR SLUMP OF CONCRETE SEE SPECIAL PROVISIONS.
8. PLACEMENT OF THE CONCRETE SHALL BE MADE BY USE OF A TREMIE OR PUMP LINE.
9. FOR INSTRUMENTATIONS IN SHAFT, SEE SHEET NOS. S4 AND S5.
10. TOP CONCRETE OF TYPE I SHAFT SHALL BE FINISHED TO A SMOOTH AND TRUE LEVEL SURFACE BY TROWELING WHILE CONCRETE REMAINS WORKABLE OR GRINDING AFTER CONCRETE IS HARDENED.
11. IN THE INSTALLATION OF HIGH STRENGTH THREAD BARS, THE CONTRACTOR SHALL PROVIDE RIGID TEMPLATES TO MAINTAIN THE PROPER LOCATIONS AND SHALL PROTECT SUCH BARS AT ALL TIMES DURING CONSTRUCTION.

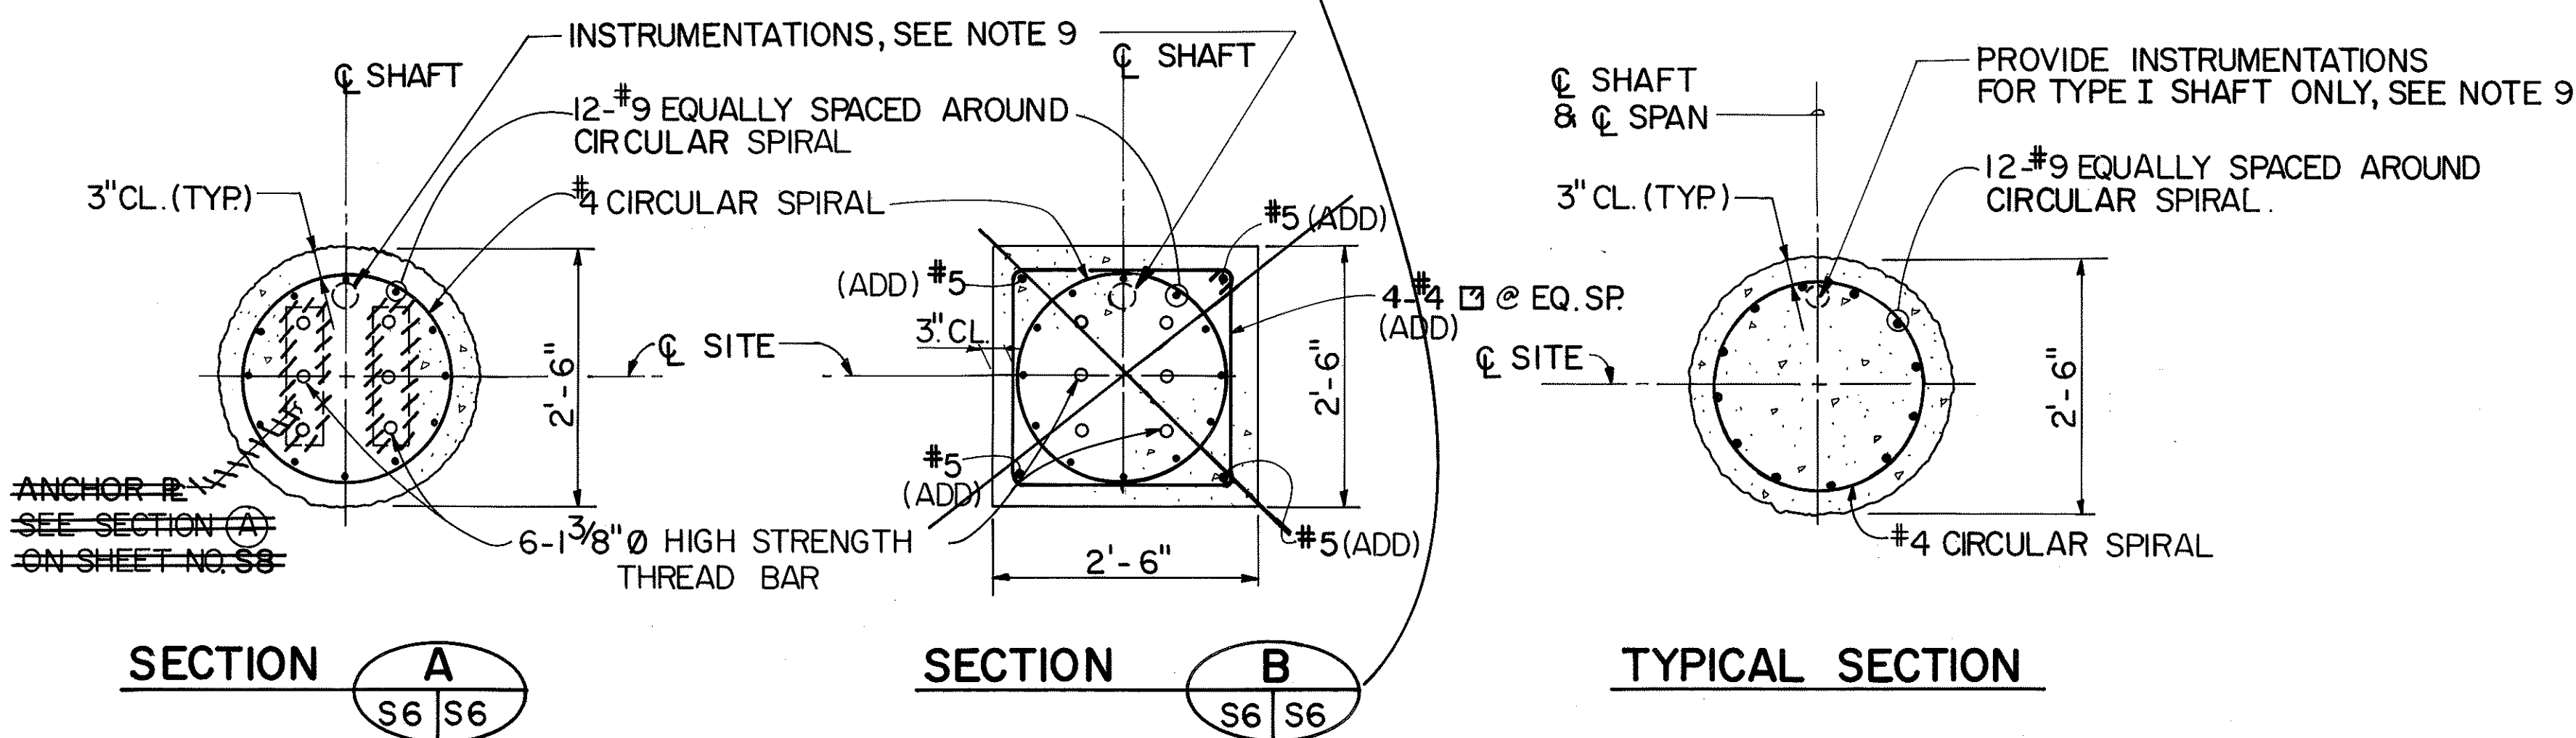

HUI PANG CHEN
 REGISTERED
 PROFESSIONAL
 ENGINEER
 No. 3863-S
 HAWAII U.S.A.

THIS WORK WAS PREPARED
 OR UNDER MY SUPERVISION
 Hui pang Chen