

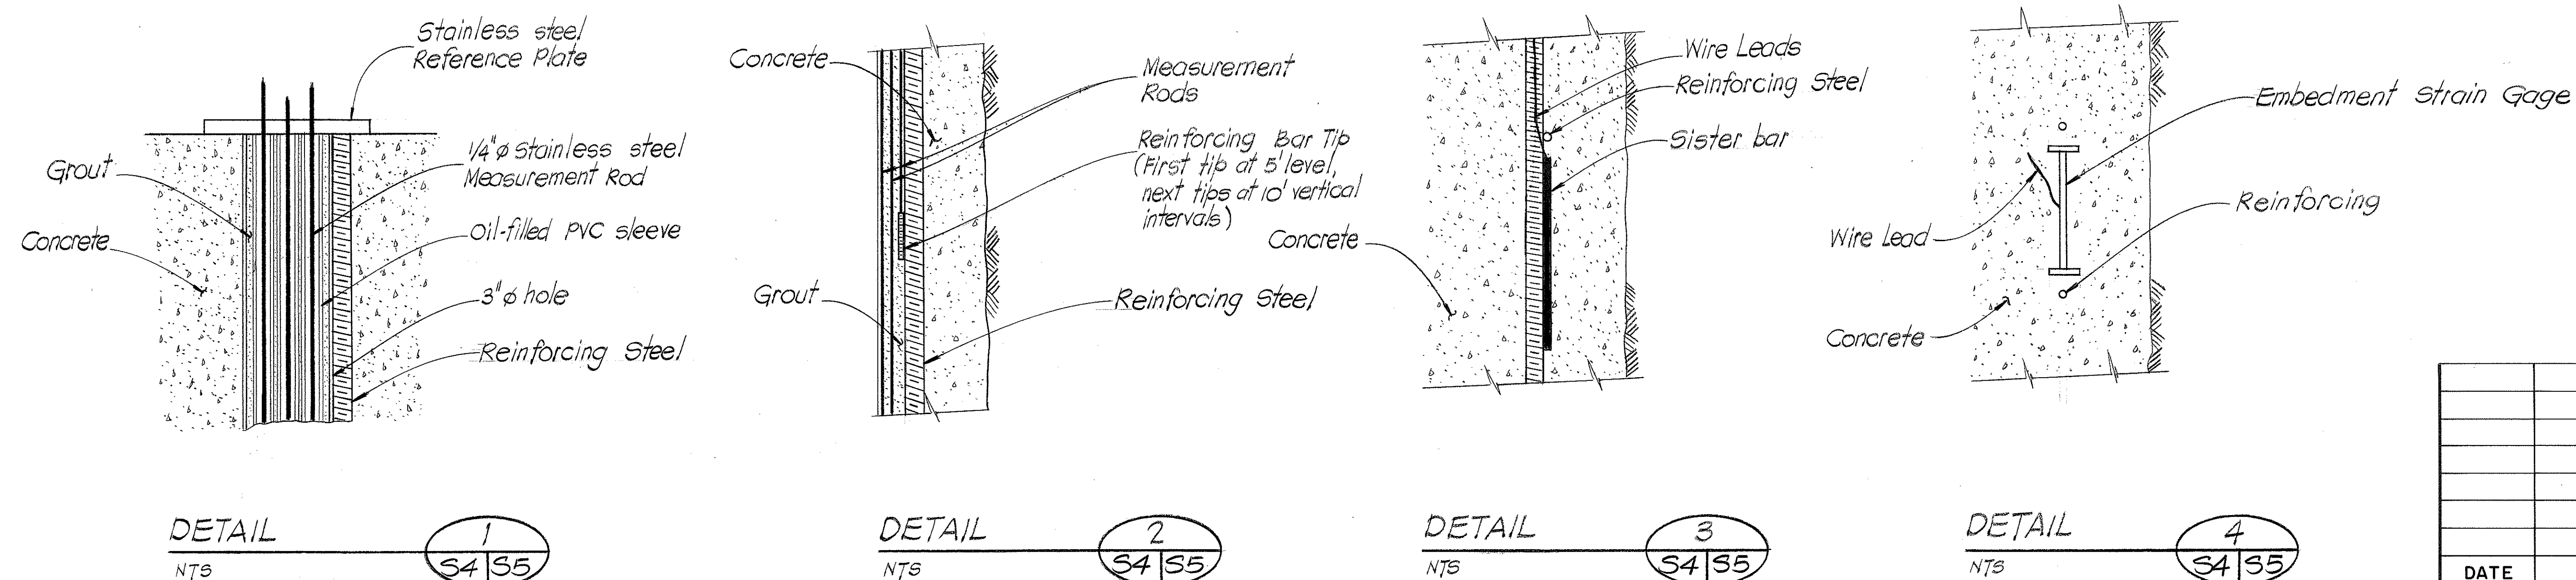


FED. ROAD DIST. NO.	STATE	FED. AID PROJ. NO.	FISCAL YEAR	SHEET NO.	TOTAL SHEETS
HAWAII	HAW.	I - H3 - J(67)	1990	6	11

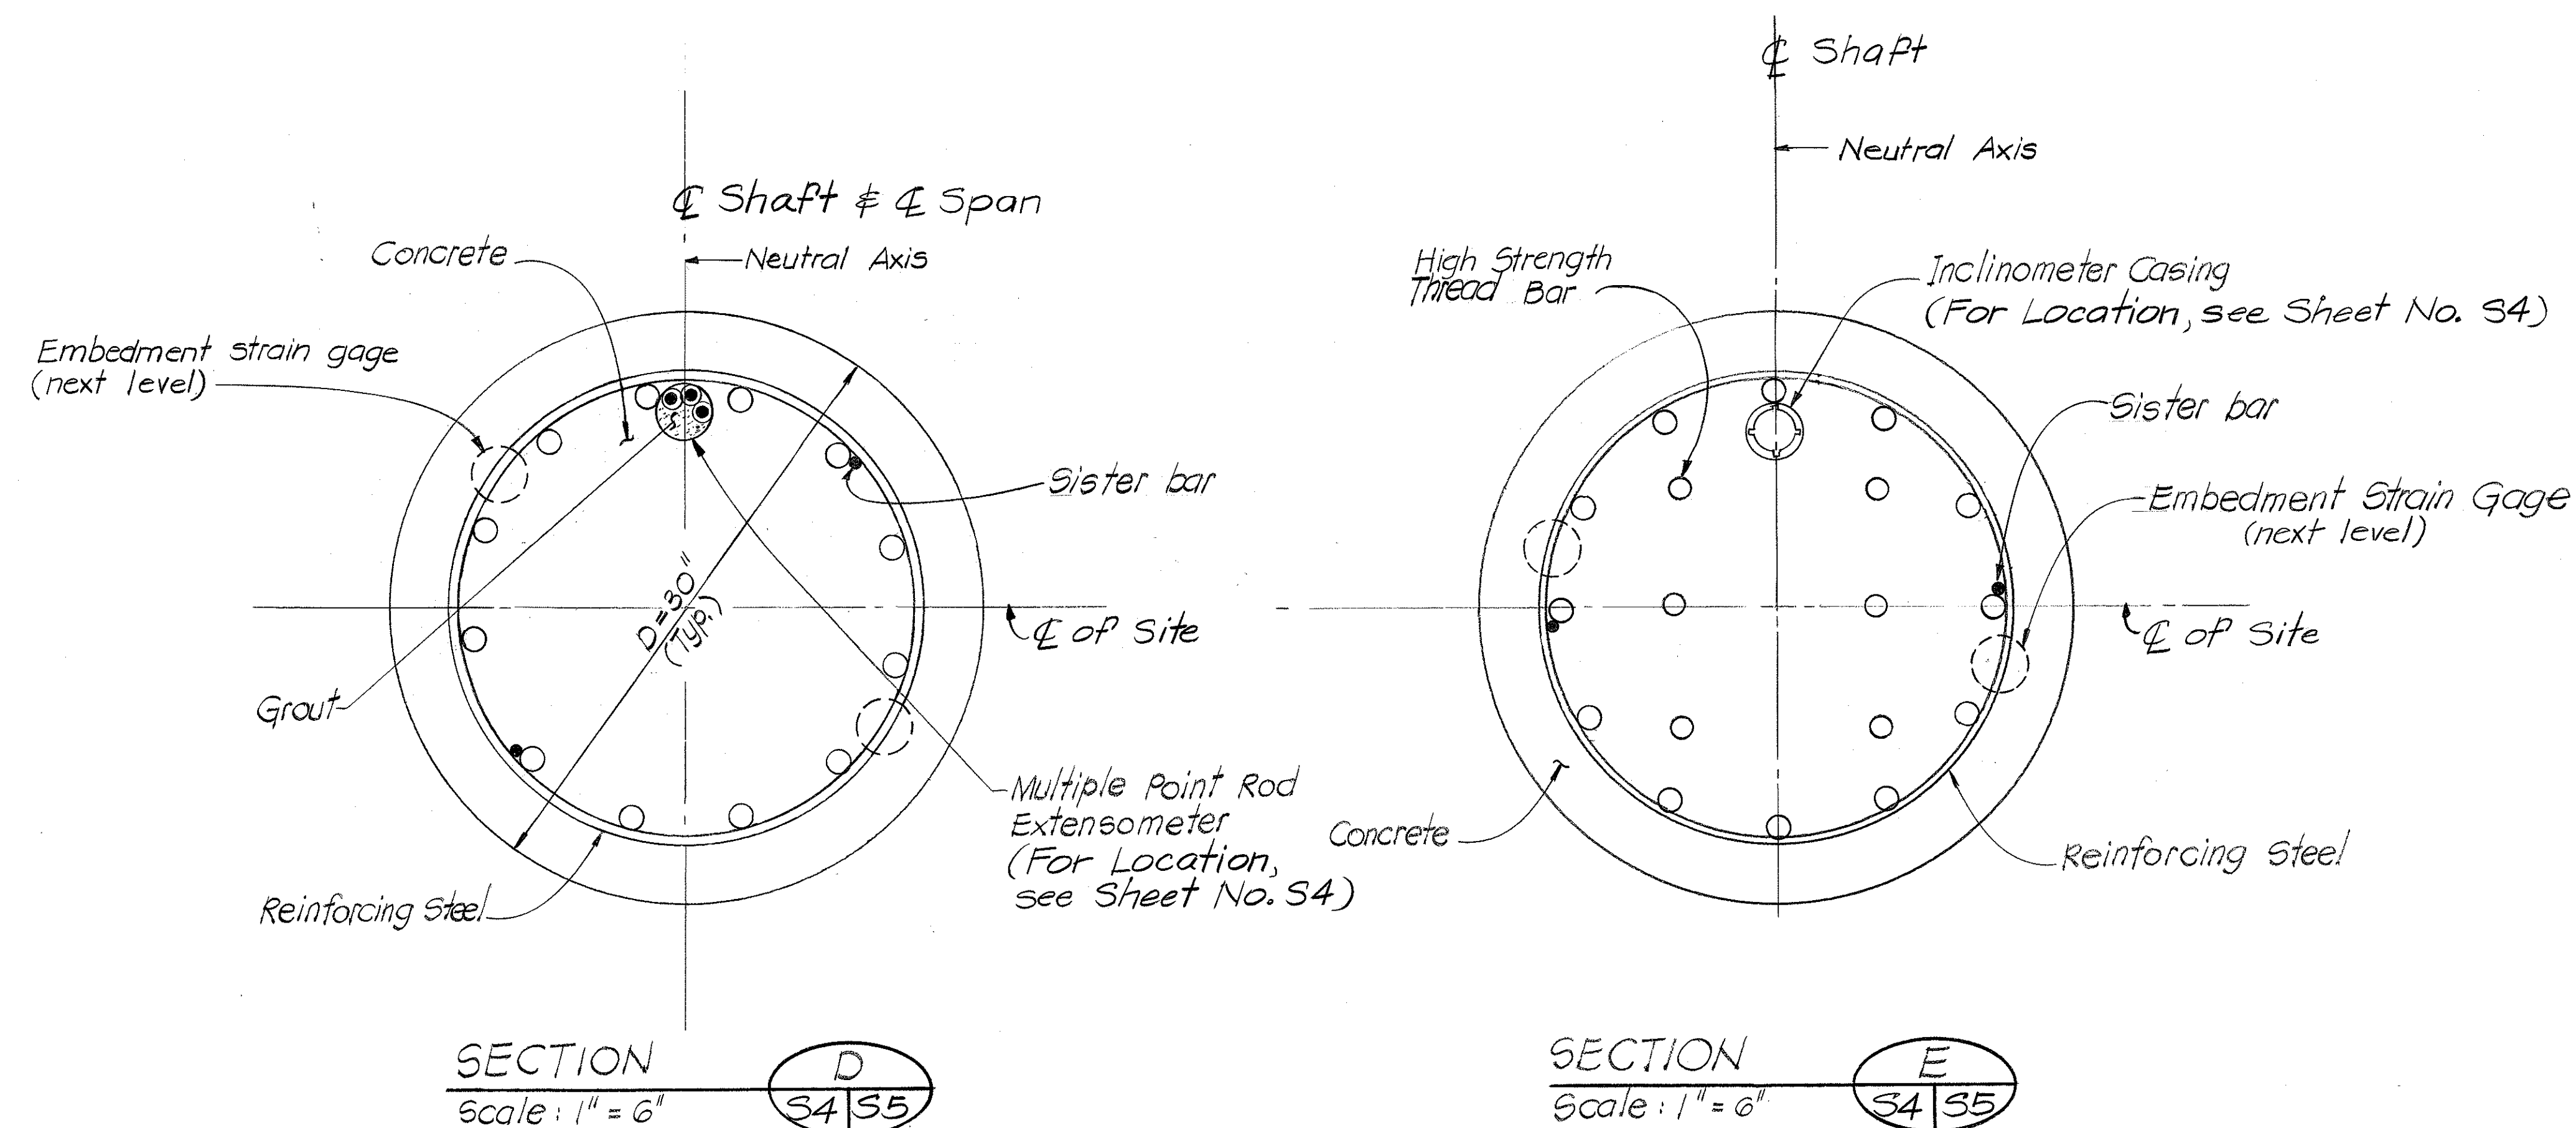

ORIGINAL PLAN	SURVEY PLOTTED BY <u>B. LEVITAS</u>	DATE <u>3/28/90</u>
NOTE BOOK	DRAWN BY _____	_____
	DESIGNED BY _____	_____
	TRACED BY <u>L. ABRAMSON</u>	<u>3/1/90</u>
	QUANTITIES BY _____	_____
	CHECKED BY _____	_____
No. _____		

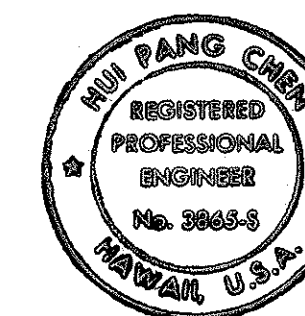

THIS WORK WAS PREPARED BY ME
OR UNDER MY SUPERVISION

Shirang Chen

DATE	REVISION

STATE OF HAWAII
DEPARTMENT OF TRANSPORTATION
HIGHWAYS DIVISION

SHAFT INSTRUMENTATION

DRILLED SHAFT TEST PROGRAM

INTERSTATE ROUTE H-3
F.A.I. PROJ. NO. I-H3-I (67)

SCALE : AS SHOWN
DATE : MAY, 1990

SHEET NO. S5
OF 10 SHEETS