



FED. ROAD DIST. NO.	STATE	FED. AID PROJ. NO.	FISCAL YEAR	SHEET NO.	TOTAL SHEETS
HAWAII	HAW.	I-H3-1(67)	1990	5	11

METHOD TEST SHAFT (A),
LENGTH= 70 FT.

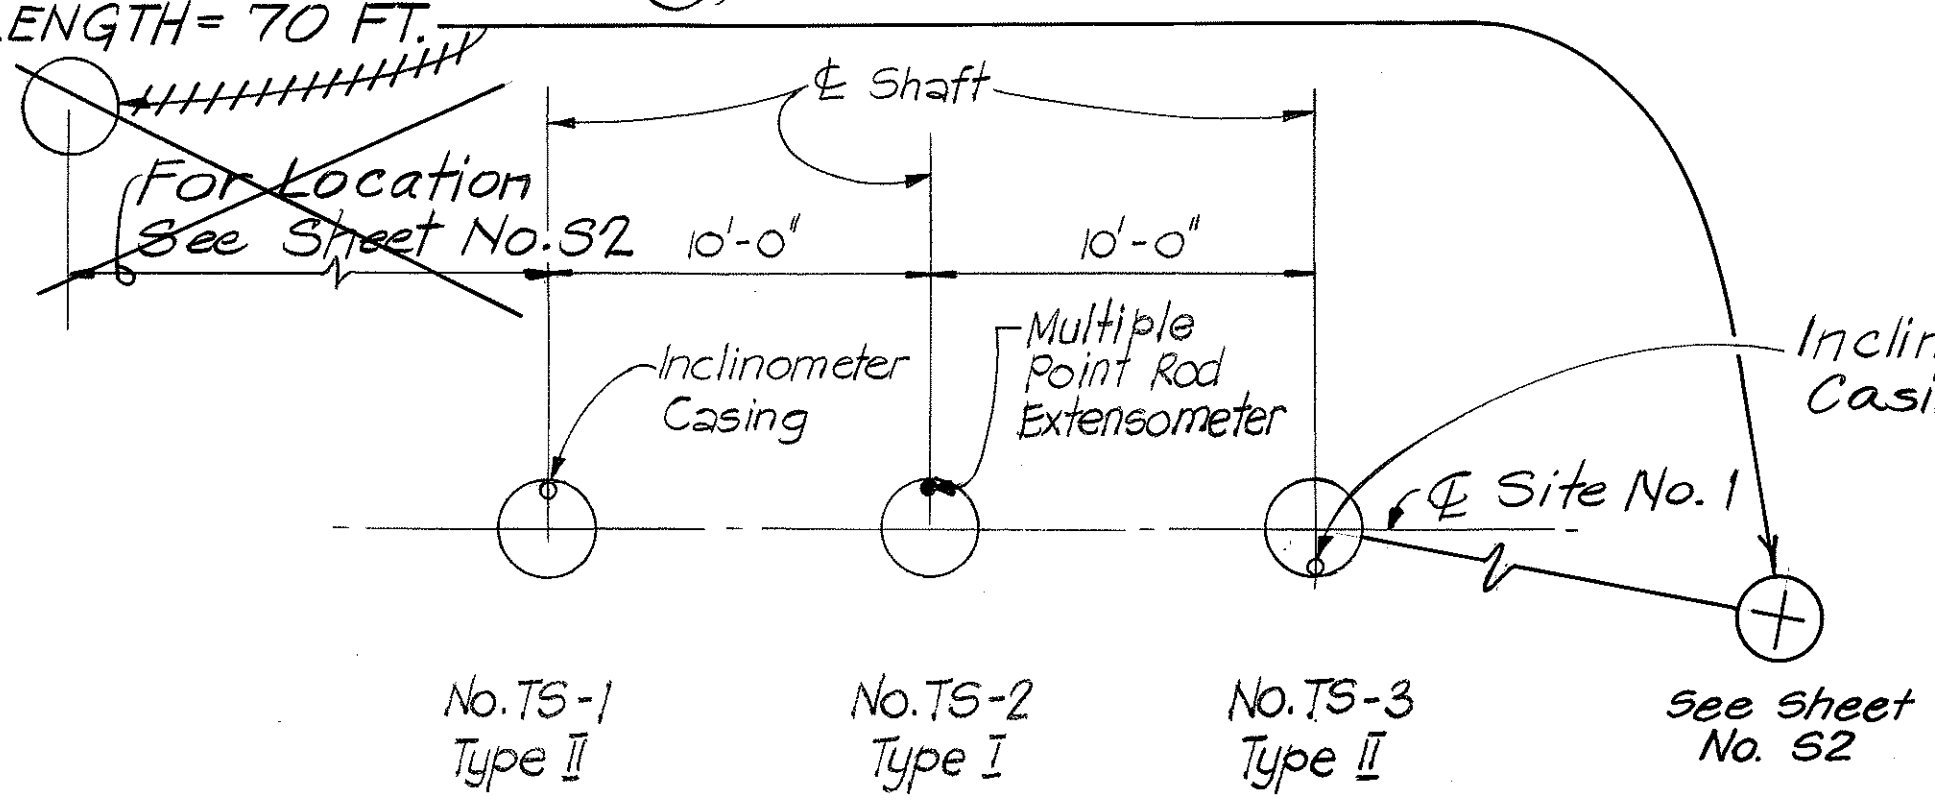


PLAN - SITE No. 1
Scale : 1" = 5'-0"


METHOD TEST SHAFT (B),
LENGTH= 40 FT.

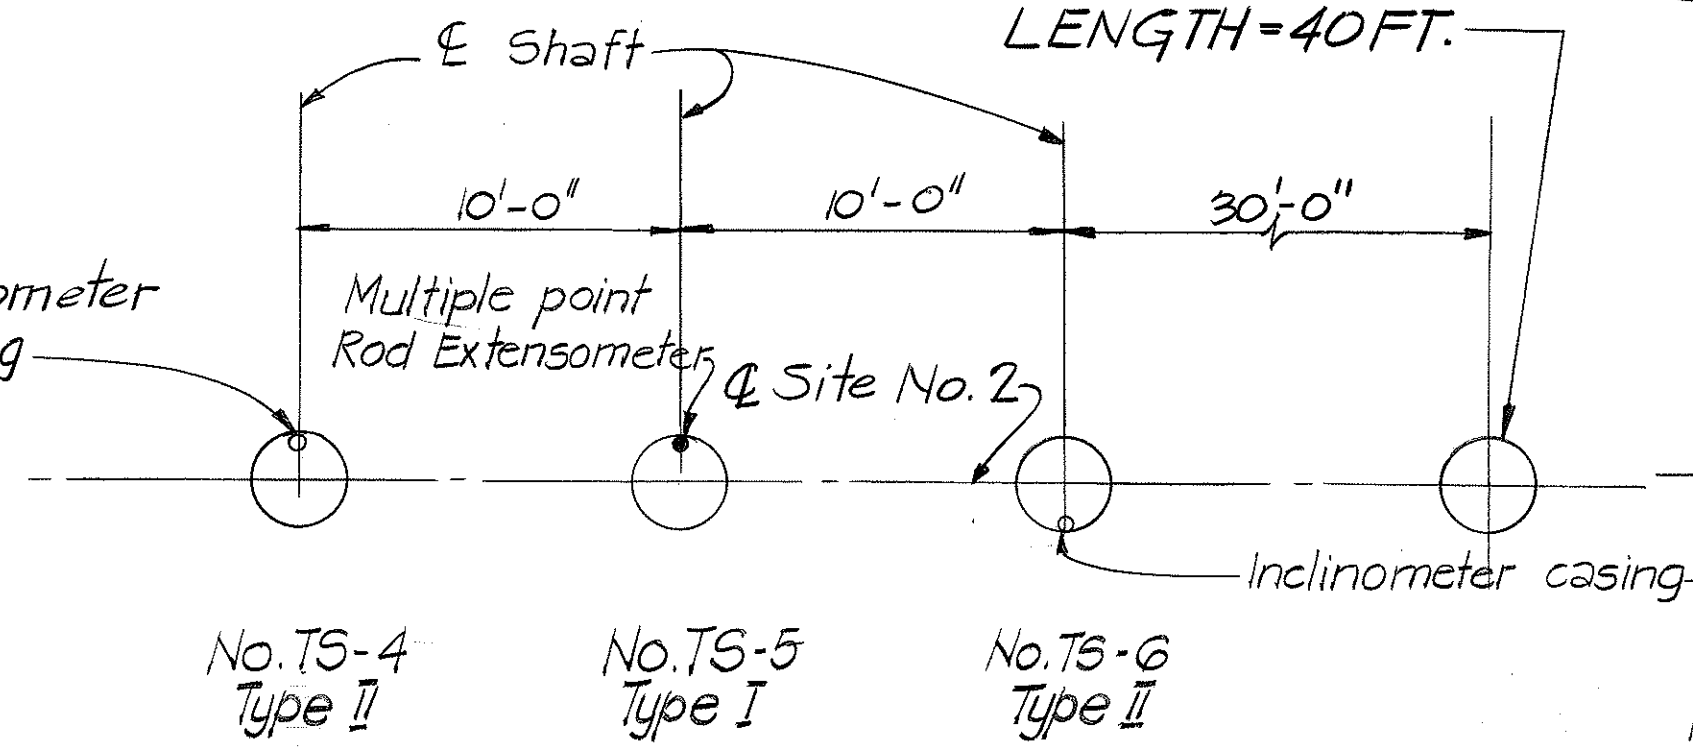

PLAN - SITE No. 2
Scale : 1" = 5'-0"

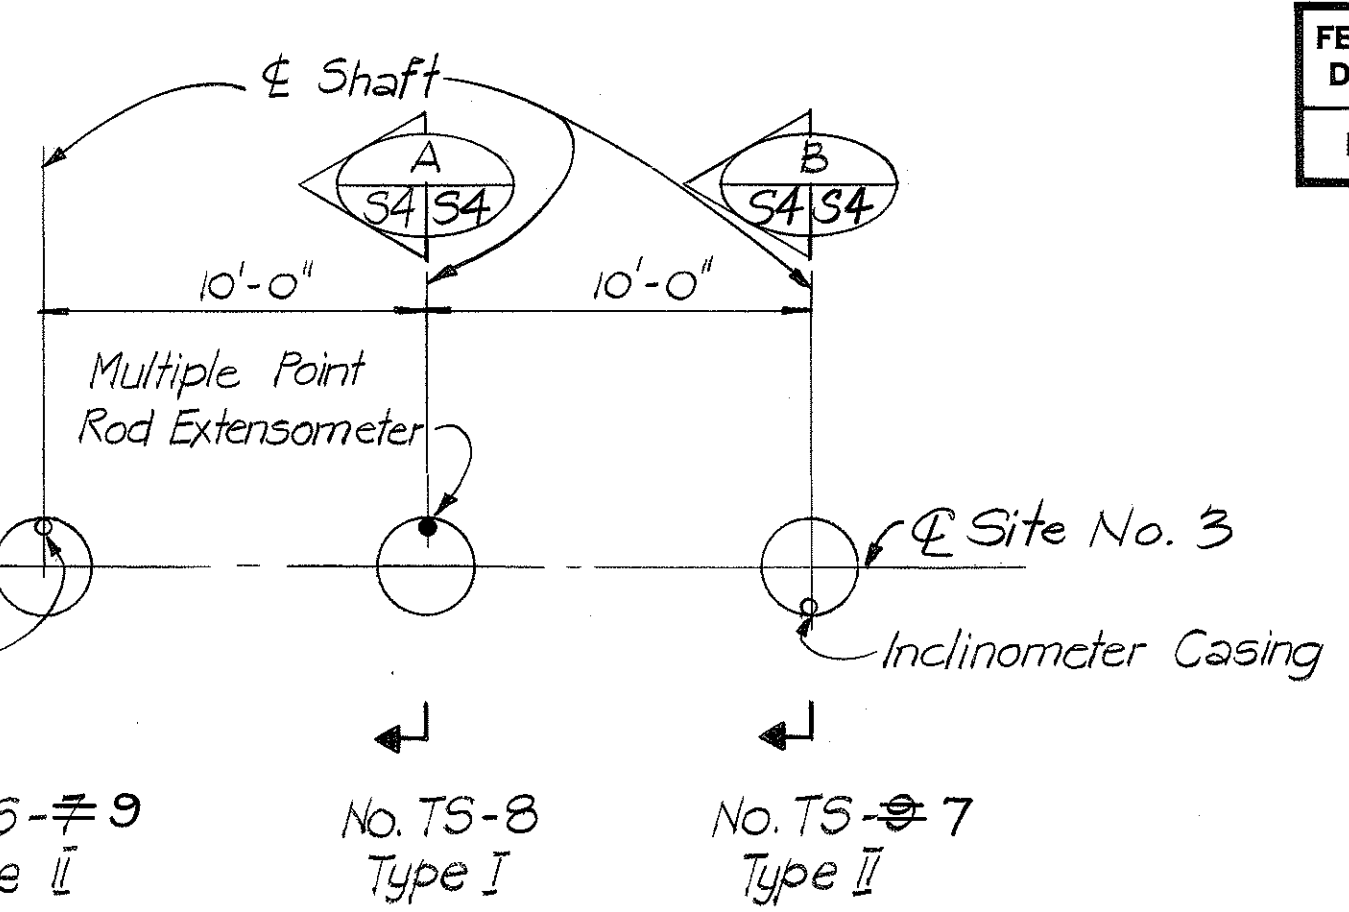

PLAN - SITE No. 3
Scale : 1" = 5'-0"

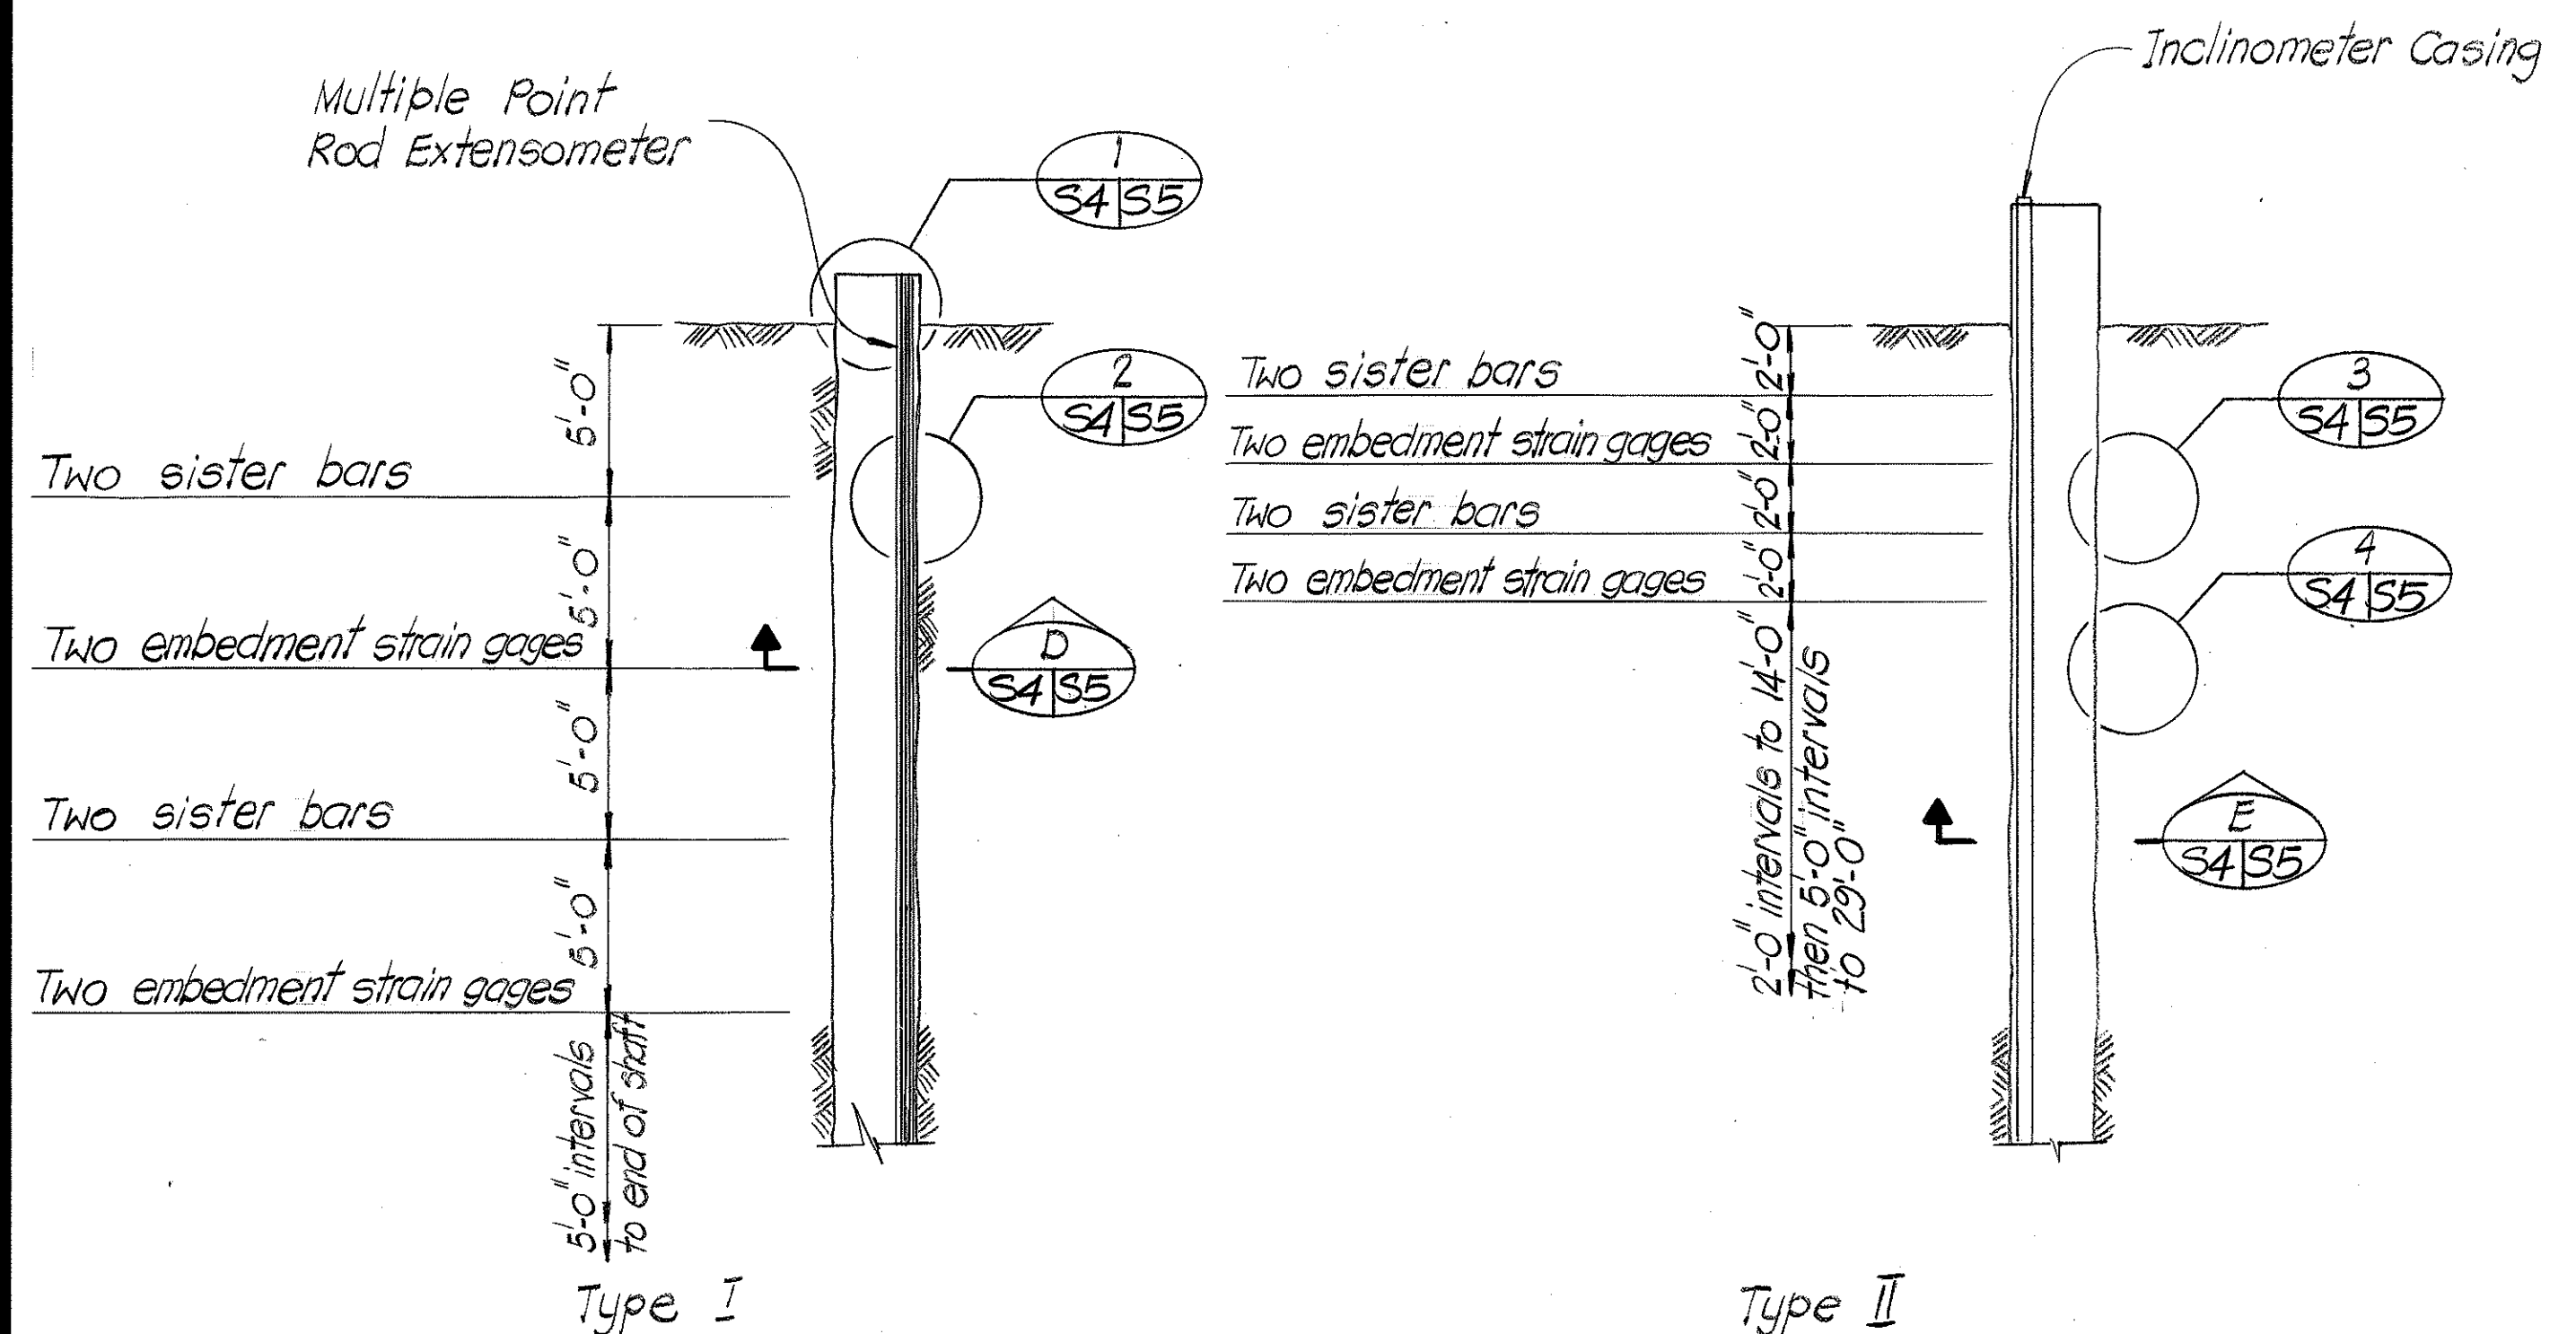

SECTION A
Scale : 1" = 5'-0"

SECTION B
Scale : 1" = 5'-0"

SCHEDULE OF INSTRUMENT TYPES

Shaft No.	Type	Est. Length ft.	Sister bars	Embedment Strain Gages	Multiple Point Rod Extens.	Inclinometer	Actual Length FT.
TS-1	II	70	X	X		X	73.3"
TS-2	I	70	X	X	X		56"
TS-3	II	70	X	X		X	71"
TS-4	II	40	X	X		X	
TS-5	I	40	X	X	X		
TS-6	II	40	X	X		X	
TS-7	II	60	X	X		X	73.3"
TS-8	I	60	X	X	X		56.2"
TS-9	II	60	X	X		X	73.6"

ORIGINAL PLAN	DATE
SURVEY PLOTTED BY	DATE
DRAWN BY	DATE
DESIGNED BY	DATE
QUANTITIES BY	DATE
CHECKED BY	DATE



THIS WORK WAS PREPARED BY ME
OR UNDER MY SUPERVISION
Nui Pang Chen

DATE	REVISION
STATE OF HAWAII DEPARTMENT OF TRANSPORTATION HIGHWAYS DIVISION	
INST. LAYOUT AND SCHEDULE DRILLED SHAFT TEST PROGRAM	
INTERSTATE ROUTE H-3 F.A.I. PROJ. NO. I-H3-1 (67)	
SCALE : AS SHOWN	DATE : MAY, 1990
SHEET NO. S4 OF 10 SHEETS	