



FED. ROAD DIST. NO.	STATE	FED. AID PROJ. NO.	FISCAL YEAR	SHEET NO.	TOTAL SHEETS
HAWAII	HAW.	I-H3-1(67)	1990	3	11

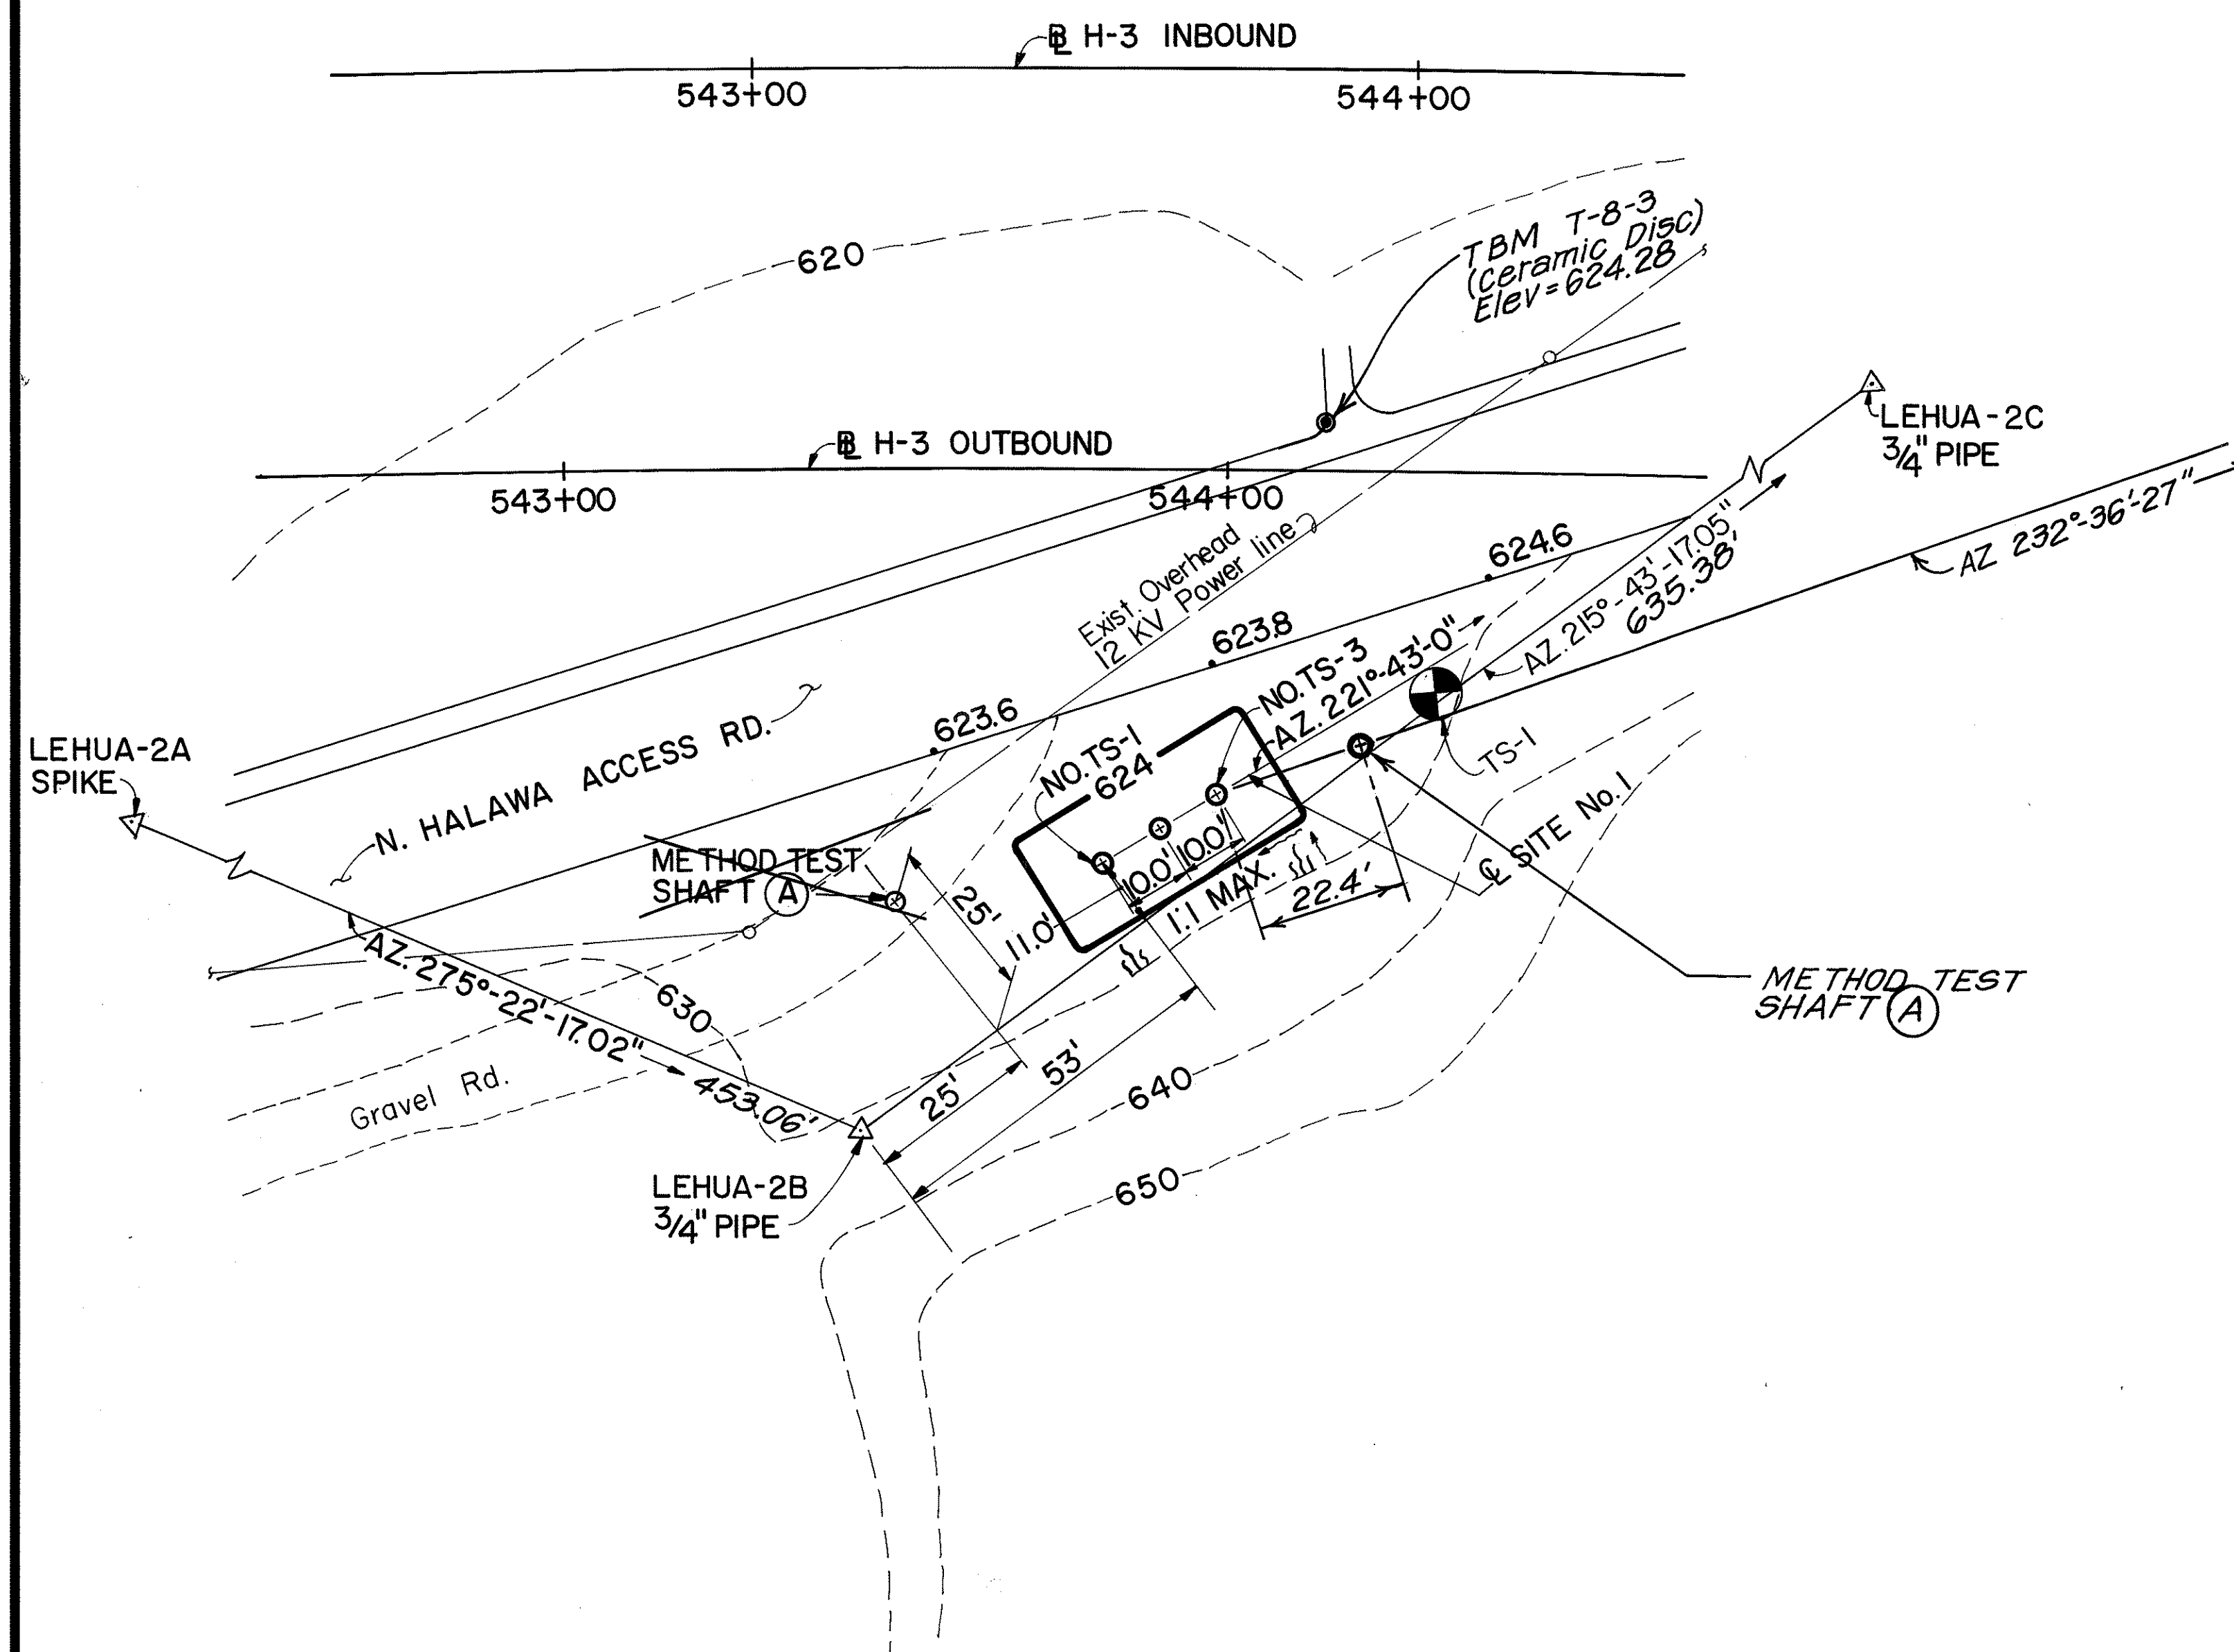

PLAN - SITE NO. 1

SCALE : 1" = 20'

ORIGINAL PLAN	SURVEY PLOTTED BY _____	DATE <u>3/27/90</u>
NOTE BOOK	DRAWN BY <u>R. MALALUAN</u>	"
	TRACED BY _____	"
	DESIGNED BY <u>K. WADA</u>	" <u>3/26/90</u>
	QUANTITIES BY _____	"
	CHECKED BY <u>H. P. CHEN</u>	" <u>3/26/90</u>
No. _____		

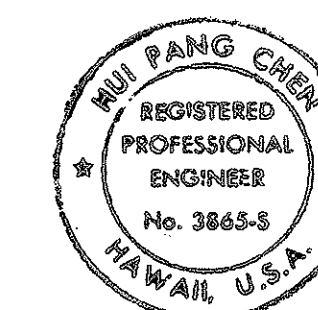

THIS WORK WAS PREPARED BY ME
OR UNDER MY SUPERVISION.

Shirong Chen

DATE	REVISION

STATE OF HAWAII
DEPARTMENT OF TRANSPORTATION
HIGHWAYS DIVISION

SITE PLANS

DRILLED SHAFT TEST PROGRAM

INTERSTATE ROUTE H-3
F.A.I. PROJ. NO. I - H3 - I (67)

SCALE: 1" = 20'
DATE: MAY, 1990


SHEET No. S2 OF 10 SHEETS

[illegible]


SITE PLANS

DRILLED SHAFT TEST PROGRAM

SCALE : 1" = 20' DATE : MAY, 1990

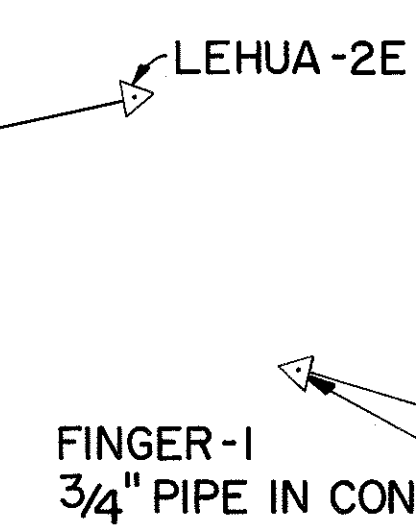

THIS WORK WAS PREPARED BY ME
OR UNDER MY SUPERVISION.
Shirong Chen

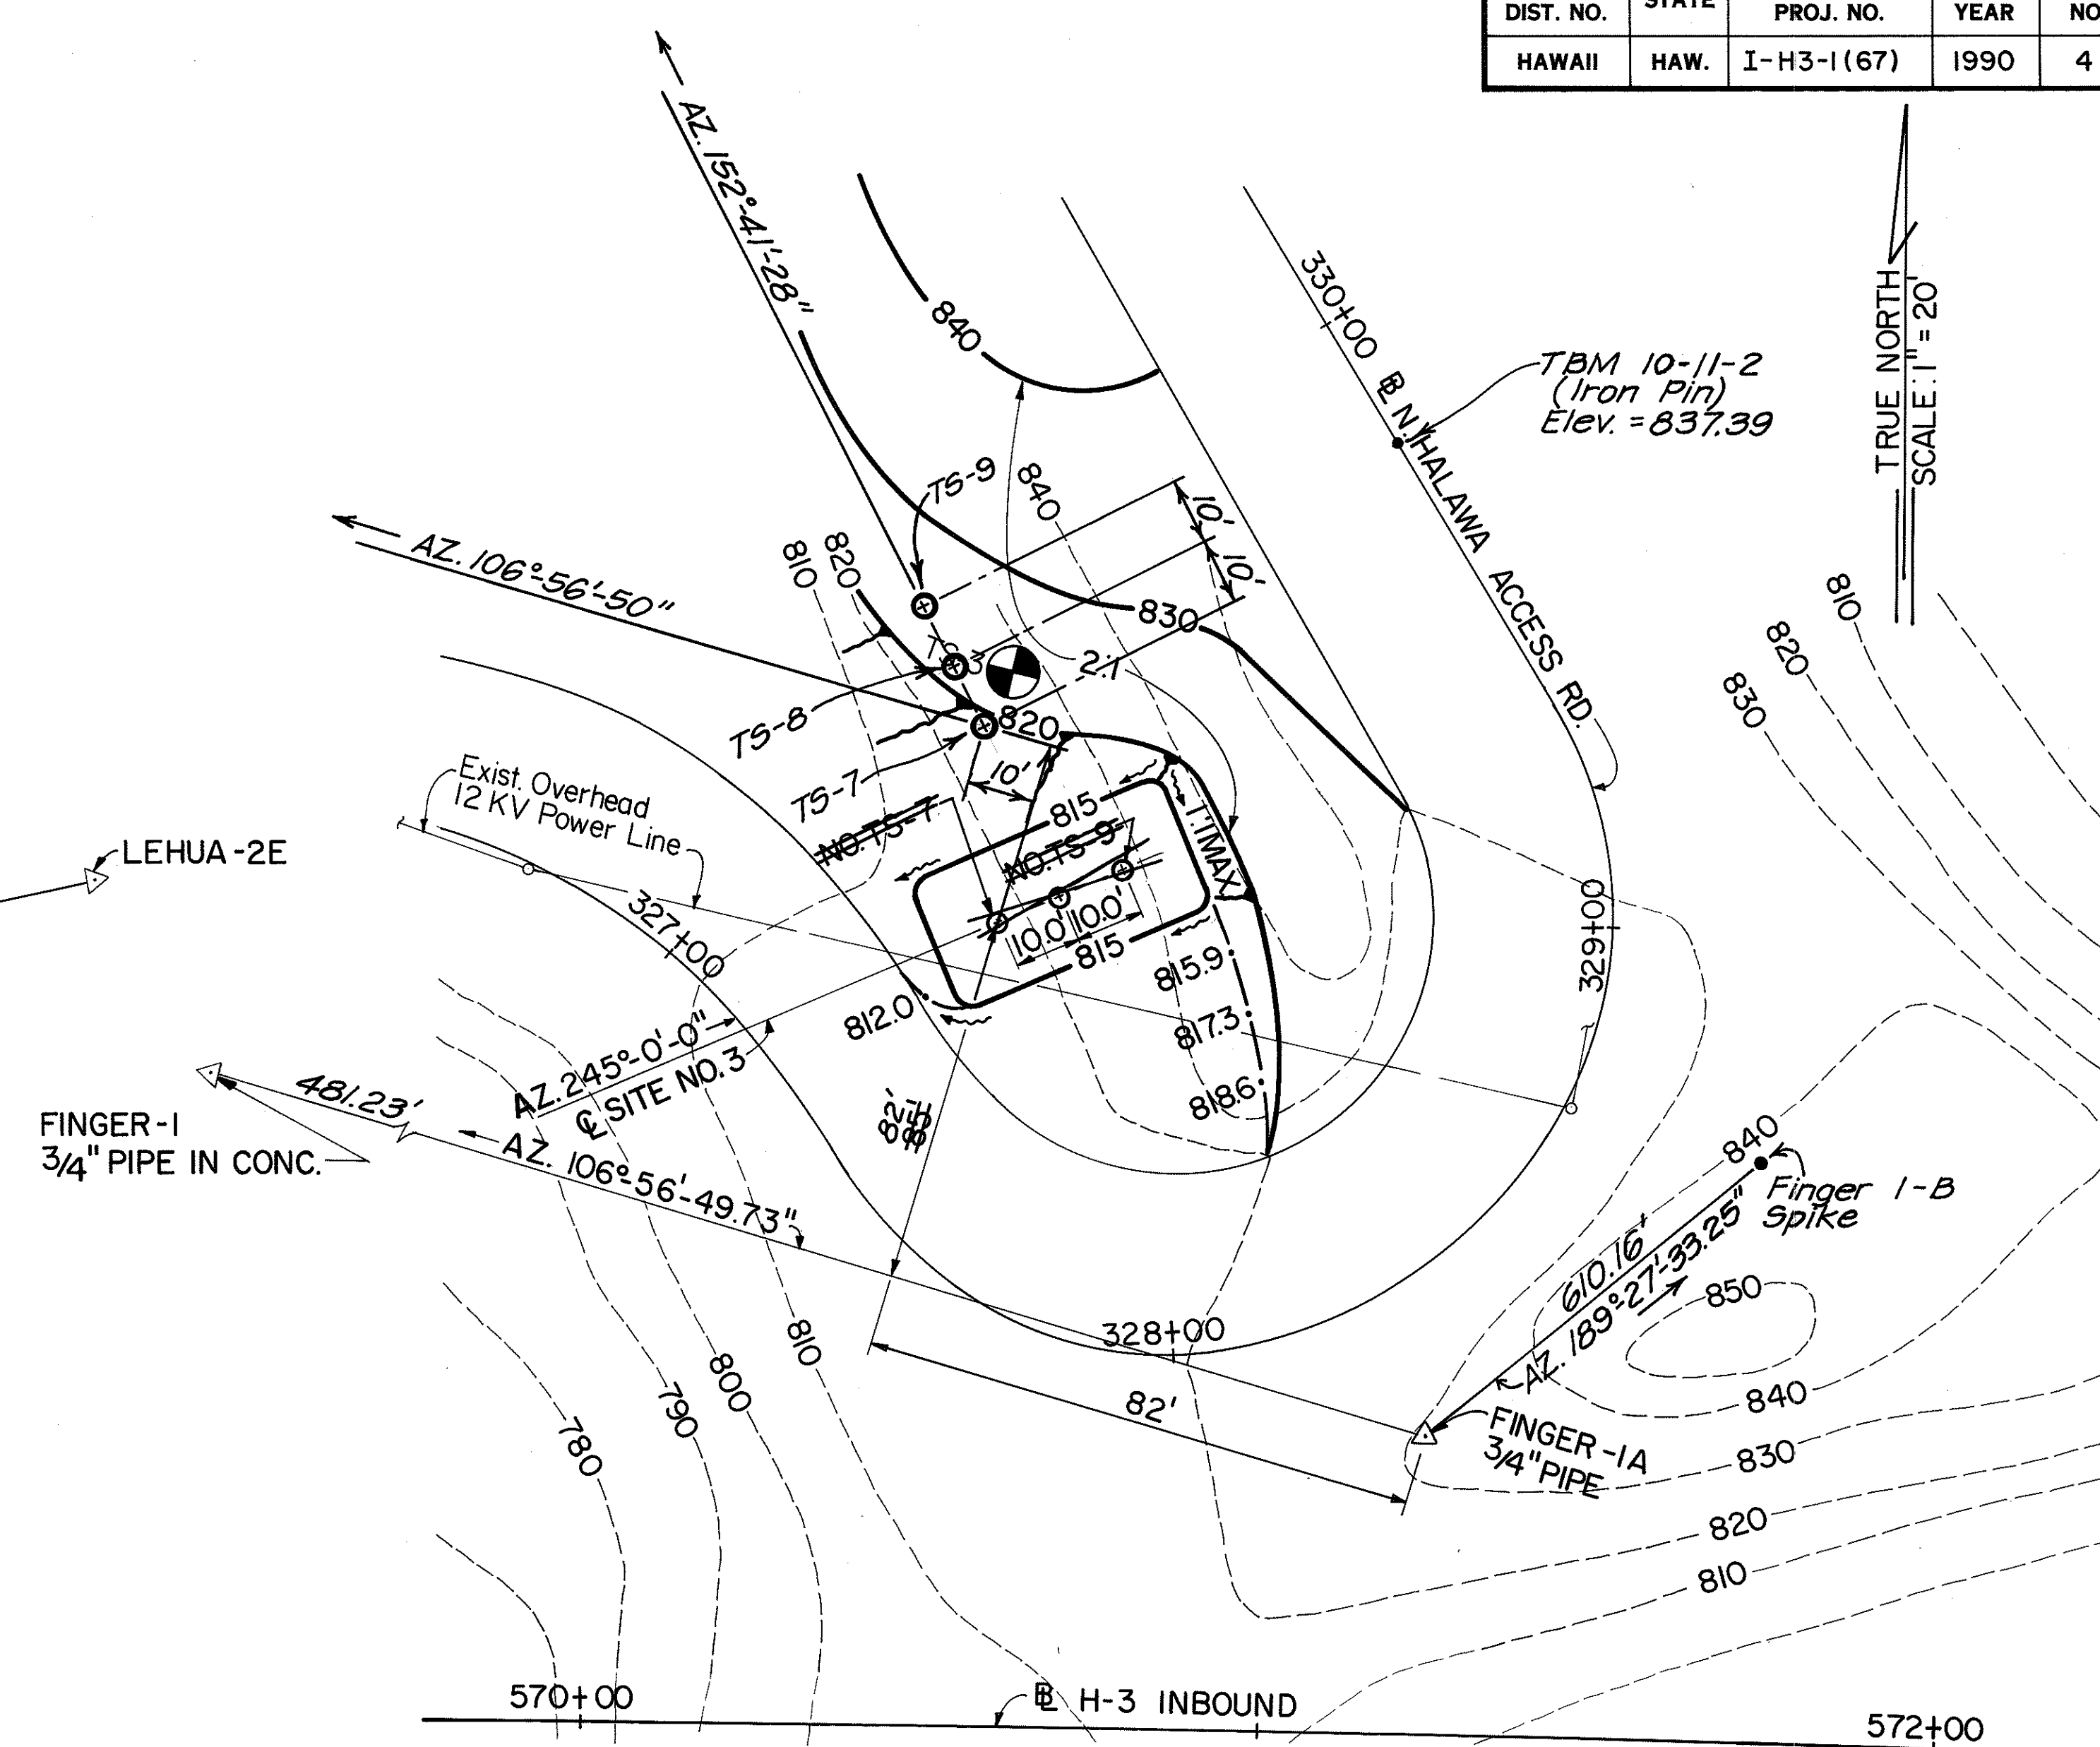

PLAN - SITE NO. 3
SCALE: 1" = 20'

ORIGINAL PLAN	SURVEY PLOTTED BY _____ DATE <u>3/21/90</u>
	DRAWN BY <u>R. MALALUAN</u>
NOTE BOOK	TRACED BY _____
	DESIGNED BY <u>G. PANG</u>
	QUANTITIES BY _____
No. _____	CHECKED BY <u>H. P. CHEN</u> DATE <u>3/20/90</u>