	and resources.
	INDEX TO DRAWINGS
SHEET NO.	DESCRIPTION
l	TITLE SHEET
2	GENERAL PLAN & NOTES
3 - 4	SITE PLANS
5	SHAFT LAYOUT AND SCHEDULE
6	SHAFT INSTRUMENTATIONS
7	DRILLED SHAFT DETAILS
8	LOAD FRAME DETAILS
9	LOAD TEST SET-UP
10 - 11	BORING LOGS

STATE OF HAWAII

DEPARTMENT OF TRANSPORTATION

HIGHWAYS DIVISION

HONOLULU, HAWAII


"AS-BUILT"
PLANS FOR


CONSTRUCTION OF A PORTION OF

INTERSTATE ROUTE H-3

DRILLED SHAFT TEST PROGRAM
FEDERAL AID INTERSTATE PROJECT NO. I - H3-1(67)

DISTRICT OF EWA ISLAND OF OAHU

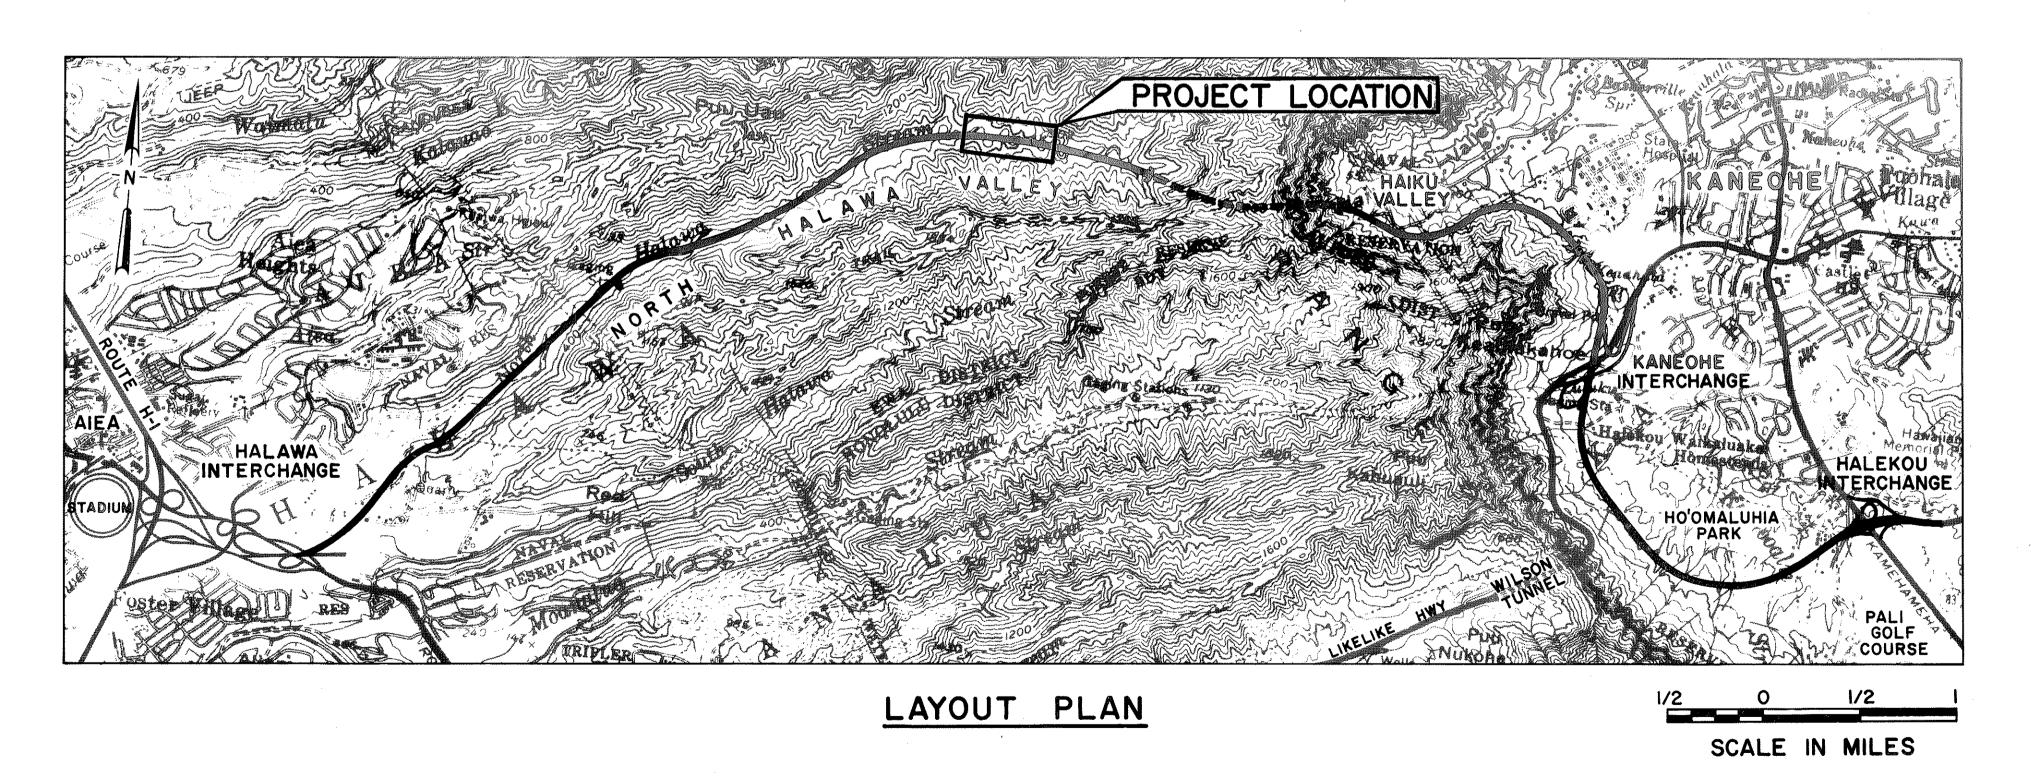

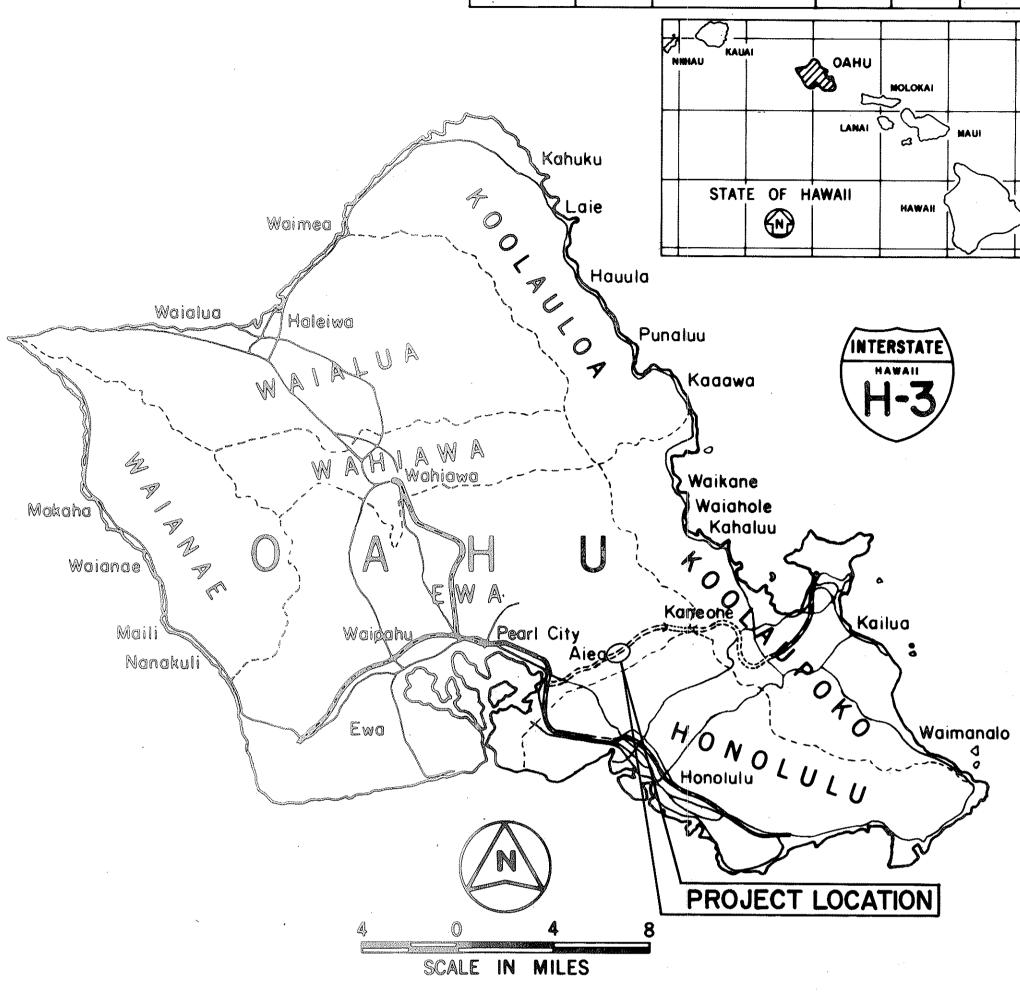

FED. ROAD DIST. NO. FED. AID PROJ. NO.

FEDERAL AID INTERSTATE PROJECTS PREVIOUSLY CONSTRUCTED OR UNDER CONSTRUCTION

ALL CHANGES MADE DURING CONSTRUCTION HAVE BEEN INCORPORATED ON THESE PLANS IN RED EXCEPT CHANGES IN THE ORIGINAL THEORETICAL QUANTITIES. FOR ACTUAL QUANTITIES, REFER TO PROJECT LEDGER AND/OR COMPUTATION BOOK.

RESIDENT ENGINEER

DATE

DEPARTMENT OF TRANSPORTATION FEDERAL HIGHWAY ADMINISTRATION APPROVED:

JUDITHUS 6/20/9

DEPARTMENT OF TRANSPORTATION
STATE OF HAWAII

APPROVED:

Khuns fhu S/10/90
DIR. OF TRANSPORTATION DATE

YAMAMOTO 548-6158 MA

PBHA